CALL BEFORE

YOU DIG!

STATEWIDE

1-800-321-ALERT

ALBUQUERQUE

260-1990

QWEST


(505)245-8706

201 Third Street NW, Suite 700 Albuquerque, New Mexico 87103

G001



IMPROVEMENTS TO ERNA FERGUSSON LIBRARY

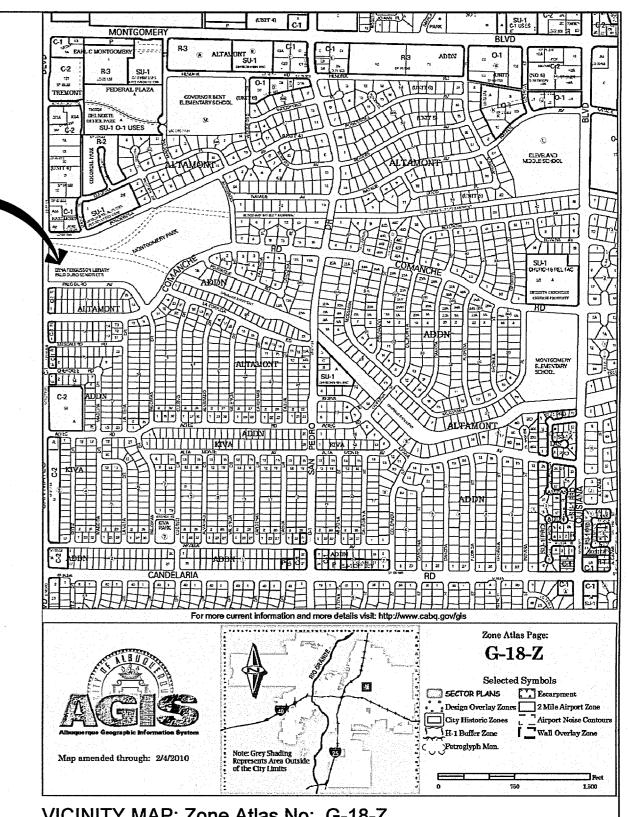

CITY OF ALBUQUERQUE ALBUQUERQUE/BERNALILLO COUNTY LIBRARY SYSTEM - Managing Department

Cultural Services Department

May 18, 2011 Cultural Services Department-Owner PHASE 1 - NIC. WORK COMPLETED PHASE 2 - NEW CONSTRUCTION

CHERRY/SEE/REAMES

ARCHITECTS, LLP

220 gold avenue sw albuquerque, nm 87102

605 - 842 - 1278 fax 505 - 766 - 9269

Property Information

Property Address: 3700 San Mateo Blvd. NE

Zone: R-1 Public Library **Building Improvements**

Legal Description

The western portion of Montgomery Park, Altamont Addition, Albuquerque, New Mexico, as the same is shown and designated on the plat filed in the Office of the County Clerk of Bernalillo County, New Mexico on February 9, 1953, book D1, page 82.

Consultants

Harmeyer Nellos Engineering - Mechanical Engineers 505 888 5808

The Response Group - Electrical Engineers 505 323 7629

Bacchus Consulting Engineering - Structural Engineers 505 262 2471

Index of Drawings

TITLE SHEET

CODE ANALYSIS

2. G101

3.	AS101	SITE PLAN
4. 5	S100 S101	STRUCTURAL DESIGN CRITERIA, MATERIALS & GENERAL NOTES COVERED LOADING DOCK STRUCTURAL PLAN, ELEVATIONS & SECTIONS
	S101	WEST WALL WINDOWS STRUCTURAL ELEVATION & SECTIONS
7.	S103	NEW ROOFTOP HVAC UNIT SUPPORT STRUCTURAL PLAN & DETAILS
8.	A001	GENERAL INFORMATION, SYMBOLS, REFERENCE AND STANDARDS
9.	A010	DEMOLITION PLAN
10.	A101	FLOOR PLAN
11.	A102	REFLECTED CEILING PLAN & ROOF PLAN

12. A201 **EXTERIOR ELEVATIONS**

13. A301 WALL SECTIONS

14. A401 INTERIOR ELEVATIONS

15. A501 **WINDOW & DOOR DETAILS**

16. A601 DOOR & FRAME ELEVATIONS & SCHEDULE, ROOM FINISH SCHEDULE

17. M101 HVAC FLOOR PLAN & ROOF PLAN 18. M601 MECHANICAL EQUIPMENT SCHEDULES

19. E101 DEMO / LIGHTING FLOOR PLAN 20. E102 **POWER & SPECIAL SYSTEMS FLOOR PLAN** 21. E501 ELECTRICAL LEGEND AND FIXTURE SCHEDULE RECORD SET OF DRAWINGS This set of drawings is provided by the Contractor as a schematic of the project in place. The Architect has not verified these conditions and is not responsible for conclusions drawn

CHERRY/SEE/REAMES ARCHITECTS 4/13/2012

UTILITY COMPANY CONTACTS

CITY OF ALBUQUERQUE **UTILITY DEVELOPMENT**


P.O. Box 1293 Albuquerque, New Mexico 87103 (505)768-2719/Bob Strong/Utility Coordination

Albuquerque, New Mexico 87107 (505)241-0525

PNM-ELECTRIC

4201 Edith Boulevard NE

PNM-GAS 4625 Edith Boulevard NE Albuquerque, New Mexico 87107 (505)241-7745

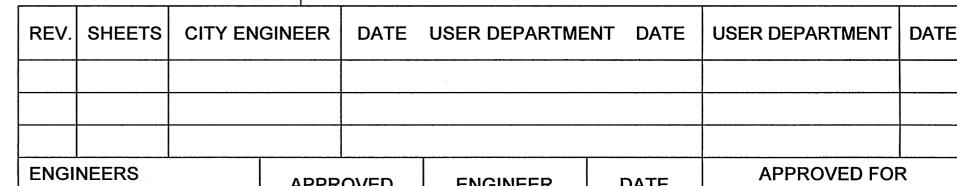

ENGINEERS STAMP & SIGNATURE		APPR	OVED	ENGINEER	DATE	APPROVE CONSTRU			
		DRC Cha	airman						
TINA M. CO REAMES AND 3772		Transpor	tation						
	TINA M. S.	Water/W	astewater			City Architect	D	ate	
		Hydrolog	у						
	3772	3772	Parks						
		Constr. N	Ingmt.			City Engineer	D	ate	
5/19/11				÷				*	
DA	TE: 5/18/2	2011	PROJE	CT#		7168.03	Sheet G001	Of	21

ORD E: 4

GENERAL PURPOSE OF PROJECT

TO PROVIDE SPACE FOR MORE PUBLIC ACCESS COMPUTER STATIONS. DUE TO BUDGET CONSTRAINTS. THIS PURPOSE IS TO BE ACCOMPUSHED IN TWO PHASES. THERE ARE CURRENTLY 16 PUBLIC ACCESS COMPUTERS. THESE RENOVATIONS WILL ADD ANOTHER 20 STATIONS FOR A TOTAL OF 36 STATIONS.

THESE DRAWINGS CONTAIN WORK FOR BOTH PHASE 1 AND PHASE 2 OF THE PROJECT. WORK FOR PHASE 2 TO BE COMPLETED AS PART OF THIS CONTRACT. PHASE 1 WORK IS NOT IN CONTRACT AND HAS ALREADY BEEN COMPLETED.

PHASE 1

PURPOSE OF PHASE 1: TO ENCLOSE EXISTING, EXTERIOR DELIVERY SPACE FOR DELIVERY AND SORTING; REMODEL EXISTING STORAGE ROOM INTO OFFICE SPACE: AND REMODEL EXISTING SORTING AREA INTO WORK SPACE AND WORK STATIONS AND OTHER WORK NOTED IN PHASE 1 ON THE DRAWINGS.

- 1. ADD KALWALL AND RELOCATED DOOR TO COVERED DELIVERY TO ENCLOSE. 2. REMOVE DOOR A103 BETWEEN COVERED DELIVERY 101 AND DELIVERY 103. BECOMES OFFICE 101R AND OFFICE 103R. TO BE USED FOR DELIVERY,
- BOOK SORTING AND OTHER WORK ROOM TASKS.
- 3. CHANGE STORAGE 102 TO OFFICE 102R WITH 2 WORK STATIONS. USE FURNITURE, NOT BUILT-IN CASEWORK.
- 4. CUT 3 NEW WINDOWS IN OFFICE 103R. NEW TOP FOR CASEWORK.
- 5. REPAIR FINISHES AND PAINT REWORK DRAINAGE OF SERVICE YARD
- RELOCATE OFFICE FUNCTIONS INTO OFFICE 102R AND OFFICE 103R IN PREPARATION FOR PHASE II.
- REWORK MECHANICAL AND ELECTRICAL SERVICE AS REQUIRED. EXISTING COVERED DELIVERY 101 WILL BECOME AN ENCLOSED SPACE. 9. INSULATE WEST WALL OF ROOM 101R.

PHASE 2

PURPOSE OF PHASE 2: TO RELOCATE OFFICE FUNCTIONS OUT OF OFFICE 107 TO ALLOW RELOCATION OF STACKS INTO THAT AREA WHICH FREES UP SPACE FOR MORE PUBLIC ACCESS COMPUTER STATIONS AND OTHER WORK NOTED IN PHASE 2 ON THE DRAWINGS.

- 1. REWORK VESTIBULE ENTRY TO RESTROOM
- MOVE DOOR A104 NORTH REMOVE PORTIONS OF LOAD-BEARING WALL BETWEEN STACKS 107R AND PUBLIC AREA TO ALLOW ENTRY TO STACKS 107R.
- 4. NEW PARTIAL PARTITION TO CLOSE OFF WORK ROOM 104R FROM STACKS 107R

5. RELOCATE STACKS FROM PUBLIC AREA INTO STACKS 107R. 6. ADD COMPUTER TABLES, SEATS, AND COMPUTERS REWORK MECHANICAL AND ELECTRICAL SERVICE AS REQUIRED. A NEW HVAC UNIT AND SUPPLY WILL BE ADDED. STRUCTURAL IS REQUIRED FOR NEW LINTELS IN LOAD-BEARING WALL. ---

GENERAL PROJECT NOTES 1. APPLICABLE CODES, LAWS, RULES & REGULATIONS: a. ADA & ABA ACCESSIBILITY GUIDELINES FOR BUILDINGS AND **FACILITIES** OSHA 1926 FOR CONSTRUCTION

2008 UNIFORM ADMINISTRATIVE CODE — EXHIBIT A 2008 UNIFORM ADMINISTRATIVE CODE ORDINANCE

2. ALL EXITS AND EXIT—WAYS ARE TO REMAIN OPEN THROUGHOUT THE CONSTRUCTION. 3. NO PATRONS WILL BE ALLOWED IN ANY WORK AREAS DURING CONSTRUCTION ACTIVITIES. THE CONTRACTOR SHALL COORDINATE WITH THE

OWNER'S REPRESENTATIVES. 4. ALL CONSTRUCTION ACTIVITIES SHALL COMPLY WITH THE LATEST VERSION OF OSHA SAFETY AND HEALTH REGULATIONS.

LEGEND ROOM OCCUPANT NUMBER EXIT LIGHT **EMERGENCY FIXTURE** PANIC HARDWARE FIRE EXTINGUISHER & CABINET DRINKING FOUNTAIN IBC OCCUPANCY LOADS PER IBC 1:XXX TABLE 1004.1.2 DISTANCE FROM EXIT

00'-00"

ZONING

The site is zoned SU-2 per Zoning Atlas G-18-Z. Conditional use was approved prior to construction.

No new parking is being provided. 79 regular spaces, 16 small car, and 4 handicapped spaces are existing.

CODE ANALYSIS PER IEBC 2006

CHERRY/SEE/REAMES

ARCHITECTS, LLP

220 gold avenue sw albuquerque, nm 87102

505 - 842 - 1278 fax 505 - 766 - 9269

ANALYSIS PER CHAPTER 7: ALTERATIONS - LEVEL 2 No new area is being added to the building. No occupancy changes are being made.

SECTION 703: BUILDING ELEMENTS AND MATERIALS The building contains no vertical openings or stairs.

SECTION 704: FIRE PROTECTION: SPRINKLERS

No sprinklers are required per 704.2.2

SECTION 704: FIRE PROTECTION: FIRE ALARMS

The existing building is protected throughout with a fire alarm system. This system will be maintained and redone in the altered rooms.

SECTION 705: MEANS OF EGRESS

705.3 The existing building has seven exterior doors for a total of 324 inches. Exit distance does not exceed 75' distance to

705.4.1 All doors to the exterior in the A-3 occupancy have panic hardware or break away functions on the east entry sliding

705.4.2 All doors swing in the direction of exit travel.

705.7 There is emergency lighting throughout the building. 705.8 All exterior exits have powered exit signs with emergency back-up.

SECTION 706: ACCESSIBILITY

The existing building conforms to ANSI A117.1-2003. All new doors and renovated spaces conform to ANSI A117.1-2003 and ADA & ABA Accessibility Guidelines for Buildings and Facilities, 7/23/04 gmended 8/5/05.

SECTION 707: STRUCTURAL

In Office 101R, three new 3'-4" wide windows are being cut in a 41'-4" long steel reinforced masonry wall. Horizontal steel frames will be used at the new openings. The existing reinforced masonry above the windows will support the bar joists and roof loads above the three windows. Lateral loads reduction on the 41'-4" wall will be insignificant, less than 10% allowed at the three new openings. At Stacks 107R south openings, conventional steel frame headers will be used, supporting the dead load above. This wall does not have One new rooftop HVAC unit will be added. Existing structure can carry the unit and ductwork.

Lights will be changed and switches will be moved. New power circuits will be added to existing panels. Existing panels have sufficient power and spaces for all new upgrades. All new work will be in compliance with NEC and IBC 2009 Sections 2701 & 2702.

SECTION 709: MECHANICAL

An additional cooling unit will be added and duct work run to the Computer Area 108R for additional cooling to the Computer Area. This will increase air flow and air changes in the building. All new mechanical work will be per the 2006 New Mexico Mechanical Code and IBC 2009 Chapter 29, Mechanical Systems.

SECTION 710: PLUMBING

No new plumbing takes place in this alteration.

SECTION 711: ENERGY CONSERVATION

No new space is being added requiring IECC upgrades. However, additional 4" rigid insulation will be added to the uninsulated portion of Office 101R west wall. Also, the north wall of 101R will be closed with 2-3/4" kalwall panels, R-13.

IBC-2006 ADDITIONAL INFORMATION

OCCUPANCY GROUPS & SQ. FT. (NET)

<u>SQ. FT.</u> 13,003 sq. ft. Heated

TOTAL OCCUPANTS TOTAL BUILDING SQ. FT. (GROSS)

15,036 sq. ft. Heated

AREA OF ALTERATIONS (PHASE 2) 631 sq. ft. VESTIBULE 33 sq. ft. RESTROOM TOTAL 71 sq. ft.

CONSTRUCTION TYPE 2003 IBC 2009 IBC EQUIVALENT TYPE III B


NUMBER OF STORIES 1 Story

Drinking Fountains:

CITY OF ALBUQUERQUE

ERNA FERGUSSON LIBRARY MODIFICATIONS TITLE: CODE ANALYSIS Design Review Committee City Engineer Approval of 21 City Project No. Zone Map No. G-18-Z G101 7168.03

NUMBER 276

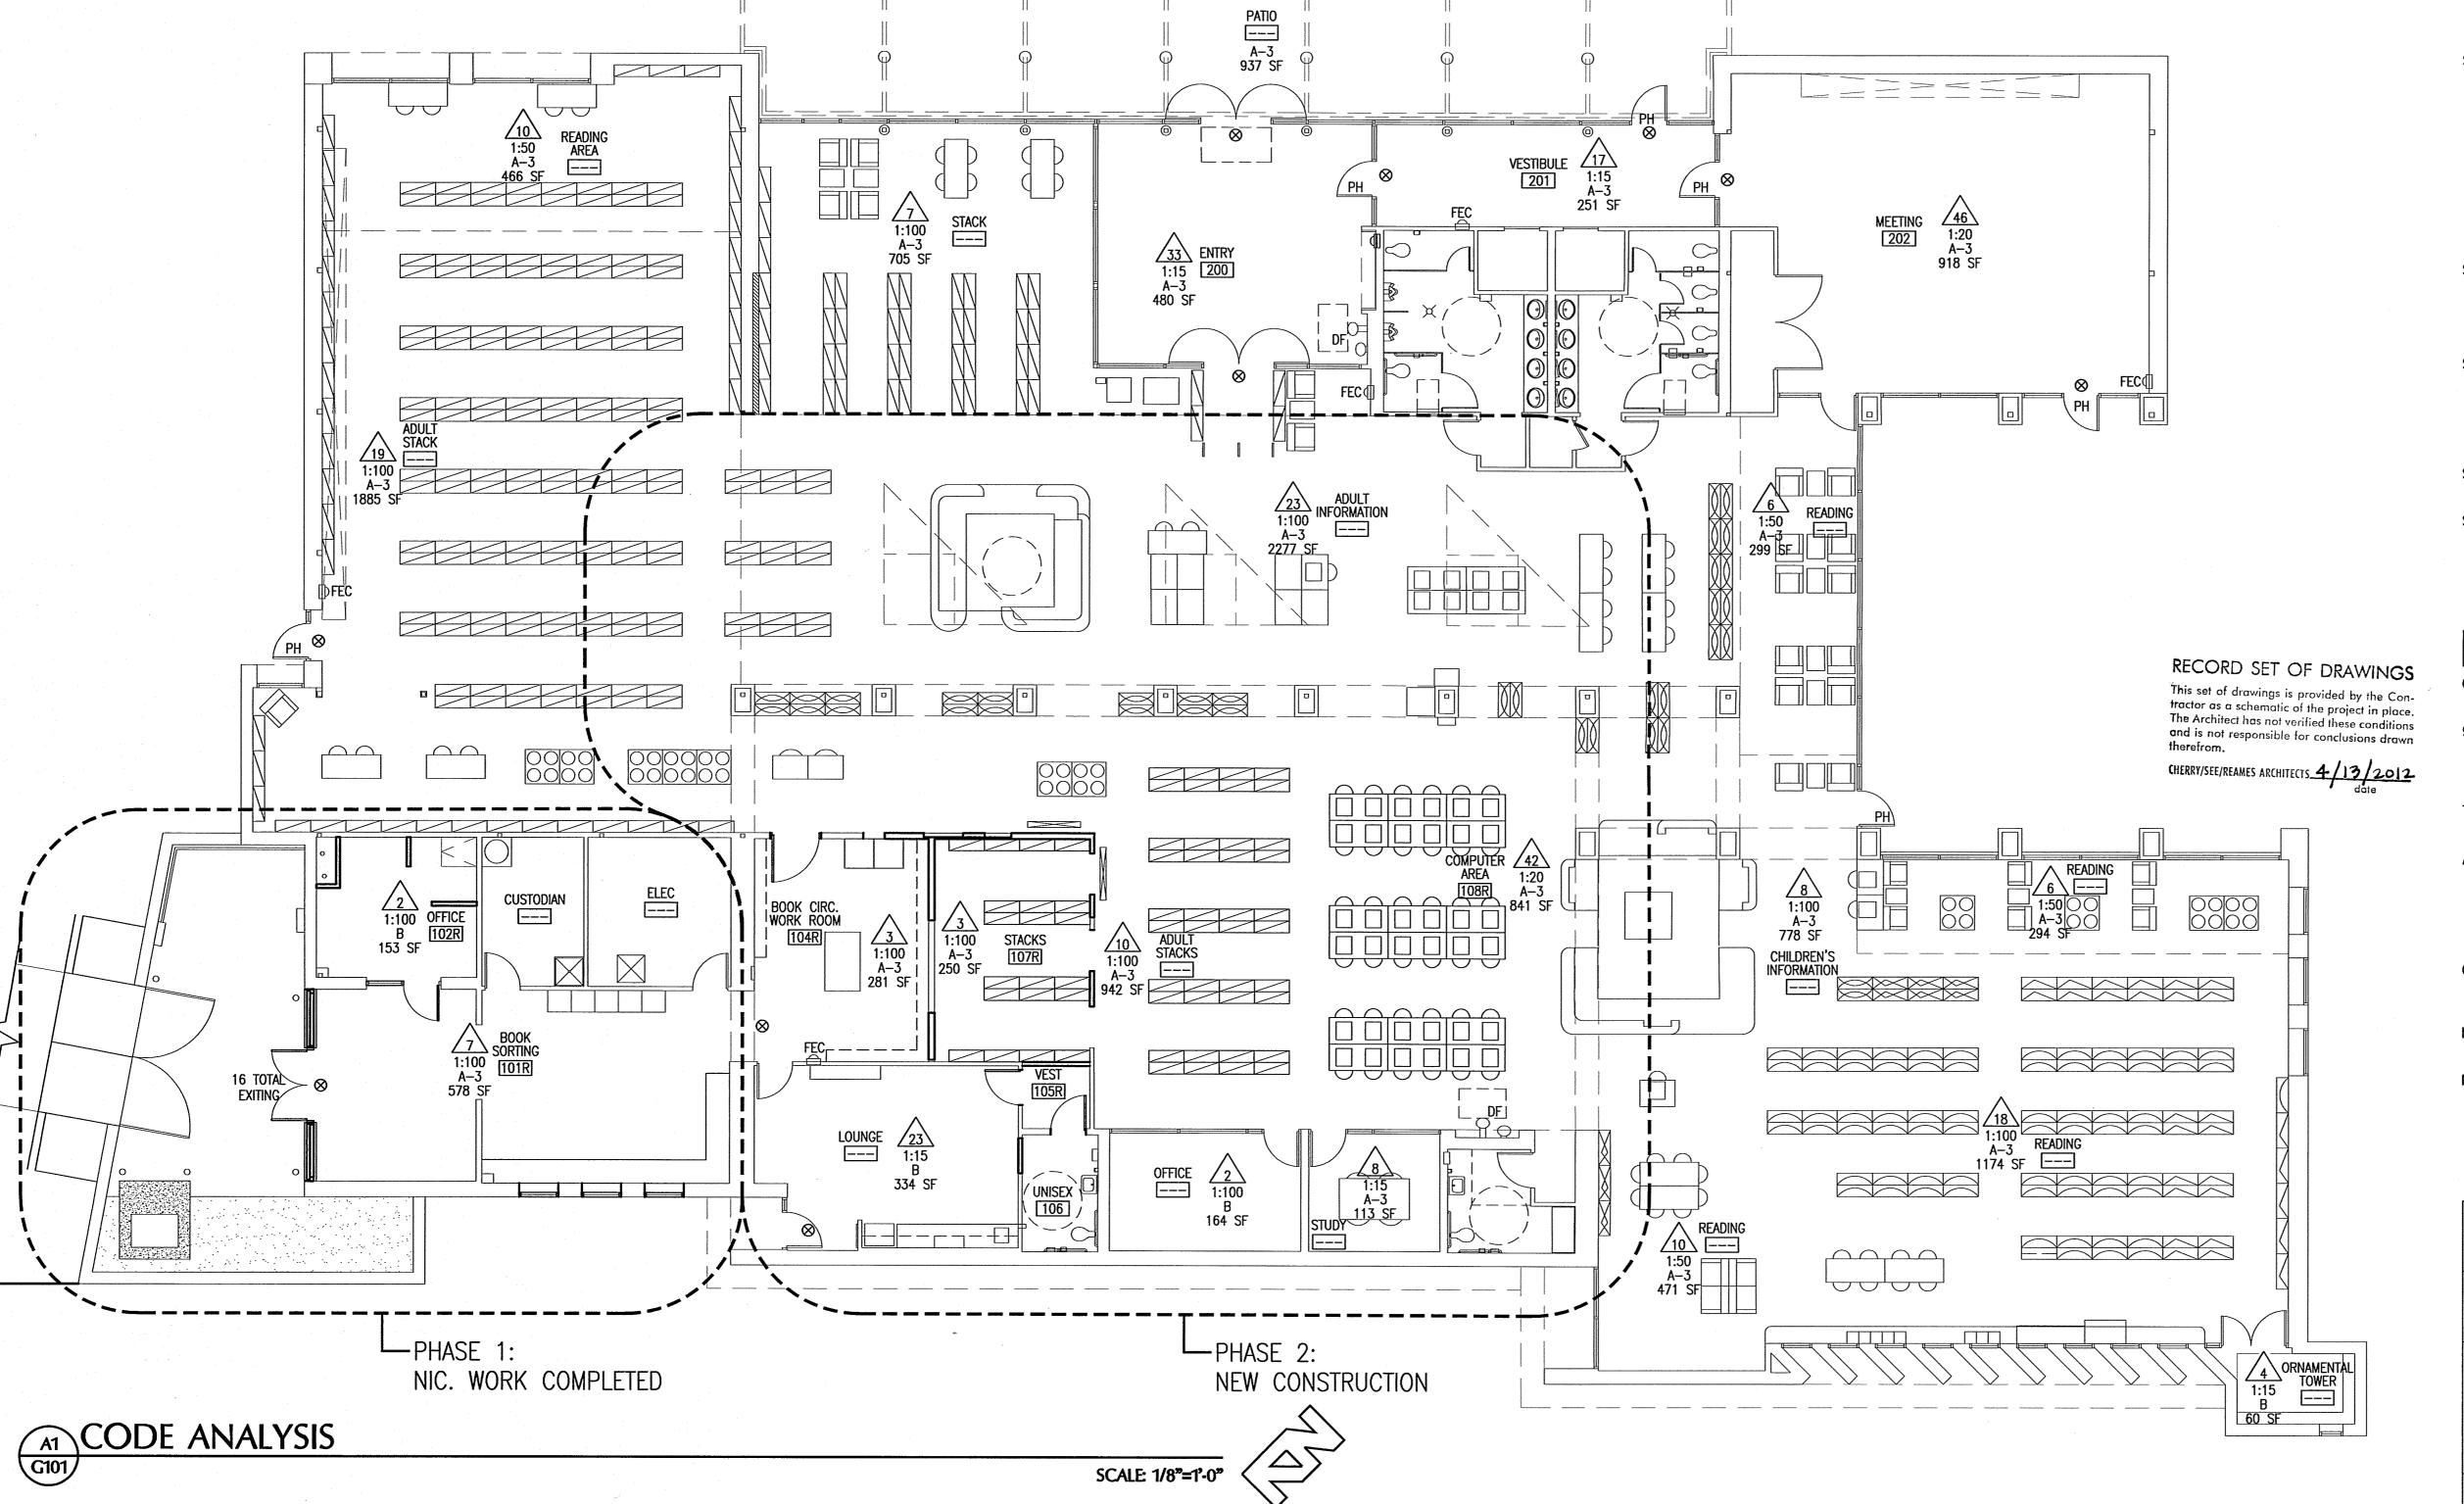

GENERAL SHEET NOTES

ALL EXISTING PARKING IS TO REMAIN.
 NO NEW COVERED SPACE IS BEING ADDED TO THE LIBRARY.

KEYED NOTES

- EXISTING FOOTPRINT OF LIBRARY TO REMAIN.
 ADD NEW ASPHALT RAMP TO SLOPE .20 OF ONE FOOT.
 REMOVE AND REPLACE WITH NEW CONCRETE DRIVE. SEE ENLARGED
- PLANS.

 4. NEW HVAC UNIT. CUT & REPAIR ROOFING AND DECK AS REQUIRED.
 SEE MECHANICAL. NEW UNIT TO BE ADDED IN PHASE 2 WORK.

CHERRY/SEE/REAMES ARCHITECTS, LLP 220 gold avenue sw albuquerque, nm 87102 505 - 842 - 1278 fax 505 - 766 - 9269

RECORD SET OF DRAWINGS

This set of drawings is provided by the Contractor as a schematic of the project in place. The Architect has not verified these conditions and is not responsible for conclusions drawn therefrom.

CHERRY/SEE/REAMES ARCHITECTS 4/13/2012

date			
E	CITY OF ALBUQUEI ERNA FERGUSSON LIBRARY		
TITLE: SITE PLAN			
Design Review Committee	City Engineer Approval	Last Design Update	MO./DAY/YR.
City Project No. 7168.03	Zone Map No. G-18-Z	Sheet AS101	3 of 21

SCALE: 1" = 20'-0"

COLUMN E OF ODEOLAL INCODECTIONS / MEDICICATIONS

SCHEDULE OF SPECIAL	INSPECTIONS / VERIFICATIONS
MATERIAL/ACTIVITY	TYPE OF INSPECTION / VERIFICATION
EARTHWORK	
Site preparation (building)	Field testing and Inspection
Fill placement (building)	Review submittals, field testing and inspecti
Fill compaction (building)	In-place density tests
Foundation sub-grade	Field inspection of foundation subgrade price
CONCRETE	to placement of concrete
Materials	Review product supplied versus certificates
Materials	of compliance and mix design
	or compliance and mix design
Reinforcing steel	Field inspection of placement
Formwork installation	Field inspection
Concreting operations and placement	Field inspection of placement and curing
Concrete curing	Field inspection of curing process
Concrete strength	Evaluation of concrete strength
STRUCTURAL STEEL	
Bolts, nuts, washers	Review certificate of compliance
Structural steel	Material identification markings

Bolts, nuts, washers	Review certificate of compliance
Structural steel	Material identification markings Review certificate of compliance
Weld filler materials and	Review certificate of compliance

welder certification

Inspection of welds Inspection of structural details Structural details

GENERAL REQUIREMENTS

VERIFICATION. Verify all dimensions, elevations and site conditions before beginning work. Notify Structural Engineer of any discrepancies.

2. CONFLICTS. In case of conflict, notes and details on the Drawings take precedence over General Notes and Typical Details.

3. SUBSTITUTIONS. Do not make any substitutions without prior written approval. Provide manufacturer's approved product evaluation reports (ICC Evaluation Service Reports) and a list of all proposed substitutions to Structural Engineer for review before fabrication.

1. SIMILAR WORK. Where construction details are not shown or noted for any part of the work, such details shall be the same as for similar work shown on the Drawings.

5. PIPES, DUCTS, SLEEVES, CHASES, etc. Do not place pipes, ducts, sleeves, chases or any similar items in slabs, beams, walls or other structural elements without prior written approval. Do not cut any structural element for installation of any item without prior written approval.

1914.6, 1914.7, 1914.8; ACI 318:5.9-10 6. EXCAVATIONS. Locate and protect underground or concealed conduit, plumbing or other utilities where new work is being performed.

> 7. CONSTRUCTION LOADS. Distribute materials placed on roofs or framed floors evenly. Do not exceed the allowable loading for supporting members and their connections.

> 8. CONSTRUCTION METHODS AND PRODUCT SAFETY. Except where specifically noted otherwise, the Structural Drawings represent the finished structure and do not indicate methods, procedures or sequence of construction. Take necessary precautions to maintain the structural integrity of the structure during construction. Neither the Owner nor the Architect/Engineer will enforce safety measures or regulations. The Contractor shall design, construct and maintain all safety devices, including shoring and bracing, and shall be solely responsible for conforming to all local, state and federal safety and health standards, laws and regulations.

GENERAL NOTES - EARTHWORK

- 1. GENERAL. Except at footings adjacent to existing construction, footings and slabs on grade shall be placed on engineered fill on prepared subgrade. Footings adjacent to existing con-struction shall be placed on prepared subgrade. Requirements for earthwork, including excavation, fill and backfill, unless specifically contained in these notes or shown on the Structural Drawings shall be in accordance with the 2009 edition of the New Mexico Commercial Building Code.
- 2. DEMOLITION. Demolish as shown on the Drawings all existing construction required to be removed to permit new construction. Protect existing construction to remain. Repair to the satisfaction of the Architect/Engineer any existing construction which is to remain after project is complete but which is damaged during demolition. Remove from the site and properly dispose of any demolished material except material which is to be retained by the Owner.
- 3.EXCAVATION AND PROTECTION OF EXCAVATIONS. Remove existing material as required. See drawings for the extent of prepared subgrade and engineered fill/backfill required. Do not undercut existing construction except as specifically shown or noted. Provide positive surface drainage away from excavations and promptly remove any surface water which may enter the excavations. Remove any subgrade material and any previously placed fill or backfill which has been softened or otherwise damaged by moisture. Replace with properly placed and compacted fill or backfill. Slope sides of excavations as shown or, if not shown, as required for slope stability. Provide barricades, lights and warning signs as necessary for the protection of existing property, construction personnel and the public.
- 4. PREPARATION OF SUBGRADE. After excavations have been completed and/or surface has been cleaned and grubbed, scarify or otherwise loosen the top 12 inches of the subgrade and moisten or dry it as necessary to bring the moisture content to within -/+ 3 percentage of optimum moisture. After required moisture content has been achieved, compact the subgrade to not less than 95% of maximum dry density as determined by ASTM 1557.
- 5.FILL AND BACKFILL. All fill and backfill material shall be clean, free of organic or frozen matter, and any other unsuitable material, and is to be approved by the Architect/Engineer before use. See listing of STRUCTURAL MATERIALS this sheet for required properties for fill and backfill materials. Site material may be used if it meets the specified material property requirements. If site material does not meet the requirements, use imported materials or a uniform mixture of site and imported materials which do meet the specified requirements.
- 6. COMPACTION OF FILL AND BACKFILL. Compact fill and backfill to not less than 95% of maximum dry density. Place fill and backfill in layers of uniform thickness not exceeding 6 inches. Perform compaction when the material to be compacted is at its optimum moisture content (plus or minus 2 percentage points). Thoroughly mix water into the soil mass to be compacted so the moisture content of the soil is uniform. Perform compaction using appropriate equipment and methods as necessary to achieve the required density percentages without damage to existing construction. Do not use ponding, flooding, jetting or other similar methods to aid in compaction.
- 7.QUALITY CONTROL. Determine maximum densities and optimum moisture contents in accordance with ASTM D1557. Determine density of in-place material in accordance with ASTM D1556 or D2922. Determine gradations of materials in accordance with ASTM D422. Determine liquid limits, plastic limits and plasticity indices in accordance with ASTM

CTDIICTIDAI ADDDEVIATIONS

REFERENCE

Field review

Field review, IBC 1704.7.1

Field review, IBC 1704.7.2

ACI 318 - Ch 4

Field review, IBC 1704.7.3

Submittal and Field Review, IBC 1904.

1905.2-1905.4, 1914.2, 1914.3

Field Review, IBC 1903.5, 1907.1.

1907.7. 1914.4. ACI 318:3.5

Field Review, IBC 1905.9, 1905.10,

Field Review, IBC 1905.11, 1905.13,

Submittal & Field Review IBC 1704.3,

AISC Bolt Specification Section 2.1

Submittal & Field Review IBC 1708.4,

Submittal & Field Review, AWS D1.1

Field Review, IBC 1704.3.1, AWS, D1.1

Field Review, IBC 1704.3.2

1914.9, ACI 318;5.11-13

Laboratory testing, IBC 1906.2,

ACI 318 - 5.6

ASTM A6

Field Review, IBC 1906, ACI 318:6.1, 6.2

Abbreviation	Term	Abbreviation	Term	Abbreviation	Term
A.R.	Anchor Rod	GA	Gage		
NDJ	Adjacent	GALV	Galvanized	P.B.	Plain Bolt
	Above Finish Floor	GLU-LAM	Glue-Laminated	PERIM	Perimeter
.F.F.				PERM	Permanent
PPROX	Approximate	GYP BD	Gypsum Board		
RCH	Architect(-ural)			PERP	Perpendicular
	•	HEM-FIR	Hemfir	PL	Plate
BLKG	Blocking	HORIZ	Horizontal	POS	Positive
BP	Base Plate	H.S.B.	High Strength Bolt	PREFAB	Prefabricated
				PRELIM	Preliminary
BM	Beam	H.S.S.	Hollow Structural	PSF	Pounds per
3.0.F.	Bottom of Footing		Section (Tube or	F3F	
3RG	Bearing		Pipe)		Square Foot
BOTT	Bottom	HVAC	Heating, Ventilating,	PSI	Pounds per
BTWN	Between		and Air Conditioning		Square Inch
	01 1				
)) D	Channel Cast in Place	I.D.	Inside Diameter	QTR	Quarter
C.I.P.		INSUL	Insulation		
IJ	Construction Joint	INV	Invert	R	Riser (stair)
CMU	Concrete Masonry	INT	Interior	RAD	Radius
	Unit	,		R.D.	Roof Drain
CLR	Clear	JNT	Joint		
COL	Column			REBAR	Reinforcing Bar
		JST	Joist	RECT	Rectangular
CONC	Concrete			REF	Reference
CONN	Connection	L	Angle	REINF	Reinforcing
CONST	Construction	LLH	Long Leg	REQD	Required
CONT	Continuous		Horizontal	REV	Revision
CONTR	Contractor	LLV	Long Leg	R.O.	Rough Opening
TR	Center	CLV	Vertical	11.0.	Mough opening
CJ	Control Joint	LONGIT		CUT	Clarak
		LONGIT	Longitudinal	SHT	Sheet
CSK	Countersunk			SIM	Similar
		MATL	Material	SPA	Spaces(-ed)
DIAG(L)	Diagonal	MAX	Maximum	SQ	Square
DIAM	Diameter	M.B.	Machine Bolt	STD	Standard
DIM	Dimension	M.C.J.	Masonry Control	STIFF	Stiffener
DIST	Distance	141.0.0.	Joint		
OTL	Detail	HECH		STL	Steel
		MECH	Mechanical	STR	Stringer
OWG	Drawing	MEZZ	Mezzanine	STRUCT	Structural
DWL	Dowel	MK	Mark	SYMM	Symmetrical
		MIN	Minimum		,
	Each	MISC	Miscellaneous	T & B	Top and Botton
E.B.	Expansion Bolt	M.L.	Match Line		•
<u>:</u> F	Each Face			TEMP	Temporary
		M.O.	Masonry Opening	T.O.C.	Top of Concrete
EJ.	Expansion Joint			T.O.P.	Top of Parapet
EW	Each Way	N.I.C.	Not in Contract	T.0.S.	Top of Slab
ELEC	Electrical	NOM	Nominal	T.O.W.	Top of Wall
ELEV	Elevation			TR	Tread (stair)
EQUIP	Equipment	N.S.	Near Side	TRANSV	Transverse
EQUIV	Equivalent	N.T.S.	Not to Scale		
EXIST	Existing			TS	Structural Tube
		OAE	Or Approved Equal	TYP	Typical
EXP	Expansion				
EXT	Exterior	o/c	On Center	U.O.N.	Unless Otherwis
D .	Floor Drain	0.D.	Outside Diameter		Noted
F	Finish Floor	OPNG	Opening	VEDT	
FIN	Finish	OPP	Opposite	VERT	Vertical
-II. FLR	Floor			VOL	Volume
FNDN	Foundation				
				w/, w/o	With, Without
FRMG	Framing			WF	Wide Flange
-S	Far Side			WP	Working Point
-TG	Footing			WWF	Welded Wire
10	3				

STRUCTURAL DESIGN CRITERIA BUILDING CODE New Mexico Commercial Building Code - 2009 edition VERTICAL LOADS Live Load (1) Live Load (1 Use or Occupancy 20 psf 30 psf 50 psf Floors and Stairs on Grade 200 psf (1) Uniform load to be applied over the full tributary area of each structural member. (2) See Framing Plans for concentrated loads from mechanical units, hoists and other equipment. DESIGN SOIL BEARING PRESSURES Maximum Vertical Pressures Building footings supported on engineered fill 1500 psf Full gravity loads Combined gravity and short—term lateral 2000 psf wind and seismic) loads Retaining wall footings supported on 1500 psf compacted engineered fill Lateral Pressures 32 psf/ft **Passive** Undisturbed Natural Soils 300 psf/ft 400 psf/ft Structural Fill 60 psf/ft At Rest 0.40 Coefficient of Friction SEISMIC DESIGN CRITERIA 56.5% 17.1% 1.25 Seismic Importance Factor, I Site Class 25 ft Building height, hn Seismic Numerical Coefficients 1.35 2.12 Seismic Use Group Seismic Design Category Response Modification Factor (R) WIND DESIGN CRITERIA 90 mph Basic wind speed (3 sec gust) Exposure Category 1.15 Importance factor, lw 15 feet Mean roof height Adjustment Factor for Building Height and Exposure (λ) 1.21 Simplified Design Wind Pressure P_{S30} Net Design Wind Pressure PNET30 Main Wind Force—Resisting system Design wind pressure $P = \lambda I_w P_{S30}$ Components and Cladding Design wind pressure $P = \lambda I_w P_{NET30}$

STRUCTURAL MATERIALS

FILL/BACKFILL MATERIALS

Gradation Sieve size (square openings)	Percent Passing (by weight)
2 inches No. 4 No. 200	100 50 - 100 15 - 50
Plasticity Index Not to exceed 12	

CONCRETE

USE		REQUIRE STRENG	
Footings, Stem walls All other uses		3000 p 4000 p) 5
Cement: ASTM C150, type IL	A or IILA		

diameter x 8" cylinder at 28 days):

Compressive strength (strength of a standard 4"

Fly Ash: ASTM C618, class F Aggregate: ASTM C33 Admixtures: As approved. Do not use any admixtures containing chlorides. Entrained air: 4% to 7% by volume in exterior exposed concrete Nominal unit weight: 145 pcf

CONCRETE REINFORCING

Bars: ASTM A615, deformed, grade 60 Fiber reinforcing: Virgin polypropylene specifically manufactured for use in concrete.


STRUCTURAL AND MISCELLANEOUS STEEL

Wide flange shapes: ASTM A992, Fy = 50,000 psi Angles, Channels and Plates unless otherwise specified: ASTM A36, Fy = 36, 000 psi Structural tubes: ASTM A500, grade B, fy = 46,000 psiStructural pipes: ASTM A53, grade B, fy = 35,000 psi

BOLTS AND NUTS

Steel-to-Steel Connections Bolts: ASTM A325, type One, tension control Nuts: ASTM A563, grade C, heavy hexagonal

Other Connections Bolts: ASTM A307, grade A, hexagonal heads Nuts: ASTM A563, grade A, hexagonal

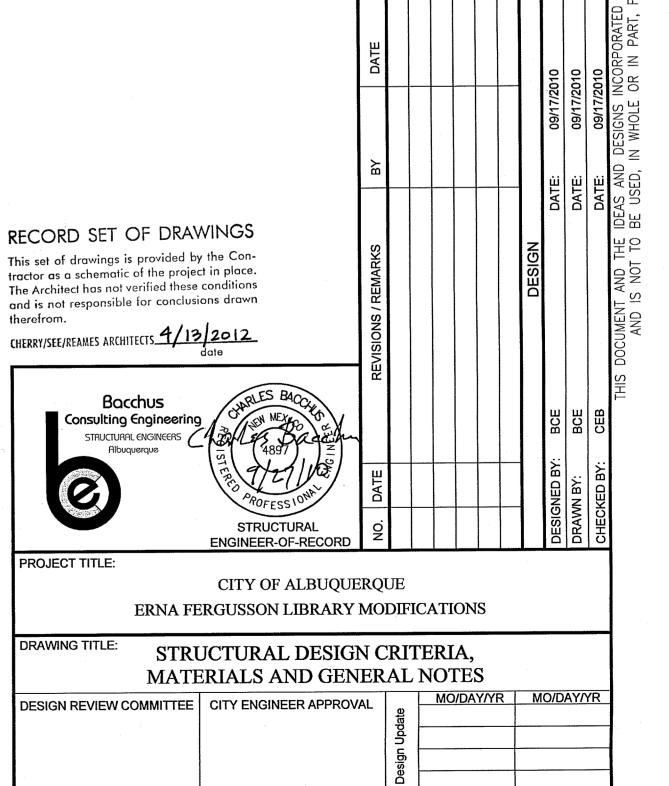

S100

4

ZONE MAP NO.

G-18-Z

ITY PROJECT NO.


CITY PROJ#


CHERRY/SEE/REAMES

ARCHITECTS, LLP


220 gold avenue sw albuquerque, nm 87102

505 - 842 - 1278 fax 505 - 766 - 9269

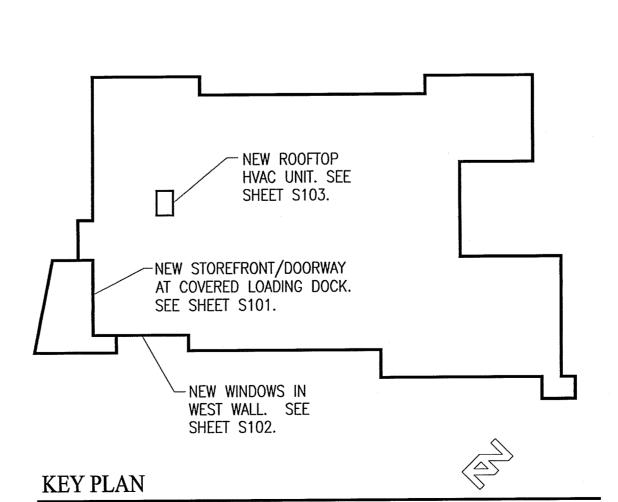

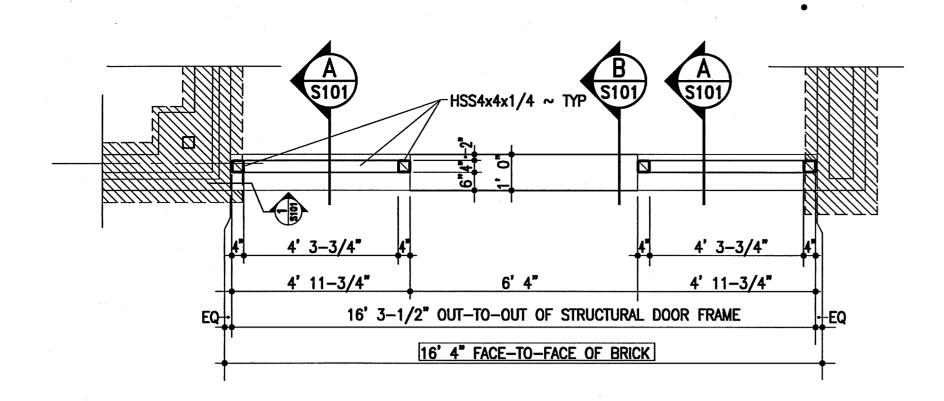


FOUNDATION PLAN ~ NEW DOOR AT LOADING DOCK

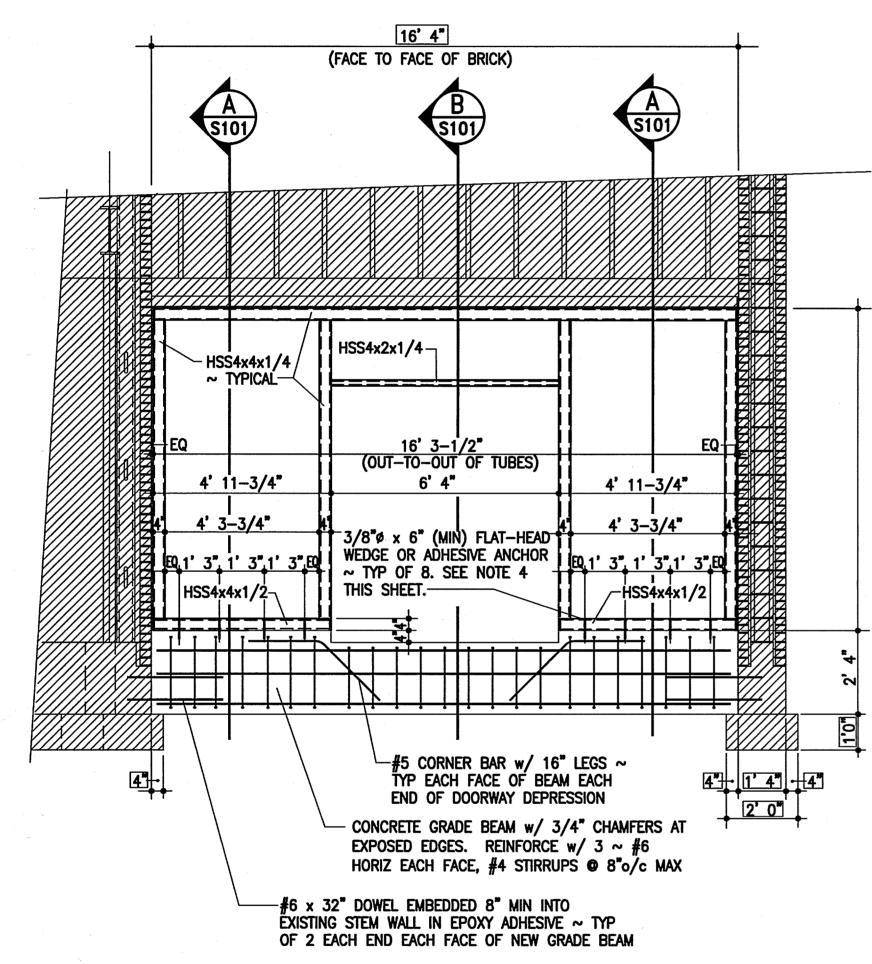


STRUCTURAL ELEVATION ~ NEW DOORWAY AT COVERED LOADING DOCK

GENERAL NOTES ~ NEW DOORWAY AT COVERED LOADING DOCK

- 1. <u>EXISTING CONSTRUCTION.</u> NOTES DEFINING EXISTING CONSTRUCTION ARE ENCLOSED IN BOXES OR INCLUDE THE TERM "EXISTG" OR BOTH. DIMENSIONS OF EXISTING CONSTRUCTION ARE CONTAINED IN BOXES. NOTES AND DESCRIPTIONS OF EXISTING CONSTRUCTION WERE TAKEN FROM RECORD DRAWINGS OF THE EXISTING FACILITY. VERIFICATION OF RELEVANT ASPECTS OF EXISTING CONSTRUCTION IS THE RESPONSIBILITY OF THE CONTRACTOR. IF THERE SIGNIFICANT DIFFERENCES BETWEEN THE DRAWINGS FOR THIS PROJECT AND THE ACTUAL CONSTRUCTION, THE CONTRACTOR SHALL ISSUE APPROPRIATE REQUESTS FOR INFORMATION (RFIs) AND CEASE WORK IN THE EFFECTED AREA UNTIL DISCREPANCIES HAVE BEEN RESOLVED.
- 2. GRADE BEAM. THE GRADE BEAM SHALL BE PLACED ON SUBGRADE PREPARED AS NOTED IN THE EARTHWORK NOTES ON SHEET \$100. SIDES OF GRADE BEAM SHALL BE FORMED. AFTER REMOVAL OF FORMS, BACKFILL SHALL BE PLACED AND COMPACTED AS NOTED IN THE EARTHWORK NOTES. GRADE BEAM REKINFORCING SHALL BE AS NOTED EXCEPT WHERE THERE MAY BE INTERFERENCE BETWEEN THE GRADE BEAM TIES AND THE ANCHORS CONNECTING THE NEW STEEL FRAME TO THE GRADE BEAM. SEE NOTE 4 BELOW.
- 3. <u>FABRICATION OF STEEL FRAME.</u> THE STEEL FRAME SHALL BE FABRICATED BY WELDING. PRIOR TO FABRICATION, THE DIMENSIONS OF THE EXISTING OPENING SHALL BE DETERMINED AND ADJUSTMENTS TO THE DIMENSIONS OF THE NEW FRAME BE MADE AS NECESSARY. HORIZONTAL TUBES AT THE TOP AND BOTTOM OF THE FRAME SHALL HAVE END PLATES OF THE SAME THICKNESS AND SIZE AS THE TUBES. WELDS SHALL BE EVEN AND SHALL BE GROUND SMOOTH FLUSH WITH ADJACENT SURFACES WHERE REQUIRED FOR TIGHT FIT OF CLOSURE PANELS AND DOORS OR WHERE WELDS WILL BE VISIBLE AFTER CONSTRUCTION IS COMPLETE.
- 4. CONNECTION OF STEEL FRAME TO GRADE BEAM. CONNECT THE NEW STEEL FRAME TO THE NEW GREADE BEAM USING FLAT—HEAD WEDGE OR ADHESIVE ANCHORS OF THE SIZE SHOWN AT THE SPACING SHOWN. COORDINATE THE LOCATION OF THE ANCHORS WITH THE LOCATION OF THE STIRRUPS IN THE GRADE BEAM TO AVOID INTERFERENCE. IF NECESSARY, THE STIRRUPS MAY BE MOVED BY NOT MORE THAN 1 INCH IN EITHER DIRECTION ALONG THE LENGTH OF THE GRADE BEAM TO AVOID INTERFERENCE. AFTER ANCHORS HAVE BEEN INSTALLED, GRIND THE TOP SURFACE OF THE ANCHORS TO BE FLUSH WITH THE TOP SURFACE OF THE BOTTOM TUBE OF THE STEEL FRAME.

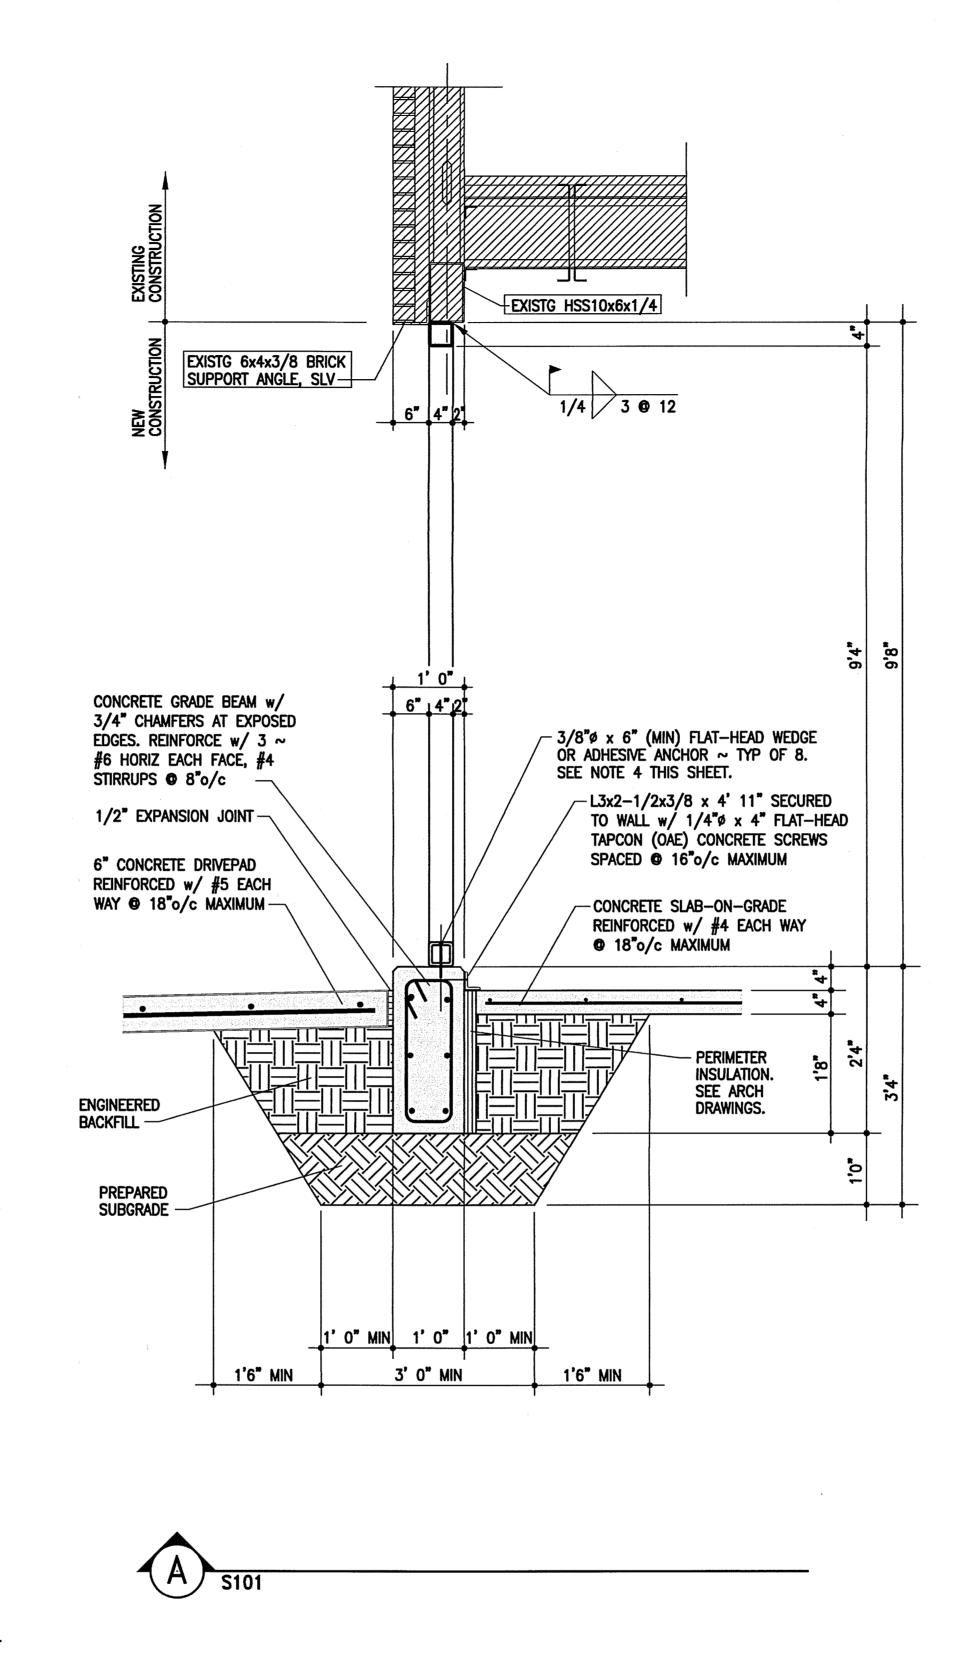


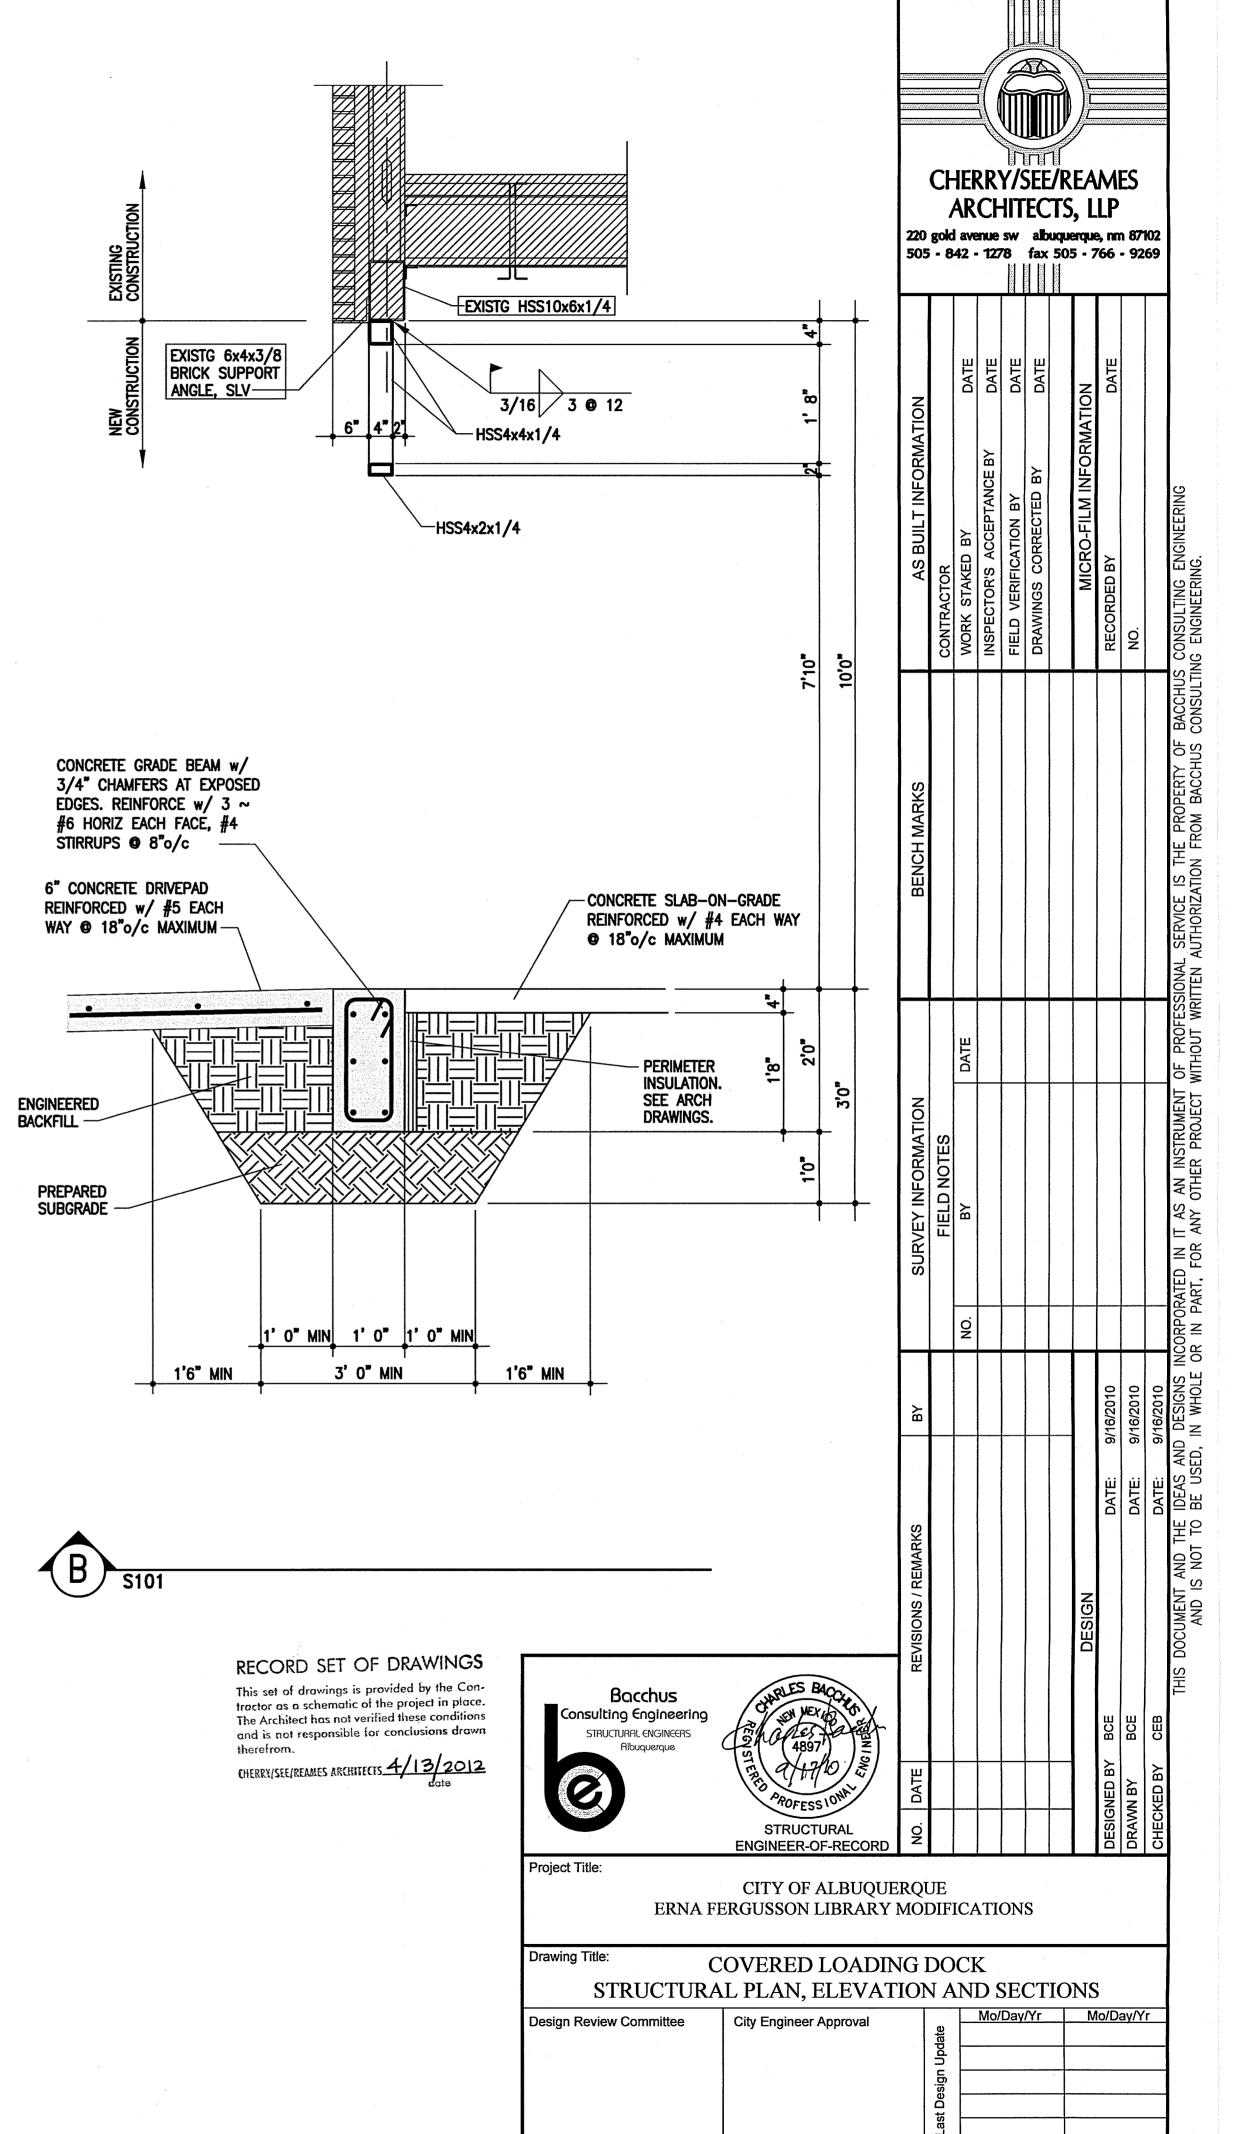

S101


G-18-Z


7168.03

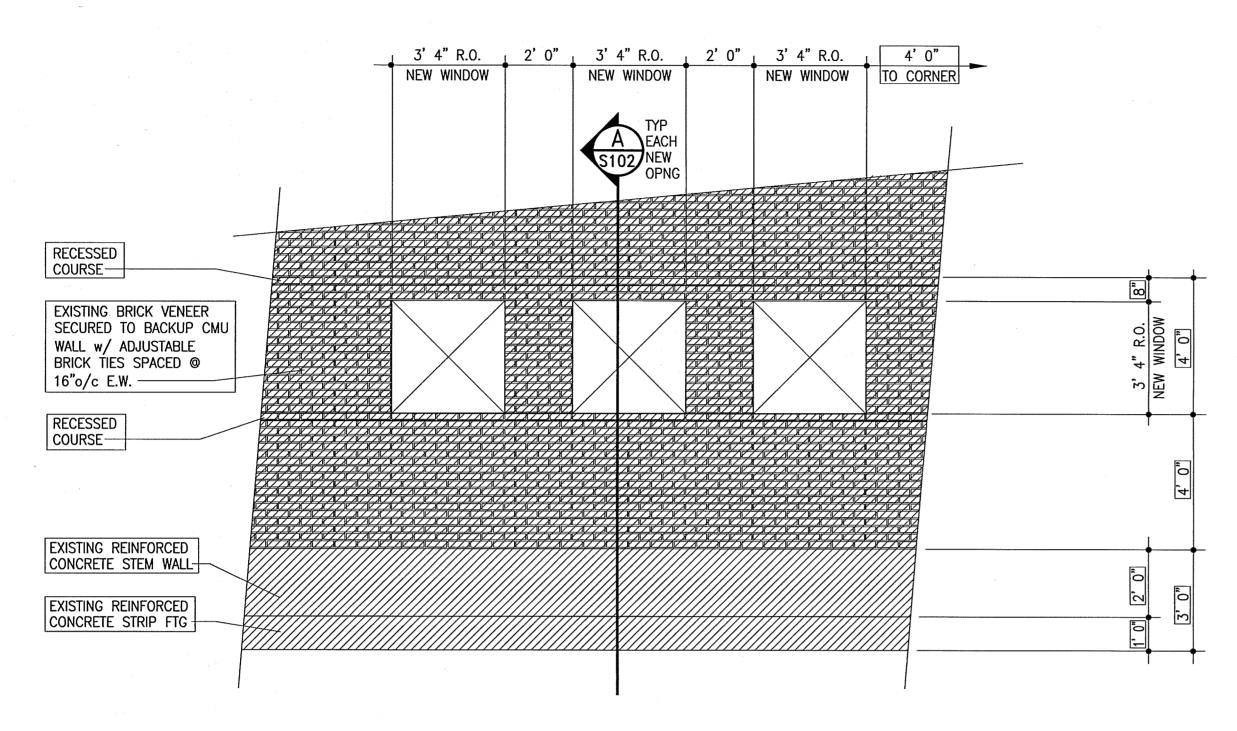

NOTE: SEE ARCHITECTURAL DRAWINGS FOR DETAILS OF WINDOWS AND WINDOW FRAMES

PARTIAL STRUCTURAL ELEVATION ~ WEST WALL AT NEW WINDOWS

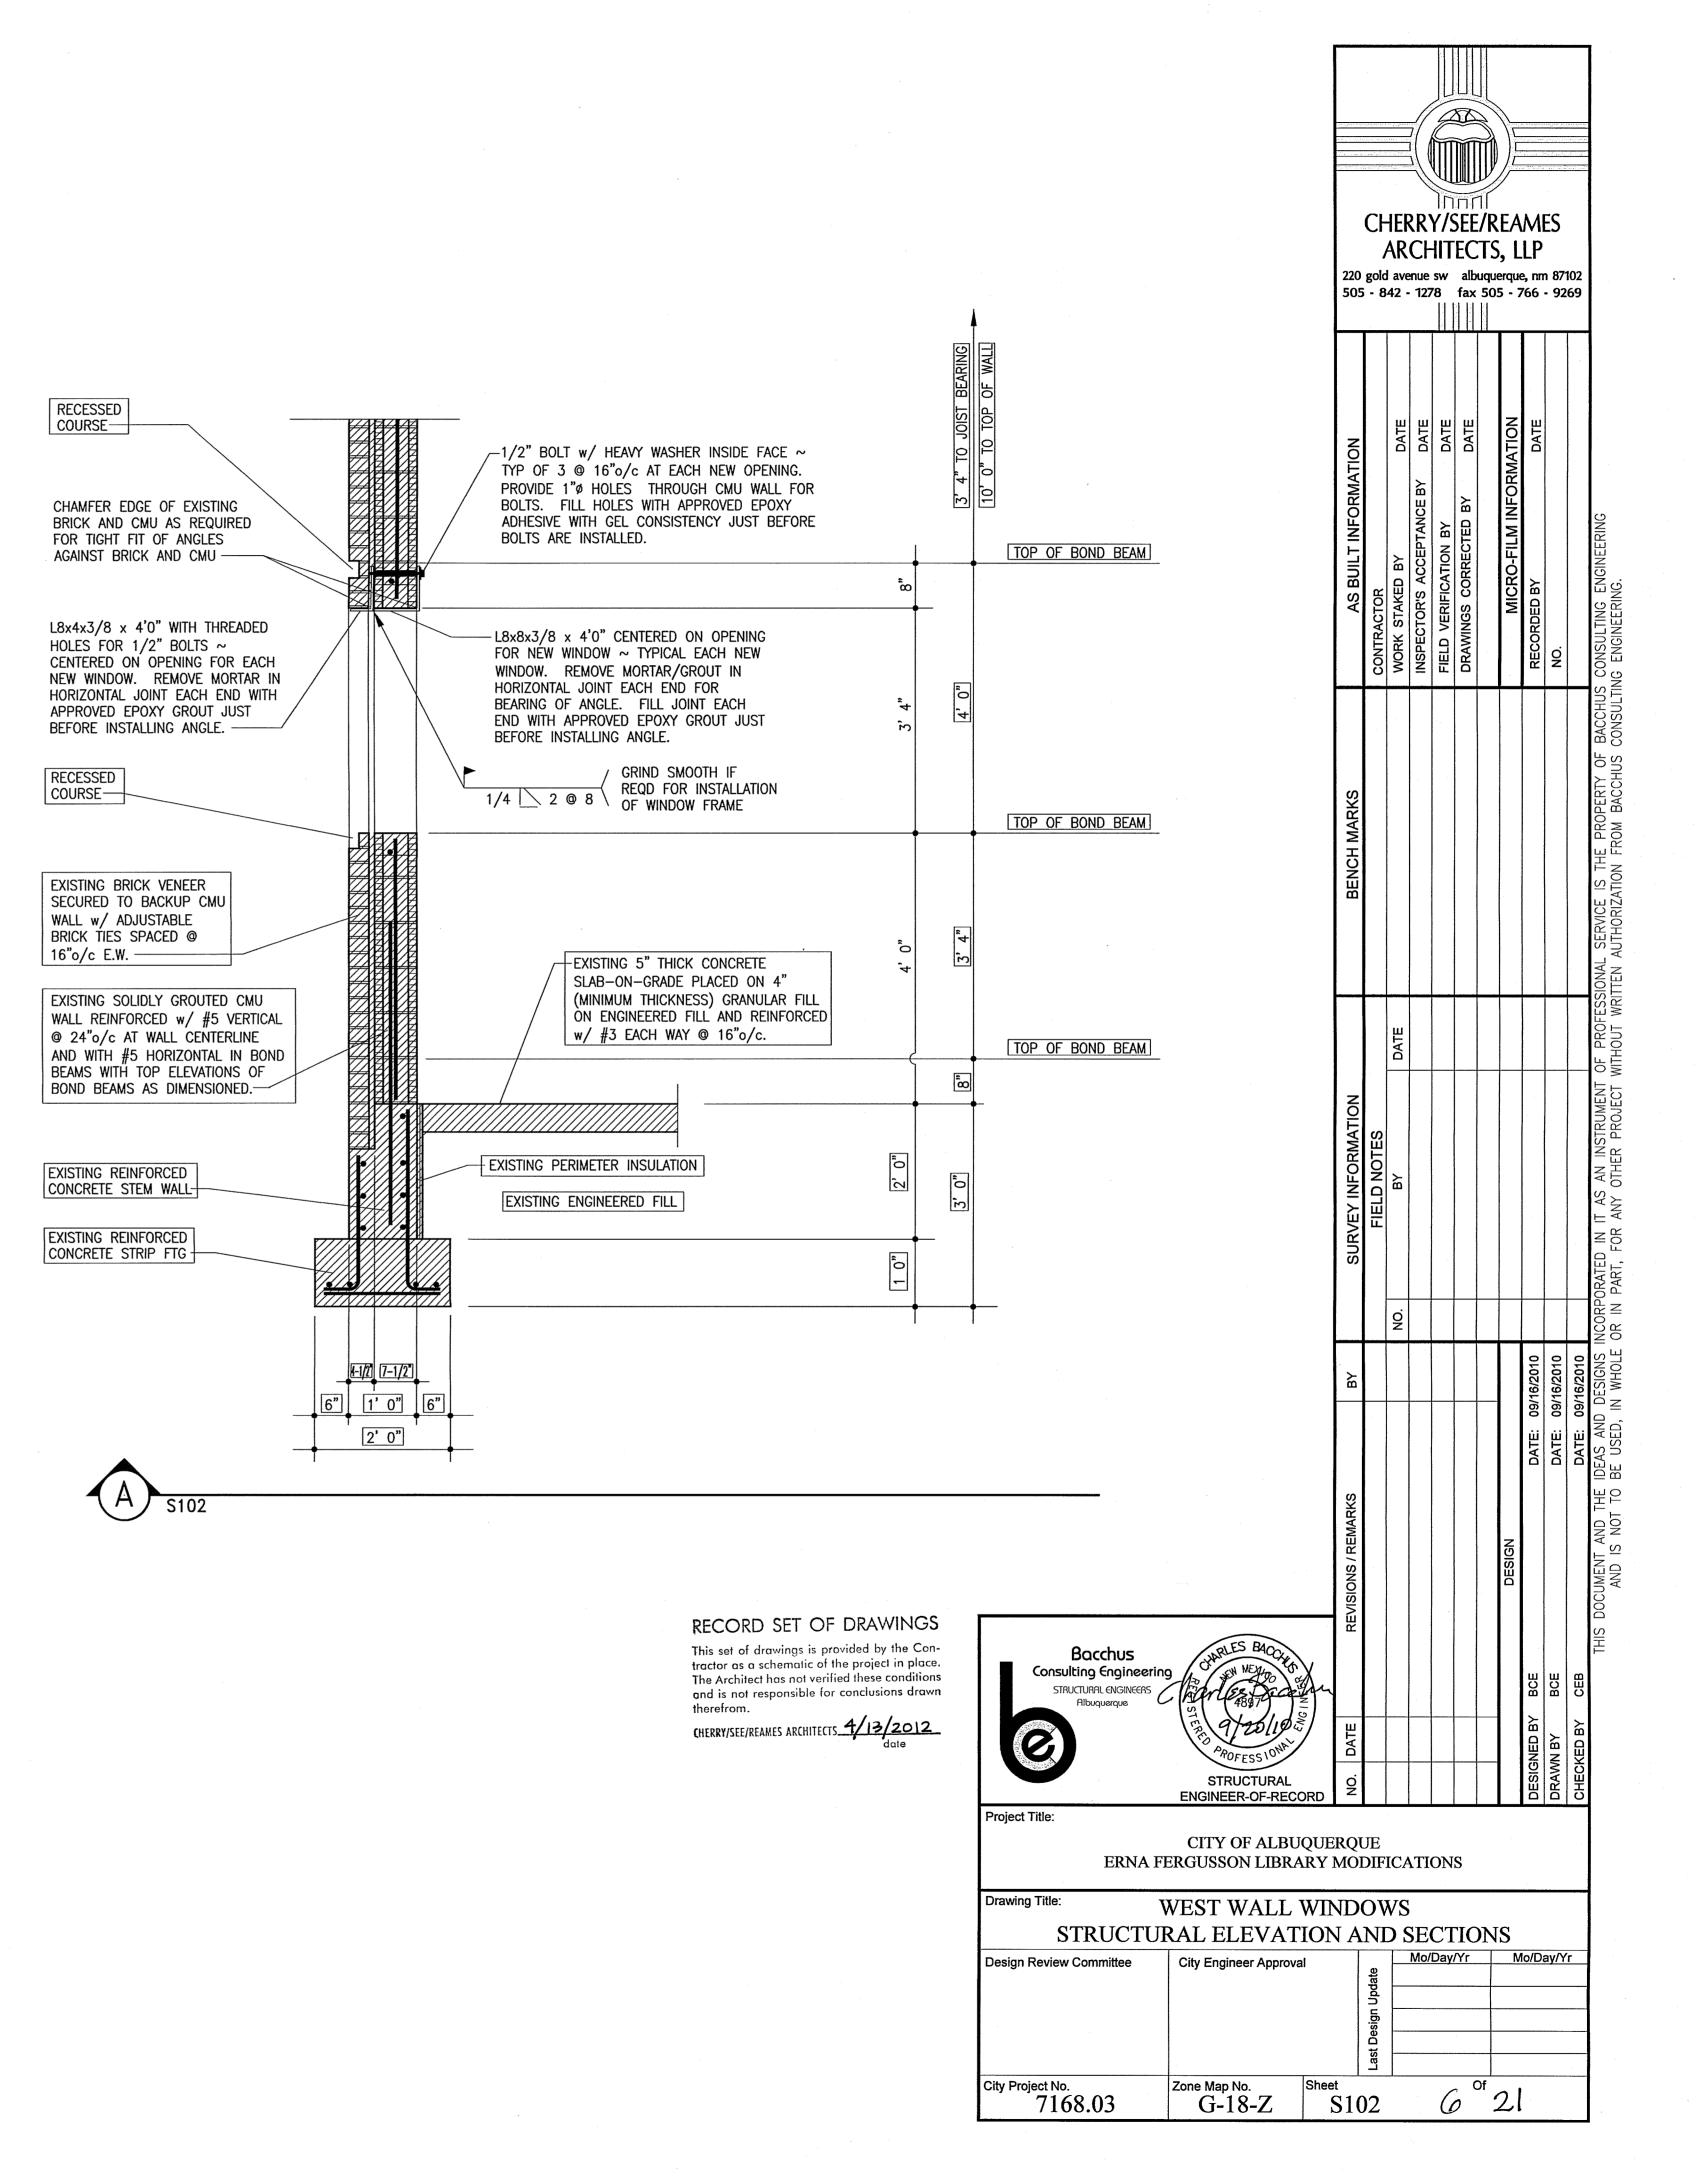


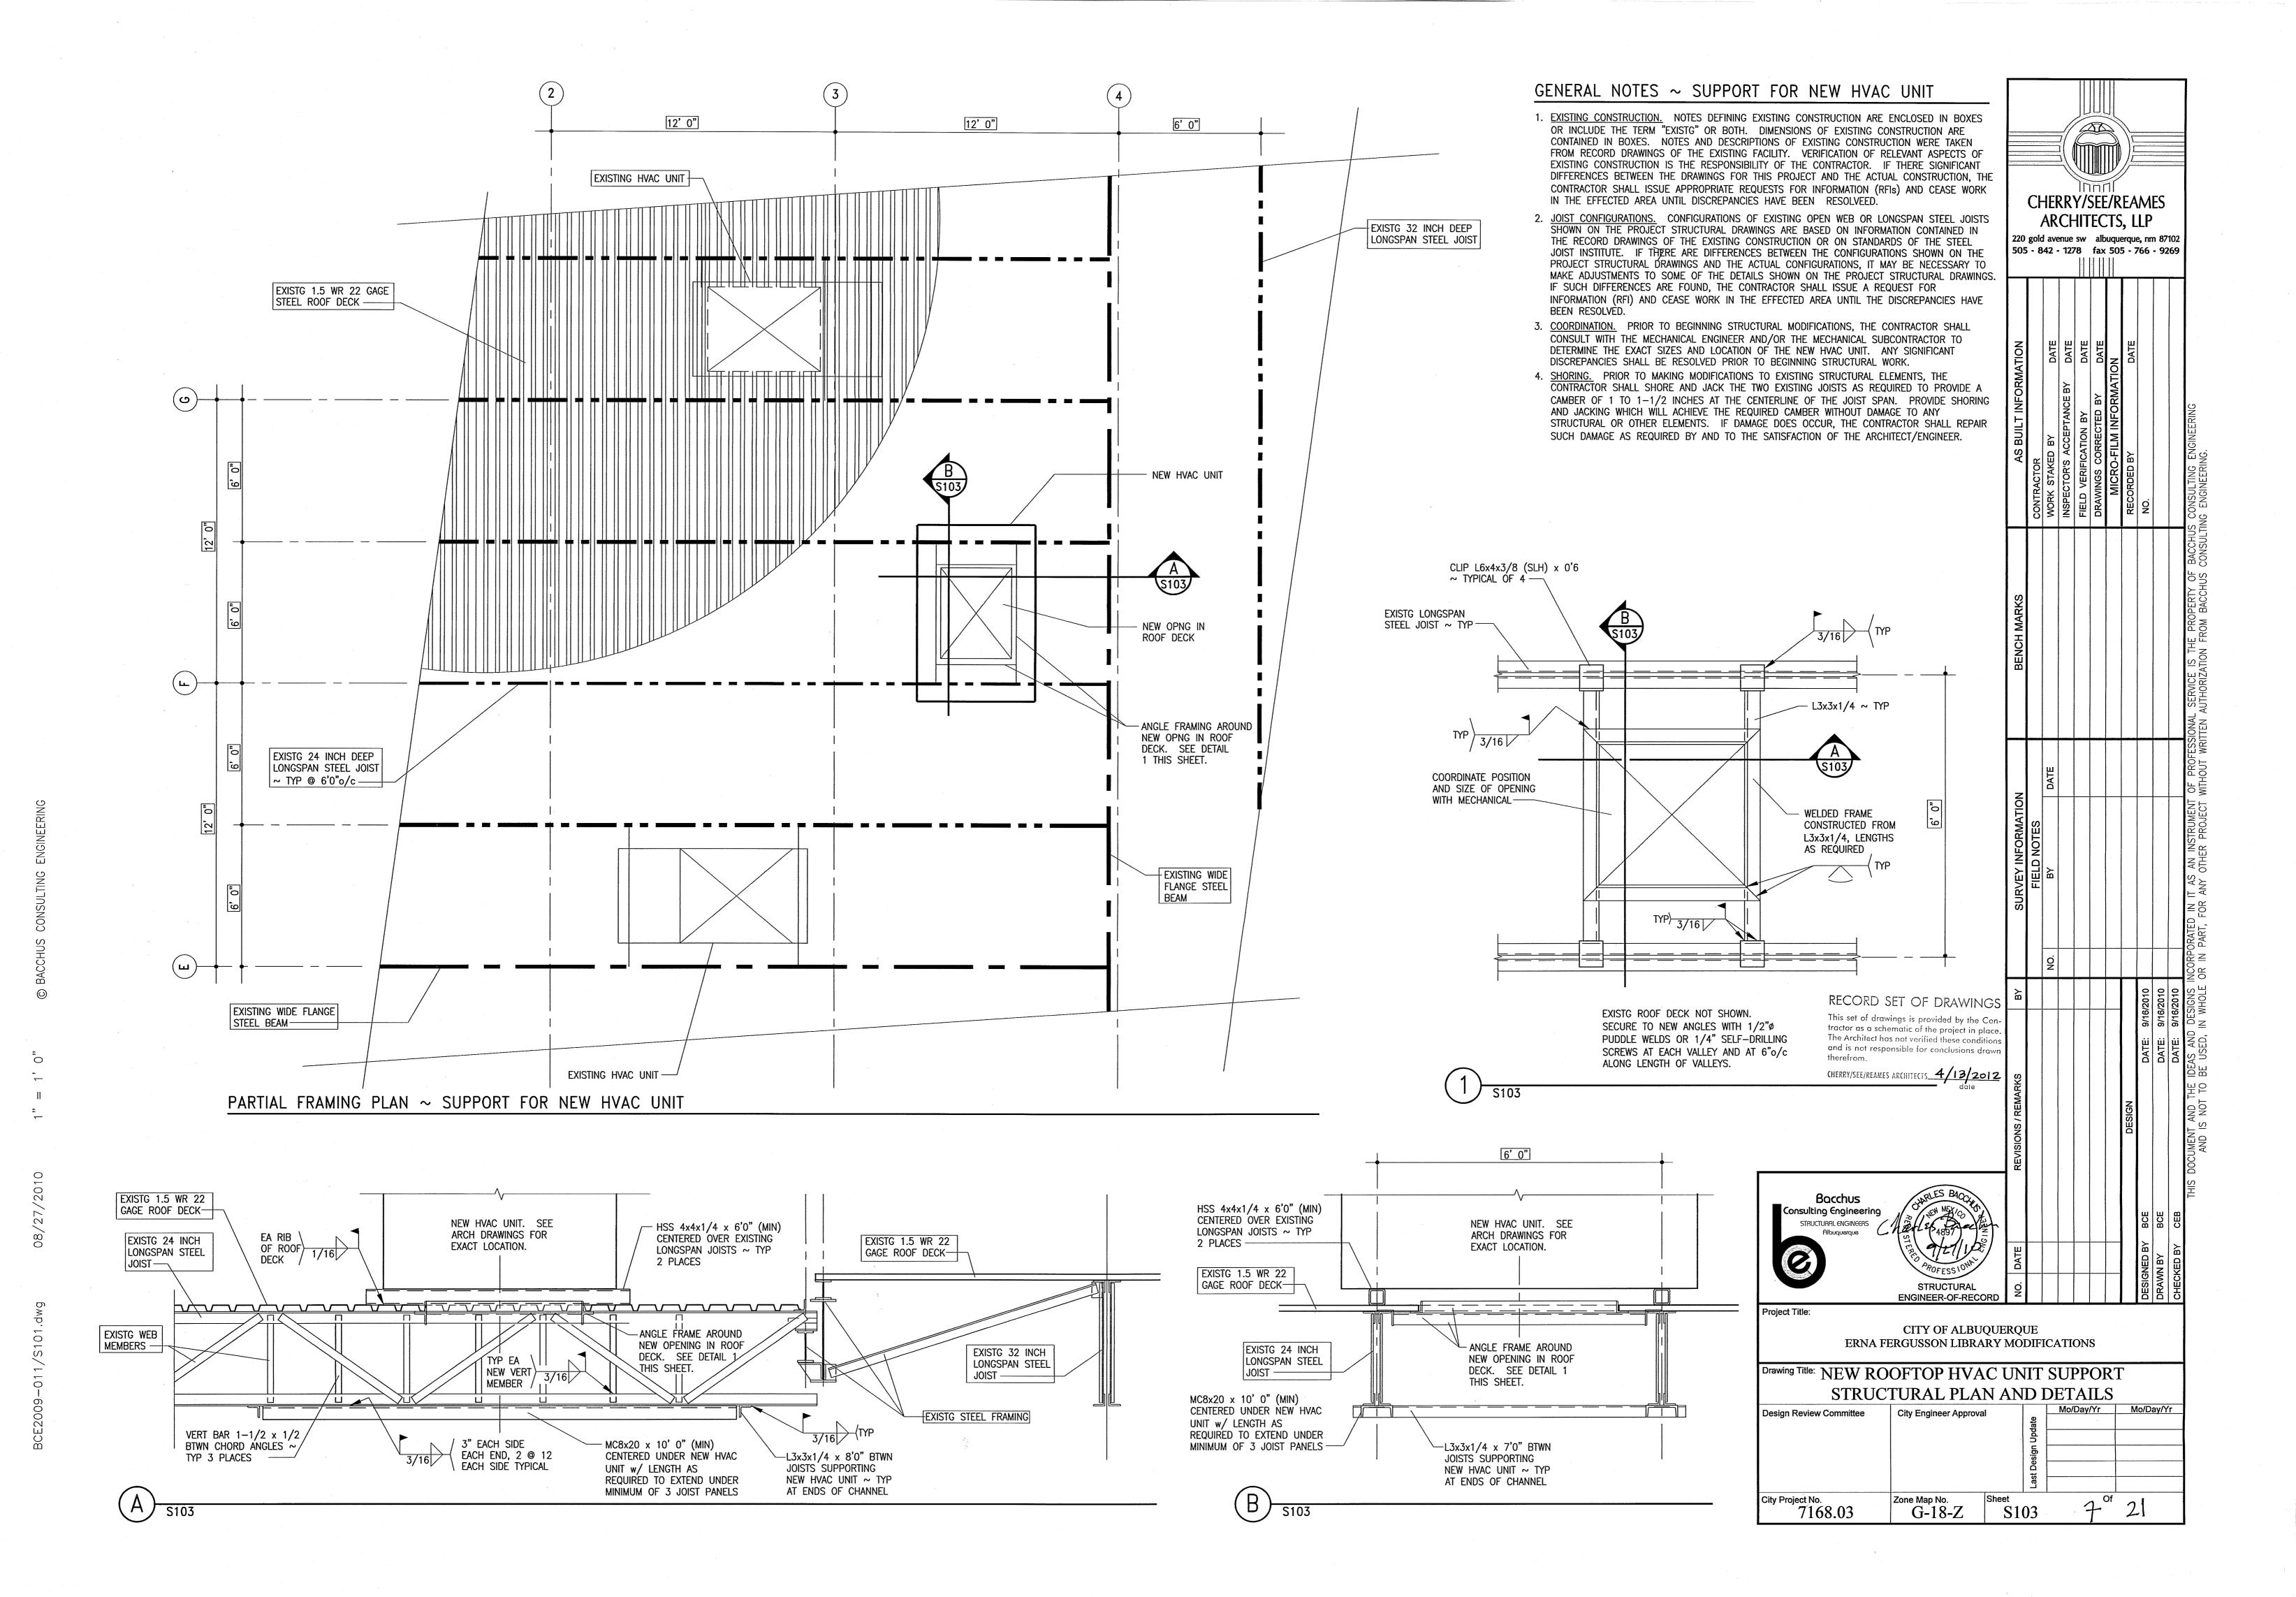

TYPICAL LAY-IN CEILING RESTRAINING WIRES AND VERTICAL STRUTS


- 1. VERTICAL HANGERS SUSPENSION WIRES SHALL NOT BE SMALLER THAN NO. 12 GAUGE SPACED AT 4' O.C. OR NO. 10 GAUGE SPACED AT 5'O.C. ALONG EACH MAIN RUNNER. EACH VERTICAL WIRE SHALL BE ATTACHED TO THE CEILING SUSPENSION MEMBER AND TO THE SUPPORT ABOVE WITH A MINIMUM OF THREE TURNS. ANY CONNECTION DEVICE AT THE SUPPORTING CONSTRUCTION SHALL BE CAPABLE OF CARRYING NOT LESS THAN 100 POUNDS. SUSPENSION WIRES SHALL NOT HANG MORE THAN THAN 1-IN-6 OUT OF PLUMB UNLESS COUNTER SLOPING WIRES ARE PROVIDED. WIRES SHALL NOT ATTACH TO OR BEND AROUND INTERFERING MATERIAL OR EQUIPMENT. A TRAPEZE OR EQUIVALENT DEVICE SHALL BE USED WHERE OBSTRUCTIONS PRECLUDE DIRECT SUSPENSION. TRAPEZE SUSPENSIONS SHALL BE A MINIMUM OF BACK-TO-BACK 1-1/4" COLD-ROLLED CHANNELS FOR SPANS EXCEEDING 48".
- 2. PERIMETER HANGERS THE PERIMETER ENDS OF EACH CROSS RUNNER AND MAIN RUNNER SHALL BE SUPPORTED INDEPENDENTLY A MAXIMUM OF 8" FROM EACH WALL OR CEILING DISCONTINUITY WITH NO. 12 GAUGE WIRE OR APPROVED WALL SUPPORT. THESE WIRES SHALL NOT HANG MORE THAN 1-IN-6 OUT -OF-PLUMB AND MUST BE CONNECTED TO AN ADJACENT WALL OR TO THE STRUCTURE ABOVE.
- 3. LATERAL FORCE BRACING WHERE DESIGN CALCULATIONS BY A STRUCTURAL ENGINEER ARE NOT PROVIDED, HORIZONTAL RESTRAINTS SHALL BE EFFECTED BY FOUR NO. 12 GAUGE WIRES SECURED TO THE MAIN RUNNER WITHIN 2" OF THE CROSS RUNNER INTERSECTION AND SPLAYED 90° FROM EACH OTHER AT AN ANGLE NOT EXCEEDING 45° FROM THE PLANE OF THE CEILING. A STRUT FASTENED TO THE MAIN RUNNER SHALL BE EXTENDED TO AND FASTENED TO THE STRUCTURAL MEMBERS SUPPORTING THE ROOF OR FLOOR ABOVE. THE STRUT SHALL BE ADEQUATE TO RESIST THE VERTICAL COMPONENT INDUCED BY THE BRACING WIRES. THESE HORIZONTAL RESTRAINT POINTS SHALL BE PLACED 12' ON CENTER IN BOTH DIRECTIONS WITH THE FIRST POINT WITHIN 6' FROM EACH WALL. ATTACHMENT OF THE RESTRAINT WIRES TO THE STRUCTURE ABOVE SHALL BE ADEQUATE FOR THE LOAD IMPOSED. LATERAL FORCE BRACING MEMBERS SHALL; BE SPACED A MINIMUM OF 6" FROM ALL HORIZONTAL PIPING OR DUCT WORK THAT IS NOT PROVIDED WITH BRACING RESTRAINTS FOR HORIZONTAL FORCES. BRACING WIRES SHALL BE ATTACHED TO THE GRID AND TO THE STRUCTURE IN SUCH A MANNER THAT THEY CAN SUPPORT A DESIGN LOAD OF NOT LESS THAN 200 POUNDS OR THE ACTUAL DESIGN LOAD, WITH A SAFETY FACTORS OF 2, WHICHEVER IS GREATER.
- 4. PERIMETER MEMBERS WALL ANGLES OR CHANNELS SHALL BE CONSIDERED AS AESTHETIC CLOSURES AND SHALL HAVE NO STRUCTURAL VALUE ASSESSED TO THEM OR THEIR METHOD OF ATTACHMENT TO THE WALLS. ENDS OF MAIN RUNNERS AND CROSS MEMBERS SHALL BE TIED TOGETHER TO PREVENT THEM FROM SPREADING.
- 5. ATTACHMENT OF MEMBERS TO THE PERIMETER TO FACILITATE INSTALLATION, MAIN RUNNERS AND CROSS RUNNERS MAY BE ATTACHED TO THE PERIMETER MEMBER AT TWO ADJACENT WALLS WITH CLEARANCE BETWEEN THE WALL AND THE RUNNERS MAINTAINED AT THE OTHER TWO WALLS.

NOTE: DRAWINGS ARE NOT TO SCALE

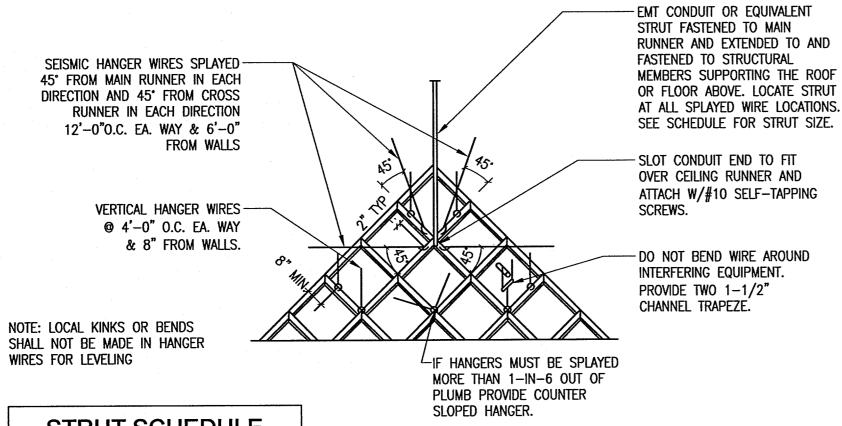


	STRUT SCHEDULE				
	EMT SIZE (NOMINAL)	LENGTH (L/r ≤ 200)			
	1/2"	≤ 3'-10"			
	3/4"	≤ 5'−0"			
-	1"	≤ 6'-6"			
-	1 1/4"	≤ 8'-6"			
	1 1/2"	≤ 9'-10"			

EMT - ELECTRICAL METALLIC TUBING

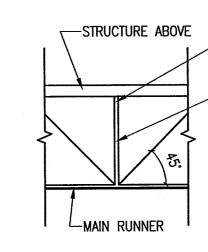


- ATTACHMENT SHALL BE ADEQUATE FOR THE LOAD IMPOSED - EMT CONDUIT OR EQUIVALENT STRUT FASTENED TO MAIN RUNNER AND EXTENDED TO AND FASTENED TO STRUCTURAL MEMBERS SUPPORTING THE ROOF OR FLOOR ABOVE. LOCATE STRUT AT ALL SPLAYED WIRE LOCATIONS. SEE SCHEDULE FOR STRUT SIZE.

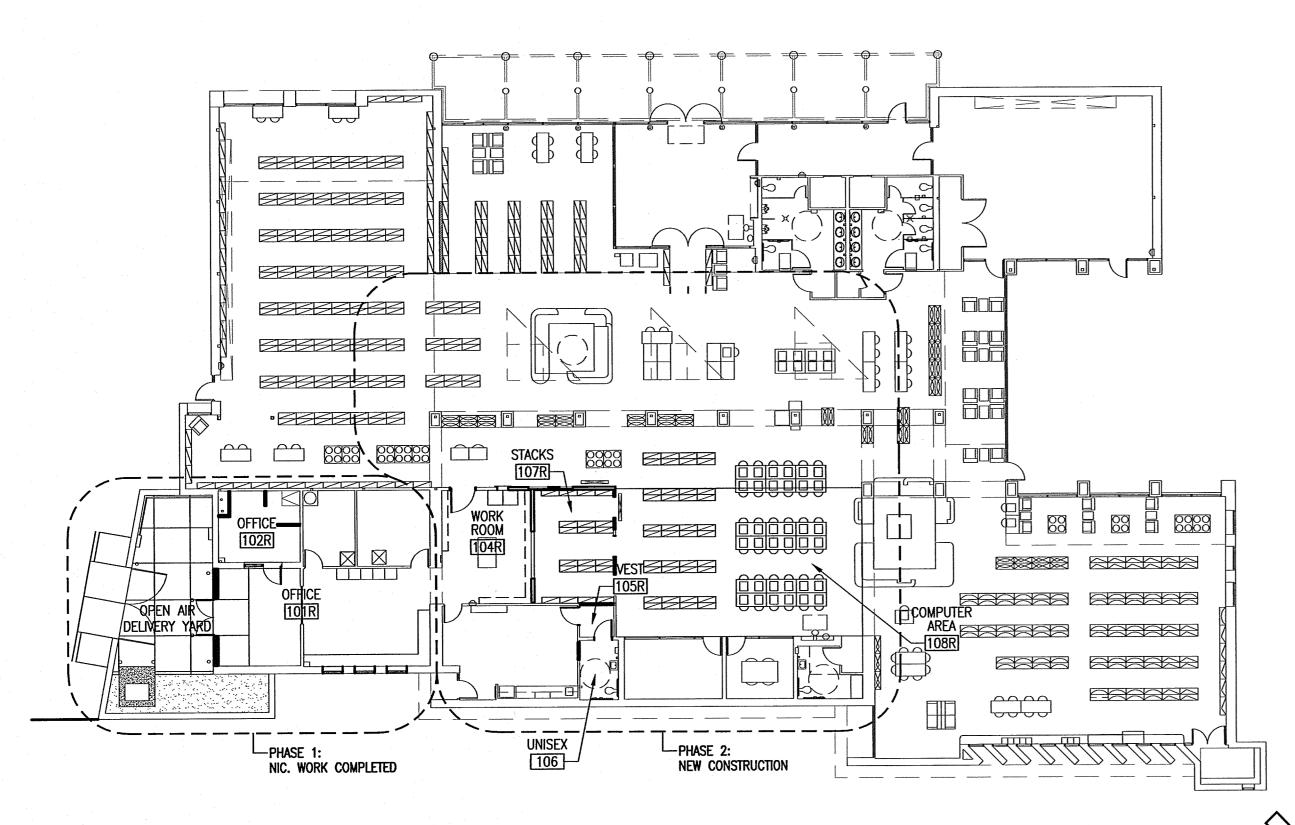


KEY PLAN




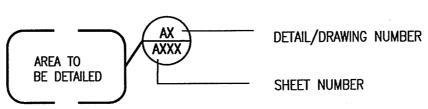


SECTION SYMBOL

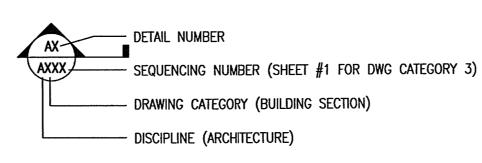

EXTERIOR ELEVATION SYMBOL

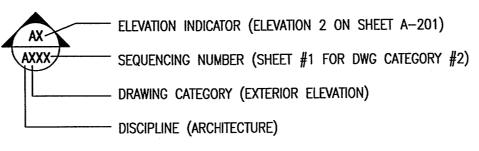


INTERIOR ELEVATION SYMBOL

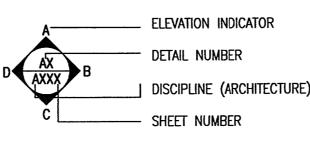


COLUMN / GRID LINE CALLOUT



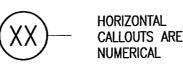


VERTICAL DATUM REFERENCE

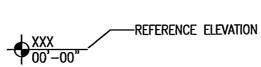

CENTERLINE SYMBOL

ROOM/SPACE IDENTIFICATION

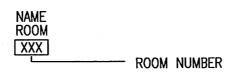


WINDOW IDENTIFICATION




WINDOW/FRAME TYPE


NORTH ARROW

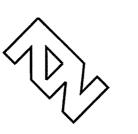

MATCH LINE AND DIRECTION LABEL

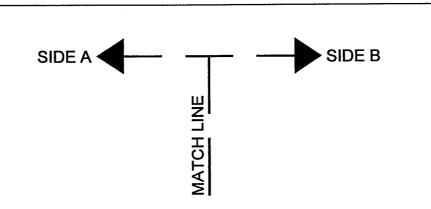


DIMENSION SYMBOL (ORIENTATION)

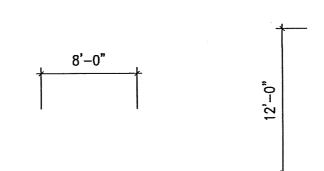


DIMENSION CRITERIA

FOR OPENING IN PARTITION WALL

- 1. WHEN ONE OCCURS AT A COLUMN OR GRIDLINE, NO DIMENSIONS WILL BE SHOWN ON THE PLANS. THE OPENING WIDTH WILL BE ESTABLISHED BY EITHER CRITERIA OR SCHEDULES. 2. WHEN NEITHER JAMB OCCURS AT A PARTITION INTERSECTION, AT A
- COLUMN OR AT A GRIDLINE; ONE JAMB WILL BE LOCATED DIMENSIONALLY BY THE DETAIL. 3. WHEN ONE JAMB IS LOCATED BY A PARTITION INTERSECTION, THE
- FOLLOWING DIAGRAM APPLIES.

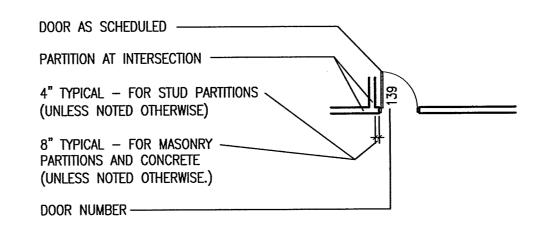

WALLS AND PARTITIONS ARE DIMENSIONED FROM FACE OF MASONRY OR STUDS UNLESS NOTED OTHERWISE.

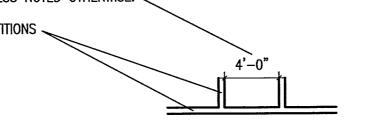

WALL TYPE

W-# ---- WALL TYPE IDENTIFICATION

DOOR NUMBER



ARCHITECTURAL ABBREVIATIONS

AHU	AIR HANDLING UNII
alt	ALTERNATE
BOB	BOTTOM OF BEAM
BOSS	BOTTOM OF STRUCTURAL STEEL
BOWD	BOTTOM OF WINDOW
BRG EL	BEARING ELEVATION
CL	CENTER LINE
CJ	CONTROL JOINT
COMP	COMPUTER ROOM
CONC	CONCRETE
CUST	CUSTODIAN'S ROOM
DF	DRINKING FOUNTAIN
EJ	EXPANSION JOINT
ELEC	ELECTRICAL ROOM
ELEV	ELEVATOR
EWC	ELECTRIC WATER COOLER
EXT	EXTERIOR
FD	FLOOR DRAIN
FEC	FIRE EXTINGUISHER CABINET
FF or	FINISH FLOOR ELEVATION
FIN FL	THIS IT I SOUTH SELECTION OF THE PARTY OF TH
GA	GAGE
GALV	GALVANIZED
GYP BD	GYPSUM BOARD
HM	HOLLOW METAL
JST BRG	
KIT	KITCHEN
MECH	MECHANICAL ROOM
MTL	METAL ROOM
	NUMBER
NO OC	
00	ON CENTER
OTD	OPEN TO DECK
PT	PRESSURE TREATED
REINF	REINFORCING
RH	ROOF HATCH
SIM	SIMILAR
	SIMILAR, OPPOSITE HAND
SS	STAINLESS STEEL
STL	STEEL
STOR	STORAGE
TH	THRESHOLD
TOJ	TOP OF JOIST
TOS	TOP OF SILL
TOSS	TOP OF STRUCTURAL STEEL
TOB	TOP OF BEAM
TOW	TOP OF WALL
TOWD	TOD OF WINDOW

TYPICAL

VESTIBULE

UNLESS NOTED OTHERWISE

RECORD SET OF DRAWINGS This set of drawings is provided by the Contractor as a schematic of the project in place. The Architect has not verified these conditions and is not responsible for conclusions drawn CHERRY/SEE/REAMES ARCHITECTS 4/13/2012

GENERAL PROJECT NOTES

- 1. THE GENERAL CONTRACTOR SHALL BRING ANY AND ALL DISCREPANCIES BETWEEN THE DRAWINGS AND SPECIFICATIONS TO THE IMMEDIATE ATTENTION OF THE ARCHITECT.
- 2. THE CONTRACTOR IS REQUIRED TO COMPLETELY FAMILIARIZE HIMSELF WITH THE ENTIRE SET OF PROJECT DRAWINGS, PROJECT MANUAL, SITE AND CONDITIONS. FAILURE TO ASCERTAIN WORK THAT MAY BE REQUIRED BY INFORMATION SHOWN ON OTHER SHEETS INCLUDING CIVIL, LANDSCAPE, STRUCTURAL, ARCHITECTURAL, PLUMBING, MECHANICAL AND ELECTRICAL SHEETS, ETC. WILL NOT BE ACCEPTABLE GROUNDS FOR ADDITIONAL COMPENSATION.

CHERRY/SEE/REAMES

ARCHITECTS, LLP

220 gold avenue sw albuquerque, nm 87102

505 - 842 - 1278 fax 505 - 766 - 9269

DATE:
DATE:
- DURING THE OPERATIONS UNDER THIS CONTRACT THE CONTRACTOR SHALL TAKE APPROPRIATE MEASURES TO PROTECT ANY AND ALL EXISTING IMPROVEMENTS THAT ARE TO REMAIN, INCLUDING VEGETATION THE CONTRACTOR SHALL REPAIR OR REPLACE ANY AND ALL ITEMS DAMAGED DURING THE COURSE OF WORK UNDER THIS CONTRACT AT NO ADDITIONAL COST TO THE OWNER.
- THE CONTRACTOR SHALL FIELD VERIFY ALL DIMENSIONS AND EXISTING EQUIPMENT AFFECTING THE WORK UNDER THIS CONTRACT BEFORE BEGINNING WORK. NOTIFY THE ARCHITECT OF ANY DISCREPANCIES
- IMMEDIATELY. 5. THE CONTRACTOR AND ALL SUB-CONTRACTORS SHALL ASSUME THAT ALL UTILITY LINES ON THE SITE ARE LIVE UNTIL AND UNLESS THE CONTRACTOR HAS DETERMINED OTHERWISE.
- 6. APPROPRIATE PLACEMENT OF THE CONSTRUCTION STAGING AREA WILL BE REVIEWED PRIOR TO THE COMMENCEMENT OF CONSTRUCTION. DIMENSIONS AT NEW CONSTRUCTION ARE TO FACE OF STUD, UNLESS STATED OTHERWISE.
- DIMENSIONS AT ALL EXISTING FEATURES ARE TO FACE OR EDGE OF FINISHED SURFACE.
- 8. INFORMATION ON EXISTING ITEMS SHOWN IN THESE DRAWINGS ARE BASED UPON THE ORIGINAL CONSTRUCTION DRAWINGS FOR THE PROJECT AND ARE PROVIDED AS A COURTESY TO THE CONTRACTOR. THE ARCHITECT BEARS NO RESPONSIBILITY FOR ANY INCORRECT INFORMATION OR LOCATIONS OF EXISTING ITEMS SHOWN ON THE PLANS. THE CONTRACTOR SHALL VERIFY INFORMATION AND LOCATION OF OBJECTS CRITICAL TO THE WORK PRIOR TO COMMENCING WORK.
- THE LIBRARY IS TO REMAIN OPEN TO THE PUBLIC FOR AS MUCH OF THE CONSTRUCTION PERIOD AS POSSIBLE. THE CONTRACTOR IS TO SCHEDULE ACTIVITIES WHICH ARE NOISY OR DISRUPTIVE TO LIBRARY PATRONS EARLY IN THE DAY, PREFERABLY BEFORE OPENING. THE OWNER SHOULD BE MADE AWARE, IN ADVANCE, OF ANY SCHEDULING CONFLICT WHICH PREVENTS THE ABOVE FROM BEING POSSIBLE, SO THAT IT CAN BE PLANNED FOR. PROVIDE DUST BARRIERS.
- 10. ALL BOOKS WILL BE REMOVED BY OWNER FROM ANY SHELVING TO BE
- 11. REFERENCE CITY STANDARD SPECS FOR PROJECT COMPLETION. 12. ALL CONSTRUCTION ACTIVITIES NEED TO COMPLY WITH OSHA 29 CFR 1926, SAFETY AND HEALTH REGULATION FOR CONSTRUCTION.


REFERENCE KEYED NOTES

	DIVISION
10 1100.A03 ———	KEYED NOTE DESIGNATION
	SPECIFICATION SECTION NUMBER

KEYED NOTES

SEE KEYED NOTE 1 ON SAME SHEET FOR ITEM BEING POINTED TO.


MATERIALS LEGEND

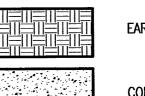


	CONCILL	
шенининининин орология и шкакан аана	BRICK IN PLAN ON	Į

BRICK IN ELEVATION

STI
STI

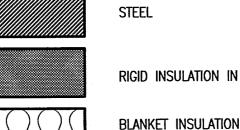


RIGID INSULATION IN SECTION

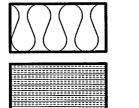

BUILT UP ROOF AND INSULATION IN SECTION

STUD WALL


GYPSUM BOARD IN SECTION

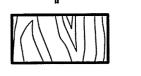

CITY OF ALBUQUERQUE ERNA FERGUSSON LIBRARY MODIFICATIONS

TITLE: GENERAL INFORMATION

DRAWING INDE	:X				
gn Review Committee	City Engineer Approval	Last Design Update	MO./DAY/YR.	MO./I	DAY/YR.
Project No. 7168.03	Zone Map No. G-18-Z	Sheet A00	1	8,	$\frac{1}{2}$

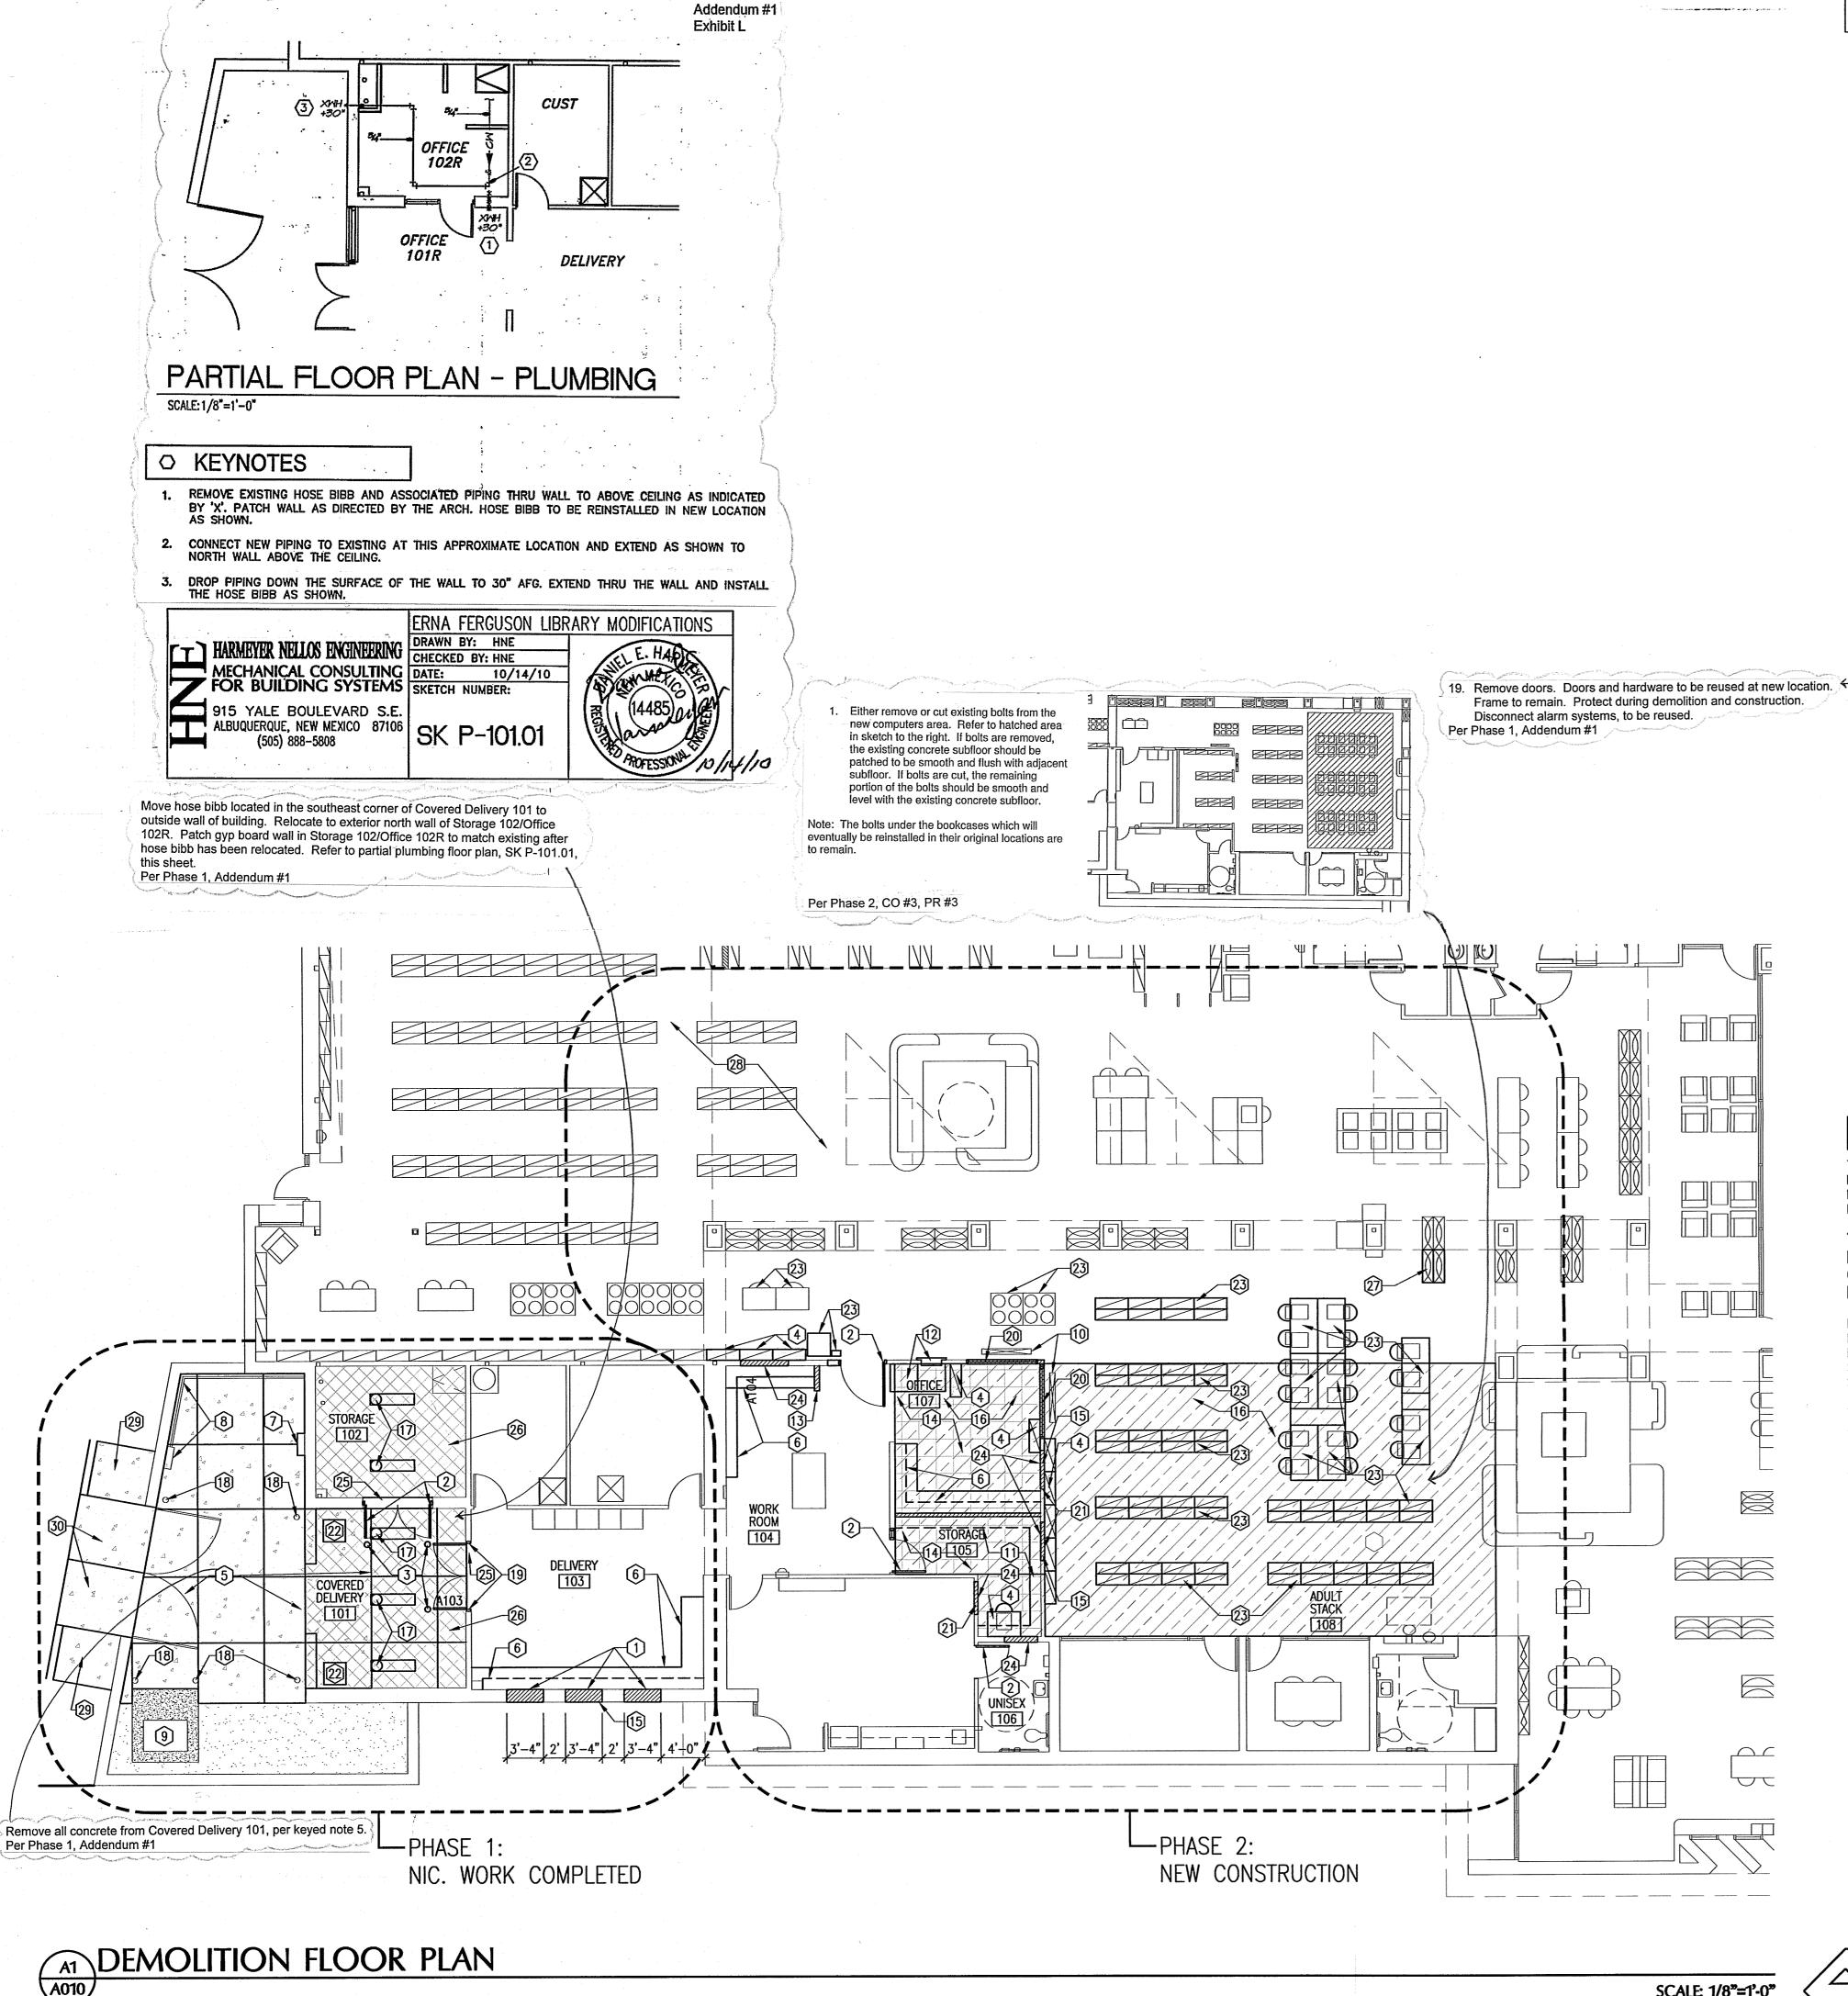

KEYED NOTES

 CUT OUT INTERIOR FURRED OUT GYPSUM BOARD WALL AS REQUIRED. SAW CUT THE NEW OPENING. INSTALL A NEW STEEL FRAME AND REMOVE THE CMU AND BRICK FOR NEW WINDOW. SEE STRUCTURAL DRAWINGS.

REMOVE DOOR AND FRAME. REMOVE CONCRETE FILLED BOLLARDS. CLEAN AND REUSE.

4. REMOVE FURNITURE. RETURN FURNITURE IN GOOD CONDITION TO

5. REMOVE CONCRETE IN SHADED AREAS. NEW, RE-GRADED, CONCRETE WILL BE POURED. SAW-CUT EXISTING AS REQUIRED.

6. REMOVE SHELVING OR CASEWORK. AT TIME OF REMOVAL, COORDINATE WITH OWNER WHETHER THE REMOVED MATERIAL IS TO BE DISPOSED OF OR SALVAGED TO THE OWNER FOR FUTURE USE. REMAINING WALL TO BE REFINISHED AND TEXTURED TO MATCH ADJACENT CONDITIONS. 7. ELECTRICAL PANEL TO REMAIN. PANEL TO BE PROTECTED DURING

DEMOLITION AND RE-POURING OF ADJACENT CONCRETE. 8. GAS METER AND PIPING TO REMAIN. METER AND PIPING TO BE PROTECTED DURING DEMOLITION AND RE-POURING OF ADJACENT

9. TRANSFORMER TO REMAIN. TRANSFORMER TO BE PROTECTED DURING DEMOLITION AND RE-POUTING OF ADJACENT CONCRETE.

10. MECHANICAL FLOOR REGISTERS TO BE REMOVED. AIR DUCTS TO BE PROTECTED AND KEPT FREE OF DUST DURING DEMOLITION AND CONSTRUCTION. GRIND FLOOR DUCT DOWN AS REQUIRED, SO

11. SHELVING AND WALL BRACKETS TO BE CAREFULLY REMOVED FOR EVENTUAL RE-USE IN THE PROJECT.

12. REMOVE BOOK DROP AND STORE FOR EVENTUAL REUSE IN PROJECT. BOOK CARTS TO REMAIN AT THE LOCATION OF THE BOOK DROP, WHILE IT IS IN USE.

13. WALL TO BE REMOVED. AT FORMER WALL JOINT, SURFACE TO BE LEVEL WITH EXISTING WALL AND PREPPED FOR FINISH MATERIAL.

14. REMOVE LAY-IN CEILING, GRID AND LIGHT FIXTURES. REFER TO ELECTRICAL DRAWINGS FOR INDICATION OF LIGHT FIXTURES TO BE SAVED FOR RE-INSTALLATION. SUPPORT JOISTS ABOVE WHEN CUTTING NEW WALL OPENINGS KEYED NOTE 24.

15. SUPPORT JOISTS AT BEARING WALL WHILE CUTTING NEW OPENINGS. 16. REMOVE CARPET IN SHADED AREA. REMAINING CARPET TO BE CUT IN SUCH A WAY AS TO BE READY TO RECEIVE NEW CARPET, WITH SMOOTH Transition.

17. REMOVE LIGHT FIXTURES.

18. REMOVE CONCRETE BOLLARDS. REINSTALL BOLLARDS IN SAME LOCATION. SEE FLOOR PLAN, SHEET A101.

19. Remove doors. Doors and hardware to be reused at new location. < 19. REMOVE DOORS AND FRAME. DOOR AND HARDWARE TO BE REUSED AT NEW LOCATION: PROTECT DURING DEMOLITION AND CONSTRUCTION. DISCONNECT ALARM SYSTEMS, TO BE REUSED.

20. REMOVE WINDOW AND FRAME.

REGISTERS LAY FLUSH WITH FLOOR.

21. SUPPORT JOISTS. 22. EXHAUST VENT TO BE REMOVED. EXHAUST TO BE DAY-LIT AT ROOF. 23. MOVE FURNITURE AND STORE ON-SITE FOR LATER USE IN PROJECT. GENERAL CONTRACTOR IS RESPONSIBLE FOR MOVING AND RE-BOLTING STACKS IN NEW LOCATION. LIBRARY STAFF IS RESPONSIBLE FOR

MOVING AND STORING BOOKS. 24. CUT WALL FOR NEW OPENING. SUPPORT WALL AND JOISTS DURING DEMOLITION AND CONSTRUCTION IF REQUIRED. CUT OUT TILE AT NEW DOOR OPENING.

25. REMOVE THRESHOLD AND REPAIR SLAB. 26. HARD CEILING IN SHADED AREA TO BE REMOVED. PREPARE REMAINING

SURFACES TO RECEIVE NEW 2'X2' LAY-IN CEILING SYSTEM. 27. REMOVE UNITS. RELOCATE END PANEL TO REMAINING UNITS.

COORDINATE WITH LIBRARY 28. REFER TO REFLECTED CEILING PLAN, SHEET A102, AND MECHANICAL

PLANS FOR AREA OF CEILING GRID AND TILES TO BE REMOVED FOR INSTALLATION OF NEW MECHANICAL DUCTS. TILES AND GRID ARE TO BE STORED FOR EVENTUAL REINSTALLATION IN SAME LOCATION, ONCE MECHANICAL WORK IS COMPLETE.

29. REMOVE SIDEWALK AND CURB SLOPING DOWN TO THE CURB CUT. 30. REMOVE SIDEWALK AND CURB AT DRIVE.

GENERAL PURPOSE OF PROJECT

TO PROVIDE SPACE FOR MORE PUBLIC ACCESS COMPUTER STATIONS. DUE TO BUDGET CONSTRAINTS, THIS PURPOSE IS TO BE ACCOMPLISHED IN TWO PHASES. THERE ARE CURRENTLY 16 PUBLIC ACCESS COMPUTERS. THESE RENOVATIONS WILL ADD ANOTHER 20 STATIONS FOR A TOTAL OF 36 STATIONS.

THESE DRAWINGS CONTAIN WORK FOR BOTH PHASE 1 AND PHASE 2 OF THE PROJECT. WORK FOR PHASE 2 TO BE COMPLETED AS PART OF THIS CONTRACT. PHASE 1 WORK IS NOT IN CONTRACT AND HAS ALREADY BEEN COMPLETED.

PURPOSE OF PHASE 1: TO ENCLOSE EXISTING, EXTERIOR DELIVERY SPACE FOR DELIVERY AND SORTING; REMODEL EXISTING STORAGE ROOM INTO OFFICE SPACE; AND REMODEL EXISTING SORTING AREA INTO WORK SPACE AND WORK STATIONS AND OTHER WORK NOTED IN PHASE 1 ON THE DRAWINGS.

ADD KALWALL AND RELOCATED DOOR TO COVERED DELIVERY TO ENCLOSE. REMOVE DOOR A103 BETWEEN COVERED DELIVERY 101 AND DELIVERY 103. BECOMES OFFICE 101R AND OFFICE 103R. TO BE USED FOR DELIVERY, BOOK SORTING AND OTHER WORK ROOM TASKS.

CHANGE STORAGE 102 TO OFFICE 102R WITH 2 WORK STATIONS. USE FURNITURE, NOT BUILT-IN CASEWORK. CUT 3 NEW WINDOWS IN OFFICE 103R. NEW TOP FOR CASEWORK.

REPAIR FINISHES AND PAINT REWORK DRAINAGE OF SERVICE YARD

RELOCATE OFFICE FUNCTIONS INTO OFFICE 102R AND OFFICE 103R IN PREPARATION FOR PHASE II.

REWORK MECHANICAL AND ELECTRICAL SERVICE AS REQUIRED. EXISTING COVERED DELIVERY 101 WILL BECOME AN ENCLOSED SPACE.

9. INSULATE WEST WALL OF ROOM 101R.

PURPOSE OF PHASE 2: TO RELOCATE OFFICE FUNCTIONS OUT OF OFFICE 107 TO ALLOW RELOCATION OF STACKS INTO THAT AREA WHICH FREES UP SPACE FOR MORE PUBLIC ACCESS COMPUTER STATIONS AND OTHER WORK NOTED IN PHASE 2 ON THE DRAWINGS.

REWORK VESTIBULE ENTRY TO RESTROOM MOVE DOOR A104 NORTH

REMOVE PORTIONS OF LOAD-BEARING WALL BETWEEN STACKS 107R AND

PUBLIC AREA TO ALLOW ENTRY TO STACKS 107R. 4. NEW PARTIAL PARTITION TO CLOSE OFF WORK ROOM 104R FROM STACKS

RELOCATE STACKS FROM PUBLIC AREA INTO STACKS 107R.

ADD COMPUTER TABLES, SEATS, AND COMPUTERS REWORK MECHANICAL AND ELECTRICAL SERVICE AS REQUIRED. A NEW HVAC UNIT AND SUPPLY WILL BE ADDED. STRUCTURAL IS REQUIRED FOR NEW LINTELS IN LOAD-BEARING WALL.

GENERAL SHEET NOTES

REFER TO SHEET A001 FOR GENERAL ARCHITECTURAL INFORMATION. CONTRACTOR TO REMOVE AND PROPERLY DISPOSE OF ALL TRASH AND

DEBRIS FROM THE BUILDING AND THE SITE. AFTER COMPLETION OF WORK, CONTRACTOR SHALL THOROUGHLY CLEAN UP ALL WORK AREAS. DURING THE OPERATIONS UNDER THIS CONTRACT THE CONTRACTOR SHALL TAKE APPROPRIATE MEASURES TO PROTECT ALL IMPROVEMENTS AND EXISTING CONDITIONS THAT ARE TO REMAIN. THE CONTRACTOR

CHERRY/SEE/REAMES

ARCHITECTS, LLP

220 gold avenue sw albuquerque, nm 87102

505 - 842 - 1278 fax 505 - 766 - 9269

COURSE OF WORK UNDER THE CONTRACT AT NO ADDITIONAL COST TO THE OWNER. THE CONTRACTOR SHALL COORDINATE WITH THE OWNER THE NECESSARY SHUT OFF OF EXISTING ELECTRICAL CIRCUITS AND OTHER UTILITIES AS MAY BE REQUIRED TO SAFELY COMPLETE THE WORK OF THIS CONTRACT

SHALL REPAIR OR REPLACE ANY AND ALL ITEMS DAMAGED DURING THE

SOME. BUT NOT ALL. MECHANICAL AND ELECTRICAL ITEMS ARE SHOWN ON THESE SHEETS. SEE MECHANICAL AND ELECTRICAL DRAWINGS FOR ADDITIONAL INFORMATION.

THE CONTRACTOR IS RESPONSIBLE FOR THE STABILITY OF ALL WALLS. PARTITIONS, FLOORS, CEILINGS AND OTHER STRUCTURES AND FEATURES DURING DEMOLITION AND CONSTRUCTION. THE CONTRACTOR IS RESPONSIBLE FOR TEMPORARY SHORING, NOT SHOWN, TO PROVIDE SUPPORT PRIOR TO INSTALLATION OF PERMANENT STRUCTURAL OR SUPPORT ELEMENTS.

MOVE ELECTRICAL CONDUIT OUTLETS, LIGHTS, ETC. AS REQUIRED FOR NEW OPENINGS.

8. IN AREAS WHERE SUSPENDED CEILING SYSTEMS ARE OPENED FOR WORK UNDER THIS CONTRACT, INSTALL CODE COMPLYING SEISMIC TIES BETWEEN THE CEILING GRID SYSTEM AND THE STRUCTURE ABOVE INSTALL CODE COMPLYING SAFETY WIRES BETWEEN ALL FOUR CORNERS OF LIGHT FIXTURES AND THE STRUCTURE ABOVE.

9. AT WALLS WITH CLOSED OR NEW OPENINGS, REFINISH THE GYPSUM BOARD AROUND THE NEW OR CLOSED OPENING. TEXTURE TO MATCH EXISTING AND PAINT THE FULL LENGTH OF THE WALL TO THE NEXT PERPENDICULAR WALL ON EACH END. AFTER THE REPAIRS HAVE BEEN

COMPLETED, NO VISIBLE REPAIRS SHALL REMAIN. 10. THE DEMOLITION AND CONSTRUCTION WORK AT THE LIBRARY IS TO BE DONE IN SUCH A WAY THAT THE BOOK SORTING ROOM RETAINS ITS FUNCTION FOR THE MAXIMUM AMOUNT OF TIME. WHEN THIS ROOM IS NOT FUNCTIONING, THE LIBRARY WILL BE CLOSED TO THE PUBLIC. AT ALL OTHER TIMES. THE LIBRARY WILL BE OPEN TO THE PUBLIC, AND DEMOLITION AND CONSTRUCTION AREAS ARE TO BE FENCED OFF FOR SAFETY. PROVIDE DUST CONTROL TO REMAINING AREAS OF THE

11. KEEP DIRT AND CONSTRUCTION DEBRIS FROM ENTERING DUCTS DURING DEMOLITION AND CONSTRUCTION.

12. DISTURBED EXISTING CONSTRUCTIONS SHALL BE PATCHED, REPAIRED AND/OR REPLACED TO RETURN TO ORIGINAL CONDITION. NEW CONSTRUCTION ADJACENT TO EXISTING CONSTRUCTION TO MATCH EXISTING IN ALL RESPECTS AS APPLICABLE UNLESS NOTED OTHERWISE WHEN WALLS OR OTHER ITEMS ARE REMOVED, REPAIR FLOOR, WALL AND CEILING AREAS WHERE THE ITEM HAS BEEN REMOVED TO THE POINT WHERE THEY ARE READY TO RECEIVE THE FINAL FINISH WITHOUT A NOTICEABLE TRANSITION. WHERE EXISTING WALLS ARE REMOVED, PATCH AND REPAIR THE SUBFLOOR TO A LEVEL CONDITION.

13. THE WALL MATERIALS SHOWN ARE ASSUMED TO BE ACTUAL WALL MATERIALS. NO REPRESENTATION IS MADE AS TO THE CONSISTENCY OF WALL MATERIALS. THE CONTRACTOR SHALL INSPECT ALL AREAS PRIOR TO BIDDING.

14. REMOVE ALL USABLE CARPET IN SPECIFIED AREAS. DISCARD OR RECYCLE UNUSABLE CARPET AS APPROPRIATE.

15. THE CONTRACTOR AND THE MECHANICAL AND ELECTRICAL SUB CONTRACTORS MUST VISIT THE SITE PRIOR TO BIDDING TO DETERMINE THE EXTENT OF DEMOLITION. ALL ELECTRICAL AND MECHANICAL ITEMS LOCATED IN FLOORS, WALLS AND CEILINGS ARE TO BE REMOVED AS PART OF BASE BID.

16. SAW CUT CONCRETE TO BE REMOVED.

17. WHERE ALARMS NEED TO BE RELOCATED, THE CONTRACTOR MUST COORDINATE WITH THE OWNER'S ALARM SERVICE.

18. NO OVERHEAD DEMOLITION OR CONSTRUCTION WILL BE ALLOWED IN OCCUPIED SPACES WITHOUT PRIOR COA RISK MANAGEMENT APPROVALS.

 LEGEND	
 LLOLIND	
•	

EXISTING WALL TO REMAIN

7,55,55		WALL TO BE REMOVED	
۵	44 44	CONCRETE TO BE REMOVED, REGR	RADED & REPLACED
		CARPET TO BE REMOVED AND REF	PLACED

LAY—IN CEILING TO BE REMOVED

CONCRETE FILLED BOLLARD TO BE REMOVED

FURNITURE TO BE REMOVED AND STORED


HARD CEILING TO BE REMOVED

RECORD SET OF DRAWINGS This set of drawings is provided by the Contractor as a schematic of the project in place. The Architect has not verified these conditions and is not responsible for conclusions drawn CHERRY/SEE/REAMES ARCHITECTS 4/13/2012

> CITY OF ALBUQUERQUE ERNA FERGUSSON LIBRARY MODIFICATIONS

TITLE ---- AND TONE DE AND

City Engineer Approval City Engineer Approval City Engineer Approval	ity Project No. 7168.03	Zone Map No. G-18-Z	Sheet A010	0	9 of	2
10 (0) (0)	esign Review Committee	City Engineer Approval		MO./DAY/YR.	MO./DAY/Y	R.

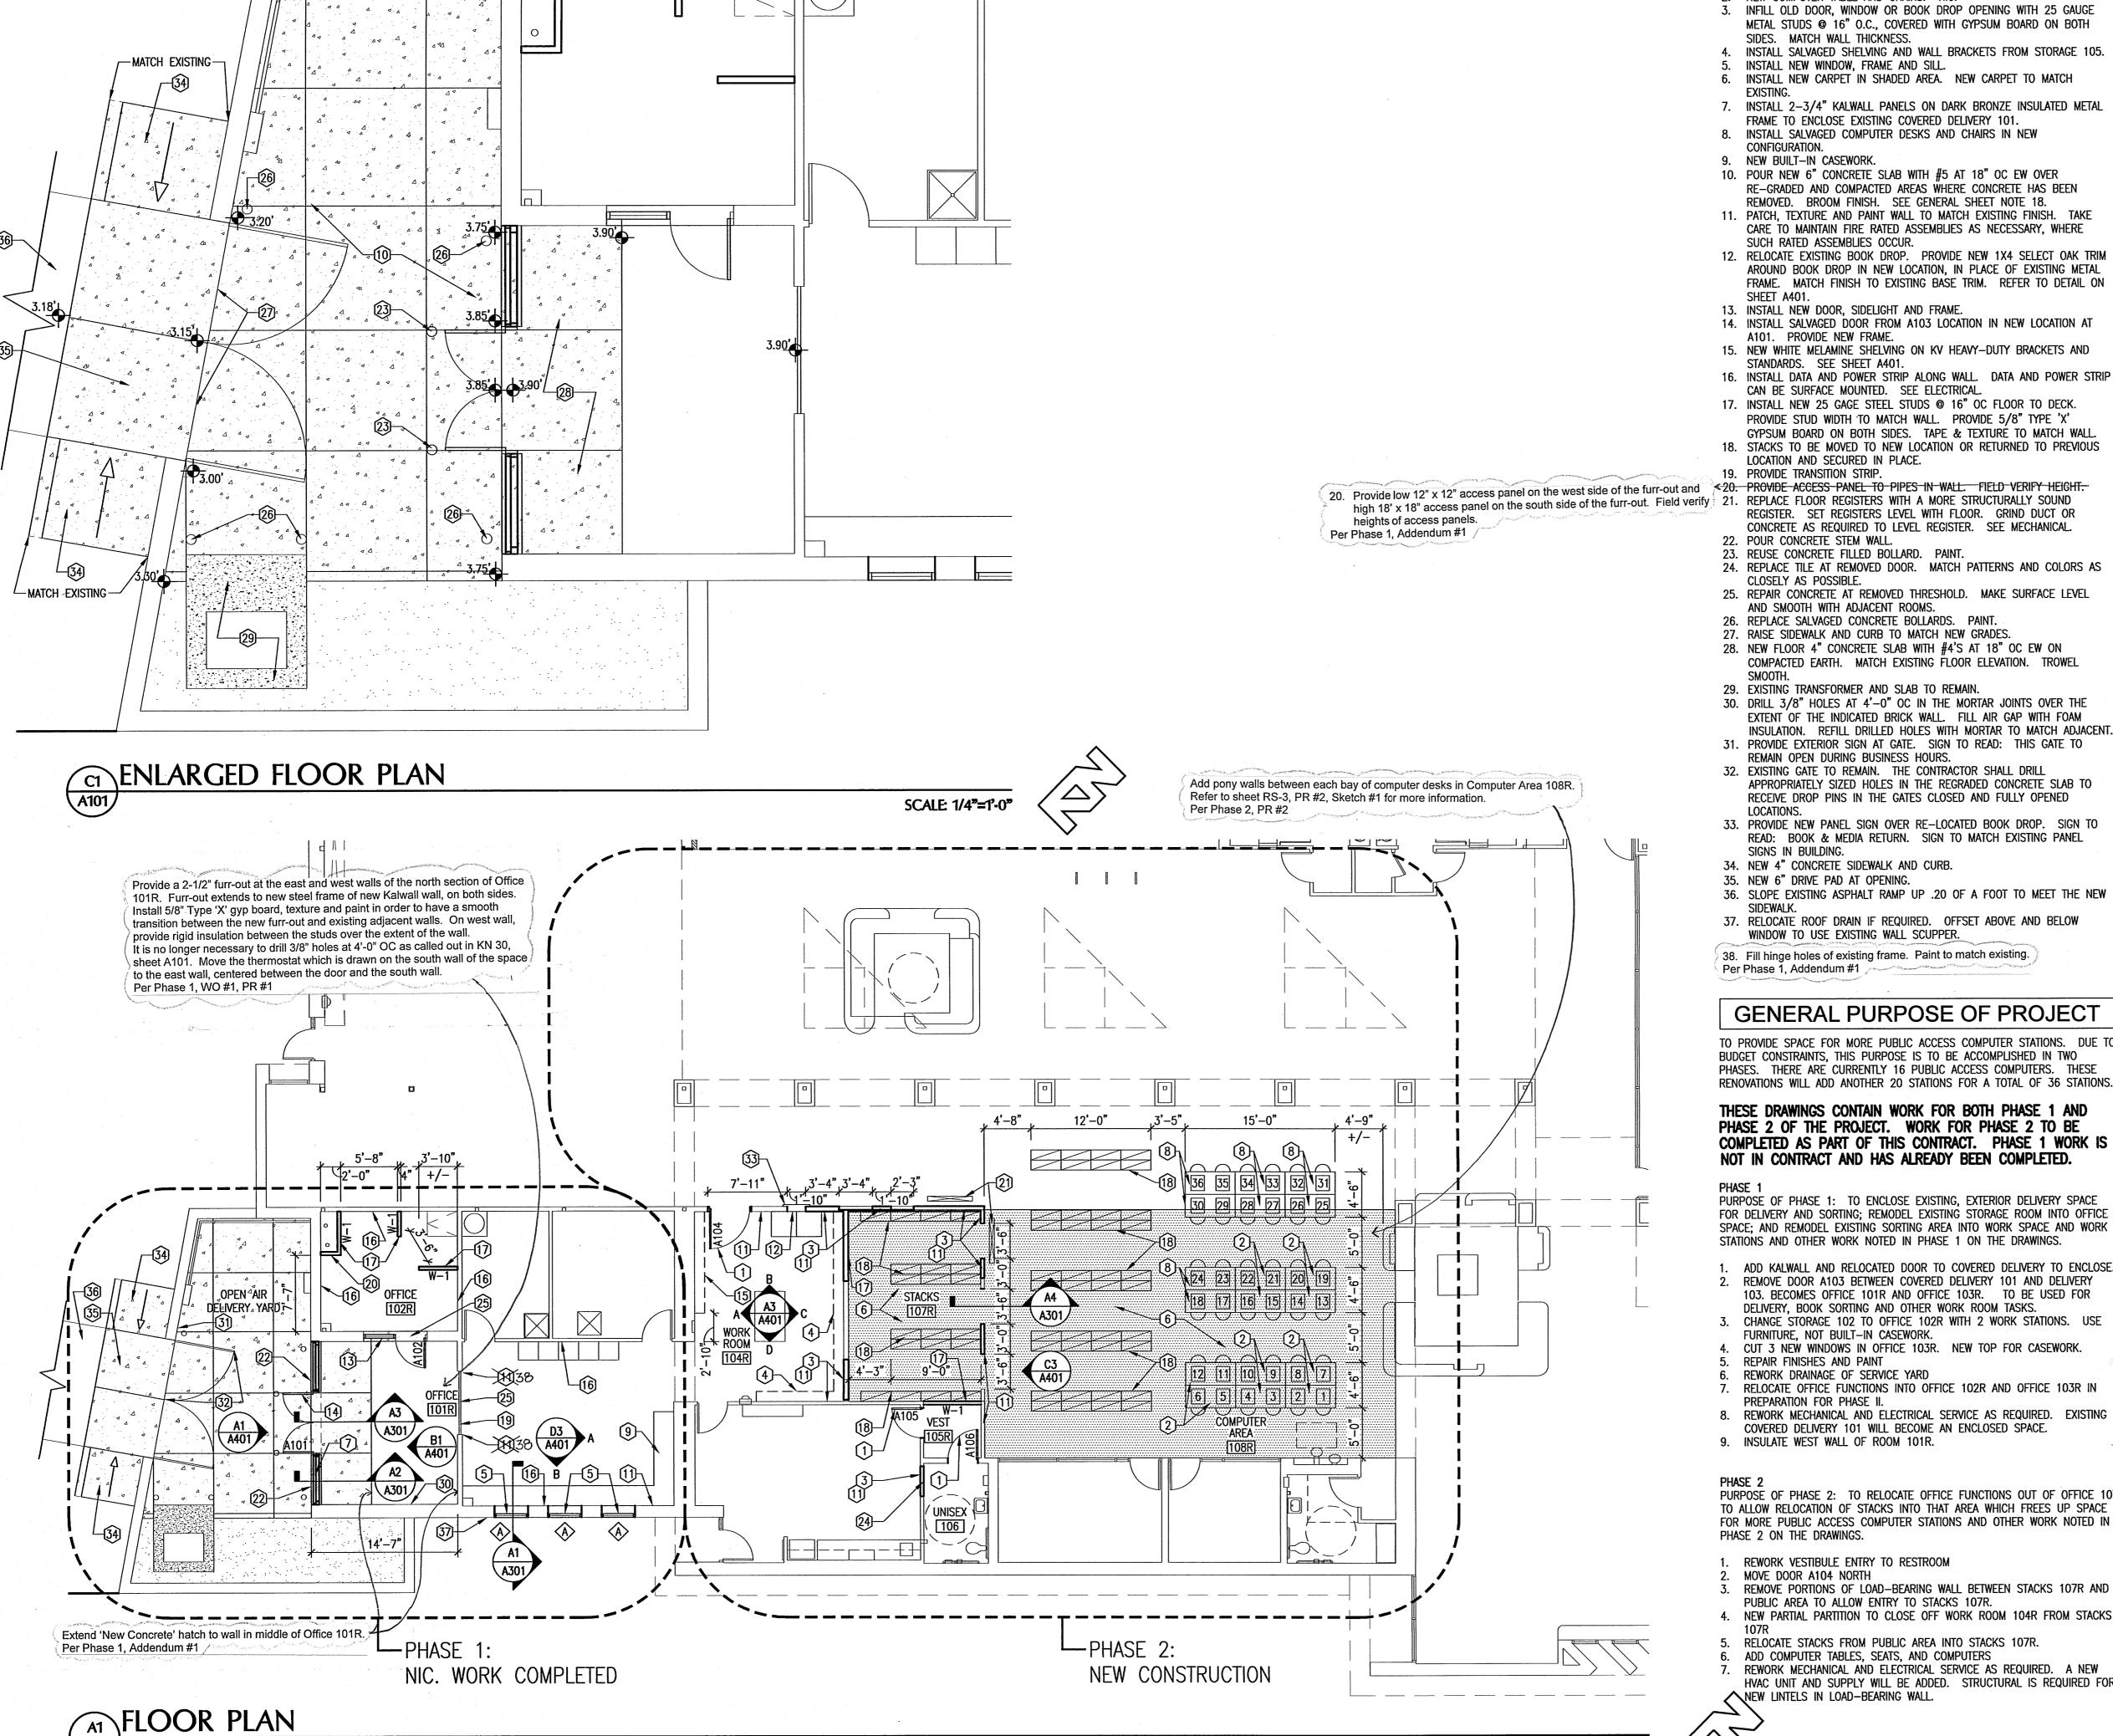

KEYED NOTES

INSTALL NEW DOOR AND FRAME.

NEW COMPUTER TABLE AND CHAIRS. NIC. 3. INFILL OLD DOOR, WINDOW OR BOOK DROP OPENING WITH 25 GAUGE METAL STUDS @ 16" O.C., COVERED WITH GYPSUM BOARD ON BOTH

SIDES. MATCH WALL THICKNESS. 4. INSTALL SALVAGED SHELVING AND WALL BRACKETS FROM STORAGE 105.

INSTALL NEW WINDOW, FRAME AND SILL. 6. INSTALL NEW CARPET IN SHADED AREA. NEW CARPET TO MATCH

7. INSTALL 2-3/4" KALWALL PANELS ON DARK BRONZE INSULATED METAL

FRAME TO ENCLOSE EXISTING COVERED DELIVERY 101. 8. INSTALL SALVAGED COMPUTER DESKS AND CHAIRS IN NEW

CONFIGURATION.

NEW BUILT-IN CASEWORK.

10. POUR NEW 6" CONCRETE SLAB WITH #5 AT 18" OC EW OVER RE-GRADED AND COMPACTED AREAS WHERE CONCRETE HAS BEEN REMOVED. BROOM FINISH. SEE GENERAL SHEET NOTE 18.

11. PATCH, TEXTURE AND PAINT WALL TO MATCH EXISTING FINISH. TAKE CARE TO MAINTAIN FIRE RATED ASSEMBLIES AS NECESSARY, WHERE SUCH RATED ASSEMBLIES OCCUR.

12. RELOCATE EXISTING BOOK DROP. PROVIDE NEW 1X4 SELECT OAK TRIM AROUND BOOK DROP IN NEW LOCATION, IN PLACE OF EXISTING METAL FRAME. MATCH FINISH TO EXISTING BASE TRIM. REFER TO DETAIL ON SHEET A401.

13. INSTALL NEW DOOR, SIDELIGHT AND FRAME.

14. INSTALL SALVAGED DOOR FROM A103 LOCATION IN NEW LOCATION AT A101. PROVIDE NEW FRAME

15. NEW WHITE MELAMINE SHELVING ON KV HEAVY-DUTY BRACKETS AND STANDARDS. SEE SHEET A401.

16. INSTALL DATA AND POWER STRIP ALONG WALL. DATA AND POWER STRIP CAN BE SURFACE MOUNTED. SEE ELECTRICAL

17. INSTALL NEW 25 GAGE STEEL STUDS @ 16" OC FLOOR TO DECK. PROVIDE STUD WIDTH TO MATCH WALL. PROVIDE 5/8" TYPE 'X'

GYPSUM BOARD ON BOTH SIDES. TAPE & TEXTURE TO MATCH WALL 18. STACKS TO BE MOVED TO NEW LOCATION OR RETURNED TO PREVIOUS LOCATION AND SECURED IN PLACE.

REGISTER. SET REGISTERS LEVEL WITH FLOOR. GRIND DUCT OR CONCRETE AS REQUIRED TO LEVEL REGISTER. SEE MECHANICAL.

22. POUR CONCRETE STEM WALL. 23. REUSE CONCRETE FILLED BOLLARD. PAINT

19. PROVIDE TRANSITION STRIP.

24. REPLACE TILE AT REMOVED DOOR. MATCH PATTERNS AND COLORS AS CLOSELY AS POSSIBLE.

25. REPAIR CONCRETE AT REMOVED THRESHOLD. MAKE SURFACE LEVEL AND SMOOTH WITH ADJACENT ROOMS.

REPLACE SALVAGED CONCRETE BOLLARDS. PAINT.

27. RAISE SIDEWALK AND CURB TO MATCH NEW GRADES. 28. NEW FLOOR 4" CONCRETE SLAB WITH #4'S AT 18" OC EW ON COMPACTED EARTH. MATCH EXISTING FLOOR ELEVATION. TROWEL

29. EXISTING TRANSFORMER AND SLAB TO REMAIN.

30. DRILL 3/8" HOLES AT 4'-0" OC IN THE MORTAR JOINTS OVER THE EXTENT OF THE INDICATED BRICK WALL. FILL AIR GAP WITH FOAM INSULATION. REFILL DRILLED HOLES WITH MORTAR TO MATCH ADJACENT.

31. PROVIDE EXTERIOR SIGN AT GATE. SIGN TO READ: THIS GATE TO

REMAIN OPEN DURING BUSINESS HOURS. 32. EXISTING GATE TO REMAIN. THE CONTRACTOR SHALL DRILL APPROPRIATELY SIZED HOLES IN THE REGRADED CONCRETE SLAB TO

33. PROVIDE NEW PANEL SIGN OVER RE-LOCATED BOOK DROP. SIGN TO READ: BOOK & MEDIA RETURN. SIGN TO MATCH EXISTING PANEL SIGNS IN BUILDING.

RECEIVE DROP PINS IN THE GATES CLOSED AND FULLY OPENED

34. NEW 4" CONCRETE SIDEWALK AND CURB. 35. NEW 6" DRIVE PAD AT OPENING.

36. SLOPE EXISTING ASPHALT RAMP UP .20 OF A FOOT TO MEET THE NEW

37. RELOCATE ROOF DRAIN IF REQUIRED. OFFSET ABOVE AND BELOW WINDOW TO USE EXISTING WALL SCUPPER.

38. Fill hinge holes of existing frame. Paint to match existing. Per Phase 1, Addendum #1

GENERAL PURPOSE OF PROJECT

TO PROVIDE SPACE FOR MORE PUBLIC ACCESS COMPUTER STATIONS. DUE TO BUDGET CONSTRAINTS, THIS PURPOSE IS TO BE ACCOMPLISHED IN TWO PHASES. THERE ARE CURRENTLY 16 PUBLIC ACCESS COMPUTERS. THESE RENOVATIONS WILL ADD ANOTHER 20 STATIONS FOR A TOTAL OF 36 STATIONS.

THESE DRAWINGS CONTAIN WORK FOR BOTH PHASE 1 AND PHASE 2 OF THE PROJECT. WORK FOR PHASE 2 TO BE COMPLETED AS PART OF THIS CONTRACT. PHASE 1 WORK IS NOT IN CONTRACT AND HAS ALREADY BEEN COMPLETED.

PURPOSE OF PHASE 1: TO ENCLOSE EXISTING, EXTERIOR DELIVERY SPACE FOR DELIVERY AND SORTING; REMODEL EXISTING STORAGE ROOM INTO OFFICE SPACE; AND REMODEL EXISTING SORTING AREA INTO WORK SPACE AND WORK STATIONS AND OTHER WORK NOTED IN PHASE 1 ON THE DRAWINGS.

ADD KALWALL AND RELOCATED DOOR TO COVERED DELIVERY TO ENCLOSE. REMOVE DOOR A103 BETWEEN COVERED DELIVERY 101 AND DELIVERY 103. BECOMES OFFICE 101R AND OFFICE 103R. TO BE USED FOR

3. CHANGE STORAGE 102 TO OFFICE 102R WITH 2 WORK STATIONS. USE FURNITURE, NOT BUILT-IN CASEWORK.

DELIVERY, BOOK SORTING AND OTHER WORK ROOM TASKS.

4. CUT 3 NEW WINDOWS IN OFFICE 103R. NEW TOP FOR CASEWORK.

REPAIR FINISHES AND PAINT 6. REWORK DRAINAGE OF SERVICE YARD

RELOCATE OFFICE FUNCTIONS INTO OFFICE 102R AND OFFICE 103R IN PREPARATION FOR PHASE II.

REWORK MECHANICAL AND ELECTRICAL SERVICE AS REQUIRED. EXISTING COVERED DELIVERY 101 WILL BECOME AN ENCLOSED SPACE.

9. INSULATE WEST WALL OF ROOM 101R.

PURPOSE OF PHASE 2: TO RELOCATE OFFICE FUNCTIONS OUT OF OFFICE 107 TO ALLOW RELOCATION OF STACKS INTO THAT AREA WHICH FREES UP SPACE FOR MORE PUBLIC ACCESS COMPUTER STATIONS AND OTHER WORK NOTED IN PHASE 2 ON THE DRAWINGS.

REWORK VESTIBULE ENTRY TO RESTROOM

NEW LINTELS IN LOAD-BEARING WALL.

MOVE DOOR A104 NORTH

REMOVE PORTIONS OF LOAD-BEARING WALL BETWEEN STACKS 107R AND PUBLIC AREA TO ALLOW ENTRY TO STACKS 107R.

HVAC UNIT AND SUPPLY WILL BE ADDED. STRUCTURAL IS REQUIRED FOR

5. RELOCATE STACKS FROM PUBLIC AREA INTO STACKS 107R. ADD COMPUTER TABLES, SEATS, AND COMPUTERS REWORK MECHANICAL AND ELECTRICAL SERVICE AS REQUIRED. A NEW

SCALE: 1/8"=1'-0"

GENERAL SHEET NOTES

REFER TO SHEET A001 FOR GENERAL ARCHITECTURAL INFORMATION. CONTRACTOR TO REMOVE AND PROPERLY DISPOSE OF ALL TRASH AND DEBRIS FROM THE BUILDING AND THE SITE. AFTER COMPLETION OF

WORK, CONTRACTOR SHALL THOROUGHLY CLEAN UP ALL WORK AREAS. DURING THE OPERATIONS UNDER THIS CONTRACT THE CONTRACTOR SHALL TAKE APPROPRIATE MEASURES TO PROTECT ALL IMPROVEMENTS AND EXISTING CONDITIONS THAT ARE TO REMAIN. THE CONTRACTOR SHALL REPAIR OR REPLACE ANY AND ALL ITEMS DAMAGED DURING THE COURSE OF WORK UNDER THE CONTRACT AT NO ADDITIONAL COST TO

4. THE CONTRACTOR SHALL COORDINATE WITH THE OWNER THE NECESSARY SHUT OFF OF FXISTING ELECTRICAL CIRCUITS AND OTHER UTILITIES AS MAY BE REQUIRED TO SAFELY COMPLETE THE WORK OF THIS CONTRACT. CHERRY/SEE/REAMES

ARCHITECTS, LLP

220 gold avenue sw albuquerque, nm 87102

505 - 842 - 1278 fax 505 - 766 - 9269

SOME, BUT NOT ALL, MECHANICAL AND ELECTRICAL ITEMS ARE SHOWN ON THESE SHEETS. SEE MECHANICAL AND ELECTRICAL DRAWINGS FOR additional information.

THE CONTRACTOR IS RESPONSIBLE FOR THE STABILITY OF ALL WALLS. PARTITIONS, FLOORS, CEILINGS AND OTHER STRUCTURES AND FEATURES DURING DEMOLITION AND CONSTRUCTION. THE CONTRACTOR IS RESPONSIBLE FOR TEMPORARY SHORING, NOT SHOWN, TO PROVIDE SUPPORT PRIOR TO INSTALLATION OF PERMANENT STRUCTURAL OR SUPPORT ELEMENTS.

MOVE ELECTRICAL CONDUIT OUTLETS, LIGHTS, ETC. AS REQUIRED FOR NEW OPENINGS. ALL NEW CONDUIT, WIRING, ETC. IS TO BE HIDDEN, UNLESS NOTED OTHERWISE.

8. IN AREAS WHERE SUSPENDED CEILING SYSTEMS ARE OPENED FOR WORK UNDER THIS CONTRACT, INSTALL CODE COMPLYING SEISMIC TIES BETWEEN THE CEILING GRID SYSTEM AND THE STRUCTURE ABOVE. INSTALL CODE COMPLYING SAFETY WIRES BETWEEN ALL FOUR CORNERS OF LIGHT FIXTURES AND THE STRUCTURE ABOVE.

AT WALLS WITH CLOSED OR NEW OPENINGS, REFINISH THE GYPSUM BOARD AROUND THE NEW OR CLOSED OPENING. TEXTURE TO MATCH EXISTING AND PAINT THE FULL LENGTH OF THE WALL TO THE NEXT PERPENDICULAR WALL ON EACH END. AFTER THE REPAIRS HAVE BEEN COMPLETED, NO VISIBLE REPAIRS SHALL REMAIN.

10. THE DEMOLITION AND CONSTRUCTION WORK AT THE LIBRARY IS TO BE DONE IN SUCH A WAY THAT THE BOOK SORTING ROOM RETAINS ITS FUNCTION FOR THE MAXIMUM AMOUNT OF TIME. WHEN THIS ROOM IS NOT FUNCTIONING. THE LIBRARY WILL BE CLOSED TO THE PUBLIC. AT ALL OTHER TIMES. THE LIBRARY WILL BE OPEN TO THE PUBLIC. AND DEMOLITION AND CONSTRUCTION AREAS ARE TO BE FENCED OFF FOR SAFETY. PROVIDE DUST CONTROL TO REMAINING AREAS OF THE

11. KEEP DIRT AND CONSTRUCTION DEBRIS FROM ENTERING DUCTS DURING DEMOLITION AND CONSTRUCTION.

12. DIMENSIONS REQUIRED FOR HANDICAPPED ACCESSIBILITY ARE CRITICAL. 13. WALL LOCATIONS MAY BE ADJUSTED BY THE CONTRACTOR TO MISS JOIST LOCATIONS AT PLUMBING. NOTIFY ARCHITECT BEFORE MAKING

ANY CHANGE. 14. SEE SPECIFICATIONS FOR EQUIPMENT SCHEDULE.

15. OWNER TO INSTALL NEW COMPUTER TABLES AND CHAIRS IN PROVIDED CONFIGURATION, UNLESS NOTED OTHERWISE. NEW TABLES AND CHAIRS TO MATCH EXISTING.

16. WHERE SHELVING CASEWORK, ETC. HAS BEEN REMOVED, PATCH, RETEXTURE AND REPAINT THE FULL WIDTH OF THE WALL.

17. AT THE NORTH LOADING DOCK, REMOVE EXISTING CONCRETE AND POUT NEW 6" CONCRETE SLAB, BROOM FINISH. 18. AT NEW DOOR OPENINGS, REPLACE FLOOR FINISHES TO MATCH THE

FLOOR COVERING ON EACH SIDE OF THE DOOR. TRANSITION MATERIAL CHANGES AT DOORS.

19. AT ALL NEW SLABS, COMPACT GRADE TO 95% MODIFIED PROCTOR.

WALL TYPES

W-1 4" 25 GAGE STUDS @ 16" OC WITH ₹" TYPE 'X' GYP BD ON BOTH SIDES RUNNING FROM THE FLOOR TO THE ROOF DECK

LEGI	END
EXISTING WALL TO	
	RECORD SET OF DRAWING
NEW WALL	This set of drawings is provided by the C

NEW WALL	This set of drawings is provided by the
NEW WINDOW	tractor as a schematic of the project in The Architect has not verified these con and is not responsible for conclusions therefrom.
	CHERRY/SEE/REAMES ARCHITECTS 4/13/20

<u> </u>					merenom.	
	NEW	CARPET	то	MATCH	CHERRY/SEE/REAME EXISTING	S ARCHITECT
4 4	NEW	CONCRE	TE			
	4	w ¹	-			

Add new door and sidelight in the Entry Lobby to section off the Entry 200 space from the Vestibule 201 space which leads to the southern Meeting Room 202, for security purposes. (Entry Lobby space not shown on this plan. See G-101 for complete building plan). Provide new Tubelite 4500 door and sidelight system as shown in Attachments #1 & #3, on sheet RS-1. Per Phase 1, WO #1, PR #2

For added scope, refer to Partial Floor Plan and notes, Exhibit R, on sheet RS-2. Per Phase 1, Addendum #1


Pigeon Gray DE6214 - at door frame in the middle of Office 101R, and at door to the adjacent custodial closet. Black Bean DE6385 – at new restroom vestibule door frames and doors A101 (at Whisper DEW340 - Interior wall color at offices and restrooms / vestibules.

Per Phase 1, ASI #1

CITY OF ALBUQUERQUE ERNA FERGUSSON LIBRARY MODIFICATIONS

TLE: FLOOR PLAN	· .		
gn Review Committee	City Engineer Approval	gn Update	MO./DAY/YR.

MO./DAY/YR. 10 of 21 City Project No. Zone Map No. A101 G-18-Z 7168.03

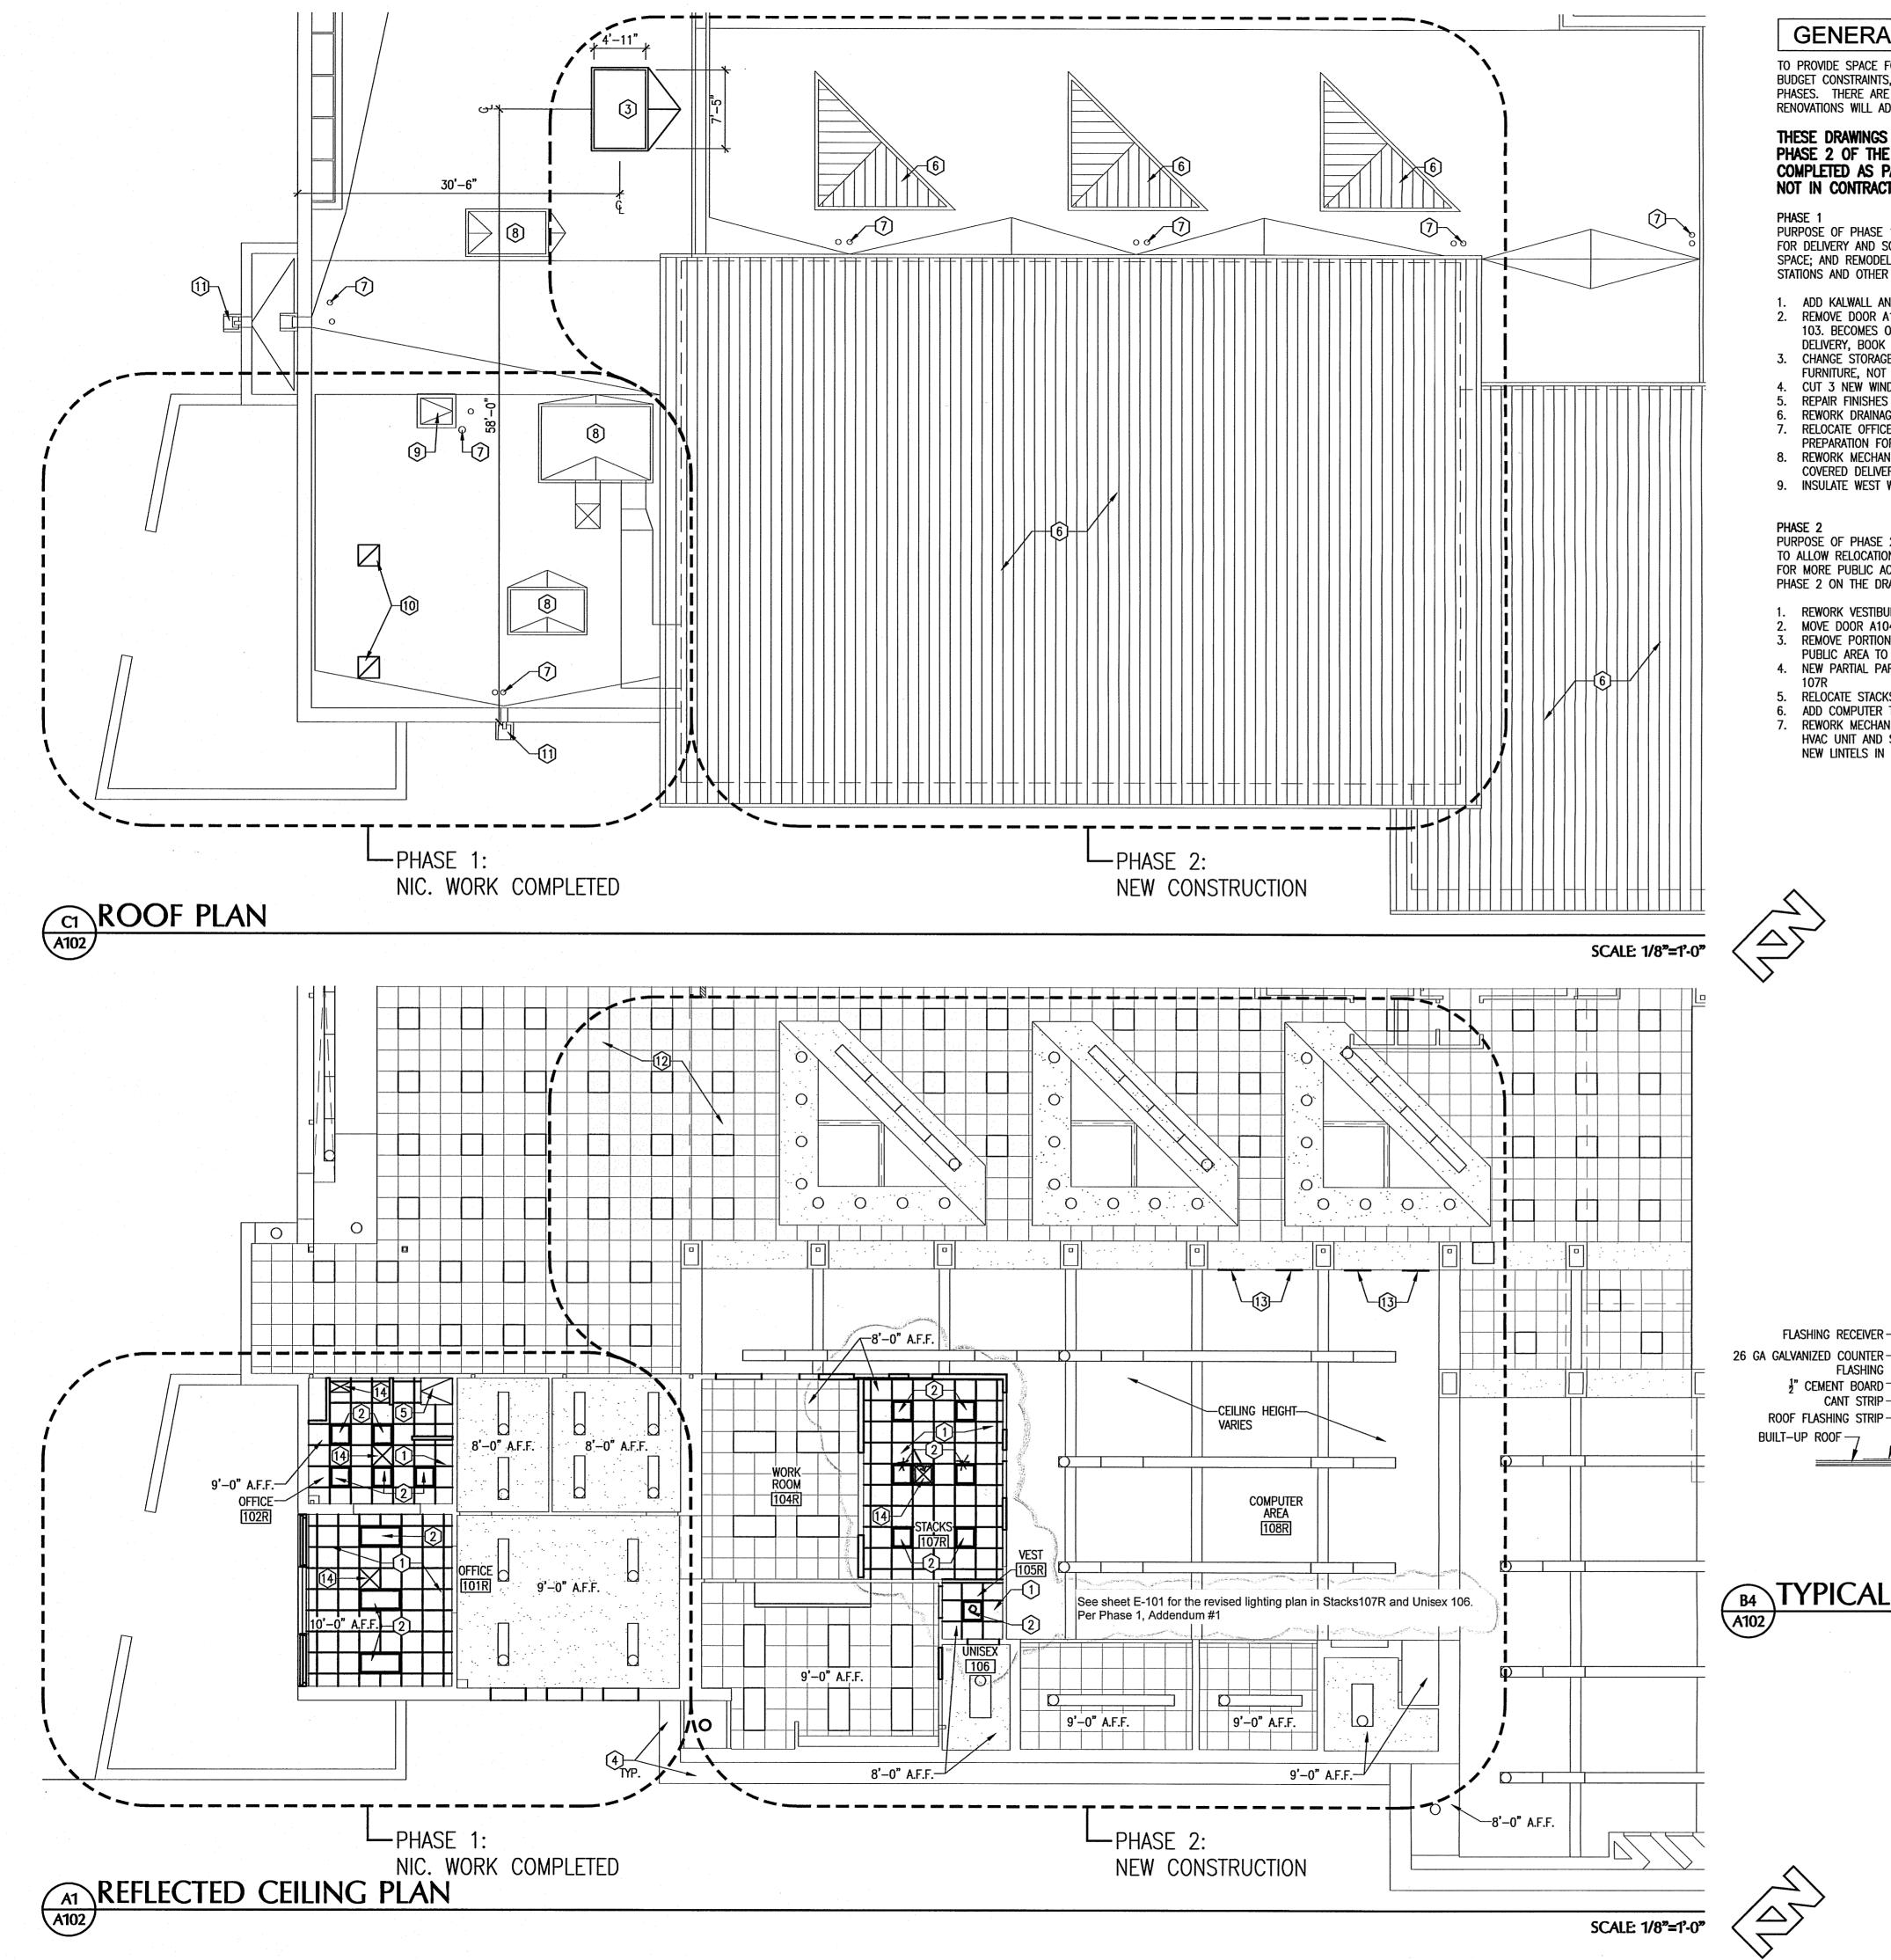

GENERAL PURPOSE OF PROJECT

TO PROVIDE SPACE FOR MORE PUBLIC ACCESS COMPUTER STATIONS. DUE TO BUDGET CONSTRAINTS, THIS PURPOSE IS TO BE ACCOMPLISHED IN TWO PHASES. THERE ARE CURRENTLY 16 PUBLIC ACCESS COMPUTERS. THESE RENOVATIONS WILL ADD ANOTHER 20 STATIONS FOR A TOTAL OF 36 STATIONS.

THESE DRAWINGS CONTAIN WORK FOR BOTH PHASE 1 AND PHASE 2 OF THE PROJECT. WORK FOR PHASE 2 TO BE COMPLETED AS PART OF THIS CONTRACT. PHASE 1 WORK IS NOT IN CONTRACT AND HAS ALREADY BEEN COMPLETED.

PHASE 1 PURPOSE OF PHASE 1: TO ENCLOSE EXISTING, EXTERIOR DELIVERY SPACE FOR DELIVERY AND SORTING; REMODEL EXISTING STORAGE ROOM INTO OFFICE SPACE; AND REMODEL EXISTING SORTING AREA INTO WORK SPACE AND WORK STATIONS AND OTHER WORK NOTED IN PHASE 1 ON THE DRAWINGS.

- ADD KALWALL AND RELOCATED DOOR TO COVERED DELIVERY TO ENCLOSE. REMOVE DOOR A103 BETWEEN COVERED DELIVERY 101 AND DELIVERY 103. BECOMES OFFICE 101R AND OFFICE 103R. TO BE USED FOR DELIVERY, BOOK SORTING AND OTHER WORK ROOM TASKS.
- 3. CHANGE STORAGE 102 TO OFFICE 102R WITH 2 WORK STATIONS. USE FURNITURE, NOT BUILT-IN CASEWORK.
- 4. CUT 3 NEW WINDOWS IN OFFICE 103R. NEW TOP FOR CASEWORK. REPAIR FINISHES AND PAINT
- 6. REWORK DRAINAGE OF SERVICE YARD RELOCATE OFFICE FUNCTIONS INTO OFFICE 102R AND OFFICE 103R IN
- PREPARATION FOR PHASE II. 8. REWORK MECHANICAL AND ELECTRICAL SERVICE AS REQUIRED. EXISTING
- COVERED DELIVERY 101 WILL BECOME AN ENCLOSED SPACE.
- 9. INSULATE WEST WALL OF ROOM 101R.

PHASE 2 PURPOSE OF PHASE 2: TO RELOCATE OFFICE FUNCTIONS OUT OF OFFICE 107 TO ALLOW RELOCATION OF STACKS INTO THAT AREA WHICH FREES UP SPACE FOR MORE PUBLIC ACCESS COMPUTER STATIONS AND OTHER WORK NOTED IN PHASE 2 ON THE DRAWINGS.

- REWORK VESTIBULE ENTRY TO RESTROOM
- MOVE DOOR A104 NORTH

FLASHING RECEIVER -

3" CEMENT BOARD

FLASHING

CANT STRIP-


- REMOVE PORTIONS OF LOAD-BEARING WALL BETWEEN STACKS 107R AND PUBLIC AREA TO ALLOW ENTRY TO STACKS 107R.
- 4. NEW PARTIAL PARTITION TO CLOSE OFF WORK ROOM 104R FROM STACKS
- 5. RELOCATE STACKS FROM PUBLIC AREA INTO STACKS 107R.
- 6. ADD COMPUTER TABLES, SEATS, AND COMPUTERS
- REWORK MECHANICAL AND ELECTRICAL SERVICE AS REQUIRED. A NEW HVAC UNIT AND SUPPLY WILL BE ADDED. STRUCTURAL IS REQUIRED FOR NEW LINTELS IN LOAD-BEARING WALL.


GENERAL SHEET NOTES

- REFER TO SHEET A001 FOR GENERAL ARCHITECTURAL INFORMATION.
- 2. SEE ELECTRICAL FOR FIXTURE TYPES. 3. SEE MECHANICAL FOR MECHANICAL EQUIPMENT.
- 4. CONNECTIONS TO STRUCTURE SHALL BE ADEQUATE FOR THE IMPOSED
- 5. DO NOT CUT ANY JOISTS FOR NEW ROOF UNIT. COORDINATE OPENINGS WITH EXISTING JOISTS. ADD 4" X 4" X 3/8" STEEL ANGLE FRAME FOR NEW UNITS AND OPENINGS. WELD TO EXISTING JOISTS.
- 6. CUT AND REPAIR ROOFING AS NEEDED FOR NEW MECHANICAL PENETRATIONS.

KEYED NOTES

- INSTALL NEW 2' X 2' SUSPENDED GRID LAY-IN CEILING. CEILING TILES TO MATCH EXISTING: VERIFY THE EXISTING TILE IS ARMSTRONG OPTIMA OPEN PLAN 2'X2'X1". MATCH SAMPLES WITH EXISTING TILE FOR COLOR AND TEXTURE. COORDINATE WITH MECHANICAL AND ELECTRICAL PLANS. LAYOUT FOR GRID AND LIGHTS TO BE CENTERED IN ROOM, AS SHOWN. NEW LAY-IN FIXTURE. SEE ELECTRICAL.
- 3. NEW ROOF TOP HVAC UNIT. REFER TO DETAIL B4/SHEET A102. SEE MECHANICAL. SEE STRUCTURAL FOR SUPPORT DETAILS.
- EXISTING ROOF OVERHANG.
- EXISTING ROOF LADDER AND HATCH TO REMAIN. EXISTING STANDING SEAM METAL ROOF SYSTEM.
- EXISTING ROOF AND OVERFLOW DRAIN.
- EXISTING ROOFTOP MECHANICAL UNIT.
- EXISTING ROOF HATCH.
- 10. NEW ROOF TOP EXHAUST HOOD. REFER TO DETAIL B4/SHEET A102. SEE MECHANICAL.
- 11. EXISTING ROOF DRAIN, SCUPPER AND SPLASH BLOCK. 12. IN SPECIFIED AREA. CAREFULLY REMOVE CEILING TILES AND GRID AS
- NECESSARY TO RUN NEW MECHANICAL DUCTS AND STRUCTURE FOR NEW MECHANICAL UNIT. REFER TO MECHANICAL AND STRUCTURAL. CEILING GRID AND TILES TO BE REPLACED AFTER MECHANICAL DUCTS HAVE BEEN INSTALLED. IT IS THE CONTRACTOR'S RESPONSIBILITY TO REPLACE ALL TILES DURING THE REMOVAL AND REINSTALLATION PROCESSES. REPLACE ANY DAMAGED TILE OR GRID.
- 13. NEW SIDEWALL SUPPLY REGISTER. SEE MECHANICAL. CUT AND REPAIR
- WALL AS NECESSARY TO MATCH EXISTING. 14. NEW AIR REGISTER OR RETURN. SEE MECHANICAL.

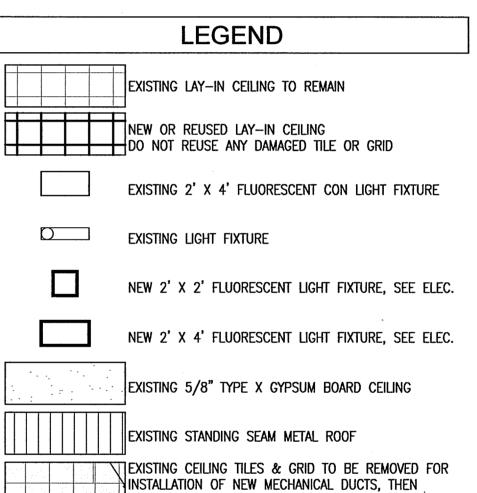

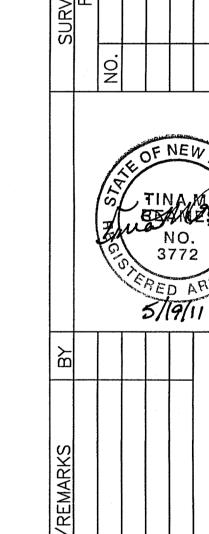

CHERRY/SEE/REAMES

ARCHITECTS, LLP

220 gold avenue sw albuquerque, nm 87102

505 - 842 - 1278 fax 505 - 766 - 9269



SEE MECHANICAL FOR EQUIPMENT AND DUCT

2X_ FIRE TREATED WOOD,

CUT TO FIT AS NECESSARY

1-1/2" INSULATION OR FILL VOID

WITH BATT INSULATION WITH FOIL

PRE-FAB CURB OR LIGHT GA

INFORMATION

VAPOR BARRIER


METAL FRAMING


RECORD SET OF DRAWINGS This set of drawings is provided by the Contractor as a schematic of the project in place. The Architect has not verified these conditions and is not responsible for conclusions drawn

CHERRY/SEE/REAMES ARCHITECTS 4/13/2012


ERNA FERGUSSON LIBRARY MODIFICATIONS					
TLE: REFLECTED CE ROOF PLAN	ILING F	PLAN &			
ign Review Committee	City	Engineer Approval	Last Design Update	MO./DAY/YR.	MO./DAY/YR.
Project No. 7168.03		Zone Map No. G-18-Z	Sheet A102	2	11 of 21

CITY OF ALBUQUERQUE

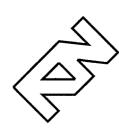

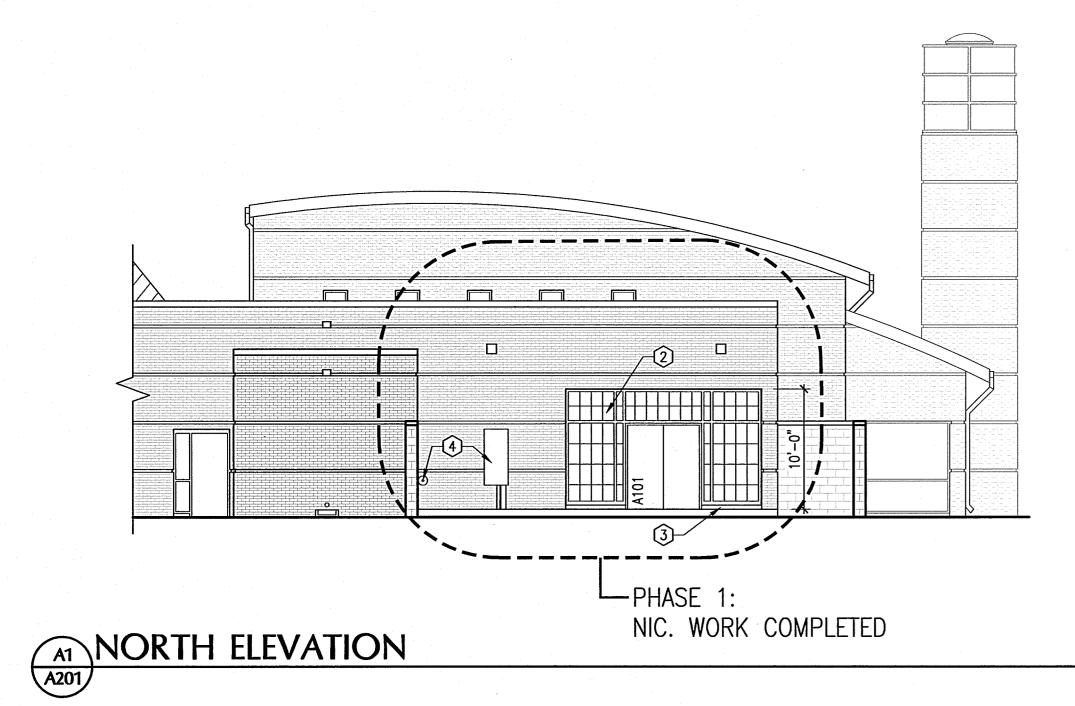

SCALE: 1/8" = 1'-0"

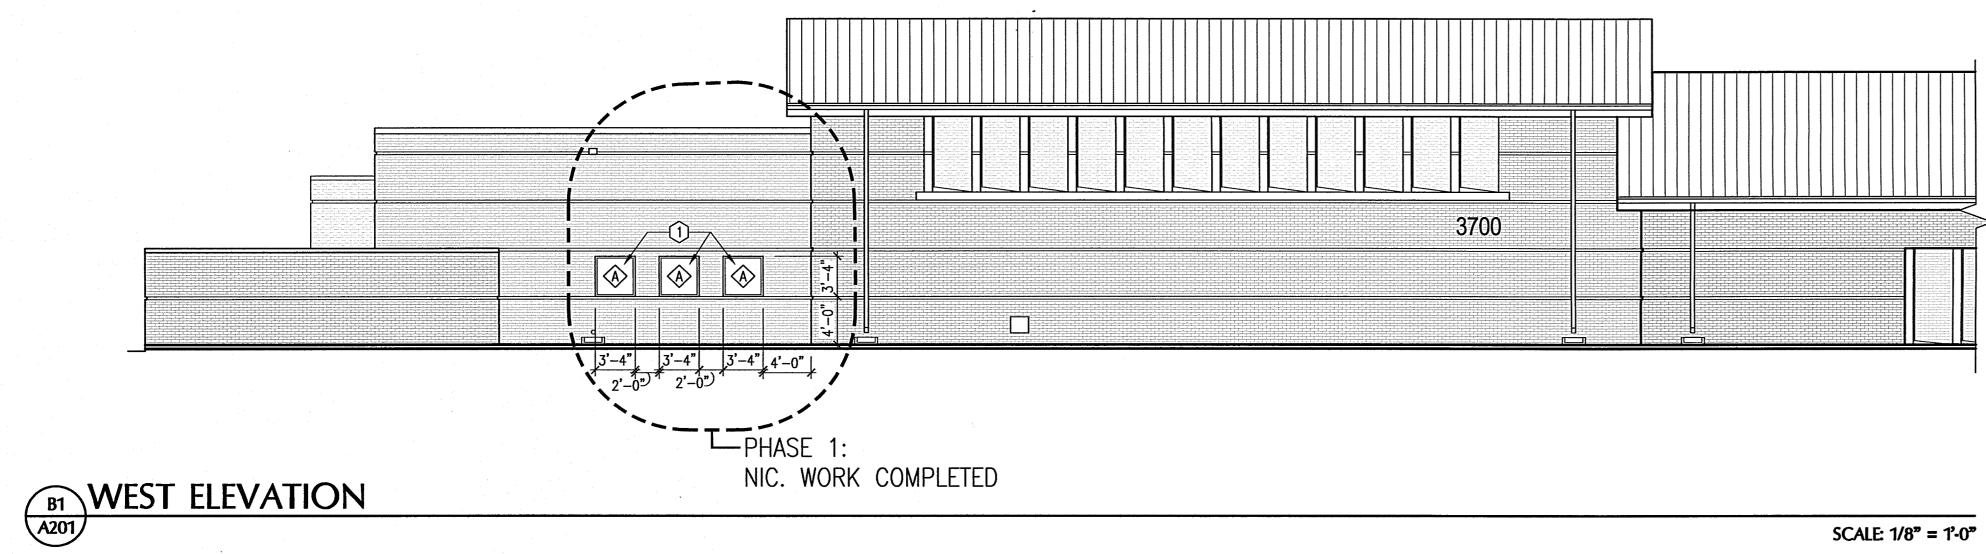

SCALE: 1/8" = 1'-0"


GENERAL SHEET NOTES

1. REFER TO SHEET A001 FOR GENERAL ARCHITECTURAL INFORMATION.

KEYED NOTES

- 3 NEW WINDOWS. CAREFULLY CUT BRICK AND REMOVE. REPLACE ANY DAMAGED BRICK ADJACENT TO THE WINDOWS. SEE STRUCTURAL FOR WALL
- CUTS FOR THE WINDOWS.


 2. NEW KALWALL AT EXISTING OPENING WITH NEW DOORS AND FRAME.
- NEW CONCRETE GRADE BEAM. SEE STRUCTURAL. 4. EXISTING GAS LINES AND ELECTRICAL PANEL.

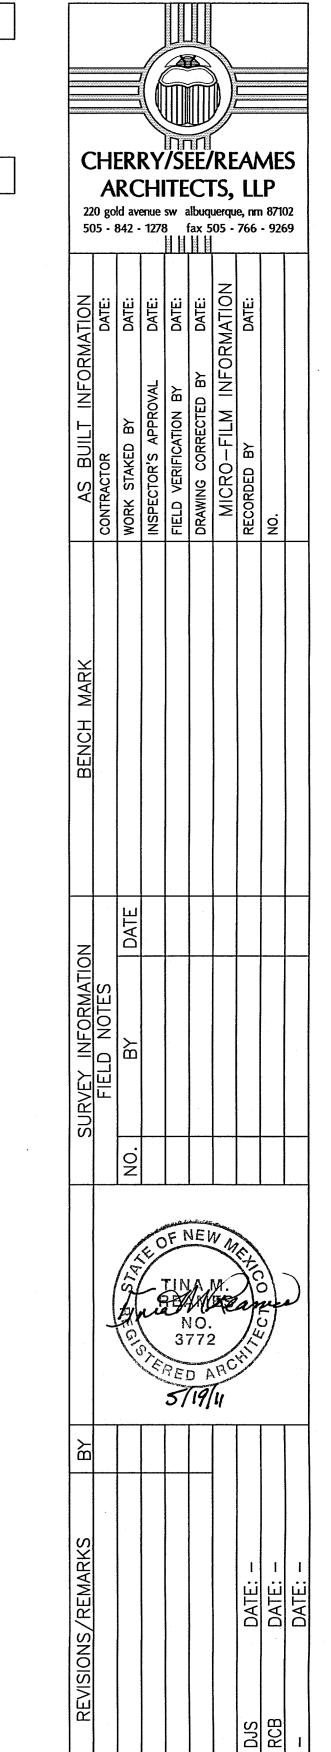


RECORD SET OF DRAWINGS

This set of drawings is provided by the Contractor as a schematic of the project in place. The Architect has not verified these conditions and is not responsible for conclusions drawn therefrom.


CITY OF ALBUQUERQUE ERNA FERGUSSON LIBRARY MODIFICATIONS TITLE: EXTERIOR ELEVATIONS City Engineer Approval Design Review Committee Zone Map No. G-18-Z Sheet A201 12 of 21 City Project No. 7168.03

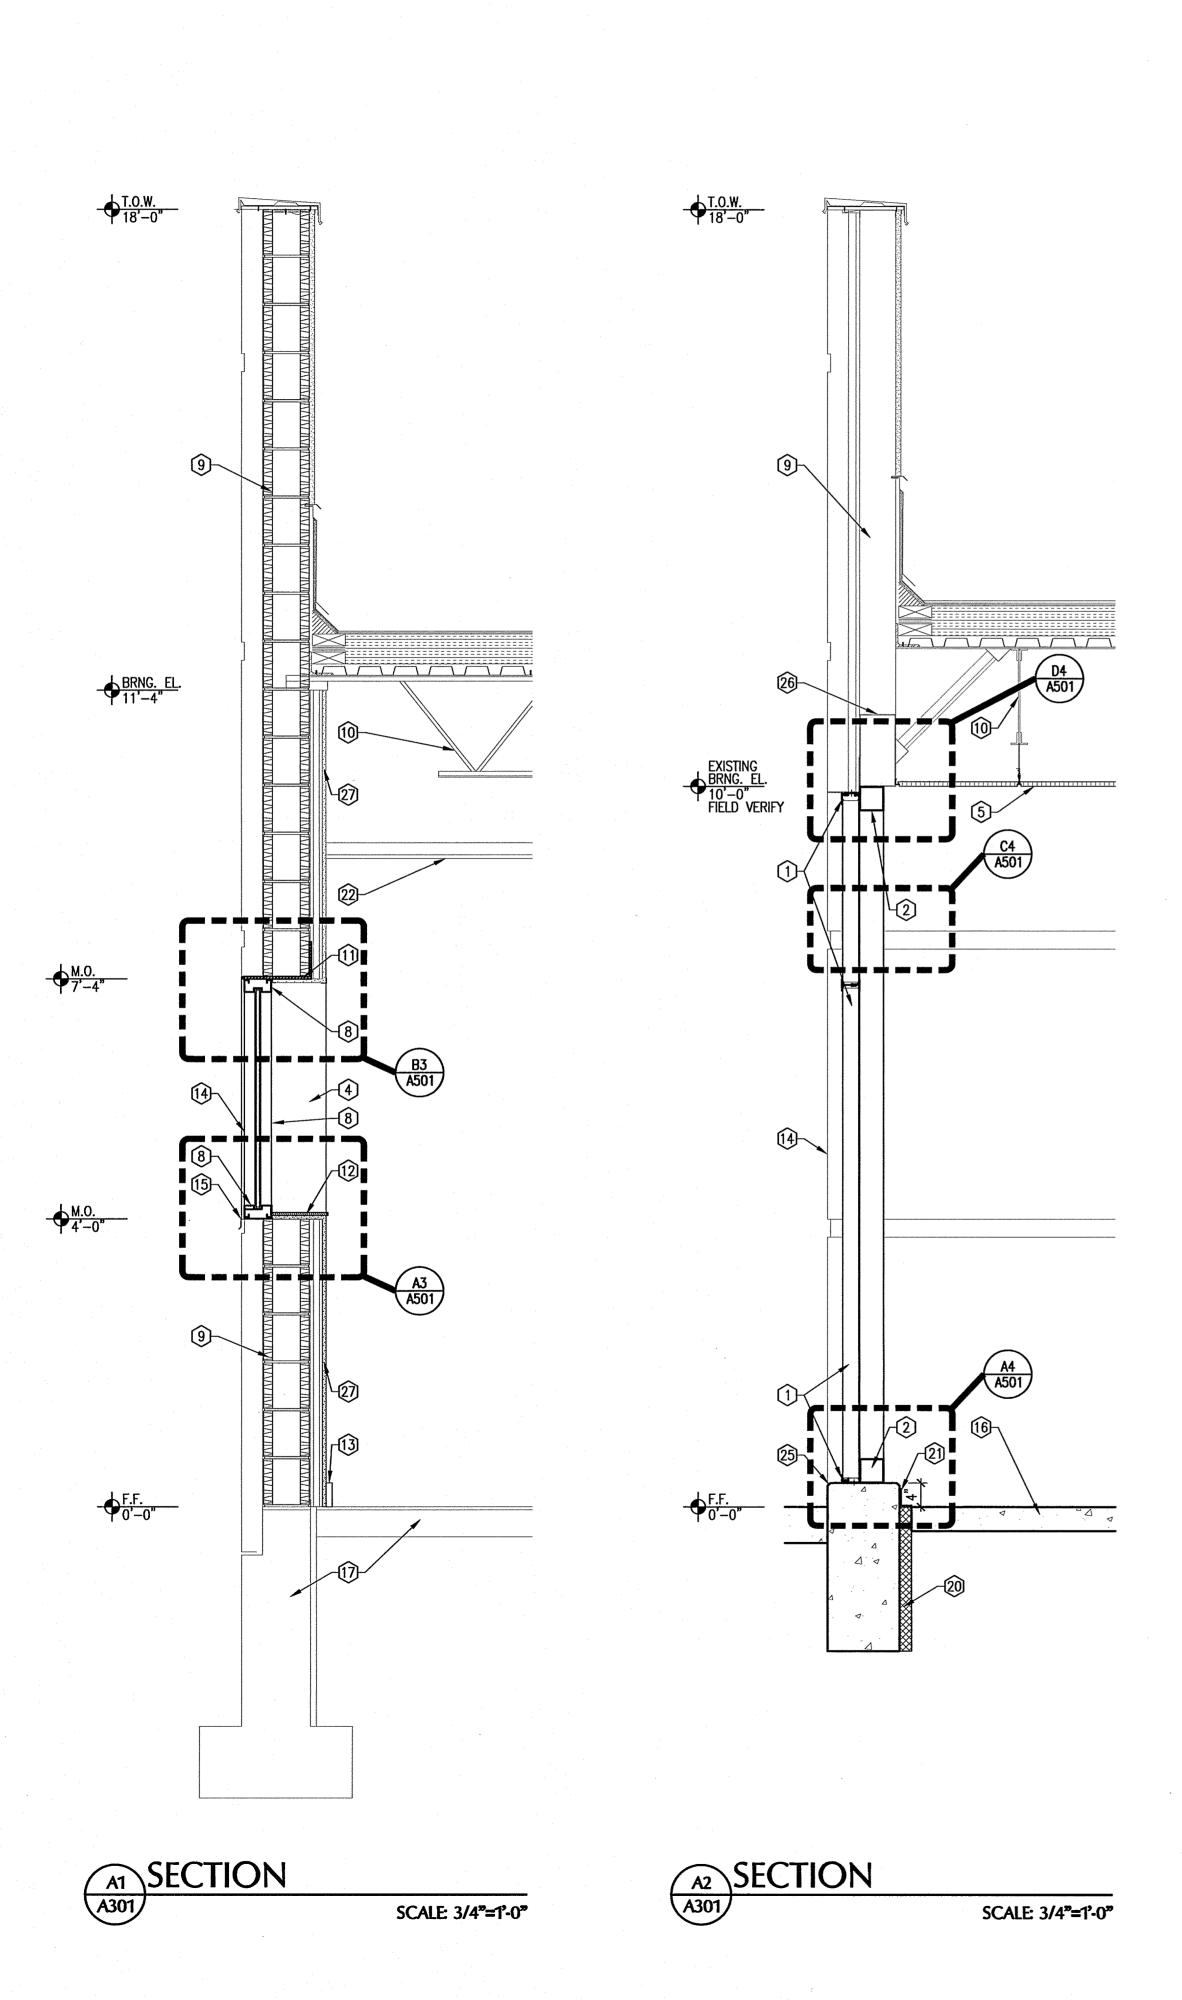

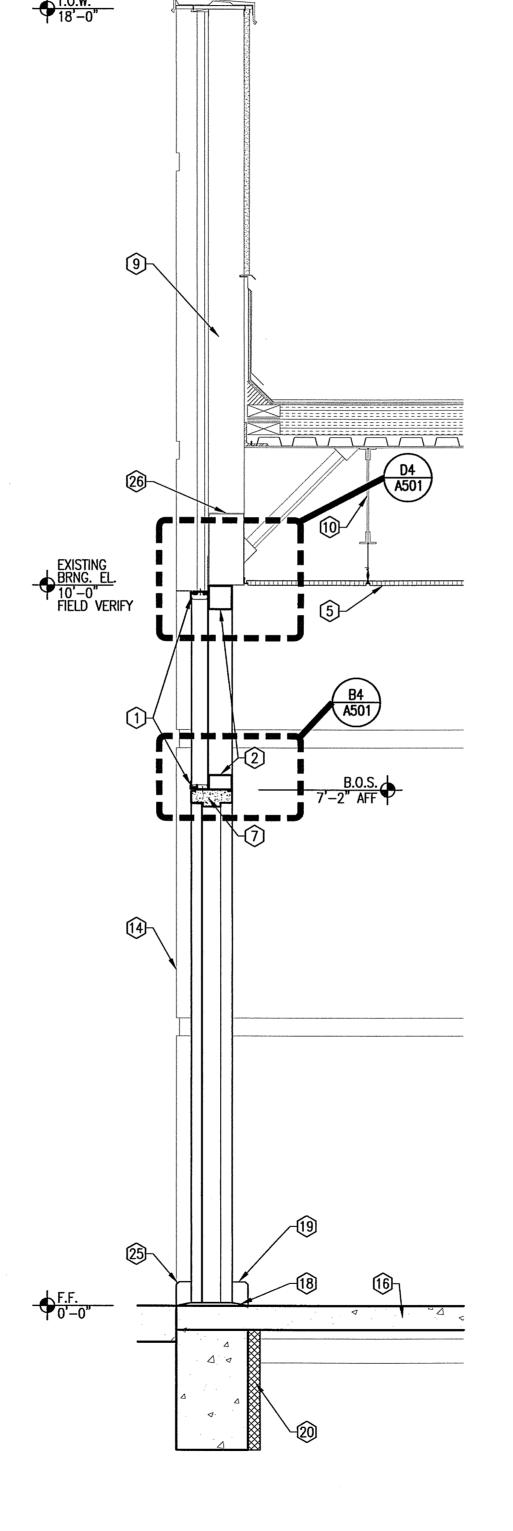

A3 SECTION

SCALE: 3/4"=1'-0"

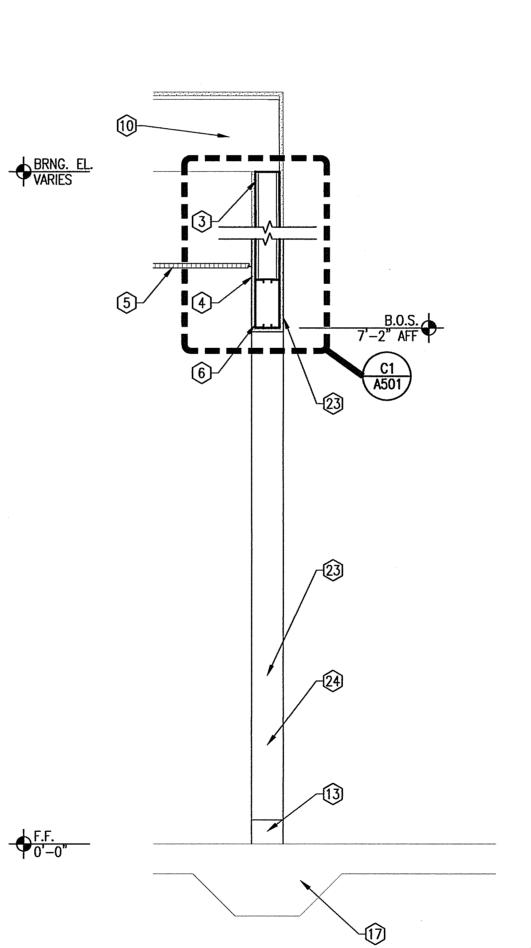

RECORD SET OF DRAWINGS This set of drawings is provided by the Contractor as a schematic of the project in place. The Architect has not verified these conditions and is not responsible for conclusions drawn

CHERRY/SEE/REAMES ARCHITECTS 4/13/2012

SECTION

SCALE: 3/4"=1'-0"

GENERAL SHEET NOTES

- 1. REFER TO SHEET A001 FOR GENERAL ARCHITECTURAL INFORMATION.
- 2. SUPPORT ABOVE STRUCTURAL WHEN CUTTING NEW OPENINGS IN GYPSUM 3. PROVIDE BOND BREAK BETWEEN DISSIMILAR METALS AT ALL LOCATIONS,

KEYED NOTES

- 1. 2-3/4" KALWALL 100 WALL SYSTEM WITH A DARK BRONZE INSULATED FRAME OR PRIOR APPROVED EQUAL. KALWALL PANELS TO BE WHITE WHITE WITH A U-VALUE OF .23 AND A LIGHT TRANSMITTANCE OF 15%. 2. STEEL TUBE FRAME. SEE STRUCTURAL.
- 3. EXISTING STUDS. WELD ALL JOINTS SOLID AND GRIND SMOOTH. PAINT. 4. 5/8" GYPSUM BOARD.
- 5. 2 X 2 LAY-IN CEILING.

UNLESS NOTED OTHERWISE.

- 6. 2 NEW 8" X 16 GAGE HEADERS AND RUNNER TRACK. 7. HM DOOR FRAME, GROUT SOLID.
- 8. INSULATED ALUMINUM WINDOW FRAME. MATCH COLOR OF EXISTING. SEE DETAILS, SHEET A501.
- EXISTING WALL.
- 10. EXISTING STRUCTURE
- 11. AT HEAD OF WINDOW, SAW A 3/8" CUT AT THE BRICK JOINT THROUGH THE BRICK AND CMU THE WIDTH OF THE WINDOW PLUS 4" ON BACK SIDE. INSERT A GALVANIZED 3/8" X 11-1/2" X WINDOW WIDTH + 8" INTO THE OPENING UNTIL THE PLATE EXTENDS 3/8" PAST THE CMU. CUT BACK THE 5/8" GYP BOARD AND FURRING AND INSULATION SO THAT A 3/8" X 8" X WIDTH OF WINDOW + 8" PLATE CAN BE PLACED FLAT ON THE END AND WELDED THE FULL LENGTH OF THE TWO PLATES. AT THAT TIME, SAW OUT THE JAMBS AND SILL OF THE WINDOW OPENING AND REMOVE THE BRICK AND CMU. PLACE THE NEW ALUMINUM FRAME IN THE OPENING. SEE STRUCTURAL.
- 12. QUARTZ SURFACING SILL.
- 13. 4" VINYL BASE.
- 14. LINE OF EXISTING BRICK BEYOND.
- 15. 24-GA. ALUMINUM FLASHING OVER SILL. 16. NEW CONCRETE SLAB. SEE STRUCTURAL.
- 17. EXISTING SLAB AND FOUNDATION.
- THRESHOLD. CURB BEYOND.
- 20. 2" RIGID INSULATION.
- 21. 3" X 2" X 1/4" STEEL ANGLE.
- 22. EXISTING CEILING.
- 23. REPAIR GYP BOARD AS REQUIRED. 24. PROVIDE 2 NEW 18 GAGE STUDS AT EACH END OF THE NEW HEADER. MATCH
- WALL THICKNESS. 25. CHAMFER EDGES, TYPICAL.
- 26. EXISTING STEEL TUBE. 27. EXISTING 5/8" GYPSUM BOARD ON Z-FURRING WITH RIGID INSULATION. PATCH AND REPAIR. REPAINT WALLS IN OFFICE 101R.

GENERAL PURPOSE OF PROJECT

TO PROVIDE SPACE FOR MORE PUBLIC ACCESS COMPUTER STATIONS. DUE TO BUDGET CONSTRAINTS, THIS PURPOSE IS TO BE ACCOMPLISHED IN TWO PHASES. THERE ARE CURRENTLY 16 PUBLIC ACCESS COMPUTERS. THESE RENOVATIONS WILL ADD ANOTHER 20 STATIONS FOR A TOTAL OF 36 STATIONS.

THESE DRAWINGS CONTAIN WORK FOR BOTH PHASE 1 AND PHASE 2 OF THE PROJECT. WORK FOR PHASE 2 TO BE COMPLETED AS PART OF THIS CONTRACT. PHASE 1 WORK IS NOT IN CONTRACT AND HAS ALREADY BEEN COMPLETED.

PHASE 1

PURPOSE OF PHASE 1: TO ENCLOSE EXISTING, EXTERIOR DELIVERY SPACE FOR DELIVERY AND SORTING; REMODEL EXISTING STORAGE ROOM INTO OFFICE SPACE; AND REMODEL EXISTING SORTING AREA INTO WORK SPACE AND WORK STATIONS AND OTHER WORK NOTED IN PHASE 1 ON THE DRAWINGS.

- ADD KALWALL AND RELOCATED DOOR TO COVERED DELIVERY TO ENCLOSE. REMOVE DOOR A103 BETWEEN COVERED DELIVERY 101 AND DELIVERY 103. BECOMES OFFICE 101R AND OFFICE 103R. TO BE USED FOR
- DELIVERY, BOOK SORTING AND OTHER WORK ROOM TASKS. 3. CHANGE STORAGE 102 TO OFFICE 102R WITH 2 WORK STATIONS. USE FURNITURE, NOT BUILT-IN CASEWORK.
- 4. CUT 3 NEW WINDOWS IN OFFICE 103R. NEW TOP FOR CASEWORK. REPAIR FINISHES AND PAINT
- 6. REWORK DRAINAGE OF SERVICE YARD 7. RELOCATE OFFICE FUNCTIONS INTO OFFICE 102R AND OFFICE 103R IN
- PREPARATION FOR PHASE II. 8. REWORK MECHANICAL AND ELECTRICAL SERVICE AS REQUIRED. EXISTING
- COVERED DELIVERY 101 WILL BECOME AN ENCLOSED SPACE.
- 9. INSULATE WEST WALL OF ROOM 101R.

PHASE 2

PURPOSE OF PHASE 2: TO RELOCATE OFFICE FUNCTIONS OUT OF OFFICE 107 TO ALLOW RELOCATION OF STACKS INTO THAT AREA WHICH FREES UP SPACE FOR MORE PUBLIC ACCESS COMPUTER STATIONS AND OTHER WORK NOTED IN PHASE 2 ON THE DRAWINGS.

- REWORK VESTIBULE ENTRY TO RESTROOM
- MOVE DOOR A104 NORTH 3. REMOVE PORTIONS OF LOAD-BEARING WALL BETWEEN STACKS 107R AND
- PUBLIC AREA TO ALLOW ENTRY TO STACKS 107R. 4. NEW PARTIAL PARTITION TO CLOSE OFF WORK ROOM 104R FROM STACKS
- 5. RELOCATE STACKS FROM PUBLIC AREA INTO STACKS 107R.
- 6. ADD COMPUTER TABLES, SEATS, AND COMPUTERS
- 7. REWORK MECHANICAL AND ELECTRICAL SERVICE AS REQUIRED. A NEW HVAC UNIT AND SUPPLY WILL BE ADDED. STRUCTURAL IS REQUIRED FOR NEW LINTELS IN LOAD-BEARING WALL.


ш						
REVISIONS/REMARKS				: DJS DATE: -	RCB DATE: -	– DATE: –
NO. DATE				DESIGNED BY: DJS	DRAWN BY:	CHECKED BY:
NO.				DESI	DRAV	CHE(


CHERRY/SEE/REAMES

ARCHITECTS, LLP


220 gold avenue sw albuquerque, nm 87102 505 - 842 - 1278 fax 505 - 766 - 9269

ERN	CITY OF ALBUQUEI NA FERGUSSON LIBRARY		
TITLE: WALL SECTIONS			
Design Review Committee	City Engineer Approval	Last Design Update	DAY/YR. MO./DAY/YR.
City Project No. 7168.03	Zone Map No. G-18-Z	Sheet A301	13 of 21

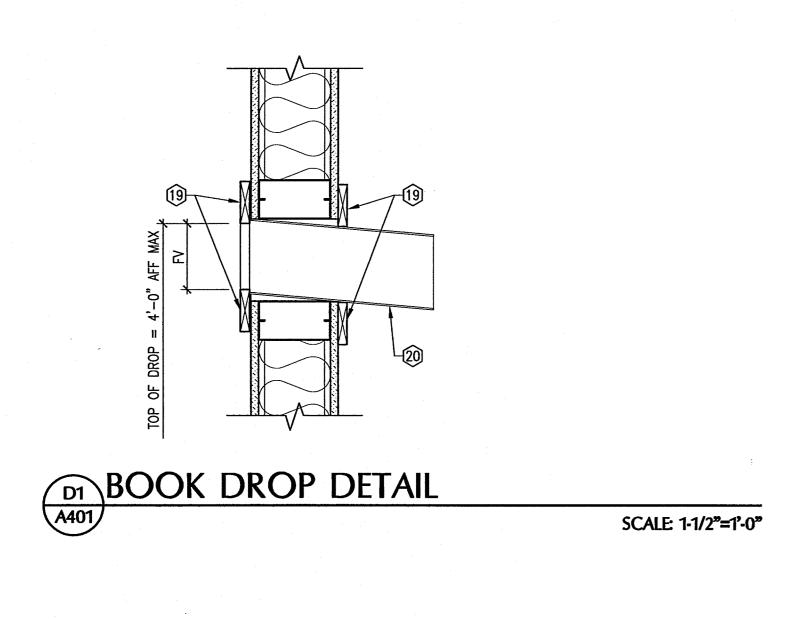

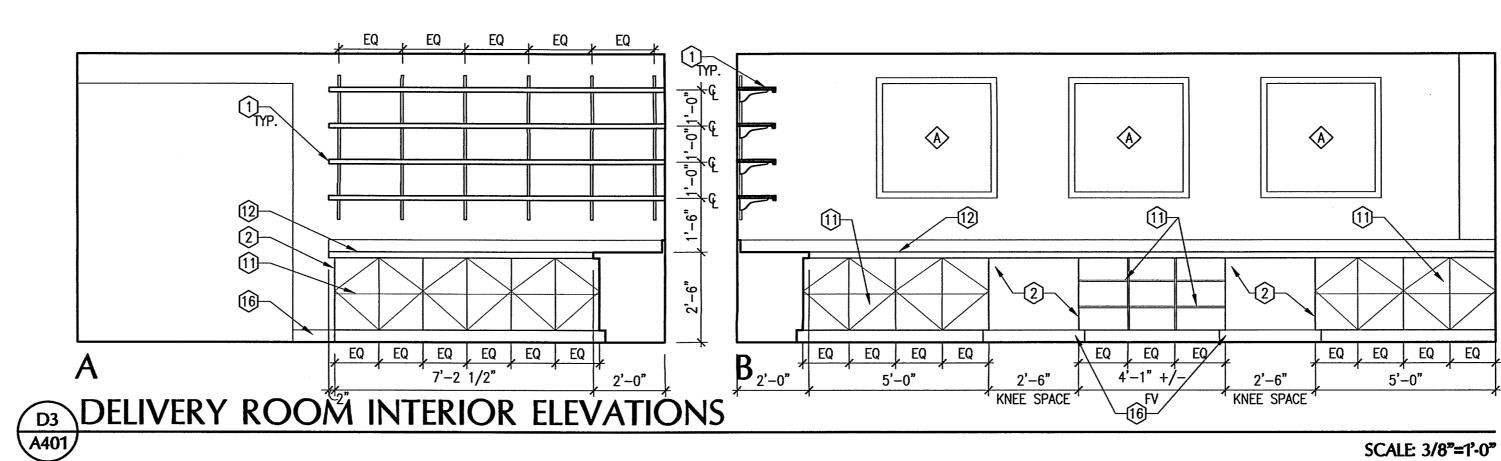



minimum programmer and the second control of the second control of

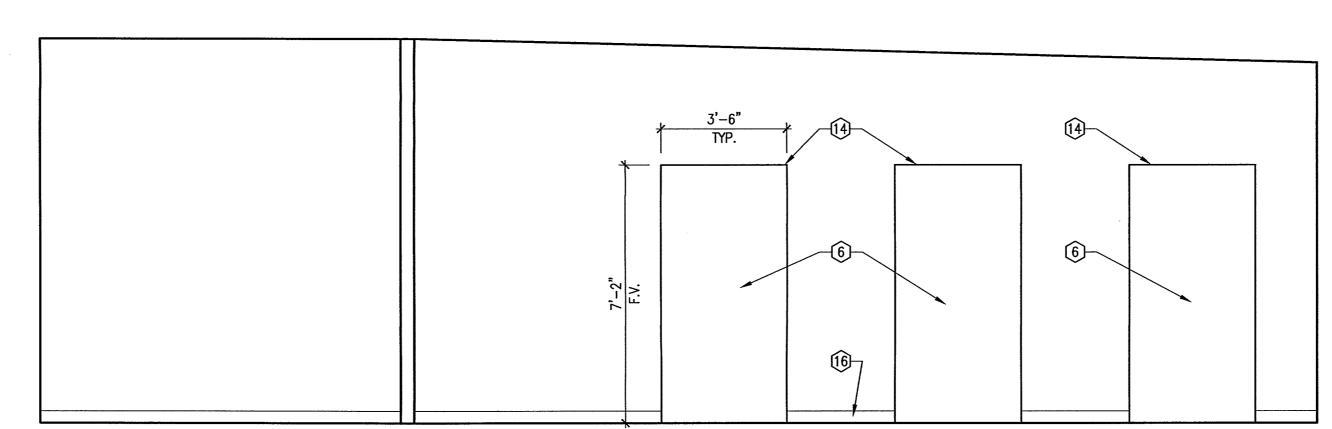

NEW STACKS AREA INTERIOR ELEVATION

A401

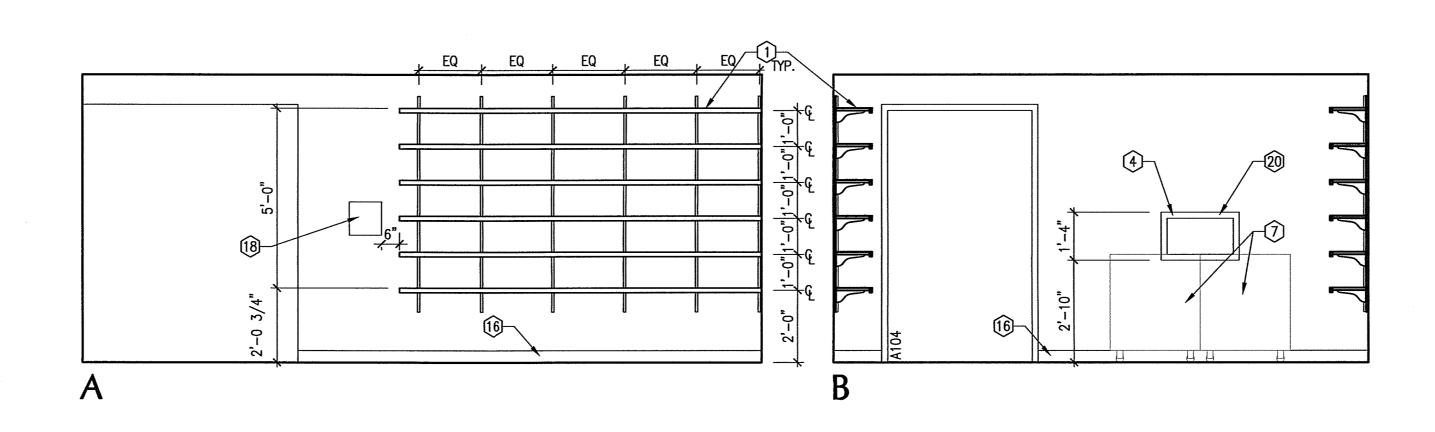

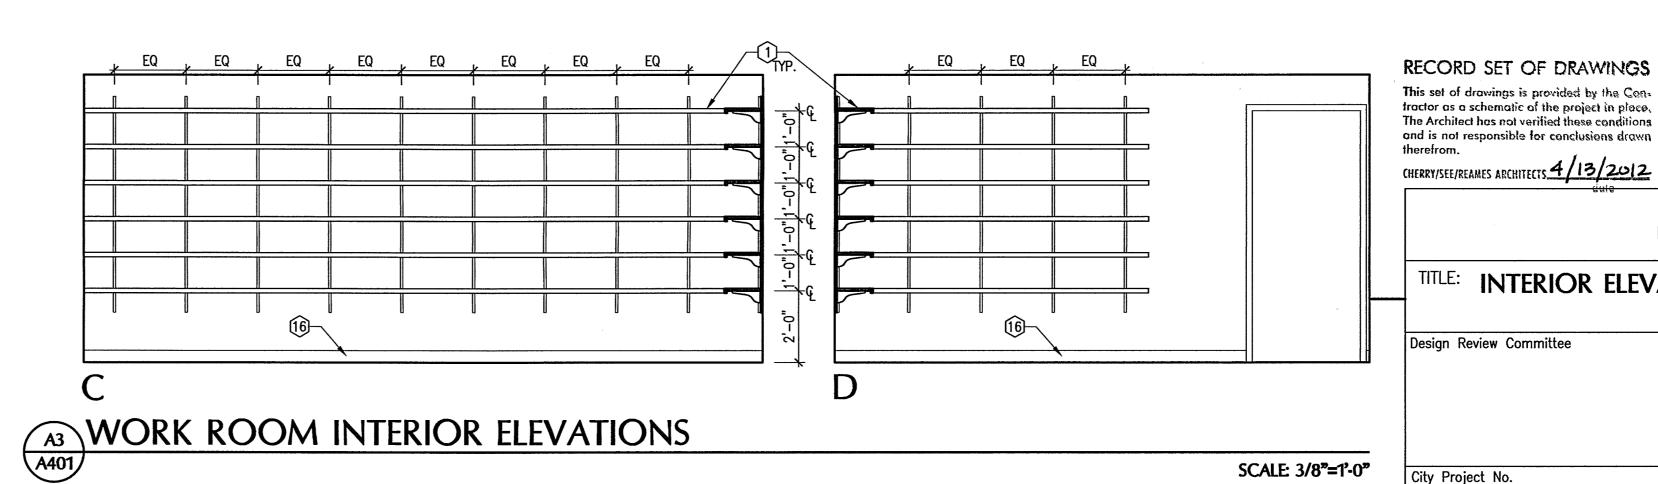


GENERAL SHEET NOTES

1. REFER TO SHEET A001 FOR GENERAL ARCHITECTURAL INFORMATION.

2. FIELD VERIFY ALL STEEL FRAME DIMENSIONS.

KEYED NOTES


- 1. 12 X 3/4" WHITE MELAMINE COVERED PARTICLE BOARD SHELVING WITH OAK NOSING ON HEAVY DUTY KV BRACKETS AND RAILS SCREWED AT EACH STUD. SEE C1/A401.
- FINISHED BACK AND ENDS, TYPICAL. 3/4" X 1-1/2" SELECT OAK NOSING.
- NEW CUT OPENING. REUSE EXISTING BOOK DROP. PROVIDE NEW OAK FRAME AROUND BOOK DROP, ON BOTH SIDES OF WALL.
- 2-3/4" KALWALL 100 WALL SYSTEM WITH A DARK BRONZE INSULATED FRAME OR PRIOR APPROVED EQUAL. KALWALL PANELS TO BE WHITE, WHITE, WITH A U-VALUE OF .23 AND A LIGHT TRANSMITTANCE OF 15%.
- OPEN TO STACKS 107R. EXISTING BOOK CART.
- 4" x 4" x 3/16" STEEL TUBE FRAME. WELD ALL JOINTS SOLID AND GRIND SMOOTH.
- HM DOOR FRAME. GROUT SOLID. 10. CONCRETE STEM WALL WITH 4 X 4 X 1/4" INSULATED WELD PLATE.
- 11. PLASTIC LAMINATE CASEWORK. PROVIDE ADJUSTABLE SHELVING WHERE
- 12. PLASTIC LAMINATE COUNTERTOP WITH 4" BACKSPLASH. 13. PROVIDE WOOD BLOCKING SCREWED TO CMU FOR BRACKETS ON THIS
- WALL, TYPICAL. 14. MATCH TOP OF EXISTING WINDOWS. FIELD VERIFY.
- 15. 2" X 4" X 3/16" STEEL TUBE FRAME. WELD ALL JOINTS SOLID AND
- 16. BASE. SEE ROOM FINISH SCHEDULE, SHEET A601. 17. PROVIDE CONTINUOUS SEALANT BETWEEN EDGE OF STEEL FRAME AND
- EXISTING WALL. 18. EXISTING WALL SAFE TO REMAIN.
- 19. 1X4 SELECT OAK TRIM AT BOOK DROP. OAK FINISH TO MATCH THAT OF EXISTING OAK BASE TRIM. MITER EDGES AT 45°.
- 20. EXISTING BOOK DROP, RELOCATED. SEE D1/A401.

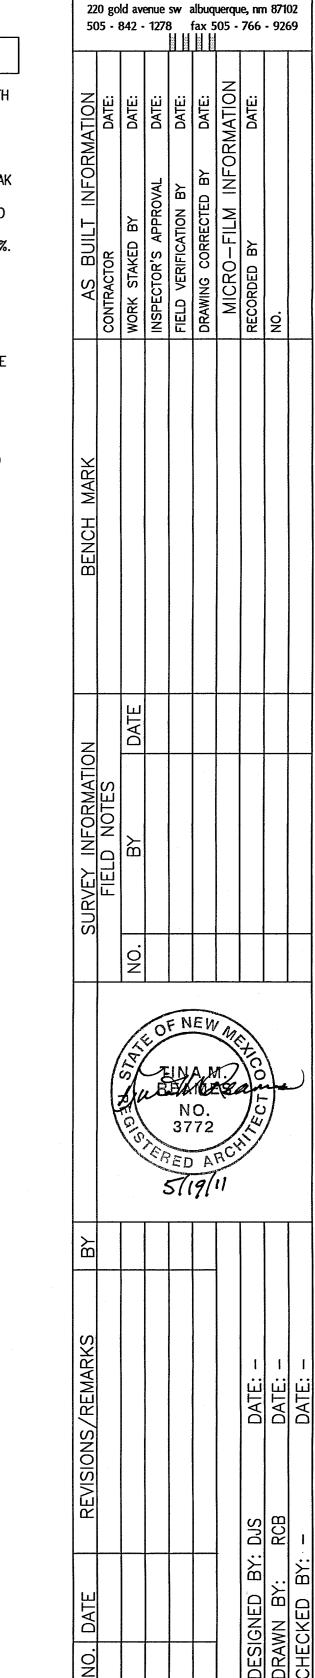

CHERRY/SEE/REAMES


ARCHITECTS, LLP

RRY/SEE/REAMES ARCHITECTS 4/13/2012			8					B	A N
ER	CITY OF ALBUQUER NA FERGUSSON LIBRARY I		CATION	IS					
TITLE: INTERIOR ELEVA	TIONS								
esign Review Committee	City Engineer Approval	ıst Design Update	M	D./DAY/	ΎR		МО.,	DAY/YF	

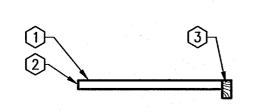


C1 TYPICAL SHELF

SCALE: 1-1/2"=1'-0"

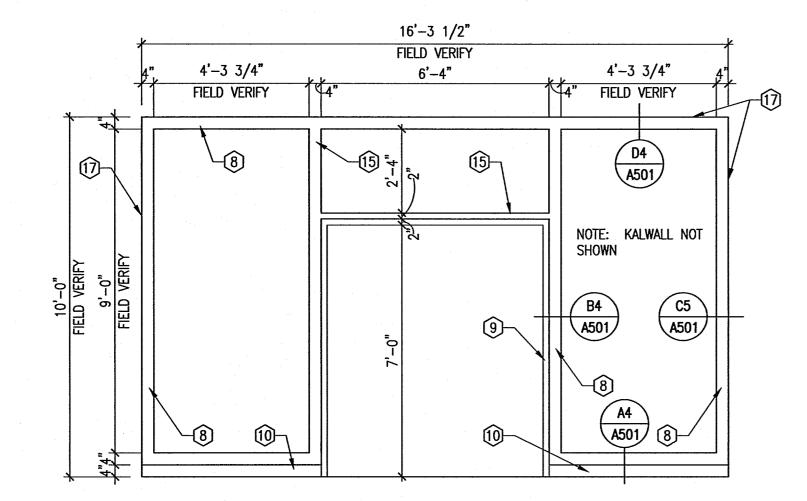

STORAGE AREA STEEL FRAME

SCALE: 3/8"=1'-0"

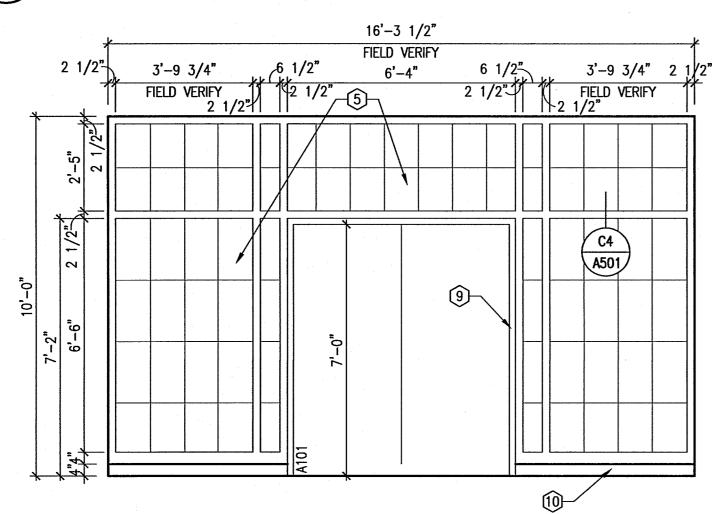

STORAGE AREA EXT. ELEVATION

SCALE: 3/8"=1'-0"


SCALE: 3/8"=1'-0"

City Project No.

7168.03

Sheet A401 Zone Map No. **G-18-Z**

14 of 21

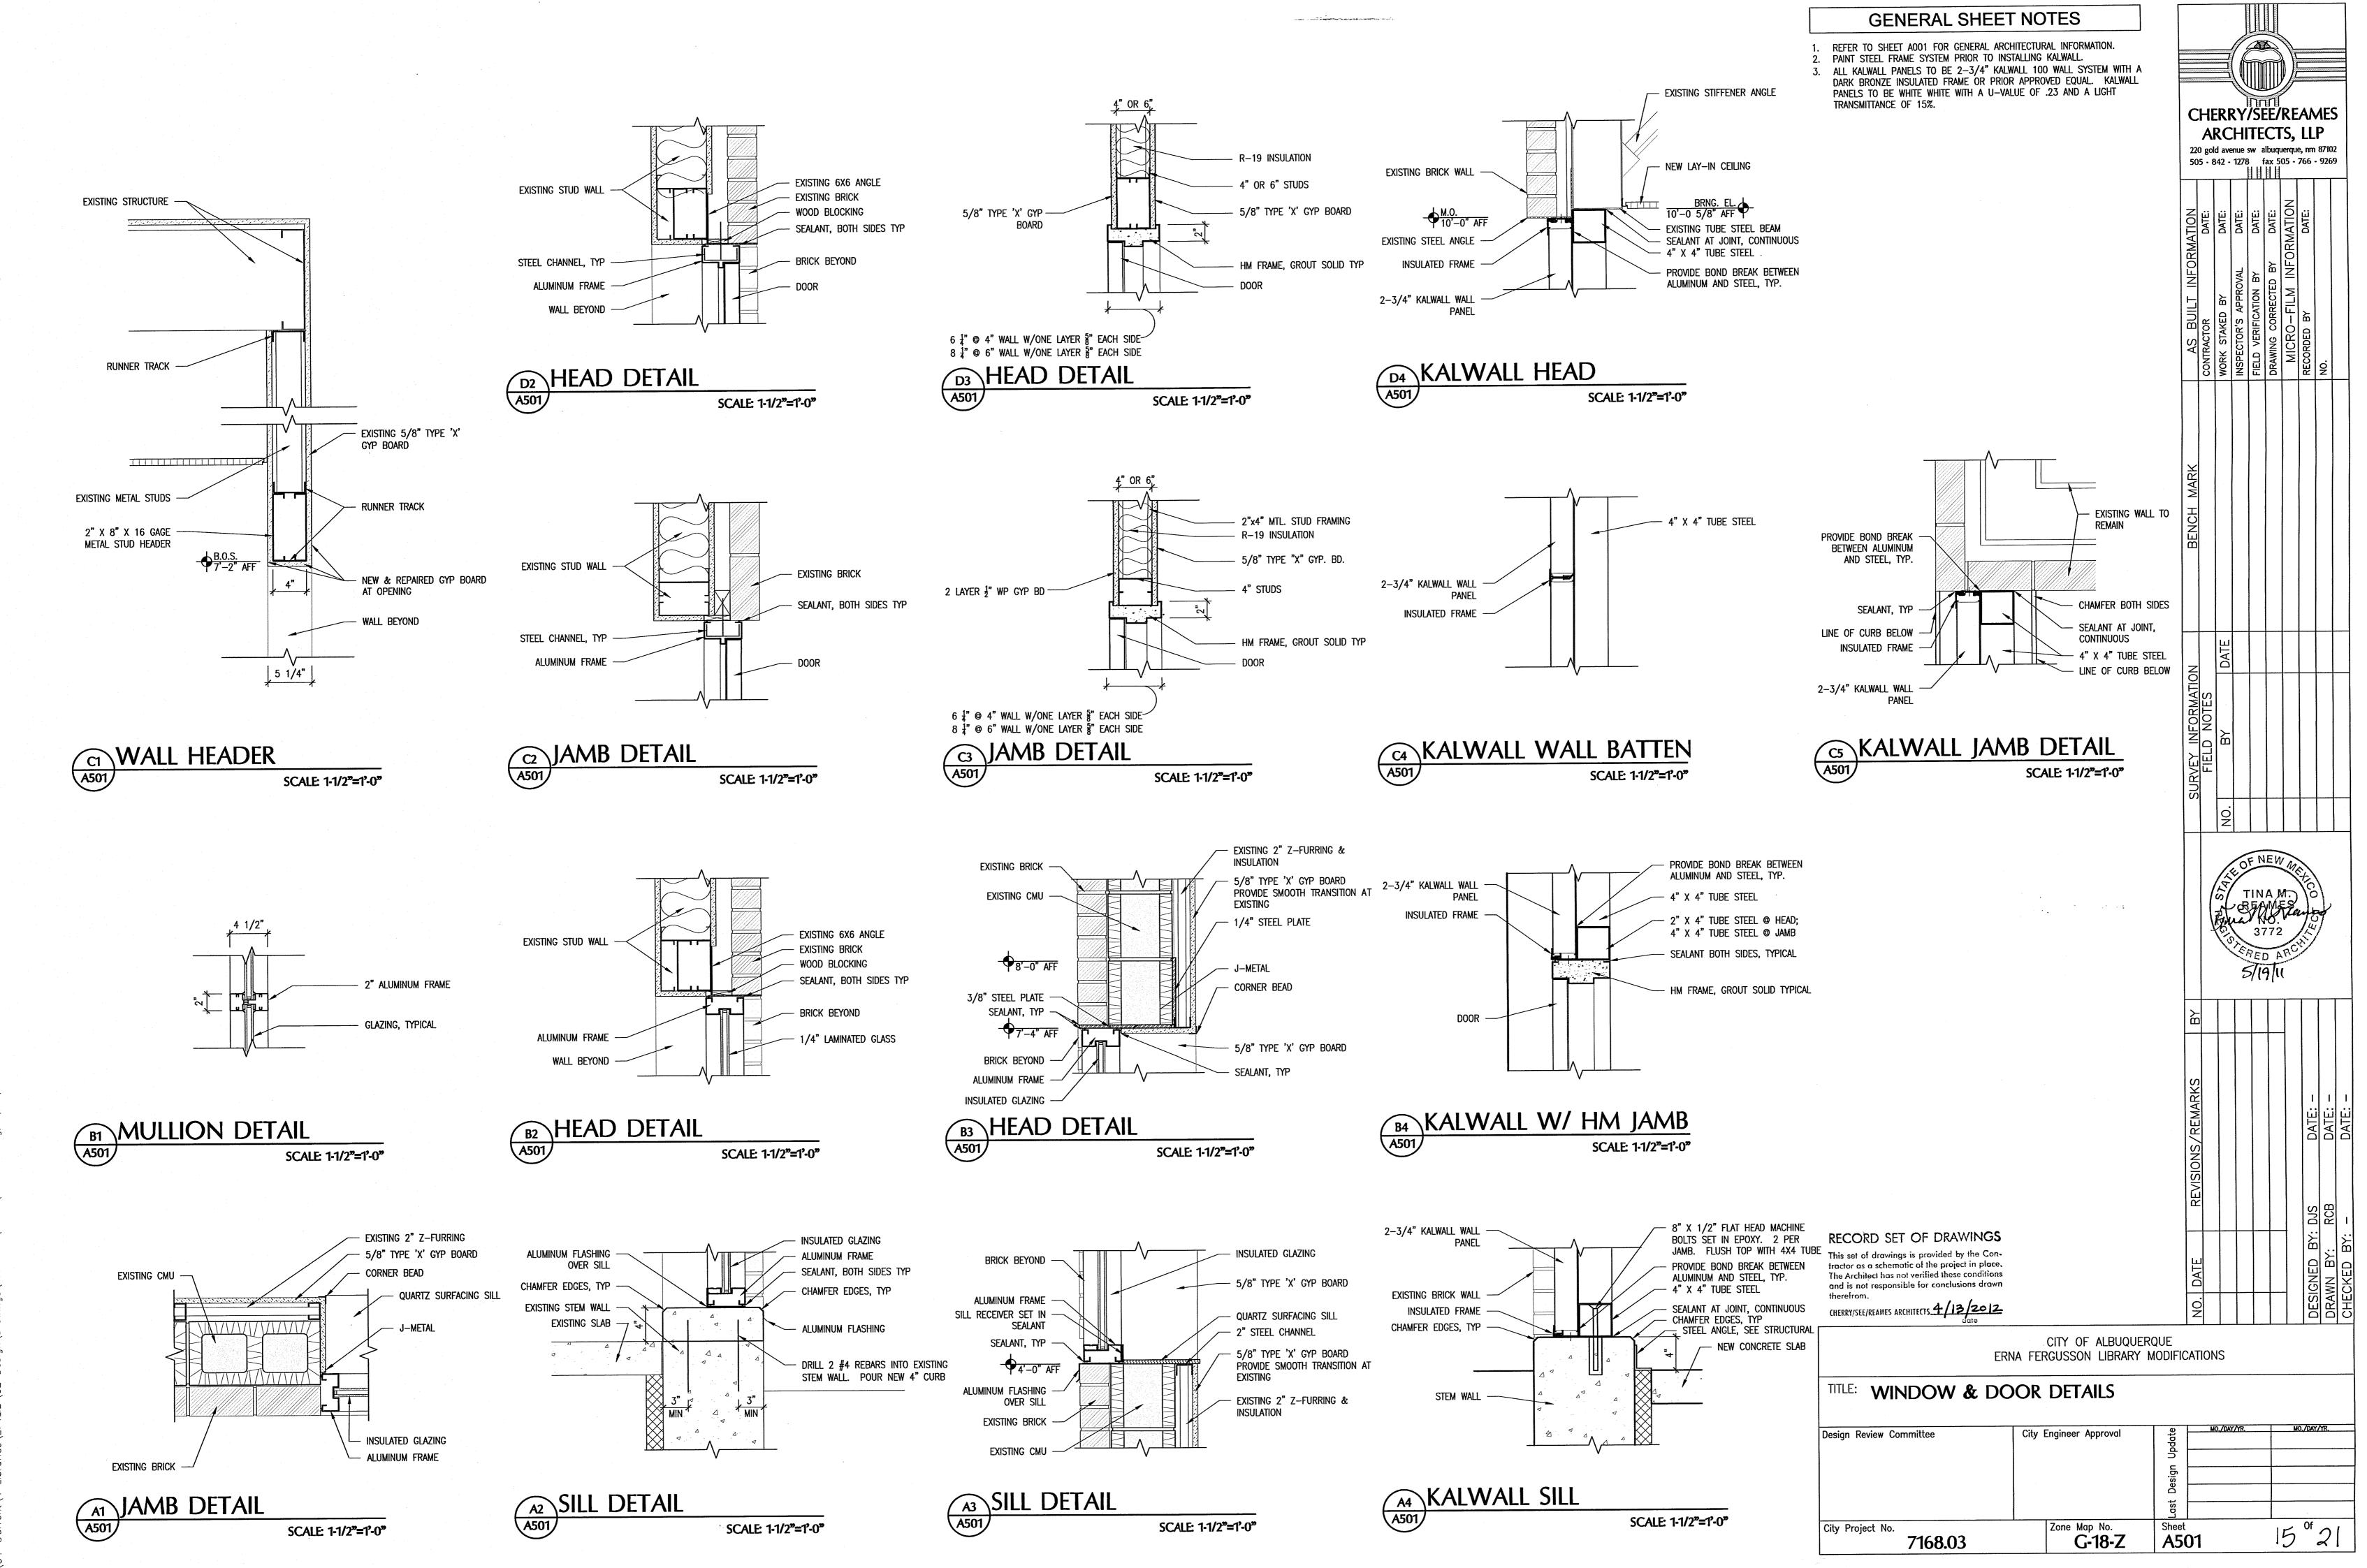


X:\04-Current\4 libraries\FF411B\02 Design\Drawings\PHASE 2\3 CD\EF A501.dwg, 5/16/2011 3:07:53 PM

	DOOR SCHEDULE											
ON a		D	OOR 🔘			FRAM	FRAME 🔷		HARDWARE KEY SIDE	CIONAGE	DENADI/C	
DOOR	W	SIZE H	T	MAT	TYPE	MAT	TYPE	RAT	KEY SIDE	SIGNAGE	REMARKS	
A101	PR 3'-0"	7'-0"	1-3/4"	НМ	В	HM	4	-	-	_	FRAME INSTALLED W/KALWALL, DOOR SALVAGED FROM PREVIOUS LOCATION	
A102	3'-0"	7'-0"	1-3/4"	НМ	Α	>)M(A	L; 2	-	-		FRAME EXISTING Per Phase 1, Addendum #1	
A104	4'-0"	7'-0"	1-3/4"	WD	С	HM	5	_	-	_	The state of the s	
A105	3'-0"	7'-0"	1-3/4"	WD	Α	НМ	1	_		_		
A106	3'-0"	7'-0"	1-3/4"	WD	Α	НМ	1	-			_	
	_	_	_	_	_	_	_	_	_	_	_	
_	_	_	–	_		_	_	_	-		-	
_		_	_	-	_	_		-	_	_		

1. SEE SPECIFICATIONS FOR HARDWARE SET NUMBER.


2. ANY CONFLICT BETWEEN THE SECTIONS AND SCHEDULE THE SCHEDULE PREVAILS. 3. HOLLOW METAL FRAMES ARE GROUTED SOLID UNLESS NOTED OTHERWISE.

4. ALUMINUM DOOR FRAMES (JAMBS AND HEADS) ARE STEEL BRACED UNLESS NOTED OTHERWISE. 5. ALL EXTERIOR DOORS TO BE INSULATED.

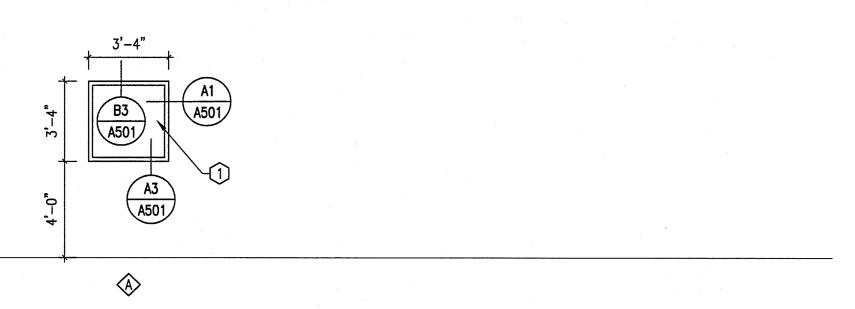


C1 WINDOW ELEVATIONS

SCALE: 1/4" = 1'-0"

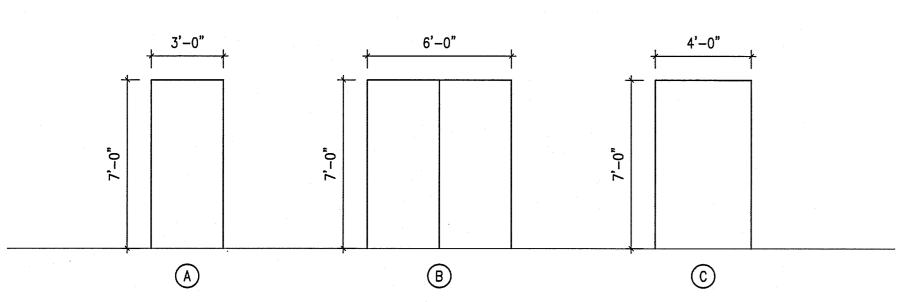

B1 DOOR TYPES

SCALE: 1/4" = 1'-0"

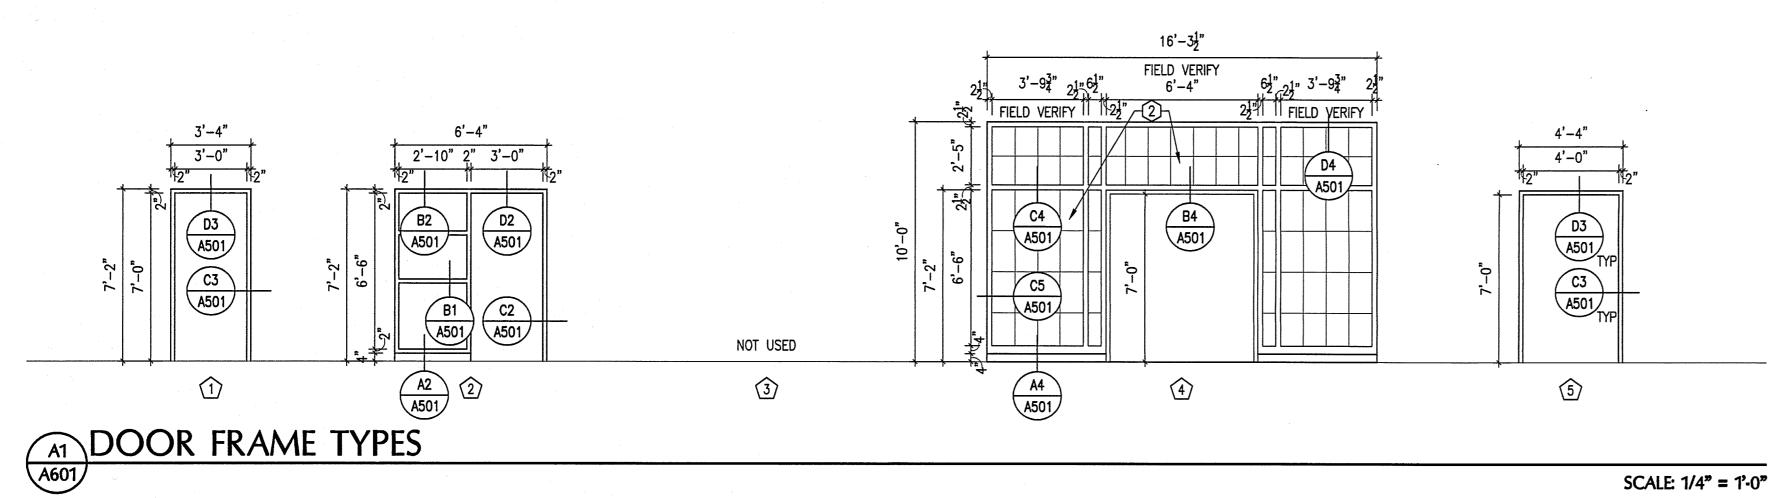

GENERAL SHEET NOTES

1. REFER TO SHEET A001 FOR GENERAL ARCHITECTURAL INFORMATION.

KEYED NOTES

1. GLAZING TO BE OPTIGRAY 23 + SOLARBAN 70XL. 2. SEE SHEET A401 FOR KALWALL TYPE KEYED NOTE.

CHERRY/SEE/REAMES

22	CHERRY/SEE/REAMES ARCHITECTS, LLP 220 gold avenue sw albuquerque, nm 87102 505 · 842 · 1278 fax 505 · 766 · 9269										
AS BUILI INFORMATION	CONTRACTOR DATE:	WORK STAKED BY DATE:	INSPECTOR'S APPROVAL DATE:	FIELD VERIFICATION BY DATE:	DRAWING CORRECTED BY DATE:	MICRO-FILM INFORMATION	RECORDED BY DATE:	NO.			
MAKK											

RECORD SET OF DRAWINGS This set of drawings is provided by the Contractor as a schematic of the project in place. The Architect has not verified these conditions and is not responsible for conclusions drawn CHERRY/SEE/REAMES ARCHITECTS 4/13/2012

		- A
	The state of the s	and the second section is a second section of the second section s
(For added scope, refer to Door & Frame Schedule Sketch, Exh	ibit R, on she
4	RS-2.	Commence of the second
- *	Per Phase 1, Addendum #1.	

and the second s				ž			
	ERNA FEI	CITY OF ALBUQUE RGUSSON LIBRARY		CATIONS	5		
TITLE: DOOR SCHEE		NS					
Design Review Committee	City	Engineer Approval	Last Design Update	MO.,	/DAY/YR.		MO./DAY/YR.
City Project No. 7168.03		Zone Map No. G-18-Z	Sheet A60			10	6 of 21

SCALE: 1/4" = 1'-0"

ROOM FINISH SCHEDULE

4. AT ALL LOCATIONS WHERE A NEW FINISH MATERIAL MEETS AN EXISTING FINISH MATERIAL, PROVIDE A SMOOTH TRANSITION. UNLESS OTHERWISE NOTED,

5. PROVIDE NEW VINYL BASE IN ALL LOCATIONS WHERE VINYL BASE IS CALLED OUT, UNLESS OTHERWISE NOTED. ARCHITECT TO SELECT COLOR. ZERO TOTAL VOC CONTENT THRU A MAXIMUM OF .50 MILLIGRAMS PER CUBIC METER PER HOUR. SPECIAL INSTALLATION AND VENTILATION PROCEDURES MUST BE

REMARKS

PROVIDE NEW OAK BASE. MATCH EXISTING.

PROVIDE OAK BASE AS NECESSARY AT CUT OPENINGS. MATCH EXISTING.

WALLS CEILINGS

 1F 2F 3F 4F
 1B 2B 3B
 1W 2W 3W 4W
 1C 2C 3C 4C

 1F 3F
 1B
 2W 4W
 2C

EXPOSED STRUCTURE IS EXISTING AND SHOULD REMAIN IN EXISTING CONDITION UNLESS NOTED OTHERWISE.

FLOORS BASE

1. ALL GYP BD FINISHES ARE PAINTED UNLESS NOTED OTHERWISE.

MATCH EXISTING FINISH MATERIAL, TEXTURE AND COLOR.

EMPLOYED WITH RUBBER PRODUCTS TO MINIMIZE VOC EMISSIONS.


3. USE USDA APPROVED EPOXY GROUT FOR TILE FLOORS. LATAPOXY 2000 OR EQUAL.


WORK ROOM

UNISEX

STACKS

105R VESTIBULE

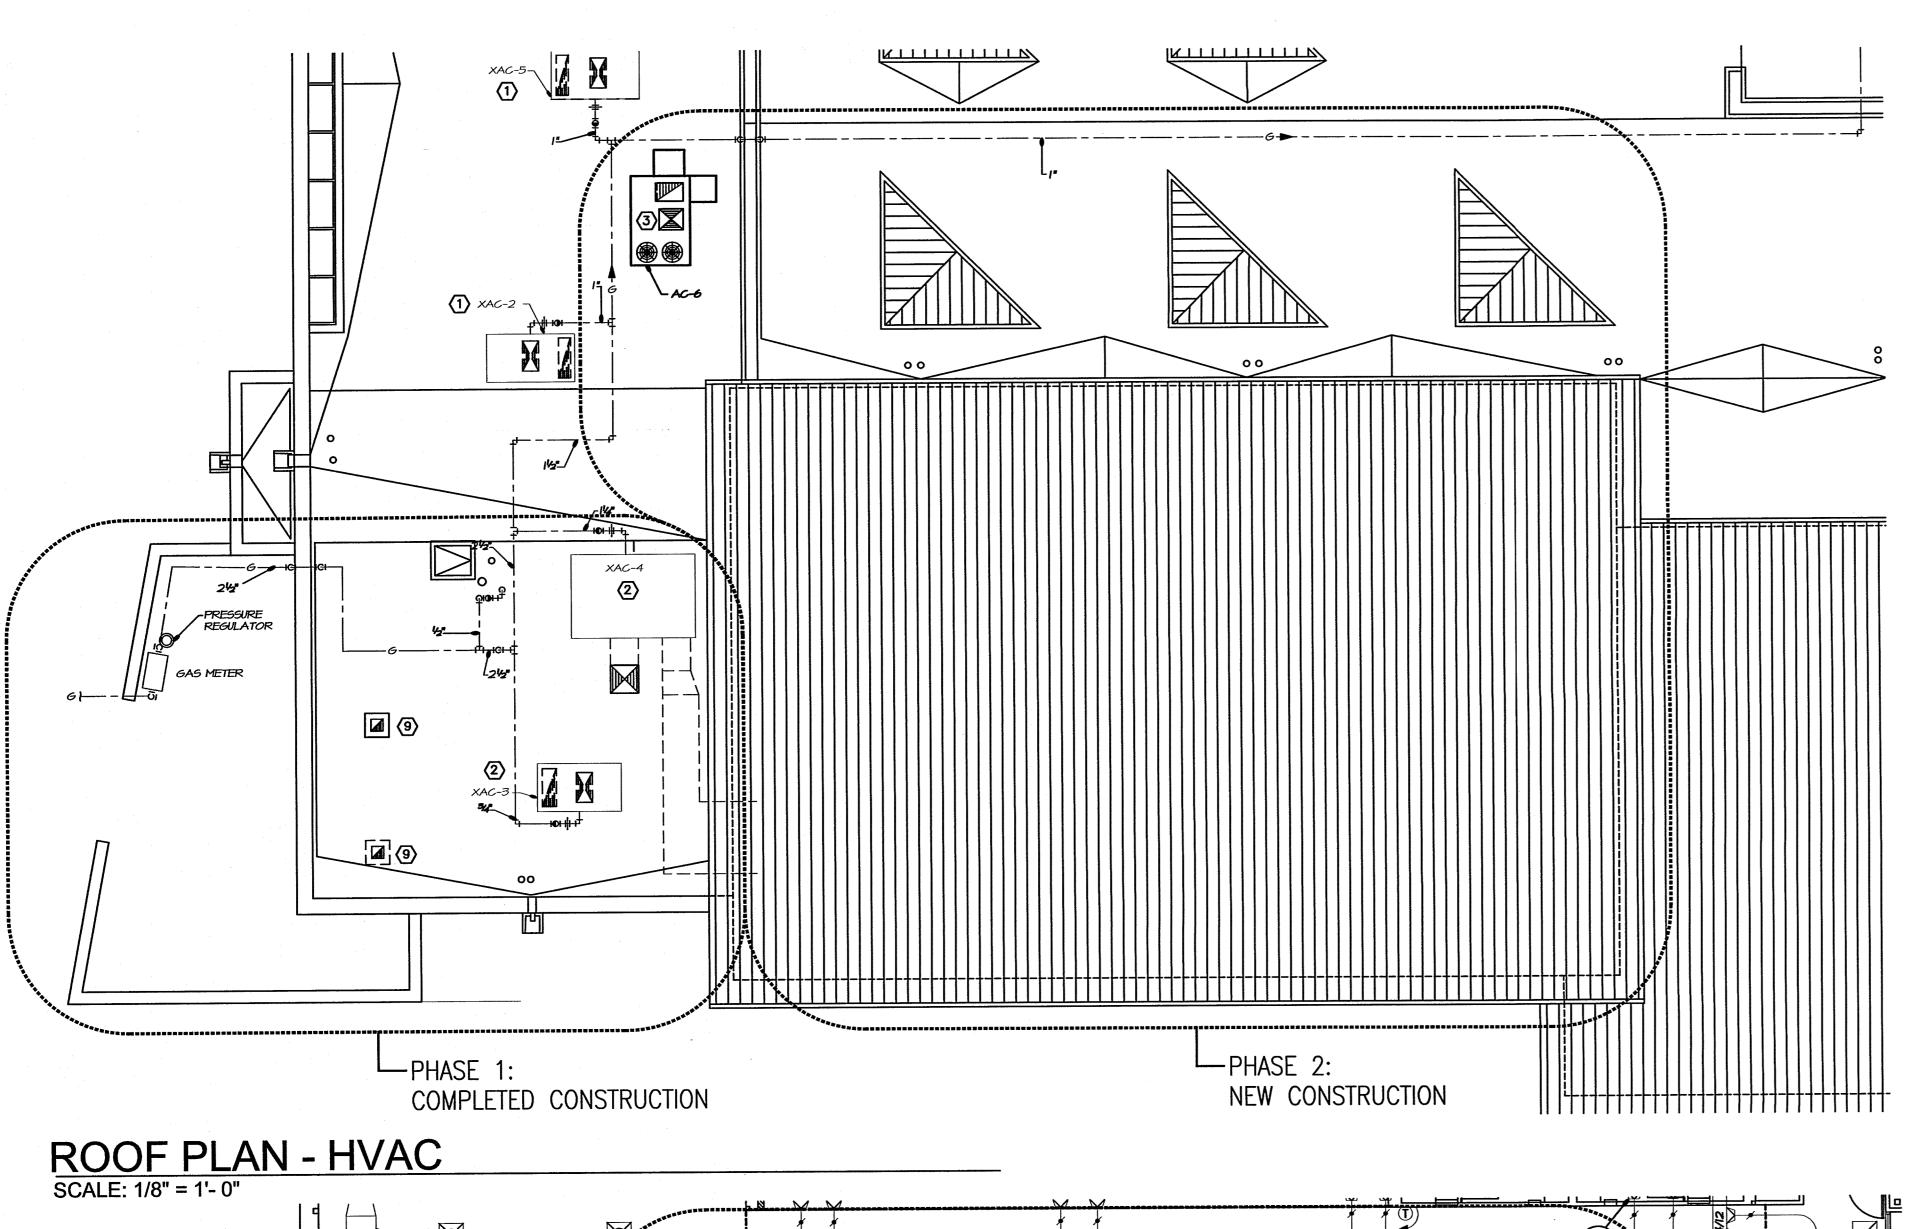

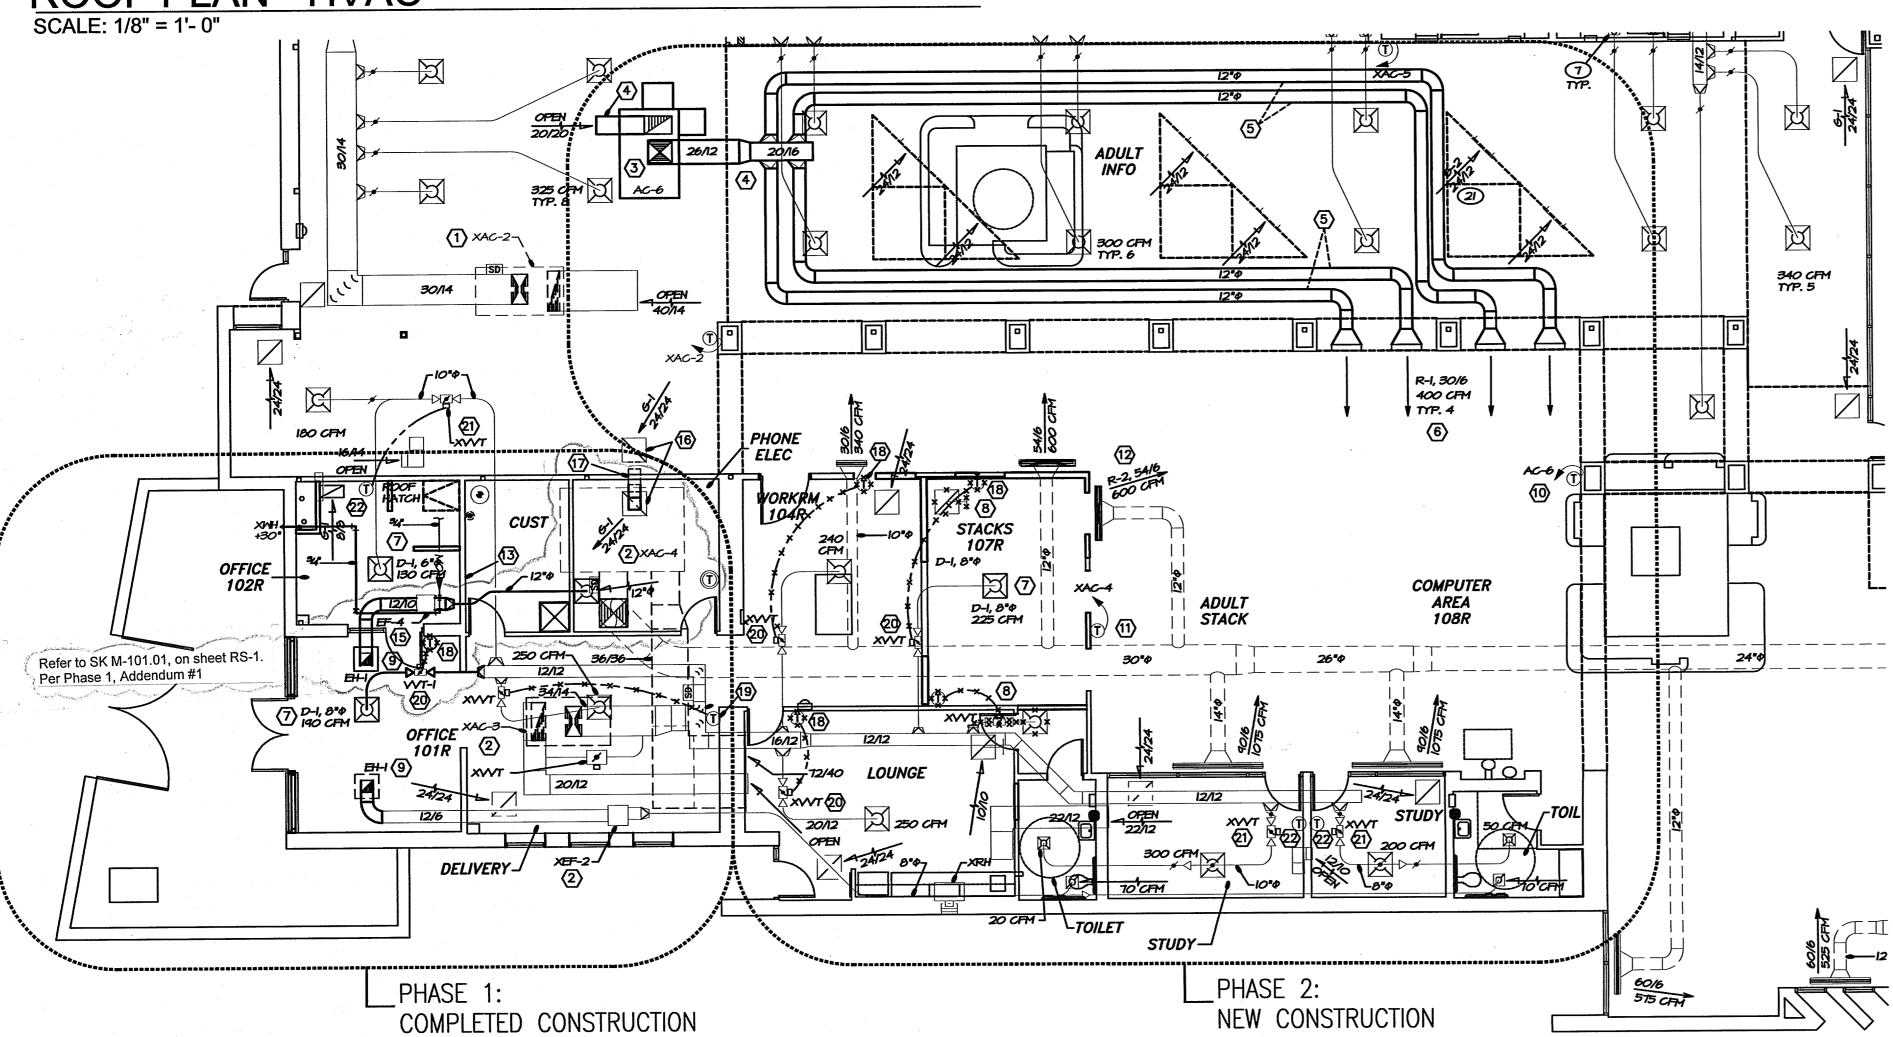

FLOOR PLAN - HVAC

SCALF: 1/8" = 1'- 0"

KEYED NOTES

- 1. EXISTING EQUIPMENT TO REMAIN AS IS.
- 2. EXISTING EQUIPMENT TO BE REBALANCED TO AIRFLOW AS INDICATED. TAB SERVICE TO BE PERFORMED UNDER PHASE 2 OF THE PROJECT.
- 3. NEW ROOFTOP AIR CONDITIONING UNIT. MOUNT ON ROOF CURB. COORDINATE INSTALLATION WITH GENERAL
- 4. NEW DUCTWORK IN CEILING SPACE. CAREFULLY COORDINATE INSTALLATION WITH STRUCTURAL AND SPACE AVAILABLE.
- 5. NEW DUCTWORK IN CEILING SPACE. ROUTE DUCT THROUGH CEILING JOIST WEBS.
- 6. NEW SIDEWALL SUPPLY AIR REGISTER. BALANCE TO AIRFLOW
- 7. NEW CEILING DIFFUSER OR GRILLE AS SHOWN. BALANCE TO AIRFLOW SHOWN.
- 8. REMOVE DUCTWORK, DIFFUSER, EQUIPMENT, ECT. AS INDICATED BY 'X'. CAP EXISTING DUCTWORK AT POINT OF REMOVAL AS REQUIRED. TYPICAL.
- 9. PROVIDE NEW ROOFTOP EXHAUST HOOD AND CONNECT TO EXISTING EXHAUST DUCTWORK AS SHOWN. COORDINATE INSTALLATION OF ROOF CURB AND EXHAUST HOOD WITH GENERAL CONTRACTOR.
- 10. EXISTING THERMOSTAT TO BE CONNECTED TO CONTROL NEW AIR CONDITIONING UNIT AC-6.
- 11. PROVIDE NEW THERMOSTAT AND CONNECT TO CONTROL EXISTING AIR CONDITIONING UNIT XAC-4.
- 12. REMOVE EXISTING FLOOR REGISTER CORE FROM FRAME. PROVIDE NEW EXTRA HEAVY DUTY R-2 FLOOR REGISTER CORE. INSTALL SECURELY IN EXISTING FRAME.
- 13. EXISTING YORK MERIDIAN VVT SYSTEM CONTROL PANEL DISCONNECT AND REMOVE COMPLETE.
- 14. PROVIDE NEW VVT-1 TERMINAL UNIT. CONNECT TO EXISTING YORK MERIDIAN VVT SYSTEM CONTROL PANEL. INSTALL WALL TEMPERATURE SENSOR AS SHOWN.
- 15. PROVIDE NEW EXHAUST FAN EF-4. GREENHECK MODEL BCF-107-4, 120V/1P, 600 CFM .4" SP. CONNECT TO EXISTING ELECTRICAL POWER AND THERMOSTAT CONTROL. CAREFULLY COORDINATE INSTALLATION WITH STRUCTURAL AND SPACE AVAILABLE.
- 16. PROVIDE NEW TRANSFER AIR GRILLES IN CEILINGS WITH 12"X12" TRANSFER AIR DUCT ABOVE THE CEILING. COORDINATE GRILLE LOCATIONS WITH LIBRARY SIDE CEILING
- 17. PROVIDE NEW 1-1/2 HR RATED FIRE DAMPER WITH SLEEVE THRU FIRE RATED WALL.
- 18. REMOVE WALL MOUNTED VVT BOX THERMOSTAT. PROVIDE STAINLESS STEEL BLANK COVER PLATE. REMOVE THERMOSTAT WIRING AS NECESSARY. THIS WORK IS PART OF THE PHASE 2 WORK.
- 19. REPLACE EXISTING VVT BOX THERMOSTAT WITH NEW ELECTRONIC PROGRAMMABLE THERMOSTAT. REMOVE EXISTING THERMOSTAT WIRING AS NECESSARY. PROVIDE NEW THERMOSTAT WIRING AND CONNECT THERMOSTAT TO EXISTING YORK XAC-3. COORDINATE UNIT CONNECTION WITH LOCAL YORK SUPPLIER NORMAN S. WRIGHT. THIS WORK IS PART OF THE PHASE 2 WORK.
- 20. DISCONNECT ACTUATOR WIRING. TEST AND BALANCE AGENCY TO USE EXISTING VVT BOX FOR BALANCING BY MANUALLY POSITIONING DAMPER AND LOCKING IN PLACE. THIS WORK IS PART OF THE PHASE 2 WORK.
- 21. REPLACE ZONE DAMPER ACTUATOR WITH NEW BELIMO LMB24 (OR APPROVED EQUAL) 24VAC ACTUATOR. ADJUST DAMPER/ACTUATOR TO MINIMUM 10% OPEN SETTING. INSTALL NEW YOUNG REGULATOR 322S DUCT TEMPERATURE SENSOR IN DUCTWORK UPSTREAM OF EXISTING ZONE DAMPER. WIRE ACTUATOR AND SENSOR TO NEW YOUNG REGULATOR T-322 THERMOSTAT. THIS WORK IS PART OF THE PHASE 2 WORK.
- REPLACE EXISTING WALL MOUNTED THERMOSTAT WITH NEW YOUNG REGULATOR T-322 THERMOSTAT. CONNECT TO EXISTING 24VAC CONTROL POWER, NEW ACTUATOR AND DUCT TEMPERATURE SENSOR. THIS WORK IS PART OF THE PHASE

DEMOLITION NOTES

- 1. DEMOLITION PLANS HAVE BEEN CREATED FROM EXISTING PLANS AND FIELD OBSERVATIONS. THEY ARE INTENDED TO GIVE THE CONTRACTOR A FAIRLY ACCURATE DESCRIPTION AND SCOPE OF WORK INVOLVED. THEY ARE NOT INTENDED TO BE EXACT AND ALL INCLUSIVE. SOME MINOR ADDITIONAL WORK MAY BE REQUIRED AT THE CONTRACTOR'S EXPENSE AS IS TYPICAL WITH RENOVATION PROJECTS.
- ALL EQUIPMENT, DUCTS, ETC, SHALL BE REMOVED WHERE INDICATED WITH "X"'S OR LISTED TO BE REMOVED PER DEMOLITION PLANS.

RECORD SET OF DRAWINGS EXISTING DUCTWORK ABOVE CEILING This set of drawings is provided by the Contractor as a schematic of the project in place. The Architect has not verified these conditions and is not responsible for conclusions drawn

CHERRY/SEE/REAMES ARCHITECTS 4/13/2012


TTT HARMEYER NELLOS ENGINEERING MECHANICAL CONSULTING FOR BUILDING SYSTEMS 915 YALE BOULEVARD S.E. ALBUQUERQUE, NEW MEXICO 87106 (505) 888-5808





LEGEND

___ NEW DUCTWORK ABOVE CEILING


______G___ - __ EXISTING NATURAL GAS LINE

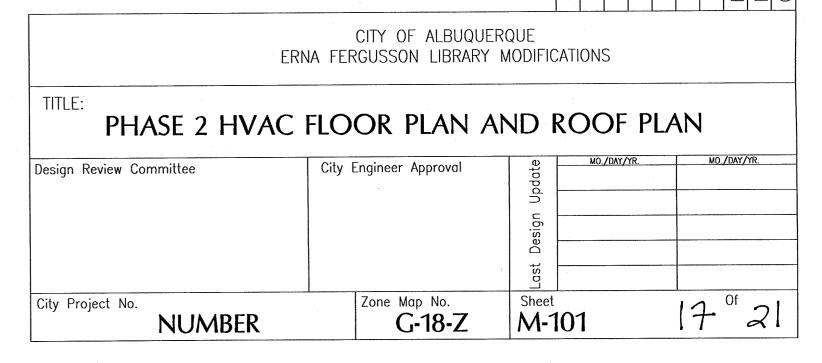

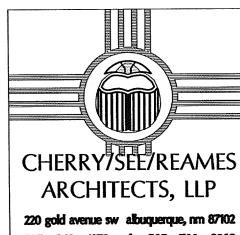

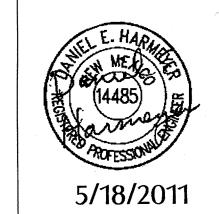

i I						ı
REVISIONS/REMARKS				DATE:	DATE:	
REV				HNE	ШZ	

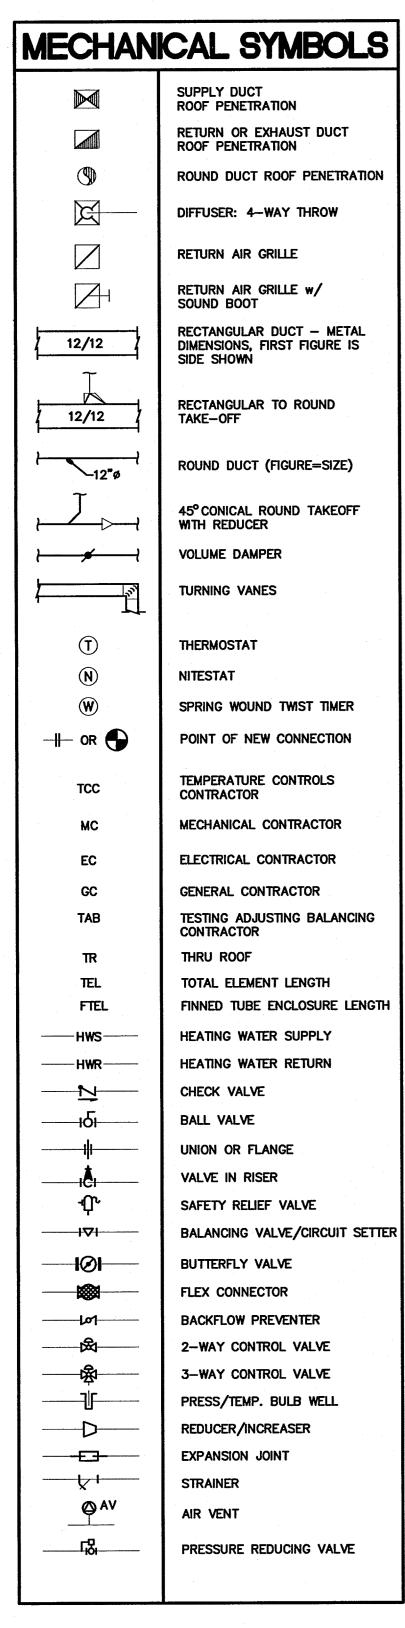


		MECH	HANICA	AL EQUIPM	ENT SCHEDULE	
MARK	FUNCTION	SERVES	LOCATION	OPERATING CONDITIONS	CAPACITIES & MOTOR RATINGS	MANUFACTURE & MODEL
AC-6	AIR CONDITIONING UNIT	COMPUTER AREA	ROOF	80F db E.A.T. 62F wb E.A.T. 105F db O.A.T. 5,300 ft. alt.	38.1 MBH total cooling 35.8 MBH sensible cooling 1,600 CFM © 0.8" E.S.P. (ductwork) 170 CFM OA, SEER/EER=15.0/12.2 1 HP Evap blower motor 460V, 3 Ph, 60Hz MCA=13 MOCP=15 Approx. Weight: 600 Lbs.	YORK: ZJ049 (4 ton)
D-1	BLOWER: F STARTER: F DRIVE: H MOTOR: 1 COMPRESSOR: N COND. FAN F COILS: F ECONOMIZER: F FILTERS: S CONTROLS: S SAFETIES: 0 OPTIONS: F ROOF CURB: F	Forward—curved, Provided with un High range belt I—speed, ODP, 1 Welded, fully her Propeller, direct ARI standard 410 Ambient air tem Side access with Complete self—c Cooling — over—delay, air dryer	centrifugal type it; fused discondrive 750 RPM, varial metic, independ drive motor 0, copper tube, perature control housing, access ontained low voltemp./over—pre on liquid line, for rol package, ha guard oof curb, min. 1	nect included ble pitch drive ent circuits, internally prot aluminum fins 1, 100% O.S.A., power exha is door, track; 4", MERV 1 ltage control circuit. Electr ss, loss of charge/low pre actory mounted supply air il guard for cond. coil, coil 4" high.	tected, vibration isolators, R—410A or equal oust 11, 60% efficiency minimum ronic programmable wall thermostat. ess switch, freezestat/evap. coil, high press	switch, comp. cycle
		 Off-white finish, CARNES, J & J		GER, METAIL AIRE, NAILOR	INDUSTRIES, PRICE, TITUS, TUTTLE & BAILE	
G-1	GRILLE	HVAC	T-bar Ceiling/sidewall		See HVAC plan for throat size See HVAC plan for panel face size	PRICE: 81TB
		Off-white finish, CARNES, J & J			INDUSTRIES, PRICE, TITUS, TUTTLE & BAILE	Y
R-1	SUPPLY REGISTER	HVAC	Sidewall		See HVAC plan for throat size and CFM	PRICE: 520FL
-	OPTIONS:	Steel construction	on, off-white fir	nish		
R-2	SUPPLY REGISTER	HVAC	Floor		See HVAC plan for throat size and CFM	PRICE: LBMH
	OPTIONS: I PRIOR APPRV: (Extra heavy dut CARNES, J & J	y aluminum con REGISTER, KRUE	struction, opposed blade of GER, METAL AIRE, NAILOR	damper, medium bronze finish, mount in ex INDUSTRIES, PRICE, TITUS, TUTTLE & BAILE	isting frame Y
EH-1	EXH HOOD	HVAC	Roof		12" x 12" Throat	GREENHECK HGR
		Provide with 14 [*] ACME, BREIDERT		K, GREENHECK, PENN, TWIN	I CITY FAN	
VVT-1	VVT BOX	HVAC	Ceiling		260 CFM © max. 1200 FPM, 6" round	YORK: MERIDIAN
	CASING: DAMPER: DRIVE: CONTROLS:	22ga. galvanized Gear driven, 57 VVT unit contro Monitors zone t	welded 18—gaug I steel blade, so second drive to I module: micro emp. set points I zone temp. se	e galvanized steel. Discher eats against rolled bead in me, micro switches to sto processor based terminal , zone temp., zone temp. etpoint. Provide with room	arge end roll crimped to fit standard round a casing, factory provided integral 24 VAC of p drive motor at full open & full closed po- unit controller, provides pressure dependent rate of change, & valve position. Airflow temperature sensor. Compatible with existi	electric actuator. esitions. flow control. controlled through
	COMMUN:	Controller has i	nherent ability t	o send. & receive data fro points & setup.	om York Meridian central control panel. Cap	able of monitoring/

2009 Albuquerq	ue Energy (2006 COMPL	IECC)	tion Cod	de
	erguson Libr Mateo Blvd NE e, NM 87110	ary Modific	ations	
Climate Zone	4			
Window and Glazing area	< 40%			
ltem		Required	Provided	Meets Re
Mechanical Equipment				
AC-6 Cooling only	<65,000 Btu/h	>/= 9.7 SEER	15.0 SEER	Yes

Ventilation Air

Room	Room Type	Area SF	Occupancy	OA CFM Required	OA CFM Provided	OA CFM Provided	Comments
Office 101R	Office	221	2	20	20	Yes	Air Handling Unit w/ Economizer
Office 102R	Office	120	2	12	14	Yes	Air Handling Unit w/ Economizer
Workroom 104R	Office	280	2	27	30	Yes	Air Handling Unit w/ Economizer
Stacks 107R	Library	250	3	45	45	Yes	Air Handling Unit w/ Economizer
Computer Area 108R	Library	810	8	137	170	Yes	Air Handling Unit w/ Economizer

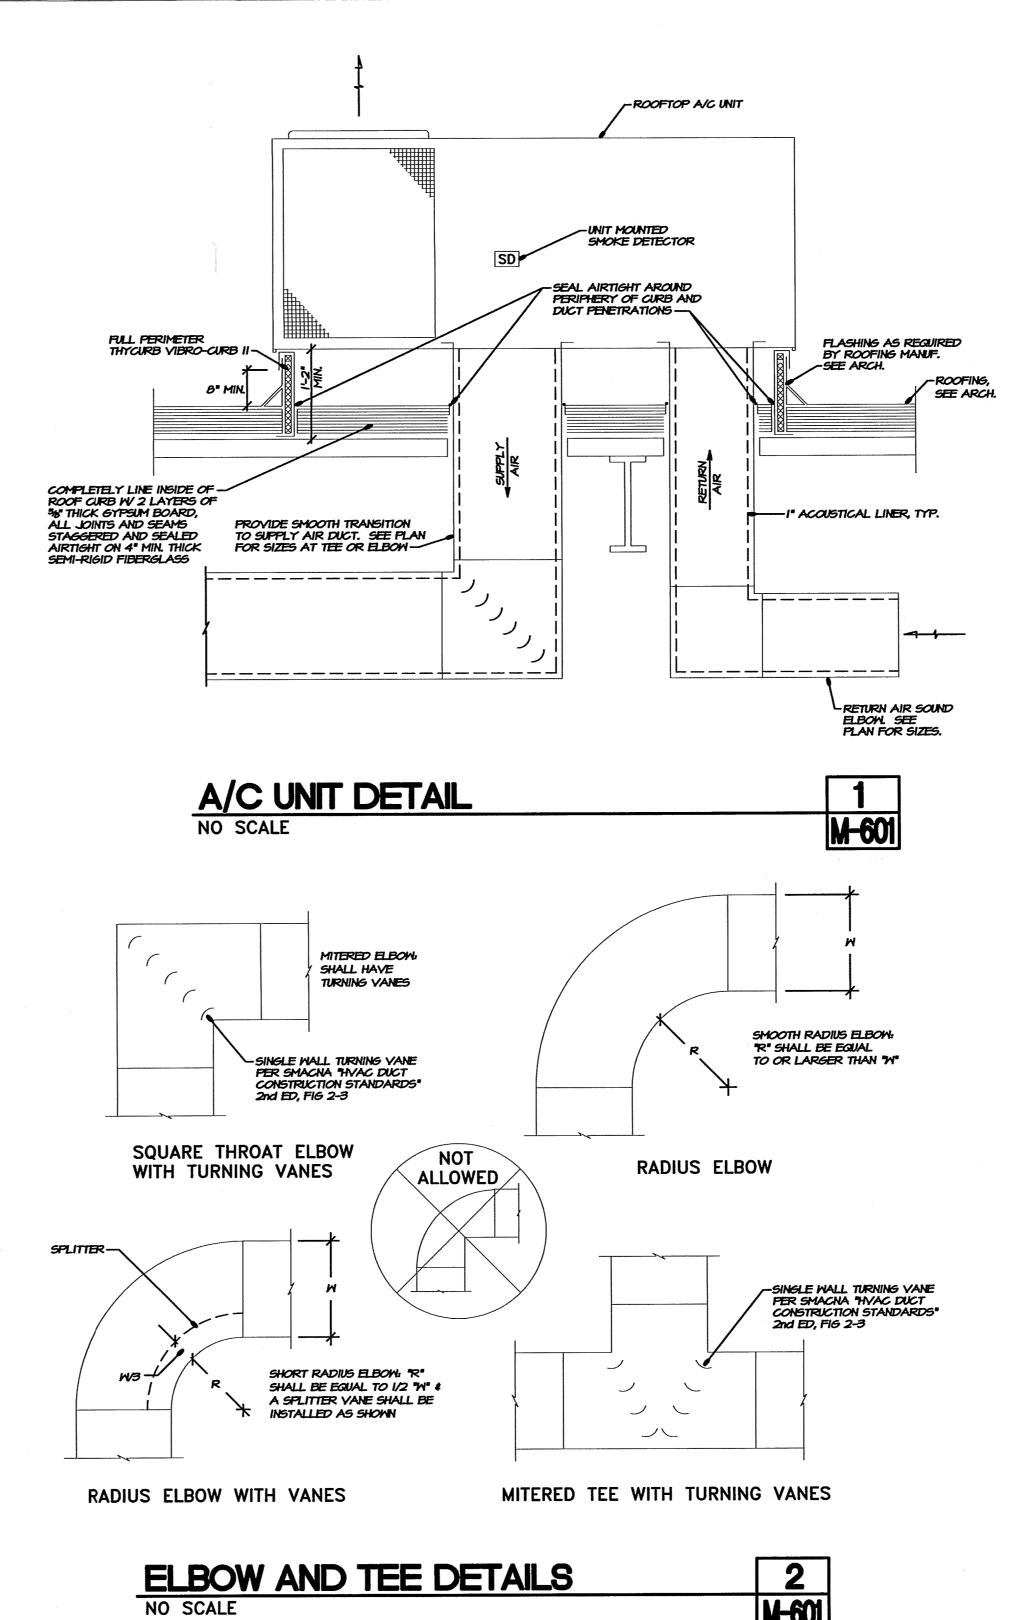


GENERAL NOTES

- 1. ALL SQUARE AND RECTANGULAR SUPPLY AND RETURN AIR DUCTWORK SHALL HAVE 1" ACOUSTIC LINER. ALL ROUND DUCT SHALL BE INSULATED WITH 1-1/2" DUCT WRAP INSULATION. ALL DUCT DIMENSIONS SHOWN ON DRAWINGS ARE SHEET METAL SIZES.
- 2. ALL JOINTS AND SEAMS ON SUPPLY, RETURN, AND EXHAUST AIR DUCTS SHALL BE SEALED AIRTIGHT WITH AN APPROVED HEAVY MASTIC DUCT SEALANT. DUCT TAPE IS NOT ACCEPTABLE.
- 3. THE SHEET METAL CONTRACTOR SHALL BE RESPONSIBLE FOR COORDINATING THE INSTALLATION OF THE DUCTWORK TO ALLOW ADEQUATE CLEARANCE OF OTHER EQUIPMENT. THE CONTRACTOR SHALL COORDINATE WITH ALL OTHER TRADES TO AVOID CONFLICTS.
- 4. ALL MECHANICAL EQUIPMENT SHALL BE INSTALLED TO PROVIDE ADEQUATE SERVICE CLEARANCES PER MANUFACTURER'S INSTRUCTIONS.
- 5. ALL ELBOWS AND TEES SHALL BE FABRICATED AS SHOWN PER DETAIL 2/M-601.
- 6. CONTRACTOR SHALL ENSURE A COMPLETE AND OPERATIONAL MECHANICAL SYSTEM.
- 7. INSTALL THERMOSTATS AT SWITCH HEIGHTS OR AS DIRECTED BY ARCH.
- 8. WHERE T-STAT GUARD OR LOCK BOX IS SPECIFIED ON PLANS, CONTRACTOR SHALL USE MODEL BTG-54VL BY BEKO (UNLESS NOTED OTHERWISE), OR APPROVED EQUAL. LOCK BOX SHALL BE METAL WITH HINGED COVER.
- 9. ALL ROOFTOP EQUIPMENT SHALL BE INSTALLED LEVEL. ADJUSTMENTS SHALL BE MADE IN THE CURBS/EQUIPMENT SUPPORTS OR BY USING TAPERED, TREATED WOOD SHIMS BELOW THE CURB AS DIRECTED BY THE ARCHITECT.
- 10. THE PHASE 2 CONTRACTOR SHALL PROVIDE TESTING, ADJSTING AND BALANCING (TAB) SERVICE FOR UNITS XAC-3, XAC-4 AND AC-6. ADJUST SUPPLY AIR OUTLETS TO CFM QUANITIES AS SHOWN ON SHEET M-101. TAB SERVICE SHALL BE PERFORMED UNDER THE PHASE 2 CONTRACT.

11. TEMPERATURE AND VVT CONTROLS AND INSTALLATION SHALL

BE PROVIDED BY THE HVAC SUBCONTRACTOR. PROVIDE ALL

- NECESSARY HARDWARE, COMPONENTS, WIRING, ETC. TO ENSURE COMPLETE AND FULLY OPERATIONAL CONTROL OF THE HVAC EQUIPMENT. 12. NOTIFY OWNER AND OCCUPANTS OF ANY OUTAGES THAT
- MAY OCCUR. GIVE A 72 HOUR NOTICE BEFORE ANY NECESSARY OUTAGE.

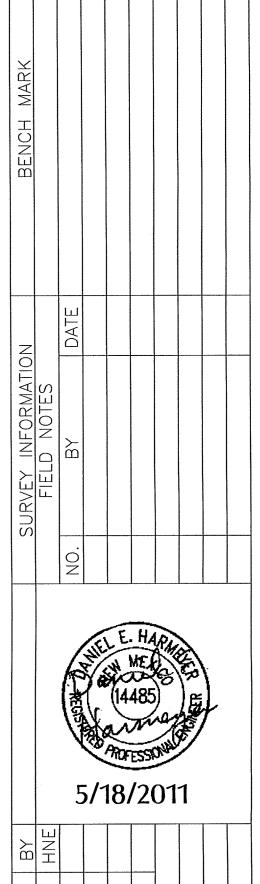

CHERRY SEE REAMES

ARCHITECTS, LLP

220 gold avenue sw albuquerque, nm 87102

RECORD SET OF DRAWINGS This set of drawings is provided by the Con-


M-601

tractor as a schematic of the project in place. The Architect has not verified these conditions and is not responsible for conclusions drawn

CHERRY/SEE/REAMES ARCHITECTS 4/13/2012

	REVISI		
HARMEYER NELLOS ENGINEERING MECHANICAL CONSULTING FOR BUILDING SYSTEMS		/2010	
915 YALE BOULEVARD S.E. ALBUQUERQUE, NEW MEXICO 87106 (505) 888-5808	DAT	9/27	
(303) 600-3008	NO.		

CITY OF ALBUQUERQUE ERNA FERGUSSON LIBRARY MODIFICATIONS									
TITLE: PHASE 2 MECHA	anical Equipa	ment sched	ULE						
Design Review Committee	City Engineer Approval	Last Design Update	MO./DAY/YR.						
City Project No. NUMBER	Zone Map No. G-18-Z	Sheet M-601	18 of 21						

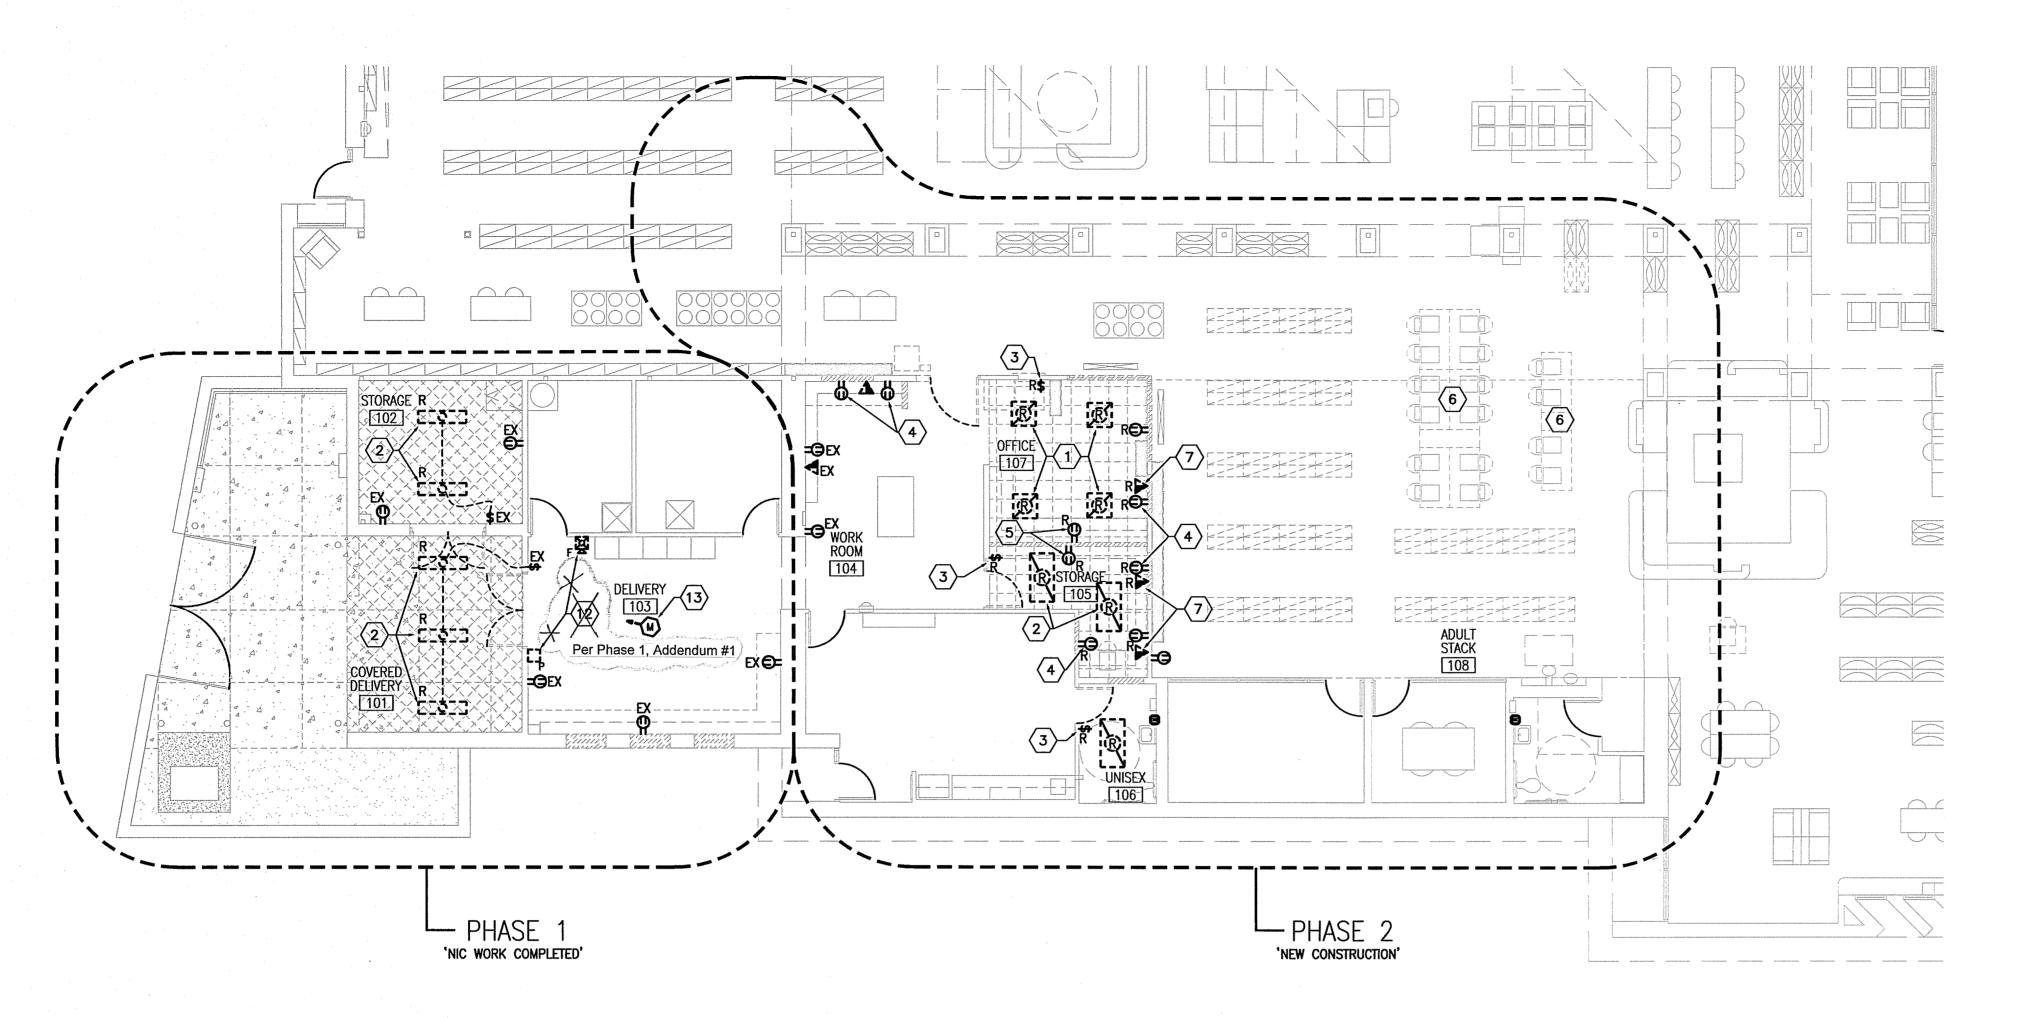

ELECTRICAL DEMO FLOOR PLAN

SCALE VID—FLOT

BID

PHASE 1

NE MINI CONTACTOR

SCALE VID—FLOT

S

A2 LIGHTING FLOOR PLAN

SCALE: 1/8"=1'-0"

LIGHTING COMPLIANCE - 2009 AECC - PHASE 1

INTERIOR LIGHTING
BUILDING TYPE: LIBRARY
SOUARE FOOTAGE: 677
TOTAL WATTS ALLOWED: 812
ACTUAL WATTS: 794

EXTERIOR LIGHTING: N.A.

TRADABLE WATTS ALLOWED: N.A.

ACTUAL TRADABLE WATTS: N.A.

NONTRADABLE WATTS ALLOWED: N.A.

ACTUAL NONTRADABLE WATTS: N.A.

THIS PROJECT IS IN COMPLIANCE WITH 2009 AECC

INDEPENDENT CONTROL AND UNIFORM LIGHT REDUCTION CAPABILITY REQUIREMENTS ARE MET CONSIDERING EXCEPTIONS.

EXTERIOR LIGHTING HAS AUTOMATIC CONTROLS CONTROLLED BY A PHOTOSENSOR OR ASTRONOMICAL TIME SWITCH TO TURN LIGHTING OFF WHEN SUFFICIENT DAYLIGHT IS AVAILABLE OR WHEN LIGHTING IS NOT REQUIRED.

FLUORESCENT AND HID LAMPS ARE PROVIDED WITH ELECTRONIC BALLASTS.

LIGHTING COMPLIANCE - 2009 AECC - PHASE 2

NTERIOR LIGHTING
BUILDING TYPE: LIBRARY
SOUARE FOOTAGE: 250
TOTAL WATTS ALLOWED: 310
ACTUAL WATTS: 308

EXTERIOR LIGHTING: N.A.

TRADABLE WATTS ALLOWED: N.A.

ACTUAL TRADABLE WATTS: N.A.

NONTRADABLE WATTS ALLOWED: N.A.

ACTUAL NONTRADABLE WATTS: N.A.

THIS PROJECT IS IN COMPLIANCE WITH 2009 AECC

INDEPENDENT CONTROL AND UNIFORM LIGHT REDUCTION CAPABILITY REQUIREMENTS ARE MET CONSIDERING EXCEPTIONS.

EXTERIOR LIGHTING HAS AUTOMATIC CONTROLLE BY A PHOTOSENSOR OR ASTRONOMICAL TIME SWITCH TO TURN LIGHTING OFF WHEN SUFFICIENT DAYLIGHT IS AVAILABLE OR WHEN LIGHTING IS NOT REQUIRED.

FLUORESCENT AND HID LAMPS ARE PROVIDED WITH ELECTRONIC BALLASTS.

KEYED NOTES (

- 1. EXISTING FIXTURE WITH RELATED CONDUIT AND CONDUCTORS SHALL BE REMOVED AND BE REINSTALLED IN PER NEW LAYOUT. EXISTING LIGHTING CIRCUIT SHALL REMAIN AND BE EXTENDED TO NEW FIXTURE LOCATIONS.
- 2. EXISTING FIXTURES WITH RELATED CONDUIT AND CONDUCTORS SHALL BE REMOVED AND TURNED OVER TO THE OWNER. EXISTING LIGHTING CIRCUIT SHALL REMAIN AND BE EXTENDED TO NEW FIXTURES.
- 3. EXISTING LIGHTING SWITCH WITH RELATED CONDUIT AND CONDUCTORS SHALL BE REMOVED. CONTINUE CIRCUIT CONTINUITY TO REMAINING DEVICES.
- 4. THE EXISTING RECEPTACLE WITH RELATED CONDUIT AND CONDUCTORS ON THIS WALL SHALL BE REMOVED IN AREAS WHERE THE WALL WILL BE REMOVED. EXISTING RECEPTACLE SHALL REMAIN IF NOT BEING AFFECTED BY THE WALL REMOVAL. CONTINUE CIRCUIT CONTINUITY TO REMAINING DEVICES.
- 5. EXISTING RECEPTACLES SHALL REMOVED. CONTINUE CIRCUIT CONTINUITY TO DEVICES THAT ARE TO REMAIN.
- 6. EXISTING IN FLOOR WIRIWAY PRESETS SHALL REMAIN.
- 7. THE EXISTING VOICE/DATA WITH RELATED CONDUIT AND CABLING ON THIS WALL SHALL BE REMOVED IN AREAS WHERE THE WALL WILL BE REMOVED. EXISTING RECEPTACLE SHALL REMAIN IF NOT BEING AFFECTED BY THE WALL REMOVAL. CONTINUE CIRCUIT CONTINUITY TO REMAINING DEVICES.
- 8. REINSTALL EXISTING 2 X 2 FIXTURE AND CONNECT AS SHOWN ON DRAWINGS.
- 9. EXTEND AND CONNECT TO EXISTING LIGHTING CIRCUIT FOR THIS AREA
- 10. PROVIDE AND INSTALL NEW WALL SWITCH WITH OCCUPANCY SENSOR. CONNECT TO EXISTING FIXTURE. SWITCH SHALL BE AS MANUFACTURED BY WATTSTOPPER #DW-100 OR APPROVED EQUAL
- 11. CONNECT NEW LIGHTING IN THIS TO THE EXISTING WALL SWITCH. EXTEND CONDUIT AND CONDUCTORS AS REQUIRED.
- 12. THE CONTRACTOR SHALL RELOCATE THE EXISTING FIRE ALARM DEVICES. REFER TO SPECIAL SYSTEM PLAN ON E102 FOR NEW LOCATION.
- 13. THE CONTRACTOR SHALL RELOCATE MOTION SENSOR. REFER TO SPECIAL SYSTEM PLAN ON E102 FOR NEW LOCATION.




For added scope, refer to Electrical Sketch, Exhibit Q, on sheet RS-2. Per Phase 1, Addendum #1

RECORD SET OF DRAWINGS


This set of drawings is provided by the Contractor as a schematic of the project in place. The Architect has not verified these conditions and is not responsible for conclusions drawn therefrom.

CHERRY/SEE/REAMES ARCHITECTS 4/13/2012



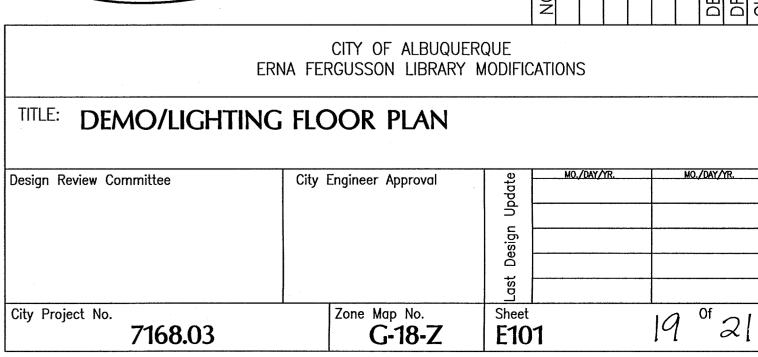



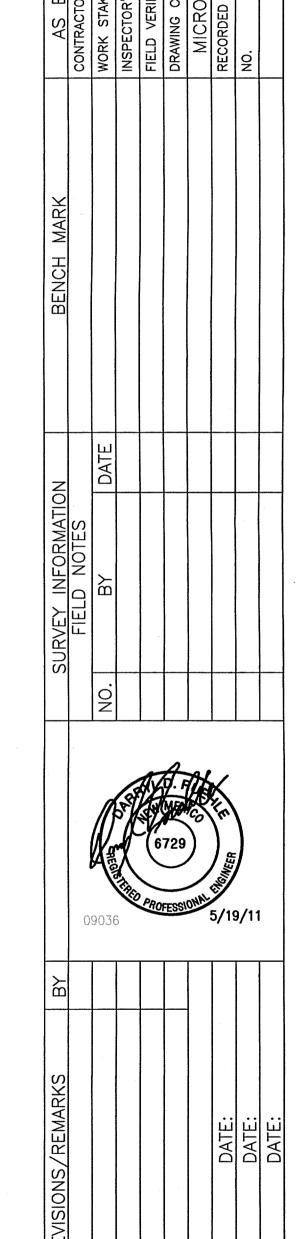


CHERRY/SEE/REAMES

ARCHITECTS, LLP

220 gold avenue sw albuquerque, nm 87102

505 - 842 - 1278 fax 505 - 766 - 9269

TION DATE: DATE: DATE: DATE:

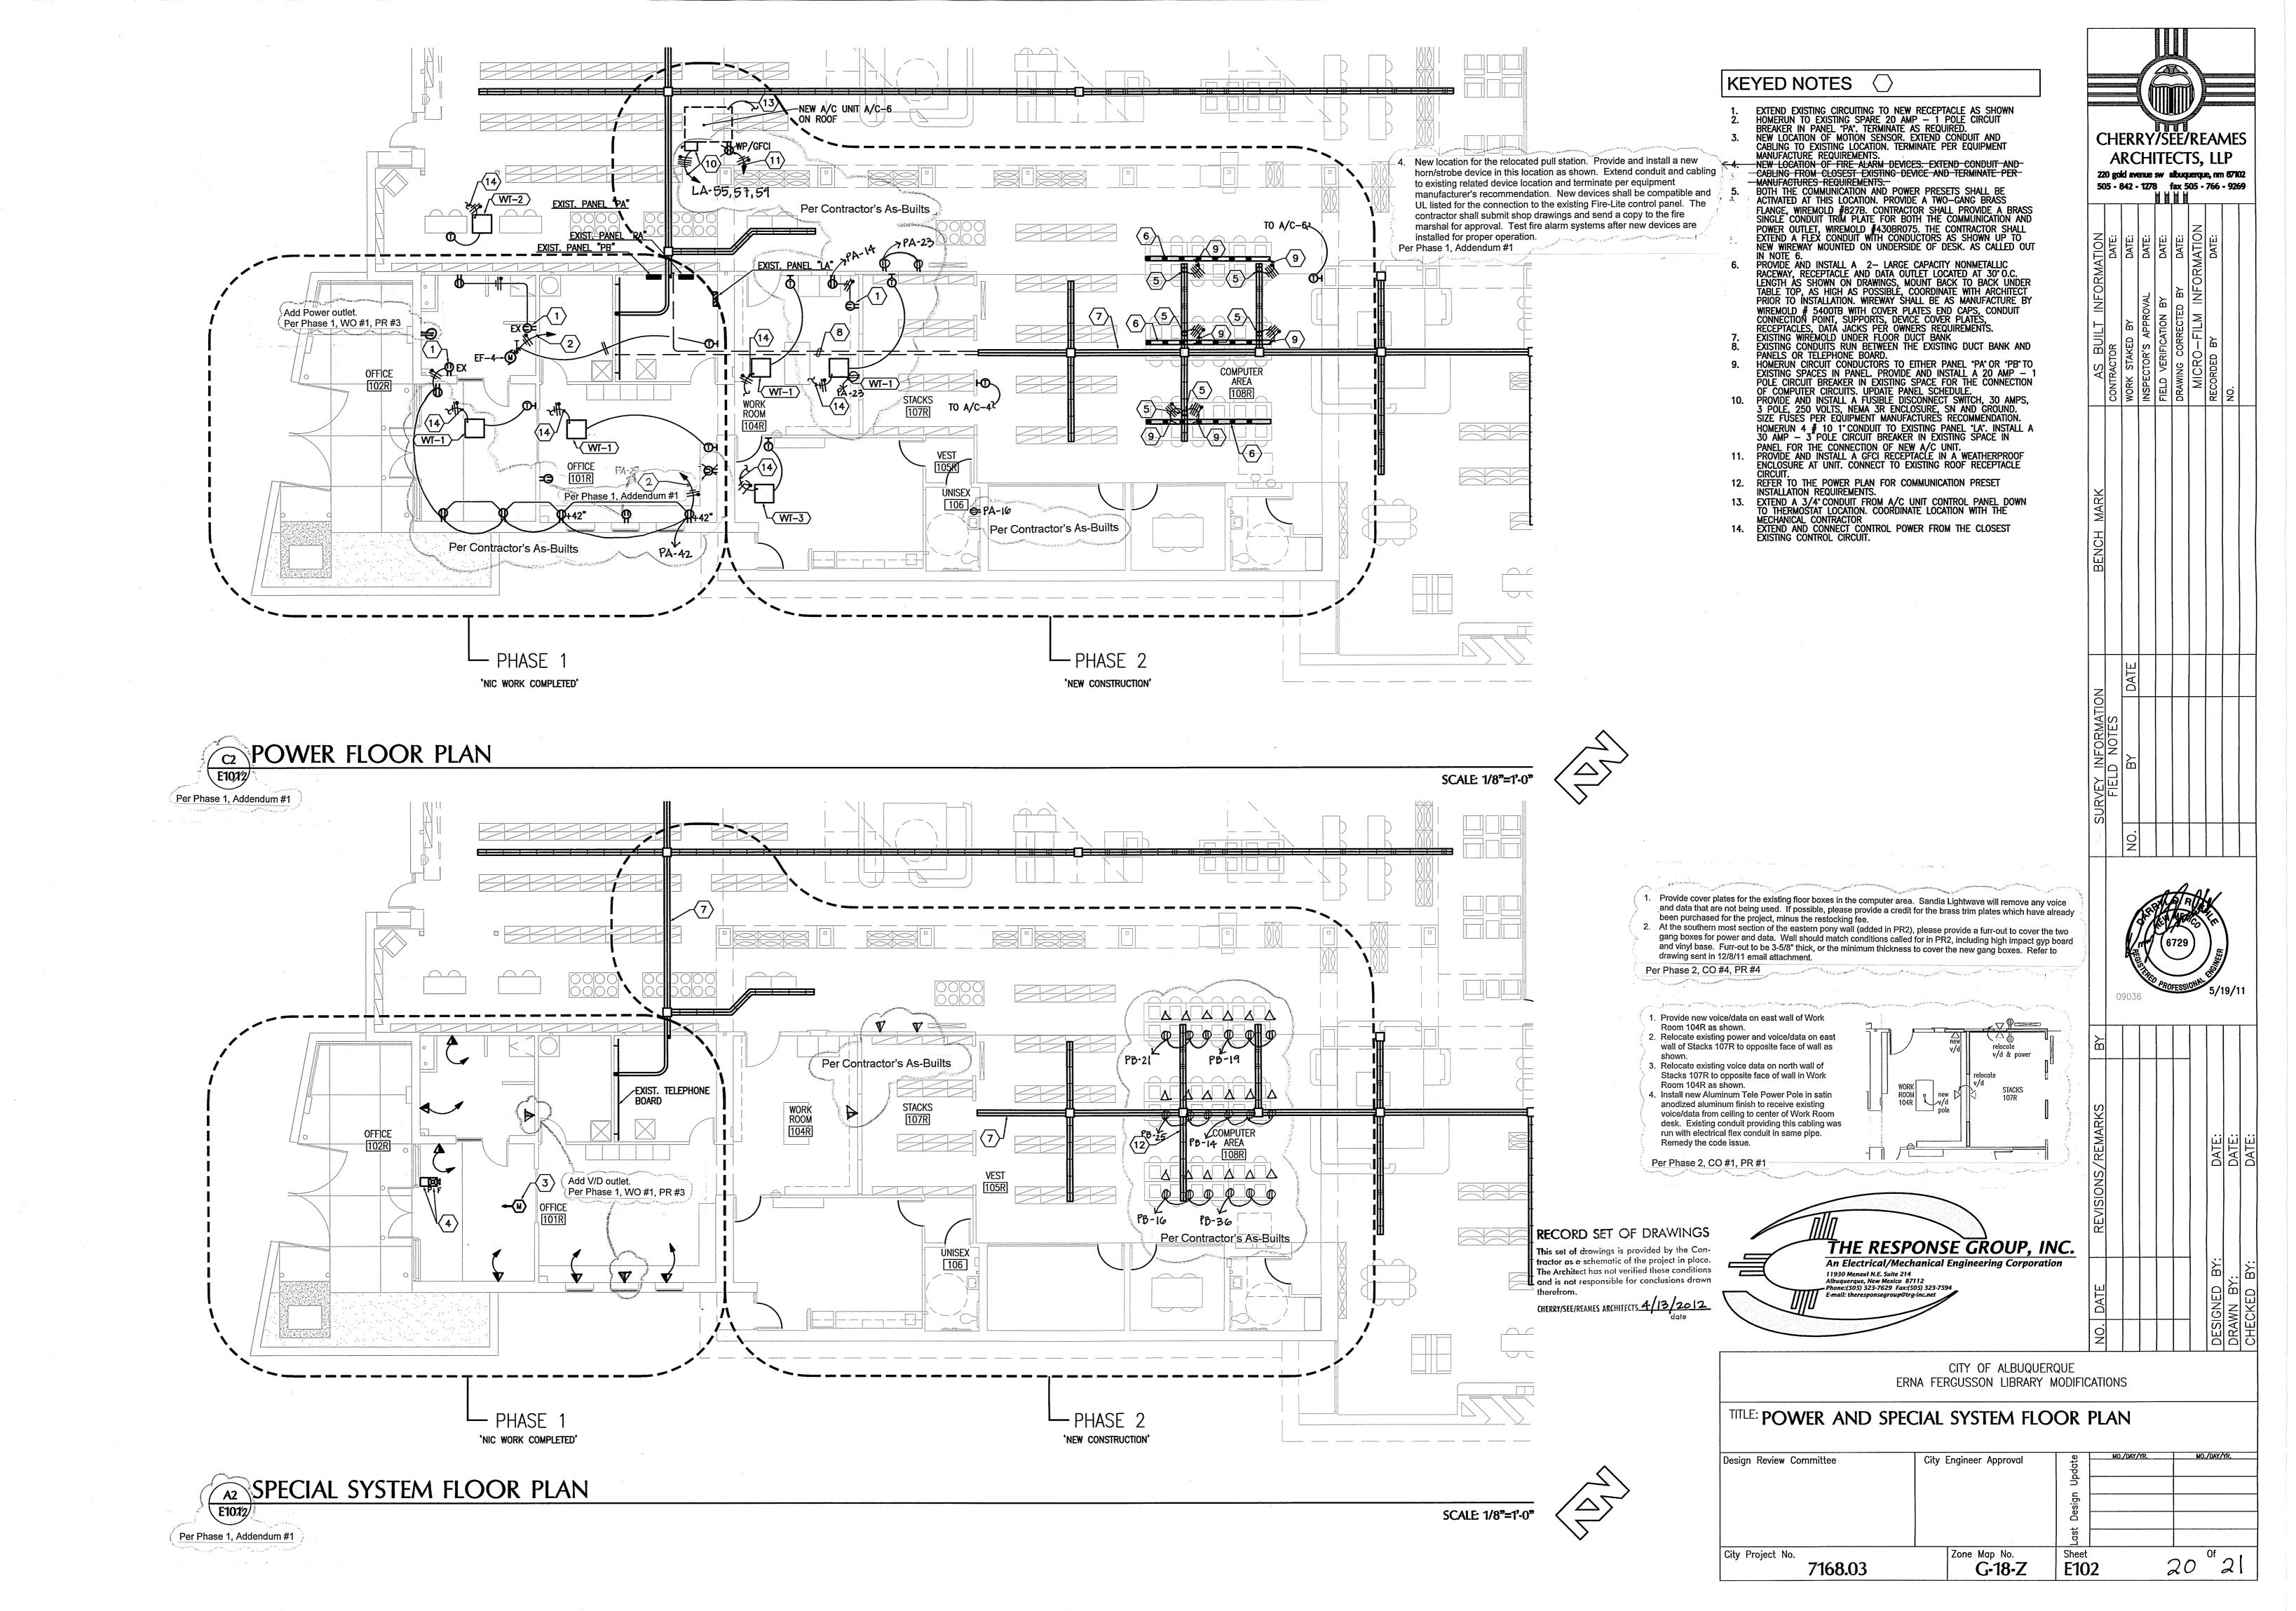

	T		laaz!		OVD (VV)		loo-l			
DESCRIPTION	BREAKER	LOAD (VA)	CCT NO.		OAD (VA) ØB		CCT NO.	LOAD (VA)	BREAKER	DESCRIPTION
LIGHTS	20A-1P	4340	1	7240			2	2900	20A-1P	LIGHTS
LIGHTS	20A-1P	3700	3		7100		4	3400	20A-1P	LIGHTS
LIGHTS	20A-1P	2600	5			6000	6	3400	20A-1P	LIGHTS
LIGHTS	20A-1P	2600	7	5200			8	2600.	20A-1P	LIGHTS
LIGHTS	20A-1P	2600	9		4300		10	1700	20A-1P	LIGHTS
LIGHTS	20A-1P	2250	11			5650	12	3400	20A-1P	LIGHTS
EXTERIOR LIGHTS	20A-1P	900	13	2140			14	1240	20A-1P	EXTERIOR LIGHTS
EXTERIOR LIGHTS	20A-1P	950	15		3550		16	2600	20A-1P	EXTERIOR LIGHTS
•	40A	8577	17			10877	18	2300	20A-1P	EXTERIOR LIGHTS
UNIT AC-1	//	8577	19	24347			20	15770	70A	1.
•	3P	8577	21		24347		22	15770	/	>UNIT AC−4
\$	40A	8577						15770	3P	
UNIT AC-2	//	8577	25				26	6114	30A	7
	3P	8577	27		14691		28	6114	/	>UNIT AC−5
EXTERIOR LIGHTS	20A-1P	665					****		3P	
	1 25A I	4675	31	5675			32	1000	20A-1P	LICUTS
UNIT AC-3	ZJA	4675			4675			1000	20A-1P	
ONIT AC-J	3P	4675	35		4073 (//////////////////////////////////////	76	м р	20A-1P	
SPARE	20A-1P	+0/3	37			4073 //////////	38	*	20A-1P	
SPARE	20A-1P		39				2	*	20A-1P	SPARE
SPARE	20A-1P	*	41	kifiliffiiffiffiffifiafii			42		20A-1P	SPARE
SPARE	20A-1P	,,,,,,,,,,,,,,,,,,,,,,,,,,,,,,,,,,,,,,	43				44	, ,	20A-1P	
SPARE	20A-1P		45				46		20A-1P	SPARE
SPARE	20A-1P	-	47	af folker			48	-	20A-1P	SPARE
SPACE ONLY	1P		<u> </u>	allala alalala la			50	3596		
~~~~~~~~~~~~~~~~~~~~~~~~~~~~~~~~~~~~~~	1P		51	3090	3596		52		20A	NEW A/C UNIT PROVIDE NEW 20A-3P
SPACE ONLY SPACE ONLY	1P		53		3390	7E06	54	3596	3P	CIRCUIT BREAKER
SPACE UNLI	40A	7920	55	4//////////////////////////////////////			56	10260	70A	OKOON BREAKEN
PANEL "PB"	I	5640		10100	12860					PANEL "PA"
FAIVLE FD S	3P	5220			mmmmmm	12240	- <del></del>	7020	3P	CLUISTE LY
*	V 25 1	3220	103			12270	1001	7020	] 3	U ·

DECORIOTON	BREAKER	LOAD (VA)	ССТ	L	OAD (VA)		ССТ	LOAD	BREAKER	DECODIDATAL	
DESCRIPTION	BKEAKEK	(VA)	NO.	ØΑ	øB	øС	NO.	LOAD (VA)	BREAKER	DESCRIPTION	
OUTLETS	20A-1P	1080	1	1980	1800		2	900	20A-1P	OUTLETS	
OUTLETS	20A-1P	900	3		1800		4	900	20A-1P	OUTLETS	
OUTLETS	20A-1P	900	5			1800	6	900	20A-1P	OUTLETS	
OUTLETS	20A-1P	1440	7	2520			8	1080	20A-1P	OUTLETS	
OUTLETS	20A-1P	540	9		1440		10	900	20A-1P	OUTLETS	
OUTLETS	20A-1P	900 .	11			1440	12	540	20A-1P	OUTLETS	
OUTLETS	20A-1P	1080	13	2160			14	1080	20A-1P	OUTLETS	
OUTLETS	20A-1P	1080	15				16	1080	20A-1P	OUTLETS	
OUTLETS	20A-1P	900	17			1980		1080	20A-1P	OUTLETS	sa personana andre de la companya de
OUTLETS	20A-1P	1080	19	1800			20	720	20A-1P	OUTLETS	-
OUTLETS	20A-1P	1080	21		1620		22	540	20A-1P	OUTLETS	in membrane de la company de l
OUTLETS	20A-1P	900	23			1800	24	900	20A-1P	OUTLETS	menta aprila a l'ara
OUTLETS	20A-1P	900	25	1800			26	900	20A-1P	EWC	merusa. Al-lu fusio
VVT BOXES	20A-1P	200	27		740		28	540	20A-1P	OUTLETS (ON ROOF)	ne granda indi
EXHAUST FAN EF-3	20A-1P	696	29			1196	30	500	20A-1P	AUTOMATIC DOORS	ia dika berbanasia
REFRIGERATOR	20A-1P	1000	31	1720				720	20A-1P	EXHAUST FAN EF-1	in the product of the
VENDING	20A-1P	1000	33		1720		34	720	20A-1P	EXHAUST FAN EF-2	el contra de la contra del la contra
MICROWAVE	20A-1P	1000	35			1500	36	500	20A-1P	IRRIGATION HOT BOX	vilage slabidate all
SPARE	20A-1P	*	37	500			38	500	20A-1P	SKYLIGHT - TOWER	A delia a lorge
SPARE	20A-1P	*	39		600		40	600	20A-1P	COMPUTERS	
SPARE	20A-1P	*	41			600	42	600	20A-1P	COMPUTERS	EVICTINO
SPARE	20A-1P		43	600			44	600	20A-1P	COMPUTERS	EXISTING CIRCUIT
SPARE	20A-1P	*	45		600		46	600	20A-1P	COMPUTERS	Oilloon
SPARE	20A-1P		47			600	48	600	20A-1P	COMPUTERS	)
COMPUTERS	20A-1P	600	49	1200			50	600	20A-1P	COMPUTERS	PROVIDE
COMPUTERS	20A-1P	600	51		600		52		1P	SPACE	20A-1P
COMPUTERS	20A-1P	600	53			600	54		1P	SPACE	BREAKER
COMPUTERS	20A-1P	600	55	600			56		1P	SPACE	Military many do
COMPUTERS	20A-1P	600	57		600		58		1P	SPACE	Voluntario de de la constante
COMPUTERS	20A-1P	600	59			600	60		1P.	SPACE	Management of the second of th

PROVIDE NEW-

BREAKERS

20A-1P CIRCUIT

ANEL: "PB" EX. PANEL OURCE: PANEL "LA"											santion are not the same of th
DESCRIPTION	BREAKER	LOAD (VA)	CCT NO.	ØA	OAD (VA) ØB		CCT NO.	LOAD (VA)	BREAKER	DESCRIPTION	analysevery design — extensive control
UTLETS	20A-1P	720	1	1440			2	720	20A-1P	OUTLETS	rational values and
UTLETS	20A-1P	720	3		1440		4	720	20A-1P	OUTLETS	age when the
UTLETS	20A-1P	720	5			1440	6	720	20A-1P	OUTLETS	
IRCULATION DESK	20A-1P	720	7	1440			8	800	20A-1P	FLOOR OUTLET	www.
RCULATION DESK	20A-1P	720	9		1320		10	600	20A-1P	FLOOR OUTLET	Several Metal Park
RCULATION DESK	20A-1P	720	11			1520	12	800	20A-1P	FLOOR OUTLET	A PART OF THE PART
RCULATION DESK	20A-1P	720	13	1440			14	720	20A-1P	FLOOR OUTLET	
RCULATION DESK	20A-1P	720	115		1440 ₺		16	720	20A-1P	FLOOR OUTLET	
RCULATION DESK	20A-1P	720	17			1440	18	720	20A-1P	DESK	Tribution and the second secon
LOOR OUTLET	20A-1P	720	19	1440			20	720	20A-1P	DESK	- Anna Anna Anna Anna Anna Anna Anna Ann
LOOR OUTLET	20A-1P	720	21		1440 🛭		22	720	20A-1P	DESK	
LOOR OUTLET	20A-1P	720	23			820	24	100	20A-1P	EAS PANEL	The state of the s
LOOR OUTLET	20A-1P	720	25	1320			26	600	20A-1P	COMPUTERS	<b>)</b>
LOOR OUTLET	20A-1P	720	27.		1320		28	600	20A-1P	COMPUTERS	CVICTIMO
LOOR OUTLET	20A-1P	720	29			1320	30	600	20A-1P	COMPUTERS	EXISTING CIRCUIT
COLUMN OUTLET	20A-1P	360	31	960			32	600	20A-1P	COMPUTERS	O.KOON
COLUMN OUTLET	20A-1P	360	33		960		34	600	20A-1P	COMPUTERS	J
PARE	20A-1P	я	35			600		600	20A-1P	COMPUTERS	PROVIDE
PARE	20A-1P	*	37				38		1P	SPACE ONLY	20A-1P
PARE	20A-1P	•	39				40		1P	SPACE ONLY	BREAKER
PARE	20A-1P	•	41				42	•	1P	SPACE ONLY	P

SYMBOL DESCRIPTION  O CEILING OUTLET AND RECESSED FIXTURE  HO WALL OUTLET AND RECESSED FIXTURE	
WALL OUTLET AND RECESSED FIXTURE	
POLE MOUNTED FIXTURE	
FLUORESCENT OUTLET AND FIXTURE	
SINGLE FACED EXIT SIGN WITH ARROWS AS	INDICATED
SINGLE POLE SWITCH, FLUSH MOUNTED 48'	A.F.F.
THERMAL SWITCH, WEATHERPROOF IF INSTAL	led outside
DUPLEX CONVENIENCE OUTLET, 18" A.F.F.	
(FLUSH MOUNTED LOCKING BOX)	ET, 18" A.F.F. BOX AND DEVICE SEYMOUR #1591-F46 (DEVICE) AND #4600
DUPLEX CONVENIENCE OUTLET, GROUND FA	JLT CIRCUIT INTERRUPTER, 18" A.F.F.
QUADPLEX CONVENIENCE OUTLET, 18" A.F.F	
JUNCTION BOX INSTALLED ABOVE THE CEILI TO LAY-IN FIXTURES. MAXIMUM 4'-0" LEN CONDUCTORS ALONG WITH GREEN GROUND	IGTH OF CONDUIT, WITH REQUIRED
JUNCTION BOX FLUSH IN WALL, HEIGHT AS CONNECTION TO EQUIPMENT	INDICATED ON DRAWINGS, WITH
CONCEALED BRANCH CIRCUIT WITH CONDUCTION SWITCH LEG AND GROUND, RESPECTIVELY	TORS AS INDICATED. NEUTRAL, HOT,
BRANCH CIRCUIT OR CONDUIT INSTALLED U	NDERGROUND OR UNDER FLOOR
$\left  - \right  = \frac{P^2 - 2.4}{4}$ HOMERUN TO PANELBOARD WITH BRANCH (	IRCUIT NUMBERS INDICATED
VOICE/DATA OUTLET, 2 GANG BOX WITH SIN 1" CONDUIT WITH PULLCORD TO TELEPHON	
VOICE/DATA OUTLET, 2 GANG BOX WITH SINT 1" CONDUIT WITH PULLCORD STUBBED INTO	IGLE GANG MUD RING, 18" A.F.F ACCESSIBLE CEILING SPACE
VOICE/DATA OUTLET, RESPECTIVELY, FLUSH PULLCORD TO TELEPHONE OR DATA TERMIN	
TV OUTLET BOX, 2 GANG BOX WITH SINGLE 3/4" CONDUIT WITH PULLCORD STUBBED IN	
FIRE ALARM MANUAL PULL STATION, 48" A.	F.F.
Fire Alarm Audio/Visual Device 80" A.F.	<del>.</del>
FIRE ALARM VISUAL DEVICE 80" A.F.F.	
FIRE ALARM SMOKE DETECTOR, PHOTOELEC	RIC TYPE
FIRE ALARM DUCT SMOKE DETECTOR	
FIRE ALARM HEAT DETECTOR	

CIRCUIT BREAKERS

LIGHT FIXTURE SCHEDULE LAMPS MOUNTING FIXTURE DESCRIPTION 2'X2' RECESSED PARABOLIC FLUORESCENT FIXTURE, SILVER 2-FU32T8 RECESSED LOUVERS, 9 CELL, SEMI-SPECULAR HAZE LOUVER FINISH, ELECTRONIC BALLAST 3500°K T-GRID METALUX #2EP3GX-2U6T8S33I-277-EB81 2'x4' FLUORESCENT STATIC TROFFER, 0.125" ACRYLIC LENS, ELECTRONIC BALLAST 2-F32T8 RECESSED 3500°K T-GRID METALUX #2GC-232-A125-277-EB81 RECESSED DOWNLIGHT 1-18 WATT PL 1-18W RECESSED PORTFOLIO #C6118-6251-LI-WF EXIT SIGN, LED, SELF-POWERED, NICKEL CALCIUM BATTERY, UNIVERSAL DIECAST HOUSING, GREEN LETTERS, WHITE FINISH WITH SURE-LITES #CAX-7-1-70-00-G-W EDGELIT EXIT SIGN, LED, SELF POWERED, NICKEL CADMIUM BATTERY, WHITE FINISH, GREEN LETTERS, CLEAR BACKGROUND WITH RECESSED UNIT CEILING SURE-LITES #ELX-7-1-70-WH-G-120/277-C

**ELECTRICAL SYMBOL LEGEND** 

MOTOR CONNECTION FOR FRACTIONAL HP MOTOR (1/3 HP OR LESS). PROVIDE

3/4" PLYWOOD TELEPHONE BACKBOARD WITH TWO COATS OF GRAY INSULATING PAINT

INTRUSION ALARM MOTION SENSOR, ARROW INDICATES DIRECTION, OWNER FURNISHED.

2-GANG BOX WITH SINGLE GANG MUD RING. 1" CONDUIT WITH PULLCORD STUBBED

INTRUSION ALARM MOTION SENSOR, ARROW INDICATES DIRECTION, OWNER FURNISHED. 2-GANG BOX WITH SINGLE GANG MUD RING. 1" CONDUIT WITH PULLCORD BACK TO

KEYED, OWNER FURNISHED, 2-GANG BOX WITH SINGLE GANG MUD RING, 48" A.F.F.

1" CONDUIT WITH PULLCORD STUBBED INTO ACCESSIBLE CEILING SPACE

NOTES: · LIGHTING FIXTURES ARE OF TYPE AS INDICATED ON LIGHT FIXTURE SCHEDULE U.N.O.

· ANY SPECIFIC DETAILS ABOVE (MOUNTING HEIGHTS, PART NUMBERS, CONNECTION METHODS, ETC) MAY BE MODIFIED OR REPLACED BY INFORMATION ON PLANS,

SCHEDULES, DETAILS, RISERS, ETC. DETAILS NOT SPECIFICALLY MODIFIED REMAIN AS

·ALL MOUNTING HEIGHTS ARE TO CENTERLINE OF DEVICE U.N.O.

THERMAL OVERLOAD SWITCH (WEATHERPROOF IF OUTSIDE) ADJACENT TO MOTOR

FUSED DISCONNECT SWITCH, FUSE, POLES AND RATING AS INDICATED OR AS REQUIRED, NEMA 3R IF INSTALLED OUTSIDE

UNLESS SWITCH IS SHOWN ELSEWHERE ON PLANS

TRANSFORMER, DRY TYPE, SIZE AS INDICATED

120V PANELBOARD, REFER TO PANEL SCHEDULE

277V PANELBOARD, REFER TO PANEL SCHEDULE

MECHANICAL (FURNISHED UNDER DIVISION 15)

SPECIAL PURPOSE CABINET, AS INDICATED ON DRAWINGS

SYMBOL DESCRIPTION

MECHANICAL UNIT

THERMOSTAT, 48" A.F.F.

INTO ACCESSIBLE CEILING SPACE

WEATHERPROOF (NEMA 3R)

ABOVE FINISHED FLOOR

ABOVE FINISHED GRADE

FIRE ALARM CONTROL PANEL

NOT IN CONTRACT

NOT TO SCALE

GIVEN ABOVE.

(RTU-1)


#### ELECTRICAL SPECIFICATIONS

- THE ELECTRICAL CONTRACTOR SHALL PROVIDE AND INSTALL ALL ELECTRICAL FACILITIES IN ACCORDANCE WITH THE FOLLOWING SPECIFICATIONS, PLANS AND ASSOCIATED NOTES, NATIONAL ELECTRICAL CODE, STATE AND LOCAL CODES AND IN A NEAT AND WORKMANLIKE MANNER.
- CONTRACTOR SHALL BECOME FAMILIAR WITH EXISTING CONDITIONS AT THE JOB SITE.
- THE ELECTRICAL CONTRACTOR SHALL INSTALL ALL THERMOSTATS, CONTROLS AND MAKE REQUIRED CONNECTIONS TO EQUIPMENT FURNISHED BY OTHERS.
- THE ELECTRICAL CONTRACTOR SHALL INCLUDE IN HIS BID THE COST OF ALL PERMITS, TESTS AND INSPECTIONS, AND VISIT THE SITE OF WORK PRIOR TO SUBMITTING BID.
- THE ELECTRICAL CONTRACTOR SHALL COORDINATE HIS WORK WITH ALL OTHER TRADES AND REFER TO ARCHITECTURAL PLANS FOR DETERMINING THE EXACT LOCATION OF OUTLETS.
- THE ELECTRICAL CONTRACTOR SHALL GUARANTEE ALL WORK AND MATERIAL FOR A PERIOD OF ONE YEAR AFTER DATE OF ACCEPTANCE.
- A SET OF MARKED UP PRINTS SHALL BE PREPARED SHOWING ALL CHANGES MADE DURING CONSTRUCTION AND TURN IT OVER TO THE OWNER AT THE END OF THE CONSTRUCTION. ALL CHANGES MUST HAVE THE
- ANY DISCREPANCY BETWEEN MATERIAL DESCRIPTION AND CATALOG NUMBER SHALL BE BROUGHT TO THE ARCHITECT'S, ENGINEER'S OR OWNER'S ATTENTION IMMEDIATELY.
- CONTRACTOR SHALL SUBMIT SHOP DRAWINGS OR CATALOG CUT SHEETS ON ALL LIGHTING FIXTURES WHICH MAY BE SUBSTITUTED FROM THAT SPECIFIED IN CONTRACT DOCUMENTS.
- INTERRUPTION OF ANY ELECTRICAL SERVICES SHALL BE COORDINATED WITH THE OWNER AT LEAST 7 DAYS PRIOR TO THE INTENDED OUTAGE AND SHALL BE REQUESTED IN WRITING WITH A COPY TO THE ARCHITECT
- CONTRACTOR SHALL OBTAIN FROM THE ARCHITECT PRIOR TO COMMENCEMENT OF WORK, THE EXISTING PLANS WHICH INDICATE THE APPROXIMATE ELECTRICAL LAYOUT OF LIGHTING FIXTURES, OUTLETS, CONDUIT, WIRING, CIRCUITS, ETC.
- ALL CONDUCTORS TO BE #12 AWG TW UNLESS NOTED OTHERWISE. IT IS PERMISSIBLE FOR THE CONTRACTOR TO USE THHN WIRING IN EXISTING CONDUITS.
- M. 120 VOLT BRANCH CIRCUIT RUNS WHICH EXCEED ONE HUNDRED FEET IN LENGTH SHALL BE #10 TW.
- PROVIDE SEPARATE COLOR CODING FOR 120/208V-3ø-4W, 240V-3ø-4W AND 277/480V-3ø-4W CIRCUITS. MAINTAIN SAME COLOR CODING THROUGHOUT.
- FIXTURES SHALL BE PROVIDED WITH ELECTRONIC BALLAST. CONDUITS SHALL BE ROUTED CONCEALED WHERE POSSIBLE IN FLOORS, WALLS, OR CEILINGS IN A NEAT
- CONDUITS RUN EXPOSED ON CEILING OR WALLS SHALL BE DONE IN A NEAT AND WORKMANLIKE MANNER,
- MAKING ALL RUNS STRAIGHT AT PARALLEL OR PERPENDICULAR ANGLES TO BUILDING STRUCTURE.
- ALL CONDUITS WHICH COME IN CONTACT WITH EARTH SHALL BE WRAPPED IN SCOTCH WRAP #51 OR PLASTIC COATED. ALL FEEDERS AND HOMERUNS SHALL BE 1" MINIMUM.
- ANY EXPOSED WIREMOLD, CONDUITS, BOXES, ETC., SHALL BE PAINTED TO MATCH WALL FINISH THAT IT IS installed on.
- T. ALL DUPLEX RECEPTACLES SHALL BE HUBBELL #5262-NORY.
- ALL COVERPLATES SHALL BE STAINLESS STEEL.

CHERRY/SEE/REAMES ARCHITECTS 4/13/2012

AND WORKMANLIKE MANNER.

- V. ALL PULLBOXES SHALL BE CODE GA. AND MEET THE MINIMUM SIZES AS RECOMMENDED BY THE N.E.C.
- W. PANELBOARDS SHALL HAVE A CIRCUIT BREAKER RATED PER THE EXISTING PANELBOARD REQUIREMENTS.
- X. FURNISH AND INSTALL ALL CHANNELS REQUIRED FOR THE SUPPORT OF RECESSED AND SURFACE FLUORESCENT AND INCANDESCENT LIGHTING FIXTURES.
- PRIOR TO INSTALLATION OF NEW AND RELOCATED LIGHTING FIXTURES, THE CONTRACTOR SHALL REMOVE THE CEILING TILES IN EACH LOCATION WHERE THE LIGHTING FIXTURES ARE INDICATED TO BE INSTALLED. IF A CONFLICT IS ENCOUNTERED AT ANY OF THE LOCATIONS, THE CONTRACTOR SHALL IMMEDIATELY INFORM THE ARCHITECT AND OWNER OF THE PROBLEM. THIS MAY REQUIRE THE SHIFTING OF ONE OR TWO COMPLETE ROWS OF FIXTURES FROM THE LOCATIONS INDICATED ON THE DRAWINGS.
- Z. EXISTING LIGHTING FIXTURES, JUNCTION BOXES, CONDUIT, POWER AND TELEPHONE RECEPTACLES THAT ARE Indicated on the plan either dashed or with the letters "ex" indicated on or near the item OF EQUIPMENT, ETC.
- AA. IT IS INTENDED FOR THE CONTRACTOR TO REUSE THE EXISTING CONDUIT SYSTEMS WITHIN THE BUILDING WHERE POSSIBLE AND FEASIBLE. WIRING SHALL BE REPLACED WHERE NEW WORK IS BEING PERFORMED. WIRING INDICATED ON PLANS IN EXISTING CONDUIT RUNS IS NEW.
- AB. IN ALL CONDUIT WHERE EXISTING CIRCUITS ARE AFFECTED BY THE REMOVAL OF CONDUIT, WIRING, RECEPTACLES OR LIGHTING FIXTURES, THE BLOCKING OUT OF EXISTING OUTLET BOXES, ETC., AND THE CIRCUIT IS STILL REQUIRED TO FEED OTHER OUTLETS, ETC., WHICH ARE TO REMAIN, THE ELECTRICAL CONTRACTOR SHALL REFEED AS REQUIRED THE ITEMS OF EQUIPMENT WHICH ARE TO REMAIN IN SERVICE AFTER THE COMPLETION OF THE REMODEL AT NO ADDITIONAL COST TO THE OWNER.
- AC. IT MAY BECOME NECESSARY FOR THE ELECTRICAL CONTRACTOR TO RELOCATE EXISTING CONDUIT, CHANNELS, AND OTHER SUPPORTS WHICH MAY PARTIALLY CONFLICT WITH SOME OF THE NEW OR RELOCATED RECESSED LIGHTING FIXTURES. CONTRACTOR SHALL RELOCATE THESE ITEMS AT NO ADDITIONAL COST TO THE OWNER.
- AD. CONTRACTOR SHALL REMOVE EXISTING PANELBOARD DIRECTORIES FROM PANELBOARDS AND REPLACE WITH NEW. CONTRACTOR SHALL TRACE OUT ALL CIRCUITS IN EACH OF THE ABOVE PANELBOARDS AND PROVIDE THE CORRECTED INFORMATION ON THE NEW TYPEWRITTEN PANELBOARD DIRECTORIES.
- AE. REMOVE EXISTING 1x4, 2x2 AND 2x4 FLUORESCENT FIXTURES WITHIN PROJECT AREA. CONTRACTOR SHALL CHECK EXISTING FIXTURE WIRING AND BALLASTS AND REPAIR OR REPLACE AS REQUIRED FOR PROPER FIXTURE OPERATION. RELAMP FIXTURES WITH NEW LAMPS. CLEAN AND WASH FIXTURE HOUSING AND LENSES. REINSTALL FIXTURES AT NEW LOCATIONS AS INDICATED ON DRAWINGS.

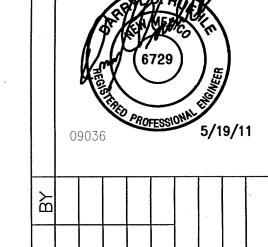

| | | | |

CHERRY/SEE/REAMES

ARCHITECTS, LLP

220 gold avenue sw albuquerque, nm 87102

505 - 842 - 1278 fax 505 - 766 - 9269


DATE:
DATE:
THE RESPONSE GROUP, INC.  An Electrical/Mechanical Engineering Corporation
11930 Menaul N.E. Suite 214 Albuquerque, New Mexico 87112 Phone:(505) 323-7629 Fax:(505) 323-7594 E-mail: theresponsegroup@trg-inc.net

•
-II-
THE RESPONSE GROUP, INC.
An Electrical/Mechanical Engineering Corporation 11930 Menaul N.E. Suite 214
Albuquerque, New Mexico 87112 Phone:(505) 323-7629 Fax:(505) 323-7594 E-mail: theresponsegroup@trg-inc.net

ERI	CITY OF ALBUQUERQUE ERNA FERGUSSON LIBRARY MODIFICATIONS									
LE: ELECTRICAL LEGEN	nd and fixture	SCHE	DULE							
gn Review Committee	City Engineer Approval	Last Design Update	MO./DAY/YR.	MQ./DAY/YR.						
Project No. <b>7168.03</b>	Zone Map No. <b>G-18-Z</b>	Sheet E501		21 0 21						

RECORD SET OF DRAWINGS This set of drawings is provided by the Contractor as a schematic of the project in place. The Architect has not verified these conditions and is not responsible for conclusions drawn

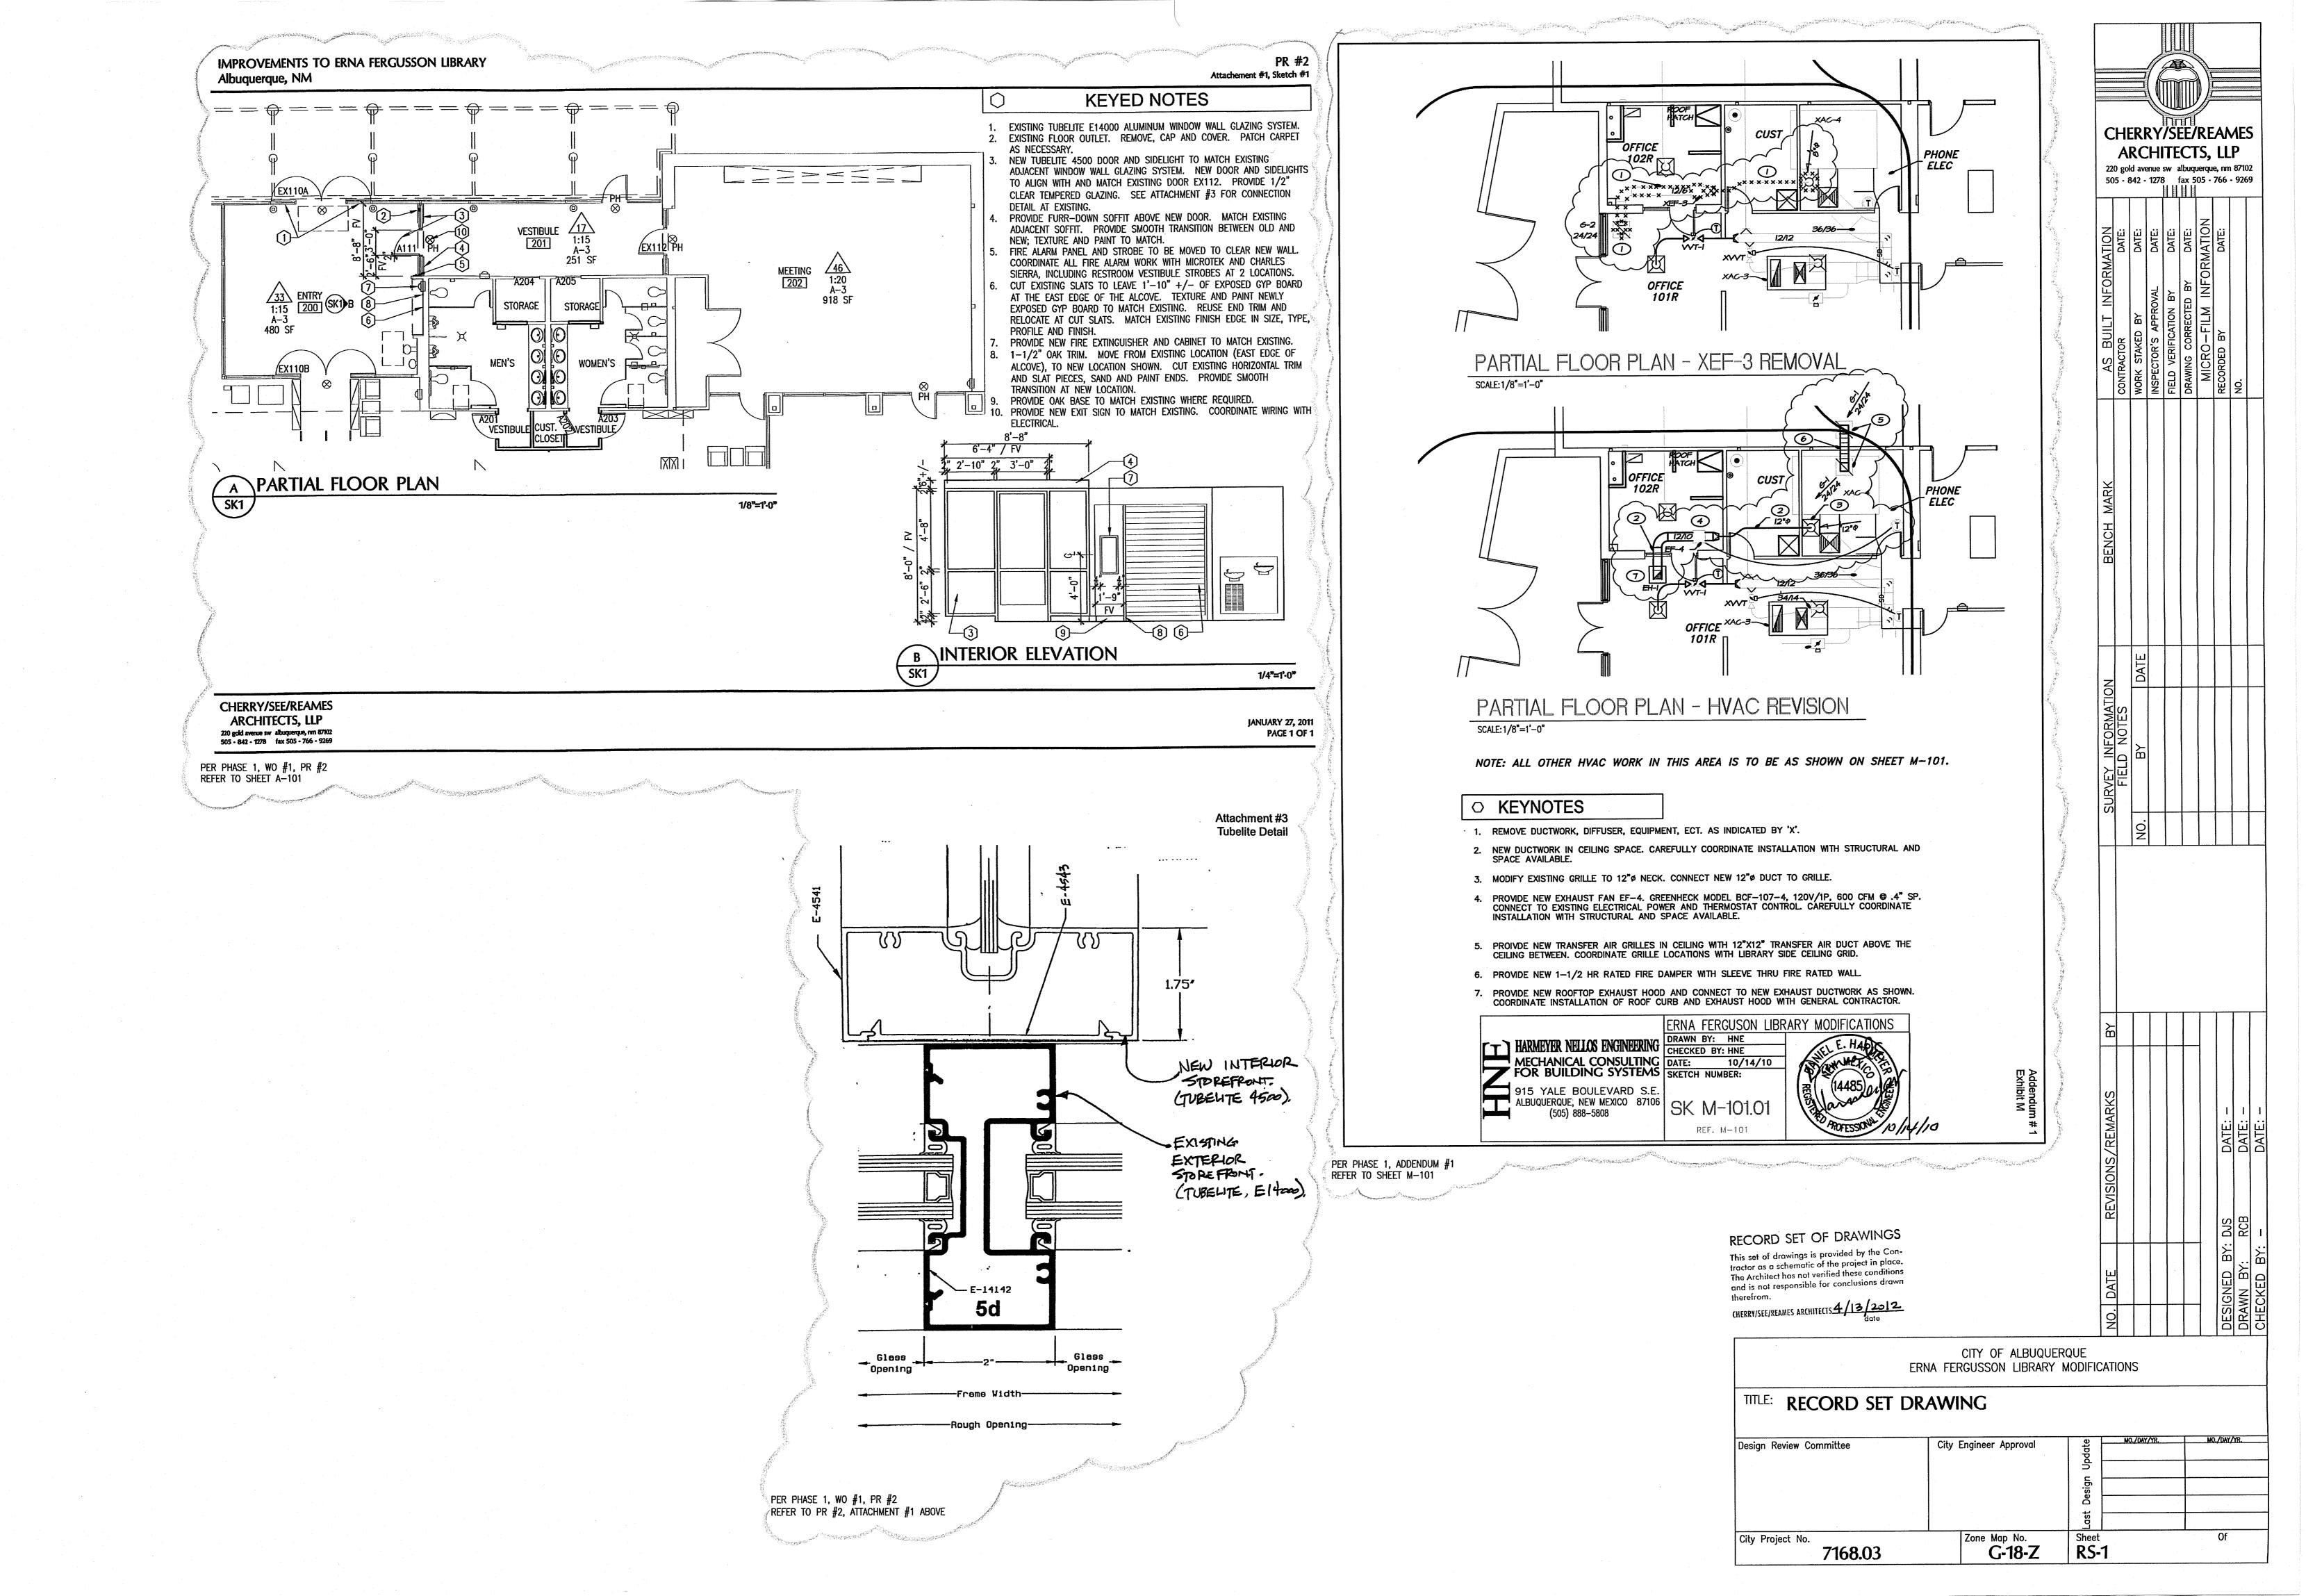

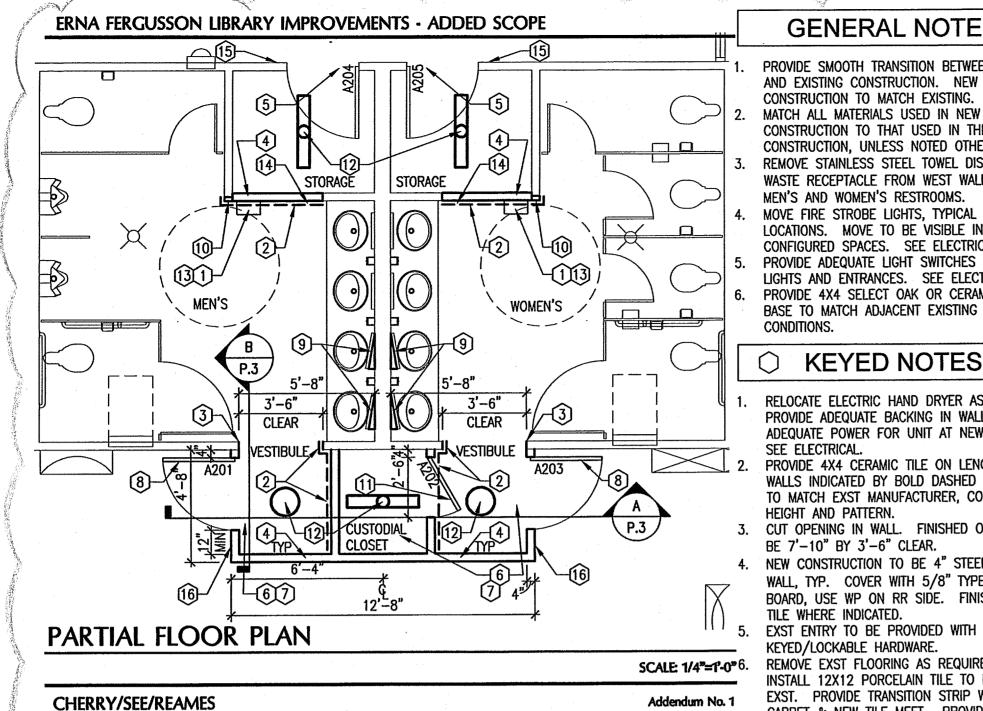

#### **GENERAL NOTES**

PROVIDE SMOOTH TRANSITION BETWEEN NEW AND EXISTING CONSTRUCTION. NEW CONSTRUCTION TO MATCH EXISTING. MATCH ALL MATERIALS USED IN NEW CONSTRUCTION TO THAT USED IN THE EXISTING CONSTRUCTION, UNLESS NOTED OTHERWISE. REMOVE STAINLESS STEEL TOWEL DISPENSER WASTE RECEPTACLE FROM WEST WALL OF MEN'S AND WOMEN'S RESTROOMS. MOVE FIRE STROBE LIGHTS, TYPICAL AT 2 LOCATIONS. MOVE TO BE VISIBLE IN NEWLY CONFIGURED SPACES. SEE ELECTRICAL. PROVIDE ADEQUATE LIGHT SWITCHES FOR NEW LIGHTS AND ENTRANCES. SEE ELECTRICAL. PROVIDE 4X4 SELECT OAK OR CERAMIC COVE

#### **KEYED NOTES**

RELOCATE ELECTRIC HAND DRYER AS SHOWN. PROVIDE ADEQUATE BACKING IN WALL AND ADEQUATE POWER FOR UNIT AT NEW LOCATION. SEE ELECTRICAL. PROVIDE 4X4 CERAMIC TILE ON LENGTH OF WALLS INDICATED BY BOLD DASHED LINE. TILE TO MATCH EXST MANUFACTURER, COLOR, HEIGHT AND PATTERN. 3. CUT OPENING IN WALL. FINISHED OPENING TO BE 7'-10" BY 3'-6" CLEAR. 4. NEW CONSTRUCTION TO BE 4" STEEL STUD WALL, TYP. COVER WITH 5/8" TYPE 'X' GYP BOARD, USE WP ON RR SIDE. FINISH WITH TILE WHERE INDICATED. FXST ENTRY TO BE PROVIDED WITH NEW KEYED/LOCKABLE HARDWARE. REMOVE EXST FLOORING AS REQUIRED. INSTALL 12X12 PORCELAIN TILE TO MATCH EXST. PROVIDE TRANSITION STRIP WHERE EXST CARPET & NEW TILE MEET. PROVIDE SMOOTH TRANSITION @ NEW & EXST FLOORS.

#### ERNA FERGUSSON LIBRARY IMPROVEMENTS - ADDED SCOPE

#### ○ KEYED NOTES, CONT.


#### CONTINUED FROM PAGE 1

7. CEILING TO BE 5/8" TYPE 'X' WP GYP BOARD TO MATCH EXST. PAINT TO MATCH. PROVIDE SMOOTH TRANSITION @ NEW & EXST CEILINGS.


- 8. PROVIDE 3'-0" X 7'-10" WOOD DOOR IN A HM FRAME TO MATCH EXST. PROVIDE DOOR HARDWARE TO MATCH
- 9. ROTATE MIRRORS SO THEY ARE HUNG AT A 10' ANGLE TO WALL AS SHOWN. PROVIDE PROPER BACKING AND
- SECURE MIRRORS TO WALL. ANGULAR FURRED-OUT PIECE OF WALL TO MATCH ADJACENT SURFACES. 10. FURR-OUT WALL TO BE LEVEL WITH OPPOSITE WALL
- BY SINKS. REMOVE TILE FROM END OF EXISTING WALL AS NECESSARY TO ENCLOSE EXISTING OPENING. 11. PROVIDE NEW LOCKING 2'-6" X 7'-0" WOOD DOOR IN
- 12. PROVIDE NEW LIGHT FIXTURE AT 5 LOCATIONS. SEE ELECTRICAL.
- 13. PROVIDE 2' WIDE STAINLESS STEEL PANEL. PANEL IS TO RUN FROM DIRECTLY BELOW THE RELOCATED HAND DRYER TO THE FLOOR.
- 14. REMOVE AND REPLACE FLOORING AS NEEDED FOR NEW WALL INSTALLATION.
- 15. REMOVE MEN'S OR WOMEN'S RR SIGNS. SIGNS TO BE REUSED IN PROJECT. REPAIR WALL BENEATH TO MATCH EXISTING ADJACENT FINISHES.
- 16. INSTALL REMOVED RR SIGNS FROM NOTE 15. INSTALL IN NEW LOCATIONS INDICATED.

CHERRY/SEE/REAMES Addendum No. 1 Exhibit R OCTOBER 20, 2010 PAGE A2 OF 3

#### ERNA FERGUSSON LIBRARY IMPROVEMENTS - ADDED SCOPE

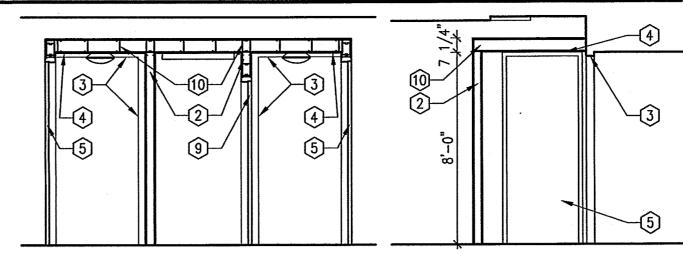

SECTION B

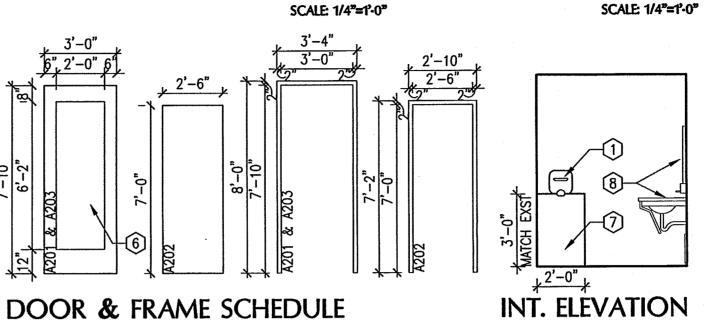

SCALE: 1/4"=1'-0"

SCALE: 1/4"=1'-0" Addendum No. 1 8. EXST LAVATORY EQUIPMENT TO REMAIN. OCTOBER 20, 2010

#### **GENERAL NOTES**

- PROVIDE SMOOTH TRANSITION BETWEEN NEW AND EXISTING CONSTRUCTION. NEW CONSTRUCTION TO MATCH EXISTING. MATCH ALL MATERIALS USED IN NEW
- CONSTRUCTION TO THAT USED IN THE EXISTING CONSTRUCTION. MOVE FIRE STROBE LIGHTS, TYP, (AT 3
- LOCATIONS). MOVE TO BE VISIBLE IN NEWLY CONFIGURED SPACES. SEE ELEC. 4. PROVIDE ADEQUATE LIGHT SWITCHES FOR
- NEW LIGHTS AND ENTRANCES. SEE ELEC PROVIDE 4X4 SELECT OAK OR CERAMIC COVE BASE TO MATCH ADJACENT EXISTING

#### ○ KEYED NOTES

RELOCATE ELECTRIC HAND DRYER AS SHOWN. PROVIDE ADEQUATE BACKING IN WALL AND ADEQUATE POWER FOR UNIT AT NEW LOCATION. SEE ELECTRICAL

- 2X4 STEEL STUD CONSTRUCTION @ 16" OC AT NEW WALLS, COVERED ON EA. SIDE WITH 5/8" TYPE 'X' WP GYP BOARD, UNLESS NOTED OTHERWISE.
- CUT OPENING IN WALL. FINISHED OPENING TO BE 7'-10" X 3'-6" CLEAR. CEILING HEIGHT IN NEW VESTIBULES TO BE 8'-0" AFF TO MATCH EXISTING CEILING HEIGHT IN RESTROOMS. FIELD VERIFY. PROVIDE NEW 3'-0" x 7'-10" WOOD DOOR IN A HM FRAME TO MATCH EXST. PROVIDE DOOR HARDWARE TO MATCH EXST. PROVIDE 1/4" FROSTED LAMINATED SAFETY GLAZING IN NEW DOOR AS SHOWN. PROVIDE 2' WIDE STAINLESS STEEL PANEL. PANEL IS TO RUN FROM DIRECTLY BELOW THE RELOCATED HAND DRYER TO THE FLOOR.

9. PROVIDE NEW LOCKING 2'-6" X 7'-0" WOOD DOOR IN HM FRAME. PAGE A3 OF 3 10. 20GA FRAMING AT NEW CEILINGS.

PER PHASE 1, ADDENDUM #1 SCOPE ADDED TO PROJECT, REFER TO A601

CHERRY/SEE/REAMES

ARCHITECTS, LLP

220 gold avenue sw albuquerque, nm 87102

505 - 842 - 1278 fax 505 - 766 - 9269

**SECTION A** 

ERNA FERGUSSON LIBRARY IMPROVEMENTS - ADDED SCOPE

#### KEYED NOTES

- 1. PROVIDE AND INSTALL A SURFACE MOUNTED 26 WATT, 277 VOLT PL LIGHTING FIXTURE. MOUNT EMERGENCY BALLAST IN CUSTODIAL CLOSET. FIXTURE SHALL BE AS MANUFACTURED BY SHAPER # 213-CFL/1/26-277-MW-REM.
- 2. PROVIDE AND INSTALL A 3'-0" SURFACE MOUNTED, 1 LAMP, STRIP FIXTURE WITH WIRE GUARD. FIXTURE SHALL BE AS MANUFACTURED BY METALUX # 3SN-125-277-EB81- WITH WIRE GUARD.
- 3. EXTEND AND CONNECT TO UNSWITCHED 277 VOLT LIGHTING CIRCUIT FEEDING THIS AREA.
- 4. RELOCATE FIRE ALARM DEVICE TO NEW LOCATION AS SHOWN. EXTEND NEW CONDUIT AND CABLING AS REQUIRED
- 5. EXISTING HAND DRYER TO BE RELOCATED. EXTEND THE EXISTING CIRCUIT FROM THE EXISTING LOCATION TO THE NEW AS SHOWN. PROVIDE CONDUIT, CONDUCTORS AND J-BOXES AS REQUIRED FOR THE EXTENSION OF THE EXISTING CIRCUITS. COORDINATE MOUNTING HEIGHT OF NEW J-BOX WITH THE ARCHITECT PRIOR TO INSTALLATION. MAKE ALL ELECTRICAL TERMINATIONS TO EXISTING HAND DRYER.
- 6. PROVIDE AND INSTALL A DUAL TECHNOLOGY WALL SWITCH SENSOR FOR THE CONTROL OF FIXTURES IN THE AREA. SENSOR SHALL BE AS MANUFACTURED BY WATTSTOPPER #DW-100 OR APPROVED EQUAL.
- 7. PROVIDE AND INSTALL A DUAL TECHNOLOGY CEILING MOUNTED OCCUPANCY SENSOR WITH POWER PACK. EXTEND THE EXISTING SWITCHING AND HOT LIGHTING CIRCUITS TO NEW OCCUPANCY SENSOR LOCATION AND TERMINATE PER MANUFACTURES REQUIREMENTS. SENSO SHALL BE AS MANUFACTURED BY WATTSTOPPER #DT-300 WITH POWER PACK.

CHERRY/SEE/REAMES ARCHITECTS, LLP 220 gold avenue sw Albuquerque, NM 87102 505 - 842 - 1278 fax 505 - 766 - 9269

Addendum No. OCTOBER 20, 2010 PAGE E2 OF 2



**CHERRY/SEE/REAMES** 

ARCHITECTS, LLP

220 gold avenue sw albuquerque, nm 87102

505 - 842 - 1278 fax 505 - 766 - 9269


TION DATE:
DATE:
DATE:
RECORD SET OF DRAWINGS This set of drawings is provided by the Contractor as a schematic of the project in place. The Architect has not verified these conditions

and is not responsible for conclusions drawn CHERRY/SEE/REAMES ARCHITECTS 4/13/2012

CITY OF ALBUQUERQUE FRNA FERGUSSON LIBRARY MODIFICATIONS

TITLE: RECORD SET DR	AWING			
Design Review Committee	City Engineer Approval	Last Design Update	MO./DAY/YR.	MO./DAY/YR.
City Project No. <b>7168.03</b>	Zone Map No. G-18-Z	Sheet RS-2		Of

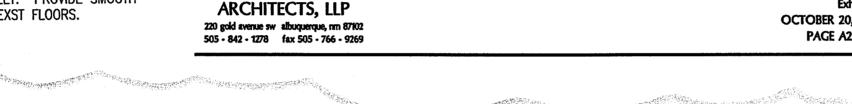

REPLACE EXISTING PLASTIC TOILET PARTITIONS IN MEN'S & WOMEN'S PUBLIC RESTROOMS WITH NEW METAL TOILET

Exhibit R

**OCTOBER 20, 2010** 

PAGE A1 OF 3

PARTITIONS. \ PER PHASE 1, WO #1, PR #4

PER PHASE 1, ADDENDUM #1

ARCHITECTS, LLP

220 gold avenue sw albuquerque, nm 87102


505 - 842 - 1278 fax 505 - 766 - 9269

SCOPE ADDED TO PROJECT, REFER TO A101

PROVIDE 1 MIRROR IN THE MEN'S PUBLIC RESTROOM. MIRROR TO MATCH SIZE AND SHAPE OF THE EXISTING MIRRORS HUNG IN THE WOMEN'S RESTROOM. MIRROR TO BE PROVIDED WITH AN ANTI-GRAFFITI FILM, AND TO BE SCREWED, NOT GLUED, TO THE WALL. NEW MIRROR TO BE INSTALLED OVER THE SINK FURTHEST EAST IN THE MEN'S RESTROOM. REPAIR TILE OVE THE SINKS IN THE MEN'S RESTROOM, WHICH WAS DAMAGED AS A RESULT OF REMOVING THE PREVIOUSLY INSTALLED 4 MIRRORS. PER PHASE 1, WO #1, PR #5

PROVIDE SHLAGE HEAVY-DUTY DEAD-BOLT LOCK, B-600 SERIES, WITH A CLASSROOM DEADBOLT FUNCTION TO MEN'S & WOMEN'S PUBLIC RESTROOM DOORS. PER PHASE 1, PR #6

#### ERNA FERGUSSON LIBRARY IMPROVEMENTS - ADDED SCOPE

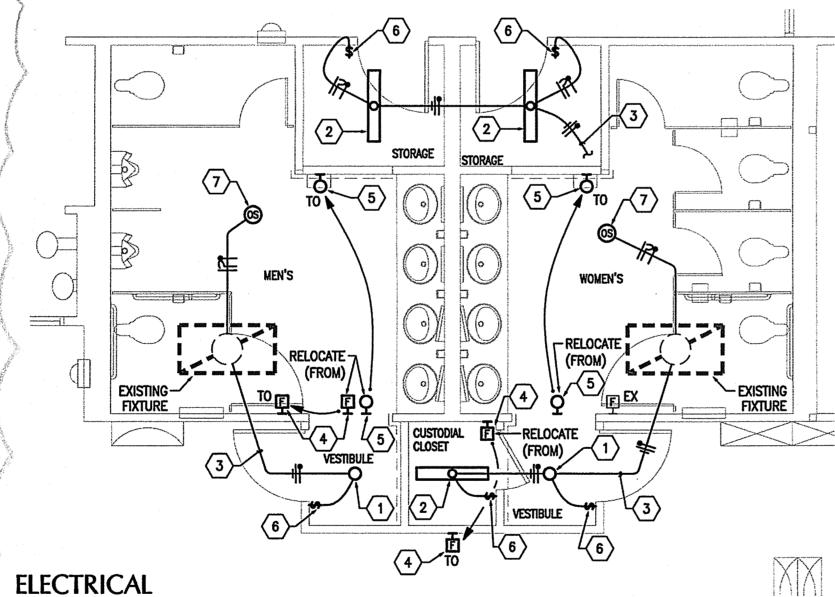

SCALE: 1/4"=1'-0"

Addendum No. 1 Exhibit C

OCTOBER 20, 2010

PAGE E1 OF 2

PER PHASE 1, ADDENDUM #1 SCOPE ADDED TO PROJECT, REFER TO E101

CHERRY/SEE/REAMES

ARCHITECTS, LLP

220 gold avenue sw Albuquerque, NM 87102 505 - 842 - 1278 fax 505 - 766 - 9269

IMPROVEMENTS TO ERNA FERGUSSON LIBRARY PR #2 Sketch #1 **KEYED NOTES** 1. 4'-0" LONG X 2'-0" TALL PONY WALL, MADE OF 3-5/8" STUDS, SPACED AT 24" OC AND COVERED WITH 5/8" TYPE 'X' GYP BOARD ON ALL FOUR SIDES AND ON TOP. TEXTURE AND PAINT TO MATCH EXISTING ADJACENT WALLS. V/D AND POWER LINES TO BE PULLED UP THROUGH EXISTING UNDERFLOOR DUCT WORK INTO THE CENTRAL PONY WALL AT EACH BAY OF COMPUTER TABLES. RUNNER TRACK. WIREMOLD TO BE INSTALLED OVER THE TOP OF EACH PONY WALL. COORDINATE WITH OWNER FOR LOCATIONS OF V/D AND POWER RECEPTACLES. WIREMOLD TO BE CENTERED OVER THE TOP OF EACH PONY WALL. NEW COMPUTER DESKS. NIC. VERIFY SIZES WITH OWNER FOR CORRECT LOCATIONS OF PONY WALLS. 4" VINYL BASE INSTALLED ON ALL FOUR SIDES. 6. PROVIDE CONTINUOUS BLOCKING ACROSS THE BOTTOM OF THE PONY WALL TO STIFFEN AND PROTECT AGAINST THE COMPUTER DESK LEGS. PROVIDE 3/8" CONCRETE EXPANSION ANCHORS AT THE BOTTOM RUNNER TRACK, EVERY 12" OC. 8. PROVIDE 12" X 12" ACCESS PANEL IN THE MIDDLE PONY WALL AT EACH BAY OF COMPUTER TABLES. COORDINATE LOCATION FOR EASIEST ACCESS OF ELECTRICAL AND V/D LINES. 9. 4'-0" LONG X 2'-0" TALL PONY WALL, MADE OF 3-5/8" STUDS, SPACED AT 24" OC AND COVERED WITH 5/8" HIGH-IMPACT XP GYP BOARD ON ALL FOUR SIDES AND ON TOP. TEXTURE AND PAINT TO MATCH EXISTING ADJACENT WALLS. 2'-5 1/2" -4 TYPICAL PONY WALL SECTION PARTIAL FLOOR PLAN SCALE: 1/8"=1"-0" SCALE: 1"=1"-0" CHERRY/SEE/REAMES ARCHITECTS, LLP OCTOBER 25, 2011 220 gold avenue sw albuquerque, nm 87102 505 - 842 - 1278 fax 505 - 766 - 9269 PAGE 1 OF 1 PER PHASE 2, CO #2, PR #2 REFER TO SHEET A-101 RECORD SET OF DRAWINGS This set of drawings is provided by the Con-tractor as a schematic of the project in place. The Architect has not verified these conditions and is not responsible for conclusions drawn CHERRY/SEE/REAMES ARCHITECTS 4/13/2012 CITY OF ALBUQUERQUE ERNA FERGUSSON LIBRARY MODIFICATIONS TITLE: RECORD SET DRAWING Design Review Committee City Engineer Approval

CHERRY/SEE/REAMES ARCHITECTS, LLP 220 gold avenue sw albuquerque, nm 87102 505 - 842 - 1278 fax 505 - 766 - 9269

Zone Map No. G-18-Z

City Project No.

7168.03

Sheet RS-3