


CONSTRUCTION PLANS FOR  
LOS PASTORES  
SHOPPING CENTER  
WYOMING BLVD & MONTGOMERY BLVD  
ALBUQUERQUE  
BERNALILLO COUNTY, NEW MEXICO  
AUGUST 2016

INDEX TO DRAWINGS

CERTIFICATE OF SUBSTANTIAL COMPLIANCE ON PLANS


I, Ronald R. Bohannon, of the firm of Tierra West LLC, a Registered Professional Engineer in the State of New Mexico, do hereby certify, to the best of my knowledge and belief, that the infrastructure installed as part of this project has been inspected by me or by a qualified person under my direct supervision and has been constructed in accordance with the plans and specifications approved by the City Engineer and that the original design intent of the approved plans has been met, except as noted by me on the as-built construction drawings. This Certification is based on site inspections by me or personnel under my direction with survey information provided by Russ P. Hugg, of Surv-Tek, Inc., NMPS number 9750

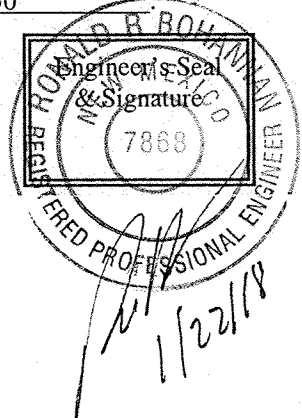

- 1 TITLE SHEET
- 2 PLAT (FOR REFERENCE ONLY)
- 3 GRADING AND DRAINAGE PLAN GR-1 (FOR REFERENCE ONLY)
- 4 GRADING AND DRAINAGE DETAILS GR-2 (FOR REFERENCE ONLY)
- 5 DEMOLITION PLAN
- 6 MASTER UTILITY PLAN
- 7 PAVING & UTILITY IMPROVEMENTS  
ALLEY "A" (NORTH), STA 10+00.00 TO 14+48.99
- 8 PAVING & UTILITY IMPROVEMENTS  
ALLEY "B" (WEST), STA 20+00.00 TO 28+46.19
- 9 PAVING IMPROVEMENTS  
WYOMING BLVD NE, STA 33+85.39 TO 36+28.91
- 10 SIGNING & STRIPING IMPROVEMENTS - ONSITE
- 11 SIGNING & STRIPING IMPROVEMENTS - OFFSITE
- 12 CITY OF ALBUQUERQUE STANDARD DETAILS FOR SIGNING & STRIPING
- 13 DETAILS
- 14 TEMPORARY EROSION CONTROL AND SEDIMENTATION PLAN
- 15 TEMPORARY EROSION CONTROL AND SEDIMENTATION DETAILS

CERTIFICATE OF SUBSTANTIAL COMPLIANCE ON PLANS (ABCWUA)

I, Ronald R. Bohannon, of the firm of Tierra West LLC, a Registered Professional Engineer in the State of New Mexico, do hereby certify, to the best of my knowledge and belief, that the infrastructure installed as part of this project has been inspected by me or by a qualified person under my direct supervision and has been constructed in accordance with the plans and specifications approved by the City Engineer and that the original design intent of the approved plans has been met, except as noted by me on the as-built construction drawings. This Certification is based on site inspections by me or personnel under my direction with survey information provided by Russ P. Hugg, of Surv-Tek, Inc., NMPS number 9750

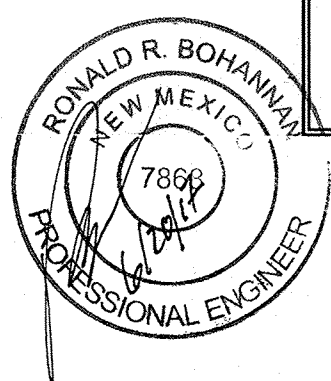

Engineer's Seal  
& Signature


SURVEYORS CERTIFICATION

I, Russ P. Hugg, New Mexico Professional Surveyor Number 9750, hereby certify that the as-built information shown hereon is the result of an actual field survey performed by me or under my direct supervision and that the same is true and correct to the best of my knowledge and belief.

Russ P. Hugg  
NMPS No. 9750  
09/06, 2017




TIERRA WEST, LLC  
5571 MIDWAY PARK PLACE NE  
ALBUQUERQUE, NEW MEXICO 87109  
505-858-3100  
www.tierrawestllc.com

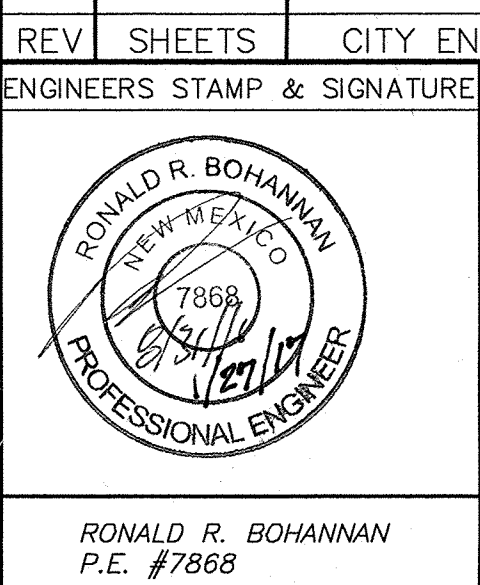

|                             |                  |                    |          |                                                  |      |            |      |
|-----------------------------|------------------|--------------------|----------|--------------------------------------------------|------|------------|------|
| REV                         | SHEETS           | CITY ENGINEER      | DATE     | USER DEPT.                                       | DATE | USER DEPT. | DATE |
| ENGINEERS STAMP & SIGNATURE | APPROVALS        | ENGINEER           | DATE     | APPROVED FOR CONSTRUCTION                        |      |            |      |
|                             | DRC Chairman     | <i>[Signature]</i> | 10/20/18 | <i>[Signature]</i> 3-29-17<br>City Engineer Date |      |            |      |
|                             | Transportation   | <i>[Signature]</i> | 9/22/16  |                                                  |      |            |      |
|                             | Water/Wastewater | <i>[Signature]</i> | 9-22-16  |                                                  |      |            |      |
|                             | Hydrology        | <i>[Signature]</i> | 9-22-16  |                                                  |      |            |      |
|                             | AMAFCA           |                    |          |                                                  |      |            |      |
| Constr. Mngmt.              |                  |                    |          |                                                  |      |            |      |
| Constr. Coord.              |                  |                    |          |                                                  |      |            |      |
| CITY PROJECT NO.            |                  | 719880             |          | SHEET                                            |      | OF         |      |
|                             |                  |                    |          | 1                                                |      | 15         |      |

RECORD DRAWINGS

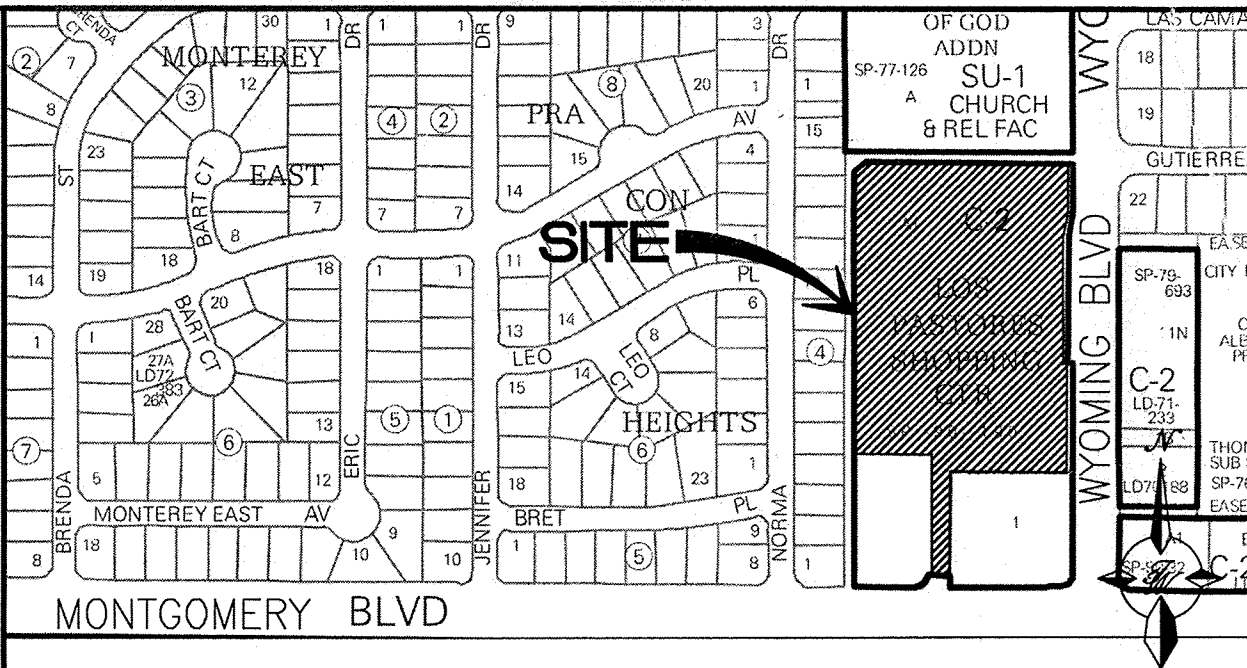


VICINITY MAP

F-19-Z  
SCALE NONE

NOTICE TO CONTRACTORS

1. ALL WORK DETAILED ON THESE PLANS TO BE PERFORMED UNDER CONTRACT SHALL, EXCEPT AS OTHERWISE STATED OR PROVIDED FOR HEREON, BE CONSTRUCTED IN ACCORDANCE WITH THE CITY OF ALBUQUERQUE STANDARD SPECIFICATIONS FOR PUBLIC WORKS CONSTRUCTION, 1988 EDITION (UPDATE #9). CONTRACTOR SHALL BE RESPONSIBLE FOR ADJUSTING TO EXISTING ROADWAY AND UTILITY FACILITIES RESULTING FROM ACTIVITIES PERFORMED UNDER THE CONTRACT FOR IMPROVEMENTS DETAILED ON THESE PLANS.
  2. TWO WORKING DAYS PRIOR TO ANY EXCAVATION, THE CONTRACTOR MUST CONTACT NEW MEXICO ONE CALL SYSTEM (280-1990) FOR LOCATION OF EXISTING UTILITIES.
  3. ANY WORK AFFECTING AN ARTERIAL ROADWAY MAY REQUIRE 24-HOUR CONSTRUCTION.
  4. PRIOR TO CONSTRUCTION, THE CONTRACTOR SHALL EXCAVATE AND VERIFY THE HORIZONTAL AND VERTICAL LOCATIONS OF ALL OBSTRUCTIONS. SHOULD A CONFLICT EXIST, THE CONTRACTOR SHALL NOTIFY THE ENGINEER OR SURVEYOR IMMEDIATELY SO THAT THE CONFLICT CAN BE RESOLVED WITH A MINIMUM AMOUNT OF DELAY.
  5. SEVEN (7) WORKING DAYS PRIOR TO BEGINNING OF CONSTRUCTION, THE CONTRACTOR SHALL SUBMIT TO CONSTRUCTION COORDINATION DIVISION A DETAILED CONSTRUCTION SCHEDULE. TWO(2) WORKING DAYS PRIOR TO CONSTRUCTION, THE CONTRACTOR SHALL OBTAIN A BARRICADING PERMIT FROM THE CONST. COORDINATION DIVISION. CONTRACTOR SHALL NOTIFY BARRICADE ENGINEER (924-3400) PRIOR TO OCCUPYING AN INTERSECTION. REFER TO STANDARD SPECIFICATIONS.
  6. ALL STREET STRIPING ALTERED OR DESTROYED SHALL BE REPLACED WITH PLASTIC REFLECTORIZED PAVEMENT MARKINGS BY THE CONTRACTOR TO THE SAME LOCATION AS EXISTING OR AS INDICATED BY THIS PLAN SET.
  7. CONTRACTOR SHALL NOTIFY THE ENGINEER NOT LESS THAN SEVEN (7) DAYS PRIOR TO STARTING WORK IN ORDER THAT THE ENGINEER MAY TAKE NECESSARY MEASURES TO INSURE THE PRESERVATION OF SURVEY MONUMENTS. CONTRACTOR SHALL NOT DISTURB PERMANENT SURVEY MONUMENTS WITHOUT THE CONSENT OF THE ENGINEER AND SHALL NOTIFY THE ENGINEER AND BEAR THE EXPENSE OF REPLACING ANY THAT MAY BE DISTURBED WITHOUT PERMISSION BY THE CITY SURVEYOR. WHEN A CHANGE IS MADE IN THE FINISHED ELEVATIONS OF THE PAVEMENT OF ANY ROADWAY IN WHICH A PERMANENT SURVEY MONUMENT IS LOCATED, CONTRACTOR SHALL, AT HIS OWN EXPENSE, ADJUST THE MONUMENT COVER TO THE NEW GRADE UNLESS OTHERWISE SPECIFIED. REFER TO SECTION 4.4 OF THE GENERAL CONDITIONS OF THE STANDARD SPECIFICATIONS. ANY PERMANENT SURVEY MONUMENT LOCATED WITHIN 50' OF THIS PROJECT THAT IS NOT SHOWN ON THE PLAN AND IS DESTROYED DURING CONSTRUCTION WILL BE REPLACED AT THE DESIGNER'S EXPENSE.
  8. CONTRACTOR SHALL MAINTAIN A GRAFFITI-FREE WORK SITE. CONTRACTOR SHALL PROMPTLY REMOVE ANY AND ALL GRAFFITI FROM EQUIPMENT, WHETHER PERMANENT OR TEMPORARY.
  9. FOR STORM DRAIN CONSTRUCTION, RCP PIPE JOINTS SHALL NOT BE GROUTED PRIOR TO FINAL INSPECTION. FINAL INSPECTION WILL DETERMINE JOINTS TO BE GROUTED FOR FINAL ACCEPTANCE OF THE CONSTRUCTION.
  10. ALL UTILITY WORK SHALL BE CONSTRUCTED IN ACCORDANCE WITH ABCWUA SPECIFICATIONS FOR WATER AND WASTEWATER FACILITIES (MOST RECENT REVISIONS).
  11. THE CONTRACTOR SHALL COORDINATE WITH THE WATER AUTHORITY SEVEN (7) DAYS IN ADVANCE OF PERFORMING WORK THAT WILL AFFECT THE PUBLIC WATER OR SANITARY SEWER INFRASTRUCTURE. WORK SHUT-OFF OF FACILITIES DESIGNATED AS MASTER PLAN FACILITIES MUST BE COORDINATED WITH THE WATER AUTHORITY 14 DAYS IN ADVANCE OF PERFORMING SUCH WORK. ONLY WATER AUTHORITY CREWS ARE AUTHORIZED TO OPERATE PUBLIC VALVES. SHUT-OFF REQUESTS MUST BE MADE ONLINE AT [http://abcwua.org/water\\_shut\\_off\\_and\\_turn\\_on\\_procedures](http://abcwua.org/water_shut_off_and_turn_on_procedures)
  12. ALL EXCAVATION, TRENCHING, AND SHORING ACTIVITIES MUST BE CARRIED OUT IN ACCORDANCE WITH OSHA 29 CFR 1926.650 SUBPART P.
  13. ELECTRONIC MARKER DEVICES (EMS) WILL BE PLACED ACCORDING TO SECTION 170 OF THE COA STANDARD SPECIFICATIONS.
  14. CONTRACTOR WILL BE RESPONSIBLE FOR PROVIDING AND MAINTAINING ALL CONSTRUCTION SIGNING UNTIL PROJECT HAS BEEN ACCEPTED BY THE COA.
- THE FOLLOWING NOTES ALSO APPLY WHEN CHECKED
- ☒ ALL UTILITIES AND UTILITY SERVICE LINES SHALL BE INSTALLED PRIOR TO PAVING.
  - ☒ BACKFILL COMPACTION SHALL BE ACCORDING TO SPECIFIED STREET USE.
  - ☐ TACK COAT REQUIREMENTS SHALL BE DETERMINED BY THE PROJECT ENGINEER.
  - ☒ SIDEWALKS AND WHEELCHAIR RAMPS WITHIN THE CURB RETURNS SHALL BE CONSTRUCTED WHEREVER A NEW CURB RETURN IS CONSTRUCTED.
  - ☐ IF CURB IS DEEPENED FOR A DRIVEPAD, THE DRIVEPAD SHALL BE CONSTRUCTED PRIOR TO ACCEPTANCE OF CURB AND GUTTER.
  - ☒ ALL STORM DRAINAGE FACILITIES SHALL BE COMPLETED PRIOR TO FINAL ACCEPTANCE.

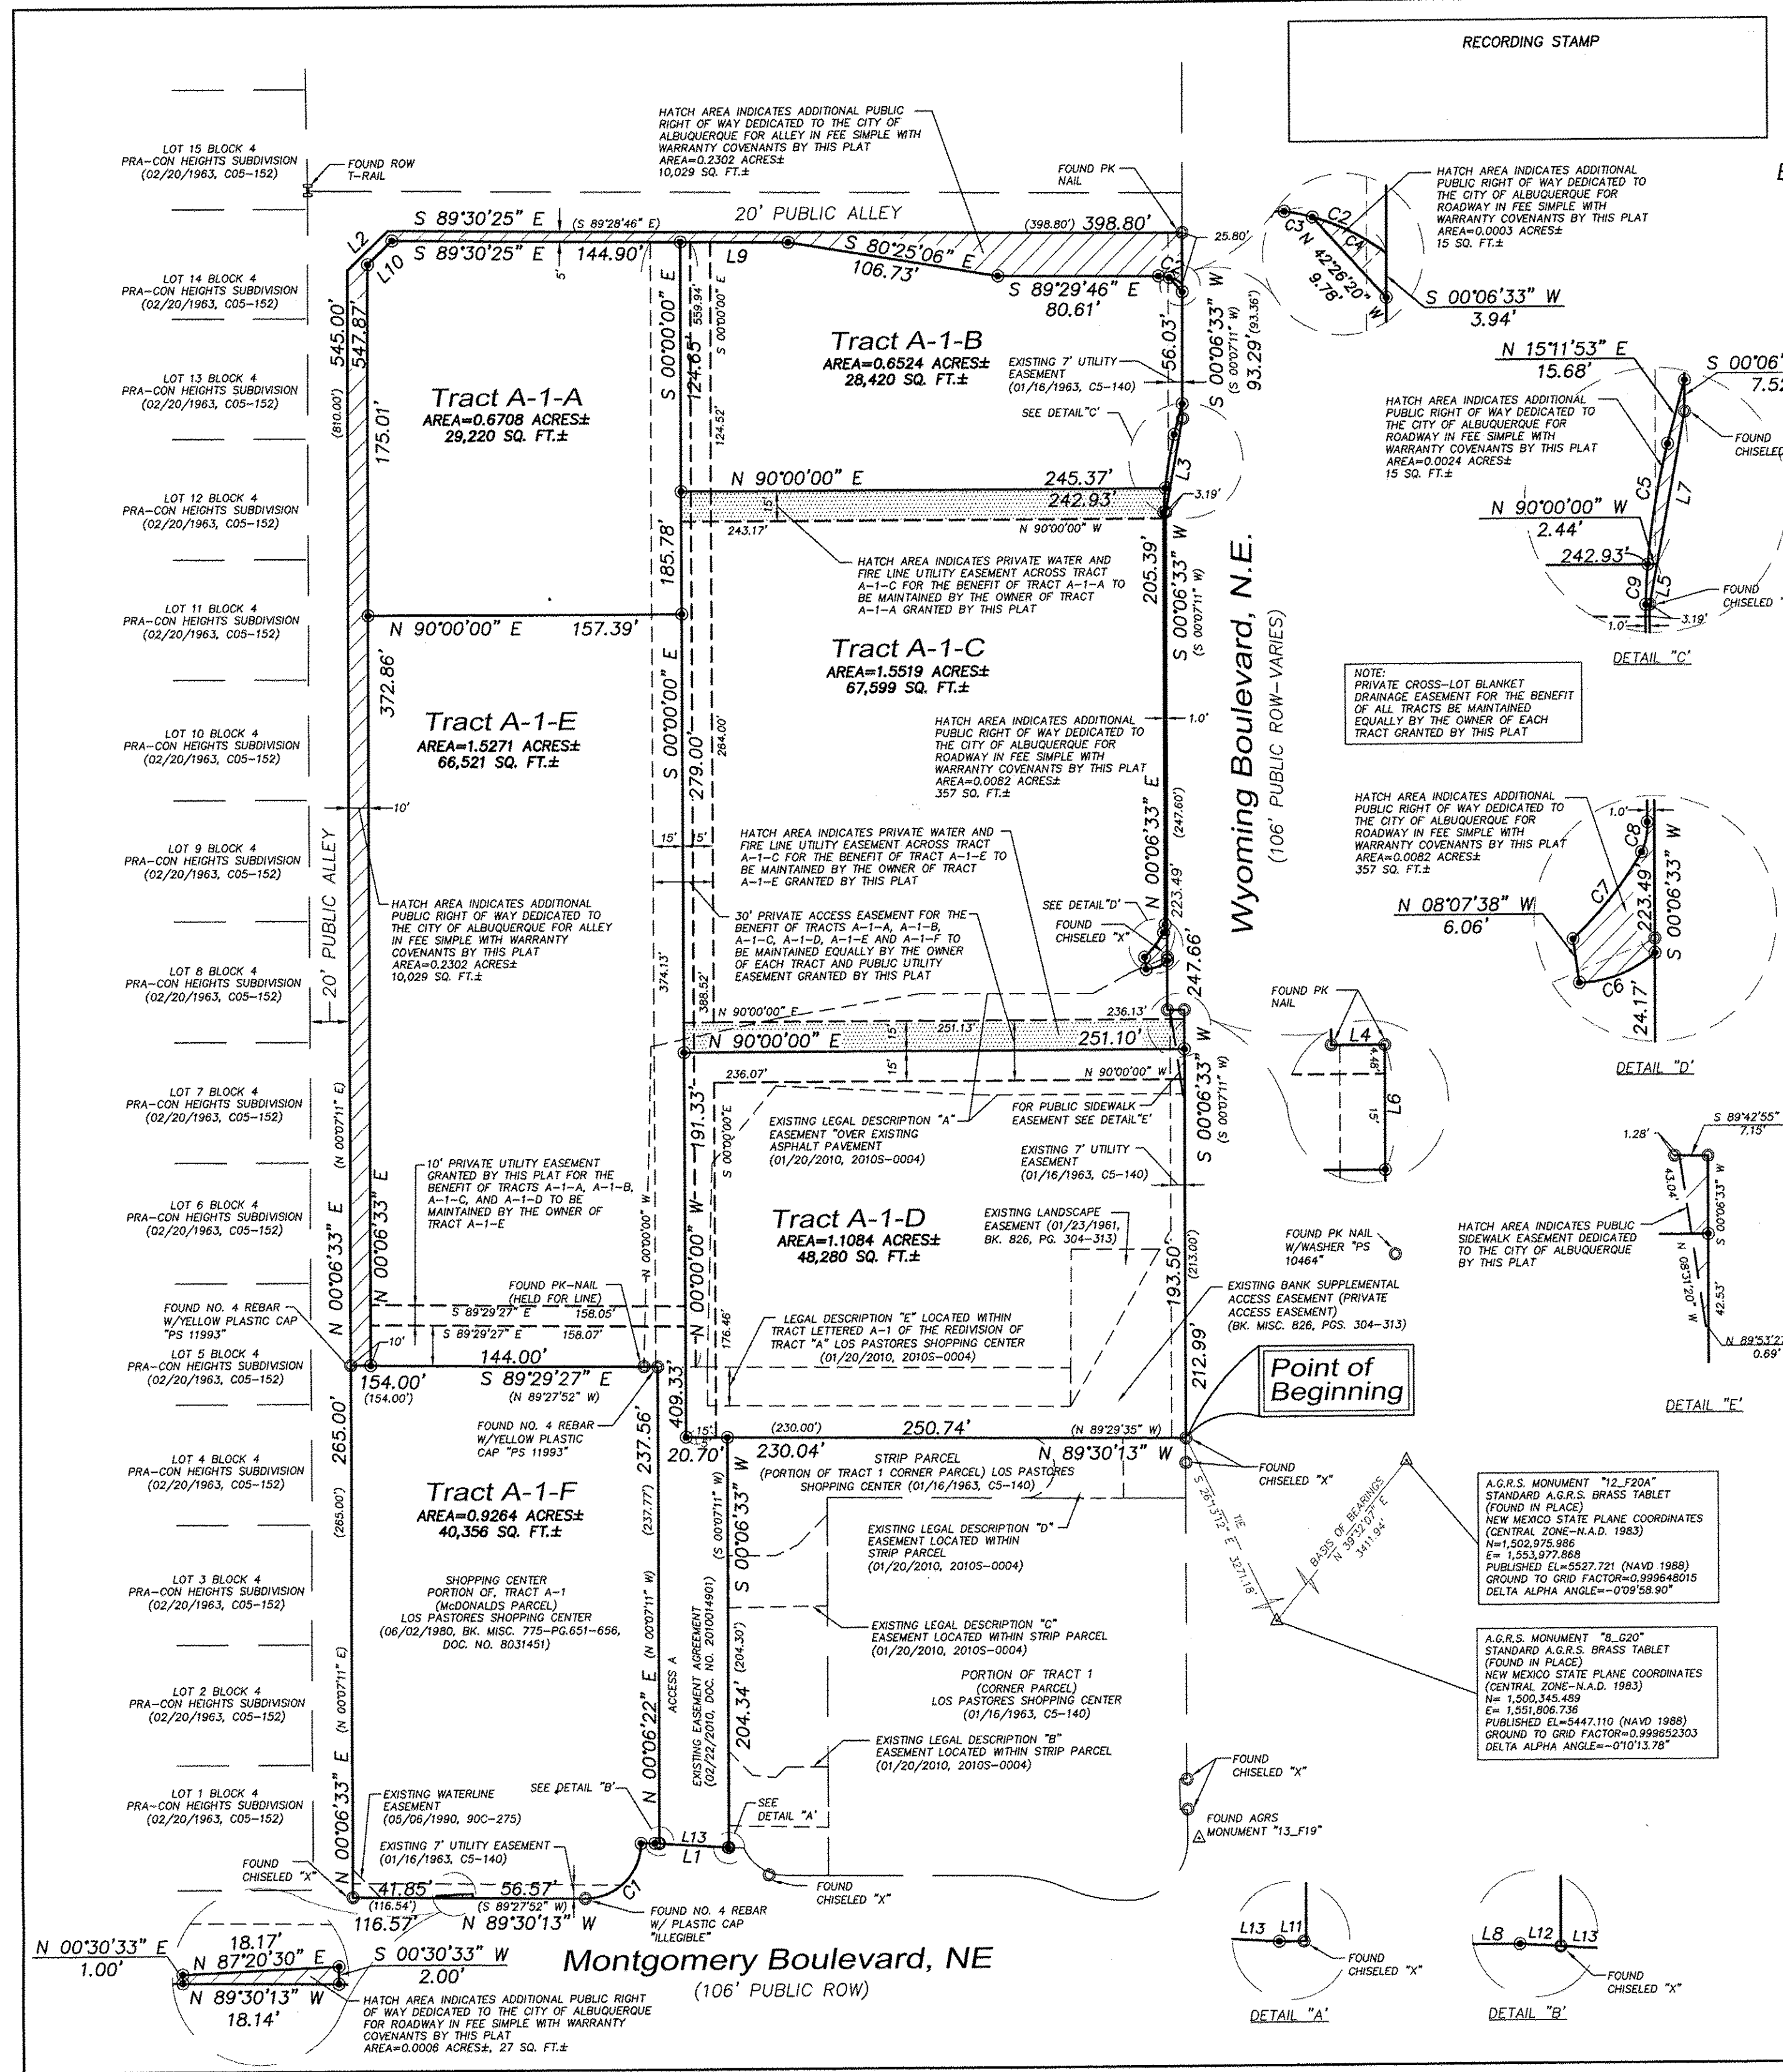

Subdivision  
Tracts A-1-A, A-1-B, A-1-C, A-1-D, A-1-E & A-1-F  
**Los Pastores Shopping Center**  
Elena Gallegos Grant, Projected Section 31, Township 11 North, Range 4 East, N.M.P.M  
Albuquerque, Bernalillo County, New Mexico  
April 2016

0 60 120 180  
SCALE: 1"=60'

**PRECISION SURVEYS, INC.**  
OFFICE LOCATION:  
5571 MIDWAY PARK PLACE, NE  
ALBUQUERQUE, NM 87109  
MAILING ADDRESS:  
PO BOX 90636  
ALBUQUERQUE, NM 87199  
505.856.5700 PHONE  
505.856.7900 FAX

**FOR REFERENCE ONLY**

**TIERRA WEST, LLC**  
5571 MIDWAY PARK PLACE NE  
ALBUQUERQUE, NM 87109  
(505)856-3100  
www.tierrawest.com

**CITY OF ALBUQUERQUE**  
PUBLIC WORKS DEPARTMENT  
ENGINEERING GROUP




TITLE: **LOS PASTORES SHOPPING CENTER**  
PLAT

DESIGN REVIEW COMMITTEE CITY ENGINEER APPROVAL  
LAST DESIGN UPDATE


CITY PROJECT NO. **719880** ZONE MAP NO. **F-19-Z** SHEET **2** OF **15**

DESIGNED BY: JH DATE: 8/19/2016  
DRAWN BY: JY DATE: 8/19/2016  
DRAWING NAME: 2014052-SHO2-PLAT JOB NO.: 2014052  
CHECKED BY: JH DATE: 8/19/2016

| AS BUILT INFORMATION   |               | BENCH MARKS                |             | SURVEY INFORMATION |    | ENGINEER'S SEAL |    |
|------------------------|---------------|----------------------------|-------------|--------------------|----|-----------------|----|
| CONTRACTOR             | DATE          | STANDARD A.G.R.S. MONUMENT | FIELD NOTES | NO.                | BY | NO.             | BY |
| WORK BY: G. GALLEGOS   | DATE: 8/19/16 | A.G.R.S. MONUMENT "B, G20" | DATE        |                    |    |                 |    |
| REVISIONS BY: JY       | DATE: 8/19/16 | NM STATE PLANE COORDINATES | BY          |                    |    |                 |    |
| ACCEPTANCE BY: JY      | DATE: 8/19/16 | CENTRAL ZONE-N.A.D. 1983   | NO.         |                    |    |                 |    |
| VERIFICATION BY: JY    | DATE: 8/19/16 | X=1,551,806.736            |             |                    |    |                 |    |
| DRAWINGS BY: JY        | DATE: 8/19/16 | Y=1,500,345.489            |             |                    |    |                 |    |
| CORRECTIONS BY: JY     | DATE: 8/19/16 | G-G-0.99962303             |             |                    |    |                 |    |
| MICRO-FILM INFORMATION |               | Doc=-071013.78"            |             |                    |    |                 |    |
| RECORDED BY            | DATE          | Elev=5447.110 (NAVD 1988)  |             |                    |    |                 |    |
| NO.                    |               |                            |             |                    |    |                 |    |

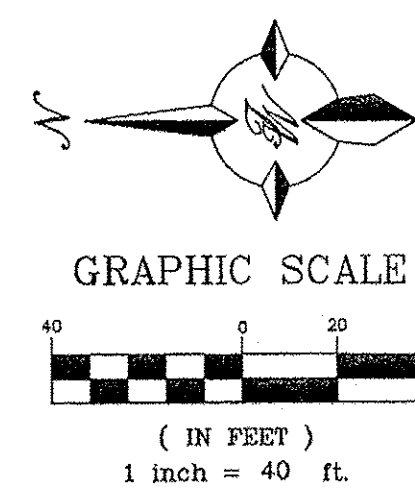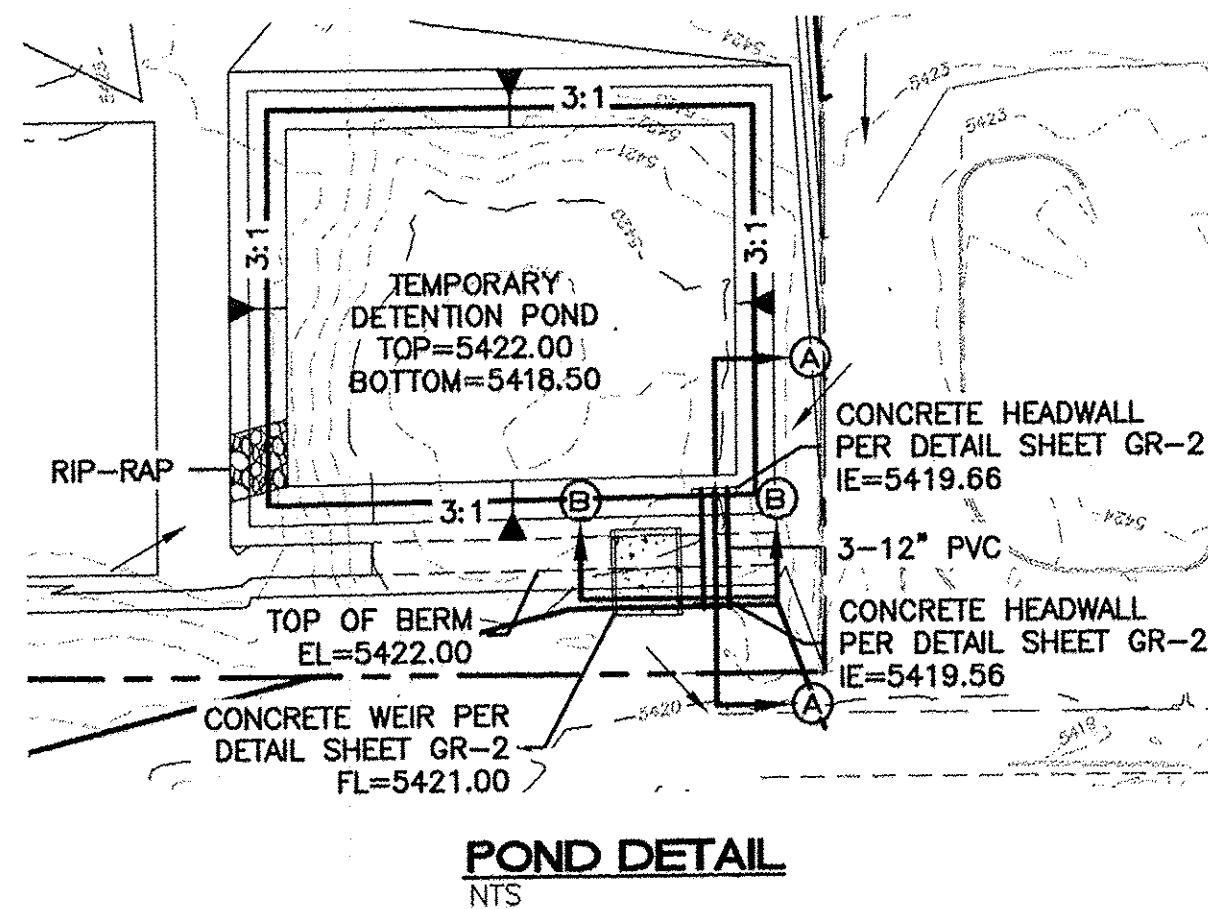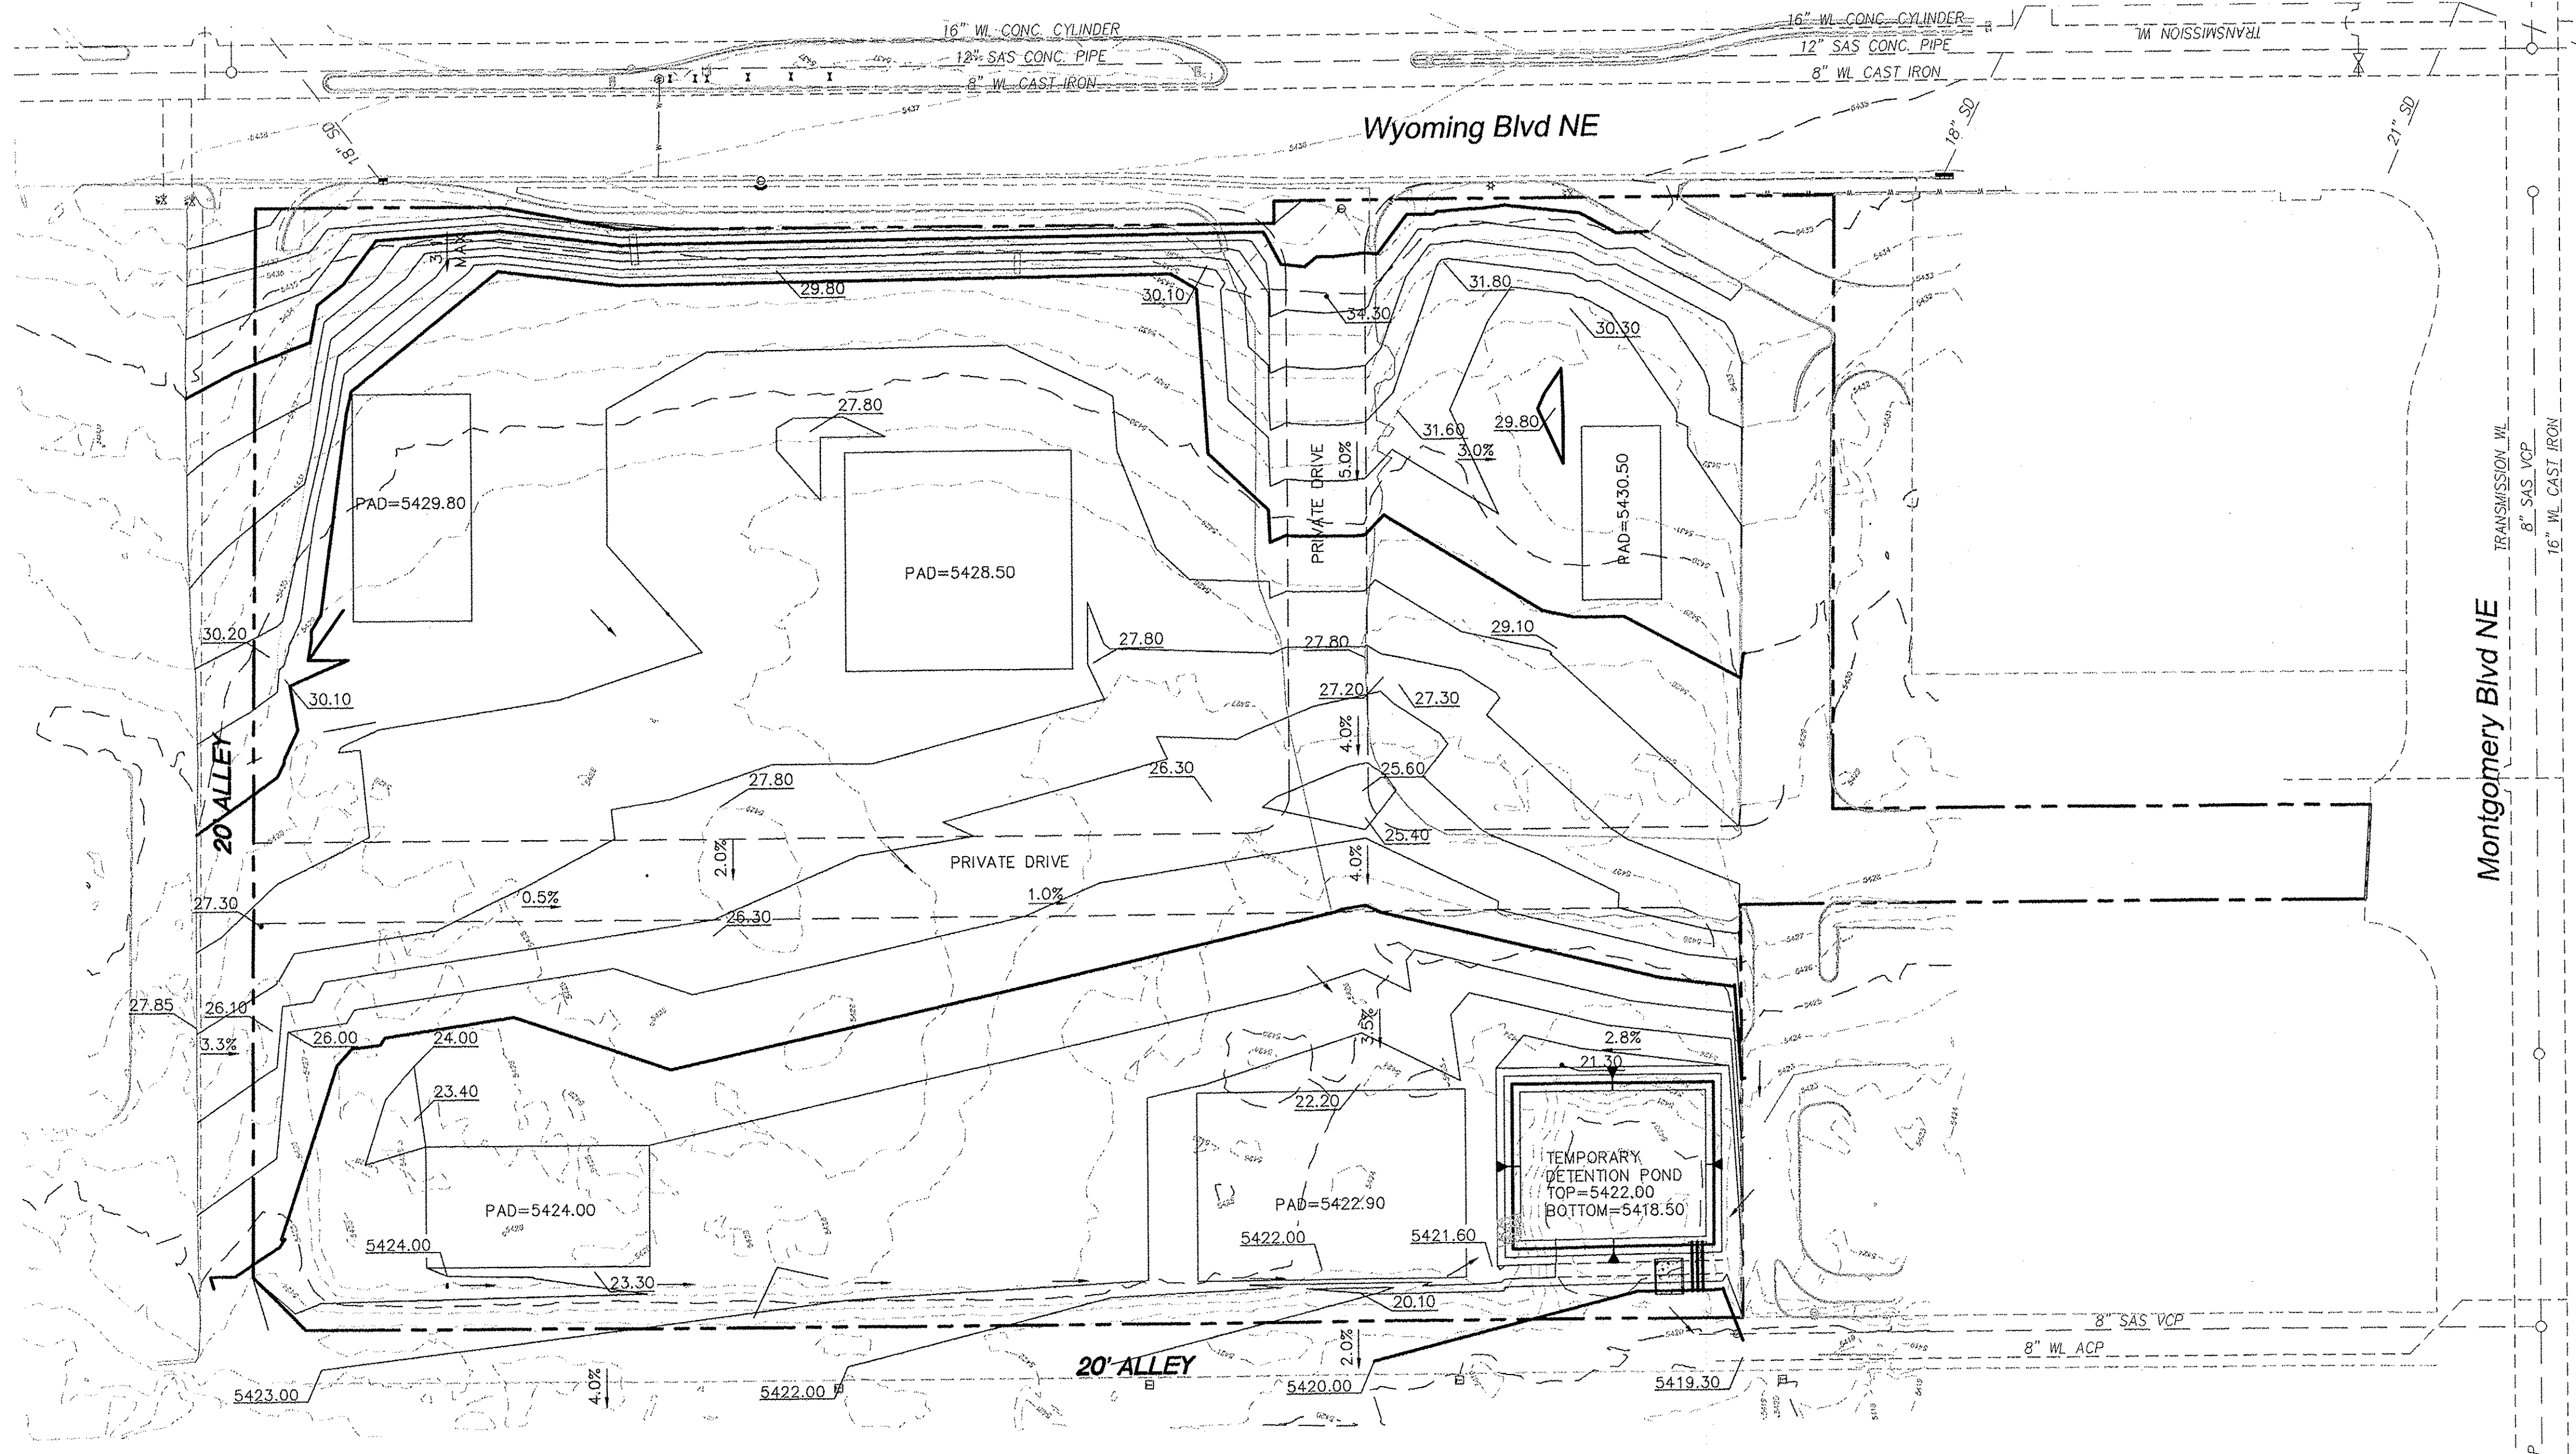


**CAUTION:**  
ALL EXISTING UTILITIES SHOWN WERE OBTAINED FROM RESEARCH, AS-BUILTS, SURVEYS OR INFORMATION PROVIDED BY OTHERS. IT SHALL BE THE SOLE RESPONSIBILITY OF THE CONTRACTOR TO CONDUCT ALL NECESSARY FIELD INVESTIGATIONS PRIOR TO AND INCLUDING ANY EXCAVATION, TO DETERMINE THE ACTUAL LOCATION OF UTILITIES AND OTHER IMPROVEMENTS, PRIOR TO STARTING THE WORK. ANY CHANGES FROM THIS PLAN SHALL BE COORDINATED WITH AND APPROVED BY THE ENGINEER.

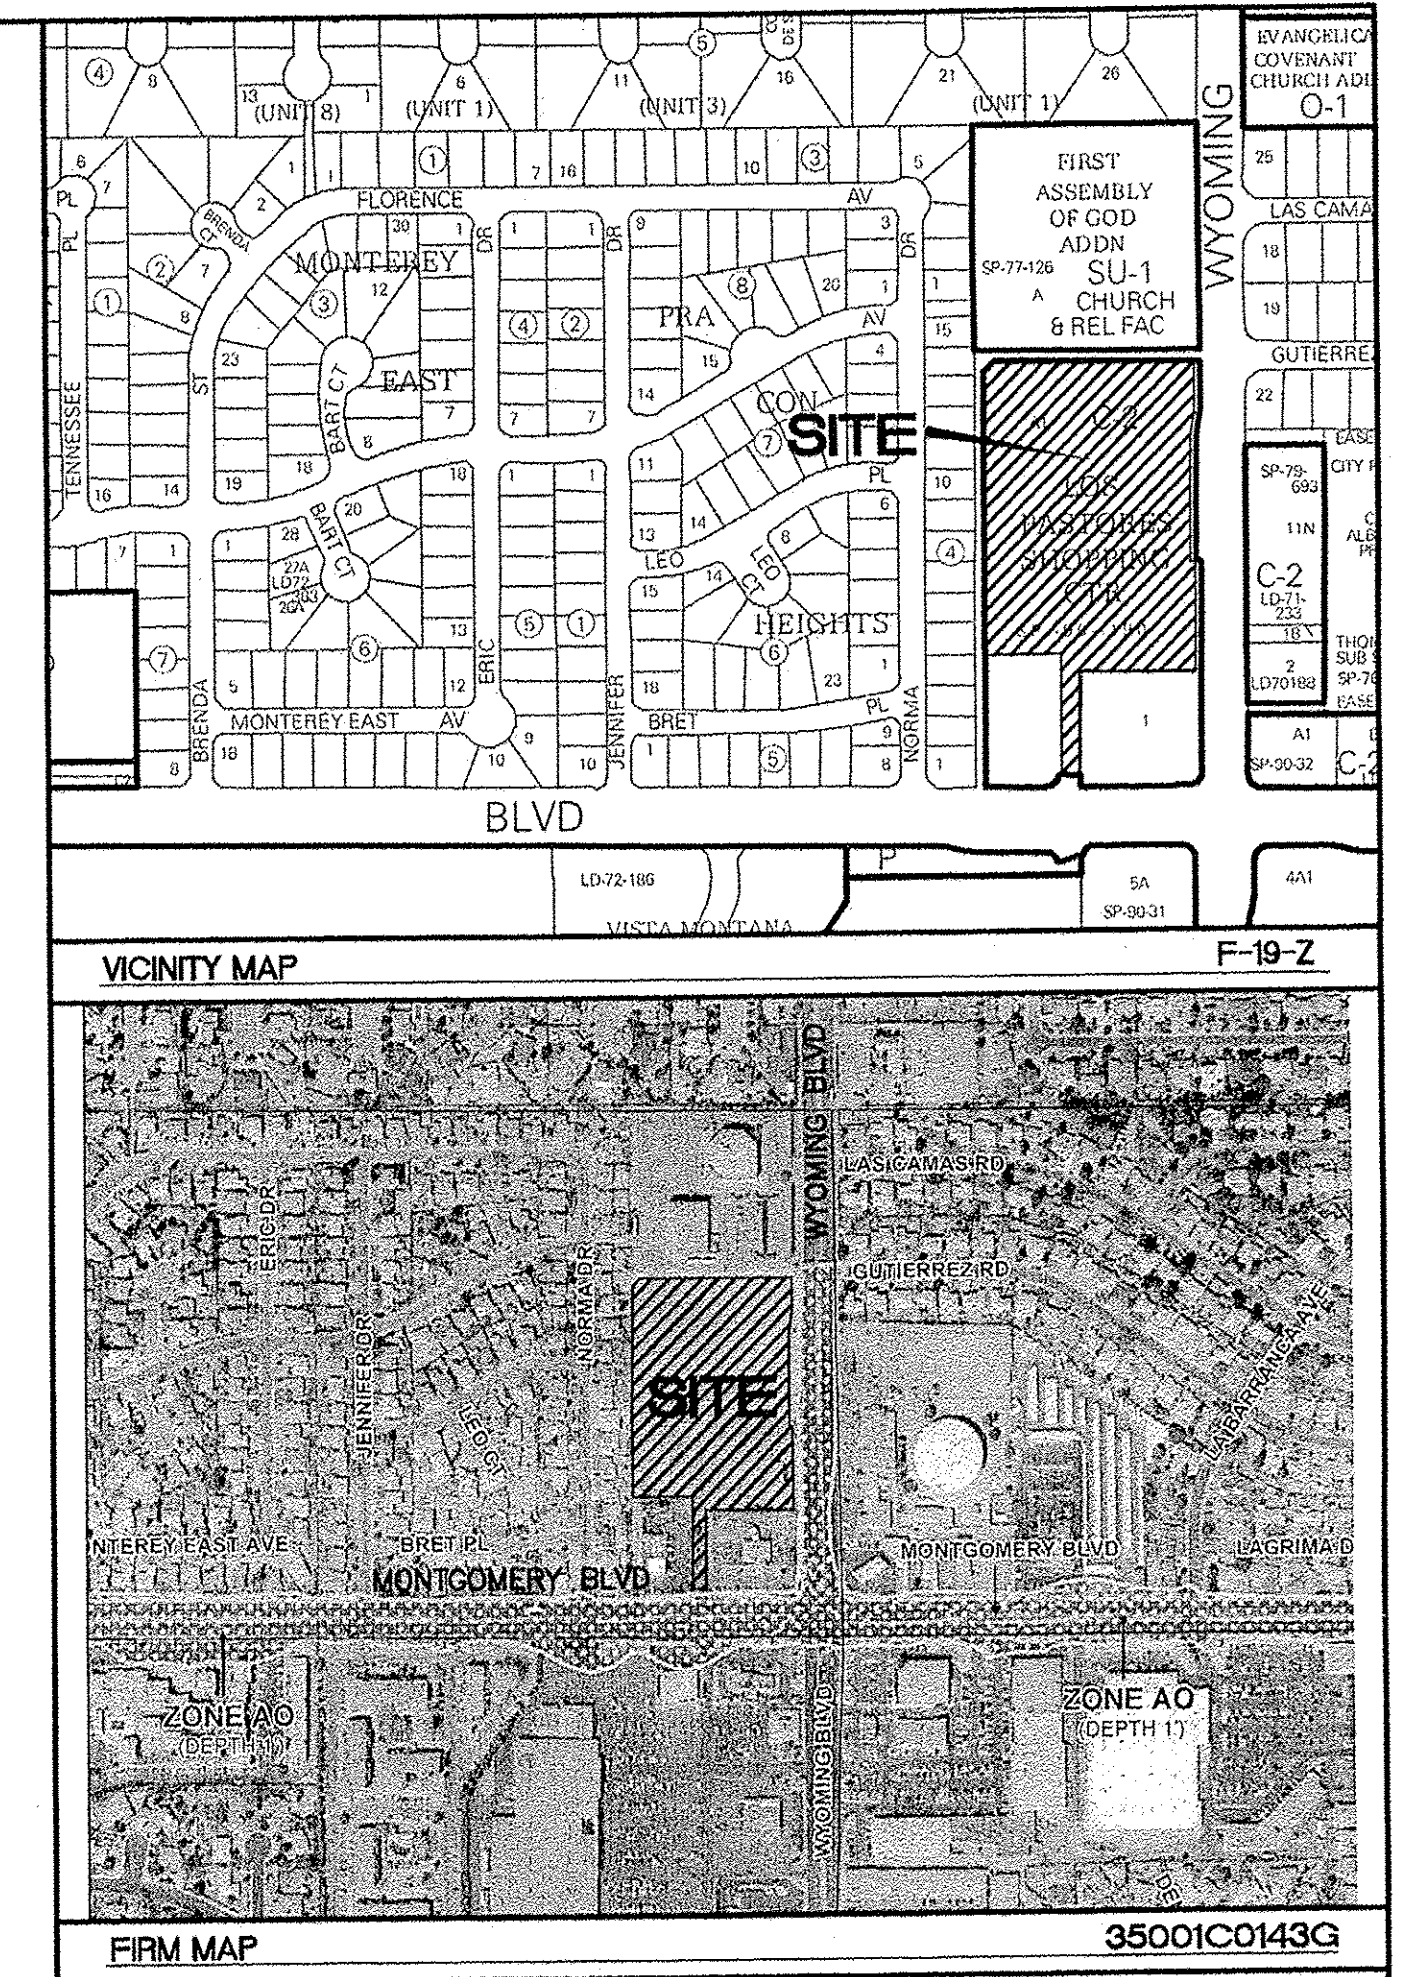


#### LEGEND

- CURB & GUTTER
- BOUNDARY LINE
- EASEMENT
- SIDEWALK
- EXISTING CURB & GUTTER
- SINGLE CLEAN OUT
- DOUBLE CLEAN OUT
- EXISTING SD MANHOLE
- EXISTING SAS MANHOLE
- EXISTING FIRE HYDRANT
- EXISTING WATER METER
- EXISTING POWER POLE
- EXISTING GAS VALVE
- u — EXISTING OVERHEAD UTILITIES
- EX. 8\"/>

#### FOR REFERENCE ONLY
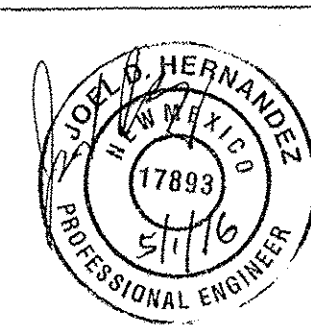
|                                                                                                                                                            |                                                                                                                          |                                                                    |
|------------------------------------------------------------------------------------------------------------------------------------------------------------|--------------------------------------------------------------------------------------------------------------------------|--------------------------------------------------------------------|
| <b>ENGINEER'S SEAL</b><br><br><b>JOEL D. HERNANDEZ</b><br>P.E. #17893 | <b>LOS PASTORES SHOPPING CENTER</b>                                                                                      | DRAWN BY<br>DY                                                     |
|                                                                                                                                                            | <b>GRADING PLAN</b>                                                                                                      | DATE<br>5/02/16                                                    |
|                                                                                                                                                            | <b>TIERRA WEST, LLC</b><br>5571 MIDWAY PARK PLACE NE<br>ALBUQUERQUE, NM 87109<br>(505) 858-3100<br>www.tierrawestllc.com | 2014052-GR-1<br><br>SHEET #<br><b>GR-1</b><br><br>JOB #<br>2014052 |



(SEE REVISED SHEET GR-1)

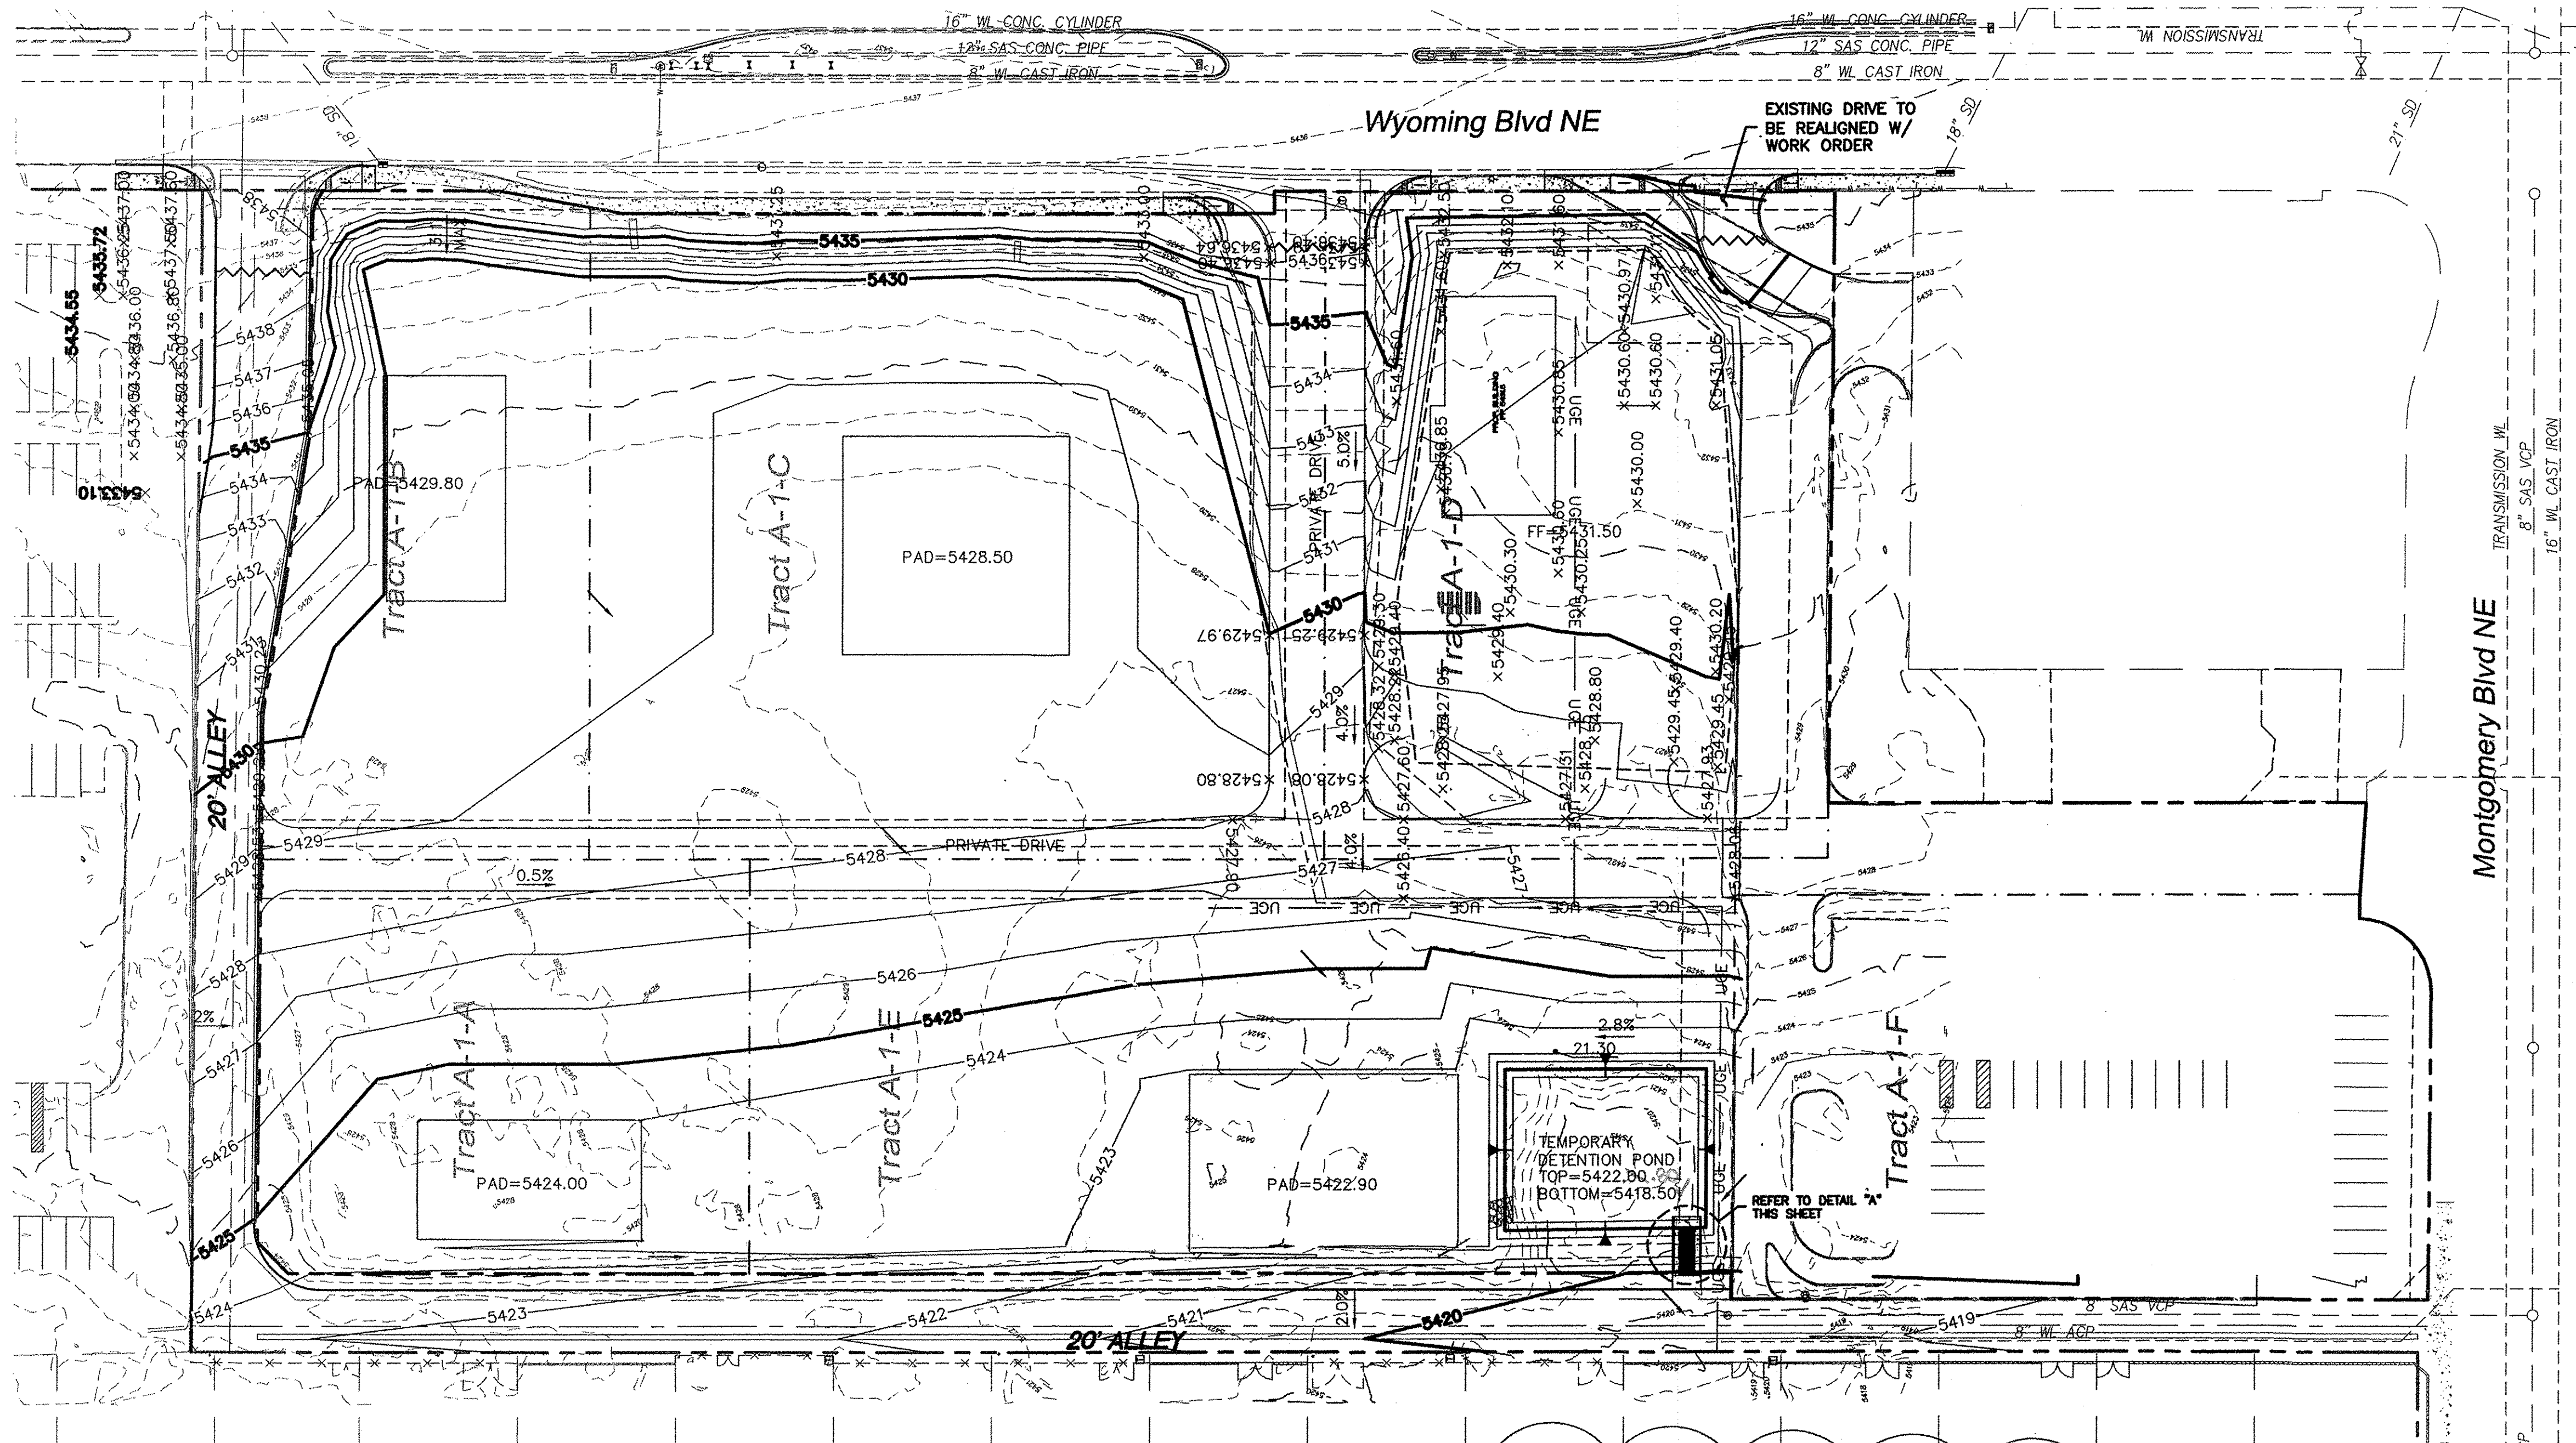


#### SURVEYORS CERTIFICATION

I, Russ P. Hugg, New Mexico Professional Surveyor Number 9750, hereby certify that the as-built information shown hereon is the result of an actual field survey performed by me or under my direct supervision and that the same is true and correct to the best of my knowledge and belief.


Russ P. Hugg  
NMPs No. 9750

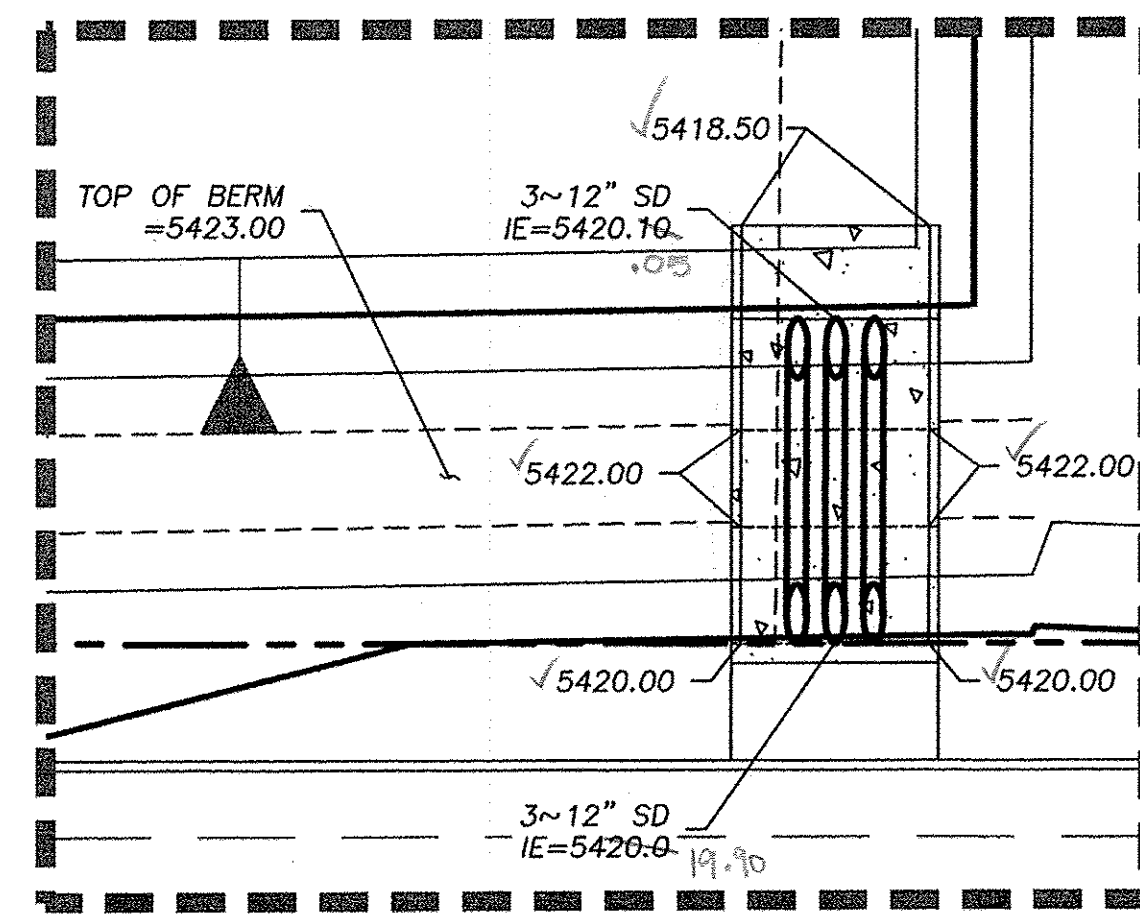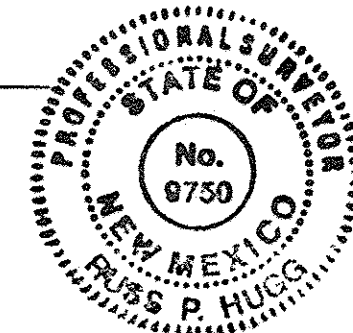

DETAIL 'A'  
SC: 1" = 10'

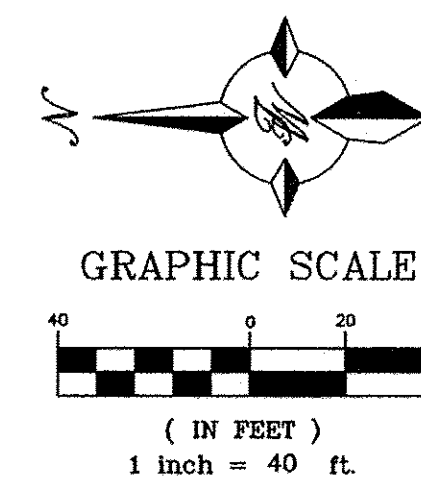

**CAUTION:**  
ALL EXISTING UTILITIES SHOWN WERE OBTAINED FROM RESEARCH, AS-BUILTS, SURVEYS OR INFORMATION PROVIDED BY OTHERS. IT SHALL BE THE SOLE RESPONSIBILITY OF THE CONTRACTOR TO CONDUCT ALL NECESSARY FIELD INVESTIGATIONS PRIOR TO AND INCLUDING ANY EXCAVATION, TO DETERMINE THE ACTUAL LOCATION OF UTILITIES AND OTHER IMPROVEMENTS, PRIOR TO STARTING THE WORK. ANY CHANGES FROM THIS PLAN SHALL BE COORDINATED WITH AND APPROVED BY THE ENGINEER.

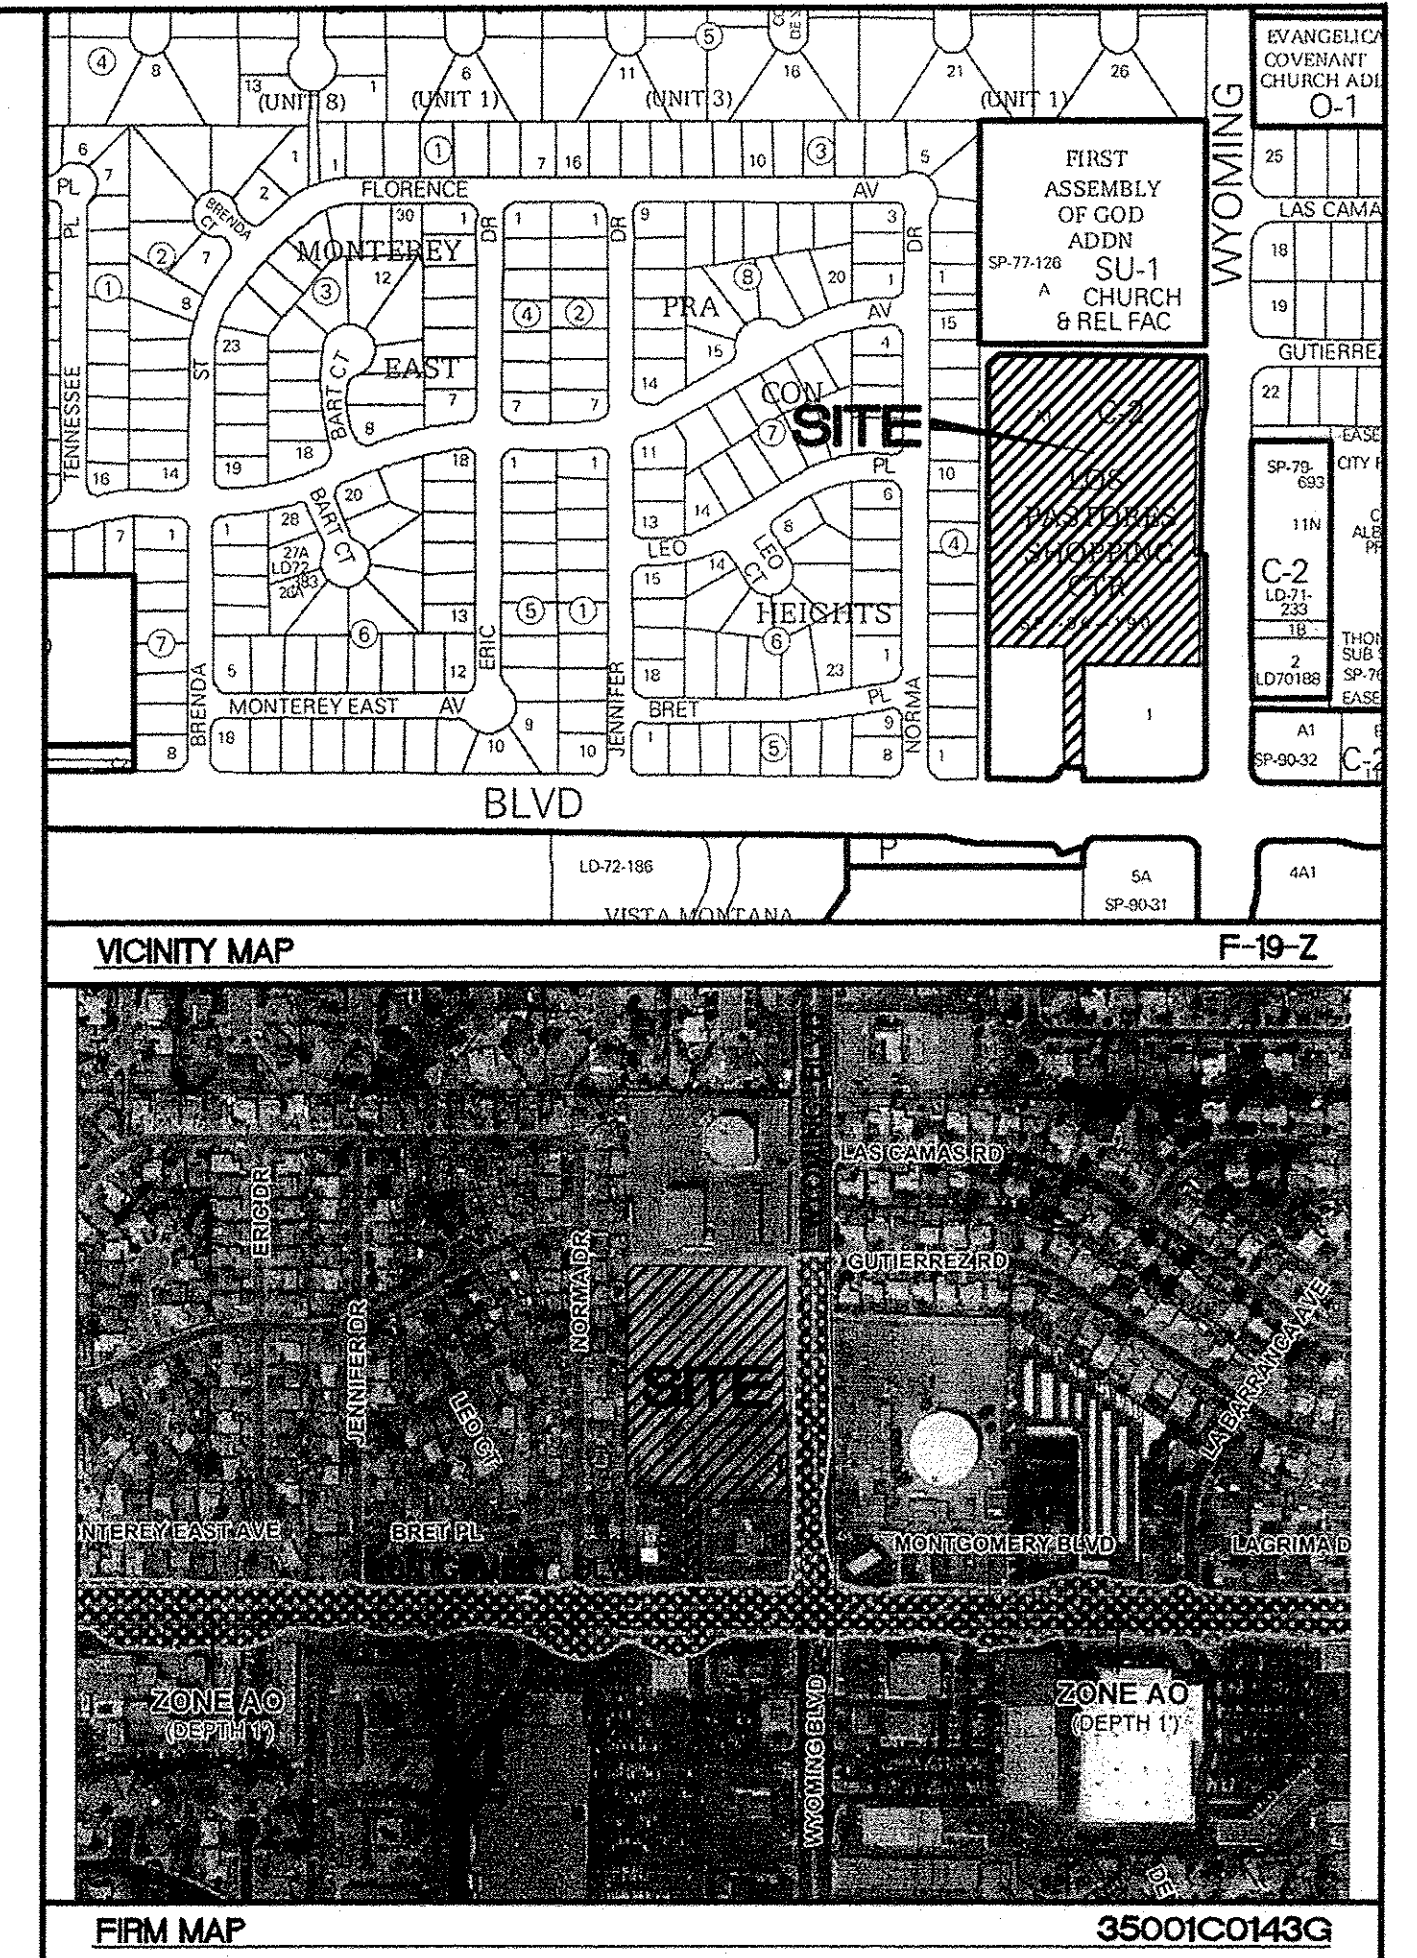


#### LEGEND

- CURB & GUTTER
- BOUNDARY LINE
- EASEMENT
- SIDEWALK
- EXISTING CURB & GUTTER
- SINGLE CLEAN OUT
- DOUBLE CLEAN OUT
- EXISTING SD MANHOLE
- EXISTING SAS MANHOLE
- EXISTING FIRE HYDRANT
- EXISTING WATER METER
- EXISTING POWER POLE
- EXISTING GAS VALVE
- U — EXISTING OVERHEAD UTILITIES
- EXISTING GAS
- EX. 8" SAS — EXISTING SANITARY SEWER LINE
- EX. WL — EXISTING WATER LINE
- EX. RCP — EXISTING STORM SEWER LINE
- 4900 — EXISTING INDEX CONTOUR
- EXISTING CONTOUR


#### FOR REFERENCE ONLY

|                 |                                                                                                                          |                        |
|-----------------|--------------------------------------------------------------------------------------------------------------------------|------------------------|
| ENGINEER'S SEAL | LOS PASTORES SHOPPING CENTER                                                                                             | DRAWN BY<br>DY         |
|                 |                                                                                                                          |                        |
|                 | GRADING PLAN                                                                                                             | DATE<br>1/27/17        |
|                 |                                                                                                                          | 2014052-GR-1           |
|                 | <b>TIERRA WEST, LLC</b><br>5571 MIDWAY PARK PLACE NE<br>ALBUQUERQUE, NM 87109<br>(505) 858-3100<br>www.tierrawestllc.com | SHEET #<br><b>GR-1</b> |
|                 |                                                                                                                          | JOB #<br>2014052       |

REVISED SHEET GR-1

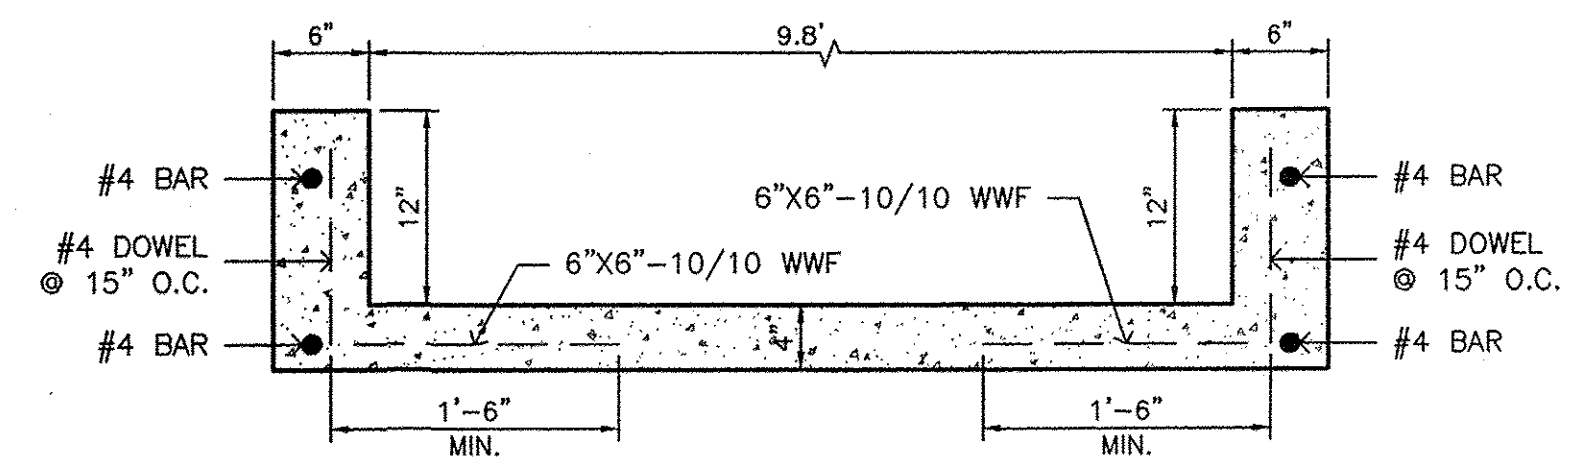

**SECTION B-B**  
NTS

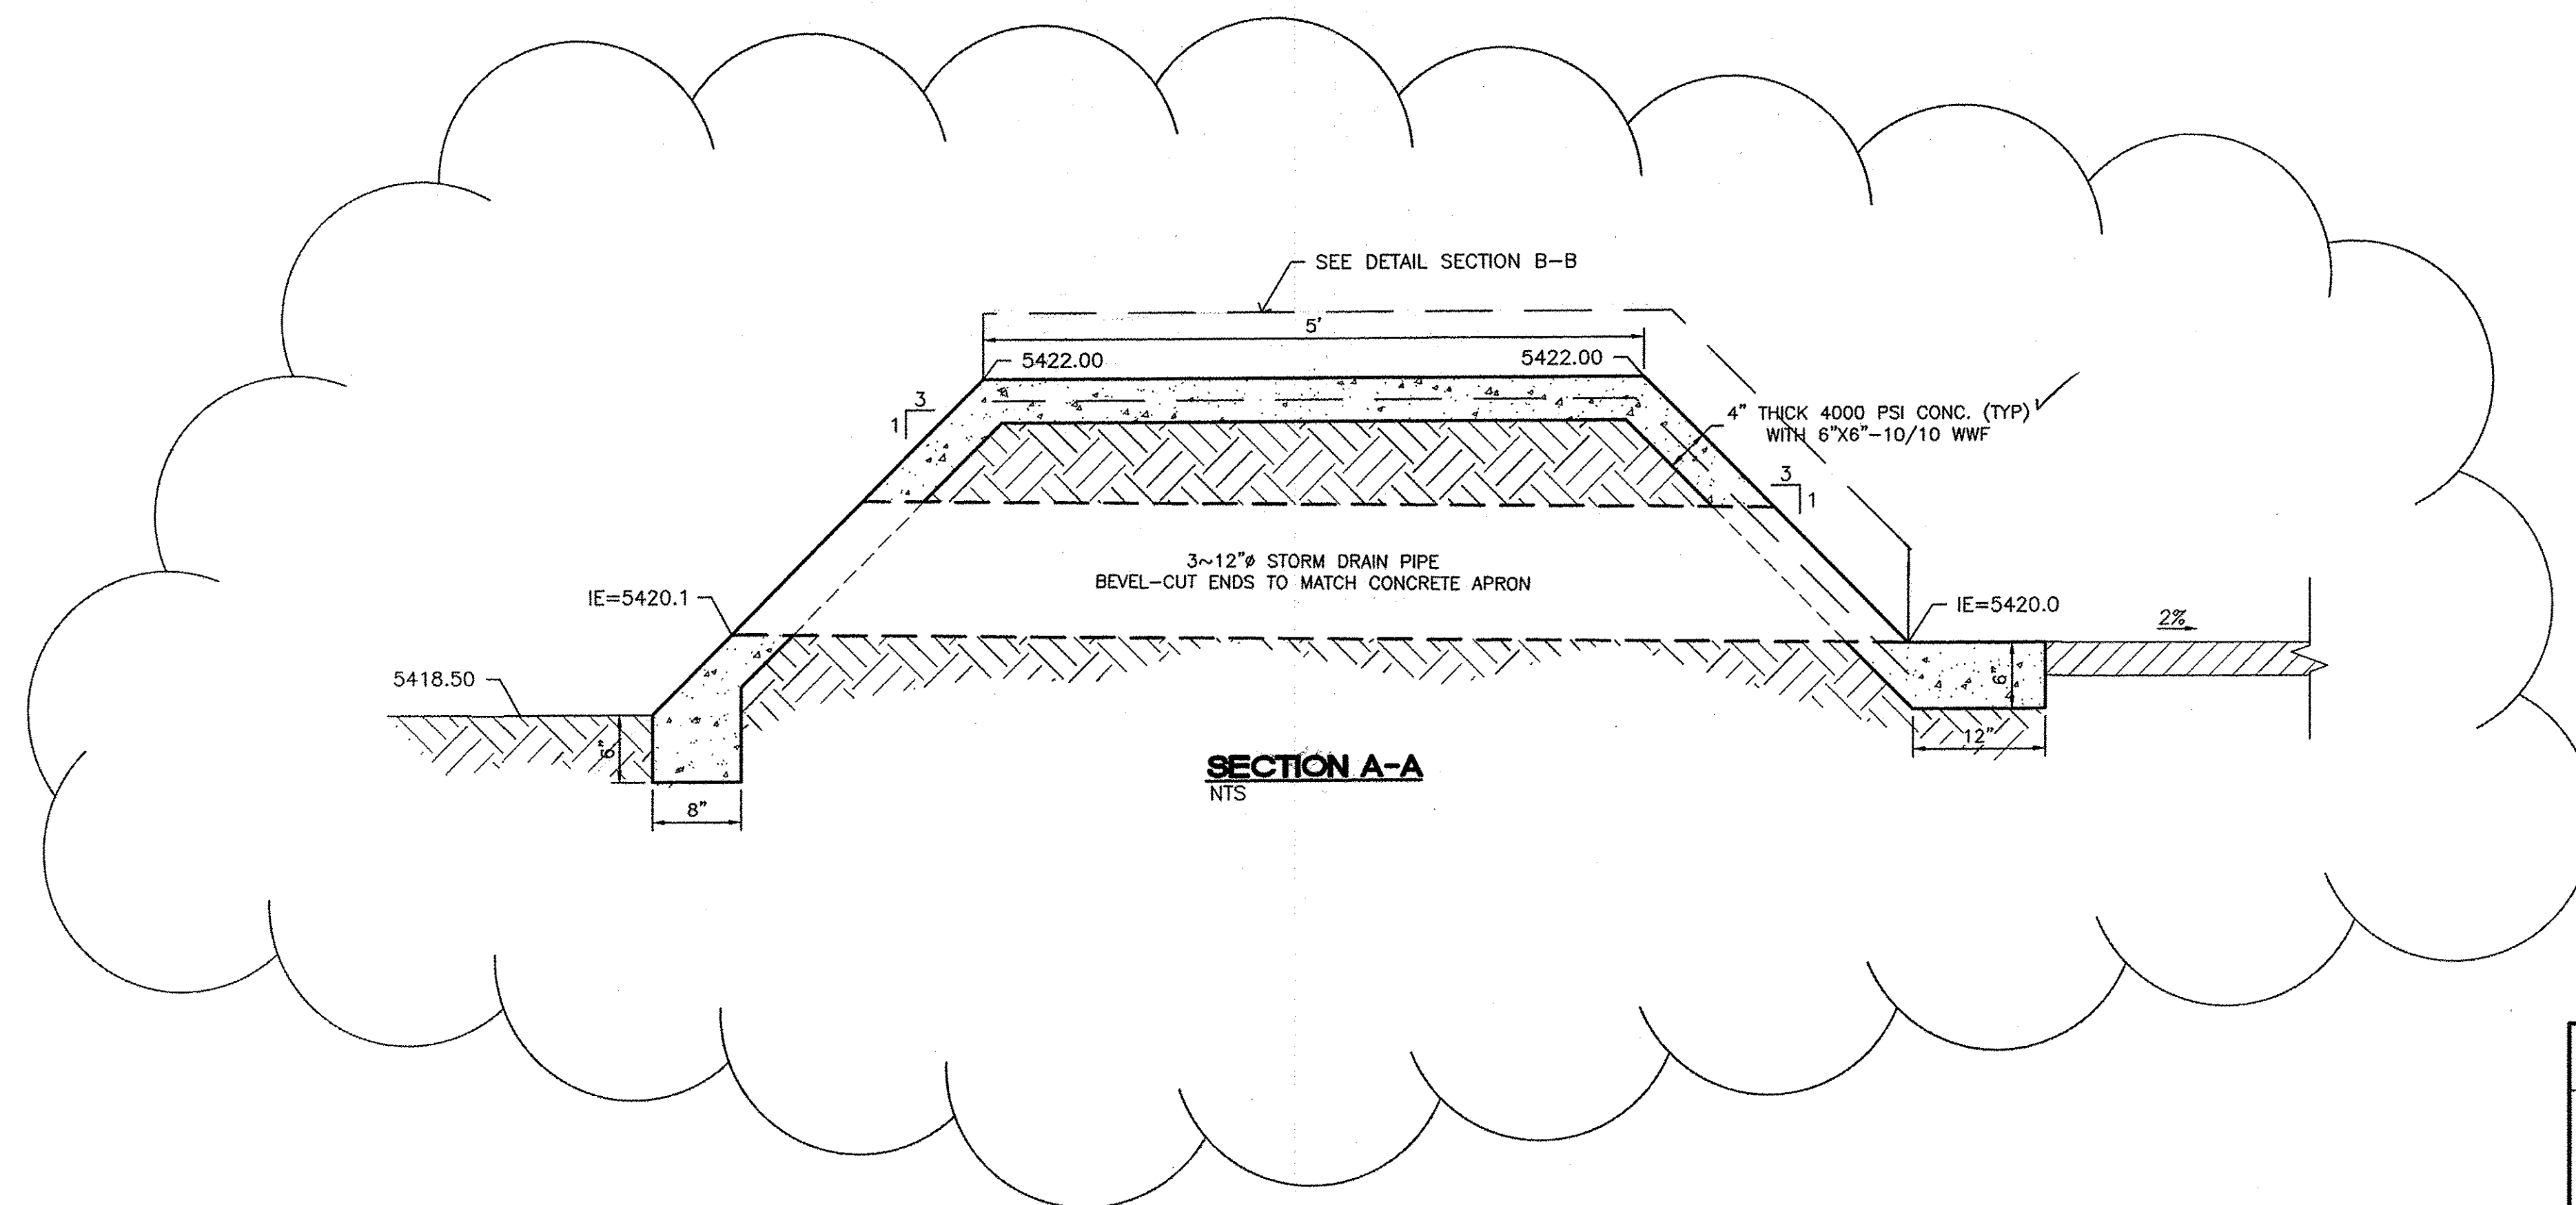

**SECTION A-A**  
NTS

**FOR REFERENCE ONLY**


|                                  |                                                                                                                          |                        |
|----------------------------------|--------------------------------------------------------------------------------------------------------------------------|------------------------|
| ENGINEER'S<br>SEAL               | LOS PASTORES<br>SHOPPING CENTER                                                                                          | DRAWN BY<br>DY         |
|                                  | GRADING DETAILS                                                                                                          | DATE<br>4/29/16        |
|                                  |                                                                                                                          | 2014052-GR-2           |
| JOEL D. HERNANDEZ<br>P.E. #17893 | <b>TIERRA WEST, LLC</b><br>5571 MIDWAY PARK PLACE NE<br>ALBUQUERQUE, NM 87109<br>(505) 858-3100<br>www.tierrowestllc.com | SHEET #<br><b>GR-2</b> |
|                                  |                                                                                                                          | JOB #<br>2014052       |

REVISED SHEET GR-2

**NOTES:**


1. CONCRETE SHALL BE 4000 PSI.
2. ALL REINFORCING STEEL #4 BARS. ALL VERTICAL AND HORIZONTAL TIE BARS 18" MAXIMUM SPACING.

| D   | H     | L     |
|-----|-------|-------|
| 12" | 2'-8" | 7'-0" |

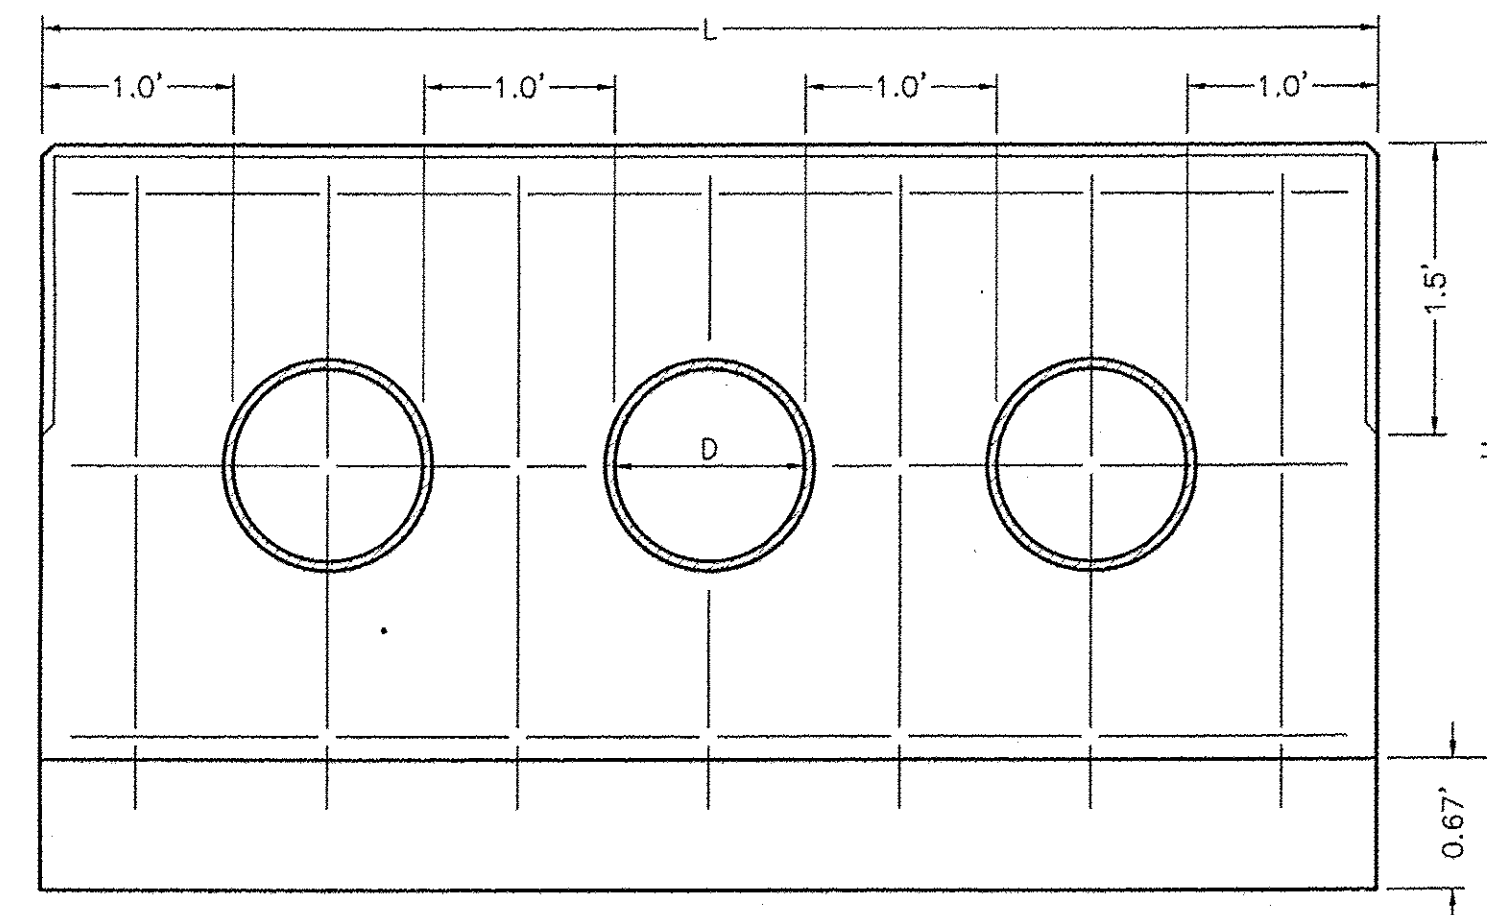


**ELEVATION**  
NTS


**CONCRETE HEADWALL**  
NTS

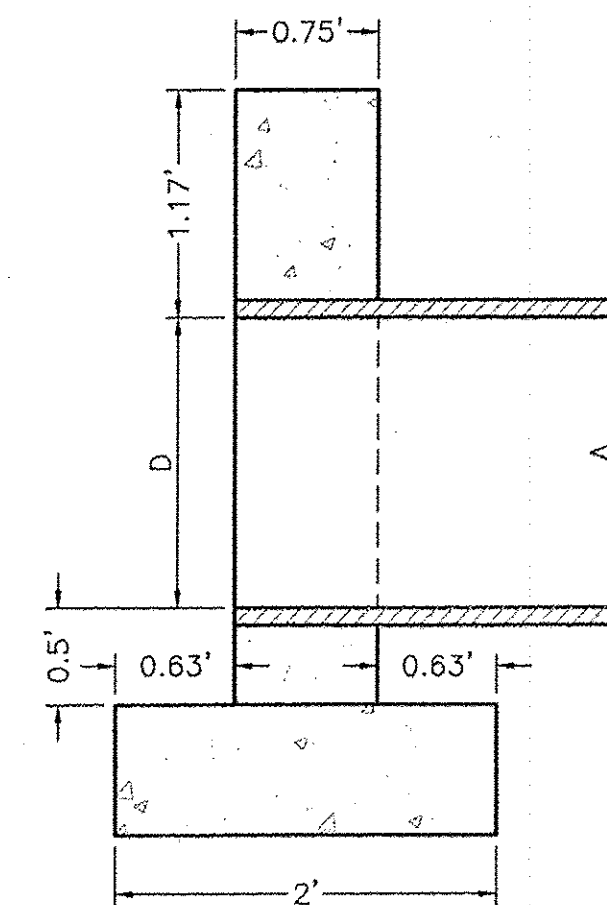

**SECTION**  
NTS

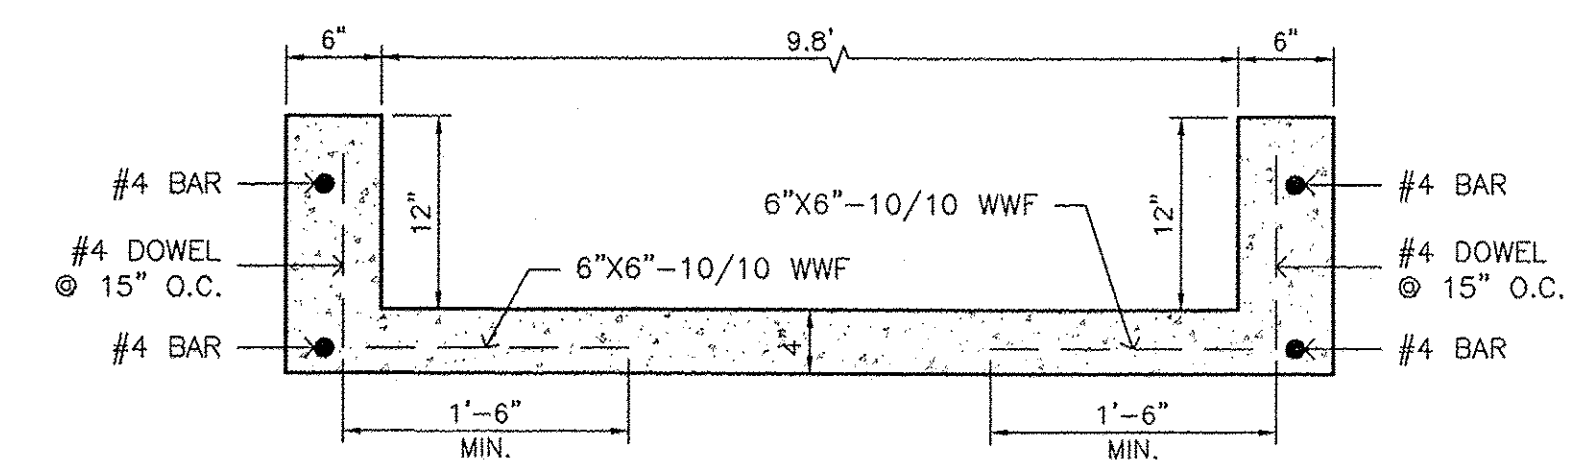

**SECTION B-B**  
NTS

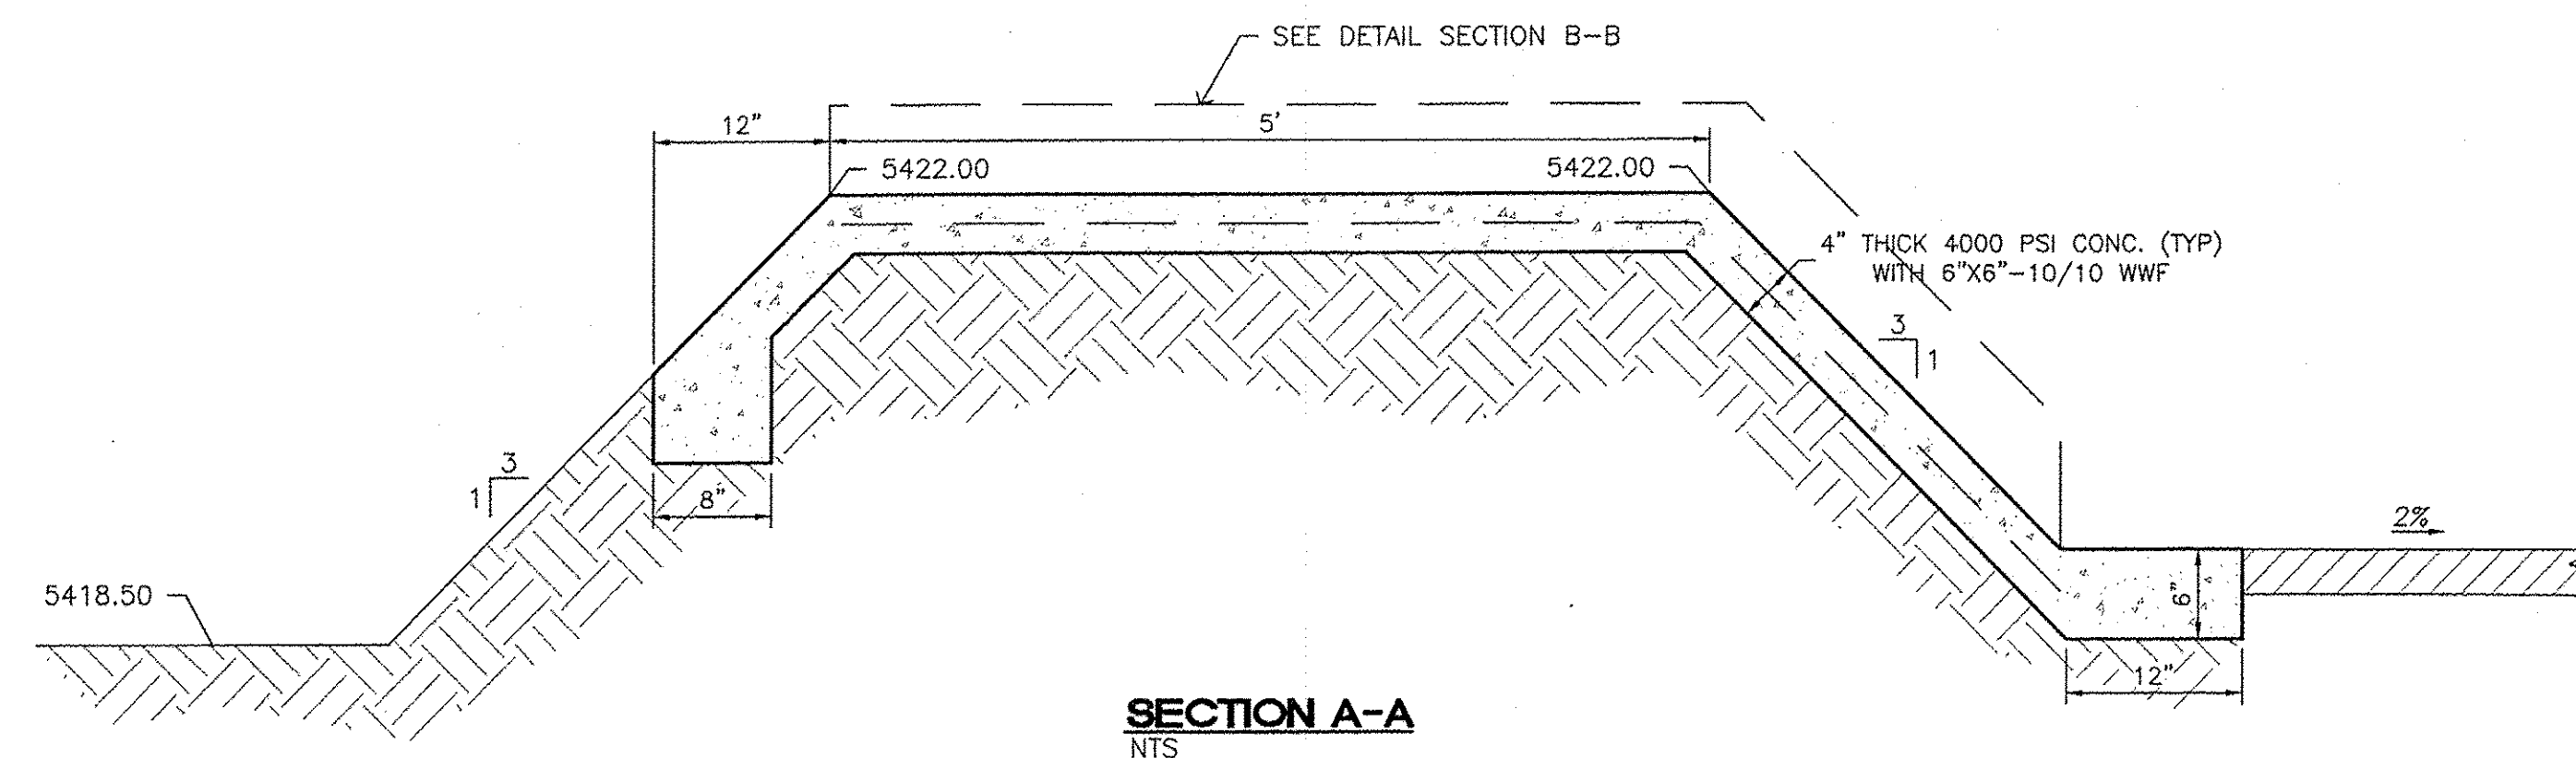


**SECTION A-A**  
NTS

FOR REFERENCE ONLY

|                                                                                                                         |                                     |                               |
|-------------------------------------------------------------------------------------------------------------------------|-------------------------------------|-------------------------------|
| <b>ENGINEER'S SEAL</b><br><br><b>JOEL D. HERNANDEZ</b><br>P.E. #17893                                                   | <b>LOS PASTORES SHOPPING CENTER</b> | <b>DRAWN BY</b><br>DY         |
|                                                                                                                         | <b>GRADING DETAILS</b>              | <b>DATE</b><br>4/29/16        |
| <b>TERRA WEST, LLC</b><br>5571 MIDWAY PARK PLACE NE<br>ALBUQUERQUE, NM 87109<br>(505) 858-3100<br>www.tierrowestllc.com |                                     | <b>2014052-GR-2</b>           |
|                                                                                                                         |                                     | <b>SHEET #</b><br><b>GR-2</b> |
|                                                                                                                         |                                     | <b>JOB #</b><br>2014052       |
|                                                                                                                         |                                     |                               |

(SEE REVISED SHEET GR-2)

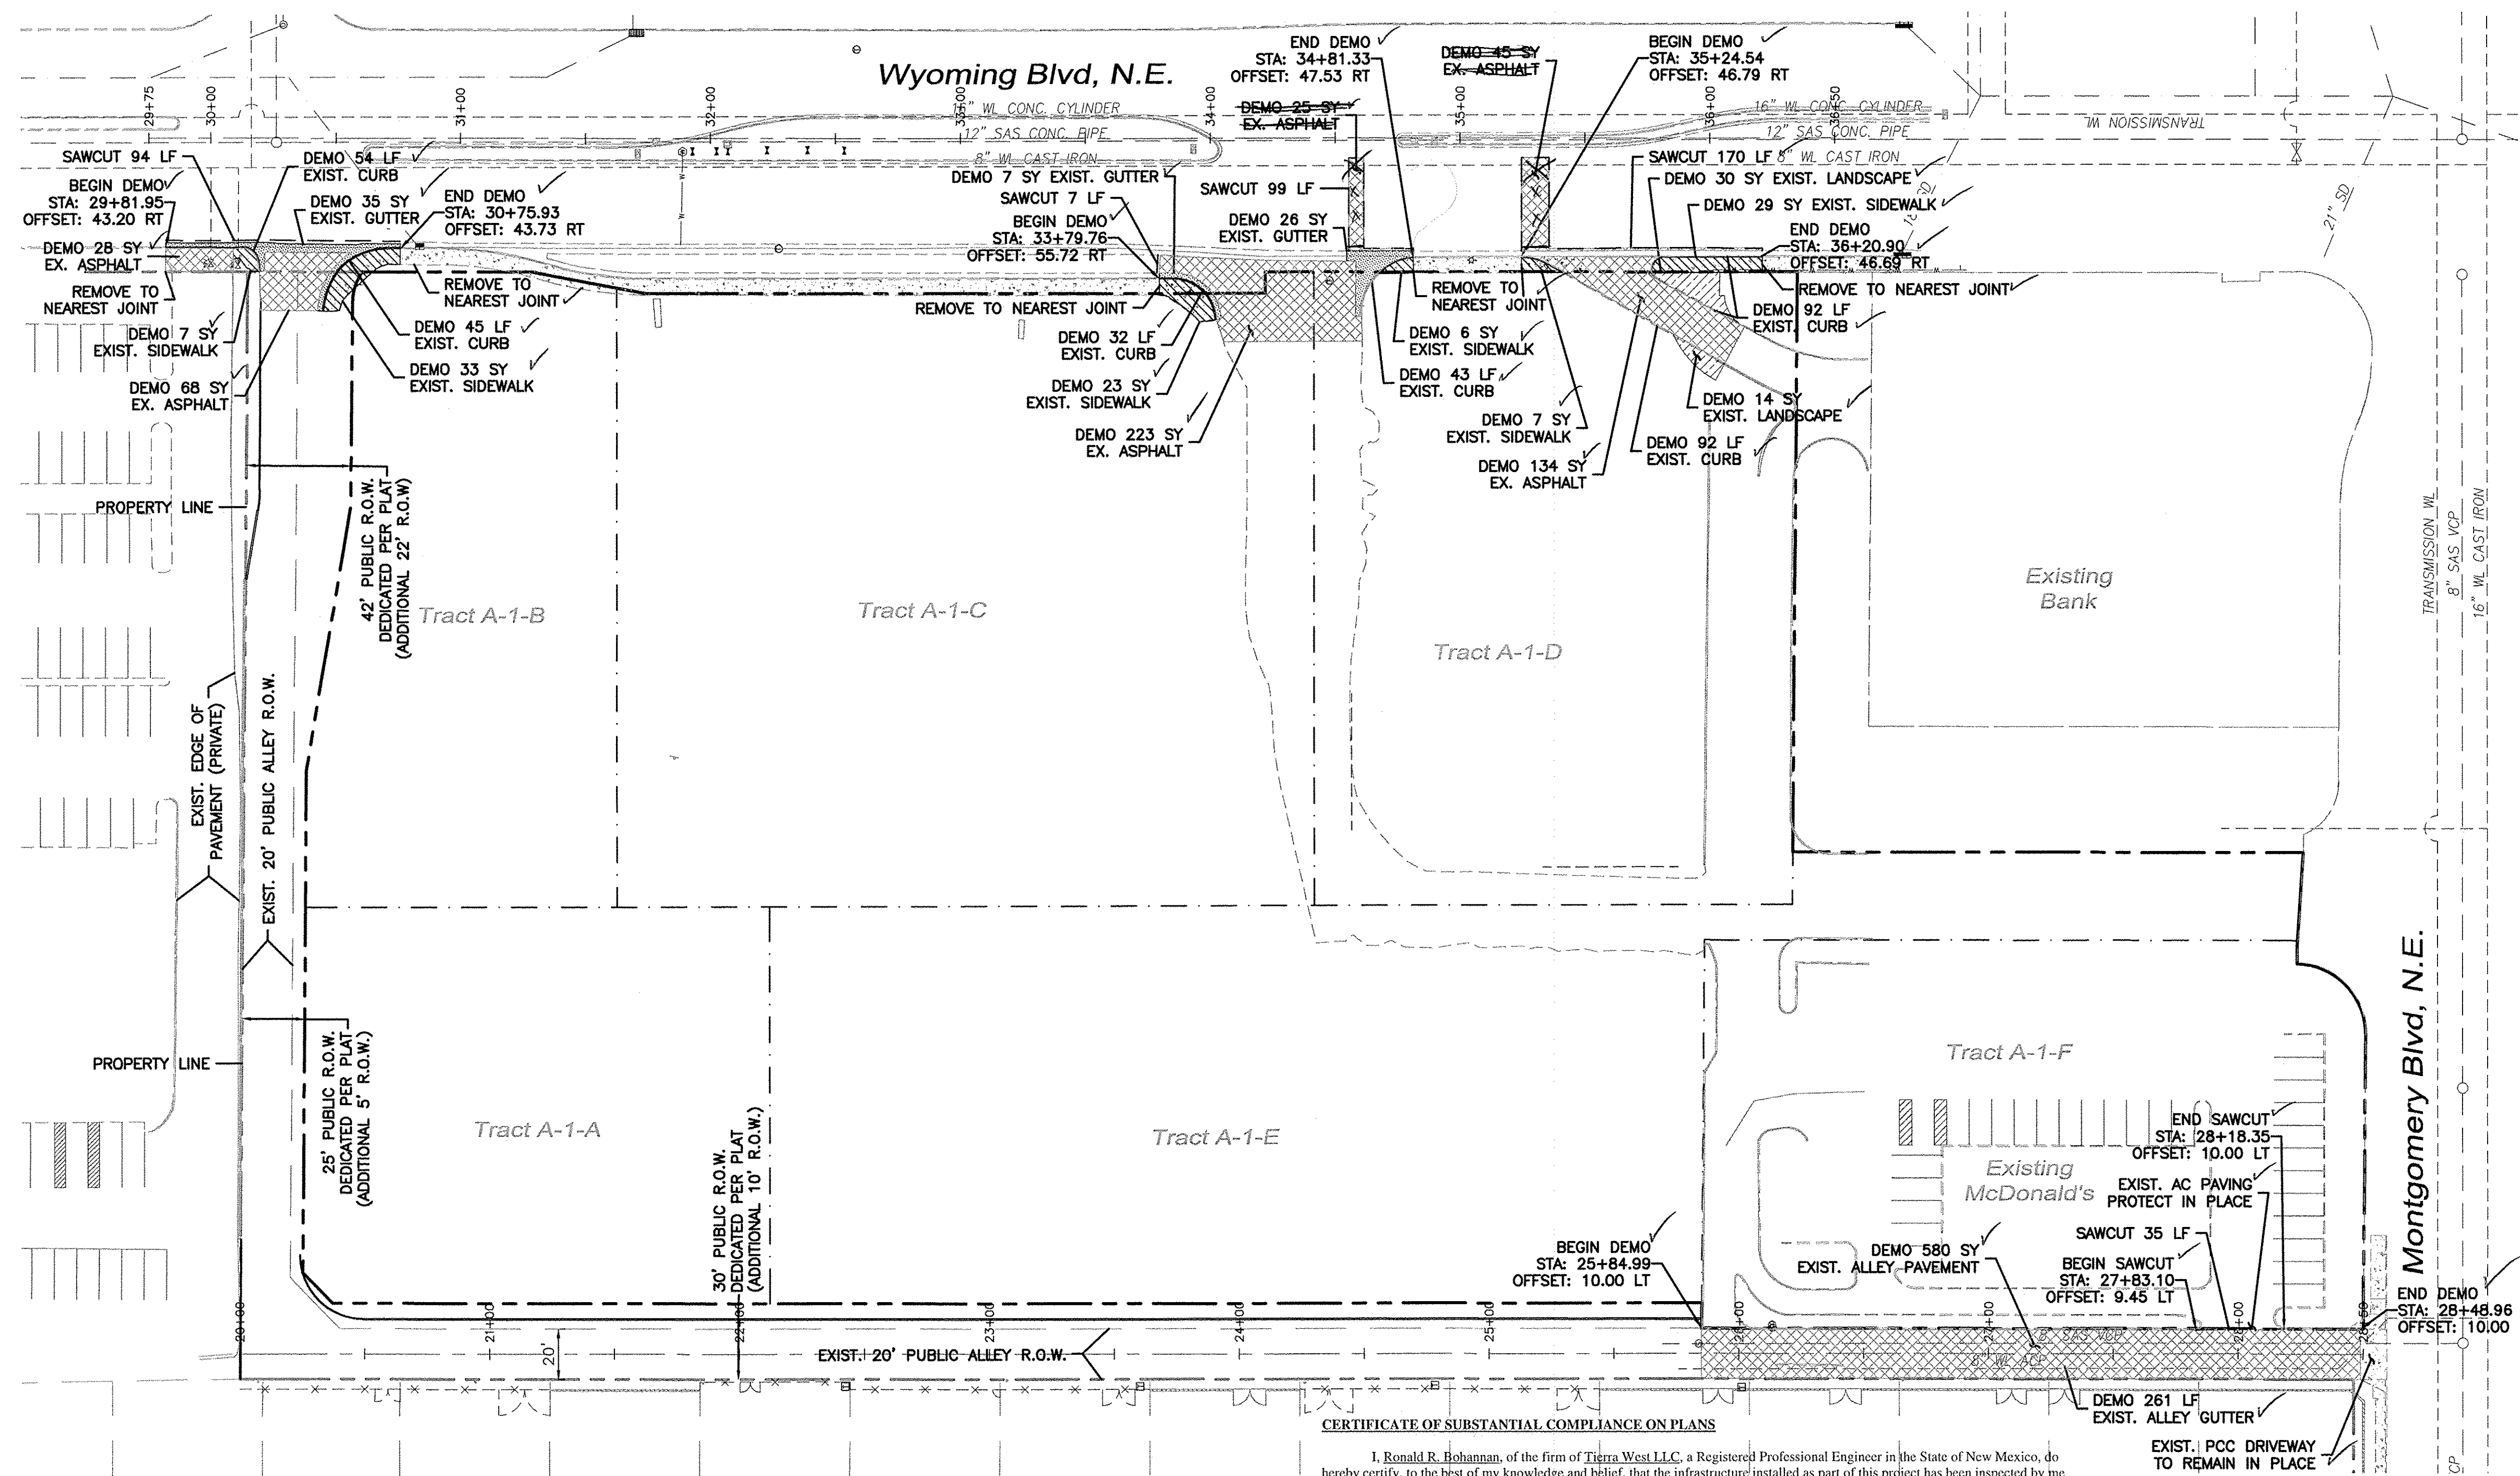

### CERTIFICATE OF SUBSTANTIAL COMPLIANCE ON PLANS

I, Ronald R. Bohannon, of the firm of Tierra West LLC, a Registered Professional Engineer in the State of New Mexico, do hereby certify, to the best of my knowledge and belief, that the infrastructure installed as part of this project has been inspected by me or by a qualified person under my direct supervision and has been constructed in accordance with the plans and specifications approved by the City Engineer and that the original design intent of the approved plans has been met, except as noted by me on the as-built construction drawings. This Certification is based on site inspections by me, or personnel under my direction with survey information provided by Russ P. Hugg, of Survey Tech, Inc., NMPMS number 9550

## NOTICE TO CONTRACTORS


1. AN EXCAVATION/CONSTRUCTION PERMIT WILL BE REQUIRED BEFORE BEGINNING ANY WORK WITHIN CITY RIGHT-OF-WAY.
2. ALL WORK DETAILED ON THESE PLANS TO BE PERFORMED, EXCEPT AS OTHERWISE STATED OR PROVIDED HEREON, SHALL BE CONSTRUCTED IN ACCORDANCE WITH CITY OF ALBUQUERQUE INTERIM STANDARD SPECIFICATIONS FOR PUBLIC WORKS CONSTRUCTION, 1985.
3. TWO WORKING DAYS PRIOR TO ANY EXCAVATION, CONTRACTOR MUST CONTACT LINE LOCATING SERVICE, 811, FOR LOCATION OF EXISTING UTILITIES.
4. PRIOR TO CONSTRUCTION, THE CONTRACTOR SHALL EXCAVATE AND VERIFY THE HORIZONTAL AND VERTICAL LOCATIONS OF ALL CONNECTIONS. SHOULD A CONFLICT EXIST, THE CONTRACTOR SHALL NOTIFY THE ENGINEER SO THAT THE CONFLICT CAN BE RESOLVED WITH A MINIMUM AMOUNT OF DELAY.
5. BACKFILL COMPACTION SHALL BE ACCORDING TO TRAFFIC/STREET USE.
6. MAINTENANCE OF THESE FACILITIES SHALL BE THE RESPONSIBILITY OF THE OWNER OF THE PROPERTY SERVED.
7. WORK ON ARTERIAL STREETS SHALL BE PERFORMED ON A 24-HOUR BASIS.

**NOTES:**

1. REMOVAL OF EXISTING CURB & GUTTER SHALL BE TO THE NEAREST JOINT.
2. ANY DAMAGE TO THE EXISTING CURB & GUTTER, PAVEMENT, SIDEWALKS, STRIPING, AND SIGNAGE DURING CONSTRUCTION SHALL BE REPLACED.
3. OVERNIGHT PARKING OF CONSTRUCTION EQUIPMENT SHALL NOT OBSTRUCT DRIVEWAYS OR DESIGNATED TRAFFIC LANES. THE CONTRACTOR SHALL NOT STORE ANY EQUIPMENT OR MATERIAL WITHIN THE PUBLIC RIGHT-OF-WAY.
4. CURB AND GUTTER, SIDEWALKS, AND DRIVE PADS SHALL MATCH THE ELEVATIONS OF ABUTTING EXISTING AREAS AS SHOWN ON THE PLANS OR AS DIRECTED BY THE PROJECT ENGINEER.
5. THE SUBGRADE PREP SHALL EXTEND ONE FOOT BEYOND THE FREE EDGE OF NEW CURB AND GUTTER AND SIDEWALK.
6. CONTRACTOR TO TEST SUBGRADE R-VALUE PRIOR TO CONSTRUCTION. IN THE EVENT THE R-VALUE IS LESS THAN 50, REMOVE 2 FEET OF SUBGRADE MATERIAL AND IMPORT MATERIAL WITH R-VALUE GREATER THAN 50 OR CONTACT THE ENGINEER IMMEDIATELY SO THE PAVEMENT SECTION CAN BE MODIFIED.
7. CONTRACTOR SHALL BE RESPONSIBLE TO PROTECT ALL EXISTING SURFACE FEATURES AND UTILITIES, UNLESS OTHERWISE SHOWN.



## LEGEND

- |                                                                                       |                                  |
|---------------------------------------------------------------------------------------|----------------------------------|
|  | CURB & GUTTER                    |
|  | BOUNDARY LINE                    |
|  | EASEMENT                         |
|  | EXISTING CURB & GUTTER           |
|  | EXISTING BOUNDARY LINE           |
|  | EXISTING ASPHALT TO BE REMOVED   |
|  | EXISTING GUTTER TO BE REMOVED    |
|  | EXISTING LANDSCAPE TO BE REMOVED |
|  | EXISTING SIDEWALK TO BE REMOVED  |
|  | SAWCUT                           |

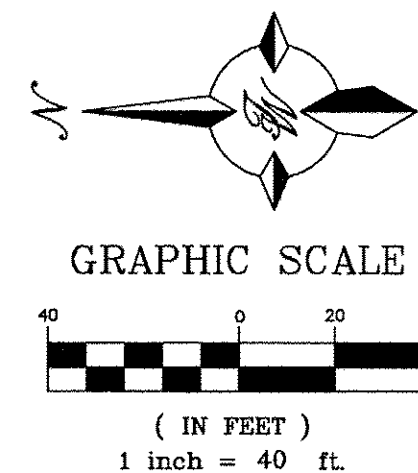

**CAUTION:**  
ALL EXISTING UTILITIES SHOWN WERE OBTAINED FROM RESEARCH, AS-BUILTS, SURVEYS OR INFORMATION PROVIDED BY OTHERS. IT SHALL BE THE SOLE RESPONSIBILITY OF THE CONTRACTOR TO CONDUCT ALL NECESSARY FIELD INVESTIGATIONS PRIOR TO AND INCLUDING ANY EXCAVATION, TO DETERMINE THE ACTUAL LOCATION OF UTILITIES AND OTHER IMPROVEMENTS, PRIOR TO STARTING THE WORK. ANY CHANGES FROM THIS PLAN SHALL BE COORDINATED WITH AND APPROVED BY THE ENGINEER.

[illegible]

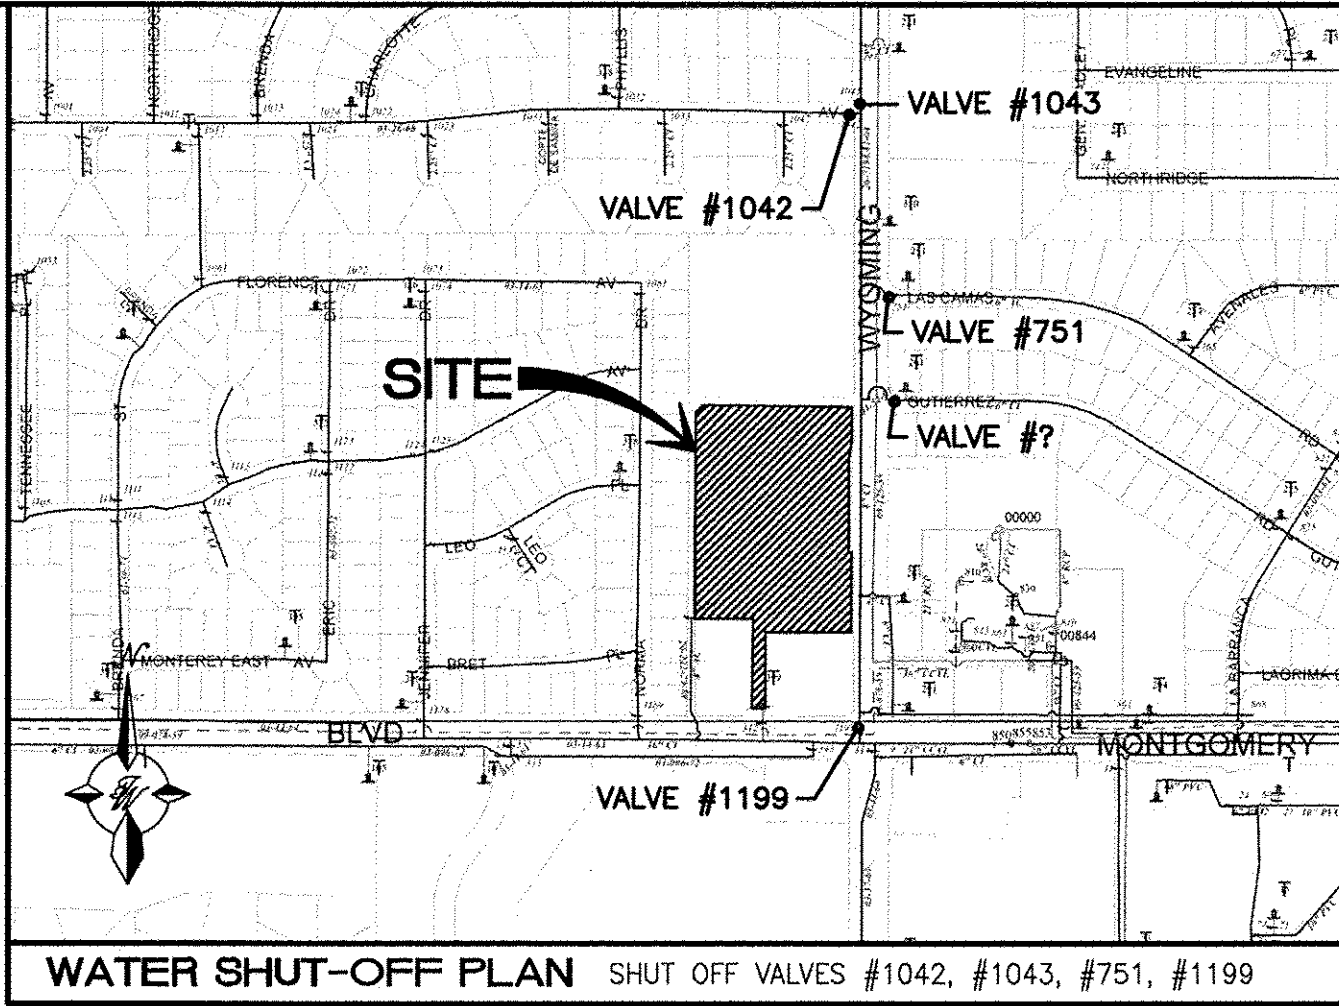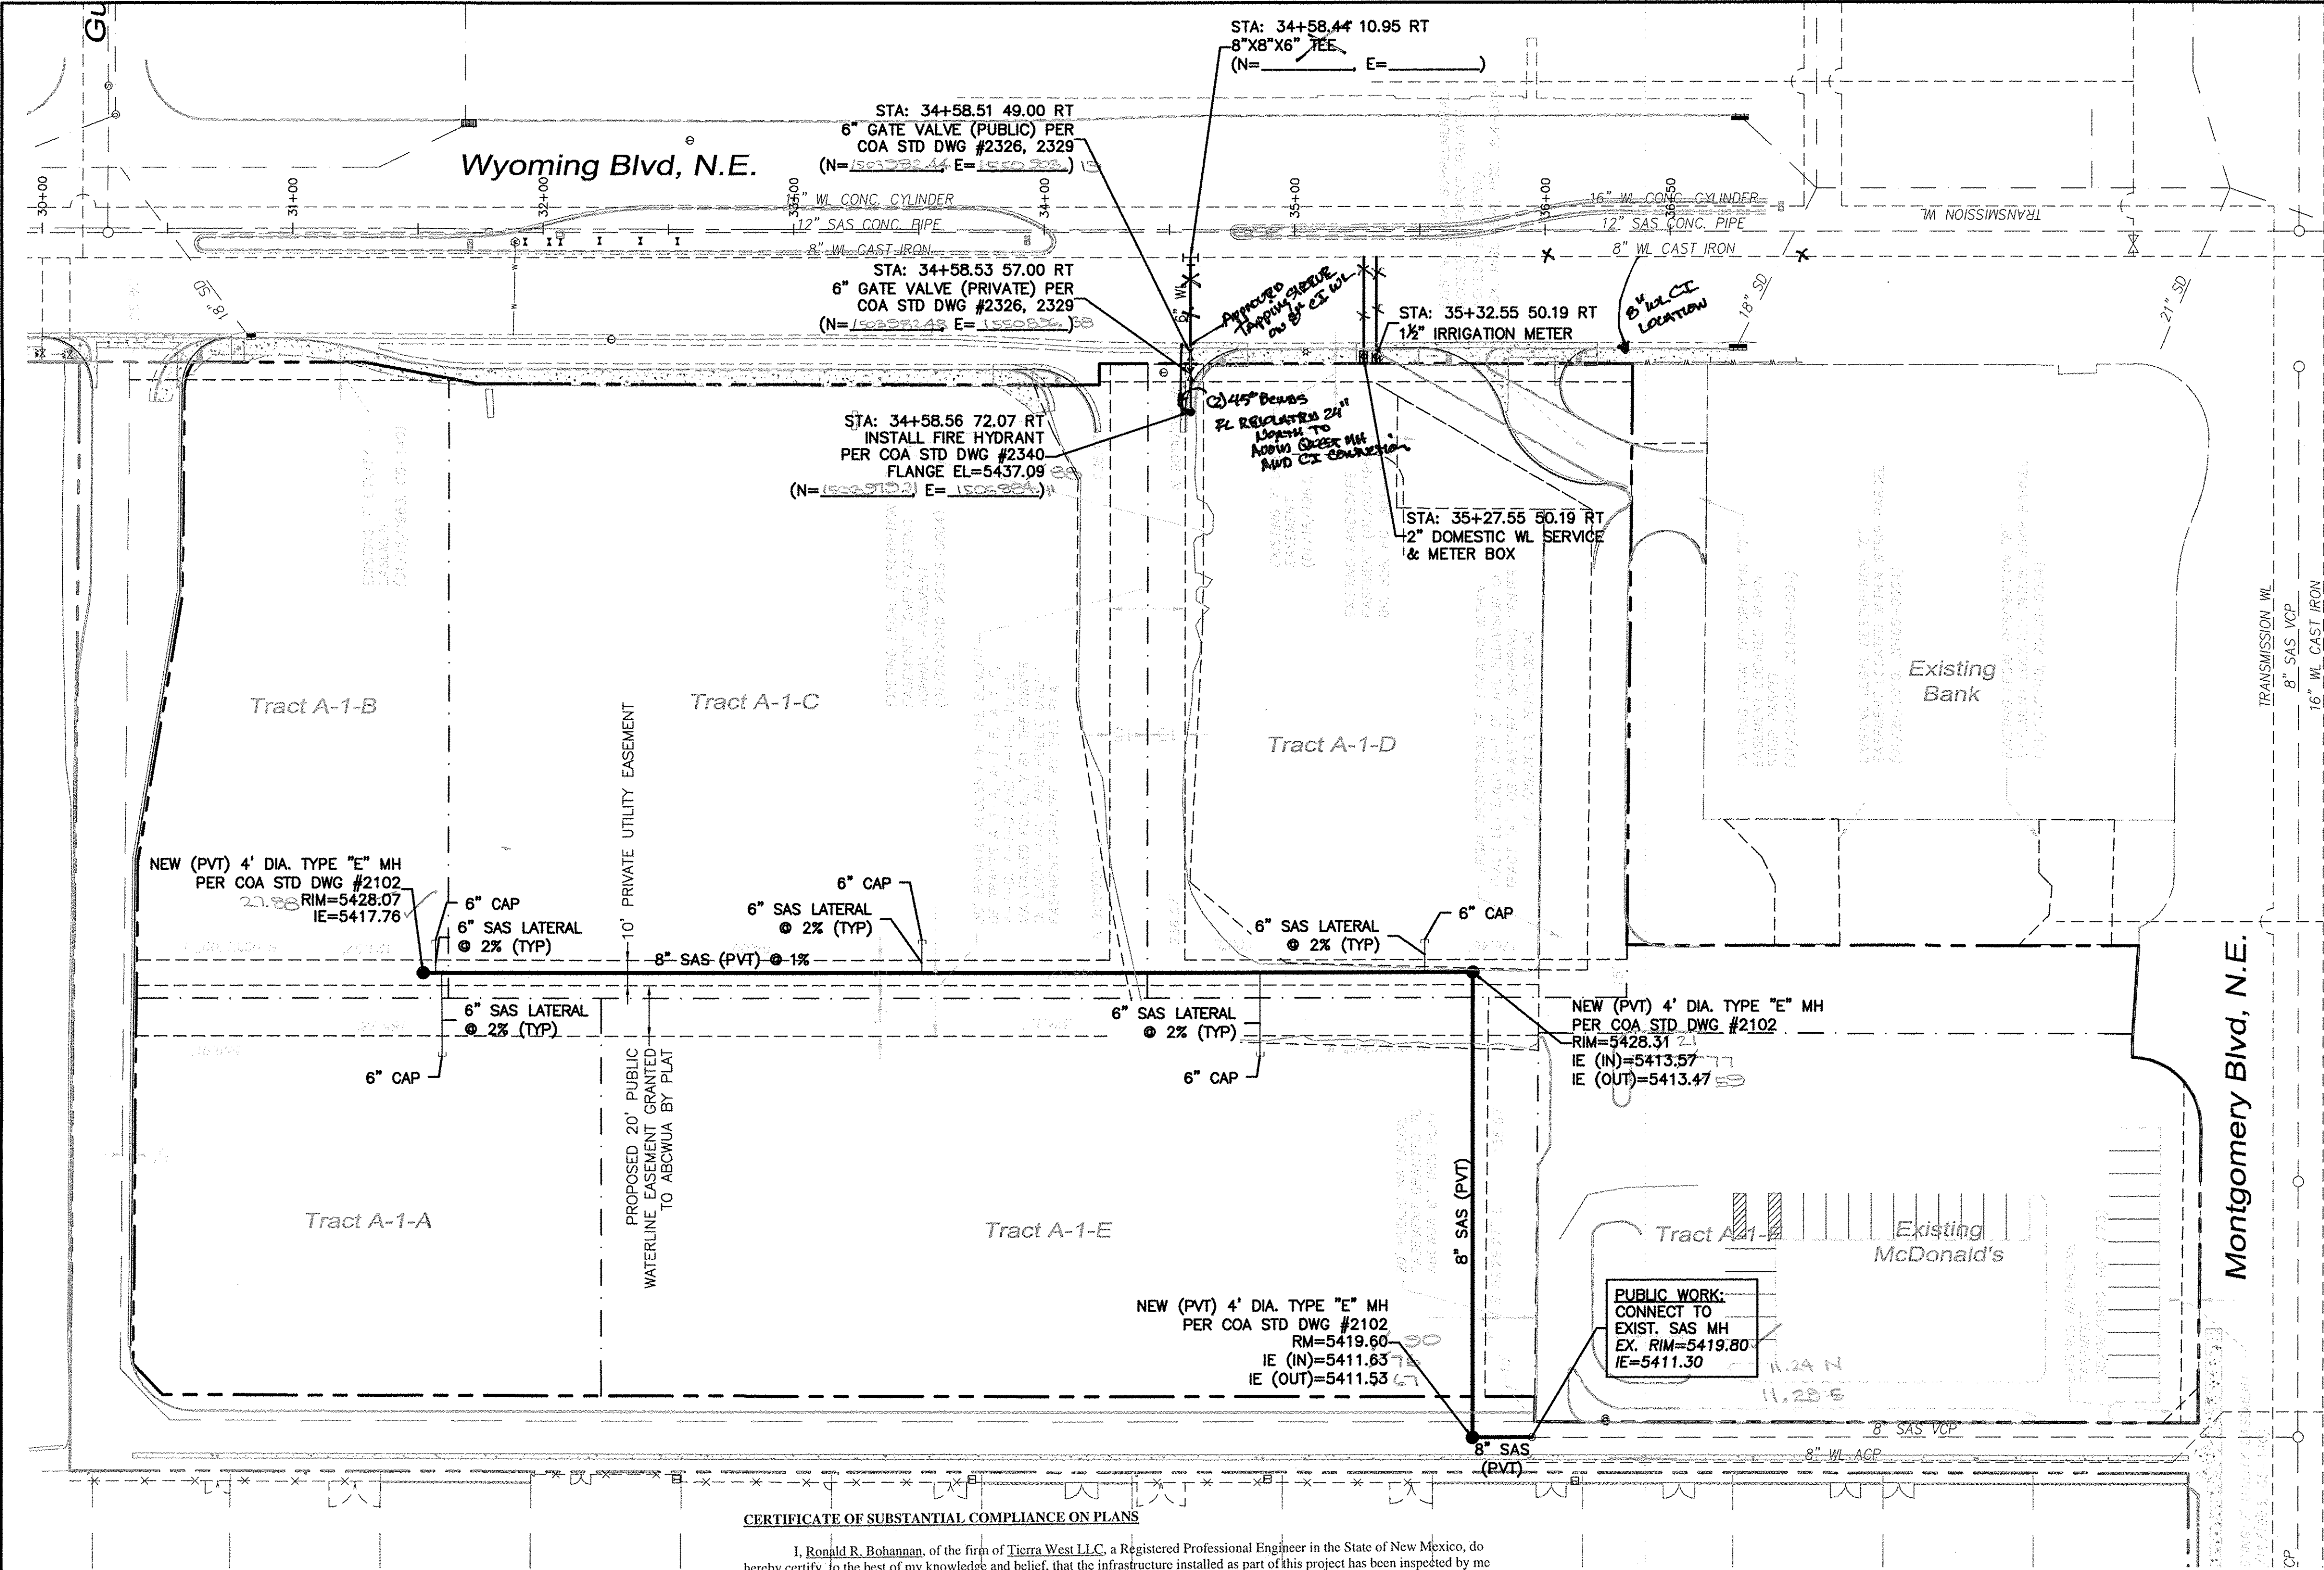


LEGEND

- CURB & GUTTER
- BOUNDARY LINE
- EASEMENT
- SIDEWALK
- RETAINING WALL
- EXISTING CURB & GUTTER
- EXISTING BOUNDARY LINE
- 36" SD — STORM SEWER LINE
- 8" SAS — SANITARY SEWER LINE
- 8" WL — WATERLINE
- DOUBLE CLEAN OUT
- EXISTING SD MANHOLE
- EXISTING INLET
- EXISTING SAS MANHOLE
- EXISTING FIRE HYDRANT
- EXISTING WATER METER
- EXISTING POWER POLE
- EXISTING GAS VALVE
- EXISTING OVERHEAD UTILITIES
- EX. UGE — EXISTING UNDERGROUND UTILITIES
- EX. 2" GAS — EXISTING GAS
- EX. 8" SAS — EXISTING SANITARY SEWER LINE
- EX. 10" WL — EXISTING WATER LINE
- EX. 18" RCP — EXISTING STORM SEWER LINE


CERTIFICATE OF SUBSTANTIAL COMPLIANCE ON PLANS (ABCWUA)

I, Ronald R. Bohannon, of the firm of Tierra West LLC, a Registered Professional Engineer in the State of New Mexico, do hereby certify, to the best of my knowledge and belief, that the infrastructure installed as part of this project has been inspected by me or by a qualified person under my direct supervision and has been constructed in accordance with the plans and specifications approved by the City Engineer and that the original design intent of the approved plans has been met, except as noted by me on the as-built construction drawings. This Certification is based on site inspections by me or personnel under my direction with survey information provided by Russ P. Hugg of Survtex, Inc., NMPS number 9750.

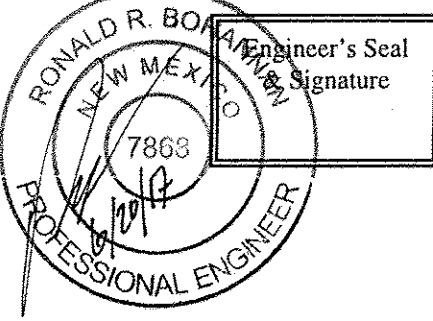

CERTIFICATE OF SUBSTANTIAL COMPLIANCE ON PLANS

I, Ronald R. Bohannon, of the firm of Tierra West LLC, a Registered Professional Engineer in the State of New Mexico, do hereby certify, to the best of my knowledge and belief, that the infrastructure installed as part of this project has been inspected by me or by a qualified person under my direct supervision and has been constructed in accordance with the plans and specifications approved by the City Engineer and that the original design intent of the approved plans has been met, except as noted by me on the as-built construction drawings. This Certification is based on site inspections by me or personnel under my direction with survey information provided by Russ P. Hugg of Survtex, Inc., NMPS number 9750.

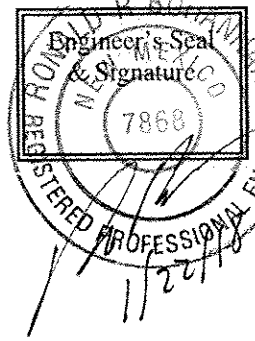

SURVEYORS CERTIFICATION

I, Russ P. Hugg, New Mexico Professional Surveyor Number 9750, hereby certify that the as-built information shown hereon is the result of an actual field survey performed by me or under my direct supervision and that the same is true and correct to the best of my knowledge and belief.

Russ P. Hugg  
NMPS No. 9750  
06/06, 2017



GENERAL UTILITY NOTES:


- ALL WATER AND SEWER UTILITY WORK TO BE DONE IN ACCORDANCE WITH COA STANDARDS AND SPECIFICATIONS LATEST EDITION.
- 3' MINIMUM BURY REQUIRED FOR ALL UTILITIES UNLESS OTHERWISE NOTED.
- CLEAN OUTS ARE TO BE BUILT PER UNIFORM PLUMBING CODE STANDARDS.
- ALL PLUMBING PIPE MATERIAL TO BE USED PER UPC.
- FIRE LINE AND DOMESTIC WATERLINE MUST HAVE BACKFLOW PREVENTORS PER UPC. IF BACKFLOW PREVENTOR IS INSTALLED EXTERIOR OF BUILDING A HOT BOX SHALL BE INSTALLED AND USED.
- ALL EX. SD INLETS AND MH SHALL HAVE CONCRETE COLLARS POURED AND BE ADJUSTED TO FINISHED GRADE.
- ALL EXCAVATION, TRENCHING AND SHORING ACTIVITIES MUST BE CARRIED-OUT IN ACCORDANCE WITH OSHA 29 CFR 1926.650 SUBPART P.
- ALL UTILITY DISTANCES SHOWN ARE FOR REFERENCE ONLY.
- REFERENCE ARCHITECTURAL PLANS FOR LIGHTING POWER ROUTING.

NOTES:


- ALL FIRE HYDRANTS ARE TO BE BUILT WITH MECH RESTRAINTS PER COA STANDARDS.
- ALL EXISTING UTILITY CONNECTION LOCATIONS AND INVERTS MUST BE FIELD VERIFIED PRIOR TO AND CONSTRUCTION OF UTILITIES.
- ALL WATERLINES ARE C900 PVC (DR18) UNLESS OTHERWISE NOTED ON PLAN ELEVATION.
- ALL METER BOXES PER COA STD DWG 2361, 2363, 2366, AND 2367.
- ALL PRIVATE HYDRANTS TO BE PAINTED ORANGE.

CAUTION:

ALL EXISTING UTILITIES SHOWN WERE OBTAINED FROM RESEARCH, AS-BUILTS, SURVEYS OR INFORMATION PROVIDED BY OTHERS. IT SHALL BE THE SOLE RESPONSIBILITY OF THE CONTRACTOR TO CONDUCT ALL NECESSARY FIELD INVESTIGATIONS PRIOR TO AND INCLUDING ANY EXCAVATION, TO DETERMINE THE ACTUAL LOCATION OF UTILITIES AND OTHER IMPROVEMENTS, PRIOR TO STARTING THE WORK. ANY CHANGES FROM THIS PLAN SHALL BE COORDINATED WITH AND APPROVED BY THE ENGINEER.

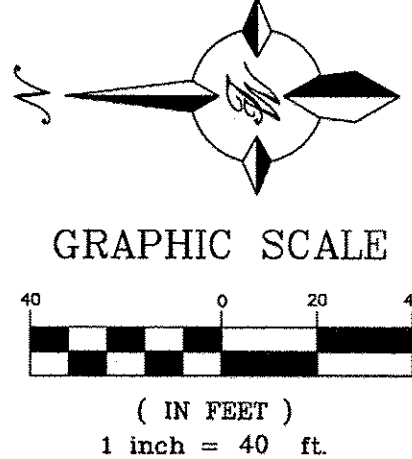


|                                                                                                                  |                                                                    |
|------------------------------------------------------------------------------------------------------------------|--------------------------------------------------------------------|
| TIERRA WEST, LLC<br>5571 MIDWAY PARK PLACE NE<br>ALBUQUERQUE, NM 87109<br>(505)858-3100<br>www.tierrawestllc.com |                                                                    |
| CITY OF ALBUQUERQUE<br>PUBLIC WORKS DEPARTMENT<br>ENGINEERING GROUP                                              |                                                                    |
| TITLE: LOS PASTORES SHOPPING CENTER<br>MASTER UTILITY PLAN                                                       |                                                                    |
| DESIGN REVIEW COMMITTEE<br>APPROVED<br>OCT 20 2016<br>DESIGN REVIEW COMMITTEE                                    | CITY ENGINEER APPROVAL<br>APPROVED<br>MAR 24 2017<br>CITY ENGINEER |
| CITY PROJECT NO.<br>719880                                                                                       | ZONE MAP NO.<br>F-19-Z                                             |
| SHEET<br>6                                                                                                       | OF<br>15                                                           |

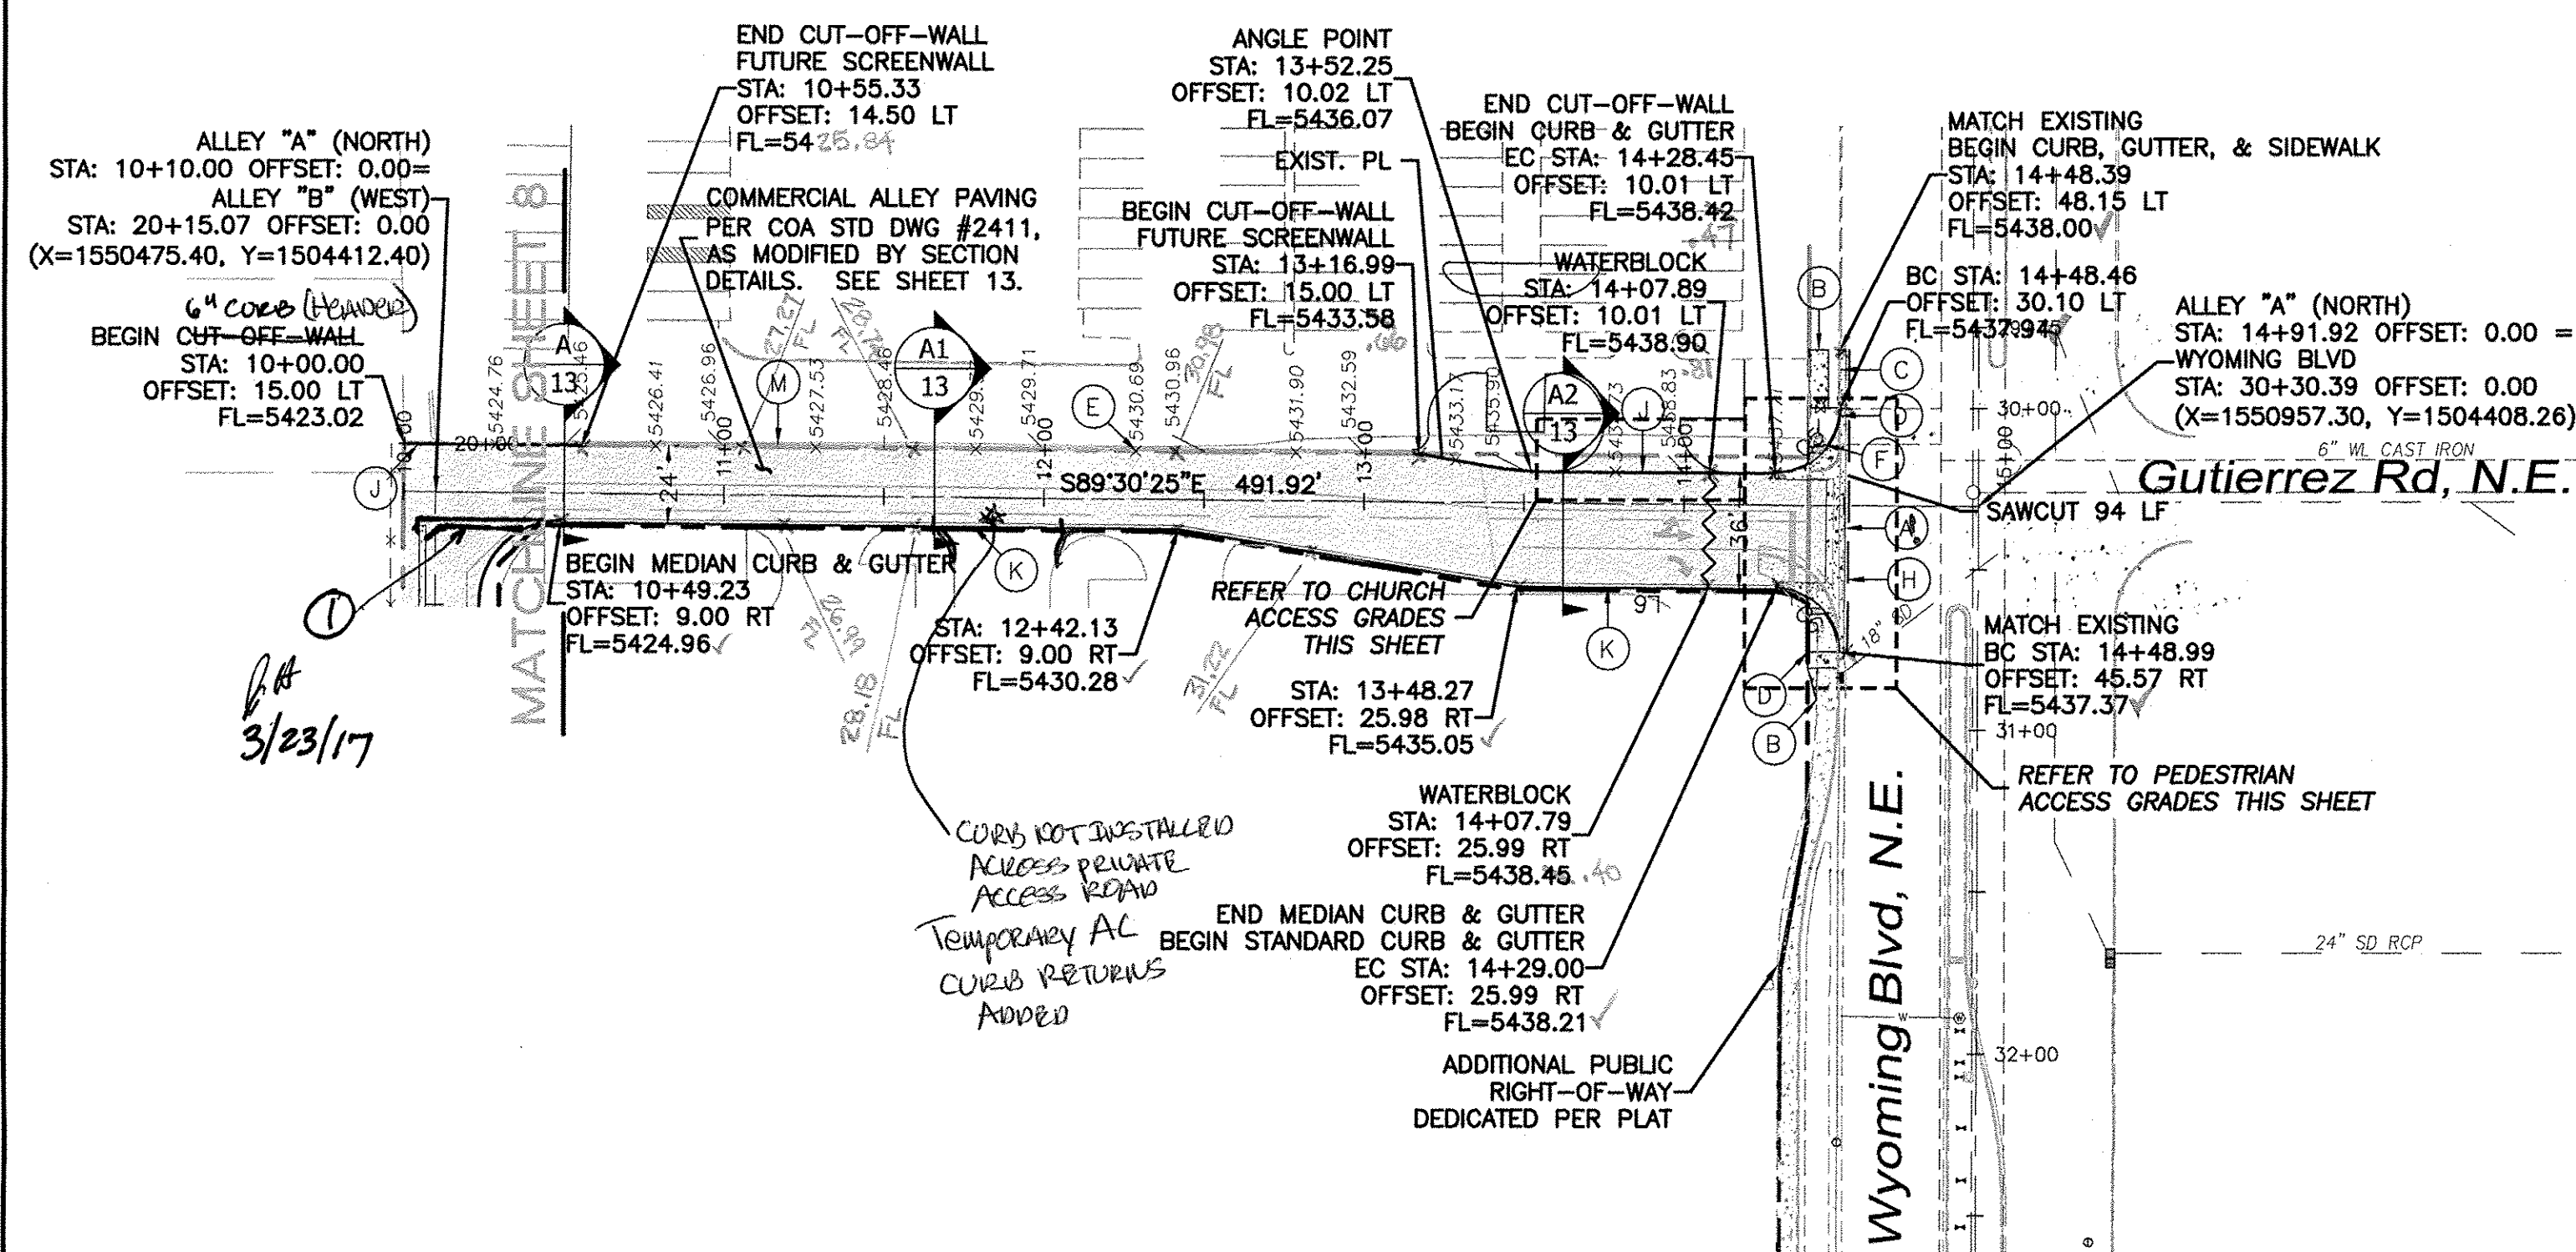

### SURVEYORS CERTIFICATION



I, Russ P. Hugg, New Mexico Professional Surveyor Number 9750, hereby certify that the as-built information shown hereon is the result of an actual field survey performed by me or under my direct supervision and that the same is true and correct to the best of my knowledge and belief.

Russ P. Hugg  
NMPS No. 9750

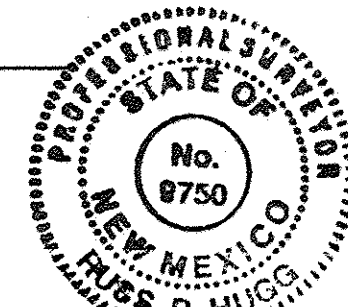


### CERTIFICATE OF SUBSTANTIAL COMPLIANCE ON PLANS

I, **Ronald R. Bohannon**, of the firm of **Tetra Tech LLC**, a Registered Professional Engineer in the State of New Mexico, do hereby certify that the best of my knowledge and belief, the infrastructure installed as part of this project has been inspected by me or by a qualified person under my direct supervision and has been constructed in accordance with the plans and specifications approved by the City Engineer and that the original design intent of the approved plans has been met, except as noted by me on the as-built construction drawings. This Certification is based on site inspections by me, or personnel under my direction with survey information provided by **Russ P. Hugg**, of **Survey-Tech, Inc.**, NMPIS number **9550**.

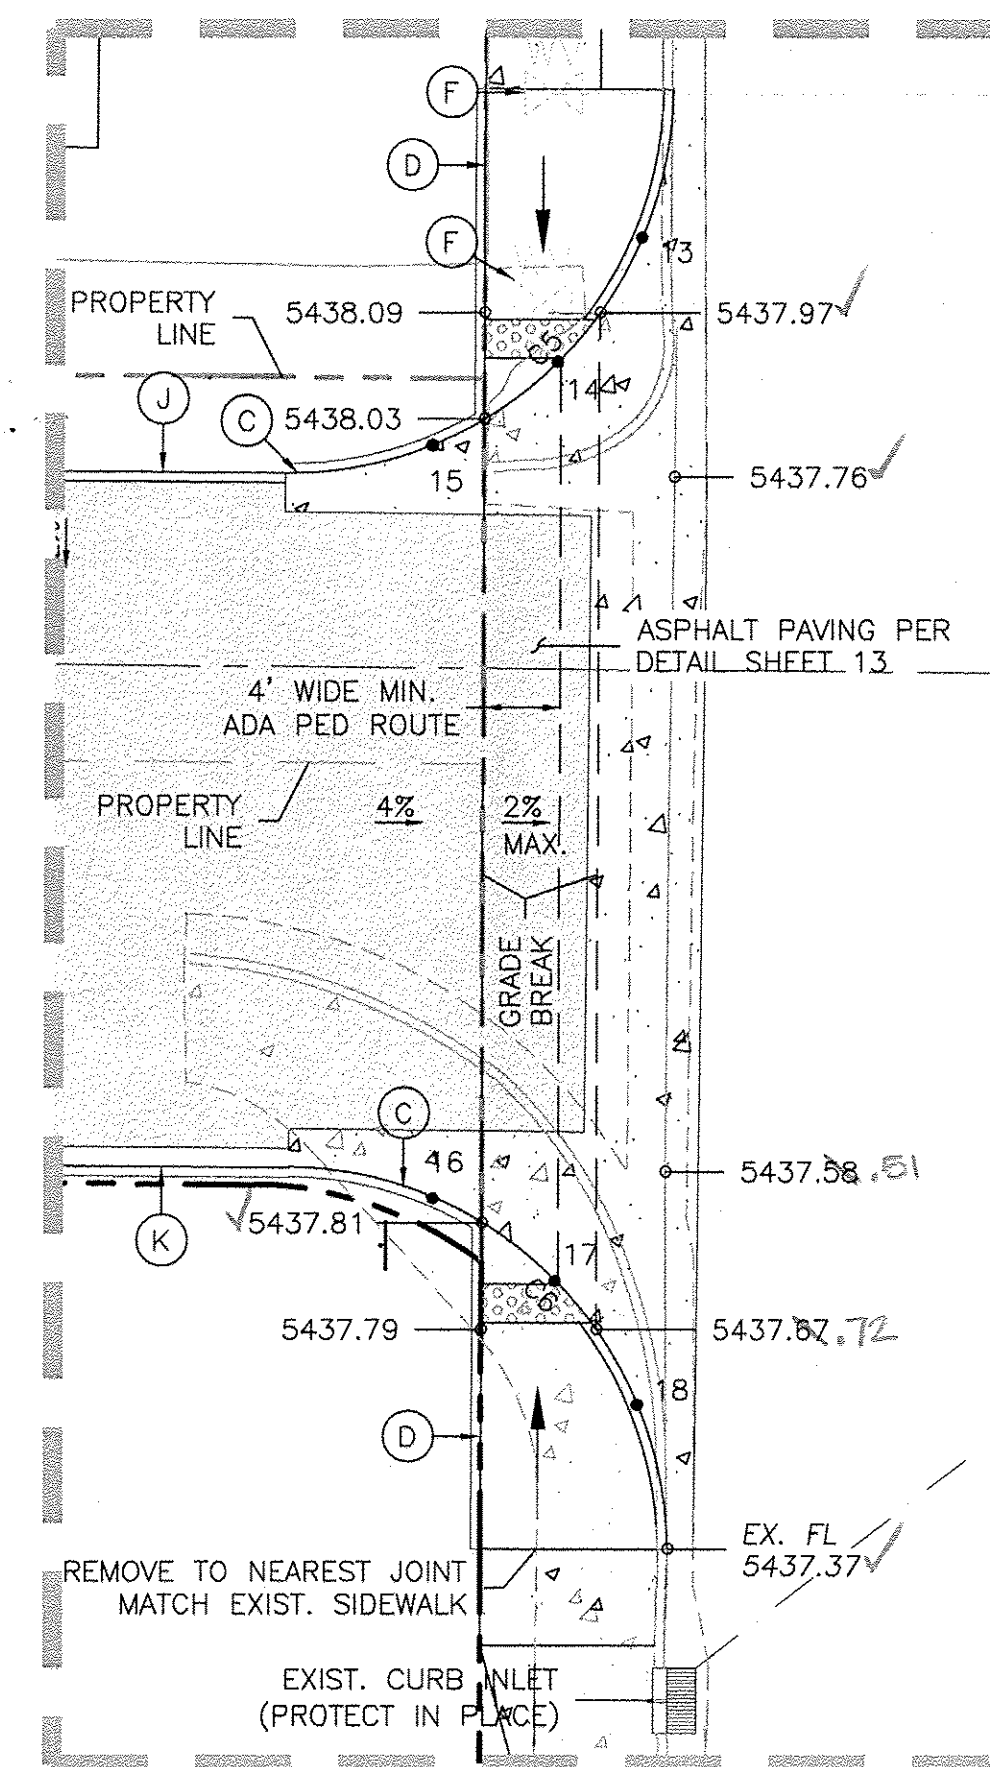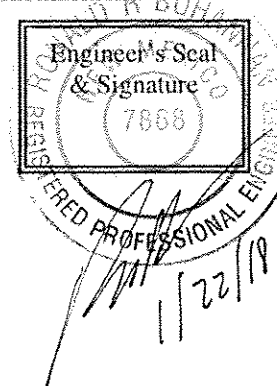


## PEDESTRIAN ACCESS GRADES

SC: 1"=10'

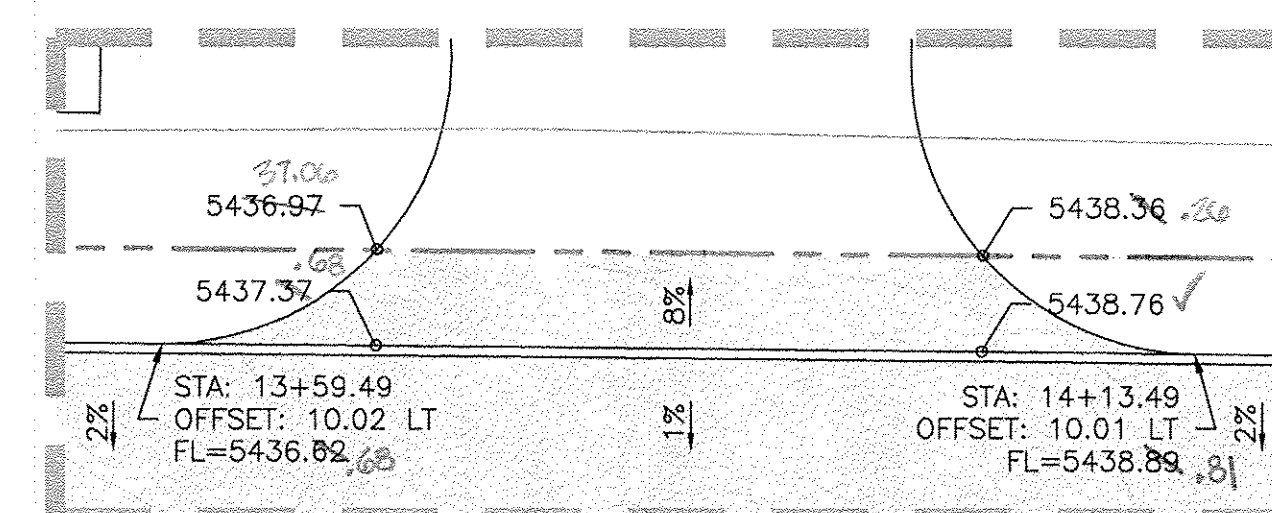

## CHURCH ACCESS GRADES

SC: 1"=10'

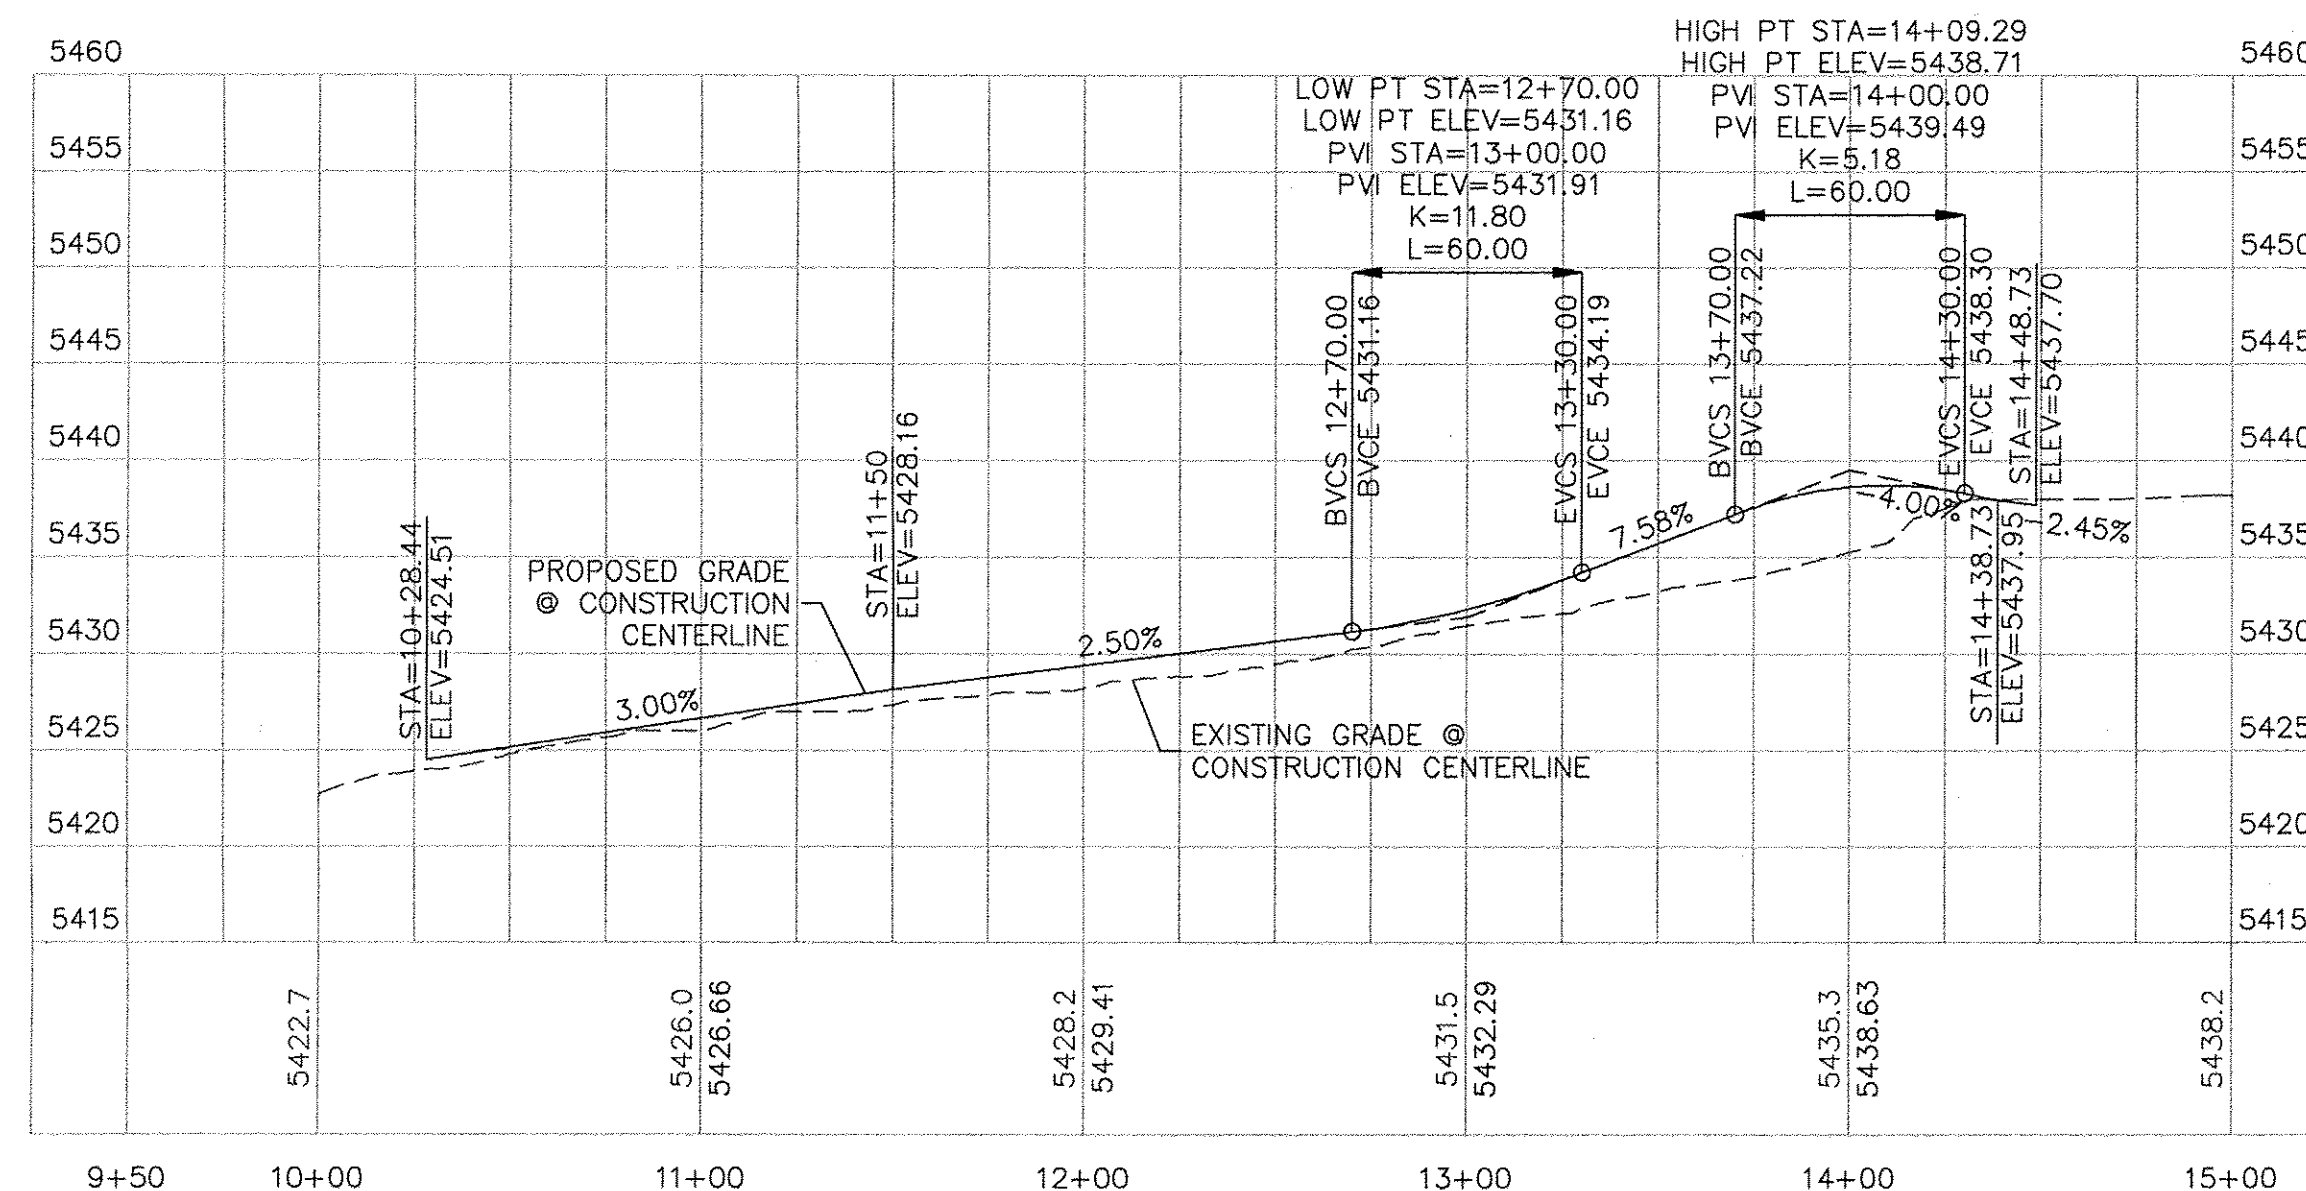


| LINE TABLE |             |        |
|------------|-------------|--------|
| LINE       | BEARING     | LENGTH |
| L6         | N89°29'46"W | 80.72  |

| CURVE TABLE |           |        |        |
|-------------|-----------|--------|--------|
| CURVE       | DELTA     | RADIUS | LENGTH |
| C5          | 90°17'23" | 20.00  | 31.52  |
| C6          | 88°46'17" | 20.00  | 30.99  |

**CAUTION:**


ALL EXISTING UTILITIES SHOWN WERE OBTAINED FROM RESEARCH, AS-BUILTS, SURVEYS OR INFORMATION PROVIDED BY OTHERS. IT SHALL BE THE SOLE RESPONSIBILITY OF THE CONTRACTOR TO CONDUCT ALL NECESSARY FIELD INVESTIGATIONS PRIOR TO AND INCLUDING ANY EXCAVATION, TO DETERMINE THE ACTUAL LOCATION OF UTILITIES AND OTHER IMPROVEMENTS, PRIOR TO STARTING THE WORK. ANY CHANGES FROM THIS PLAN SHALL BE COORDINATED WITH AND APPROVED BY THE ENGINEER.

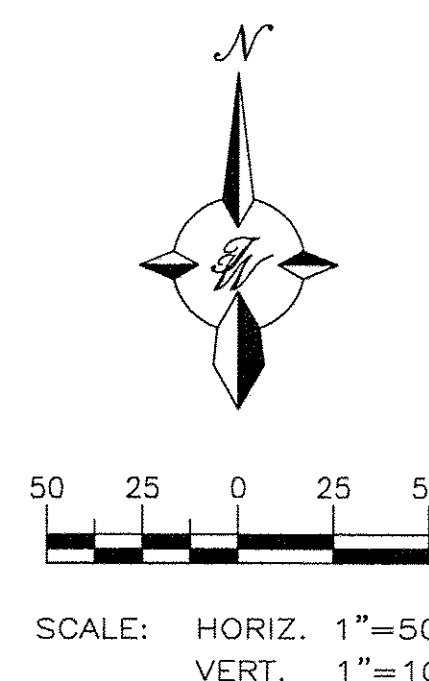

## NOTICE TO CONTRACTORS

1. AN EXCAVATION/CONSTRUCTION PERMIT WILL BE REQUIRED BEFORE BEGINNING ANY WORK WITHIN CITY RIGHT-OF-WAY.
2. ALL WORK DETAILED ON THESE PLANS TO BE PERFORMED, EXCEPT AS OTHERWISE STATED OR PROVIDED HERON, SHALL BE CONSTRUCTED IN ACCORDANCE WITH CITY OF ALBUQUERQUE INTERIM STANDARD SPECIFICATIONS FOR PUBLIC WORKS CONSTRUCTION, 1985.
3. TWO WORKING DAYS PRIOR TO ANY EXCAVATION, CONTRACTOR MUST CONTACT LINE LOCATING SERVICE, 765-1234, FOR LOCATION OF EXISTING UTILITIES.
4. PRIOR TO CONSTRUCTION, THE CONTRACTOR SHALL EXCAVATE AND VERIFY THE HORIZONTAL AND VERTICAL LOCATIONS OF ALL CONNECTIONS. SHOULD A CONFLICT EXIST, THE CONTRACTOR SHALL NOTIFY THE ENGINEER SO THAT THE CONFLICT CAN BE RESOLVED WITH A MINIMUM AMOUNT OF DELAY.
5. BACKFILL COMPACTION SHALL BE ACCORDING TO TRAFFIC/STREET USE.
6. MAINTENANCE OF THESE FACILITIES SHALL BE THE RESPONSIBILITY OF THE OWNER OF THE PROPERTY SERVED.
7. WORK ON ARTERIAL STREETS SHALL BE PERFORMED ON A 24-HOUR BASIS.
 
## LEGEND



 CURB & GUTTER  
 BOUNDARY LINE  
 EASEMENT  
 CENTERLINE  
 SIDEWALK  
 EXISTING CURB & GUTTER  
 EXISTING BOUNDARY LINE  
 PROPOSED CONCRETE VALLEY GUTTER  
 PROPOSED ASPHALT  
 SAWCUT


**KEYED NOTE:**

- (A) 6' VALLEY GUTTER PER COA STD DWG #2420
- (B) 6' SIDEWALK PER COA STD DWG #2430 (2% MAX. CROSS SLOPE)
- (C) STANDARD CURB & GUTTER PER COA STD DWG #2415A
- (D) ACCESSIBLE RAMP W/ SLOPED CURB & CAST IN PLACE REPLACEABLE DUMPS PER COA STD DWG #2441 & DETAIL SHEET 13 (8.3% MAX., 7.5% PREFERRED)
- (E) EDGE OF PAVEMENT
- (F) ADJUST EXIST. VALVE TO GRADE. INSTALL NEW COLLAR.
- (G) ADJUST EXIST. MANHOLE TO GRADE. SEE COA STD DWG #2461
- (H) REMOVE AND REPLACE EXISTING PAVEMENT 1-FOOT BEYOND PROPOSED VALLEY GUTTER PER COA STD DWG #2465 - ARTERIAL
- (I) 2' ALLEY GUTTER PER COA STD DWG #2415A
- (J) 6"x18" CUT-OFF-WALL PER COA STD DWG #2411
- (K) 6' MEDIAN CURB & GUTTER PER COA STD DWG #2415A
- (L) CONCRETE APRON EXTENSION
- (M) FUTURE SCREEN WALL PER ADMINISTRATIVE AMENDMENT

### QUARTER POINTS

| C5 | FL | ELEV.   | C6 | FL | ELEV.  |
|----|----|---------|----|----|--------|
|    | 13 | 5437.95 |    | 16 | 5437.9 |
|    | 14 | 5438.03 |    | 17 | 5437.7 |
|    | 15 | 5438.15 |    | 18 | 5437.6 |
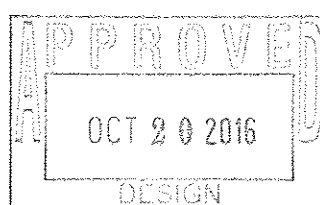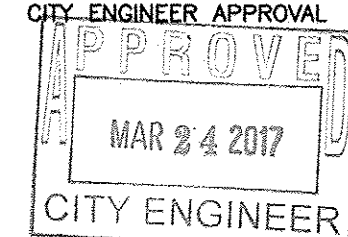
|                                                                                                                                                                                                                                                              |  |             |                                                                                                                 |             |         |                    |       |             |  |             |  |
|--------------------------------------------------------------------------------------------------------------------------------------------------------------------------------------------------------------------------------------------------------------|--|-------------|-----------------------------------------------------------------------------------------------------------------|-------------|---------|--------------------|-------|-------------|--|-------------|--|
|  <p><b>TIERRA WEST, LLC</b><br/>         5571 MIDWAY PARK PLACE NE<br/>         ALBUQUERQUE, NM 87109<br/>         (505)858-3100<br/>         www.tierrawestllc.com</p> |  |             |                                                                                                                 |             |         |                    |       |             |  |             |  |
|                                                                                                                                                                                                                                                              |  | DESIGNED BY |                                                                                                                 | DRAWN BY: D |         | DATE               |       | NO.         |  | DRAWING NO. |  |
| <p align="center"><b>CITY OF ALBUQUERQUE</b><br/> <b>PUBLIC WORKS DEPARTMENT</b><br/> <b>ENGINEERING GROUP</b></p>                                                                                                                                           |  |             |                                                                                                                 |             |         |                    |       |             |  |             |  |
| <p><b>TITLE: LOS PASTORES SHOPPING CENTER</b><br/>         PAVING IMPROVEMENTS<br/>         ALLEY "A" (NORTH): STA: 10+00.00 TO 14+48.99</p>                                                                                                                 |  |             |                                                                                                                 |             |         |                    |       |             |  |             |  |
| DESIGN REVIEW COMMITTEE<br>                                                                                                                                             |  |             | CITY ENGINEER APPROVAL<br> |             |         | LAST DESIGN UPDATE |       | MO./DAY/YR. |  | MO./DAY/YR. |  |
| CITY PROJECT NO. 719880                                                                                                                                                                                                                                      |  |             | ZONE MAP NO.<br>F-19-N                                                                                          |             | SHEET 7 |                    | OF 15 |             |  |             |  |

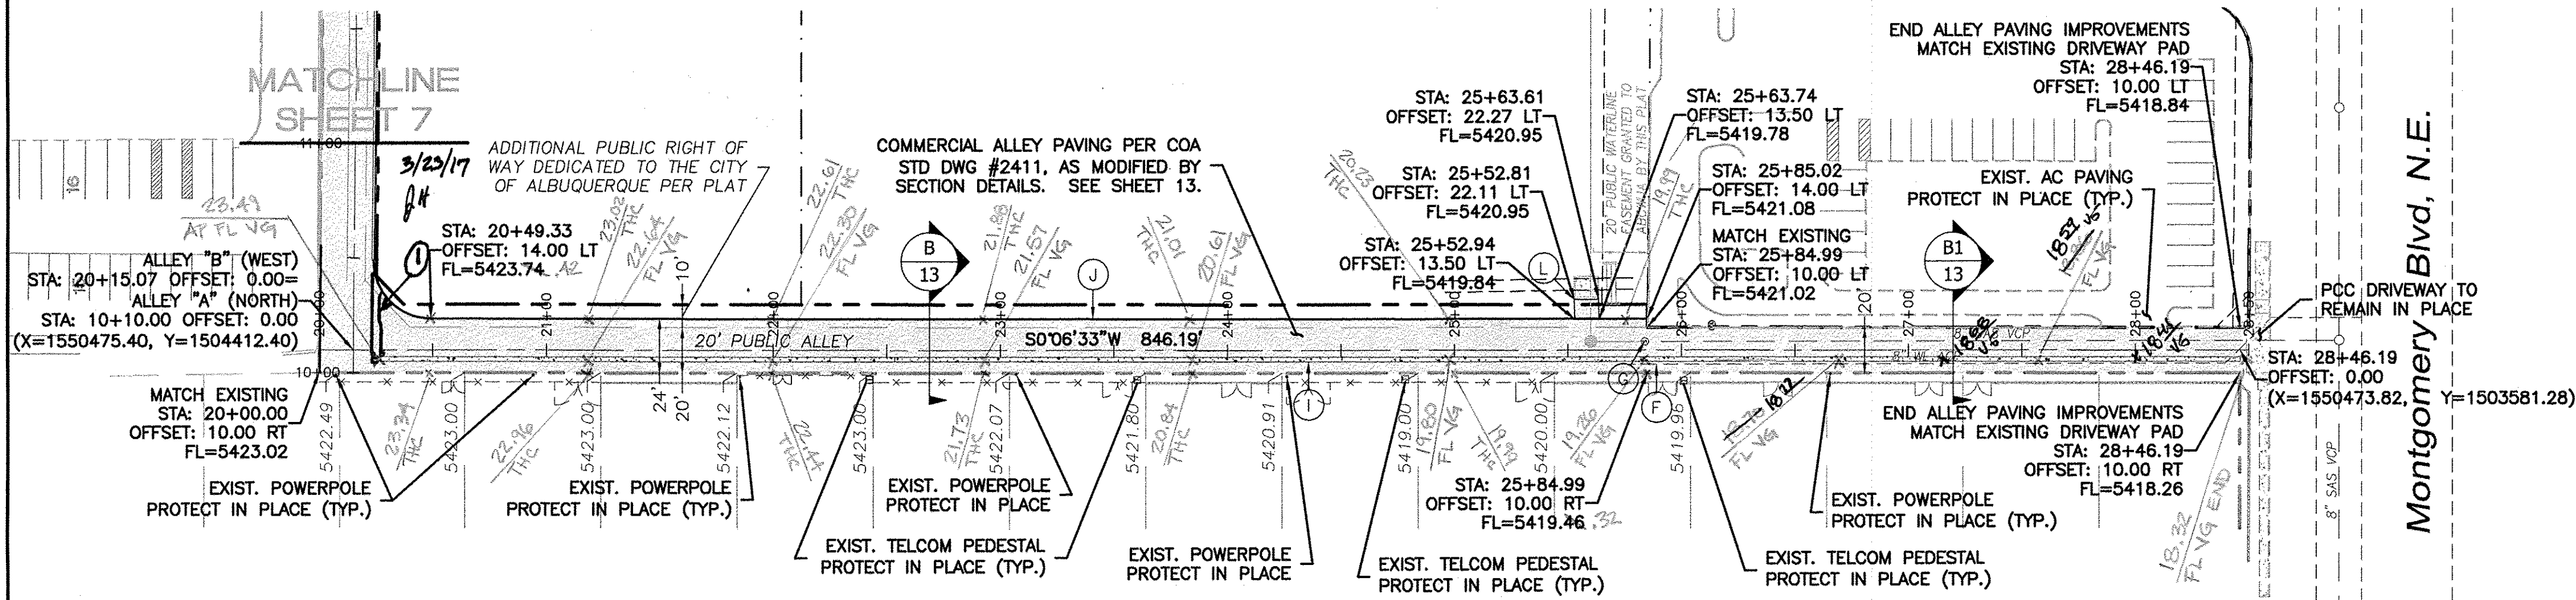

NOTICE TO CONTRACTORS


1. AN EXCAVATION/CONSTRUCTION PERMIT WILL BE REQUIRED BEFORE BEGINNING ANY WORK WITHIN CITY RIGHT-OF-WAY.
2. ALL WORK DETAILED ON THESE PLANS TO BE PERFORMED, EXCEPT AS OTHERWISE STATED OR PROVIDED HERON, SHALL BE CONSTRUCTED IN ACCORDANCE WITH CITY OF ALBUQUERQUE INTERIM STANDARD SPECIFICATIONS FOR PUBLIC WORKS CONSTRUCTION, 1985.
3. TWO WORKING DAYS PRIOR TO ANY EXCAVATION, CONTRACTOR MUST CONTACT LINE LOCATING SERVICE, 765-1234, FOR LOCATION OF EXISTING UTILITIES.
4. PRIOR TO CONSTRUCTION, THE CONTRACTOR SHALL EXCAVATE AND VERIFY THE HORIZONTAL AND VERTICAL LOCATIONS OF ALL CONNECTIONS. SHOULD A CONFLICT EXIST, THE CONTRACTOR SHALL NOTIFY THE ENGINEER SO THAT THE CONFLICT CAN BE RESOLVED WITH A MINIMUM AMOUNT OF DELAY.
5. BACKFILL COMPACTION SHALL BE ACCORDING TO TRAFFIC/STREET USE.
6. MAINTENANCE OF THESE FACILITIES SHALL BE THE RESPONSIBILITY OF THE OWNER OF THE PROPERTY SERVED.
7. WORK ON ARTERIAL STREETS SHALL BE PERFORMED ON A 24-HOUR BASIS.

**CAUTION:**  
ALL EXISTING UTILITIES SHOWN WERE OBTAINED FROM RESEARCH, AS-BUILTS, SURVEYS OR INFORMATION PROVIDED BY OTHERS. IT SHALL BE THE SOLE RESPONSIBILITY OF THE CONTRACTOR TO CONDUCT ALL NECESSARY FIELD INVESTIGATIONS PRIOR TO AND INCLUDING ANY EXCAVATION, TO DETERMINE THE ACTUAL LOCATION OF UTILITIES AND OTHER IMPROVEMENTS, PRIOR TO STARTING THE WORK. ANY CHANGES FROM THIS PLAN SHALL BE COORDINATED WITH AND APPROVED BY THE ENGINEER.

SURVEYORS CERTIFICATION


I, Russ P. Hugg, New Mexico Professional Surveyor Number 9750, hereby certify that the as-built information shown hereon is the result of an actual field survey performed by me or under my direct supervision and that the same is true and correct to the best of my knowledge and belief.

Russ P. Hugg  
NMPs No. 9750  
1-5, 2016

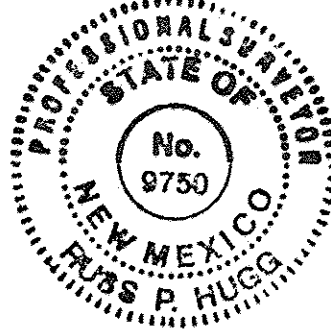

CERTIFICATE OF SUBSTANTIAL COMPLIANCE ON PLANS

I, Ronald R. Bohannon, of the firm of Tierra West LLC, a Registered Professional Engineer in the State of New Mexico, do hereby certify, to the best of my knowledge and belief, that the infrastructure installed as part of this project has been inspected by me or by a qualified person under my direct supervision and has been constructed in accordance with the plans and specifications approved by the City Engineer and that the original design intent of the approved plans has been met, except as noted by me on the as-built construction drawings. This Certification is based on site inspections by me, or personnel under my direction with survey information provided by Russ P. Hugg, of Surry-Tek, Inc., NMPs number 9550.


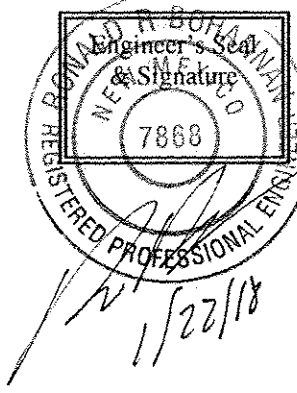


LEGEND

- CURB & GUTTER
- - - BOUNDARY LINE
- - - EASEMENT
- - - CENTERLINE
- SIDEWALK
- - - EXISTING CURB & GUTTER
- - - EXISTING BOUNDARY LINE
- PROPOSED CONCRETE VALLEY GUTTER
- PROPOSED ASPHALT

KEYED NOTE


- (A) 6" VALLEY GUTTER PER COA STD DWG #2420
- (B) 6" SIDEWALK PER COA STD DWG #2430 (2% MAX. CROSS SLOPE)
- (C) STANDARD CURB & GUTTER PER COA STD DWG #2415A
- (D) ACCESSIBLE RAMP W/ SLOPED CURB & CAST IN PLACE
- (E) REPLACEABLE DOMES PER COA STD DWG #2441 & DETAIL SHEET 13 (8.3% MAX., 7.5% PREFERRED)
- (F) EDGE OF PAVEMENT
- (G) ADJUST EXIST. VALVE TO GRADE. SEE COA STD DWG #2426, #2461
- (H) ADJUST EXIST. MANHOLE TO GRADE. SEE COA STD DWG #2461
- (I) REMOVE AND REPLACE EXISTING PAVEMENT 1-FOOT BEYOND PROPOSED VALLEY GUTTER PER COA STD DWG #2465 - ARTERIAL
- (J) 2' ALLEY GUTTER PER COA STD DWG #2415A
- (K) 6"x18" CUT-OFF-WALL PER COA STD DWG #2411
- (L) 6" MEDIAN CURB PER COA STD DWG #2415A
- (M) CONCRETE APRON EXTENSION

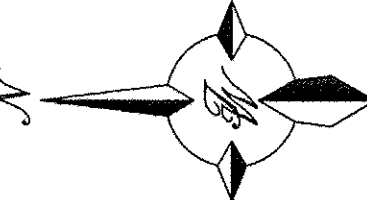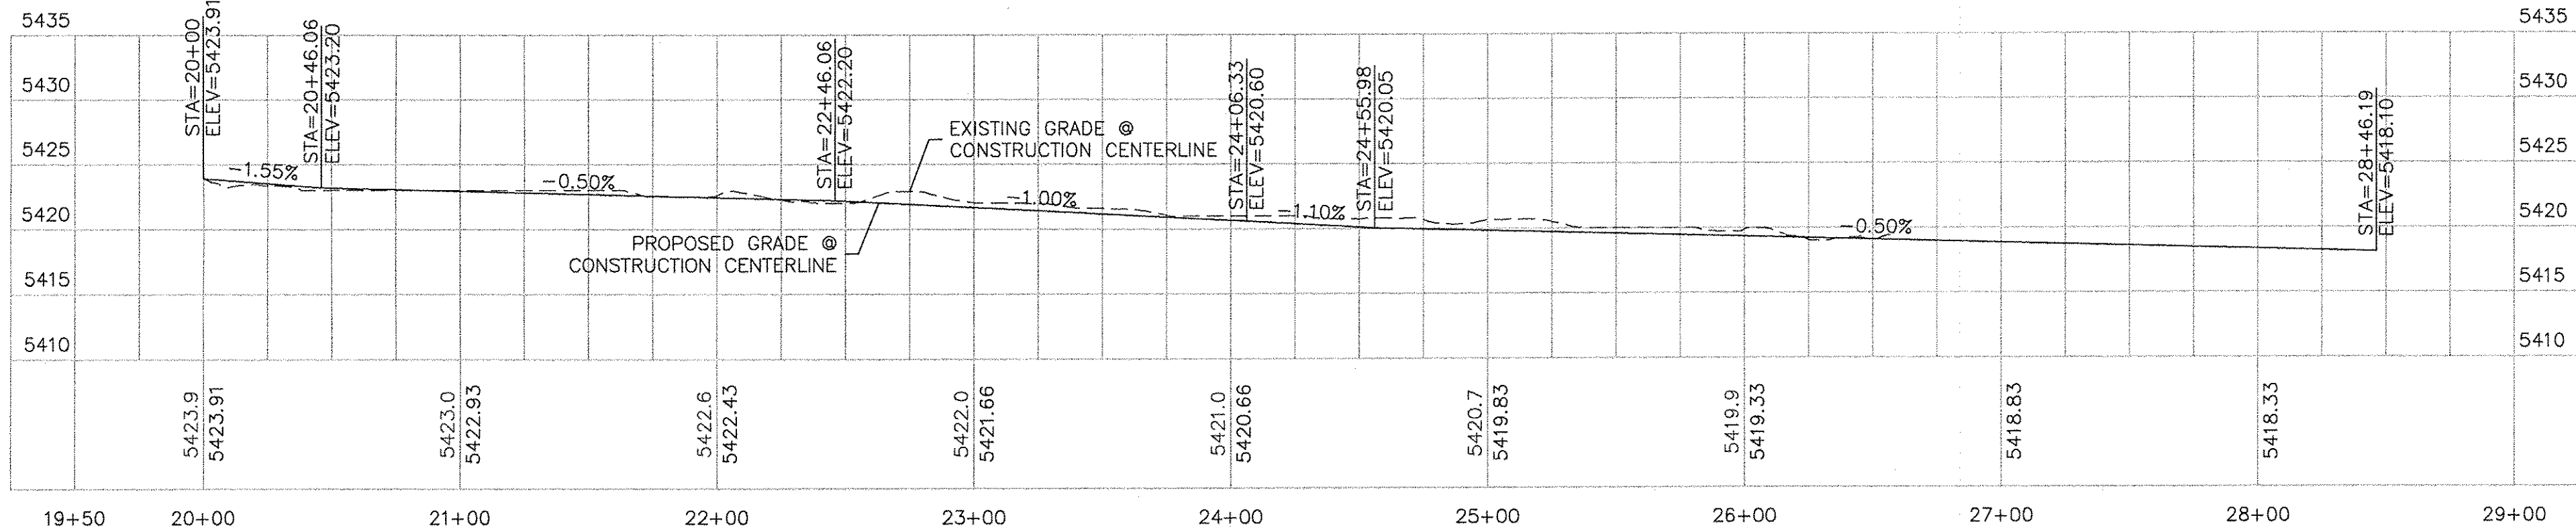

SCALE: HORIZ. 1"=50'  
VERT. 1"=10'

|                                                                                                                          |                                                                    |
|--------------------------------------------------------------------------------------------------------------------------|--------------------------------------------------------------------|
| <b>TIERRA WEST, LLC</b><br>5571 MIDWAY PARK PLACE NE<br>ALBUQUERQUE, NM 87109<br>(505) 868-3100<br>www.tierrowestllc.com |                                                                    |
| CITY OF ALBUQUERQUE<br>PUBLIC WORKS DEPARTMENT<br>ENGINEERING GROUP                                                      |                                                                    |
| TITLE: <b>LOS PASTORES SHOPPING CENTER</b><br>PAVING IMPROVEMENTS<br>ALLEY "B" (WEST): STA: 20+00.00 TO 28+46.19         |                                                                    |
| DESIGN REVIEW COMMITTEE<br>APPROVED<br>OCT 20 2016<br>DESIGN REVIEW COMMITTEE                                            | CITY ENGINEER APPROVAL<br>APPROVED<br>MAR 24 2017<br>CITY ENGINEER |
| CITY PROJECT NO. 719880                                                                                                  | ZONE MAP NO. F-19-Z                                                |
| SHEET 8 OF 15                                                                                                            |                                                                    |



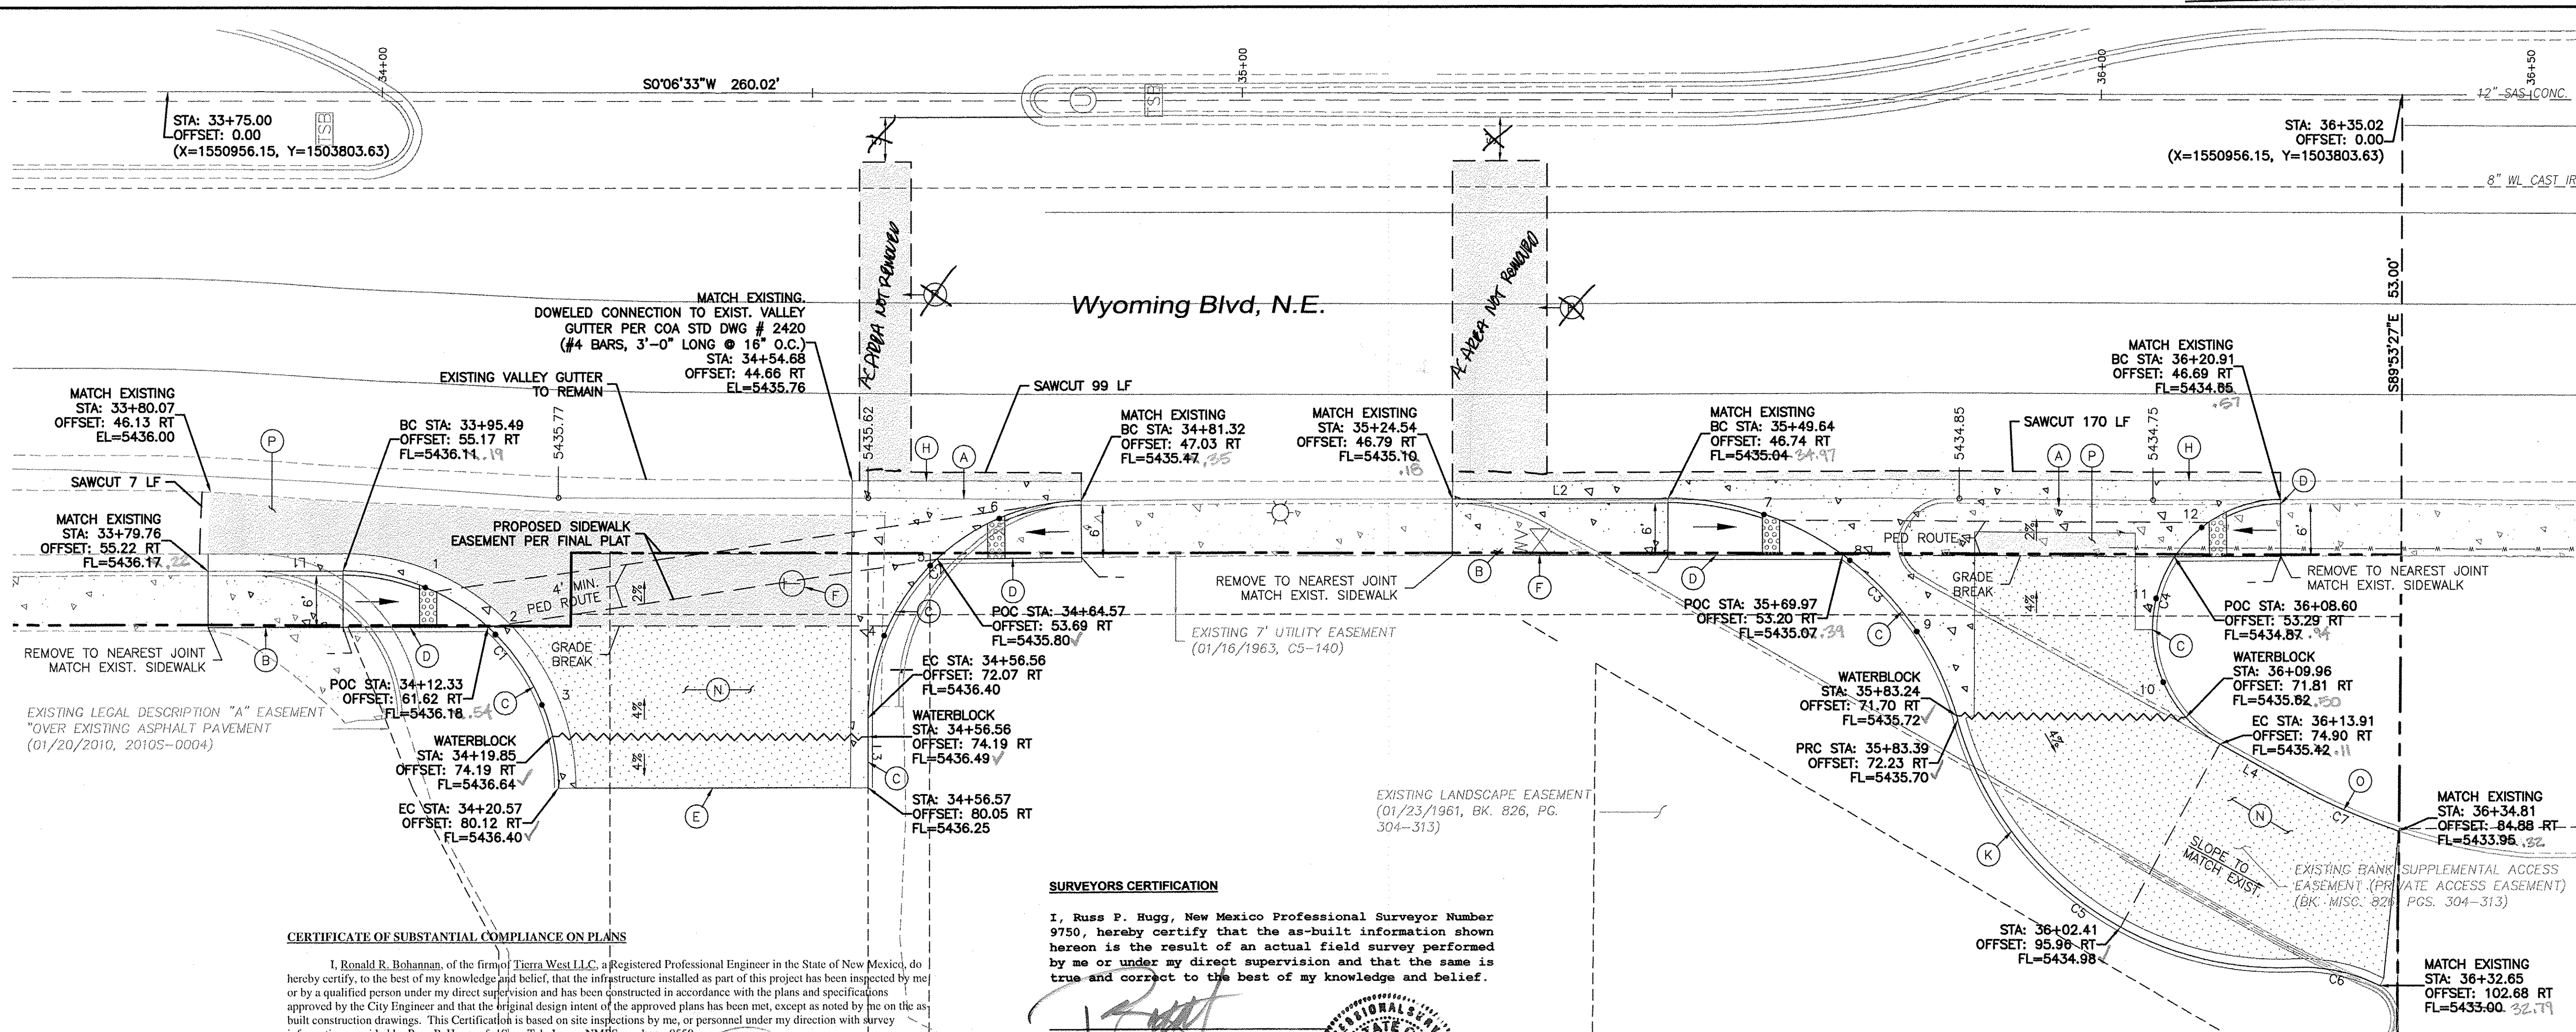

### SURVEYORS CERTIFICATION

I, Russ P. Hugg, New Mexico Professional Surveyor Number 9750, hereby certify that the as-built information shown hereon is the result of an actual field survey performed by me or under my direct supervision and that the same is true and correct to the best of my knowledge and belief.

Russ P. Hugg  
NMPS No. 9750



## QUARTER POINTS

| C1 | FL | ELEV.   | C2 | FL | ELEV.   |
|----|----|---------|----|----|---------|
|    | 1  | 5436.11 |    | 4  | 5436.01 |
|    | 2  | 5436.20 |    | 5  | 5435.82 |
|    | 3  | 5436.38 |    | 6  | 5435.66 |

| C3 | FL | ELEV.   | C4 | FL | ELEV.   |
|----|----|---------|----|----|---------|
|    | 7  | 5435.02 |    | 10 | 5435.38 |
|    | 8  | 5435.10 |    | 11 | 5435.07 |
|    | 9  | 5435.40 |    | 12 | 5434.78 |

## LEGEND


|  |                                 |
|--|---------------------------------|
|  | CURB & GUTTER                   |
|  | BOUNDARY LINE                   |
|  | EASEMENT                        |
|  | CENTERLINE                      |
|  | SIDEWALK                        |
|  | EXISTING CURB & GUTTER          |
|  | EXISTING BOUNDARY LINE          |
|  | PROPOSED CONCRETE VALLEY GUTTER |
|  | PROPOSED ASPHALT (PUBLIC)       |
|  | PROPOSED ASPHALT (PRIVATE)      |
|  | PROPOSED ASPHALT OVERLAY        |
|  | SAWCUT                          |

### KEYED NOTE:

- (A) 6" VALLEY GUTTER PER COA STD DWG #2420
- (B) 6" SIDEWALK PER COA STD DWG #2430 (2% MAX. CROSS SLOPE)
- (C) STANDARD CURB & GUTTER PER COA STD DWG #2415A
- (D) ACCESSIBLE RAMP W/ SLOPED CURB & CAST IN PLACE REPLACEABLE DOMES PER COA STD DWG #2441 & DETAIL SHEET 13 (8.3% MAX., 7.5% PREFERRED)
- (E) EDGE OF PAVEMENT
- (F) ADJUST EXIST. VALVE TO GRADE. SEE COA STD DWG #2426, #2461
- (G) ADJUST EXIST. MANHOLE TO GRADE. SEE COA STD DWG #2461
- (H) REMOVE AND REPLACE EXISTING PAVEMENT 1-FOOT BEYOND PROPOSED VALLEY GUTTER PER COA STD DWG #2465 - ARTERIAL
- (I) 2' ALLEY GUTTER PER COA STD DWG #2415A
- (J) 6"x18" CUT-OFF-WALL PER COA STD DWG #2411
- (K) 6" MEDIAN CURB PER COA STD DWG #2415A
- (L) CONCRETE APRON EXTENSION
- (M) FUTURE SCREEN WALL
- (N) PRIVATE DRIVE SECTION
- (O) 6" HEADER CURB PER COA STD DWG #2415B
- (P) AC PAVEMENT PER COA STD DWG #2465 - ARTERIAL

**CAUTION:**

**CAUTION:** ALL EXISTING UTILITIES SHOWN WERE OBTAINED FROM RESEARCH, AS-BUILTS, SURVEYS OR INFORMATION PROVIDED BY OTHERS. IT SHALL BE THE SOLE RESPONSIBILITY OF THE CONTRACTOR TO CONDUCT ALL NECESSARY FIELD INVESTIGATIONS PRIOR TO AND INCLUDING ANY EXCAVATION, TO DETERMINE THE ACTUAL LOCATION OF UTILITIES AND OTHER IMPROVEMENTS, PRIOR TO STARTING THE WORK. ANY CHANGES FROM THIS PLAN SHALL BE COORDINATED WITH AND APPROVED BY THE ENGINEER.

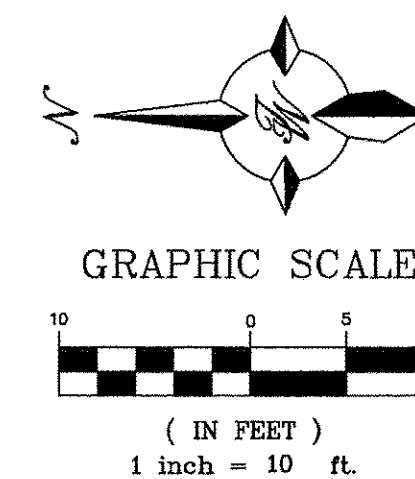



TIERRA WEST, LLC

5571 MIDWAY PARK PLACE N  
ALBUQUERQUE, NM 87109  
(505)858-3100  
[www.tierrawestllc.com](http://www.tierrawestllc.com)

CITY OF ALBUQUERQUE  
PUBLIC WORKS DEPARTMENT  
ENGINEERING GROUP

TITLE: **LOS PASTORES SHOPPING CENTER**  
PAVING IMPROVEMENTS  
WYOMING BLVD: STA: 33+85.39 TO 36+28.91
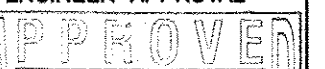
|                                                                                                                  |  |                                                                                                                 |  |                        |  |                 |  |                 |  |
|------------------------------------------------------------------------------------------------------------------|--|-----------------------------------------------------------------------------------------------------------------|--|------------------------|--|-----------------|--|-----------------|--|
| DESIGN REVIEW COMMITTEE<br> |  | CITY ENGINEER APPROVAL<br> |  | LAST DESIGN UPDATE<br> |  | MO./DAY/YR.<br> |  | MO./DAY/YR.<br> |  |
| CITY PROJECT NO.<br>719880                                                                                       |  | ZONE MAP NO.<br>F-19-Z                                                                                          |  | SHEET<br>9             |  | OF<br>15        |  |                 |  |

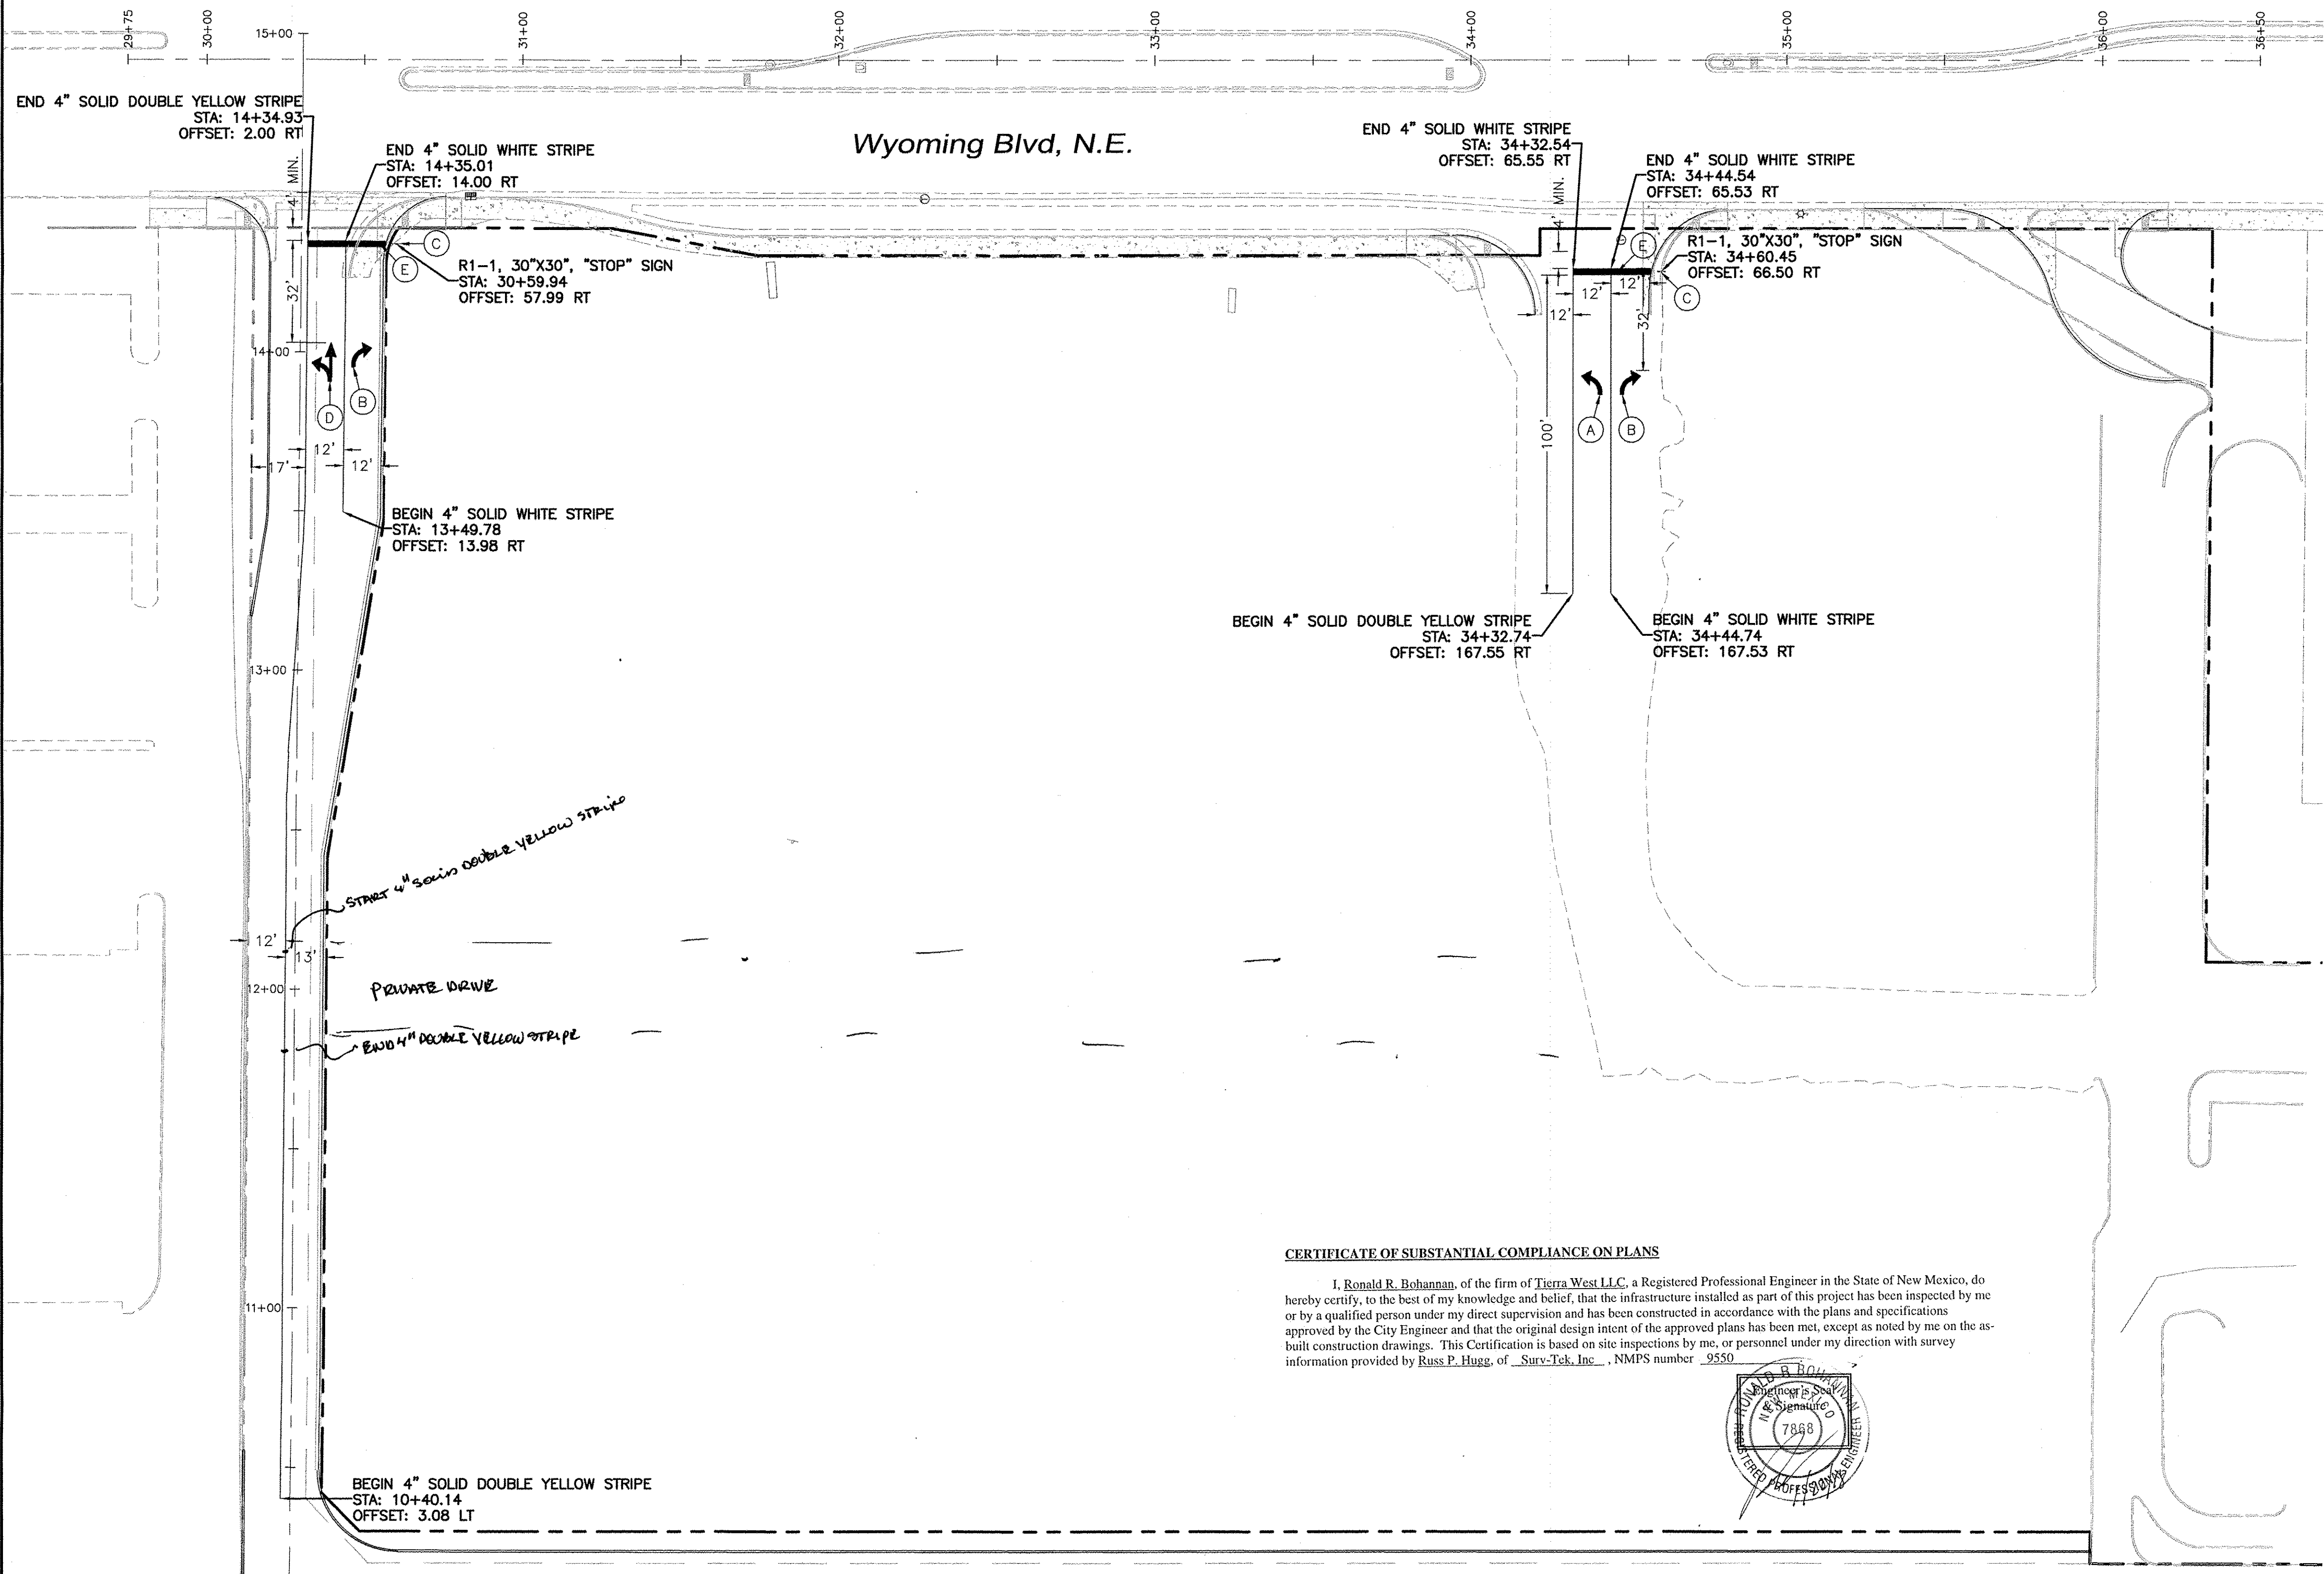


**LEGEND**

|  |                        |
|--|------------------------|
|  | CURB & GUTTER          |
|  | BOUNDARY LINE          |
|  | EASEMENT               |
|  | CENTERLINE             |
|  | SIDEWALK               |
|  | EXISTING CURB & GUTTER |
|  | EXISTING BOUNDARY LINE |
|  | EXISTING SIDEWALK      |
|  | EXISTING LANE          |
|  | EXISTING STRIPING      |
|  | PROPOSED STRIPING      |


- KEYED NOTE:**
- (A) LEFT TURN LANE ARROW, THERMOPLASTIC
  - (B) RIGHT TURN LANE ARROW, THERMOPLASTIC
  - (C) STOP SIGN (R1-1-30), 2 FT. FROM CURB
  - (D) TURN AND THROUGH LANE ARROWS, THERMOPLASTIC
  - (E) STOP BAR, 24-INCH SOLID WHITE, THERMOPLASTIC
- \*SEE SHEET 12 FOR SIGNING AND STRIPING DETAILS

**CERTIFICATE OF SUBSTANTIAL COMPLIANCE ON PLANS**

I, Ronald R. Bohannon, of the firm of Tierra West LLC, a Registered Professional Engineer in the State of New Mexico, do hereby certify, to the best of my knowledge and belief, that the infrastructure installed as part of this project has been inspected by me or by a qualified person under my direct supervision and has been constructed in accordance with the plans and specifications approved by the City Engineer and that the original design intent of the approved plans has been met, except as noted by me on the as-built construction drawings. This Certification is based on site inspections by me, or personnel under my direction with survey information provided by Russ P. Hugg, of Surv-Tek, Inc., NMPS number 9550.




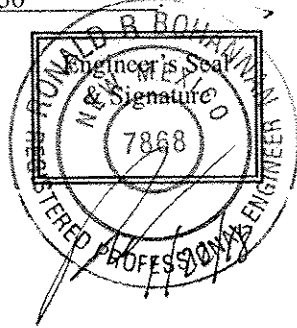


**CAUTION:**  
ALL EXISTING UTILITIES SHOWN WERE OBTAINED FROM RESEARCH, AS-BUILTS, SURVEYS OR INFORMATION PROVIDED BY OTHERS. IT SHALL BE THE SOLE RESPONSIBILITY OF THE CONTRACTOR TO CONDUCT ALL NECESSARY FIELD INVESTIGATIONS PRIOR TO AND INCLUDING ANY EXCAVATION, TO DETERMINE THE ACTUAL LOCATION OF UTILITIES AND OTHER IMPROVEMENTS, PRIOR TO STARTING THE WORK. ANY CHANGES FROM THIS PLAN SHALL BE COORDINATED WITH AND APPROVED BY THE ENGINEER.

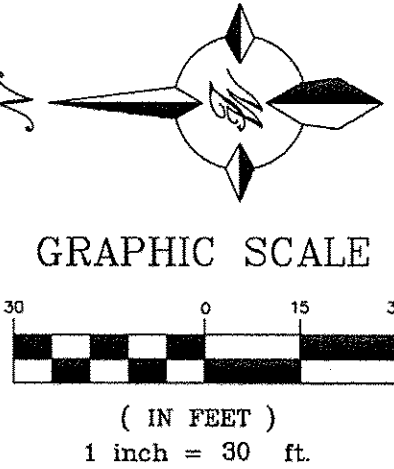


|                                                                                                                         |                            |
|-------------------------------------------------------------------------------------------------------------------------|----------------------------|
| <b>TIERRA WEST, LLC</b><br>5571 MIDWAY PARK PLACE NE<br>ALBUQUERQUE, NM 87109<br>(505)856-3100<br>www.tierrawestllc.com |                            |
| CITY OF ALBUQUERQUE<br>PUBLIC WORKS DEPARTMENT<br>ENGINEERING GROUP                                                     |                            |
| TITLE: <b>LOS PASTORES SHOPPING CENTER</b><br>SIGNING & STRIPING PLAN - ONSITE                                          |                            |
| DESIGN REVIEW COMMITTEE<br>                                                                                             | CITY ENGINEER-APPROVAL<br> |
| CITY PROJECT NO. 719880                                                                                                 | ZONE MAP NO. F-19-Z        |
| SHEET 10                                                                                                                | OF 15                      |



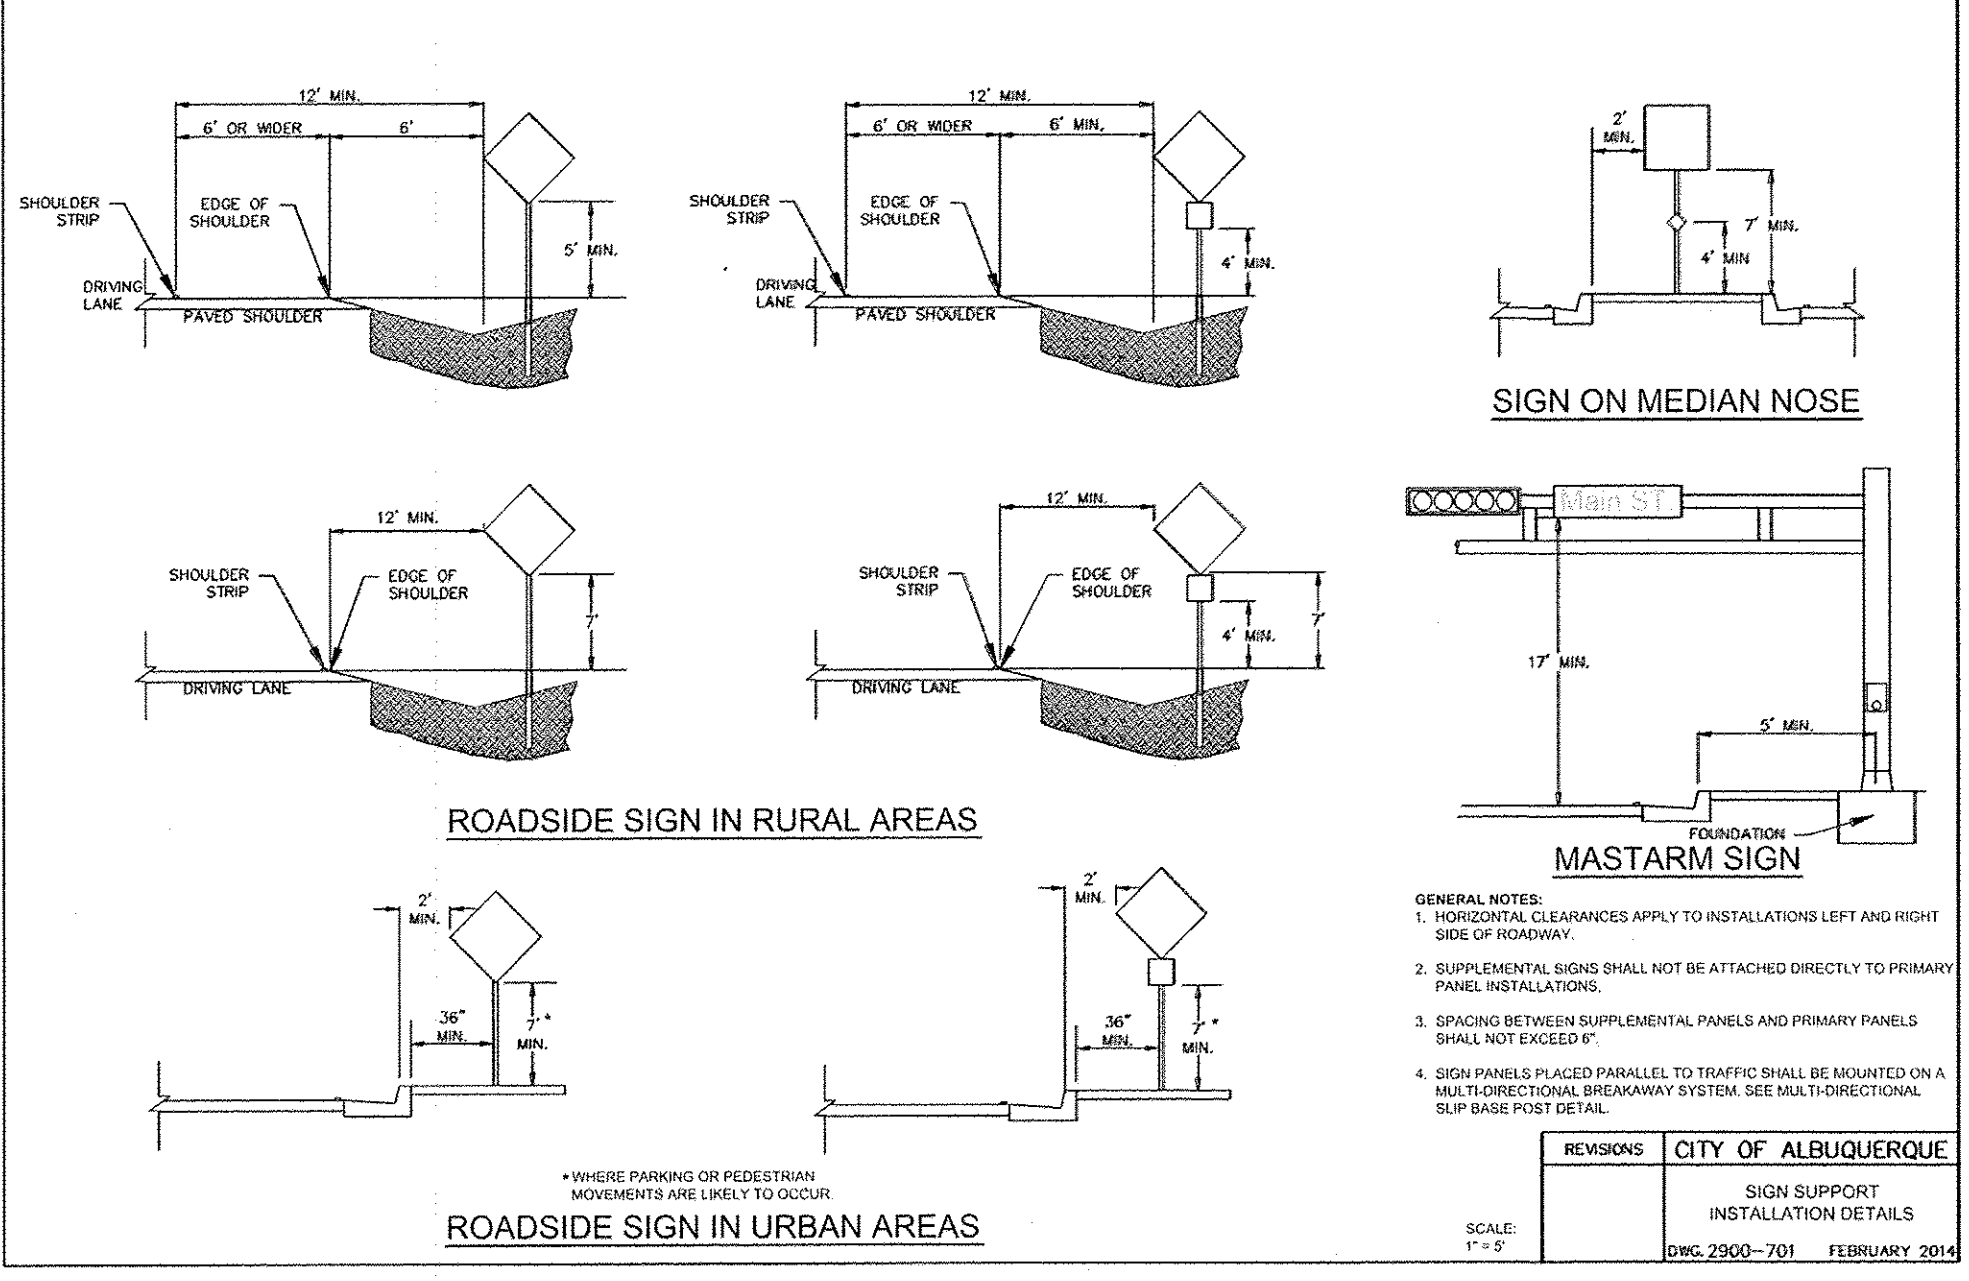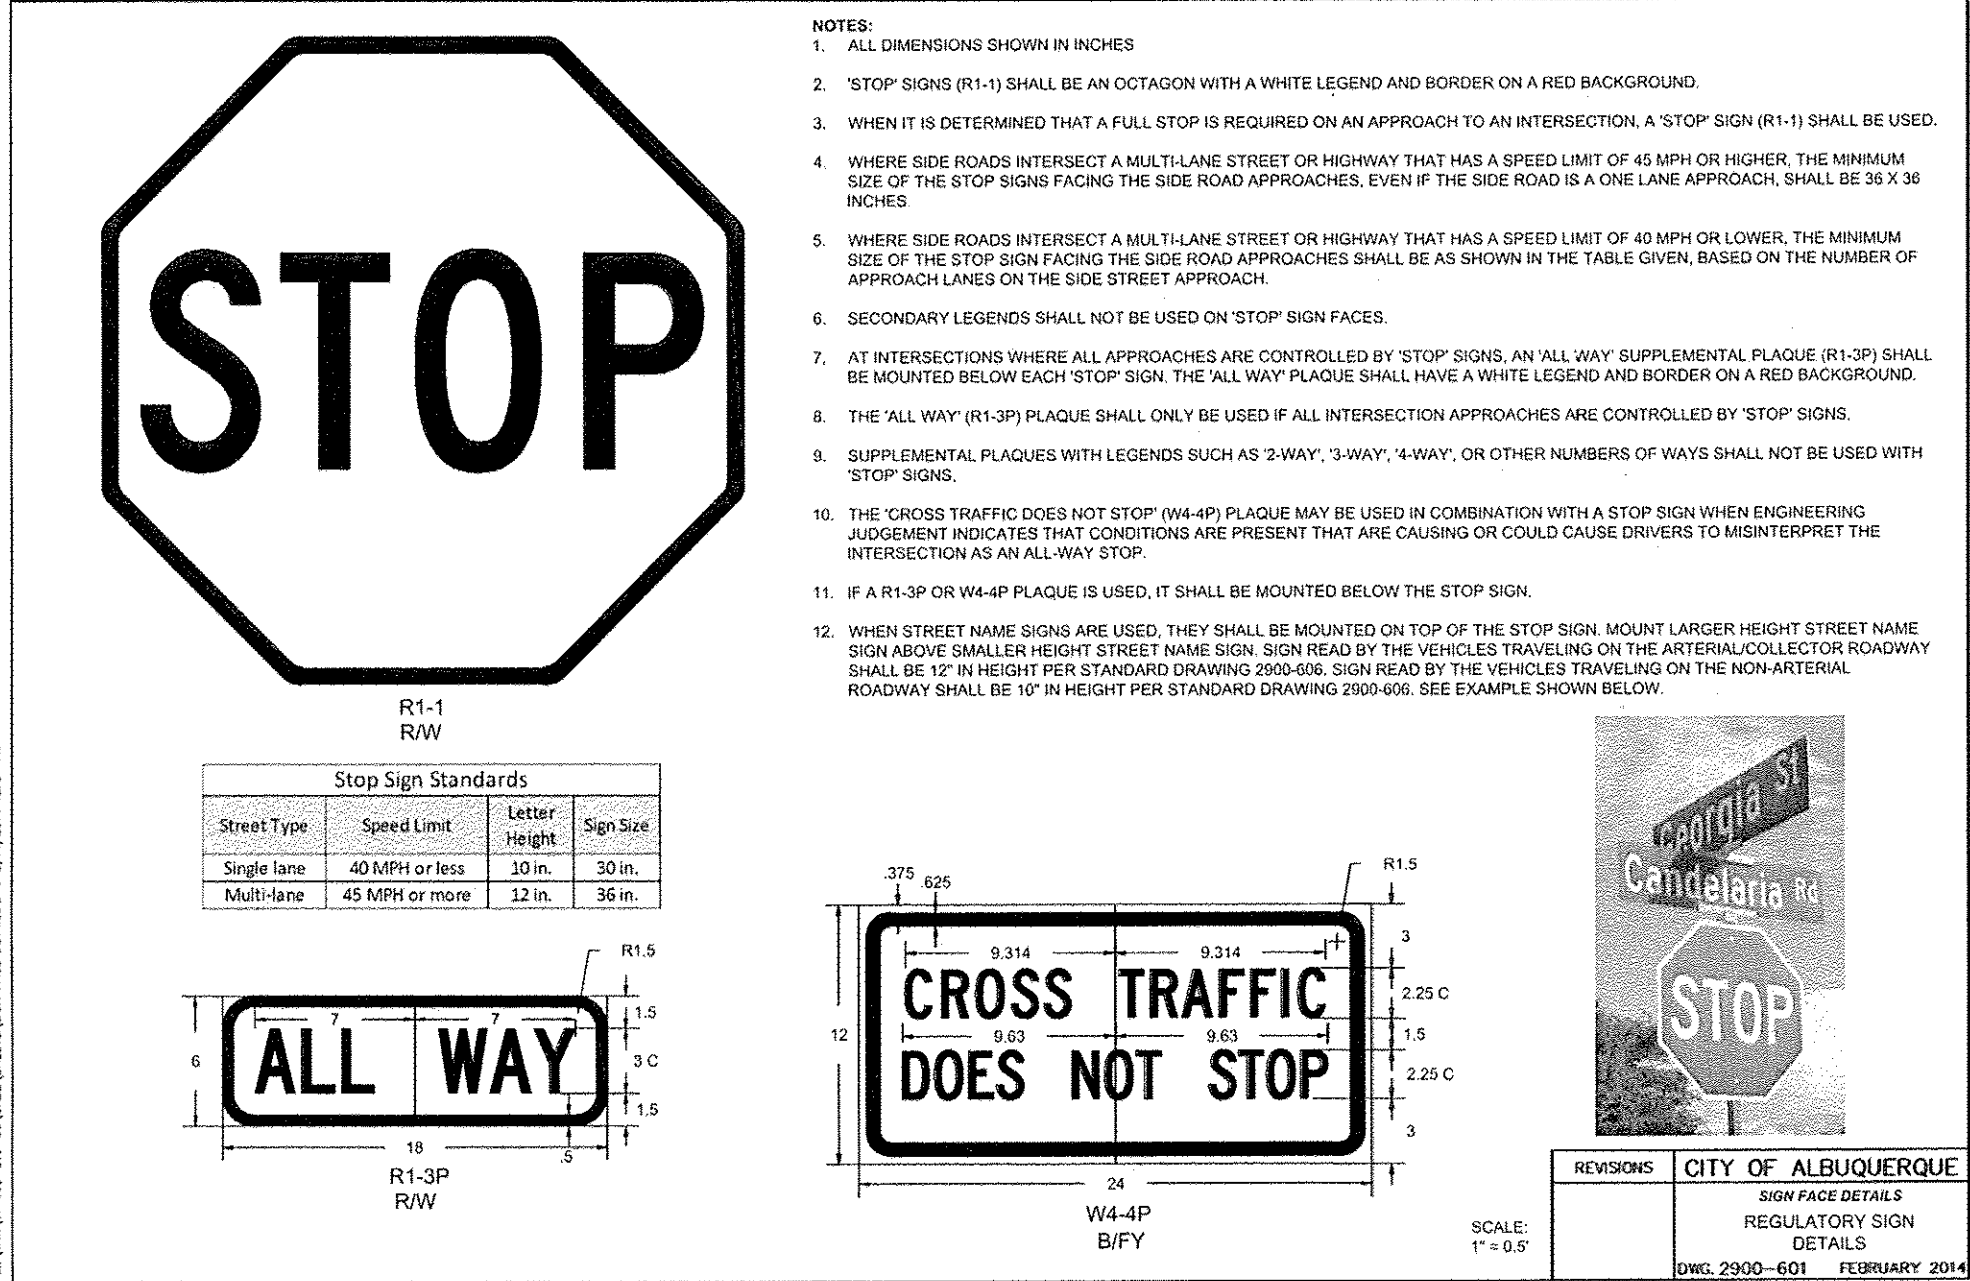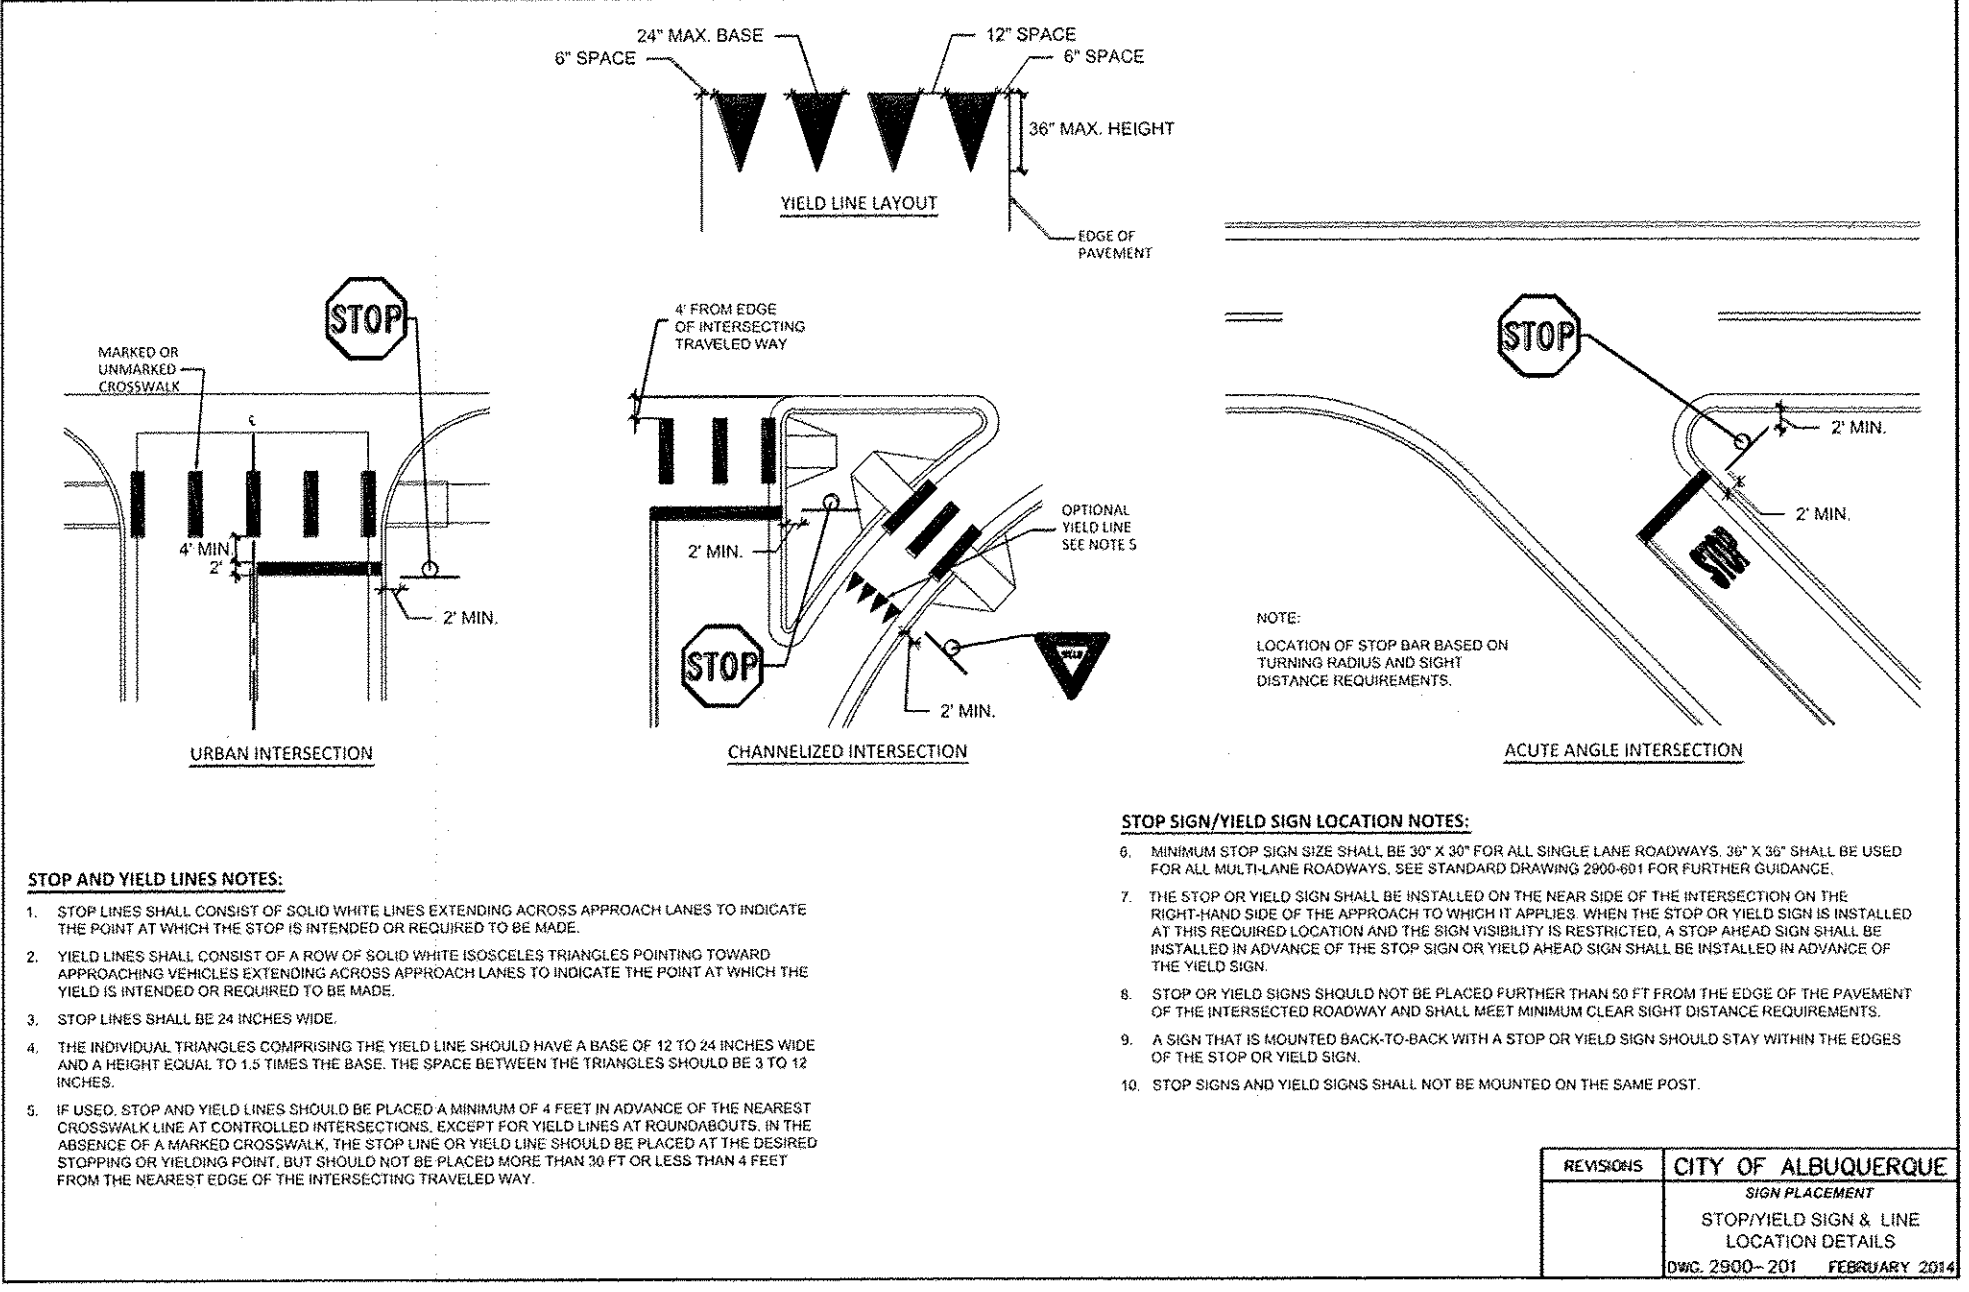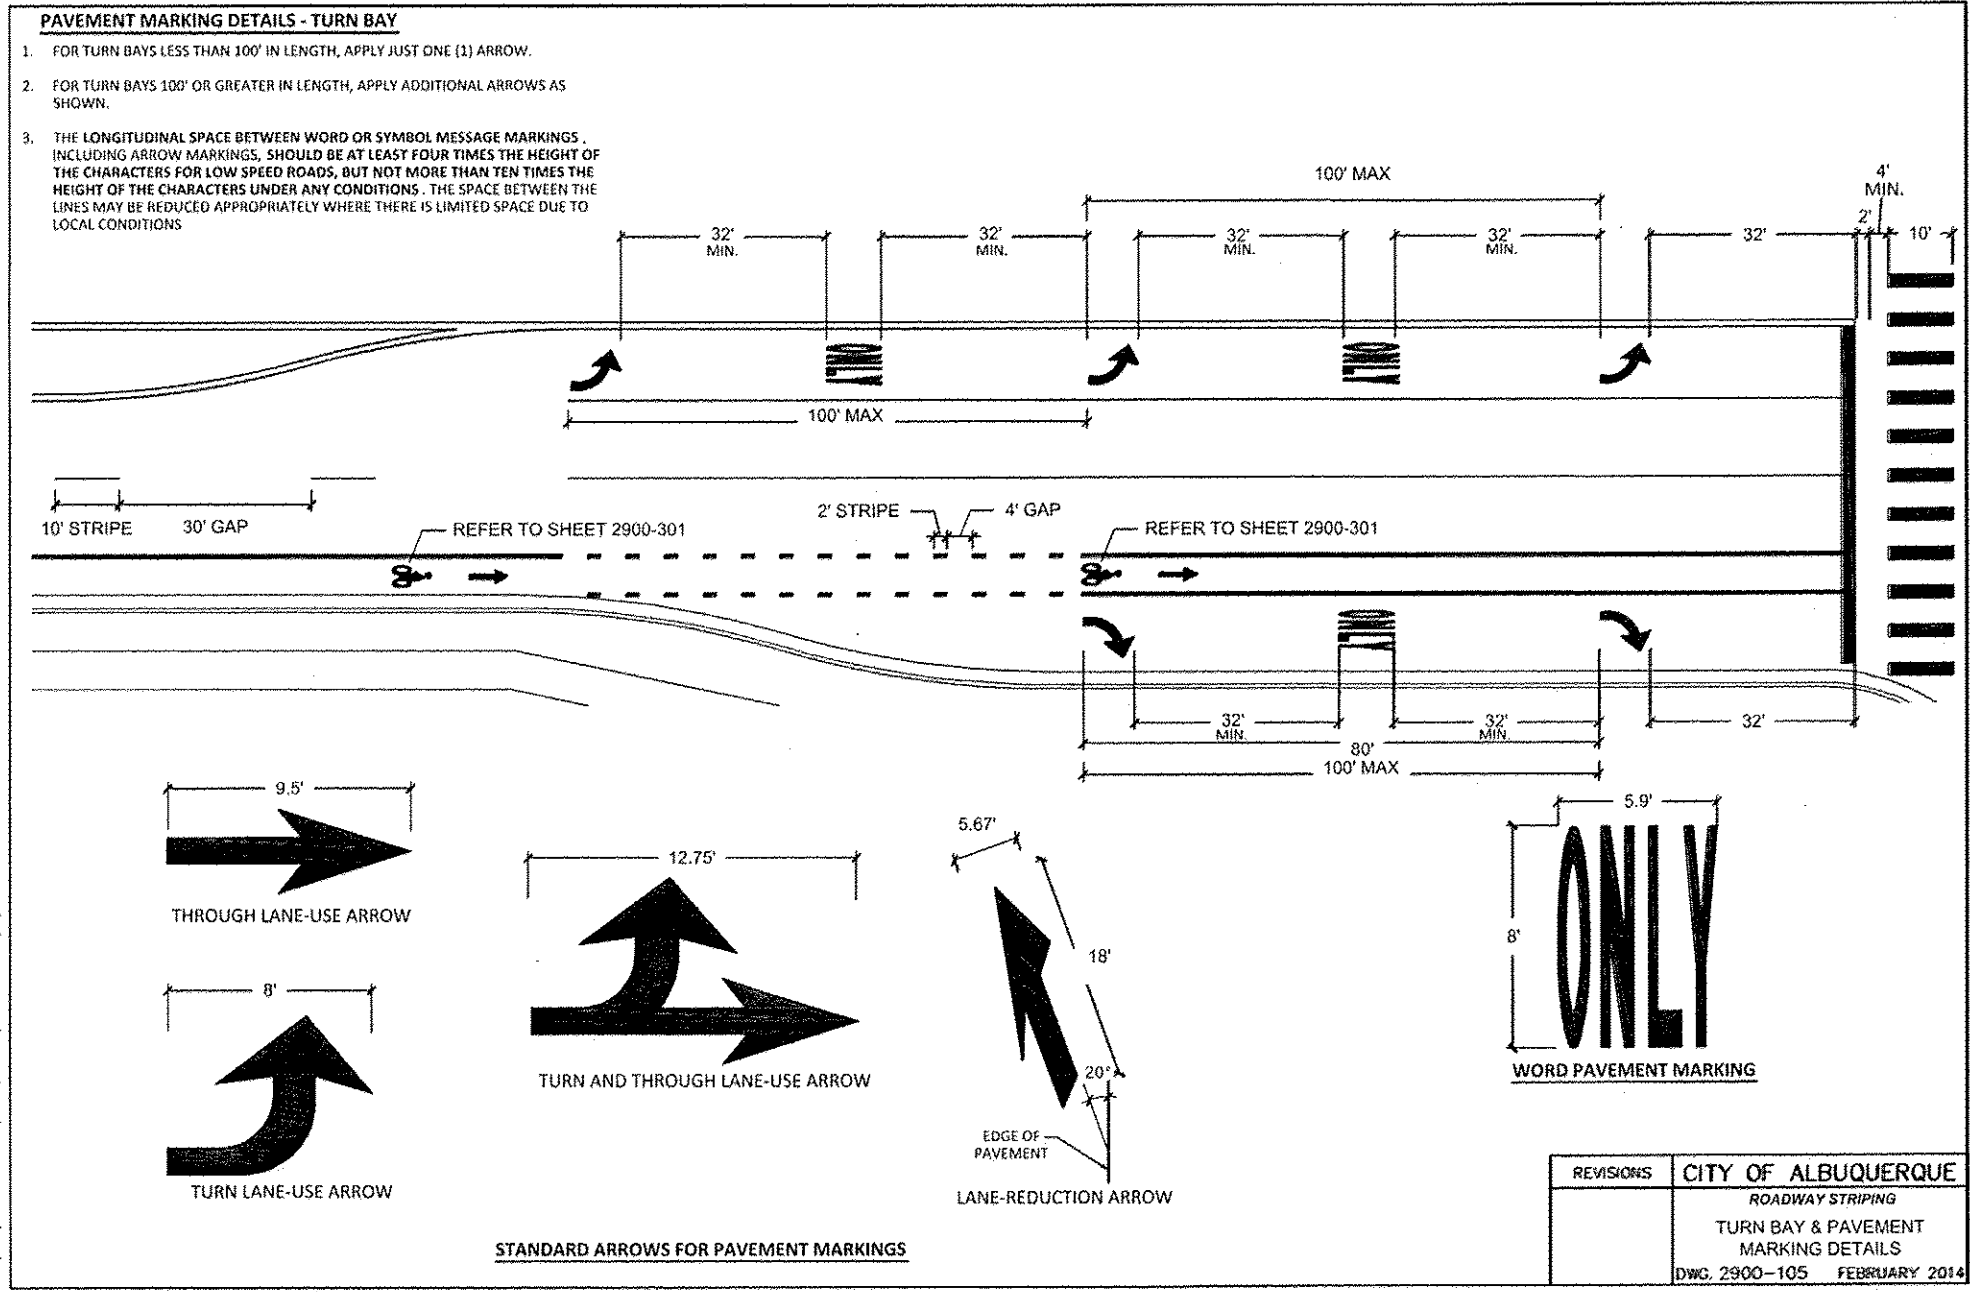

**CERTIFICATE OF SUBSTANTIAL COMPLIANCE ON PLANS**

I, Ronald R. Bohannon, of the firm of Tierra West LLC, a Registered Professional Engineer in the State of New Mexico, do hereby certify, to the best of my knowledge and belief, that the infrastructure installed as part of this project has been inspected by me or by a qualified person under my direct supervision and has been constructed in accordance with the plans and specifications approved by the City Engineer and that the original design intent of the approved plans has been met, except as noted by me on the as-built construction drawings. This Certification is based on site inspections by me, or personnel under my direction with survey information provided by Russ P. Hugg, of \_Surv-Tek, Inc., NMPS number \_9550.

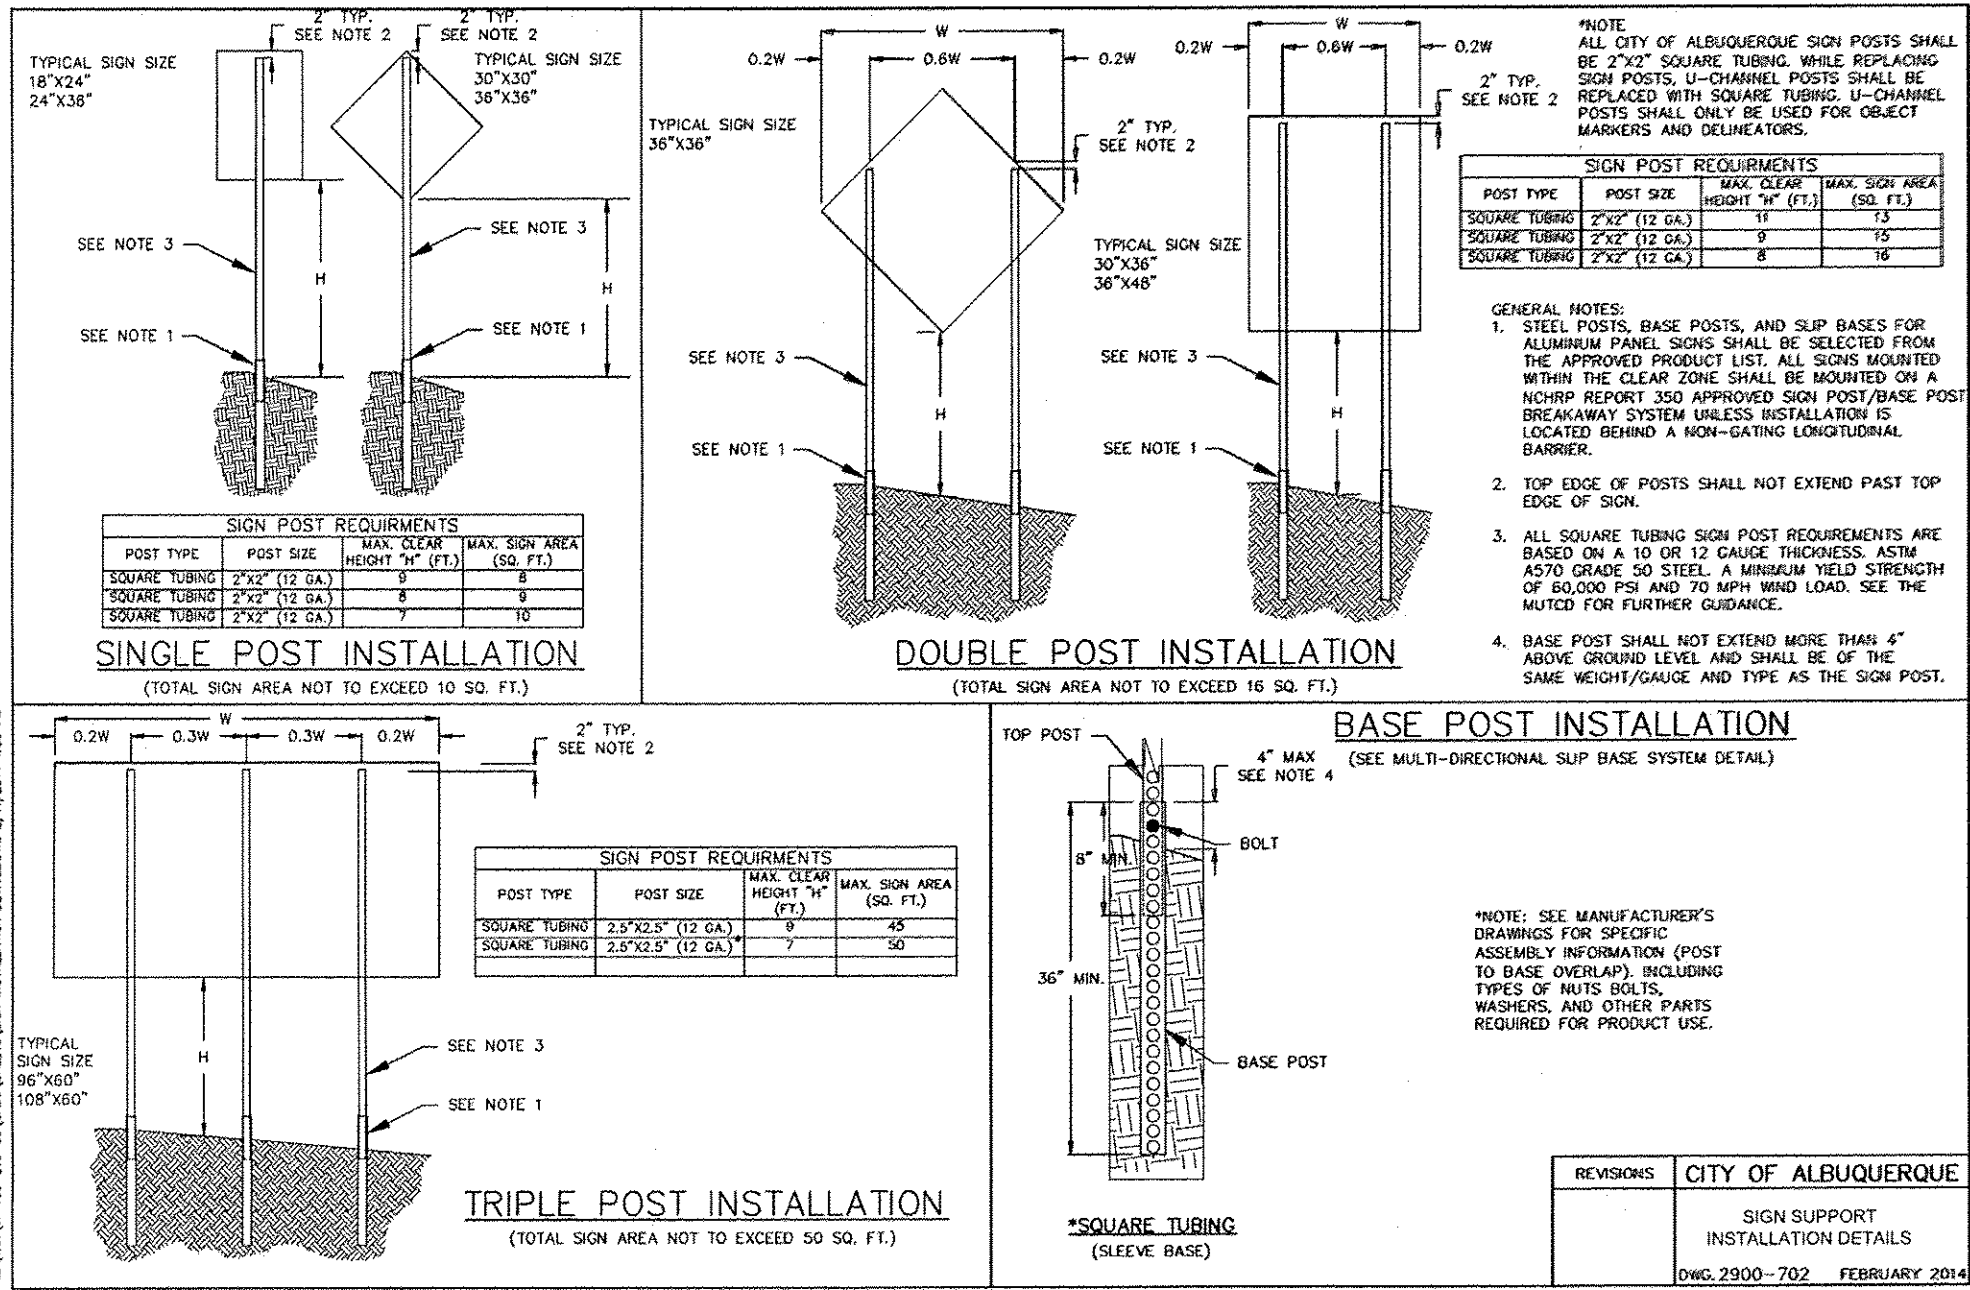

**TIERRA WEST, LLC**  
5571 MIDWAY PARK PLACE NE  
ALBUQUERQUE, NM 87109  
(505)858-3100  
www.tierrawestllc.com

**CITY OF ALBUQUERQUE**  
PUBLIC WORKS DEPARTMENT  
ENGINEERING GROUP

**TITLE: LOS PASTORES SHOPPING CENTER**  
CITY OF ALBUQUERQUE STANDARD DETAILS  
FOR SIGNING & STRIPING

**DESIGN REVIEW COMMITTEE**  
APPROVED  
OCT 20 2016







**CITY ENGINEER APPROVAL**  
APPROVED  
MAR 24 2017  
CITY ENGINEER

**DESIGNED BY: JH**  
**DRAWN BY: DY**  
**DRAWING NAME: 2014052-SHT2-COA DETAILS**  
**CHECKED BY: JH**

**REVISIONS**

| NO. | DATE      | REMARKS |
|-----|-----------|---------|
| 1   | 8/01/2016 | DESIGN  |
| 2   | 8/01/2016 | DESIGN  |
| 3   | 2014052   | DESIGN  |

**CITY PROJECT NO. 719880**  
**ZONE MAP NO. F-19-Z**  
**SHEET 12 OF 15**

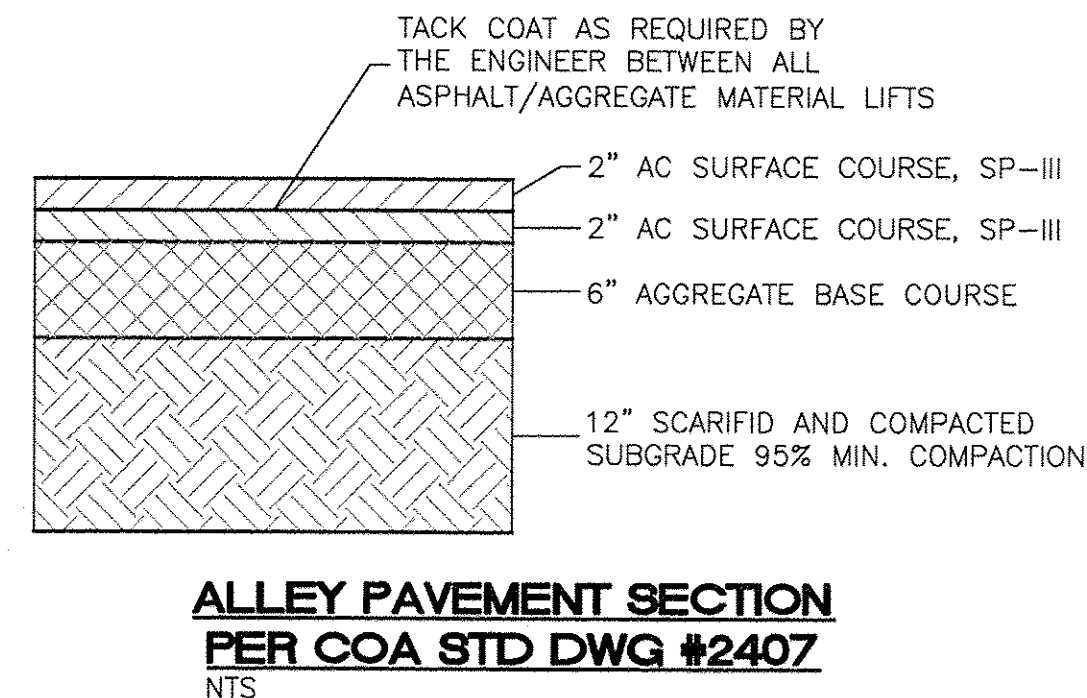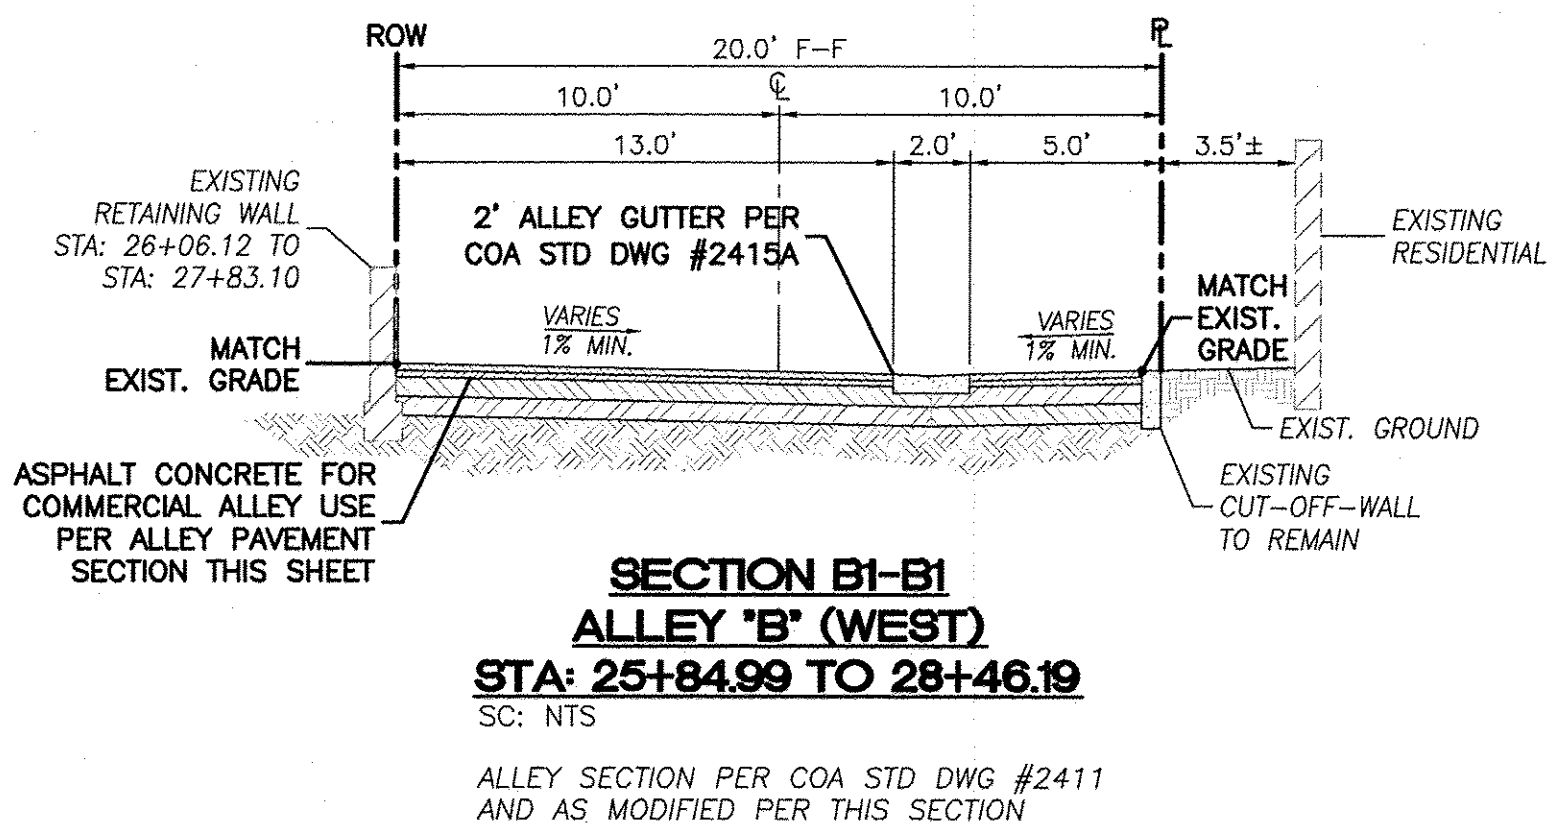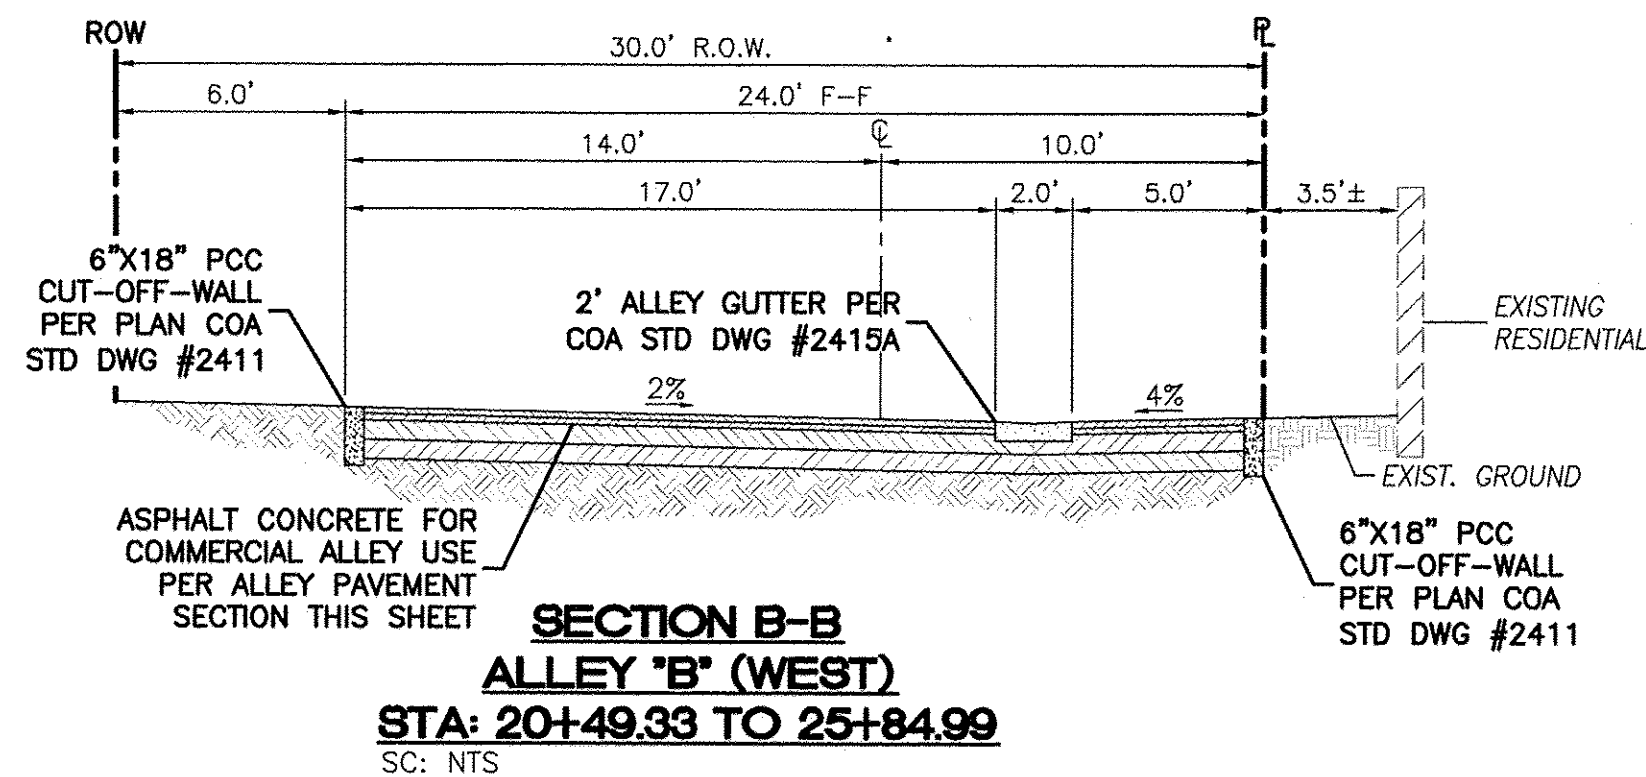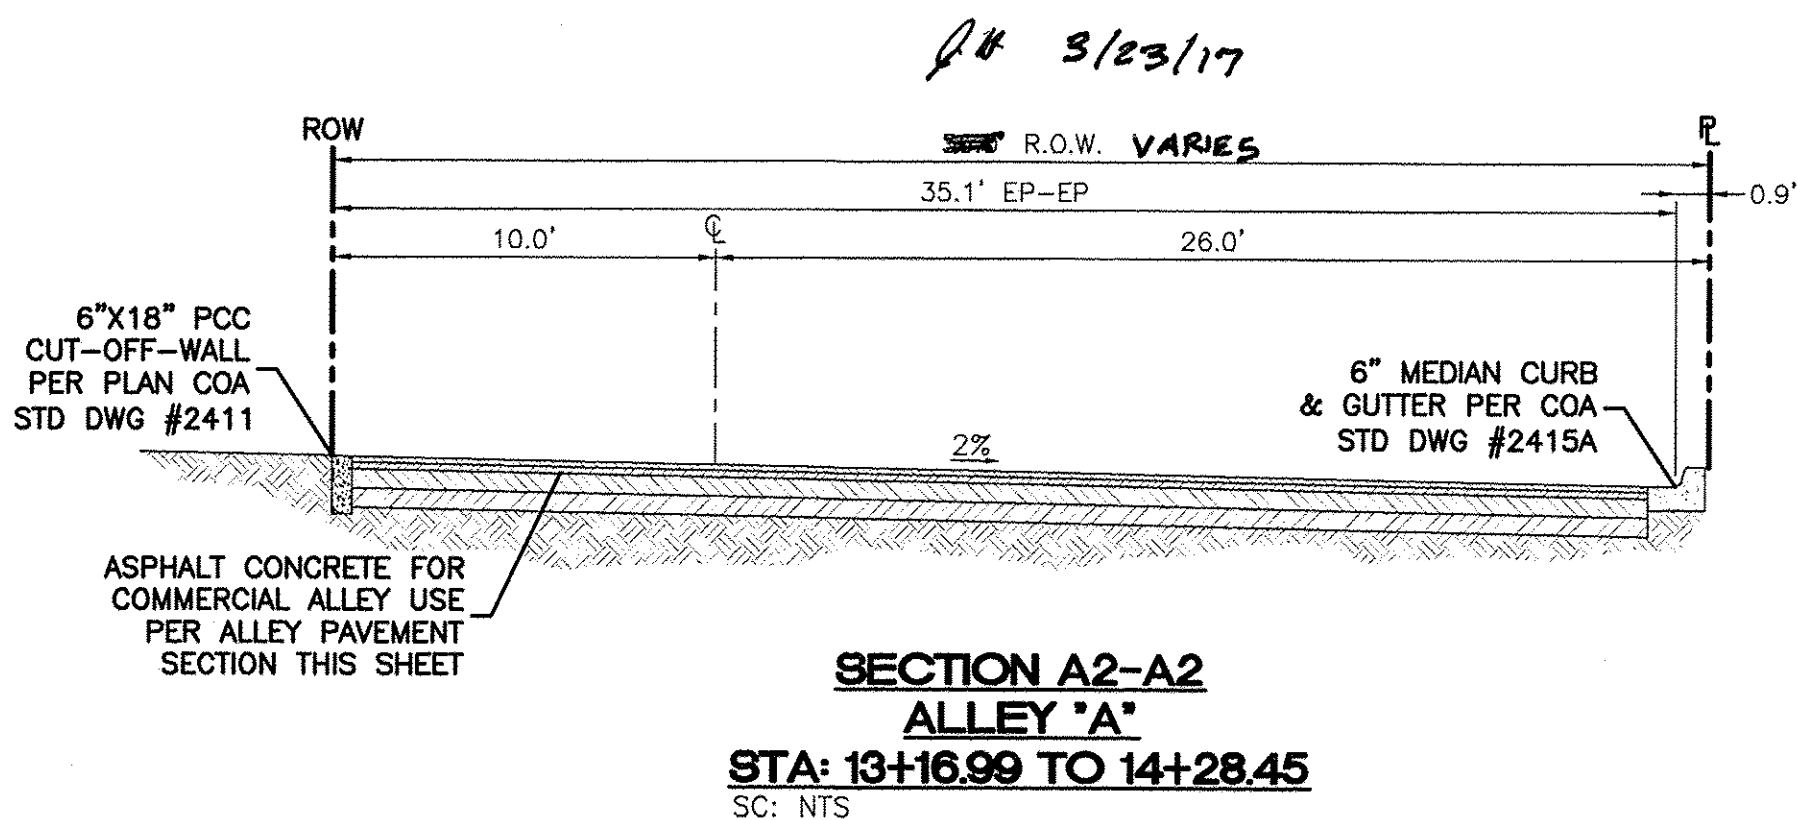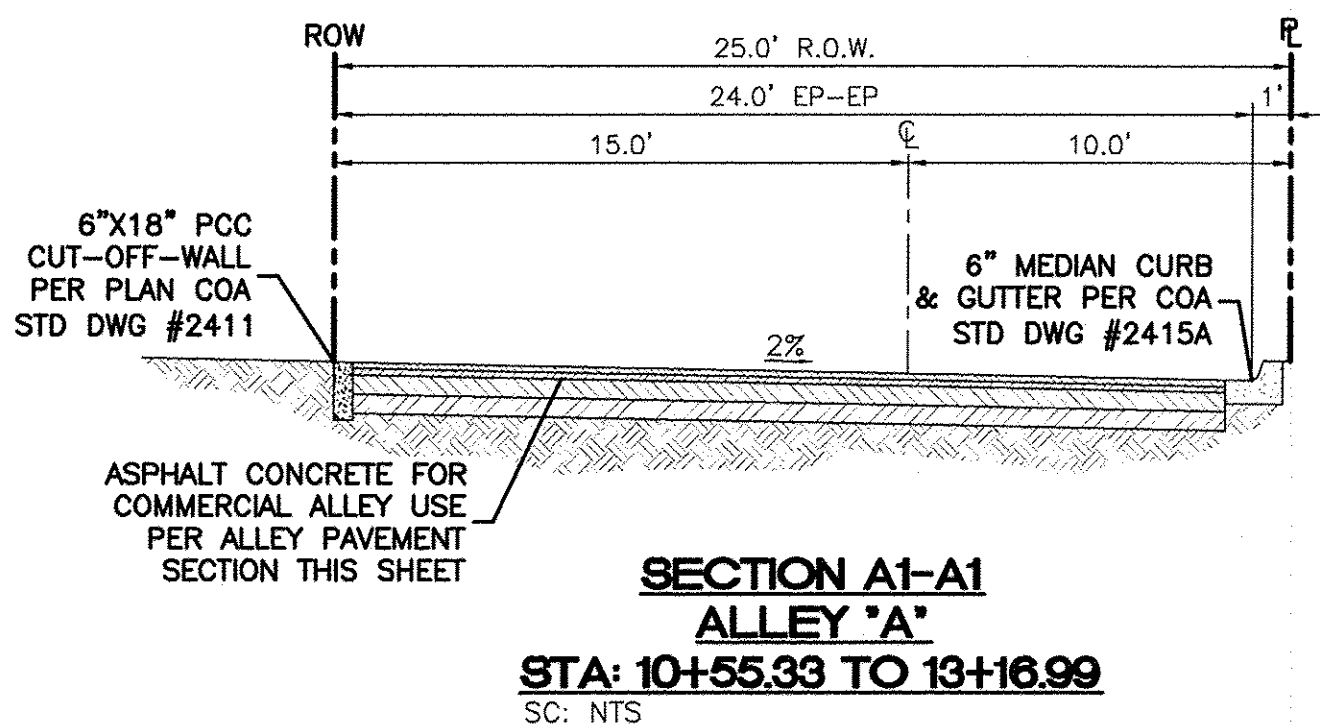
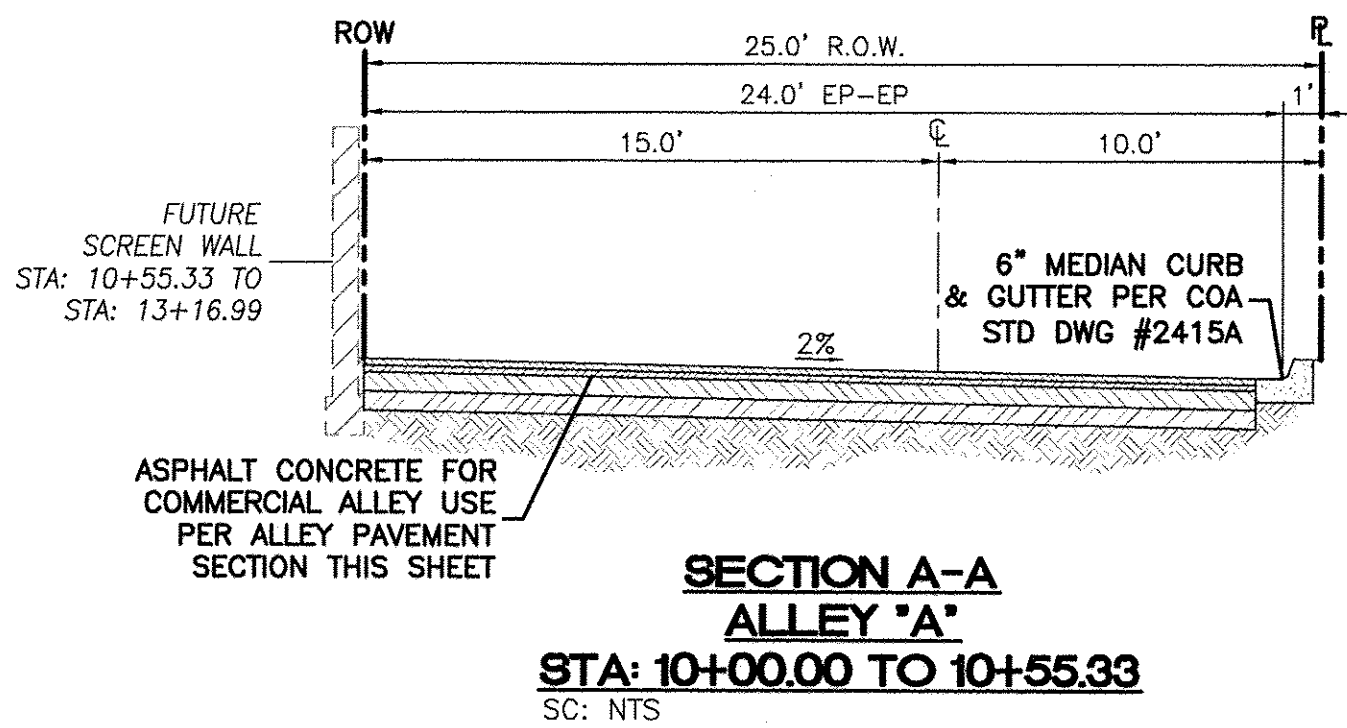


ALLEY SECTION PER COA STD DWG #2411  
AND AS MODIFIED PER THIS SECTION



ALLEY SECTION PER COA STD DWG #2411  
AND AS MODIFIED PER THIS SECTION

CERTIFICATE OF SUBSTANTIAL COMPLIANCE ON PLANS

I, Ronald R. Bohannon, of the firm of Tierra West LLC, a Registered Professional Engineer in the State of New Mexico, do hereby certify, to the best of my knowledge and belief, that the infrastructure installed as part of this project has been inspected by me or by a qualified person under my direct supervision and has been constructed in accordance with the plans and specifications approved by the City Engineer and that the original design intent of the approved plans has been met, except as noted by me on the as-built construction drawings. This Certification is based on site inspections by me, or personnel under my direction with survey information provided by Russ P. Hugg, of Surv-Tek, Inc., NMPS number 9550.

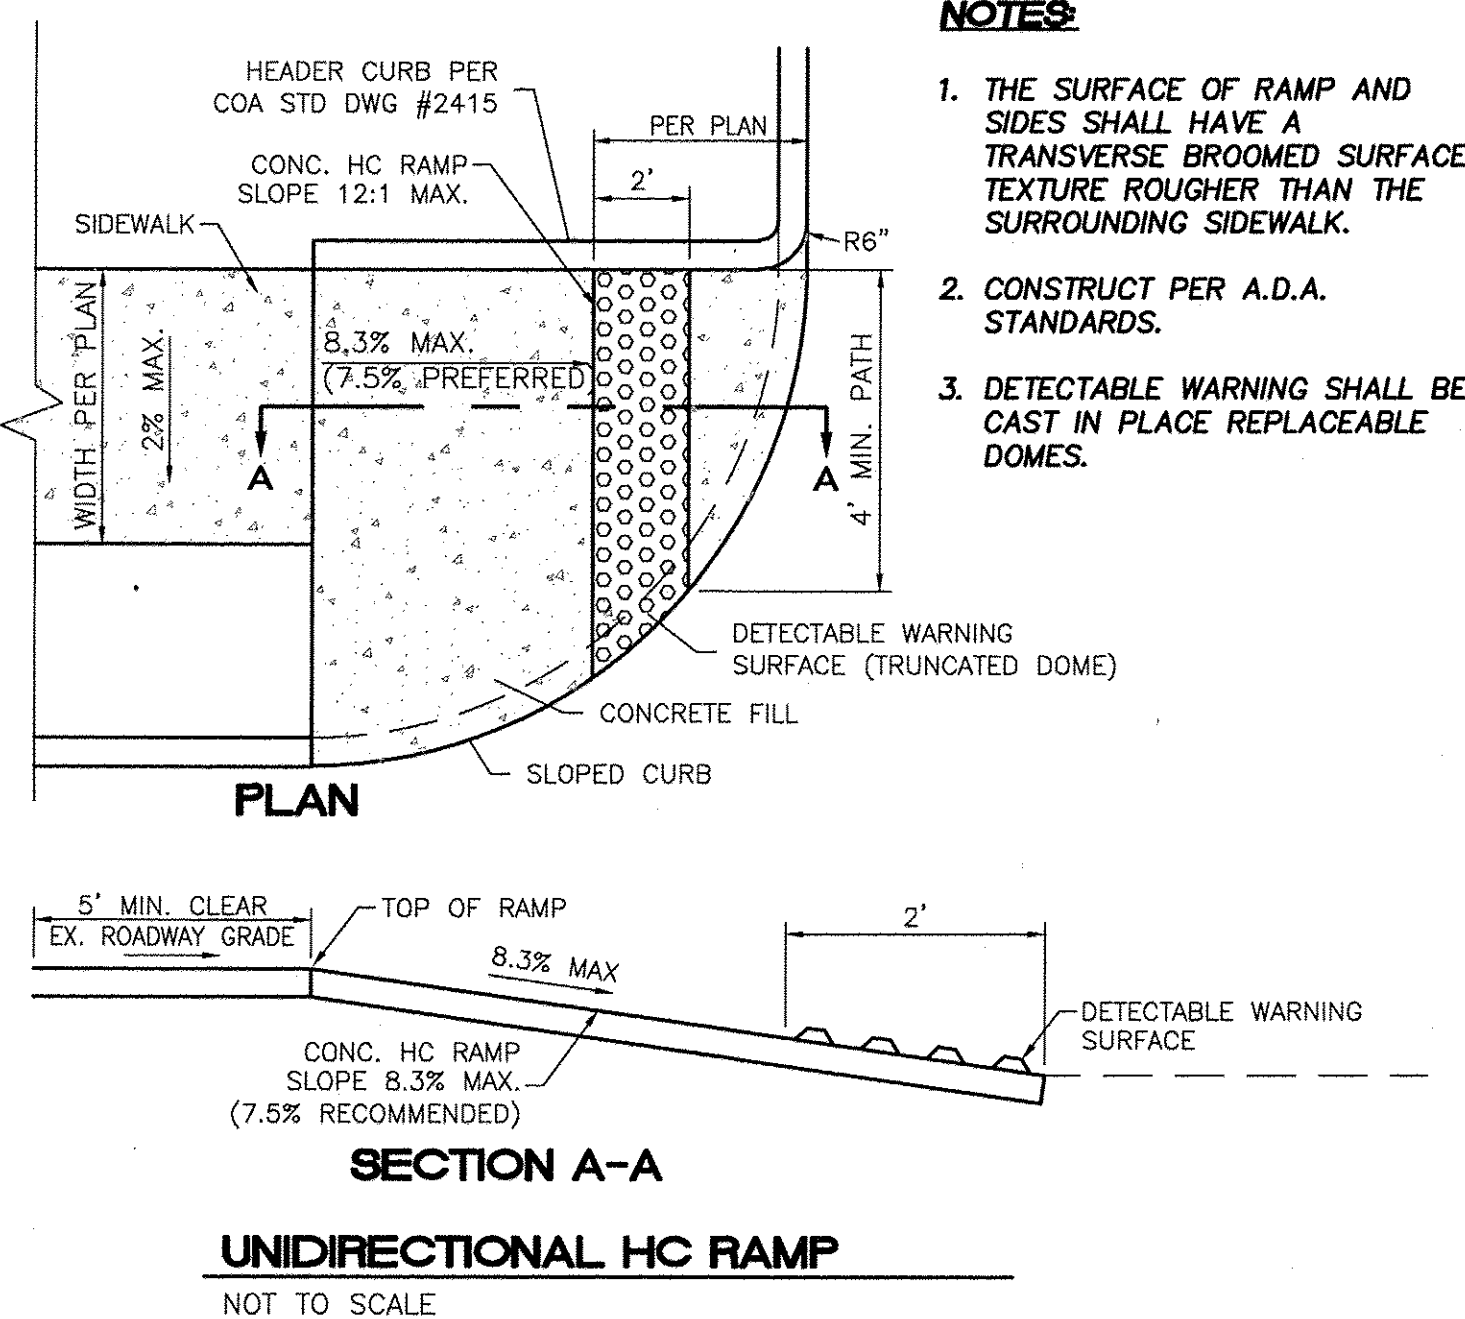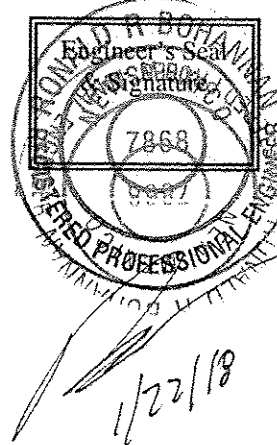

- NOTES:**
1. THE SURFACE OF RAMP AND SIDES SHALL HAVE A TRANSVERSE BROOMED SURFACE TEXTURE ROUGHER THAN THE SURROUNDING SIDEWALK.
  2. CONSTRUCT PER A.D.A. STANDARDS.
  3. DETECTABLE WARNING SHALL BE CAST IN PLACE REPLACEABLE DOMES.

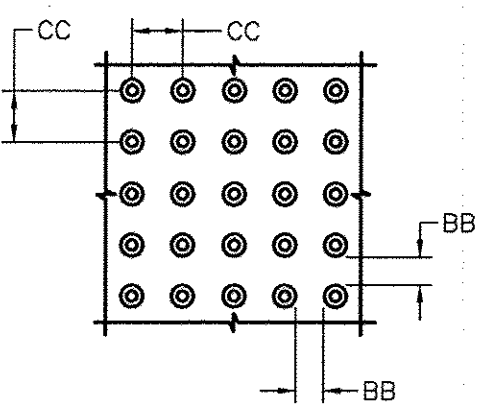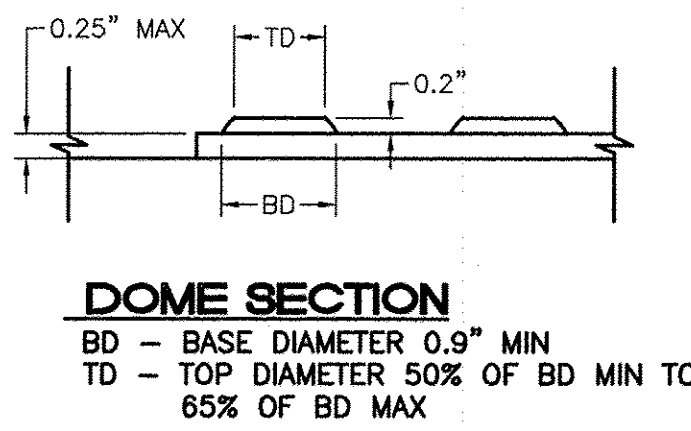


**DOME SPACING**  
CC - CENTER TO CENTER SPACING 2.35"  
BB - BASE TO BASE SPACING 1.48" MIN

**TIERRA WEST, LLC**  
5571 MIDWAY PARK PLACE NE  
ALBUQUERQUE, NM 87109  
(505)858-3100  
www.tierrawestllc.com


**CITY OF ALBUQUERQUE**  
PUBLIC WORKS DEPARTMENT  
ENGINEERING GROUP  
**TITLE: LOS PASTORES SHOPPING CENTER**  
DETAILS

|                                                    |                                          |             |             |
|----------------------------------------------------|------------------------------------------|-------------|-------------|
| DESIGN REVIEW COMMITTEE                            | CITY ENGINEER APPROVAL                   | MO./DAY/YR. | MO./DAY/YR. |
| APPROVED<br>OCT 20 2016<br>DESIGN REVIEW COMMITTEE | APPROVED<br>MAR 24 2017<br>CITY ENGINEER |             |             |
| CITY PROJECT NO.                                   | ZONE MAP NO.                             | SHEET       | OF          |
|                                                    | 719880                                   | F-19-Z      | 13 15       |

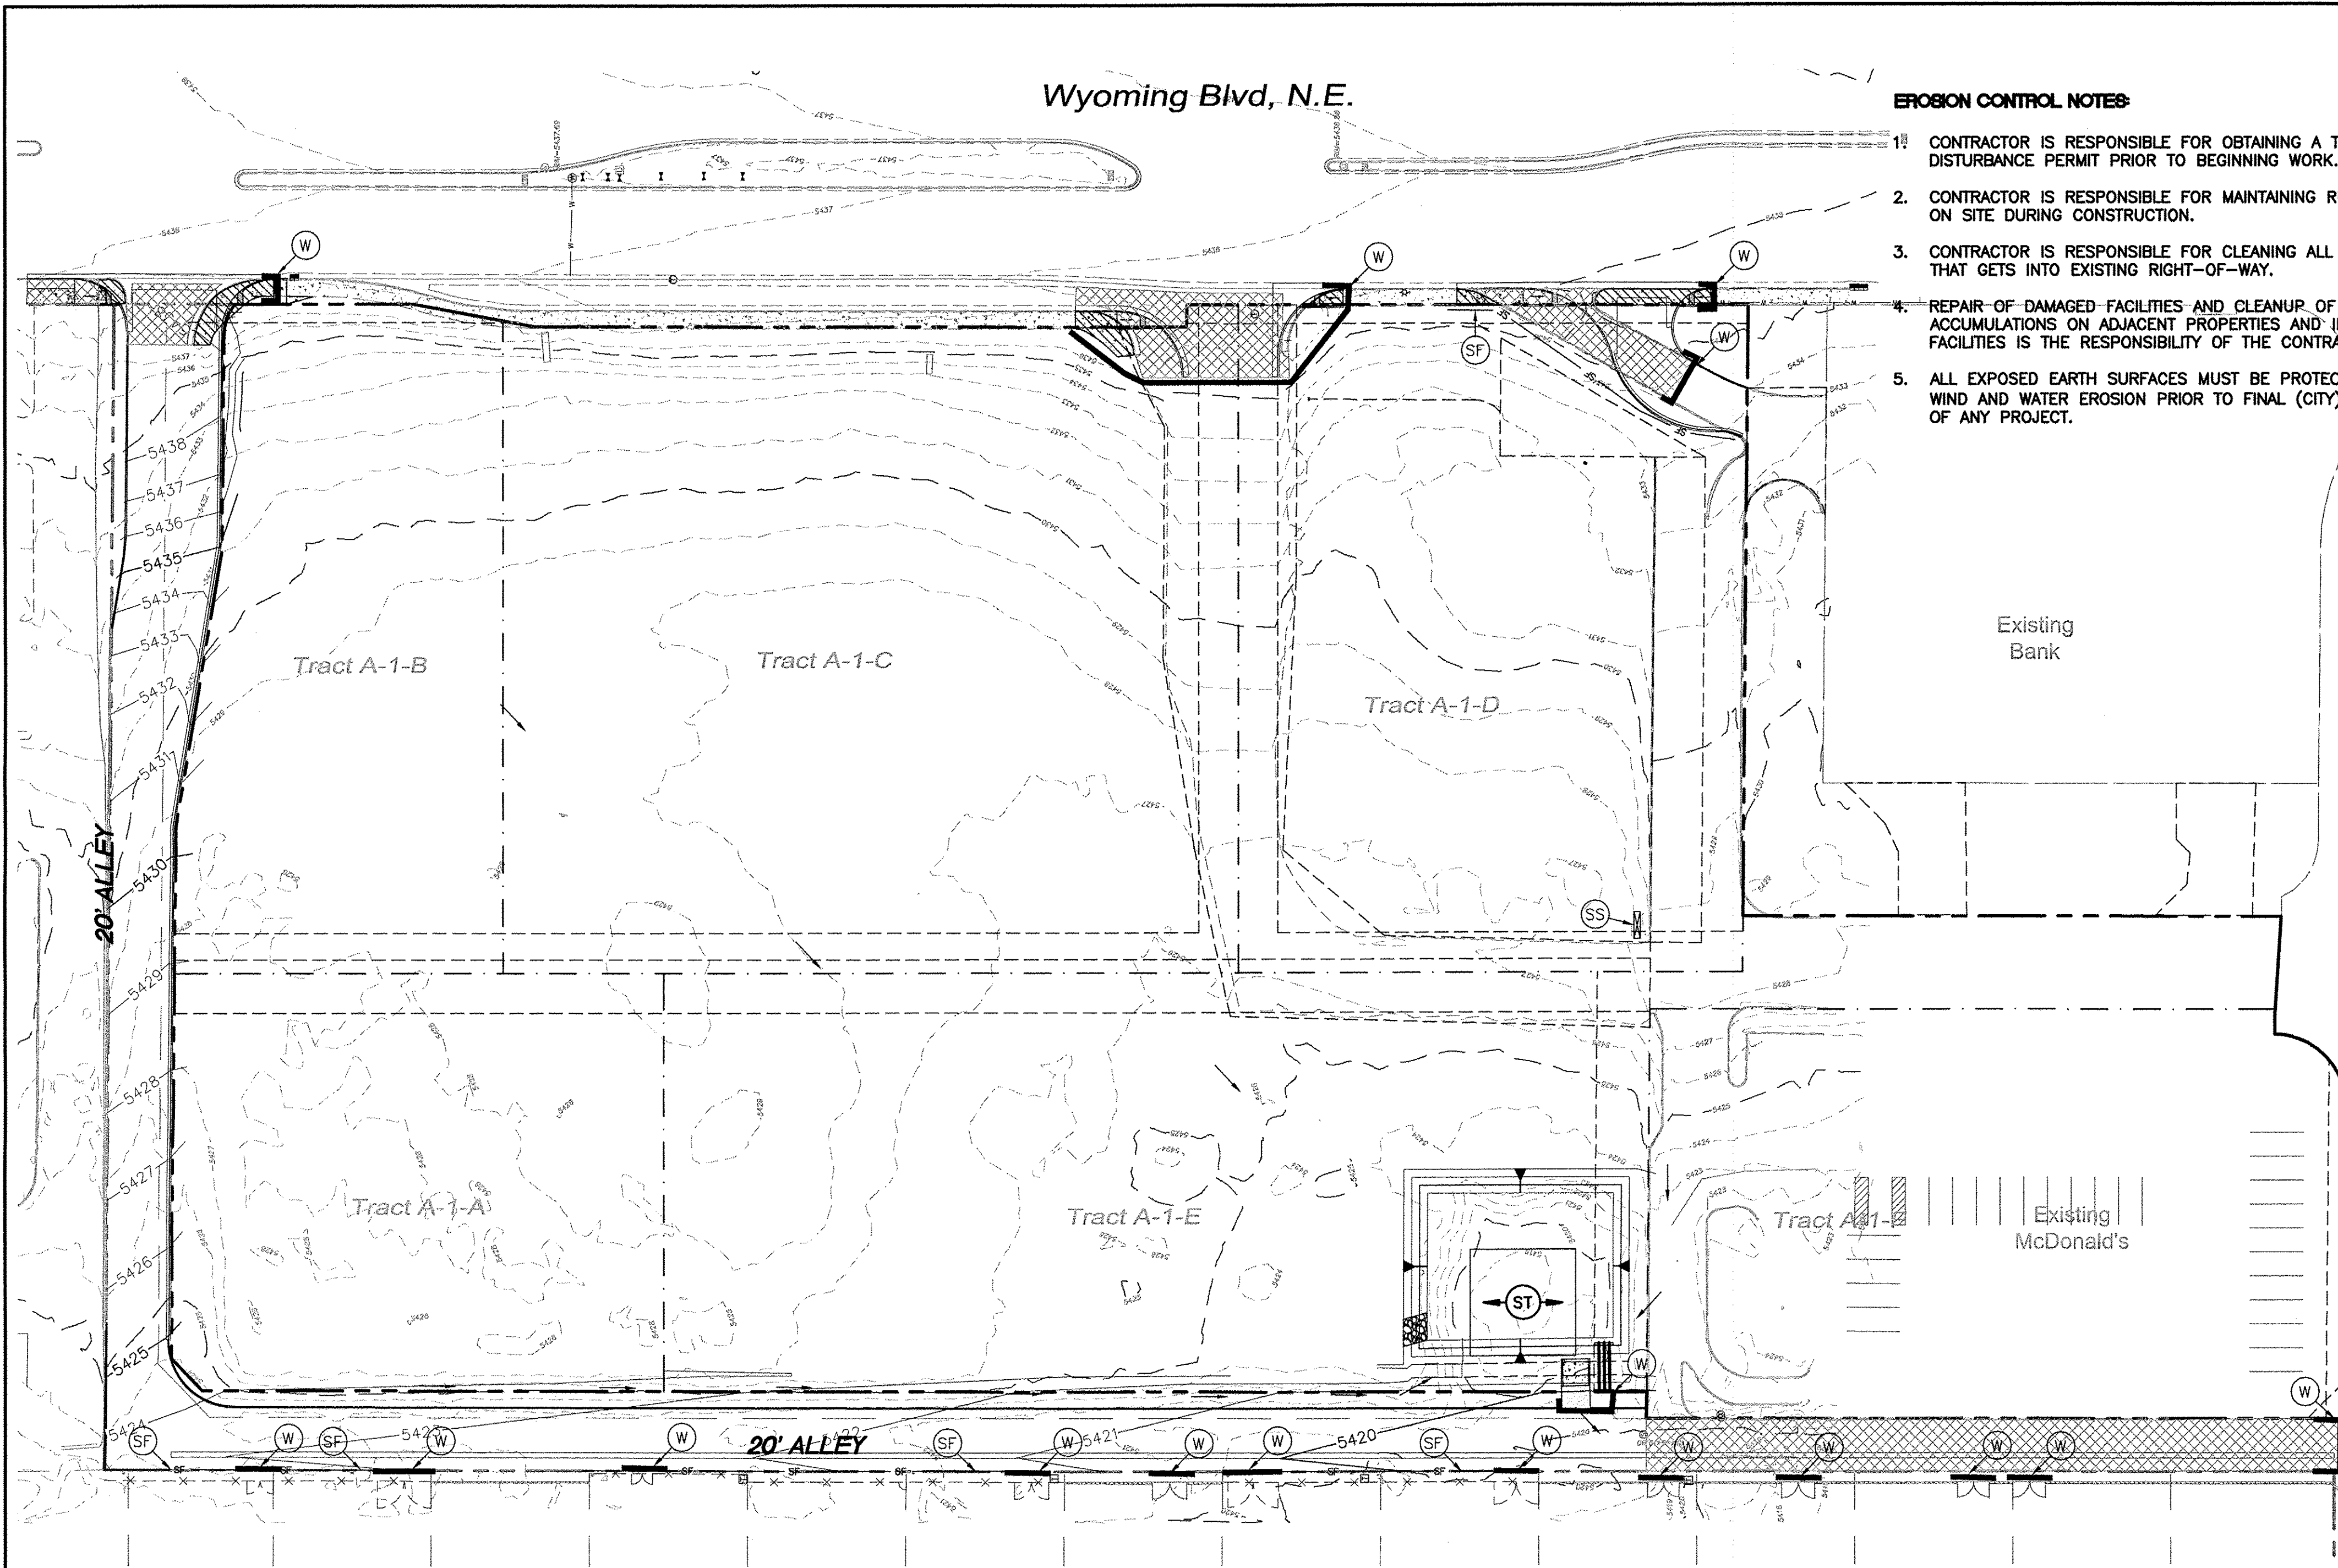

#### EROSION CONTROL NOTES

1. CONTRACTOR IS RESPONSIBLE FOR OBTAINING A TOPSOIL DISTURBANCE PERMIT PRIOR TO BEGINNING WORK.
2. CONTRACTOR IS RESPONSIBLE FOR MAINTAINING RUN-OFF ON SITE DURING CONSTRUCTION.
3. CONTRACTOR IS RESPONSIBLE FOR CLEANING ALL SEDIMENT THAT GETS INTO EXISTING RIGHT-OF-WAY.
4. REPAIR OF DAMAGED FACILITIES AND CLEANUP OF SEDIMENT ACCUMULATIONS ON ADJACENT PROPERTIES AND IN PUBLIC FACILITIES IS THE RESPONSIBILITY OF THE CONTRACTOR.
5. ALL EXPOSED EARTH SURFACES MUST BE PROTECTED FROM WIND AND WATER EROSION PRIOR TO FINAL (CITY) ACCEPTANCE OF ANY PROJECT.

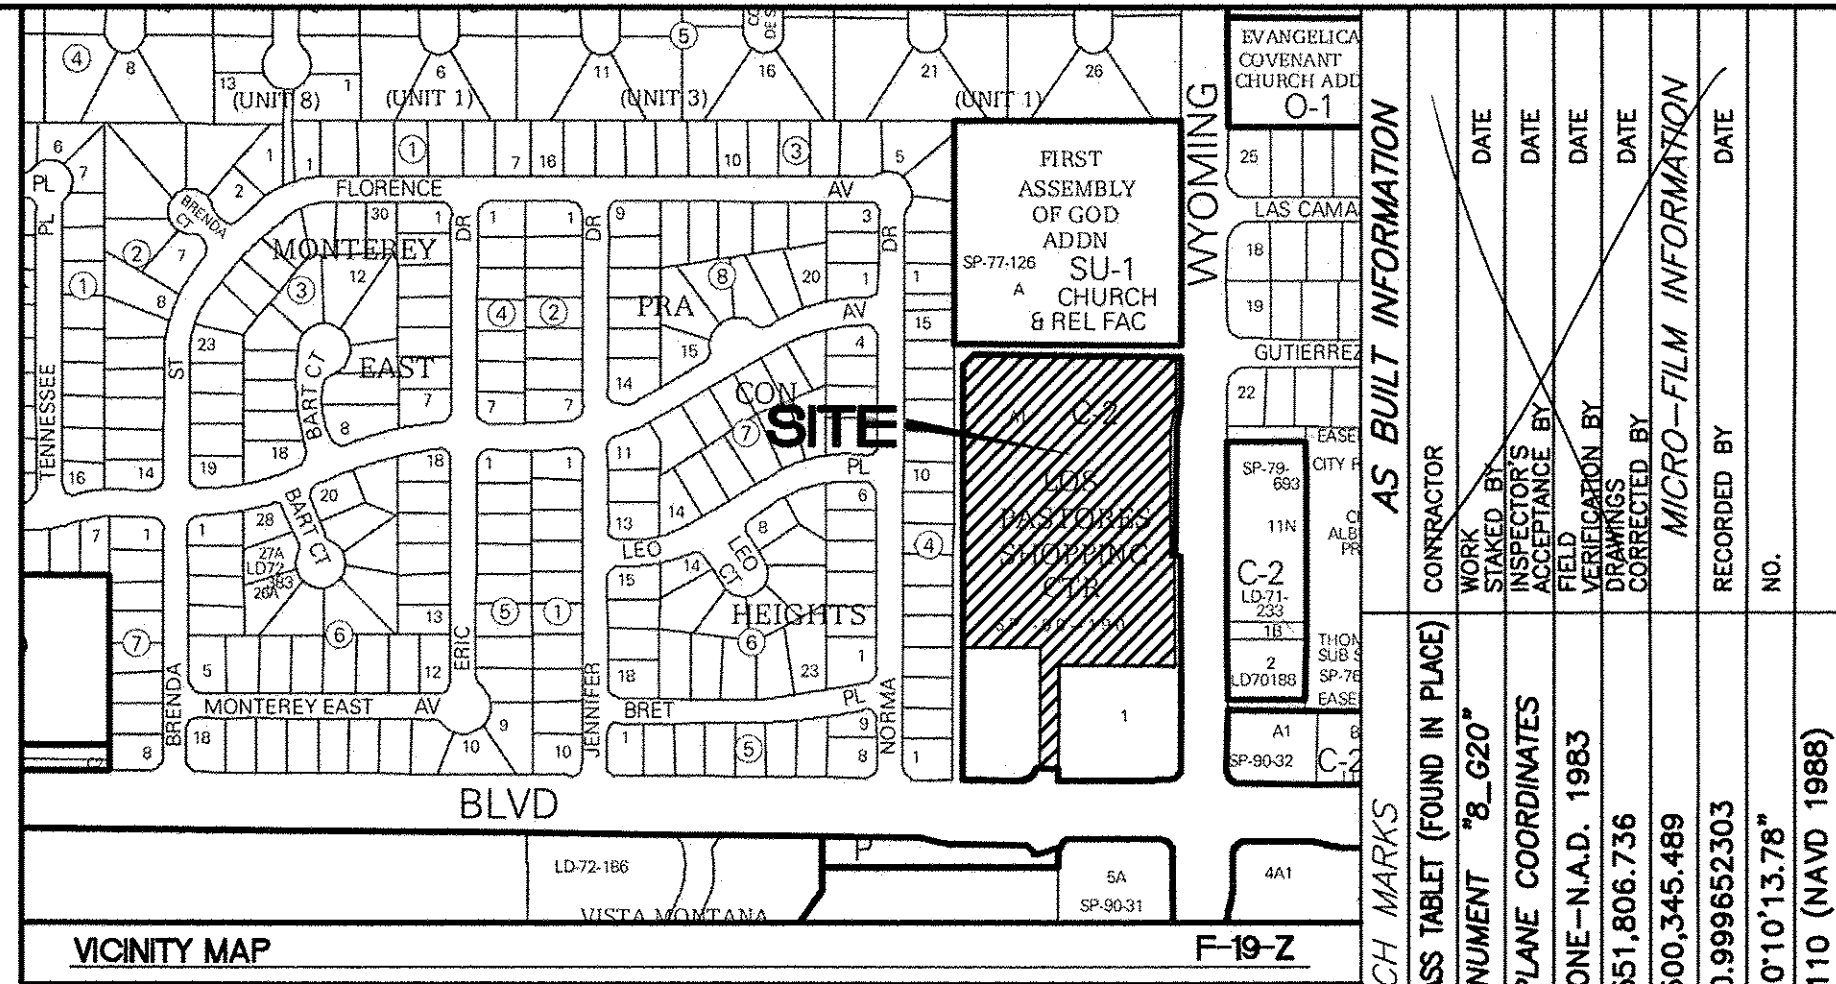

#### GENERAL EROSION NOTES

- A. THE STORMWATER POLLUTION PREVENTION PLAN (SWPPP) IS COMPRISED OF THIS DRAWING ("SITE MAP"), THE STANDARD DETAILS, THE PLAN NARRATIVE, PLUS THE PERMIT AND ALL SUBSEQUENT REPORTS AND RELATED DOCUMENTS.
- B. ALL CONTRACTORS AND SUBCONTRACTORS INVOLVED WITH STORM WATER POLLUTION PREVENTION SHALL OBTAIN A COPY OF THE STORM WATER POLLUTION PREVENTION PLAN AND THE STATE OF NEW MEXICO NATIONAL POLLUTANT DISCHARGE ELIMINATION SYSTEM GENERAL PERMIT (NPDES PERMIT) AND BECOME FAMILIAR WITH THEIR CONTENTS.
- C. CONTRACTOR SHALL IMPLEMENT BEST MANAGEMENT PRACTICES AS REQUIRED BY THE SWPPP. ADDITIONAL BEST MANAGEMENT PRACTICES SHALL BE IMPLEMENTED AS DICTATED BY CONDITIONS AT NO ADDITIONAL COST TO OWNER THROUGHOUT ALL PHASES OF CONSTRUCTION.
- D. BEST MANAGEMENT PRACTICES (BMP'S) AND CONTROLS SHALL CONFORM TO FEDERAL, STATE, OR LOCAL REQUIREMENTS OR MANUAL OF PRACTICE, AS APPLICABLE CONTRACTOR SHALL IMPLEMENT ADDITIONAL CONTROLS AS DIRECTED BY PERMITTING AGENCY OR OWNER.
- E. SITE MAP MUST CLEARLY DELINEATE ALL STATE WATERS. PERMITS FOR ANY CONSTRUCTION ACTIVITY IMPACTING STATE WATERS OR REGULATED WETLANDS MUST BE MAINTAINED ON SITE AT ALL TIMES.
- F. CONTRACTOR SHALL MINIMIZE CLEARING TO THE MAXIMUM EXTENT PRACTICAL OR AS REQUIRED BY THE GENERAL PERMIT.
- G. GENERAL CONTRACTOR SHALL DENOTE ON PLAN THE TEMPORARY PARKING AND STORAGE AREA WHICH SHALL ALSO BE USED AS THE EQUIPMENT MAINTENANCE AND CLEANING AREA, EMPLOYEE PARKING AREA, AND AREA FOR LOCATING PORTABLE FACILITIES, OFFICE TRAILERS, AND TOILET FACILITIES.
- H. ALL WASH WATER (CONCRETE TRUCKS, VEHICLE CLEANING, EQUIPMENT CLEANING, ETC.) SHALL BE DETAINED AND PROPERLY TREATED OR DISPOSED.
- I. SUFFICIENT OIL AND GREASE ABSORBING MATERIALS AND FLOTATION BOOMS SHALL BE MAINTAINED ON SITE OR READILY AVAILABLE TO CONTAIN AND CLEAN-UP FUEL OR CHEMICAL SPILLS AND LEAKS.
- J. DUST ON THE SITE SHALL BE CONTROLLED THE USE OF MOTOR OILS AND OTHER PETROLEUM BASED OR TOXIC LIQUIDS FOR DUST SUPPRESSION OPERATIONS IS PROHIBITED.
- K. RUBBISH, TRASH, GARBAGE, LITTER, OR OTHER SUCH MATERIALS SHALL BE DEPOSITED INTO SEALED CONTAINERS. MATERIALS SHALL BE PREVENTED FROM LEAVING THE PREMISES THROUGH THE ACTION OF WIND OR STORMWATER DISCHARGE INTO DRAINAGE DITCHES OR WATERS OF THE STATE.
- L. ALL STORM WATER POLLUTION PREVENTION MEASURES PRESENTED ON THIS PLAN, AND IN THE STORM WATER POLLUTION PREVENTION PLAN, SHALL BE INITIATED AS SOON AS PRACTICABLE.
- M. DISTURBED PORTIONS OF THE SITE WHERE CONSTRUCTION ACTIVITY HAS STOPPED FOR AT LEAST 21 DAYS, SHALL BE TEMPORARILY SEEDED. THESE AREAS SHALL BE SEEDED NO LATER THAN 14 DAYS FROM THE LAST CONSTRUCTION ACTIVITY OCCURRING THESE AREAS. PROVIDE ADEQUATE TEMPORARY IRRIGATION FOR GERMINATION.
- N. DISTURBED PORTIONS OF THE SITE WHERE CONSTRUCTION ACTIVITY HAS PERMANENTLY STOPPED SHALL BE PERMANENTLY SEEDED. THESE AREAS SHALL BE SEEDED NO LATER THAN 14 DAYS AFTER THE LAST CONSTRUCTION ACTIVITY OCCURRING IN THESE AREAS. REFER TO THE GRADING PLAN AND/OR LANDSCAPE PLAN.
- O. IF THE ACTION OF VEHICLES TRAVELING OVER THE GRAVEL CONSTRUCTION ENTRANCES IS NOT SUFFICIENT TO REMOVE THE MAJORITY OF DIRT OR MUD, THEN THE TIRES MUST BE WASHED BEFORE THE VEHICLES ENTER A PUBLIC ROAD. IF WASHING IS USED, PROVISION MUST BE MADE TO INTERCEPT THE WASH WATER AND TRAP THE SEDIMENT BEFORE IT IS CARRIED OFF THE SITE.
- P. ALL MATERIALS SPILLED, DROPPED, WASHED, OR TRACKED FROM VEHICLES ONTO ROADWAYS OR INTO STORM DRAINS MUST BE REMOVED IMMEDIATELY.
- Q. CONTRACTORS OR SUBCONTRACTORS WILL BE RESPONSIBLE FOR REMOVING SEDIMENT IN THE DETENTION POND AND ANY SEDIMENT THAT MAY HAVE COLLECTED IN THE STORM SEWER DRAINAGE SYSTEMS IN CONJUNCTION WITH THE STABILIZATION OF THE SITE.
- R. ON-SITE & OFFSITE SOIL STOCKPILE AND BORROW AREAS SHALL BE PROTECTED FROM EROSION AND SEDIMENTATION THROUGH IMPLEMENTATION OF BEST MANAGEMENT PRACTICES, AS REQUIRED PER THE CONSTRUCTION GENERAL PERMIT. STOCKPILE AND BORROW AREA LOCATIONS SHALL BE NOTED ON THE SITE MAP AND PERMITTED IN ACCORDANCE WITH GENERAL PERMIT REQUIREMENTS.
- S. SLOPES SHALL BE LEFT IN A ROUGHENED CONDITION DURING THE GRADING PHASE TO REDUCE RUNOFF VELOCITIES AND EROSION.
- T. DUE TO THE GRADE CHANGES DURING THE DEVELOPMENT OF THE PROJECT, THE CONTRACTOR SHALL BE RESPONSIBLE FOR ADJUSTING THE EROSION CONTROL MEASURES (SILT FENCES, STRAW BALES, ETC.) TO PREVENT EROSION.
- U. ALL CONSTRUCTION SHALL BE STABILIZED AT THE END OF EACH WORKING DAY, THIS INCLUDES BACKFILLING OF TRENCHES FOR UTILITY CONSTRUCTION AND PLACEMENT OF GRAVEL OR BITUMINOUS PAVING FOR ROAD CONSTRUCTION.

#### FOR REFERENCE ONLY

|                                                                                                                        |                                                                           |
|------------------------------------------------------------------------------------------------------------------------|---------------------------------------------------------------------------|
| <b>TERRA WEST, LLC</b><br>5571 MIDWAY PARK PLACE NE<br>ALBUQUERQUE, NM 87109<br>(505)858-3100<br>www.tierrawestllc.com |                                                                           |
| CITY OF ALBUQUERQUE<br>PUBLIC WORKS DEPARTMENT<br>ENGINEERING GROUP                                                    |                                                                           |
| TITLE: <b>LOS PASTORES SHOPPING CENTER</b><br>TEMPORARY EROSION CONTROL AND SEDIMENTATION PLAN                         |                                                                           |
| DESIGN REVIEW COMMITTEE<br><b>APPROVED</b><br>OCT 20 2016<br>DESIGN REVIEW COMMITTEE                                   | CITY ENGINEER APPROVAL<br><b>APPROVED</b><br>MAR 24 2017<br>CITY ENGINEER |
| CITY PROJECT NO. 719880                                                                                                | ZONE MAP NO. F-19-Z                                                       |
| SHEET 14                                                                                                               | OF 15                                                                     |

#### ESC Plan Standard Notes

2-29-16, 3-11-16, 4-26-16

1. Please add a note that "When doing work in the City ROW (e.g. sidewalk, drive pads, utilities, etc...) prevent dirt from getting into the street. If dirt is present in the street, the street should be swept every few days or the same day if rain is imminent.
2. When cutting the street for utilities add a Keyed Note that the dirt should be placed on the uphill side of the street cut and the area swept after the work is complete.
3. On streets where the longitudinal slope is steeper than 2.5%, wattles or j-hook silt fence should be placed in the front yard swale.
4. When installing utilities behind the curb, the excavated dirt should not be placed in the street.
5. A sediment pond should be built at the downstream end of long streets with a large wattle or numerous smaller wattles placed at the pond spillway.

#### SEQUENCE OF CONSTRUCTION

1. INSTALL STABILIZED CONSTRUCTION ENTRANCES.
2. CONSTRUCT THE SILT FENCES ON THE SITE.
3. PREPARE TEMPORARY PARKING AND STORAGE AREA.
4. CONSTRUCT THE SEDIMENTATION AND SEDIMENT TRAP BASINS.
5. PERFORM DEMOLITION ON THE SITE.
6. UNDERCUT GRADE AS REQUIRED.
7. START CONSTRUCTION OF BUILDING PAD AND STRUCTURES.
8. FINISH GRADING THE SITE. RAISE GRADES TO INDUCE DRAINAGE TOWARD TEMPORARY SEDIMENT BASINS

#### MAINTENANCE

ALL MEASURES STATED ON THIS EROSION AND SEDIMENT CONTROL PLAN, AND IN THE STORM WATER POLLUTION PREVENTION PLAN, SHALL BE MAINTAINED IN FULLY FUNCTIONAL CONDITION UNTIL NO LONGER REQUIRED FOR A COMPLETED PHASE OF WORK OR FINAL STABILIZATION OF THE SITE. ALL EROSION AND SEDIMENTATION CONTROL MEASURES SHALL BE CHECKED BY A QUALIFIED PERSON AT LEAST ONCE EVERY SEVEN CALENDAR DAYS AND WITHIN 24 HOURS OF THE END OF A 0.5" RAINFALL EVENT, AND CLEANED AND REPAIRED IN ACCORDANCE WITH THE FOLLOWING:

1. INLET PROTECTION DEVICES AND BARRIERS SHALL BE REPAIRED OR REPLACED IF THEY SHOW SIGNS OF UNDERMINING, OR DETERIORATION.
2. ALL SEEDED AREAS SHALL BE CHECKED REGULARLY TO SEE THAT A GOOD STAND IS MAINTAINED. AREAS SHOULD BE FERTILIZED, WATERED, AND RESEEDED AS NEEDED.
3. SILT FENCES SHALL BE REPAIRED TO THEIR ORIGINAL CONDITIONS IF DAMAGED. SEDIMENT SHALL BE REMOVED FROM THE SILT FENCES WHEN IT REACHES ONE-HALF THE HEIGHT OF THE SILT FENCE.
4. THE CONSTRUCTION ENTRANCES SHALL BE MAINTAINED IN A CONDITION WHICH WILL PREVENT TRACKING OR FLOW OF MUD ONTO PUBLIC RIGHTS-OF-WAY. THIS MAY REQUIRE PERIODIC TOP DRESSING OF THE CONSTRUCTION ENTRANCES AS CONDITIONS DEMAND.
5. ANY TEMPORARY PARKING AND STORAGE AREAS SHALL BE KEPT IN GOOD CONDITION (SUITABLE FOR PARKING AND STORAGE). THIS MAY REQUIRE PERIODIC TOP DRESSING OF THE TEMPORARY PARKING AS CONDITIONS DEMAND. ONCE IDENTIFIED, NOTE ON THE SWPPP PLAN.
6. OUTLET STRUCTURES IN THE SEDIMENTATION BASINS SHALL BE MAINTAINED IN OPERATIONAL CONDITIONS AT ALL TIMES. SEDIMENT SHALL BE REMOVED FROM SEDIMENT BASINS OR TRAPS WHEN THE DESIGN CAPACITY HAS BEEN REDUCED BY 50%.

#### CAUTION:


ALL EXISTING UTILITIES SHOWN WERE OBTAINED FROM RESEARCH, AS-BUILTS, SURVEYS OR INFORMATION PROVIDED BY OTHERS. IT SHALL BE THE SOLE RESPONSIBILITY OF THE CONTRACTOR TO CONDUCT ALL NECESSARY FIELD INVESTIGATIONS PRIOR TO AND INCLUDING ANY EXCAVATION, TO DETERMINE THE ACTUAL LOCATION OF UTILITIES AND OTHER IMPROVEMENTS, PRIOR TO STARTING THE WORK. ANY CHANGES FROM THIS PLAN SHALL BE COORDINATED WITH AND APPROVED BY THE ENGINEER.

#### EROSION NOTES

- TPS TEMPORARY PARKING AND STORAGE
- LIMITS OF DISTURBANCE
- WATTLE

#### EROSION DETAILS

- CE TEMPORARY STONE CONSTRUCTION EXIT
- SF TEMPORARY SILT FENCE
- ST TEMPORARY SEDIMENT TRAP
- SS SWPPP SIGN
- W WATTLE
- IP INLET PROTECTION

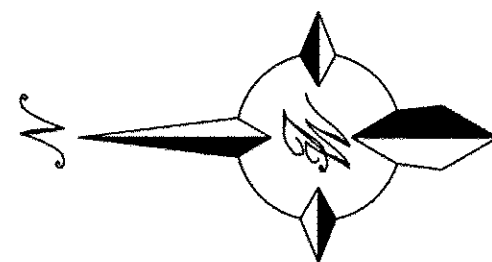

#### GRAPHIC SCALE

