

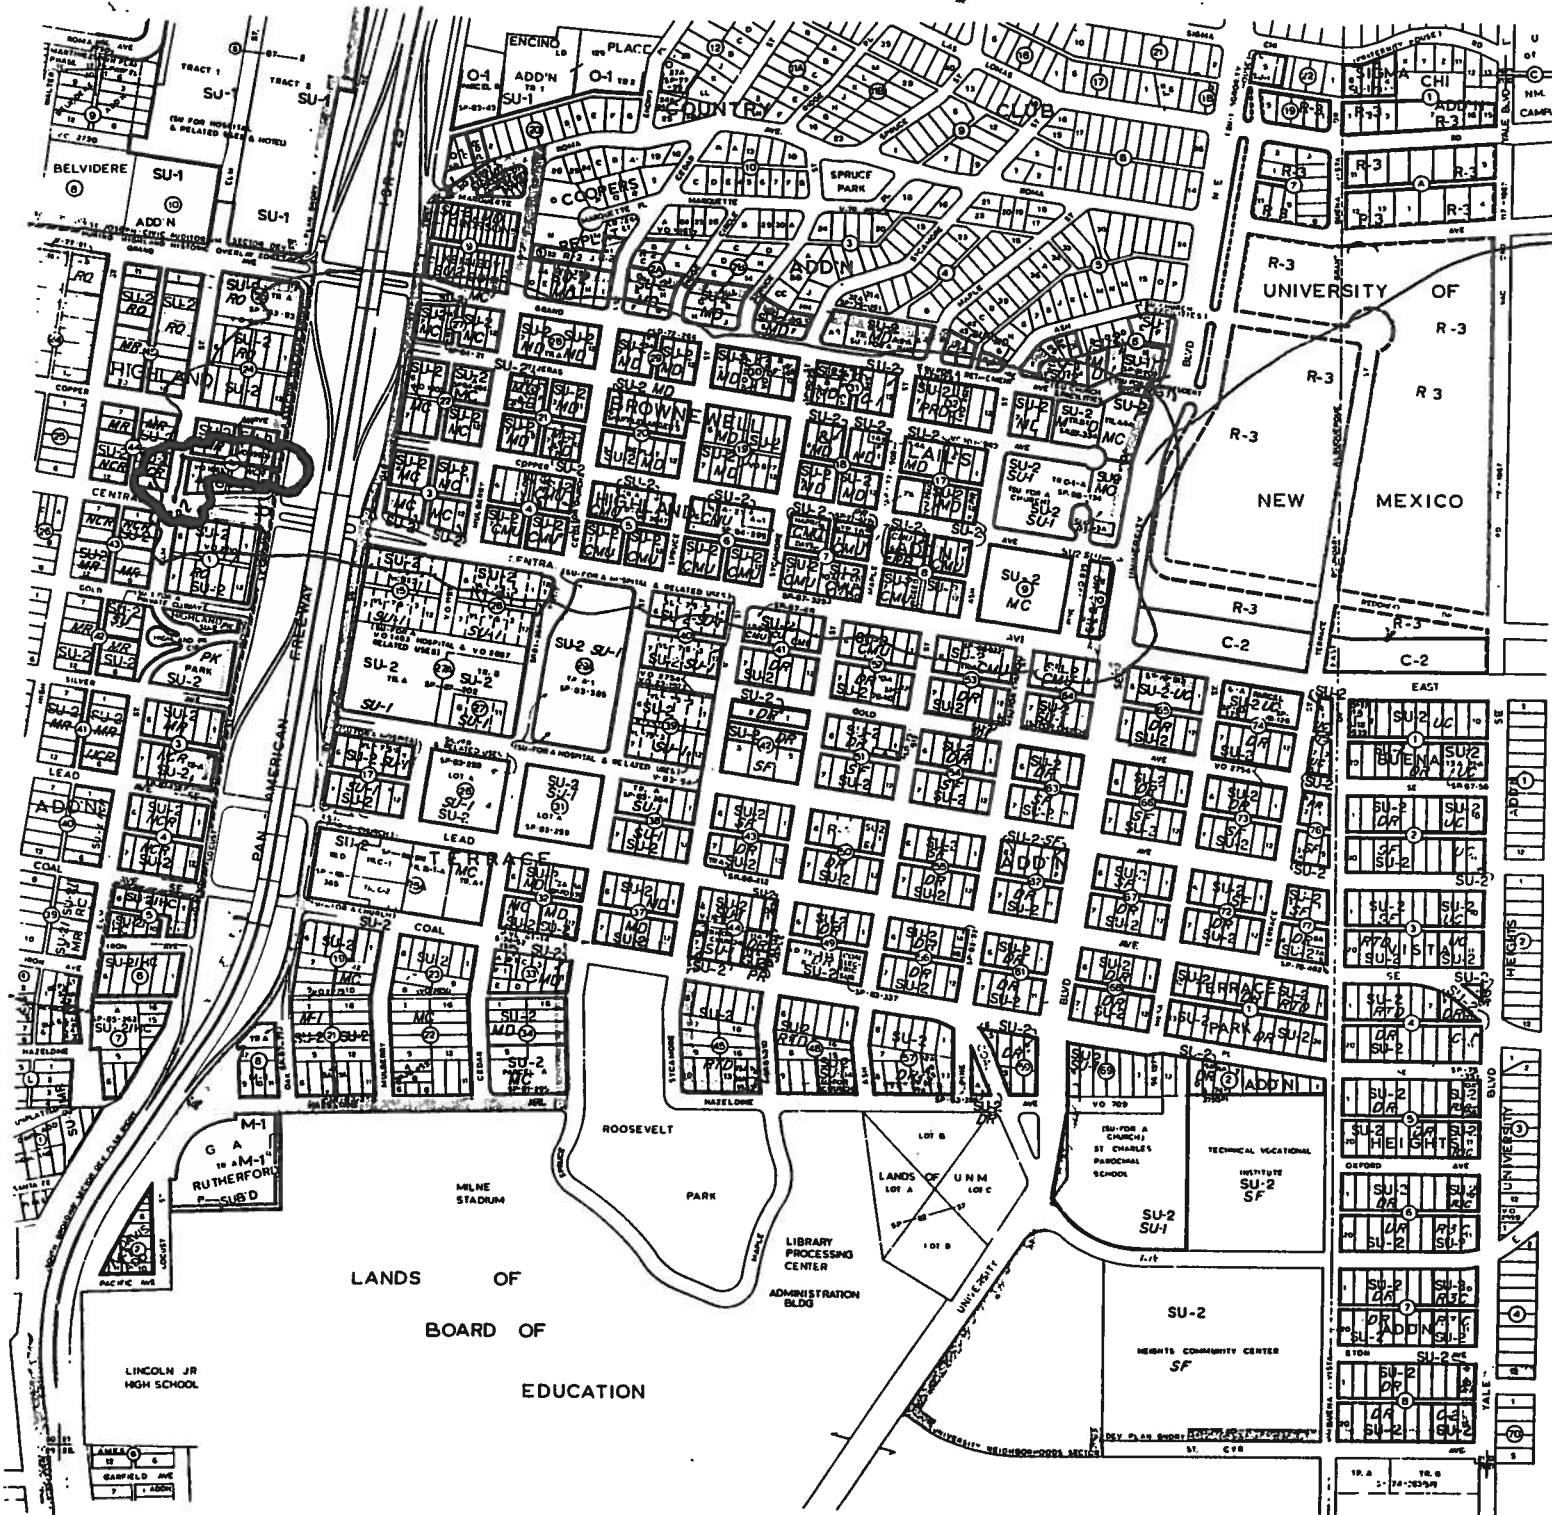


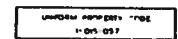


NEED SAS
MAP OF THIS
AREA.

Rick.

U.R. HALL
PNC 2003-2
7200.02

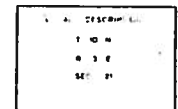

The regulations governing SU-2 zoning in the Heights Community Area and University Neighborhood Area are included in the Sector Development Plan Section of the City of Albuquerque. The area boundary is indicated by a shaded pattern along the perimeter of the area.

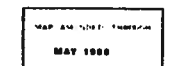

15+65
Existing M.H. #1

NA

Central & Elm S.A.S. Replacement,
Project # 7200.02 - 2003-02
Contractor - J.R. Hale
Map # K-15
*Check-Cut Sheet For INV.
Elev.
*Check-T.V. Insp. For S.A.S. Serv.
Location

187'81"

1.61%

13+77
New M.H. #3
4' Dia

1.54%

Ally

New 8" S.A.S.
SDR-35

127'19"

New
4' Dia M.H. #2
11+90

New 8" S.A.S.
SDR-35

190.07' 1.805%

Elm

Central

Existing
M.H. #1
10+00

ELM	/	SPRUCE	SAS
-----	---	--------	-----

STA	Offset EL	100 EL	C/100	Rim C/F	Offset Dist
MH 10+00	4999.72	92.33	7.39	0.36/F ⁵⁰	16.23
10+53.56	5000.01	93.39	6.62		15.63
11+39.57	5000.41	94.76	5.65		15.57
MH 11+90.07	5000.79	95.76	5.03	0.37/F ⁵⁰	15.58
12+43.22	5002.99	96.69	6.30		7.01
13+19.91	5005.34	98.02	7.32		7.47
MH 13+72.26	5008.24	99.02	9.22	0.83/C ⁴⁰	7.63
14+11.88	5009.38	99.59	9.79		6.79
14+60.19	5010.94	100.39	10.55		8.22
15+12.84	5012.33	101.26	11.07		8.96
MH 15+65.07	5013.29	102.12	11.17	13.09/F ⁵⁰	18.68

Bobby Smith

Frontage Rd
(SPRUGG) Locust

Note ELEVATIONS & STATIONS
Are Assumed

