

HIGHLAND DETENTION BASIN SYSTEM-PHASE III B

NOVEMBER 2003

INDEX OF DRAWINGS

SHEET NO.	DESCRIPTION
1 OF 21	TITLE SHEET, INDEX OF DRAWINGS AND VICINITY MAP
2 OF 21	LEGEND AND GENERAL NOTES
3 OF 21	SHEET INDEX MAP
4 OF 21	WATER VALVE LOCATION PLAN STORM DRAIN PLAN AND PROFILE
5 OF 21	VALVERDE DIVERSION
6 OF 21	"
7 OF 21	BURTON AVE. EAST SPUR LINE
8 OF 21	"
9 OF 21	TRUMAN ST. SPUR LINE
10 OF 21	"
11 OF 21	ANDERSON AVE. SPUR LINE
12 OF 21	ANDERSON AVE. SPUR LINE
13 OF 21	ROSS AVE. SPUR LINE
14 OF 21	CENTRAL AVE. BY-PASS
15 OF 21	CENTRAL AVE. SPUR
16 OF 21	"
17 OF 21	"
18 OF 21	"
19 OF 21	TRAFFIC CONTROL SIGNING AND CONSTRUCTION TRAFFIC CONTROL STANDARDS
20 OF 21	"
21 OF 21	TRAFFIC CONTROL PLAN

Not Included In
This Project


UTILITY COMPANY CONTACTS

DATE LAST EDITED: 7-28-2003

CROWEL, DAVID	OFFICE PHONE: (505) 842-2911 OFFICE FAX: 842-2890 dcrowel@att.com	AT&T RESOURCE SUPERVISOR 111 3rd STREET NW ALBUQUERQUE, NM 87103	MUELLER, RICK	OFFICE PHONE: (505) 244-3161 OFFICE FAX: 244-0094 MOBILE: 228-3329 rdmueller@mcleodusa.com	MCLEOD USA SUPERVISOR OF OUTSIDE TECHS. 505 MARQUETTE NW (COMPASS BANK) SUITE 1600 ALBUQUERQUE, NM 87102
DARNELL, ANDY	OFFICE PHONE: (505) 346-4470 OFFICE FAX: 346-4481 andy.darnell@wcom.com	MCI WORLDWIDE OPERATIONS MANAGER 6001 MIDWAY PARK NE ALBUQUERQUE, NM 87109	MULLER, DAVID	OFFICE PHONE: (505) 245-8706 OFFICE FAX: 245-6831 dmuller@uswest.com	QWEST/US WEST CAPACITY PROVISIONING SPECIALIST 201 3rd STREET NW (BANK OF ALBUQUERQUE) SUITE 700 ALBUQUERQUE, NM 87102
ERICKSON, RITA	OFFICE PHONE: (505) 761-6235 OFFICE FAX: 761-0599 rita_erickson@cable.comcast.com	COMCAST PLANNING AND DESIGN SUPERVISOR 4611 MONTBEL PLACE NE ALBUQUERQUE, NM 87107	OLSON, GREG	OFFICE PHONE: (505) 768-2719 OFFICE FAX: (505) 768-3629 goison@cabq.gov	CITY OF ALBUQUERQUE PRINCIPAL ENGINEER, UTILITY DEVELOPMENT P.O. BOX 1293 ALBUQUERQUE, NM 87103
ROMANOWSKI, JEFF	OFFICE PHONE: (505) 241-7703 OFFICE FAX: (505) 241-7753 jromano@pnm.com	PNM - GAS CO. OF NM PROJECT ENGINEER 4625 EDITH BLVD. NE ALBUQUERQUE, NM 87107	HARRISON, ROYAL	OFFICE PHONE: (505) 938-7339 OFFICE FAX: (505) 938-7380 Royal.Harrison@twtelecom.com	TIME WARNER TELECOM PLANT MANAGER 3830 SINGER BLVD. NE SUITE 1000 ALBUQUERQUE, NM 87109
BOUCHARD, MARK	OFFICE PHONE: (505) 241-3402 OFFICE FAX: (505) 241-0559 mbouchard@pnm.com	PNM - ELECTRIC ENGINEERING REPRESENTATIVE 4201 EDITH BLVD. NE/ MS-ES61 ALBUQUERQUE, NM 87107	KETTERER, JEFF	OFFICE PHONE: (317) 633-5562 OFFICE FAX: (317) 633-4824 Jeffery.ketterer@genuity.com	GENUITY SUPERVISOR-OSP MAINTENANCE 175 NORTH COLLEGE AVE. INDIANAPOLIS, IN 46202
BENJAMIN, STEVE	OFFICE PHONE: (505) 998-2220 OFFICE FAX: (505) 998-2200 Steve.Benjamin@espire.net	XSPEDIUS MANAGEMENT CO. OPERATIONS SUPPORT MANAGER 505 MARQUETTE NW SUITE 1605 ALBUQUERQUE, NM 87102	SALGADO, MONICO	OFFICE PHONE: (505) 328-0848 OFFICE FAX: (505) 217-0070 Jhcookco_jn@att.net	CITYNET TELECOMMUNICATIONS CONSULTANT 505 MARQUETTE AVE. NW SUITE 119-A ALBUQUERQUE, NM 87102
GAY, BOB	OFFICE PHONE: (505) 898-2661 OFFICE FAX: (505) 898-6379 bobgaynmui@yahoo.com	NEW MEXICO UTILITIES OPERATIONS SUPERINTENDENT 4700 IRVING BLVD. NW, SUITE 201 ALBUQUERQUE, NM 87114			

MAP INDEX K

MAP INDEX L

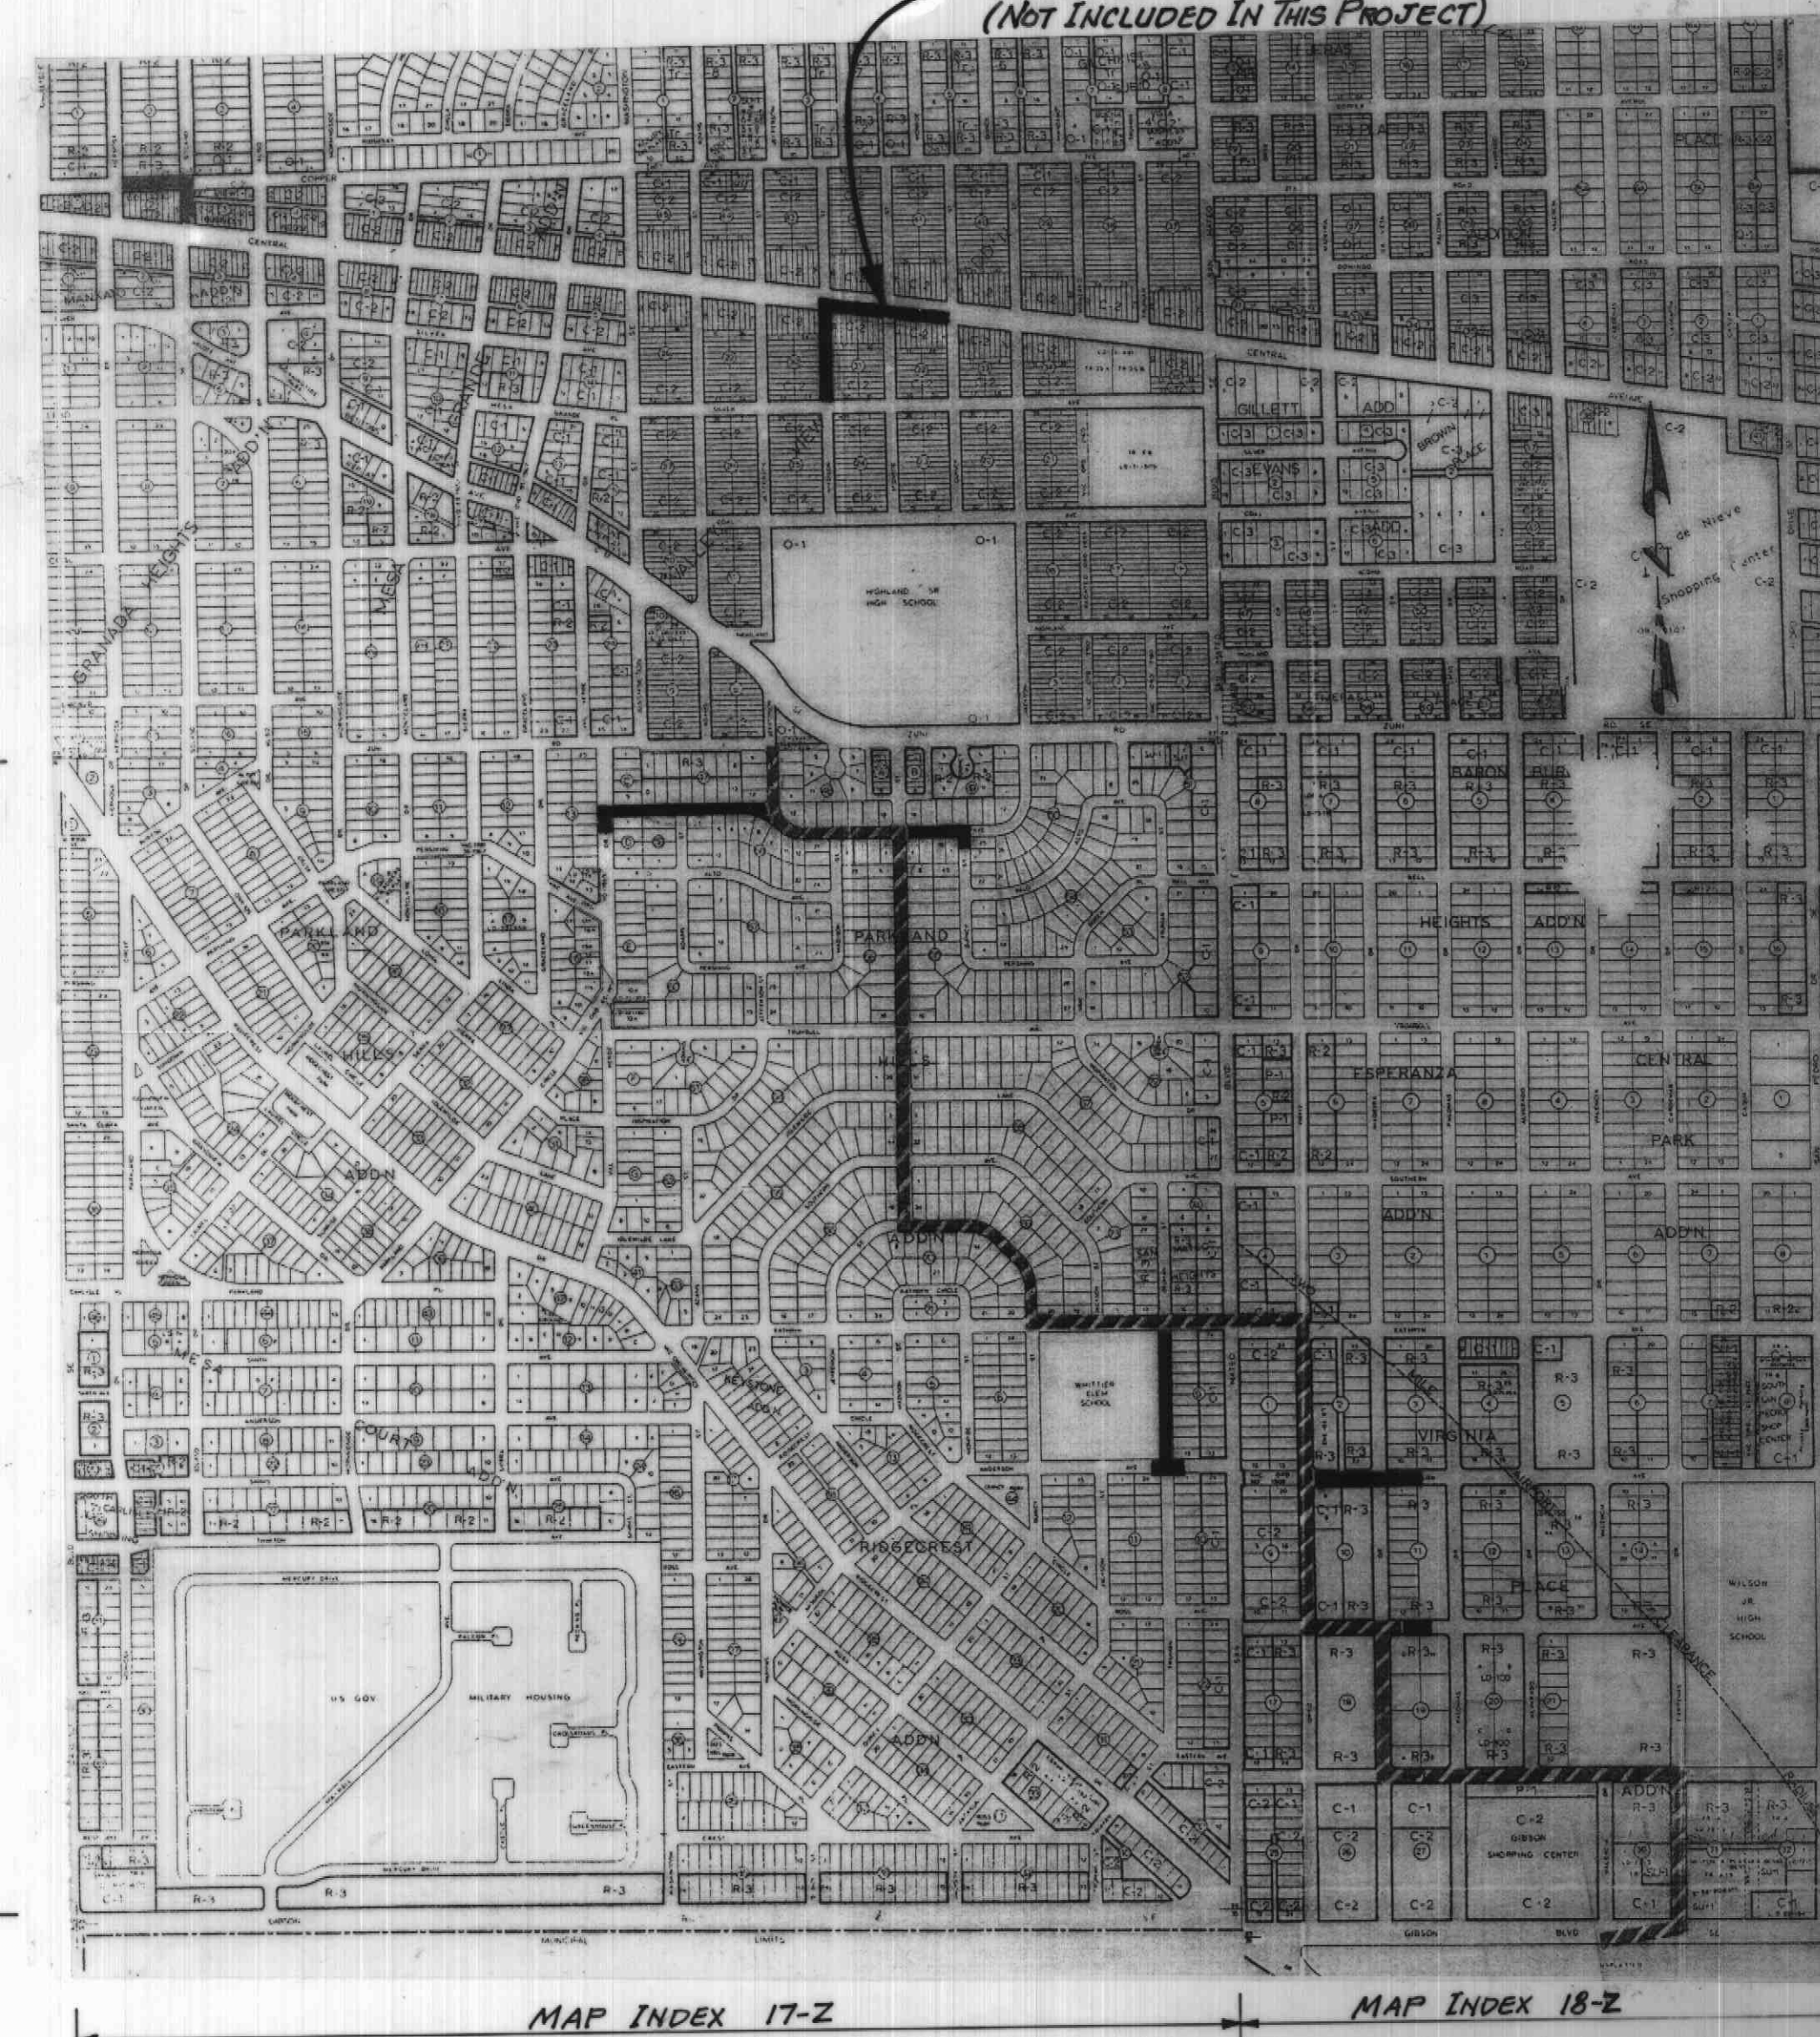

VICINITY MAP
SCALE: 1"=800'

INDICATES PHASE III B
INDICATES PHASE II

APPROVAL OF RECORD DRAWINGS
CHIEF CONSTRUCTION ENGINEER
E. Baurer
DATE 7/11/05

Project Manager

ASCG
INCORPORATED

ENGINEERS • ARCHITECTS • SURVEYORS • PLANNERS

6501 AMERICAS PARKWAY NE, SUITE 400
ALBUQUERQUE, NEW MEXICO 87110-5372
PHONE 505.247.0294 • FAX 505.242.4845

RECORD DRAWING

Date: Feb. 10, 2005
These drawings have been revised based on field data and every reasonable attempt has been made to depict construction as actually performed.

APPROVALS	ENGINEER	DATE
DRC Chairman	<i>[Signature]</i>	11-25-03
Transportation	<i>[Signature]</i>	11/17/03
Water/Wastewater	<i>[Signature]</i>	11/13/03
Hydrology	<i>[Signature]</i>	11/13/03
Parks & Recreation		



TITLE SHEET, INDEX
OF DRAWINGS
AND VICINITY MAP
LEEDSHILL-HERKENHOFF, INC.
Copper Square, 500 Copper Ave. N.W.
P.O. Box 1217
Albuquerque, New Mexico 87103
(505) 247-0294

APPROVED FOR
CONSTRUCTION

[Signature] 11/25/03
C.E.

PROJECT NO. **MDD PROJECT
720391**

SHEET OF
1 21

ASCG PROJECT NO. 215815
LH PROJECT NO. 1871.41

(SEE PLANS FOR ITEMS WITHIN THIS PROJECT)

LEGEND

PROPOSED	EXISTING	DESCRIPTION	PROPOSED	EXISTING	DESCRIPTION
		SANITARY SEWER MANHOLE			STORM DRAIN MANHOLE
		WATER MANHOLE			TELEPHONE MANHOLE
		SANITARY SEWER LINE WITH SIZE AND TYPE			STORM DRAIN LINE WITH SIZE AND TYPE
		WATER LINE WITH SIZE AND TYPE			OVERHEAD ELECTRICAL LINE
		UNDERGROUND ELECTRICAL/TRAFFIC CONTROL			UNDERGROUND TELEPHONE
		GAS LINE WITH SIZE AND TYPE			CABLE TELEVISION LINE
		ENCASEMENT			CATCH BASIN
		GATE VALVE			BUTTERFLY VALVE
		FIRE HYDRANT			REDUCER
		SANITARY SEWER SERVICE CONNECTION			WATER SERVICE CONNECTION
		TEE			CROSS
		BEND			CAP AND PLUG
		WATER METER			DOUBLE WATER METER
		VALVE BOX			POWER POLE
		LIGHT POLE			TRAFFIC LIGHT
		TRAFFIC CONTROL BOX			PULL BOX
		TELEPHONE BOOTH			

ABBREVIATIONS

AB	ANCHOR BOLT	DWG	DRAWING	MH	MANHOLE	SD	STORM DRAIN
AC	ASPHALTIC CONCRETE	E	EAST	MIN	MINIMUM	SF	SQUARE FEET
AHD	AHEAD	EA	EACH	MISC	MISCELLANEOUS	SIM	SIMILAR
APPROX	APPROXIMATELY	EF	EACH FACE	MO	MASONRY OPENING	SM	SUCTION MANIFOLD
BK	BACK	EG	EXISTING GRADE	MOV	MOTOR OPERATED VALVE	SQ	SQUARE
BLDG	BUILDING	EJ	EXPANSION JOINT	N	NORTH	STA	STATION
BLK	BLOCK	EL	ELEVATION	NIC	NOT IN CONTRACT	STD DWG	STANDARD DRAWING
BM	BEAM/BENCH MARK	ELEC	ELECTRICAL	NO	NUMBER	SY	SQUARE YARDS
BOP	BOTTOM OF PIPE	EP	EDGE OF PAVEMENT	NTS	NOT TO SCALE	SYM	SYMMETRICAL
BOT	BOTTOM	EW	ELECTRIC WATER COOLER	OD	OUTSIDE DIAMETER	TA	TOP OF ASPHALT
BRG	BEARING	EXIST	EXISTING	OPP	OPPOSITE	TAN	TANGENT
CAV	CABLE TELEVISION	FD	FLOOR DRAIN	PC	POINT OF CURVE	TC	TOP OF CONCRETE
CB	STORM CATCH BASIN/INLET	F-F	FACE-TO-FACE	PED	PEDESTAL	TG	TOP OF GRAVEL
CCY	CONCRETE CINDER PIPE	FF	FINISH FLOOR	PI	POINT OF INTERSECTION	THC	TOP OF HEADER CURB
CFM	CUBIC FEET PER MINUTE	FG	FINISH GRADE	PL/B	PLATE	THK	THICK/THICKNESS
CFS	CUBIC FEET PER SECOND	FL	FLOW LINE ELEVATION/FLANGE	POL	POINT ON LINE	TOT	TOP OF TIE
CI	CAST IRON	FOC	FACE OF CURB	ROW	RIGHT OF WAY	T.O.P.	TOP OF PIPE
CJ	CONSTRUCTION JOINT	FPS	FEET PER SECOND	PRC	POINT REVERSE CURVE	TOS	TOP OF STEEL
CL or CL	CENTERLINE	FT	FOOT/FEET	PRV	PRESSURE REDUCING VALVE	TOW	TOP OF WALL
CL CONST	CENTERLINE OF CONSTRUCTION	GA	GAGE	PSF	POUNDS PER SQUARE FOOT	TP	TOP OF PAVEMENT
CLC	CEILING	GPM	GALLONS PER MINUTE	PSI	POUNDS PER SQUARE INCH	TP	TYPICAL
CLR	CLEAR	HB	HOSE BIB	PT	POINT OF TANGENT	T&B	TOP AND BOTTOM
CMU	CONCRETE MASONRY UNIT	HC	HOLLOW CORE	PVC	POLY VINYL CHLORIDE	TW	TOP OF WALL
CO	CLEANOUT	HGL	HYDRAULIC GRADE LINE	Q	QUANTITY	UE	UNDERGROUND ELECTRICAL
COA	CITY OF ALBUQUERQUE	HORIZ	HORIZONTAL	QTY	QUANTITY	V	VELOCITY
COL	COLUMN	HP	HIGH PRESSURE	R	RADIUS	VERT	VERTICAL
CONC	CONCRETE	IN	INCH	RCP	REINFORCED CONCRETE PIPE	VRT	VENT THROUGH ROOF
CONST	CONSTRUCTION	INV	INVERT	ROD	RESERVOIR OVERFLOW DRAIN	W	WEST
CP	CONTROL POINT	LB	POUND	ROD	ROOF DRAIN	WC	WELL COLLECTOR
CY	CUBIC YARDS	LLH	LONG LEG HORIZONTAL	RT	RIGHT	WL	WATER LINE
DET	DETAIL	LLV	LONG LEG VERTICAL	S	SOUTH		
DI	DUCTILE IRON	LT	LIGHT/LEFT	SAS	SANITARY SEWER		
DIA	DIAMETER	MAX	MAXIMUM				
DM	DISCHARGE MANIFOLD	MFR	MANUFACTURER				
DN	DOWN						

GENERAL NOTES


- ALL WORK DETAILED ON THESE PLANS TO BE PERFORMED UNDER THIS CONTRACT SHALL, EXCEPT AS OTHERWISE STATED OR PROVIDED FOR HEREON, BE CONSTRUCTED IN ACCORDANCE WITH THE CITY OF ALBUQUERQUE STANDARD SPECIFICATIONS FOR PUBLIC WORKS CONSTRUCTION - 1986 EDITION (REFERRED TO HEREAFTER AS THE STANDARD SPECIFICATIONS AS UPDATED THROUGH UPDATE NO. 7) AND THE PROJECT SPECIFICATIONS TITLED "HIGHLAND DETENTION BASIN SYSTEM - PHASE III B".
- SEVEN (7) WORKING DAYS PRIOR TO ANY EXCAVATION, CONTACT NEW MEXICO ONE-CALL SYSTEM, PH. 260-1990, FOR LOCATION OF EXISTING UTILITIES.
- PRIOR TO CONSTRUCTION, EXCAVATE AND VERIFY THE HORIZONTAL AND VERTICAL LOCATIONS OF ALL OBSTRUCTIONS. SHOULD A CONFLICT EXIST, NOTIFY THE ENGINEER SO THAT THE CONFLICT CAN BE RESOLVED WITH A MINIMUM AMOUNT OF DELAY.
- COORDINATE CONSTRUCTION ACTIVITIES WITH OTHER CONTRACTORS AND UTILITY COMPANIES WORKING IN THE SAME AREA.
- ALL PERMANENT R.O.W. AND CONSTRUCTION EASEMENTS ON PRIVATE PROPERTY WILL BE OBTAINED BY THE CITY OF ALBUQUERQUE PRIOR TO THE BEGINNING OF CONSTRUCTION. AS APPLICABLE.
- WHEN ABUTTING NEW PAVEMENT TO EXISTING, SAWCUT EXISTING PAVEMENT TO A STRAIGHT LINE, AS REQUIRED, TO REMOVE ANY BROKEN OR CRACKED PAVEMENT AND MATCH NEW TO EXISTING.
- EXERCISE DUE CARE TO AVOID DISTURBING EXISTING UNDERGROUND UTILITIES. COORDINATE WITH THE UTILITY COMPANIES IN ORDER TO PREVENT ANY SERVICE DISRUPTION.
- SEVEN (7) WORKING DAYS PRIOR TO CONSTRUCTION IN PAVED AREAS, OBTAIN A BARRICADING PERMIT FROM THE CONSTRUCTION COORDINATION DIVISION. NOTIFY BARRICADE ENGINEER (924-3400) PRIOR TO OCCUPYING STREET.
- REPLACE ALL STREET STRIPING ALTERED OR DESTROYED WITH PLASTIC REFLECTORIZED PAVEMENT MARKINGS TO EXISTING LOCATION OR AS INDICATED BY THIS PLAN SET.
- NOTIFY THE ENGINEER NOT LESS THAN SEVEN (7) CALENDAR DAYS PRIOR TO STARTING WORK SO THAT THE ENGINEER MAY TAKE NECESSARY MEASUREMENTS TO INSURE PRESERVATION OF SURVEY MONUMENTS. DO NOT DISTURB PERMANENT SURVEY MONUMENTS WITHOUT THE CONSENT OF THE ENGINEER. NOTIFY THE ENGINEER AND BEAR THE EXPENSE OF REPLACING ANY SURVEY MONUMENTS THAT MAY BE DISTURBED WITHOUT PERMISSION. REPLACEMENT WILL BE DONE ONLY BY THE CITY SURVEYOR. WHEN A CHANGE IS MADE IN THE FINISHED ELEVATIONS OF THE PAVEMENT OF ANY ROADWAY IN WHICH A PERMANENT SURVEY MONUMENT IS LOCATED, ADJUST, AT THE CONTRACTOR'S EXPENSE, THE MONUMENT COVER TO THE NEW GRADE UNLESS OTHERWISE SPECIFIED. REFER TO SECTION 4.4 OF THE GENERAL CONDITIONS OF THE STANDARD SPECIFICATIONS.
- PLACE EXCAVATED MATERIALS AS APPROVED BY THE ENGINEER OR PROJECT ADMINISTRATOR.
- THE REMOVAL AND REPLACEMENT OF PRIVATE SIGNS AND OBSTRUCTIONS SHALL BE PERFORMED BY THE RESPECTIVE PROPERTY OWNERS UNLESS OTHERWISE NOTED. COORDINATION SHALL BE THE RESPONSIBILITY OF THE ENGINEER.
- WHERE TRENCHING EXPOSES EXISTING UTILITY LINES, THE CONTRACTOR IS RESPONSIBLE FOR SUPPORTING THE LINE DURING CONSTRUCTION AND ASSURE THAT IT IS BACKFILLED AND COMPACTED IN ACCORDANCE WITH THE STANDARD SPECIFICATIONS.
- BACKFILL AND COMPACT IN ACCORDANCE WITH THE STANDARD SPECIFICATIONS AND SUPPLEMENTAL TECHNICAL SPECIFICATIONS.
- ANY AREA NOT PAVED OR LANDSCAPED WHICH IS DISTURBED DURING CONSTRUCTION SHALL BE SEEDED WITH NATIVE GRASS PER CITY OF ABQ "SANDY SOILS" SPECIFICATION. THE COST OF SEEDING SHALL BE CONSIDERED INCIDENTAL TO THE WORK.
- ALL EXISTING REGULATORY SIGNS THAT NEED TO BE REMOVED, RELOCATED OR REINSTALLED WILL BE PERFORMED BY THE CITY OF ALBUQUERQUE PUBLIC WORKS DEPARTMENT CONSTRUCTION COORDINATOR. NOTIFY THE CITY CONSTRUCTION COORDINATOR THREE (3) WORKING DAYS IN ADVANCE OF ANY REQUIRED WORK.
- REPLACE ALL TRAFFIC SIGNS REMOVED IN KIND TO ORIGINAL LOCATIONS OR AS INDICATED BY THIS PLAN SET. THE CONTRACTOR SHALL NOTIFY THE CITY CONSTRUCTION COORDINATOR THREE (3) WORKING DAYS IN ADVANCE OF ANY REQUIRED WORK.
- COORDINATE WITH CITY OF ALBUQUERQUE SEVEN (7) WORKING DAYS PRIOR TO ANY WORK NEEDING THE EXECUTION OF THE WATER VALVE SHUT-OFF AND TO OBTAIN A WATER SHUT-OFF PERMIT.
- CONTRACTOR IS RESPONSIBLE FOR ANY DAMAGE TO EXISTING FACILITIES, PAVEMENTS, PAVEMENT MARKINGS, CURB AND GUTTER, DRIVEPADS, WHEELCHAIR RAMPS, SIDEWALK, GATES FENCING, ANY OTHER IMPROVEMENTS DURING CONSTRUCTION EXCEPT FROM THOSE SECTIONS INDICATED FOR REMOVAL ON THE PLANS. REPAIR OR REPLACE DAMAGED IMPROVEMENTS PER COA STANDARDS AT CONTRACTOR'S EXPENSE.
- MAINTAIN A GRAFFITI-FREE WORK SITE. PROMPTLY REMOVE ANY AND ALL GRAFFITI FROM EQUIPMENT, WHETHER PERMANENT OR TEMPORARY.
- PERFORM ALL EXCAVATION, TRENCHING AND SHORING ACTIVITIES IN ACCORDANCE WITH OSHA 29CFR1926.650 SUBPART P, OR CURRENT OSHA STANDARD.
- PRIOR TO THE REMOVAL OF ANY PAVEMENT, CURB AND GUTTER, AND OTHER IMPROVEMENTS, SURVEY TO ENSURE RESTORATION OF PROPER GRADES, CROWN AND ELEVATIONS. REMOVE AND REPLACE SHORT (LESS THAN 6') EXISTING SECTIONS OF PAVEMENT AND CURB AND GUTTER REMAINING AFTER PRIMARY REMOVALS ARE COMPLETED.
- MINOR ADJUSTMENTS TO HORIZONTAL AND VERTICAL LOCATIONS OF IMPROVEMENTS AND RELATED COMPONENTS IS CONSIDERED INCIDENTAL TO THE WORK.
- ALL REFERENCE TO CITY STANDARD DRAWINGS WILL BE PER CITY OF ALBUQUERQUE STANDARD SPECIFICATIONS FOR PUBLIC WORKS CONSTRUCTION 1986 AS REVISED THROUGH UPDATE NO. 7.
- PRESSURE MANHOLE COVERS AS SHOWN ON THE PLANS SHALL BE NEENAH R-1916-K OR APPROVED EQUAL (30" CLEAR OPENING) AND ARE CONSIDERED INCIDENTAL TO THE WORK.
- ALL MANHOLE COVERS, WATER VALVES, OR OTHER SERVICE ACCESS SHALL MATCH EXISTING GRADE OF PAVEMENT. ON UNPAVED SURFACES, THESE SHALL MATCH EXISTING GROUND SURFACES OR FINAL GRADES, WHICHEVER APPLIES.
- REFERENCES USED IN PREPARATION OF THESE PLANS INCLUDE THE ALBUQUERQUE MASTER DRAINAGE STUDY, BOHANNAN-HUSTON, INC., JANUARY 1981; HIGHLAND DETENTION BASIN STUDY - PRELIMINARY DESIGN ANALYSIS, INCLUDING CALCULATION APPENDIX, LEEDSHILL-HERKENHOFF, INC., MARCH 1984. THESE ARE ON FILE WITH THE CITY OF ALBUQUERQUE.
- THE HYDRAULIC GRADE LINE SHOWN ON THE PLANS DEPICTS THAT OF THE ULTIMATE SYSTEM.
- THE LIMITS OF CONSTRUCTION SHOWN ON THE PLANS IS AN APPROXIMATION TO SHOW AREAS OF ANTICIPATED PAVEMENT, CURB AND GUTTER AND/OR OTHER SURFACE REMOVAL. THE CONTRACTOR SHALL ENDEAVOR TO MINIMIZE THE ACTUAL CONSTRUCTION LIMITS BUT IN NO CASE SHALL SUCH LIMITS OF WORK RESTRICT THE CONTRACTORS WORK WHERE SAFETY WOULD BE IMPAIRED.
- ALL REFERENCE TO CURB AND GUTTER IS TO STANDARD CURB AND GUTTER UNLESS OTHERWISE NOTED.
- DRIVEPADS THAT ARE IN AN AREA OF RECONSTRUCTION THAT ARE BLOCKED OR NOT BEING USED SHALL BE RECONSTRUCTED AS STANDARD CURB AND GUTTER.
- REPLACE ALL REMOVED PAVING, CURB & GUTTER, DRIVEPADS, SIDEWALK, WATER METERS, WATER SERVICES, SEWER SERVICES AND OTHER CITY OWNED INFRASTRUCTURE IN KIND IN ACCORDANCE WITH THE STANDARD SPECIFICATIONS INCLUDING:
SIDEWALK WORK - COA STD. DWG. 2430, 2431, 2432
CURB & GUTTER WORK - COA STD. DWG. 2415A, 2415B
CURB ACCESS RAMPS (WHEELCHAIR) - COA STD. DWG. 2440 & 2441
DRIVEPADS & ALLEY INTERSECTIONS - COA STD. DWG. 2425, 2426, 2428
CATCH BASINS & STORM INLETS - COA STD. DWG. 2201, 2202, 2205, 2207, 2215, 2216, 2220, 2221
WATERLINES & APPURTENANCES - COA STD. DWG. 2460, 2301, 2315, 2320, 2326, 2328, 2333
WATER SERVICE & METER - COA STD. DWG. 2361, 2362, 2363, 2366, 2367, 2368, 2369
FIRE HYDRANT - COA STD. DWG. 2340, 2344, 2347
VALLEY GUTTERS - COA STD. DWG. 2420, 2421, 2422
MANHOLES - COA STD. DWG. 2101, 2102, 2107, 2110, 2111, 2116, 2460
SEWER SERVICE LINES - COA STD. DWG. 2118, 2125, 2134, 2135, 2136
PAVING - SEE GENERAL NOTES 33 AND 34.
- MAJOR LOCAL STREET (RESIDENTIAL) PAVEMENT REPLACEMENT: ALL PAVEMENT REPLACEMENT IS DESIGNATED MAJOR LOCAL STREET (RESIDENTIAL) PAVING EXCEPT CENTRAL AVENUE. ALL PAVEMENT CUTS SHALL BE EITHER PERPENDICULAR TO OR PARALLEL TO TRAFFIC FLOW (NO DIAGONAL CUTS). SUBGRADE MATERIAL SHALL HAVE AN R-VALUE OF 50 OR GREATER. IN THE EVENT SUBGRADE MATERIAL WITH R-VALUE LESS THAN 50 IS ENCOUNTERED, REMOVE AND REPLACE AS DIRECTED BY THE CITY PROJECT MANAGER. RESIDENTIAL PAVEMENT SECTION SHALL CONSIST OF 12" SUBGRADE PREP, 2" AC BASE COURSE, 2" AC SURFACE COURSE. REPLACE ALL REMOVED PAVEMENT IN ACCORDANCE WITH THE STANDARD SPECIFICATIONS AND AS FOLLOWS:
PAVEMENT CUT WIDER THAN 8' WIDE: MACHINE LAYDOWN REQUIRED - PAVEMENT SECTION SHALL CONSIST OF 12" SUBGRADE PREP, 2" AC BASE COURSE, 2" AC SURFACE COURSE - COA STD. DWG. 2400, 2405B, 2465.
PAVEMENT CUT LESS THAN 8' WIDE: PAVEMENT SECTION SHALL CONSIST OF 12" SUBGRADE PREP, 4" AC BASE COURSE, 2" AC SURFACE COURSE-COA STD. DWG. 2400, 2405B, 2465.
- ARTERIAL PAVEMENT REPLACEMENT IN CENTRAL AVENUE: ALL PAVEMENT CUTS SHALL BE EITHER PERPENDICULAR TO OR PARALLEL TO TRAFFIC FLOW (NO DIAGONAL CUTS). THE UPPER 24" OF SUBGRADE MATERIAL SHALL HAVE AN R-VALUE OF 50 OR GREATER. IN THE EVENT SUBGRADE MATERIAL WITH R-VALUE LESS THAN 50 IS ENCOUNTERED, REMOVE AND REPLACE AS DIRECTED BY THE CITY PROJECT MANAGER. REPLACE ALL REMOVED ARTERIAL PAVEMENT IN ACCORDANCE WITH THE STANDARD SPECIFICATIONS AND AS FOLLOWS:
PAVEMENT CUT WIDER THAN 8' WIDE: MACHINE LAYDOWN REQUIRED - MATCH EXISTING PAVEMENT SECTION PLUS 2" ADDITIONAL BASE COURSE AND 2" ADDITIONAL SURFACE COURSE - COA STD. DWG. 2400, 2465.
PAVEMENT CUT LESS THAN 8' WIDE: MATCH EXISTING PAVEMENT SECTION PLUS 2" ADDITIONAL SURFACE COURSE-COA STD. DWG. 2400, 2465.
- THE CONTRACTOR WILL ESTABLISH, MAINTAIN AND REMOVE AN AREA FOR CONTRACTOR'S YARD FOR STORAGE OF EQUIPMENT AND MATERIALS, FOR EQUIPMENT FUELING AND FOR CLEAN-OUT OF CONCRETE TRUCKS, ASPHALT TRUCKS ETC. PROVIDE A TEMPORARY CONTAINMENT BERM AROUND THE SITE. DO NOT ALLOW DISCHARGE OF STORM WATER RUNOFF FROM THE CONTRACTOR'S YARD. REMOVE AND PROPERLY DISPOSE OF ALL CONSTRUCTION DEBRIS FROM CONTRACTOR'S YARD PRIOR TO THE END OF THE PROJECT. THE COST OF THE CONTRACTOR'S YARD SHALL BE CONSIDERED INCIDENTAL TO THE WORK.
- CENTRAL AVENUE NOTES:
THE STORM DRAIN LINE IN CENTRAL AVENUE SHALL BE DONE IN FOUR PHASES (SEE SHEET 21 FOR DEFINITION OF THE PHASES). TWO WEEKS PRIOR TO THE START OF PHASE ONE, THE CONTRACTOR SHALL ORGANIZE AND HOLD A MEETING WITH ALL BUSINESSES IN THE AREA. AT THIS TIME, THE CONTRACTOR SHALL OUTLINE HOW ACCESS IS TO BE MAINTAINED TO THEIR BUSINESS DURING CONSTRUCTION. THIS MEETING SHALL BE COORDINATED THROUGH THE PROJECT ENGINEER AND TRAFFIC ENGINEERING.
- CONSTRUCTION SECTOR PLAN:
CONSTRUCTION ACTIVITIES ARE LIMITED TO RESTRICTED AREAS DESCRIBED AS THE CONSTRUCTION SECTOR PLAN IN THE SPECIAL PROVISIONS OF THE CONTRACT DOCUMENTS.
- UTILITY PLAN:
A UTILITY PLAN SHALL BE PREPARED AND IMPLEMENTED BY THE CONTRACTOR FOR THE CENTRAL AVENUE BYPASS CONSTRUCTION AND FOR VALVERDE DIVERSION CONSTRUCTION.
- FOR STORM DRAIN CONSTRUCTION, RCP PIPE JOINTS SHALL NOT BE GROUTED PRIOR TO FINAL INSPECTION. FINAL INSPECTION WILL DETERMINE JOINTS TO BE GROUTED FOR FINAL ACCEPTANCE OF THE CONSTRUCTION.
- WATER AND SEWER SERVICE REPLACEMENTS SHALL CONFORM TO UPDATE NO. 7 OF THE STANDARD SPECIFICATIONS. UTILIZE ONLY BALL VALVES AND COPPER TUBING FOR WATER SERVICE REPLACEMENTS.



CITY OF ALBUQUERQUE PUBLIC WORKS DEPARTMENT HYDROLOGY DIVISION			
TITLE: HIGHLAND DETENTION BASIN SYSTEM PHASE IIIB GENERAL NOTES, ABBREVIATIONS AND LEGEND			
Design/Review Committee	City Engineer Approval	Mo./Day/Yr.	Mo./Day/Yr.
City Project No.	Zone Map No.	Sheet	Of
720391	1-17	2	21

RECORD DRAWING

Date **FEB. 10, 2005**
These drawings have been revised based on field data and every reasonable attempt has been made to depict construction as actually performed.

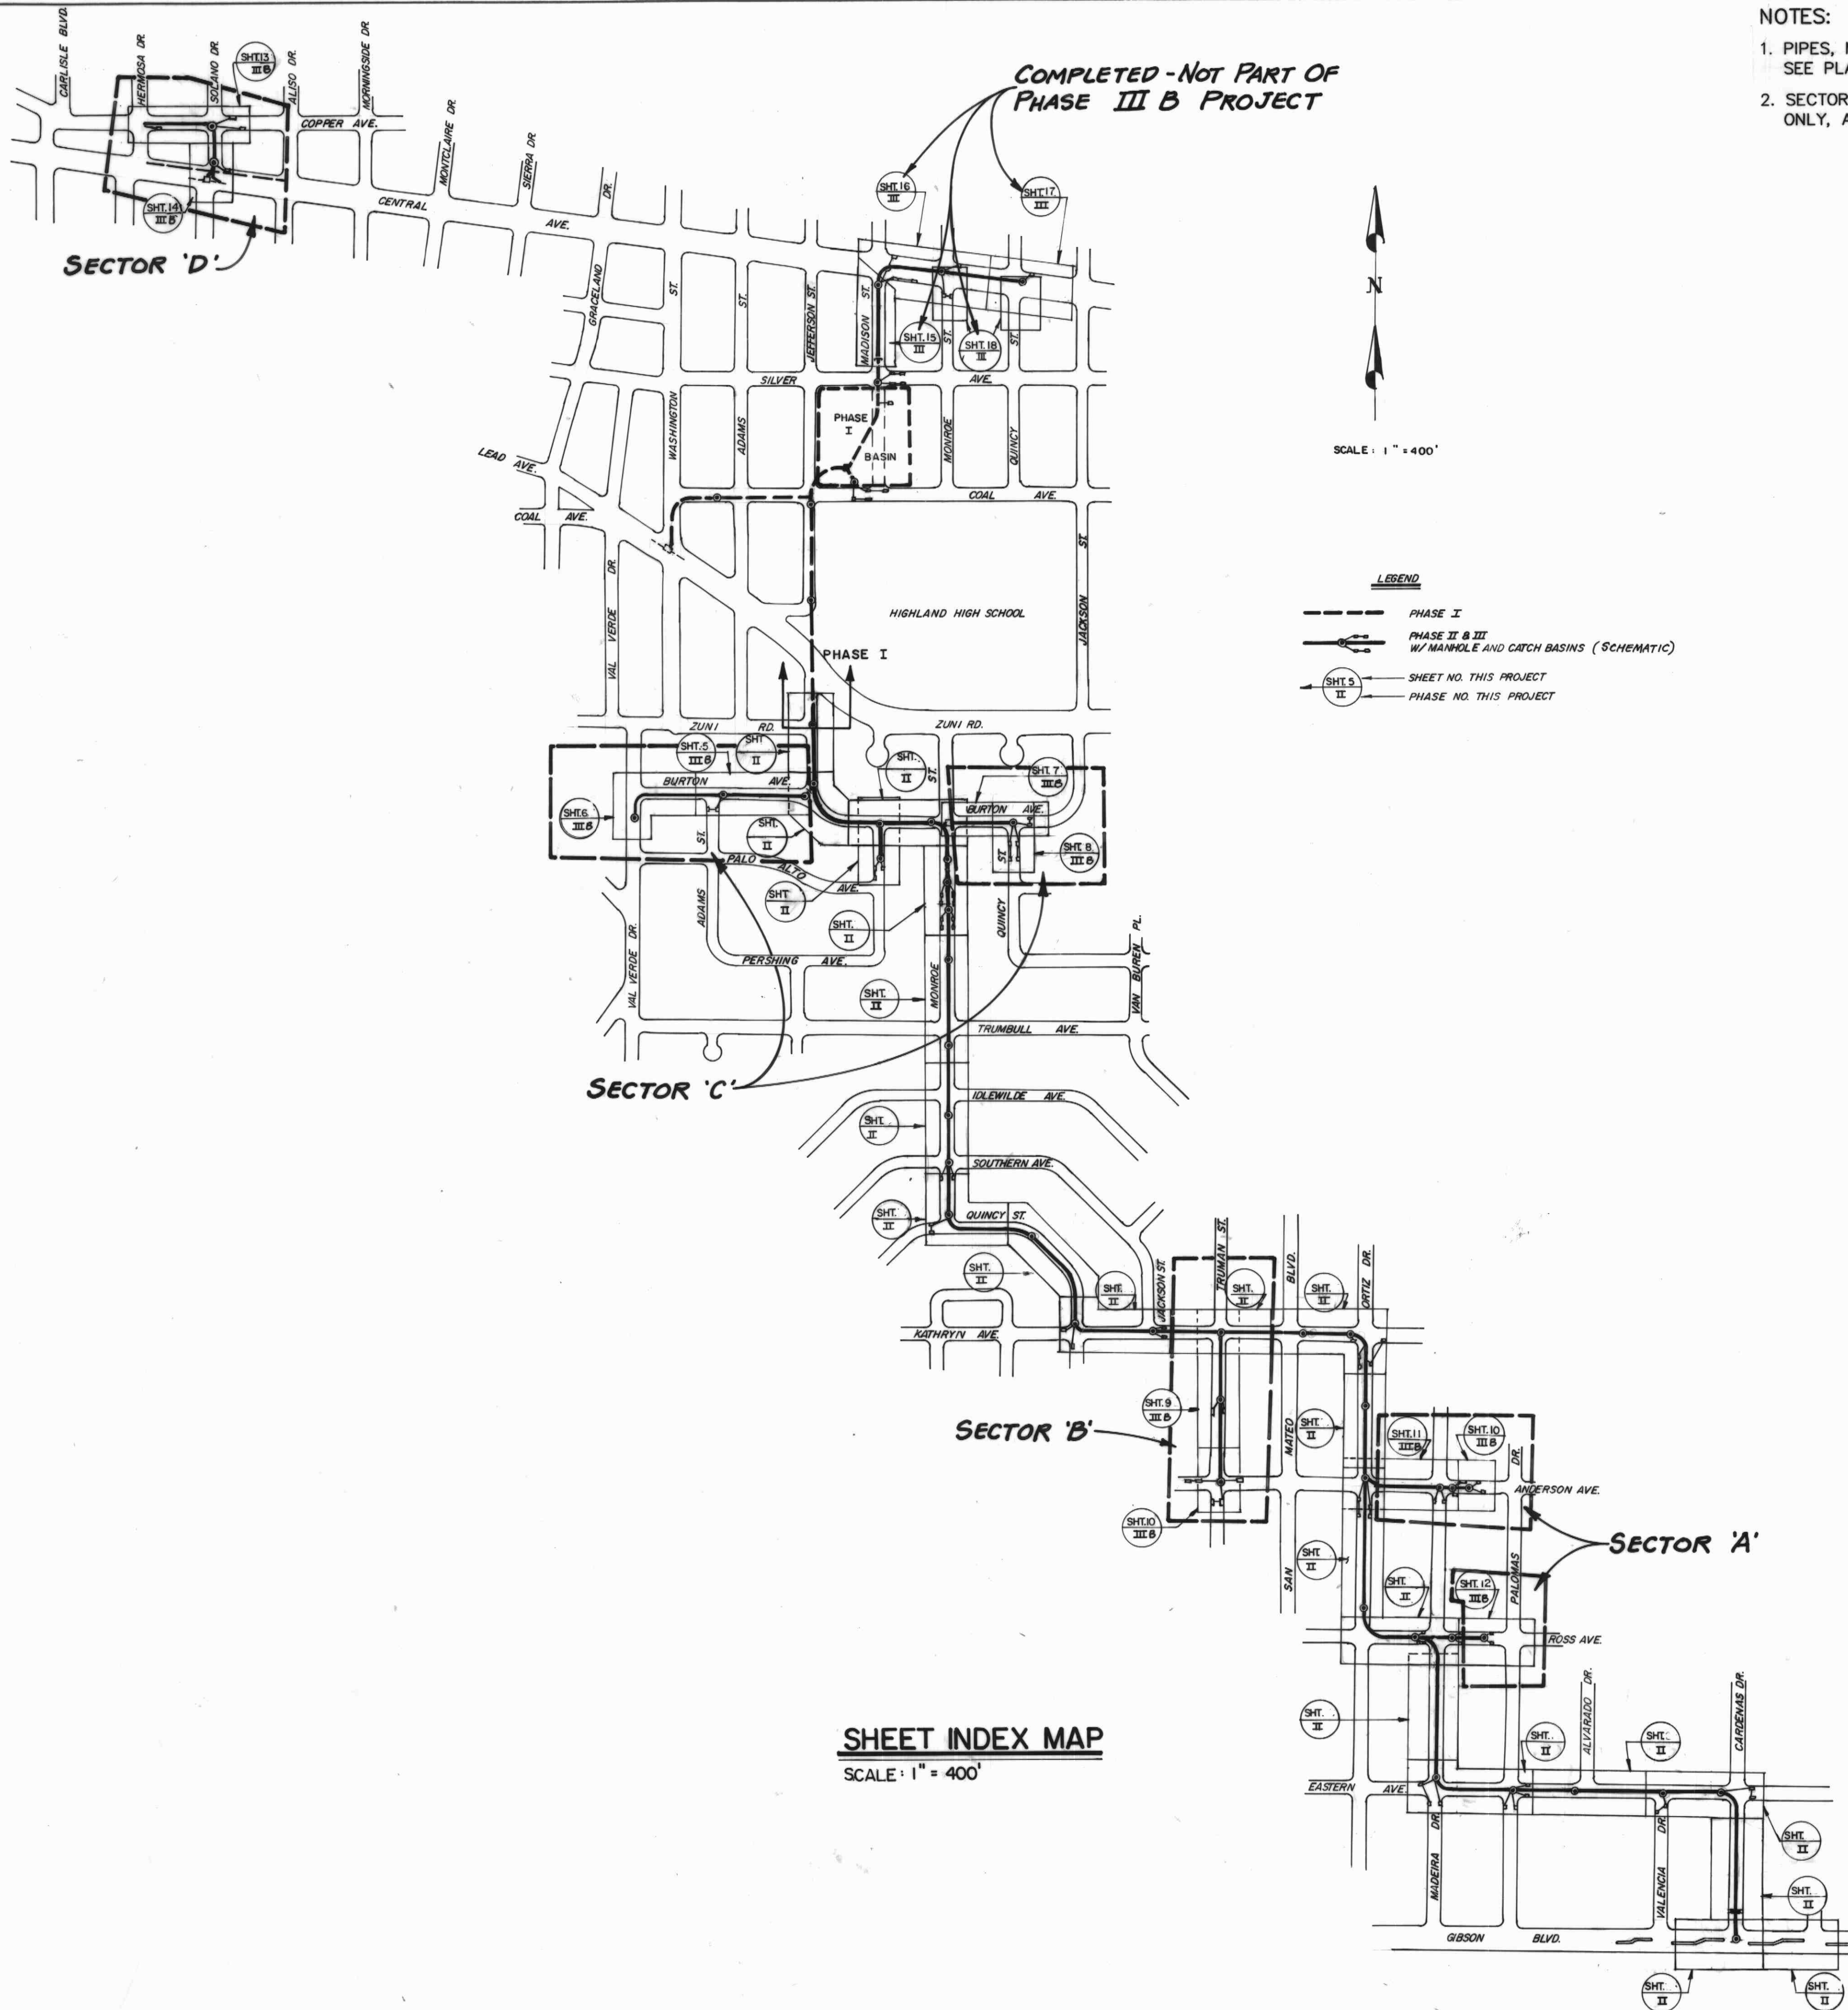

- NOTES:
1. PIPES, MANHOLES AND CATCH BASINS SHOWN ARE SCHEMATIC. SEE PLANS FOR EXACT LOCATIONS.
 2. SECTOR LOCATIONS ARE FOR GENERAL IDENTIFICATION PURPOSES ONLY, AND DO NOT DELINEATE LIMITS OF CONSTRUCTION.

LEGEND

--- PHASE I

— PHASE II & III

○ SHT. I

○ SHT. II

○ SHT. III

○ SHT. IV

W/ MANHOLE AND CATCH BASINS (SCHEMATIC)

SHEET NO. THIS PROJECT

PHASE NO. THIS PROJECT

SHEET INDEX MAP

SCALE: 1" = 400'

RECORD DRAWING

Date **FEB. 10, 2005**
These drawings have been revised based on field data and every reasonable attempt has been made to depict construction as actually performed.

AS BUILT INFORMATION			BENCH MARKS			SURVEY INFORMATION			ENGINEER'S SEAL		
CONTRACTOR	DATE	BY	NO.	BY	DATE	NO.	DATE	REMARKS	NO.	DATE	REVISIONS
CONTRACTOR: J.R. Hale	DATE: 12/03	BY: J.R. Hale	NO.	BY	DATE	NO.	DATE	REMARKS	NO.	DATE	REVISIONS
STATED BY: J.R. Hale	DATE: 12/03	BY: J.R. Hale	NO.	BY	DATE	NO.	DATE	REMARKS	NO.	DATE	REVISIONS
ACCEPTANCE BY: J.R. Hale	DATE: 12/03	BY: J.R. Hale	NO.	BY	DATE	NO.	DATE	REMARKS	NO.	DATE	REVISIONS
VERIFICATION BY: J.R. Hale	DATE: 12/03	BY: J.R. Hale	NO.	BY	DATE	NO.	DATE	REMARKS	NO.	DATE	REVISIONS
CORRECTED BY: J.R. Hale	DATE: 12/03	BY: J.R. Hale	NO.	BY	DATE	NO.	DATE	REMARKS	NO.	DATE	REVISIONS
MICRO-FILM INFORMATION	DATE	BY	NO.	BY	DATE	NO.	DATE	REMARKS	NO.	DATE	REVISIONS
RECORDED BY: J.R. Hale	DATE	BY: J.R. Hale	NO.	BY	DATE	NO.	DATE	REMARKS	NO.	DATE	REVISIONS
DATE	DATE	DATE	DATE	DATE	DATE	DATE	DATE	DATE	DATE	DATE	DATE

ASCg
INCORPORATED

CITY OF ALBUQUERQUE
MUNICIPAL DEVELOPMENT DEPARTMENT
ENGINEERING DIVISION


TITLE: HIGHLAND DETENTION BASIN SYSTEM - PHASE III B

SHEET INDEX MAP

APPROVALS	ENGINEER	DATE	APPROVALS	ENGINEER	DATE
City Engineer			Liquid Waste		
A.C.E. - Design			Traffic		
A.C.E. - Hydrology			Water		

DESIGNED BY: JAE CD, 9/03
DATE: Dec. 1994
DRAWN BY: KDW
DATE: Dec. 1994
CHECKED BY: CD
DATE: Dec. 1994


DRAWING NO. **720391** MAP NO. **L-17** SHEET **3** OF **21**

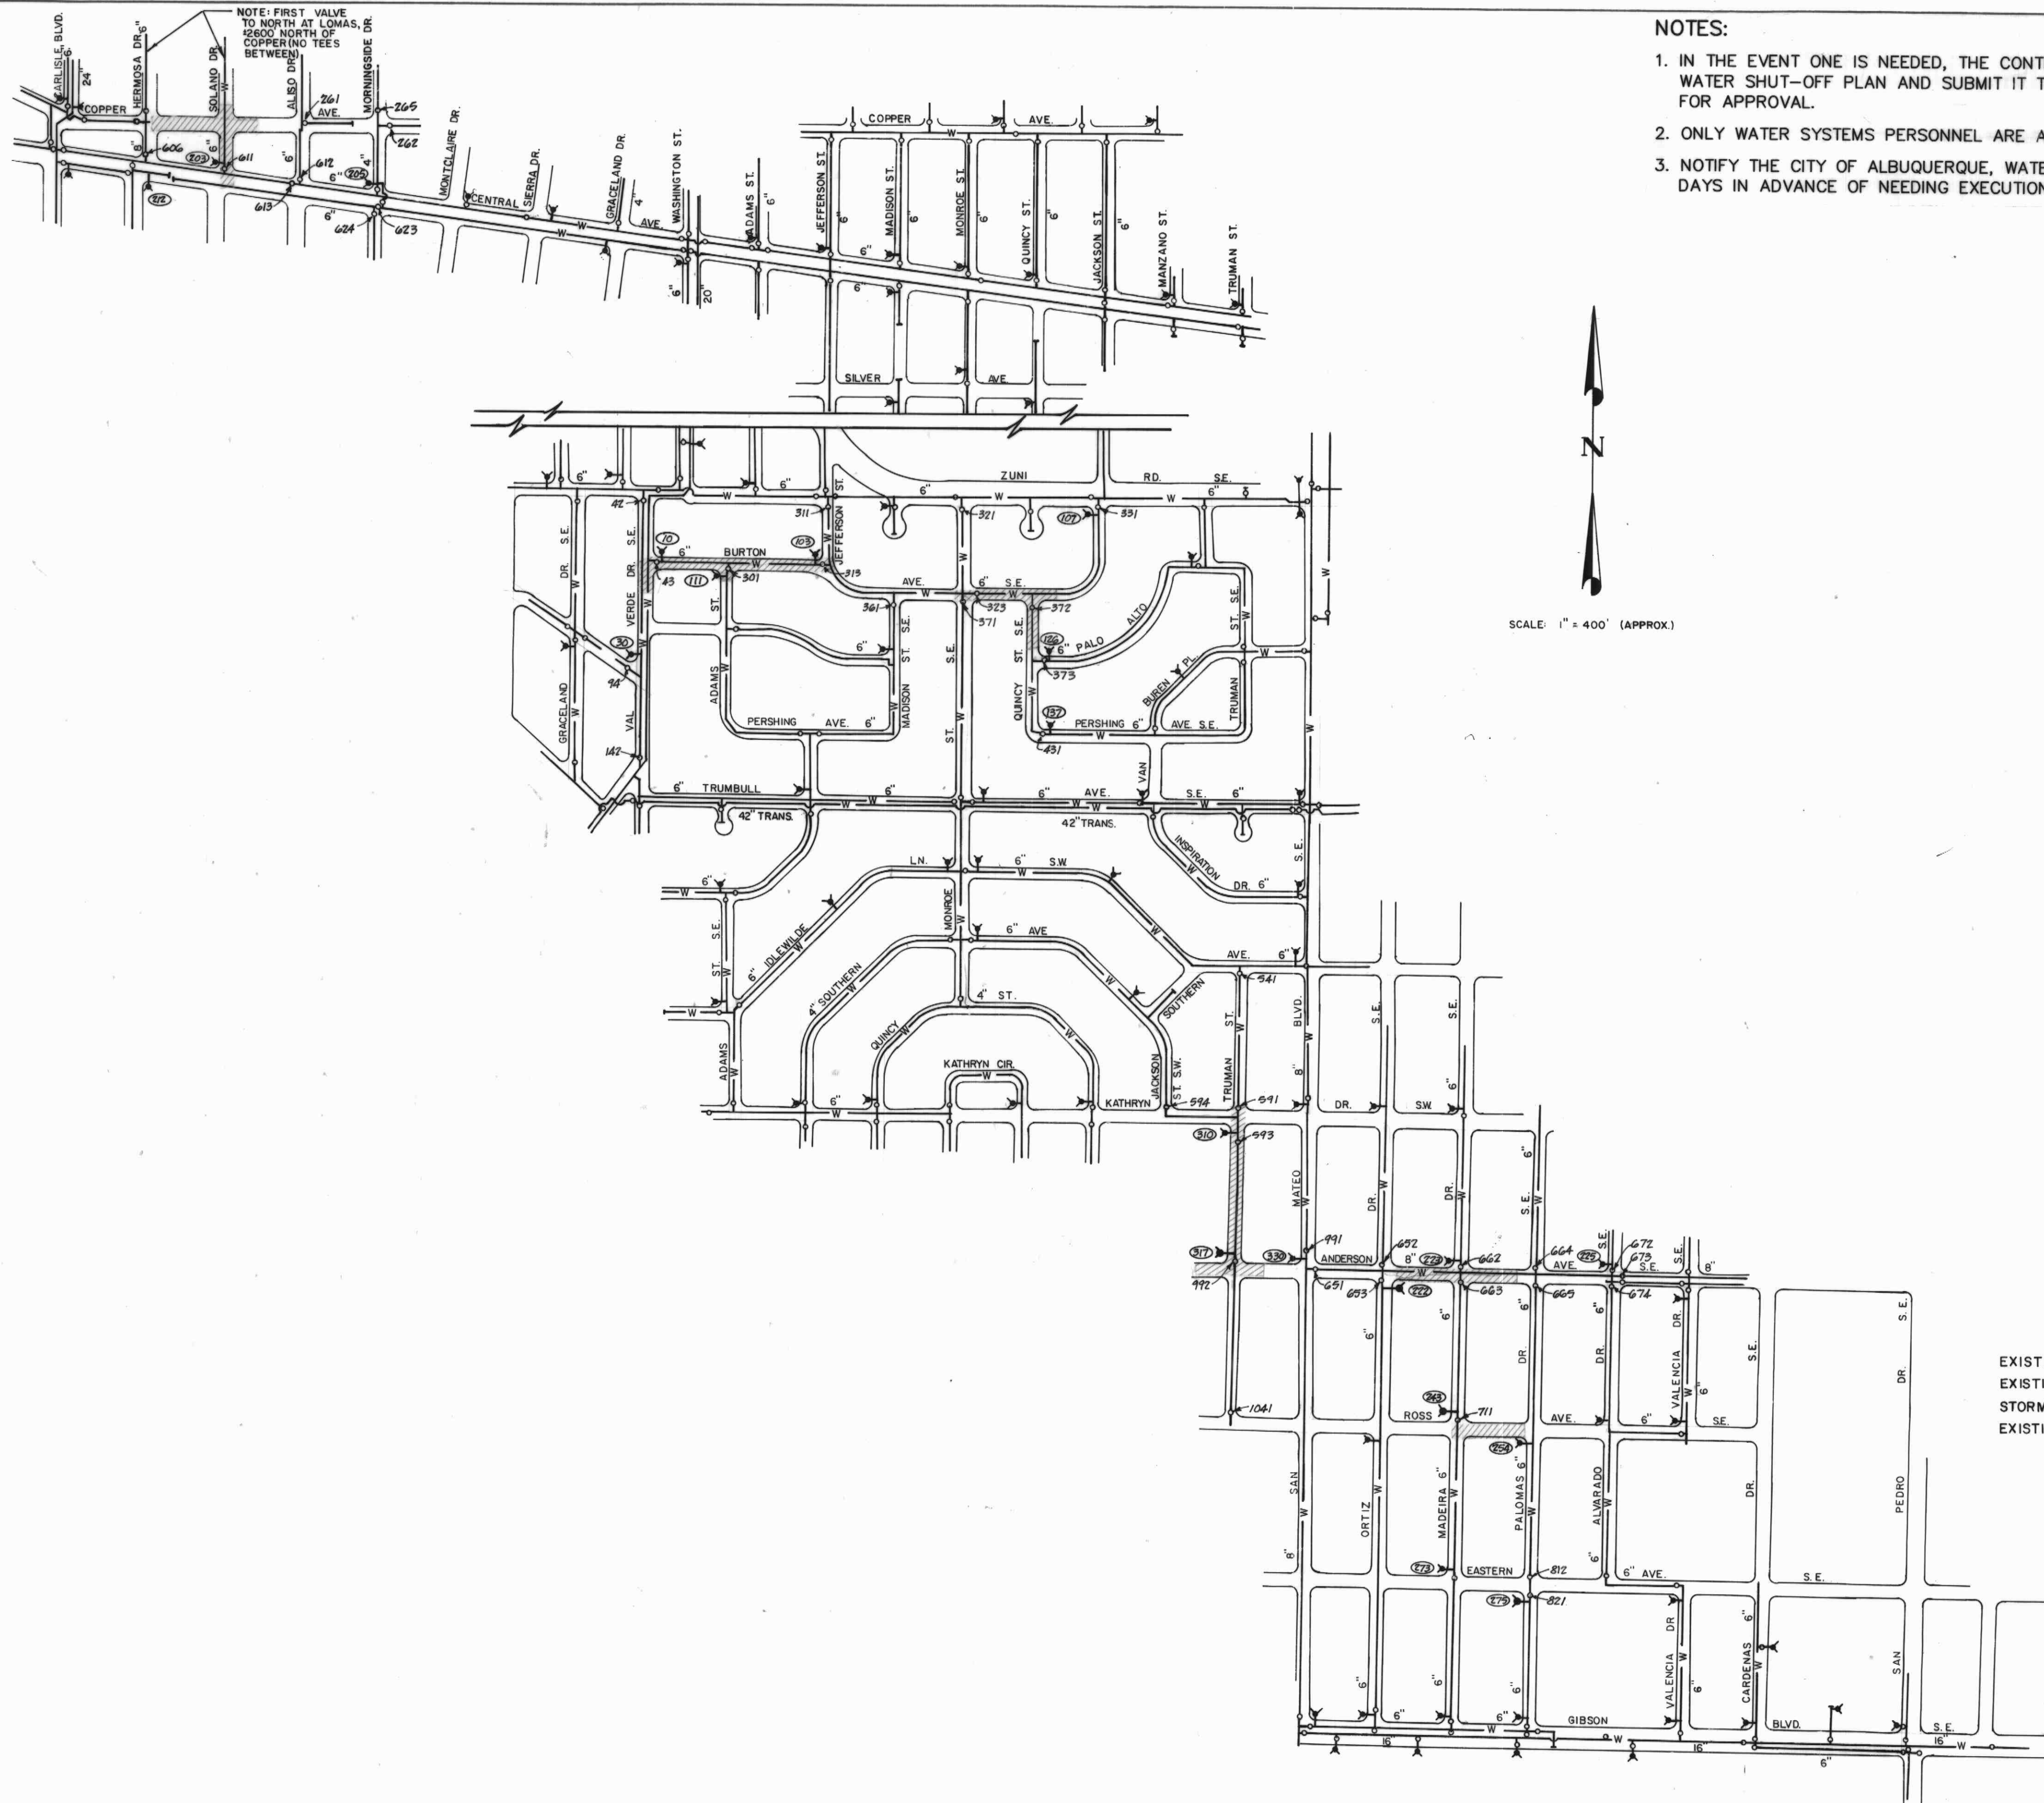

- NOTES:
1. IN THE EVENT ONE IS NEEDED, THE CONTRACTOR SHALL DEVELOP A WATER SHUT-OFF PLAN AND SUBMIT IT TO THE CITY OF ALBUQUERQUE FOR APPROVAL.
 2. ONLY WATER SYSTEMS PERSONNEL ARE AUTHORIZED TO OPERATE VALVES.
 3. NOTIFY THE CITY OF ALBUQUERQUE, WATER SYSTEMS SEVEN (7) WORKING DAYS IN ADVANCE OF NEEDING EXECUTION OF THE WATER SHUT-OFF PLAN.

LEGEND

- EXISTING WATER LINES.
- EXISTING WATER VALVES.
- STORM DRAIN THIS PROJECT
- EXISTING FIRE HYDRANTS

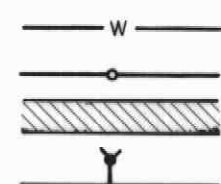

RECORD DRAWING
Date FEB. 10, 2005
These drawings have been revised based on field data and every reasonable attempt has been made to depict construction as actually performed.

ASCG
INCORPORATED

CITY OF ALBUQUERQUE
MUNICIPAL DEVELOPMENT DEPARTMENT
ENGINEERING DIVISION



TITLE: HIGHLAND DETENTION BASIN SYSTEM - PHASE II B
WATER VALVE LOCATION PLAN



APPROVALS	ENGINEER	DATE	APPROVALS	ENGINEER	DATE
City Engineer			Liquid Waste		
A.C.E.-Design			Traffic		
A.C.E.-Hydrology			Water		

DRAWING NO.	720391	MAP NO.	K-17	SHEET	4	OF	21
-------------	--------	---------	------	-------	---	----	----

ENGINEER'S SEAL			SURVEY INFORMATION		BENCH MARKS		AS BUILT INFORMATION	
			FIELD NOTES					
			NO.	BY	DATE		CONTRACTOR	DATE
							INSPECTOR'S	DATE
							FIELD	DATE
							VERIFICATION BY	DATE
							CORRECTED BY	DATE
							MICRO-FILM INFORMATION	
							RECORDED BY	DATE
							NO.	



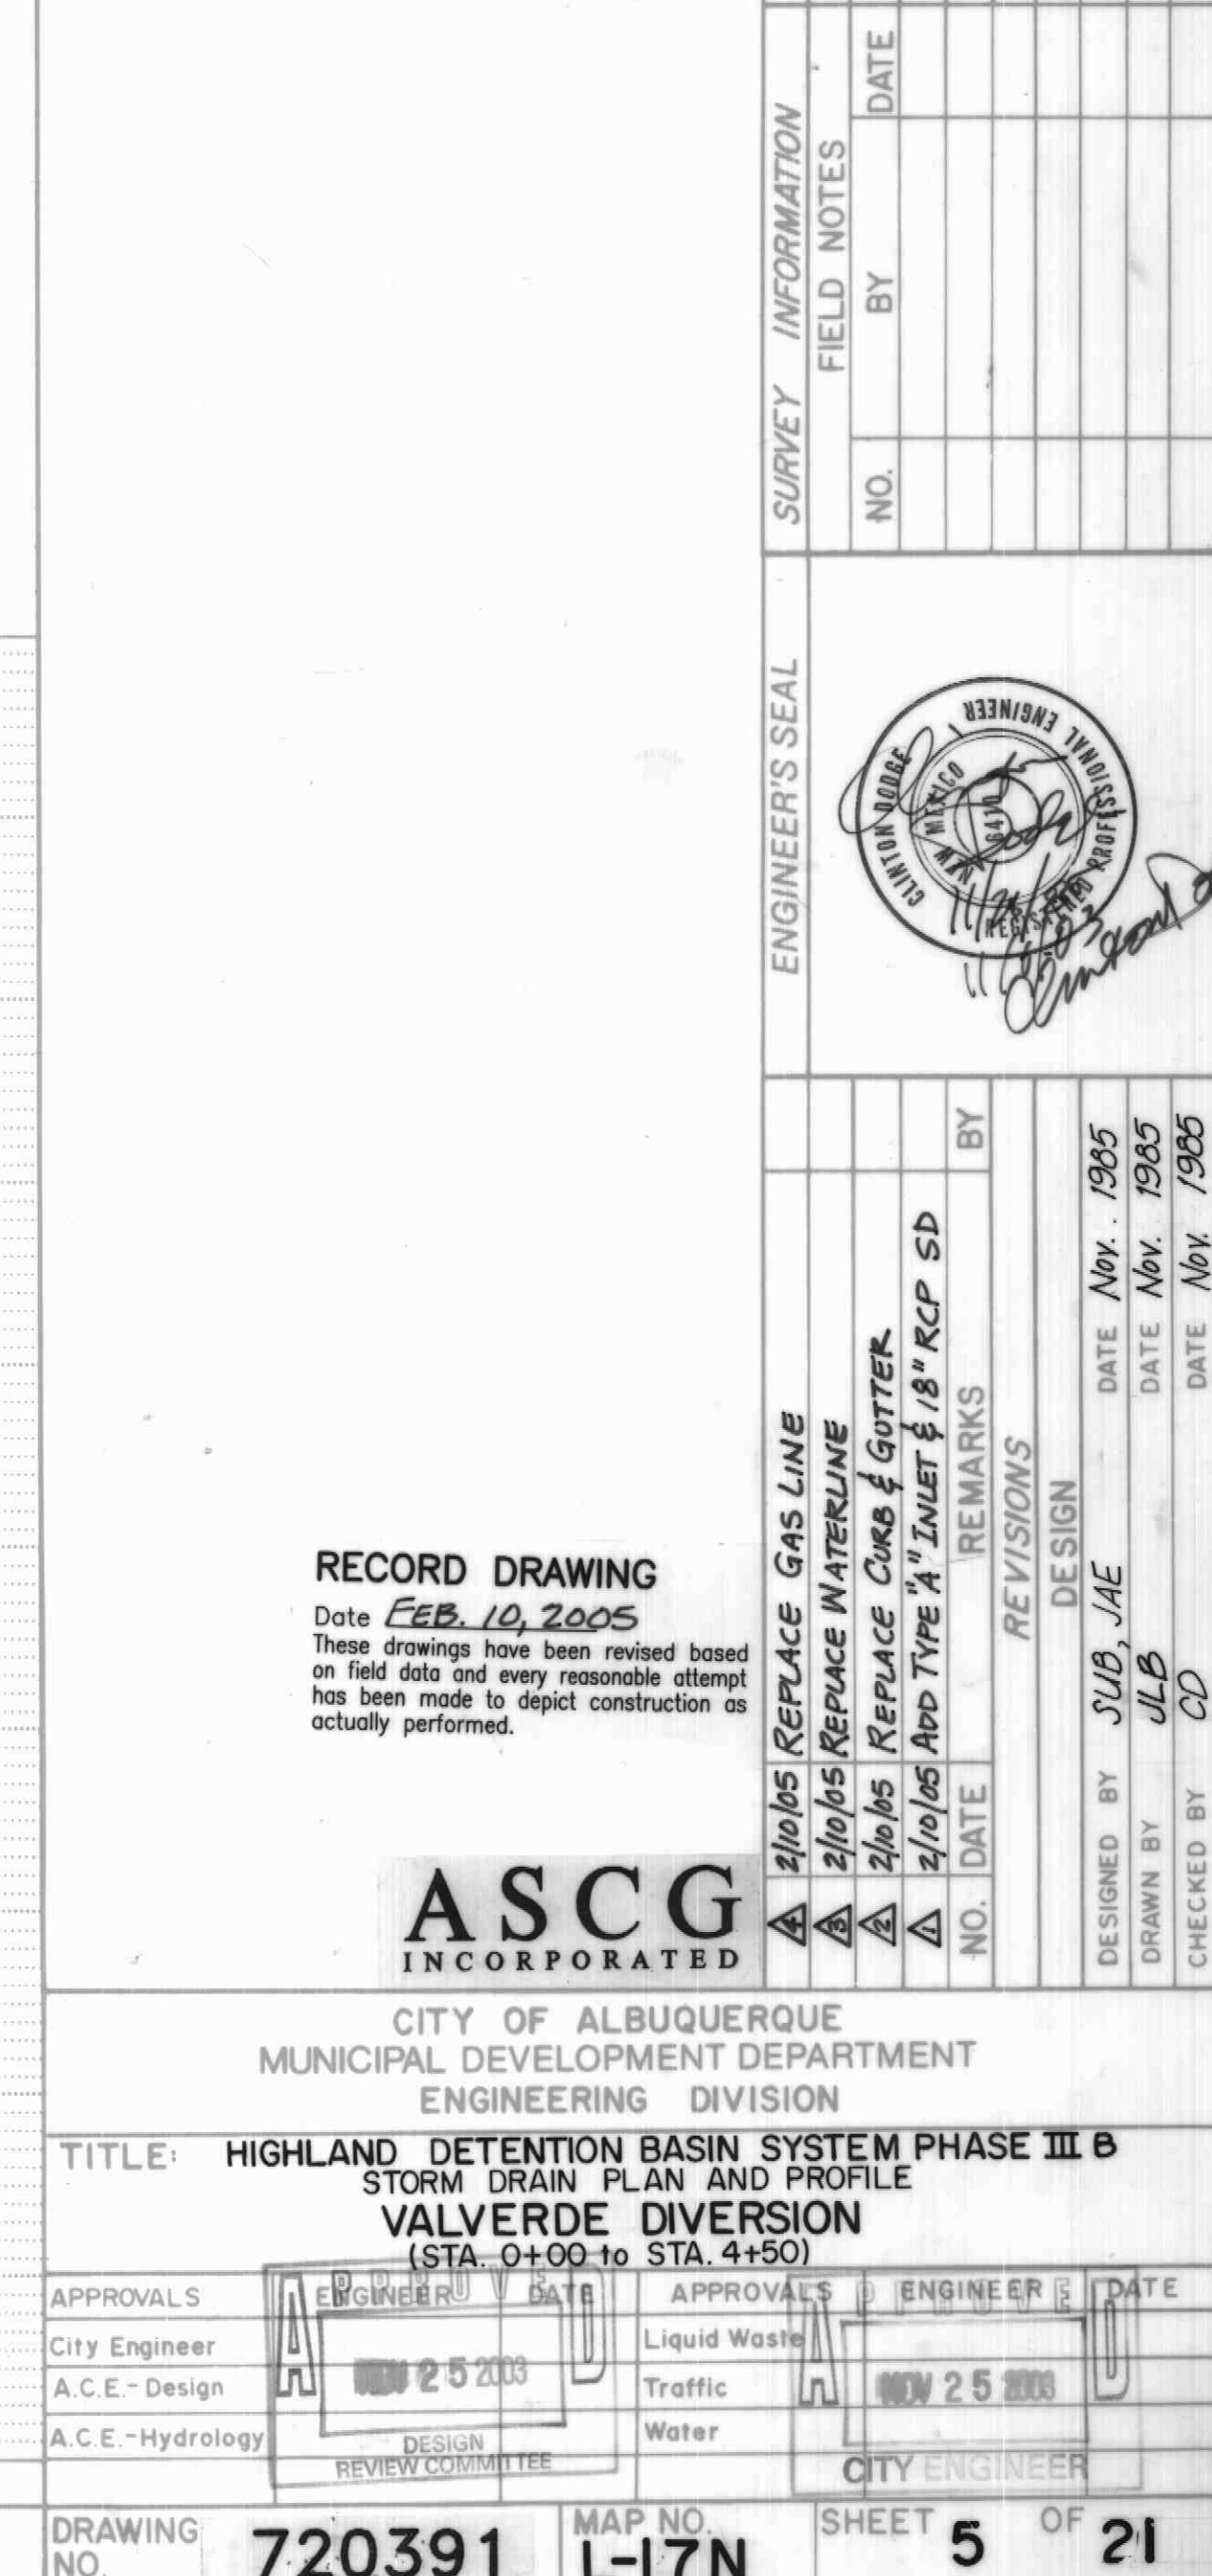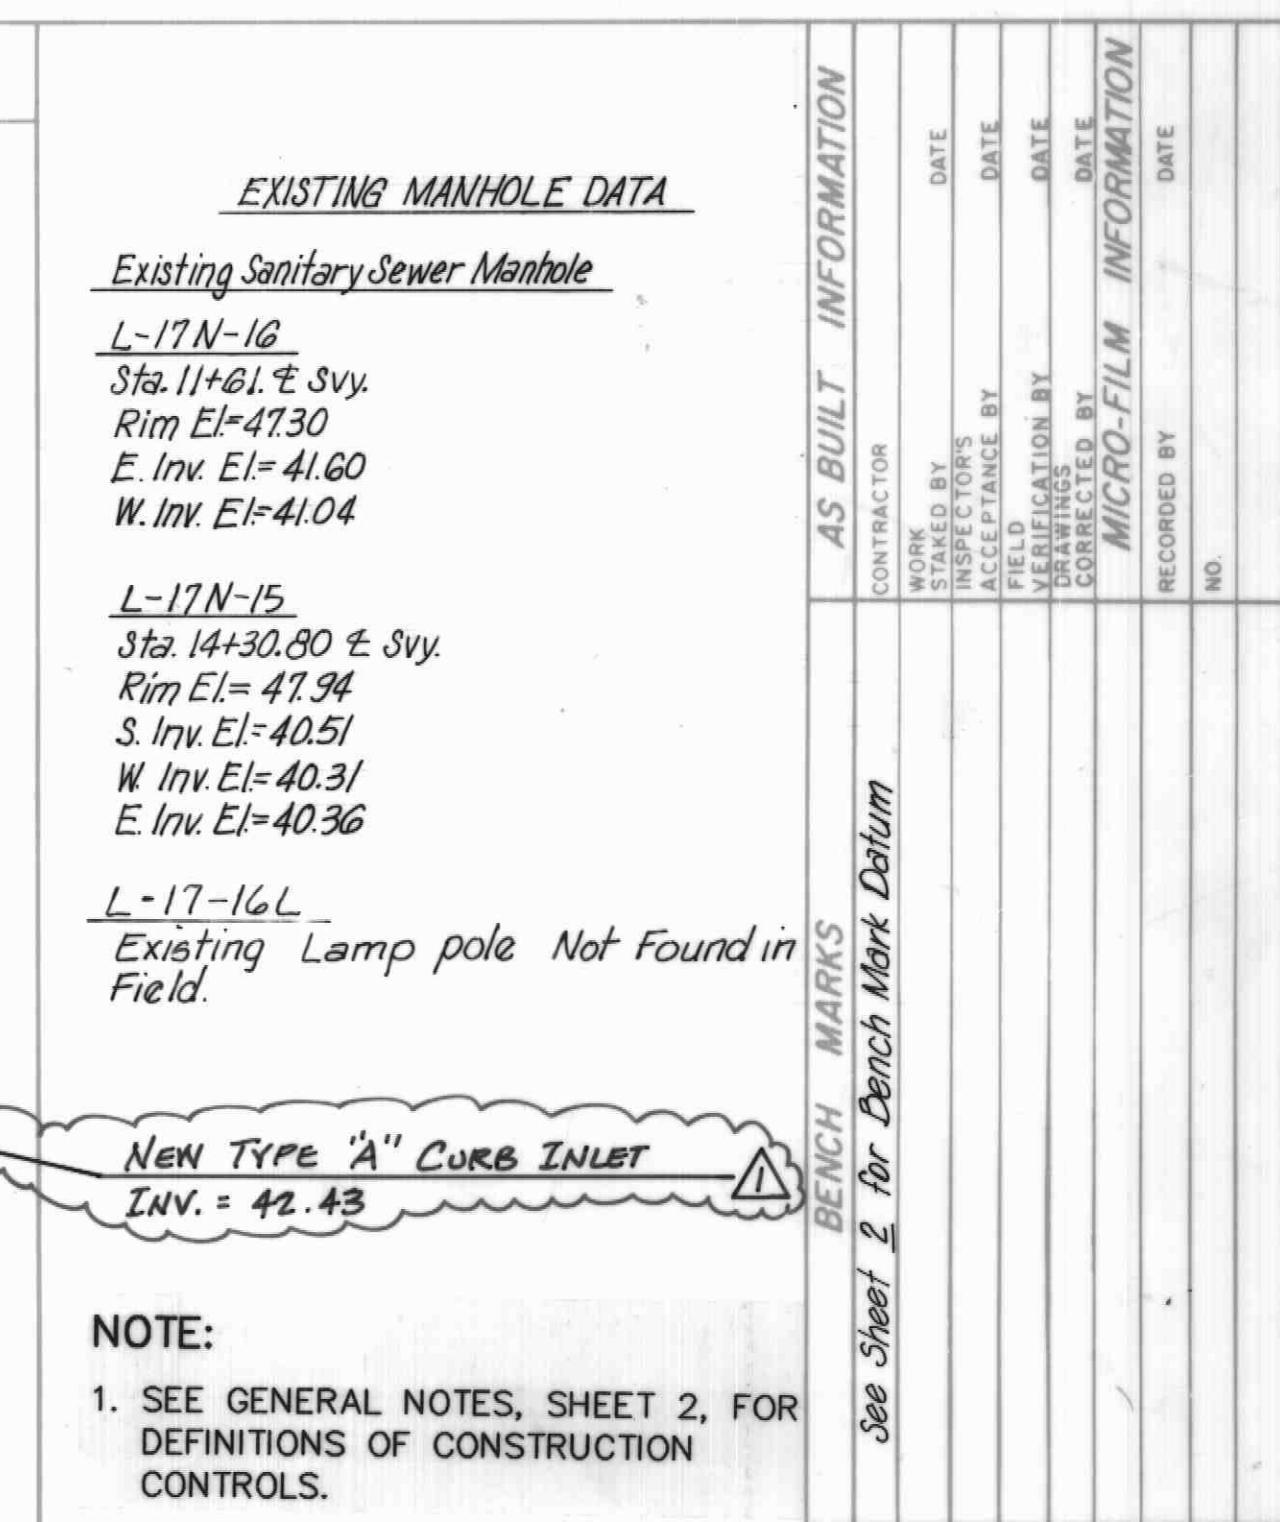

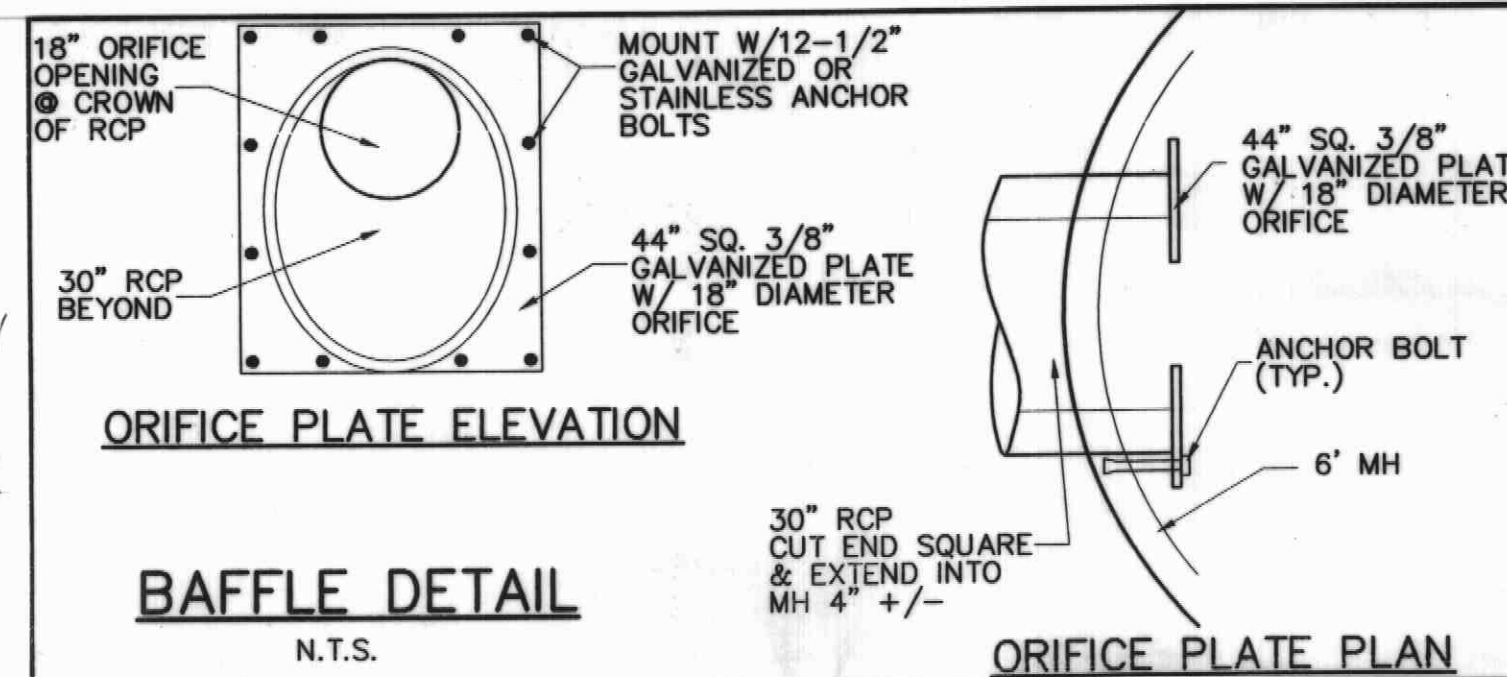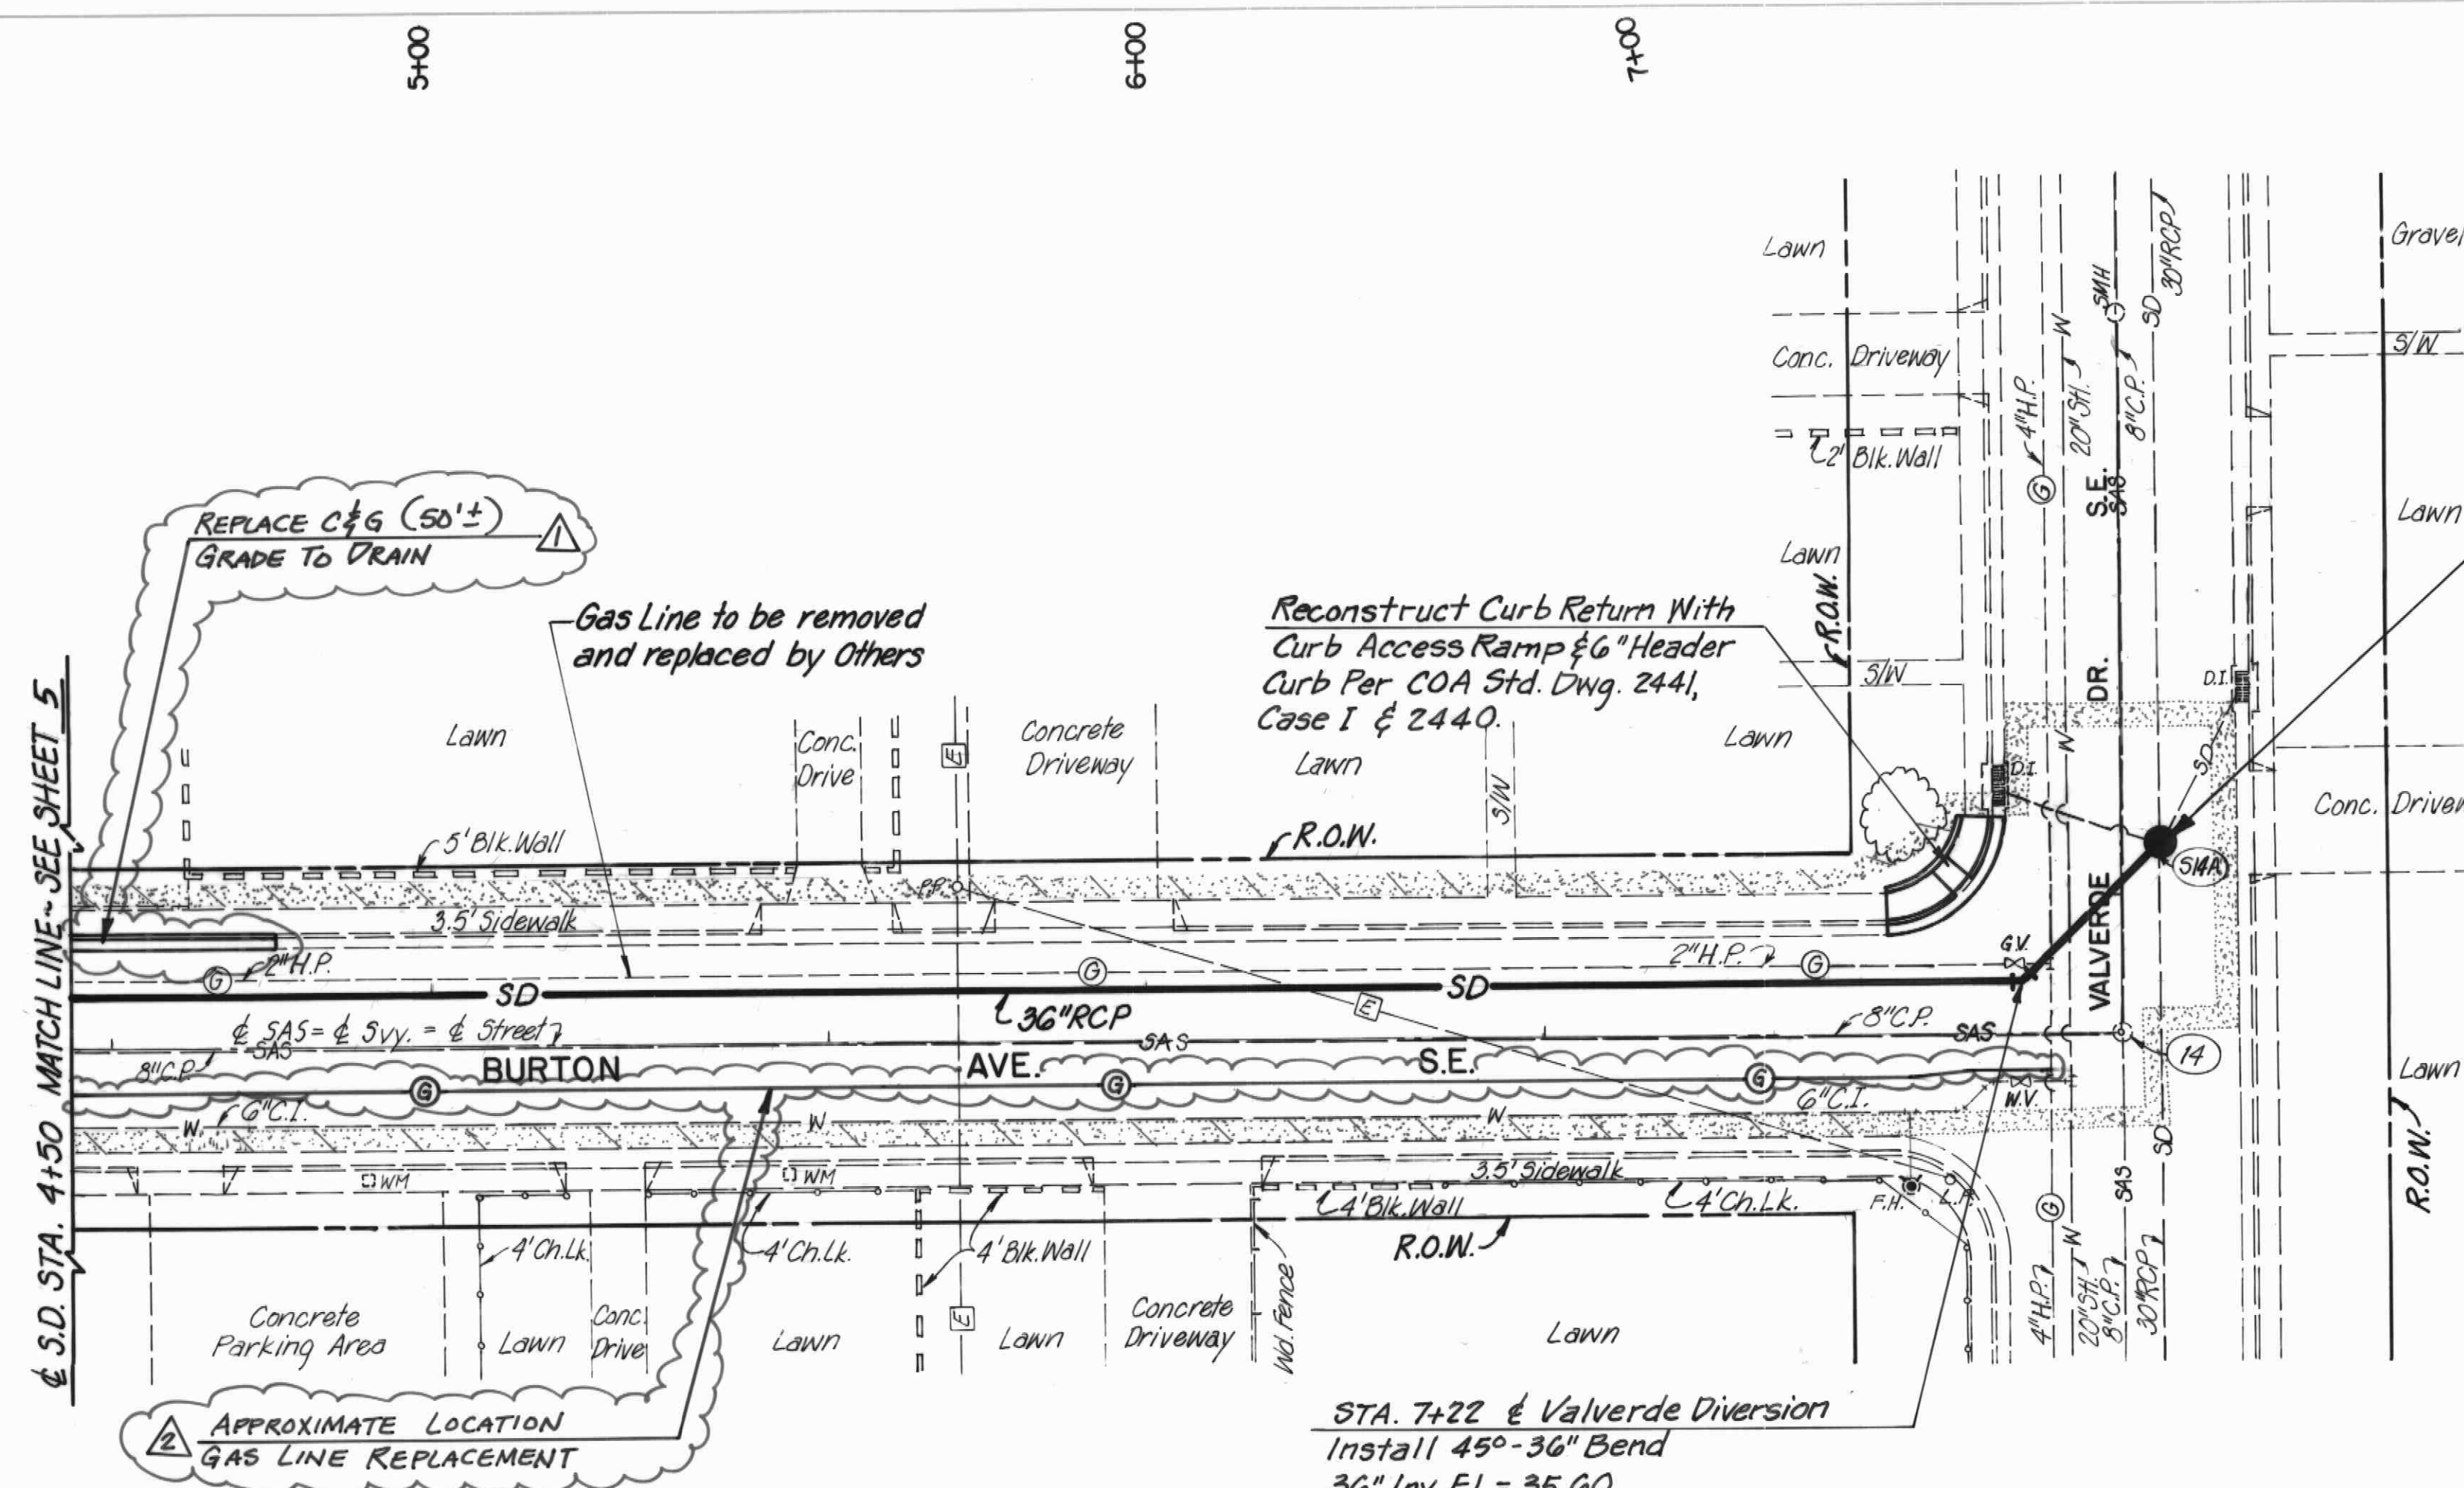


VALVERDE DIVERSION UTILITY PLAN NOTE:

PRIOR TO BEGINNING CONSTRUCTION OF THE VALVERDE DIVERSION PREPARE, SUBMIT, AND OBTAIN APPROVAL FROM THE CITY PROJECT MANAGER OF THE "VALVERDE DIVERSION UTILITY PLAN" (THE PLAN). IMPLEMENT AND CONSTRUCT THE PLAN TO MAINTAIN EXISTING UTILITY SERVICE DURING CONSTRUCTION. IDENTIFY AND SCHEDULE ALL UTILITY OUTAGES IN THE PLAN.

IDENTIFY IN THE VALVERDE DIVERSION UTILITY PLAN ALL UTILITIES AFFECTED BY THE CONSTRUCTION OF THE VALVERDE DIVERSION AND THE UTILITY OWNER/OPERATOR. THIS INCLUDES THE BURTON AVE. AND VALVERDE DR. INTERSECTION, BURTON AVE. AND THE BURTON AVE. AND JEFFERSON ST. INTERSECTION. IDENTIFY HOW THE CONTRACTOR WILL PROVIDE THE NECESSARY STRUCTURAL SUPPORT, BYPASS PUMPING, BYPASS PIPING, REMOVAL AND REPLACEMENT, SEQUENCE AND SCHEDULE OF CONSTRUCTION, AND OTHER RELEVANT INFORMATION FOR ALL CITY OWNED OR OPERATED UTILITIES. COORDINATE WITH NON-CITY UTILITIES AND INCLUDE IN THE PLAN.

PAYMENT FOR PREPARING, SUBMITTING, OBTAINING APPROVAL, IMPLEMENTING AND CONSTRUCTING THE "VALVERDE DIVERSION UTILITY PLAN" SHALL BE PAID AS A LUMP SUM INCLUDING SHOVELLY AND BYPASS PIPING, REMOVAL AND REPLACEMENT OF EXISTING UTILITIES, TEMPORARY AND PERMANENT SUPPORT AND ALL INCIDENTALS. ADDITIONAL WORK REQUESTED BY THE CITY (FOR EXAMPLE, REPLACEMENT OF DETERIORATED LINES) WILL BE PAID FOR IN ACCORDANCE WITH THE CONTRACT DOCUMENTS. REMOVAL AND REPLACEMENT OF UTILITIES SPECIFICALLY IDENTIFIED IN THE CONSTRUCTION DOCUMENTS WILL BE PAID IN ACCORDANCE WITH THE BID PROPOSAL ITEMS.

SCALES
1" = 20' Horizontal
1" = 5' Vertical

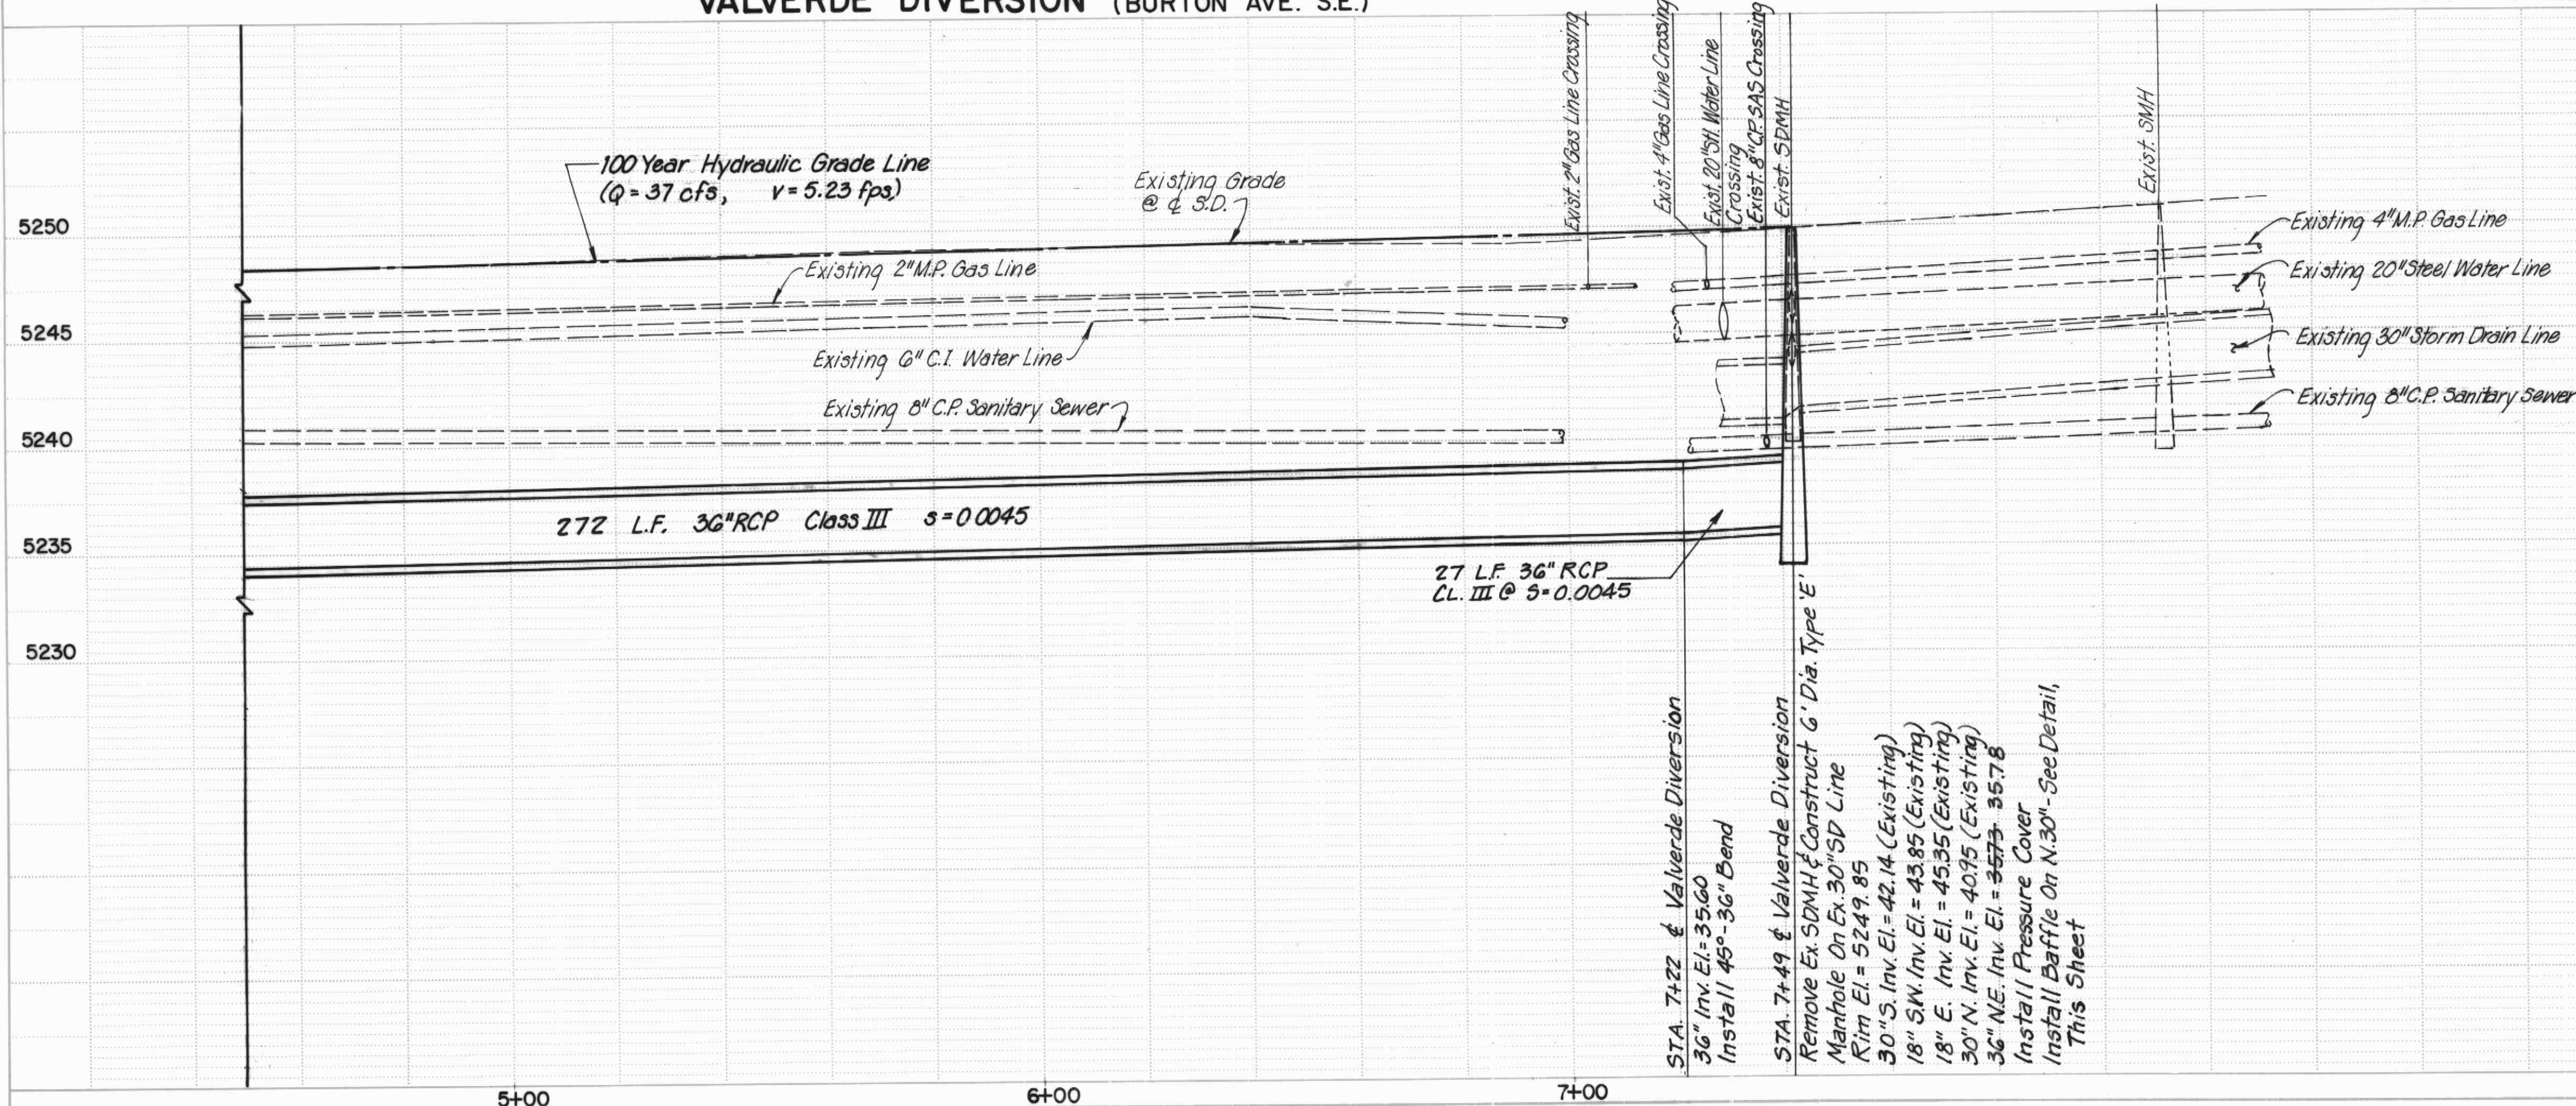

EXISTING MANHOLE DATA

Existing Sanitary Sewer Manhole

L-17N-14
Sta. 17+80.8 & Svy.
N. Rim El. = 5249.30
8" N. Inv. El. = 39.19
8" S. Inv. El. = 39.22
8" E. Inv. El. = 39.68

Existing Storm Drain Manhole

L-17N-S14A
Sta. 18+07, 5.4' Rt. & Svy.
N. Rim El. = 5249.85
30" N. Inv. El. = 40.95
30" S. Inv. El. = 41.40
18" SW. Inv. El. = 43.85
18" E. Inv. El. = 45.35

NOTE:

- SEE GENERAL NOTES, SHEET 2, FOR DEFINITIONS OF CONSTRUCTION CONTROLS.

RECORD DRAWING

Date FEB. 10, 2005
These drawings have been revised based on field data and every reasonable attempt has been made to depict construction as actually performed.

ASCG
INCORPORATED

CITY OF ALBUQUERQUE
MUNICIPAL DEVELOPMENT DEPARTMENT
ENGINEERING DIVISION


TITLE: HIGHLAND DETENTION BASIN SYSTEM - PHASE III B
STORM DRAIN PLAN AND PROFILE
VALVERDE DIVERSION
(STA. 4+50 TO STA. 7+22.60)

APPROVALS	ENGINEER	DATE	APPROVALS	ENGINEER	DATE
City Engineer	A	25 2003	Liquid Waste	A	25 2003
A.C.E. - Design			Traffic		
A.C.E. - Hydrology			Water		
REVIEW COMMITTEE			CITY ENGINEER		

DRAWING NO. 720391 MAP NO. L-17N SHEET 6 OF 21

AS BUILT INFORMATION		BENCH MARKS		SURVEY INFORMATION		ENGINEER'S SEAL	
CONTRACTOR	DATE	CONTRACTOR	DATE	NO.	DATE	NO.	DATE
INSPECTED BY	DATE	INSPECTED BY	DATE	FIELD NOTES	DATE	REVISIONS	DATE
FIELD CHANGE BY	DATE	FIELD CHANGE BY	DATE			DESIGN	DATE
VERIFICATION BY	DATE	VERIFICATION BY	DATE			DRAWN BY	DATE
CORRECTED BY	DATE	CORRECTED BY	DATE			CHECKED BY	DATE
MICRO-FILM INFORMATION		MICRO-FILM INFORMATION					
NO.		NO.					



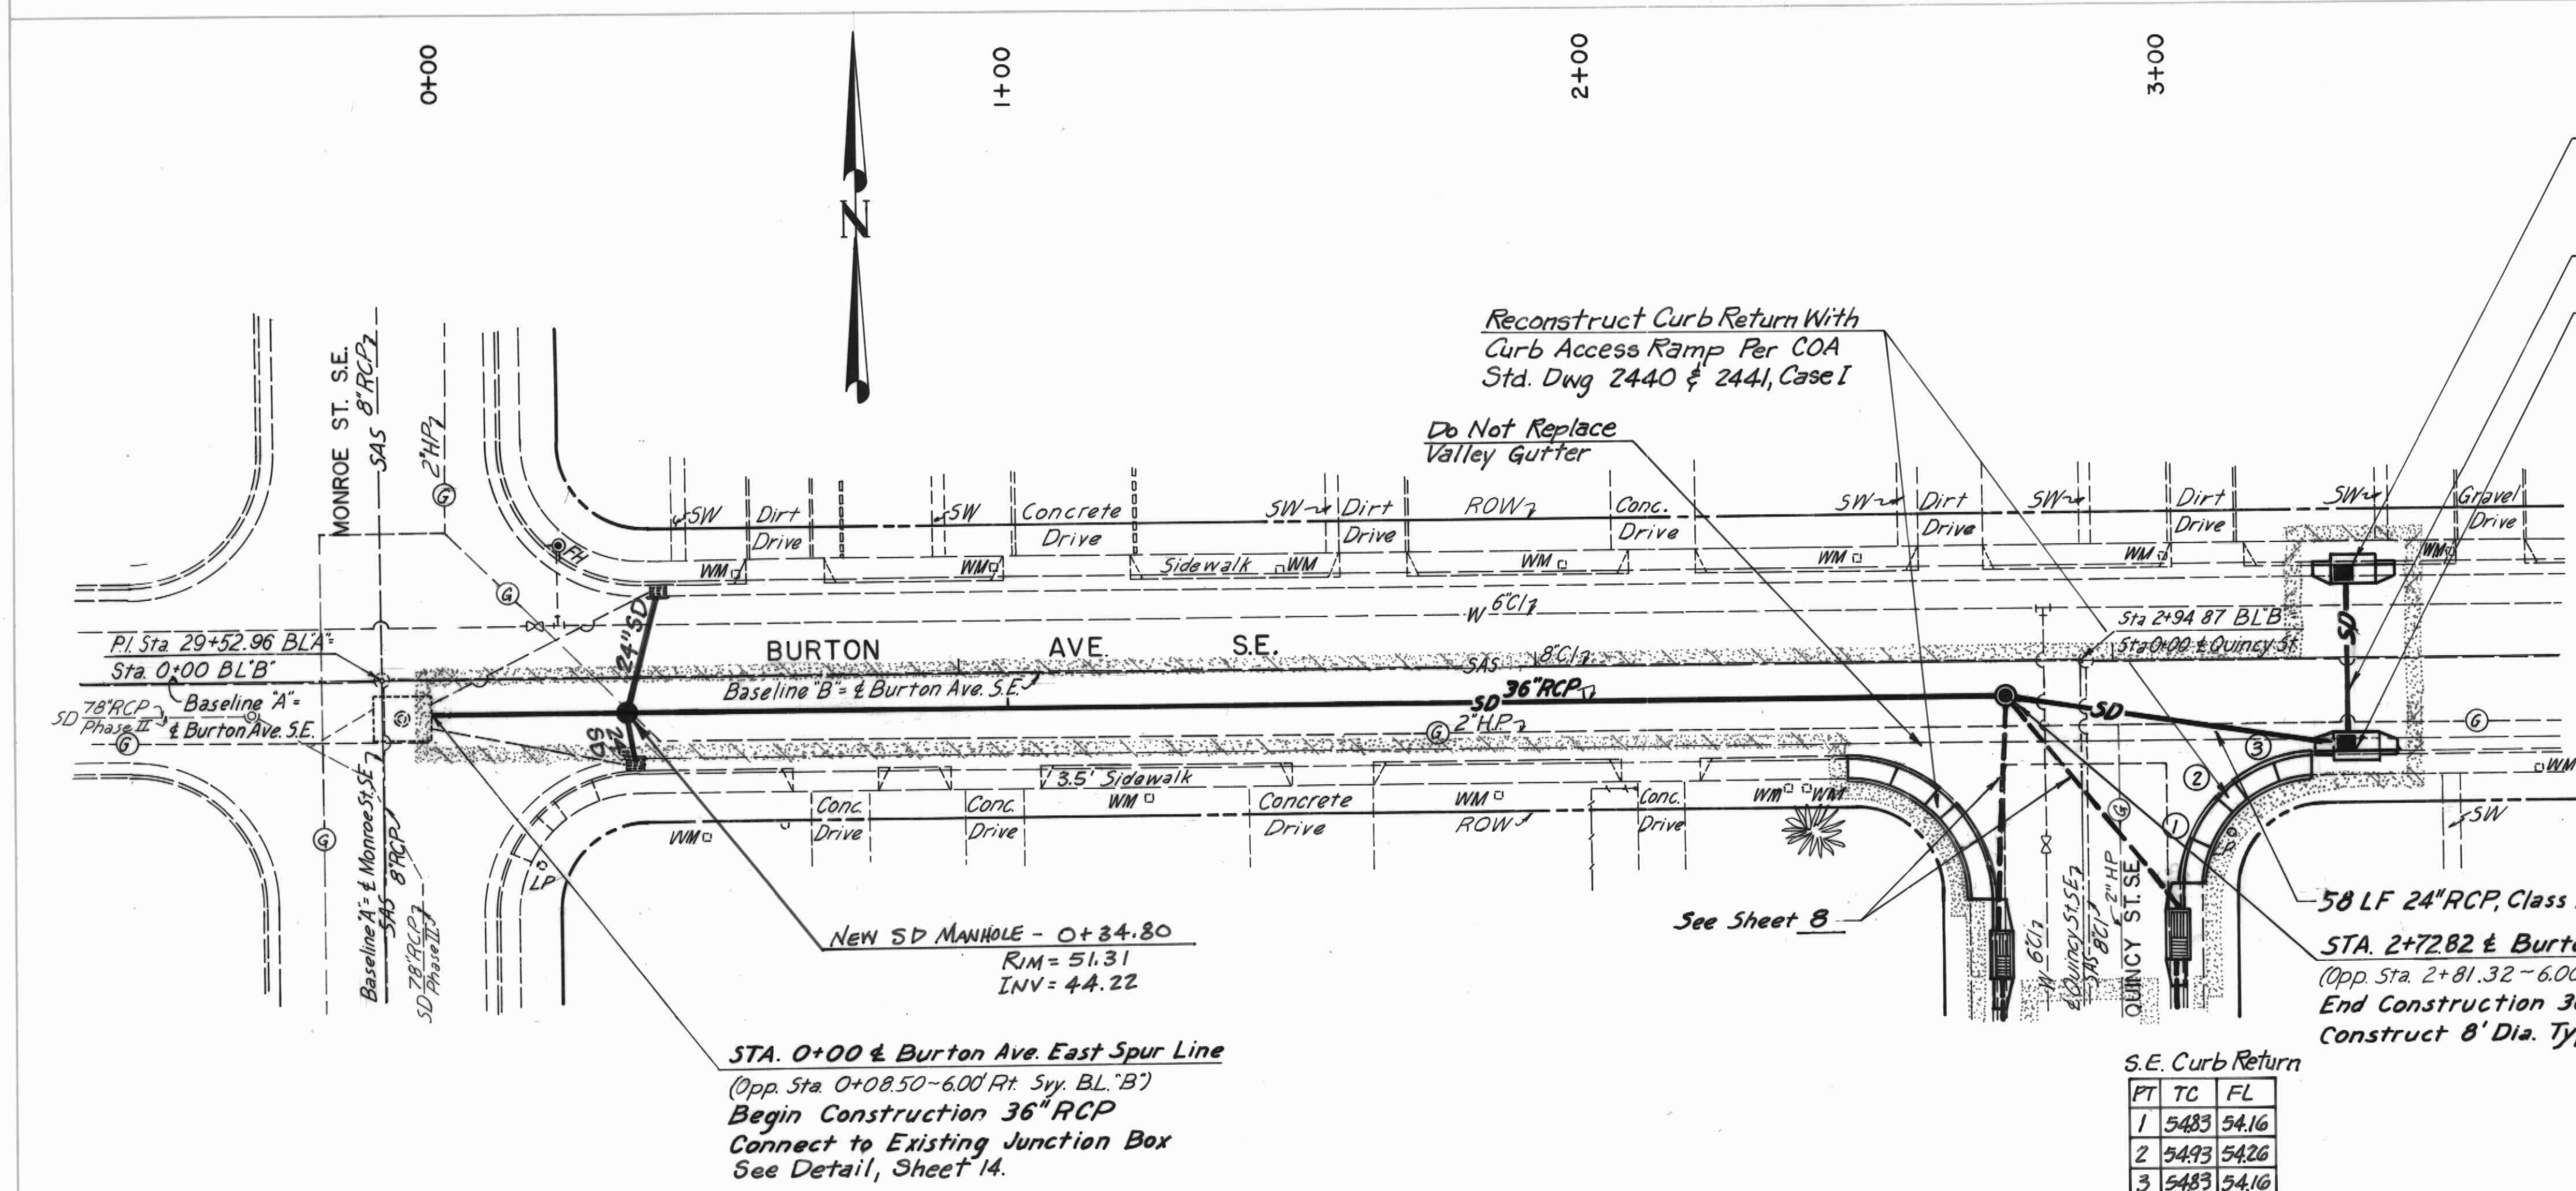


OPP. STA. 3+42.0-16.5' Lt. Svy. BL "B"
Construct Type 'A' Catch Basin
Grate El. = 54.28
18" S. Invert El. = ~~48.50~~ 48.78
28 LF. 18" RCP, Class IV, S=0.010
OPP. STA. 3+42.0-16.5' Rt. Svy. BL "B"
Construct Type 'A' Catch Basin
Grate El. = 54.26
18" N. Invert El. = ~~48.22~~ 48.46
24" W. Invert El. = ~~48.00~~ 48.26

EXISTING MANHOLE DATA
Existing Sanitary Sewer Manholes
L-17N-20 - 4' Dia.
Sta. 29+52.96 BL "A"
N. Rim El. = 51.03
8" E. Inv. El. = 41.95
8" S. Inv. El. = 41.93
8" N. Inv. El. = 41.85
8" W. Inv. El. = 42.00
L-17N-22 - 4' Dia.
Sta. 2+95.80, 0.2' Rt. & Svy. BL "B"
N. Rim El. = 54.45
8" E. Inv. El. = 45.50
8" W. Inv. El. = 45.45
8" S. Inv. El. = 45.63
Existing Storm Drain Junction Box
L-17N-572 - 8'x10' Box
Sta. 29+59.30, 3.5' Lt. & Svy. BL "A"
N. Rim El. = 51.10
E. Inv. El. = 40.68 (54" S & 60" W)
15" NW Inv. El. = 44.43
15" NE Inv. El. = 44.52
15" SE Inv. El. = 44.52
18" SW Inv. El. = 44.10
36" E Inv. El. = 44.50 (New)

NOTE:
1. SEE GENERAL NOTES, SHEET 2, FOR DEFINITIONS OF CONSTRUCTION CONTROLS.

SCALES
1" = 20' Horizontal
1" = 5' Vertical

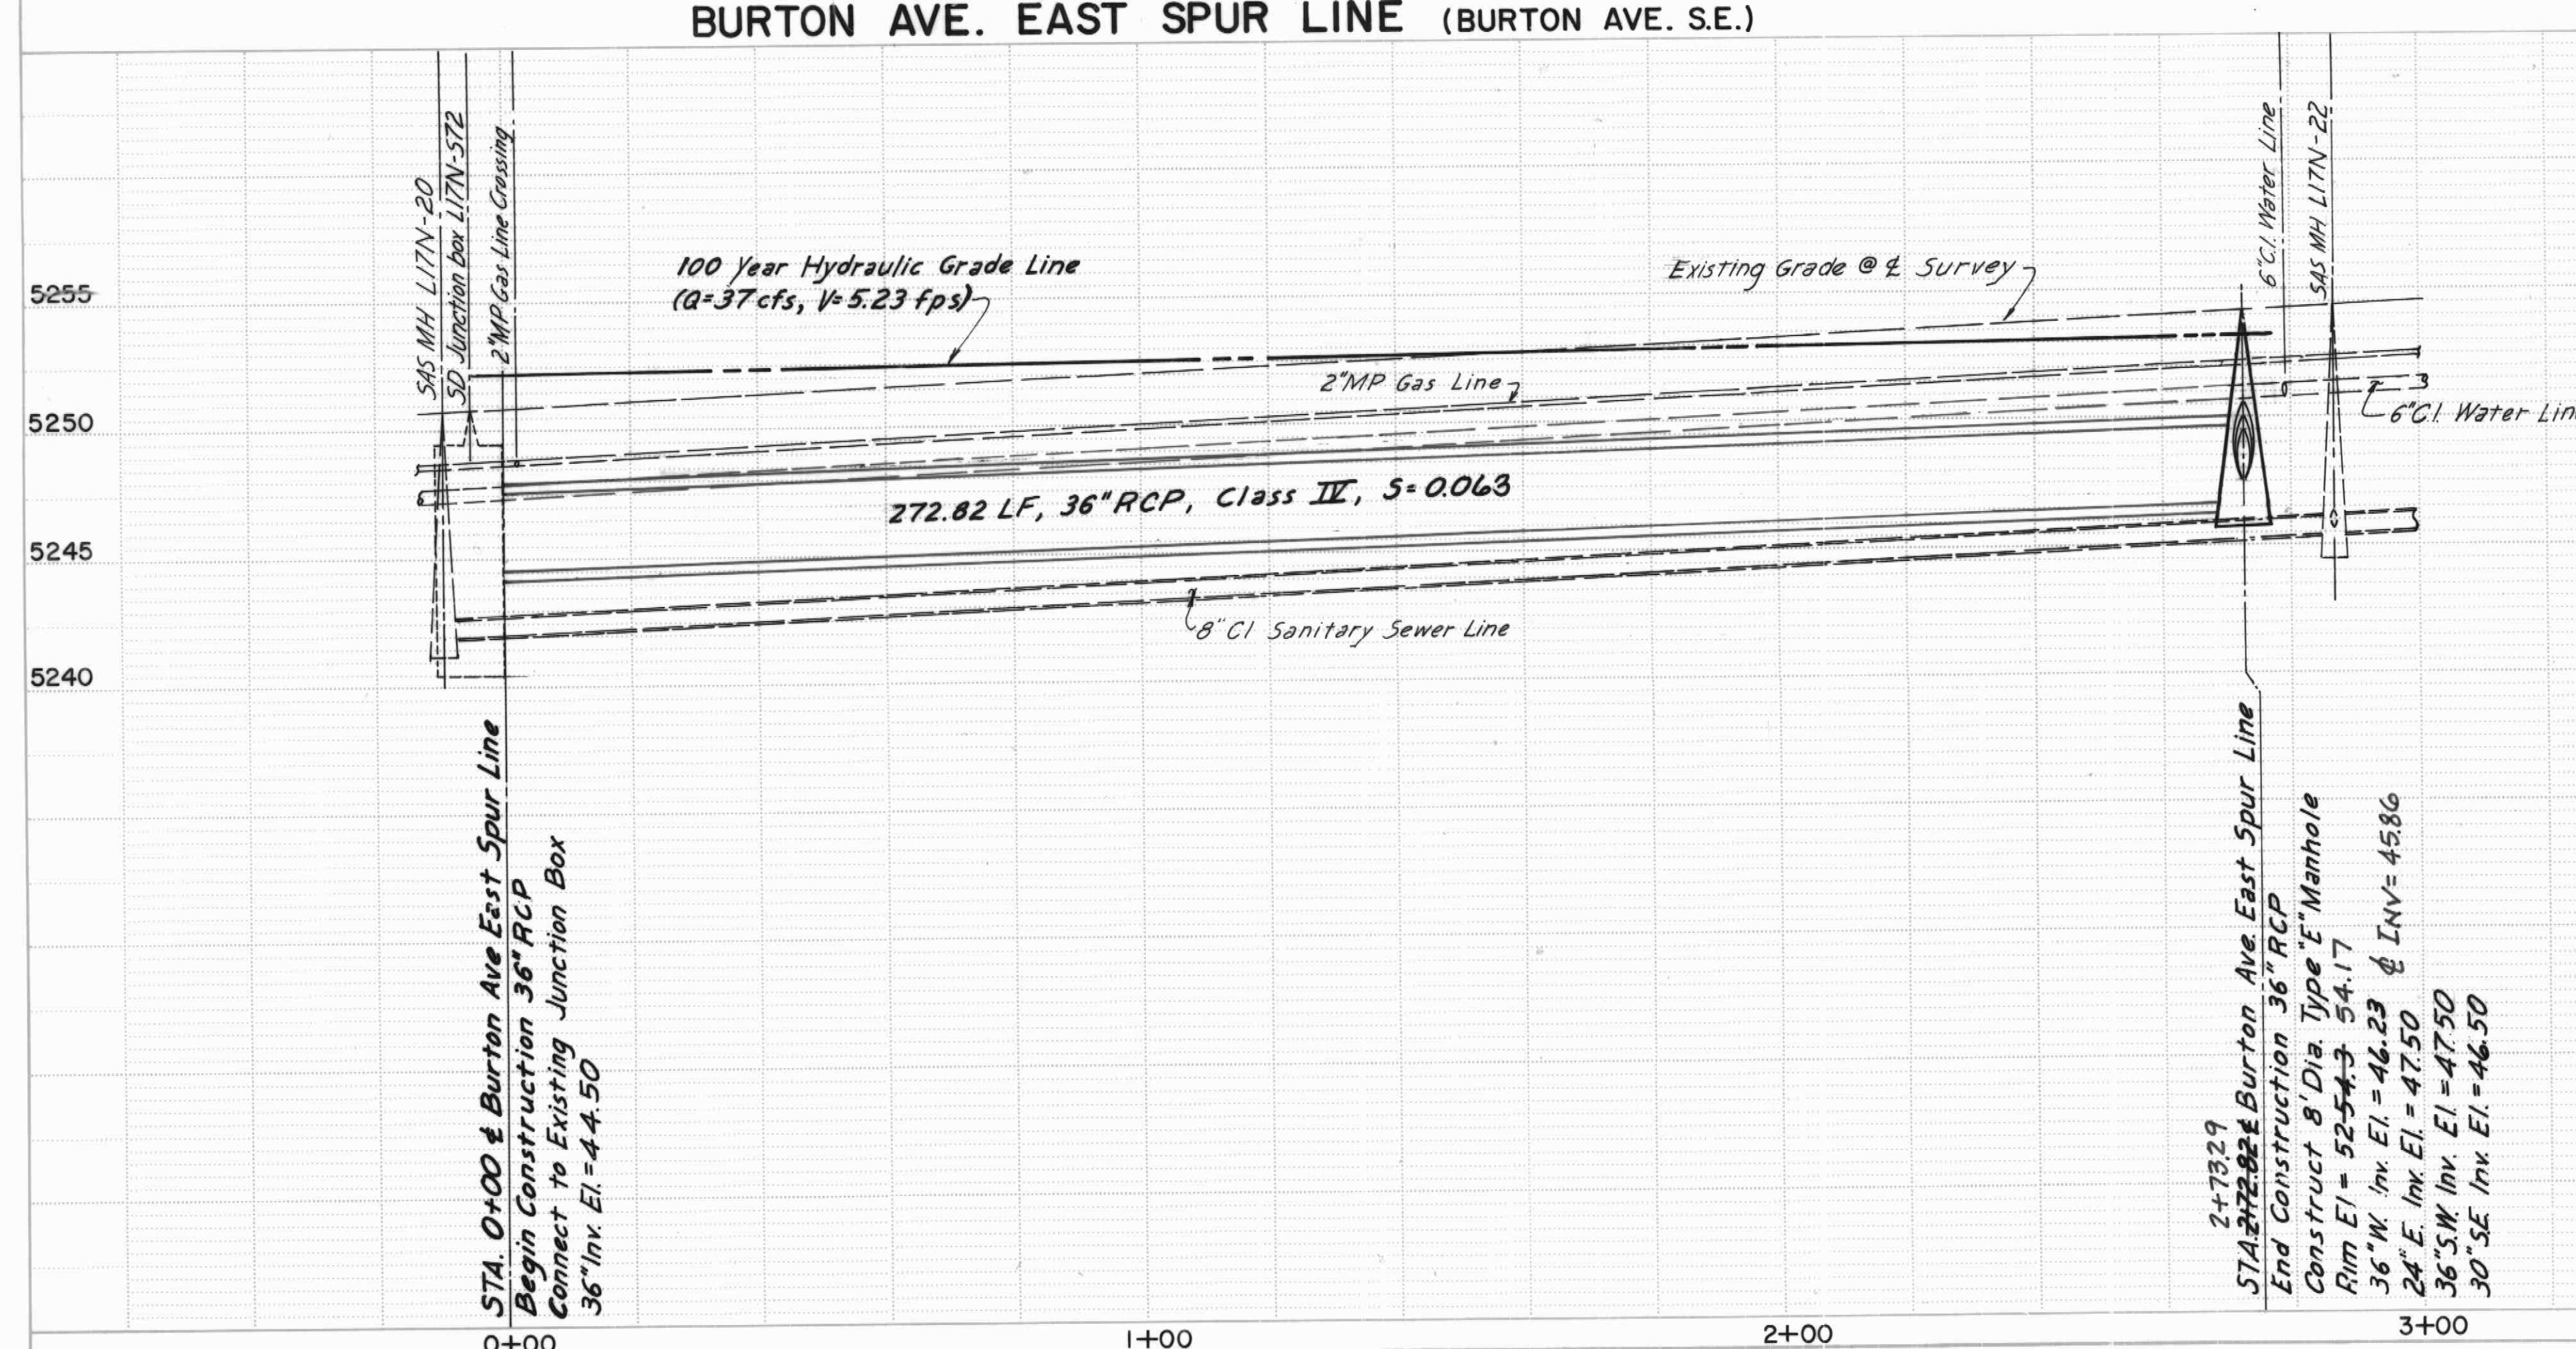

RECORD DRAWING
Date **FEB. 12, 2005**
These drawings have been revised based on field data and every reasonable attempt has been made to depict construction as actually performed.



ASCG
INCORPORATED

CITY OF ALBUQUERQUE
MUNICIPAL DEVELOPMENT DEPARTMENT
ENGINEERING DIVISION

TITLE: HIGHLAND DETENTION BASIN SYSTEM PHASE IIB STORM DRAIN PLAN AND PROFILE BURTON AVE. EAST SPUR LINE (STA. 0+00 to STA. 2+728.2)

APPROVALS	ENGINEER	DATE	APPROVALS	ENGINEER	DATE
City Engineer	A.C.E. - Design	2/5/2005	Liquid Waste	A.C.E. - Hydrology	2/5/2005
REVIEW COMMITTEE			CITY ENGINEER		

DRAWING NO. **720391** MAP NO. **L-17N** SHEET **7** OF **21**

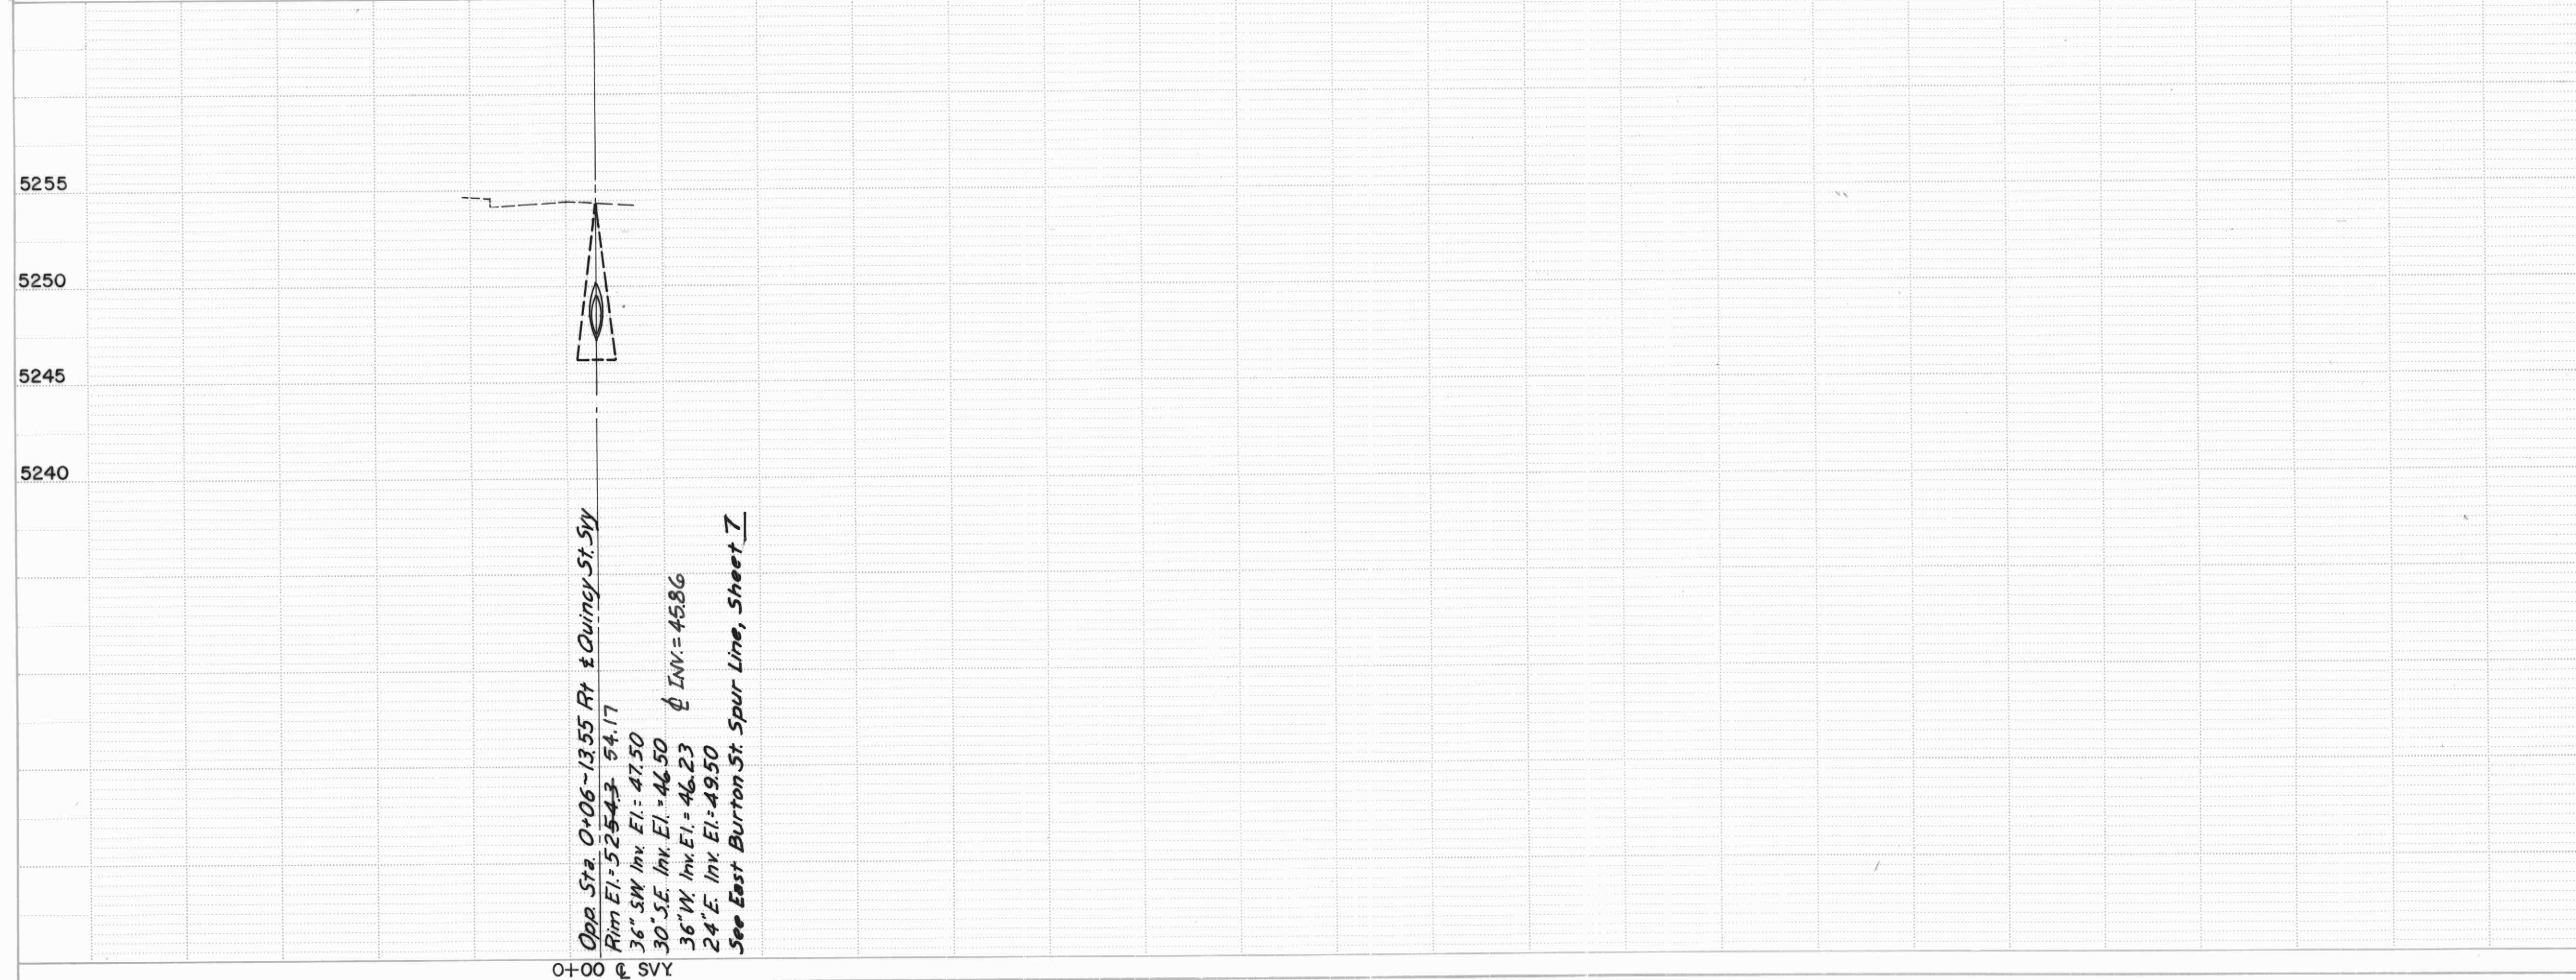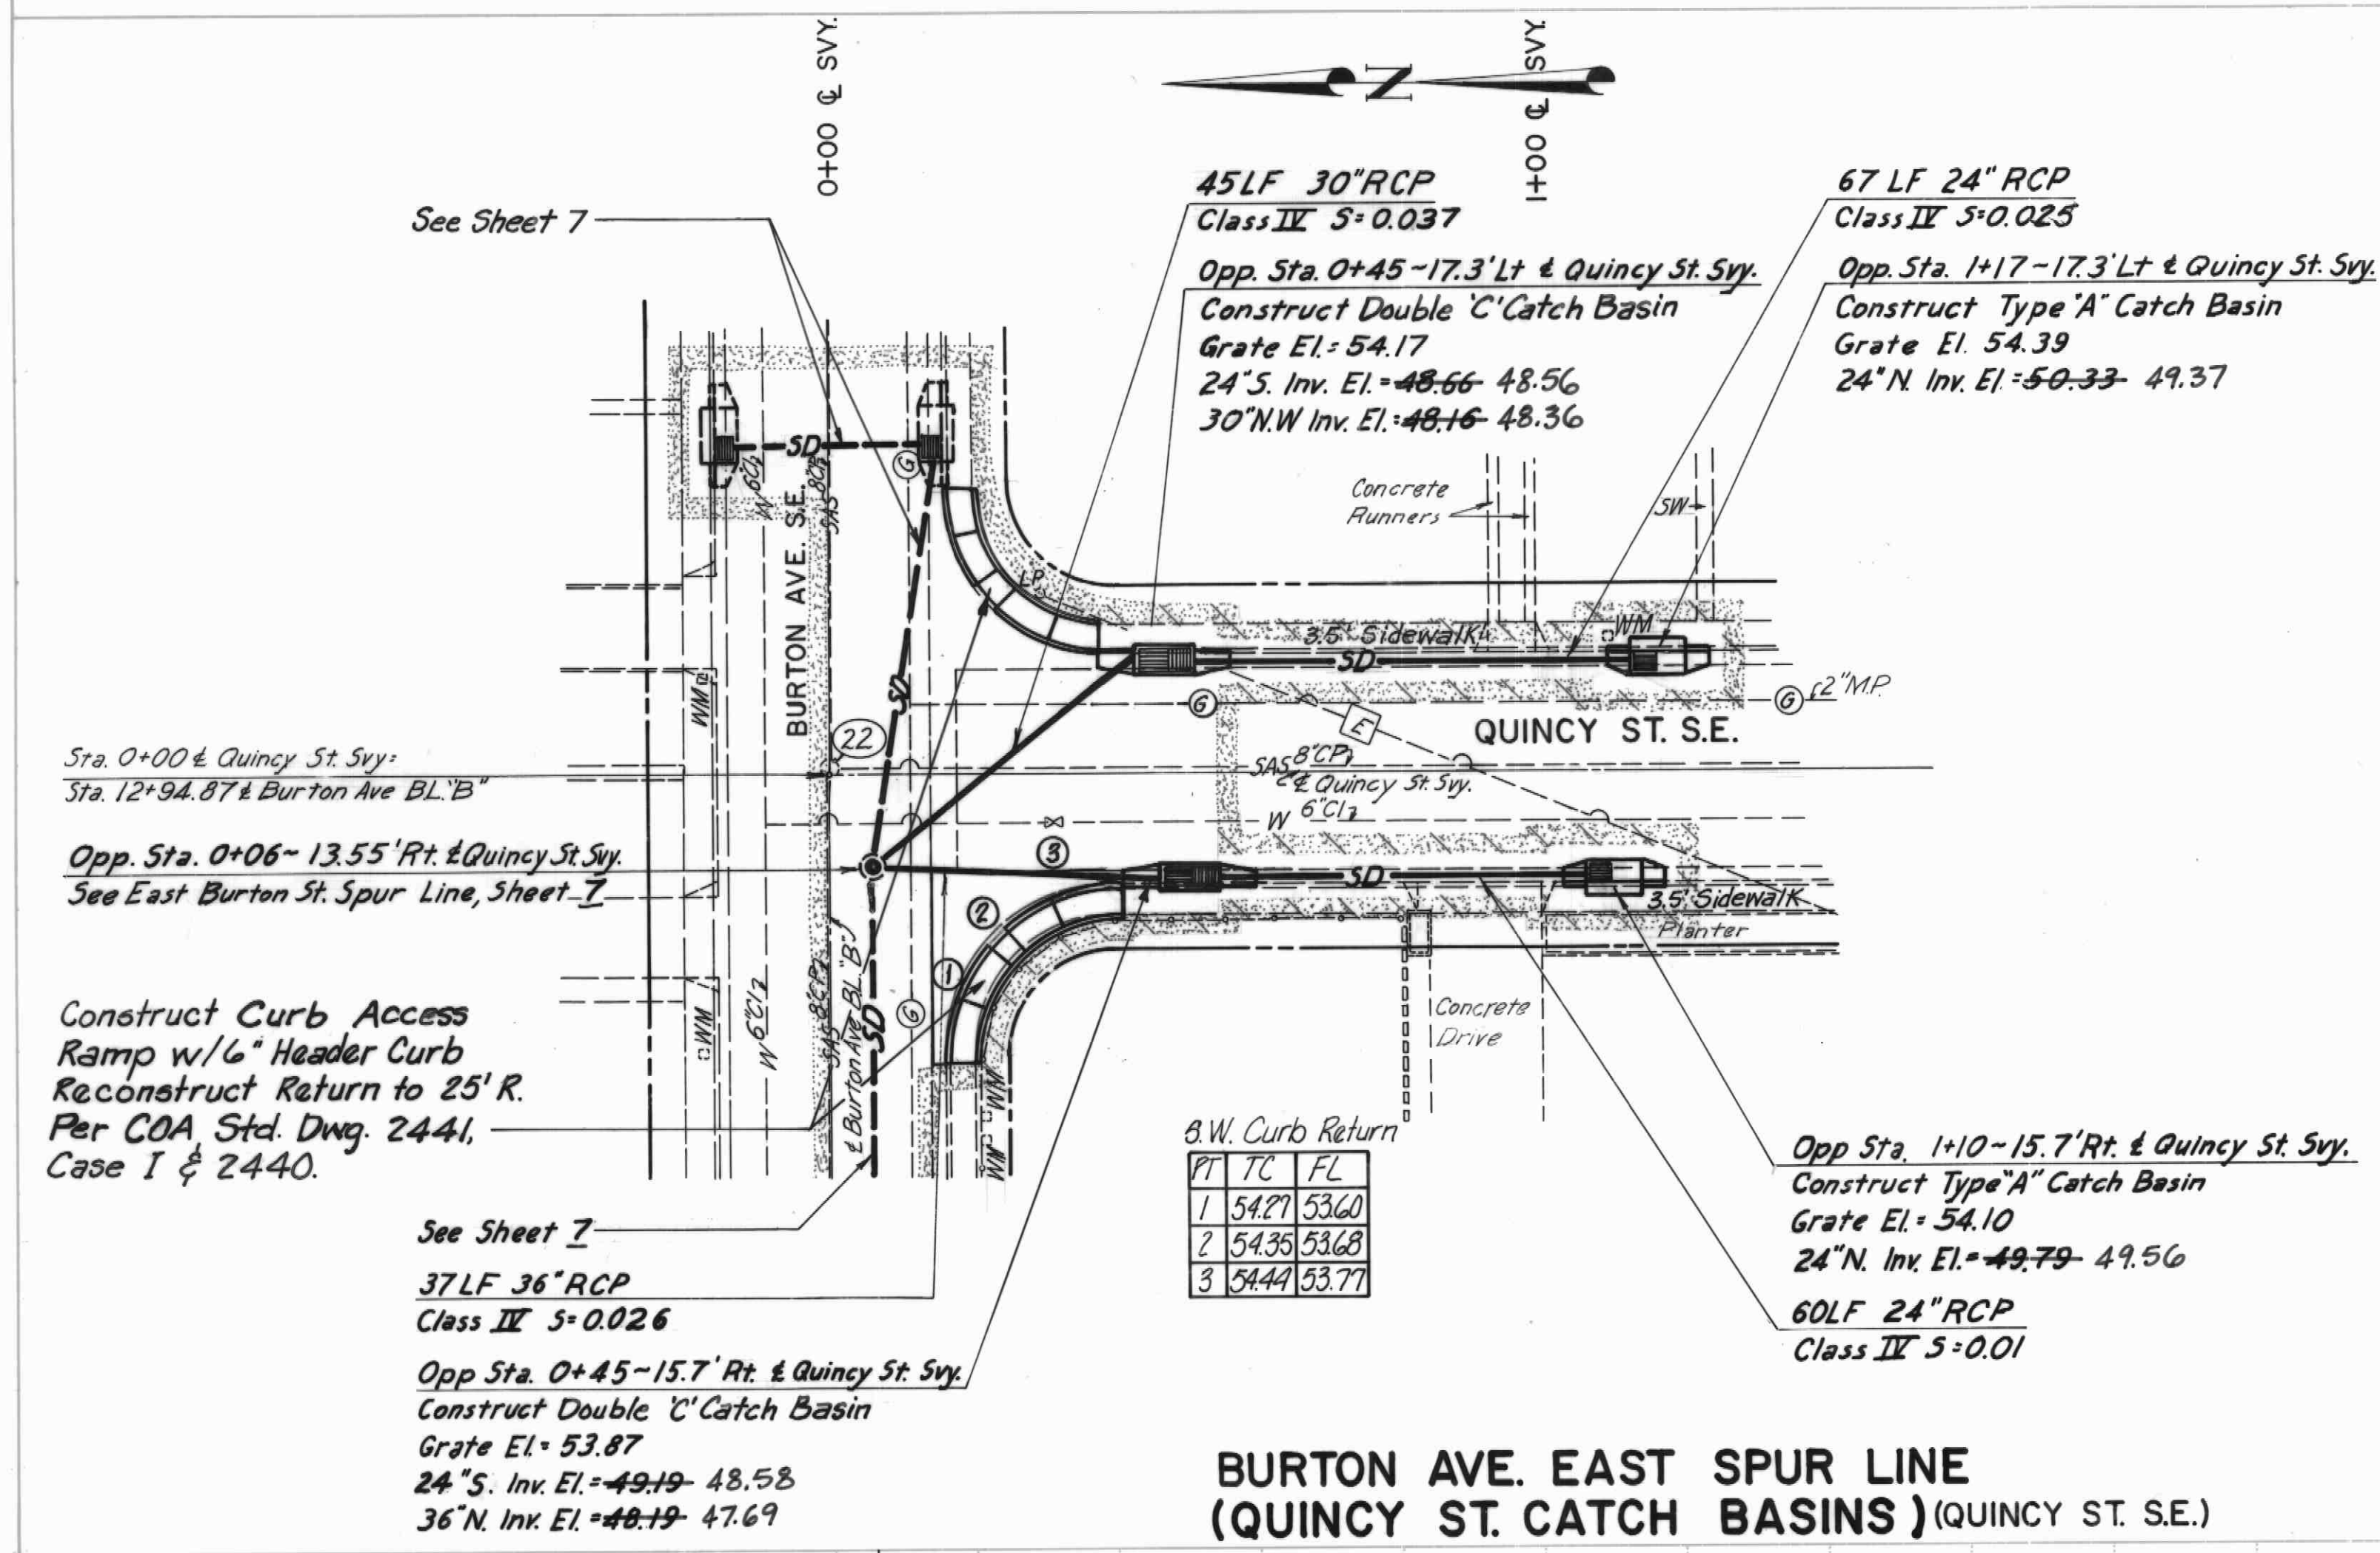

EXISTING MANHOLE DATA

Existing Sanitary Sewer Manhole

L-17N-22-4' Dia

Sta. 2+95.80, 0.2' Rt. & Svy BL'B"

N. Rim El. = 54.45

8" E. Inv. El. = 45.50

8" W. Inv. El. = 45.45

8" S. Inv. El. = 45.63

NOTE:

1. SEE GENERAL NOTES, SHEET 2, FOR DEFINITIONS OF CONSTRUCTION CONTROLS.

SCALES

1"=20' Horizontal

1"=5' Vertical

RECORD DRAWING

Date **FEB. 10, 2005**

These drawings have been revised based on field data and every reasonable attempt has been made to depict construction as actually performed.

ASCG

INCORPORATED

CITY OF ALBUQUERQUE

MUNICIPAL DEVELOPMENT DEPARTMENT

ENGINEERING DIVISION

TITLE: **HIGHLAND DETENTION BASIN SYSTEM PHASE II B**

BURTON AVE. EAST SPUR LINE (QUINCY ST. CATCH BASINS)

(STA. 0+06 to STA. 1+17)


APPROVALS	ENGINEER	DATE	APPROVALS	ENGINEER	DATE
City Engineer			Liquid Waste		
A.C.E.-Design			Traffic		
A.C.E.-Hydrology			Water		

DESIGN REVIEW COMMITTEE

CITY ENGINEER


DESIGNED BY	DATE	REVISIONS	BY	DATE
JAE, SUB	Sept. 1985	DESIGN		
DRAWN BY	DATE			
KHK	Sept. 1985			
CHECKED BY	DATE			
CD	Nov. 1985			

DRAWING NO.	MAP NO.	SHEET	OF
720391	L-17N	8	21

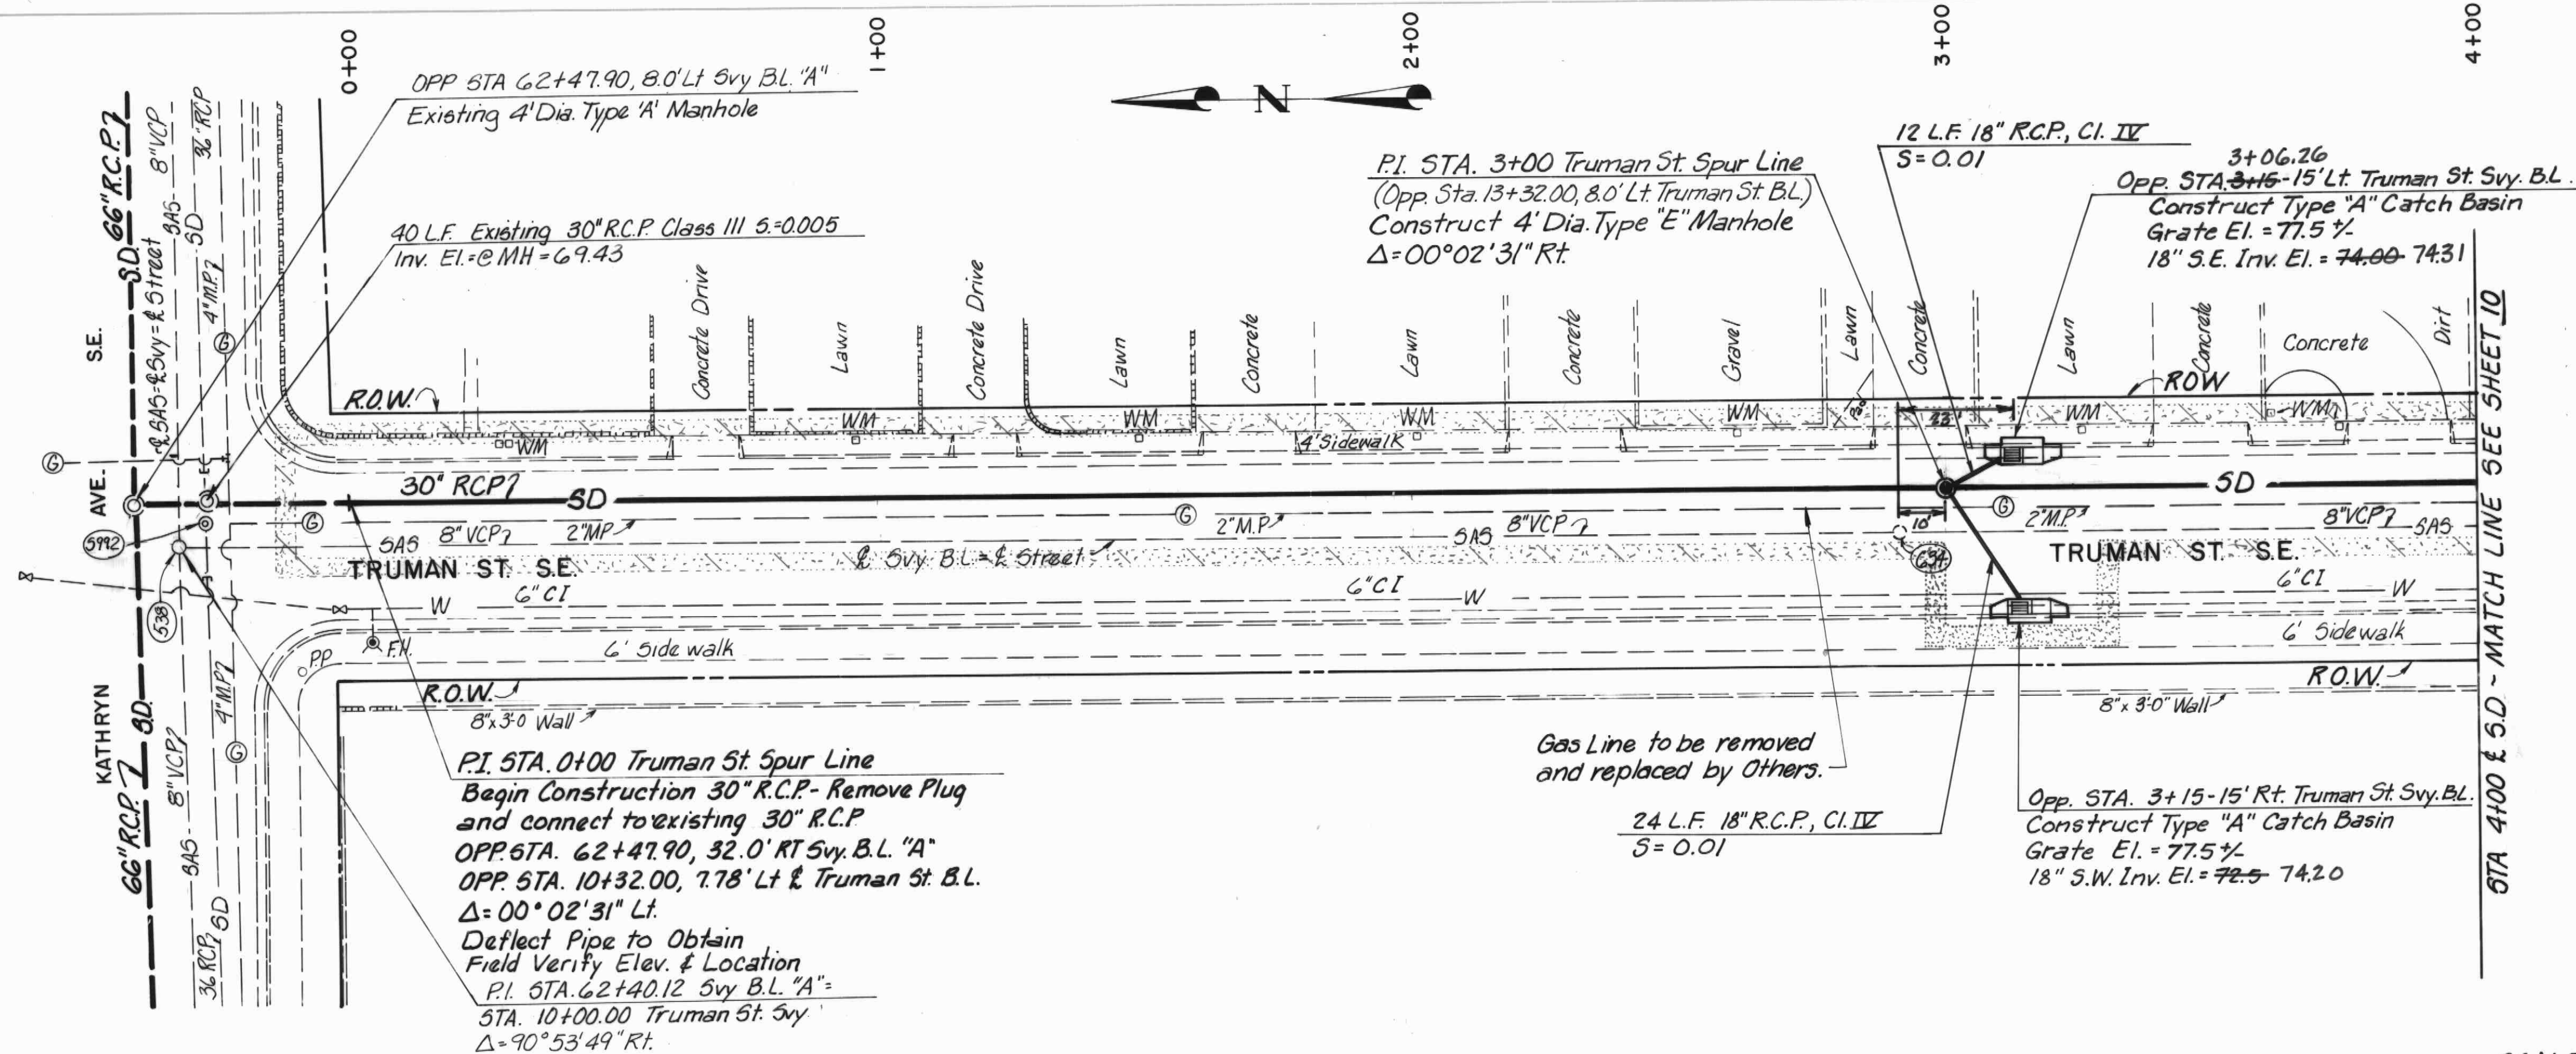

TRUMAN ST. S.E. SPUR LINE (TRUMAN ST. S.E.)

SCALES:
Horiz. 1" = 20'
Vert. 1" = 5'

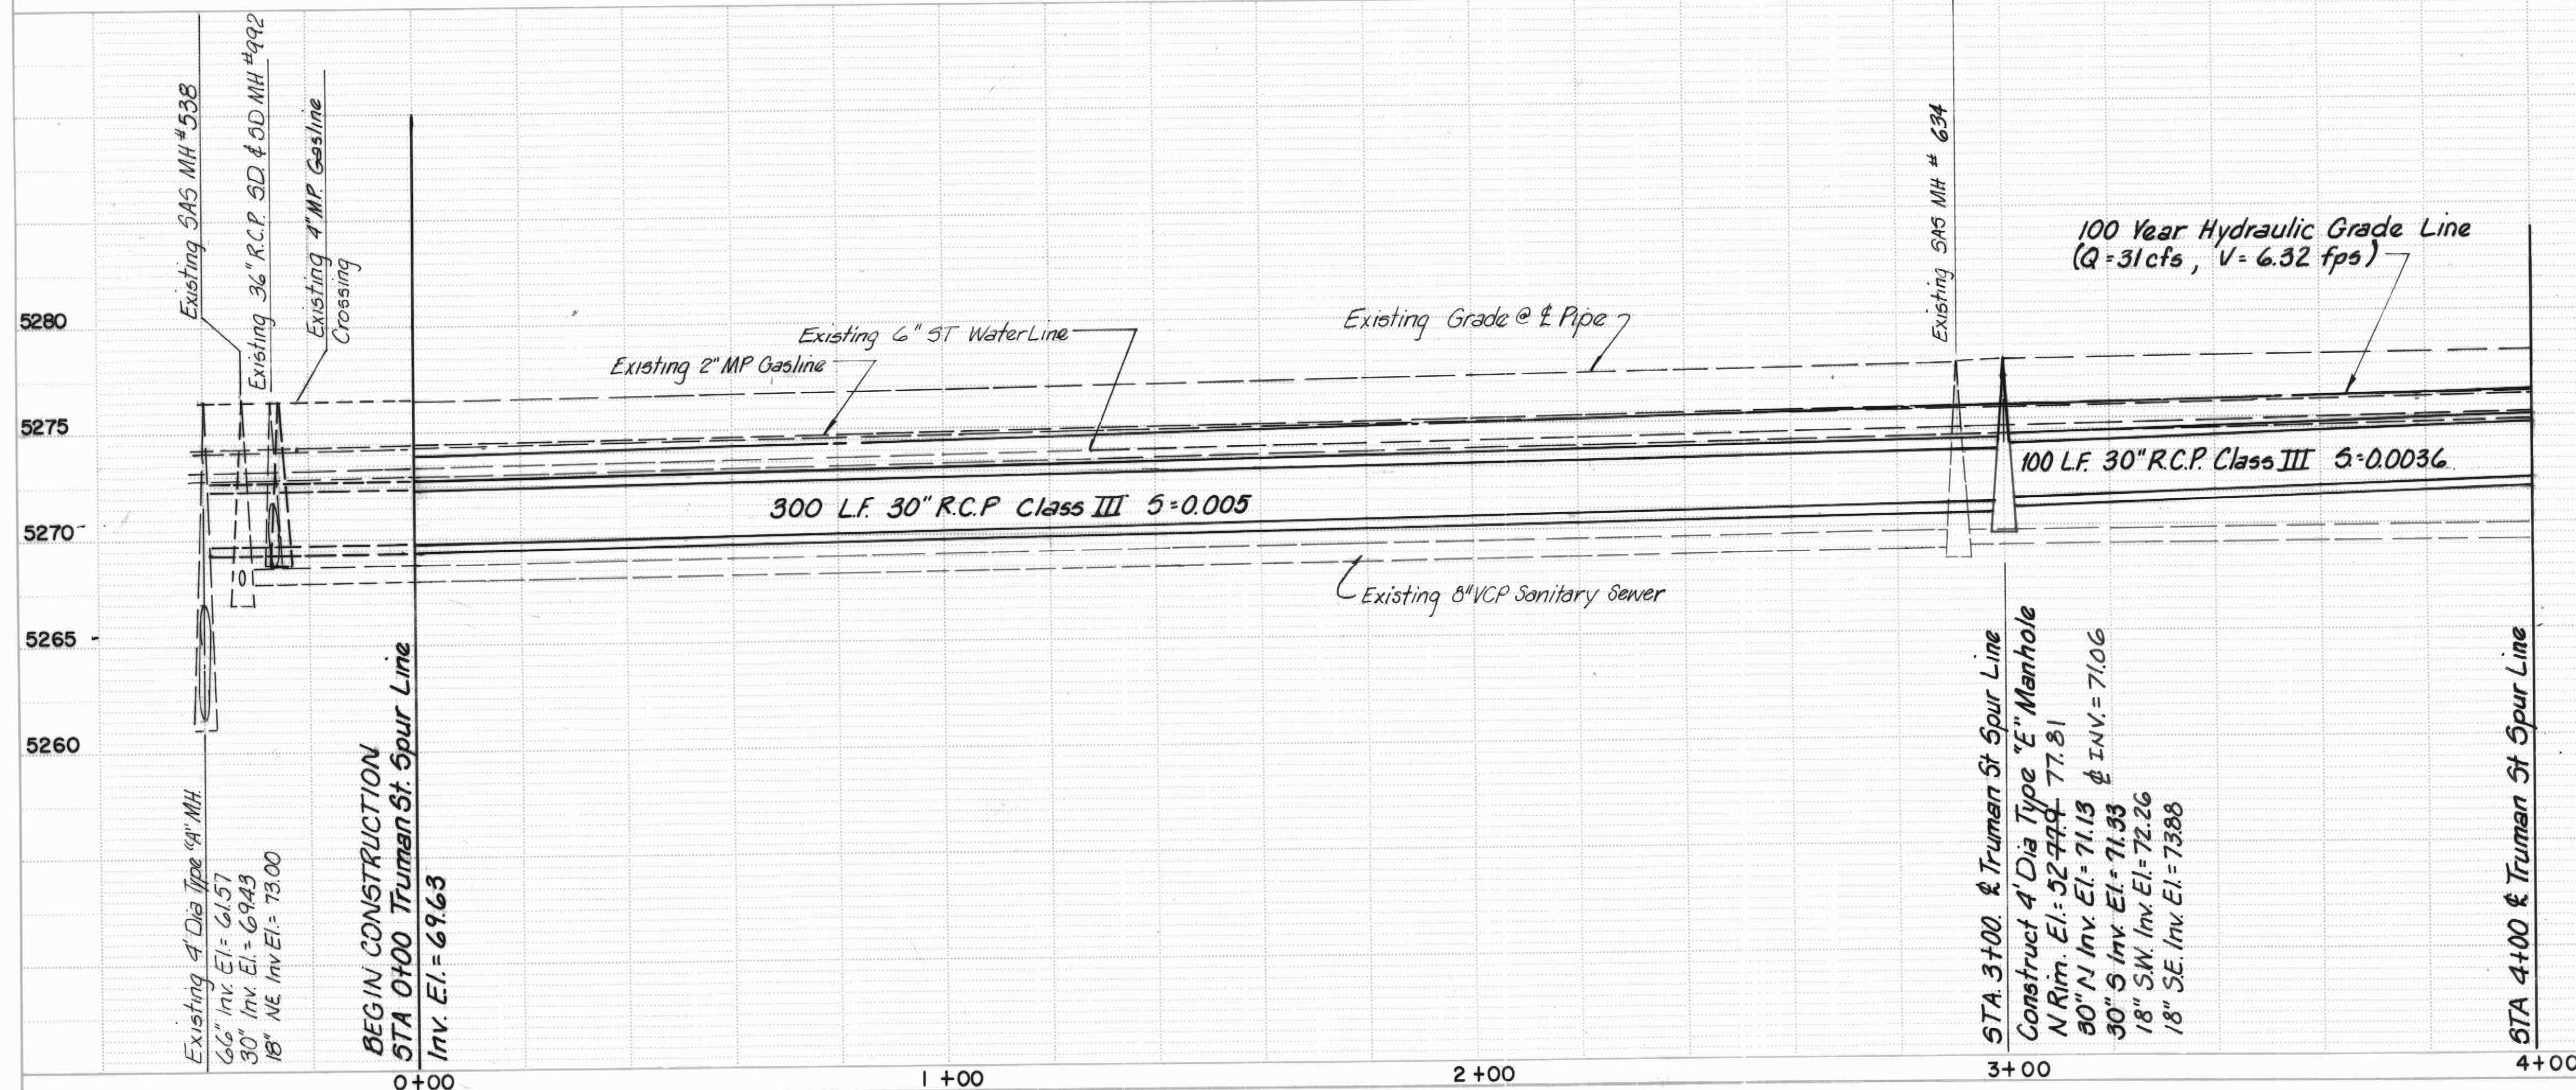

Existing Manhole Data
Existing Sanitary Sewer Manhole
L-173-634
Sta. 13+23.7 0.2' Rt & Svy
N. Rim El. = 77.85
8" N. Inv. El. = 69.12
8" S. Inv. El. = 69.06

NOTE:

- SEE GENERAL NOTES, SHEET 2, FOR DEFINITIONS OF CONSTRUCTION CONTROLS.

RECORD DRAWING

Date FEB. 10, 2005
These drawings have been revised based on field data and every reasonable attempt has been made to depict construction as actually performed.

ASCG
INCORPORATED

CITY OF ALBUQUERQUE
MUNICIPAL DEVELOPMENT DEPARTMENT
ENGINEERING DIVISION

TITLE: HIGHLAND DETENTION BASIN SYSTEM PHASE II B
STORM DRAIN PLAN AND PROFILE
TRUMAN ST. S.E. SPUR LINE
(STA 0+00 to STA. 4+00)

APPROVALS	ENGINEER	DATE	APPROVALS	ENGINEER	DATE
City Engineer	A	25 2003	Liquid Waste	A	25 2003
A.C.E. - Design			Traffic		
A.C.E. - Hydrology			Water		

DRAWING NO. 720391 MAP NO. L-17-S SHEET 9 OF 21



AS BUILT INFORMATION	
CONTRACTOR	NO.
WORK STARTED BY	DATE
FIELD ACCEPTANCE BY	DATE
FIELD REVISION BY	DATE
CORRECTED BY	DATE
RECORDED BY	DATE
NO.	

BENCH MARKS	
See Sheet 2 for Bench Mark Data	

SURVEY INFORMATION	
FIELD NOTES	DATE
NO.	BY



REVISIONS	
NO.	DATE
DESIGN	DATE Sept 1985
DRAWN BY JLB	DATE Sept 1985
CHECKED BY CD	DATE Sept 1985

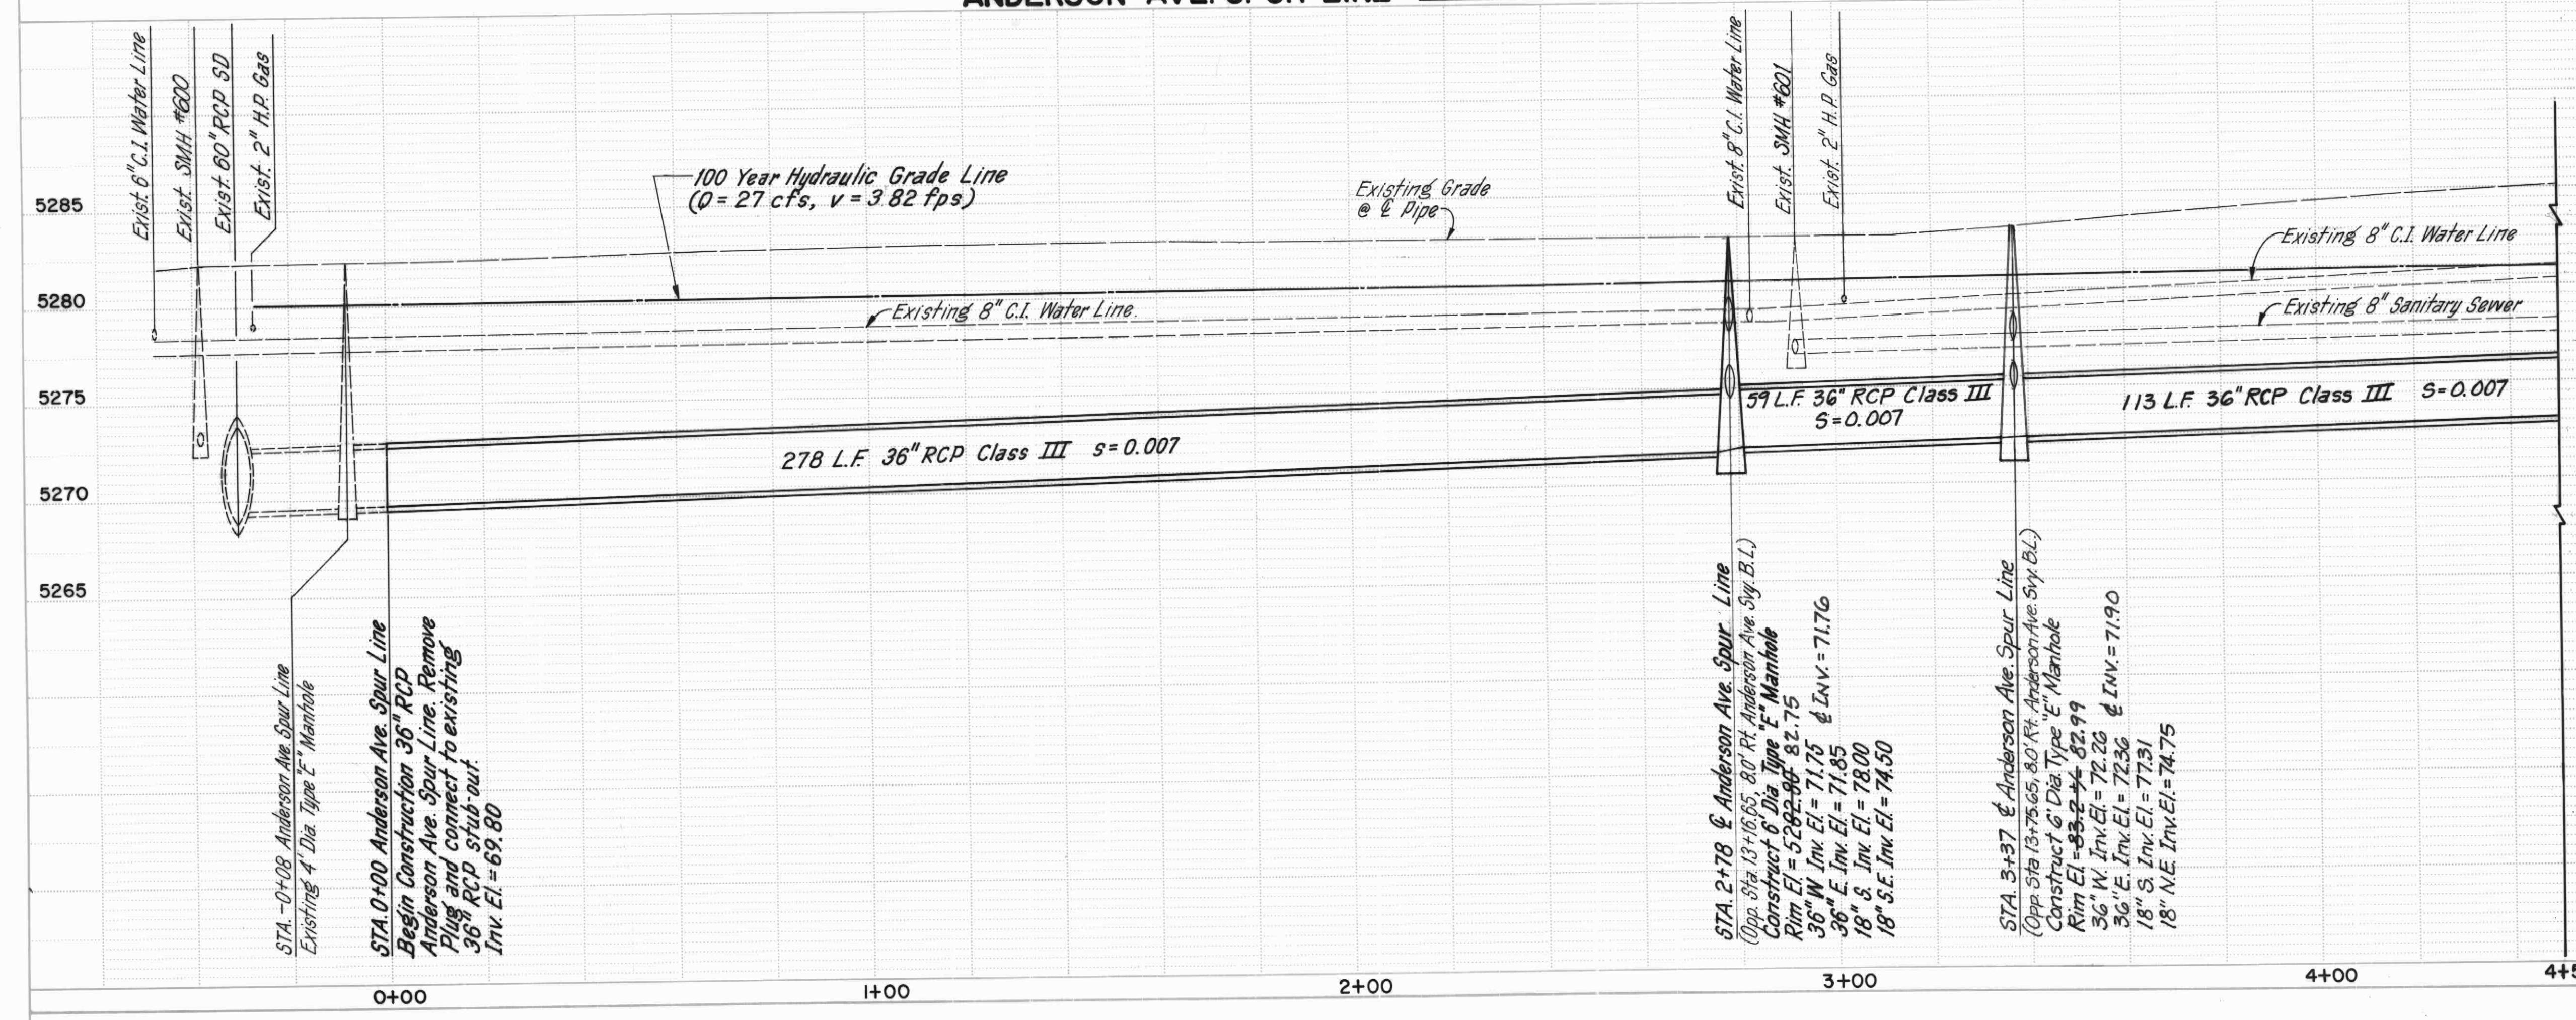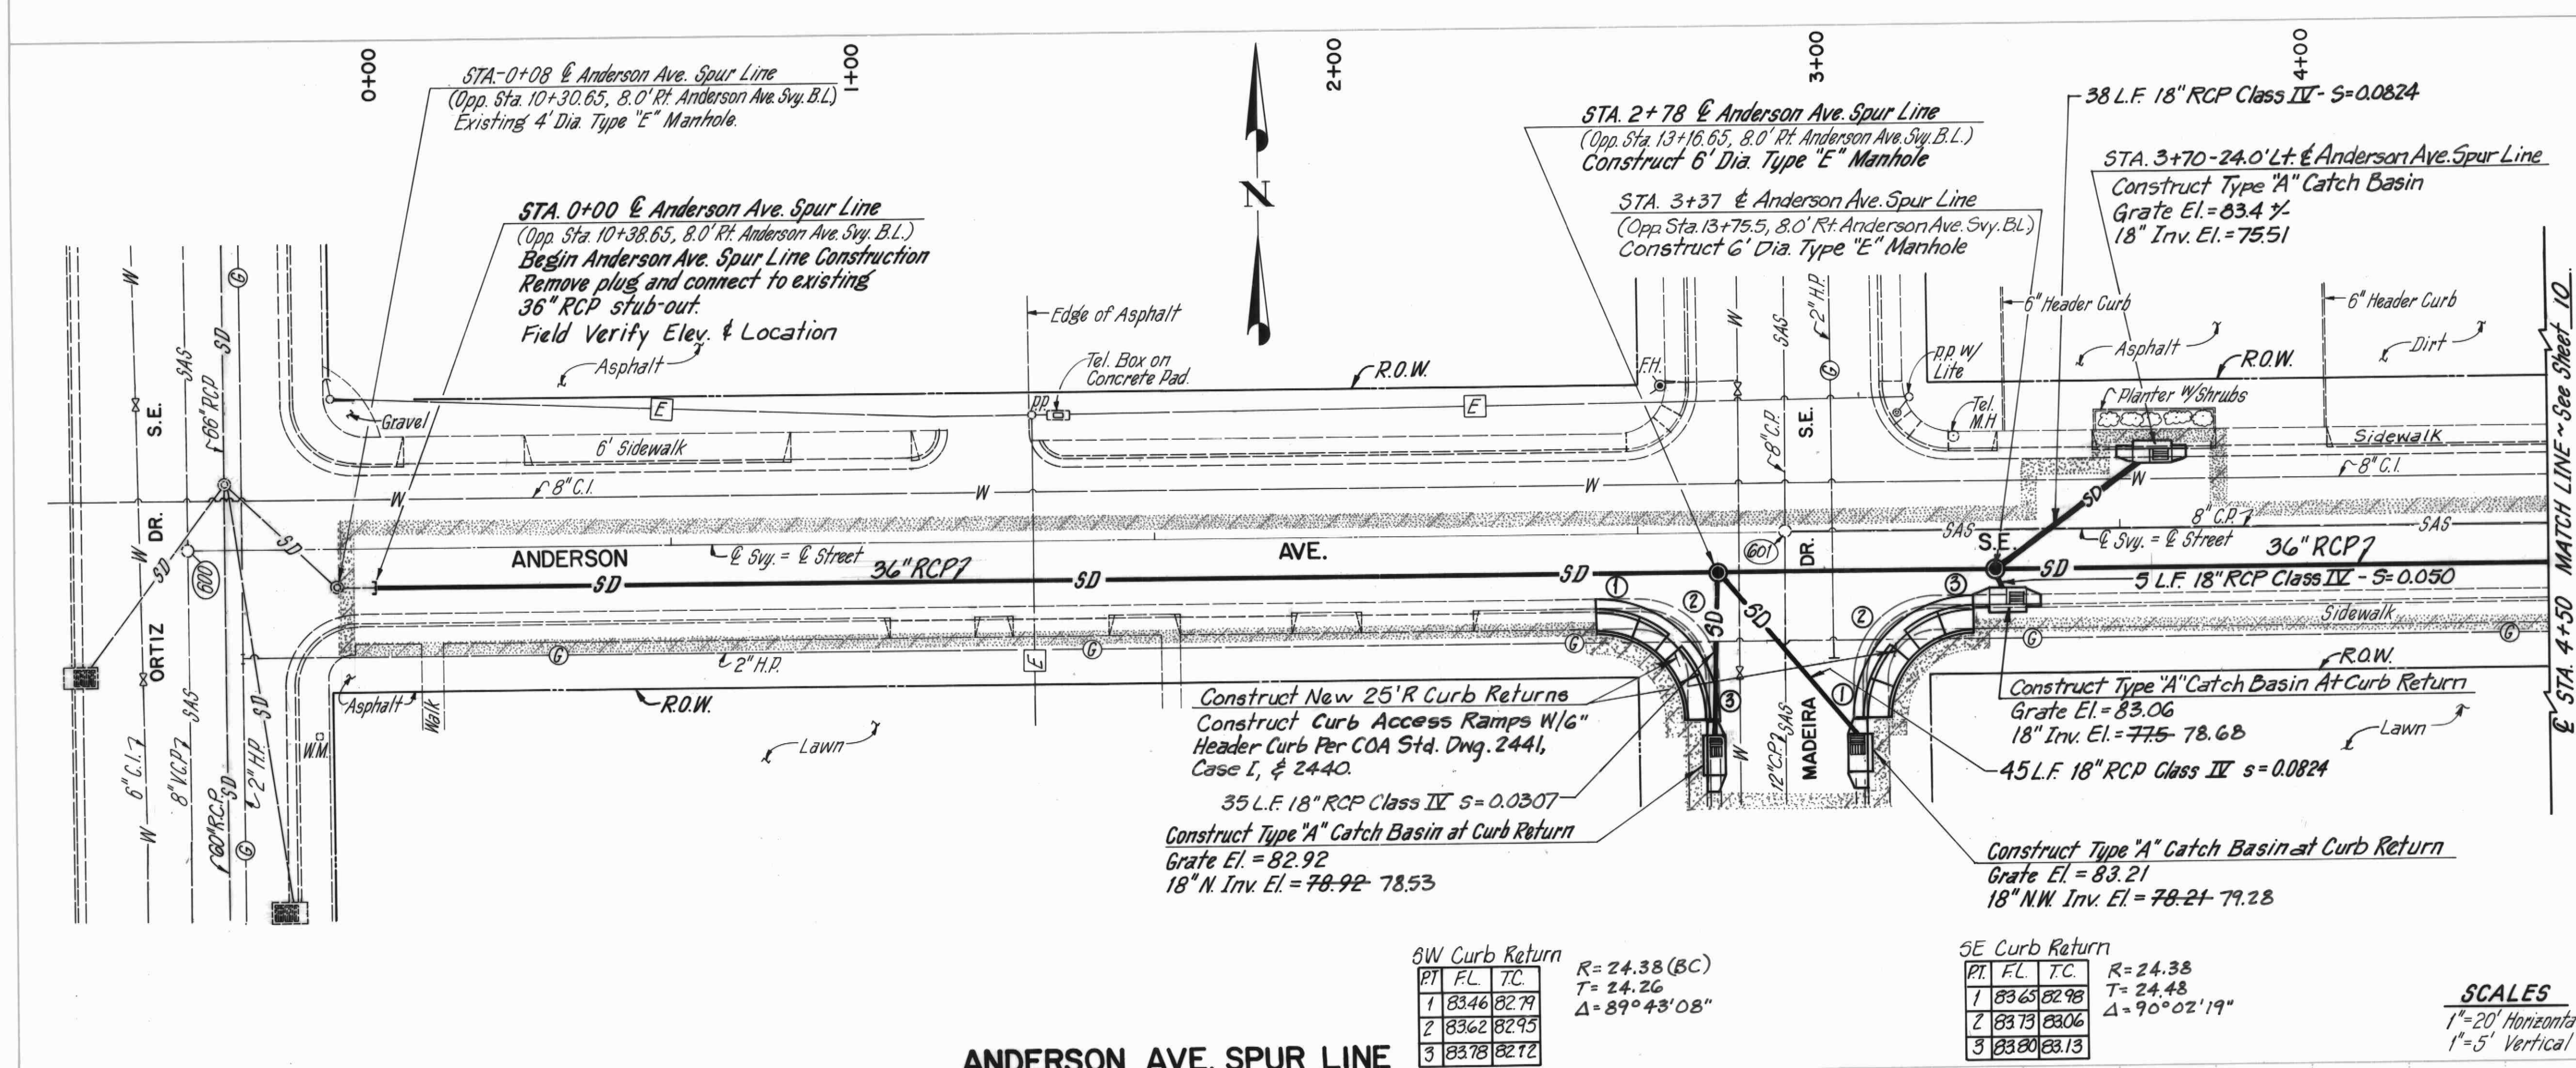

EXISTING MANHOLE DATA

Existing Sanitary Sewer Manhole

L-18-S 601

Sta. 13+30.4, 0.4' Lt. & Svy. B.L. (Anderson)

N. Rim El. = 82.60

8" N. Inv. El. = 76.68

12" S. Inv. El. = 76.67

8" E. Inv. El. = 76.87

NOTE:

1. SEE GENERAL NOTES, SHEET 2, FOR DEFINITIONS OF CONSTRUCTION CONTROLS.

RECORD DRAWING

Date **FEB. 10, 2005**

These drawings have been revised based on field data and every reasonable attempt has been made to depict construction as actually performed.

AS BUILT INFORMATION

CONTRACTOR	DATE	BY	NO.

ENGINEER'S SEAL

11/03

REGISTERED PROFESSIONAL ENGINEER

NO. DATE

REVISIONS

DESIGN

DATE

DESIGNED BY

DRAWN BY

CHECKED BY

ASC G

INCORPORATED

CITY OF ALBUQUERQUE

MUNICIPAL DEVELOPMENT DEPARTMENT

ENGINEERING DIVISION

TITLE: HIGHLAND DETENTION BASIN SYSTEM - PHASE III B

ANDERSON AVE. SPUR LINE

(STA. 0+00 TO STA. 4+50)

APPROVALS

City Engineer

A.C.E. - Design

A.C.E. - Hydrology

APPROVALS

Liquid Waste

Traffic


Water

CITY ENGINEER

DRAWING NO. **720391**

MAP NO. **L-18S**

SHEET **11** OF **21**

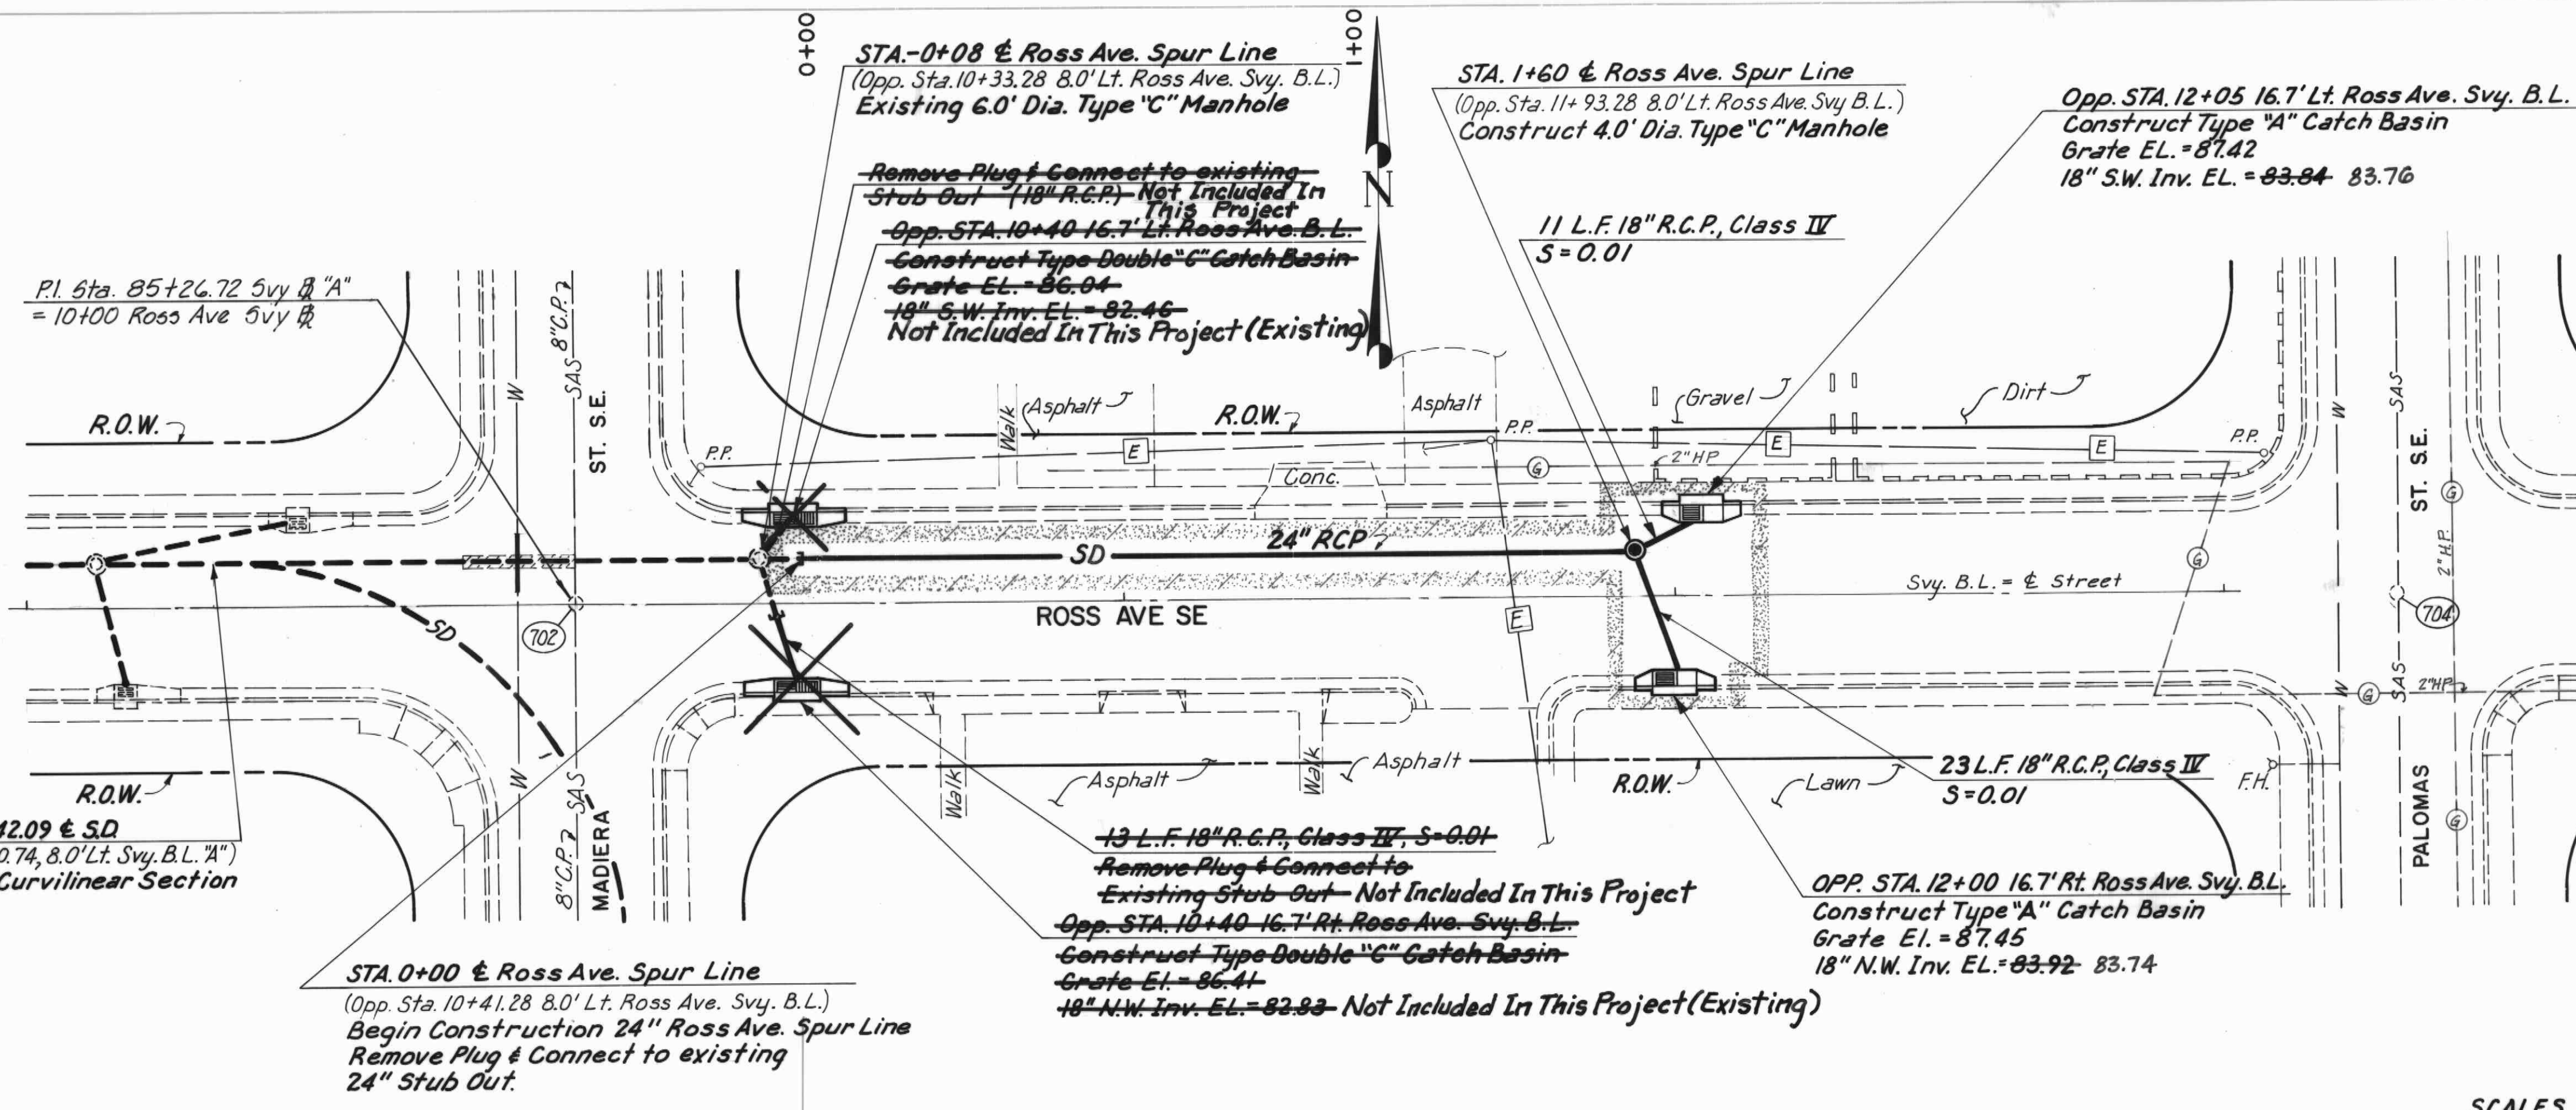

EXISTING MANHOLE DATA

Existing Sanitary Sewer Manhole


L-18S-702 - 4' Diameter
Sta. 10+00, 0.4' Lt. & Svy.
N. Rim EL. = 86.32
8" N. Inv. EL. = 79.33
8" S. Inv. EL. = 79.42

NOTE:

1. SEE GENERAL NOTES, SHEET 2, FOR DEFINITIONS OF CONSTRUCTION CONTROLS.

SCALES

1" = 20' Horizontal
1" = 5' Vertical

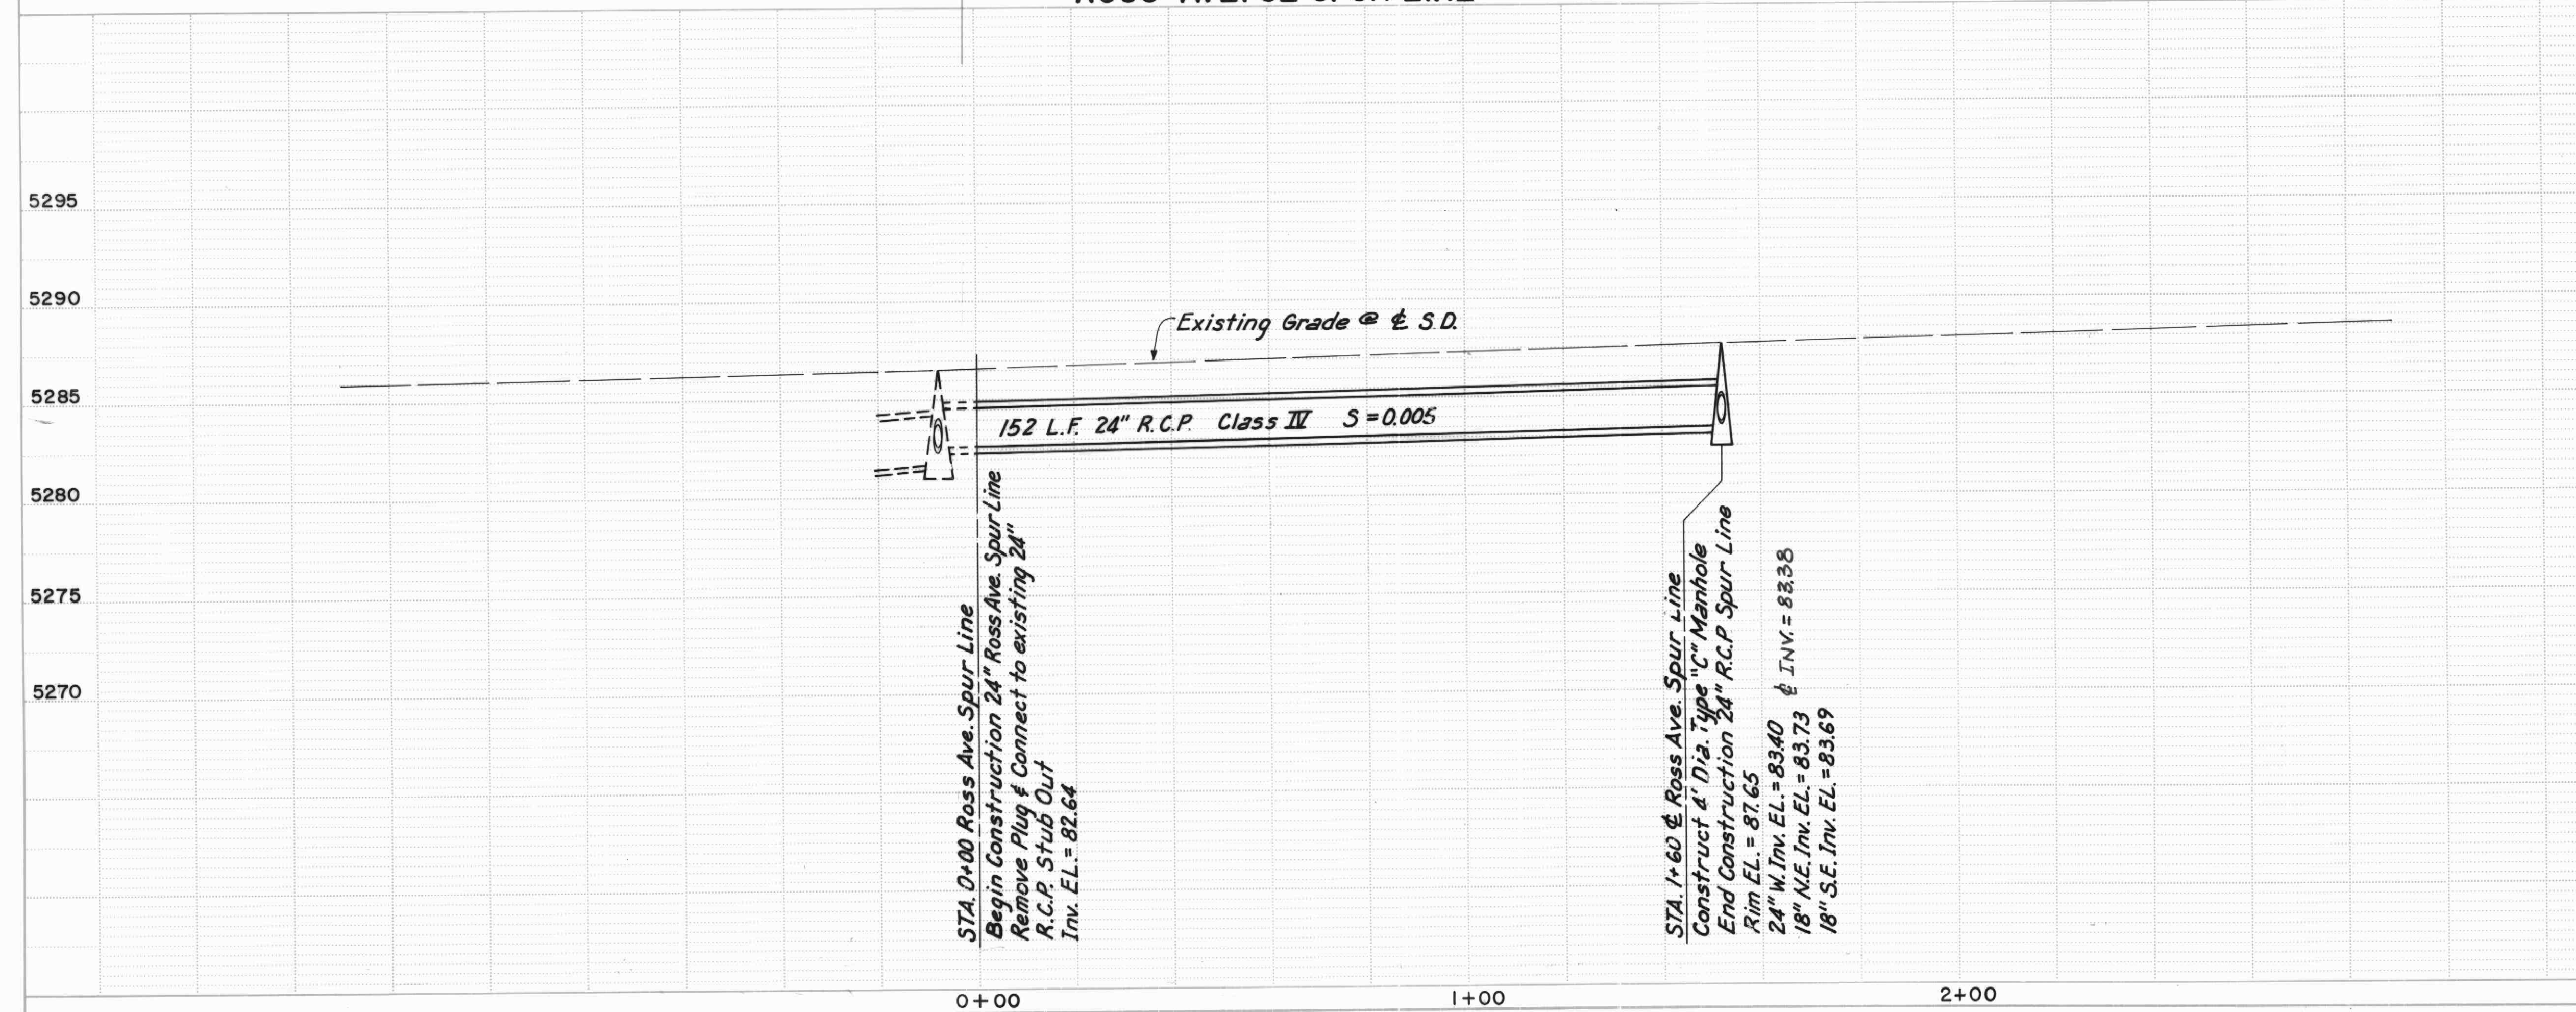

RECORD DRAWING

Date FEB. 10, 2005

These drawings have been revised based on field data and every reasonable attempt has been made to depict construction as actually performed.

ASCG
INCORPORATED


CITY OF ALBUQUERQUE
MUNICIPAL DEVELOPMENT DEPARTMENT
ENGINEERING DIVISION

TITLE: HIGHLAND DETENTION BASIN SYSTEM PHASE III B
STORM DRAIN PLAN AND PROFILE
ROSS AVE. SE SPUR LINE
(STA. 0+00 to STA. 1+60)

APPROVALS	REVISIONS	APPROVALS
City Engineer	DESIGN	City Engineer
A.C.E. - Design	DATE Sept. 1985	DATE Sept. 1985
A.C.E. - Hydrology	DRAWN BY S.L.B., J.A.E.	CHECKED BY C.D.
	DATE Nov. 1985	

DRAWING NO. 720391 MAP NO. L-18-S SHEET 12 OF 21

Construct 16' Driveway -
Hermosa Dr. to Parking Area.
Coordinate Location With
City Project Manager.

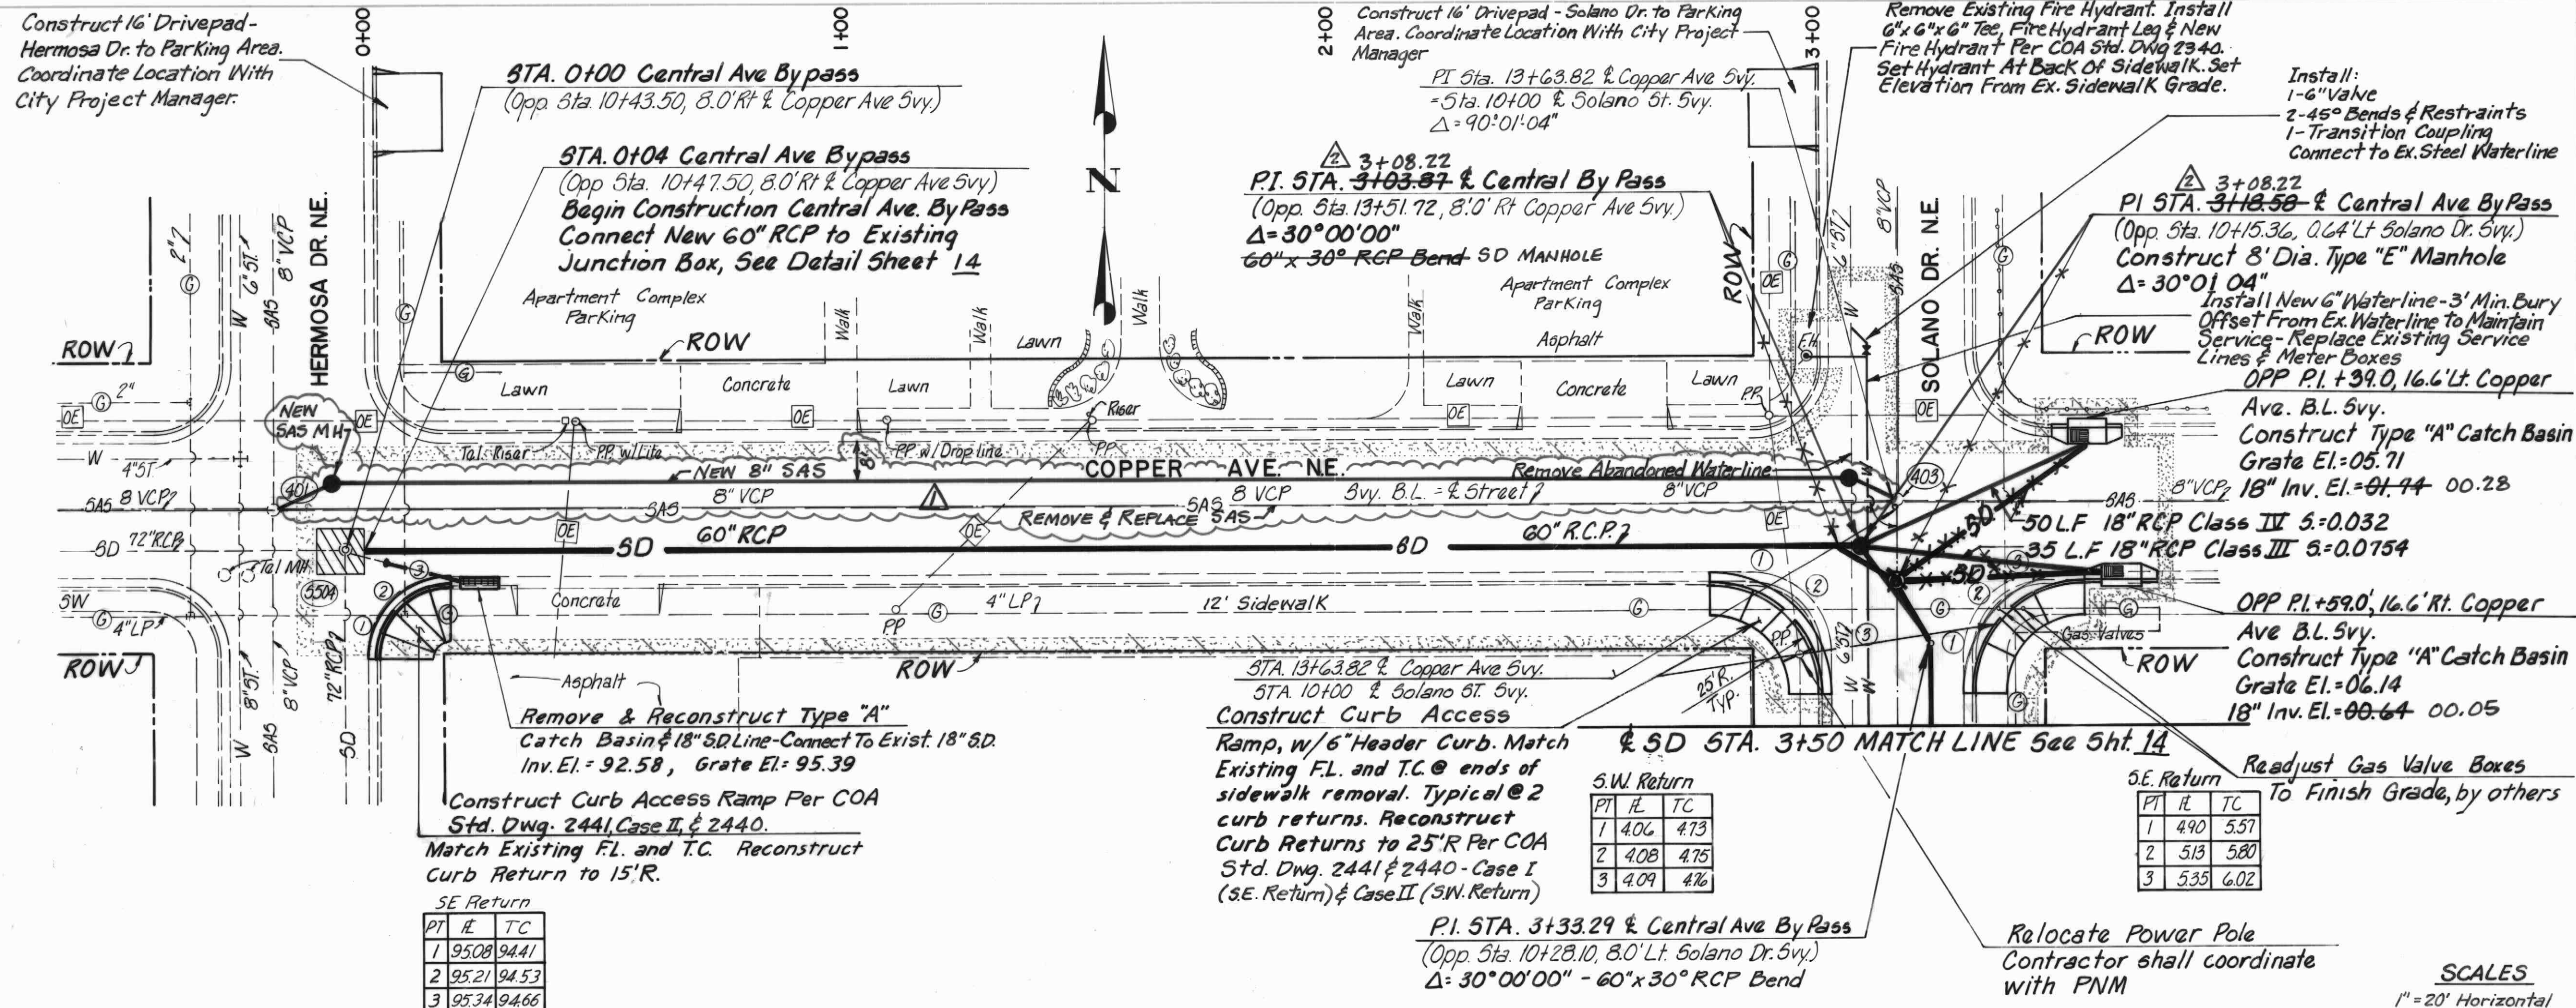


CENTRAL AVE BYPASS (COPPER AVE. NE.)

CENTRAL AVENUE UTILITY PLAN NOTE:

PRIOR TO BEGINNING CONSTRUCTION OF THE CENTRAL AVE. BYPASS PREPARE, SUBMIT, AND OBTAIN APPROVAL FROM THE CITY PROJECT MANAGER OF THE "CENTRAL AVE. UTILITY PLAN" (THE PLAN). IMPLEMENT AND CONSTRUCT THE PLAN TO MAINTAIN EXISTING UTILITY SERVICE DURING CONSTRUCTION. IDENTIFY AND SCHEDULE ALL UTILITY OUTAGES IN THE PLAN.

IDENTIFY IN THE CENTRAL AVE. UTILITY PLAN ALL UTILITIES AFFECTED BY THE CONSTRUCTION OF THE CENTRAL AVE. BYPASS AND THE UTILITY OWNER/OPERATOR. THIS INCLUDES THE CENTRAL AVE. AND SOLANO DR. INTERSECTION, THE COPPER AVE. AND HERMOSA DR. AND SOLANO DR. INTERSECTIONS AND THE REACHES BETWEEN THE INTERSECTIONS. IDENTIFY HOW THE CONTRACTOR WILL PROVIDE THE NECESSARY STRUCTURAL SUPPORT, BYPASS PUMPING, BYPASS PIPING, REMOVAL AND REPLACEMENT, SEQUENCE AND SCHEDULE OF CONSTRUCTION, AND OTHER RELEVANT INFORMATION FOR ALL CITY OWNED OR OPERATED UTILITIES. COORDINATE WITH NON-CITY UTILITIES AND INCLUDE IN THE PLAN.

PAYMENT FOR PREPARING, SUBMITTING, OBTAINING APPROVAL, IMPLEMENTING AND CONSTRUCTING THE "CENTRAL AVE. UTILITY PLAN" SHALL BE PAID AS A LUMP SUM INCLUDING SHOE-FLY AND BYPASS PIPING, REMOVAL AND REPLACEMENT OF EXISTING UTILITIES, TEMPORARY AND PERMANENT SUPPORT AND ALL INCIDENTALS. ADDITIONAL WORK REQUESTED BY THE CITY (FOR EXAMPLE, REPLACEMENT OF DETERIORATED LINES) WILL BE PAID FOR IN ACCORDANCE WITH THE CONTRACT DOCUMENTS. REMOVAL AND REPLACEMENT OF UTILITIES SPECIFICALLY IDENTIFIED IN THE CONSTRUCTION DOCUMENTS WILL BE PAID IN ACCORDANCE WITH THE BID PROPOSAL ITEMS.

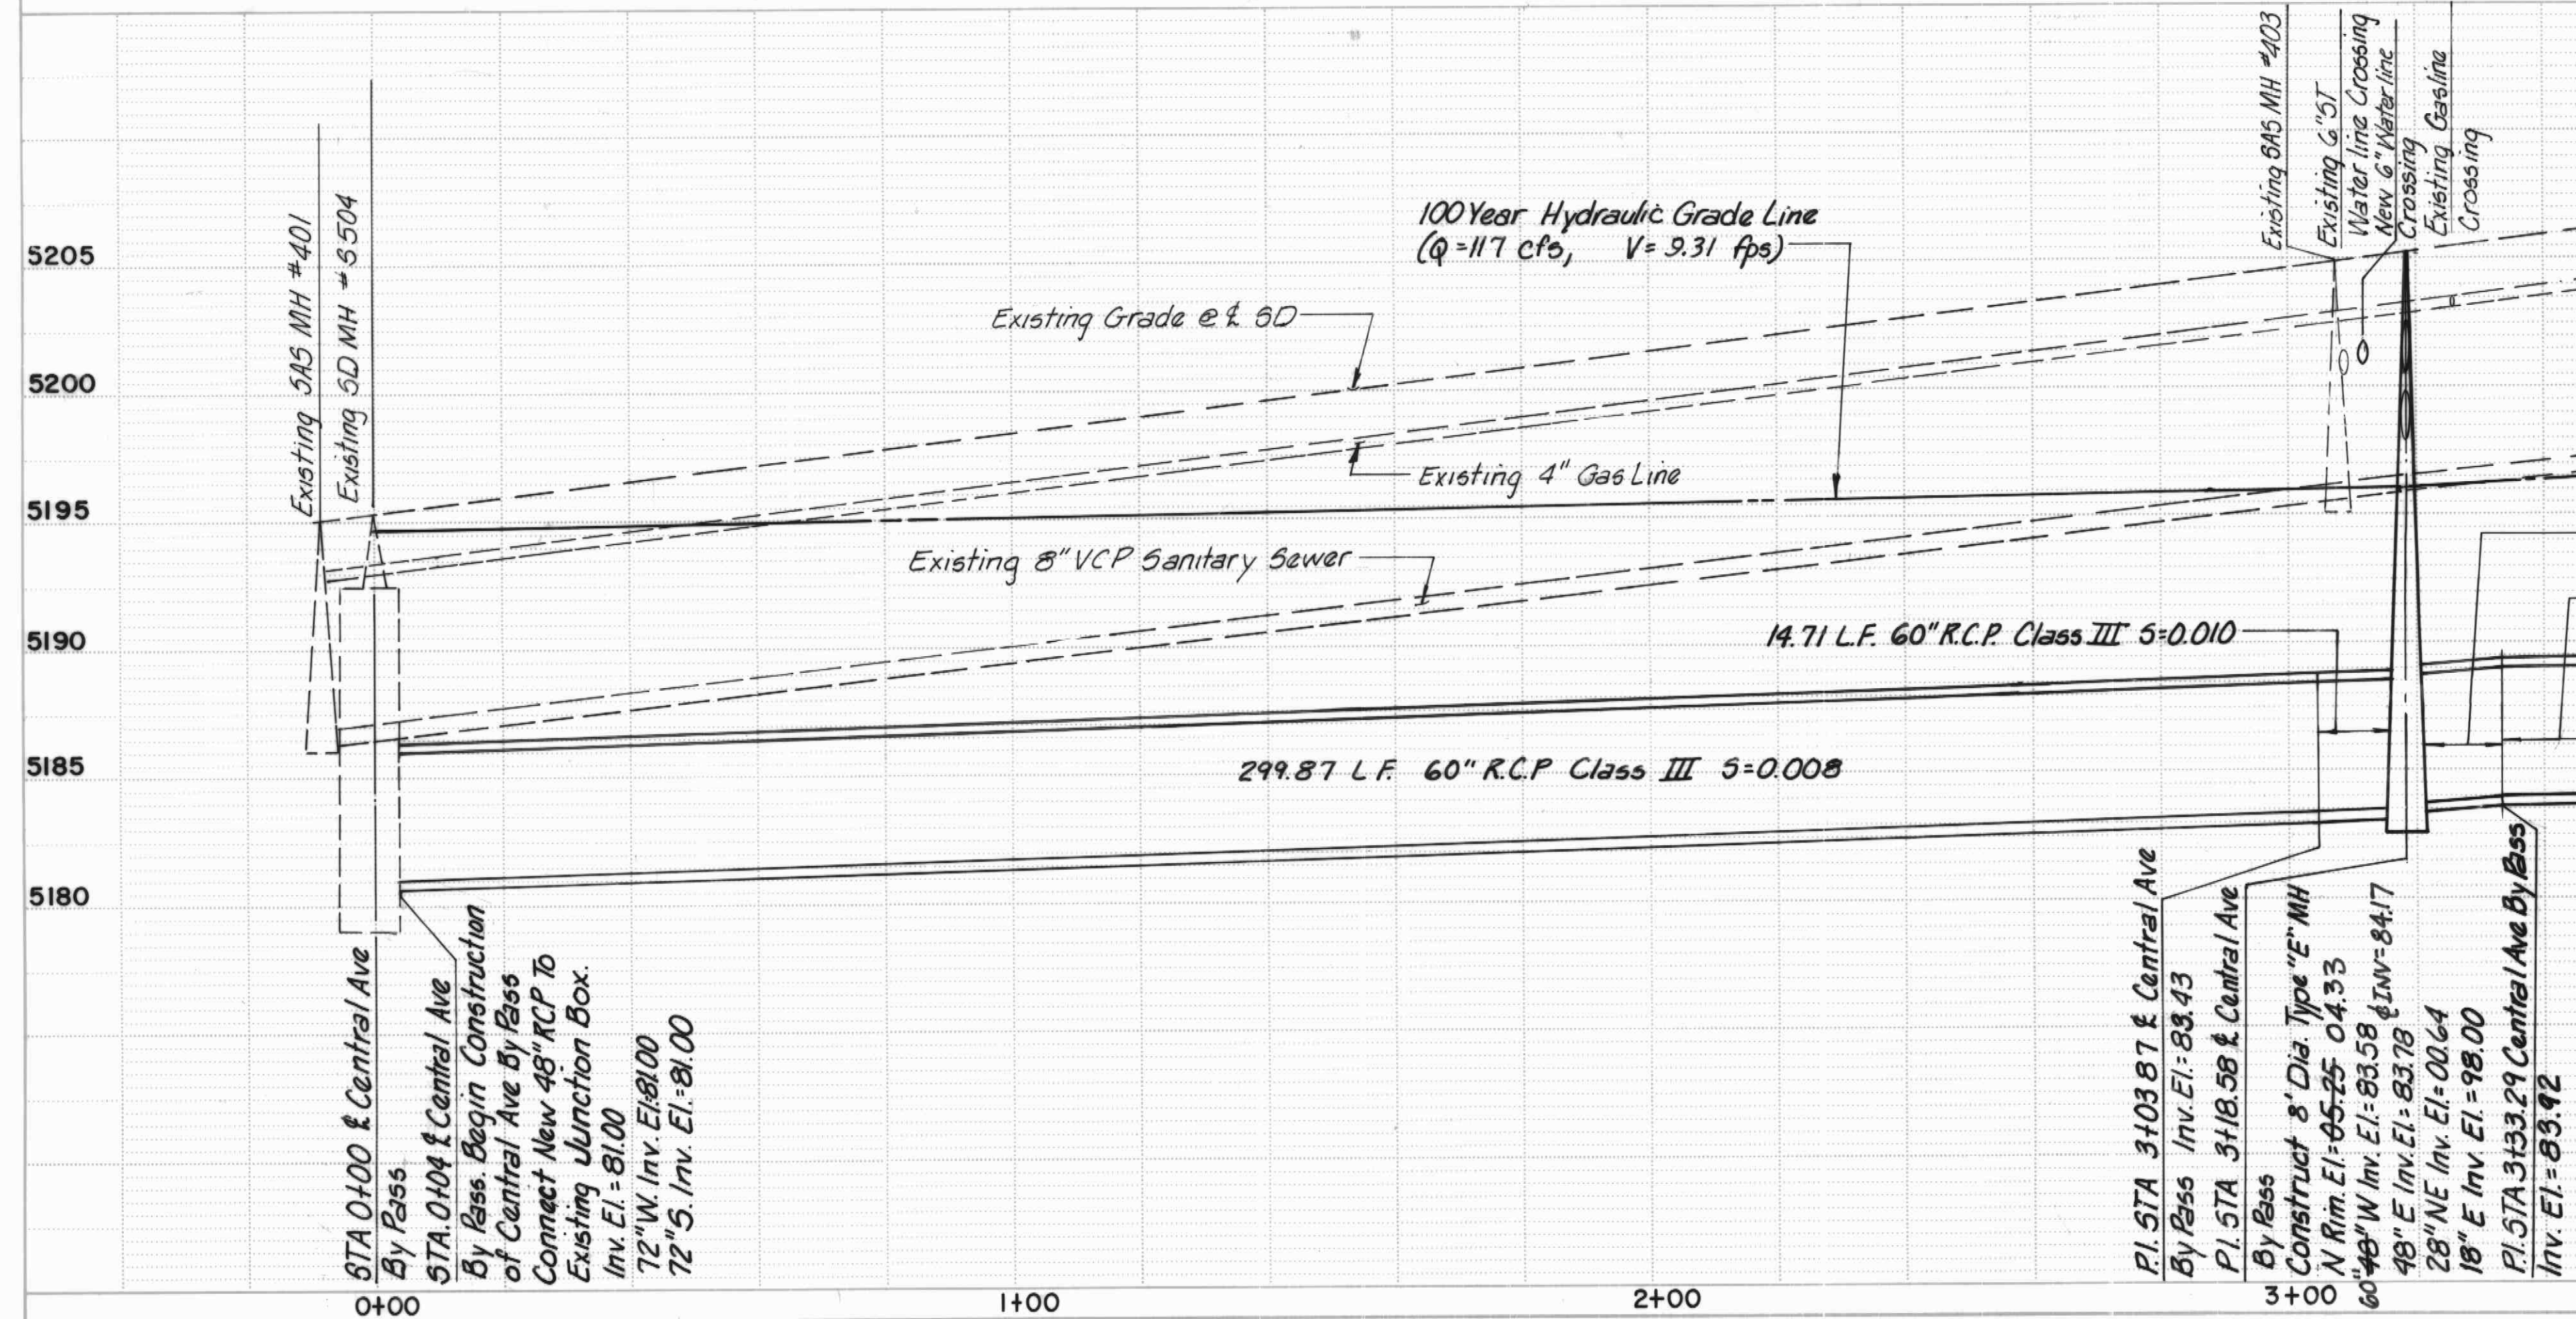

Existing Manhole Date
Existing Sanitary Sewer Manhole
K-175 401
Sta. 10+34.5, 0.3' Rt & 5vy
N. Rim. El. 95.06
8" W. Inv. El. 86.21
8" E. Inv. El. 86.27
8" N. Inv. El. 86.29, 91.06
8" S. Inv. El. 86.32

K-175 403
Sta. 13+64.3, 0.7' Lt & 3vy
N. Rim. El. 94.78
8" E. Inv. El. 96.29
8" W. Inv. El. 96.03
8" N. Inv. El. 96.16
8" S. Inv. El. 96.16

Existing Storm Sewer Manhole
K-175 5504
Sta. 10+43.5, 8.1' Rt & 5vy
N. Rim. El. 95.02
72" W. Inv. El. 81.00
72" S. Inv. El. 81.00
8E. Inv. El. 81.00

NOTE:

- SEE GENERAL NOTES, SHEET 2, FOR DEFINITIONS OF CONSTRUCTION CONTROLS.

SCALES
1" = 20' Horizontal
1" = 5' Vertical

RECORD DRAWING
Date: FEB. 10, 2005
These drawings have been revised based on field data and every reasonable attempt has been made to depict construction as actually performed.

ASCG
INCORPORATED

CITY OF ALBUQUERQUE
MUNICIPAL DEVELOPMENT DEPARTMENT
ENGINEERING DIVISION

TITLE: HIGHLAND DETENTION BASIN SYSTEM PHASE III B
STORM DRAIN PLAN AND PROFILE
CENTRAL AVE. BYPASS
(STA. 0+00 TO STA. 3+50)

APPROVALS	REVISIONS	DATE	BY
City Engineer	2/10/05 RELOCATE SD MANHOLE	2/10/05	JB
A.C.E. - Design	2/10/05 REMOVE/REPLACE SAS IN COPPER	2/10/05	JB
A.C.E. - Hydrology			

DRAWING NO. 720391 MAP NO. K-17-S SHEET 13 OF 21

CONSTRUCTION TRAFFIC CONTROL GENERAL NOTES

1. CONTRACTOR MUST OBTAIN FROM CONSTRUCTION COORDINATION AN EXCAVATION/BARRICADE PERMIT BEFORE ENGAGING IN ANY CONSTRUCTION, MAINTENANCE OR REPAIR WORK IN ANY OF THE CITY OF ALBUQUERQUE'S RIGHTS-OF-WAY. EMERGENCY WORK THAT WOULD PRESERVE LIFE OR PROPERTY IS EXCLUDED WITH THE UNDERSTANDING, THAT A PERMIT SHALL BE OBTAINED WITHIN 24 TO 48 HOURS.

2. CONTRACTOR SHALL AT THE TIME OF PERMIT REQUEST, SUBMIT FOR APPROVAL BY CONSTRUCTION COORDINATION, A TRAFFIC CONTROL PLAN DETAILING ALL EXISTING TOPOGRAPHY SUCH AS LANE WIDTHS, DRIVEWAYS, AND BUSINESS/RESIDENTIAL ACCESSES. THE TRAFFIC CONTROL PLAN SHALL INCLUDE ALL PHASES OF WORK AND SCHEDULES INVOLVED IN THE CONSTRUCTION PROJECT. ANY SEPARATE PHASES OF A CONSTRUCTION PROJECT SHALL BE GIVEN AN INDIVIDUAL PERMIT EACH. BLANKET PERMITS WILL NOT BE ISSUED.

3. THESE TYPICAL TRAFFIC CONTROL PLANS DO NOT REFLECT THE EXISTING TOPOGRAPHY SUCH AS DRIVEWAYS, LANE WIDTHS, AND BUSINESS/RESIDENTIAL ACCESSES. EVERY LOCATION THAT REQUIRES CONSTRUCTION TRAFFIC CONTROL SHALL HAVE A DETAILED TRAFFIC CONTROL PLAN SHOWING ALL EXISTING TOPOGRAPHY.

4. CONSTRUCTION SHALL NOT BEGIN UNLESS A TRAFFIC CONTROL PLAN HAS BEEN APPROVED AND VERIFIED BY CONSTRUCTION COORDINATION.

5. CONSTRUCTION COORDINATION SHALL BE NOTIFIED 48 HOURS PRIOR TO ANY TRAFFIC CONTROL CHANGES NEEDED BY CONTRACTOR, THAT WERE NOT PREVIOUSLY APPROVED. THESE TRAFFIC CONTROL CHANGES SHALL BE REQUESTED IN WRITING ACCOMPANIED WITH A TRAFFIC CONTROL PLAN REFLECTING SUCH CHANGES.

6. ALL CONSTRUCTION TRAFFIC CONTROL DEVICES SHALL COMPLY TO THE MANUAL ON UNIFORM TRAFFIC CONTROL DEVICES (MUTCD), LATEST EDITION. IT IS THE RESPONSIBILITY OF THE CONTRACTOR TO INSTALL, SERVICE AND MAINTAIN ALL TRAFFIC CONTROL DEVICES. TRAFFIC CONTROL DEVICES SHALL NOT BE REMOVED OR ALTERED IN ANY WAY WITHOUT THE APPROVAL OF CONSTRUCTION COORDINATION, PER SECTION 6A-4 OF THE MUTCD, LATEST EDITION.

7. THE CONSTRUCTION TRAFFIC CONTROL INITIAL SET-UP SHALL BE BY AN AMERICAN TRAFFIC SAFETY SERVICES ASSOCIATION (ATSSA) CERTIFIED WORKSITE TRAFFIC SUPERVISOR. THE MAINTENANCE AND SERVICING SHALL ALSO BE DONE BY AN ATSSA CERTIFIED WORKSITE TRAFFIC SUPERVISOR OR EQUIVALENT.

8. CONTRACTOR IS RESPONSIBLE TO MAINTAIN AND SERVICE ALL TRAFFIC CONTROL DEVICES 24 HOURS A DAY, 7 DAYS A WEEK THROUGHOUT LENGTH OF PROJECT. CONTRACTOR IS RESPONSIBLE THAT ALL TRAFFIC CONTROL DEVICES COMPLY WITH THE MUTCD, LATEST EDITION.

9. ALL ADVANCE WARNING SIGNS SHALL BE DOUBLE INDICATED WHENEVER THERE ARE MULTI-LANE TRAFFIC IN ANY ONE GIVEN DIRECTION AND THERE IS SUFFICIENT MEDIAN SPACE.

10. ALL BARRICADES IN ALL TAPERS AND TANGENTS SHALL BE PLACED APART, A DISTANCE MEASURED IN FEET, EQUAL TO THAT OF THE POSTED SPEED LIMIT. NO EXCEPTIONS UNLESS APPROVED BY CONSTRUCTION COORDINATION PER MUTCD SECTION 6A-4.

11. ALL WORK IN ARTERIAL ROADWAYS SHALL BE ON A CONTINUOUS 24 HOUR PER DAY BASIS UNTIL COMPLETED.

12. CONTRACTOR IS RESPONSIBLE TO PROVIDE CONSTRUCTION COORDINATION, A WEEKLY LOG OF DAILY INSPECTIONS OF BARRICADE AND MAINTENANCE SCHEDULES ON PROJECTS THAT ARE OVER ONE WEEK DURATION.

13. EQUIPMENT OR MATERIALS SHALL NOT BE STORED WITHIN 15 FEET OF A TRAVELED TRAFFIC LANE DURING NON-WORKING HOURS WITHOUT THE APPROVAL OF CONSTRUCTION COORDINATION.

14. CONTRACTOR SHALL PROVIDE AND MAINTAIN A SAFE AND ADEQUATE MEANS OF CHANNELIZING PEDESTRIAN TRAFFIC AROUND AND THROUGH THE CONSTRUCTION AREA.

15. CONTRACTOR IS RESPONSIBLE FOR OBLITERATION OF ANY CONFLICTING STRIPING AND RESPONSIBLE FOR ALL TEMPORARY STRIPING.

16. CONTRACTOR SHALL MAINTAIN ACCESS TO ALL FACILITIES, BUSINESSES AND/OR RESIDENTS AT ALL TIMES.

17. CONTRACTOR SHALL PROVIDE ACCESS SIGNS FOR BUSINESSES LOCATED WITHIN THE CONSTRUCTION AREA UNDER THE SUPERVISION OF CONSTRUCTION COORDINATION. EACH ACCESS SIGN SHALL HAVE 5 INCH, WHITE OPAQUE LETTERING ON BLUE REFLECTORIZED BACKGROUND. ACCESS SIGNS SHALL BE CONSIDERED INCIDENTAL TO THE BID AND NOT PART OF THE CONTRACT UNLESS OTHERWISE STATED. NO MORE THAN 3 BUSINESSES SHALL BE LISTED ON A ACCESS SIGN. SHOPPING CENTERS AND MALLS SHALL BE LISTED AS SUCH.

18. ALL ADVANCE WARNING SIGNS SHALL MEET THE MINIMUM REFLECTIVE INTENSITY REQUIREMENTS SET FORTH BY THE CITY OF ALBUQUERQUE. CONSTRUCTION COORDINATION SHALL DETERMINE ALL REQUIREMENTS AND APPROVE OR DISAPPROVE ANY ADVANCE WARNING SIGN PER SECTION 6A-4 OF THE MUTCD, LATEST EDITION.

19. 48 HOURS PRIOR TO OCCUPANCY OR CLOSING OF A RIGHT-OF-WAY, CONTRACTOR SHALL NOTIFY: POLICE, FIRE DEPARTMENT, SCHOOLS, HOSPITALS, TRANSIT AUTHORITY, BUSINESSES AND/OR RESIDENTS THAT WILL BE AFFECTED BY THE CONSTRUCTION.

20. ANY FIELD ADJUSTMENTS SHALL BE APPROVED BY CONSTRUCTION COORDINATION.

21. EXCAVATIONS SHALL BE PLATED, TEMPORARILY PATCHED OR RESURFACED PRIOR TO OPENING OF TRAFFIC. A MINIMUM OF 11 FEET SHALL BE PROVIDED FOR TRAFFIC IN ANY GIVEN DIRECTION. CONTRACTOR IS RESPONSIBLE FOR ANY WORK INVOLVED IN SATISFYING THESE REQUIREMENTS.

22. CONTRACTOR SHALL AT ALL TIMES COMPLY WITH THE FOLLOWING:
1. STANDARDS AND REQUIREMENTS SET FORTH IN THE MANUAL ON UNIFORM TRAFFIC CONTROL DEVICES, LATEST EDITION.
2. THE CITY OF ALBUQUERQUE TRAFFIC CODE, LATEST EDITION.
3. SECTION 19 OF THE CITY OF ALBUQUERQUE'S STANDARD SPECIFICATIONS FOR PUBLIC WORK CONSTRUCTION, AS WELL AS OTHER SECTIONS.

23. FAILURE TO COMPLY WITH ANY OF THE ABOVE MENTIONED, WILL BE ADEQUATE CAUSE TO CEASE ALL WORK ON ANY CONSTRUCTION PROJECT. WORK WILL NOT RESUME UNTIL ALL REQUIREMENTS ARE ADDRESSED AND APPROVED BY CONSTRUCTION COORDINATION.

24. ALL TRAFFIC CONTROL DEVICES SHALL BE KEPT IN NEW-CLEAN CONDITION, WASHING OF EQUIPMENT IS INCIDENTAL TO ITS PLACEMENT AND MAINTENANCE.



25. TRAFFIC CONTROL STANDARDS APPLY ONLY WHERE THE CONSTRUCTION TRAFFIC CONTROL PLANS ARE NOT SPECIFIC.

33. ADVANCE WARNING SIGNS SHALL BE 36"x36" MIN. WITH SUPER ENGINEERING GRADE SHEETING OR BETTER. MOUNTING HEIGHT AT TOP OF SIGN SHALL BE THE SAME AS FOR A 48" SIGN AS INDICATED IN THE M.U.T.C.D.


27. CONTRACTOR SHALL MAINTAIN A GRAFFITI-FREE WORKSITE. ALL GRAFFITI SHALL BE PROMPTLY REMOVED FROM ALL EQUIPMENT, BOTH PERMANENT AND TEMPORARY.

TAPER CRITERIA	
TYPE OF TAPER	TAPER LENGTH
UPSTREAM TAPER:	
MERGING TAPER	L MINIMUM
SHIFTING TAPER	1/2 L MINIMUM
SHOULDER TAPER	1/2 L MINIMUM
TWO-WAY TRAFFIC TAPER	100 FEET MAXIMUM
DOWNSTREAM TAPERS	100 FEET PER LANE

TAPER LENGTH COMPUTATION	
SPEED LIMIT	
40 MPH OR LESS	$L = \frac{W \cdot S^2}{80}$
40 MPH OR GREATER	$L = W \times S$
L = TAPER LENGTH	
W = WIDTH OF OFFSET IN FEET	
S = POSTED SPEED OR OFF-PEAK 85-PERCENTILE SPEED IN MPH	

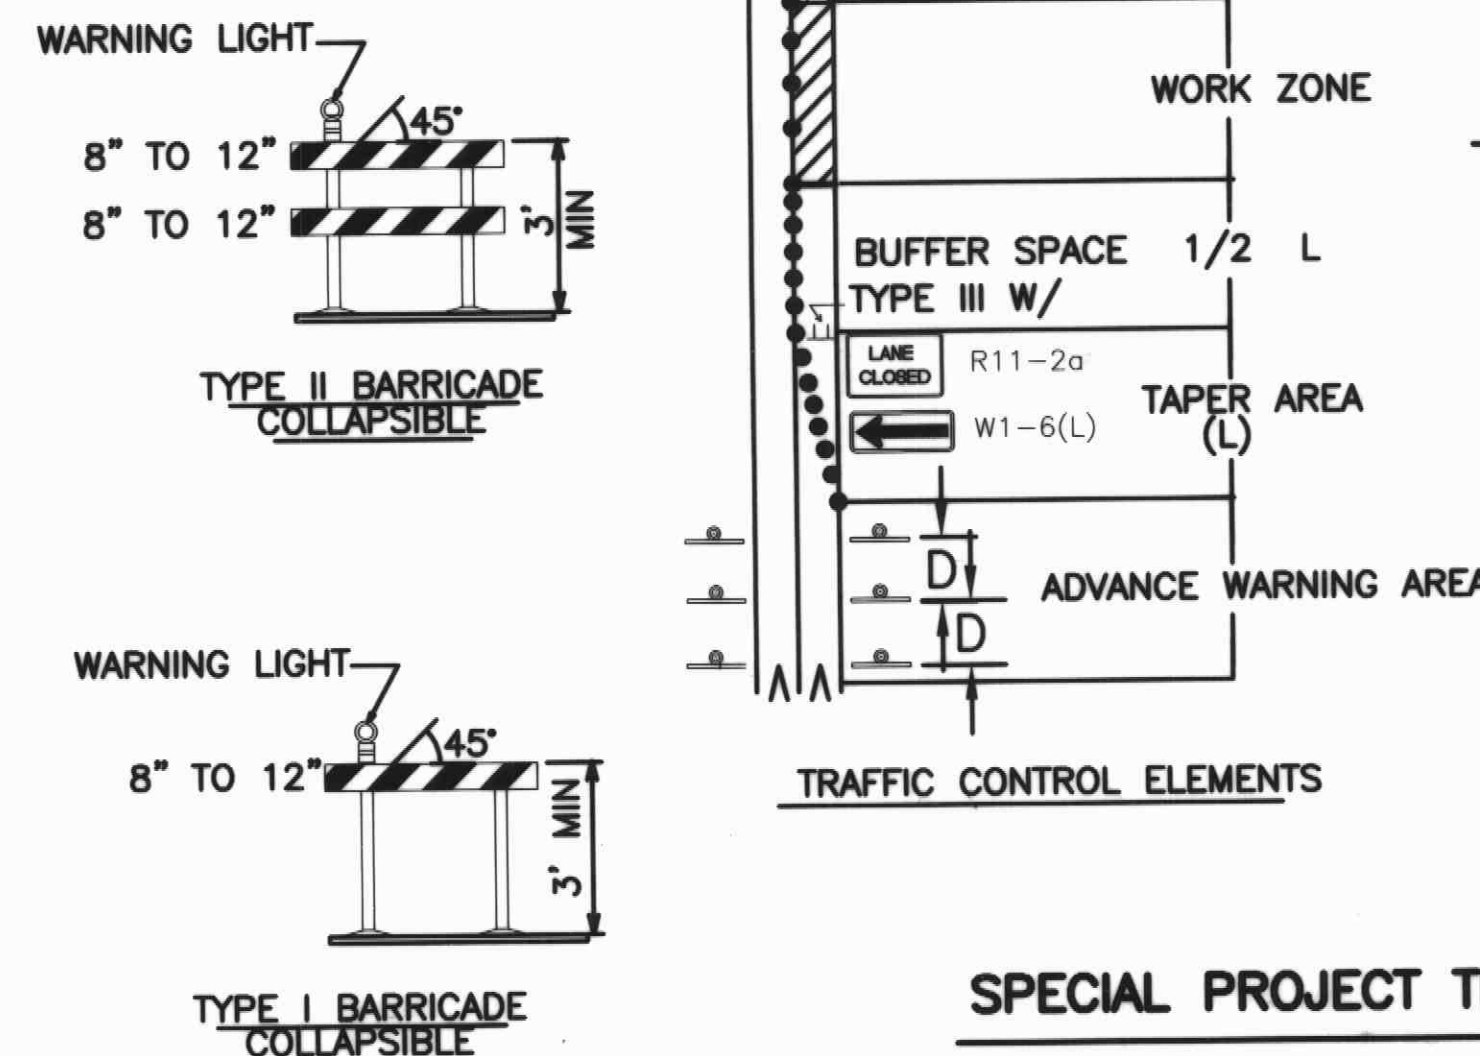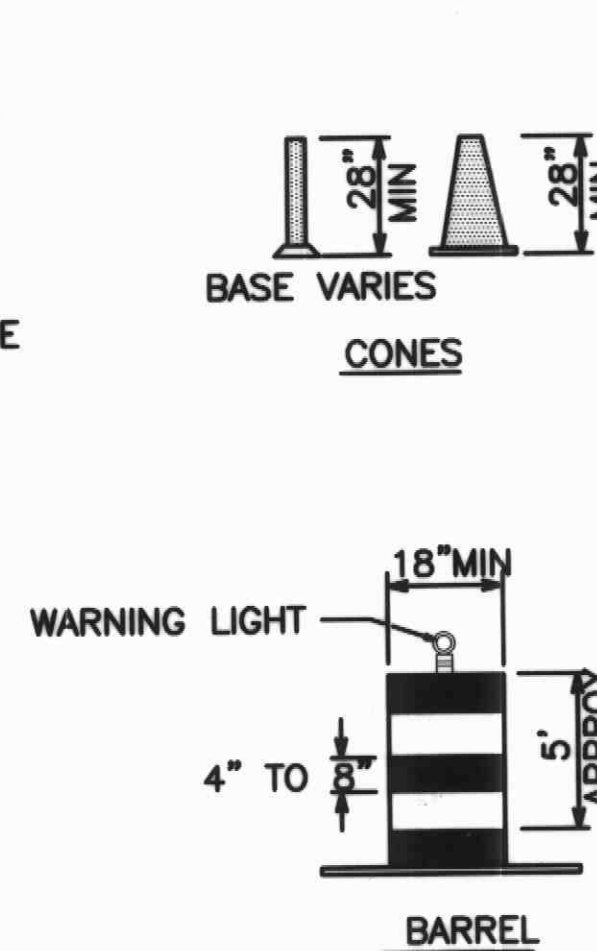

SIGN FACE DETAILS

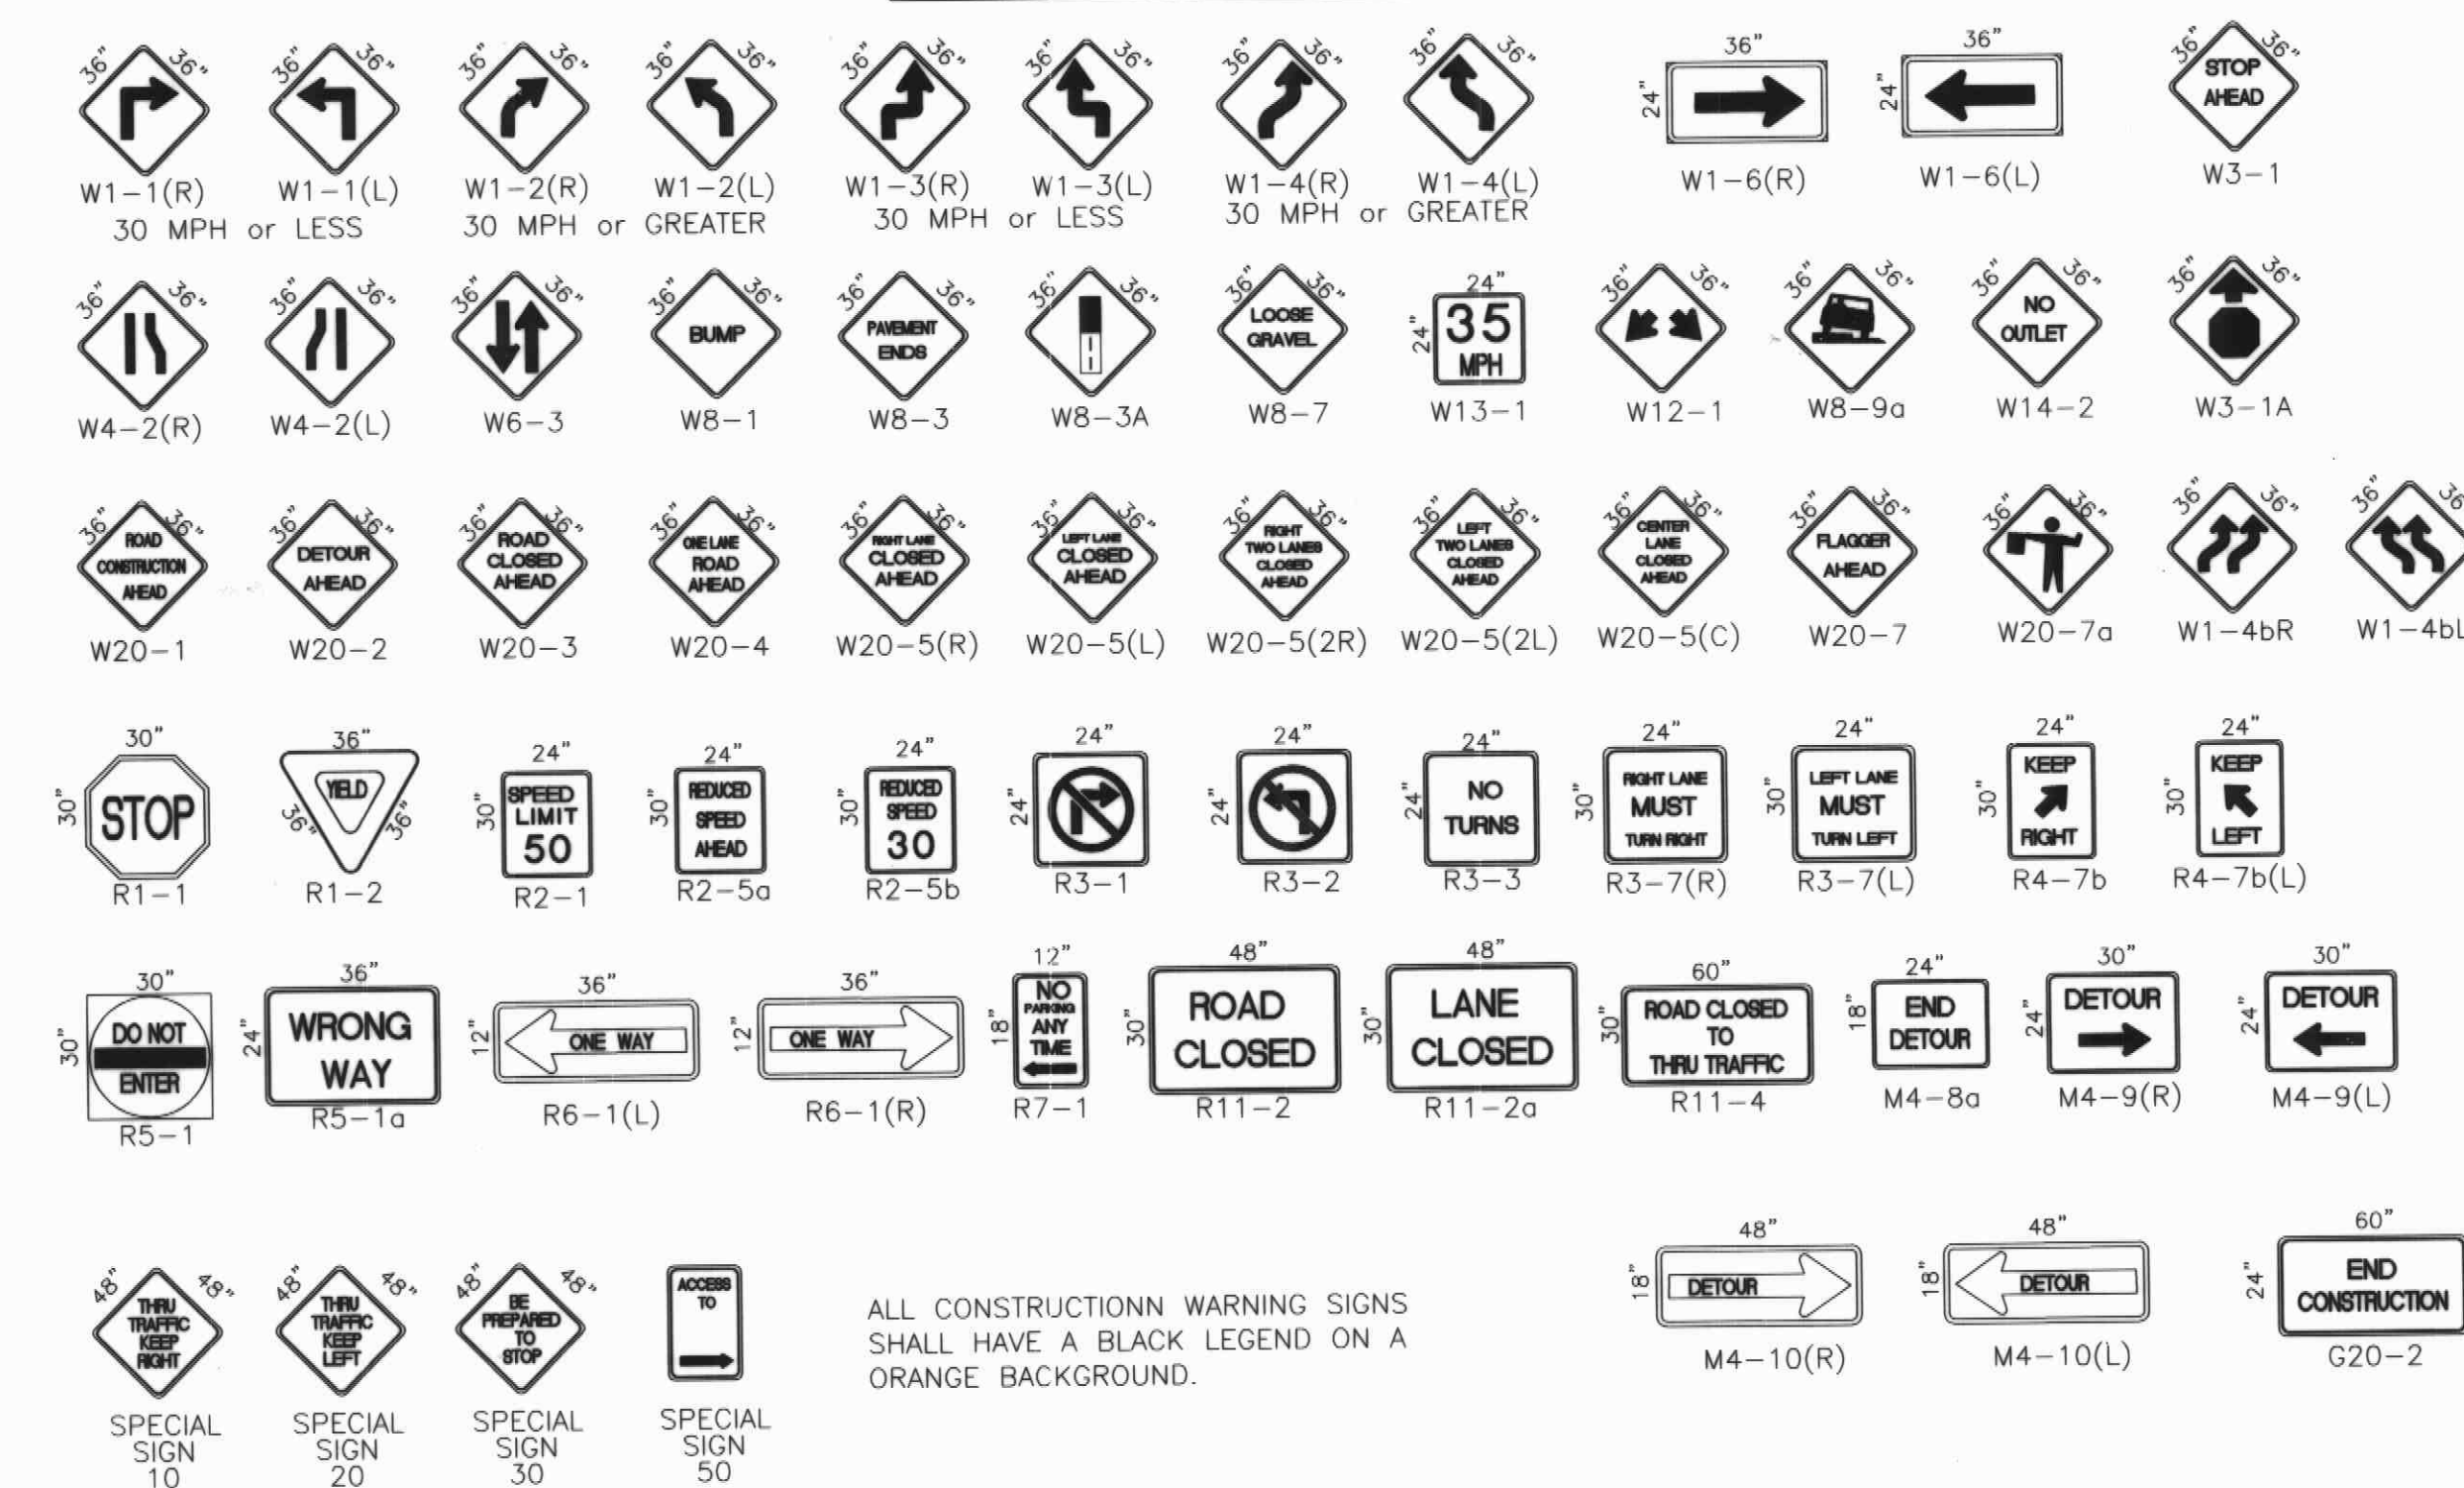

ALL CONSTRUCTION WARNING SIGNS SHALL HAVE A BLACK LEGEND ON A ORANGE BACKGROUND.

LEGEND

- WORK AREA
- BARRICADE - TYPE I, TYPE II, OR BARREL
- BARRICADE - TYPE III
- VERTICAL PANEL
- WARNING SIGN
- DISTANCE BETWEEN SIGNS - A DISTANCE MEASURED IN FEET EQUAL TO A VALUE OF TEN TIMES THE SPEED LIMIT OF THE STREET
- FLAGMAN POSITION
- SPACING BETWEEN BARRICADES - A DISTANCE MEASURED IN FEET EQUAL TO THE STREET LIMIT OF THE STREET
- TAPER LENGTH - SEE CHART BELOW

THE TANGENT LENGTH IS EQUAL TO THE TAPER LENGTH FOR A GIVEN STREET.

TAPER REQUIREMENT

SPEED LIMIT (MPH)	TAPER LENGTH (L) (FEET)			MINIMUM NUMBER OF DEVICES FOR TAPER	MAXIMUM DEVICE SPACING IN FEET	
	10' LANE	11' LANE	12' LANE		ALONG TAPER	AFTER TAPER
20	70	75	80	5	20	20
25	105	115	125	6	25	25
30	150	165	180	7	30	30
35	205	225	245	8	35	35
40	270	295	320	9	40	40
45	450	495	540	13	45	45
50	500	550	600	13	50	50
55	550	605	660	13	55	55

RECOMMENDED SIGN SPACING(D) FOR ADVANCE WARNING SIGN SERIES

SPEED MILES PER HOUR	MINIMUM DISTANCE BETWEEN SIGNS	MINIMUM DISTANCE IN FEET FROM LAST SIGN TO TAPER
0-20	10 X SPEED LIMIT	10 X SPEED LIMIT
25-30	10 X SPEED LIMIT	10 X SPEED LIMIT
30-35	10 X SPEED LIMIT	10 X SPEED LIMIT
40-45	10 X SPEED LIMIT	10 X SPEED LIMIT
50-60	10 X SPEED LIMIT	10 X SPEED LIMIT

SPECIAL PROJECT TRAFFIC CONTROL NOTES:

ASCG
INCORPORATED

ENGINEERS - ARCHITECTS - SURVEYORS - PLANNERS

6501 AMERICAS PARKWAY NE, SUITE 400
ALBUQUERQUE, NEW MEXICO 87110-5372
PHONE: 505.247.0294 FAX: 505.245.4845

ALCOA/20332A/DWG/G1-9.DWG/06-30-03/00


CITY OF ALBUQUERQUE
PUBLIC WORKS DEPARTMENT
ENGINEERING DEVELOPMENT GROUP

TITLE: **HIGHLAND DETENTION BASIN PHASE III B
TRAFFIC CONTROL SIGNING AND
CONSTRUCTION TRAFFIC CONTROL STANDARDS**

Design Review Committee	City Engineer Approval	Mo./Day/Yr.	Mo./Day/Yr.
COA	STD		
City Project No.	Zone Map No.	Sheet	19 of 21
720391			

RECORD DRAWING

Date: **FEB. 10, 2005**
These drawings have been revised based on field data and every reasonable attempt has been made to depict construction as actually performed.

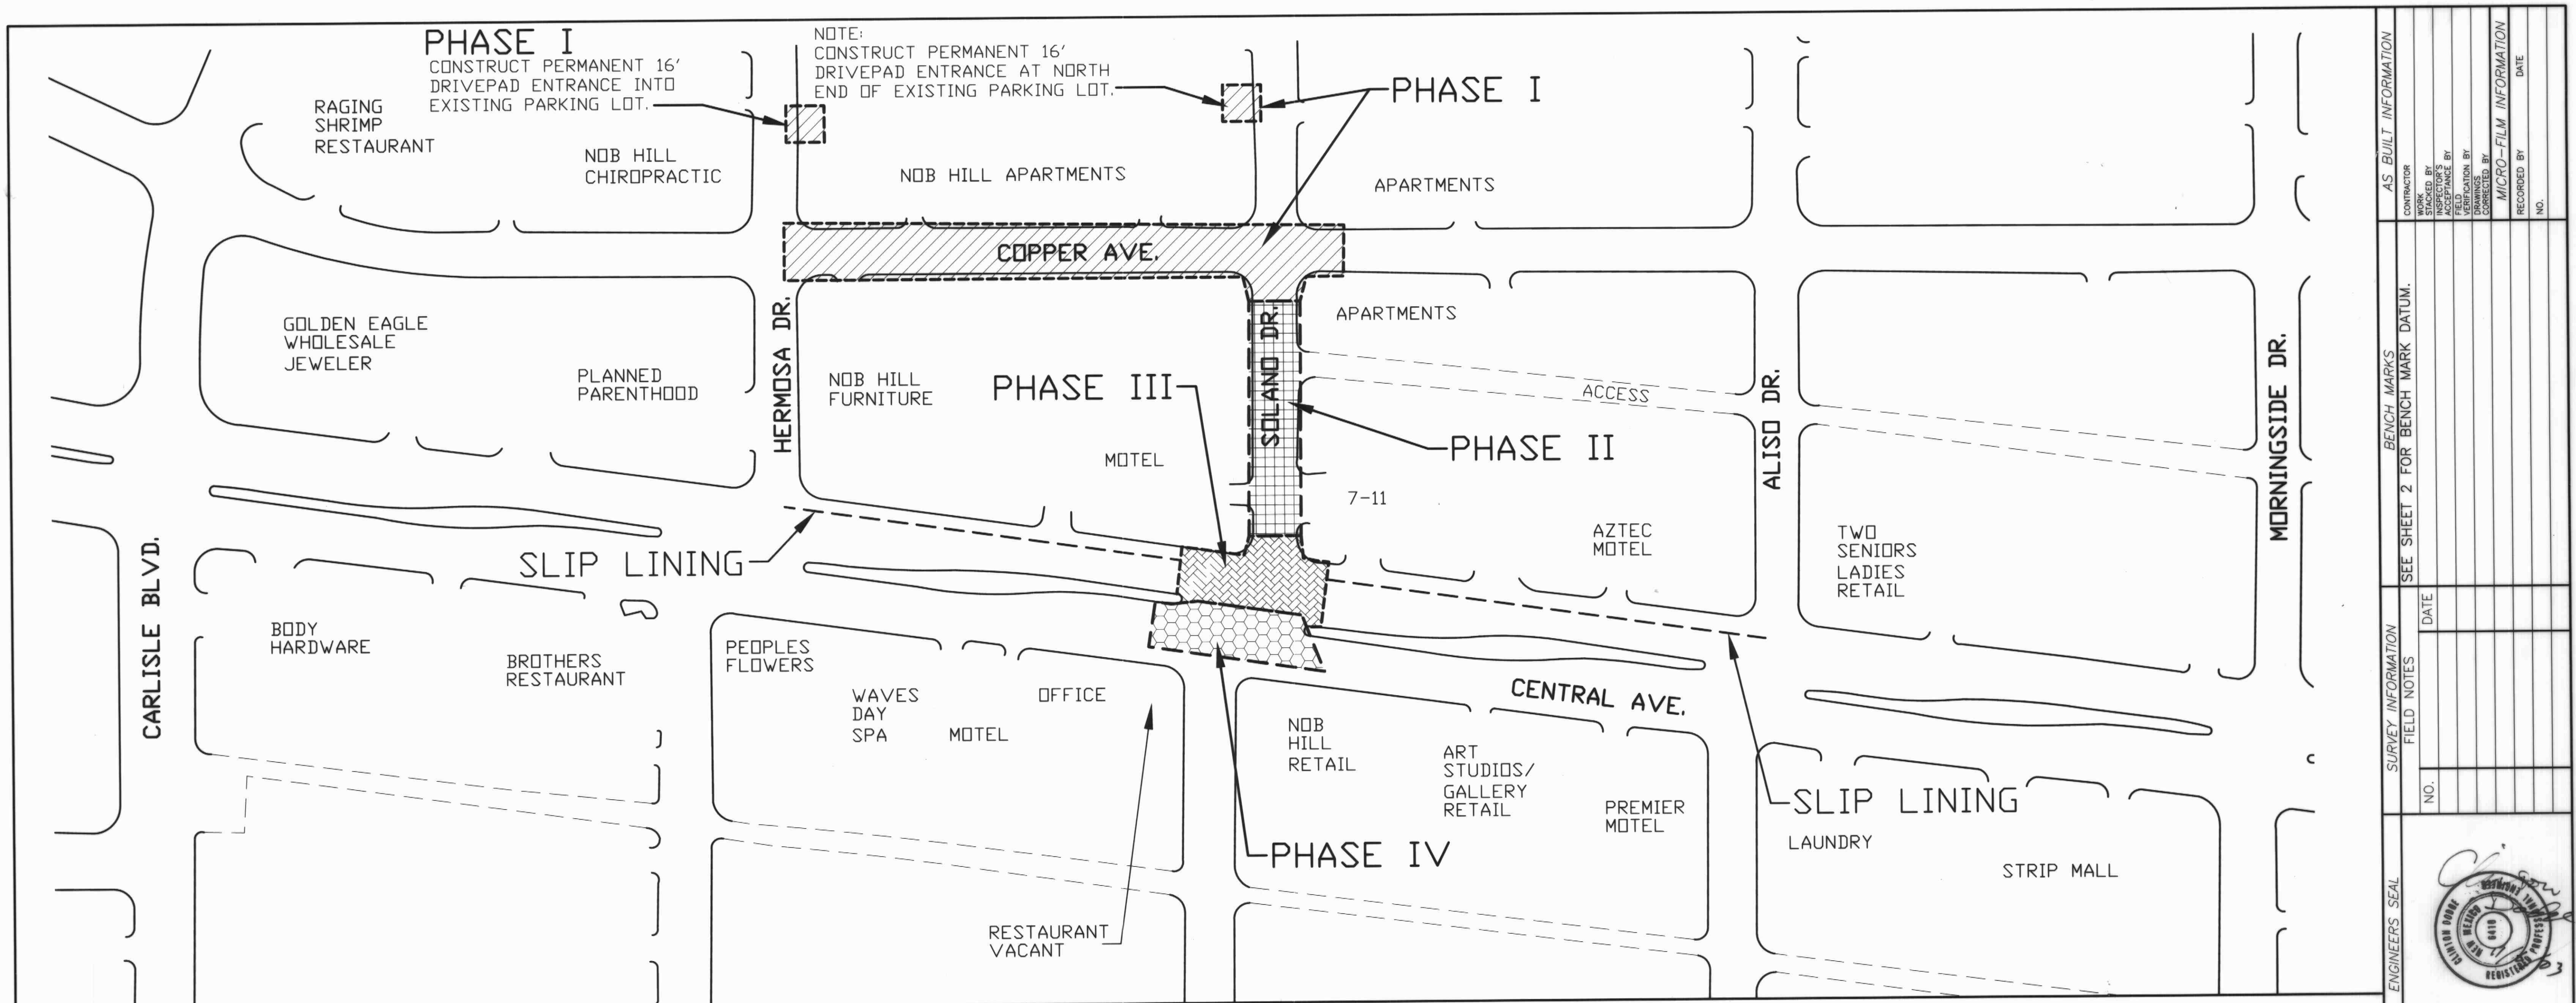

CENTRAL BYPASS TRAFFIC PHASING

NOTE: CONTRACTOR MAY SUBMIT AN ALTERNATE PHASING AND TRAFFIC CONTROL PLAN FOR REVIEW.

PHASE I

COPPER AVE. CONSTRUCTION:
CLOSE COPPER AVE. AND SOLAND DRIVE AT INTERSECTION. CONSTRUCT PERMANENT DRIVEPAD ENTRANCES TO NOB HILL APARTMENTS ON SOLAND DRIVE AND HERMOSA DRIVE. COORDINATE WITH PROJECT MANAGER. SEE TYPICAL STREET CLOSURE DETAILS, SHEET 20. PROVIDE ACCESS SIGNS FOR NOB HILL APARTMENTS, NOB HILL FURNITURE, AND APARTMENTS EAST OF SOLAND ON COPPER AVENUE.

PHASE II

SOLAND DRIVE CONSTRUCTION:
CLOSE SOLAND DRIVE BETWEEN COPPER AVE. AND CENTRAL AVE. SEE TYPICAL STREET CLOSURE DETAILS, SHEET 20. PROVIDE ACCESS SIGNS FOR MOTEL AND 7-11.

PHASE III


CENTRAL AVE. NORTH CONSTRUCTION:
CLOSE WESTBOUND LANES OF CENTRAL AVE. BETWEEN HERMOSA DRIVE AND ALISO DRIVE WITH LOCAL ACCESS. OPEN SOLAND NORTH OF DRIVE ENTRANCES. MAINTAIN TWO-WAY TRAFFIC ON SOUTH SIDE OF CENTRAL AVE. SEE TYPICAL TRAFFIC SPLIT (RAISED MEDIAN), SHEET 20. PROVIDE ACCESS SIGNS FOR MOTEL, 7-11, AZTEC MOTEL, AND NOB HILL FURNITURE.

PHASE IV

CENTRAL AVE. SOUTH CONSTRUCTION:
MAINTAIN ONE LANE OF EAST BOUND TRAFFIC ON SOUTH SIDE OF CENTRAL AND ONE LANE OF WEST BOUND TRAFFIC ON NORTH SIDE OF CENTRAL. SEE TYPICAL LEFT LANE CLOSURE, SHEET 20. PROVIDE TEMPORARY TRAFFIC IMPACT BARRIERS BETWEEN EASTBOUND LANE AND CONSTRUCTION ZONE.

PHASE III & IV CONSTRUCTION NOTES


1. PROVIDE TWO VARIABLE MESSAGE BOARDS 5 DAYS PRIOR TO, AND DURING ALL CONSTRUCTION.
2. PROVIDE ARROW BOARDS FOR LANE CLOSURES.
3. NARROW TRAFFIC LANES TO 10' FROM FACE OF CURB ON SOUTH SIDE OF CENTRAL AVE. DURING PHASE III CONSTRUCTION AND PROVIDE "RESTRICTED LANE WIDTH" SIGNAGE. POSTED MAXIMUM SPEED TO BE 20 MPH.

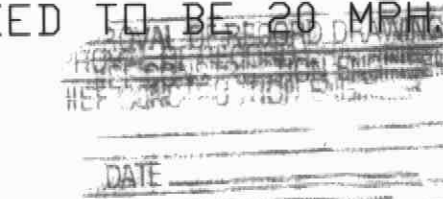

DATE

LEGEND

- PHASE I WORK ZONE
- PHASE II WORK ZONE
- PHASE III WORK ZONE
- PHASE IV WORK ZONE

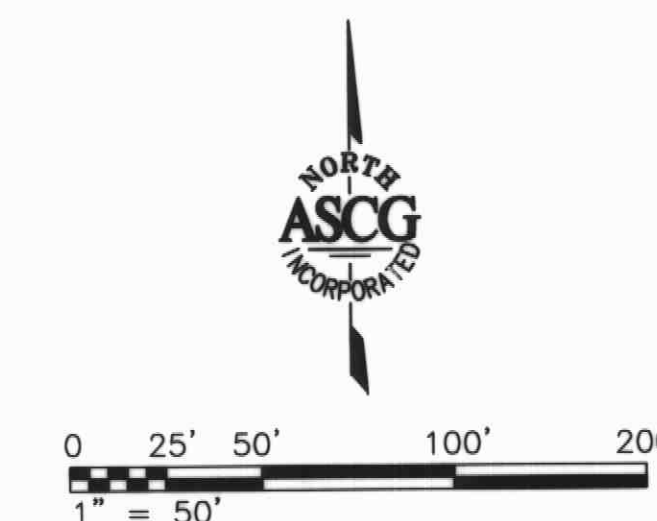

RECORD DRAWING

Date **FEB. 10, 2005**

These drawings have been revised based on field data and every reasonable attempt has been made to depict construction as actually performed.

ASCG
INCORPORATED

ENGINEERS • ARCHITECTS • SURVEYORS • PLANNERS

6501 AMERICAS PARKWAY NE, SUITE 400
ALBUQUERQUE, NEW MEXICO 87110-5372
PHONE 505.247.0294 • FAX 505.242.4845

CITY OF ALBUQUERQUE PUBLIC WORKS DEPARTMENT ENGINEERING DEVELOPMENT GROUP			
TITLE: HIGHLAND DETENTION BASIN PHASE III B CENTRAL BYPASS TRAFFIC CONTROL PLAN			
Design Review Committee APPROVED NOV 25 2003	City Engineer Approval APPROVED NOV 25 2003	Mo./Day/Yr. Last Design Update	Mo./Day/Yr.
City Project No. 720391	Zone Map No. K-17	Sheet 21	Of 21