

CONSTRUCTION PLANS FOR GIBSON BLVD. IMPROVEMENTS ALBUQUERQUE, NEW MEXICO

INDEX

SHEET NO.	DESCRIPTION
1	COVER SHEET
2	OVERALL PAVING PLAN
3-9	PAVING PLAN AND PROFILE SHEETS
10	OVERALL UTILITY PLAN
11-12	UTILITY PLAN AND PROFILE SHEETS
13	MISCELLANEOUS DETAILS
14-15	GIBSON BLVD. STRIPING PLAN
16	GIBSON BLVD. IMPROVEMENTS MISCELLANEOUS SECTION AND DETAILS
17-18	GIBSON BLVD. IMPROVEMENTS RETAINING WALL SECTIONS AND DETAILS
19-20	NMSH & TD CONCRETE BOX CULVERT BARRELS TRIPLE OPENING (SERIAL CB-33)
21A-21F	CONCRETE WALL BARRIER - TYPE 42
22	NMSH & TD METAL RAILING - (NOT USED IN THIS PLAN SET) GENERAL NOTES & TYPICAL DETAILS (SERIAL BMR-001-10)
23	NMSH & TD TRANSITION DETAILS STEEL BRIDGE RAILING TO THRIE BEAM TO W-BEAM (DWG 036)
24	NMSH & TD METAL BARRIER MATERIALS AND PLACEMENT PROCEDURES (SERIAL M-21-62)
25	NMSH & TD METAL BARRIER THRIE BEAM ROADSIDE AND BOX CULVERT (SERIAL M-21-75)
26-27	NMSH & TD METAL BARRIER AT BRIDGE APPROACHES (SERIAL M-21-77)

PAVING PLANS

SHEET NO.	DESCRIPTION
3-7	GIBSON BLVD.
8	AMOLE ARROYO CROSSING
9	GUARD RAIL LAYOUT - AMOLE ARROYO CROSSING


UTILITY PLANS

SHEET NO.	DESCRIPTION
11	MESSINA DRIVE / GIBSON BLVD.
12	GIBSON BLVD. / DE ANZA DRIVE

CERTIFICATE OF SUBSTANTIAL COMPLIANCE ON PLANS

I, Timothy Aldrich, of the firm of BOHANNAN HUSTON, a Registered Professional Engineer in the State of New Mexico, do hereby certify to the best of my knowledge and belief, that the infrastructure installed as part of this project has been inspected by me or by a qualified person under my direct supervision and has been constructed in accordance with the plans and specifications approved by the City Engineer and that the original design intent of the approved plans has been met, except as noted by me on the as-built construction drawings. This certificate is based on site inspections by me or personnel under my direction and survey information as shown on the record drawings.

DATE: 08-11-04 BY: TIM ALDRICH NHPMS number: 7719

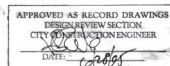

SURVEYOR'S CERTIFICATION

I, Timothy Aldrich, a duly qualified Registered Professional Land Surveyor under the laws of the State of New Mexico, do hereby certify that the "as-built" information shown on these drawings was obtained from field construction and "as-built" surveys performed by me or under my supervision, that the "as-built" information shown on these drawings was added by me or under my supervision, and that this "as-built" information is true and correct to the best of my knowledge and belief. I, Timothy Aldrich, Land Surveying is not responsible for any of the design concepts, calculations, or information shown on the record drawings.

DATE: 08-11-04 BY: TIM ALDRICH




NOTES

1. AMAFCA FIELD ENGINEER SHALL BE NOTIFIED 48-HOURS PRIOR TO ANY WORK WITHIN THE AMAFCA R/W OR EXCAVATION. TEL (505) 884-2235 JERRY LOWMEYER.
2. NO WORK WILL BE PERFORMED IN THE AMAFCA R/W BETWEEN MAY 15 AND OCTOBER 15 WITHOUT WRITTEN PERMISSION FROM AMAFCA.
3. ALL SUBGRADE, BACKFILL AND EMBANKMENT SHALL BE COMPACTED TO 95% (MODIFIED PROCTOR) WITHIN THE AMAFCA R/W. TESTING REPORTS SHALL BE PROVIDED TO AMAFCA FIELD ENGINEER.
4. AMAFCA FIELD ENGINEER WILL BE NOTIFIED 48 HOURS PRIOR TO FINAL INSPECTION OF ANY FACILITIES WITHIN THE AMAFCA R/W.
5. ALL DISTURBED GROUND AREAS SHALL BE REVEGETATED IN ACCORDANCE WITH CITY OF ALBUQUERQUE STANDARD SPECIFICATIONS FOR PUBLIC WORKS CONSTRUCTION, SECTION 1002 NATIVE GRASS SEEDING AS CURRENTLY UPDATED.

APPROVED FOR CONSTRUCTION WITHIN AMAFCA RIGHT OF WAY OR EASEMENT:

Timothy Aldrich 1/20/04 (DATE)

Bohannon & Huston
Engineers & Spatial Data • Advanced Technologies
Copyright © 1990 Jefferson St. NE Albuquerque, NM 87108-4088

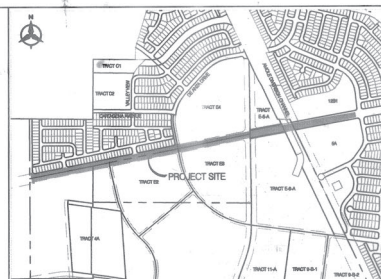

VICINITY MAP
M-9, N-9

NOTICE TO CONTRACTORS

1. AN EXCAVATION/CONSTRUCTION PERMIT WILL BE REQUIRED BEFORE BEGINNING ANY WORK WITHIN THE CITY RIGHT-OF-WAY.
2. ALL WORK DETAILLED ON THESE PLANS TO BE PERFORMED UNDER CONTRACT SHALL, EXCEPT AS OTHERWISE STATED OR PROVIDED FOR HEREON, BE CONSTRUCTED IN ACCORDANCE WITH THE CITY OF ALBUQUERQUE STANDARD SPECIFICATIONS FOR PUBLIC WORKS CONSTRUCTION, 1988 EDITION AS REVISED THROUGH UPDATE #2.
3. TWO WORKING DAYS PRIOR TO ANY EXCAVATION, THE CONTRACTOR MUST CONTACT NEW MEXICO CALL SYSTEM (280-1990) FOR LOCATION OF EXISTING UTILITIES.
4. PRIOR TO CONSTRUCTION, THE CONTRACTOR SHALL EXCAVATE AND VERIFY THE HORIZONTAL AND VERTICAL LOCATIONS OF ALL EXISTING UTILITIES. REPLACEMENT SHALL BE DONE ONLY BY THE CITY SURVEYOR. WHEN A CONFLICT IMMEDIATELY SO THAT THE CONFLICT CAN BE RESOLVED WITH A MINIMUM AMOUNT OF DELAY.
5. FIVE (5) WORKING DAYS PRIOR TO BEGINNING CONSTRUCTION, THE CONTRACTOR SHALL SUBMIT TO CONSTRUCTION COORDINATION DIVISION A DETAILED CONSTRUCTION SCHEDULED. TWO (2) WORKING DAYS PRIOR TO THE START OF CONSTRUCTION, THE CONTRACTOR SHALL OBTAIN A BARRICADE PERMIT FROM THE CONSTRUCTION COORDINATION DIVISION. CONTRACTOR SHALL NOTIFY THE CONSTRUCTION COORDINATION ENGINEER (280-3460) PRIOR TO OCCUPANCY AN INTERSECTION. REFER TO SECTION 19 OF THE GENERAL CONDITIONS OF THE STANDARD SPECIFICATIONS.
6. ALL WORK EFFECTING ARTERIAL ROADWAYS REQUIRES TWENTY-FOUR HOUR CONSTRUCTION.
7. ALL STREET STRIPING ALTERED OR DESTROYED SHALL BE REPLACED WITH PLASTIC REFLECTORIZED PAVEMENT MARKING BY CONTRACTOR TO THE SAME LOCATION AS WAS EXISTING, OR AS INDICATED BY THIS PLAN SET.
8. CONTRACTOR SHALL NOTIFY THE ENGINEER NOT LESS THAN SEVEN (7) DAYS PRIOR TO STARTING WORK IN ORDER THAT THE CITY SURVEYOR MAY TAKE NECESSARY MEASURES TO REQUIRE THE PRESERVATION OF SURVEY MONUMENTS. CONTRACTOR SHALL NOT DESTROY PERMANENT SURVEY MONUMENTS WITHOUT THE CONSENT OF THE CITY SURVEYOR AND SHALL NOTIFY THE CITY SURVEYOR AND BEAR THE EXPENSE OF REPLACING ANY THAT MAY BE DESTROYED WITHIN THE CONSTRUCTION. REPLACEMENT SHALL BE DONE ONLY BY THE CITY SURVEYOR. WHEN A CONFLICT IS MADE IN THE FINISHED ELEVATIONS OF THE PAVEMENT OF ANY ROADWAY IN WHICH A PERMANENT SURVEY MONUMENT IS LOCATED, CONTRACTOR SHALL, AT HIS OWN EXPENSE, ADJUST THE MONUMENT COVER TO THE NEW GRADE, UNLESS OTHERWISE SPECIFIED. REFER TO SECTION 4.4 OF THE GENERAL CONDITIONS OF THE STANDARD SPECIFICATIONS.
9. CONTRACTOR SHALL RECORD DATA ON ALL UTILITY LINES AND ACCESSORIES AS REQUIRED BY THE CITY OF ALBUQUERQUE FOR THE PREPARATION OF "AS CONSTRUCTED" DRAWINGS. CONTRACTOR SHALL NOT COVER UTILITY LINES AND ACCESSORIES UNTIL ALL DATA HAS BEEN RECORDED.
10. CONTRACTOR SHALL MAINTAIN A GRADE-FREE WORK SITE. CONTRACTOR SHALL PROMPTLY REMOVE ANY GRAFFITI FROM ALL EQUIPMENT, WHETHER PERMANENT OR TEMPORARY.
11. CONTRACTOR SHALL COORDINATE WITH THE CITY OF ALBUQUERQUE WATER UTILITY DIVISION (287-4200) SEVEN (7) WORKING DAYS IN ADVANCE OF ANY WORK THAT MAY AFFECT EXISTING PUBLIC WATER OR SEWER UTILITIES. EXISTING VALVES TO BE OPERATED BY CITY PERSONNEL ONLY. CONTRACTOR SHALL CONTACT THE WATER SYSTEMS DIVISION SEVEN (7) WORKING DAYS PRIOR TO READING VALVES TURNED ON OR OFF.

THE FOLLOWING NOTES ALSO APPLY WHEN CHECKED


- ALL UTILITIES AND UTILITY SERVICE LINES SHALL BE INSTALLED PRIOR TO PAVING.
- BACKFILL COMPACTION SHALL BE ACCORDING TO SPECIFIED STREET USE.
- ☒ SIDEWALKS AND WHEELCHAIR RAMPS WITHIN THE CURB RETURNS SHALL BE CONSTRUCTED WHETHER A NEW CURB RETURN IS CONSTRUCTED.
- ☒ IF CURB IS DEPRESSSED FOR A DRIVEWAY, THE DRIVEWAY SHALL BE CONSTRUCTED PRIOR TO ACCEPTANCE OF CURB AND GUTTER.
- ☒ ALL STORM DRAINAGE FACILITIES SHALL BE COMPLETED PRIOR TO FINAL ACCEPTANCE.
- ☒ THE REQUESTOR OR DEVELOPER SHALL BE RESPONSIBLE FOR REPAIR OR REPLACEMENT OF ALL CURB AND GUTTER OR SIDEWALK DAMAGED AFTER APPROVAL BY THE CITY ENGINEER OF WORK COMPLETED BY THE CONTRACTOR.



CONSTRUCTION NOTES:

1. THE CONTRACTOR SHALL ABIDE BY ALL LOCAL, STATE, AND FEDERAL LAWS, RULES, AND REGULATIONS WHICH APPLY TO THE CONSTRUCTION OF THESE IMPROVEMENTS.
2. PRIOR TO CONSTRUCTION, CONTRACTOR SHALL EXCAVATE AND VERIFY THE HORIZONTAL AND VERTICAL LOCATIONS OF ALL POTENTIAL OBSTRUCTIONS. SHOULD A CONFLICT EXIST, THE CONTRACTOR SHALL NOTIFY THE ENGINEER OR CONSTRUCTION OBSERVER SO THAT THE CONFLICT MAY BE RESOLVED WITH A MINIMUM AMOUNT OF DELAY.
3. ALL ELECTRICAL, TELEPHONE, CABLE TV, GAS AND OTHER UTILITY LINES, CABLES AND APPURTENANCES ENCOUNTERED DURING CONSTRUCTION THAT REQUIRE RELOCATION, SHALL BE COORDINATED WITH THAT UTILITY. THE CONTRACTOR SHALL BE RESPONSIBLE FOR COORDINATION OF ALL NECESSARY UTILITY ADJUSTMENTS. NO ADDITIONAL COMPENSATION WILL BE ALLOWED FOR DELAYS OR INCONVENIENCES CAUSED BY UTILITY COMPANY WORK CHECKS. THE CONTRACTOR MAY BE REQUIRED TO REDEVELOP HIS ACTIVITIES TO ALLOW UTILITY CHECKS TO PERFORM THEIR REQUIRED WORK.
4. DISPOSAL SITE FOR ALL EXCESS EXCAVATION MATERIAL, AND UNSUITABLE MATERIAL SHALL BE DETERMINED BY THE CONTRACTOR IN COMPLIANCE WITH APPLICABLE ENVIRONMENTAL REGULATIONS AND APPROVED BY THE CONSTRUCTION OBSERVER. ALL COSTS INCURRED IN OBTAINING A DISPOSAL SITE AND SHALL INCURRED SHALL BE CONSIDERED INCIDENTAL TO THE PROJECT AND NO SEPARATE REIMBURSEMENT OR PAYMENT SHALL BE MADE.
5. THE CONTRACTOR IS RESPONSIBLE FOR PROTECTING THE EXISTING UTILITY LINES WITHIN THE CONSTRUCTION AREA. ANY DAMAGE TO EXISTING FACILITIES CAUSED BY CONSTRUCTION ACTIVITY SHALL BE REPAIRED OR REPLACED AT THE CONTRACTOR'S EXPENSE AND APPROVED BY THE CONSTRUCTION OBSERVER.
6. CONSTRUCTION ACTIVITY SHALL BE LIMITED TO THE PROPERTY AND/OR PROJECT LIMITS. ANY DAMAGE TO ADJACENT PROPERTIES RESULTING FROM THE CONSTRUCTION PROCESS IS THE RESPONSIBILITY OF THE CONTRACTOR. ANY COSTS INCURRED FOR REPAIRS SHALL BE THE COST OF THE CONTRACTOR.
7. OVERNIGHT PARKING OF CONSTRUCTION EQUIPMENT SHALL NOT OBSTRUCT DRIVEWAYS OR DESIGNATED TRAFFIC LANES. THE CONTRACTOR SHALL NOT STORE ANY EQUIPMENT OR MATERIAL WITHIN THE PUBLIC RIGHT-OF-WAY.
8. THE CONTRACTOR SHALL OBTAIN ALL THE NECESSARY PERMITS FOR THE PROJECT PRIOR TO COMMENCING CONSTRUCTION (I.E. BARRICADES, SURFACE OBSTRUCTIONS).
9. THE CONTRACTOR SHALL BE RESPONSIBLE TO REPLACE AT HIS EXPENSE ANY AND ALL PROPERTY DAMAGED DURING CONSTRUCTION. ALL PROPERTY DAMAGES MUST BE RESET BY A REGISTERED LAND SURVEYOR.
10. ALL PERMANENT PAVEMENT MARKING AND TRAFFIC SIGNING SHALL BE FURNISHED BY THE CONTRACTOR PER PLAN.
11. THE CONTRACTOR SHALL FOLLOW THE CONSTRUCTION TRAFFIC CONTROL ALBUQUERQUE, TWO SIGNING PLAN PROVIDED HEREIN. THE CONTRACTOR SHALL COORDINATE WITH THE CITY OF TRAFFIC ENGINEERING DEPARTMENT, PRIOR TO BEGINNING ANY CONSTRUCTION WORK ON OR ADJACENT TO EXISTING STREETS.
12. ALL BARRICADES AND CONSTRUCTION SIGNING SHALL CONFORM TO APPLICABLE SECTIONS OF THE "MANUAL OF UNIFORM TRAFFIC CONTROL DEVICES" (MUTCD), U.S. DEPARTMENT OF TRANSPORTATION, LATEST EDITION.
13. THE CONTRACTOR SHALL MAINTAIN ALL CONSTRUCTION BARRICADES AND SIGNING AT ALL TIMES. THE CONTRACTOR SHALL VERIFY THE PROPER LOCATION OF ALL BARRICADES AT THE END AND BEGINNING OF EACH DAY.
14. ALL SAWCUT PAVEMENT SHALL HAVE A UNIFORM EDGE AND BE SPRAYED WITH TACK.
15. WHEN ABUTTING NEW CURB AND GUTTER TO EXISTING PAVEMENT, A 1" WIDE SECTION OF EXISTING PAVEMENT ADJACENT TO THE CURB AND GUTTER SHALL BE SAWCUT, REMOVED, AND REPLACED AS PER THE STANDARD SPECIFICATIONS.
16. THE CONTRACTOR SHALL ASSUME RESPONSIBILITY FOR ANY DAMAGE TO EXISTING PAVEMENTS, PAVEMENT MARKINGS, CURB & GUTTER, DRIVE PADS, WHEELCHAIR RAMPS, AND SIDEWALK DURING CONSTRUCTION, AWAY FROM THOSE SECTIONS INDICATED FOR REMOVAL ON THE PLANS AND SHALL REPAIR OR REPLACE PER COA STANDARDS, AT HIS OWN EXPENSE.
17. FOR STORM DRAIN CONSTRUCTION, PEZ PIPE JOINTS SHALL NOT BE GROUDED PRIOR TO FINAL INSPECTION. FINAL INSPECTION WILL DETERMINE JOINTS TO BE GROUDED FOR FINAL ACCEPTANCE OF THE CONSTRUCTION.
18. ALL EXCAVATION, TRENCHING, AND SIGNING ACTIVITIES MUST BE CARRIED-OUT IN ACCORDANCE WITH OSHA 29 CFR 1926.650 SUBPART P.

1 2 3 100

--	--	
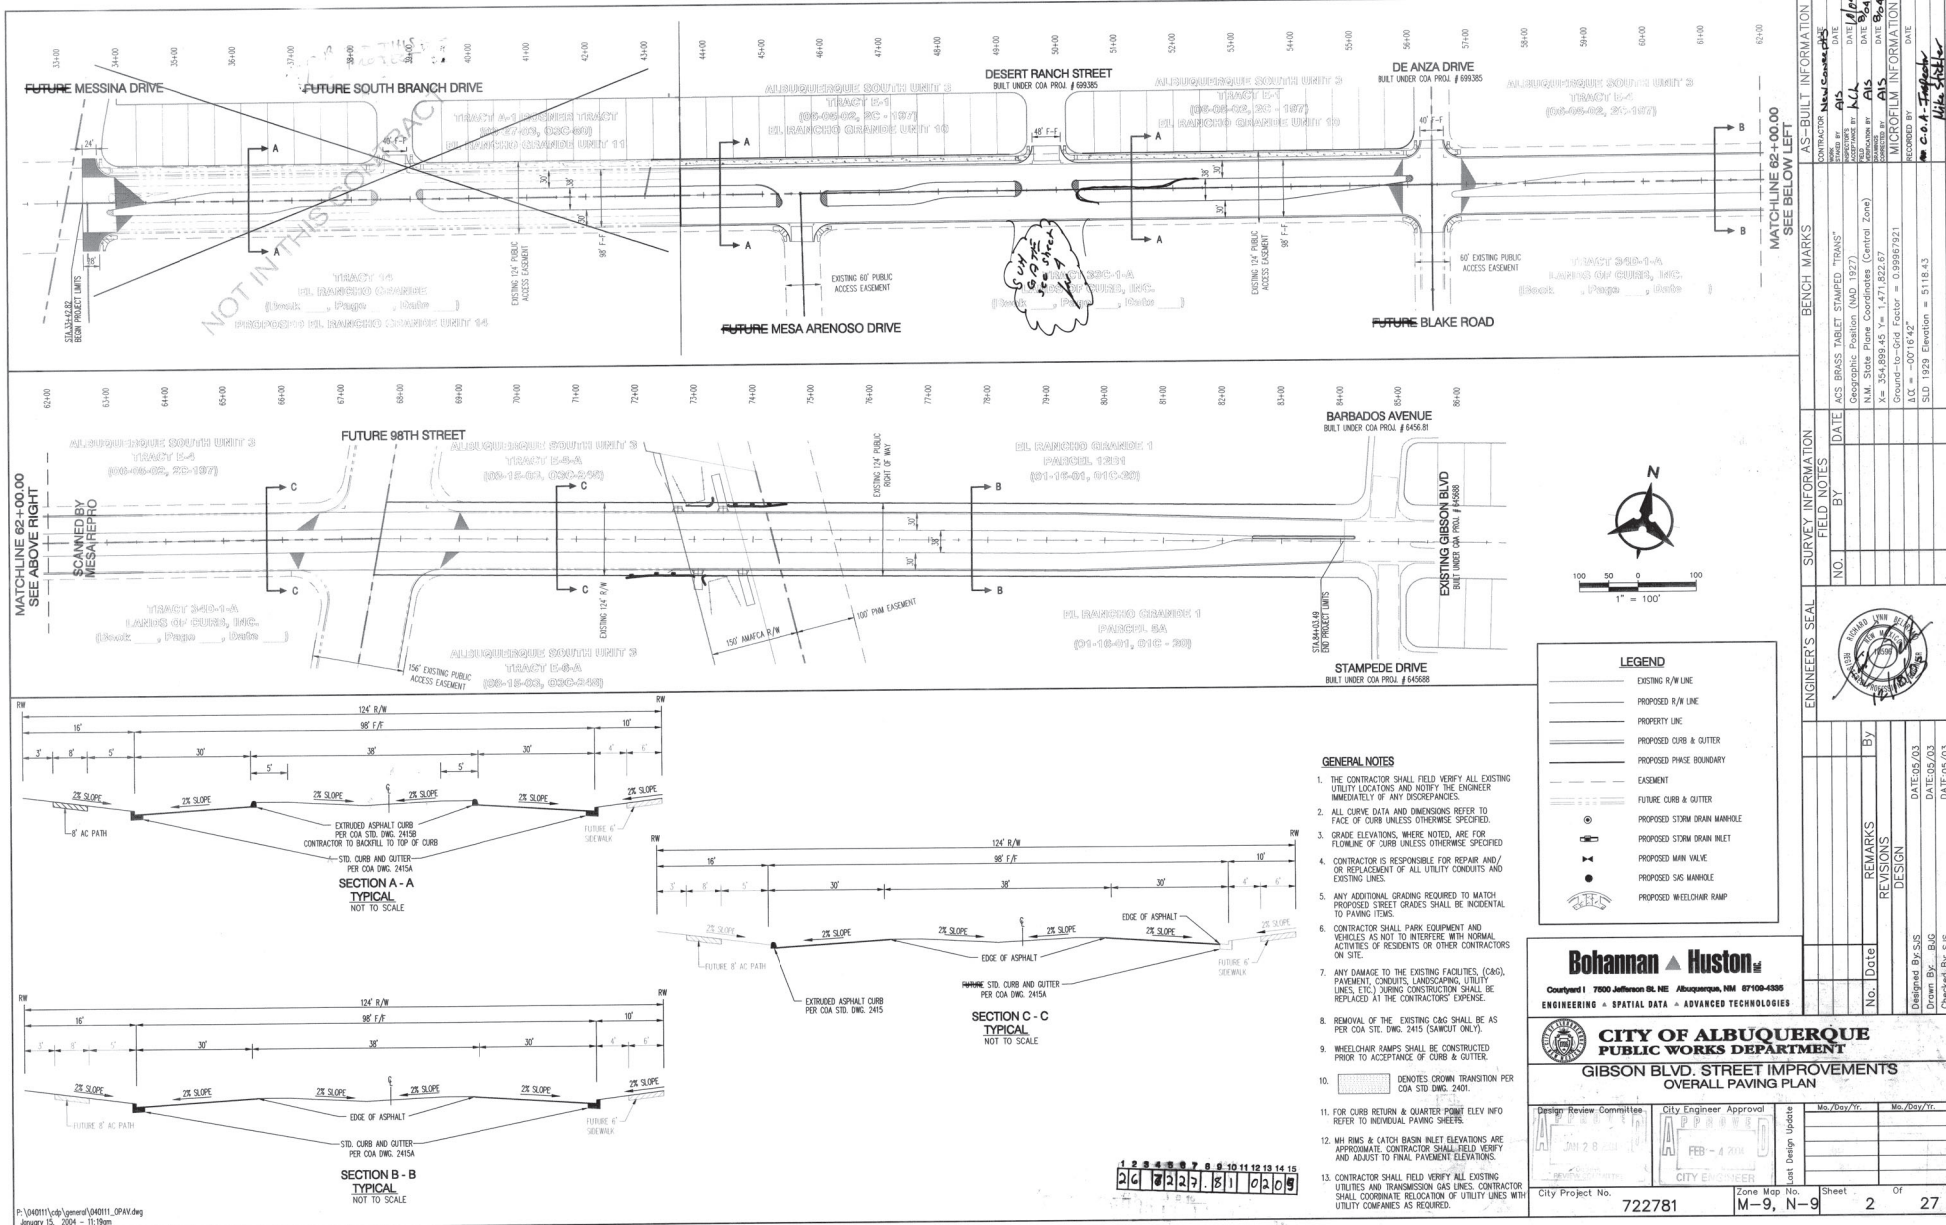

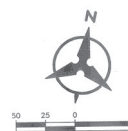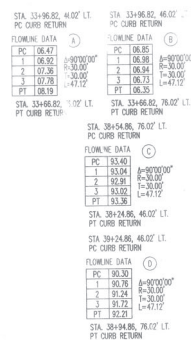

ELEVATIONS ARE IN NGVD 29

- FUTURE
KEYED NOTES (NOT IN THIS CONTRACT)

- | | | | | | | | | | | | | | | |
|---|---|---|---|---|---|---|---|---|----|----|----|----|----|----|
| 1 | 2 | 3 | 4 | 5 | 6 | 7 | 8 | 9 | 10 | 11 | 12 | 13 | 14 | 15 |
| 2 | 6 | | 7 | 2 | 2 | 7 | . | 8 | 1 | | 0 | 3 | 0 | 5 |

* NOT USED THIS SHEET.

Bohannon ▲ Huston inc.

Courtyard I 7500 Jefferson St NE Albuquerque, NM 87109-4336
ENGINEERING • SPATIAL DATA • ADVANCED TECHNOLOGIES



CITY OF ALBUQUERQUE
PUBLIC WORKS DEPARTMENT

**GIBSON BLVD. IMPROVEMENTS
PAVING PLAN AND PROFILE
FUTURE GIBSON BLVD. 33+00.00 - 44+00.00**

Design Review Committee	City Engineer Approval	date


JAN 28 2004 FEB - 4 2004

DESIGN REVIEW COMMITTEE CITY ENGINEER

City Project No.	722781	Zone Map No.	M-9, N
------------------	--------	--------------	--------

[illegible]

ERQUE MENT	
EMENTS OFILE	
.00 - 44 + 00.00	
Mo./Day/Yr.	Mo./Day/Yr.
o. Sheet	Of
1-9	3 27

 

KEYED NOTES

- 1 BUILD ARTERIAL PAVEMENT PER ARTERIAL SECTION, SHEET 13.
- 2 INSTALL 6" CONCRETE VALLEY CUTTER PER CO STD. DWG. 2452.
- 3 BUILD STD. CURB & GUTTER PER CO STD. DWG. 2415A.
- 4 BUILD EXTRUDED ASPHALT CURB PER CO STD. DWG. 2418B.
- 5 EDGE OF PROPOSED ASPHALT.
- 6 BUILD 6' SIDEWALK PER CO STD. DWG. 2430.
- 7 BUILD 8" ASPHALT PATH PER CO STD. DWG. & DETAIL SHEET 13.
- 8 INSTALL SPECIAL HANDICAP RAMP "B" PER CO STD. DWG. 2415B.
- 9 BUILD MEDIAN CURB & GUTTER PER CO STD. DWG. 2415D.
- 10 BUILD CONCRETE MEDIAN PAVING PER CO STD. DWG. 2408.
- 11 INSTALL HANDICAP RAMP PER HANDICAP & AMP DETAIL "B", SEE SHEET 13.
- 12 BUILD ARTERIAL PAVEMENT PER RESIDENTIAL SECTION, SHEET 13.
- 13 BUILD TEMPORARY PAVEMENT PER SECTION, SHEET 13.
- 14 INSTALL 4" STAMPED CONCRETE 10' BACK FROM MEDIAN NOS. BAJA RD, RUNNING BOND PATTERN.

* NOT USED THIS SHEET.

Bohannon ▲ Huston, MD

Courtyard I 7500 Jefferson St. NE Albuquerque, NM 87109-4335
ENGINEERING • SPATIAL DATA • ADVANCED TECHNOLOGIES



**GIBSON BLVD. IMPROVEMENTS
PAVING PLAN AND PROFILE
GIBSON BLVD. 44+00.00 - 54+00.00**

Design Review Committee	City Engineer Approval	Note	Mo./Day/Yr.	Mo./Day/Yr.
-------------------------	------------------------	------	-------------	-------------

[illegible]






REVIEW COMMITTEE	CITY ENGINEER	DATE		
City Project No.	Zone Map No.	Sheet	Of	

City Project No.	722781	State Map No.	M-9, N-9	Sheet	4	of	27
------------------	--------	---------------	----------	-------	---	----	----

[illegible]

SCANNED BY
MESA REPRO

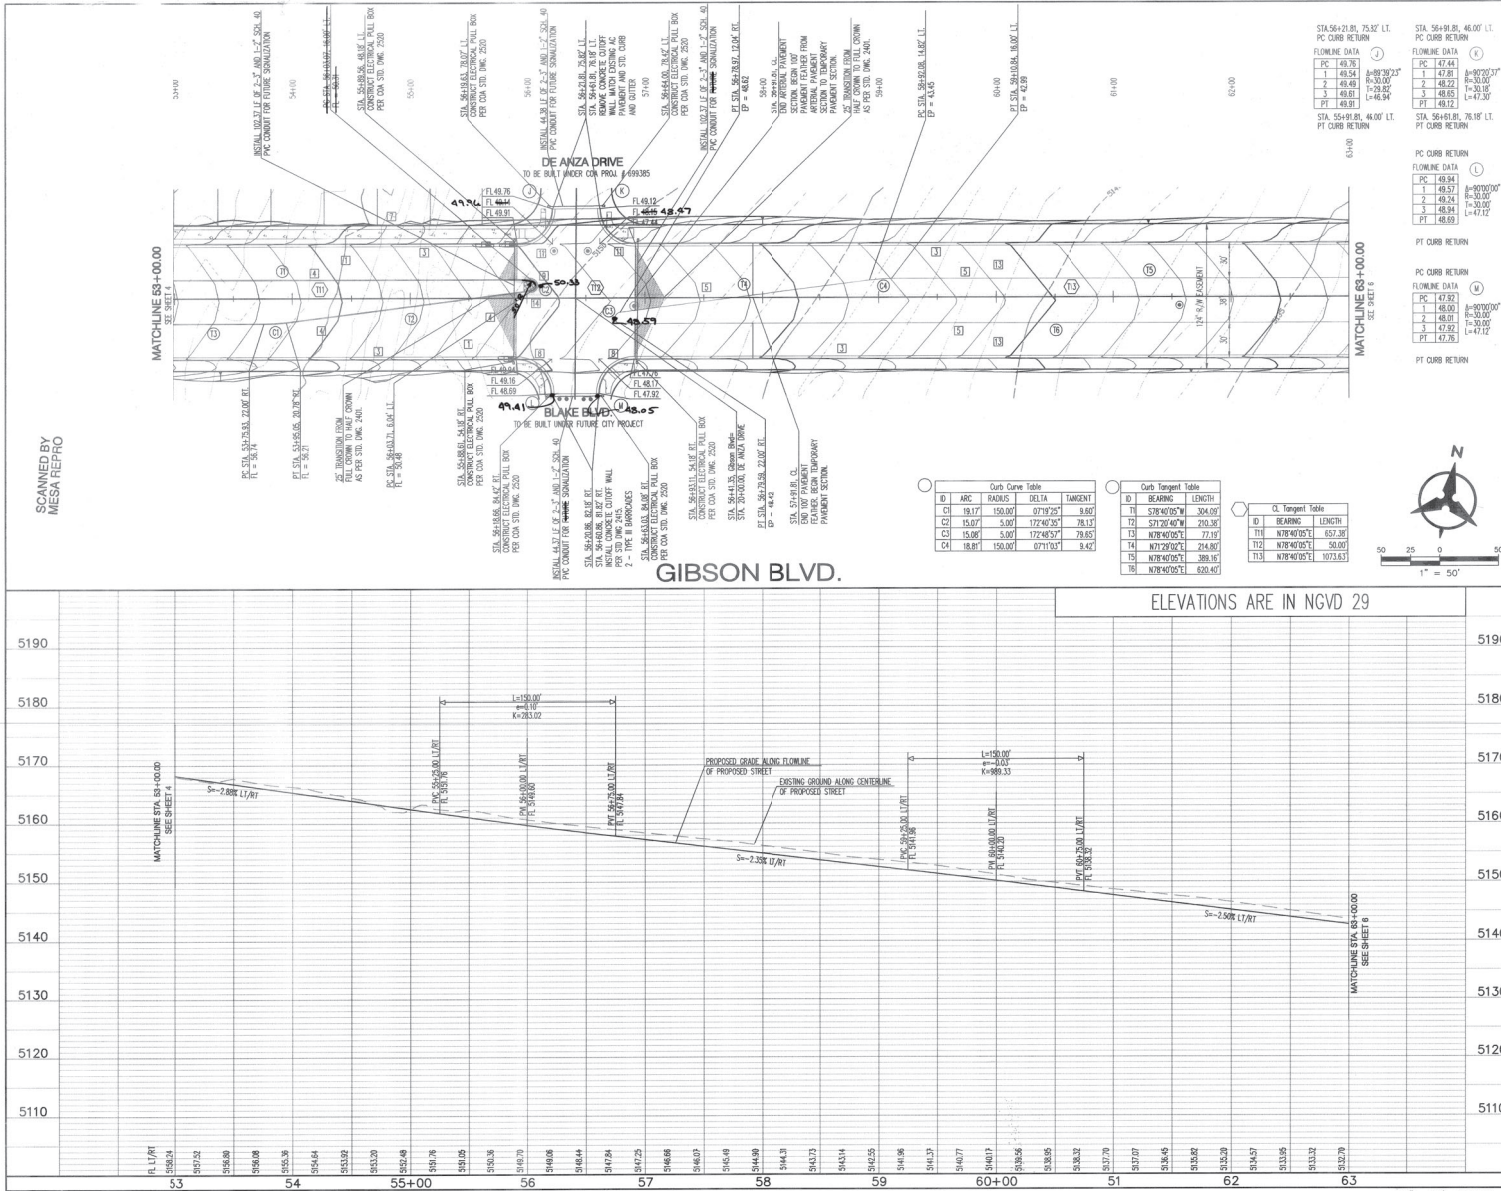

NOTES

- THE CONTRACTOR SHALL VERIFY ALL EXISTING UTILITY LOCATIONS AND NOTIFY THE ENGINEER IMMEDIATELY OF ANY DISCREPANCIES.
- ALL CURB RETURN RAMP SHALL BE 30' UNLESS OTHERWISE SPECIFIED.
- ALL CURVE DATA AND DIMENSIONS REFER TO FACE OF CURB UNLESS OTHERWISE SPECIFIED.
- GRADE ELEVATIONS, WHERE NOTED, ARE FOR FLOWLINE OF CURB UNLESS OTHERWISE SPECIFIED.
- CONTRACTOR IS TO INSTALL A 4" x 4" x 5'-0" POST AND END AT THE END OF EACH SANITARY SEWER SERVICE.
- CONTRACTOR IS RESPONSIBLE FOR REPAIR AND/OR REPLACEMENT OF ALL UTILITY CONDUITS AND EXISTING LINES.
- ANY ADDITIONAL GRADING REQUIRED TO MATCH PROPOSED STREET GRADES SHALL BE INCIDENTAL TO PAVING TRIG.
- CONTRACTOR SHALL PROVIDE THE INSPECTORS, (CITY AND PRIVATE) WITH THE PROPOSED VERTICAL TESTING PLAN. THE PLAN MUST BE APPROVED BEFORE TESTING OPERATIONS BEGIN.
- CONTRACTOR SHALL PARK EQUIPMENT AND VEHICLES AS NOT TO INTERFERE WITH NORMAL ACTIVITIES OF RESIDENTS OR OTHER CONTRACTORS ON SITE.
- ANY DAMAGE TO THE EXISTING FACILITIES (CURB & GUTTER, PAVEMENT, CONDUITS, LANDSCAPING, UTILITY LINES ETC) DURING CONSTRUCTION SHALL BE REPLACED AT THE CONTRACTORS' EXPENSE.
- REMOVAL OF THE EXISTING CURB & GUTTER SHALL BE PER COA STD. DWG. 2415 (SANDOUT ONLY).
- WHEEL-CHAIR RAMPS SHALL BE CONSTRUCTED PRIOR TO ACCEPTANCE OF CURB & GUTTER.

KEYED NOTES

- BUILD ARTERIAL PAVEMENT PER ARTERIAL SECTION, SHEET 13.
- INSTALL 6" CONCRETE VALLEY GUTTER PER COA STD. DWG. 2420.
- BUILD STD. CURB & GUTTER PER COA STD. DWG. 2415A.
- BUILD EXTRUDED ASPHALT CURB PER COA STD. DWG. 2415B.
- EDGE OF PROPOSED ASPHALT.
- BUILD 6" SIDEWALK PER COA STD. DWG. 2430.
- BUILD 8" ASPHALT PATH PER COA STD. DWG. 2415B & DETAIL SHEET 13.
- INSTALL SPECIAL HANDICAP RAMP "B" DETAIL "B". SEE SHEET 13.
- BUILD MEDIAN CURB & GUTTER PER COA STD. DWG. 2415B.
- BUILD CONCRETE MEDIAN PAVING PER COA STD. DWG. 2408.
- INSTALL HANDICAP RAMP PER HANDICAP RAMP DETAIL "B". SEE SHEET 13.
- BUILD RESIDENTIAL PAVEMENT PER RESIDENTIAL SECTION, SHEET 13.
- BUILD TEMPORARY PAVEMENT PER TEMPORARY SECTION, SHEET 13.
- INSTALL 4" STAMPED CONCRETE 10' BACK FROM MEDIAN NOSE BARR. RED. RUNNING BOND PATTERN PER STD. DWG. 2402.

* NOT USED THIS SHEET.

Bohannon & Huston
 7700 Jefferson BL NE Albuquerque, NM 87100-4205
 ENGINEERING & SPATIAL DATA • ADVANCED TECHNOLOGIES


CITY OF ALBUQUERQUE
 PUBLIC WORKS DEPARTMENT
 GIBSON BLVD. IMPROVEMENTS
 PAVING PLAN AND PROFILE
 GIBSON BLVD. 54+00.00 - 64+00.00

Design Review Committee: [] City Engineer Approval: []
 Date: 2/8/2014 Date: FEB - 8 2014
 Scale: 1" = 50' (HORIZ.) 1" = 10' (VERT.)


Project No. 722781 Zone Map No. M-9, N-9 Sheet 5 of 27

REMARKS
 DESIGN
 DATE: 08/03/09
 DRAWN BY: []
 CHECKED BY: []

SCANNED BY
MESA REPRO

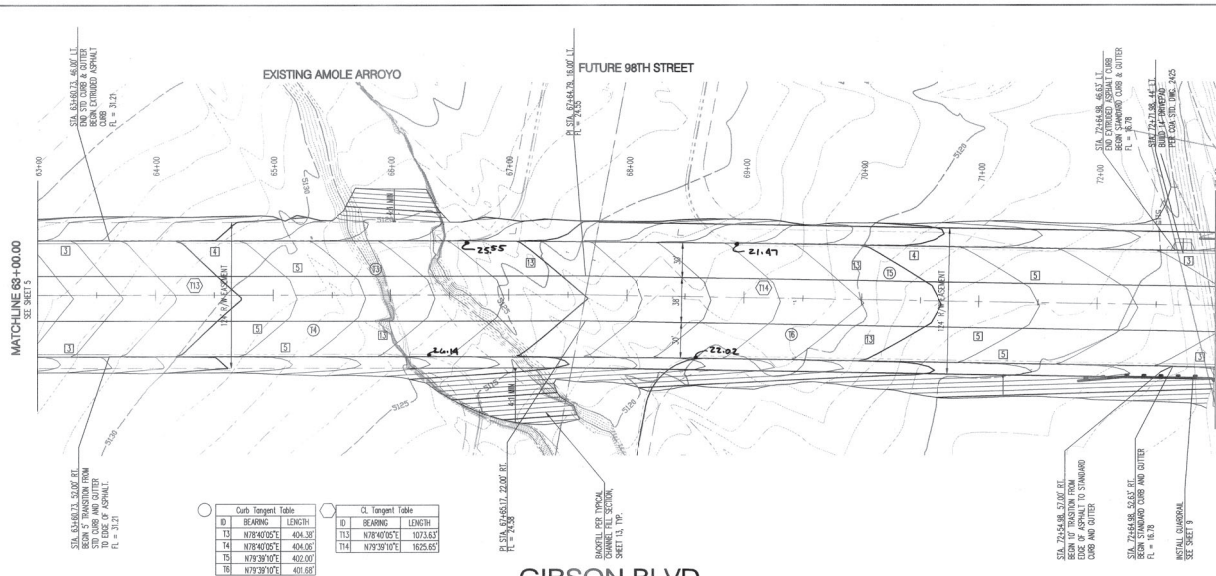

Curb Segment Table			C/L Segment Table		
ID	BEARING	LENGTH	ID	BEARING	LENGTH
13	N78°40'05"E	404.38	113	N78°40'05"E	1073.63
14	N78°40'05"E	404.06	114	N79°38'10"E	1625.65
15	N79°38'10"E	402.00			
16	N79°38'10"E	491.66			

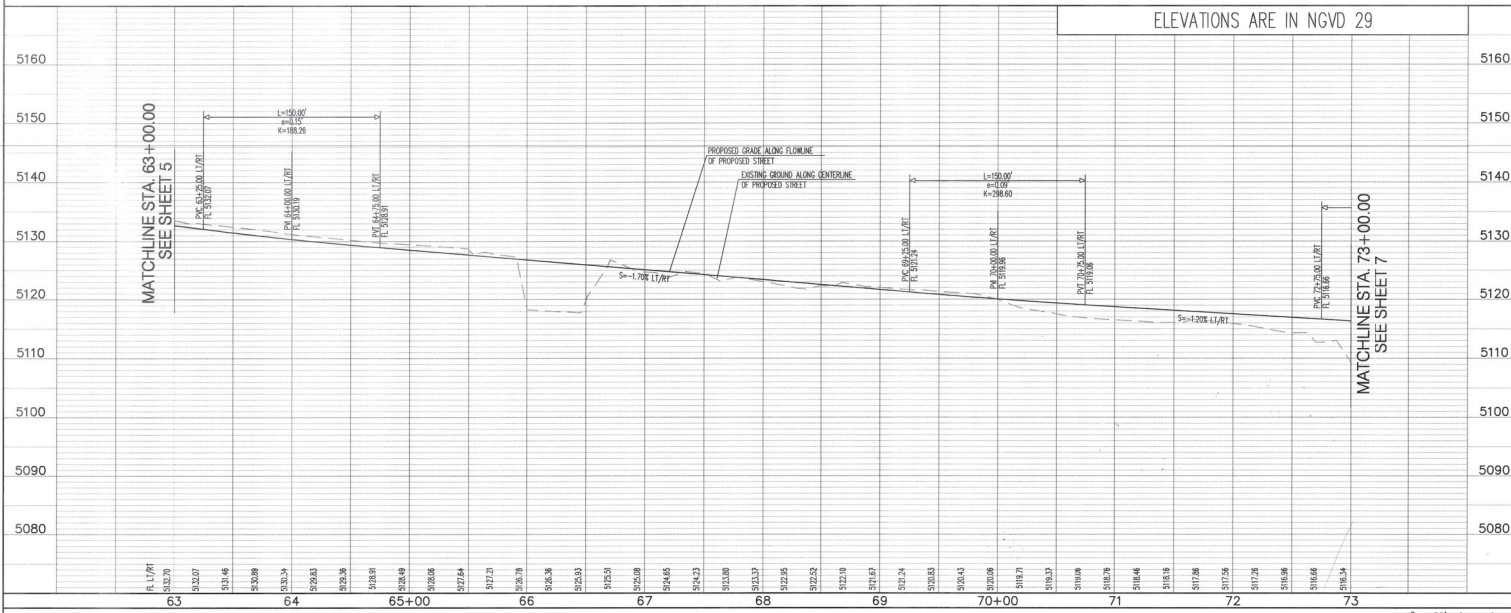

- NOTES**
1. THE CONTRACTOR SHALL FIELD VERIFY ALL EXISTING UTILITY LOCATIONS AND NOTIFY THE ENGINEER IMMEDIATELY OF ANY DISCREPANCIES.
 2. ALL CURB RETURN RADIUS SHALL BE 30' UNLESS OTHERWISE SPECIFIED.
 3. ALL CURVE DATA AND DIMENSIONS REFER TO FACE OF CURB UNLESS OTHERWISE SPECIFIED.
 4. GRADE ELEVATIONS, WHERE NOTED, ARE FOR FLOWLINE OF CURB UNLESS OTHERWISE SPECIFIED.
 5. CONTRACTOR IS TO INSTALL A 4" x 4" 5' POST AND END AT THE END OF EACH SANITARY SEWER SERVICE.
 6. CONTRACTOR IS RESPONSIBLE FOR REPAIR AND/OR REPLACEMENT OF ALL UTILITY CONDUITS AND EXISTING LINES.
 7. ANY ADDITIONAL GRADING REQUIRED TO MATCH PROPOSED STREET GRADES SHALL BE INCIDENTAL TO PAVING ITEMS.
 8. CONTRACTOR SHALL PROVIDE THE INSPECTORS, (CITY AND PRIVATE) WITH THE PROPOSED HYDROSTATIC TESTING PLAN. THE PLAN MUST BE APPROVED BEFORE TESTING OPERATIONS BEGIN.
 9. CONTRACTOR SHALL PARK EQUIPMENT AND VEHICLES AS NOT TO INTERFERE WITH NORMAL ACTIVITIES OF RESIDENTS OR OTHER CONTRACTORS ON SITE.
 10. ANY DAMAGE TO THE EXISTING FACILITIES (CURB & GUTTER, PAVEMENT, CONDUITS, LANDSCAPING, UTILITY LINES ETC.) DURING CONSTRUCTION SHALL BE REPLACED AT THE CONTRACTOR'S EXPENSE.
 11. REMOVAL OF THE EXISTING CURB & GUTTER SHALL BE PER COA STD. DWG. 2415 (SANDOUT ONLY).
 12. WHEELCHAIR RAMPS SHALL BE CONSTRUCTED PRIOR TO ACCEPTANCE OF CURB & GUTTER.

KEYED NOTES

- * [1] BUILD ARTERIAL PAVEMENT PER ARTERIAL SECTION, SHEET 13.
- * [2] INSTALL 6" CONCRETE VALLEY GUTTER PER COA STD. DWG. 2420.
- * [3] BUILD STD. CURB & GUTTER PER COA STD. DWG. 2415A.
- * [4] BUILD EXTRUDED ASPHALT CURB PER COA STD. DWG. 2415B.
- * [5] EDGE OF PROPOSED ASPHALT.
- * [6] BUILD 6" SIDEWALK PER COA STD. DWG. 2430.
- * [7] BUILD 8" ASPHALT PATH PER COA STD. DWG. 2415B & DETAIL SHEET 13.
- * [8] INSTALL SPECIAL HANDICAP RAMP "B" SHEET 13.
- * [9] BUILD MEDIAN CURB & GUTTER PER COA STD. DWG. 2415B.
- * [10] BUILD CONCRETE MEDIAN PAVING PER COA STD. DWG. 2405.
- * [11] INSTALL HANDICAP RAMP PER HANDICAP RAMP DETAIL "B", SEE SHEET 13.
- * [12] BUILD RESIDENTIAL PAVEMENT PER RESIDENTIAL SECTION, SHEET 13.
- * [13] BUILD TEMPORARY PAVEMENT PER TEMPORARY SECTION, SHEET 13.
- * [14] INSTALL 4" STAMPED CONCRETE 10' BACK FROM MEDIAN NOSE BAWA RED, RUNNING BOND PATTERN.

1	2	3	4	5	6	7	8	9	10	11	12	13	14	15
26	7	2	2	7	8	1	1	6	6	6	6	6	6	6

* NOT USED THIS SHEET.

Bohannon & Huston
 7000 Jefferson St. NE Albuquerque, NM 87109-4386
 ENGINEERING • SPATIAL DATA • ADVANCED TECHNOLOGIES


CITY OF ALBUQUERQUE
 PUBLIC WORKS DEPARTMENT

GIBSON BLVD. IMPROVEMENTS
 PAVING PLAN AND PROFILE
 GIBSON BLVD. 64+00.00 - 74+00.00

Design/Review Committee	City Engineer Approval	City Engineer Update	Ms./Day/Tr.	Ms./Day/Tr.
JAN 28 2004	FEB 4 2004			

City Project No. **722781** Zone Map No. **M-9, N-9** Sheet **6** Of **27**

AS-BUILT INFORMATION		BENCH MARKS		SURVEY INFORMATION		FIELD NOTES		ENGINEER'S SEAL	
CONTRACTOR	DATE	AS-BUILT	DATE	NO.	BY	NO.	BY	NO.	BY
Bohannon & Huston	1/15/04	AS-BUILT	1/15/04						
PROJECT NO.	DATE	PROJECT NO.	DATE						
722781	1/15/04	722781	1/15/04						
MICROFILM INFORMATION				REVISIONS					
MICROFILM INFORMATION				DESIGN					
MICROFILM INFORMATION				DATE: 08/03					
MICROFILM INFORMATION				DATE: 08/03					
MICROFILM INFORMATION				DATE: 08/03					
MICROFILM INFORMATION				DATE: 08/03					

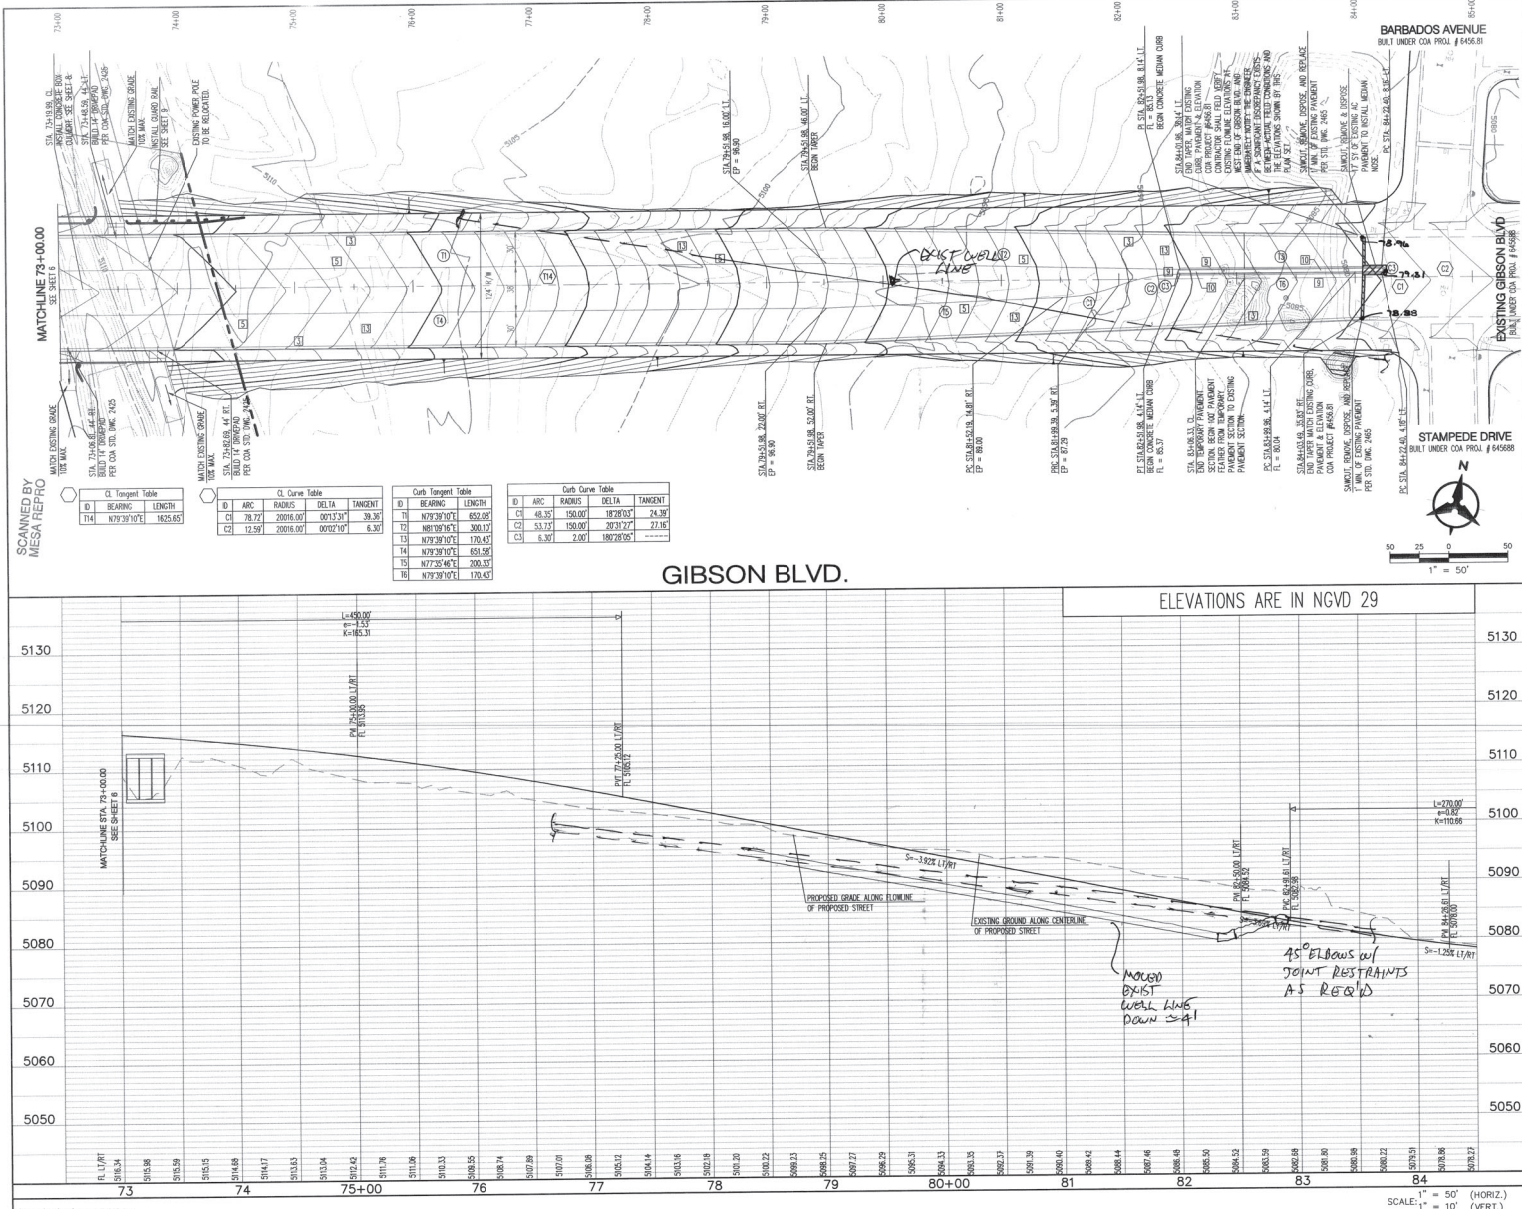

NOTES

1. THE CONTRACTOR SHALL FIELD VERIFY ALL EXISTING UTILITY LOCATIONS AND NOTIFY THE ENGINEER IMMEDIATELY OF ANY DISCREPANCIES.
2. ALL CURB RETURN RADIUS SHALL BE 30' UNLESS OTHERWISE SPECIFIED.
3. ALL CURVE DATA AND DIMENSIONS REFER TO FACE OF CURB UNLESS OTHERWISE SPECIFIED.
4. GRADE ELEVATIONS, WHERE NOTED, ARE FOR FLOWLINE OF CURB UNLESS OTHERWISE SPECIFIED.
5. CONTRACTOR IS TO INSTALL A 4" x 4" x 5' POST AND END AT THE END OF EACH SANITARY SEWER SERVICE.
6. CONTRACTOR IS RESPONSIBLE FOR REPAIR AND/OR REPLACEMENT OF ALL UTILITY CONDUITS AND EXISTING LINES.
7. ANY ADDITIONAL GRADING REQUIRED TO MATCH PROPOSED STREET GRADES SHALL BE INCIDENTAL TO PAVING ITEMS.
8. CONTRACTOR SHALL PROVIDE THE INSPECTORS (CITY AND PRIVATE) WITH THE PROPOSED HYDROSTATIC TESTING PLAN. THE PLAN MUST BE APPROVED BEFORE TESTING OPERATIONS BEGIN.
9. CONTRACTOR SHALL PARK EQUIPMENT AND VEHICLES AS NOT TO INTERFERE WITH NORMAL ACTIVITIES OF RESIDENTS OR OTHER CONTRACTORS ON SITE.
10. ANY DAMAGE TO THE EXISTING FACILITIES (CURB & GUTTER, PAVEMENT, CONDUITS, LANDSCAPING, UTILITY LINES ETC.) DURING CONSTRUCTION SHALL BE REPLACED AT THE CONTRACTOR'S EXPENSE.
11. REMOVAL OF THE EXISTING CURB & GUTTER SHALL BE PER COA STD. DWG. 2415 (SMOOTH ONLY).
12. WHEELBAR RAMP SHALL BE CONSTRUCTED PRIOR TO ACCEPTANCE OF CURB & GUTTER.

KEYED NOTES

- * [1] BUILD ARTERIAL PAVEMENT PER ARTERIAL SECTION, SHEET 13.
- * [2] INSTALL 6" CONCRETE VALLEY GUTTER PER COA STD. DWG. 2420.
- * [3] BUILD STD. CURB & GUTTER PER COA STD. DWG. 2415A.
- * [4] BUILD EXTRUDED ASPHALT CURB PER COA STD. DWG. 2415B.
- * [5] EDGE OF PROPOSED ASPHALT.
- * [6] BUILD 6" SIDEWALK PER COA STD. DWG. 2430.
- * [7] BUILD 8" ASPHALT PATH PER COA STD. DWG. 2415B & DETAIL, SHEET 13.
- * [8] INSTALL SPECIAL HANDICAP RAMP "B" SHEET 13.
- * [9] BUILD MEDIAN CURB & GUTTER PER COA STD. DWG. 2415B.
- * [10] BUILD CONCRETE MEDIAN PAVING PER COA STD. DWG. 2408.
- * [11] INSTALL HANDICAP RAMP PER HANDICAP RAMP DETAIL "B" SEE SHEET 13.
- * [12] BUILD RESIDENTIAL PAVEMENT PER RESIDENTIAL SECTION, SHEET 13.
- * [13] BUILD TEMPORARY PAVEMENT PER TEMPORARY SECTION, SHEET 13.
- * [14] INSTALL 4" STAMPEDE CONCRETE 10' BACK FROM MEDIAN NOSE BAJA RED, RUNNING BOND PATTERN.

* NOT USED THIS SHEET.

Bohannon & Huston
 Courtyard 1 7800 Jefferson St. NE Albuquerque, NM 87109-4385
 ENGINEERING & SPATIAL DATA • ADVANCED TECHNOLOGIES



CITY OF ALBUQUERQUE
 PUBLIC WORKS DEPARTMENT

GIBSON BLVD. IMPROVEMENTS
 PAVING PLAN AND PROFILE
 GIBSON BLVD. 74+00.00

Design Review Committee	City Engineer Approval	Mo./Day/Yr.	Mo./Day/Yr.
JAN 28 2024	FEB 4 2024		
City Project No. 722781	Zone Map No. M-9, N-9	Sheet 7	Of 27

SCANNED BY
MESA REPRO

\\cityofalbuquerque\proj\040111\JMP07.dwg
January 15, 2008 - 12:54pm

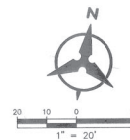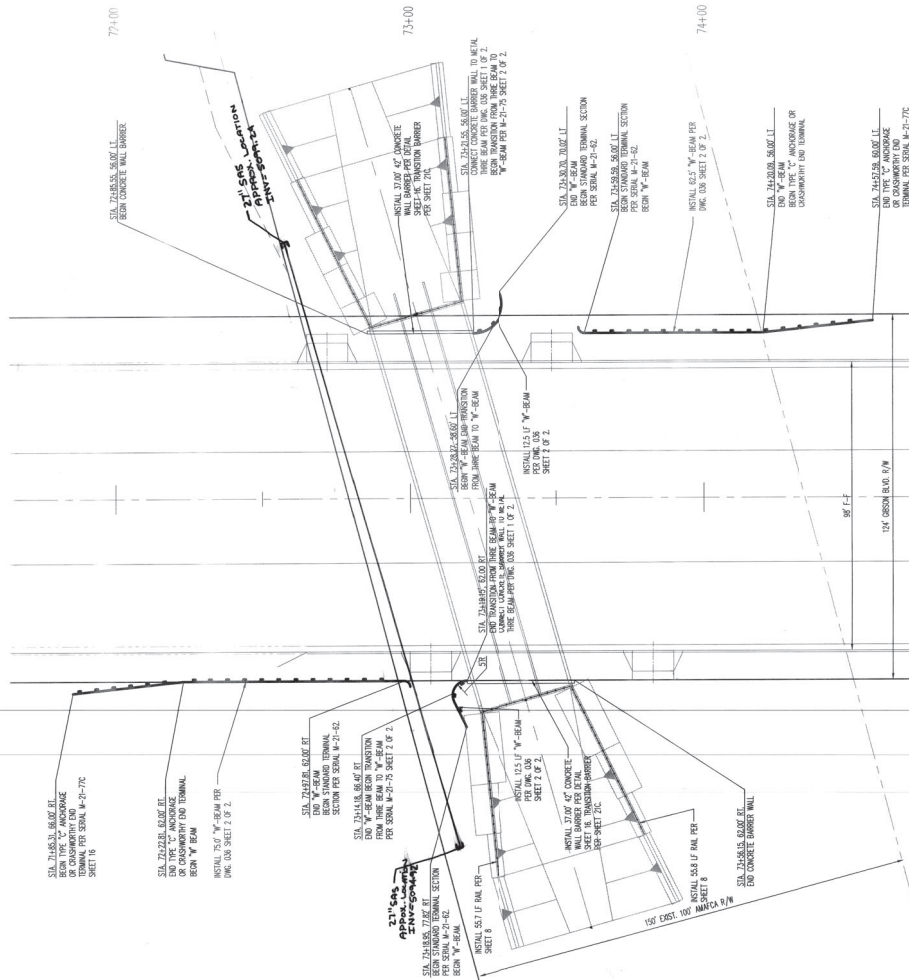




1 2 3 4 5 6 7 8 9 10 11 12 13 14 15
26 27 28 29 30 31 32 33 34 35

Bohannon & Huston Countywide 7000 Jefferson St. NE Albuquerque, NM 87109-0895 ENGINEERING • SPATIAL DATA • ADVANCED TECHNOLOGIES	
CITY OF ALBUQUERQUE PUBLIC WORKS DEPARTMENT GIBSON BLVD. IMPROVEMENTS PAVING PLAN GUARD RAIL AT AMOLE ARROYO CROSSING	
Design/Review Committee JAN 28 2008	City Engineer Approval FEB - 4 2008
City Project No. 722781	Zone Map No. M-9, N-9
Sheet 9	Of 27

ENGINEER'S SEAL		SURVEY INFORMATION		BENCH MARKS		AS-BUILT INFORMATION	
No.	Date	No.	Date	AS-BRASS TABLET STAMPED "TRANS"		CONTRACTOR New Concepts	
				Geographic Position (NAD 1927)		Drawn By ALS	
				N.M. State Plane Coordinates (Central Zone)		Checked By ALS	
				X = 354,899.45 Y = 1,471,922.87		DATE 06-4	
				Ground to Grid Factor = 0.99987921		DATE 06-4	
				E.U. = 50.001642		MICROFILM INFORMATION	
				SUD 1929 Elevation = 5118.43		RECORDED BY	
						DATE	
						No.	

SCANNED BY
MESA RETRO

MATCHLINE 62+00.00
SEE ABOVE RIGHT

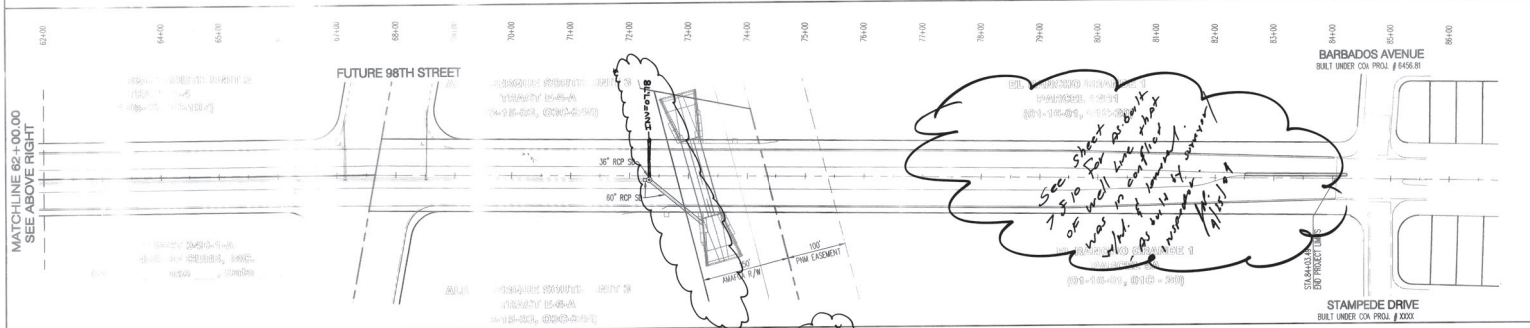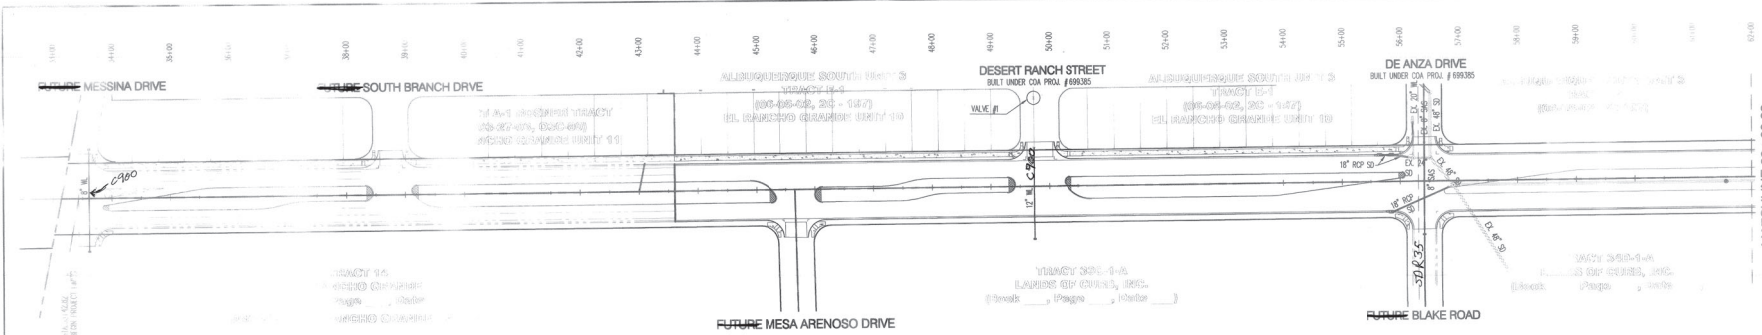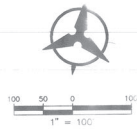

GENERAL NOTES

1. THE CONTRACTOR SHALL FIELD VERIFY ALL EXISTING UTILITY LOCATIONS AND NOTIFY THE ENGINEER IMMEDIATELY OF ANY DISCREPANCIES.
2. ALL CURB DATA AND DIMENSIONS ARE CALCULATED FROM CENTERLINE OF PIPE OR MANHOLE. ALL SAS & SD SLOPES ARE CALCULATED TO TRUE PIPE DIMENSIONS FROM INVERT TO INVERT. (P&T ITEMS ARE SHOWN IN PARENTHESES)
3. GRADE ELEVATIONS, WHERE NOTED, ARE FOR FLOWLINE OF CURB UNLESS OTHERWISE SPECIFIED.
4. CONTRACTOR IS TO INSTALL A 4" X 4" X 5' POST AND END AT THE END OF EACH SANITARY SEWER SERVICE.
5. CONTRACTOR IS RESPONSIBLE FOR REPAIR AND/OR REPLACEMENT OF ALL UTILITY CONDUITS AND EXISTING LINES.
6. CONTRACTOR SHALL PROVIDE THE INSPECTORS WITH THE PROPOSED TESTING PLAN. THE PLAN MUST BE APPROVED BEFORE TESTING OPERATIONS BEGIN.
7. CONTRACTOR SHALL PARK EQUIPMENT AND VEHICLES AS NOT TO INTERFERE WITH NORMAL ACTIVITIES OF RESIDENTS OR OTHER CONTRACTORS ON SITE.
8. ANY DAMAGE TO THE EXISTING FACILITIES (CURB & GUTTER, PAVEMENT, CONDUITS, LANDSCAPING, UTILITY LINES, ETC) DURING CONSTRUCTION SHALL BE REPLACED AT THE CONTRACTOR'S EXPENSE.
9. WHEN RIMS & CATCH BASIN INLET ELEVATIONS, VALVE BOXES, ANY FIRE HYDRANT & FLANGE ELEVATIONS ARE APPROPRIATE, CONTRACTOR SHALL FIELD VERIFY AND ADJUST TO FINAL PAVEMENT GRADES.
10. SAS STATIONING FOLLOWING CL OF ROAD UNLESS OTHERWISE NOTED.
11. FLOWLINE ELEVATIONS FOR DROP INLETS ARE PROJECTED FROM FLOWLINE OF STANDARD CURB TO WOODS OF DOWNSIDE GRATE.
12. ALL WATERLINE APPURTENANCES SHALL USE BLODING.
13. FOR STORM DRAIN CONSTRUCTION: ALL RCP JOINTS SHALL NOT BE GROUDED PRIOR TO FINAL INSPECTION. FINAL INSPECTION SHALL DETERMINE WHICH JOINTS ARE TO BE GROUDED FOR FINAL ACCEPTANCE OF THE CONSTRUCTION.
14. ALL EXCAVATION, TRENCHING AND SHORING ACTIVITIES MUST BE CARRIED-OUT IN ACCORDANCE WITH OSHA 29 CFR 1926.650 SUBPART P.

MATERIALS:

SAS LINE: 300-5 PVC

WATER LINE: C900-PVC

WATER SHUT-OFF PLAN:

FOR CONNECTION VALVE CLOSED
DESERT RANCH STREET VALVE #1

CONTRACTOR WILL BE RESPONSIBLE FOR FLUSHING, DISINFECTING, AND TESTING THE LINES AS REQUIRED BY THE CITY OF ALBUQUERQUE.

WATER SHUT-OFF REQUIREMENTS:

CONTRACTOR WILL BE RESPONSIBLE FOR THE TIMING AND COORDINATION OF THE WATER SHUT-OFF REQUIREMENTS IN CONJUNCTION WITH THE COMPLETION OF CONNECTIONS. AT LEAST SEVEN (7) WORKING DAYS PRIOR TO CONSTRUCTION, THE CONTRACTOR SHALL CONTACT THE CITY OF ALBUQUERQUE (981-8800) TO INITIATE IMPLEMENTATION OF THE WATER SHUT-OFF PLAN. CONTRACTOR SHALL NOT OPERATE VALVES ON THE PROJECT.

LEGEND

- PROPERTY LINE
- NEW EASEMENT
- SAS
- EXISTING SANITARY SEWER
- EXISTING WATER LINE
- EXISTING STORM DRAIN
- EXISTING WATER METER
- EXISTING CAP
- EXISTING VALVE
- EXISTING FIRE HYDRANT
- EXISTING SANITARY SEWER MANHOLE
- EXISTING STORM DRAIN
- SAS
- PROPOSED SANITARY SEWER
- PROPOSED WATER LINE
- PROPOSED VALVE
- PROPOSED HYDRANT
- PROPOSED CAP
- PROPOSED WATER METER
- PROPOSED SANITARY SEWER MANHOLE
- PROPOSED STORM DRAIN
- PROPOSED STREET LIGHT

Bohannon & Huston




Contract # 7000 Jefferson St NE Albuquerque, NM 87109-0885
ENGINEERING & SPATIAL DATA • ADVANCED TECHNOLOGIES



CITY OF ALBUQUERQUE
PUBLIC WORKS DEPARTMENT

GIBSON BLVD. IMPROVEMENTS
OVERALL UTILITY PLAN

Design/Review Committee	City Engineer Approval	Mo./Day/Yr.	Mo./Day/Yr.
DESIGN REVIEW COMMITTEE	CITY ENGINEER	JAN 28 2004	FEB - 4 2004
City Project No.	Zone Map No.	Sheet	Of
722781	M-9, N-9	10	27

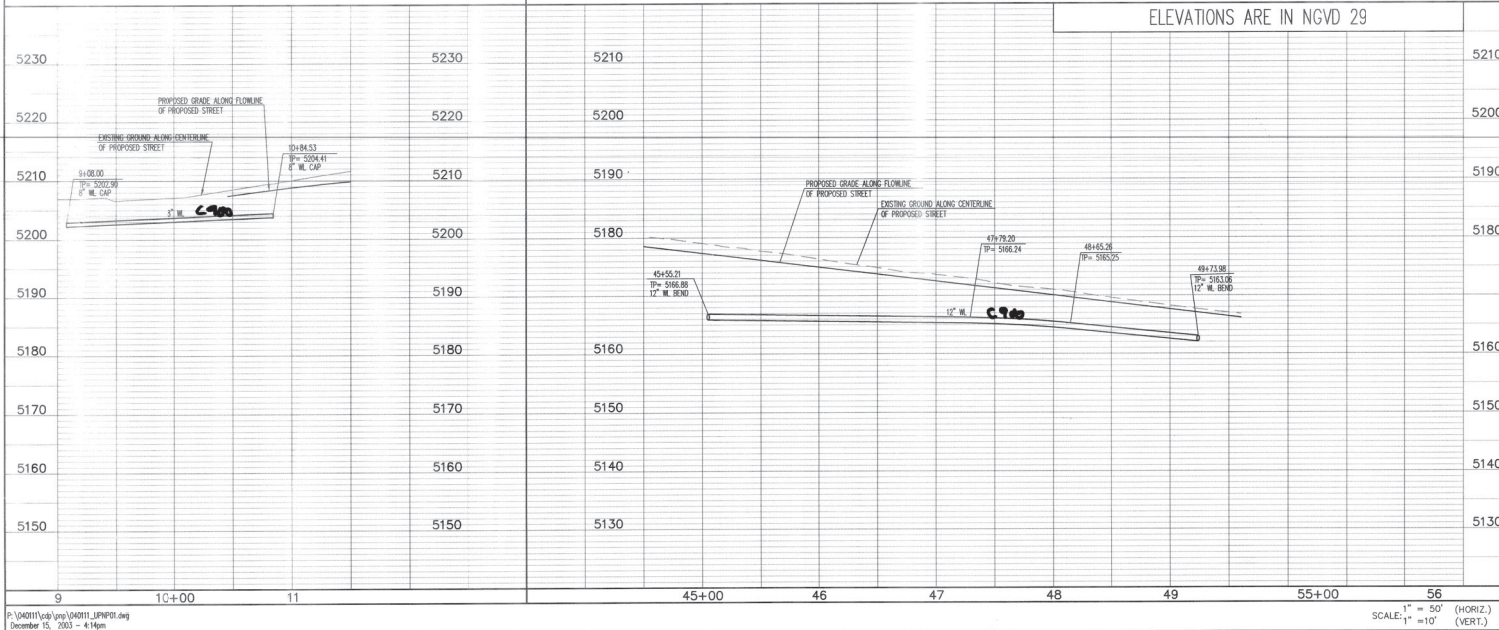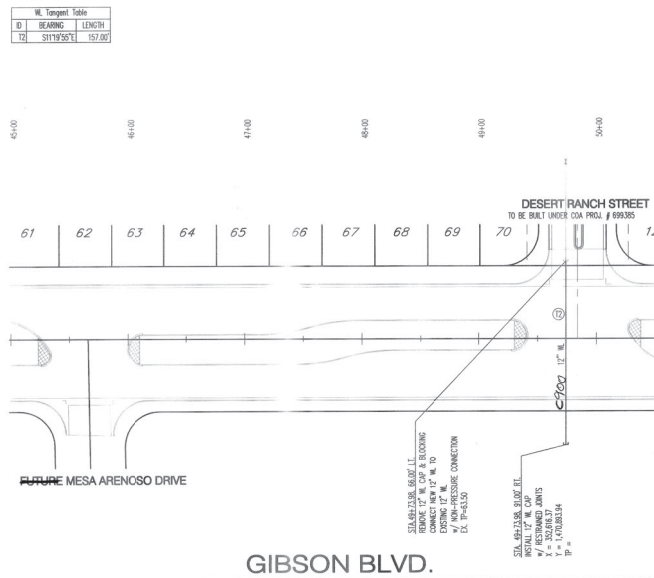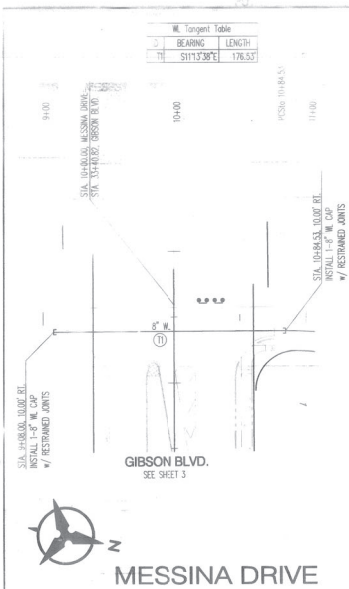

GENERAL NOTES

- THE CONTRACTOR SHALL VERIFY ALL EXISTING UTILITY LOCATIONS AND NOTIFY THE ENGINEER IMMEDIATELY OF ANY DISCREPANCIES.
- ALL CURB DATA AND ELEVATIONS ARE CALCULATED FROM CENTERLINE OF PAVEMENT. ALL CURB ELEVATIONS SHALL BE ADJUSTED TO 30 INVERT FEET FROM INVERT TO INVERT. PAIEMENT IS CONSIDERED IN PLACE.
- GRADE ELEVATIONS, WHEN NOTED, ARE FOR FLOWLINE OF STANDARD CURB UNLESS OTHERWISE NOTED.
- CONTRACTOR IS TO INSTALL A 4" x 4" POST AND DAD AT THE END OF EACH SANITARY SEWER LINE.
- CONTRACTOR IS RESPONSIBLE FOR DETECT AND REPAIR/REPLACE ALL UTILITY CONFLICTS AND EXISTING LINES.
- CONTRACTOR SHALL PROVIDE THE INSPECTORS WITH THE PROPOSED TESTING PLAN. THE PLAN MUST BE APPROVED BEFORE TESTING OPERATIONS BEGIN.
- CONTRACTOR SHALL PARK COMPACTORS AND VEHICLES AS NOT TO INTERFERE WITH EXISTING UTILITIES OR CAUSE DAMAGE TO EXISTING CONDUITS OR USE.
- ANY DAMAGE TO THE EXISTING FACILITIES (CABLE & OTHER) PUNCTURES, CONDUITS, LANDSCAPING, UTILITY LINES, ETC.) DURING CONSTRUCTION SHALL BE REPAIRED BY THE CONTRACTOR AT HIS OWN EXPENSE.
- WEIR AND GATEY BASIN MUST ELEVATIONS. THE WEIR AND GATE ELEVATIONS ARE APPROXIMATE. CONTRACTOR SHALL VERIFY AND ADJUST TO FINAL PAVEMENT GRADES.
- SAS STATIONS FOLLOWES C&D ROAD UNLESS OTHERWISE NOTED.
- STATIONING OF DROP INLET IS TO BE WOODEN DOWEL GRATE AT FACE OF CURB.
- FLOWLINE ELEVATIONS FOR DROP INLETS ARE PROJECTED FROM FLOWLINE OF STANDARD CURB TO WOODEN DOWEL GRATE.
- ALL WATER APPURTENANCES SHALL USE RESTRAINED JOINTS.
- FOR STORM DRAIN CONNECTION, ALL RCP JOINTS SHALL NOT BE GROUDED OR GROUTED. ALL JOINTS SHALL BE GROUDED FOR ALL STORM DRAINING JOINTS ARE TO BE GROUDED FOR FINAL ACCEPTANCE OF THE CONSTRUCTION.

SURVEY INFORMATION		BENCH MARKS		AS-BUILT INFORMATION	
NO.	FIELD NOTES BY DATE			CONTRACTOR DRAUGHTED BY DATE	REVISIONS DATE
	MC5 BRASS TABLET STAMPED "TRANS"			ALB	NEW CONCEPTS
	Geographic Position (IND 1927)			Approved by: LCU	10/1/04
	N.M. Slide Plane Coordinates (Control Zone)			Reviewed by: ALB	8/24/04
	Ex 354,899.45 N 147,662.69 E			Checked by: ALB	8/24/04
	Ex 354,899.45 N 147,662.69 E			Micro-Information	
	Alt = -207.1642'			RECORDED BY: ALB	DATE
	SLD 1929 Elevation = 5118.43				

ENGINEER'S SEAL

[illegible]

--	--	--	--

ER	
TIME	
WEM	
ROFIL	
ON BI	

4-9

[illegible]

QU
NT
ENT
E
WD.
/Day/

Sheet

REMARKS	By

No.	Date
-----	------

E	
S	
f_i	

11

VISIONS
DESIGN

	0
Continued on next page	
K	

Mo./Do.

Of

LEGEND

- | | |
|---|--------------------------|
|  | DOUBLE WATER METER |
|  | SINGLE WATER METER |
|  | WATER LINE SHUTOFF VALVE |
|  | WATER LINE TEE |
|  | SAS LATERAL |
|  | SAS MANHOLE |
|  | STORM DRAIN MANHOLE |
|  | STORM DRAIN INLET |
|  | PROPOSED FIRE HYDRANT |
|  | EXISTING WATER VALVE |
|  | PROPOSED STREET LIGHT |

1	2	3	4	5	6	7	8	9	10	11	12	13	14	15
2	6		7	2	2	7	.	8	1		1	1	0	9

Bohannon ▲ Huston, inc.

Courtyard | 7500 Jefferson St. NE Albuquerque, NM 87109-4335
ENGINEERING • SPATIAL DATA • ADVANCED TECHNOLOGIES

CITY OF ALBUQUERQUE
PUBLIC WORKS DEPARTMENT

**GIBSON BLVD. IMPROVEMENTS
UTILITY PLAN AND PROFILE
MESSINA DRIVE / GIBSON BLVD.**

Design Review Committee

City Engineer Approval

Update	Mo./Day/Yr.

FEB - 4 2004

Design		
--------	--	--

City Project No. _____

CITY ENGINEER

Last	
ap No.	Sheet

72





2781	M-9
------	-----

, N-9	11
-------	----

P:\040111\cdp\jnp\040111_UPNP01.dwg
December 15, 2003 - 4:14pm

SCALE: $1'' = 50'$ (HORIZ.)
 $1'' = 10'$ (VERT.)

SCANNED BY
MESA HEPHO

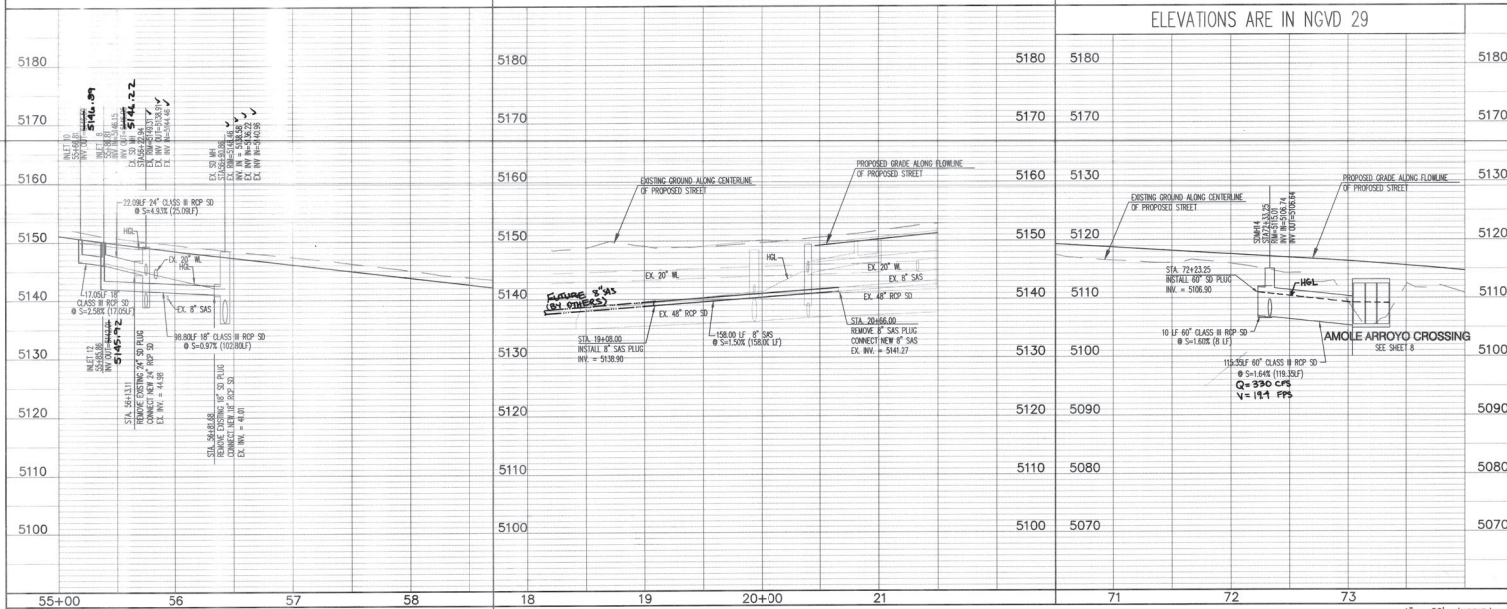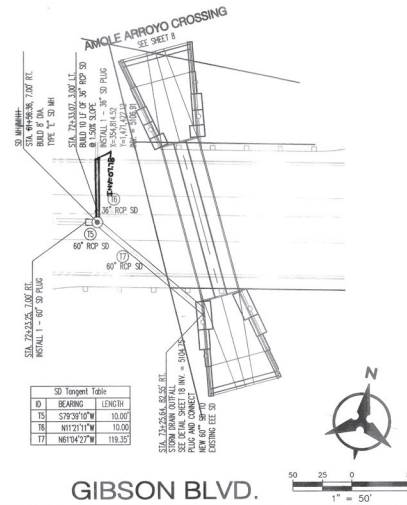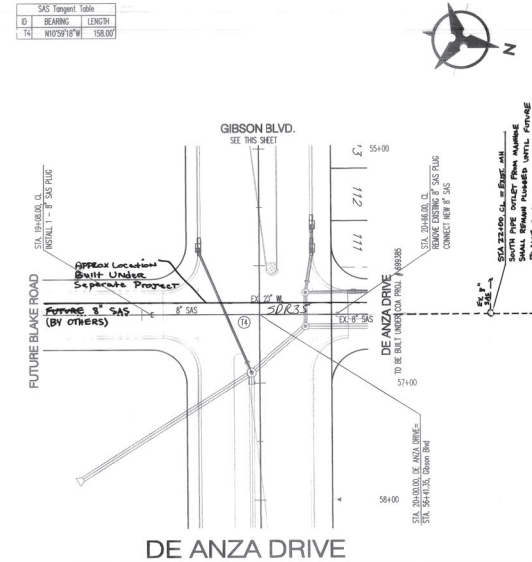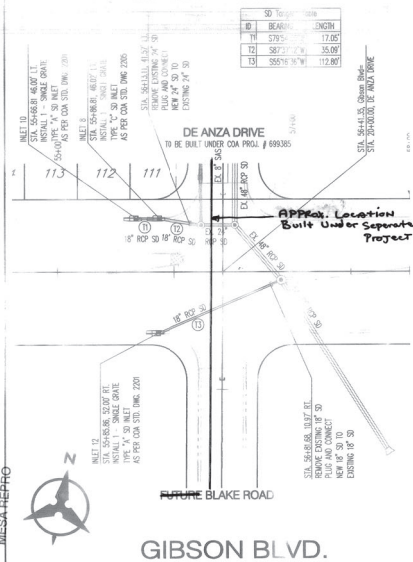

- GENERAL NOTES**
- THE CONTRACTOR SHALL FIELD VERIFY ALL EXISTING UTILITY LOCATIONS AND NOTIFY THE ENGINEER IMMEDIATELY OF ANY DISCREPANCIES.
 - ALL CURVE DATA AND DIMENSIONS ARE CALCULATED FROM CENTERLINE OF PIPE OR MANHOLE. ALL SAS & SD SLOPES ARE CALCULATED TO THREE PIPE DIMENSIONS FROM INVERT TO INVERT. PAVE FLOORS ARE SHOWN IN PARENTHESES.
 - GRADE ELEVATIONS, WHERE NOTED, ARE FOR FLOWLINE OF STANDARD CURB UNLESS OTHERWISE SPECIFIED.
 - CONTRACTOR IS TO INSTALL A 4" X 4" X 5' POST AND END AT THE END OF EACH SENTRY SERVICE.
 - CONTRACTOR IS RESPONSIBLE FOR REPAIR AND/OR REPLACEMENT OF ALL UTILITY CONDUITS AND EXISTING LINES.
 - CONTRACTOR SHALL PROVIDE THE INSPECTORS WITH THE PROPOSED TESTING PLAN. THE PLAN MUST BE APPROVED BEFORE TESTING OPERATIONS BEGIN.
 - CONTRACTOR SHALL PARK EQUIPMENT AND VEHICLES AS NOT TO INTERFERE WITH NORMAL ACTIVITIES OF RESIDENTS OR OTHER CONTRACTORS ON SITE.
 - ANY DAMAGE TO THE EXISTING FACILITIES (CURB & GUTTER, PAVEMENT, CONCRETE, LANDSCAPING, UTILITY LINES, ETC.) DURING CONSTRUCTION SHALL BE REPLACED AT THE CONTRACTOR'S EXPENSE.
 - MANHOLE & CATCH BASIN INLET ELEVATIONS, FIRE HYDRANT & FLANGE ELEVATIONS ARE APPROXIMATE. CONTRACTOR SHALL FIELD VERIFY AND ADJUST TO FINAL PAVEMENT GRADES.
 - SAS STATIONING FOLLOWS CL OF ROAD UNLESS OTHERWISE NOTED.
 - STATIONING OF DROP INLET IS TO MIDDLE OF DOWN HILL GRATE AT FACE OF CURB.
 - FLOWLINE ELEVATIONS FOR DROP INLETS ARE PROJECTED FROM FLOWLINE OF STANDARD CURB TO MIDDLE OF DOWNHILL GRADE.
 - ALL WATERLINE APPROPRIATIONS SHALL USE RESTRAINED JOINTS.
 - FOR STORM DRAIN CONSTRUCTION, ALL JOINTS SHALL NOT BE GROUDED PRIOR TO FINAL INSPECTION. FINAL INSPECTION SHALL DETERMINE WHICH JOINTS ARE TO BE GROUDED FOR FINAL ACCEPTANCE OF THE CONSTRUCTION.

LEGEND

- DOUBLE WATER METER
- SINGLE WATER METER
- WATER LINE SHUTOFF VALVE
- WATER LINE TEE
- SAS LATERAL
- SAS MANHOLE
- STORM DRAIN MANHOLE
- STORM DRAIN INLET
- PROPOSED FIRE HYDRANT
- EXISTING WATER VALVE
- PROPOSED STREET LIGHT


1 2 3 4 5 6 7 8 9 10 11 12 13 14 15
26 72227.81 1269

Bohannon & Huston
 7700 Jefferson St NE Albuquerque, NM 87109-4305
 ENGINEERING & SPATIAL DATA • ADVANCED TECHNOLOGIES




**CITY OF ALBUQUERQUE
 PUBLIC WORKS DEPARTMENT**
**GIBSON BLVD. IMPROVEMENTS
 UTILITY PLAN AND PROFILE
 GIBSON BLVD./DE ANZA DR.**

Design Review Committee	City Engineer Approval	Ms/2007/11	Ms/2007/11
JAN 28 2008	FEB 4 2008		
DESIGN REVIEW COMMITTEE	CITY ENGINEER		
City Project No. 722781	Zone Map No. M-9, N-9	Sheet 12	Of 27

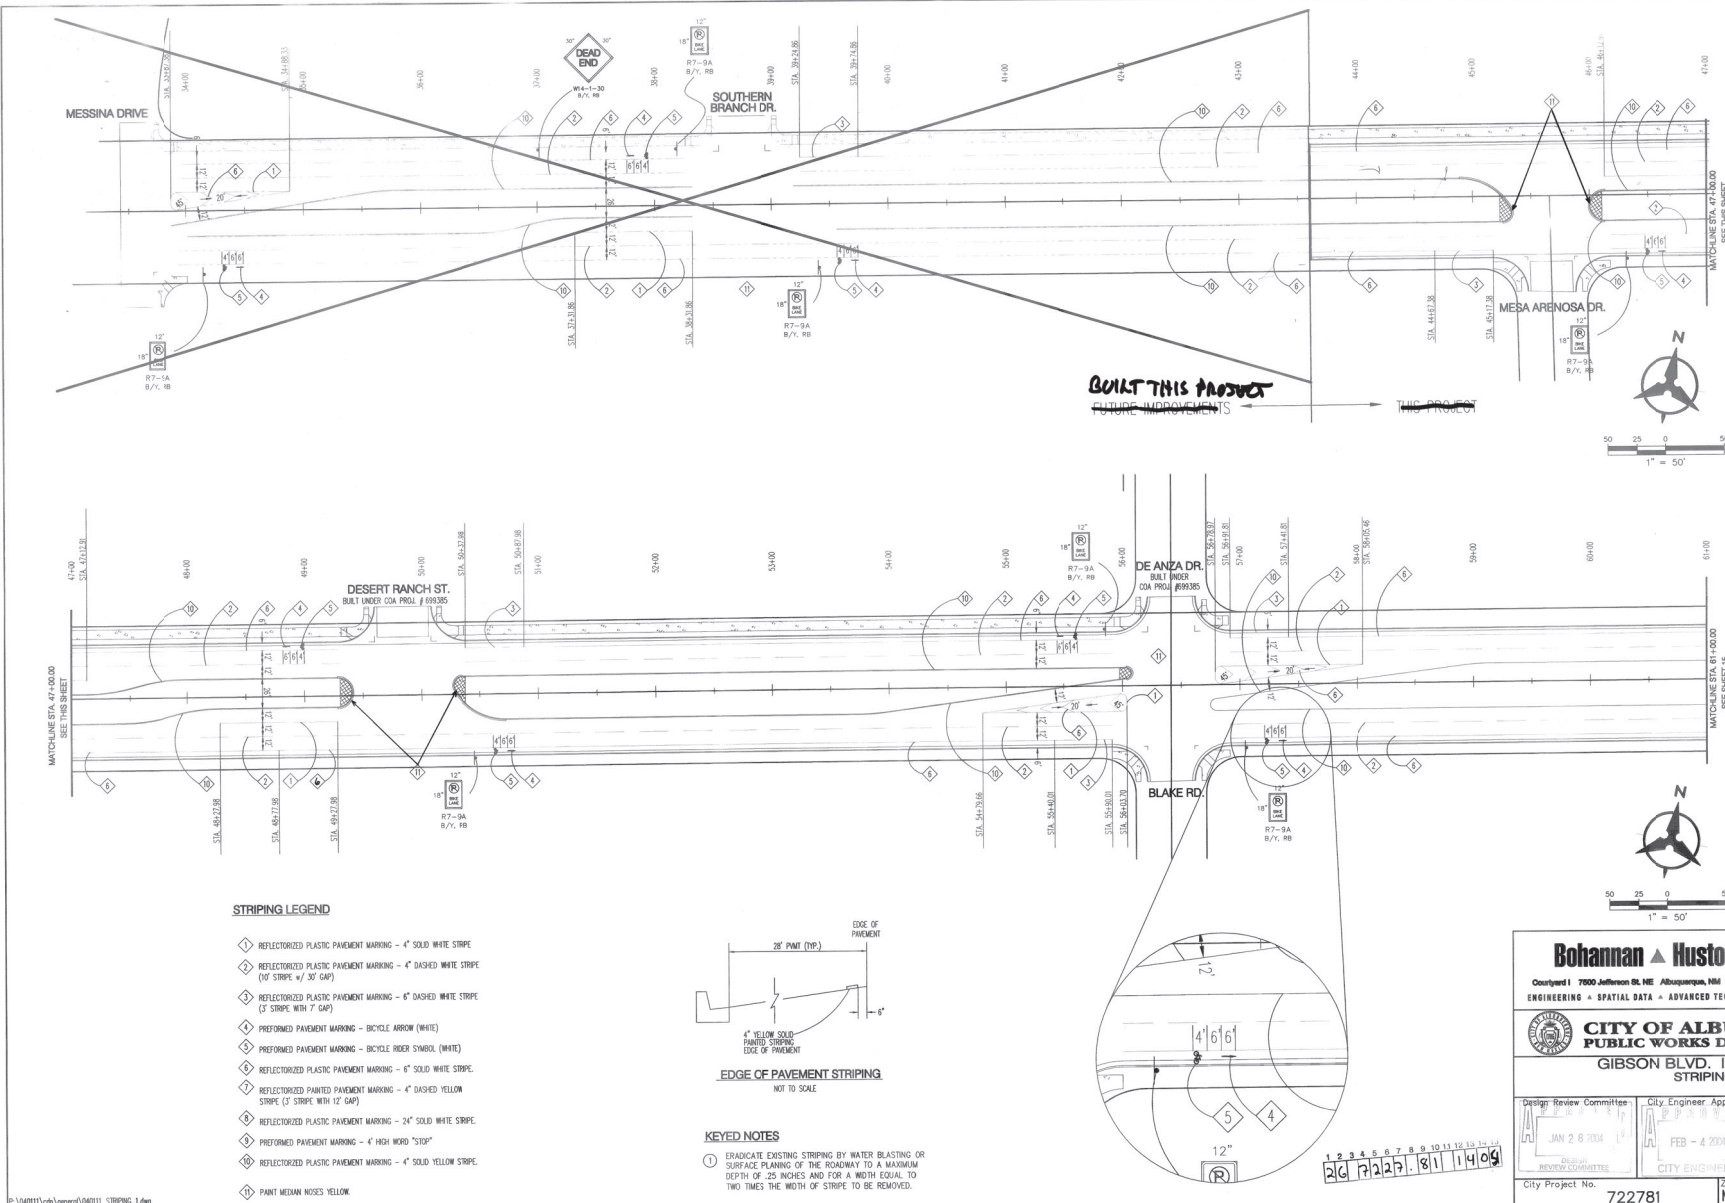

STRIPING LEGEND

- ① REFLECTORIZED PLASTIC PAVEMENT MARKING - 4" SOLID WHITE STRIPE
- ② REFLECTORIZED PLASTIC PAVEMENT MARKING - 4" DASHED WHITE STRIPE (6" STRIPE W/ 3" GAP)
- ③ REFLECTORIZED PLASTIC PAVEMENT MARKING - 6" DASHED WHITE STRIPE (5" STRIPE WITH 7" GAP)
- ④ PREFORMED PAVEMENT MARKING - BICYCLE ARROW (WHITE)
- ⑤ PREFORMED PAVEMENT MARKING - BICYCLE RIDER SYMBOL (WHITE)
- ⑥ REFLECTORIZED PLASTIC PAVEMENT MARKING - 6" SOLID WHITE STRIPE
- ⑦ REFLECTORIZED PLASTIC PAVEMENT MARKING - 4" DASHED YELLOW STRIPE (5" STRIPE WITH 12" GAP)
- ⑧ REFLECTORIZED PLASTIC PAVEMENT MARKING - 24" SOLID WHITE STRIPE
- ⑨ PREFORMED PAVEMENT MARKING - 4" HIGH WORD "STOP"
- ⑩ REFLECTORIZED PLASTIC PAVEMENT MARKING - 4" SOLID YELLOW STRIPE
- ⑪ PAINT MEDIAN NOSES YELLOW

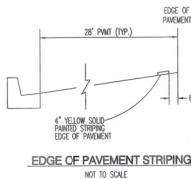

KEYED NOTES

- ① ERADICATE EXISTING STRIPING BY WATER BLASTING OR SURFACE PLANING OF THE ROADWAY TO A MAXIMUM DEPTH OF 25 INCHES AND FOR A WIDTH EQUAL TO TWO TIMES THE WIDTH OF STRIPE TO BE REMOVED.

**BUILT THIS PROJECT
FUTURE IMPROVEMENTS**


THIS PROJECT

Bohannon & Huston, Inc.
Overland 1 7500 Jefferson St. NE Albuquerque, NM 87109-4205
ENGINEERING • SPATIAL DATA • ADVANCED TECHNOLOGIES

**CITY OF ALBUQUERQUE
PUBLIC WORKS DEPARTMENT**
GIBSON BLVD. IMPROVEMENTS
STRIPING PLAN


Design Review Committee	City Engineer Approval	Mo./Day/Yr.	Mo./Day/Yr.
JAN 28 2004	FEB - 4 2004		
Design Review Committee	CITY ENGINEER	last Design Update	
City Project No. 722781	Zone Map No. M-9, N-9	Sheet 14	Of 27

ENGINEER'S SEAL		SURVEY INFORMATION		BENCH MARKS		AS-BUILT INFORMATION	
	REMARKS DESIGN DATE: 01/23/03 DRAWN BY: BAC CHECKED BY: BAC DATE: 02/03/03	NO.	BY	DATE	ACS BRASS TABLE STAMPED "TRANS"	CONTRACTOR	AS-BUILT INFORMATION
					Geographic Position (NAD 1927)	Bohannon & Huston, Inc.	Bohannon & Huston, Inc.
					N.M. State Plane Coordinates (Central Zone)	Bohannon & Huston, Inc.	Bohannon & Huston, Inc.
					X: 35489.89 E: 14712.57 Zone Factor = 0.99997921 A.C.S. = -007 61.42"	Bohannon & Huston, Inc.	Bohannon & Huston, Inc.
					SLD 1929 Elevation = 5118.43		

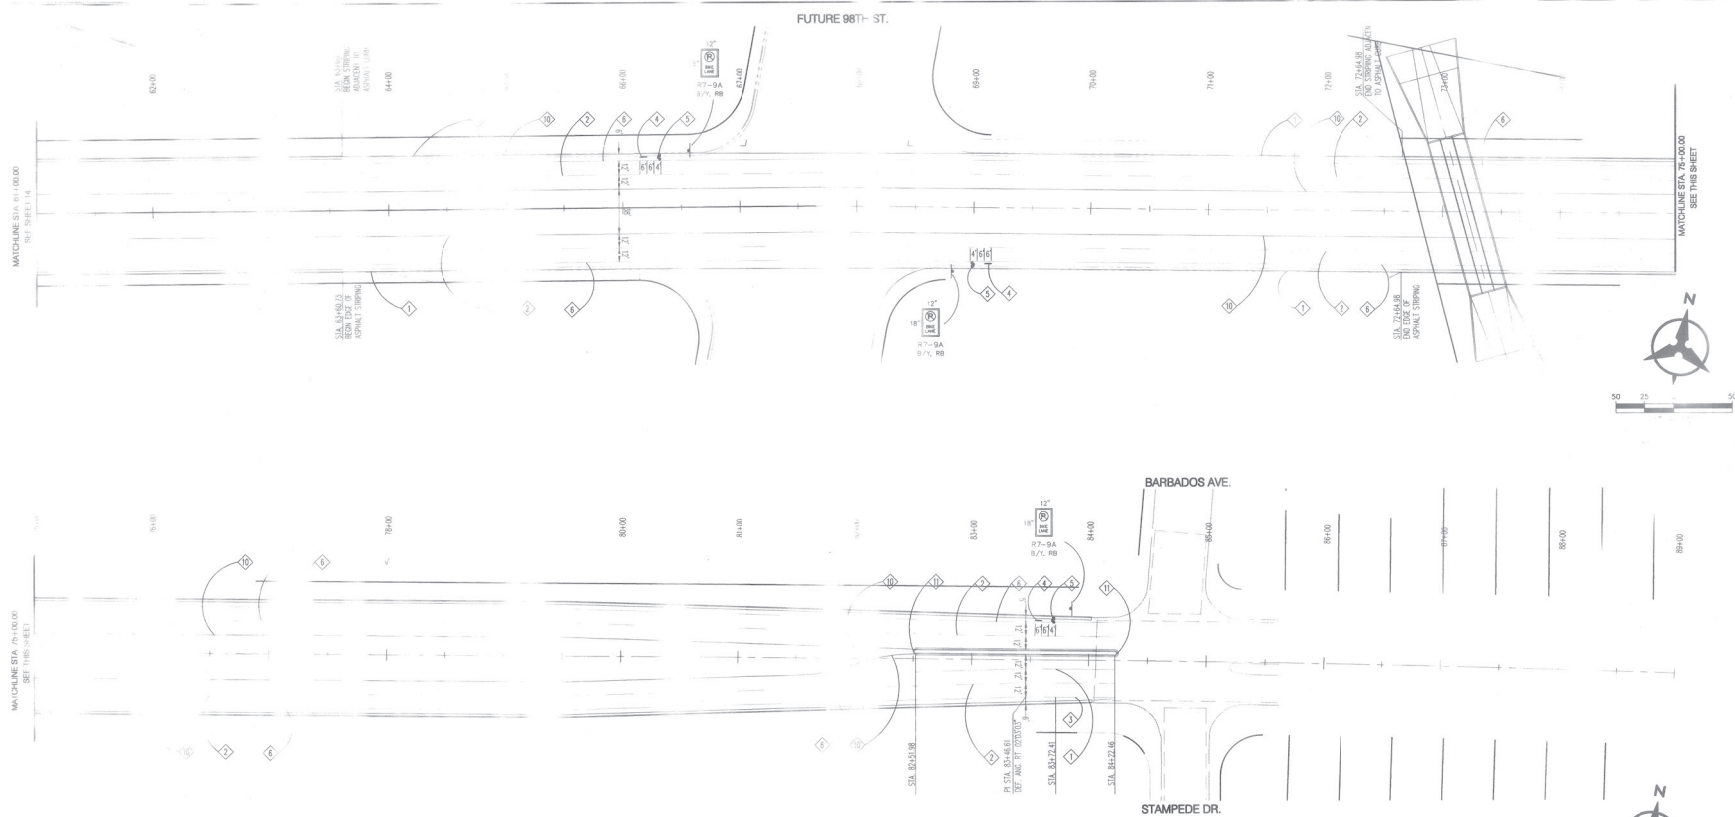

STRIPING LEGEND

- ① REFLECTORIZED PLASTIC PAVEMENT MARKING - 4" SOLID WHITE STRIPE
- ② REFLECTORIZED PLASTIC PAVEMENT MARKING - 4" DASHED WHITE STRIPE (10' STRIPE w/ 30' GAP)
- ③ REFLECTORIZED PLASTIC PAVEMENT MARKING - 6" DASHED WHITE STRIPE (3' STRIPE WITH 7' GAP)
- ④ PREFORMED PAVEMENT MARKING - BICYCLE ARROW
- ⑤ PREFORMED PAVEMENT MARKING - BICYCLE RIDER SYMBOL
- ⑥ REFLECTORIZED PLASTIC PAVEMENT MARKING - 6" SOLID WHITE STRIPE
- ⑦ REFLECTORIZED PLASTIC PAVEMENT MARKING - 4" DASHED YELLOW STRIPE (3' STRIPE WITH 12' GAP)
- ⑧ REFLECTORIZED PLASTIC PAVEMENT MARKING - 24" SOLID WHITE STRIPE
- ⑨ PREFORMED PAVEMENT MARKING - 4" HIGH WORD "STOP"
- ⑩ REFLECTORIZED PLASTIC PAVEMENT MARKING - 4" SOLID YELLOW STRIPE
- ⑪ PAINT MEDIAN NOSES YELLOW

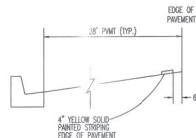

EDGE OF PAVEMENT STRIPING
NOT TO SCALE

KEYED NOTES

- ① ERADICATE EXISTING STRIPING BY WATER BLASTING OR SURFACE PLANING OF THE ROADWAY TO A MAXIMUM DEPTH OF .25 INCHES AND FOR A WIDTH EQUAL TO TWO TIMES THE WIDTH OF STRIPE TO BE REMOVED.

1 2 3 4 5 6 7 8 9 10 11 12 13 14 15
26 2227.81 1509

Bohannon & Huston
 17000 Jefferson Blvd NE Albuquerque, NM 87108-0385
 ENGINEERING • SPATIAL DATA • ADVANCED TECHNOLOGIES




CITY OF ALBUQUERQUE
PUBLIC WORKS DEPARTMENT
GIBSON BLVD. IMPROVEMENTS
STRIPING PLAN

Design Review Committee: JAN 28 2004
 City Engineer Approval: FEB - 4 2004
 City Engineer: [Signature]
 City Engineer: [Signature]


Mo. Appr. / Cr. Mo. Appr. / Cr.
 [Signature] [Signature]
 [Signature] [Signature]

City Project No. 722781 Zone Map No. M-9, N-9 Sheet 15 of 27


ENGINEER'S SEAL		SURVEY INFORMATION		BENCH MARKS		AS-BUILT INFORMATION	
No.	Date	BY	DATE	AS	BRASS TABLE STAMPED "TRANS"	CONTRACTOR	AS-BUILT INFORMATION
					Geographic Position (NAD 1927)	Bohannon & Huston	CONTRACTOR
					N.M. State Plane Coordinate (Central Zone)		Bohannon & Huston
					X = 354,899.45 Y = 1,471,822.67		Bohannon & Huston
					Zone = 12N		Bohannon & Huston
					Ground Elevation = 5118.43		Bohannon & Huston
					S.D. 1929 Elevation		Bohannon & Huston
							Bohannon & Huston

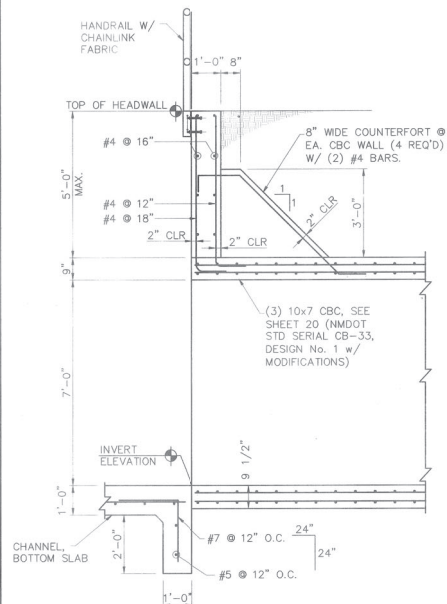


D
16

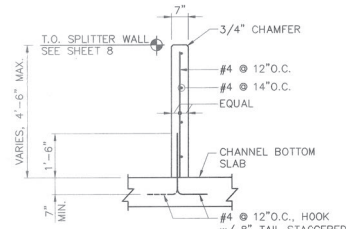


E SPLITTER WALL SECTION
16 SCALE: N.T.S.

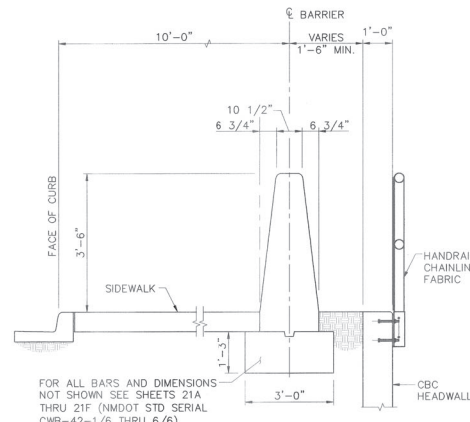


PEDESTRAIN RAILING
TYPICAL SECTION
SCALE: N.T.S.

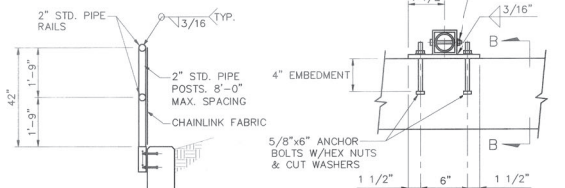

TYPICAL SECTION

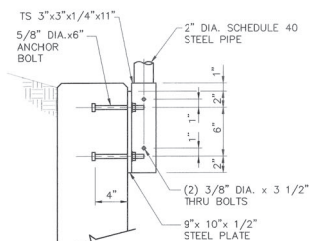

SECTION B-B

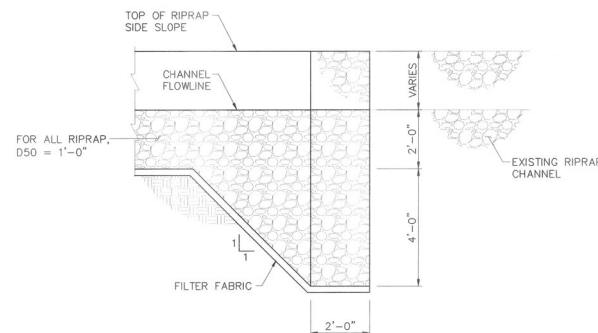

WIRE TIED RIPRAP CUTOFF WALL SECTION

NOTES FOR CAST IN PLACE CBC AND HEADWALLS

1. WORKMANSHIP AND MATERIALS SHALL CONFORM TO THE CITY OF ALBUQUERQUE STANDARD SPECIFICATIONS FOR PUBLIC WORKS' CONSTRUCTION, LATEST EDITION.
2. **STRUCTURAL CAST-IN-PLACE CONCRETE:** STRUCTURAL CONCRETE SHALL BE IN ACCORDANCE WITH SECTION 101, TABLE 101-C, HYDRAULIC STRUCTURES, $F_c=4000$ PSI.
3. **REINFORCING STEEL:** STEEL REINFORCEMENT AND PLACEMENT SHALL BE IN ACCORDANCE WITH SECTION 102-STEEL REINFORCEMENT, AND SHALL CONFORM TO ASTM A615, GRADE 60. ALL LAP SPICES SHALL BE AS SHOWN ON THE PLANS.
4. **SUBGRADE PREPARATION:** EXPOSED SOILS SHOULD BE SCARIFIED TO A DEPTH OF 8", MOISTURE CONDITIONED TO A NEAR OPTIMUM (3%) MOISTURE CONTENT TO A MINIMUM DEPTH OF FIVE FEET. COMPACT TO A MINIMUM OF 95% OF MAXIMUM DENSITY AS DETERMINED BY ASTM D-1557. THE CONTRACTOR SHALL BE LIMITED TO THE USE OF HAND OPERATED COMPACTION EQUIPMENT WITHIN A ZONE OF FIVE FEET HORIZONTALLY FROM THE BACK OF THE WASTEWATER CONSTRUCTION. SEE REFERENCE REPORT NO. 03-1-276, DATED 12-7-03, PREPARED BY VINYARD & ASSOCIATES, INC.
5. THE CONTRACTOR SHALL BE RESPONSIBLE FOR PROVIDING SAFE AND ADEQUATE SHORING FOR ALL PARTS OF THE WALLS AND ANY ADJACENT STRUCTURES DURING CONSTRUCTION , AS WELL AS WORKER SAFETY AND COMPLIANCE WITH OSHA OR OTHER AGENCY SAFETY GUIDELINES.
6. THE CONTRACTOR SHALL BE RESPONSIBLE FOR CODE _____ ADMINISTRATION APPROVAL AND FEES ASSOCIATED WITH IT.
7. THE CONTRACTOR SHALL BE RESPONSIBLE TO SEE THAT ALL REBAR IS PROPERLY ALIGNED AND TIED IN PLACE BEFORE PLACING CONCRETE. ALL STEEL SHALL BE ACCURATELY LOCATED AND SECURED IN PLACE SO THAT IT REMAINS IN POSITION DURING THE PLACEMENT OF THE CONCRETE. ANY REBAR IMPROPERLY INSTALLED SHALL BE CORRECTED AT NO ADDITIONAL COST TO THE OWNER.
8. THE CONTRACTOR SHALL CLEAN ALL CONSTRUCTION DEBRIS

9. CONCRETE USED IN WINDWALLS AND CHANNEL TRANSITIONS SHALL BE TINTED WITH 1 LB "SAN DIEGO BUFF" PER SACK OF CEMENT.

DESIGN DATA

SOIL:	
EFP (ACTIVE)	=34 PCF
EFP (PASSIVE)	=400 PCF
SOIL UNIT WEIGHT	=128 PCF
ALLOWABLE BEARING PRESSURE	=1500 PSF
COEFFICIENT OF FRICTION FOR SLIDING	=0.4C

LIVE LOAD:
2'-0" SOIL SURCHARGE

TYPICAL HANDRAIL DETAILS
SCALE: N.T.S.

N.T.S.

7	8	9	10	11	12	13	14	15
7	8	1			1	6	0	5




Bohannon  **Huston** INC.
 Courtyard | 7500 Jefferson St. NE Albuquerque, NM 87109-4335
 ENGINEERING • SPATIAL DATA • ADVANCED TECHNOLOGIES


CITY OF ALBUQUERQUE
PUBLIC WORKS DEPARTMENT

**GIBSON BLVD. IMPROVEMENTS
MISCELLANEOUS SECTIONS AND DETAILS**

AMOLE ARROYO CROSSING		Mo./Day/Yr.	Mo./Day/Yr.
Design Review Committee	City Engineer Approval		
JAN 28 2004	FEB - 4 2004		
DESIGN REVIEW COMMITTEE	CITY ENGINEER		

City Project No.	7	Zone Map No.	M-9, N-9	Sheet	16	Of	27
------------------	---	--------------	----------	-------	----	----	----

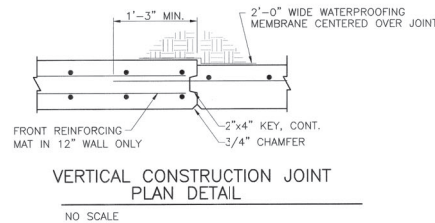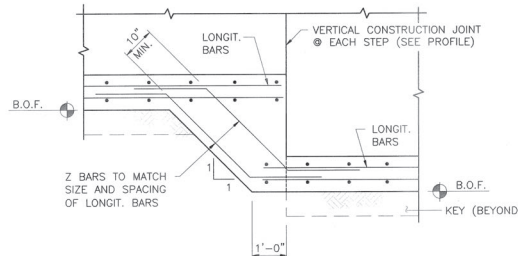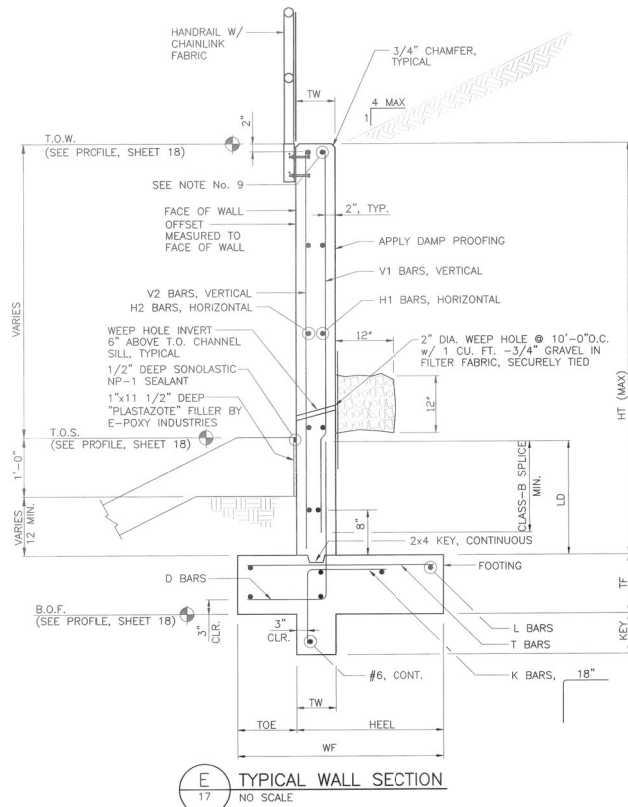

NOTES FOR CAST IN PLACE RETAINING WALLS

- WORKMANSHIP AND MATERIALS SHALL CONFORM TO THE CITY OF ALBUQUERQUE STANDARD SPECIFICATIONS FOR PUBLIC WORKS CONSTRUCTION, LATEST EDITION.
- STRUCTURAL CAST-IN-PLACE CONCRETE: STRUCTURAL CONCRETE SHALL BE IN ACCORDANCE WITH SECTION 101, TABLE 101.C, HYDRAULIC STRUCTURES, $F_c=4000$ PSI.
- REINFORCING STEEL: STEEL REINFORCEMENT AND PLACEMENT SHALL BE IN ACCORDANCE WITH SECTION 102-STEEL REINFORCEMENT, AND SHALL CONFORM TO ASTM A615, GRADE 60. ALL LAP SPICES SHALL BE AS SHOWN ON THE PLANS.
- SUBGRADE PREPARATION: EXPOSED SOILS SHOULD BE SCARIFIED TO A DEPTH OF 8", MOISTURE CONDITIONED TO A NEAR OPTIMUM (3%) MOISTURE CONTENT TO A MINIMUM DEPTH OF FIVE FEET. COMPACT TO A MINIMUM OF 95% OF MAXIMUM DENSITY AS DETERMINED BY ASTM D-1557. THE CONTRACTOR SHALL BE LIMITED TO THE USE OF HAND OPERATED COMPACTION EQUIPMENT WITHIN A ZONE OF FIVE FEET HORIZONTALLY FROM THE BACK OF THE WALL. CONTRACTOR SHALL REFERENCE REPORT NO. 03-1-276, DATED 12-17-03, PREPARED BY VINYARD & ASSOCIATES, INC.
- THE CONTRACTOR SHALL BE RESPONSIBLE FOR PROVIDING SAFE AND ADEQUATE SHORING FOR ALL PARTS OF THE WALL AND ANY ADJACENT STRUCTURES DURING CONSTRUCTION, AS WELL AS WORKER SAFETY AND COMPLIANCE WITH OSHA OR OTHER AGENCY SAFETY GUIDELINES.
- VERTICAL CONSTRUCTION JOINTS SHALL BE PLACED AS SHOWN ON THE PROFILE, SHEET 18.
- THE CONTRACTOR SHALL NOTIFY THE ENGINEER PRIOR TO THE CONCRETE FOOTING PLACEMENT, FOR THE INSPECTION OF COMPACTION UNDER THE FOOTING, FOOTING DEPTH AND WIDTH, THE WALL STEEL SPACING. FINAL INSPECTION OF THE FOOTING AND WALL WILL BE REQUIRED.
- THE CONTRACTOR SHALL BE RESPONSIBLE FOR CODE ADMINISTRATION APPROVAL AND FEES ASSOCIATED WITH IT.
- THE CONTRACTOR SHALL BE RESPONSIBLE TO SEE THAT ALL REBAR IS PROPERLY ALIGNED AND TIED IN PLACE BEFORE PLACING CONCRETE. ALL STEEL SHALL BE ACCURATELY LOCATED AND SECURED IN PLACE SO THAT IT REMAINS IN POSITION DURING THE PLACEMENT OF THE CONCRETE. ANY REBAR IMPROPERLY INSTALLED SHALL BE CORRECTED AT NO ADDITIONAL COST TO THE OWNER.
- THE CONTRACTOR SHALL CLEAN ALL CONSTRUCTION DEBRIS FROM THE AREA.

DESIGN LOADS

EFP (ACTIVE)	=34 PCF
EFP (PASSIVE)	=40C PCF
SOIL UNIT WEIGHT	=128 PCF
ALLOWABLE BEARING PRESSURE	=2000 PSF
COEFFICIENT OF FRICTION FOR SLIDING	=0.40

LAP SPICES-CLASS B	
BAR	LENGTH (IN)
4	18
5	22
6	26
7	43
8	54
9	66

DIMENSIONS								
WALL TYPE	HT (MAX)	TF (IN)	TW (IN)	TOE (IN)	HEEL (IN)	WF (IN)	KEY (IN)	LD (IN)
A	4'-6"	12	8	16	26	42	-	20
B	6'-4"	12	8	24	28	52	-	24
C	10'-8"	18	10	28	92	120	-	45
D	15'-0"	24	12	69	81	150	15	68

WALL SCHEDULE

REINFORCING														
WALL TYPE	D SIZE	D SPACE	V1 SIZE	V1 SPACE	H1 SIZE	H1 SPACE	V2 SIZE	V2 SPACE	H2 SIZE	H2 SPACE	L SIZE	L NO. REQ'D	T SIZE	T SPACE
A	4	18	4	18	4	12	-	-	-	-	5	4	4	18
B	4	9	4	18	4	12	-	-	-	-	5	4	5	18
C	6	9	6	18	5	12	-	-	-	-	6	9	6	12
D	9	7	7	14	5	18	4	18	4	18	6	15	6	10

1 2 3 4 5 6 7 8 9 10 11 12 13 14 15
26 22 27 8 11 12 13 14

Bohannon & Huston

Copyright © 1990 Bohannon & Huston, Inc. Albuquerque, NM 87109-4335
ENGINEERING • SPATIAL DATA • ADVANCED TECHNOLOGIES


CITY OF ALBUQUERQUE
PUBLIC WORKS DEPARTMENT

GIBSON BLVD. IMPROVEMENTS
RETAINING WALL SECTIONS AND DETAILS
AMOLE ARROYO CROSSING

Design Review Committee: JAN 28 2004
City Engineer Approval: FEB - 4 2004
City Engineer: [Signature]


City Project No. 722281
Zone Map No. M-9, N-9
Sheet 17 of 27

SCANNED BY
MESA REPRO


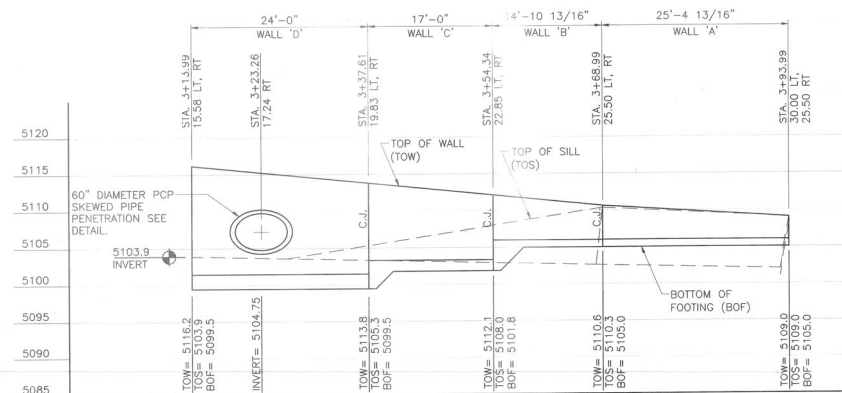


SOUTH WALL PROFILE
SCALE: 1/8"=1'-0"


NOTE:
"C.J." = CONSTRUCTION JOINT.
SEE SHEET 17 FOR DETAILS.

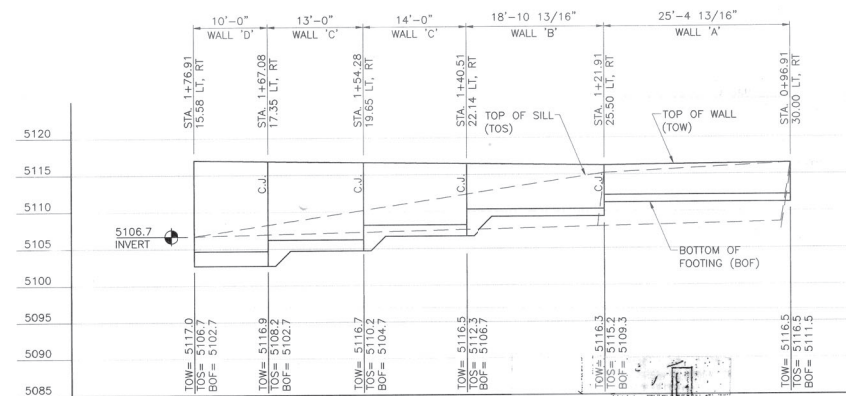


NORTH WALL PROFILE
SCALE: 1/8"=1'-0"

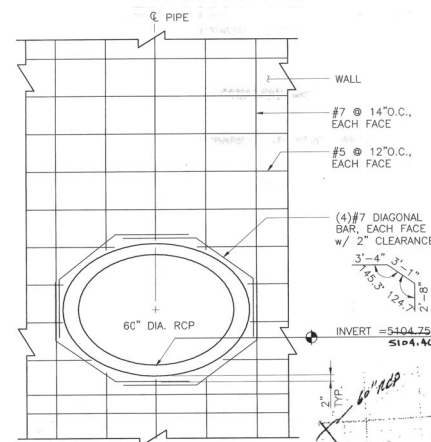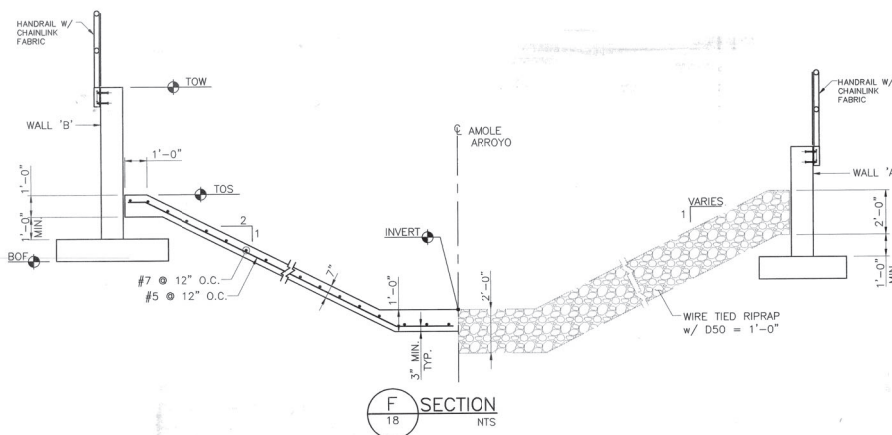

WALL PIPE PENETRATION DETAIL
NO SCALE

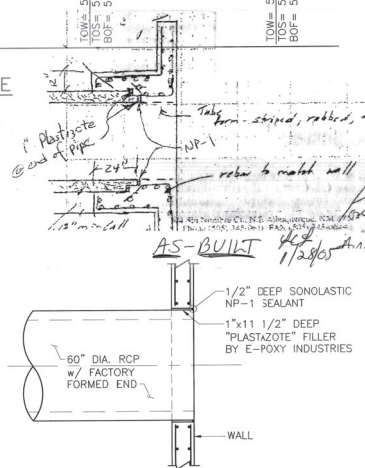

WALL PIPE PENETRATION SECTION
NO SCALE

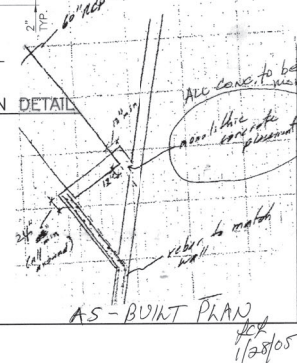


AS-BUILT PLAN
1/28/05

AS-BUILT INFORMATION CONTRACTOR: Bohannon & Huston DRAWN BY: ALB CHECKED BY: ALB DATE: 1/28/05	
ENGINEER'S SEAL I, ALB , a duly Licensed Professional Engineer in the State of New Mexico, do hereby certify that I am the author of the design shown on this drawing, and that I am a duly Licensed Professional Engineer in the State of New Mexico. My Commission No. is 10016 . My Expiration Date is 12/31/05 . My Seal No. is 10016 . My Seal Date is 1/28/05 .	
REVISIONS No. Date Description 1 1/28/05 AS-BUILT PLAN	
DESIGN No. Date Description 1 1/28/05 AS-BUILT PLAN	
APPROVALS Design Review Committee: JAN 28 2004 City Engineer: FEB - 4 2004 City Project No. 722281 Zone Map No. M-9, N-9 Sheet 18 of 27	


DESIGNED BY: H.T. 10/60
 DETAILED BY: J.A.K. 10/60

DESIGNED BY: H.T. 10/60


SCANNED BY
MESA REPRO

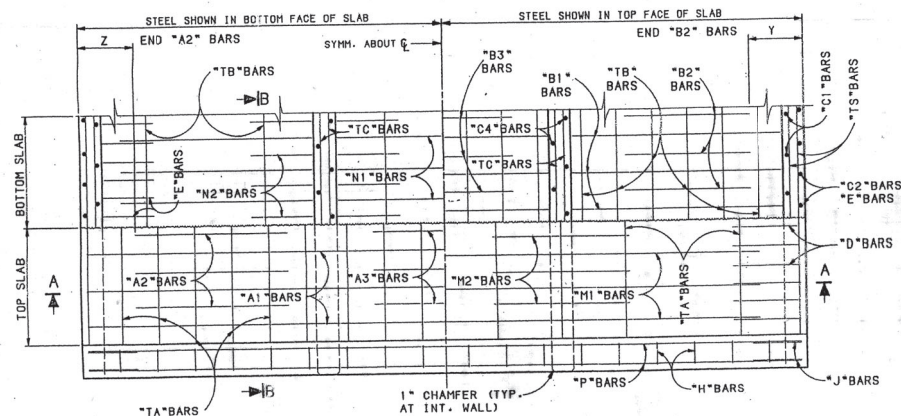


PART PLAN AND PART SECTION C-C

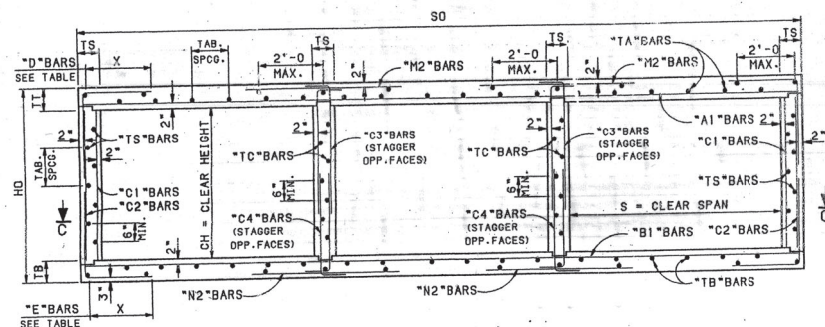

SECTION A-A

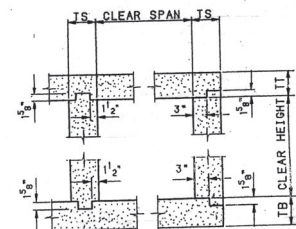


CONSTRUCTION JOINT DETAIL

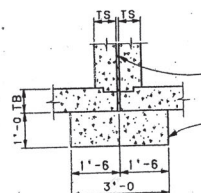


1. PREFORMED BITUMINOUS JOINT FILLER SHALL BE USED BETWEEN ADJACENT UNITS AND IT SHALL EXTEND BETWEEN BARRELS, PARAPETS, AND CUT-OFF WALLS.

2. THE FOUNDATION BLOCK SHALL BE PLACED IN NEAR EXCAVATION AND EXTENDED FOR THE ENTIRE LENGTH OF BARREL UNDER JOINT BETWEEN UNITS. PLACE ONE LAYER OF TAR PAPER OVER THE ENTIRE TOP SURFACE OF THE FOUNDATION BLOCK. CONCRETE QUANTITY = 0.111 CU. YDS. PER LIN. FT. OF BLOCK.

JOINT DETAIL FOR MULTIPLE UNIT BOXES

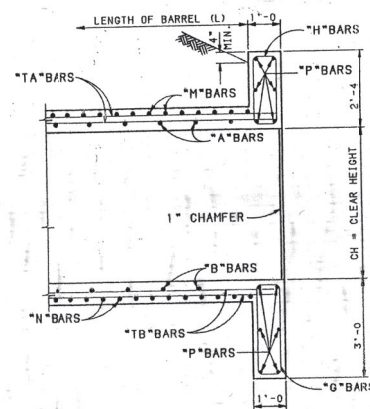

PART SECTION B-B

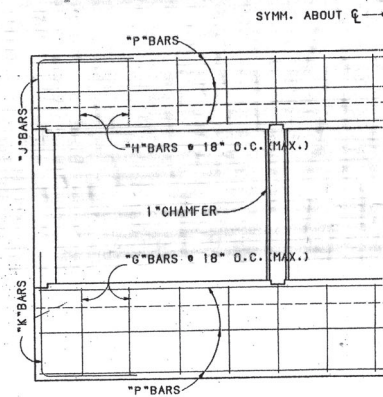

PART END ELEVATION

- ## GENERAL NOTES
1. ALL CONCRETE SHALL BE CLASS "A". CHAMFER ALL THE EXPOSED EDGES 3/4".
 2. ALL REINFORCING STEEL TO BE DEFORMED BARS, CONFORMING TO AASHTO H-31, GRADE 60. ALL DIMENSIONS REFER TO THE CENTERLINE OF BAR.
 3. WHEN NECESSARY, "1" BARS MAY BE SPLICED BY LAPPING AT LEAST 20 BAR DIAMETERS. PLACE WEIGHT FOR REINFORCING STEEL DOES NOT INCLUDE SPLICES. THE COST OF THE SPLICE MATERIAL IS TO BE INCLUDED IN THE UNIT PRICE BID FOR REINFORCING STEEL.
 4. VOLUME OF CONCRETE = (L) x (CONCRETE QUANTITY / L IN. FT.) PLUS CONCRETE AT ENDS.
 5. WEIGHT OF REINFORCING STEEL = (L) x (WEIGHT OF REINF. / L IN. FT.) PLUS WEIGHT AT ENDS.
 6. PLACE "1" BARS ON "A" BARS AND "1" BARS UNDER "B" BARS, SPACED AS SHOWN IN THE TABLE. THE REMAINING "1" BARS, AND "1" BARS ARE TO BE PLACED ADJACENT TO THE "D", "E", "H", AND "N" BARS AS INDICATED IN "SECTION A-A", AT 2'-0" MAX.
 7. PLACE "1" TS BARS NEXT TO "C1" BARS, SPACED AS SHOWN IN THE TABLE. THE REMAINING "1" BARS SHALL BE PLACED IN SIDEWALK NEXT TO "C2", "D", AND "E" BARS. WHEN "C1" BARS ARE NOT INDICATED, PLACE ALL "1" TS BARS NEXT TO "C2", "D", AND "E" BARS.
 8. PLACE "A1", "A3", "B1", "B3", "H1", AND "N1" BARS SYMMETRICAL TO THE CENTERLINE OF THE BOX. PLACE "H2" AND "N2" BARS SYMMETRICAL TO THE CENTERLINE OF THE WALLS.
 9. "COVER" IS HEIGHT OF FILL FROM TOP OF THE BOX TO THE FINISHED GRADE.

DESIGN DATA

DESIGN ACCORDING TO A.A.S.H.O. SPECIFICATIONS, 1957.
LIVE LOAD: H20-S16-44 & INTERSTATE ALTERNATE LOADING
WEIGHT OF FILL ON TOP OF BOX: 84#/CU.FT.
HORIZONTAL EARTH PRESSURE: 30#/CU.FT.², 2' SURCHARGE
DESIGN STRESSES: $f'_{c} = 3000$ psi, $f_{c} = 1200$ psi.
 $f_{s} = 20,000$ psi, $n = 10$.

4			
3			
4			
4			
3			
2			
2			
REVISED NOTE #2		5-8-94	P
NO.	DESCRIPTION	DATE	BY
REVISIONS (OR CHANGE NOTICES)			
NEW MEXICO STATE			
HIGHWAY AND TRANSPORTATION			
DEPARTMENT			
CONCRETE BOX CULVERT BARRELS			
TRIPLE OPENING - NORMAL			
ALL DESIGNS			
722781			
GENERAL DATA			
LAYOUT BY	APPROVED	<i>[Signature]</i>	DATE
DRAWN BY	RECHECKED	DATE REVIEWED	SCALE
CHECKED BY	<i>[Signature]</i>	DATE	SCALE
SERIAL 08-33		SHEET 1 OF 5	


PRJ. NO. 72278V

N. M. P. SHEET. . . .

SHEET 19 OF 27

[illegible]

* NOTE: QUANTITIES "AT ONE END" INCLUDE PARAPET, CUT-OFF WALL, AND BARREL BEYOND LENGTH "L". WINGWALL QUANTITIES ARE NOT INCLUDED.

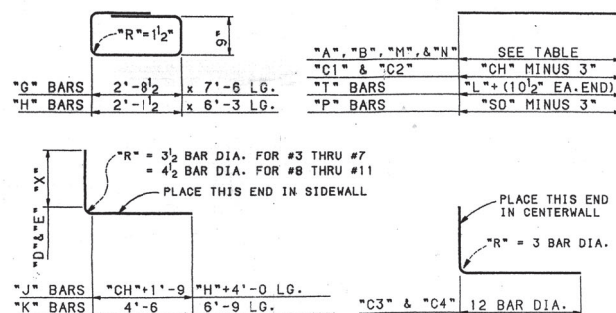

NOTE: "J" BARS ARE THE SAME SIZE AS "D" BARS.
"K" BARS ARE THE SAME SIZE AS "E" BARS.

REINFORCING STEEL DIAGRAM

BRIDGE#1/STANDARDS/BRIDGE/STANDARDS\$16A

REINFORCING BARS

[illegible]

"P" BARS

CLEAR SPAN	4'	6'	8'	10'	12'	14'
SIZE	#5	#5	#6	#7	#8	#9

NUMBER OF BARS REQUIRED

"A1", "A3", "B1", "B3", "M1", & "N1" BARS: $12L \div \text{SPACING}$
 "A2", "B2", "C2", "D", "E", "M2", & "N2" BARS: $24L \div \text{SPACING}$
 "P" BARS: 12 FOR CUT-OFF & PARAPET AT EACH END
 "C1" BARS: $(24L \div \text{SPACING}) \text{ PLUS } 12$

"C3" & "C4" BARS: (48L ÷ SPACING) PLUS
4 AT EACH END

"J" & "K" BARS: 4 OF EACH AT EACH END
(FOR PARAPET AND CUT-OFF WALL)

OTHER BARS: SEE TABLE
 "L" = LENGTH OF BARREL IN FEET
 "CH" = CLEAR HEIGHT

NOTE: REFER TO SERIAL CB-33 SHEET 1 OF 5
FOR CONCRETE BOX CULVERT DETAILS,
DESIGN DATA, AND GENERAL NOTES.

6			
5			
4			
3			
2			
1			
NO.	DESCRIPTION	DATE	BY

REVISIONS (OR CHANGE NOTICES)


NEW MEXICO STATE
HIGHWAY AND TRANSPORTATION
DEPARTMENT

CONCRETE BOX CULVERT BARRELS
TRIPLE OPENING - NORMAL
DESIGN No. 1
0' TO 5' COVER

722781


LAYOUT BY DRAWN BY	APPROVAL <i>[Signature]</i> 4/11/11
	RECOMMENDED BY <i>[Signature]</i> INTAKE ENGINEER DATE
	APPROVED <i>[Signature]</i> 4/11/11

SERIAL CB-33

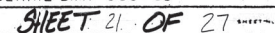


NOTES


- ALL WORK SHALL BE DONE IN ACCORDANCE WITH THE STANDARD SPECIFICATIONS FOR HIGHWAY AND BRIDGE CONSTRUCTION.
- CONCRETE SHALL BE CLASS "A".
- FOOTING IS REQUIRED AT CONCRETE BARRIER ENDS AND AT INTERRUPTIONS IN CONCRETE BARRIER.
- EXPANSION AND CONTRACTION JOINTS IN CONCRETE WALL BARRIER SHALL BE LOCATED AT THE CONCRETE PAVEMENT JOINTS. JOINT FILLER MATERIAL SHALL BE THE SAME SIZE AS JOINT OR 1/2" IN. MINIMUM.
- REINFORCING STIRRUP, R3 IS NOT REQUIRED FOR VERTICAL ROADWAY OFFSETS LESS THAN 1 FOOT. FOR OFFSETS LESS THAN 1 FOOT WALL BARRIERS SHALL BE CAST MONOLITHIC.
- FOR ADDITIONAL DETAILS SEE STANDARD PLAN "CONCRETE WALL BARRIER TYPE 42 AT COLUMN AND SIGN PEDESTALS".
- CHAMFER ALL EXPOSED EDGES 3/4".
- CONCRETE COVER FOR REINFORCING BARS SHALL BE A MIN. OF 2 IN. CLEAR.
- PROVIDE CONTRACTION JOINTS AT 30 FEET MAX INTERVALS. CONTRACTION JOINTS SHALL BE MADE USING COLD JOINTS, OR SAW CUTS. SAW CUT JOINTS SHALL BE SEALED WITH A SILICON SEALANT APPROVED BY THE PROJECT MANAGER.
- EXPANSION JOINTS SHALL BE LOCATED AT 300 FT. MAX INTERVALS. EXPANSION JOINTS SHALL BE CONSTRUCTED 0 FEET AND 15 FEET FROM END OF BRIDGE RAILING. (SEE CONNECTION TO STRUCTURE DETAIL, THIS SHEET) SEE DRAWING TITLED "42 IN. DOWEL ASSEMBLY FOR EXPANSION JOINTS IN CONCRETE WALL BARRIER AND CONCRETE BARRIER RAILING" FOR EXPANSION JOINT DETAILS.
- FOR DOWEL AND SLEEVE ASSEMBLY SEE SERIAL NO. CWB-42-2/8 TITLED "42 IN. DOWEL ASSEMBLY FOR EXPANSION JOINTS IN CONCRETE WALL BARRIER AND CONCRETE BARRIER RAILING".
- ADDITIONAL STEEL REINFORCING REQUIRED BY THE CONTRACTOR FOR CONSTRUCTION OF THE BARRIER WALL SHALL BE INCIDENTAL TO THE UNIT PRICE FOR CONCRETE WALL BARRIER.
- CWB SHALL BE INSTALLED BY EITHER SLIP-FORMING OR CASTING-IN-PLACE. PRECAST SECTION INSTALLATION IS NOT PERMITTED.
- THE LONGITUDINAL REBARS MAY BE SUBSTITUTED WITH WELDED DEFORMED WIRE FABRIC (ASTM A497, $f_y = 70,000$ psi) WITH AN EQUIVALENT AREA OF STEEL. THE CASE SHALL REMAIN IN THE INTEREST POSITION DURING CONSTRUCTION.
- CONCRETE WALL BARRIER TYPE 42 SHALL BE PAID PER LINEAR FOOT PER INSTALLATION.
- REINFORCING BARS SHALL BE INCLUDED IN THE COST OF THE CONCRETE WALL BARRIER.

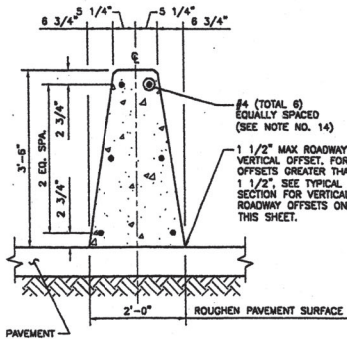


TYPICAL SECTION

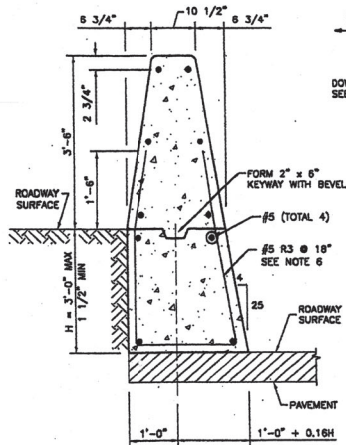


TYPICAL SECTION FOR VERTICAL ROADWAY OFFSETS

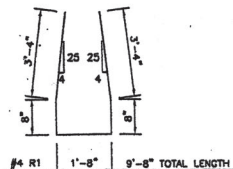


NO. REQ'D = 6 PER END ANCHORAGE
6 PER CONNECTION TO STRUCTURE

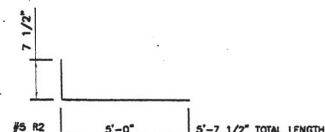


NO. REQ'D = 4 PER END ANCHORAGE
4 PER CONNECTION TO STRUCTURE

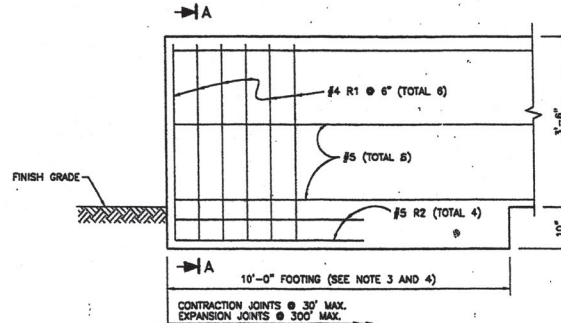

END ANCHORAGE

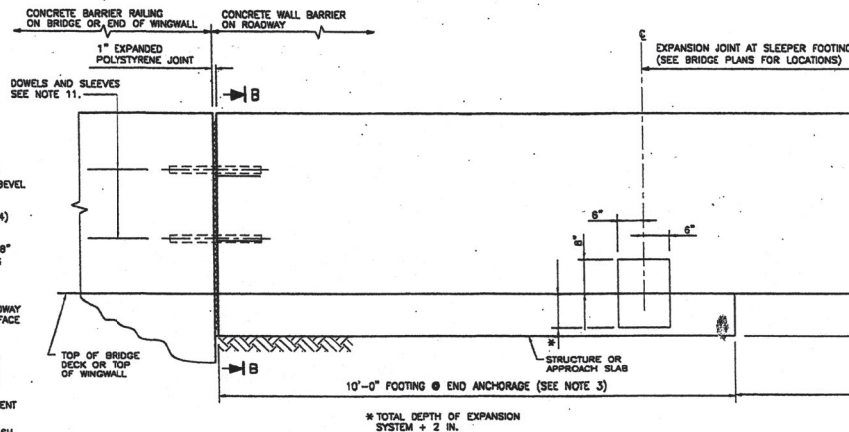

CONNECTION TO STRUCTURE

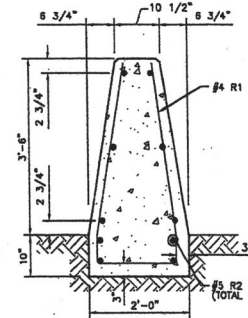


SECTION A-A

ESTIMATED QUANTITIES

(FOR CONTRACTOR'S INFORMATION ONLY)

ITEM	UNIT	TOTAL
REINFORCING BARS, GR 60	LB/FT	6.3
STRUCTURAL CONCRETE, CLASS "A"	CY/FT	0.19

THE QUANTITIES SHOWN IN THE ABOVE TABLE ARE BASED ON THE TYPICAL SECTION. ADDITIONAL QUANTITIES MUST BE CALCULATED FOR END ANCHORAGE AND CONNECTION TO STRUCTURE.

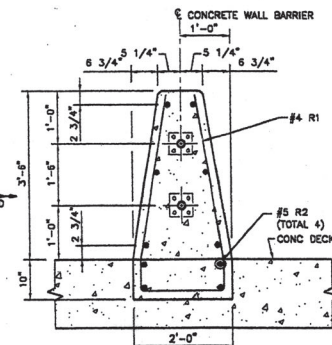

SECTION B-B

NEW MEXICO STATE HIGHWAY
& TRANSPORTATION DEPARTMENT

CONCRETE WALL BARRIER
TYPE 42

722781


CWB-42-1/6 SHEET 21A OF 27

NO.	DESCRIPTION	DATE	BY
1	REVISIONS (OR CHANGE NOTICES)		
2	DESIGNED BY: NA	7-17-92	
3	APPROVED: [Signature]		
4	RECOMMENDATION: [Signature]		
5	CHECKED BY: RM		
6	APPROVED: [Signature]		


1 2 3 4 5 6 7 8 9 10 11 12 13 14 15
26 7 2 2 2 2 2 1 1 1 1 1 1 1 1 1

GENERAL NOTES


1. WORKMANSHIP AND MATERIALS SHALL CONFORM TO THE NEW MEXICO STATE HIGHWAY AND TRANSPORTATION DEPARTMENT STANDARD SPECIFICATIONS FOR HIGHWAY AND BRIDGE CONSTRUCTION.
2. STRUCTURAL STEEL SHALL CONFORM TO AASHTO M 183 UNLESS OTHERWISE NOTED ON THE DETAILS, AND SHALL BE GALVANIZED IN ACCORDANCE WITH SECTION 545.23 OF THE STANDARD SPECIFICATIONS.
3. THE SLEEVE ASSEMBLY SHALL BE SET PARALLEL TO THE BRIDGE DECK GRADE AND THE OUTSIDE FACE OF THE CONCRETE BARRIER RAILING.
4. AFTER CONCRETE HAS TAKEN INITIAL SET, REMOVE STYROFOAM FILLER, 1/4" # HEX. HD. CAP SCREWS, AND THE PLYWOOD FORMS FROM THE JOINT. (CUT THE 1/4" # SCREWS TO FACILITATE THE PLYWOOD FORM REMOVAL).
5. PLYWOOD FORMS AND STYROFOAM FILLER SHALL BE CUT TO THE CROSS SECTION OF THE CONCRETE BARRIER RAILING. PLYWOOD FORMS SHALL BE COATED WITH AN APPROVED NON-BREAKER.
6. FOR MOVEMENT LENGTHS IN EXCESS OF 300 FEET INCREASE JOINT OPENING (*) AS REQUIRED.
7. THE COST OF ALL MATERIALS AND INSTALLATION FOR THE JOINTS SHALL BE CONSIDERED INCIDENTAL TO THE COST TO THE BRIDGE BARRIER RAILING. CONCRETE WALL BARRIER AND, THEREFORE, NO DIRECT PAYMENT WILL BE MADE.

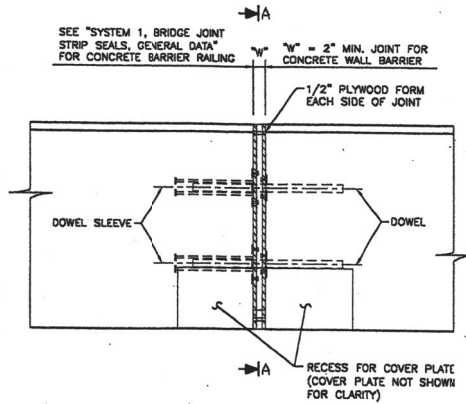


ASSEMBLY DETAIL

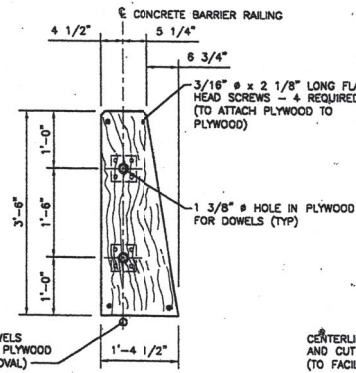


SECTION A-A
BRIDGE BARRIER RAILING

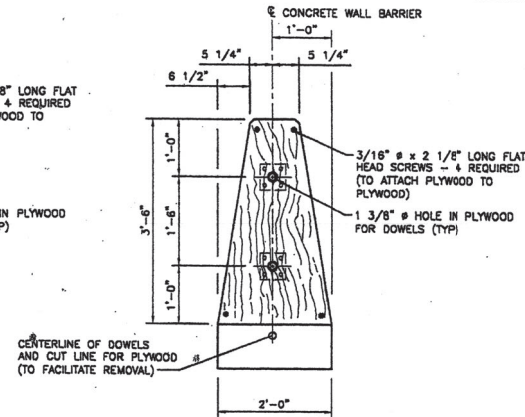


SECTION A-A
CONCRETE WALL BARRIER

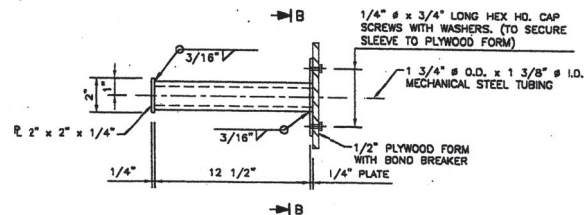


DOWEL SLEEVE DETAIL

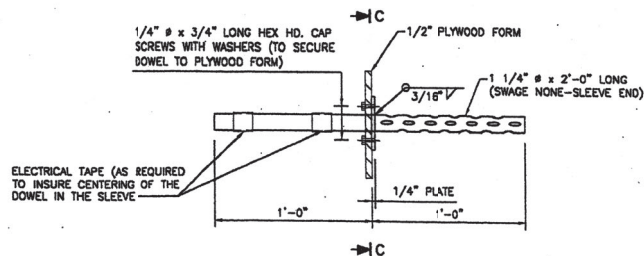

DOWEL DETAIL

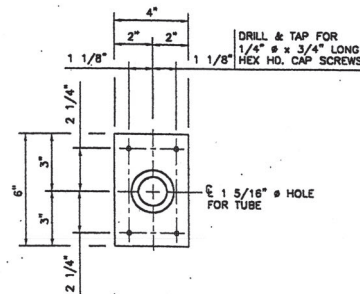

SECTION B-B
1/4 IN. THICK PLATE

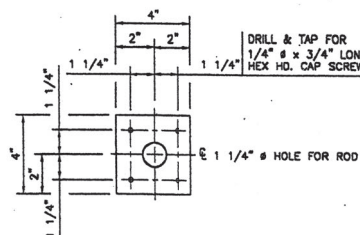

SECTION C-C
1/4 IN. THICK PLATE


1	2	3	4	5	6	7	8	9	10	11	12	13	14	15
26		72	27				81	21	30	9				

City Proj # 722781

NEW MEXICO STATE HIGHWAY
& TRANSPORTATION DEPARTMENT


42 IN. DOWEL ASSEMBLY
FOR EXPANSION JOINTS IN
CONCRETE WALL BARRIER
& CONCRETE BARRIER RAILING

CWB-42-2/6 SHEET 21B OF 27

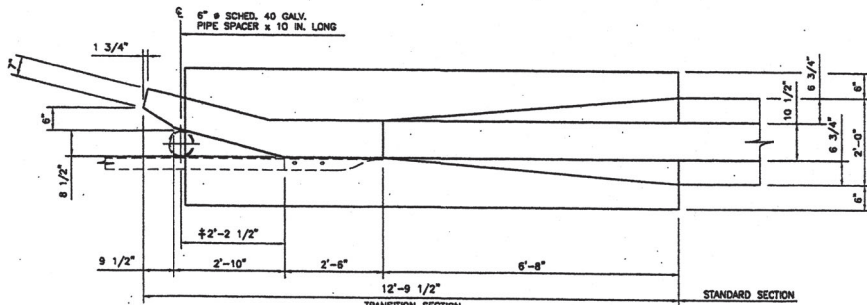


± MOVE SPACER RIGHT OR LEFT AS REQUIRED TO FIT SNUGLY BETWEEN BARRIER AND THREE BEAM.

PLAN

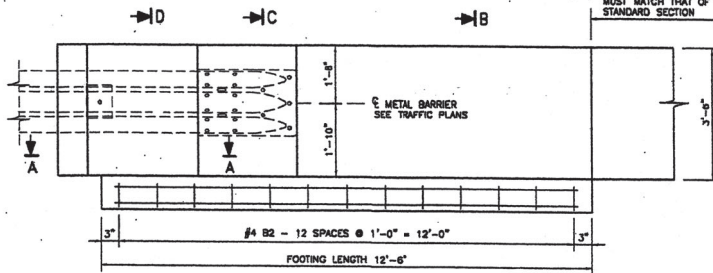

ELEVATION

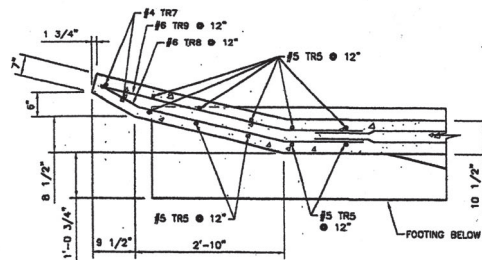


SECTION A - A

**** ESTIMATED QUANTITIES**
(FOR ONE TRANSITION WITH FOOTINGS)


ITEM	UNIT	TOTAL
REINFORCING BARS, GRADE 60	LB	280
STRUCTURAL CONCRETE CLASS "A"	CY	3.8

**FOR CONTRACTOR'S INFORMATION ONLY


* THESE DIMENSIONS SHALL BE MEASURED ABOVE THE TOP OF WEARING SURFACE.
(TOP OF SURFACE OR TOP OF OVERLAY - IF ANY)

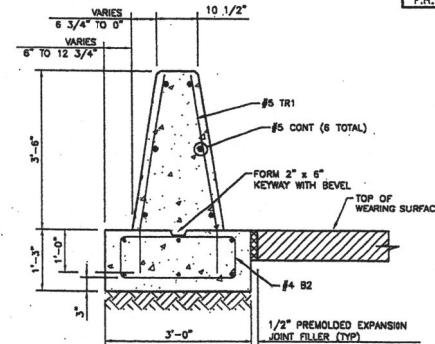


SECTION B-B

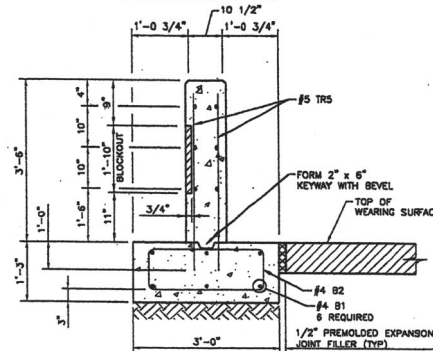




SECTION C-C

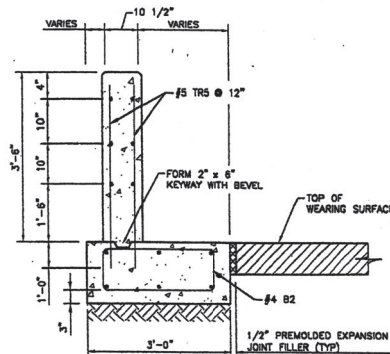

SECTION D-D

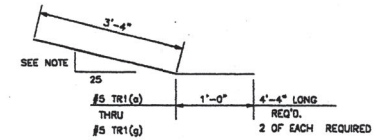

NOTE: BEVEL VARIES FROM 4 TO 0 IN 5 EQUAL INCREMENTS.

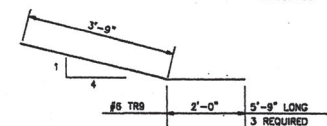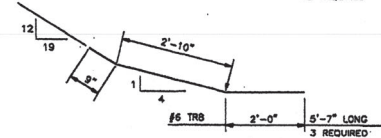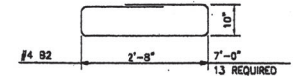

#5 TRS	4'-4"	10 REQUIRED
#4 TR7	3'-2"	2 REQUIRED
#4 B1	12'-0"	6 REQUIRED

REBAR SCHEDULE
(FOR ONE TRANSITION)

NOTES

1. REINFORCING BARS SHALL CONFORM TO THE REQUIREMENTS CONTAINED IN 540.21(a) OF THE STANDARD SPECIFICATIONS. REINFORCING BARS AND SHALL BE GRADE 60 UNLESS A DIFFERENT GRADE IS SPECIFIED ELSEWHERE IN THE PLANS. DIMENSIONS SHOWN REFER TO THE CENTERLINE OF BARS UNLESS NOTED OTHERWISE.
2. CHAMFER ALL EXPOSED EDGES 3/4 IN.
3. CONCRETE COVER FOR REINFORCING BARS SHALL BE A MIN. OF 2 IN. CLEAR.

1 2 3 4 5 6 7 8 9 10 11 12 13 14 15
26 22 27 8 1 2 1 0 9

NO.	DESCRIPTION	DATE	BY
1	DESIGNED BY: NA		
2	CHECKED BY: NA		
3	APPROVED BY: NA		
4	DESIGNED BY: NA		
5	CHECKED BY: NA		
6	APPROVED BY: NA		
7	DESIGNED BY: NA		
8	CHECKED BY: NA		
9	APPROVED BY: NA		
10	DESIGNED BY: NA		
11	CHECKED BY: NA		
12	APPROVED BY: NA		
13	DESIGNED BY: NA		
14	CHECKED BY: NA		
15	APPROVED BY: NA		


**NEW MEXICO STATE HIGHWAY
& TRANSPORTATION DEPARTMENT**

**42 IN. CONCRETE WALL
BARRIER**




TRANSITION SECTION DETAILS

City Proj # 722781


CWB-42-3/6 SHEET 21C OF 27

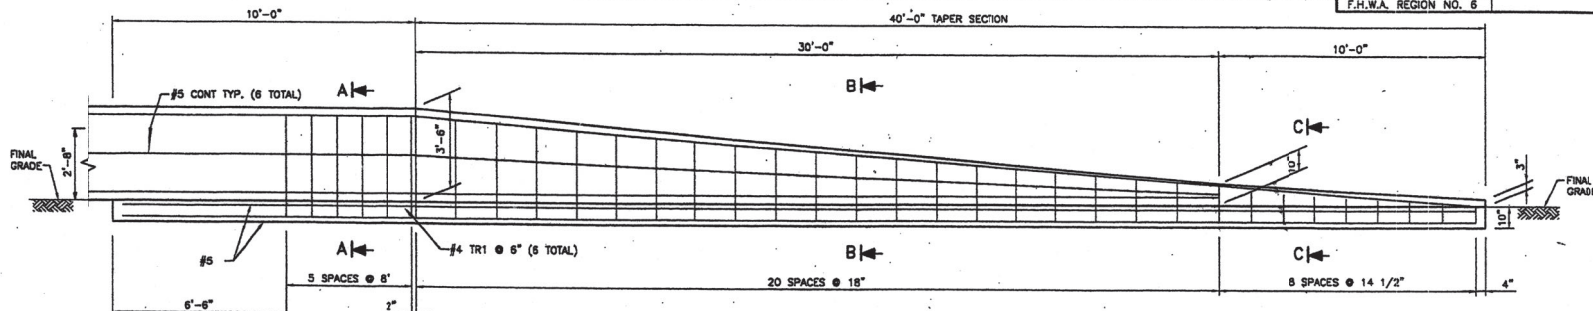

ELEVATION OF BARRIER TRANSITION

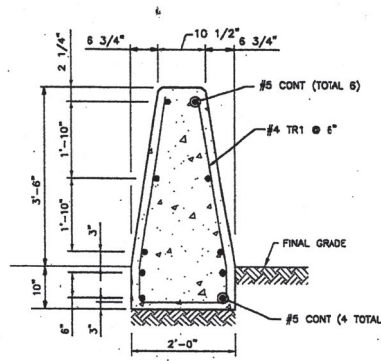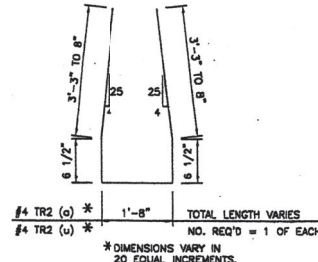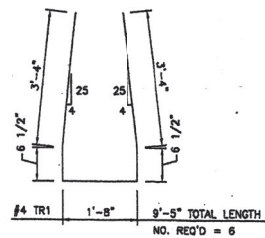


SECTION A-A

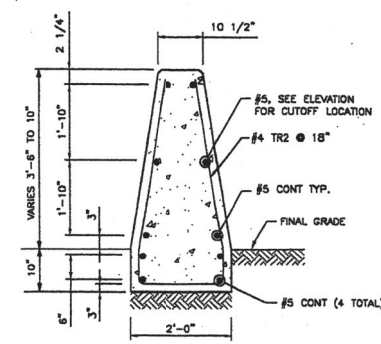


SECTION B-B

NOTES

1. ALL WORK SHALL BE DONE IN ACCORDANCE WITH THE STANDARD SPECIFICATIONS FOR HIGHWAY & BRIDGE CONSTRUCTION. SHOP DRAWING APPROVAL IS REQUIRED ON PRECAST SECTIONS.
2. CONCRETE SHALL BE STRUCTURAL CONCRETE, CLASS "A".
3. CONCRETE WALL BARRIER TRANSITION TO BE USED ONLY WHEN A MINIMUM OF 30 FEET RECOVERY AREA IS PROVIDED ON THE TRAFFIC APPROACH SIDE.
4. CHAMFER ALL EXPOSED EDGES 3/4 IN.
5. CONCRETE COVER FOR REINFORCING BARS SHALL BE A MIN. OF 2 IN. CLEAR.
6. CONCRETE WALL BARRIER TYPE 42 TRANSITION SHALL BE PAID PER LINEAR FOOT PER INSTALLATION.

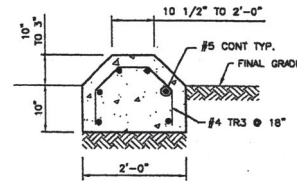

SECTION C-C

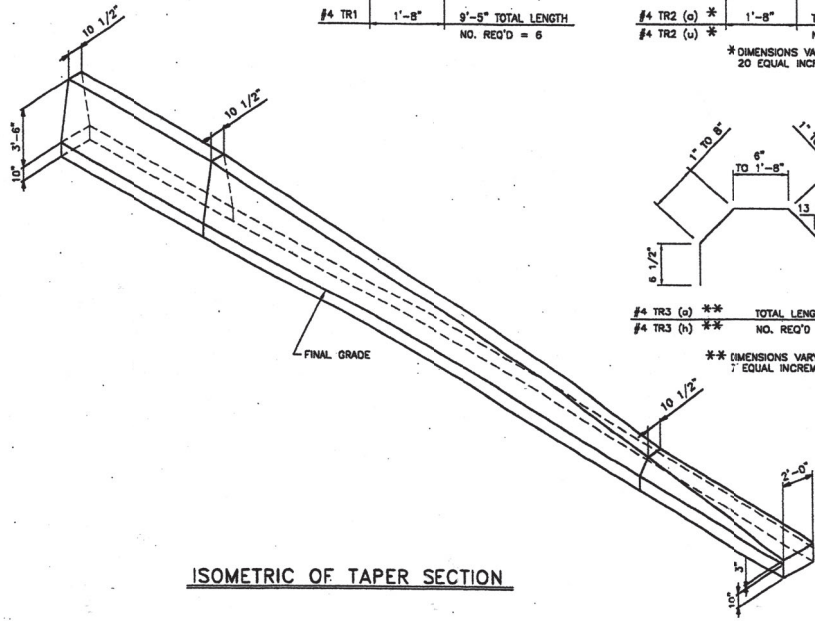

ISOMETRIC OF TAPER SECTION


*** ESTIMATED QUANTITIES

ITEM	UNIT	TOTAL
REINFORCING BARS, GRADE 60	LB	640
STRUCTURAL CONCRETE CLASS "A"	CY	8.5

***FOR CONTRACTOR'S INFORMATION ONLY


1 2 3 4 5 6 7 8 9 10 11 12 13 14 15
26 72222 81211009

NEW MEXICO STATE HIGHWAY & TRANSPORTATION DEPARTMENT	
CONCRETE WALL BARRIER TYPE 42 TRANSITION	
722781	
CWB-42-4/6 SHEET 21D OF 27	

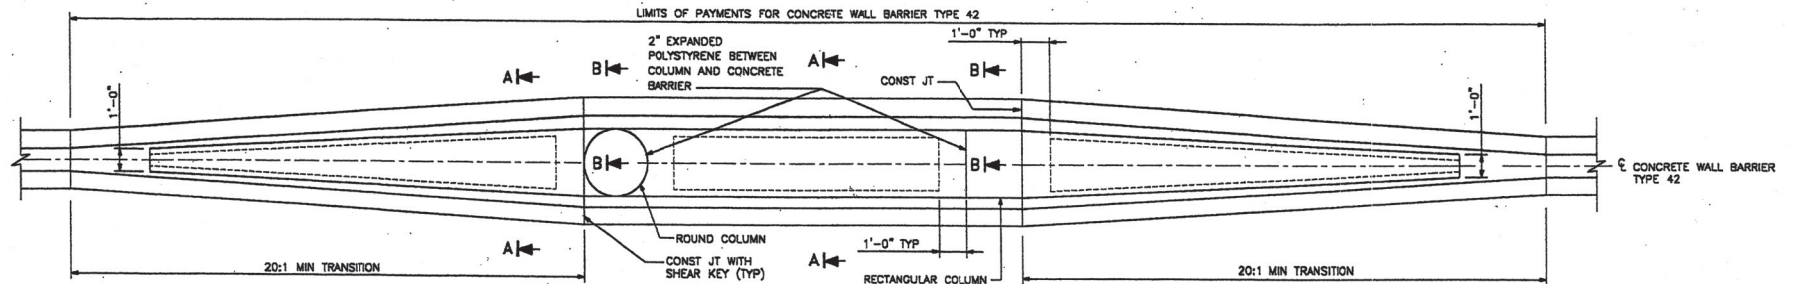


TRANSITION AT BRIDGE COLUMNS

N.T.S.

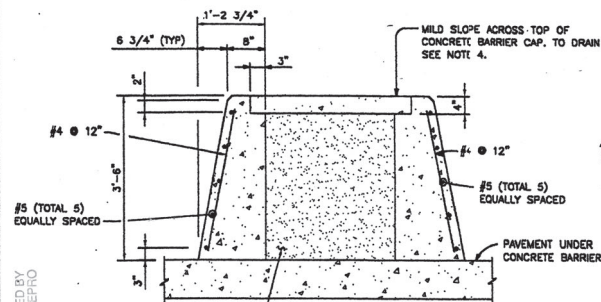


SECTION A-A

N.T.S.

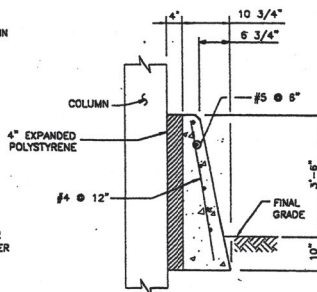

SECTION B-B

N.T.S.

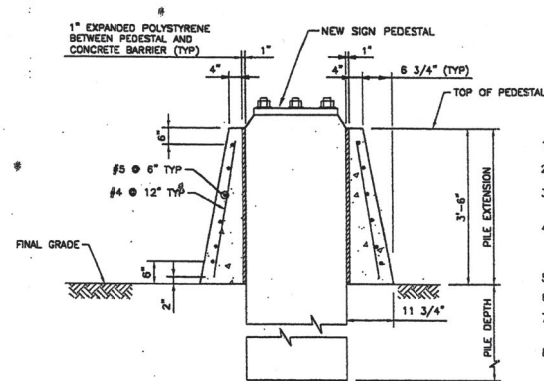


SECTION C-C

N.T.S.

NOTES

- SEE STANDARD PLAN FOR CONCRETE WALL BARRIER TYPE 42.
- PLACE GRANULAR MATERIAL FROM BASE TO BOTTOM OF 4 IN. CAP.
- REINFORCING STEEL SHALL EXTEND CONTINUOUS THROUGH CONSTRUCTION JOINTS.
- ADJUST HEIGHT OF CONCRETE BARRIER WALL ON LOW SIDE OF OFFSET OR SUPERELEVATED ROADWAYS TO PROVIDE LEVEL GRADE ACROSS TOP OF CONCRETE BARRIER CAP.
- CONCRETE SHALL BE CLASS "A".
- CHAMFER ALL EXPOSED EDGES 3/4 IN.
- CONCRETE COVER FOR REINFORCING BARS SHALL BE A MIN. OF 2 IN. CLEAR.
- CONCRETE WALL BARRIER TYPE 42 AT COLUMN AND SIGN PEDESTALS SHALL BE PAID PER LINEAR FOOT PER COMPLETE INSTALLATION, WHICH INCLUDES BOTH SIDES OF THE OBSTRUCTION.

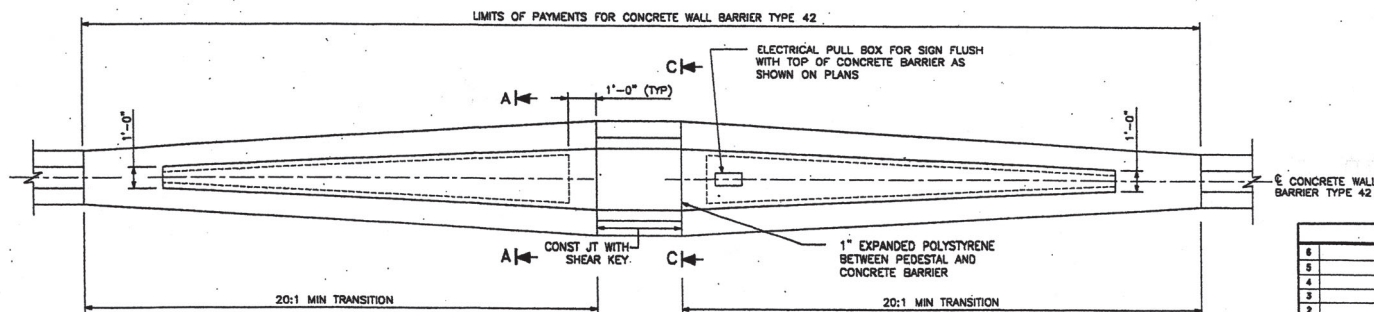

TRANSITION AT SIGN PEDESTAL

N.T.S.

1 2 3 4 5 6 7 8 9 10 11 12 13 14 15
26 22 27 21 21 20 9


NO.	DESCRIPTION	DATE	BY
1	DESIGNED BY: RA		
2	DRAWN BY: LH		
3	CHECKED BY: RA		
4	APPROVED		
5	DESIGN SURVEY CHIEF		
6	APPROVAL		
7	RECOMMENDATION		
8	DESIGN ENGINEER		
9	DATE		
10	2-19-92		

NEW MEXICO STATE HIGHWAY
& TRANSPORTATION DEPARTMENT


CONCRETE WALL BARRIER
TYPE 42 AT COLUMN
AND SIGN PEDESTALS

722781


CWB-42-5/6 SHEET 21 OF 27

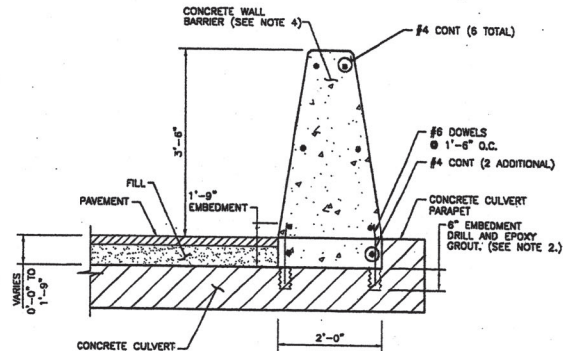

TYPICAL SECTION FOR
0'-0" TO 1'-9" FILL
N.T.S.

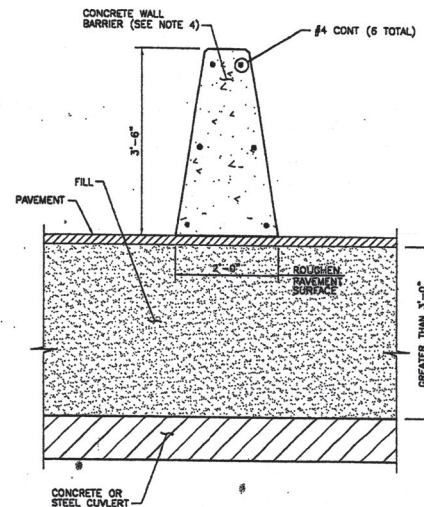

TYPICAL SECTION FOR
OVER 3'-0" FILL
N.T.S.

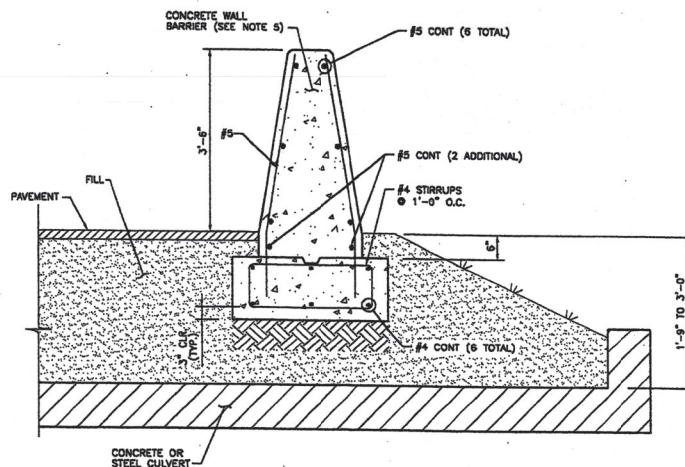


TYPICAL SECTION FOR
1'-9" TO 3'-0" FILL
N.T.S.

NOTES

1. REINFORCING BARS SHALL CONFORM TO THE REQUIREMENTS CONTAINED IN 540.21(g) OF THE STANDARD SPECIFICATIONS. REINFORCING BARS SHALL BE GRADE 60 UNLESS A DIFFERENT GRADE IS SPECIFIED ELSEWHERE IN THE PLANS.
2. MATERIAL TO BE USED FOR CORING AND GROUTING SHALL COMPLY WITH SECTION 522 OF NMSHTD STANDARD SPECIFICATIONS FOR HIGHWAY AND BRIDGE CONSTRUCTION, LATEST EDITION, AND SHALL BE APPROVED BY THE PROJECT MANAGER.
3. ADDITIONAL LONGITUDINAL REINFORCEMENT, DOWELS, EPOXY GROUT AND EXPANSION JOINT FILLER SHALL BE INCIDENTAL TO THE CONCRETE WALL BARRIER.
4. FOR ALL BARS AND DIMENSIONS NOT SHOWN FOR THE 0'-0" TO 1'-9" FILL BARRIER AND THE OVER 3'-0" FILL BARRIER, SEE TYPICAL SECTION ON SERIAL NO. CWB-42-1/6 TITLED "CONCRETE WALL BARRIER, TYPE 42".
5. FOR ALL BARS AND DIMENSIONS NOT SHOWN FOR THE 1'-9" TO 3'-0" FILL BARRIER, SEE SECTION B-8 ON SERIAL NO. CWB-42-4/6 TITLED "42 IN. CONCRETE WALL BARRIER, TRANSITION SECTION DETAILS".

1 2 3 4 5 6 7 8 9 10 11 12 13 14 15
26 7 22 7 8 12 10 9

NEW MEXICO STATE HIGHWAY & TRANSPORTATION DEPARTMENT	
42 IN. CONCRETE WALL BARRIER OVER CULVERT	
7.22781	
CWB-42-6/6 SHEET 21 OF 27	
DESIGNED BY: RA	APPROVED: [Signature] 7-19-02
DETAILED BY: LH	DESIGNED BY: RA
CHECKED BY: RA	APPROVED: [Signature]
DESIGN BUREAU CHIEF	

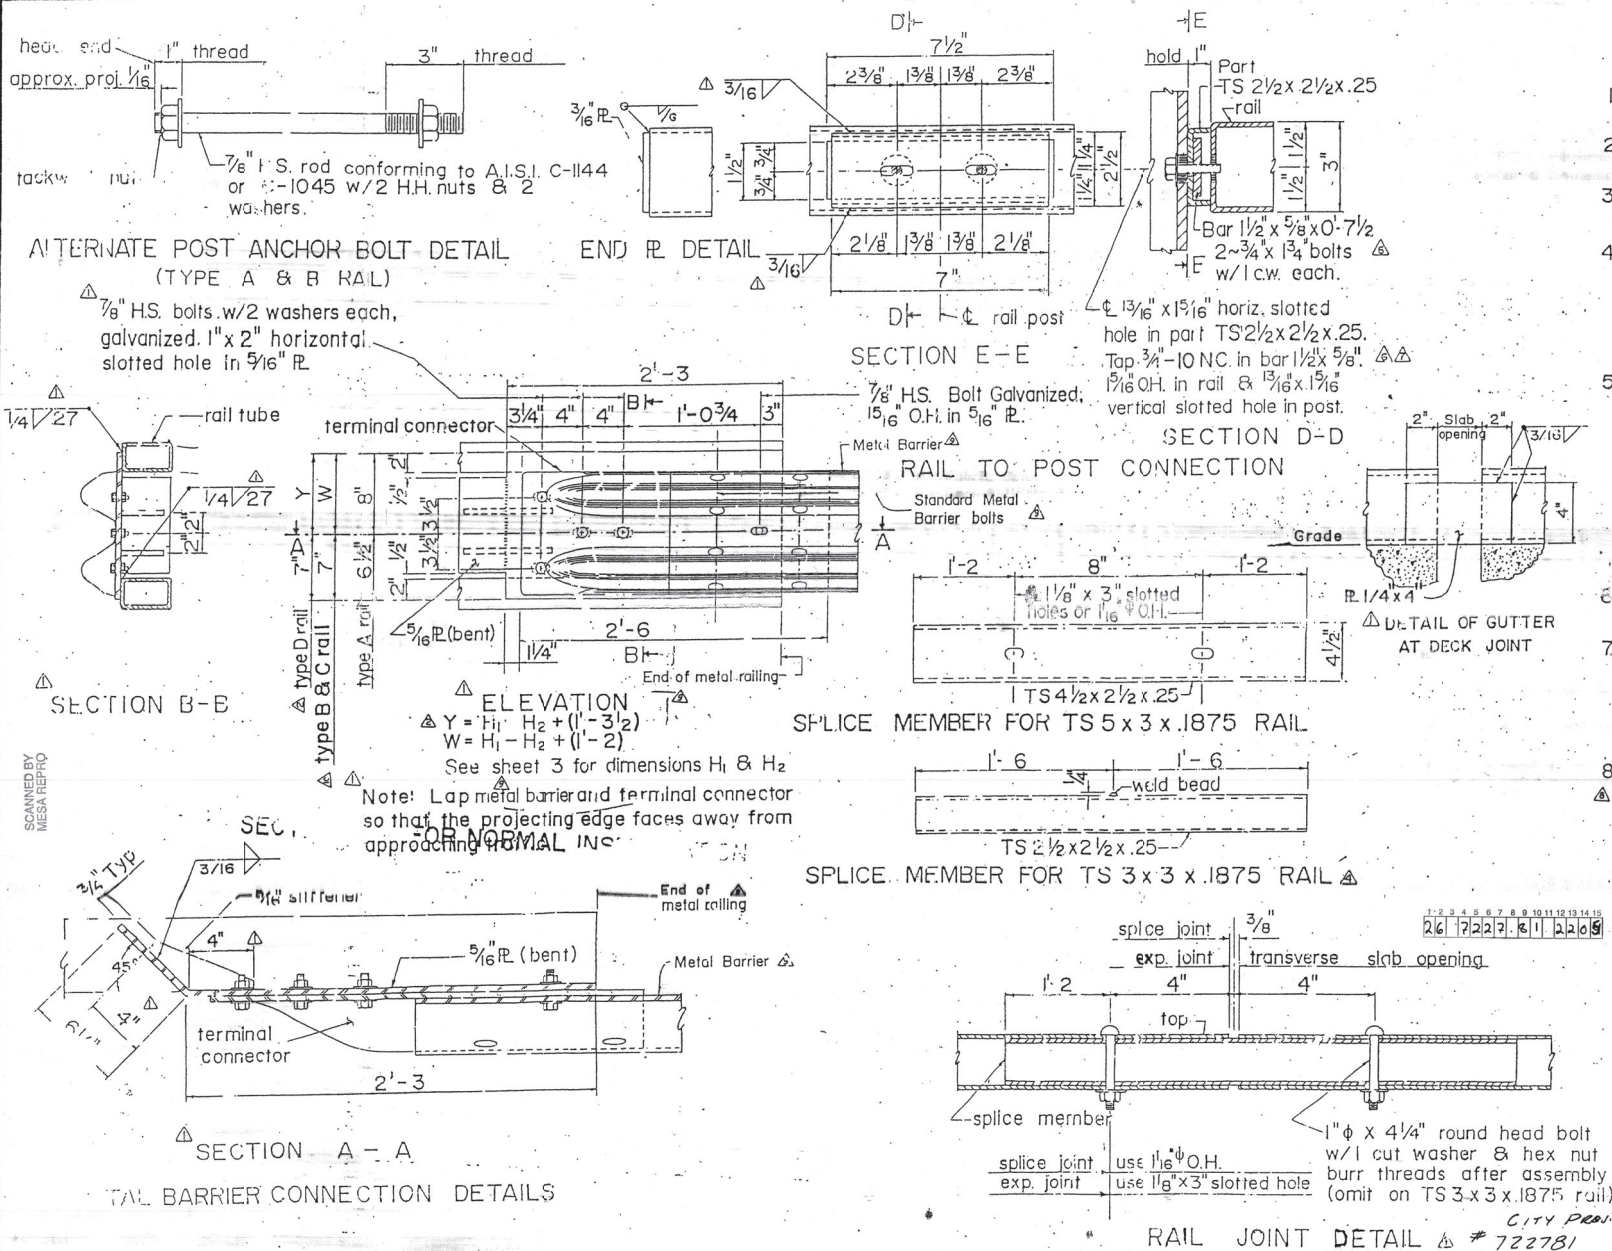

STATE	SHEET NO.	TOTAL SHEETS
NEW MEXICO	6	22

GENERAL NOTES



- Design in accordance with 1977 AASHTO Specifications.
- All rails to be parallel to grade unless otherwise shown.
- See structure details for post spacing and other details not shown.
- Details shown are for steel only. A steel or aluminum railing of an alternate design may be substituted for the railing shown on these sheets provided the alternate design is approved by the Engineer before fabrication.
- Steel rail tubes shall conform to the requirements of ASTM designation A500 or A501. Post spacing shown on the plans is based on the use of TS5x3x.1875 conforming to the requirements of ASTM designation A500 grade B. If the contractor elects to use tubes of another grade, the post spacing shown on the plans will be revised by the Bridge Design Section.
- Metal railing will be paid for at the unit price per foot.
- Terminal connector shall be AASHTO-ARBA STD HM-TF J3/RE-8, shall conform to AASHTO Specification M-160 be galvanized and of class B sheet thickness.
- Caulking compound used under gutter channels and rail post base plates shall be a single component cold applied, non sagging compound having either a silicone rubber base or a synthetic rubber base of the chemically curing type and shall conform to the requirements of Federal Specifications TT-S-00543 A or TTS 230C.

REVISIONS (OR CHANGE NOTICES)	DATE	BY
1. STRENGTHENED RAIL-POST CONNECTION	2-6-80	E.R.D.
2. CHANGED SERIAL DESIGNATION	10-26-79	E.R.D.
3. ADDED TYPE 'B' TO CONNECTION DETAIL	4-19-80	A.Z.
4. CHANGE GUARDRAIL TOTAL BARR. DET. BRIDGE	3-9-80	A.Z.
5. ADDED GENERAL NOTE NO. 8	10-25-82	E.R.D.
6. UPDATE 3" THREAD	3-15-80	E.R.D.
IDENT. NO.	DESCRIPTION	DATE
	NEW MEXICO	
	STATE HIGHWAY DEPARTMENT	
	METAL RAILING	
	GENERAL NOTES & TYPICAL DETAILS	
DESIGNED BY: G.V.	APPROVED BY: T. Tolson	2-10-76
DRAWN BY: G.V.	RECOMMENDED BY: D. TE	
CHECKED BY: M.G.	APPROVED BY: T. Tolson	3-2-76
	ENGINEER OF DESIGN	DATE
	SERIAL BMR-001-10	

DOUBLE THRIE BEAM (ONE 12'-6" SECTION SET INSIDE A STANDARD 25'-0" SECTION) • POST SPACING SHOWN.




F.H.W.A. REGION NO. 6
NEW MEXICO PROJECT NO. _____
SHEET NO. _____

GA-20

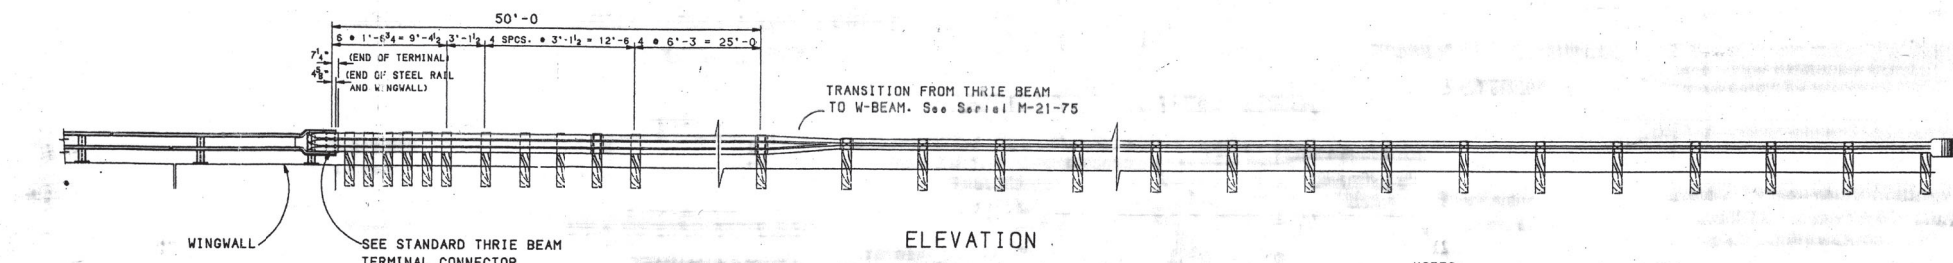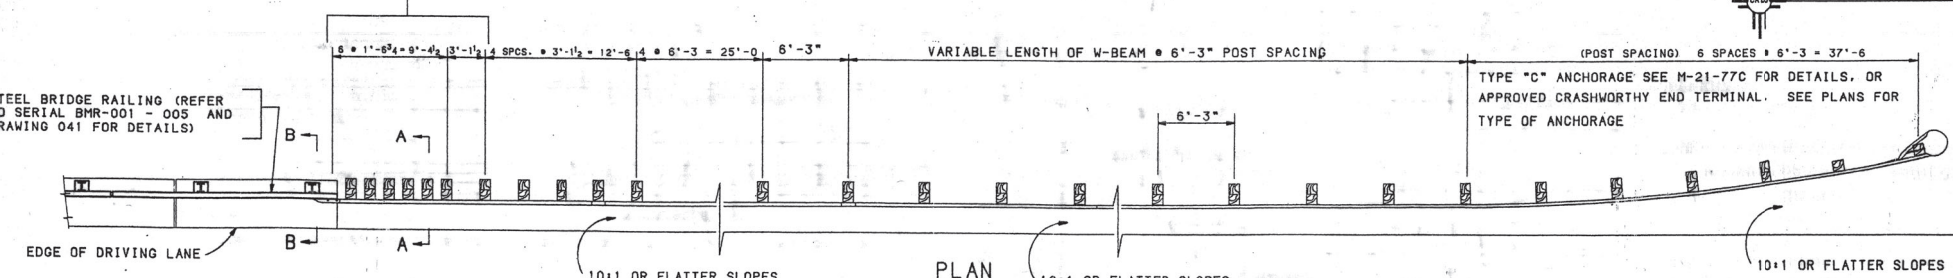

NOTES:

1. FOR DETAILS OF TYPE "C" ANCHORAGE SEE M-21-77C.
2. SEE STANDARDS M-21-62, M-21-75, AND CMB-75 FOR ADDITIONAL DETAILS.
3. REFER TO DRAWING 041 FOR DETAILS PERTAINING TO THE CONNECTION PLATE AND MODIFICATIONS MADE TO THE NEW STEEL BRIDGE RAILING TO ACCOMMODATE THE THRIE BEAM RAILING.

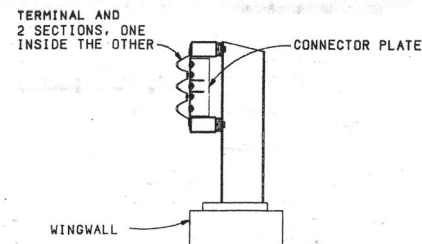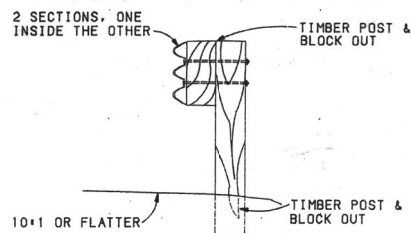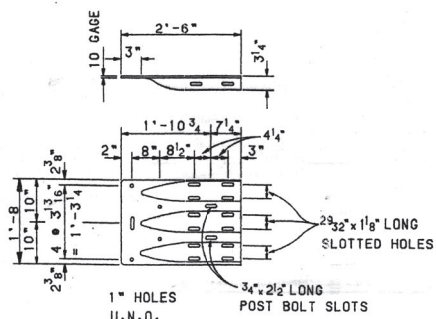

1 2 3 4 5 6 7 8 9 10 11 12 13 14 15
26 7 2 2 2 2 8 11 23 0 9

NO.	DESCRIPTION	DATE	BY
1	REVISIONS (OR CHANGE NOTICES)		
2			
3			
NEW MEXICO STATE
HIGHWAY AND TRANSPORTATION
DEPARTMENT

TRANSITION DETAILS
STEEL BRIDGE RAILING
TO THRIE BEAM TO W-BEAM
(APPROACH)

722781

DRAWING 036

SHEET 13 OF 27


STANDARD THRIE BEAM TERMINAL CONNECTOR

SECTION A-A


SECTION B-B

PRJ. NO. 722781

THIS SERIAL REVISED: 11-11-85

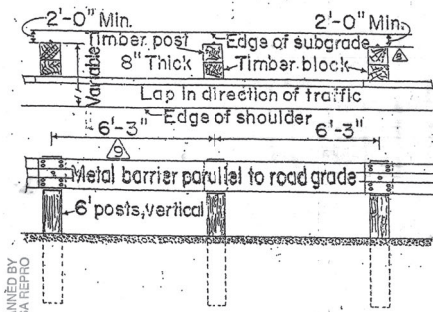


ROADSIDE INSTALLATION

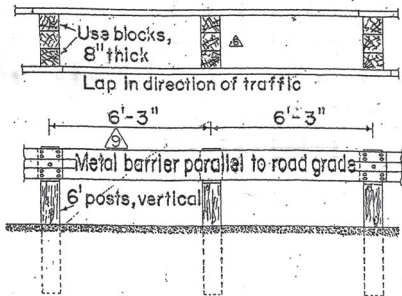


METAL BEAM RIGID BARRIER INSTALLATION


△ Metal barrier elements

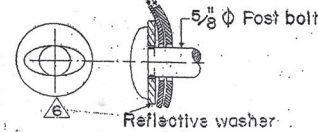


REFLECTIVE WASHER DETAIL

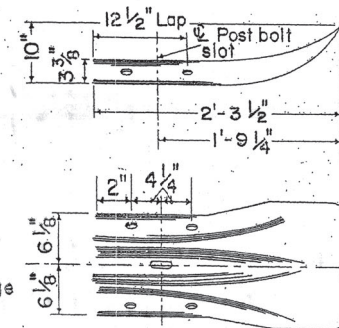


STANDARD TERMINAL SECTION

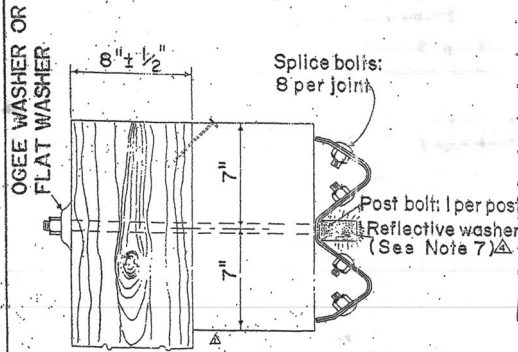


SECTION AT JOINT, SINGLE RAIL

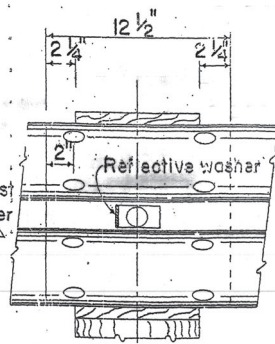


JOINT ASSEMBLY

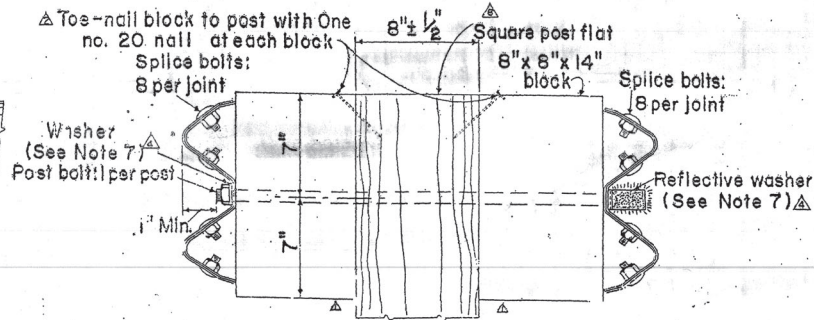


SECTION AT JOINT, METAL RIGID BARRIER

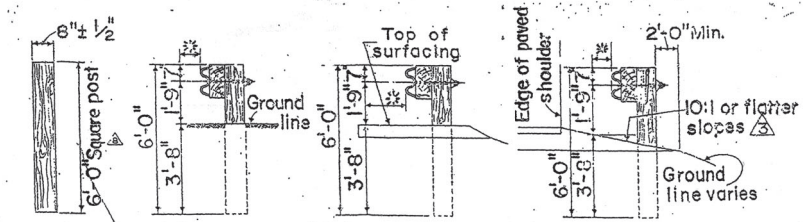

PLACEMENT PROCEDURES

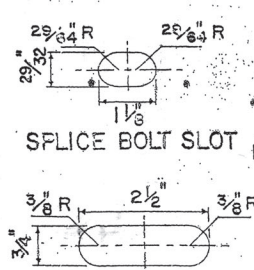


POST BOLT SLOT

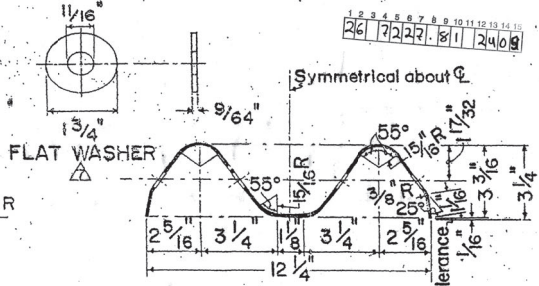


SECTION THRU METAL BARRIER ELEMENT

- NOTES**
1. Top of posts shall be flat.
 2. Unless otherwise provided, rail elements and terminal sections shall be .105 inch thick. Rail elements may be furnished in 12 1/2 ft. or 25 ft. lengths.
 3. Where the radius of curved alignment is 150 ft. or less, the individual railing sections shall be shop-formed by the manufacturer to fit the curvature.
 4. Timber blocks to be 8" x 8" x 14" high, except where otherwise noted. Blocks and posts may be rough or S4S.
 5. Contractor to use 8" square post.
 6. Rail element shall conform to AASHTO Spec. M180, Class A, Type I., unless otherwise specified.
 7. Reflective washers shall be placed facing approaching traffic at 25 ft. intervals on one-way and divided roadways. On two-way roadways, reflective washers shall be placed at 12 1/2 ft. intervals with every 2nd washer facing opposing traffic. Rectangular flat washers to be placed at all other post bolts.
 8. Amber reflective washers in lieu of silver shall be used when the metal barrier is on the left side to approaching traffic on multi-lane facilities.


CHANGED GUARDRAIL TO METAL BARRIER		2-1-85	J.R.R.
Added flat washers - 100' and 250' R.D. post marks		11-11-85	J.R.R.
ADDED NOTE 8 - ADDED NEW BOLT FIGURE (post bolt)		5-21-86	M.S.P.
REVISED SLOPES - ADDED NOTE 7		8-29-77	J.R.
REMOVED LOWER NAILS - REVISED NAILING NOTE		6/2/77	TGM.
IDENT. NO.	DESCRIPTION	DATE	BY
REVISIONS (OR CHANGE NOTICES)			
NEW MEXICO			
STATE HIGHWAY DEPARTMENT			
METAL BARRIER MATERIALS			
AND PLACEMENT PROCEDURES			
DESIGNED BY L.A.L.	APPROVAL	6/24/86	2-4-76
DRAWN BY J.L.M.	RECOMMENDED - TRAFFIC ENGINEER	DATE	
CHECKED BY L.A.L.	APPROVED	6/24/86	2-4-76
	ENGINEER/AT DESIGN	DATE	
SERIAL M-21-62		SHEET 51 OF 1	

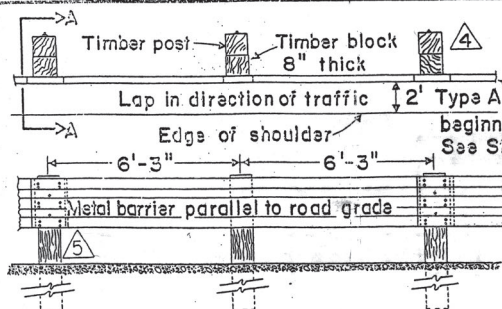


ROADSIDE INSTALLATION

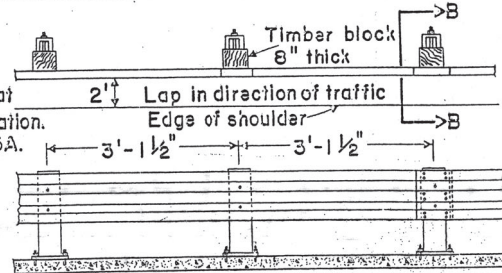


BOX CULVERT INSTALLATION
(See note 9)

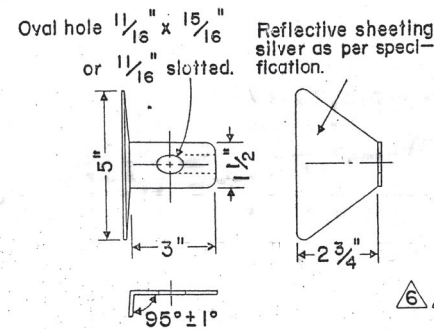


ALTERNATE REFLECTIVE
WASHER DETAIL

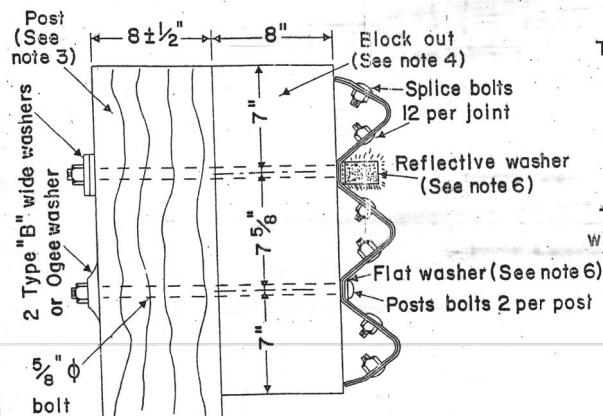


ROADSIDE SECTION AT JOINT

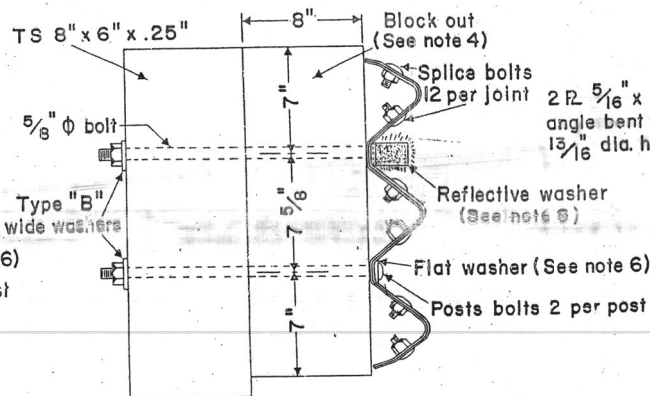


BOX CULVERT SECTION AT JOINT

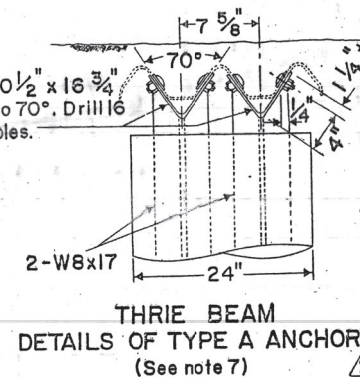


THREE BEAM
DETAILS OF TYPE A ANCHOR
(See note 7)

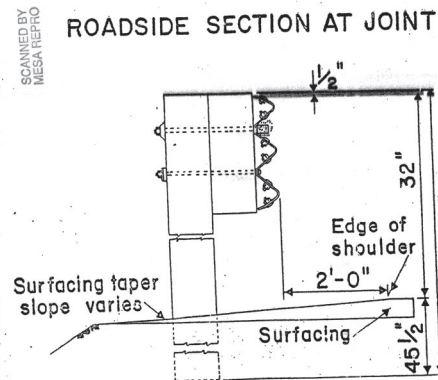

SECTION A-A

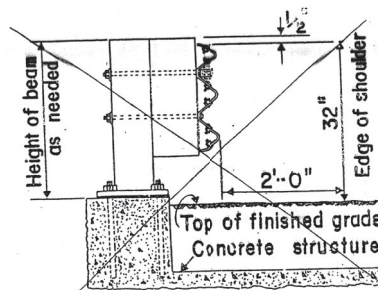

SECTION B-B
DO NOT USE - PARAPET MOUNT

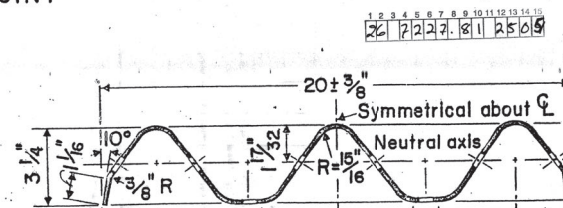

SECTION THRU RAIL ELEMENT

NOTES
1. All material and workmanship shall be done in accordance to the N.M. State Highway Department Specifications.

2. Unless otherwise provided, rail elements shall be .105 inches thick. Rail elements may be furnished in 12-1/2 ft. or 25 ft. lengths.

3. Contractor to use 8"x8"x6' 6" rough post or surfaced on four sides (S4S), W6x8.5x6' 6" steel post or W6x9.0x6' 6" steel post.

4. Timber blocks shall be 8"x8"x1' 9 5/8" high. Blocks may rough or (S4S). Steel block shall W6x8.5x1' 9.5" or W6x9x1' 9.5".

5. Timber posts and blocks are to be treated as specified.

6. Reflective washers as per this sheet or standard M-21-62 shall be placed every 25 ft. on upper bolt slot of metal barrier elements. Flat washers to be placed at all other bolt slots.

7. For additional details see standards M-21-62, M-21-77, M-21-65A.

8. Rail elements shall be steel conforming to the requirements of AASHTO M180, Class A, Type I, except as shown otherwise on this sheet.


9. For Box Culvert installation see standard M-21-67A-75-1/2.

10. When steel posts and steel blocks are used, a 1 foot rail section must be placed behind rail elements at intermediate posts (non-splice-posts).

THIS SERIAL REVISED: 3-2-66


REVISIONS (OR CHANGE NOTICES)	DATE	BY
1. ADD TO SERIAL TO METAL BARRIER	2-1-65	DRR
2. CHANGED SUBORDINATE TO METAL BARRIER	2-1-65	DRR
3. CHANGED RAIL POSTS TO SQUARE POSTS. Revised note 3	11-18-63	FWL
4. CHANGED SHEET 1 OF 1 TO 1 OF 2	9-20-63	CVT
5. ADDED NOTE 10.	11/15/78	J.R.
6. REVISED NOTE 7.	12/28/77	J.R.
7. REVISIONS (OR CHANGE NOTICES)		
NEW MEXICO		
STATE HIGHWAY DEPARTMENT		
METAL BARRIER THREE BEAM		
ROADSIDE AND BOX CULVERT		
DESIGNED BY L.A.L.	APPROVED <i>G. B. B. B.</i>	7-13-72
DRAWN BY J.L.M.	RECOMMENDED - TRAFFIC ENGINEER	DATE
CHECKED BY L.A.L.	APPROVED <i>Barry B. B. B.</i>	7-13-72
ENGINEER OF DESIGN		
SERIAL M-21-75		
SHEET 1 OF 2		

SHEET 25 OF 27

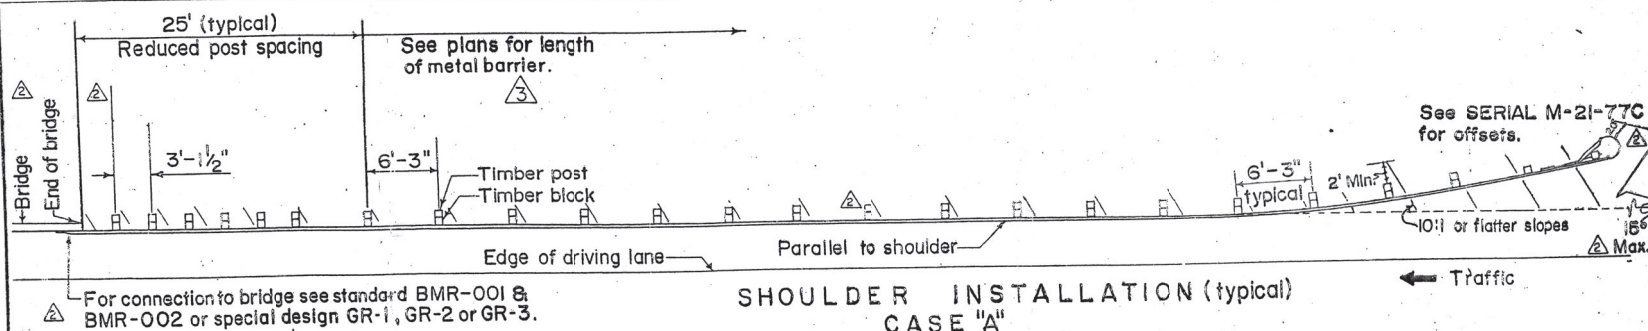

SHOULDER INSTALLATION (typical)
CASE "A"

- GENERAL NOTES**
1. Build metal barrier at structures when noted on plans.
 2. For metal barrier details, see New Mexico Standard M-21-62.
 3. For special installations, Project Engineer will determine the exact radius of rail and location of posts and notify contractor before material is fabricated.
 4. At the discretion of the designer, the metal barrier may be installed parallel to the shoulder (CASE "A") or with a flare rate (CASE "B").
 5. See SERIAL M-21-77C for anchorage details.

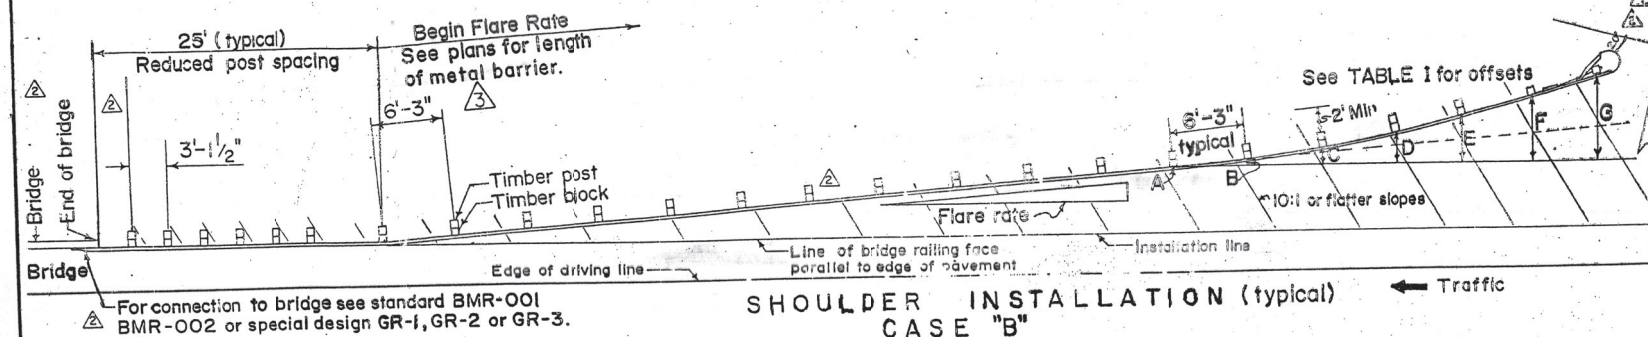


SHOULDER INSTALLATION (typical)
CASE "B"


TABLE I
CASE "B"
FLARE RATE

	50:1	25:1
A	0.0'	0.0'
B	0.24'	0.36'
C	0.69'	0.94'
D	1.38'	1.75'
E	2.30'	2.80'
F	3.43'	4.05'
G	4.75'	5.50'


1 2 3 4 5 6 7 8 9 10 11 12 13 14 15
26 22 27 21 24 25

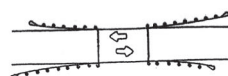

Two-Lane Highway

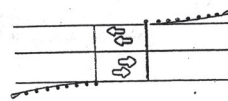

Multi-Lane
Single-Structure

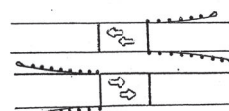

Multi-Lane
Double Structure

APPLICATION

THIS SERIAL REVISED: 2-5-55

CHANGED GUARDRAIL TO METAL BARRIER	2-5-55	D.R.R.
Revise Table I, Posts And Notes	11-22-55	P.L.
REDREW STANDARD	1-25-56	J.R.
IDENT. NO.	DESCRIPTION	DATE BY



REVISIONS (OR CHANGE NOTICES)

NEW MEXICO
STATE HIGHWAY DEPARTMENT

METAL BARRIER AT BRIDGE APPROACHES

DESIGNED BY J.R.	APPROVAL	DATE
DRAWN BY G.O.	RECOMMENDED	ENGINEER
CHECKED BY N.	APPROVED	ENGINEER OF DESIGN

SERIAL M-21-77 SHEET 1 OF 2

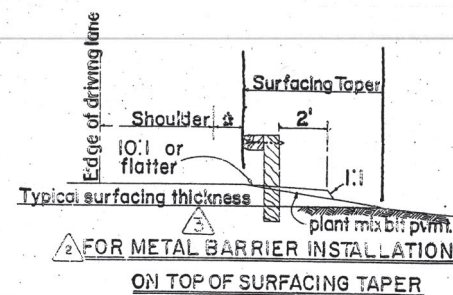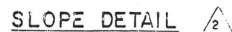

✕ See plans for offset distance.

1. For additional details see Serials M-21-62, M-21-77 sheet 1 of 2 and M-21-77C.
2. The embankment material shall be compacted to 95 percent of maximum density.
3. Unless otherwise specified on the plans, the cost of the embankment material and the placing thereof shall be included in the unit bid price for metal barrier.

THIS SERIAL REVISED: 2-7-85

CHANGED GUARDRAIL TO METAL-BARRIER	2/7/85	GR
DETAIL LABELS WERE CHANGED	3/20/84	CV
REVISED GENERAL NOTES	3/20/84	CV
IDENT. NO.	DESCRIPTION	DATE
REVISIONS (OR CHANGE NOTICES)		
NEW MEXICO		
STATE HIGHWAY DEPARTMENT		
-APPROACH SLOPE PREPARATION		
METAL BARRIER INSTALLATION		
DESIGNED BY P.L.	APPROVAL	DATE
DRAWN BY F.L.P.	RECOMMENDED	DATE
CHECKED BY P.L.	APPROVED	DATE
	ENGINEER OF DESIGN	DATE
SERIAL M-21-77		SHEET 2 OF 2

PRJ. NO. 722781

SHEET 27 OF 27