

SCANNED
BY *PLN*

26 723581 06


CONSTRUCTION PLANS FOR REDLANDS SHOPPING CENTER / COORS BLVD.

PAVING AND STORM SEWER IMPROVEMENTS

CITY OF ALBUQUERQUE
NEW MEXICO
FEBRUARY 2005

INDEX TO DRAWINGS

1. TITLE SHEET
2. PLAT
3. OVERALL GRADING AND DRAINAGE PLAN
4. COORS BLVD. PAVING & STORM SEWER IMPROVEMENTS

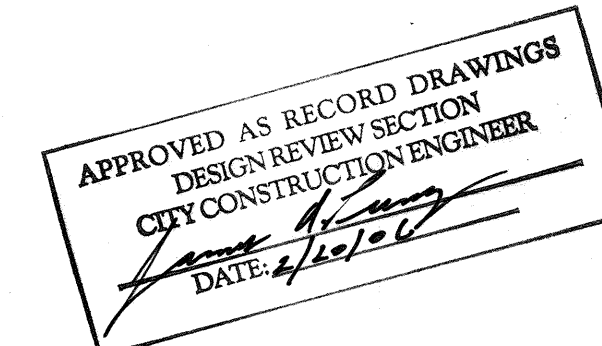


RECORD DRAWING

I, SHAHAB BIAZAR, OF THE FIRM OF ADVANCED ENGINEERING AND CONSULTING, LLC, A REGISTERED PROFESSIONAL ENGINEER IN THE STATE OF NEW MEXICO, DO HEREBY CERTIFY, TO THE BEST OF MY KNOWLEDGE AND BELIEF, THAT THE INFRASTRUCTURE INSTALLED AS PART OF THIS PROJECT HAS BEEN INSPECTED BY ME OR BY A QUALIFIED PERSON UNDER MY DIRECT SUPERVISION AND HAS BEEN CONSTRUCTED IN ACCORDANCE WITH THE PLANS AND SPECIFICATIONS APPROVED BY THE CITY ENGINEER AND THAT THE ORIGINAL DESIGN INTENT OF THE APPROVED PLANS HAS BEEN MET, EXCEPT AS NOTED BY ME ON THE AS-BUILT CONSTRUCTION DRAWINGS. THIS CERTIFICATION IS BASED ON SITE INSPECTIONS BY ME OR PERSONNEL UNDER MY DIRECTION AND SURVEY INFORMATION PROVIDED BY LEONARD MARTINEZ OF ADVANCED ENGINEERING, NMPS NUMBER [blank].

SHAHAB BIAZAR, PE
NMPE NO. 13479
DATE 2/9/06
Advanced Eng. & Cons., LLC

TRAFFIC CONTROL PLAN

USE COA TRAFFIC CONTROL PLAN.

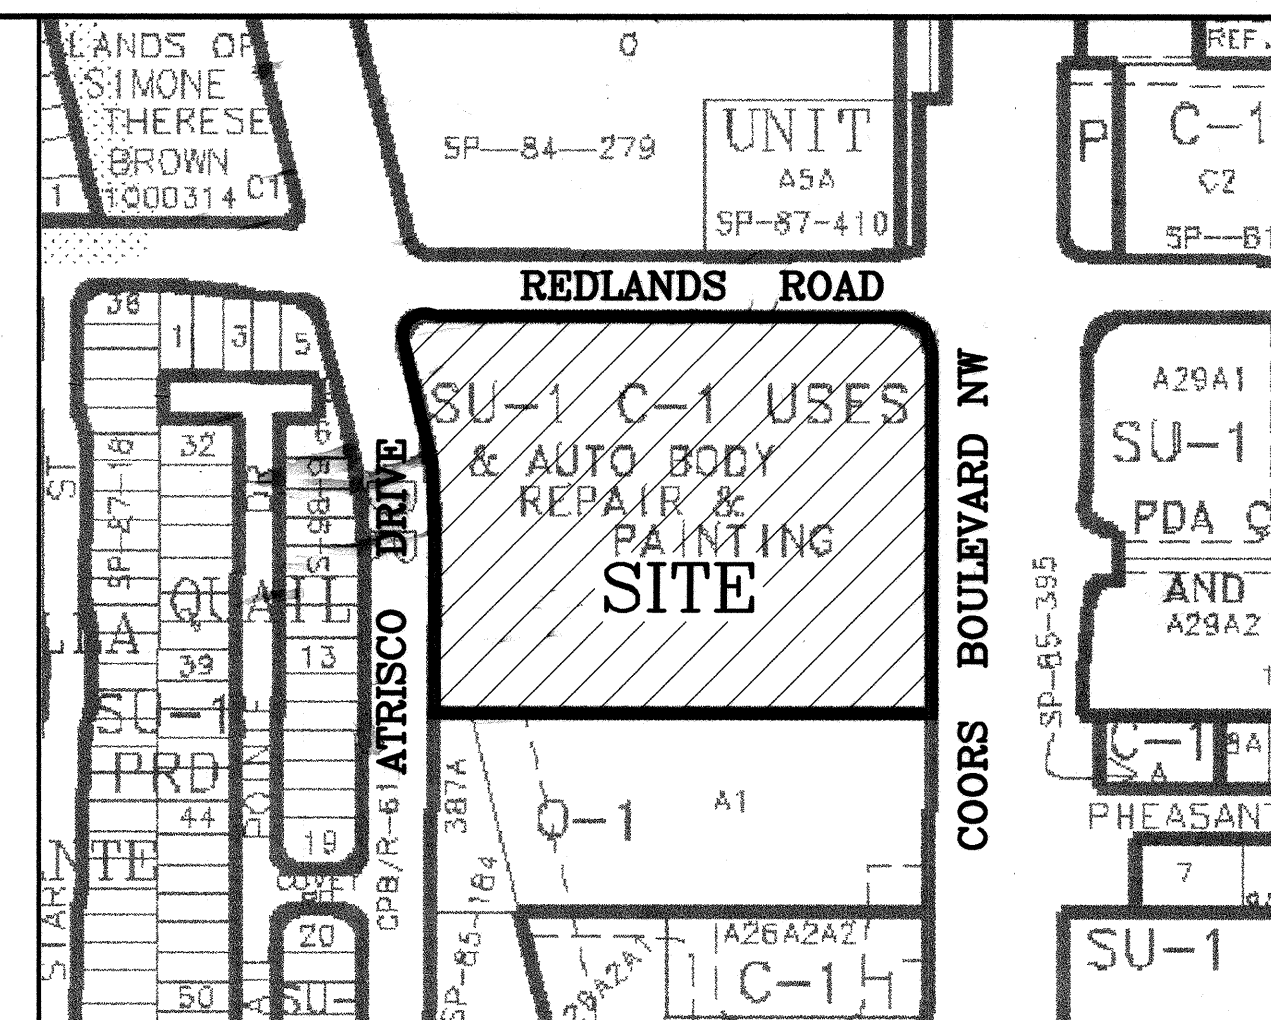

VICINITY MAP ZONE ATLAS G-11-Z

N.T.S.


NOTICE TO CONTRACTORS

1. ALL WORK DETAILED ON THESE PLANS TO BE PERFORMED UNDER CONTRACT SHALL, EXCEPT AS OTHERWISE STATED OR PROVIDED FOR HEREON, BE CONSTRUCTED IN ACCORDANCE WITH THE CITY OF ALBUQUERQUE STANDARD SPECIFICATIONS FOR PUBLIC WORKS CONSTRUCTION, 1986 EDITION (UPDATE #7).
2. TWO WORKING DAYS PRIOR TO ANY EXCAVATION, THE CONTRACTOR MUST CONTACT NEW MEXICO ONE CALL SYSTEM (260-1990) FOR LOCATION OF EXISTING UTILITIES.
3. ANY WORK AFFECTING AN ARTERIAL ROADWAY REQUIRES 24-HOUR CONSTRUCTION.
4. PRIOR TO CONSTRUCTION, THE CONTRACTOR SHALL EXCAVATE AND VERIFY THE HORIZONTAL AND VERTICAL LOCATIONS OF ALL OBSTRUCTIONS. SHOULD A CONFLICT EXIST, THE CONTRACTOR SHALL NOTIFY THE ENGINEER OR SURVEYOR IMMEDIATELY SO THAT THE CONFLICT CAN BE RESOLVED WITH A MINIMUM AMOUNT OF DELAY.
5. FIVE (5) WORKING DAYS PRIOR TO BEGINNING OF CONSTRUCTION, THE CONTRACTOR SHALL SUBMIT TO CONSTRUCTION COORDINATION DIVISION A DETAILED CONSTRUCTION SCHEDULE. TWO(2) WORKING DAYS PRIOR TO CONSTRUCTION, THE CONTRACTOR SHALL OBTAIN A BARRICADE PERMIT FROM THE CONST. COORDINATION DIVISION. CONTRACTOR SHALL NOTIFY BARRICADE ENGINEER (924-3400) PRIOR TO OCCUPYING AN INTERSECTION. REFER TO STANDARD SPECIFICATIONS.
6. ALL STREET STRIPING ALTERED OR DESTROYED SHALL BE REPLACED WITH PLASTIC REFLECTORIZED PAVEMENT MARKINGS BY THE CONTRACTOR TO LOCATION AS EXISTING OR AS INDICATED BY THIS PLAN SET.
7. CONTRACTOR SHALL NOTIFY THE ENGINEER NOT LESS THAN SEVEN (7) DAYS PRIOR TO STARTING WORK IN ORDER THAT THE ENGINEER MAY TAKE NECESSARY MEASURES TO INSURE THE PRESERVATION OF SURVEY MONUMENTS. CONTRACTOR SHALL NOT DISTURB PERMANENT SURVEY MONUMENTS WITHOUT THE CONSENT OF THE ENGINEER AND SHALL NOTIFY THE ENGINEER AND BEAR THE EXPENSE OF REPLACING ANY THAT MAY BE DISTURBED WITHOUT PERMISSION. REPLACEMENT SHALL BE DONE ONLY BY THE CITY SURVEYOR. WHEN A CHANGE IS MADE IN THE FINISHED ELEVATIONS OF THE PAVEMENT OF ANY ROADWAY IN WHICH A PERMANENT SURVEY MONUMENT IS LOCATED, CONTRACTOR SHALL, AT HIS OWN EXPENSE, ADJUST THE MONUMENT COVER TO THE NEW GRADE UNLESS OTHERWISE SPECIFIED. REFER TO SECTION 4.4 OF THE GENERAL CONDITIONS OF THE STANDARD SPECIFICATIONS. ANY PERMANENT SURVEY MONUMENT LOCATED WITHIN 50' OF THIS PROJECT THAT IS NOT SHOWN ON THE PLAN AND IS DESTROYED DURING CONSTRUCTION WILL BE REPLACED AT THE DESIGNERS EXPENSE.
8. FOR STORM DRAIN CONSTRUCTION, RCP PIPE JOINTS SHALL NOT BE GROUTED PRIOR TO FINAL INSPECTION. FINAL INSPECTION WILL DETERMINE JOINTS TO BE GROUTED FOR FINAL ACCEPTANCE OF THE CONSTRUCTION.
9. ALL EXCAVATION, TRENCHING AND SHORING ACTIVITIES MUST BE CARRIED-OUT IN ACCORDANCE WITH OSHA 29 CFR 1926.650 SUBPART P.

THE FOLLOWING NOTES ALSO APPLY WHEN CHECKED

- ☐ ALL UTILITIES AND UTILITY SERVICE LINES SHALL BE INSTALLED PRIOR TO PAVING.
- ☒ BACKFILL COMPACTION SHALL BE ACCORDING TO SPECIFIED STREET USE.
- ☐ TACK COAT REQUIREMENTS SHALL BE DETERMINED BY THE DESIGN ENGINEER.
- ☐ SIDEWALKS AND WHEELCHAIR RAMPS WITHIN THE CURB RETURNS SHALL BE CONSTRUCTED WHEREVER A NEW CURB RETURN IS CONSTRUCTED.
- ☐ IF CURB IS DEPRESSIONED FOR A DRIVEPAD, THE DRIVEPAD SHALL BE CONSTRUCTED PRIOR TO ACCEPTANCE OF CURB AND GUTTER.
- ☒ ALL STORM DRAINAGE FACILITIES SHALL BE COMPLETED PRIOR TO FINAL ACCEPTANCE.

DRB CASE NUMBER 1002405

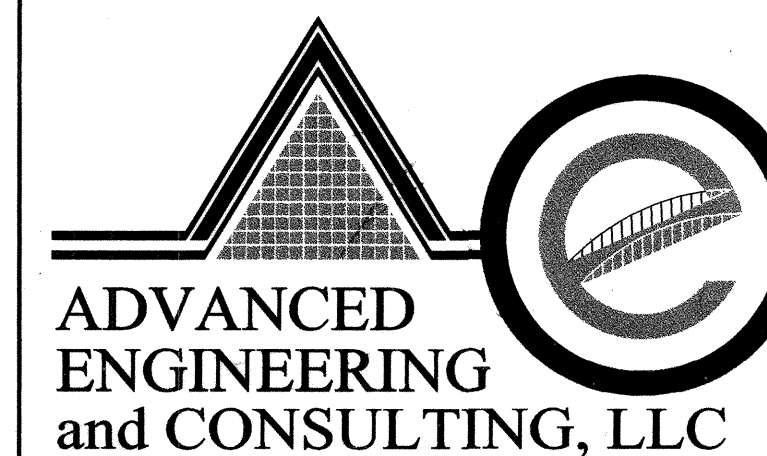

ADVANCED
ENGINEERING
and CONSULTING, LLC

4416 ANAHEIM AVE., NE
ALBUQUERQUE, NEW MEXICO 87113
(505)899-5570

DRAWING: 200426-TITLE DRAWN BY: SHH DATE: 02-03-05

																																																																																																																																																																																																																																																																																																																																																																																																																																																																																																																																																																																																																																																																																																																																																																																																																																																																																																																																																																																																																																																																																																																																																																																																																																																																																																																																																																																																																					</
--	--	----

APPROVED FOR CONSTRUCTION
[Signature] 7-13-05
City Engineer Date




PURPOSE OF PLAT

- SUBDIVIDE TRACT A-28-B1-NORTHEAST UNIT, TOWN OF ATRISCO GRANT INTO 2 TRACTS
- GRANT NEW EASEMENTS AS SHOWN
- DEDICATE NEW RIGHT-OF-WAY AS SHOWN

LEGAL DESCRIPTION

A tract of land situate within the Town of Atrisco Grant, projected Section 2, Township 10 North, Range 2 East, New Mexico Principal Meridian, City of Albuquerque, Bernalillo County, New Mexico being all of TRACT A-28-B1, NORTHEAST UNIT, TOWN OF ATRISCO GRANT, and the same is situated in the NE1/4 of Section 2, Township 10 North, Range 2 East, New Mexico Principal Meridian, City of Albuquerque, Bernalillo County, New Mexico, and the same is shown as being more or less, as shown on the plat filed for record in the office of the County Clerk of Bernalillo County, New Mexico on May 3, 1996 in Volume 96C, Folio 181 and containing 4.8182 acres more or less.

NOTES (SEE SHEET 2 OF 3)

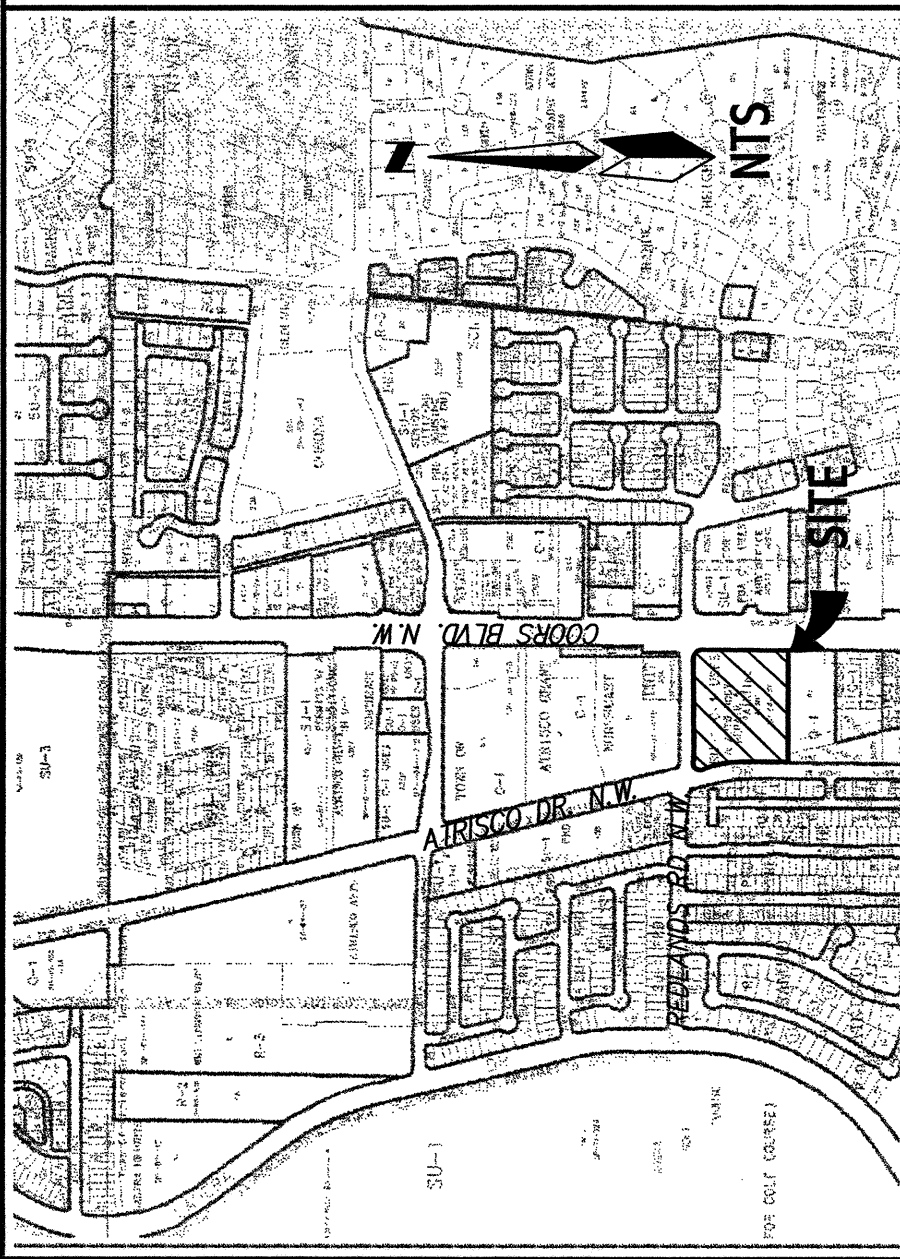

LOCATION MAP

ZONE ATLAS G-11-Z

SUBDIVISION DATA

GROSS ACREAGE 4.8182 AC
ZONE G-11-Z
NO. OF EXISTING TRACTS 1
NO. OF TRACTS CREATED 2
DATE OF SURVEY OCTOBER 1999
UTILITY CONTROL LOCATION SYSTEM LOG NUMBER 2004372353
ZONING SU-1, C-1 USES

FREE CONSENT AND DEDICATION

The subdivision hereon described is with the free consent and in accordance with the desires of the undersigned owner(s) and/or proprietor(s) thereof and said owner(s) and/or proprietor(s) do hereby dedicate additional right-of-ways as shown hereon to the City of Albuquerque in fee simple with warranty covenants and do hereby grant: all access, utility and drainage easements shown hereon including the right to construct, operate, inspect, and maintain facilities therein; and all public utility easements shown hereon for the common and joint use of gas, electrical power and communication services for buried distribution lines, overhead power lines and poles and appurtenant easements and the right to interfere with trees and shrubs. Said owner(s) and/or proprietor(s) do hereby consent to all of the foregoing and do hereby certify that this subdivision is their free act and deed. Said owner(s) warrant that they hold among them complete and indefeasible title in fee simple to the land subdivided.

Signature for Plat for Tract A-28-B1-1 and A-28-B1-2

Lee S. Blaugrund, individually and as Co-Trustee of the L. Alongi Family Trust; and as attorney-in-fact for Linda Blaugrund Alongi, as Trustee of the Linda Blaugrund Alongi Revocable Trust UTA dated August 24, 1994; and as attorney-in-fact for Clifford Earl Blaugrund as Co-Trustee of the L. Alongi Family Trust; and as attorney-in-fact for Clifford Earl Blaugrund and Nancy Dreyer Blaugrund, as trustees of the Clifford Earl Blaugrund and Nancy Dreyer Blaugrund Revocable Trust UTA, dated February 12, 1998, as amended by First Amendment dated November 20, 2001, FBO Clifford Earl Blaugrund.

Owner's Acknowledgment

STATE OF NEW MEXICO } ss.
COUNTY OF BERNALILLO }

This instrument was acknowledged before me on October 20, 2004, by Lee S. Blaugrund, individually and as Co-Trustee of the L. Alongi Family Trust; and as attorney-in-fact for Linda Blaugrund Alongi, as Trustee of the Linda Blaugrund Alongi Revocable Trust UTA dated August 24, 1994; and as attorney-in-fact for Clifford Earl Blaugrund as Co-Trustee of the L. Alongi Family Trust; and as attorney-in-fact for Clifford Earl Blaugrund and Nancy Dreyer Blaugrund, as trustees of the Clifford Earl Blaugrund and Nancy Dreyer Blaugrund Revocable Trust UTA, dated February 12, 1998, as amended by First Amendment dated November 20, 2001, FBO Clifford Earl Blaugrund.

My Commission Expires: _____
Notary Public

TIMOTHY ALDRICH, P.S. No. 7719

ALDRICH LAND SURVEYING
P.O. BOX 30701, ALBQ., N.M. 87190
505-884-1990


AS SHOWN	Drawn: STEPHEN	Checked: ALS	Sheet of 1 3
Scale: AS SHOWN	Date: 09/24/04	Job: A04067	

PLAT FOR
TRACT A-28-B1-A and A-28-B1-B
NORTHEAST UNIT, TOWN OF ATRISCO GRANT
WITHIN THE
PROJECTED SECTION 2

TOWN OF ATRISCO GRANT
TOWNSHIP 10 NORTH RANGE 2 EAST, NWPM
CITY OF ALBUQUERQUE
BERNALILLO COUNTY, NEW MEXICO
OCTOBER 2004

CURVE	RADIUS	DELTA	LENGTH	TANGENT	CHORD-BEARING	CHORD-DISTANCE
C1	549.00'	1600.27"	153.38'	77.19'	N07°23'13"W	152.88'
C2	25.00'	105°34'57"	46.07'	32.93'	N37°24'02"E	39.82'
C3	38.00'	90°00'05"	59.69'	38.00'	S44°48'28"E	53.74'

REDLANDS ROAD N.W. (R/W 60')

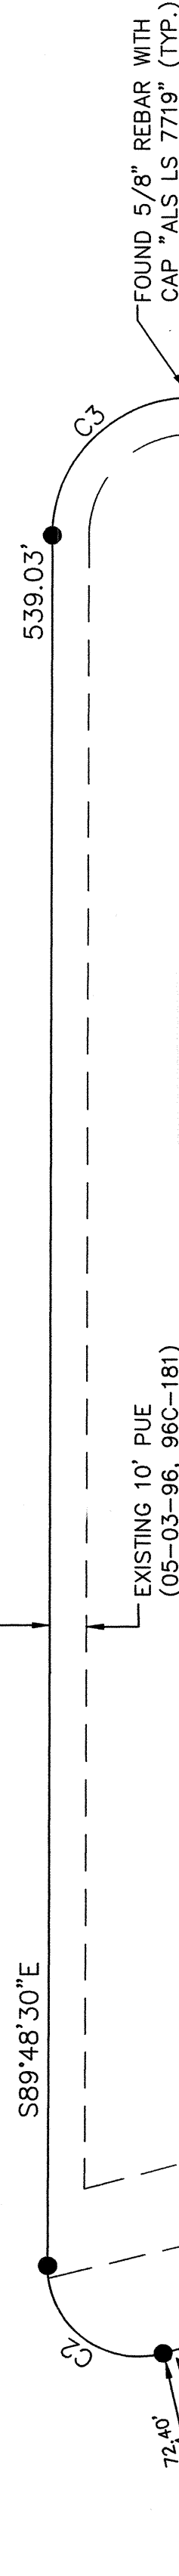


NOTES

- Bearings are New Mexico State Plane Grid Bearings (Central Zone).
- Bearings and distances are field and record.
- Basis of boundary are the following plats of record entitled:
PLAT FOR "NORTHEAST UNIT, TOWN OF ATRISCO GRANT, TRACTS A-28-B1 & A-28-B2", (05-03-96, 96C-181)
PLAT FOR "TOWN OF ATRISCO GRANT, LOTS A1, 387A, 387B AND 387C", (05-20-85, C27-56)
all being records of Bernalillo County, New Mexico.
- Field Survey performed: October 1999.
- Title Report: None provided.
- Utility Council Location System No.: 2004372353
- These tracts are affected by a RIGHT-OF-WAY EASEMENT to American Telephone and Telegraph Company, recorded May 17, 1950 in Book 112, Page 290, said easement amended by a MODIFICATION EASEMENT, recorded February 13, 1973 in Book Misc. 298, Page 635, said easement assigned to the Mountain States Telephone and Telegraph Company by ASSIGNMENT recorded December 19, 1977, in Book Misc. 575, Page 928 all being records of Bernalillo County, New Mexico.
- Flood Zone Designation: Zone X, as established on Panel 327 of 825, Flood Insurance Rate Map, Bernalillo County, New Mexico dated September 20, 1996. (This property does not lie within the 100 year flood plain).




LOT A-1
TOWN OF ATRISCO GRANT
(5-20-85, C27-56)

ACS MONUMENT
"12-HIT"
Y=14977656.42
X=306000.00
G=0.0015134"
CENTRAL ZONE
(NAD 1927/SLD 1929)
ELEVATION=5102.169

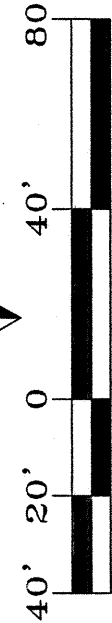

ALDRICH LAND SURVEYING
P.O. BOX 30701, ALBQ., N.M. 87190
505-884-1990


SCANNED BY PLW

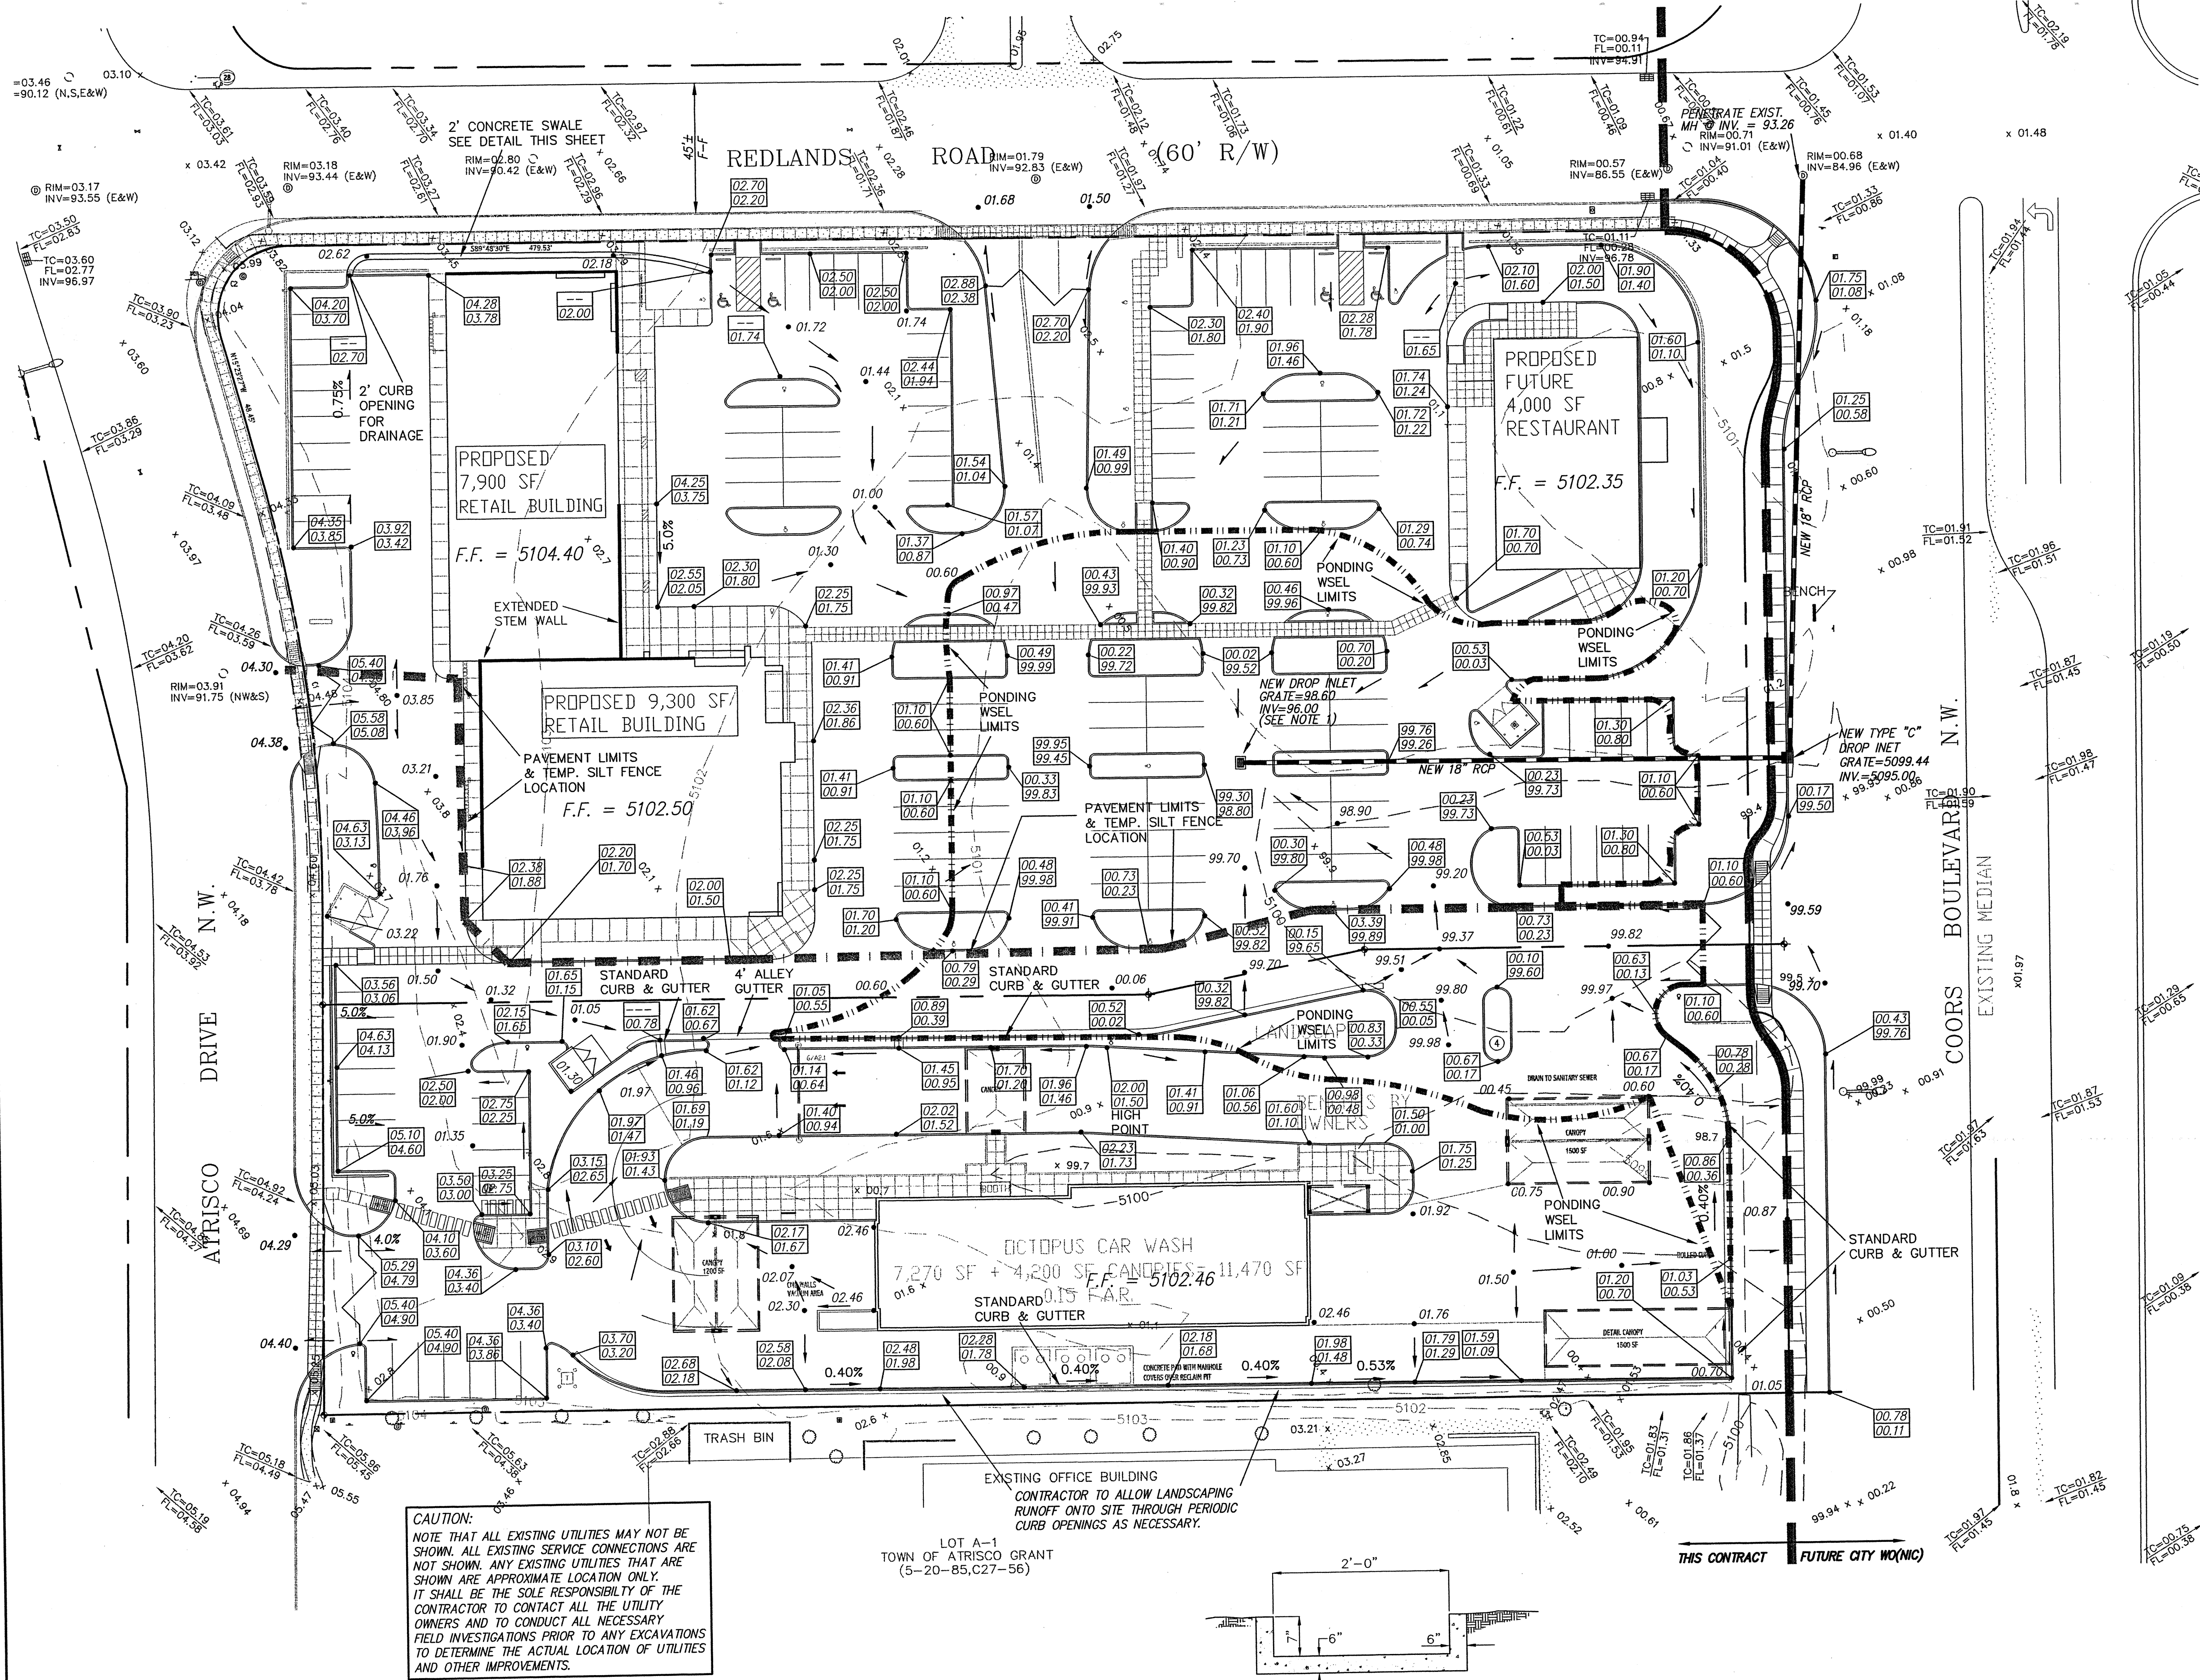

CAUTION:
NOTE THAT ALL EXISTING UTILITIES MAY NOT BE SHOWN. ALL EXISTING SERVICE CONNECTIONS ARE NOT SHOWN. ANY EXISTING UTILITIES THAT ARE SHOWN ARE APPROXIMATE LOCATION ONLY. IT SHALL BE THE SOLE RESPONSIBILITY OF THE CONTRACTOR TO CONTACT ALL THE UTILITY OWNERS AND TO CONDUCT ALL NECESSARY FIELD INVESTIGATIONS PRIOR TO ANY EXCAVATIONS TO DETERMINE THE ACTUAL LOCATION OF UTILITIES AND OTHER IMPROVEMENTS.

LOT A-1
TOWN OF ATRISCO GRANT
(5-20-85, C27-56)

CONCRETE SWALE SECTION
N.T.S.

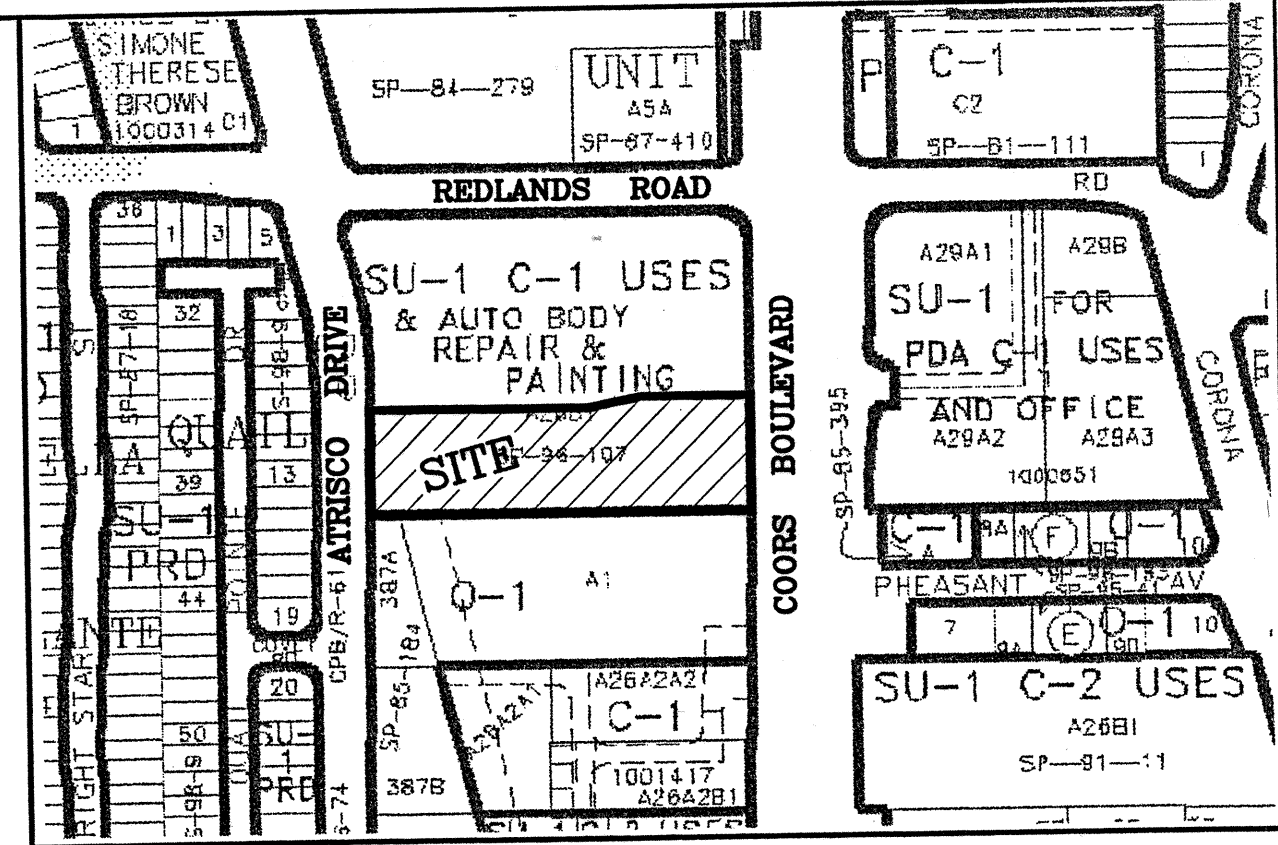

VICINITY MAP:

G-11-Z

LEGAL DESCRIPTION:

TRACT 4-28-B1 AND A-28-B2, NORTHEAST UNIT, TOWN OF ATRISCO GRANT, SECTION 2 TOWNSHIP 10 NORTH, RANGE 2 EAST, NMPM CITY OF ALBUQUERQUE BERNALILLO COUNTY, NEW MEXICO.


GENERAL NOTES

- THE OPENING FROM THE ON-SITE DROP INLET TO THE 18" RCP OUTFALL SHALL BE COVERED WITH A 1/4" THICK STAINLESS STEEL PLATE WITH A 3 1/2" DIAMETER BORING LOCATED SO THAT ITS BOTTOM MATCHES THE FLOWLINE OF THE RCP.
- THIS PROPERTY IS NOT LOCATED IN A FEMA FLOODPLAIN PER FIRM NO. 35001C0327.
- THERE ARE NO SIGNIFICANT OFFSITE FLOWS ENTERING THIS SITE. EXISTING MINOR OFF-SITE FLOWS FROM THE SOUTH WILL BE ROUTED THROUGH THE SITE.
- PROPERTY OWNER IS RESPONSIBLE FOR MAINTAINING DRAINAGE IMPROVEMENTS ON THE PROPERTY SO THAT THEY CONTINUE TO FUNCTION PROPERLY YEAR AFTER YEAR.
- ELEVATIONS SHOWN HEREON ARE INTENDED TO BE FINAL GRADES. OWNER, ROUGH GRADING CONTRACTOR AND LANDSCAPE CONTRACTOR ARE RESPONSIBLE FOR ASSURING THAT AFTER ALL WORK IS COMPLETE, SITE'S FINAL SURFACE GRADES ARE AS SHOWN HEREON.
- EARTHWORK CONTRACTOR IS RESPONSIBLE FOR OBTAINING AND FOLLOWING REQUIREMENTS OF THE SURFACE DISTURBANCE PERMIT FROM THE CITY ENVIRONMENTAL HEALTH DEPARTMENT.
- OWNER AND ALL ASSOCIATED CONTRACTORS WHO ENGAGE IN ALTERATION OF SITE SURFACES, SHALL FILE A NOTICE OF INTENT WITH EPA AND FOLLOW STORM WATER POLLUTION PREVENTION PLAN REQUIREMENTS.
- EXCEPT ALONG COORS BOULEVARD (CITY WO LATER), ALL NEW DRIVEWAYS SHALL BE CONSTRUCTED IN ACCORDANCE WITH CITY STANDARD DETAILS.


LEGEND

- 5100 — EXISTING CONTOUR (MAJOR)
- 5102 — EXISTING CONTOUR (MINOR)
- — — BOUNDARY LINE
- — — EASEMENT
- TC — 70.90 — PROPOSED GRADE
- FL — 70.40 — PROPOSED SPOT ELEVATION
- X 70.28 — EXISTING GRADE
- * 5265.16 — EXISTING GRADE
- — — EXISTING POWER LINES
- — — PROPOSED EXTENDED STEM WALL
- TRW=38.00 — TOP OF RETAINING WALL
- TF=32.00 — TOP OF FOOTING
- TSW=34.00 — TOP OF EXTENDED STEM WALL
- TF=32.00 — TOP OF FOOTING

GRAPHIC SCALE

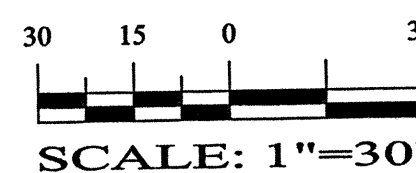

SHAHAB BIAZAR
P.E. #13479

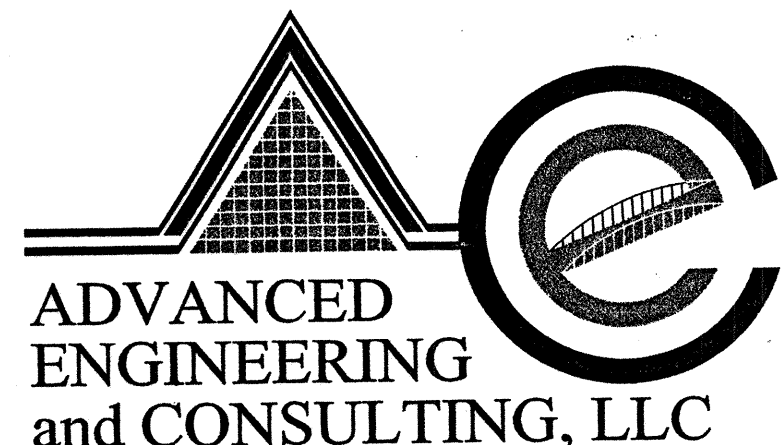


ADVANCED
ENGINEERING
and CONSULTING, LLC

4416 ANAHEIM AVE., NE
ALBUQUERQUE, NEW MEXICO 87113
(505)899-5570

REDLANDS SHOPPING CENTER OVERALL GRADING AND DRAINAGE PLAN

DRAWING:	DRAWN BY:	DATE:	SHEET #
200426-GR-OV.DWG	SBB	04-28-2004	


SCANNED BY PLW

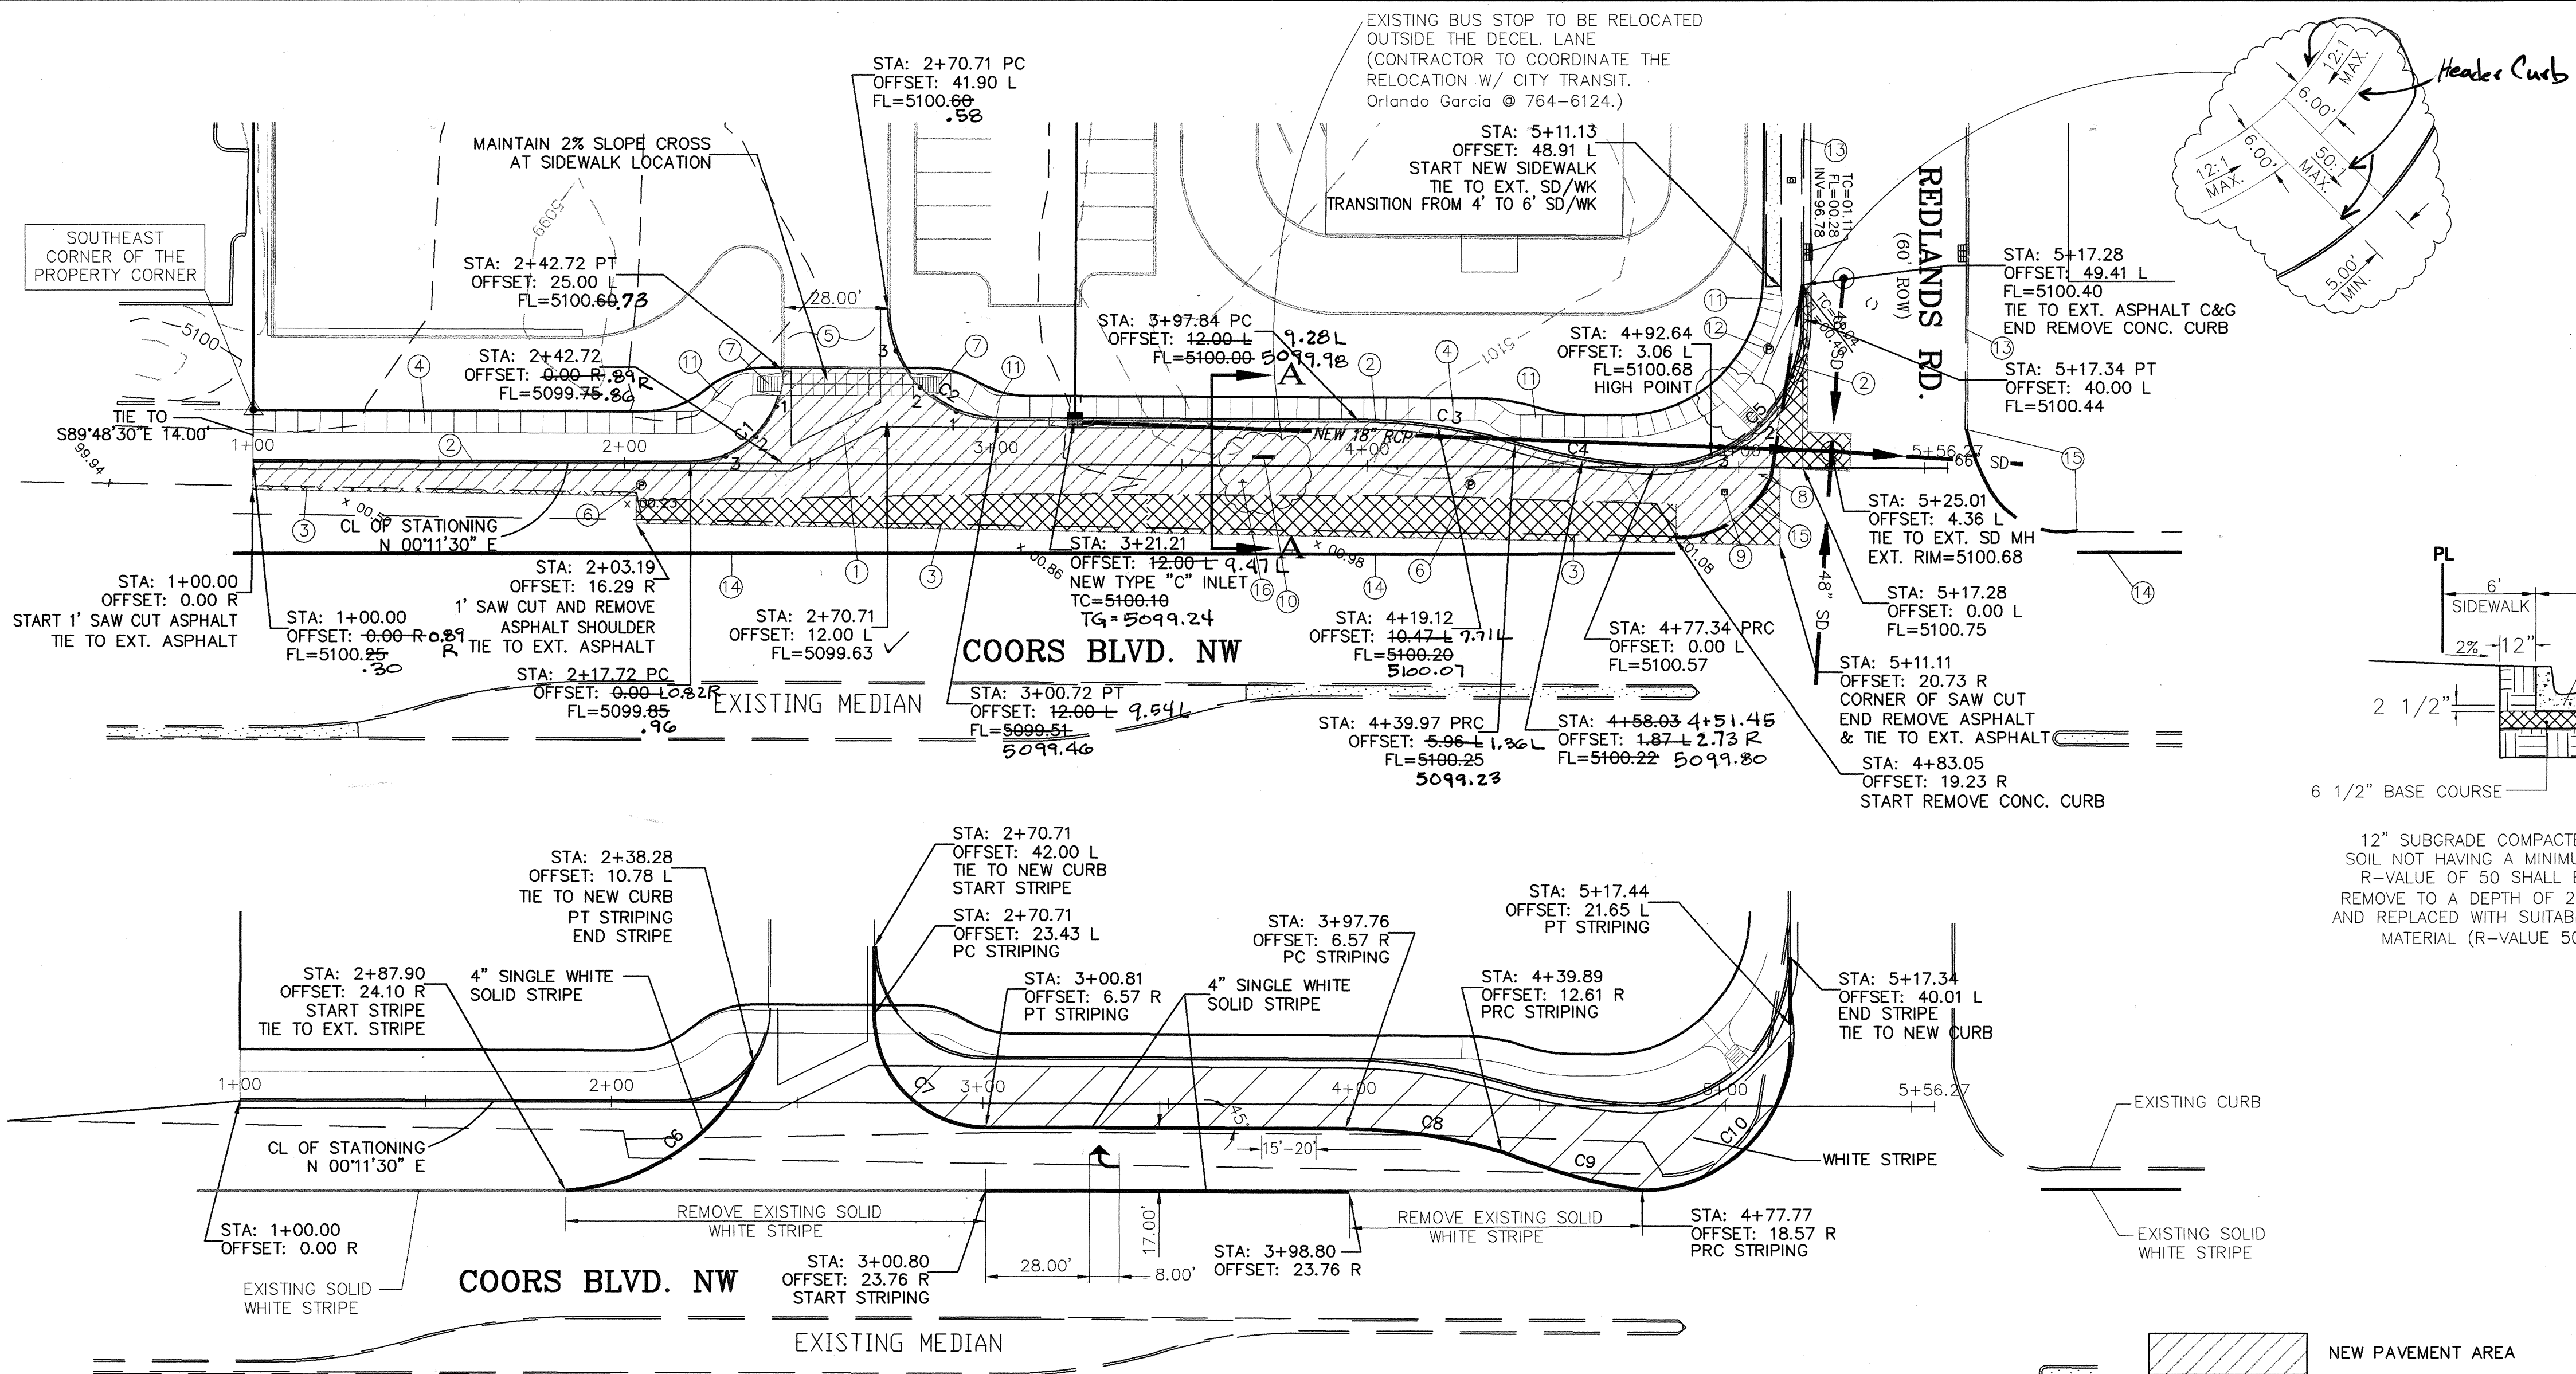

CURVE TABLE FOR STRIPING						
CURVE	LENGTH	RADIUS	TANGENT	DELTA	CHORD	CHORD DIRECTION
C6	64.33	60.00	35.65	61°25'51"	61.29	N55°30'22"E
C7	47.12	30.00	30.00	89°59'49"	42.43	S44°48'35"W
C8	42.70	150.00	21.50	16°18'43"	42.56	N81°39'09"W
C9	39.38	150.00	19.80	15°02'33"	39.27	S74°31'30"E
C10	62.75	40.00	39.91	89°52'33"	56.51	N44°48'59"E

CURVE TABLE FOR PROPOSED CURB						
CURVE	LENGTH	RADIUS	TANGENT	DELTA	CHORD	CHORD DIRECTION
C1	39.27	25.00	25.00	90°00'11"	35.36	N44°48'35"W
C2	47.13	30.00	30.00	90°00'34"	42.43	N45°11'18"E
C3	42.70	150.00	21.50	16°18'43"	42.56	N08°20'51"E
C4	37.94	150.00	19.07	14°29'25"	37.83	N09°15'30"E
C5	62.84	40.00	40.01	90°00'51"	56.58	N44°48'55"W

QUARTER POINTS					
STATION	FL	ELEV.	STATION	FL	ELEV.
1	5100.47	5100.47	1	5099.56	5100.52
2	5099.99	5100.48	2	5099.84	5100.60
3	5099.80	5100.24	3	5100.11	5100.68

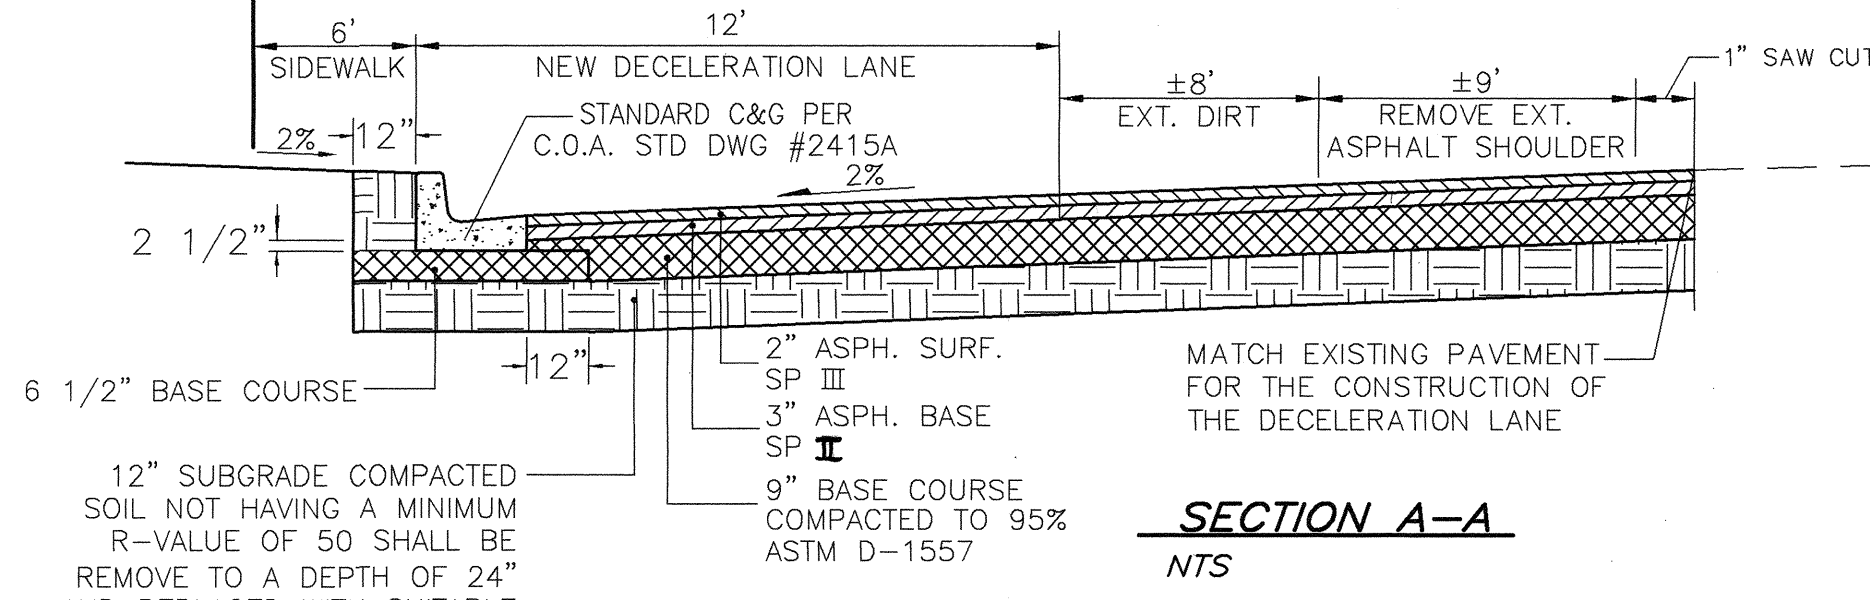


- NOTES:
- NEW 6" VALLEY GUTTER PER COA STANDARD DRAWING #2420.
 - STANDARD CURB AND GUTTER PER COA STD. DWG. #2415A.
 - EDGE OF EXISTING ASPHALT.
 - NEW 6" SIDEWALK PER COA STD. DWG. #2430.
 - NEW DRIVE WAY ENTRANCE PER COA STD. DWG. #2426.
 - EXISTING LIGHT POLE TO BE REMOVED AND RELOCATED BEHIND THE SD/WK (CONTRACTOR TO COORDINATE W/ PNM).
 - NEW UNIDIRECTIONAL WHEELCHAIR RAMP PER COA STD. DWG. #2426.
 - EXISTING STOP SIGN TO BE RELOCATED (CONTRACTOR TO COORDINATE W/ CITY OF ALBUQUERQUE @ 857-8683).
 - EXISTING ELECTRIC BOX TO BE REMOVED AND RELOCATED (CONTRACTOR TO COORDINATE W/ PNM).
 - EXISTING BENCH TO BE RELOCATED (CONTRACTOR TO COORDINATE W/ TRANSIT DEPT. Orlando Garcia @ 764-6124).
 - SIDEWALK TRANSITION PER COA STD. DWG. #2432.
 - EXISTING LIGHT POLE, SIDEWALK OBSTRUCTION PER COA STD. DWG. #2431.
 - EXISTING ASPHALT CURB.
 - EXISTING SINGLE WHITE SOLID STRIPE.
 - EXISTING CONCRETE CURB.
 - EXISTING BUS STOP SIGN TO BE RELOCATED BY THE CITY (CONTRACTOR TO COORDINATE W/ TRANSIT DEPT. Orlando Garcia @ 764-6124).

NOTE:
-ALL STATIONING IS CENTERLINE STATIONING.
-ALL THE CITY TRAFFIC INTERCONNECTS ARE LOCATED ON THE EAST SIDE OF COORS BLVD.

STRIPING PLAN FOR COORS BLVD. NW
-STRIPING ERADICATION SHALL BE ACCOMPLISHED BY WATER BLASTING OR SURFACE PLANING OF THE ROADWAY TO A MAXIMUM DEPTH OF 25 INCHES (MAXIMUM) AND FOR A WIDTH EQUAL TO TWO TIMES THE WIDTH OF THE STRIPE OR MARKING TO BE REMOVED.

COORS BLVD. NW
STA: 0+00.00 TO 5+50.00

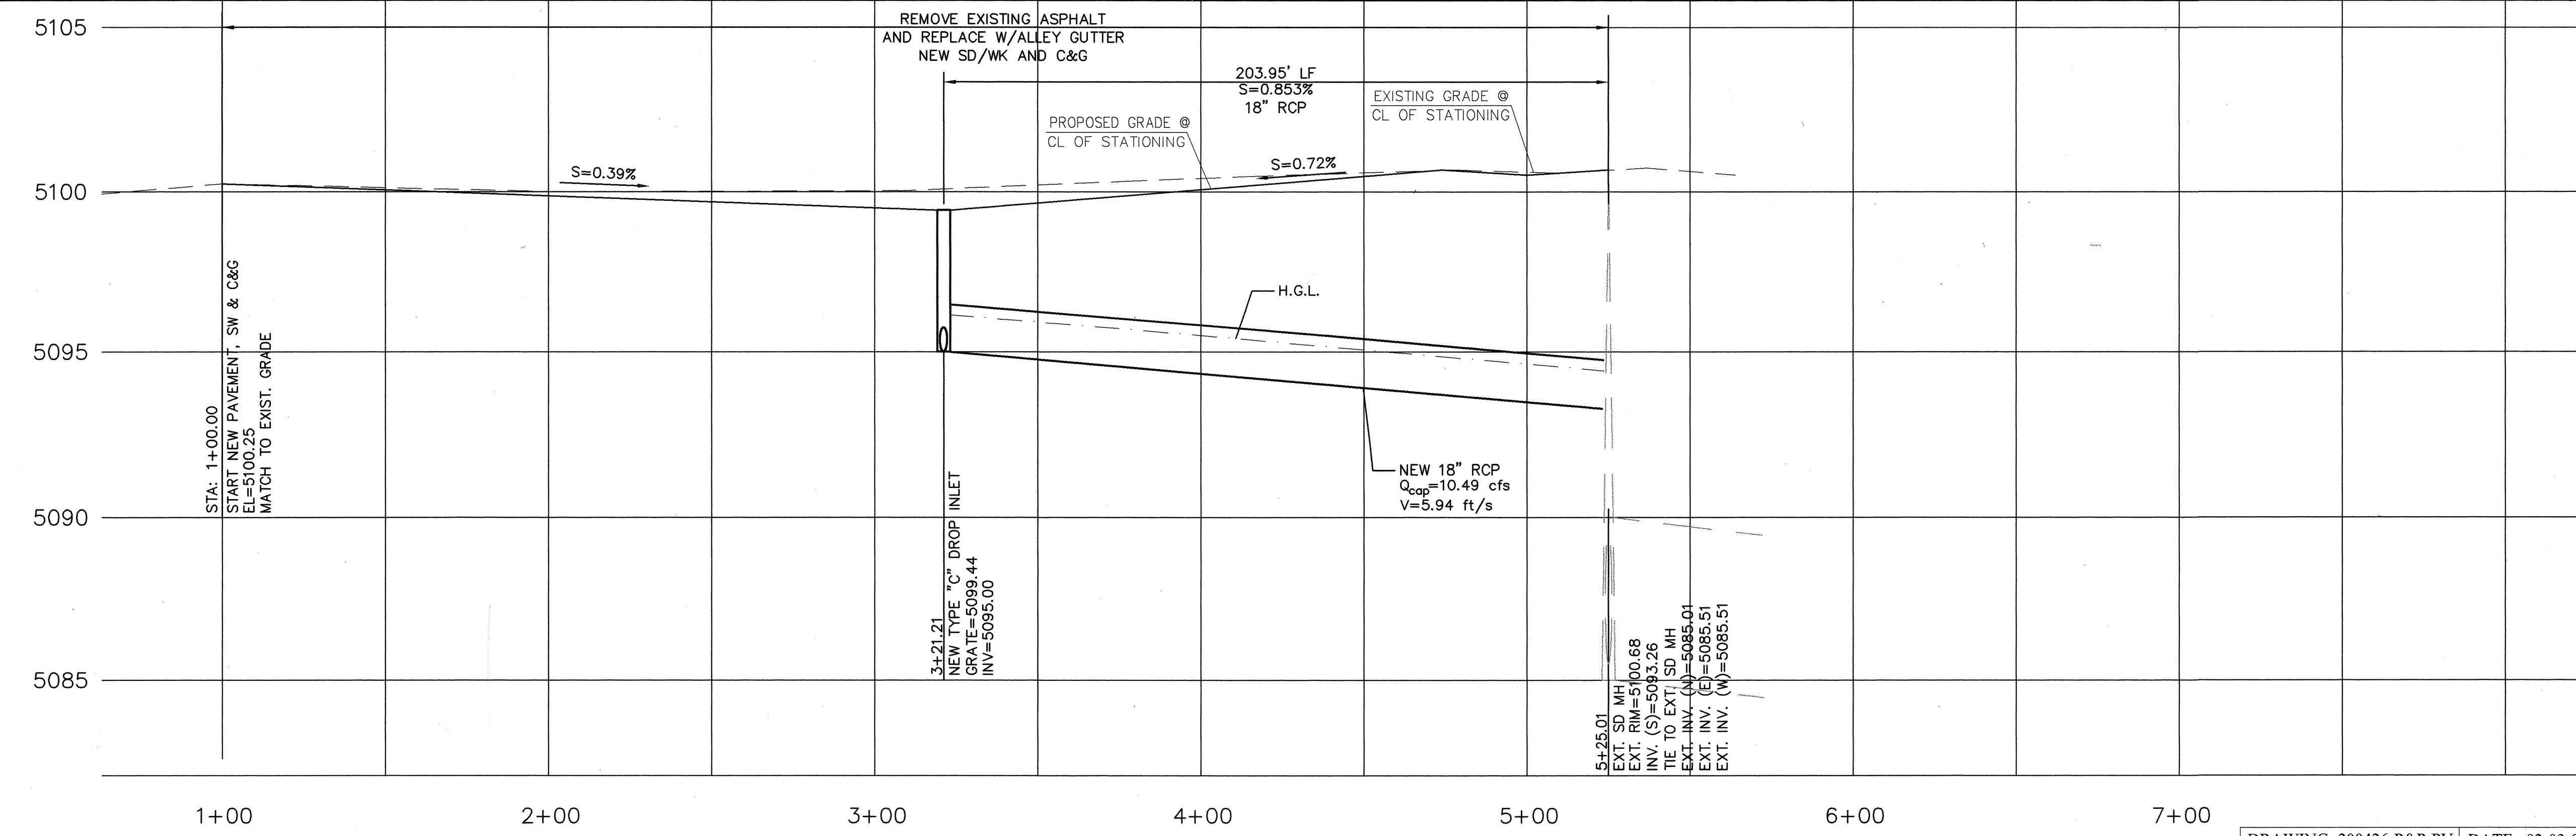

ADVANCED ENGINEERING and CONSULTING, LLC
4416 ANAHEIM AVE., NE
ALBUQUERQUE, NEW MEXICO 87113
(505)899-5570

CITY OF ALBUQUERQUE PUBLIC WORKS DEPARTMENT ENGINEERING GROUP	
TITLE: COORS BOULEVARD PAVING & STORM SEWER IMPROVEMENTS	
DESIGN REVIEW COMMITTEE APPROVE MAR - 1 2005	CITY ENGINEER APPROVAL APPROVE JULY 13 2005
DESIGNED BY: SB	DRAWN BY: SHH
CHECKED BY: SB	DATE: 12-04
CITY PROJECT NO. 723581	
ZONE MAP NO. G-11-Z	
SHEET 4 OF 4	

AS BUILT INFORMATION		BENCH MARKS		SURVEY INFORMATION		ENGINEER'S SEAL	
CONTRACTOR: Gold Martin		IN A TRAFFIC ISLAND IN THE SE QUARTER OF COORS & QUAL		DATE: 02-03-05		BY: [Signature]	
INSPECTOR: [Signature]		CENTRAL STATION DATA-NAD 1927		NO.:		REMARKS: [Signature]	
FIELD ENGINEER: [Signature]		NM STATE PLANE COORDINATES		DATE: 12-04		DESIGNED BY: SB	
VERIFICATION BY: [Signature]		X=365,168.46		DATE: 12-04		DRAWN BY: SHH	
CORRECTED BY: [Signature]		Y=1,497,456.42-NAD 1927		DATE: 12-04		CHECKED BY: SB	
MICRO-FILM INFORMATION		G-G=0.9997688					
		Do = -0°15'34"					
		ELEV=5102.169-SLD 1929					