

CONSTRUCTION PLANS FOR

CORLEY'S ALBUQUERQUE NEW
LINCOLN MERCURY VOLVO DEALERSHIP
ALBUQUERQUE, NEW MEXICO

INDEX

SHEET NO.	SHEET TITLE
1	TITLE SHEET
2	SURVEY PLAT
3	GRADING PLAN – EAST HALF
4	GRADING PLAN – WEST HALF
5	OVERALL UTILITY AND PAVING PLAN
6	WATER AND STORMDRAIN, EAGLE ROCK AVENUE NE
7	STORMDRAIN, PAN AMERICAN FRONTAGE ROAD NE
8	PAVING PLAN AND PROFILE, EAGLE ROCK AVENUE NE
9	PAVING PLAN AND PROFILE, EAGLE ROCK AVENUE NE
10	PAVING PLAN AND PROFILE, PAN AMERICAN FRONTAGE ROAD NE
11	WATER DETAILS AND ROAD CROSS SECTIONS
12	BOX STRUCTURE ON PAN AMERICAN FRONTAGE ROAD NE
13	NMDOT CONSTRUCTION NOTES – PAN AMERICAN FRONTAGE ROAD NE
14	NMDOT CONSTRUCTION NOTES – PAN AMERICAN FRONTAGE ROAD NE
15	TRAFFIC CONTROL AND BARRICADING – PAN AMERICAN FRONTAGE ROAD NE

CAUTION:
NOTE THAT ALL EXISTING UTILITIES MAY NOT BE
SHOWN. ALL EXISTING SERVICE CONNECTIONS ARE
NOT SHOWN. ANY EXISTING UTILITIES THAT ARE
SHOWN ARE APPROXIMATE LOCATION ONLY. IT
SHALL BE THE SOLE RESPONSIBILITY OF THE
CONTRACTOR TO CONTACT ALL THE UTILITY OWNERS
AND TO CONDUCT ALL NECESSARY FIELD
INVESTIGATIONS PRIOR TO ANY EXCAVATIONS TO
DETERMINE THE ACTUAL LOCATION OF UTILITIES
AND OTHER IMPROVEMENTS.

THE FOLLOWING NOTES ALSO APPLY WHEN CHECKED

- X ALL UTILITIES AND UTILITY SERVICE LINES SHALL BE INSTALLED PRIOR TO PAVING.
- X BACKFILL COMPACTION SHALL BE ACCORDING TO SPECIFIED STREET USE.
- X TACK COAT REQUIREMENTS SHALL BE DETERMINED BY THE ENGINEER.
- SIDEWALK AND WHEELCHAIR RAMPS WITHIN THE CURB RETURNS SHALL BE CONSTRUCTED WHEREVER A NEW CURB RETURN IS CONSTRUCTED
- IF CURB IS DEPRESSED FOR A DRIVEPAD, THE DRIVEPAD SHALL BE CONSTRUCTED PRIOR TO ACCEPTANCE OF CURB AND GUTTER.
- X ALL STORM DRAINAGE FACILITIES SHALL BE COMPLETED PRIOR TO FINAL ACCEPTANCE.
- THE REQUESTOR OR DEVELOPER SHALL BE RESPONSIBLE FOR REPAIR OR REPLACEMENT OF ALL CURB AND GUTTER OR SIDEWALK DAMAGE AFTER APPROVAL BY THE CITY ENGINEER OR WORK COMPLETED BY THE CONTRACTOR.

RECORD DRAWINGS


I, Gilbert Aldaz of the firm of Applied Engineering & Surveying, Inc., a Registered Professional Engineer in the State of New Mexico, do hereby certify, to the best of my knowledge and belief, that the infrastructure installed as part of this project has been inspected by me or by a qualified person under my direct supervision and has been constructed in accordance with the plans and specifications approved by the City Engineer, that the original design intent of the approved plans has been met, except as noted by me on the as-built construction drawings. This certification is based on site inspections by me or personnel under my direction.



THE SUBJECT PROPERTY IS LOCATED NEAR A FORMER LANDFILL. DUE TO THE SUBJECT PROPERTY BEING NEAR A FORMER LANDFILL CERTAIN PRECAUTIONARY MEASURES MAY NEED TO BE TAKEN TO ENSURE THE HEALTH AND SAFETY OF THE PUBLIC. RECOMMENDATIONS MADE BY A PROFESSIONAL ENGINEER WITH EXPERTISE IN LANDFILLS AND LANDFILL GAS ISSUES (AS REQUIRED BY THE MOST CURRENT VERSION OF THE INTERIM GUIDELINES FOR DEVELOPMENT WITHIN CITY DESIGNATED LANDFILL BUFFER ZONES) SHALL BE CONSULTED PRIOR TO DEVELOPMENT OF THE SITE.

Anganne Busch
CITY OF ALBUQUERQUE ENVIRONMENTAL HEALTH DEPT.

DRB - 1006505

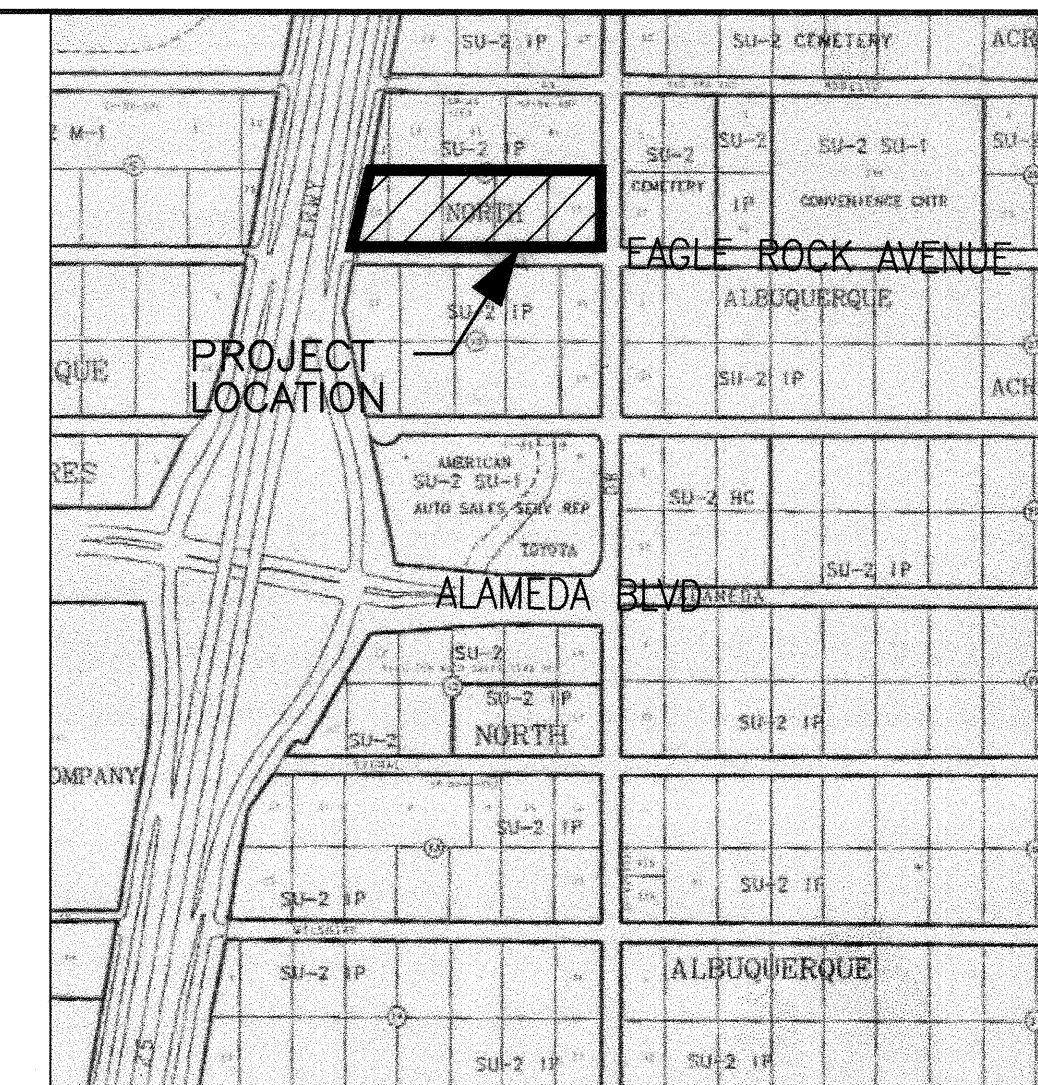

VICINITY MAP (C-18)




GENERAL NOTES
NOTICE TO CONTRACTORS

1. ALL WORK DETAILED ON THESE PLANS TO BE PERFORMED UNDER CONTRACT SHALL, EXCEPT AS OTHERWISE STATED OR PROVIDED FOR HEREON, BE CONSTRUCTED IN ACCORDANCE WITH THE CITY OF ALBUQUERQUE STANDARD SPECIFICATIONS FOR PUBLIC WORKS CONSTRUCTION, 1986 EDITION AS REVISED THROUGH UPDATE #7, INCLUDING AMENDMENT No. 1.
2. TWO WORKING DAYS PRIOR TO ANY EXCAVATION, CONTRACTOR MUST CONTACT NEW MEXICO ONE CALL SYSTEM (260-1990) AND DETERMINE LOCATION OF EXISTING UTILITIES.
3. PRIOR TO ANY CONSTRUCTION, THE CONTRACTOR SHALL EXCAVATE AND VERIFY THE HORIZONTAL AND VERTICAL LOCATIONS OF ALL OBSTRUCTION. SHOULD A CONFLICT EXIST, THE CONTRACTOR SHALL NOTIFY THE ENGINEER OR THE SURVEYOR SO THAT THE CONFLICT CAN BE RESOLVED WITHOUT DELAY.
4. ALL EXISTING SIGNS, MARKERS, DELINEATORS, ETC. WITHIN THE CONSTRUCTION LIMITS SHALL BE REMOVED, STORED AND RE-SET BY THE CONTRACTOR.
5. THE CONTRACTOR SHALL NOTIFY THE ENGINEER NOT LESS THAN SEVEN (7) DAYS PRIOR TO STARTING WORK IN ORDER THAT THE ENGINEER MAY TAKE NECESSARY MEASURES TO INSURE THE PRESERVATION OF SURVEY MONUMENTS. CONTRACTOR SHALL NOT DISTURB PERMANENT SURVEY MONUMENTS WITHOUT THE CONSENT OF THE ENGINEER AND SHALL NOTIFY THE ENGINEER AND BEAR THE EXPENSE OF REPLACING ANY THAT MAY BE DISTURBED WITHOUT PERMISSION. REPLACEMENT SHALL BE DONE ONLY BY THE CITY SURVEYOR. WHEN A CHANGE IS MADE IN THE FINISHED ELEVATIONS OF THE PAVEMENT OF ANY ROADWAY IN WHICH A PERMANENT SURVEY MONUMENT IS LOCATED, CONTRACTOR SHALL, AT HIS OWN EXPENSE, ADJUST THE MONUMENT COVER TO THE NEW GRADE UNLESS OTHERWISE SPECIFIED. REFER TO SECTION 4.4 OF THE GENERAL CONDITIONS OF THE STANDARD SPECIFICATIONS.
6. SEVEN (7) WORKING DAYS PRIOR TO BEGINNING CONSTRUCTION, THE CONTRACTOR SHALL SUBMIT TO CONSTRUCTION COORDINATION DIVISION A DETAILED CONSTRUCTION SCHEDULE. TWO (2) WORKING DAYS PRIOR TO THE START OF CONSTRUCTION, THE CONTRACTOR SHALL OBTAIN A BARRICADING PERMIT FROM THE CONSTRUCTION COORDINATION DIVISION; CONTRACTOR SHALL NOTIFY THE CONSTRUCTION COORDINATION ENGINEER (924-3400) PRIOR TO OCCUPYING AN INTERSECTION. REFER TO SECTION 19 OF THE GENERAL CONDITIONS OF THE STANDARD SPECIFICATIONS.
7. THE WATER AUTHORITY WILL BE NOTIFIED BY THE CONTRACTOR SEVEN (7) WORKING DAYS IN ADVANCE OF ANY WORK WHICH MAY AFFECT THE EXISTING PUBLIC WATER FACILITIES, CONTACT THE WATER AUTHORITY AT 857-8200.
8. ALL EXCAVATION, TRENCHING, AND SHORING ACTIVITIES MUST BE CARRIED-OUT IN ACCORDANCE WITH OSHA 29CFR 1926.650 SUBPART P.
9. CONTRACTOR WILL BE RESPONSIBLE FOR PROVIDING AND MAINTAINING ALL CONSTRUCTION SIGNING UNTIL PROJECT HAS BEEN ACCEPTED BY COA.
10. ADJUST ALL VALVE CANS AND MANHOLE RIM COVERS TO FINAL GRADE.
11. FOR ALL WORK WITHIN PAN AMERICAN FRONTAGE ROAD SEE ADDITIONAL GENERAL NOTES ON SHEET 10 FOR NMDOT REQUIREMENTS.
12. CONTRACTOR TO OBTAIN TRAFFIC CONTROL PERMIT FROM NMDOT FOR ANY WORK TO BE DONE IN NMDOT RIGHT-OF-WAY. PERMIT MAY BE OBTAINED BY CALLING 841-2700.

APPROVED AS RECORD DRAWINGS
DESIGN REVIEW SECTION
CITY CONSTRUCTION ENGINEER
Anthony Lopez
DATE: 05/23/09

APPLIED Engineering & Suveying, Inc.
1605 BLAIR DRIVE NE
ALBUQUERQUE, NEW MEXICO 87112
PHONE (505)237-1456

[illegible]

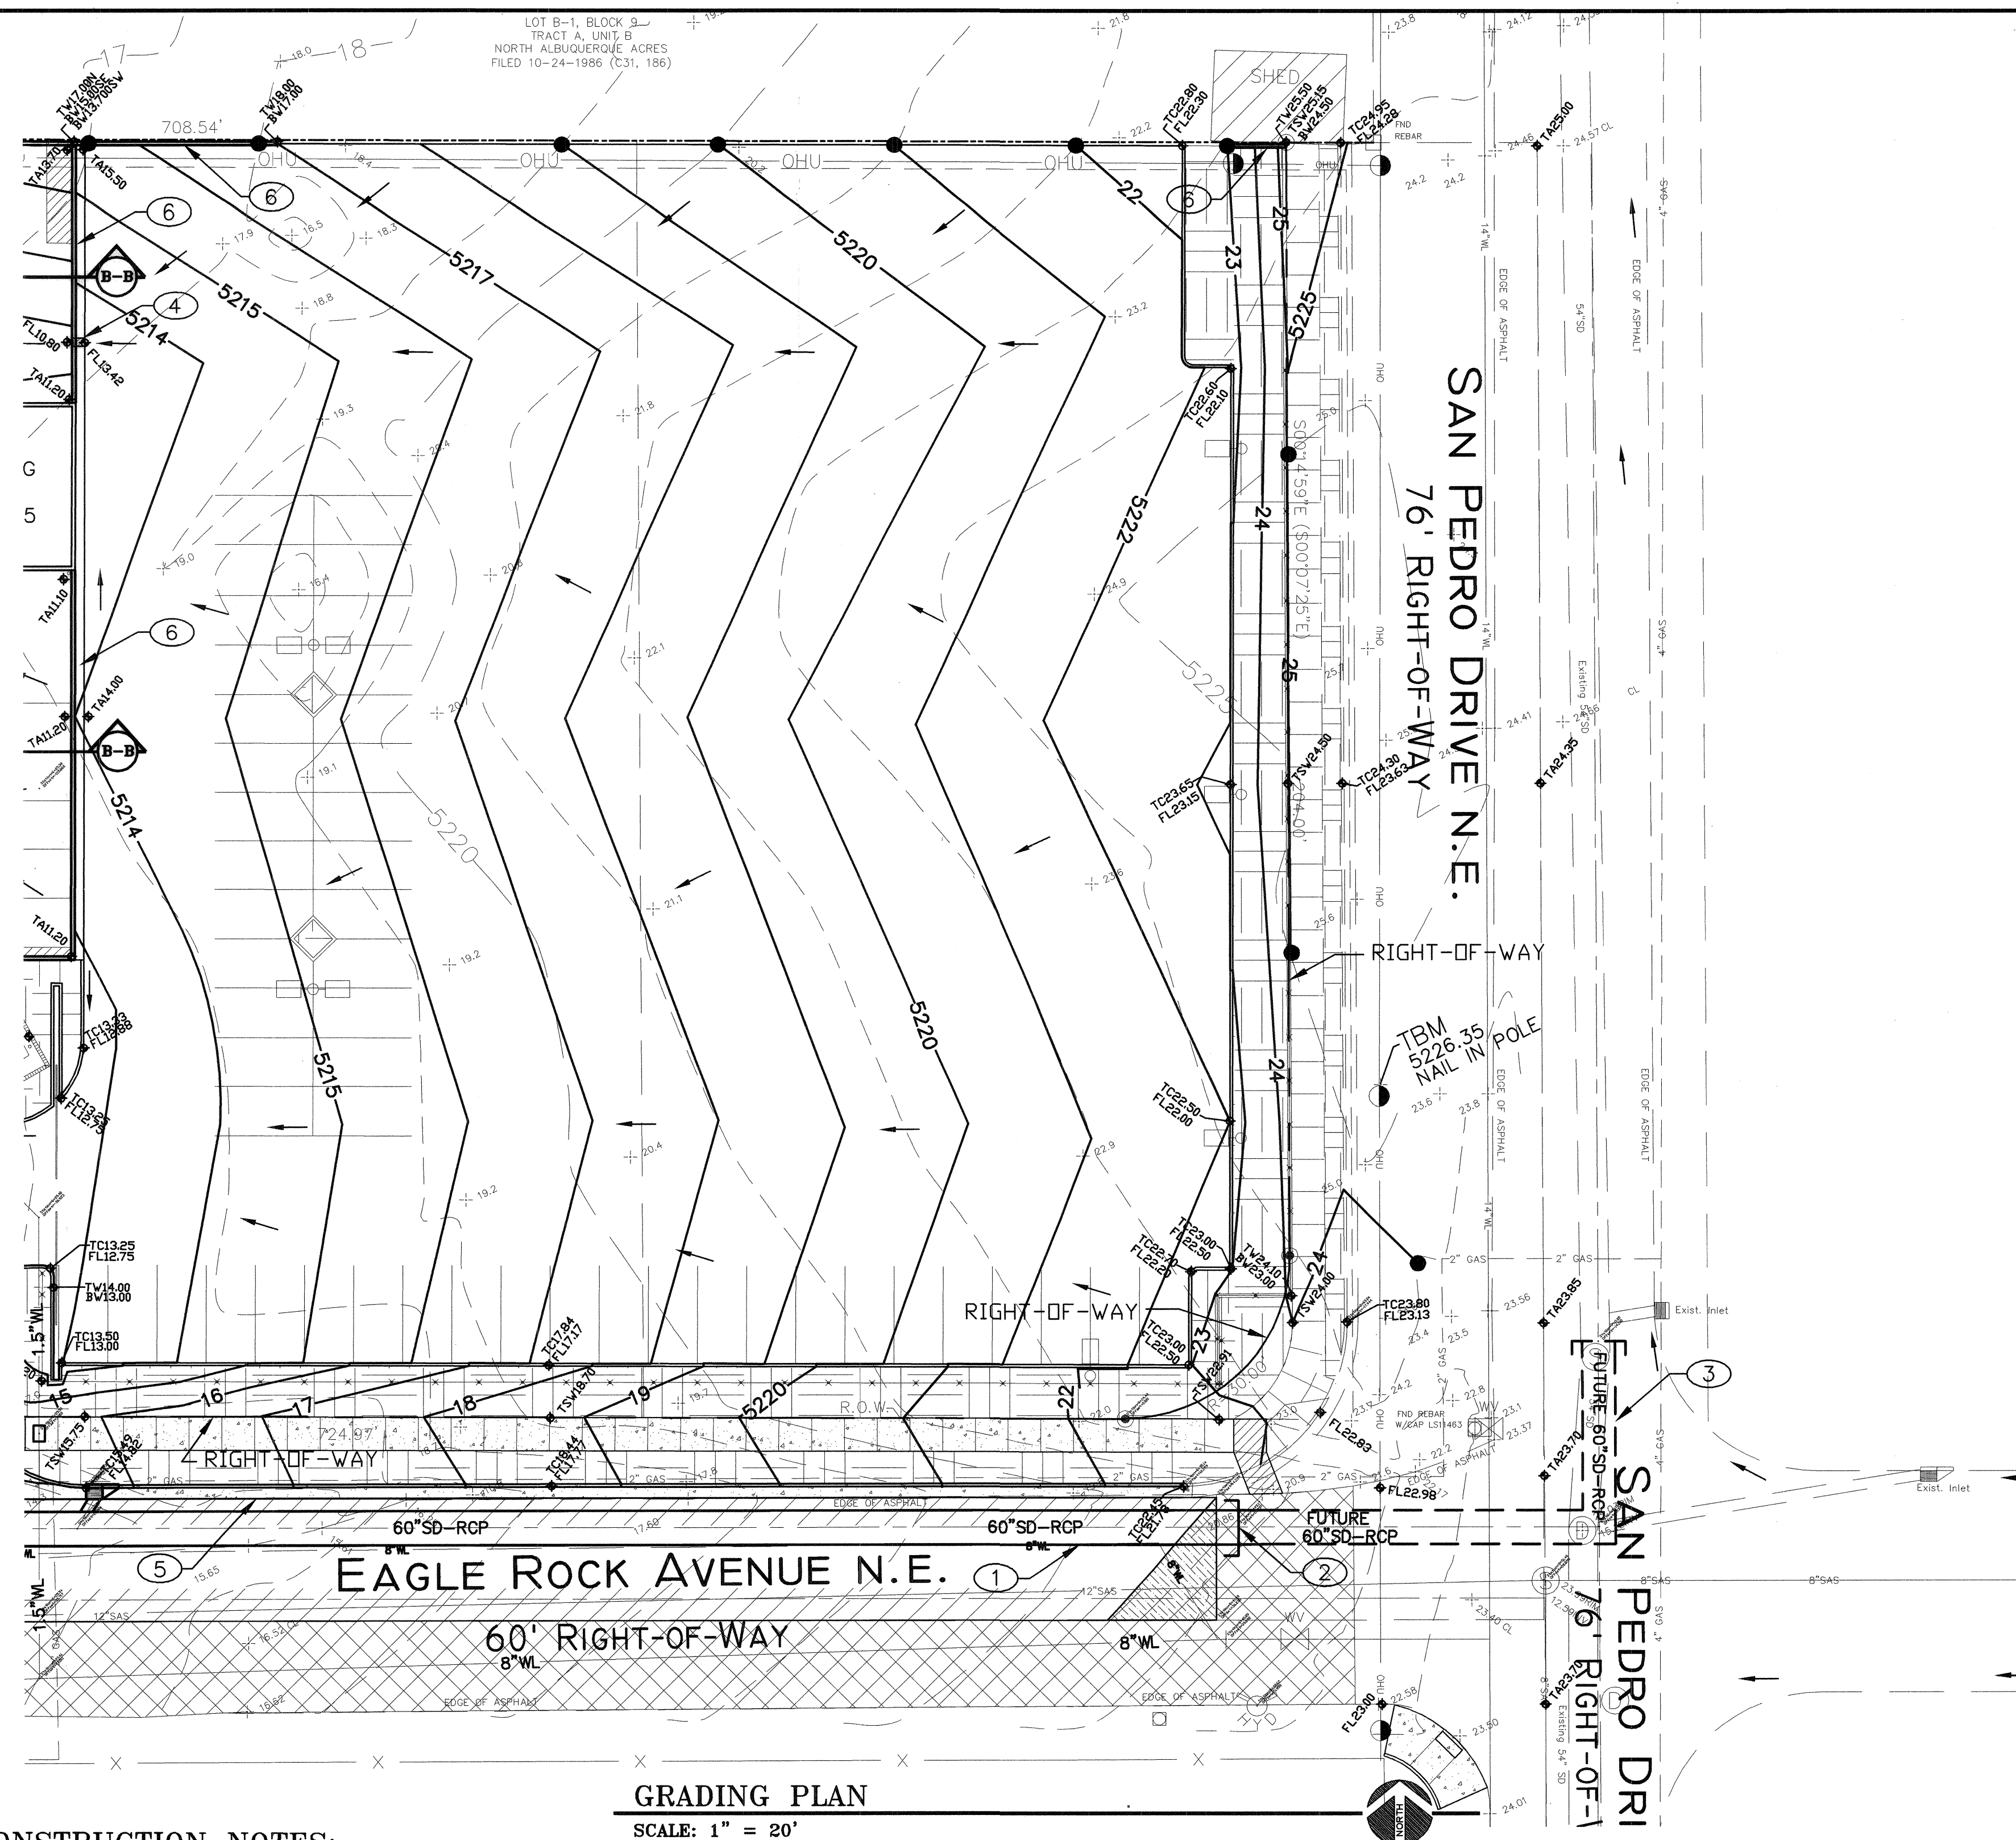

CONSTRUCTION NOTES:

- ① INSTALL APPROXIMATELY 270LF OF 60"RCP WITH THIS PROJECT.
- ② CAP 60" STORMDRAIN
- ③ FUTURE STORMDRAIN.
- ④ INSTALL 1.67' WIDE BY 8" DEEP OPENING IN RETAINING WALL.
- ⑤ INSTALL CITY STANDARD CURB AND GUTTER PER CITY STANDARD DRAWING 2415A.
- ⑥ INSTALL RETAINING WALL, HEIGHT VARIES, SEE SHEET 4 OF 5 FOR DETAILS.

NOTE: ALL WORK IN THE RIGHT OF WAY IS TO BE
BUILT UNDER A SEPARATE WORK ORDER.

EROSION CONTROL NOTES:

1. CONTRACTOR IS RESPONSIBLE FOR OBTAINING A TOPSOIL DISTURBANCE PERMIT PRIOR TO BEGINNING WORK.
2. CONTRACTOR IS RESPONSIBLE FOR MAINTAINING RUN-OFF ON SITE DURING CONSTRUCTION.
3. CONTRACTOR IS RESPONSIBLE FOR CLEANING ALL SEDIMENT THAT GETS INTO EXISTING RIGHT-OF-WAY.
4. ALL EXPOSED EARTH SURFACES MUST BE PROTECTED FROM WIND AND WATER EROSION PRIOR TO FINAL (CITY) ACCEPTANCE OF ANY PROJECT.
5. REPAIR OF DAMAGED FACILITIES AND CLEANUP OF SEDIMENT ACCUMULATIONS ON ADJACENT PROPERTIES AND IN PUBLIC FACILITIES IS THE RESPONSIBILITY OF THE CONTRACTOR.


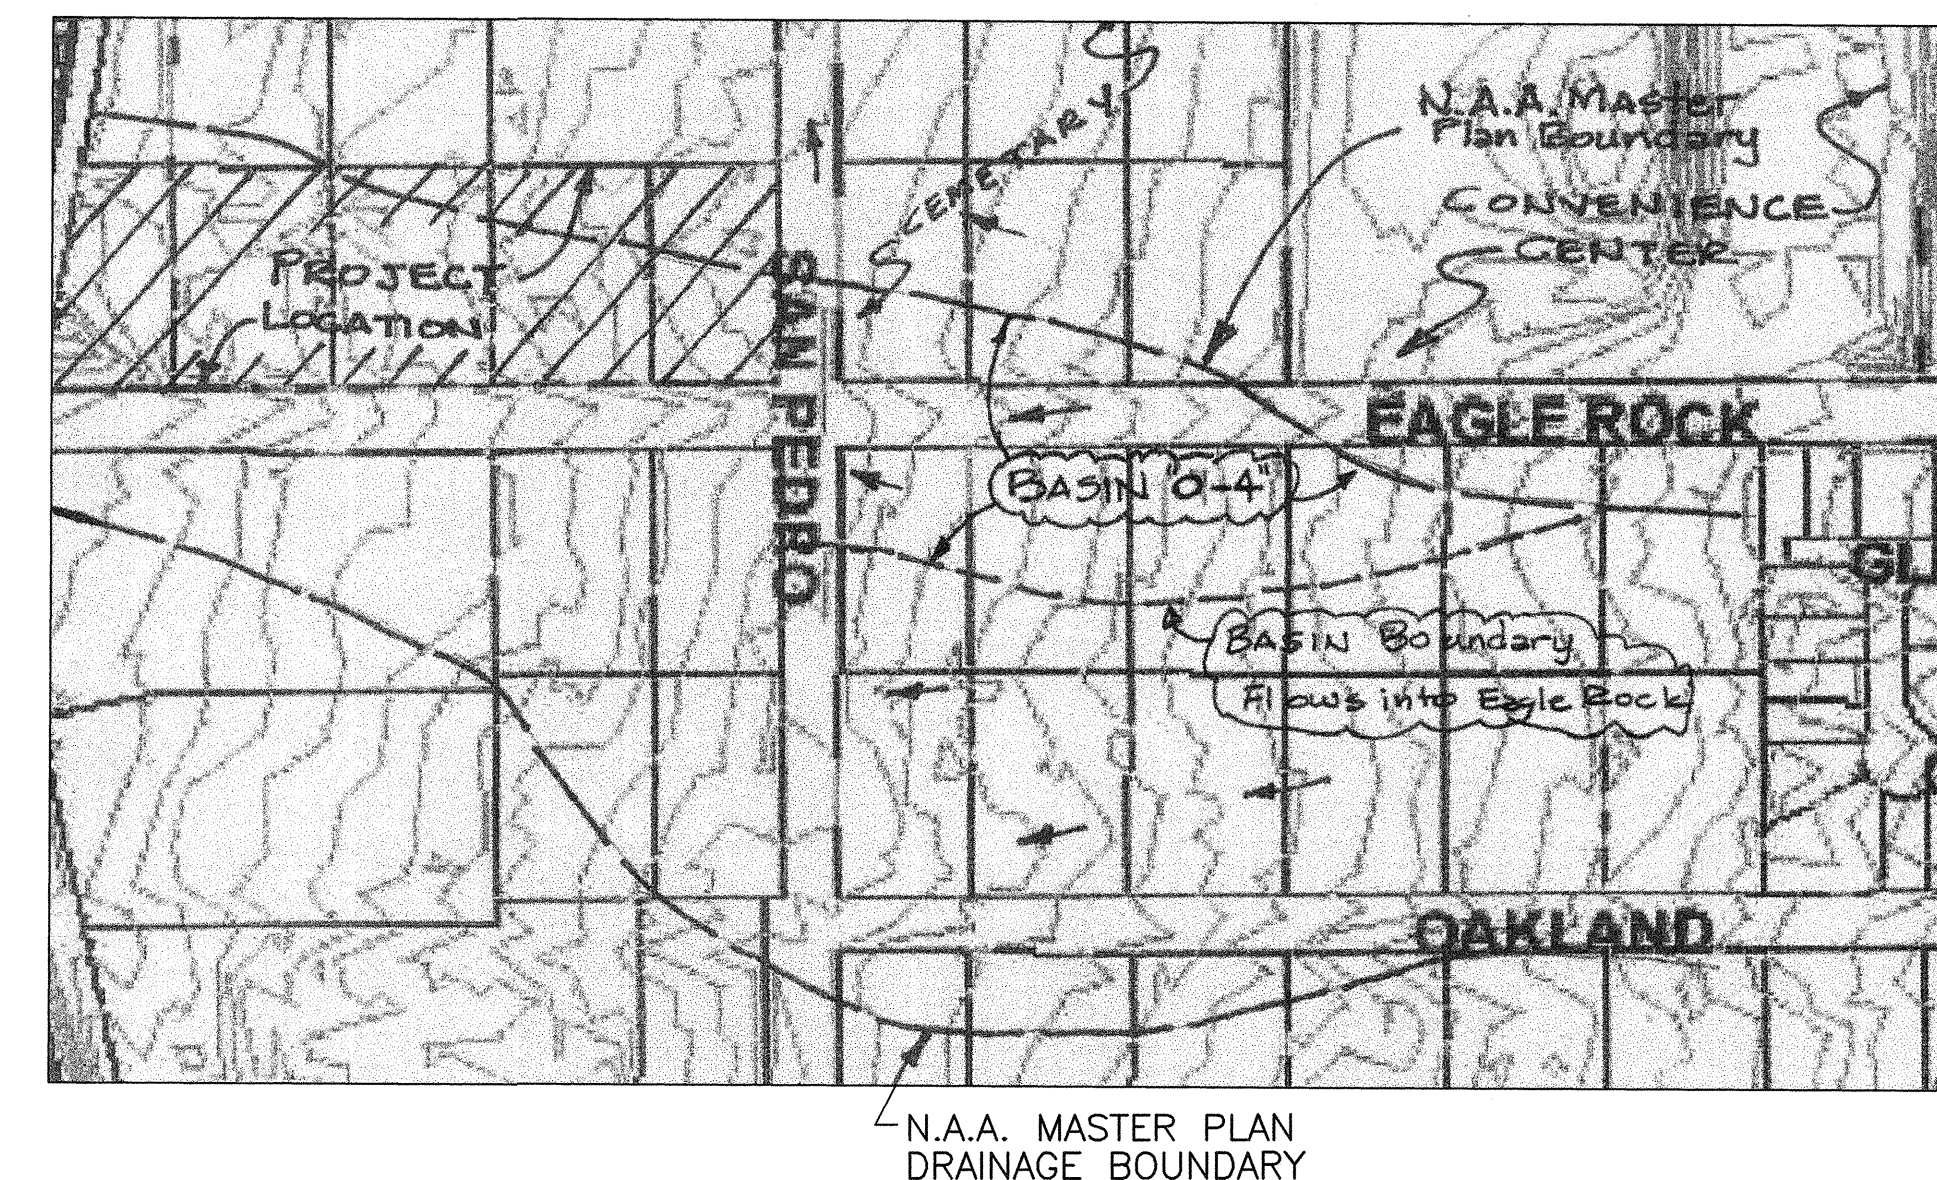


EXHIBIT "A" - BASIN 0-4

SCALE: 1"=200' - MAP BOUNDARY FOR FLOWS
EAST OF SAN PEDRO BLVD ON EAGLE ROCK AVE.

UTILITY PRECAUTIONS

THE CONTRACTOR SHALL INFORM ITSELF OF THE LOCATION OF ANY UTILITY LINE, PIPELINE, OR UNDERGROUND UTILITY LINE IN OR NEAR THE AREA OF THE WORK IN ADVANCE OF AND DURING EXCAVATION WORK. THE CONTRACTOR SHALL BE RESPONSIBLE FOR ANY DAMAGE AND DAMAGE CAUSED BY ITS FAILURE TO LOCATE, IDENTIFY AND PRESERVE ANY AND ALL EXISTING UTILITIES, PIPELINES, AND UNDERGROUND UTILITY LINES. IN PLANNING AND CONDUCTING EXCAVATION, THE CONTRACTOR SHALL COMPLY WITH STATE STATUTES, MUNICIPAL AND LOCAL ORDINANCES, RULES AND REGULATIONS, IF ANY, PERTAINING TO THE LOCATION OF THESE LINES AND FACILITIES.

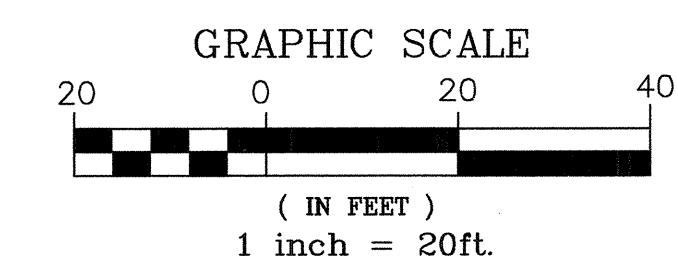

**APPLIED ENGINEERING AND
SURVEYING, INC.
ENGINEERS AND PLANNERS**

1505 Blvd Drive NE
Albuquerque, New Mexico 87112
Office (505) 237-1456
Fax (505) 237-1456


CITY OF ALBUQUERQUE
PUBLIC WORKS DEPARTMENT
ENGINEERING DEVELOPMENT GROUP

TITLE: GRADING PLAN - EAST HALF
CORLEY'S ALBUQUERQUE

Design Review Committee	City Engineer Approval	Last Design Update 	Ms./Day/Yr.	Ms./Day/Yr.
FOR INFORMATION ONLY				
City Project No.	Zone Map No.	Sheet	Of	
724582	C-18	3	15	

[illegible]

SCANNED BY
PLANNING

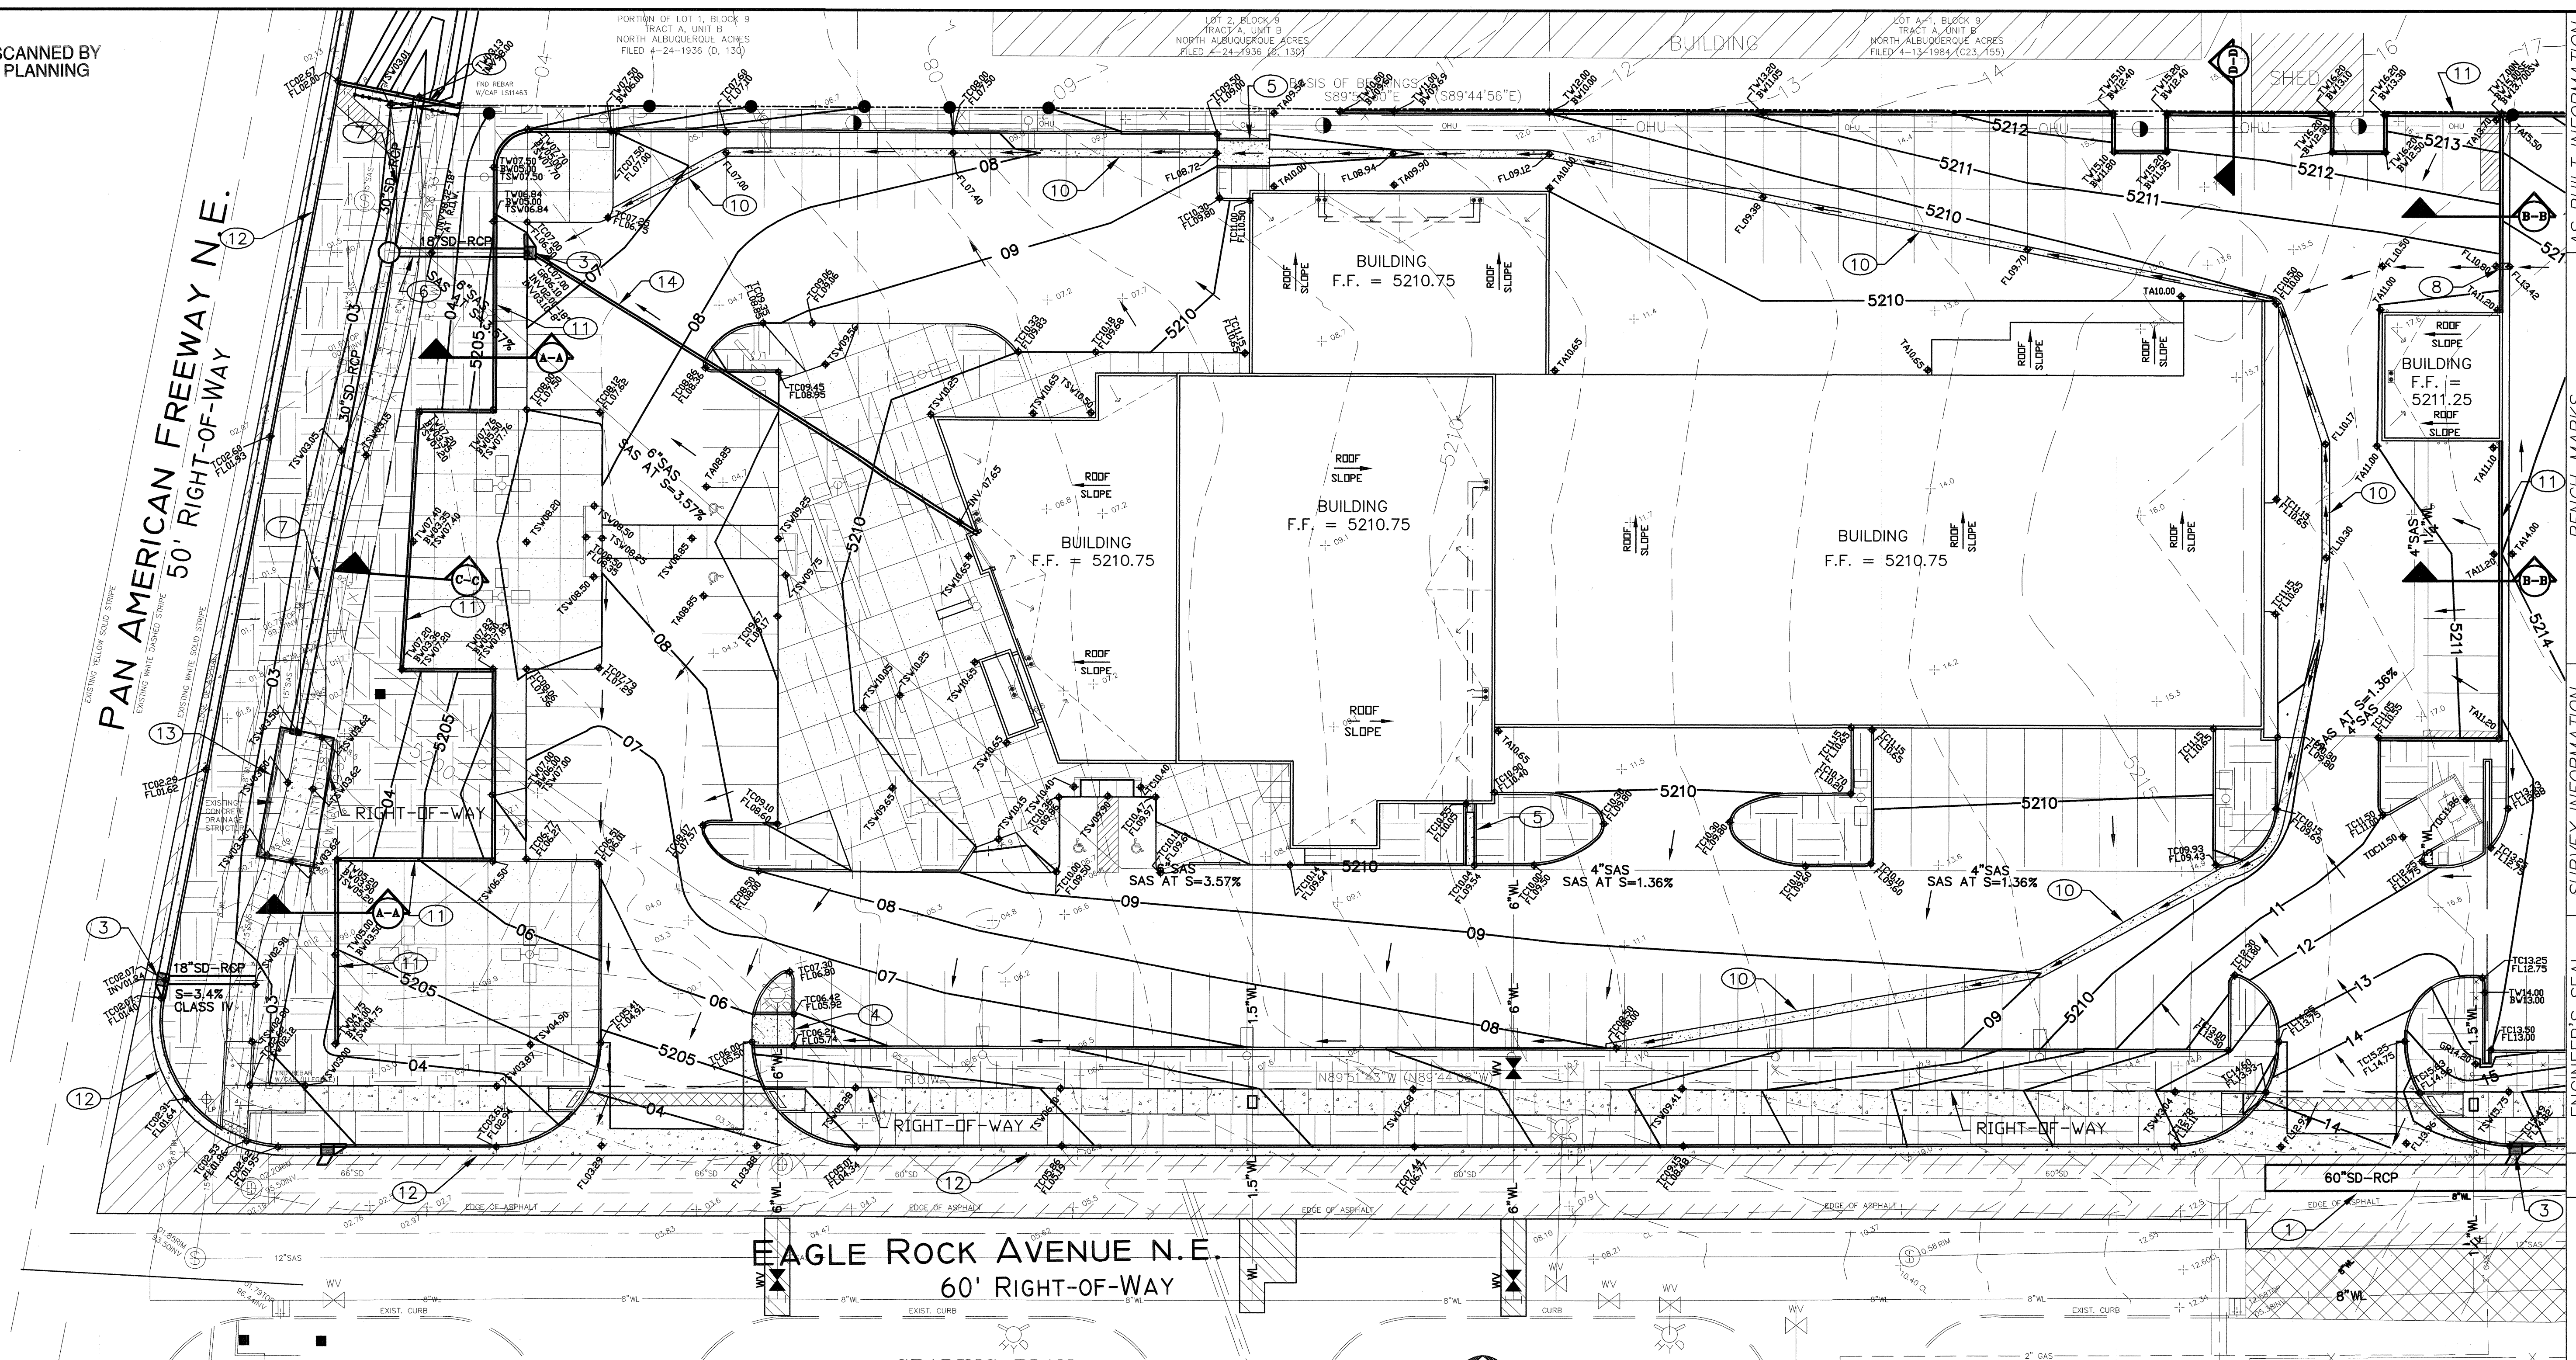

CONSTRUCTION NOTES:

- ① INSTALL APPROXIMATELY 270LF OF 60"RCP WITH THIS PROJECT.
- ② INSTALL 8" ROOF DRAIN PIPE AT 4% SLOPE, CONNECT FROM INLET INTO DOWNSPOUT ROOF LEADER, SEE MECHANICAL DRAWINGS FOR LOCATION OF TIE IN.
- ③ INSTALL STORM INLETS TYPE "A" PER CITY STANDARD DRAWING 2201.
- ④ INSTALL 7.5' WIDE BY 6" DEEP CONCRETE CHANNEL PER CITY STANDARD DRAWING 2260.
- ⑤ INSTALL 6.0' WIDE BY 6" DEEP CONCRETE CHANNEL PER CITY STANDARD DRAWING 2260.
- ⑥ INSTALL 30LF OF 18"RCP AT SLOPE = -16%
- ⑦ INSTALL 154LF OF 30"RCP
- ⑧ INSTALL 1.67' WIDE BY 8" DEEP OPENING IN RETAINING WALL.

GRADING PLAN


SCALE: 1" = 20'

- (9) INSTALL HEADWALL PER NMSHTD STANDARD DRAWING __
- (10) INSTALL 2' WIDE ALLEY GUTTER PER CITY STANDARD DRAWING 2415A.
- (11) INSTALL RETAINING WALL, HEIGHT VARIES, SEE SHEET 4 OF 5 FOR DETAILS.
- (12) INSTALL CITY STANDARD CURB AND GUTTER PER CITY STANDARD DRAWING 2415A.
- (13) INSTALL COVER ON EXISTING DRAINAGE STRUCTURE, SEE STRUCTURAL DRAWINGS FOR DETAILS.
- (14) INSTALL 8" STORM DRAIN AT 3.9% SLOPE 3' OF COVER, STORM DRAIN FROM 5' OF BUILDING EDGE AND CONNECT INTO EXISTING INLET.

NOTE: ALL WORK IN THE RIGHT OF WAY IS TO BE
BUILT UNDER A SEPARATE WORK ORDER.

UTILITY PRECAUTIONS

THE CONTRACTOR SHALL INFORM ITSELF OF THE LOCATION OF ANY UTILITY LINE, PIPELINE, OR UNDERGROUND UTILITY LINE IN OR NEAR THE AREA OF THE WORK IN ADVANCE OF AND DURING EXCAVATION. ONLY THE CONTRACTOR IS FULLY RESPONSIBLE FOR ANY AND ALL DAMAGE CAUSED BY ITS FAILURE TO LOCATE, IDENTIFY AND PRESERVE ANY AND ALL EXISTING UTILITIES. BEFORE ANY AND ALL EXCAVATION BEGINS, THE CONTRACTOR SHALL COMPLY WITH STATE STATUTES, MUNICIPAL AND LOCAL ORDINANCES, RULES AND REGULATIONS, TO ANY, PERTAINING TO THE LOCATION OF THESE LINES AND FACILITIES.

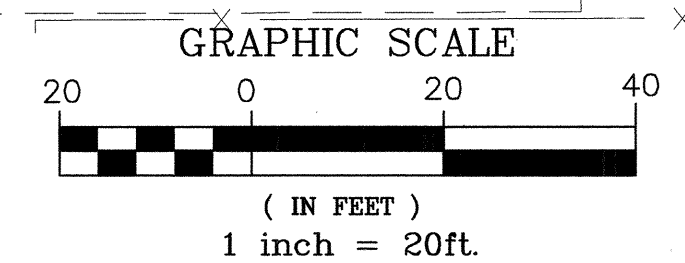

**APPLIED ENGINEERING AND
SURVEYING, INC.
ENGINEERS AND PLANNERS**

CITY OF ALBUQUERQUE
PUBLIC WORKS DEPARTMENT
ENGINEERING DEVELOPMENT GROUP

TITLE:	GRADING PLAN - WEST HALF CORLEY'S ALBUQUERQUE
--------	--

Design Review Committee	City Engineer Approval
-------------------------	------------------------

FOR INFORMATION ONLY

City Project No.

Zone Map No. _____


Sheet	Of
-------	----

Mo./Day/Yr.	Mo./Day/Yr.

[illegible]

SURVEY INFORMATION	BENCH MARKS	DATE
NO.	THE BASIS OF ELEVATIONS FOR THIS SURVEY IS AGS BENCHMARK 10-CH8, THE PUBLISHED ELEVATION OF WHICH IS 522P.09. NAVD88. BENCHMARK IS LOCATED ON THE EAST RIGHT-OF-WAY OF SAN PEDRO BLVD. NE. 48' SOUTH OF THE ENTERLINE OF MODESTO AVENUE NE AT ITS INTERSECTION WITH SAN PEDRO BLVD.	WORK ORDER NO. INSPECTOR'S ACCEPTANCE BY VERIFICATION BY CORRECTIONS MICRO-FILM INFORMATION
		DATE/06 DATE/06 DATE/06 DATE/06 DATE/06 DATE/06
		COPY TO CONTRACTING WORK ORDER BY TARA LEWIS-SUNNY W APPLIED ENGR APPLIED ENGR APPLIED ENGR APPLIED ENGR APPLIED ENGR
		NO. RECORDED BY DATE

THE BASIS OF ELEVATIONS FOR THIS SURVEY IS ACS BENCHMARK 40-C10; THE PUBLISHED ELEVATION OF WHICH IS 5222.09, NAVD88. BENCHMARK IS LOCATED ON THE EAST RIGHT-OF-WAY OF SAN PEDRO BLVD. NE. 48' SOUTH OF THE ENTERLINE OF MODESTO AVENUE NE AT ITS INTERSECTION WITH SAN PEDRO BLVD).	DENVER MAPS AS BUILT INFORMATION WORKED BY <i>Teresa Lemo-Serna</i> DATE <i>06/08</i> INSPECTORS ADJUSTMENTS BY <i>Applied Engr.</i> DATE <i>06/08</i> VERIFICATION BY <i>Applied Engr.</i> DATE <i>06/08</i> CORRECTED BY <i>Applied Engr.</i> DATE <i>06/08</i> MICRO-FILM INFORMATION RECORDED BY NO. DATE
--	--

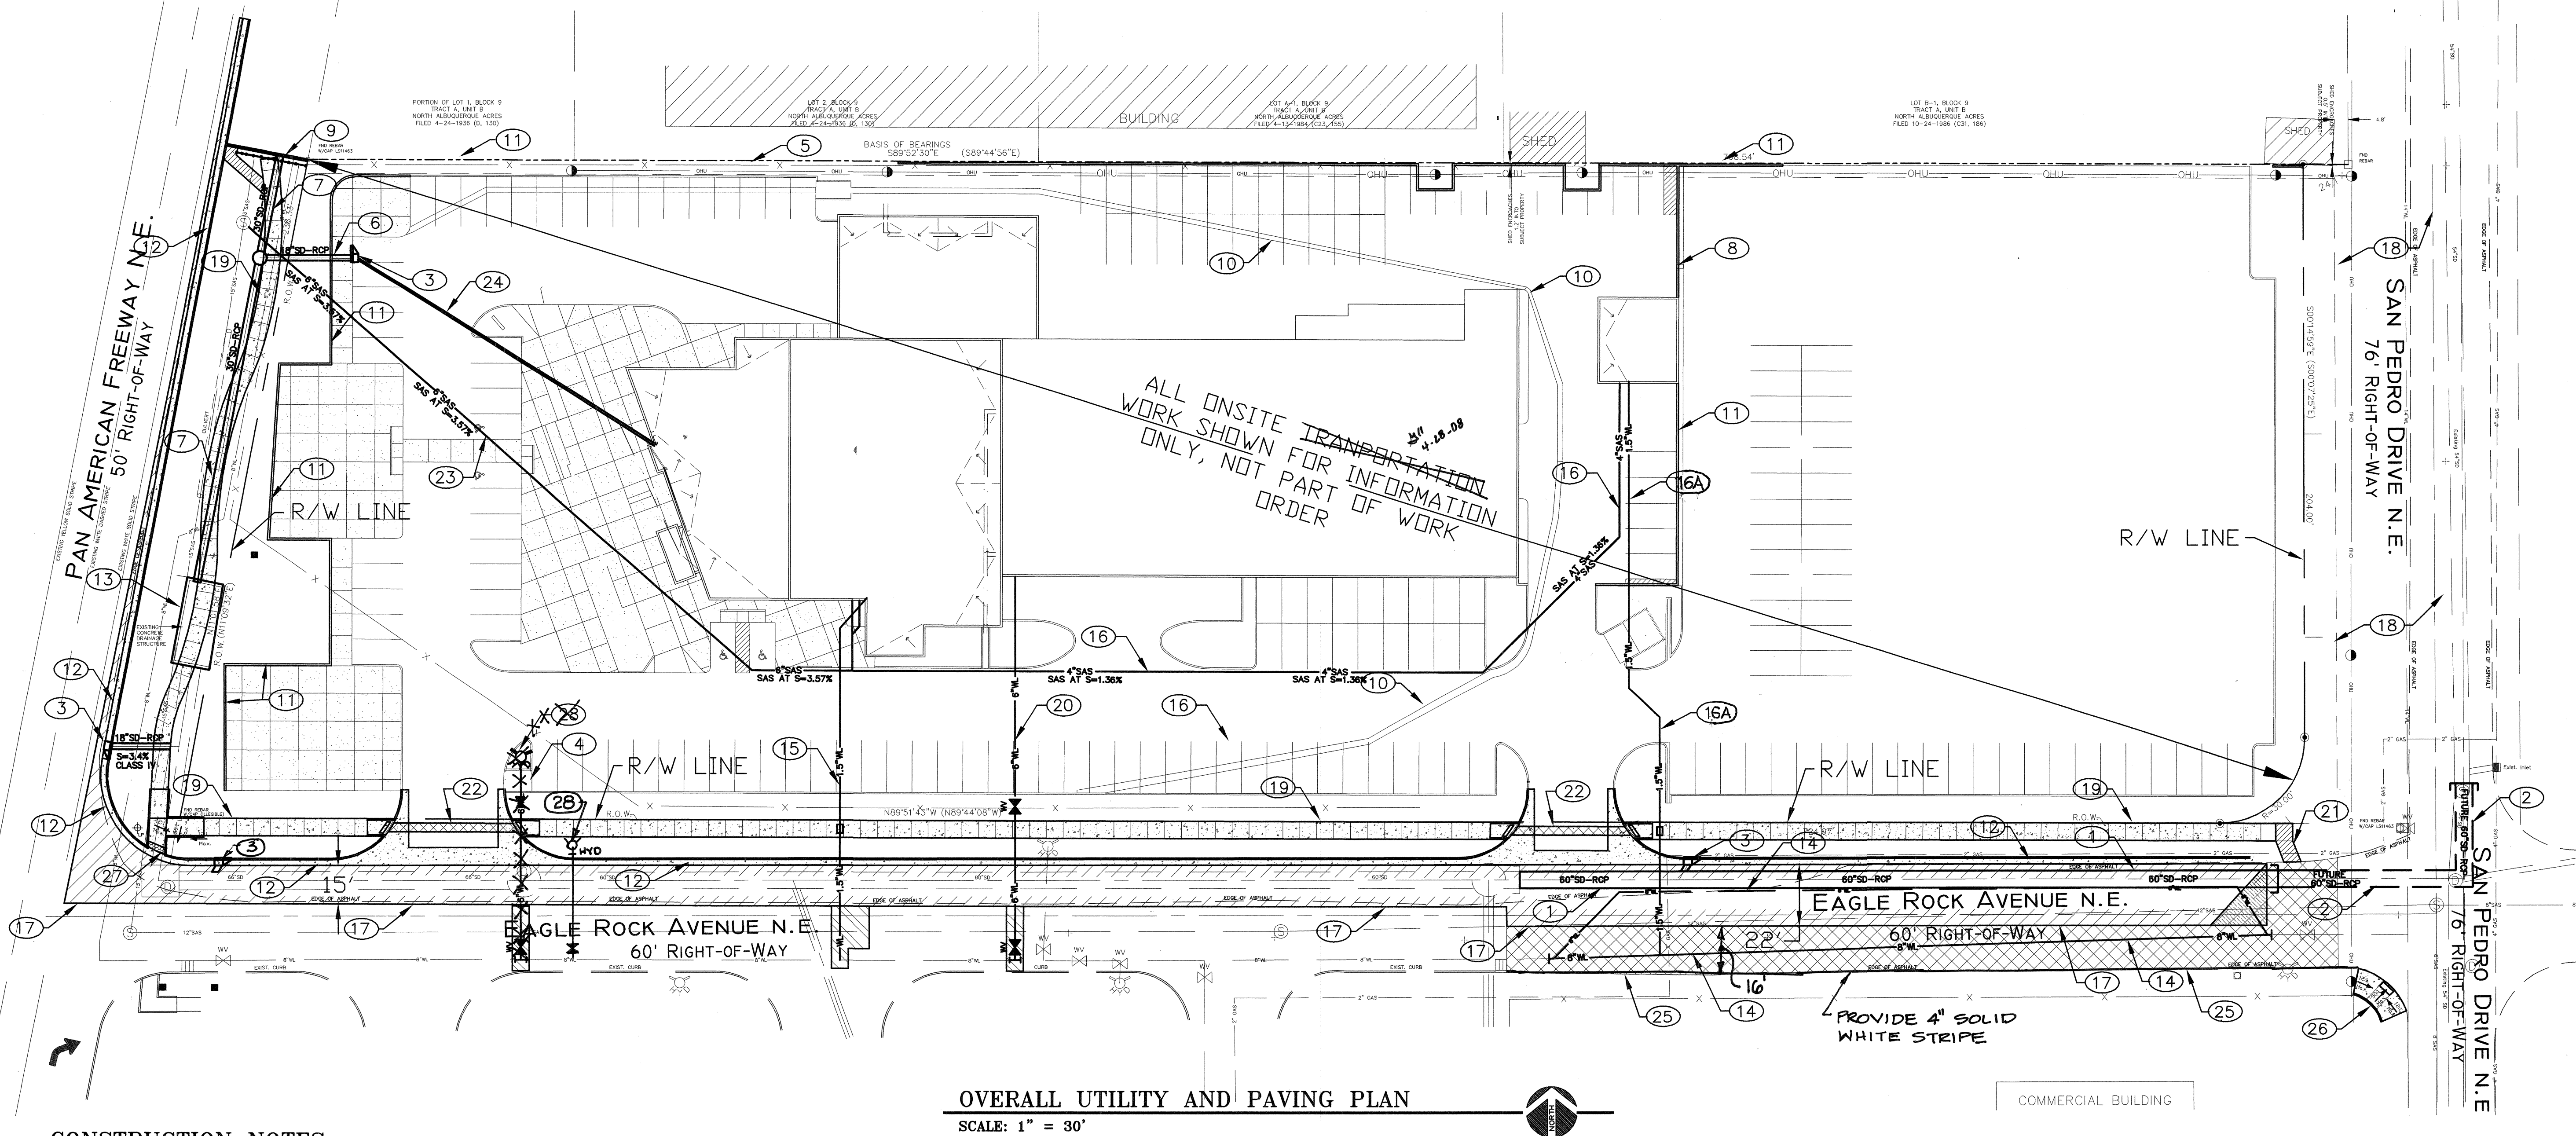


CONSTRUCTION NOTES:

- ① INSTALL APPROXIMATELY 270LF OF 60"RCP WITH THIS PROJECT.
- ② FINANCIALLY GUARANTY WITH CITY APPROXIMATELY 100LF OF 60" RCP WITH THIS PROJECT.
- ③ INSTALL STORM INLETS TYPE "A" PER CITY STANDARD DRAWING 2201, INLET GRATES PER 2220.
- ④ INSTALL 6.5' WIDE BY 6' DEEP CONCRETE CHANNEL PER CITY STANDARD DRAWING 2260.
- ⑤ INSTALL 2.5' WIDE BY 12' DEEP CONCRETE CHANNEL PER CITY STANDARD DRAWING 2260.
- ⑥ INSTALL 30LF OF 18"RCP
- ⑦ INSTALL 154LF OF 30"RCP
- ⑧ INSTALL 1.67' WIDE BY 8' DEEP OPENING IN RETAINING WALL.

UTILITY PRECAUTIONS

THE CONTRACTOR SHALL INFORM ITSELF OF THE LOCATION OF ANY UTILITY LINE, PIPELINE, OR UNDERGROUND UTILITY LINE IN OR NEAR THE AREA OF THE WORK IN ADVANCE OF AND DURING EXCAVATION WORK. THE CONTRACTOR IS FULLY RESPONSIBLE FOR ANY AND ALL DAMAGE CAUSED BY ITS FAILURE TO LOCATE, IDENTIFY AND PRESERVE ANY AND ALL EXISTING UTILITIES, PIPELINES, AND UNDERGROUND UTILITY LINES. IN PLANNING AND CONDUCTING EXCAVATION, THE CONTRACTOR SHALL COMPLY WITH STATE STATUTES, MUNICIPAL AND LOCAL ORDINANCES, RULES AND REGULATIONS, IF ANY, PERTAINING TO THE LOCATION OF THESE LINES AND

- ⑨ INSTALL HEADWALL PER NMDOT STANDARD DETAIL 511-03-1/1.
- ⑩ INSTALL 2' WIDE ALLEY GUTTER PER CITY STANDARD DRAWING 2415A. (NOT PART OF WORK ORDER)
- ⑪ INSTALL RETAINING WALL, HEIGHT VARIES, SEE STRUCTURAL DRAWINGS FOR DETAILS.
- ⑫ INSTALL CITY STANDARD CURB AND GUTTER PER CITY STD. DWG. 2415A.
- ⑬ INSTALL COVER ON EXISTING DRAINAGE STRUCTURE, SEE STRUCTURAL DRAWINGS FOR DETAILS.
- ⑭ RELOCATE 8" WATERLINE DUE TO CONFLICT WITH NEW STORM DRAIN LINE AND REMOVE EXISTING 8" WATERLINE COMPLETELY.
- ⑮ INSTALL 1-1/2" WATERLINE (PRIVATE) WITH 1-1/2" WATER METER.
- ⑯ INSTALL 4" SEWERLINE AND CLEANDOUTS PER INTERNATIONAL PLUMBING CODE REQUIREMENTS (PRIVATE)
- ⑰ INSTALL 1-1/4" WATERLINE (PRIVATE) WITH 1-0" WATER METER.
- ⑱ INSTALL 1/2 STREET SECTION OF EAGLE ROCK AVENUE PER CITY STANDARDS AND PER SECTIONS ON SHEET 11.
- ⑲ INSTALL 1/2 STREET SECTION OF SAN PEDRO BOULEVARD PER CITY STANDARDS. (FUTURE DESIGN AND CONSTRUCTION - NOT PART OF THIS PROJECT)
- ⑳ INSTALL 6' WIDE CONCRETE SIDEWALK PER CITY STD. DWG. 2430.
- ㉑ INSTALL 6" FIRELINE WATERLINE (PRIVATE).
- ㉒ INSTALL 6' WIDE ASPHALT PATH FROM EDGE OF NEW SIDEWALK TO EDGE OF EXISTING ASPHALT PAVING.
- ㉓ PROVIDE 3' WIDE AT 2% CROSS SLOPE BETWEEN HANDICAP RAMPS FOR ADA ACCESS.
- ㉔ INSTALL 6" SEWERLINE AND CLEANDOUTS PER INTERNATIONAL PLUMBING CODE (PRIVATE).
- ㉕ INSTALL 8" STORM DRAIN
- ㉖ REMOVE EXISTING ASPHALT PAVEMENT AND REPLACE WITH TEMPORARY ASPHALT PAVEMENT PER SECTION SHOWN ON SHEET 11.
- ㉗ INSTALL WHEELCHAIR CURB ACCESS RAMP PER CITY STD. DWG. 2441, CASE 1, WITH TRUNCATED DOWNS, NOT REQD - SEE REVISION No. 2 - INFRASTRUCTURE LIST.
- ㉘ INSTALL WHEELCHAIR CURB ACCESS RAMP AT THE NORTHEAST CORNER OF PAN AMERICAN FRONTAGE ROAD AND EAGLE ROCK ROAD PER NMDOT SPECIFICATIONS AND DETAIL SHOWN ON SHEET 10.
- ㉙ INSTALL FIRE HYDRANT

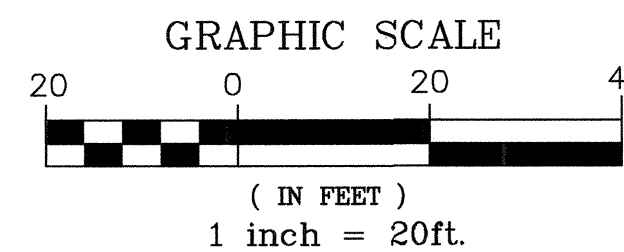


APPLIED ENGINEERING AND SURVEYING, INC.
ENGINEERS AND PLANNERS
1205 Blue Drive NE
Albuquerque, New Mexico 87112
Office: (505) 237-1456 Fax: (505) 237-1456

CITY OF ALBUQUERQUE
PUBLIC WORKS DEPARTMENT
ENGINEERING DEVELOPMENT GROUP
TITLE: OVERALL UTILITY AND PAVING PLAN
CORLEY'S ALBUQUERQUE


Design Review Committee
APPROVED
MAY 15 2008
DESIGN REVIEW COMMITTEE
City Project No. 724582

City Engineer Approval
APPROVED
JUN 04 2008
CITY ENGINEER
Zone Map No. C-18

Mo./Day/Yr.
Mo./Day/Yr.
Last Design Update
Sheet 5 Of 15

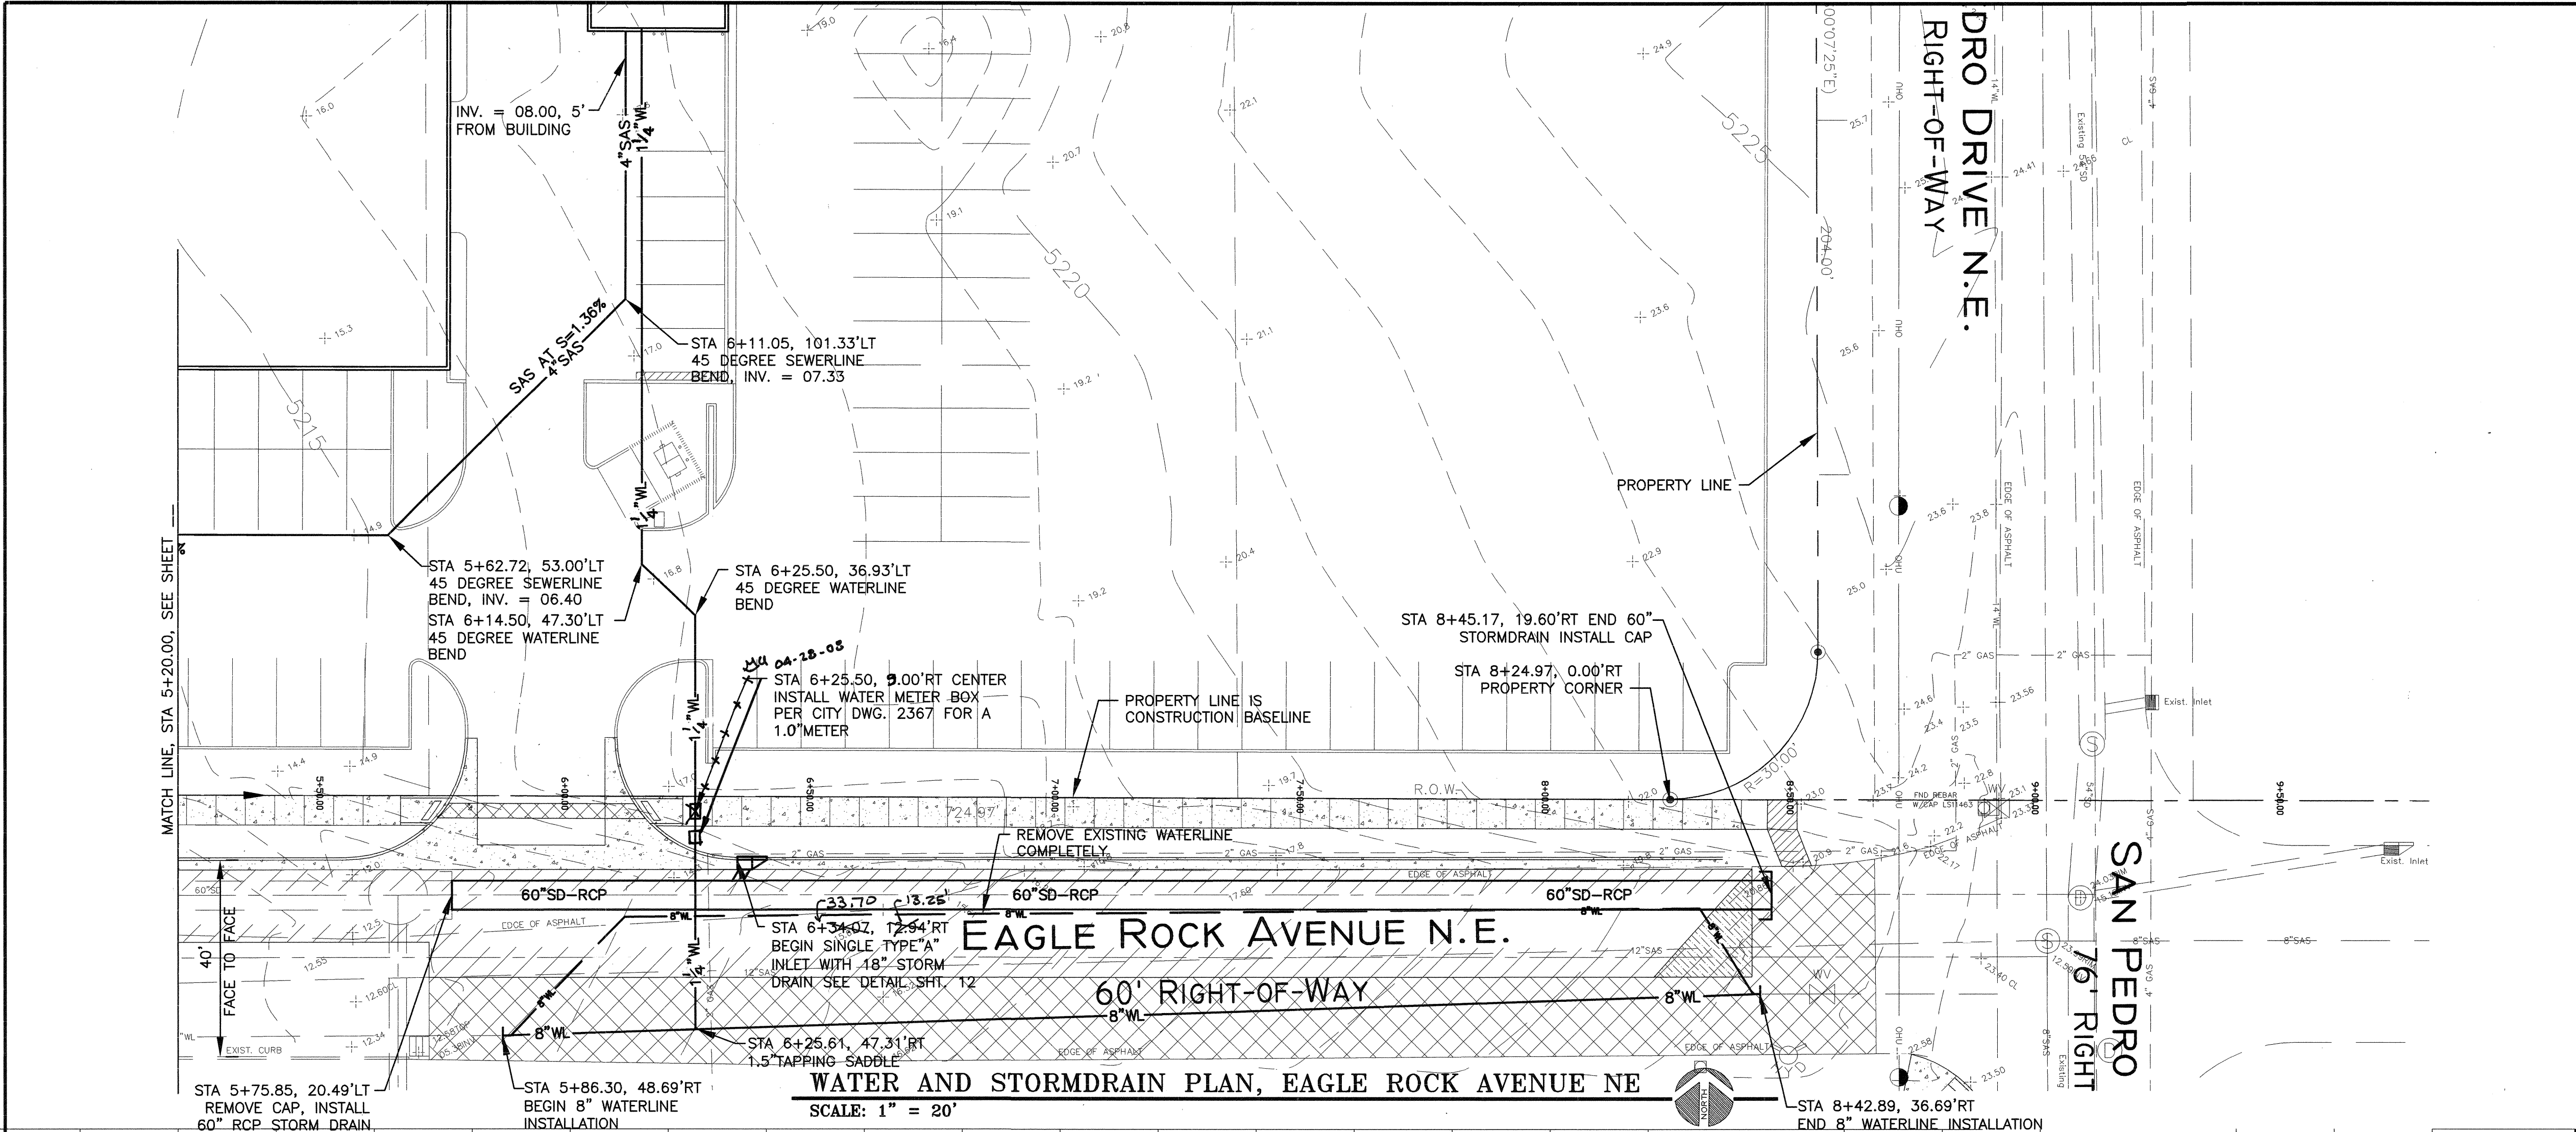


WATER AND STORMDRAIN PLAN, EAGLE ROCK AVENUE NE
SCALE: 1" = 20'

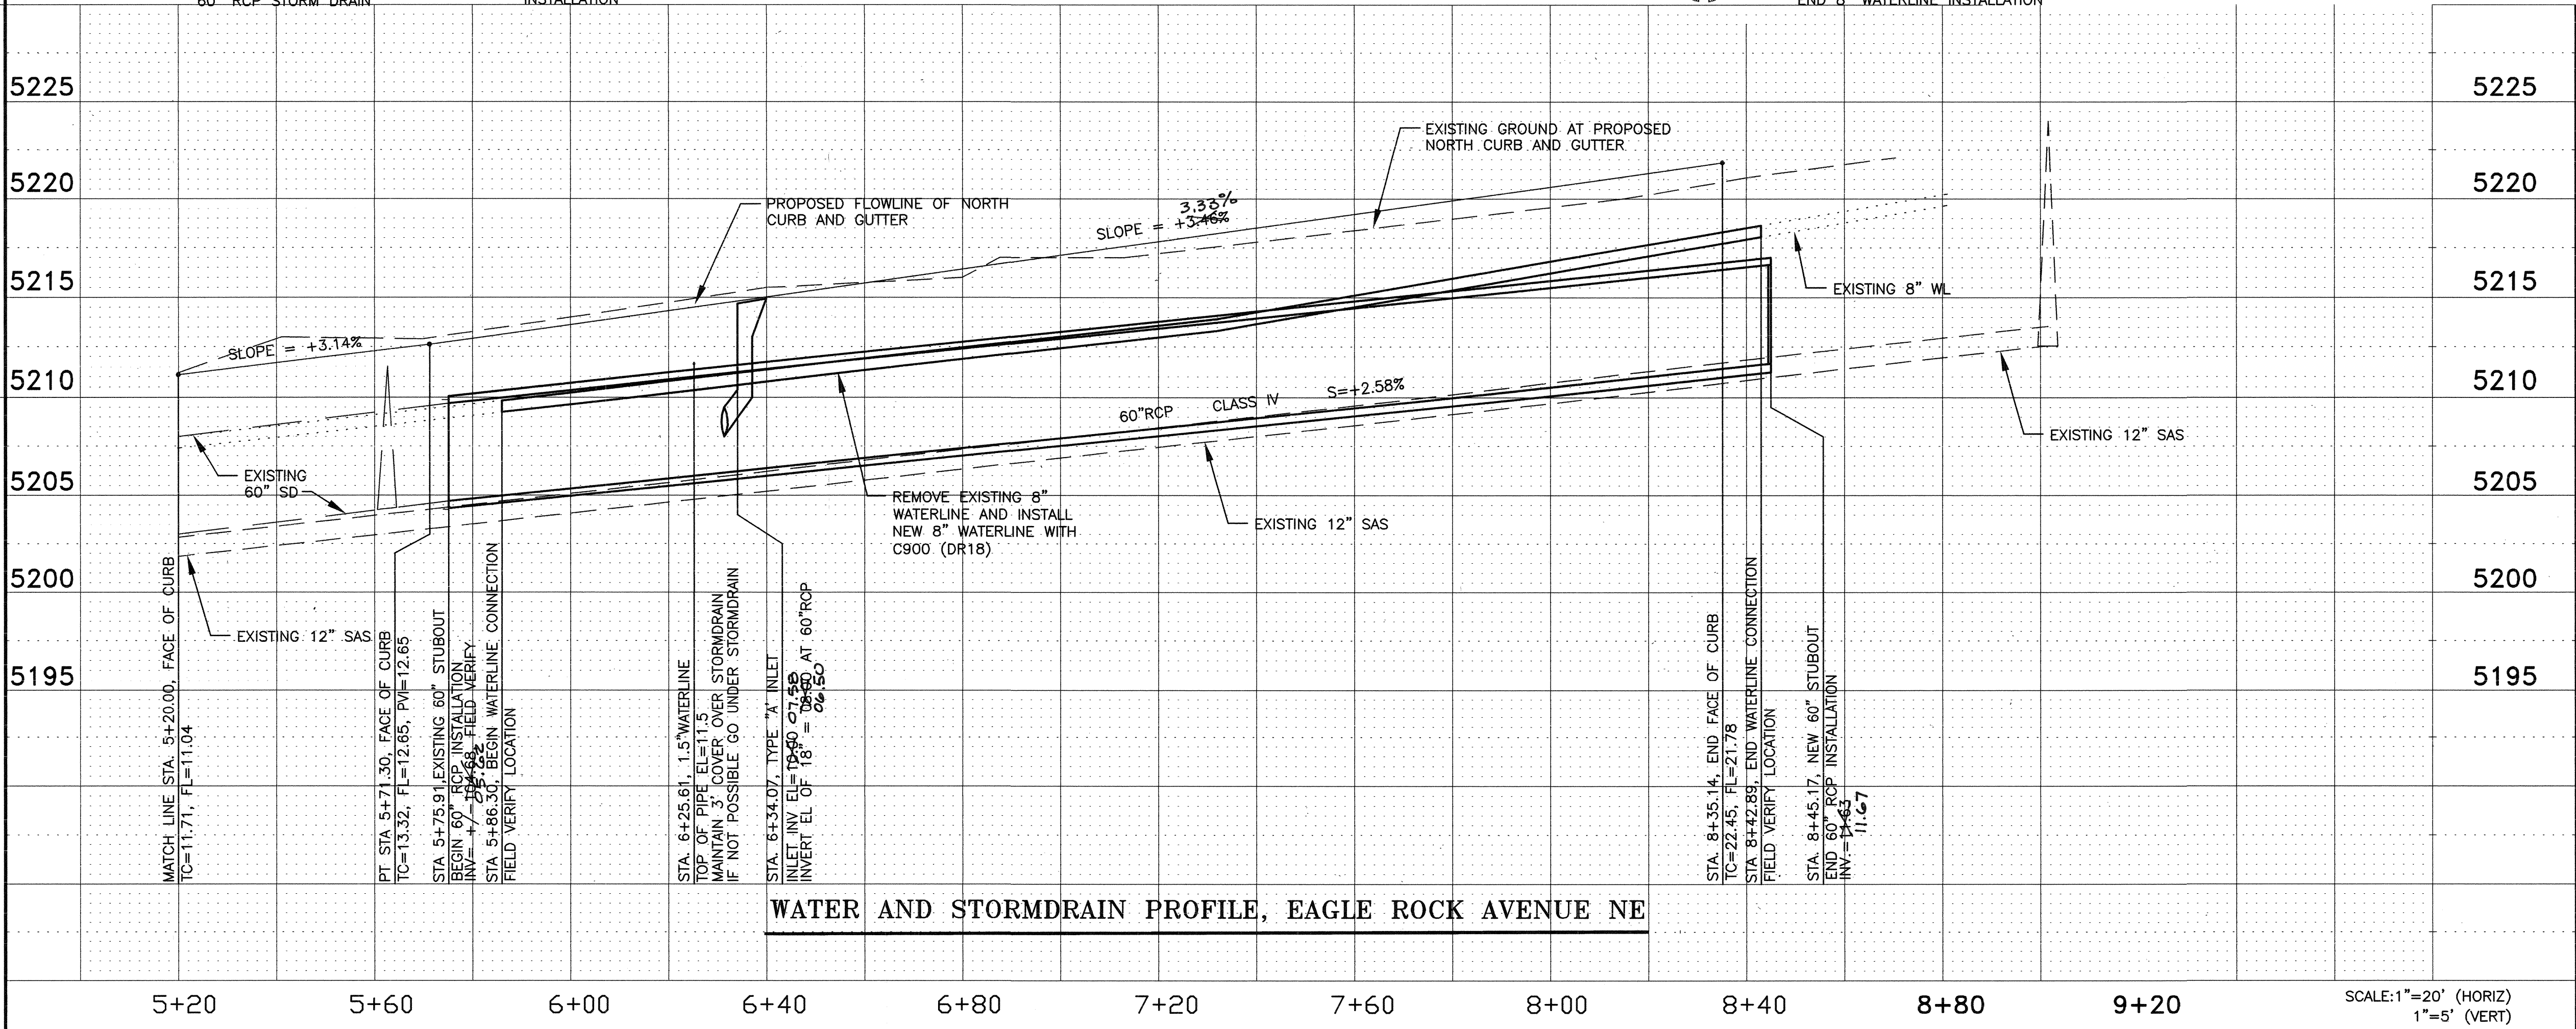

WATER AND STORMDRAIN PROFILE, EAGLE ROCK AVENUE NE
SCALE: 1" = 20' (HORIZ)
1" = 5' (VERT)

CONSTRUCTION NOTES:

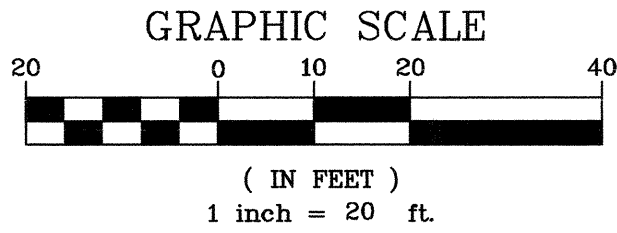

APPLIED ENGINEERING AND SURVEYING, INC.
ENGINEERS AND PLANNERS
1800 Blvd. Santa Fe, N.M. 87512
Albuquerque, New Mexico 87112
Phone: (505) 237-1456


CITY OF ALBUQUERQUE
PUBLIC WORKS DEPARTMENT
ENGINEERING DEVELOPMENT GROUP



TITLE: CORLEY'S ALBUQUERQUE
WATER AND STORMDRAIN, EAGLE ROCK AV NE

Design Review Committee
APPROVED
MAY 15 2008
DESIGN REVIEW COMMITTEE

City Engineer Approval
APPROVED
JUN 04 2008
CITY ENGINEER


Mo./Day/Yr.	Mo./Day/Yr.

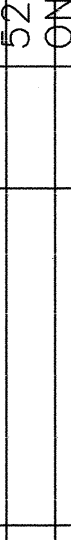ENGINEER'S SEAL			SURVEY INFORMATION		BENCH MARKS		AS BUILT INFORMATION		
			FIELD NOTES		THE BASIS OF ELEVATIONS FOR THIS SURVEY IS ACS BENCHMARK 10-C18, THE PUBLISHED ELEVATION OF WHICH IS 5222.09, NAVD83. BENCHMARK IS LOCATED ON THE EAST RIGHT-OF-WAY OF SAN PEDRO BLVD. NE, 48' SOUTH OF THE ENTERLINE OF MODESTO AVENUE NE AT ITS INTERSECTION WITH SAN PEDRO BLVD.				
			NO.	BY	DATE				
			REMARKS						
			DESIGN						
			DATE						
			DRAWN BY						
			CHECKED BY						
NO.	DATE	BY							

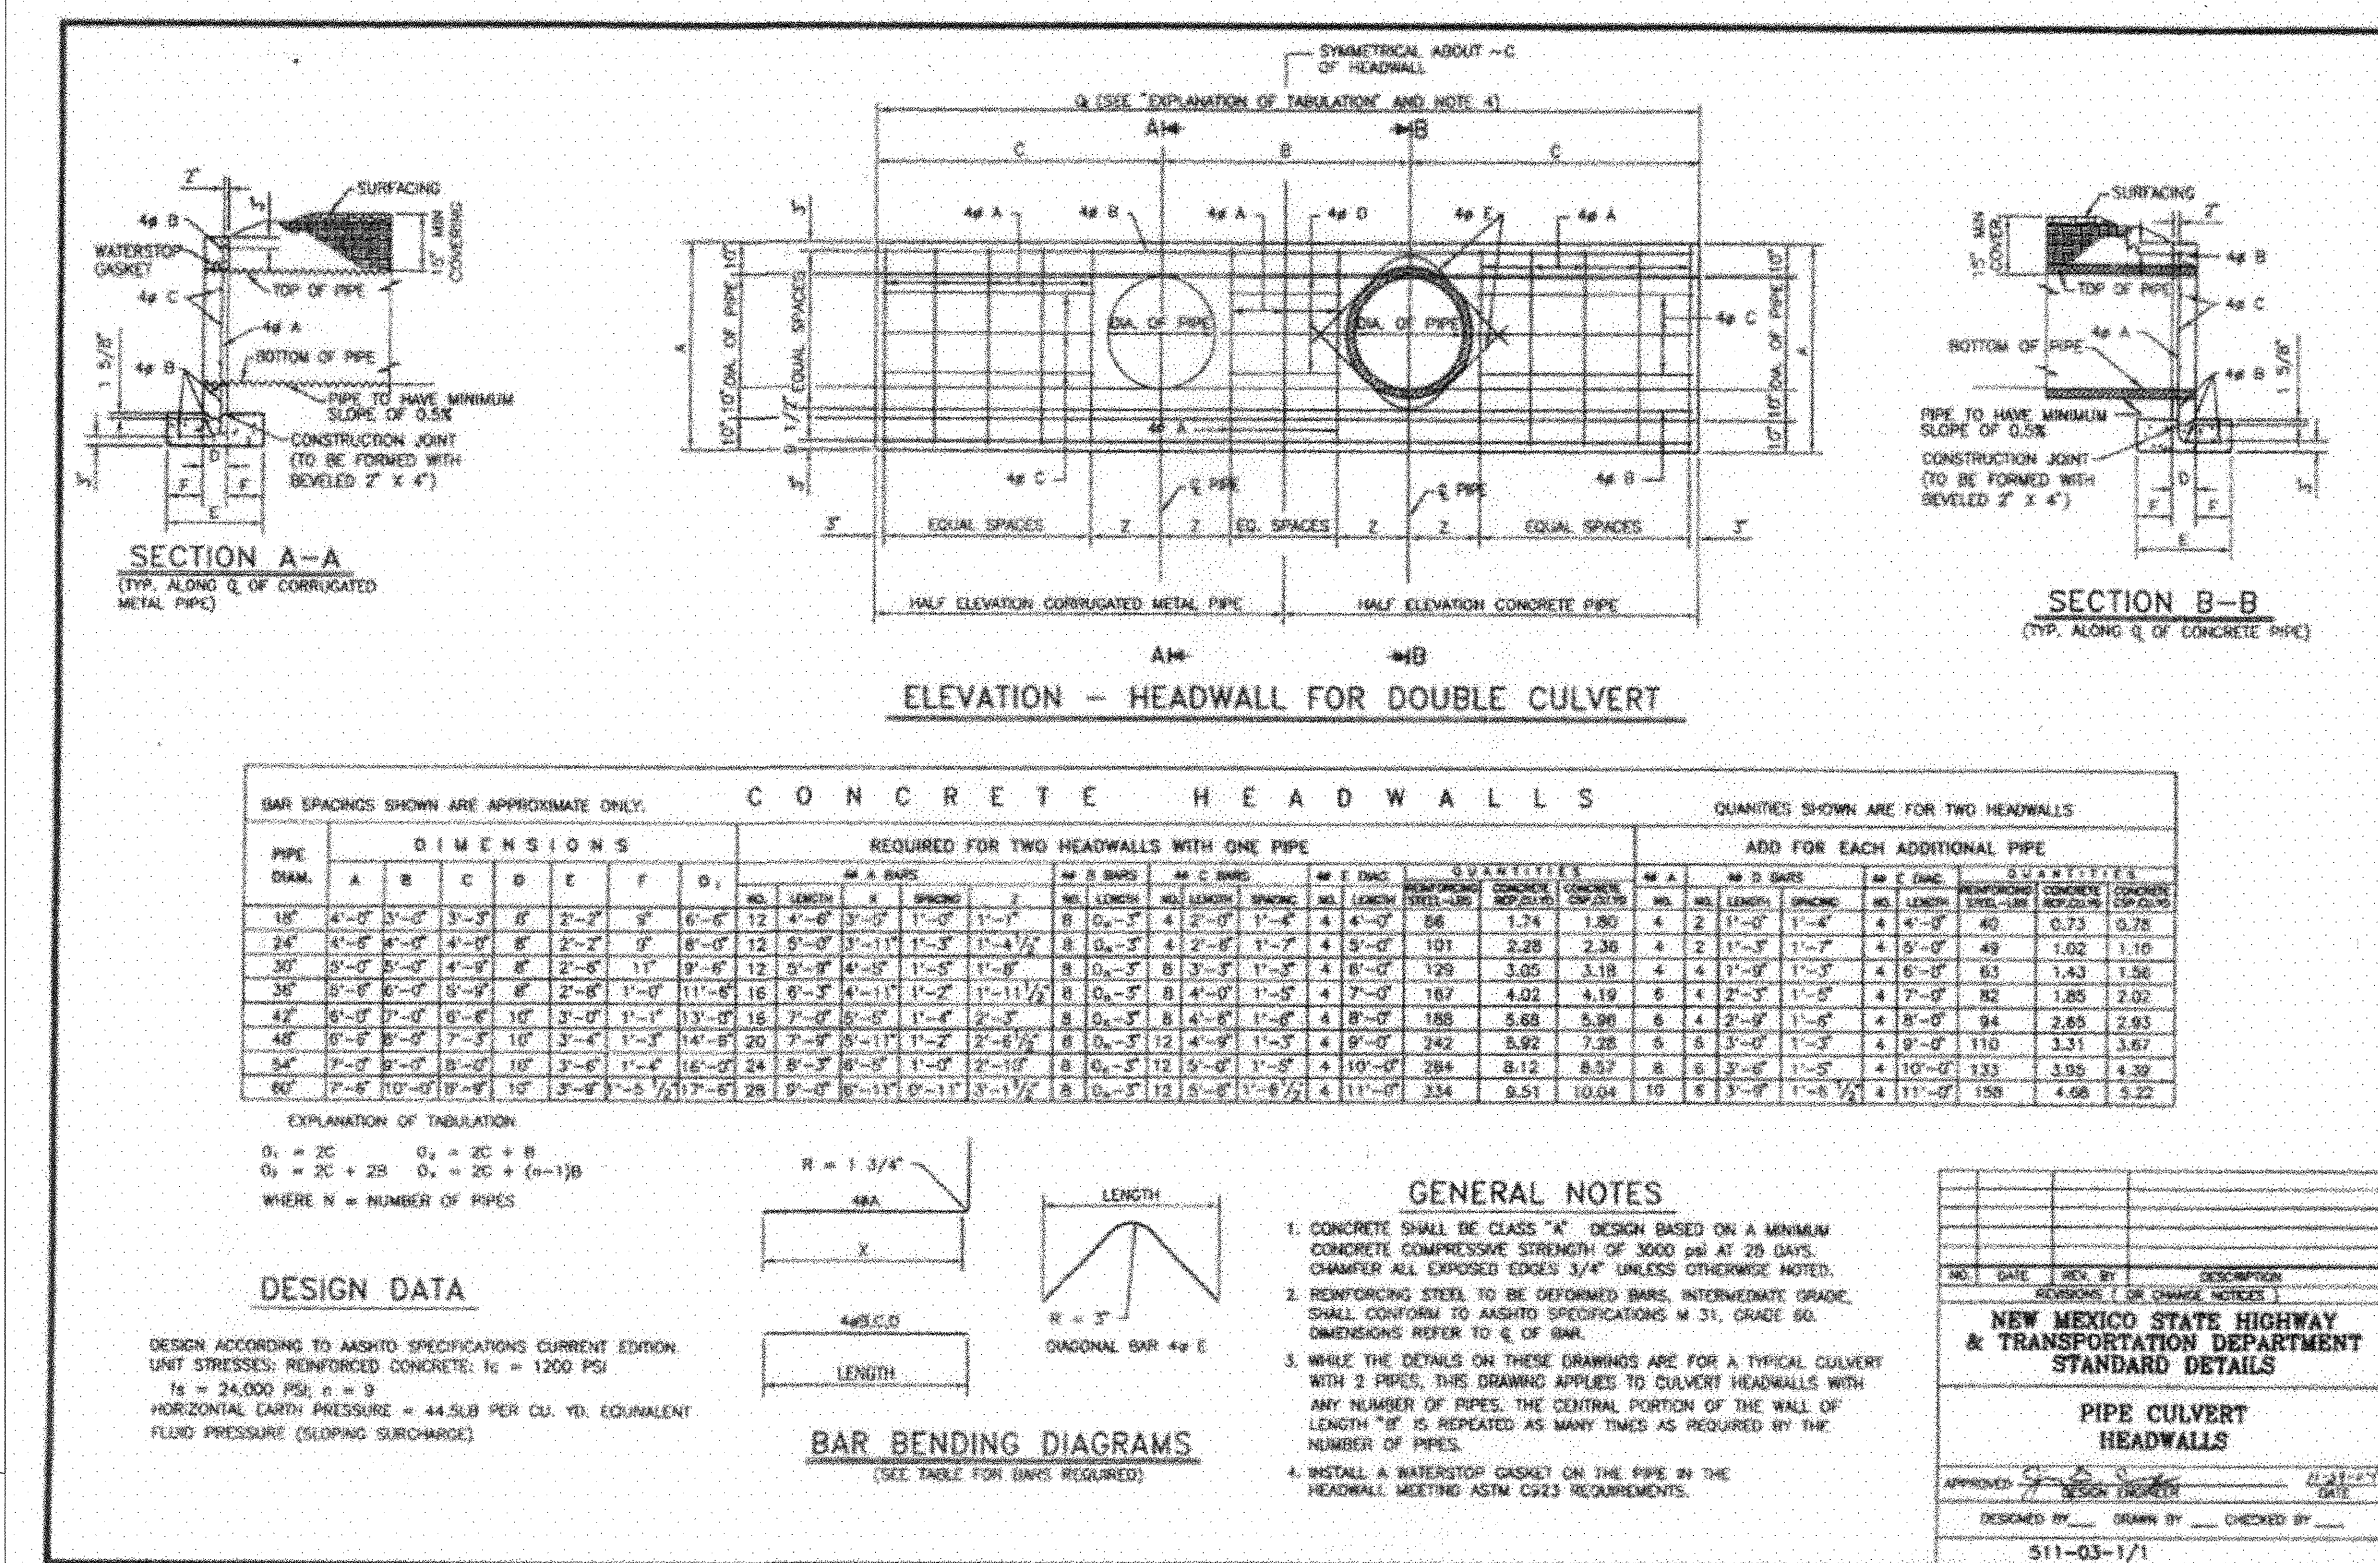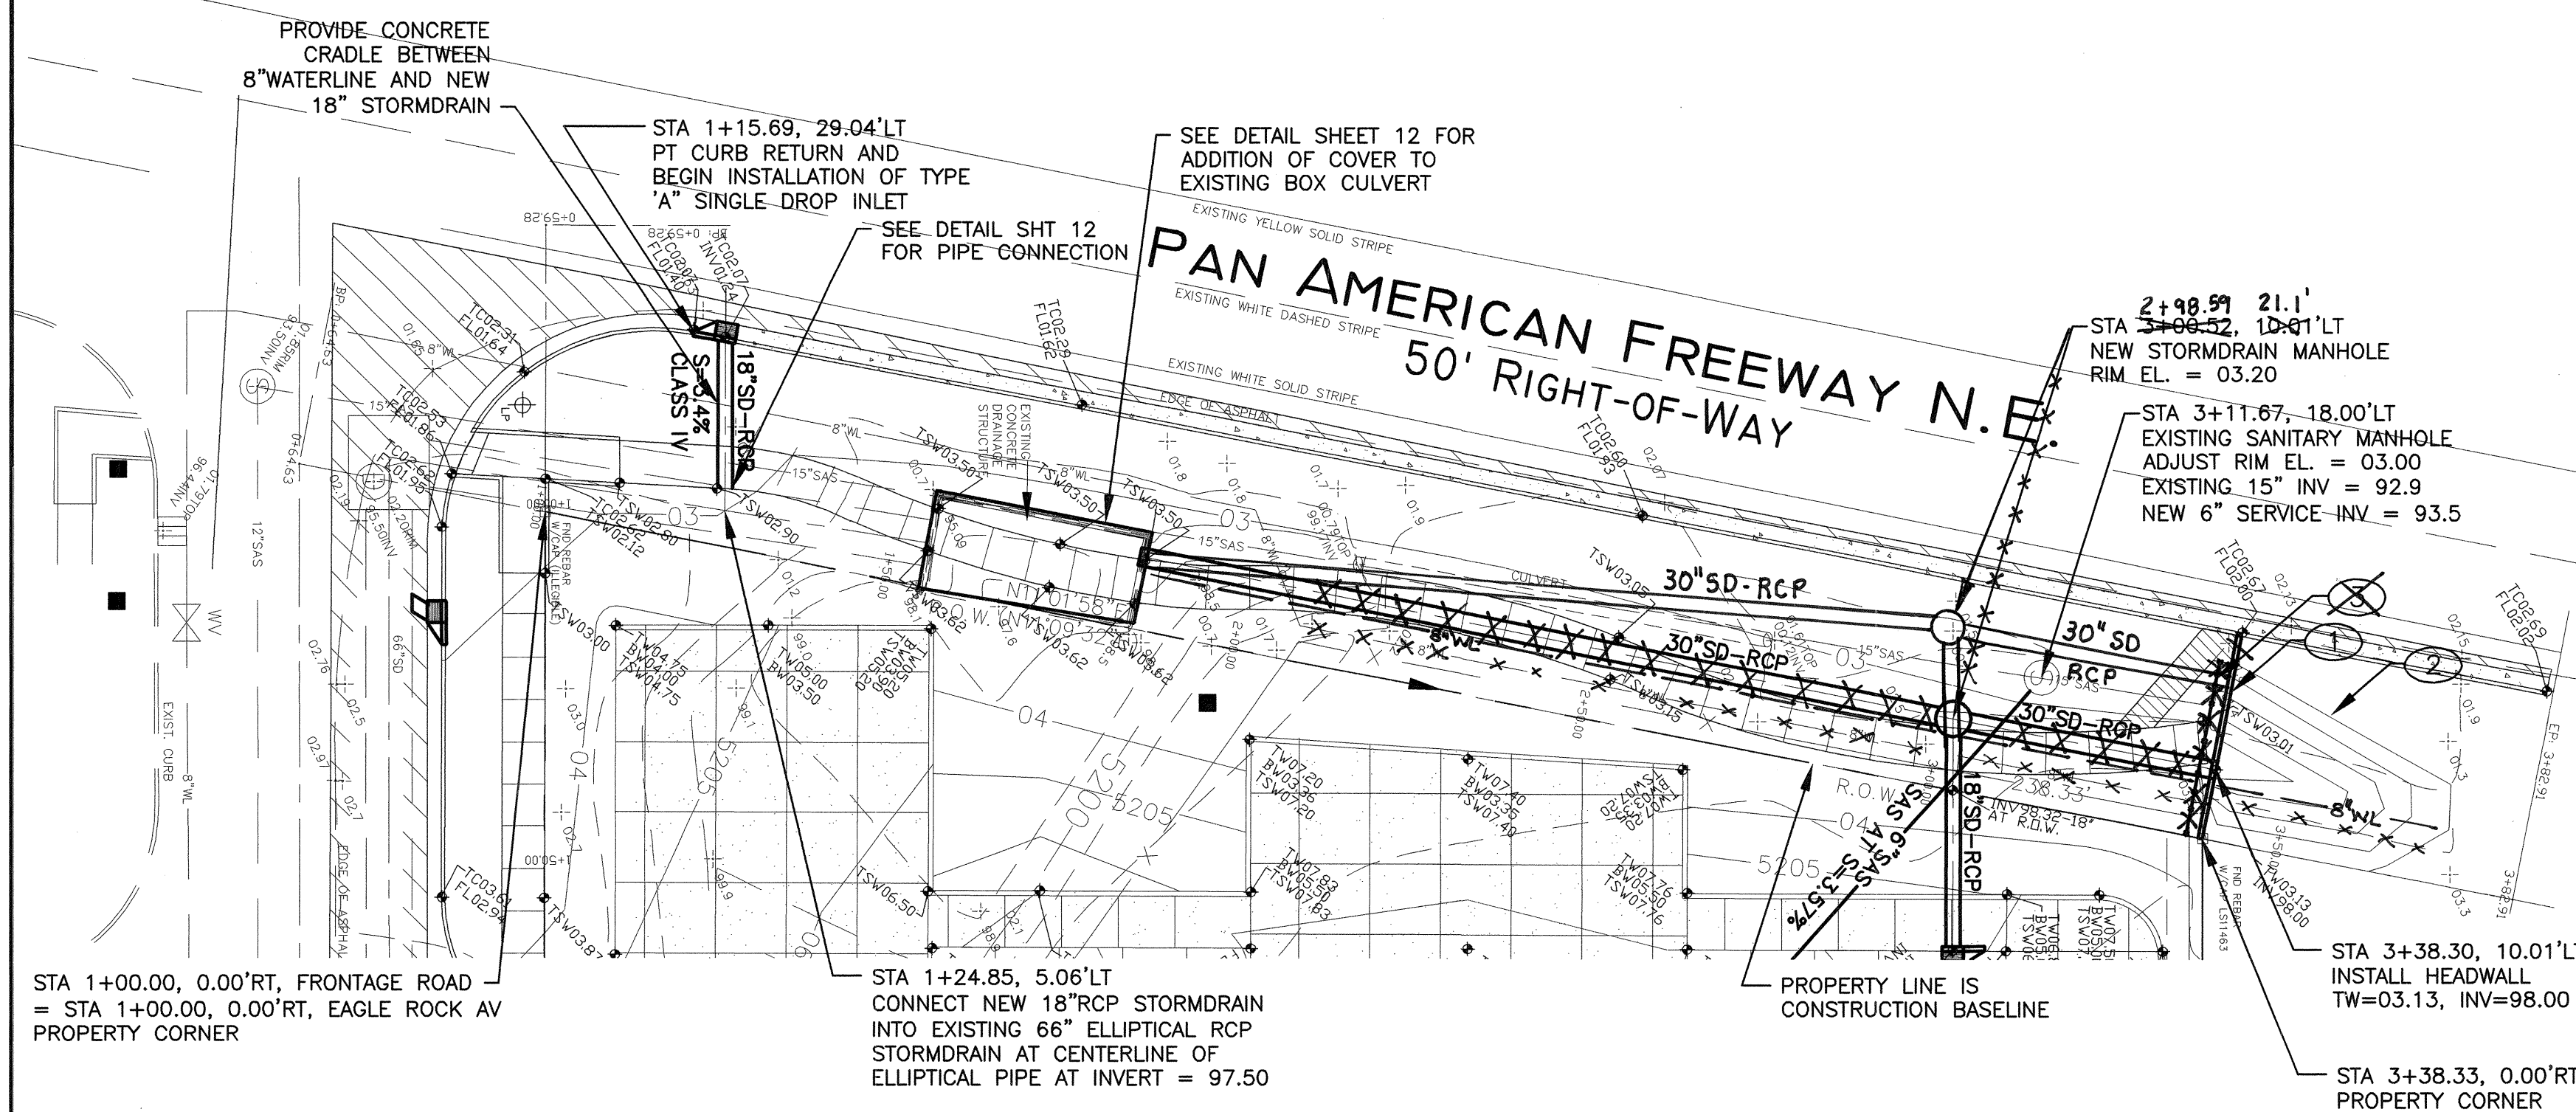

STORMDRAIN PLAN, PAN AMERICAN FRONTAGE ROAD NE


SCALE: 1" = 20'

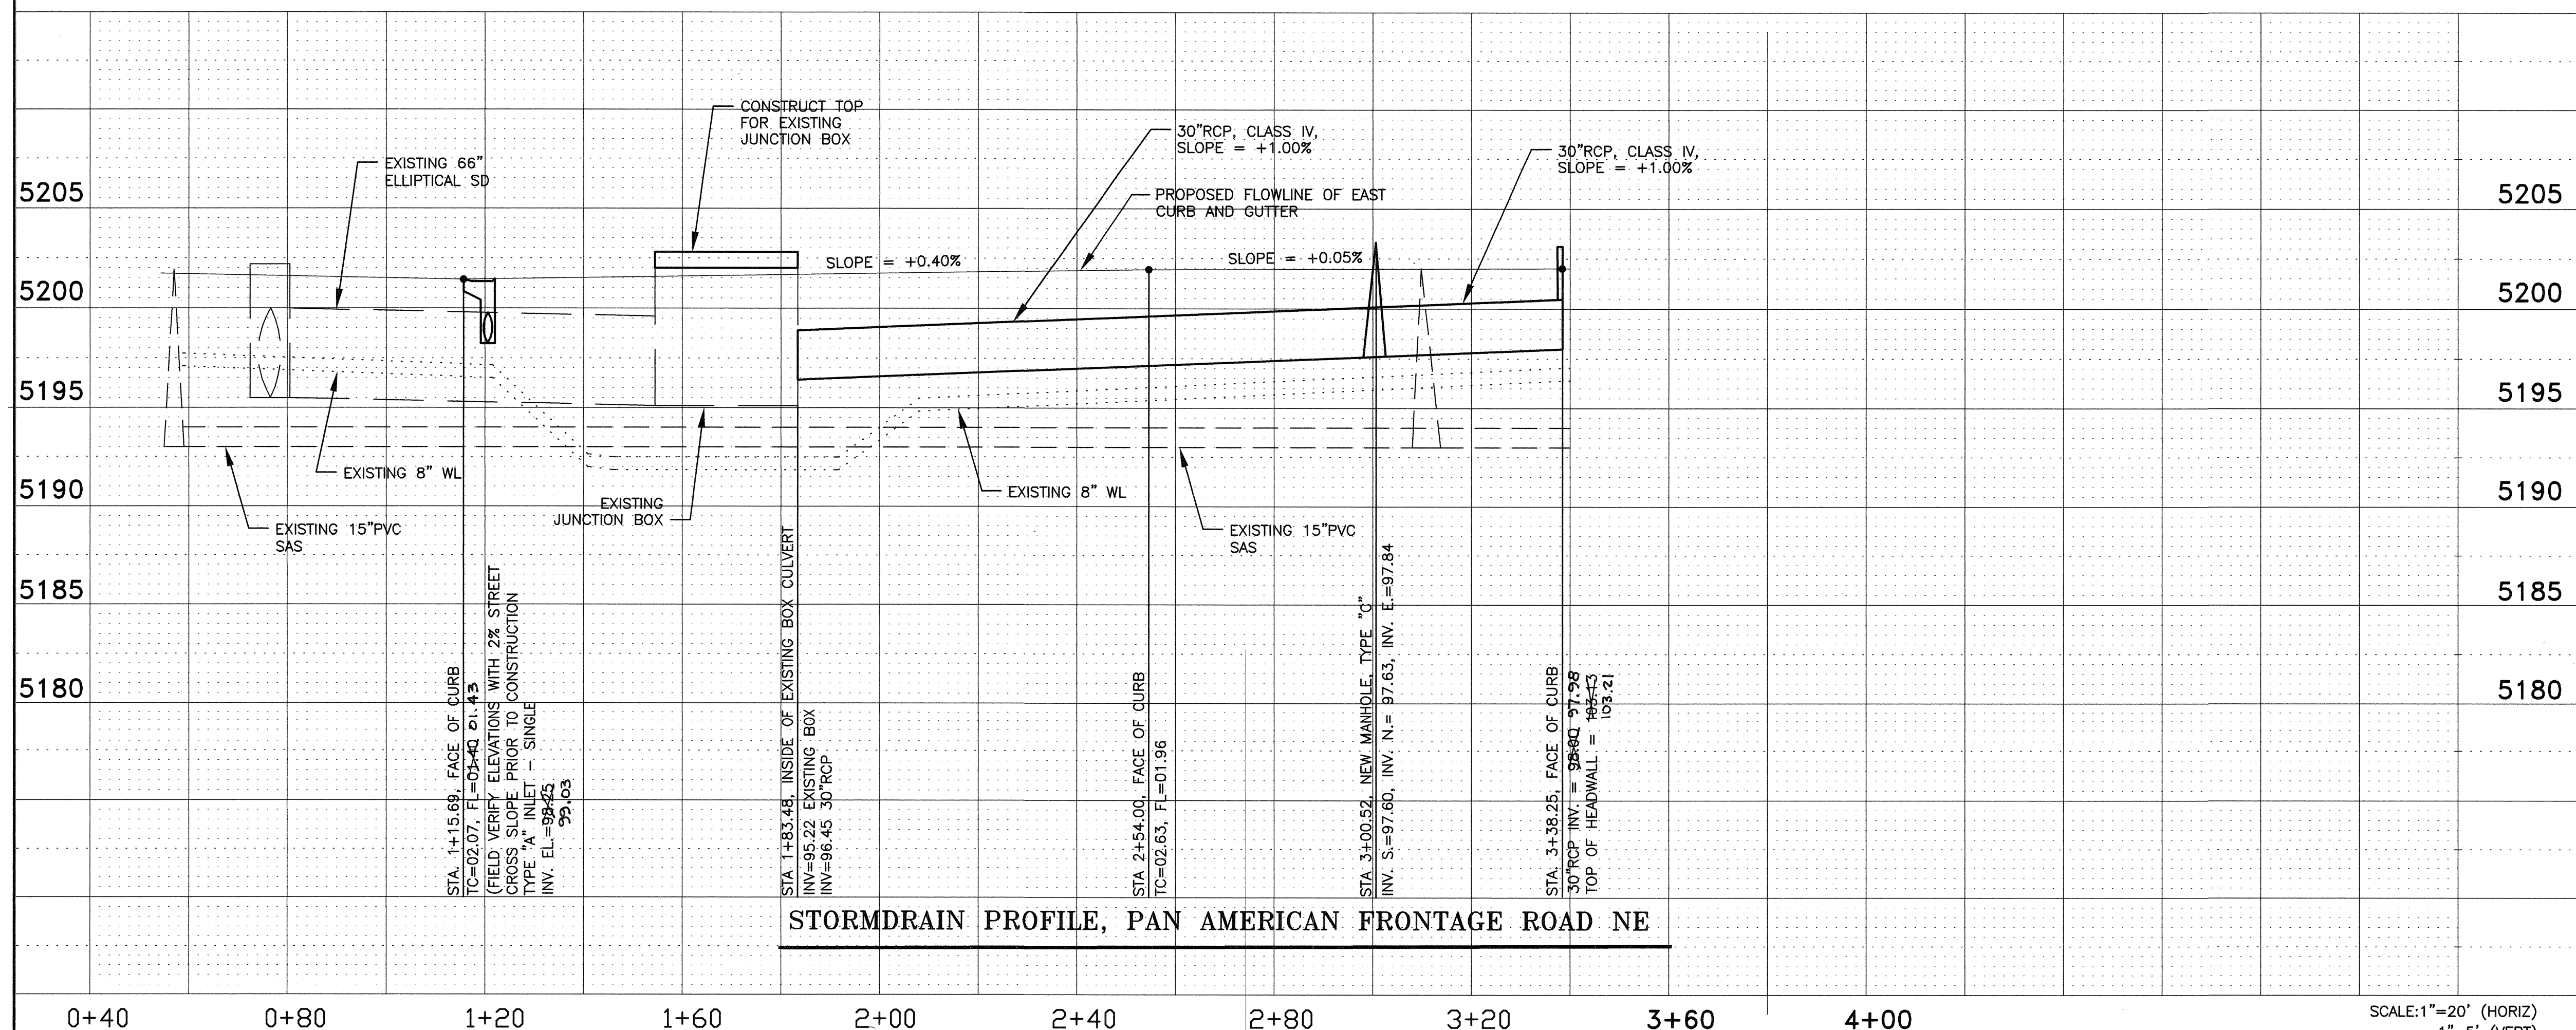

STORMDRAIN PROFILE, PAN AMERICAN FRONTAGE ROAD NE

CONSTRUCTION NOTES:

- ① CONSTRUCT PIPE CULVERT HEADWALL PER NEW MEXICO STATE HIGHWAY AND TRANSPORTATION DEPARTMENT STANDARD DETAILS 511-03-1/1, EXTEND WALL TO BACK OF NEW CURB AND TO EXISTING PROPERTY LINE.
- ~~② GRADE +/- 30 FEET OF EXISTING CHANNEL TO DRAIN INTO INVERT OF NEW 30" STORM DRAIN.~~
- ~~③ INSTALL 4' HIGH STANDARD CHAIN LINK FENCE PER CITY OF ALBUQUERQUE STANDARD DRAWING 2252, END 4' FROM BACK OF CURB LINE.~~
- ② SEE TEMPORARY STORM DRAIN CONNECTION AND DESILTATION POND ADDED PER NMDOT, SHEET 14 OF 15.

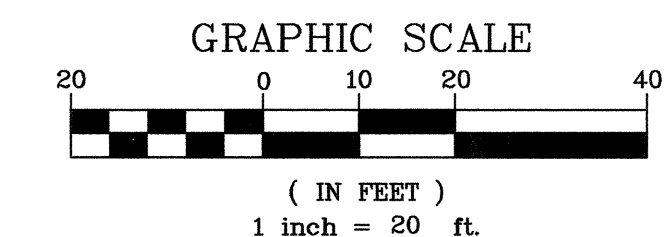

**APPLIED ENGINEERING AND
SURVEYING, INC.**
ENGINEERS AND PLANNERS

1605 Blair Drive NE
Office: (505) 223-7-1456

Albuquerque, New Mexico 87112
Facsimile: (505) 237-1456

CITY OF ALBUQUERQUE
PUBLIC WORKS DEPARTMENT
ENGINEERING DEVELOPMENT GROUP

TITLE: CORLEY'S ALBUQUERQUE
STORMDRAIN, FRONTAGE ROAD NE

Design Review Committee 	City Engineer Approval 	Last Design Update 	Mo./Day/Yr. 	Mo./Day/Yr.
City Project No. 724582	Zone Map No. 15	Sheet 7 Of 15		

SURVEY INFORMATION		BENCH MARKS		AS BUILT INFORMATION	
NO.	FIELD NOTES	DATE	BY	WORK STAMPED BY INSTRUMENT FIELD	DATE
	THE BASIS OF ELEVATIONS FOR THIS SURVEY IS ACS BENCHMARK 10-C18, THE PUBLISHED ELEVATION OF WHICH IS 5222.09, NAVD86. BENCHMARK IS LOCATED ON THE EAST RIGHT-OF-WAY OF SAN PEDRO BLVD. NE, 48' SOUTH OF THE ENTERLINE OF MODESTO AVENUE NE AT ITS INTERSECTION WITH SAN PEDRO BLVD.			CONTRACTOR JP Contracting STAMPED BY Terra Lano INSTRUMENT Survey FIELD Applied Engr VERIFICATION BY Applied Engr CORRECTED BY Applied Engr	12/26/2018 12/26/2018 12/26/2018 12/26/2018 12/26/2018
				MICRO-FILM INFORMATION RECORDED BY NO.	DATE

ENGINEER'S SEAL

QUE
MEN
T GR

RQU
E R

	Mr
	S

NO.	FIELD NOTES	DATE	BY	CONTRACTOR'S FIELD CONTRACTING	DATE
	SURVEY IS ACS BENCHMARK 10-C18. THE PUBLISHED ELEVATION OF WHICH IS 5222.09. NAVD86. BENCHMARK IS LOCATED ON THE EAST RIGHT-OF-WAY OF SAN PEDRO BLVD. NE, 48' SOUTH OF THE ENTERLINE OF MOPESHO AVENUE NE AT ITS INTERSECTION WITH SAN PEDRO BLVD.			STARTED BY <u>Terre Lano Surveying</u> INSPECTED BY <u>Applied Engr</u> FIELD ACCEPTANCE BY <u>Applied Engr</u> DRAWINGS BY <u>Applied Engr</u> CORRECTED BY <u>Applied Engr</u> MICRO-FILM INFORMATION RECORDED BY DATE	DATE <u>12/14/2016</u> DATE <u>12/14/2016</u> DATE <u>12/14/2016</u> DATE <u>12/14/2016</u> DATE <u>12/14/2016</u>

[illegible]

REMARKS	DATE
REVISIONS	DATE
DESIGN	DATE


				NO.	DATE
DESIGNED BY _____					
DRAWN BY _____					
CHECKED BY _____					

T
OUP

ROAD NE

Mo./Day/Yr.	Mo./Day/Yr.

Sheet 7 Of 15

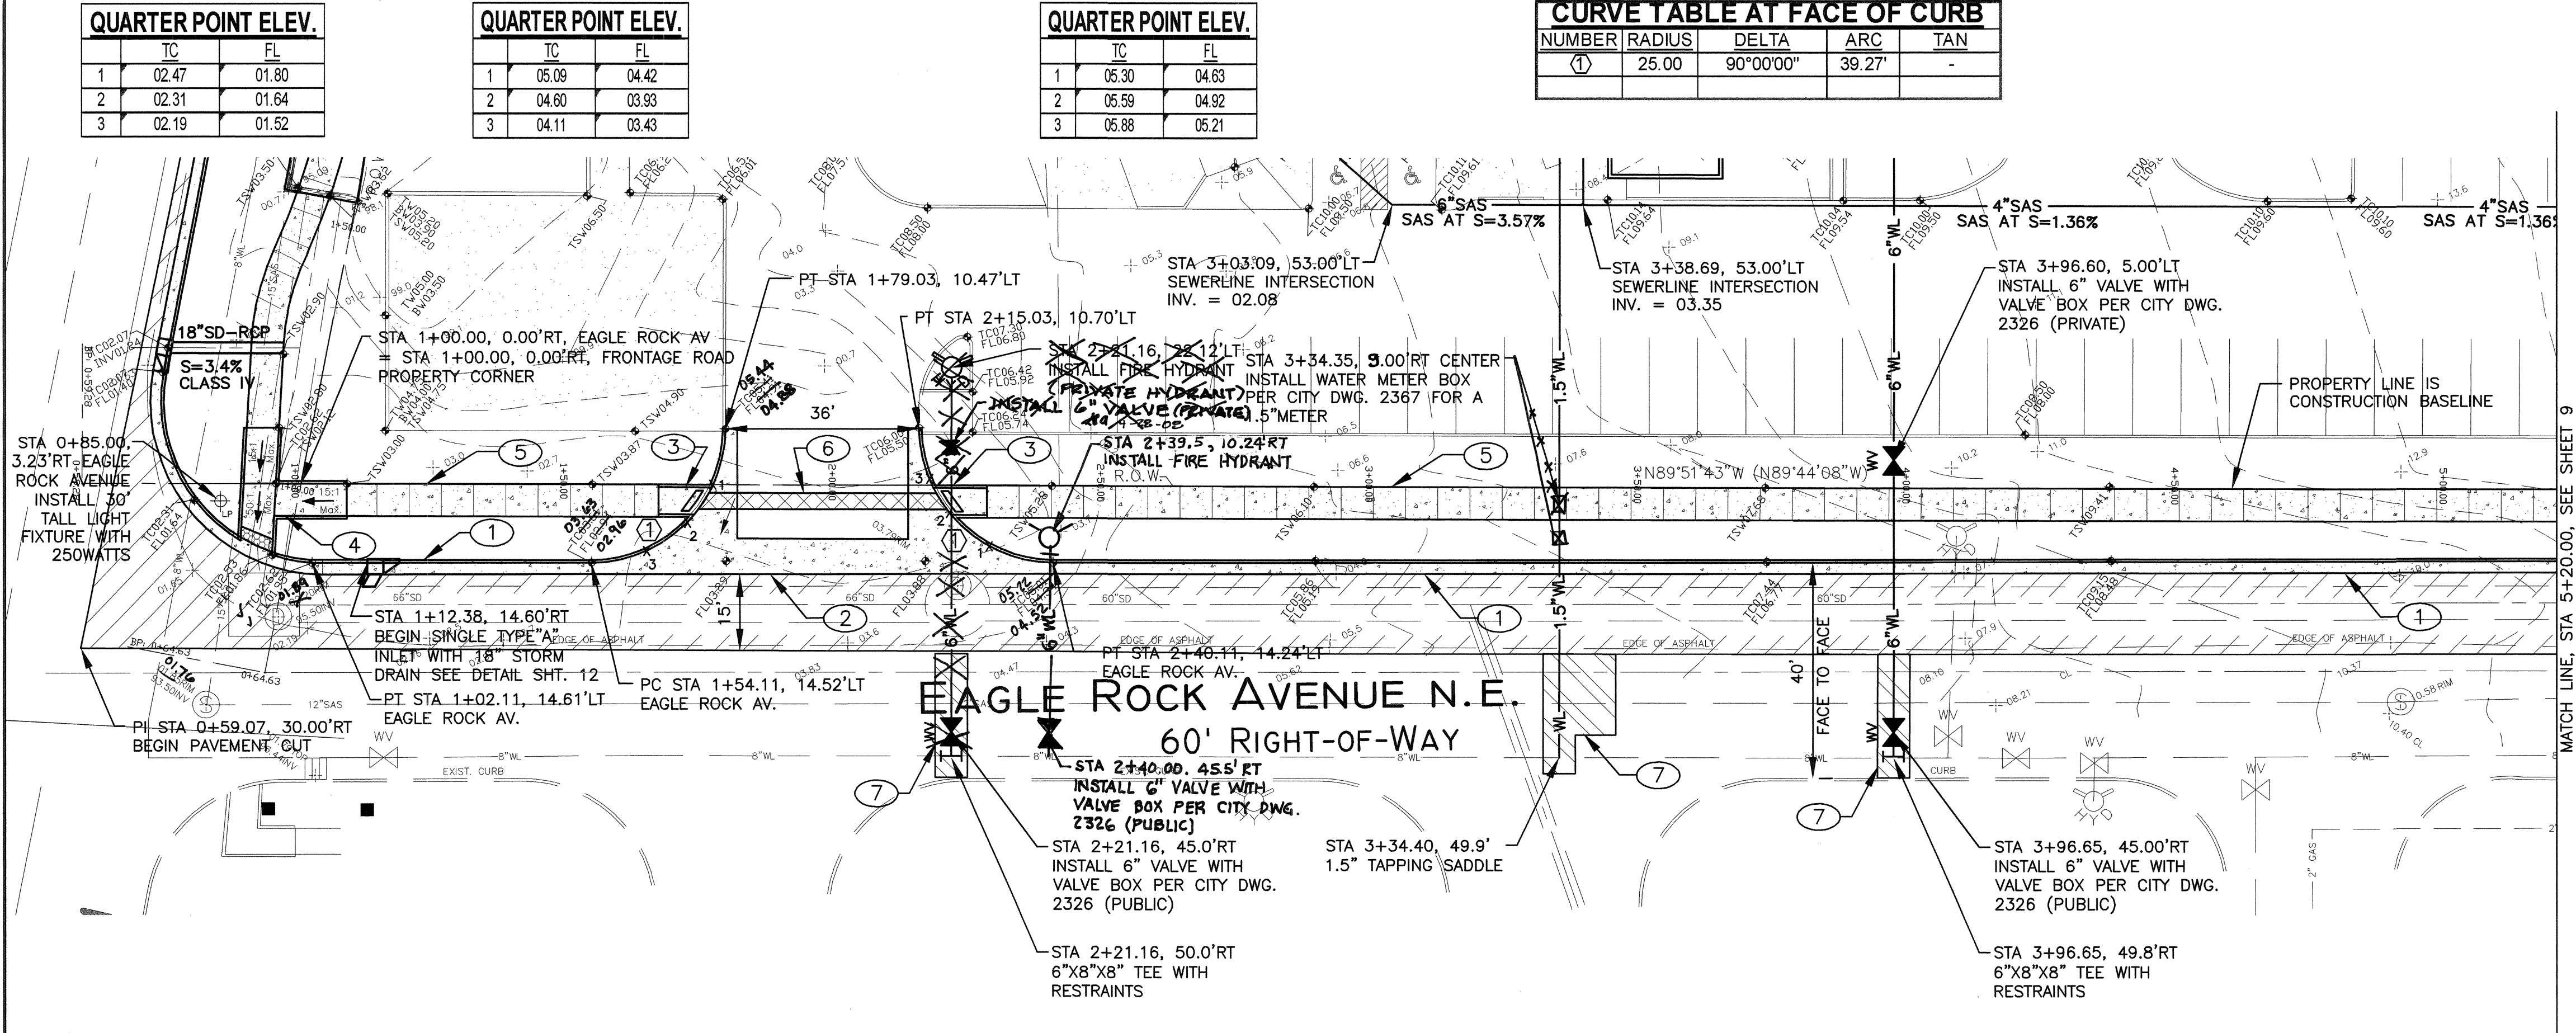


PAVING PLAN, EAGLE ROCK AVENUE NE

SCALE: 1" = 20'


CONSTRUCTION NOTES:

- ① CONSTRUCT STANDARD CURB & GUTTER PER COA STD. DWG. 2415A.
- ② CONSTRUCT 6' WIDE CONCRETE VALLEY GUTTER PER COA STD. DWG. 2420.
- ③ CONSTRUCT (WHEELCHAIR) UNIDIRECTIONAL RAMPS PER COA STD. DWG. 2426 WITH THE FOLLOWING TRUNCATED DOMES:
 - * DESIGN PER ADA GUIDELINES
 - * SUBMIT SPECS TO CITY CONSTRUCTION PRIOR TO CONSTRUCTION.
- ④ CONSTRUCT (WHEELCHAIR) RAMP PER NMDOT SPECIFICATIONS, SEE DETAIL SHEET 10.
- ⑤ CONSTRUCT 6' WIDE SIDEWALK PER SIDEWALK DETAILS PER COA STD. DWG. 2430.
- ⑥ PROVIDE 3' WIDE AT 2% CROSS SLOPE BETWEEN HANDICAP RAMPS FOR ADA ACCESS.
- ⑦ ALL PAVEMENT CUTS FOR UTILITIES SHALL BE IN ACCORDANCE WITH CITY STD. DWG. 2465 (MAJOR LOCAL).

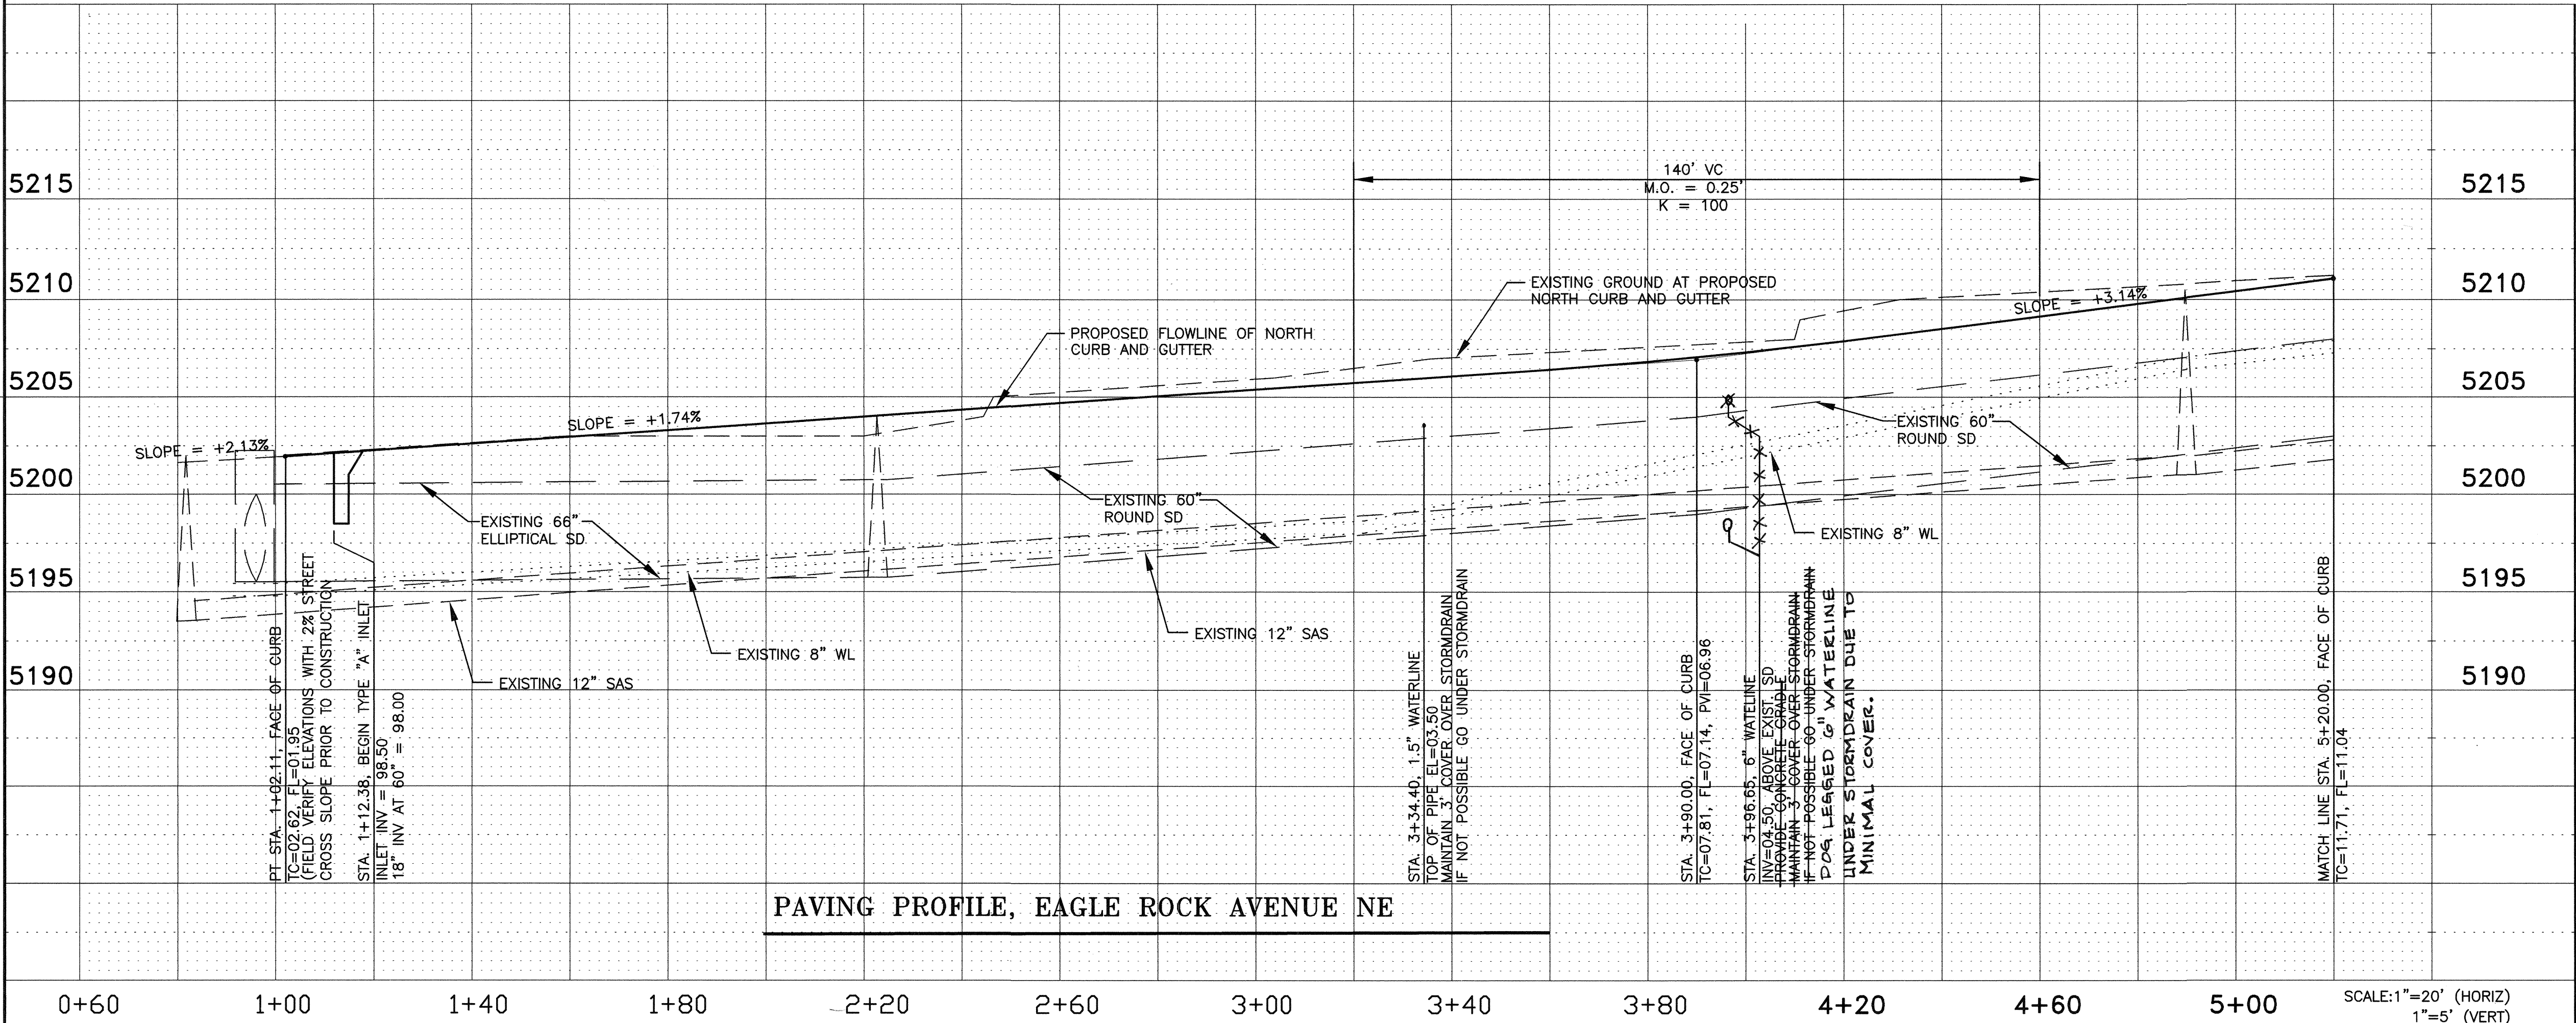

PAVING PROFILE, EAGLE ROCK AVENUE NE

SCALE: 1" = 20' (HORIZ)
1" = 5' (VERT)

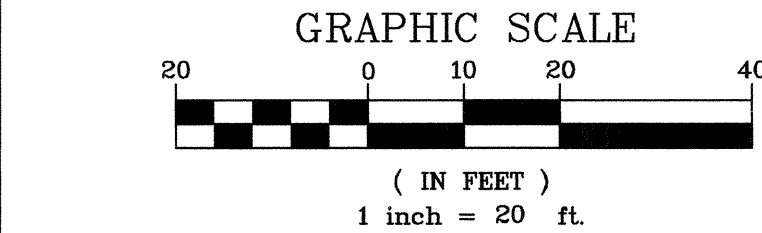

APPLIED ENGINEERING AND SURVEYING, INC.
ENGINEERS AND PLANNERS
1620 Blvd. Drive NE
Albuquerque, New Mexico 87112
Office: (505) 237-1400
Fax: (505) 237-1401

CITY OF ALBUQUERQUE
PUBLIC WORKS DEPARTMENT
ENGINEERING DEVELOPMENT GROUP

TITLE: **CORLEY'S ALBUQUERQUE
PAVING PLAN & PROFILE, EAGLE ROCK AV. NE**


Design Review Committee: **APPROVED** MAY 15 2008
City Engineer Approval: **APPROVED** JUN 04 2008
Last Design Update: _____
City Project No. 724582
Zone Map No. C-18
Sheet 8 of 15

AS BUILT INFORMATION		BENCH MARKS		SURVEY INFORMATION		ENGINEER'S SEAL	
CONTRACTOR: JPD Contracting	DATE: 12/08	THE BASIS OF ELEVATIONS FOR THIS SURVEY IS ACS BENCHMARK 10-C18. THE PUBLISHED ELEVATION OF WHICH IS 5222.09, NAVD83. BENCHMARK IS LOCATED ON THE EAST RIGHT-OF-WAY OF SAN PEDRO BLVD. NE, 46' SOUTH OF THE INTERLINE OF MODESTO AVENUE NE AT ITS INTERSECTION WITH SAN PEDRO BLVD.	DATE: 12/08	FIELD NOTES	NO.	BY	NO.
WORK STARTED BY: JPD Contracting	DATE: 12/08		DATE: 12/08				
FIELD ACCEPTANCE BY: Applied Engr	DATE: 12/08		DATE: 12/08				
CORRECTED BY: Applied Engr	DATE: 12/08		DATE: 12/08				
RECORDED BY: MICRO-FILM INFORMATION	DATE: 12/08		DATE: 12/08				

QUARTER POINT ELEV.		
TC	FL	
1	14.55	13.88
2	14.48	13.81
3	13.63	12.96


QUARTER POINT ELEV.		
TC	FL	
1	15.50	14.83
2	15.51	14.84
3	15.57	14.90

CURVE TABLE AT FACE OF CURB				
NUMBER	RADIUS	DELTA	ARC	TAN
(1)	25.00	90°00'00"	39.27'	-

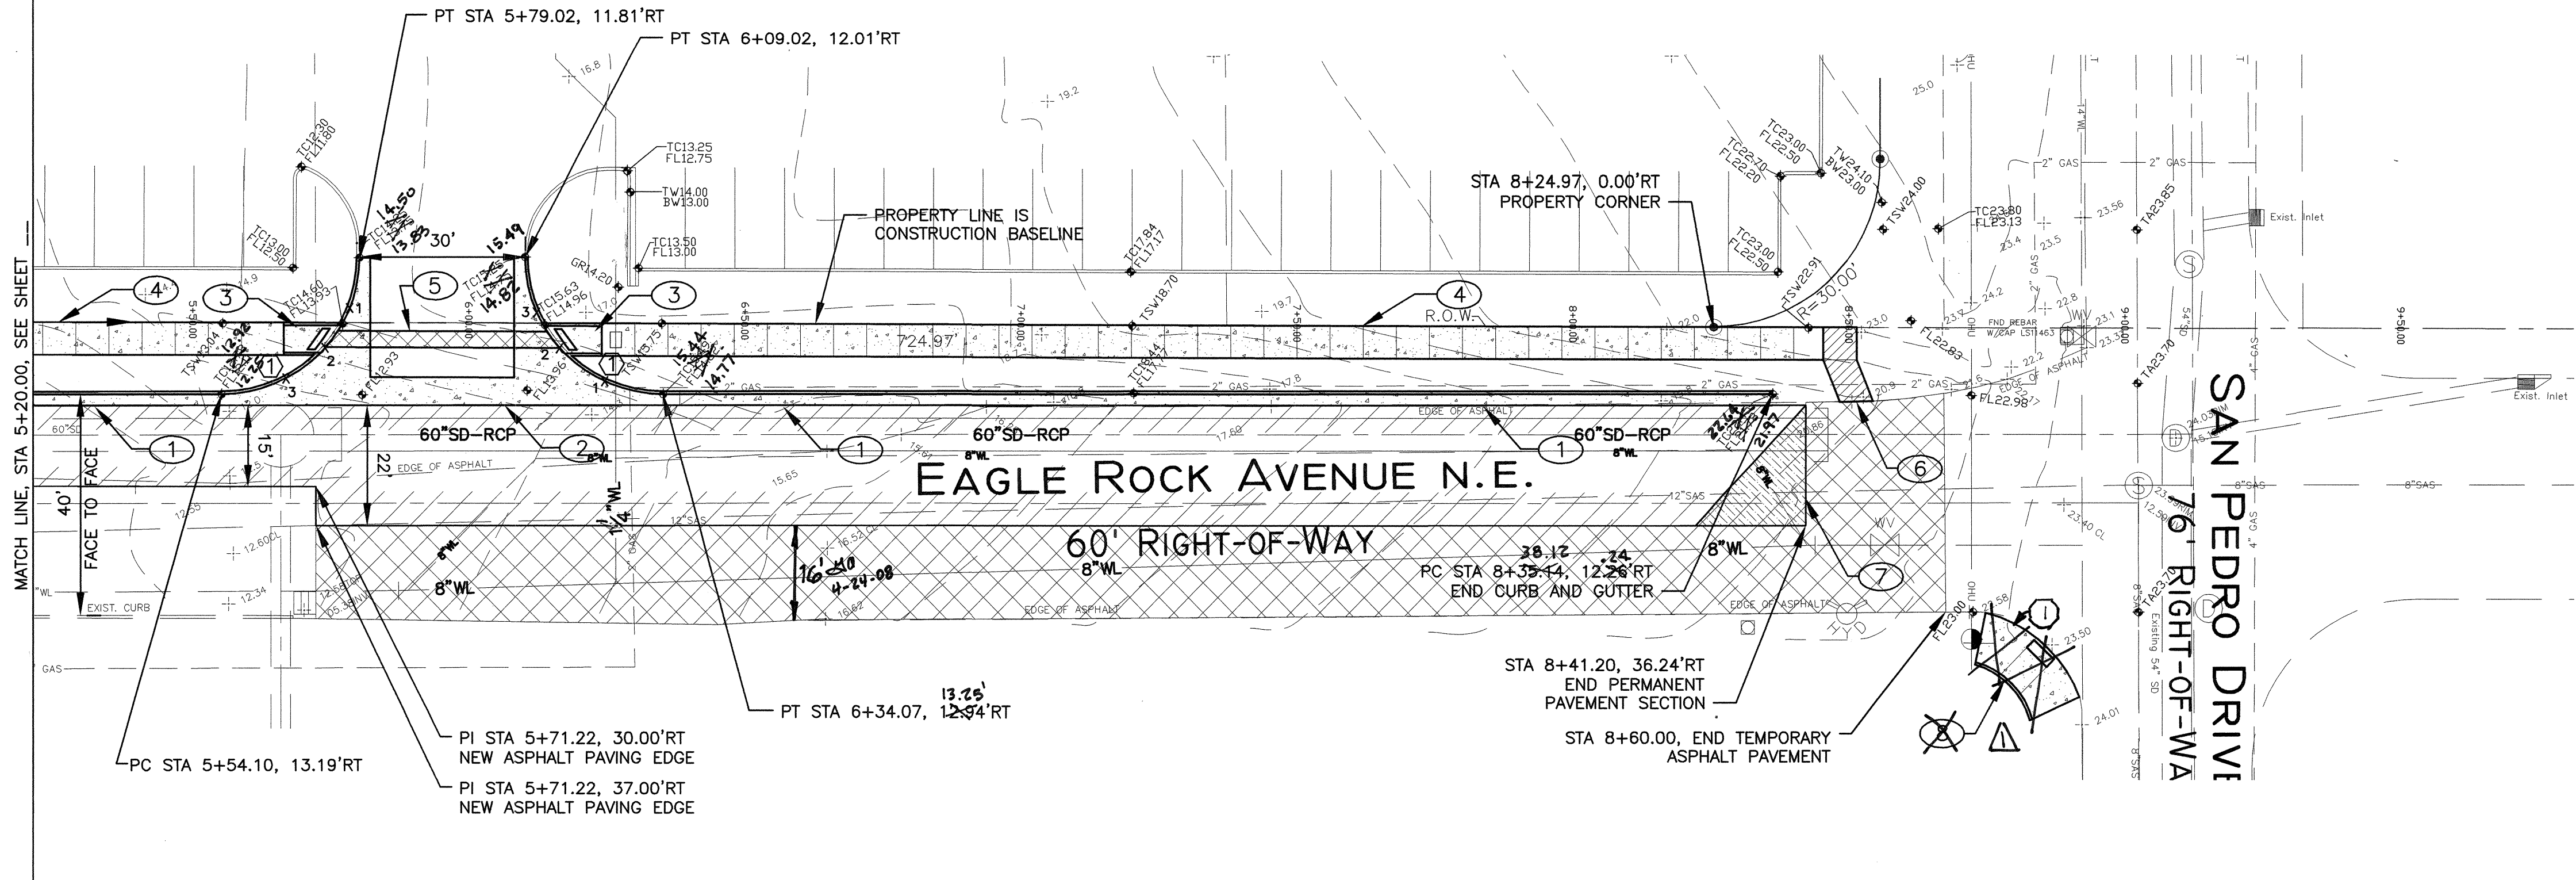


PAVING PLAN, EAGLE ROCK AVENUE NE

SCALE: 1" = 20'

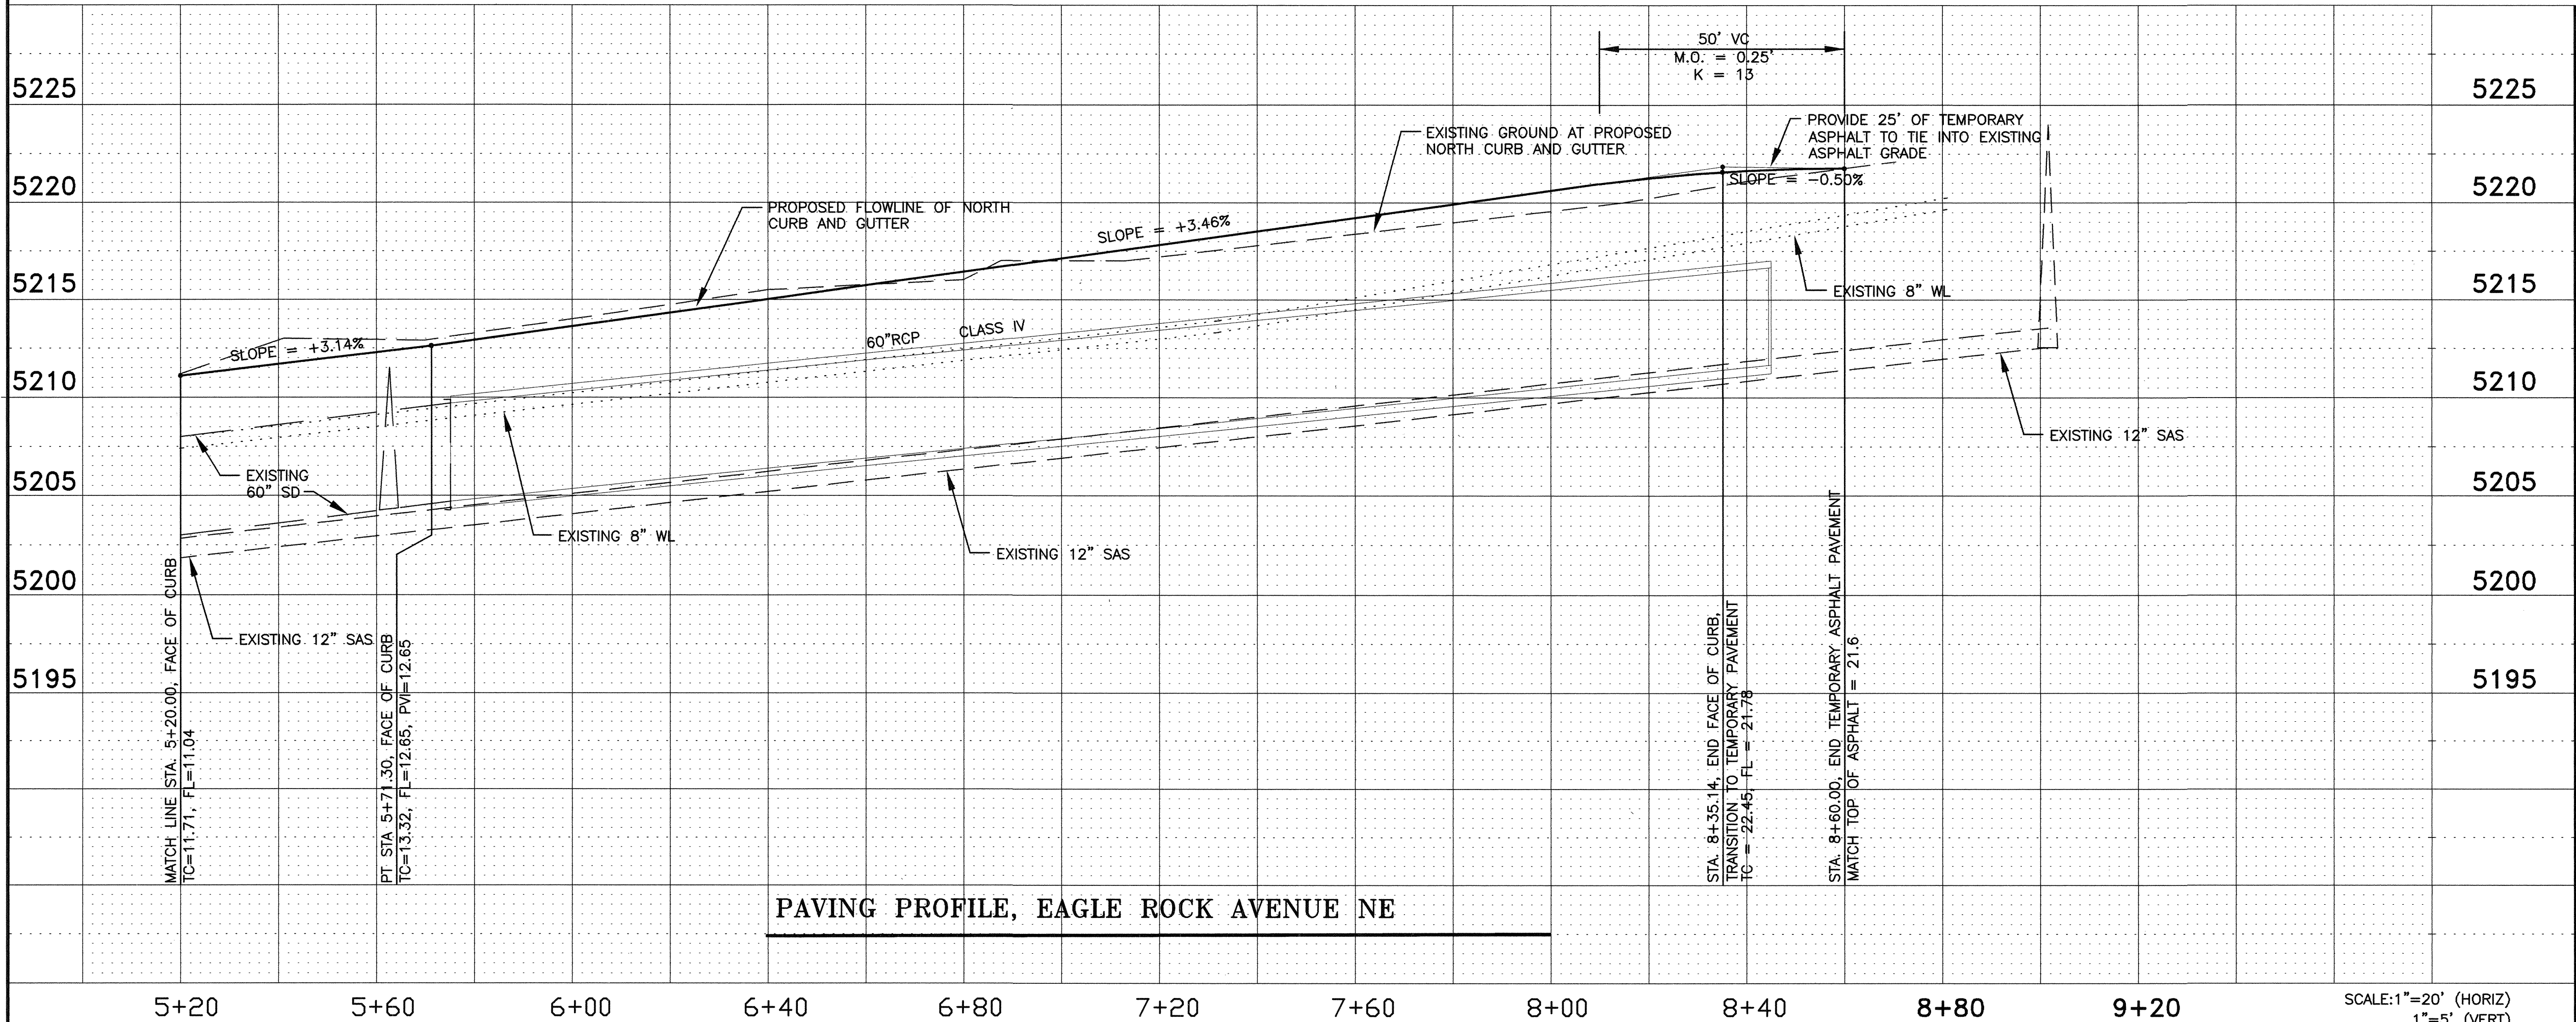


PAVING PROFILE, EAGLE ROCK AVENUE NE

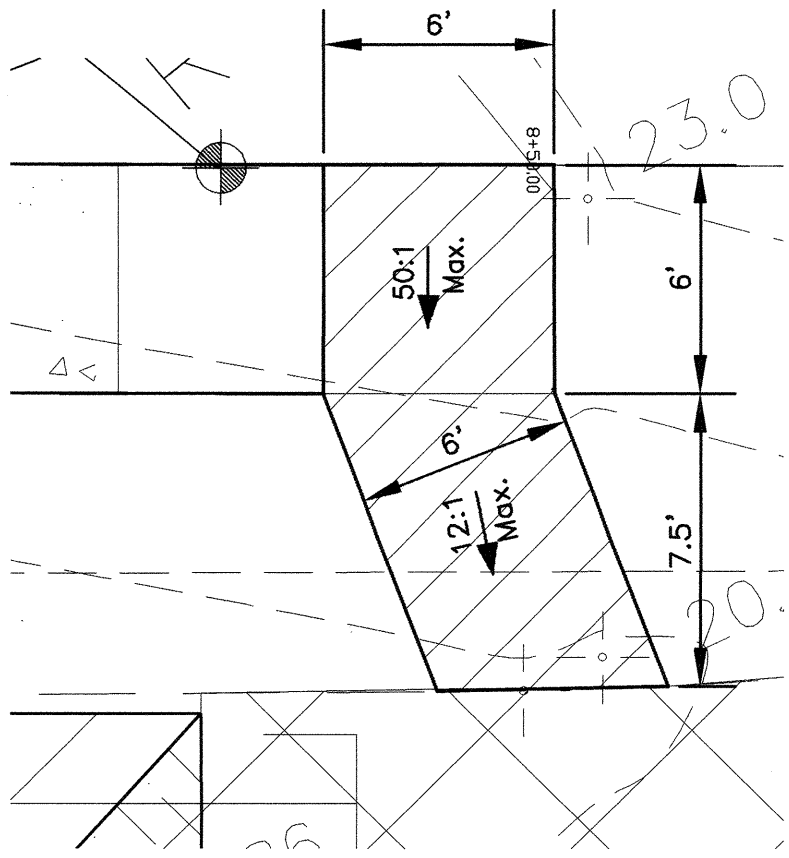

TEMPORARY WHEEL CHAIR RAMP


CONSTRUCTION NOTES:

1. CONSTRUCT STANDARD CURB & GUTTER PER COA STD. DWG. 2415A.
2. CONSTRUCT 6' WIDE CONCRETE VALLEY GUTTER PER COA STD. DWG. 2420.
3. CONSTRUCT (WHEELCHAIR) UNIDIRECTIONAL RAMPS PER COA STD. DWG. 2426 WITH THE FOLLOWING TRUNCATED DOMES:
 - * DESIGN PER ADA GUIDELINES
 - * SUBMIT SPECS TO CITY CONSTRUCTION PRIOR TO CONSTRUCTION.
4. CONSTRUCT 6' WIDE SIDEWALK PER SIDEWALK DETAILS PER COA STD. DWG. 2430.
5. PROVIDE 3' WIDE AT 2% CROSS SLOPE BETWEEN HANDICAP RAMPS FOR ADA ACCESS.
6. PROVIDE 6' WIDE TEMPORARY ASPHALT PATH 2" THICK, TYPE "B" WITH 8" SUBGRADE PREPARATION AT 95% PER CITY STD. DWG. 2415B, FOR PEDESTRIAN ACCESS, SEE TEMPORARY DETAIL THIS SHEET.
7. PROVIDE CROWN TRANSITION PER CITY STD. DWG. 2401.
8. CONSTRUCT (WHEELCHAIR) RAMP PER COA STD. DWG. 2444, CASE II WITH THE FOLLOWING TRUNCATED DOMES:
 - * DESIGN PER ADA GUIDELINES
 - * SUBMIT SPECS TO CITY CONSTRUCTION PRIOR TO CONSTRUCTION. - NOT RECD.SEE REVISION No 2 INFRASTRUCTURE LIST.

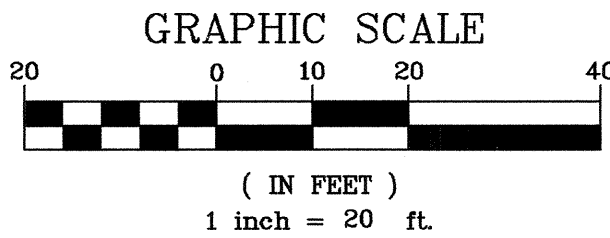

APPLIED ENGINEERING AND SURVEYING, INC.
ENGINEERS AND PLANNERS
1800 Blue Drive, NE
Albuquerque, New Mexico 87112
Office: (505) 223-1456 Fax: (505) 223-1459

CITY OF ALBUQUERQUE
PUBLIC WORKS DEPARTMENT
ENGINEERING DEVELOPMENT GROUP
TITLE: **CORLEY'S ALBUQUERQUE**
PAVING PLAN & PROFILE, EAGLE ROCK AV. NE

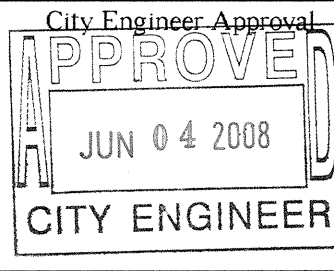


City Project No. **724582** Zone Map No. **C-18** Sheet **9** of **15**

AS BUILT INFORMATION		BENCH MARKS		SURVEY INFORMATION		ENGINEER'S SEAL	
CONTRACTOR	DATE	THE BASIS OF ELEVATIONS FOR THIS SURVEY IS ACS BENCHMARK 10-C18, THE PUBLISHED ELEVATION OF WHICH IS 5222.09, NAVD83. BENCHMARK IS LOCATED ON THE EAST RIGHT-OF-WAY OF SAN PEDRO BLVD. NE, 48' SOUTH OF THE ENTERLINE OF MODESTO AVENUE NE AT ITS INTERSECTION WITH SAN PEDRO BLVD.	NO.	BY	NO.	DATE	DATE
WORK	DATE						
STATIONED BY	DATE						
ACCEPTANCE BY	DATE						
FIELD	DATE						
DRAWINGS	DATE						
CORRECTED BY	DATE						
MICRO-FILM	DATE						
INFORMATION	DATE						



QUARTER POINT ELEV.		
	TC	FL
1	RAMP GRADE	01.81
2	02.31	01.64
3	02.19	01.52

R-VALUE SUBGRADE NOTE:
R VALUE IN ROADWAY FOR SUBGRADE MATERIAL MUST BE GREATER THAN 50, IF NOT THE CONTRACTOR SHALL REMOVE UNSUITABLE SUBGRADE MATERIAL AND IMPORT SUITABLE FILL MATERIAL TO A DEPTH OF 24" AND TO EXCEED AN R VALUE OF 50.

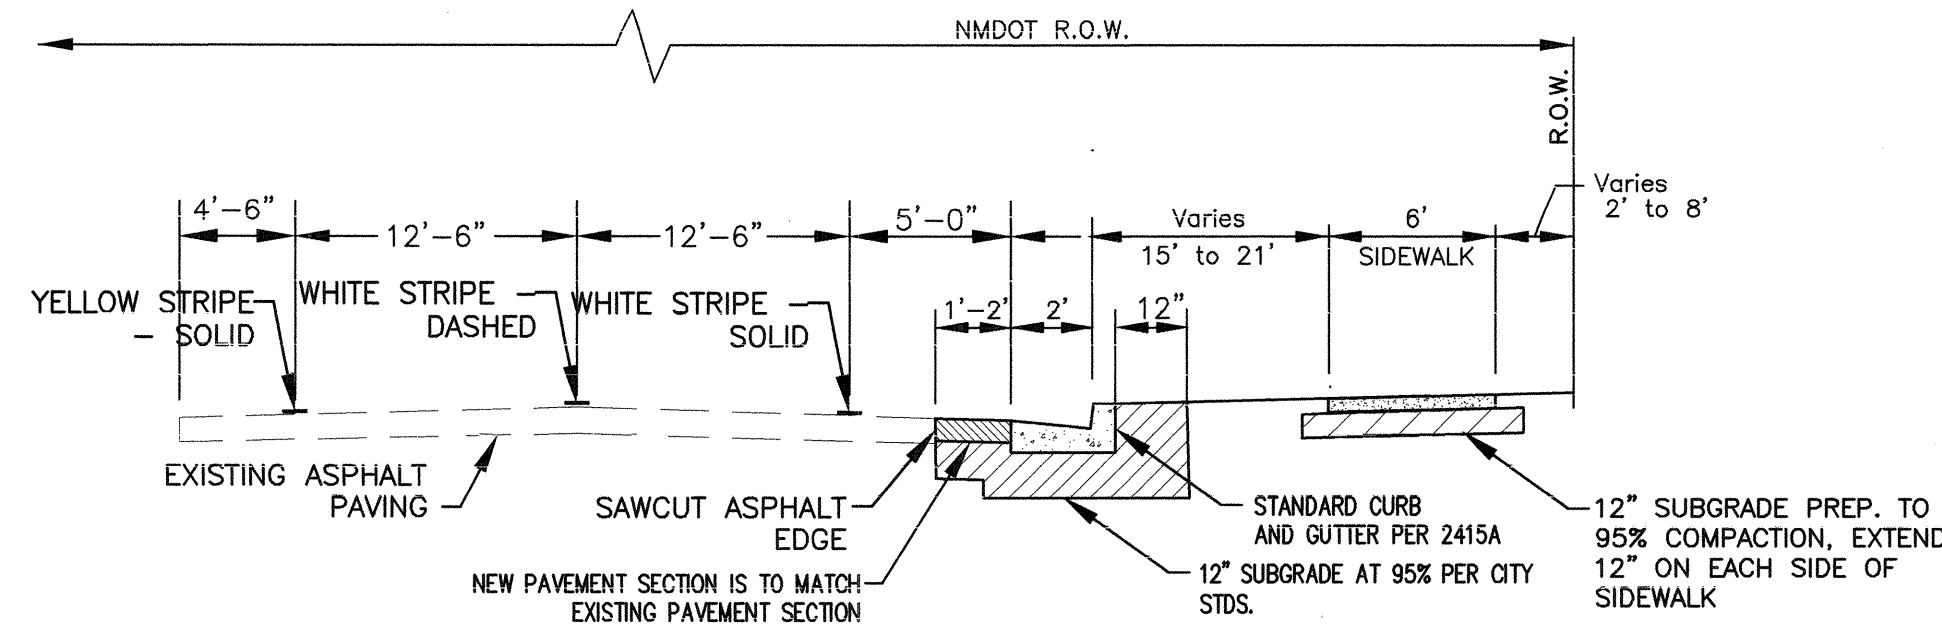

PAN AMERICAN FRONTAGE ROAD
CROSS SECTION - LOOKING NORTH

SCALE: Not to Scale

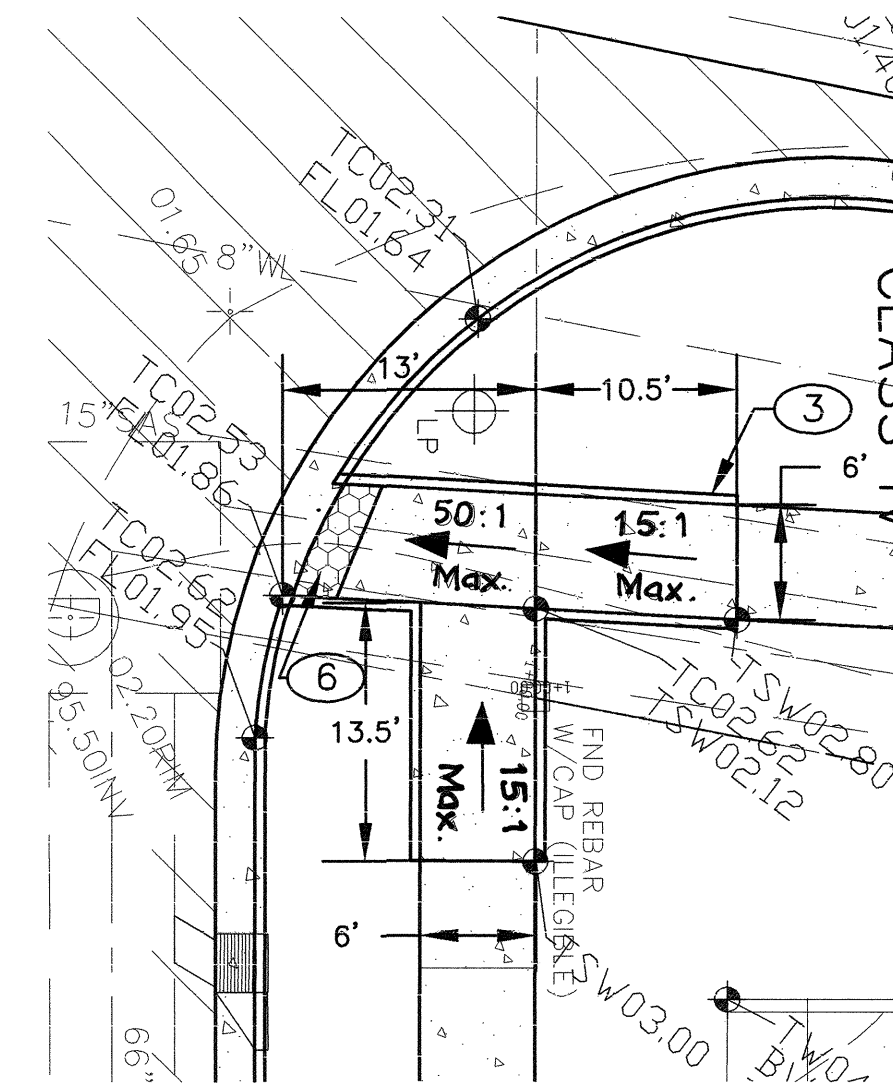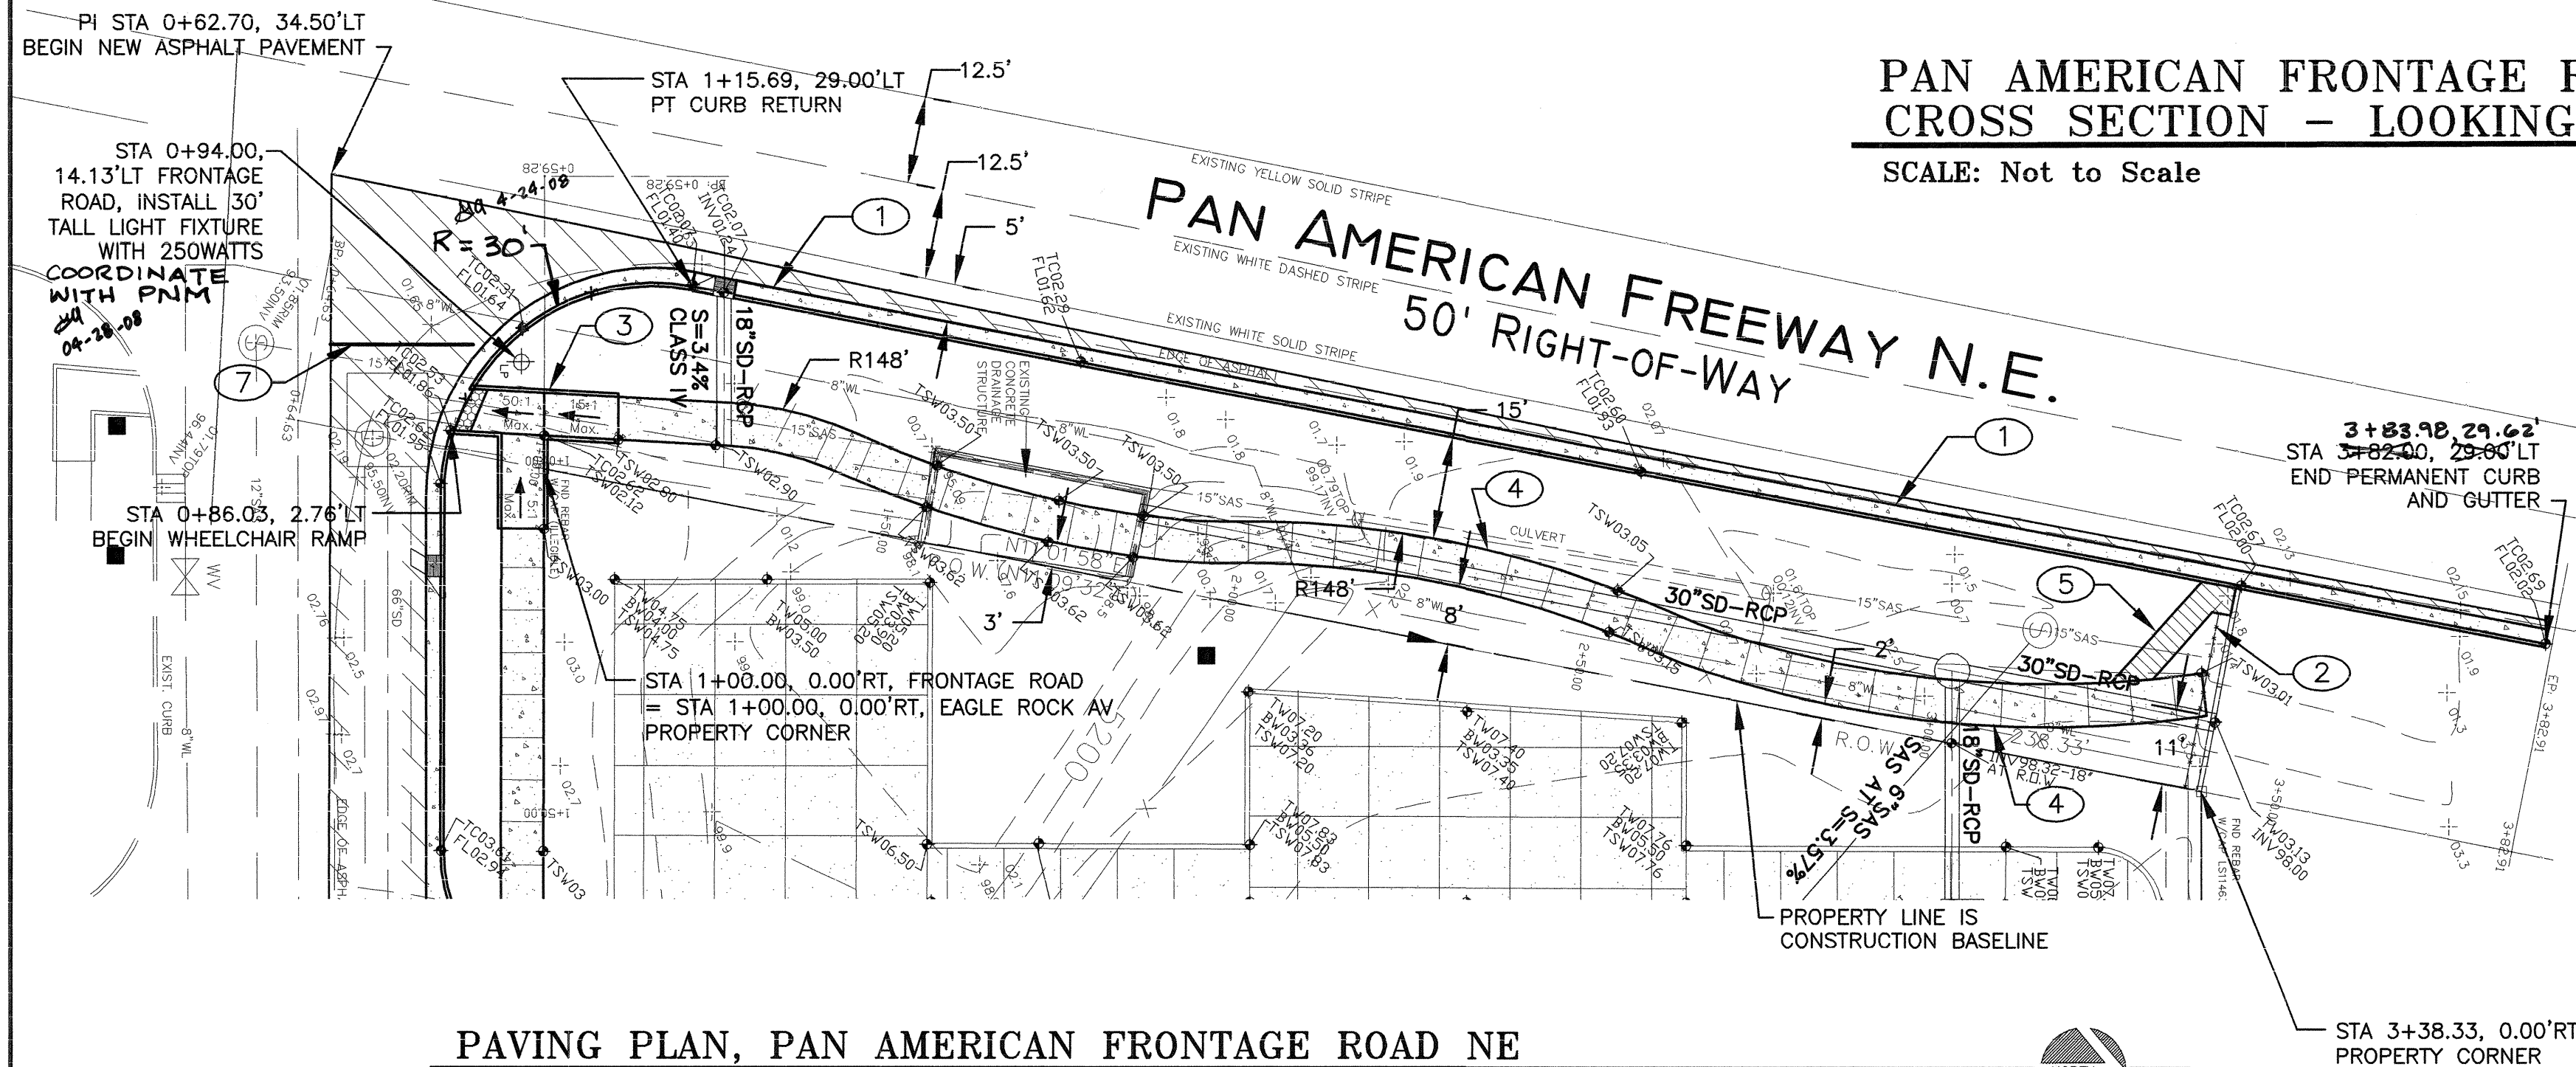


WHEELCHAIR RAMP DETAIL

SCALE: 1" = 10'

PAVING PLAN, PAN AMERICAN FRONTAGE ROAD NE

SCALE: 1" = 20'

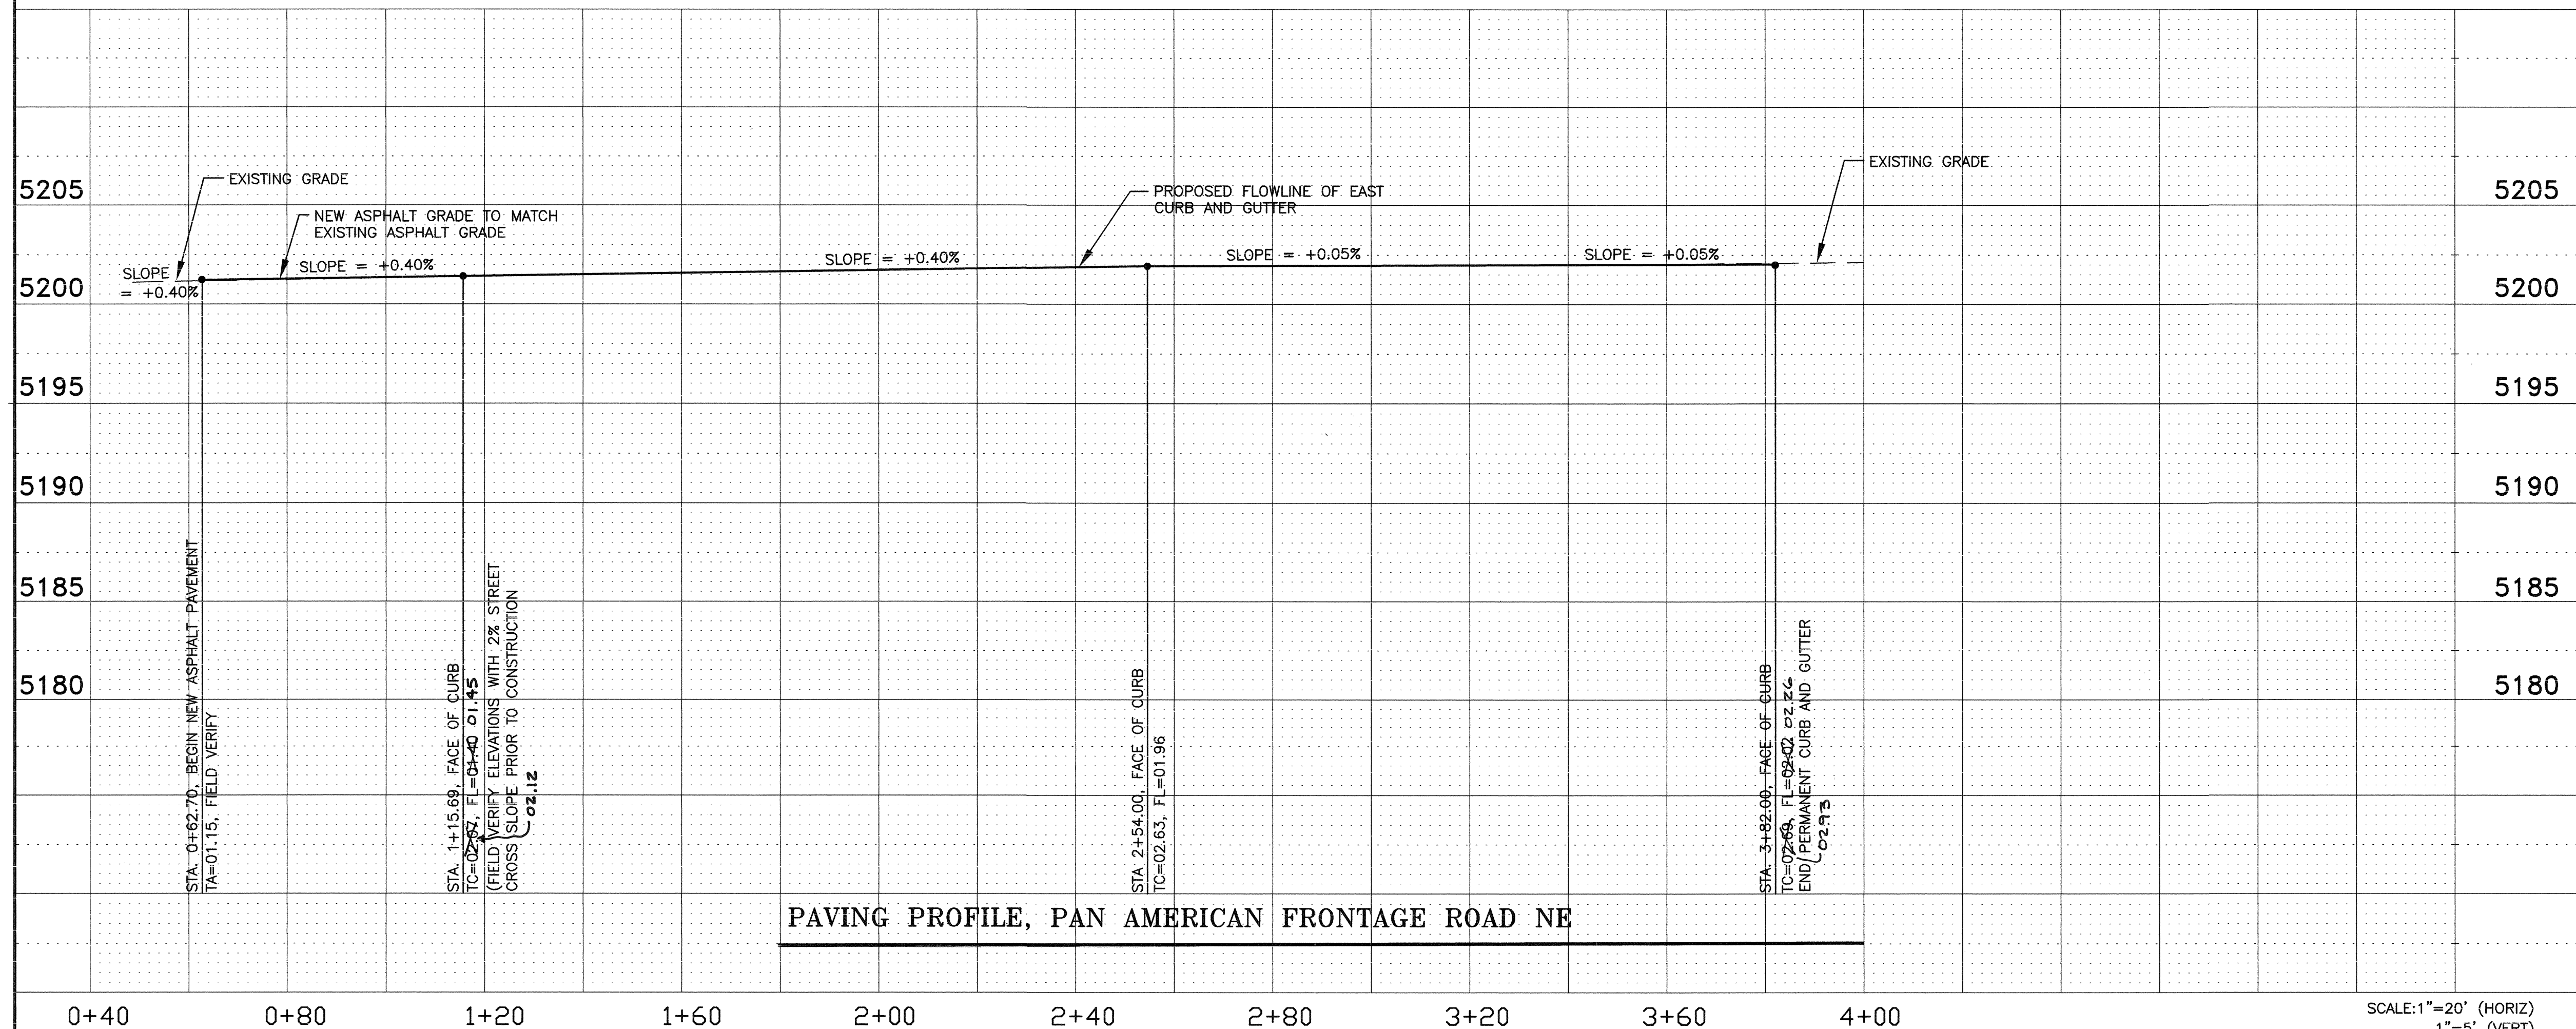


PAVING PROFILE, PAN AMERICAN FRONTAGE ROAD NE

SCALE: 1"=20' (HORIZ)
1"=5' (VERT)

CONSTRUCTION NOTES:

- ① CONSTRUCT STANDARD CURB & GUTTER PER COA STD. DWG. 2415A.
- ② ~~INSTALL 4' HIGH CHAIN LINK FENCE PER CITY OF ALBUQUERQUE STANDARD DRAWING 2252, END 2' FROM CURB LINE. SEE SHEET 14 OF 15~~
- ③ CONSTRUCT (WHEELCHAIR) CURB ACCESS RAMP, PER NEW MEXICO DEPARTMENT OF TRANSPORTATION PEDESTRIAN SPECIFICATIONS AND ACCESS DETAILS SHOWN.
- ④ CONSTRUCT 6' WIDE SIDEWALK PER SIDEWALK DETAILS PER COA STD. DWG. 2430.
- ⑤ PROVIDE 4' WIDE TEMPORARY ASPHALT PATH 2" THICK, TYPE "B" WITH 8" SUBGRADE PREPARATION AT 95% [ER CITY STD. DWG. 2415B, FOR PEDESTRIAN ACCESS AROUND CULVERT HEADWALL.
- ⑥ DETECTABLE WARNING SURFACE PER NMDOT SPECIFICATIONS.
- ⑦ INSTALL 12" WHITE STOP BAR - HOT THERMOPLASTIC PAVEMENT MARKING.

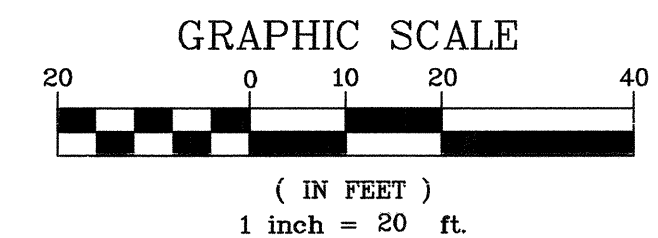

**APPLIED ENGINEERING AND
SURVEYING, INC.**
ENGINEERS AND PLANNERS

CITY OF ALBUQUERQUE
PUBLIC WORKS DEPARTMENT
ENGINEERING DEVELOPMENT GROUP

TITLE: CORLEY'S ALBUQUERQUE
PAVING PLAN, FRONTAGE ROAD NE

Design Review Committee
APPROVE
MAY 15 2008
DESIGN
REVIEW COMMITTEE
City Project No.

CITY ENGINEER APPROVAL

JUN 04 2008

CITY ENGINEER

Last Design Update






Mo./Day/Yr.	Mo./Day/Yr.

Sheet
10
Of
15

SURVEY INFORMATION		BENCH MARKS	AS BUILT INFORMATION	
NO.	FIELD NOTES		CONTRACTOR	DATE
	THE BASIS OF ELEVATIONS FOR THIS SURVEY IS ACS BENCHMARK 10-C18. THE PUBLISHED ELEVATION OF WHICH IS 5222.09' NAVD83. BENCHMARK IS LOCATED ON THE EAST RIGHT-OF-WAY OF SAN PEDRO BLVD. NE, 48' SOUTH OF THE ENTERLINE OF MODESTO AVENUE NE AT ITS INTERSECTION WITH SAN PEDRO BLVD.		WORK INSPECTED BY <i>Terza</i>	<i>DATE 12/08</i>
			ACCEPTANCE BY <i>Applied Engr</i>	<i>DATE 12/08</i>
			VERIFICATION BY <i>Applied Engr</i>	<i>DATE 12/08</i>
			DRAWINGS BY <i>Applied Engr</i>	<i>DATE 12/08</i>
			MICRO-FILM INFORMATION	
			RECORDED BY	DATE
			NO.	


ENGINEER'S SEAL

NO.	DATE	REMARKS	BY
<i>REVISIONS</i>			
<i>DESIGN</i>			
DESIGNED BY		DATE	
DRAWN BY		DATE	

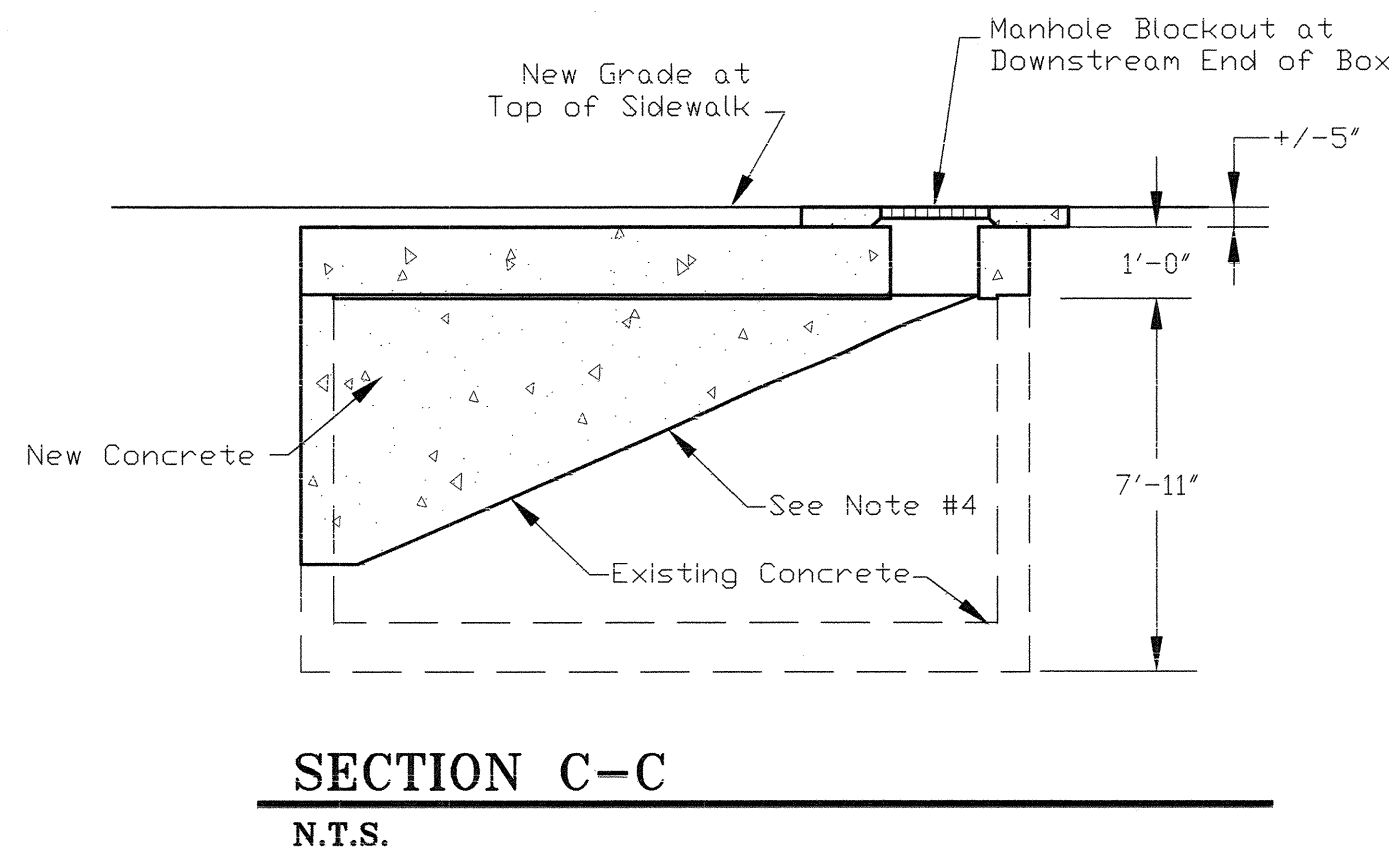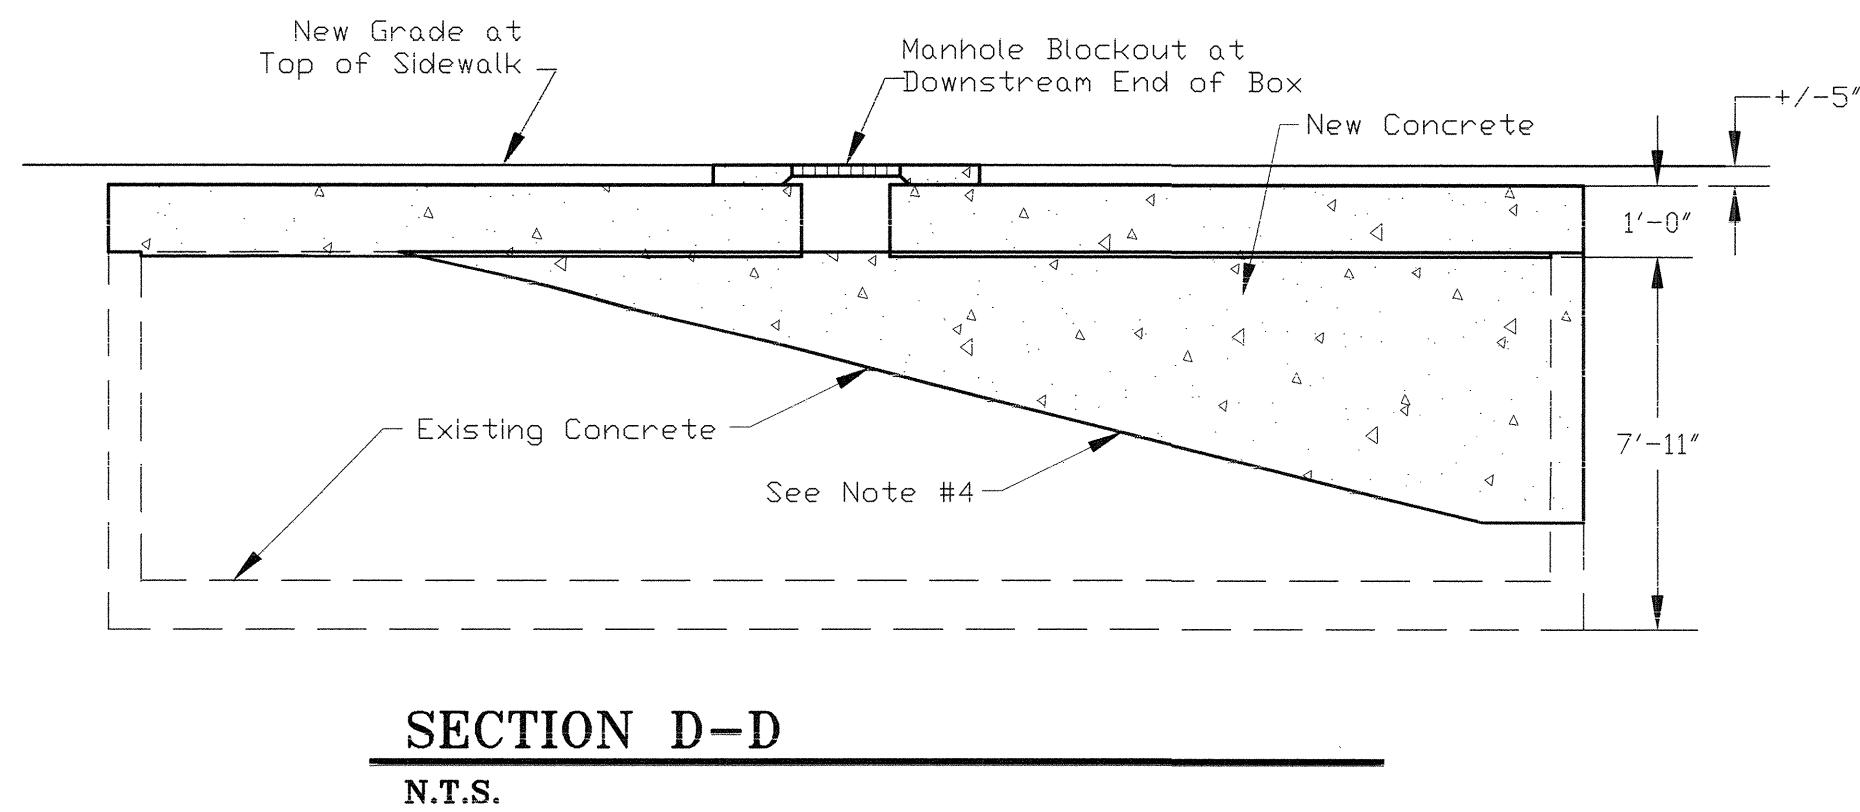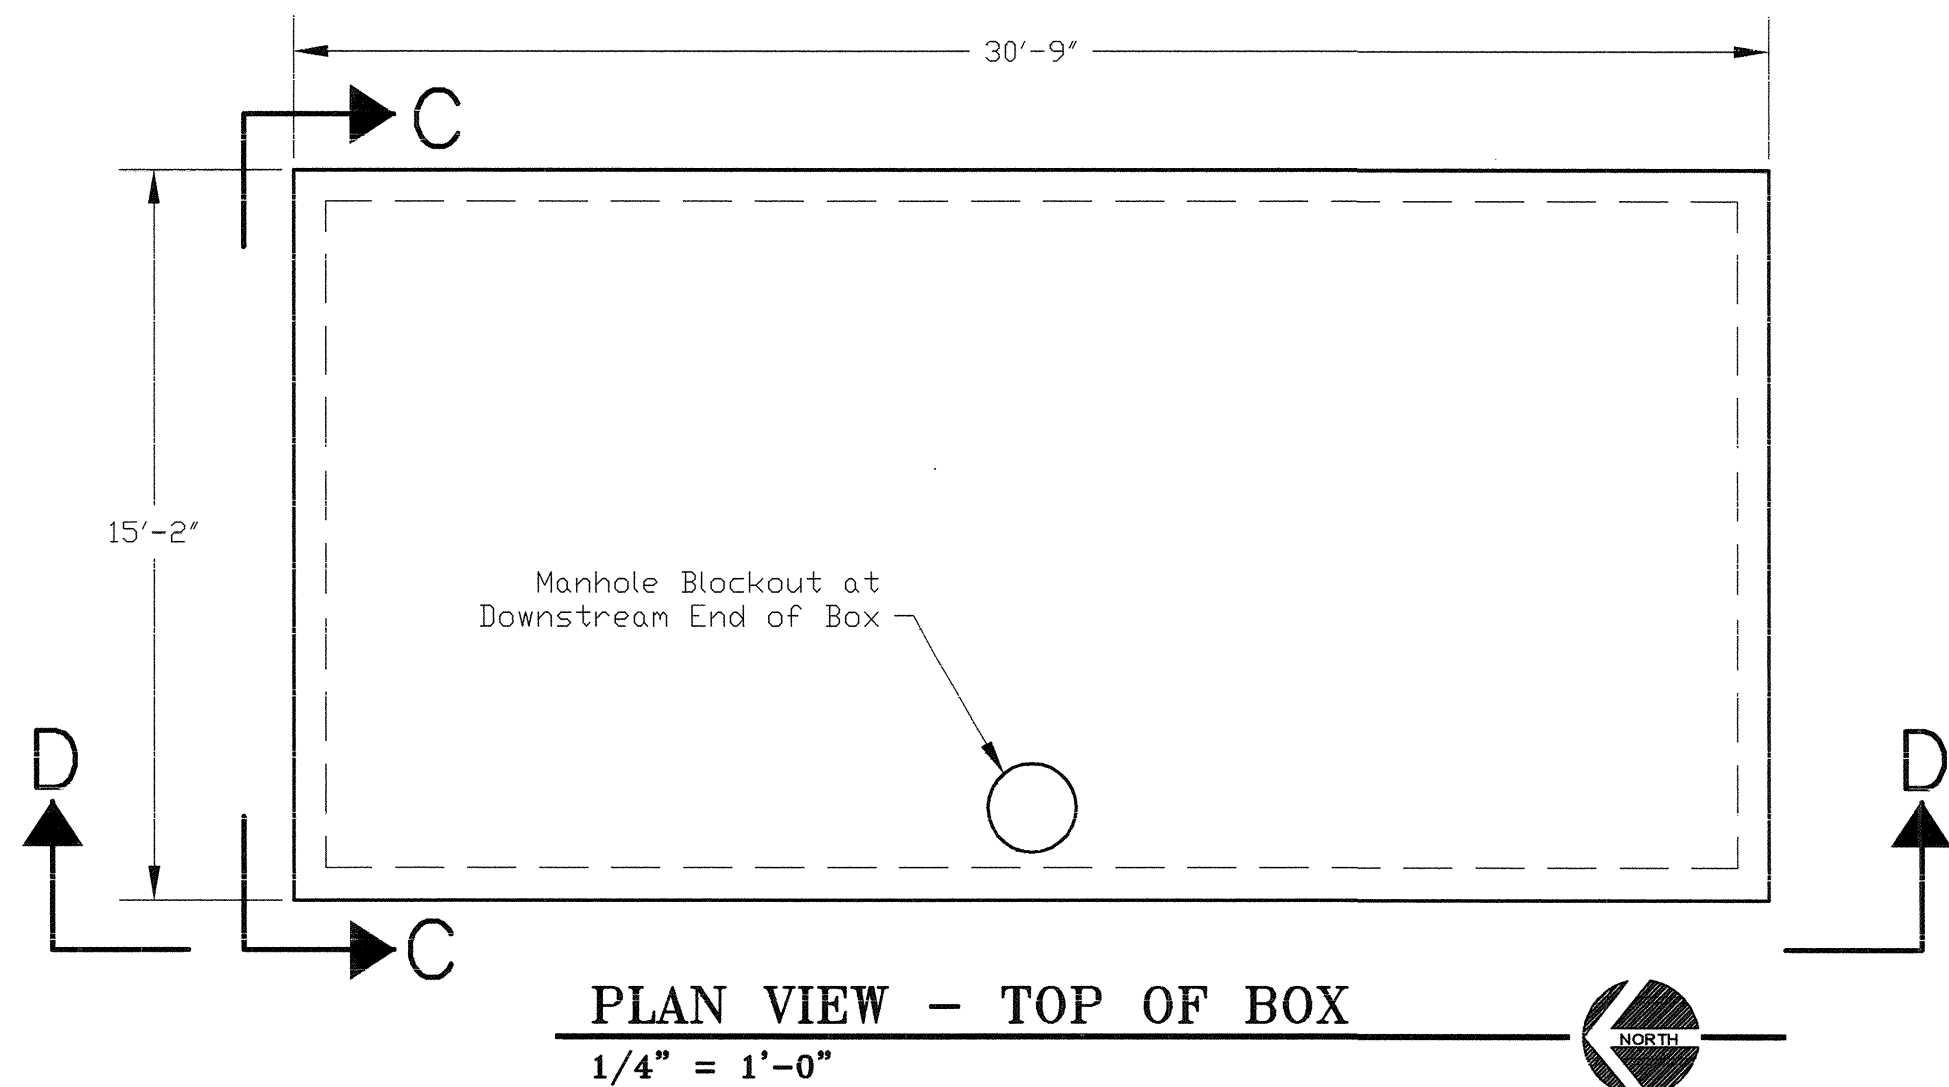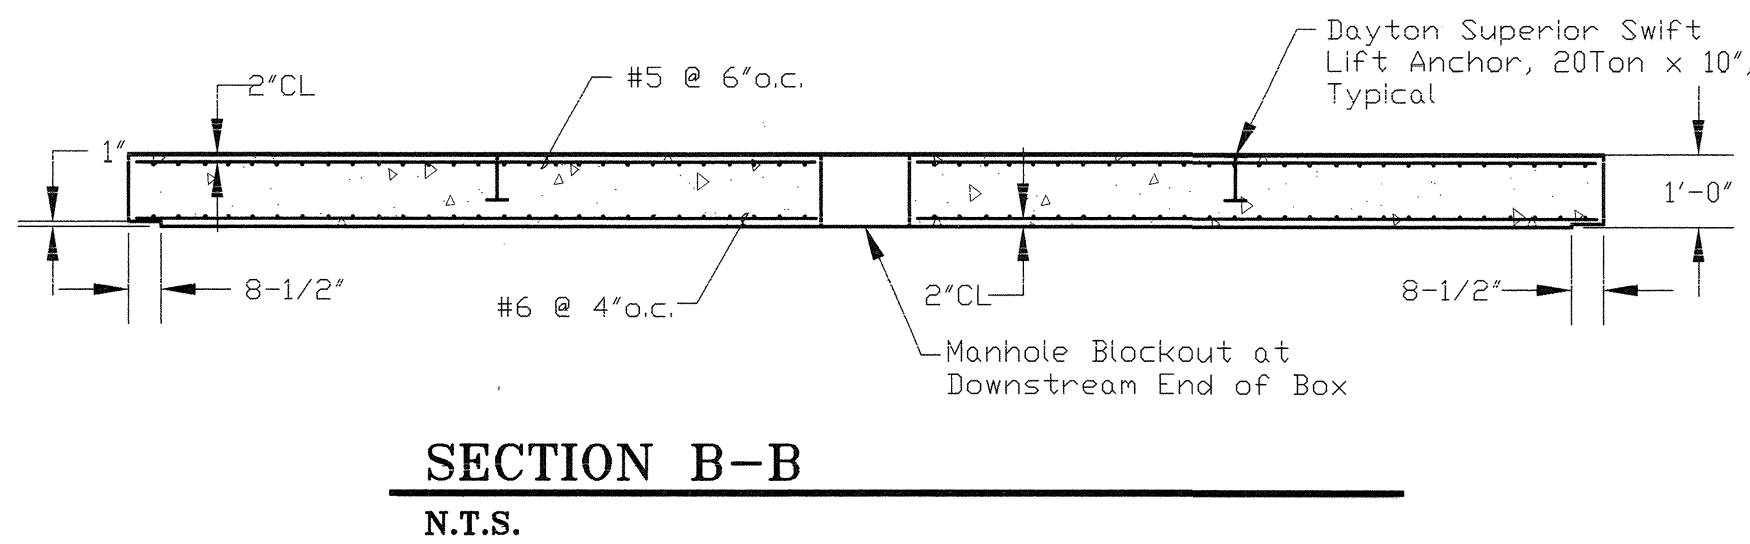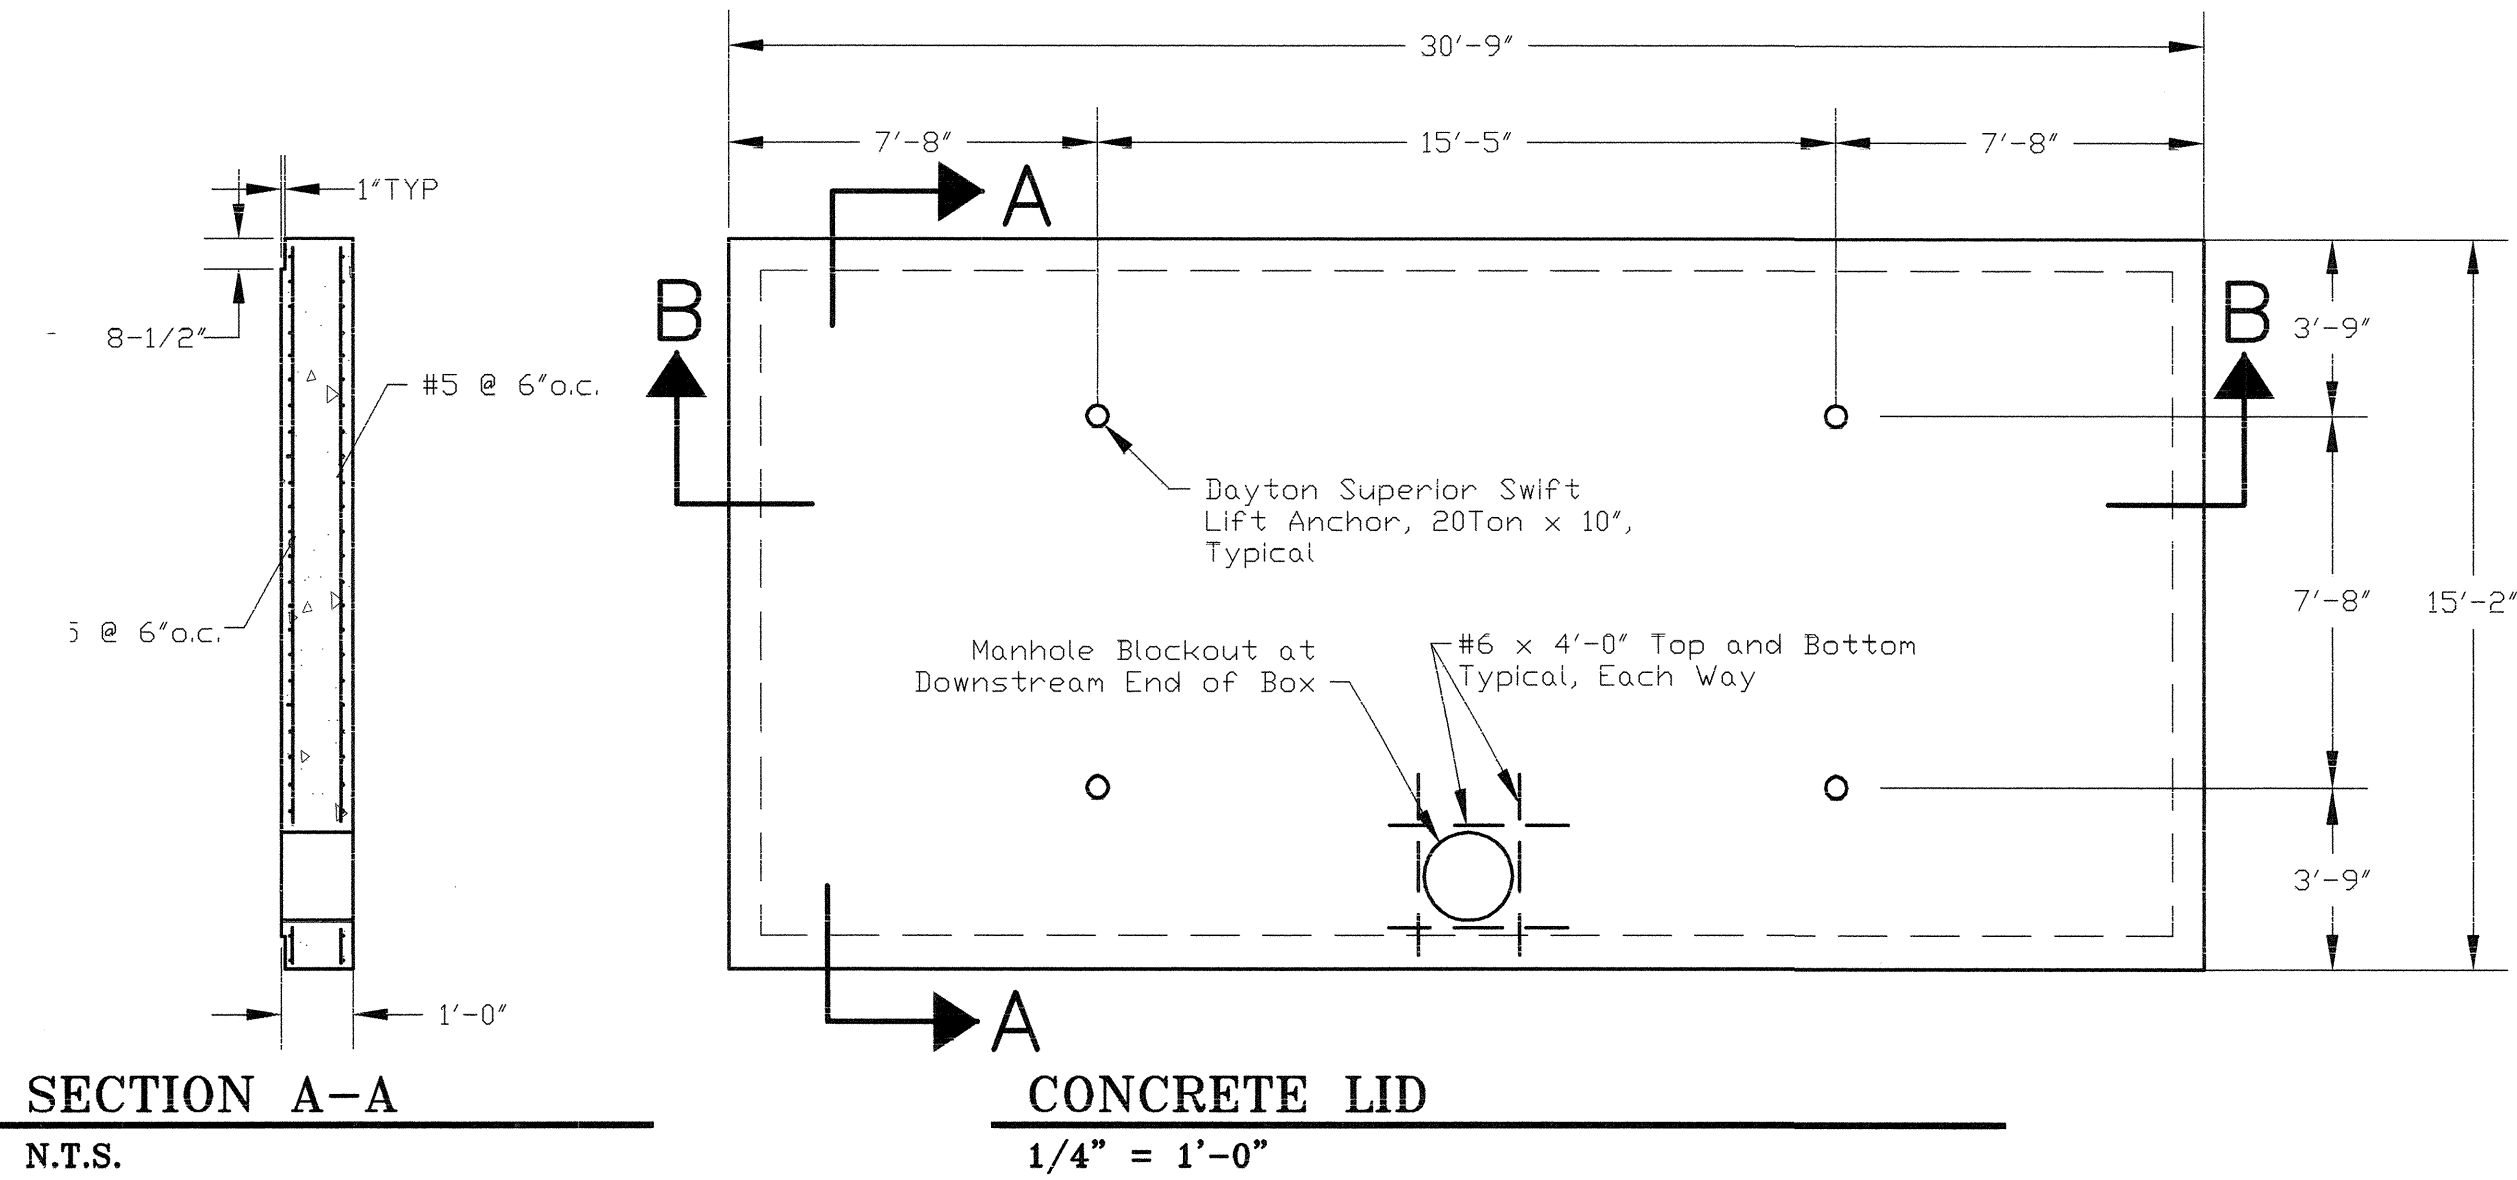


CONSTRUCTION NOTES:

1. CONTRACTOR TO VERIFY ALL DIMENSION OF EXISTING BOX CULVERT PRIOR TO CONSTRUCTION. IF ANY DIMENSIONS VARY FROM THE DIMENSIONS SHOWN ON THIS PLAN CONTRACTOR TO CONTACT ENGINEER.
2. ALL CONCRETE SHALL BE 4000psi.
3. ALL REBAR SHALL BE 60ksi.
4. REMOVE CONCRETE TO EXPOSE VERTICAL AND HORIZONTAL #5 REBAR. SPLICE INTO EXPOSED VERTICAL AND HORIZONTAL REBAR USING DAYTON SUPERIOR BAR LOCK COUPLERS, #5s @ 6"o.c., EXTEND #5 REBAR TO TOP AND ENDS OF CONCRETE BOX. AT THE CORNER, SUPPLY #5 CORNER BAR WITH 24" BAR LAP WITH STRAIGHT BARS. THOROUGHLY CLEAN EXPOSED CONCRETE AND APPLY DAYTON SUPERIOR RESI-BOND (J-58). WHILE RESI-BOND IS STILL TACKY, PLACE FRESH, 4000psim CONCRETE TO COMPLETE 8" WALLS OF BOX STRUCTURE.

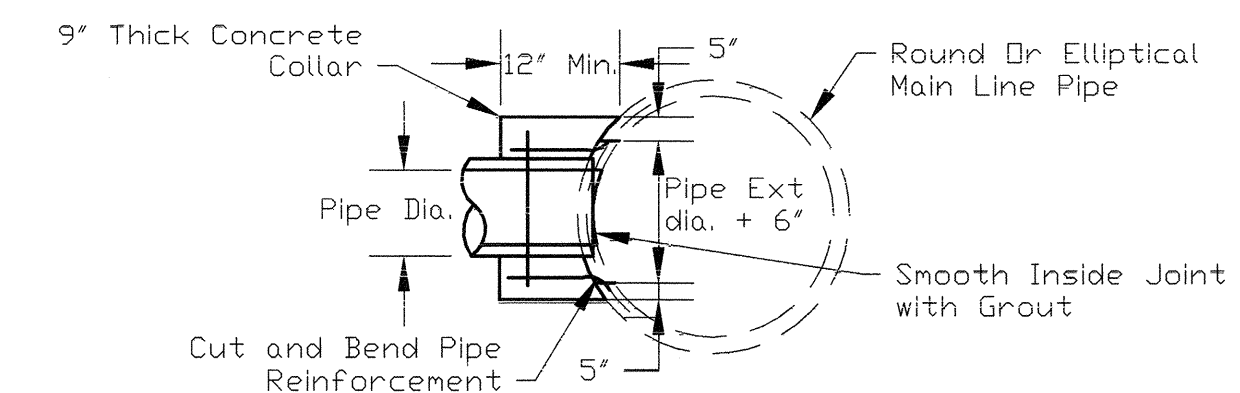

**CONCRETE COLLAR FOR JOINING
MAINLINE PIPE AND STUB PIPE**
N.T.S.

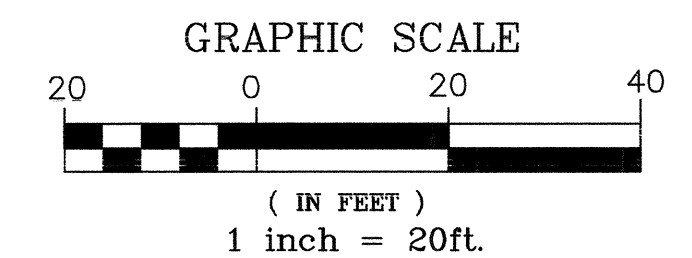

APPLIED ENGINEERING AND SURVEYING, INC. ENGINEERS AND PLANNERS 1525 Bluff Drive NE Albuquerque, New Mexico 87112 Office: (505) 237-1456 Fax: (505) 237-1456	
CITY OF ALBUQUERQUE PUBLIC WORKS DEPARTMENT ENGINEERING DEVELOPMENT GROUP	
TITLE: BOX STRUCTURE ON PAN AMERICA RD CORLEY'S ALBUQUERQUE	
Design Review Committee APPROVE MAY 15 2008 DESIGN REVIEW COMMITTEE	City Engineer Approval APPROVE JUN 04 2008 CITY ENGINEER
City Project No. 724582	Zone Map No. C-18
Sheet 12	Of 15

AS BUILT INFORMATION		BENCH MARKS		SURVEY INFORMATION		ENGINEER'S SEAL	
CONTRACTOR	DATE	THE BASIS OF ELEVATIONS FOR THIS SURVEY IS ACS BENCHMARK 10-C18. THE PUBLISHED ELEVATION OF WHICH IS 5222.09. NAVD88. BENCHMARK IS LOCATED ON THE EAST RIGHT-OF-WAY OF SAN PEDRO BLVD. NE, 48' SOUTH OF THE ENTERLINE OF MODESTO AVENUE NE AT ITS INTERSECTION WITH SAN PEDRO BLVD.	NO.	BY	NO.	BY	NO.
STARTED BY	DATE						
ACCEPTED BY	DATE						
FIELD CHECKED BY	DATE						
DRAWN BY	DATE						
CHECKED BY	DATE						
RECORDED BY	DATE						
NO.							

PERMANENT SIGNING & STRIPING NOTES

1. ALL REGULATORY, WARNING, SPECIAL, AND GUIDE SIGNS SHALL COMPLY WITH THE FOLLOWING REQUIREMENTS:

SIGN	SIGN CODE	COLOR	LETTER SHEETING	BACKGROUND SHEETING
STOP	R1-1	(W/RED)	TYPE VIII OR IX	TYPE VIII OR IX
YIELD	R1-2	(W/RED)	TYPE VIII OR IX	TYPE VIII OR IX
DO NOT ENTER	R5-1	(W/RED)	TYPE VIII OR IX	TYPE VIII OR IX
WRONG WAY	R5-1a	(W/RED)	TYPE VIII OR IX	TYPE VIII OR IX
SCHOOL BUS SIGN	S3-1	(BLK/FLOURESCENT YELLOW GREEN)	TYPE VIII OR IX	TYPE VIII OR IX
SCHOOL BUS XING	S1-1	(BLK/FLOURESCENT YELLOW GREEN)	TYPE VIII OR IX	TYPE VIII OR IX
PEDESTRIAN XING	W11-2	(BLK/FLOURESCENT YELLOW GREEN)	TYPE VIII OR IX	TYPE VIII OR IX
BIKE XING	W11-1	(BLK/FLOURESCENT YELLOW GREEN)	TYPE VIII OR IX	TYPE VIII OR IX
ALL SCHOOL/PED/BIKE SUPPLEMENTAL PLAQUES		(BLK/FLOURESCENT YELLOW GREEN) WHEREVER BLK/YELLOW IS SPECIFIED AS COLOR IN MUTCD	TYPE VIII OR IX	TYPE VIII OR IX
ALL OTHER WARNING SIGNS & SUPPLEMENTAL PLAQUES		(BLK/FLOURESCENT YELLOW) WHEREVER BLK/YELLOW IS SPECIFIED AS COLOR IN MUTCD	TYPE VIII OR IX	TYPE VIII OR IX
GUIDE & DESTINATION SIGNS INCLUDE EXTRUDED & NON-EXTRUDED (OVERHEAD & GROUND MOUNTED)	ALL	(W/GREEN) EXCEPT WHERE SPECIFIED IN THE MUTCD	TYPE VIII OR IX	TYPE IV
E-CODE SIGNS	E 11-1, 1a, 1b, 1c	(BLK/FLOURESCENT YELLOW)	TYPE VIII OR IX	TYPE IV
RECREATIONAL & CULTURAL INTERESTS	ALL	(W/BROWN)	TYPE VIII OR IX	TYPE IV
GENERAL SERVICE	ALL	(W/BBLUE)	TYPE VIII OR IX	TYPE IV
SPECIFIC SERVICE	ALL	(W/BBLUE)	TYPE VIII OR IX	TYPE IV
ALL OTHER PERMANENT SIGNS		(BLK/WHITE) EXCEPT WHERE SPECIFIED OTHERWISE IN THE MUTCD	TYPE IV	TYPE IV

12. SIGN POSTS SHALL BE SQUARE TUBING AS APPROVED BY THE PROJECT MANAGER OR THE DISTRICT TRAFFIC ENGINEER.
13. CONTRACTOR SHALL FIELD VERIFY ALL SIGNING INFORMATION, TEXT, AND LOCATIONS PRIOR TO FABRICATION AND INSTALLATION. NEW SIGN LOCATIONS SHALL BE APPROVED BY THE PROJECT MANAGER OR THE DISTRICT TRAFFIC ENGINEER.
14. HOT THERMOPLASTIC PAVEMENT MARKING SHALL BE USED ON ALL STRIPING (LONG LINES, LEGENDS, SYMBOLS, ETC.). THE THERMOPLASTIC PAVEMENT MARKING SHALL BE APPLIED AT A THICKNESS OF 120 MIL.
15. WATER BLASTING IS THE ONLY APPROVED METHOD OF EXISTING STRIPE REMOVAL WITHIN DISTRICT THREE. THE USE OF BLACK PAINT AS A METHOD OF REMOVING OR COVERING EXISTING STRIPING IS STRICTLY PROHIBITED

January 29, 2007

- 3 – The Department will require certified test reports per Subsection 402.21. PG binders and aggregate gradation may require adjustment from that shown in approved mix design to account for stopped or slow speed traffic.
- 4 – Type I only
- 5 – 4500 tons or less at the Department's discretion
- 6 – Greater than 4500 tons at the Department's discretion

In addition, all sections of Division 700 – Traffic Control Devices may apply, especially to driveway permits for commercial improvements.

In general, the pay factor charts and acceptance limits that are provided in the specifications will be modified for the driveway permit application process and offsite improvements. **It is the applicant's responsibility to obtain any revisions from the District Traffic Engineer prior to soliciting bids for the work to be performed.**

MATERIALS
Materials that have currently approved NMDOT mix designs and component material sources must be used for the proposed improvements. Manufactured materials and components must be on the current Approved Products List.
The approval status of mix designs and material sources can be obtained from the NMDOT State Materials Bureau or the respective District. The current Approved Products List can be obtained from the NMDOT State Maintenance Bureau.

SAMPLING AND TESTING
Material sampling and testing shall be performed by laboratories on the Department's approved list and technicians that are TTCP (Technician Training and Certification Program) registered. A current listing of approved laboratories may be obtained from the NMDOT State Materials Bureau, and current registered technicians can be verified with ACNM (Associated Contractors of New Mexico). All test results shall be sealed and signed by a professional engineer licensed to practice in New Mexico.

Material tests shall be provided at the frequencies noted in the specifications for the material being placed. Failure of the applicant to perform the required testing or use testing methods that do not follow approved procedures will cause the driveway permit application or offsite improvements to be subject to rejection as determined by the District Traffic Engineer.

ACCEPTANCE
Acceptance testing will usually be the responsibility of the applicant, but in some cases the Department may perform this function.
For manufactured items the applicant shall submit certificates of compliance for review and approval before inclusion in the proposed improvements.
Upon completion of the proposed improvements the applicant shall submit results of required materials tests to the District Lab Supervisor. Results and test methods will be analyzed to verify compliance with the acceptable limits in the specifications or the modifications noted in this guide.

2

January 29, 2007

PERMANENT SIGNING & STRIPING NOTES (CON'T)

2. ONLY 0.125 INCHES THICK ALUMINUM PANEL SIGNS ARE PERMITTED FOR WARNING AND REGULATORY SIGNS.
3. ANTI GRAFFITI COATING SHALL BE APPLIED ON ALL REGULATORY, WARNING, GUIDE, AND SPECIAL SIGNS.
4. QUANTITIES MAY VARY AS FIELD CONDITIONS DICTATE. THE CONTRACTOR WILL BE PAID FOR ACTUAL QUANTITIES USED.
5. ALL TRAFFIC CONTROL DEVICES SHALL COMPLY WITH N.M. STANDARD SPECIFICATIONS FOR HIGHWAY AND BRIDGE CONSTRUCTION (LATEST EDITION) AND ANY APPLICABLE SPECIAL PROVISION AND/OR SUPPLEMENTAL SPECIFICATION. ALSO THE DEVICES SHALL COMPLY WITH CURRENT EDITION, WITH REVISIONS, OF THE MUTCD.
6. EACH SIGN FACE SHOWN ON PLANS SHALL MEET THE SPECIFICATIONS IN THE STANDARD HIGHWAY SIGNS MANUAL (CURRENT EDITION) FOR PROPER ARRANGEMENT, SPACING OF LETTERS, LETTER HEIGHT, SYMBOLS AND BORDERS FOR THE SPECIFIED SIZE AND MESSAGE AS SHOWN ON PLANS.
7. POST LENGTHS ARE BASED ON A MINIMUM OF 5 FT FOR RURAL ROADWAY SECTIONS TO A MINIMUM OF 7 FT FOR URBAN AND INTERSTATE ROADWAY SECTIONS. THE LENGTHS ARE MEASURED FROM THE BOTTOM OF THE SIGN TO NEAR EDGE OF THE DRIVING LANE.
8. THE LATERAL CLEARANCE OF SIGNS SHALL BE NO CLOSER THAN THE 6 FT FROM THE EDGE OF SHOULDER OR 12 FT FROM THE EDGE OF TRAVELED WAY FOR RURAL AREAS AND NO CLOSER THAN 2 FT FROM FACE OF CURB FOR URBAN AREAS.
9. ALL SIGNING HARDWARE, INCLUDING BRACKETS, (FOR MOUNTING ALL STREET NAME SIGNS, W1-3-18 BACK TO BACK MOUNTING, ETC.) ARE CONSIDERED INCIDENTAL TO SIGN INSTALLATION. THEREFORE, NO PAYMENT WILL BE MADE.
10. THREE 4 LB/FT SIGN POST INSTALLATION APPROVED ONLY IF THE SPAN BETWEEN THE OUTER POSTS EXCEEDS 84" (SIGN WIDTH OF 96" OR GREATER).
11. 3'- 6" BASE POSTS ARE REQUIRED FOR ALL SMALL SIGN POSTS. SEE STANDARD DRAWING 701-02-1/3 FOR DETAILS.

NMDOT District Three
Construction and Material Requirements for Developer Built
Improvements within NMDOT Rights-of-Way

The following guidelines are to provide information on NMDOT construction requirements for private parties, developers, and local governments that are building property improvements that require a driveway permit application in accordance with 18.31.6 NMAC, *State Highway Access Management Requirements*, and for off-system improvements required to mitigate impacts to the state highway system. It is the applicant's responsibility to ensure a contractor is hired that can construct the proposed improvements in accordance with the NMDOT's specifications and standard drawings

SPECIFICATIONS
The applicant shall comply with the requirements of the NMDOT's Standard Specifications for Highway and Bridge Construction (Current Edition), Standard Drawings, and any revisions provided by the District Traffic Engineer. The current specifications have an issue date of August 2005 and can be accessed at <http://www.nmsthd.state.nm.us/main.asp?secid=11183>.

Listed below are the most likely sections to which the applicant may need to refer.

- 203 – Excavation, Borrow, and Embankment
207 – Subgrade Preparation
304 – Base Course (Non-QC/QA)¹
401 – Pavement Smoothness Measurement²
402 – Bituminous Materials, Hydrated Lime, and Liquid Anti-Stripping Agents³
404 – Open-Graded Friction Course (Non-QC/QA)⁴
407 – Tack Coat
408 – Prime Coat
414 – Cold Milling
416 – Minor Paving
422 – Plant-Mix Bituminous Pavement (Superpave Non-QC/QA)⁵
451 – Portland Cement Concrete Pavement
455 – Diamond-Grinding and Grooving of PCCP
570 – Pipe Culverts
606 – Metal and Concrete Wall Barrier
608 – Sidewalks, Drive Pads, and Concrete Median Pavement
609 – Curb and Gutter
610 – Cattle Guards
623 – Drop Inlets

- 1 – Type I only
2 – At a minimum, straightedging will be applied to all surface and friction course material and removal and replacement or any necessary corrective work methods will be determined by the Department

January 29, 2007

Determination of which applicant's proposed improvements will be subject to acceptance testing provided by the Department will be done by random methods. However, if in the Department's judgment, the scope and public impact of proposed improvements is significant, the NMDOT reserves the right to arbitrarily choose when to perform full or partial verification testing to assure that the proposed improvements are in compliance with the specifications or any revisions. Applicant's whose proposed improvements will be fully subject to Department acceptance testing will be notified after the applicant's construction schedule and traffic control plan are approved and before the District Traffic Engineer gives the authorization to begin construction.
Acceptance of manufactured materials will be based on valid certificates of compliance from the product manufacturer and submitted by the applicant.
All materials and items that do not meet the acceptance requirements must be removed and replaced before the driveway permit is approved.

CONTACTS
District Three Traffic Engineer Tony Abbo (505) 841-2700
District Three Laboratory Supervisor Carlos Giron (505) 841-2700
State Materials Bureau Bob Meyers (505) 827-9811
State Maintenance Bureau Tom Raught (505) 827-5176
Associated Contractors of New Mexico Bryan Legan (505) 344-2072

APPLIED ENGINEERING AND SURVEYING, INC. ENGINEERS AND PLANNERS 1605 Bluff Drive NE Albuquerque, New Mexico 87112 Office: (505) 237-1456 Fax: (505) 237-1456	
CITY OF ALBUQUERQUE PUBLIC WORKS DEPARTMENT ENGINEERING DEVELOPMENT GROUP	
TITLE: NMDOT CONSTRUCTION NOTES CORLEY'S ALBUQUERQUE	
Design Review Committee APPROVE MAY 15 2008 DESIGN REVIEW COMMITTEE	City Engineer Approval APPROVE JUN 04 2008 CITY ENGINEER
City Project No. 724582	Zone Map No. C-18
Sheet 13	Of 15

1

3

Traffic Control Notes

- The Contractor/TCP firm MUST adhere to the dates and times listed on the TCP permit. Failure to do so will result in the permit being revoked.
- The NMDOT reserves the right to make any changes and/or modifications to the approved Traffic Control Permit.
- The Contractor/TCP firm shall adhere to all the requirements listed in the latest edition of the Manual on Uniform Traffic Control Devices (MUTCD).
- In the areas of pavement operations or other activities within the traveled way and adjacent to the existing traveled lane, the contractor shall assure that no pavement drop-offs are left exposed during non-working hours. The contractor shall initiate corrective means as per "the New Mexico Department Of Transportation Pavement Drop-off Guideline" to achieve a minimum 6:1 slope between traveled lanes and a minimum 3:1 slope adjacent to the existing traveled lane with two 11-foot driving lanes as shown in the detail below.



- The Contractor/TCP firm will be required to cover up all conflicting signs within or in advance of the work zone.
- In covering up any conflicting signs, the contractor is to use an approved method of covering existing signing so as not to damage/distort sign sheeting or markings. The Contractor/TCP firm shall not place a patch on the sign and tape the patch directly to the face of the sign. Failure to adhere to this requirement will result in the Contractor/TCP firm being required to replace the sign.
- The Contractor/TCP firm shall not place a lane drop taper along a horizontal curve. The lane drop taper shall be placed in advance of the horizontal curve so that it is visible to all oncoming traffic.
- On crest vertical curves, the Contractor/TCP firm shall place lane drops in advance or at the beginning of the curve to enhance visibility of the lane drop to oncoming traffic.
- The Contractor/TCP firm SHALL contact Mr. Phil Gallegos, D3 Public Information Officer (PIO), at least 48 hours before any work listed in the TCP is performed, to confirm the actual start dates of the construction. Mr. Gallegos can then publish the upcoming work in the District Three Traffic Report. Mr. Gallegos can be reached at 841-2700.
- All traffic devices shall be kept clean throughout the duration of the project. Any sign that is tagged by Graffiti shall be cleaned within 24 hours or removed and replaced.
- "BUMP", "LOOSE GRAVEL", "LANE DROP-OFF SIGN" sign placement the contractor shall place W8-1-48 signs ("BUMP" - B/FO), W8-7-48 signs ("LOOSE GRAVEL" - B/FO) and/or W8-9a-48 signs ("SHOULDER DROP-OFFS" - B/FO) in advance of bridge approaches or other locations during cold milling and overlay operations as needed or as directed by the project manager. See standard drawing 702-01-1/3 for sign details.
- The following reflectivity material shall be used on all signing placed on NMDOT roadways

SIGN	SIGN CODE	COLOR	LETTER SHEETING	BACKGROUND SHEETING
APPROACH SIGNS	W20-1,2,3,4,5,7	(BLK.FLOURESCENT Orange)	-----	Type VII, VIII or IX
CHEVRONS	W1-8	(BLK.FLOURESCENT Orange)	-----	Type VII, VIII or IX
CURVES	W1-2	(BLK.FLOURESCENT Orange)	-----	Type VII, VIII or IX
REVERSE CURVE	W1-4	(BLK.FLOURESCENT Orange)	-----	Type VII, VIII or IX
MERGE	W4-1	(BLK.FLOURESCENT Orange)	-----	Type VII, VIII or IX
NO PASSING ZONE	W14-3	(BLK.FLOURESCENT Orange)	-----	Type VII, VIII or IX
FLAGGER PADDLE		(BLK.FLOURESCENT Orange side one with Red on side 2)	-----	Type VII, VIII or IX
ALL DRUMS		(BLK.FLOURESCENT Orange)	-----	Type VII, VIII or IX
All Other Const. Signs		Black on Orange	-----	Type III

Rev. 03/25/2007

- When flaring the leading end of a Temporary Concrete Wall Barrier (TCWB) within a construction work zone, the flare rate shall be done in accordance with the rates shown in the table below:

Roadway Speed Limit	Minimum Taper/Flare Rate	Desirable Taper/Flare Rate
Less than 45 MPH	8:1	18:1
Between 45 MPH and 55 MPH	10:1	24:1
Greater than 55 MPH	15:1	30:1

- When CWB is placed in a construction work zone, a 5' buffer area is strongly recommended between the Temporary Concrete Wall Barrier and the work zone to accommodate barrier deflection. When a 5' buffer area is not attainable, consideration shall be given to anchoring the TCWB to the pavement surface. (See attachment "B" - note 8 in standard drawing 606-20-1/4 dated 1/11/2005).
- The crash cushion attenuators shall be designed as per the District Traffic Engineer's recommendations. The District May elect to either utilize the posted speed or the 85% speed in the layout of the crash cushion attenuators within the work zone.
- All construction signing shall have a Type III or higher reflective background.
- All devices that are placed within the NMDOT R/W shall adhere to section 702 - Traffic Control Devices For Construction - in the latest edition of the NMDOT Specification book
- All stationary objects within clear zone shall be properly shielded and outlined with drums mounted with Type "A" warning lights. Use of vertically mounted retro-reflective material in lieu of a Type A warning light is strictly prohibited.
- Use of Type I or II barricades for approach tapers on rural Interstate or secondary roadways are prohibited.
- Any equipment, materials, or vehicles stored within ROW shall be outside of clear zone (based on existing posted speed).
- Any equipment, material or vehicle stored within clear zone shall be properly shielded.
- Materials, work activities, equipment, and vehicles shall not be stored within the established buffer space.
- All construction equipment, vehicles and materials shall remain behind traffic control devices.
- All traffic control device types, quantities and spacing shall not deviate from the approved Traffic Control Plan. Any changes to the traffic control plan must be approved by the District Traffic Engineer or his/her designee
- The following Taper lengths, buffer zone, and spacing of devices requirements shall be adhered to:

Posted Speed (MPH)	Formula	Merging (L) & Shifting Taper (S) Length (FT) *			Shoulder Taper (FT) *			Transition Area/ Clearing Zone * (FT) (ft)	Buffer Space or Distance * to Flagging Station	Maximum Spacing of Devices (ft) *	
		1 st Lane	1 st Lane	1 st Lane	1 st L	1 st L	1 st L			On a Taper	On a Taper
20		75	80	80	40	85	85	9	13	10	22
25	Lanes/No	115	80	125	85	135	70	14	21	25	35
30		165	85	185	90	195	75	16	23	28	40
35		225	115	245	125	265	135	27	41	84	88
40		285	150	320	150	340	175	38	53	71	88
45		345	200	360	200	400	200	49	68	100	100
50		405	250	420	250	460	250	60	80	120	120
55		465	300	480	300	520	300	71	93	135	135
60		525	350	540	350	580	350	82	106	150	150
65		585	400	600	400	640	400	93	119	165	165
70		645	450	660	450	680	450	104	132	180	180
75		705	500	720	500	740	500	115	145	195	195

See Section 6C-38 on page 6C-5 and Figure 6C-2 on page 6C-6 of the 2003 MUTCD
1. See Section 6C-38 on page 6C-5 and Figure 6C-2 on page 6C-6 of the 2003 MUTCD
2. See Figure 6B-37 on page 6B-17 of the 2003 MUTCD
3. See Figure 6C-38 on page 6C-4 and 6C-45 of the 2003 MUTCD


Rev. 03/25/2007

- If any of the signs and/or traffic control devices, on the attached TCP, are being used overnight the following minimum reflectivity standards shall be required:

New MUTCD Table 2A-3. Minimum Maintained Retroreflectivity Levels				
SIGN COLOR	SHEETING TYPE (ASTM D4956-04)			ADDITIONAL CRITERIA
	Beaded Sheeting		Prismatic Sheeting	
	I	II	III	
White on Green	W1-G a 7	W1-G a 15	W1-G a 25	Overhead
Black on Yellow or Black on Orange	Y1-O a 7	Y1-O a 15	Y1-O a 25	Ground-mounted
White on Red	W1-R a 7	W1-R a 15	W1-R a 25	Overhead
Black on White	W1-W a 7	W1-W a 15	W1-W a 25	Overhead
* The minimum maintained retroreflectivity levels shown in this table are in units of cd/m ² /m ² measured at an observation angle of 0.2° and an entrance angle of -4.0°.				
* For text and line symbol signs measuring at least 1200 mm (48 in) and for all sizes of bold symbol signs				
* For text and line symbol signs measuring less than 1200 mm (48 in)				
* Minimum Sign Contrast Ratio a 3:1 (white retroreflectivity > red retroreflectivity)				
* This sheeting type should not be used for this color for this application.				
BOLD SYMBOL SIGNS				
• W1-1, 2 - Turn and Curve	• W3-1 - Stop Ahead	• W11-3 - Deer Crossing		
• W1-3, 4 - Reverse Turn and Curve	• W3-2 - Yield Ahead	• W11-4 - Cattle Crossing		
• W1-5 - Winding Road	• W3-3 - Signal Ahead	• W11-5 - Farm Equipment		
• W1-6, 7 - Large Arrow	• W4-1 - Merge	• W11-6 - Staggered Crossing		
• W1-8 - Chevron	• W4-2 - Lane Ends	• W11-7 - Equicenter Crossing		
• W1-10 - Intersection in Curve	• W4-3 - Added Lane	• W11-8 - Fire Station		
• W1-15 - 270 Degree Loop	• W4-6 - Entering Roadway Added Lane	• W11-10 - Truck Crossing		
• W2-1 - Cross Road	• W2-1, 2 - Divided Highway Begins and Ends	• W12-1 - Double Arrow		
• W2-2, 3 - Side Road	• W2-3 - Two-Way Traffic	• W16-5, -6, -7, -8 - Righting Arrow Plaques		
• W2-4, -5 - T and Y Intersection	• W10-1, -2, -3, -4, -11, -12 - Highway-Railroad Advance Warning	• W20-7a - Hagger		
• W2-6 - Circular Intersection	• W11-3 - Pedestrian Crossing	• W21-1a - Worker		
FINE SYMBOL SIGNS - Symbol Signs Not Listed As Bold Symbol Signs				
SPECIAL CASES				
• W3-1 - Stop Ahead: Red retroreflectivity a 7				
• W3-2 - Yield Ahead: Red retroreflectivity a 7; White retroreflectivity a 35				
• W3-3 - Signal Ahead: Red retroreflectivity a 7; Green retroreflectivity a 7				
• W3-5 - Speed Reduction: White retroreflectivity a 30				
• For non-diamond shaped signs such as W14-3 (No Passing Zone), W4-4p (Cross Traffic Does Not Stop), or W13-1, -2, -3, -5 (Speed Advisory Plaques), use largest sign dimension to determine proper minimum retroreflectivity level.				


- Placement of the sequential arrow shall be at or near the beginning of the lane closure taper. In areas of insufficient pavement width, the sequential arrow may be placed within the taper, but not to exceed 1/2 the taper length. In all cases, the sequential arrow shall be placed behind the channelization devices.
- All signing on the interstate and on high speed 4 lane divided facilities shall be double indicated.
- All signs that are part of work zone that is in place for more than 3 days shall be placed on posts.
- Covering existing white and yellow stripes with black paint as a method of stripe removal is strictly prohibited.
- All warning and regulatory signs shall meet the following size requirements:
 - Interstate: Warning sign 48"x48" Regulatory 48"x60"
 - Non-Interstate: Warning sign 36"x36" Regulatory 36"x42"
- All CWB ends, within the clear zone, have to be protected with an approved crash cushion attenuator (approved based on the design speed of the road).

Rev. 03/25/2007

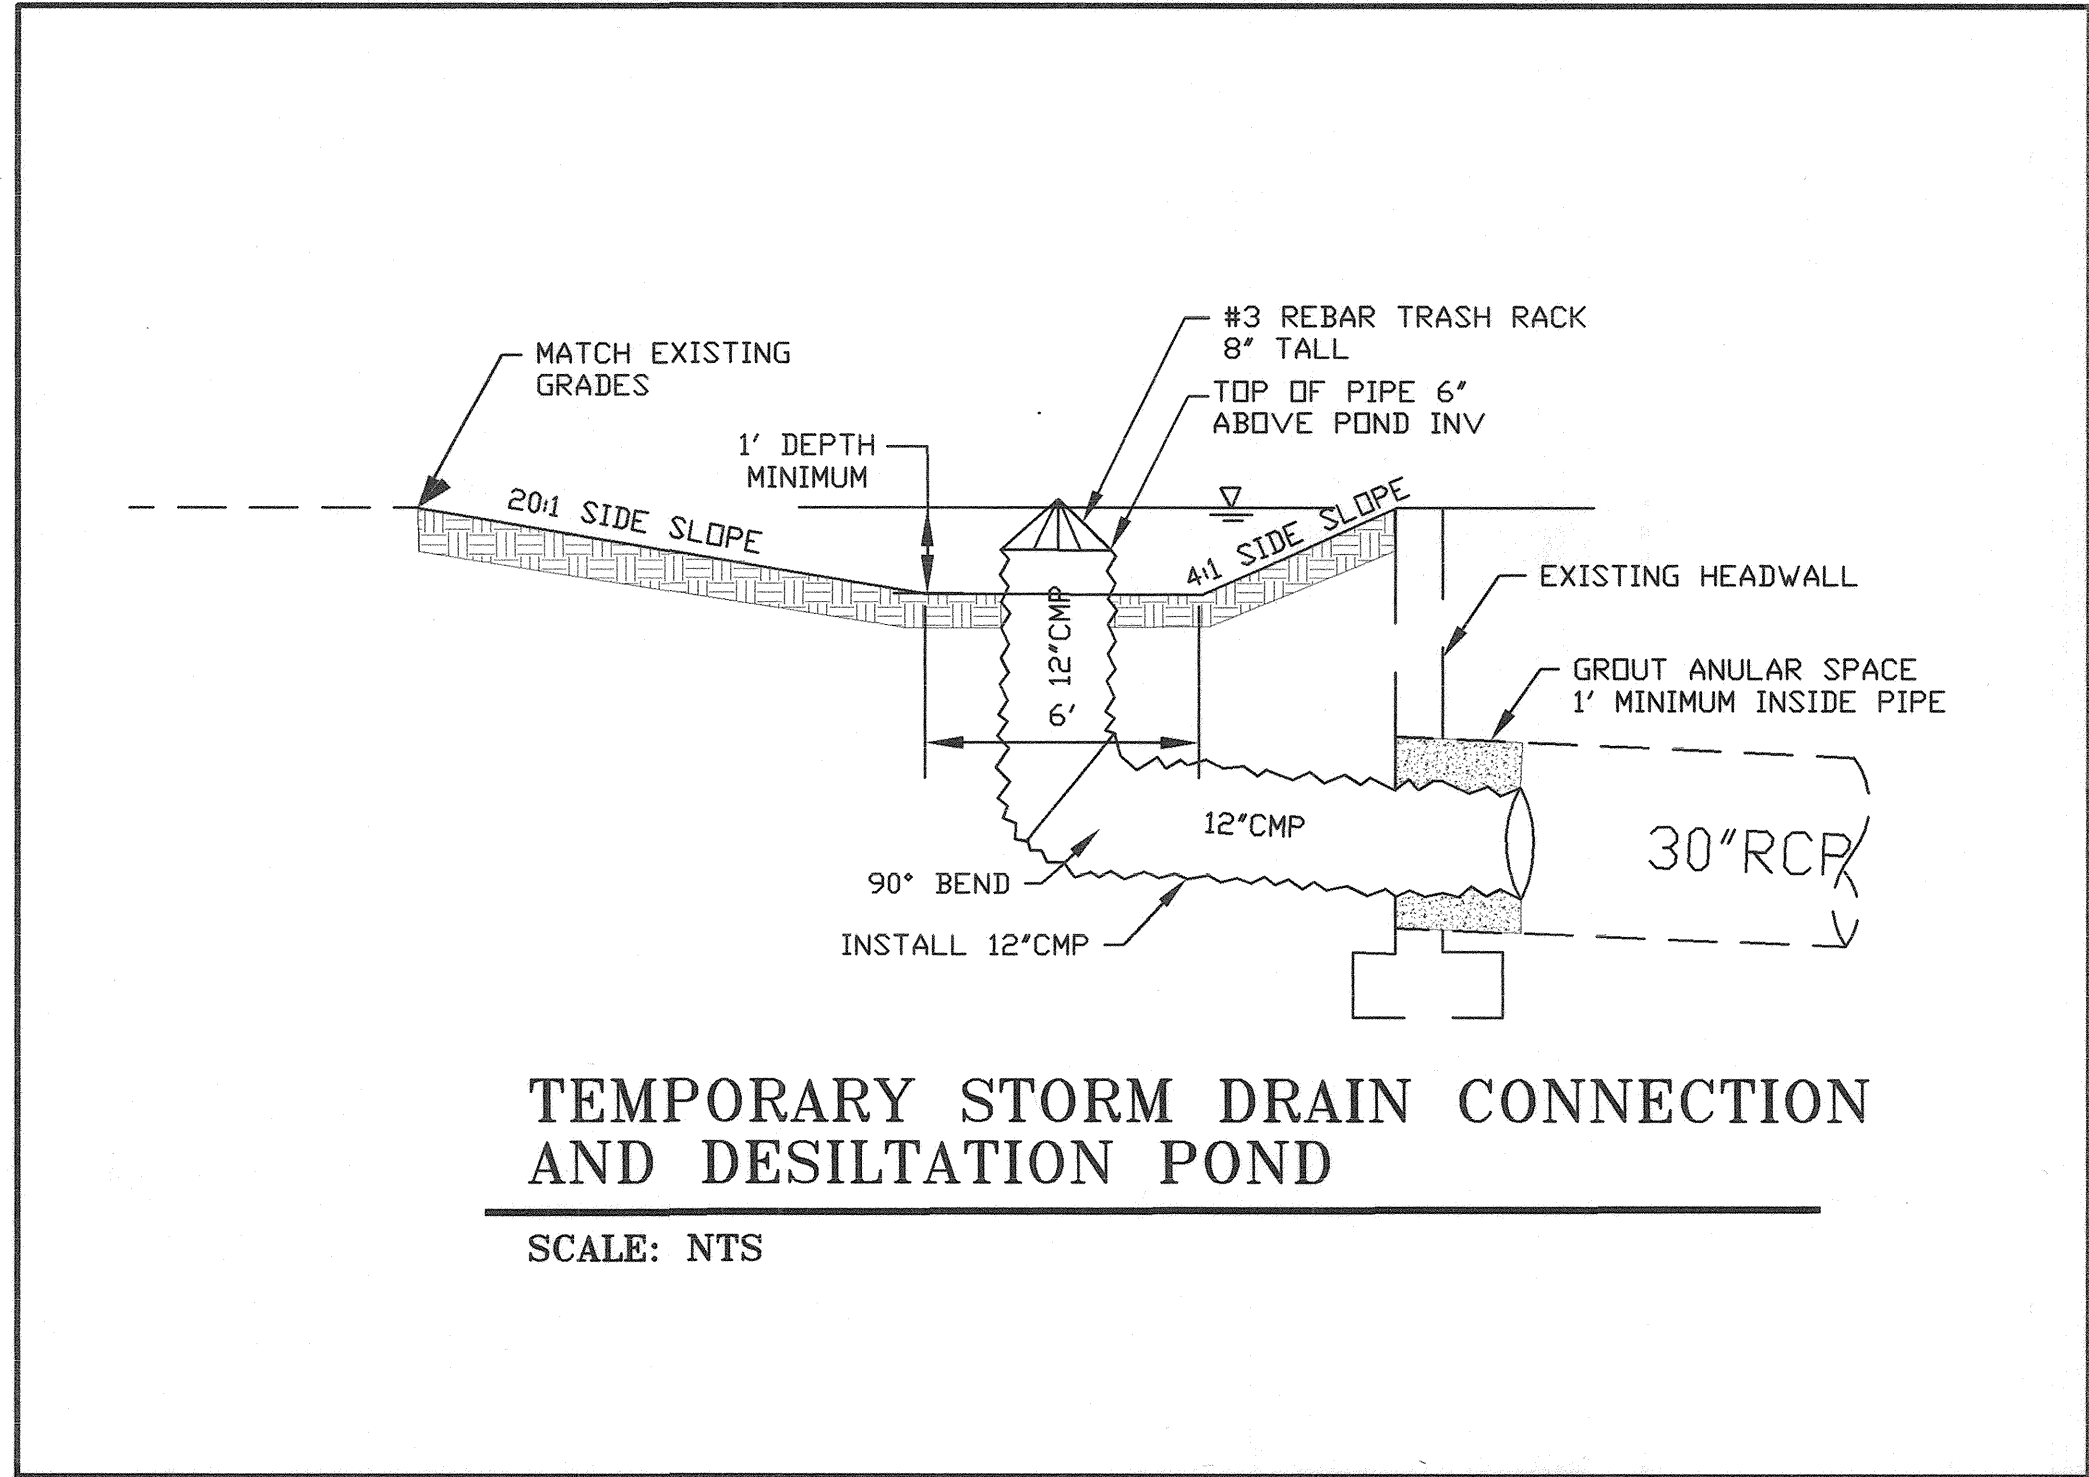

TEMPORARY STORM DRAIN CONNECTION AND DESILTATION POND

SCALE: NTS

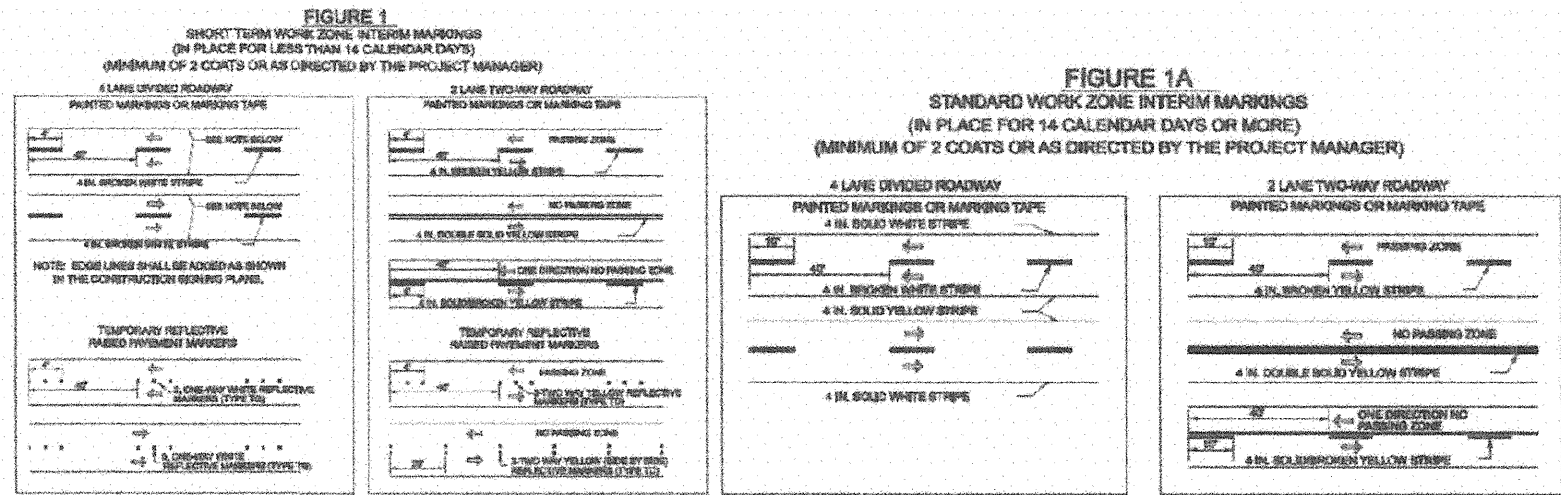

APPLIED ENGINEERING AND SURVEYING, INC. ENGINEERS AND PLANNERS 1905 Bluff Drive NE Albuquerque, New Mexico 87112 Office: (505) 237-1456	
CITY OF ALBUQUERQUE PUBLIC WORKS DEPARTMENT ENGINEERING DEVELOPMENT GROUP	
TITLE: NMDOT CONSTRUCTION NOTES CORLEY'S ALBUQUERQUE	
Design Review Committee APPROVED MAY 15 2008 DESIGN REVIEW COMMITTEE	City Engineer Approval APPROVED JUN 04 2008 CITY ENGINEER
City Project No. 724582	Zone Map No. C-18
Sheet 14	Of 15

