

GENERAL NOTES

1.

ALL WORK DETAILED ON THESE PLANS, EXCEPT AS OTHERWISE PROVIDED HEREON, SHALL BE CONSTRUCTED IN ACCORDANCE WITH THE CITY OF ALBUQUERQUE STANDARD SPECIFICATIONS FOR PUBLIC WORKS CONSTRUCTION, LATEST EDITION.
2.

ALL WORK ON THIS PROJECT SHALL BE PERFORMED IN ACCORDANCE WITH APPLICABLE FEDERAL, STATE, AND LOCAL LAWS, RULES, AND REGULATIONS CONCERNING CONSTRUCTION SAFETY AND HEALTH. THESE DRAWINGS DO NOT INCLUDE NECESSARY COMPONENTS FOR CONSTRUCTION SAFETY AND HEALTH. THESE DRAWINGS DO NOT INCLUDE NECESSARY COMPONENTS FOR CONSTRUCTION SAFETY WHICH SHALL REMAIN THE CONTRACTOR'S RESPONSIBILITY.
3.

THESE DRAWINGS REFLECT INFORMATION ON UTILITIES GATHERED BY SITE INSPECTION, DISCUSSIONS WITH MUNICIPAL OFFICIALS, AND UTILITY COMPANY CONSTRUCTION DRAWINGS. IT IS POSSIBLE THAT THE EXACT LOCATION OF LINES AND UTILITY CONNECTION POINTS IN THE VICINITY OF THE REQUIRED WORK MAY BE DIFFERENT FROM THE LOCATION SHOWN ON THESE DRAWINGS. PRIOR TO CONSTRUCTION, THE CONTRACTOR SHALL EXCAVATE AND VERIFY THE HORIZONTAL AND VERTICAL LOCATIONS OF ALL UTILITY OBSTRUCTIONS. SHOULD A CONFLICT ARISE, THE CONTRACTOR SHALL NOTIFY THE ENGINEER SO THAT THE CONFLICT CAN BE RESOLVED WITH A MINIMUM AMOUNT OF DELAY.
4.

THE CONTRACTOR SHALL PROTECT AND MAINTAIN IN SERVICE ALL EXISTING UTILITIES. THE CONTRACTOR SHALL ADEQUATELY SUPPORT AND PROTECT EXISTING UTILITIES AFFECTED BY THE CONTRACTOR'S OPERATIONS. IN EVENT THAT EXISTING UTILITIES ARE DAMAGED BY THE CONTRACTORS OPERATIONS, THE CONTRACTOR SHALL ARRANGE FOR AND COORDINATE PROMPT REPAIR BY THE RESPECTIVE UTILITY AND SHALL BEAR THE COST OF REPAIRS.
5.

TWO WORKING DAYS PRIOR TO ANY EXCAVATION, THE CONTRACTOR SHALL CONTACT UTILITY LOCATORS FOR SPOTTING OF EXISTING UTILITIES. THE CONTRACTOR SHALL ALSO CALL FOR RE-SPOTS AS NECESSARY TO KEEP UTILITY LOCATIONS CURRENT. OBTAIN BOUNDARY PERMITS AS REQUIRED.
6.

WATER SYSTEM FACILITIES ARE OPERATED AND CONTROLLED BY THE CITY OF ALBUQUERQUE WATER UTILITY DEPARTMENT. THE CONTRACTOR SHALL CONTACT THE UTILITY DIVISION AT LEAST THREE (3) WORKING DAYS IN ADVANCE OF ANY WORK AFFECTING OR REQUIRING SHUTOFFS OF WATER OR SEWER FACILITIES.
7.

THE CONTRACTOR SHALL BE RESPONSIBLE FOR OBTAINING ALL WATER NECESSARY FOR CONSTRUCTION. THE COSTS FOR WATER SHALL BE CONSIDERED INCIDENTAL TO COMPLETION OF THE PROJECT AND NO SEPARATE MEASUREMENT OR PAYMENT SHALL BE MADE THEREFOR.
8.

THE CONTRACTOR SHALL MAINTAIN A DETAILED UP TO DATE SET OF AS BUILT PLANS FOR THE PROJECT. THESE PLANS SHALL BE KEPT CURRENT, WITHIN TWO WEEKS, AT ALL TIMES AND SHALL BE SUBJECT TO REVIEW BY THE PROJECT MANAGER THROUGHOUT THE PROJECT AND WILL BE REVIEWED BY THE PROJECT MANAGER FOR ACCURACY AND COMPLETENESS AT LEAST ONCE EVERY 30 DAYS. THE FINAL AS BUILT PLANS SHALL BE SUBMITTED TO THE PROJECT MANAGER PRIOR TO FINAL PAYMENT.
9.

TRAFFIC CONTROL TO BE IMPLEMENTED BY THE CONTRACTOR PER NMUTCD. A STANDARD TRAFFIC CONTROL PLAN IS PROVIDED, BUT CONTRACTOR SHALL FURNISH THE SPECIFIC PLANS, AS REQUIRED TO COINCIDE WITH SEQUENCING OF CONSTRUCTION. CONTRACTOR SHALL FURNISH A TRAFFIC CONTROL PLAN (DRAWING SHEET) WITH ANY DETOUR ARRANGEMENTS TO THE PUBLIC WORKS AND UTILITY DEPARTMENTS PRIOR TO COMMENCING WORK. CONTRACTOR MUST NOTIFY THE ALBUQUERQUE PUBLIC WORKS DEPARTMENT, 48 HOURS IN ADVANCE OF STARTING OR ALTERING ANY TRAFFIC CONTROL PROGRAM.
10.

WHEN ABUTTING NEW PAVEMENT TO EXISTING, SAW CUT EXISTING PAVEMENT TO A STRAIGHT LINE, AS REQUIRED, TO REMOVE ANY BROKEN OR CRACKED PAVEMENT AND MATCH NEW TO EXISTING.
11.


WHERE TRENCHING EXPOSES EXISTING UTILITY LINES, THE CONTRACTOR IS RESPONSIBLE FOR SUPPORTING THE LINE DURING CONSTRUCTION AND ASSURE THAT IT IS BACKFILLED AND COMPACTED IN ACCORDANCE WITH THE STANDARD SPECIFICATIONS.
12.

ANY AREA NOT PAVED OR LANDSCAPED WHICH IS DISTURBED DURING CONSTRUCTION SHALL BE SEEDED WITH NATIVE GRASS. THE COST OF SEEDING SHALL BE CONSIDERED INCIDENTAL TO THE WORK.

INDEX OF DRAWINGS

SEQUENCE	SHEET	DESCRIPTION
1	C-001	TITLE SHEET
2	C-002	PROJECT INFORMATION SHEET
3	C-001	TYPICAL PAVEMENT SECTIONS
4	C-101	GEOMETRY LAYOUT PLAN
5	C-201	PASEO DEL VOLCAN PLAN AND PROFILE - STA. 10+00.0 TO STA. 14+00.0
6	C-202	PASEO DEL VOLCAN PLAN AND PROFILE - STA. 14+00.0 TO STA. 18+40.0
7	C-203	PASEO DEL VOLCAN PLAN AND PROFILE - STA. 18+40.0 TO STA. 22+80.0
8	C-204	PASEO DEL VOLCAN PLAN AND PROFILE - STA. 22+80.0 TO STA. 27+20.0
9	C-205	PASEO DEL VOLCAN PLAN AND PROFILE - STA. 27+20.0 TO STA. 31+80.0
10	C-206	PASEO DEL VOLCAN PLAN AND PROFILE - STA. 31+80.0 TO STA. 36+20.0
11	C-207	PASEO DEL VOLCAN PLAN AND PROFILE - STA. 36+20.0 TO END OF ROAD
12	C-208	PASEO DEL VOLCAN AIRPORT ACCESS ROAD - STA. 10+00.0 TO STA. 13+50.0
13	C-209	PASEO DEL VOLCAN AIRPORT ACCESS ROAD - STA. 13+50.0 TO INTERSECTION
14	C-210	PASEO DEL VOLCAN CULVERT #1 PLAN AND PROFILE
15	C-211	PASEO DEL VOLCAN CULVERT #2 PLAN AND PROFILE
16	C-301	PASEO DEL VOLCAN / AIRPORT ACCESS ROAD INTERSECTION GEOMETRY LAYOUT PLAN
17	C-401	SIGNING AND STRIPING PLAN
18	C-402	SIGNING AND STRIPING PLAN

VICINITY MAP

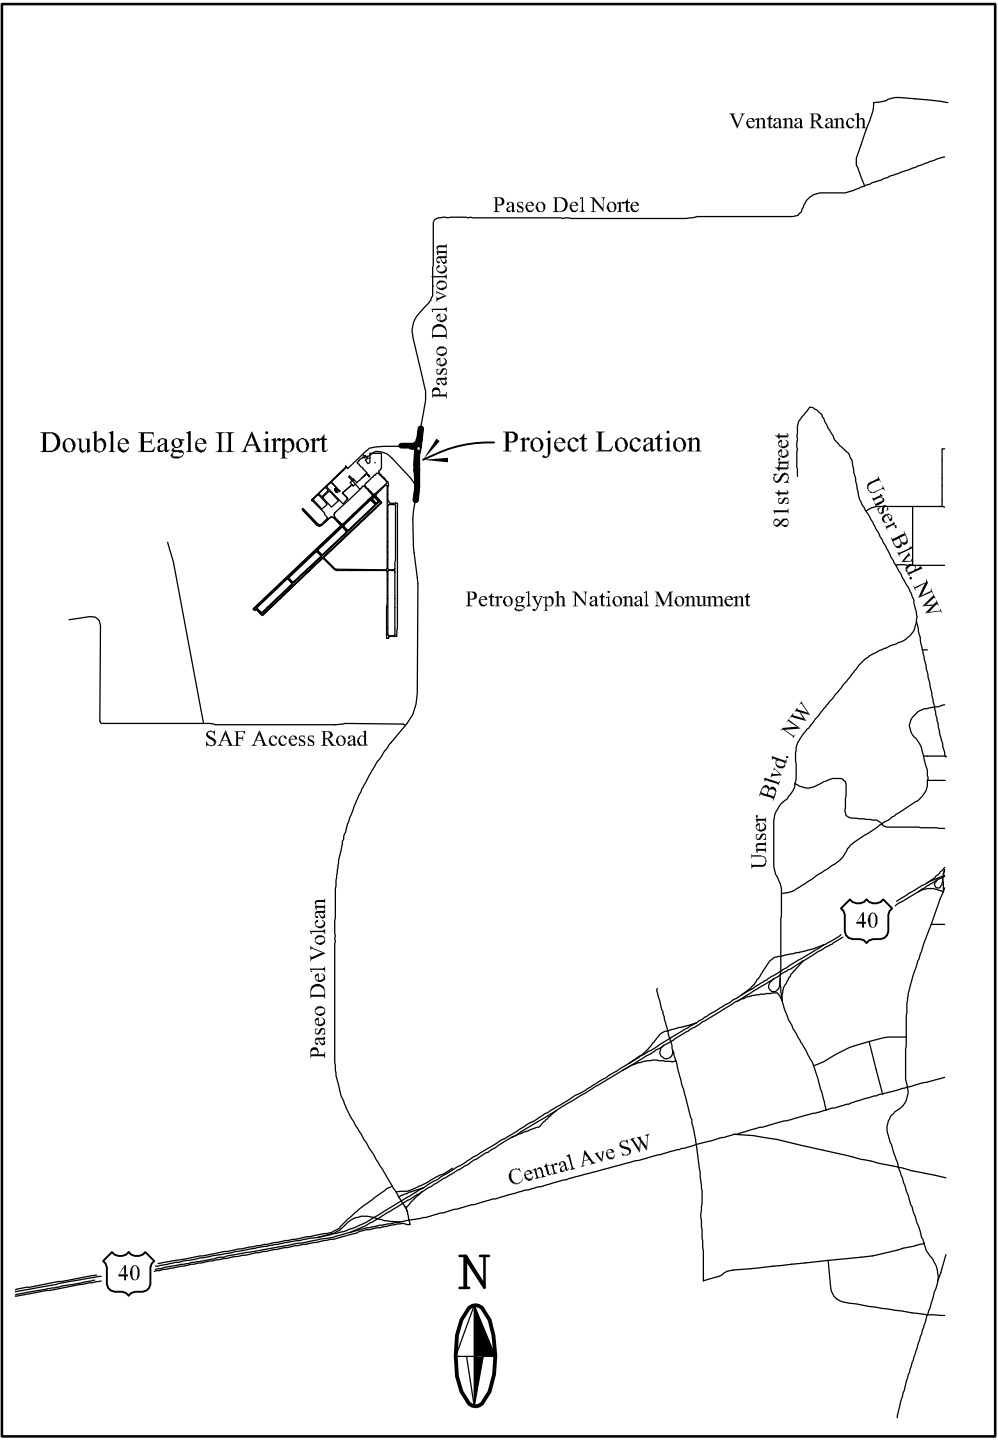

CONSTRUCTION SEQUENCE

1.

CONSTRUCT ROADWAY WITHIN CONSTRUCTION ZONE WHILE MAINTAINING SAFE CLEARANCE FROM EXISTING ACTIVE ROADWAY
2.

CONSTRUCT SOUTH DETOUR AND SWITCH TRAFFIC ON TO IT. BUILD CONNECTION TO EXISTING PASEO DEL VOLCAN. TRAFFIC TO REMAIN ON DETOUR UNTIL COMPLETION OF PROJECT.
3.

CONSTRUCT DETOUR ON WEST LEG AND SWITCH TRAFFIC ON TO IT. BUILD CONNECTION TO EXISTING AIRPORT ACCESS ROAD. TRAFFIC TO REMAIN ON DETOUR UNTIL COMPLETION OF PROJECT.
4.

CLOSE ENTIRE ROADWAY, NORTH AND SOUTHBOUND LANES OF PASEO DEL VOLCAN. CONSTRUCT LAST CONNECTION ON NORTH END TO EXISTING PASEO DEL VOLCAN. OPEN ROADWAY. CONTRACTOR TO ENSURE NEW ROADWAY IS TRAFFIC WORTHY PRIOR TO CLOSURE AND FINAL TRAFFIC SWITCH.

2701 MILES RD SE
ALBUQUERQUE, NM 87106
TEL: 505.242-5700
FAX: 505.242-0673


MOLZEN-CORBIN

ScAssociates


ENGINEERS/ARCHITECTS/PLANNERS

RECORD DRAWING	
DATE: 03/17/09	DRAWN BY: JCB
THESE RECORD DRAWINGS HAVE BEEN PREPARED, IN PART, ON THE BASIS OF INFORMATION COMPILED AND FURNISHED BY OTHERS. MOLZEN-CORBIN AND ASSOCIATES WILL NOT BE RESPONSIBLE FOR ANY ERRORS OR OMISSIONS WHICH HAVE BEEN INCORPORATED INTO THIS DOCUMENT AS A RESULT.	

2	6	-	7	2	5	8	.	0	2	-	0	9	
City Project No. 725802										Zone Map No. E-5 & E-6		Sheet G-002	Of ##

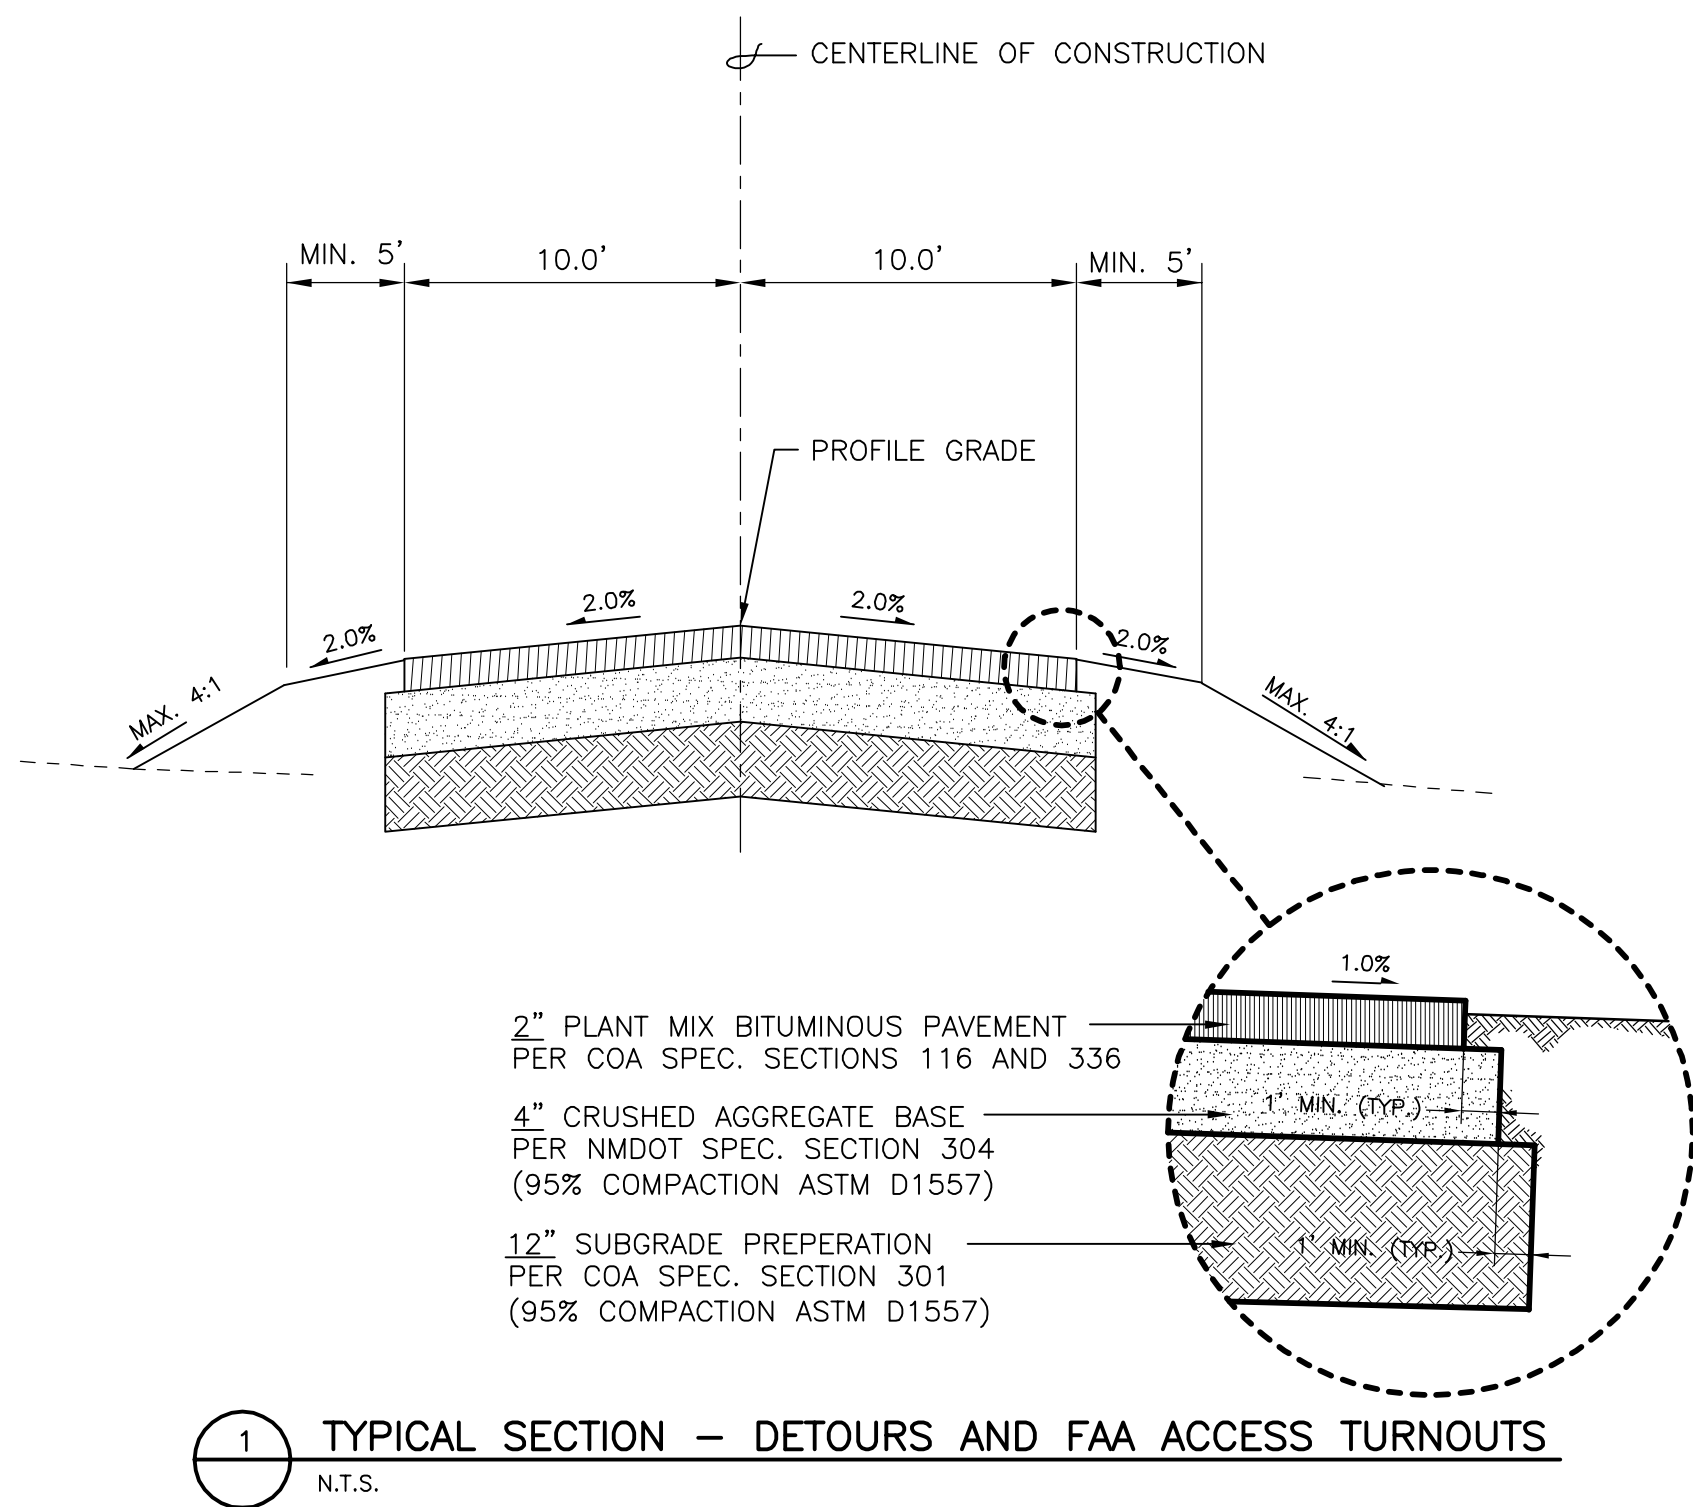

1 TYPICAL SECTION – DETOURS AND FAA ACCESS TURNOUTS
N.T.S.

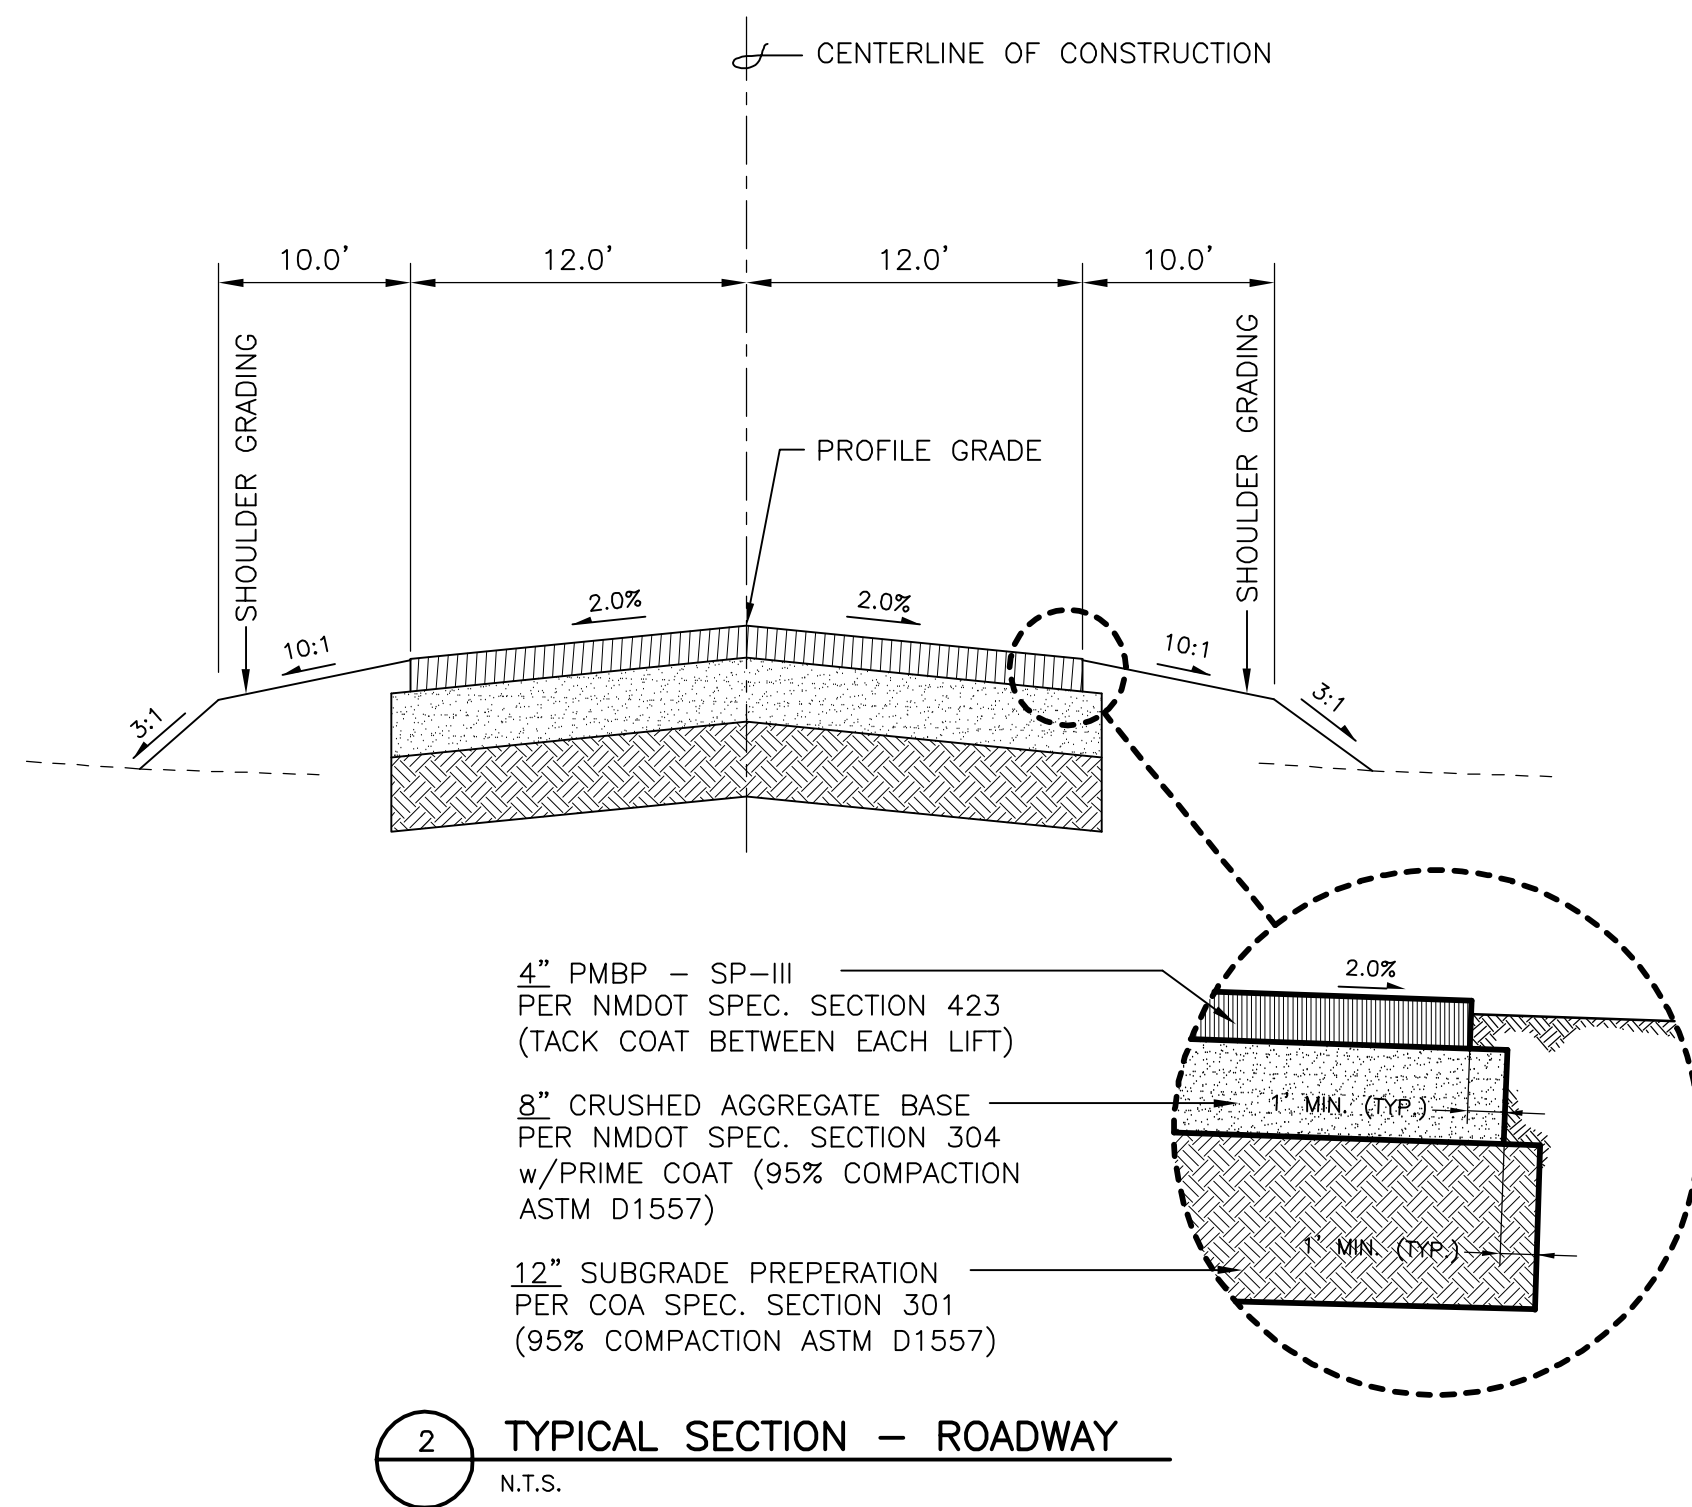

2 TYPICAL SECTION – ROADWAY
N.T.S.

2701 MILES RD SE
ALBUQUERQUE, NM 87106
TEL: 505.242-5700
FAX: 505.242-0673

MOLZEN-CORBIN & Associates
ENGINEERS/ARCHITECTS/PLANNERS

RECORD DRAWING
DATE: 03/17/09 DRAWN BY: JCB
THESE RECORD DRAWINGS HAVE BEEN PREPARED, IN PART, ON THE BASIS OF INFORMATION COMPILED AND FURNISHED BY OTHERS. MOLZEN-CORBIN AND ASSOCIATES WILL NOT BE RESPONSIBLE FOR ANY ERRORS OR OMISSIONS WHICH HAVE BEEN INCORPORATED INTO THIS DOCUMENT AS A RESULT.

PROJECT CONTROL

DESCRIPTION	NORTHING	EASTING	ELEVATION
EAGLEAIR BRASS CAP	1508539.46	1480099.96	
N93A BRASS CAP	1510295.71	1479939.18	

ALL COORDINATES AND BEARINGS ON THIS PROJECT ARE NEW MEXICO STATE PLANE,
GRID BEARINGS (NAD 83 CENTRAL ZONE, NGVD 29)

DISTANCES ARE GRID DISTANCES

CENTERLINE CURVE DATA
Included angle = 13-34-56
Radius = 2000.00'
Tangent length = 273.65'
Arc length = 543.93'
Chord length = 542.25'
External secant = 18.63'
Mid ordinate = 18.46'
Degree of curve = 02-51-53

STA. 10+00.0
BEGIN ROADWAY CONSTRUCTION
MATCH EXISTING ELEVATION
N=1511660.67
E=1480206.84

PC STA. 15+84.67
N=1512240.40
E=1480282.64

PRC STA. 21+28.60
N=1512782.65
E=1480279.40


STA. 10+00.0
BEGIN ROADWAY CONSTRUCTION
MATCH EXISTING ELEVATION
N=1513953.28
E=1479597.71

STA. 40+62.31
END ROADWAY CONSTRUCTION
MATCH EXISTING ROADWAY ELEVATION
N=1514702.03
E=1480436.53

CENTERLINE CURVE DATA
Included angle = 16-29-05
Radius = 3000.00'
Tangent length = 434.57'
Arc length = 863.14'
Chord length = 860.17'
External secant = 31.31'
Mid ordinate = 30.99'
Degree of curve = 01-54-35

PT STA. 29+91.74
N=1513642.82
E=1480281.04


STA. 33+06.86=
STA. 17+29.10
N=1513954.60
E=1480326.81

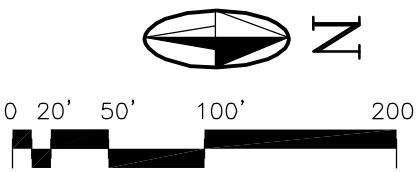

RECORD DRAWING
DATE: 03/17/09 DRAWN BY: JCB
THESE RECORD DRAWINGS HAVE BEEN PREPARED, IN PART, ON THE BASIS OF INFORMATION COMPILED AND FURNISHED BY OTHERS. MOLZEN-CORBIN AND ASSOCIATES WILL NOT BE RESPONSIBLE FOR ANY ERRORS OR OMISSIONS WHICH HAVE BEEN INCORPORATED INTO THIS DOCUMENT AS A RESULT.

CITY OF ALBUQUERQUE PUBLIC WORKS DEPARTMENT ENGINEERING DEVELOPMENT GROUP	
TITLE: PASEO DEL VOLCAN DOUBLE EAGLE II ACCESS ROAD REALIGNMENT GEOMETRY LAYOUT PLAN	
Design Review Committee	City Engineer Approval
Last Design Update	
Mo./Day/Yr. Mo./Day/Yr.	
City Project No. 725802	
Zone Map No. E-5 & E-6	
Sheet C-101 Of	

SURVEY INFORMATION		BENCH MARKS		AS BUILT INFORMATION	
NO.	FIELD NOTES	NO.	DATE	CONTRACTOR	DATE
	BY			STAKED BY	DATE
				ACCEPTED BY	DATE
				FIELD	DATE
				CONSTRUCTION BY	DATE
				DRAWINGS	DATE
				CORRECTED BY	DATE
				MICRO-FILM INFORMATION	
				RECORDED BY	DATE
				NO.	

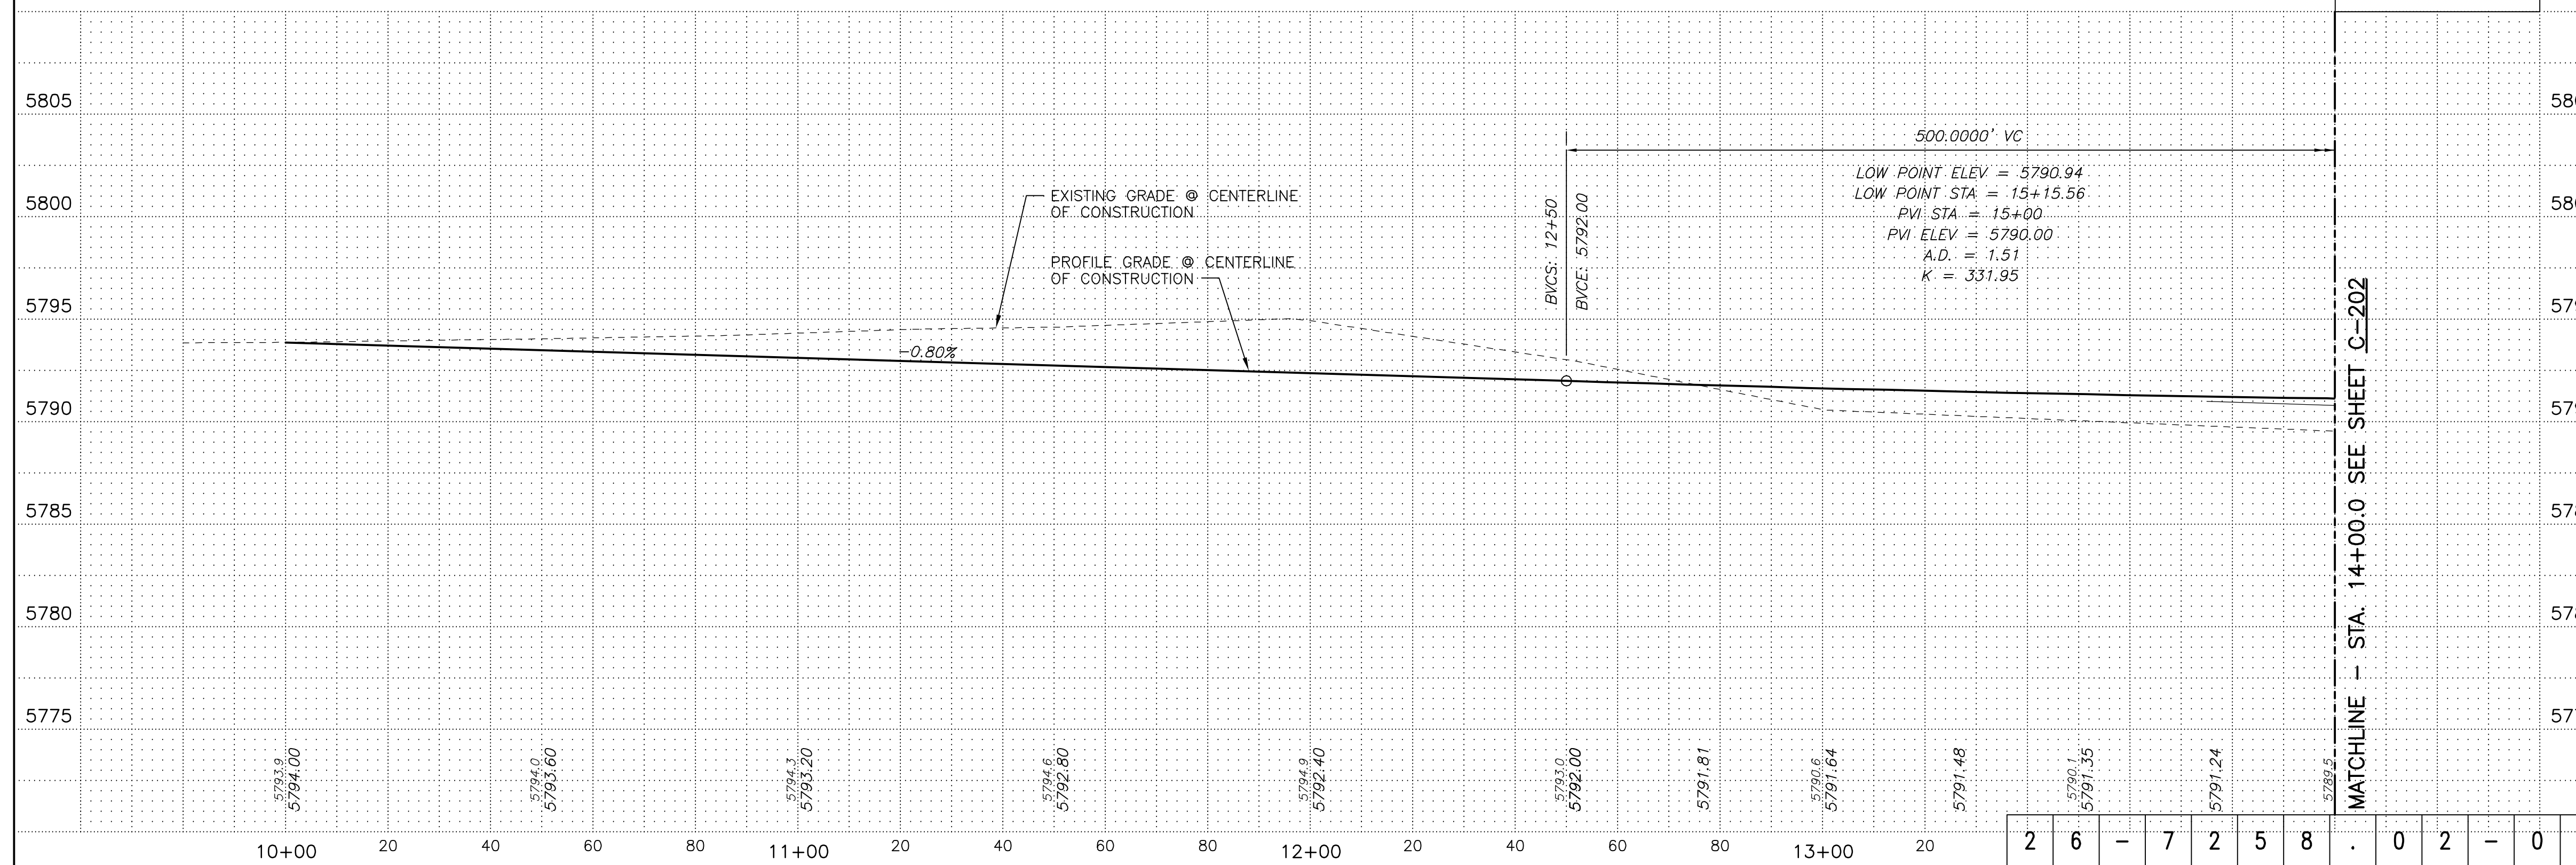

DESIGN CRITERIA

STOPPING SIGHT DISTANCE



-
-
GENERAL NOTES

- ALL DISTURBED AREA WILL BE SEEDED PER NMDOT STANDARDS AND SPECIFICATIONS.

ENGINEER'S SEAL		SURVEY INFORMATION		BENCH MARKS		AS BUILT INFORMATION	
		FIELD NOTES					
		NO.	BY	DATE			
						WORKED BY	CONTRACTOR
						INSPECTOR'S	DATE
						APPROVAL BY	DATE
						VERIFICATION BY	DATE
						WORKSHEET CORRECTED BY	DATE
						<i>MICRO-FILM INFORMATION</i>	
						RECORDED BY	DATE
						NO.	


CITY OF ALBUQUERQUE PUBLIC WORKS DEPARTMENT ENGINEERING DEVELOPMENT GROUP					
TITLE: PASEO DEL VOLCAN DOUBLE EAGLE II ACCESS ROAD REALIGNMENT					
PASEO DEL VOLCAN PLAN AND PROFILE STA. 10+00.0 TO STA. 14+00.0					
Design Review Committee		City Engineer Approval		Last Design Update	Mo./Day/Yr.
City Project No.		Zone Map No.		Sheet	Mo./Day/Yr.
725802		E-5 & E-6		Of	C-201

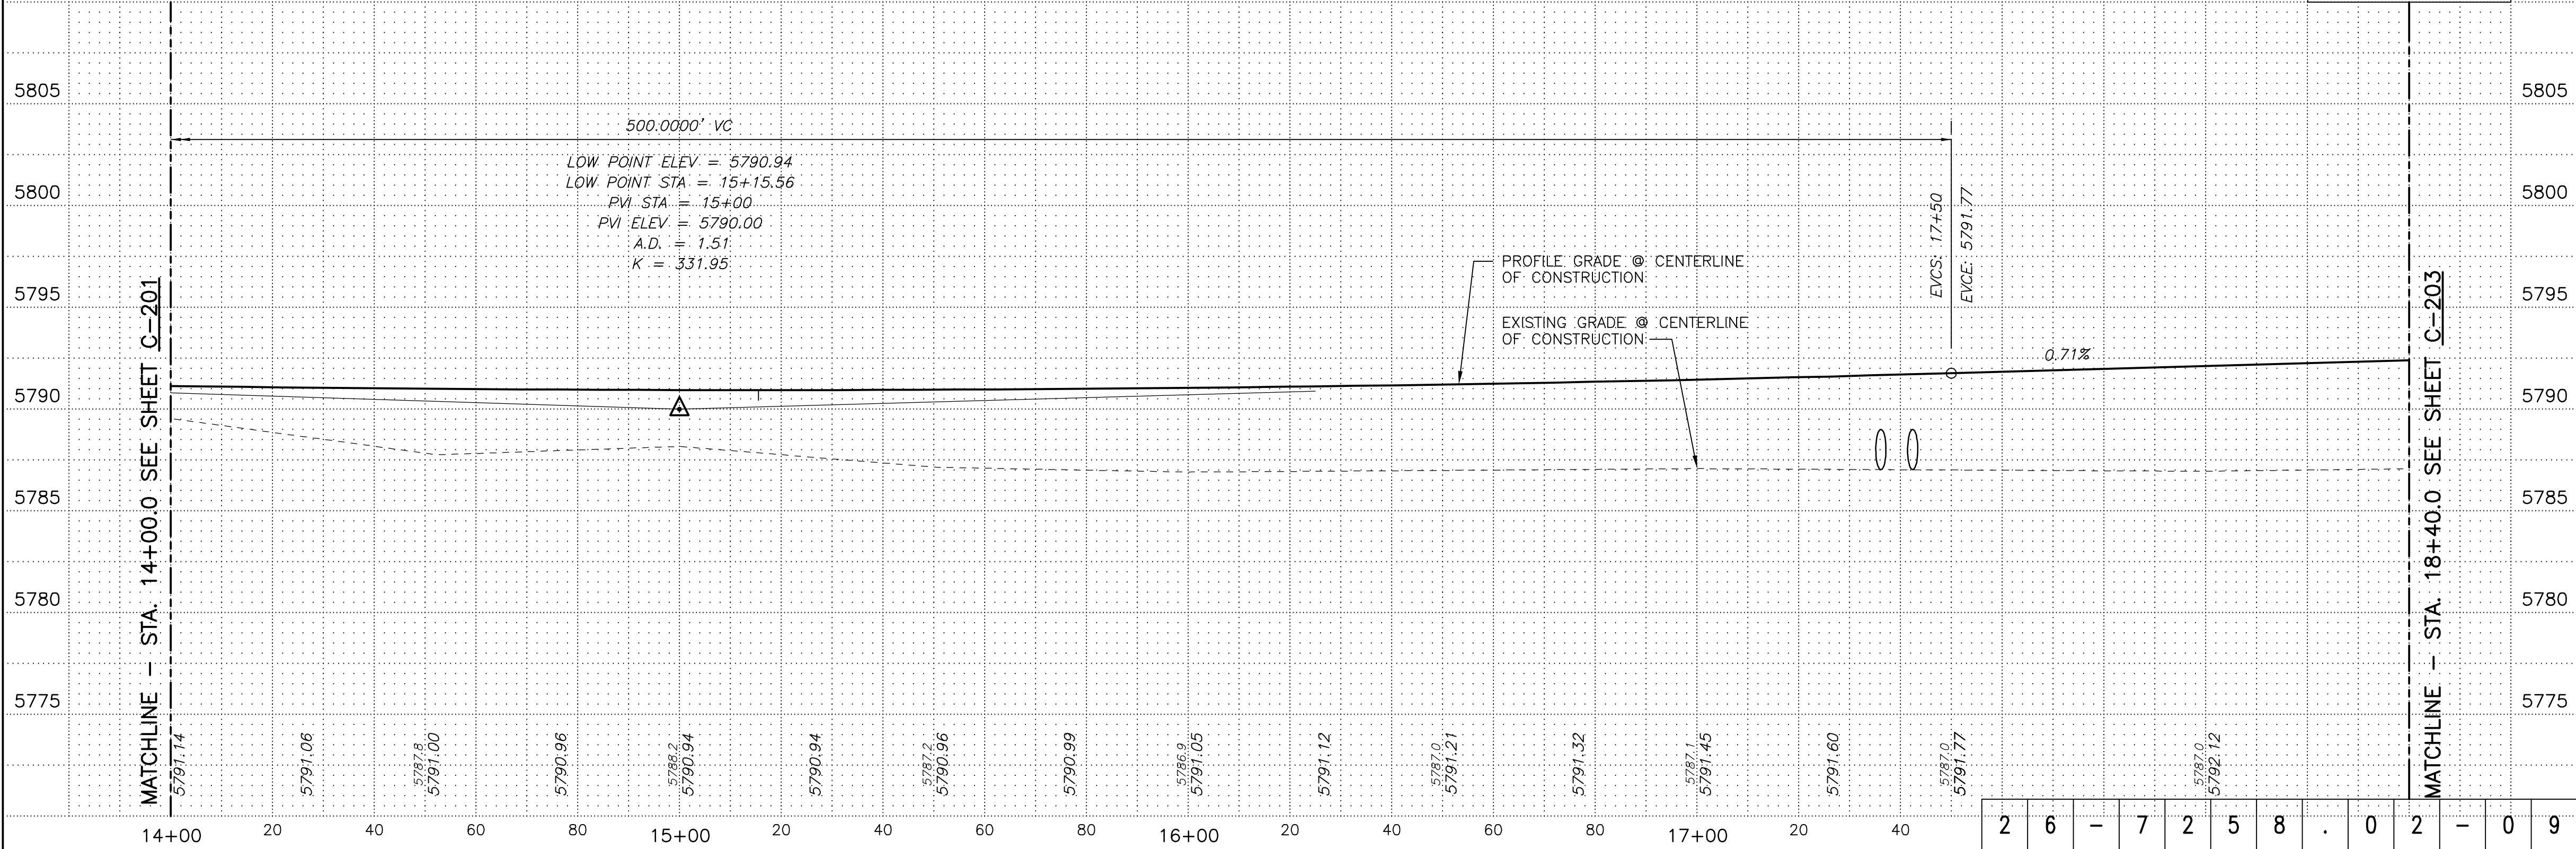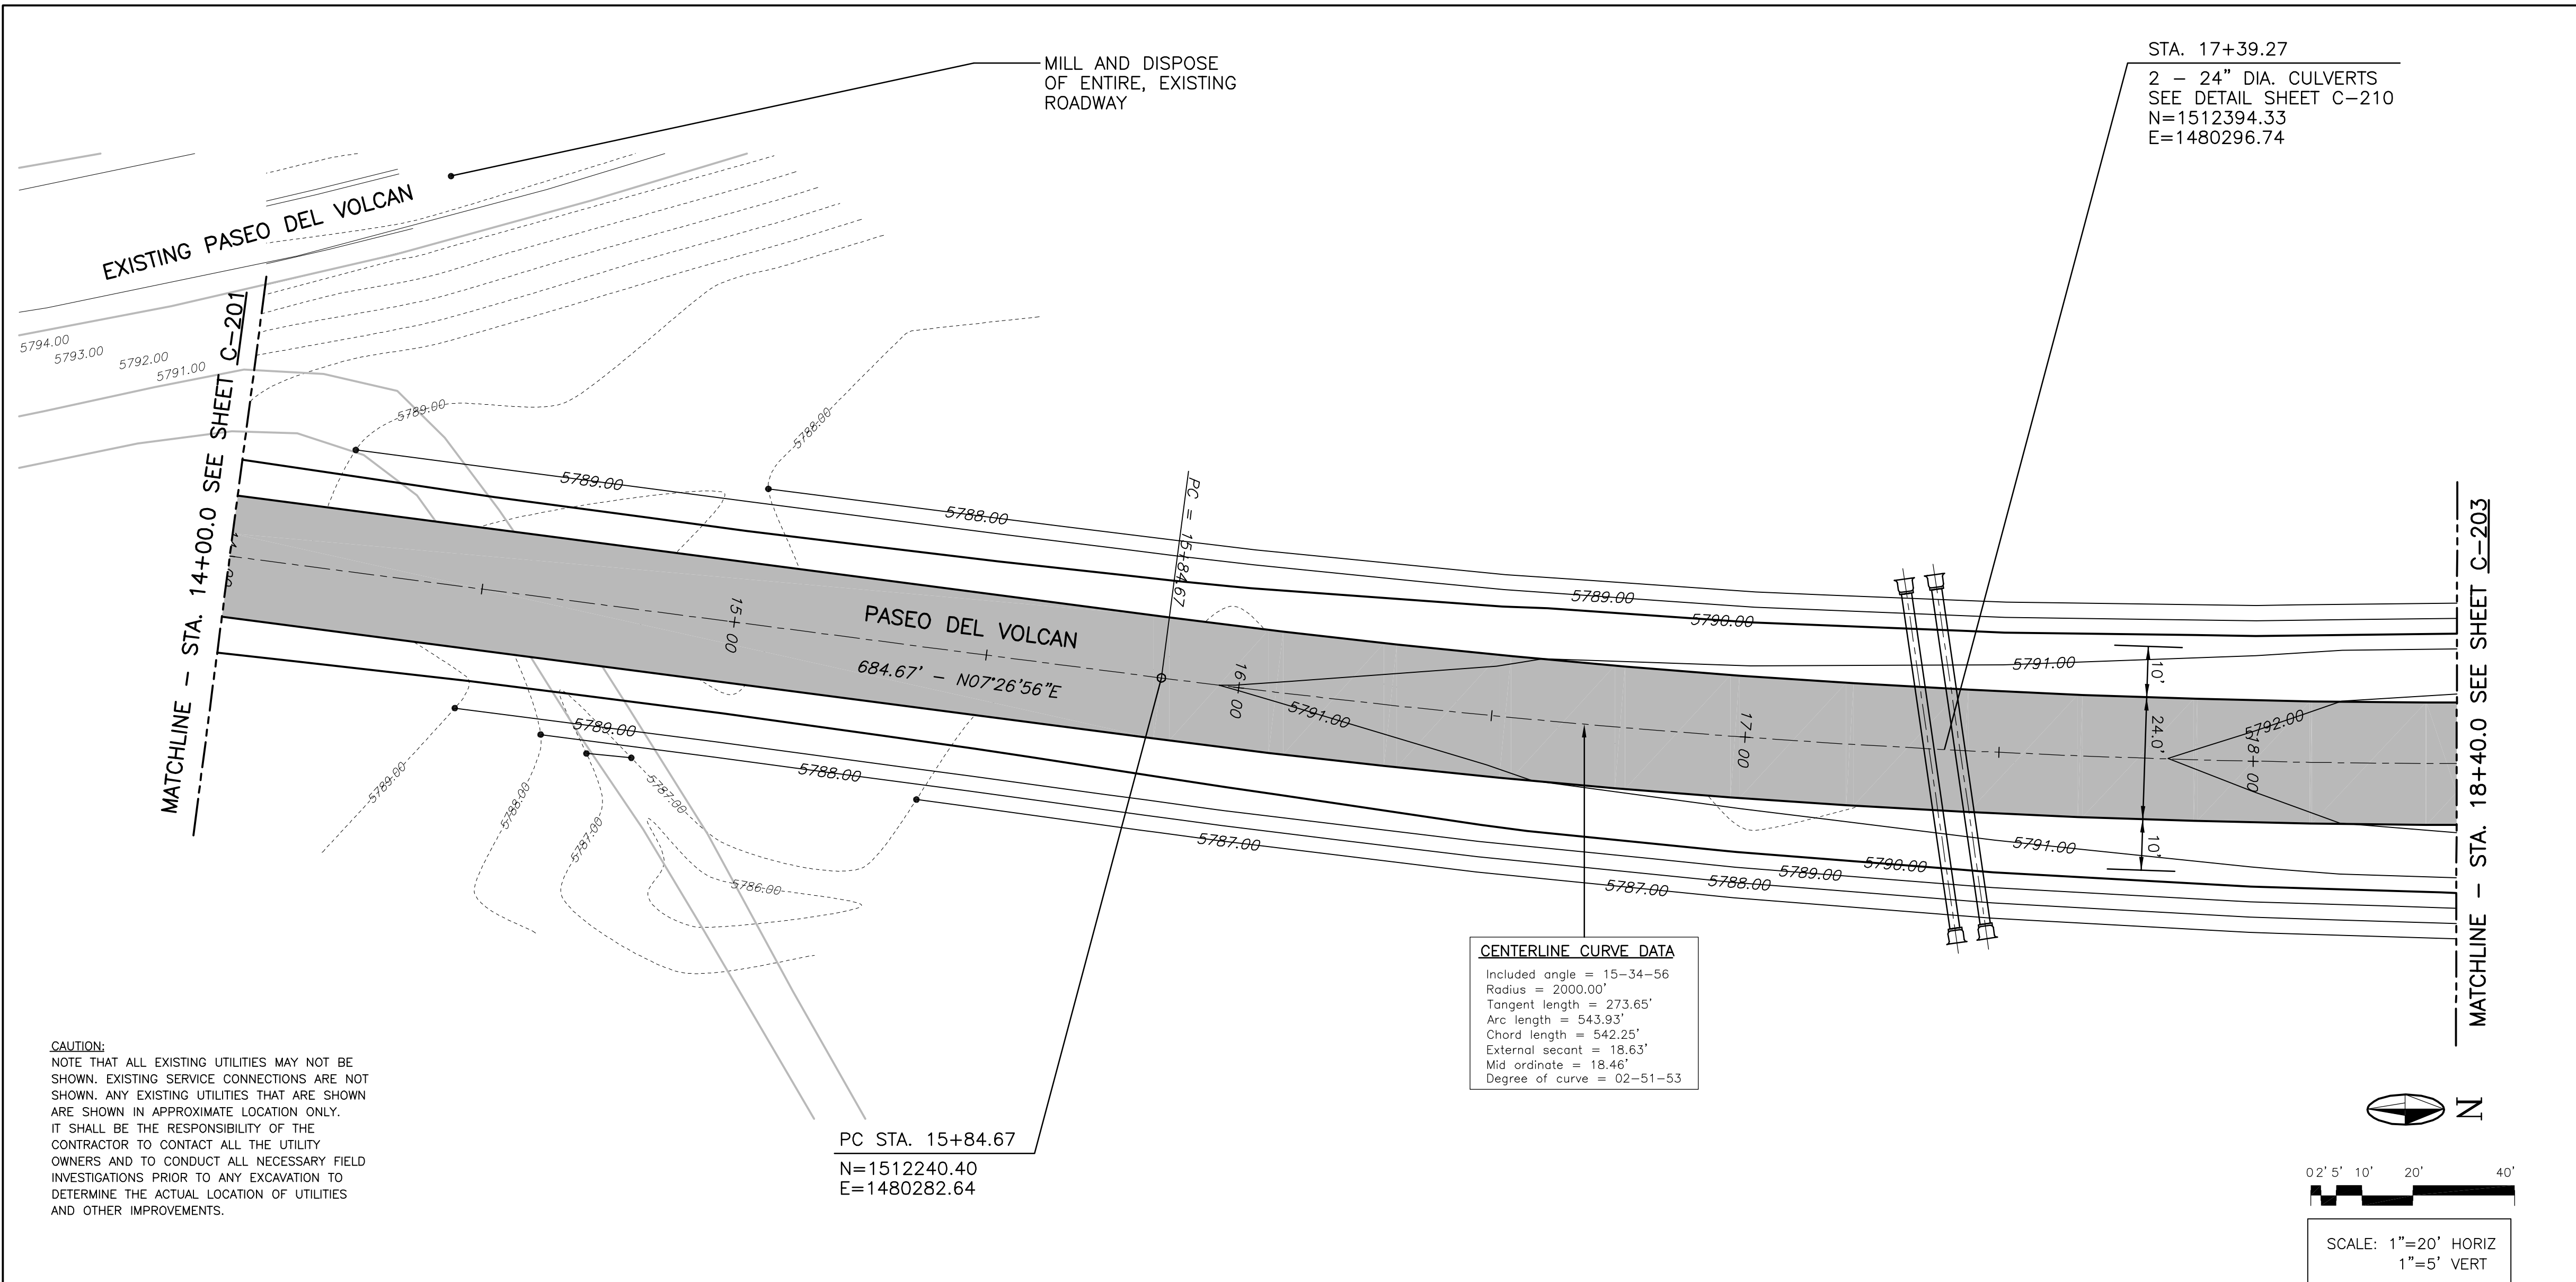

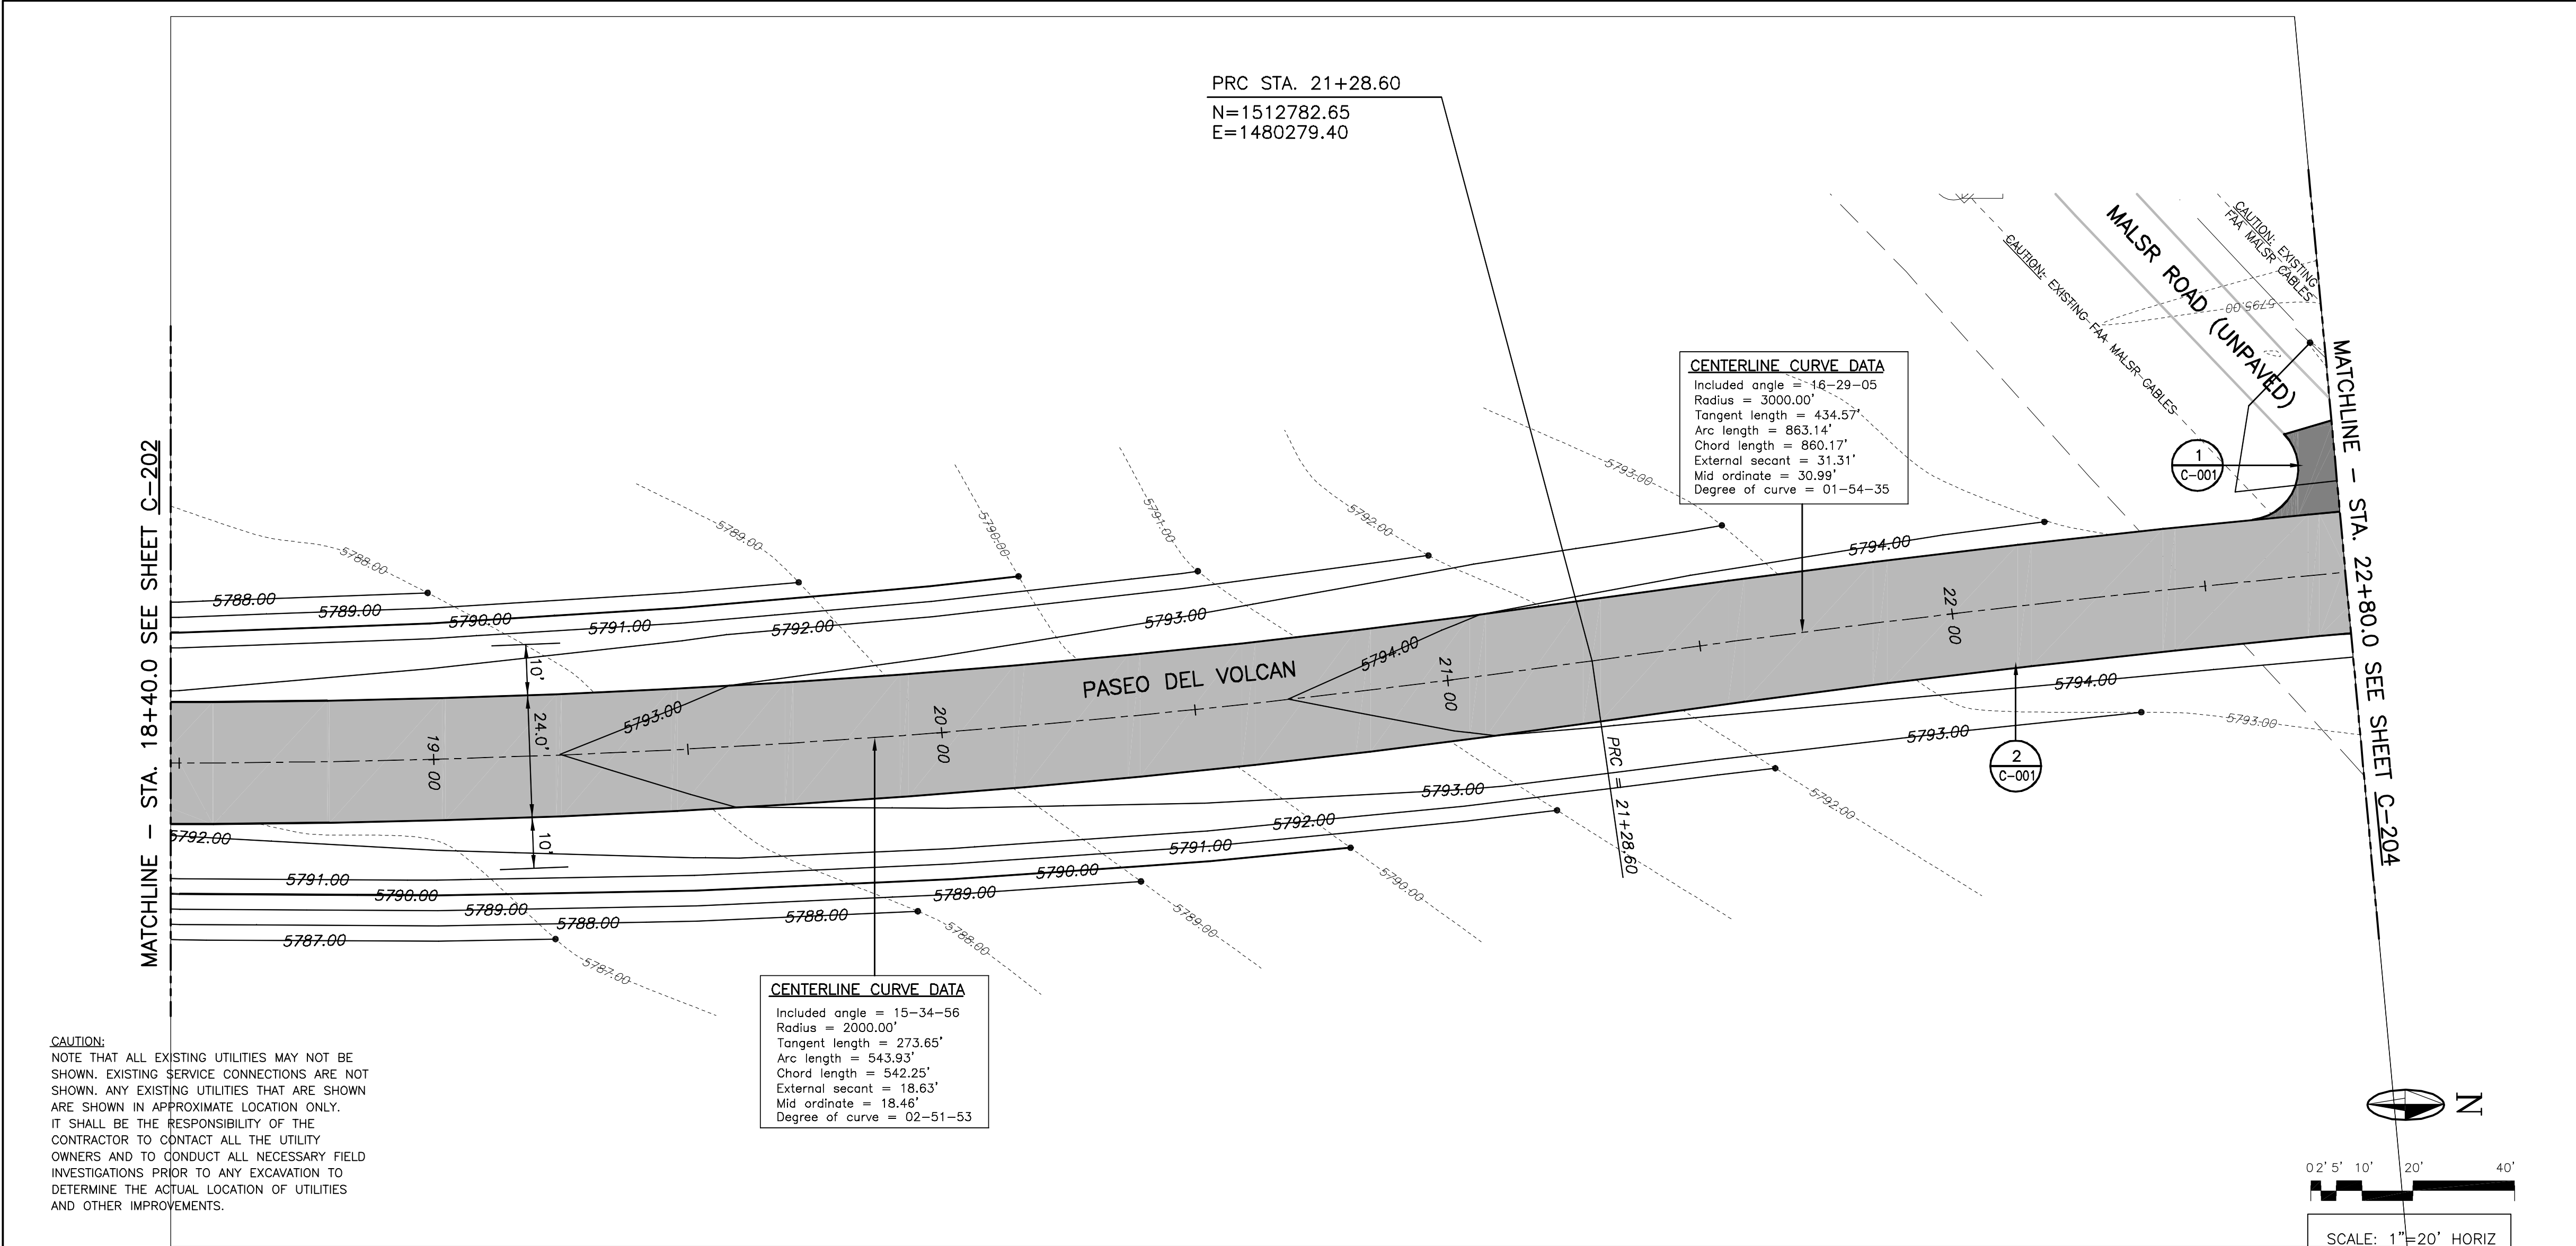

GENERAL NOTES

- ALL DISTURBED AREA WILL BE SEEDED PER NMDOT STANDARDS AND SPECIFICATIONS.

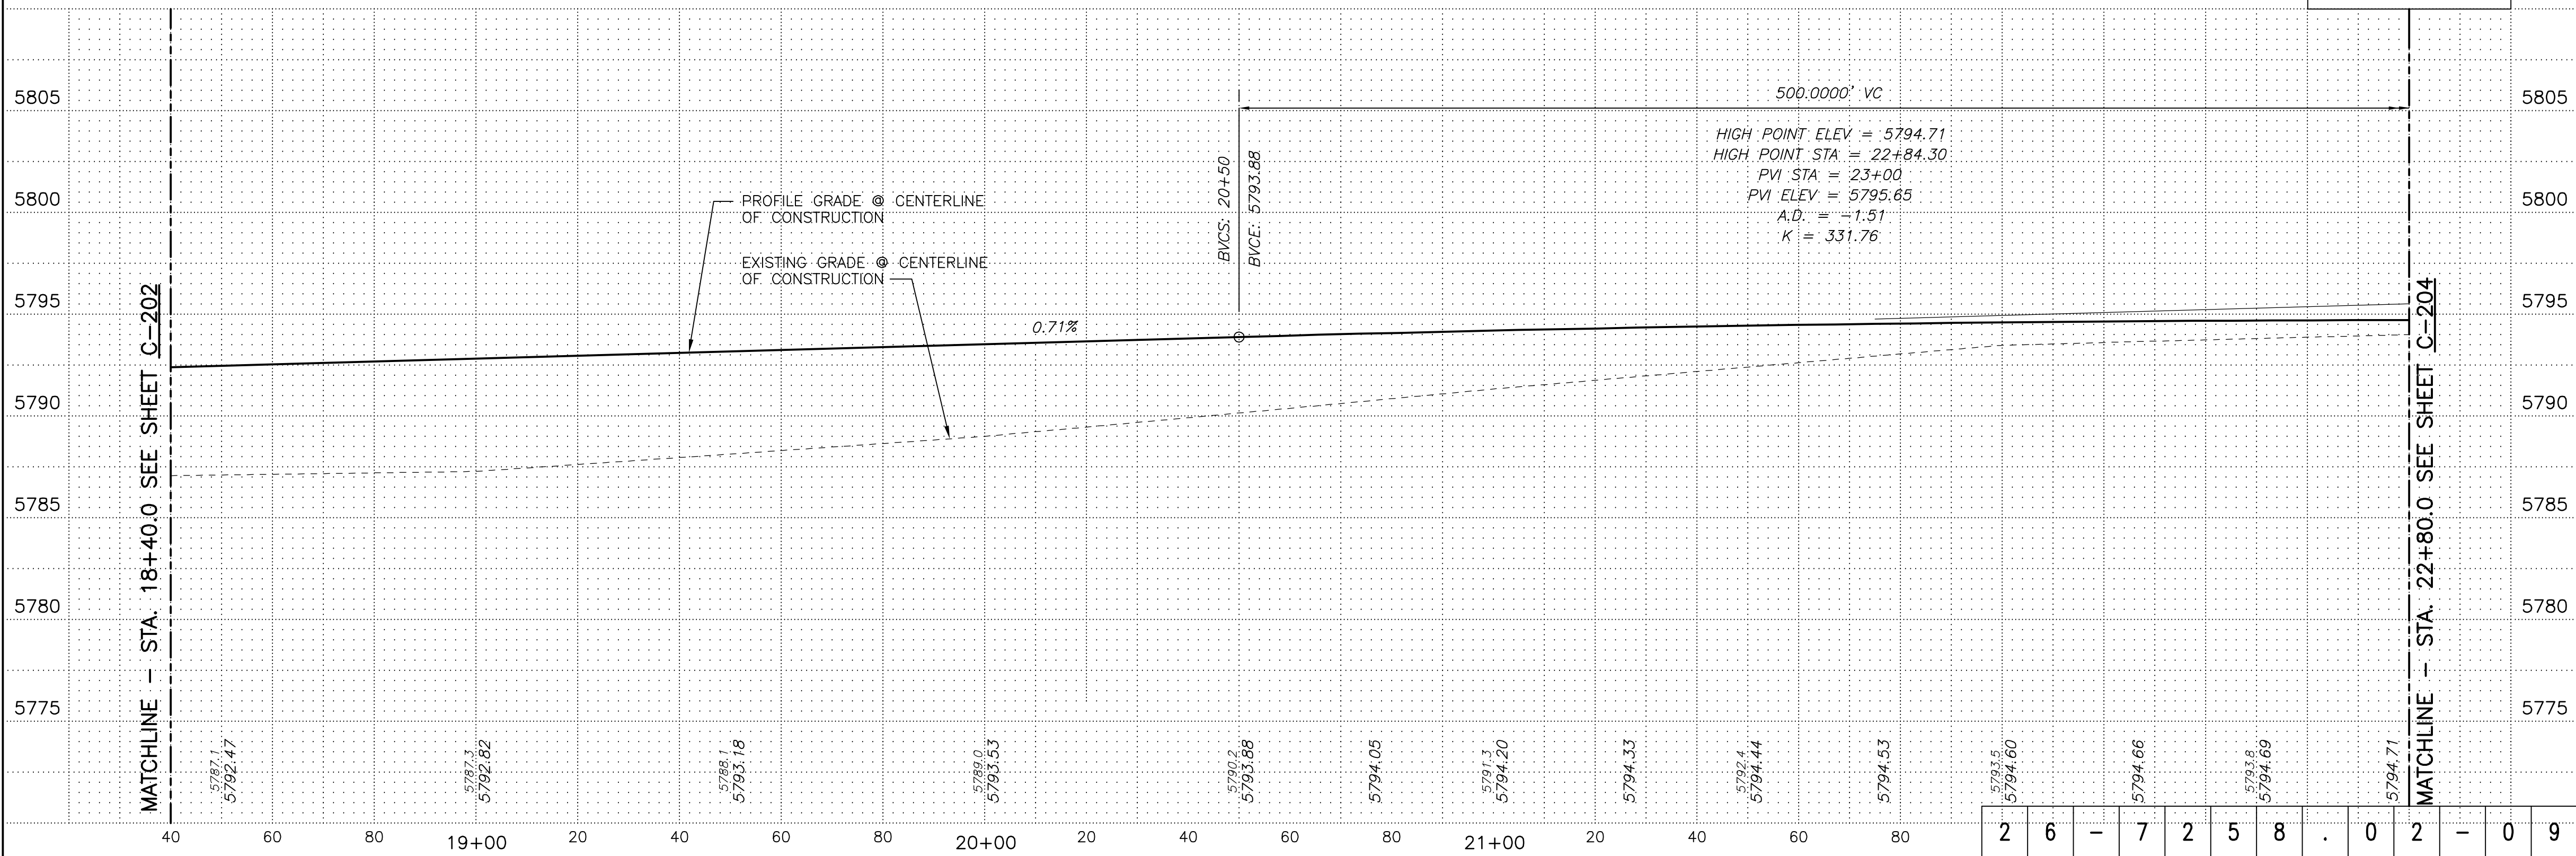

RECORD DRAWING

DATE: 03/17/09 DRAWN BY: JCB

THESE RECORD DRAWINGS HAVE BEEN PREPARED, IN PART, ON THE BASIS OF INFORMATION COMPILED AND FURNISHED BY OTHERS. MOLZEN-CORBIN AND ASSOCIATES WILL NOT BE RESPONSIBLE FOR ANY ERRORS OR OMISSIONS WHICH HAVE BEEN INCORPORATED INTO THIS DOCUMENT AS A RESULT.

2701 MILES RD SE
ALBUQUERQUE, NM 87106
TEL: 505.242.6700
FAX: 505.242.0673

MOLZEN-CORBIN & Associates
ENGINEERS/ARCHITECTS/PLANNERS

CITY OF ALBUQUERQUE
PUBLIC WORKS DEPARTMENT
ENGINEERING DEVELOPMENT GROUP

TITLE: PASEO DEL VOLCAN DOUBLE EAGLE II ACCESS ROAD REALIGNMENT

PASEO DEL VOLCAN PLAN AND PROFILE
STA. 18+40.0 TO STA. 22+80.0


Design Review Committee	City Engineer Approval	Last Design Update	Mo./Day/Yr.	Mo./Day/Yr.
City Project No.	725802	Zone Map No.	E-5 & E-6	Sheet C-203 Of

ENGINEER'S SEAL		SURVEY INFORMATION		BENCH MARKS		AS BUILT INFORMATION	
			</				

CENTERLINE CURVE DATA
 Included angle = 16-29-05
 Radius = 3000.00'
 Tangent length = 434.57'
 Arc length = 863.14'
 Chord length = 860.17'
 External secant = 31.31'
 Mid ordinate = 30.99'
 Degree of curve = 01-54-35

Matchlines:
 MATCHLINE - STA. 22+80.0 SEE SHEET C-203
 MATCHLINE - STA. 27+20.0 SEE SHEET C-205

Scale:
 0' 2' 5' 10' 20'
 SCALE: 1"=20' H

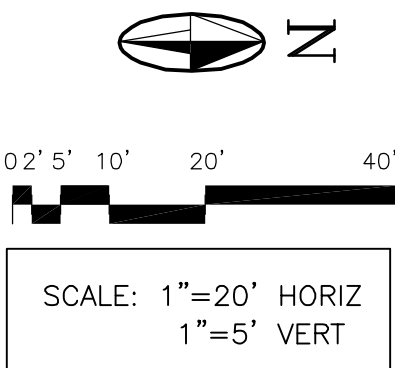

RECORD DRAWING	
DATE: 03/17/09	DRAWN BY: JCB
THESE RECORD DRAWINGS HAVE BEEN PREPARED, IN PART, ON THE BASIS ON INFORMATION COMPILED AND FURNISHED BY OTHERS, MOLZEN-CORBIN AND ASSOCIATES WILL NOT BE RESPONSIBLE FOR ANY ERRORS OR OMISSIONS WHICH HAVE BEEN INCORPORATED INTO THIS DOCUMENT AS A RESULT.	

2701 MILES RD SE
ALBUQUERQUE, NM 87106
TEL: 505.242-5700
FAX: 505.242-0673





MOLZEN-CORBIN & Associates
ENGINEERS/ARCHITECTS/PLANNERS

GENERAL NOTES

- ALL DISTURBED AREA WILL BE SEEDED PER NMDOT STANDARDS AND SPECIFICATIONS.

[illegible]

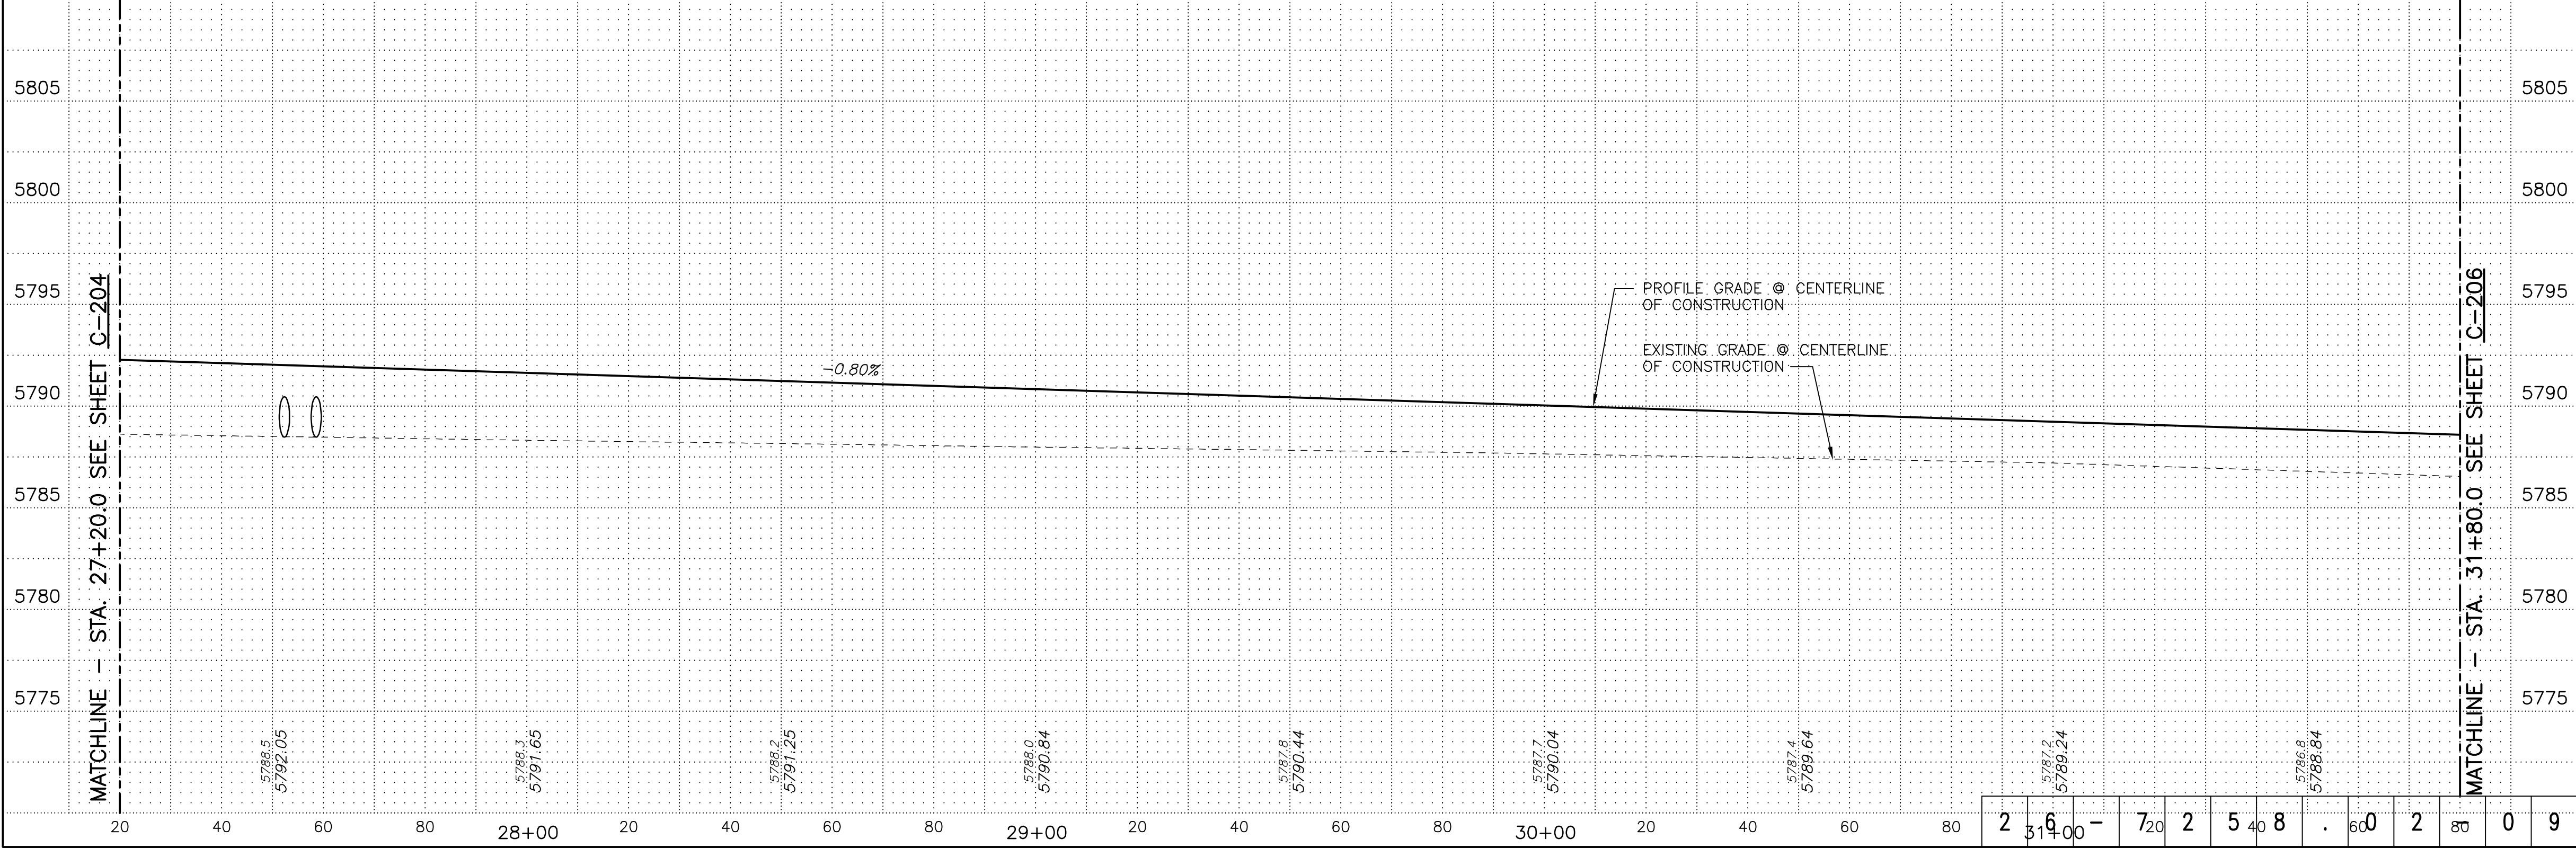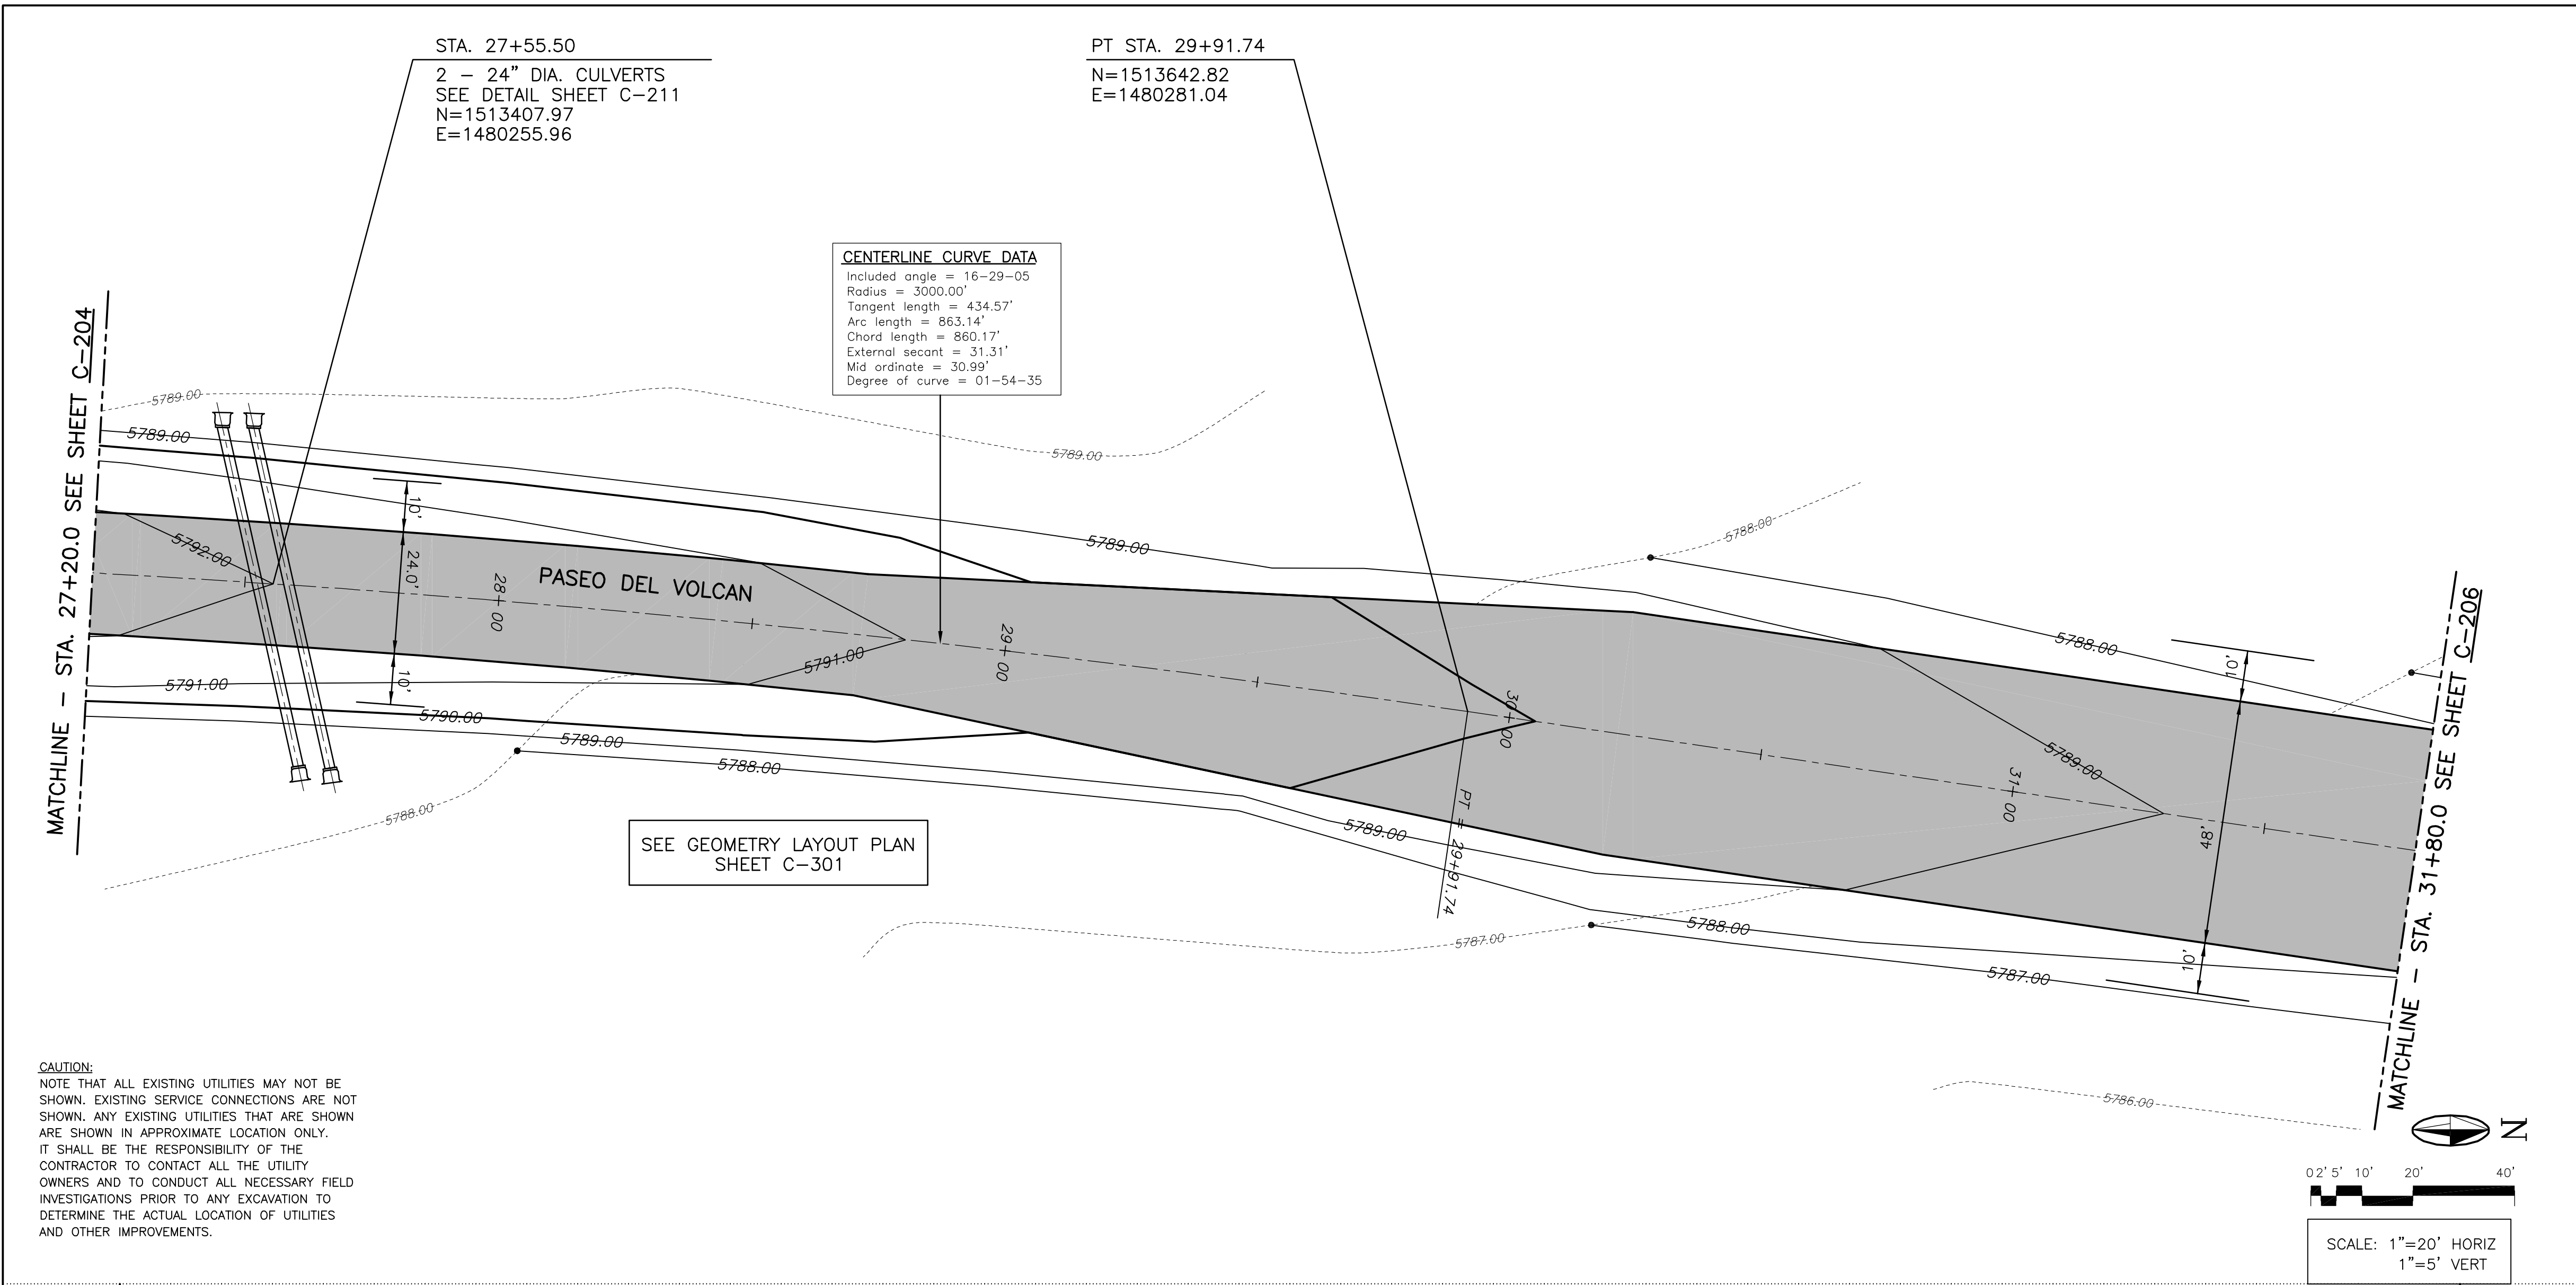

- GENERAL NOTES**
- ALL DISTURBED AREA WILL BE SEEDED PER NMDOT STANDARDS AND SPECIFICATIONS.

RECORD DRAWING

DATE: 03/17/09	DRAWN BY: JCB
-------------------	------------------

THESE RECORD DRAWINGS HAVE BEEN PREPARED, IN PART, ON THE BASIS OF INFORMATION COMPILED AND FURNISHED BY OTHERS. MOLZEN-CORBIN AND ASSOCIATES WILL NOT BE RESPONSIBLE FOR ANY ERRORS OR OMISSIONS WHICH HAVE BEEN INCORPORATED INTO THIS DOCUMENT AS A RESULT.




CITY OF ALBUQUERQUE
PUBLIC WORKS DEPARTMENT
ENGINEERING DEVELOPMENT GROUP

TITLE: PASEO DEL VOLCAN DOUBLE EAGLE II ACCESS ROAD REALIGNMENT

PASEO DEL VOLCAN PLAN AND PROFILE
STA. 27+20.0 TO STA. 31+80.0

Design Review Committee	City Engineer Approval	Last Design Update	Mo./Day/Yr.	Mo./Day/Yr.
City Project No. 725802	Zone Map No. E-5 & E-6	Sheet C-205	Of	

ENGINEER'S SEAL		SURVEY INFORMATION		BENCH MARKS		AS BUILT INFORMATION	
						</	

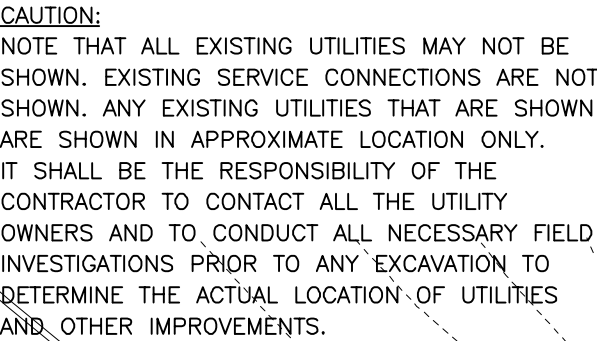



- ALL DISTURBED AREA WILL BE SEEDED PER NMDOT STANDARDS AND SPECIFICATIONS.

2701 MILES RD SE
ALBUQUERQUE, NM 87106
TEL: 505.242-5700
FAX: 505.242-0673



MOLZEN-CORBIN & Associates
ENGINEERS/ARCHITECTS/PLANNERS

Design Review Committee	City Engineer Approval	Last Design Update	Mo./Day/Yr.	Mo./Day/Yr.

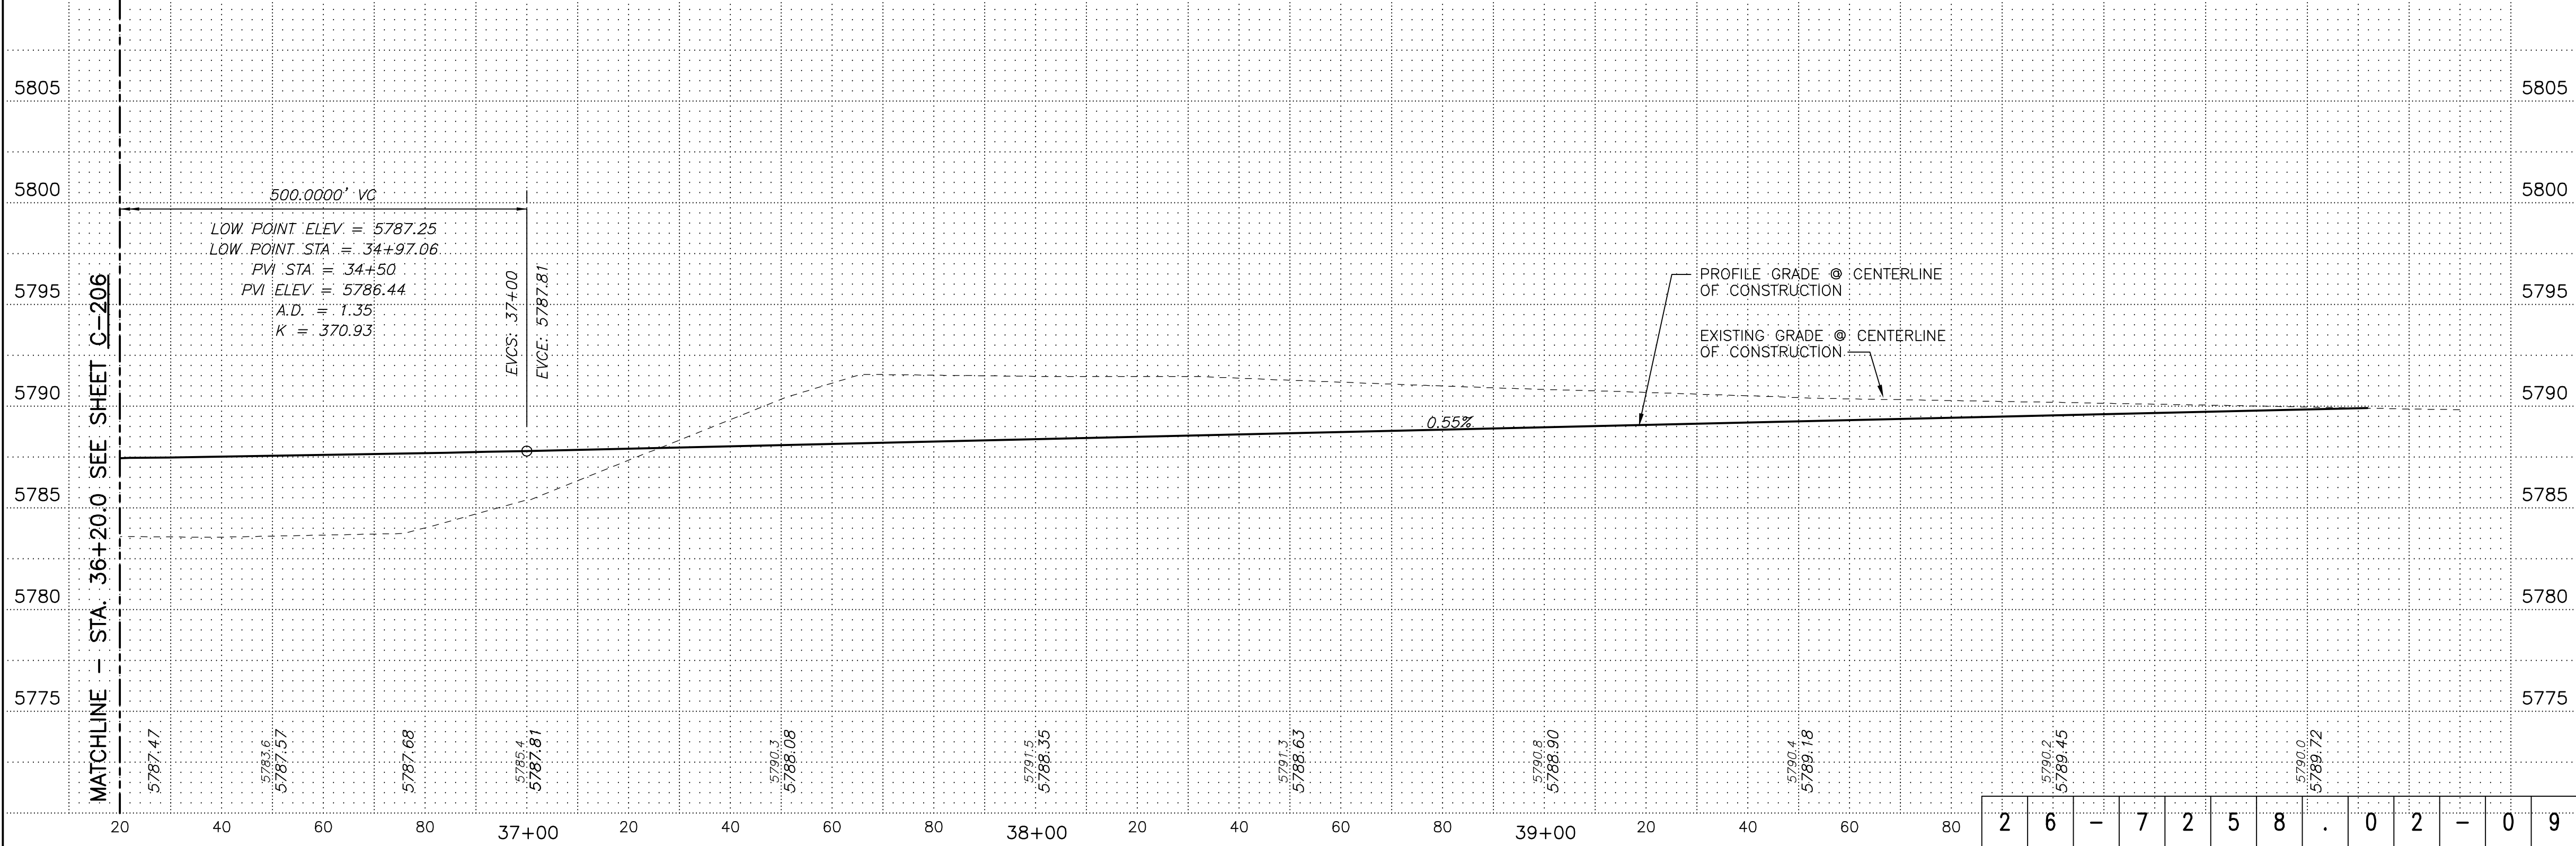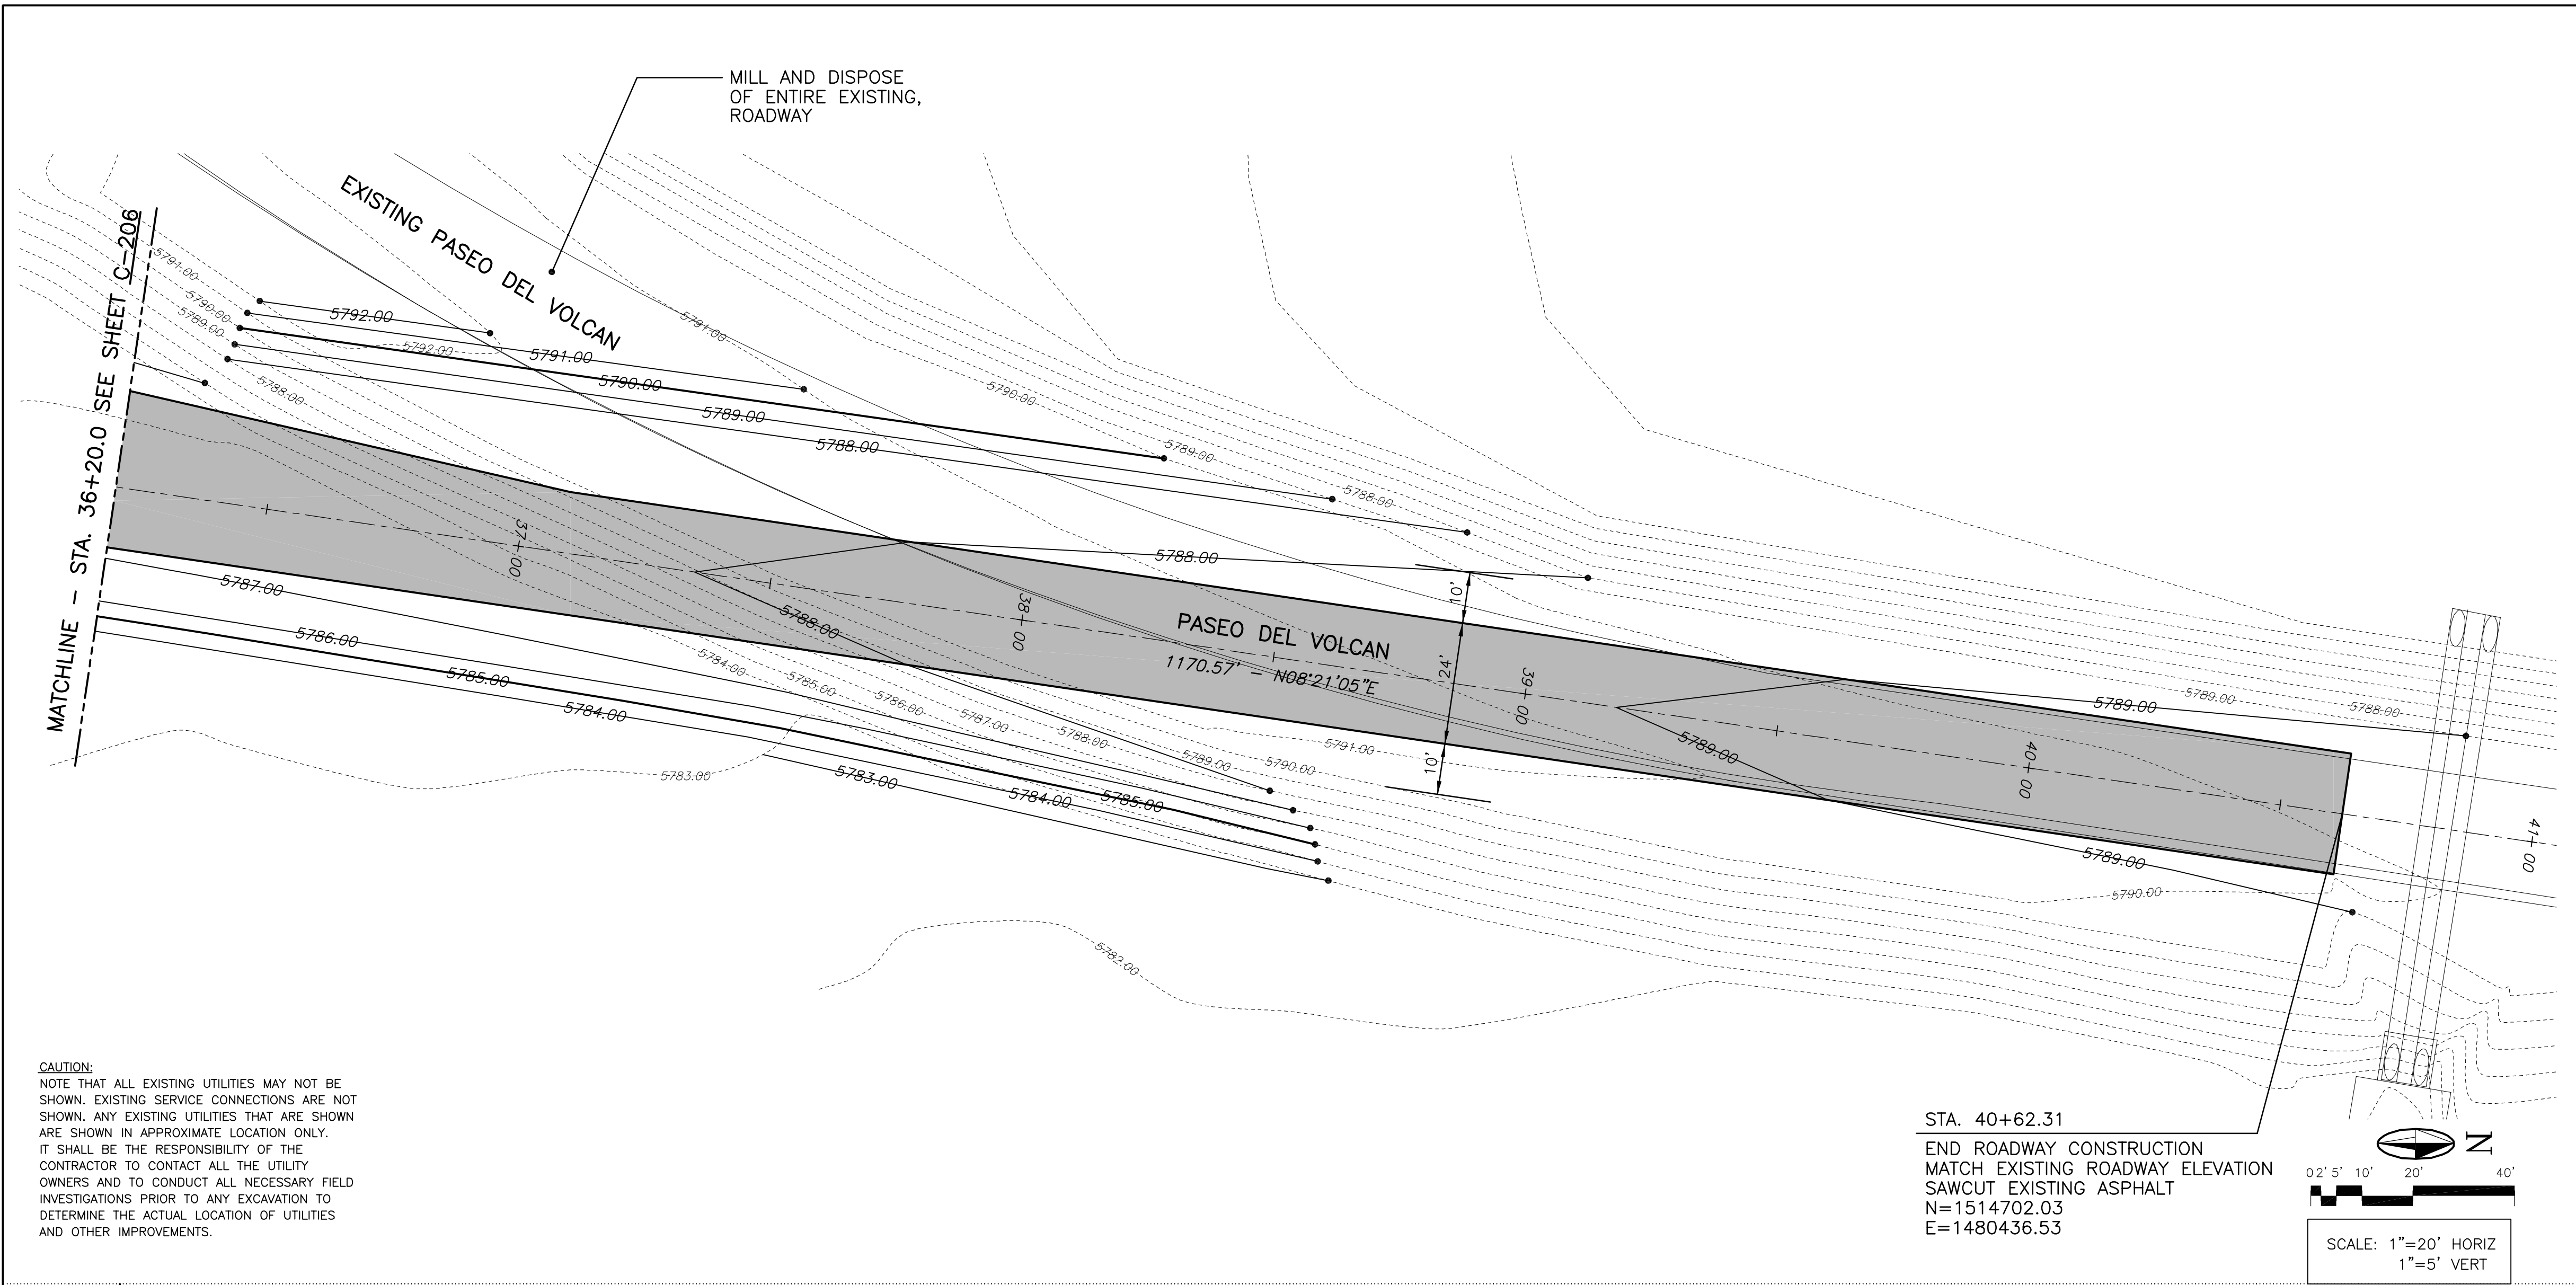

GENERAL NOTES



- ALL DISTURBED AREA WILL BE SEEDED PER NMDOT STANDARDS AND SPECIFICATIONS.

RECORD DRAWING	
DATE: 03/17/09	DRAWN BY: JCB
THESE RECORD DRAWINGS HAVE BEEN PREPARED, IN PART, ON THE BASIS OF INFORMATION COMPILED AND FURNISHED BY OTHERS. MOLZEN-CORBIN AND ASSOCIATES WILL NOT BE RESPONSIBLE FOR ANY ERRORS OR OMISSIONS WHICH HAVE BEEN INCORPORATED INTO THIS DOCUMENT AS A RESULT.	



CITY OF ALBUQUERQUE PUBLIC WORKS DEPARTMENT ENGINEERING DEVELOPMENT GROUP			
TITLE: PASEO DEL VOLCAN DOUBLE EAGLE II ACCESS ROAD REALIGNMENT			
PASEO DEL VOLCAN PLAN AND PROFILE STA. 36+20.0 TO END OF ROAD			
Design Review Committee	City Engineer Approval	Last Design Update	
		Mo./Day/Yr.	Mo./Day/Yr.
City Project No. 725802		Zone Map No. E-5 & E-6	Sheet C-207 Of

ENGINEER'S SEAL		SURVEY INFORMATION		BENCH MARKS		AS BUILT INFORMATION	
		FIELD NOTES		SEE SURVEY CONTROL PLAN SHEET G-006			
		NO.	BY	DATE			
					WORK STAKED BY		DATE
					INSPECTED BY		DATE
					ACCEPTANCE BY		DATE
					FIELD VERIFICATION BY		DATE
					DRAWINGS		DATE
					CORRECTED BY		DATE
				MICRO-FILM INFORMATION			
					RECORDED BY		DATE
					NO.		

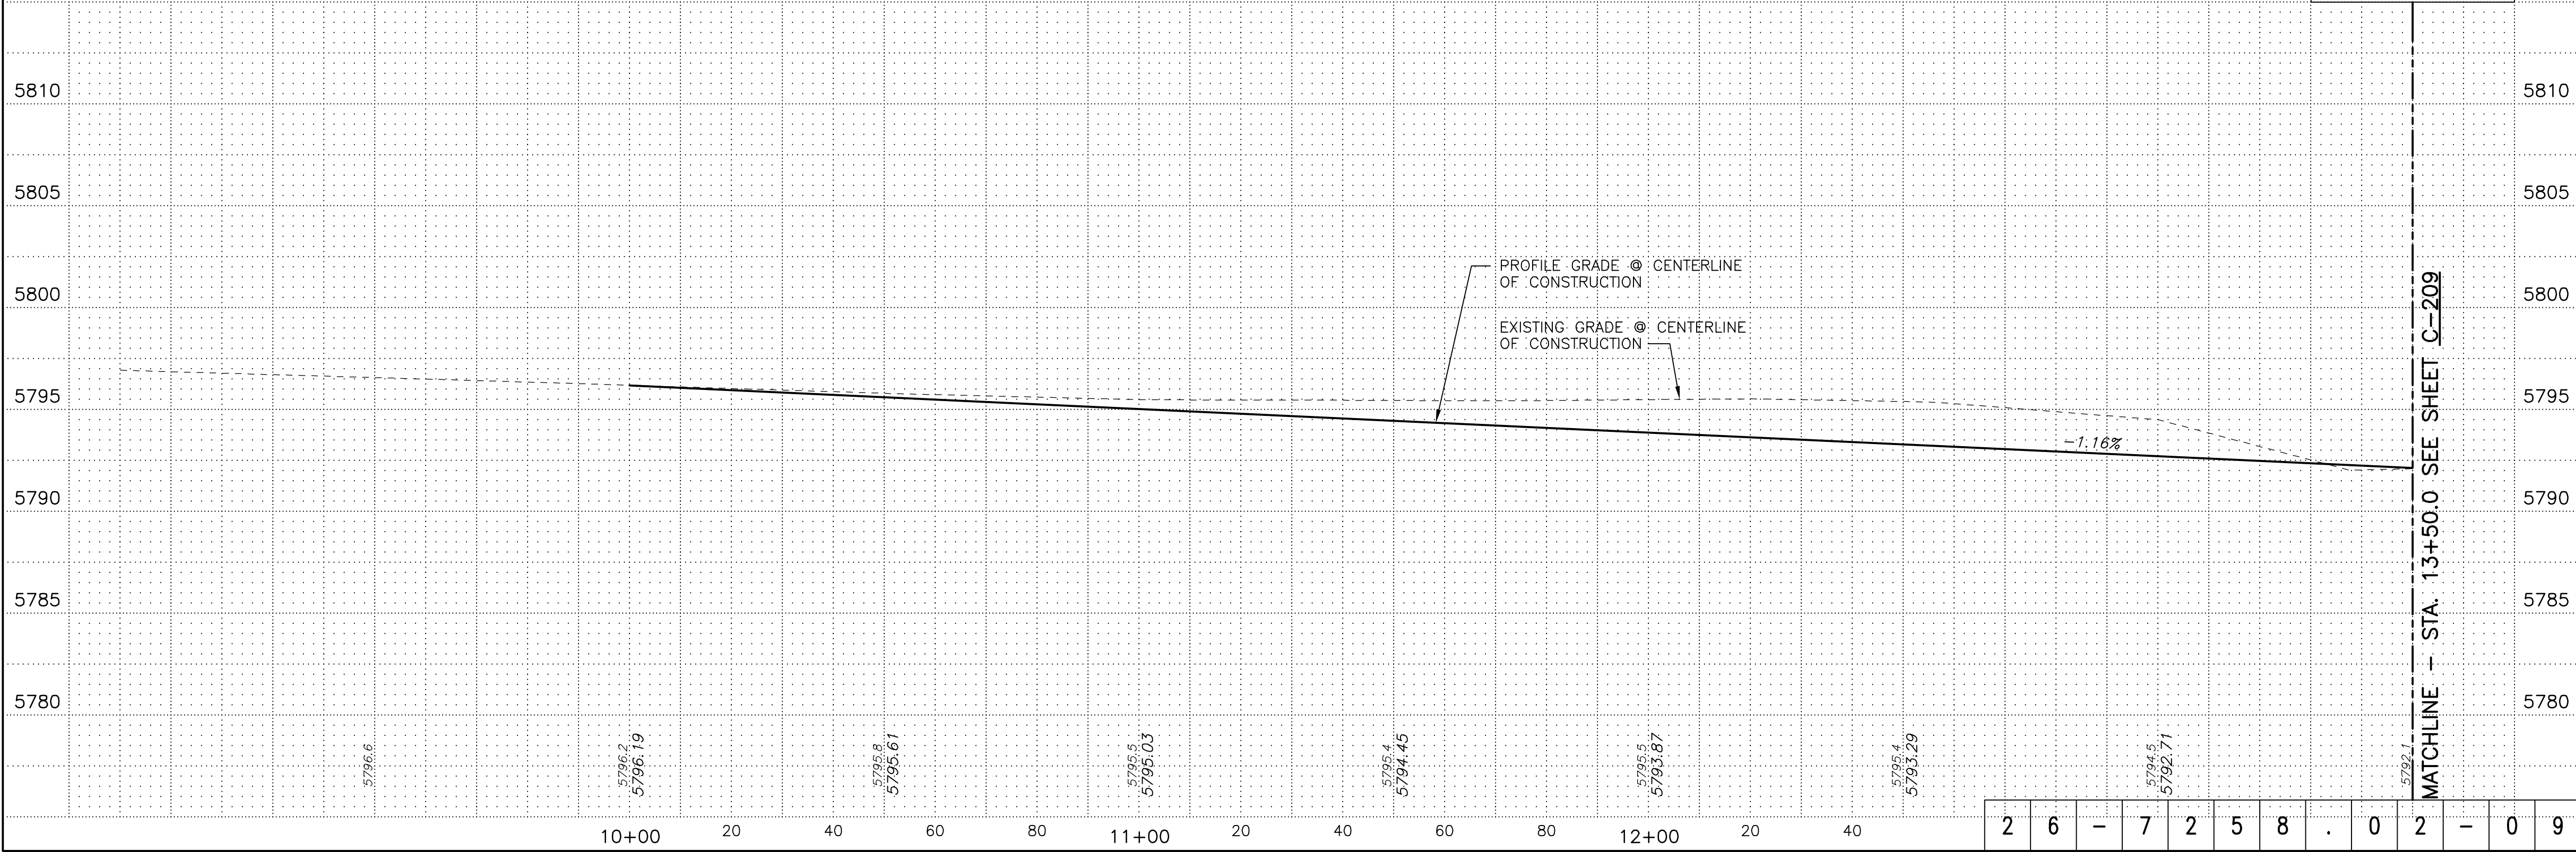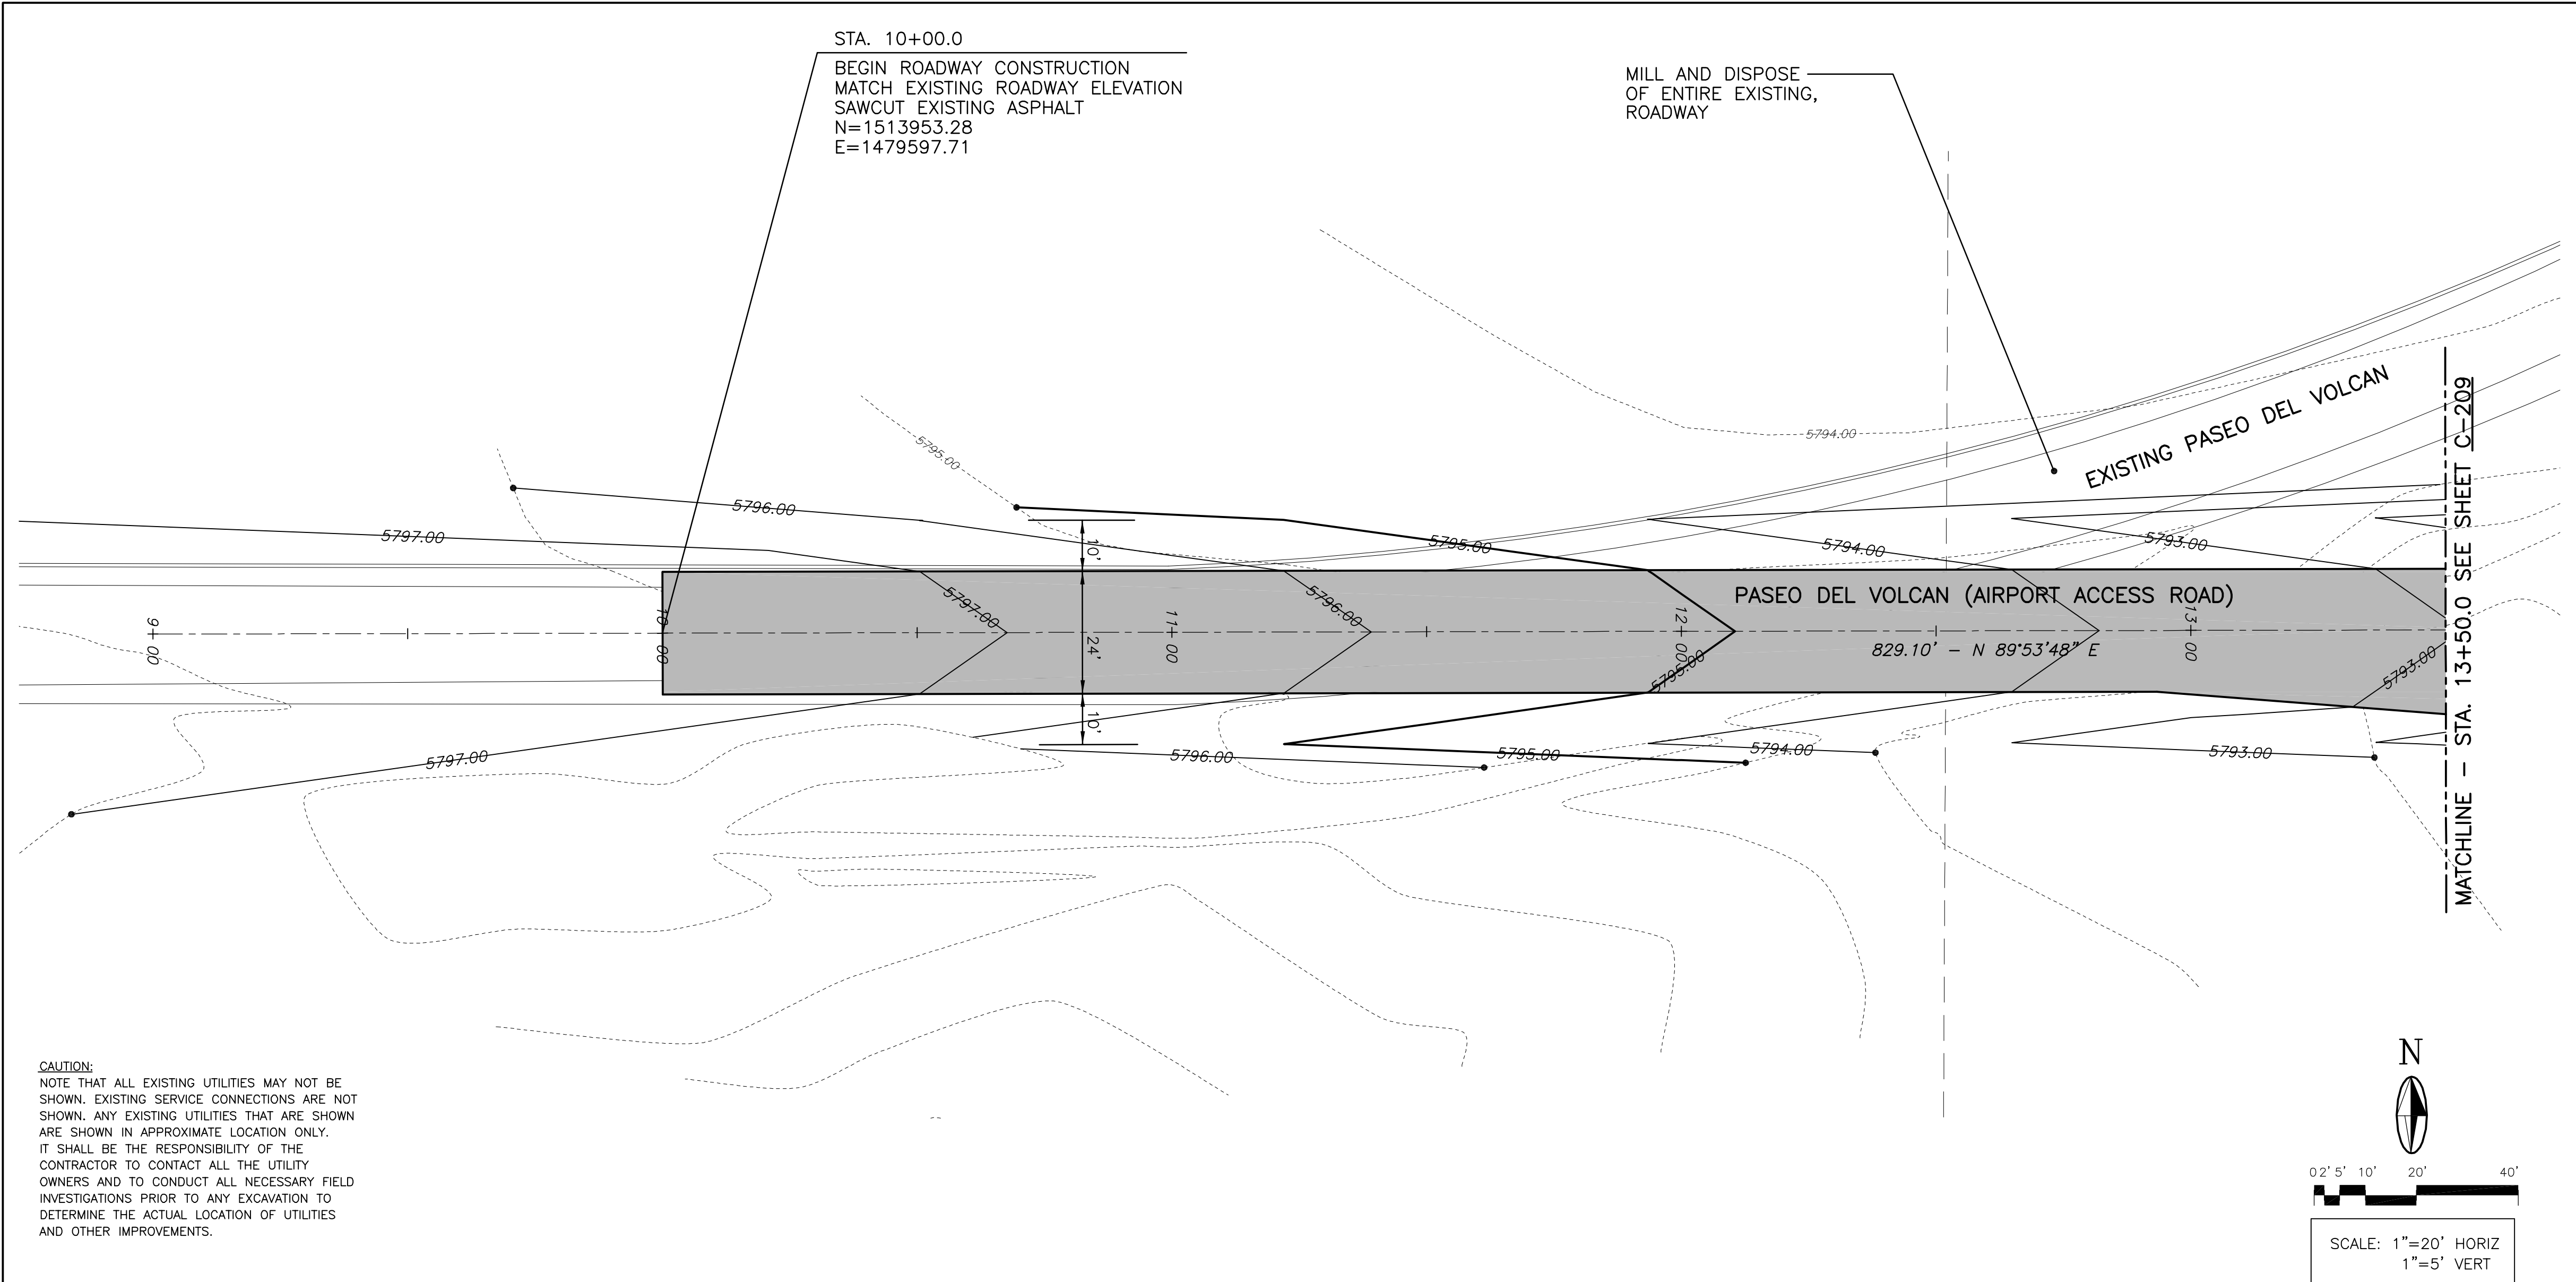

GENERAL NOTES

- ALL DISTURBED AREA WILL BE SEEDED PER NMDOT STANDARDS AND SPECIFICATIONS.

ENGINEER'S SEAL		SURVEY INFORMATION		BENCH MARKS		AS BUILT INFORMATION	
NO.	BY	DATE	NO.	BY	DATE	CONTRACTOR	DATE
						STAKED BY	DATE
						INSPECTED BY	DATE
						FIELD	DATE
						ADJUSTMENT BY	DATE
						DRAWINGS	DATE
						CORRECTED BY	DATE
						MICRO-FILM INFORMATION	
						RECORDED BY	DATE
						NO.	

RECORD DRAWING

DATE: 03/17/09

DRAWN BY: JCB

THESE RECORD DRAWINGS HAVE BEEN PREPARED, IN PART, ON THE BASIS ON INFORMATION COMPILED AND FURNISHED BY OTHERS. MOLZEN-CORBIN AND ASSOCIATES WILL NOT BE RESPONSIBLE FOR ANY ERRORS OR OMISSIONS WHICH HAVE BEEN INCORPORATED INTO THIS DOCUMENT AS A RESULT.

2701 MILES RD SE
ALBUQUERQUE, NM 87106
TEL: 505.242-5700
FAX: 505.242-0673


MOLZEN-CORBIN & Associates
ENGINEERS/ARCHITECTS/PLANNERS

CITY OF ALBUQUERQUE
PUBLIC WORKS DEPARTMENT
ENGINEERING DEVELOPMENT GROUP

TITLE: PASEO DEL VOLCAN DOUBLE EAGLE II ACCESS ROAD REALIGNMENT
PASEO DEL VOLCAN AIRPORT ACCESS ROAD
PLAN AND PROFILE
STA. 10+00.0 TO STA. 13+50.0

Design	Review	Committee	City Engineer	Approval

City Project No. 725802

Zone Map No. E-5 & E-6

Sheet C-208 Of


Last Design Update


Mo./Day/Yr.	Mo./Day/Yr.


© COPYRIGHT

AB0082-11.D20

REDRAWN FOR RECORD PURPOSES

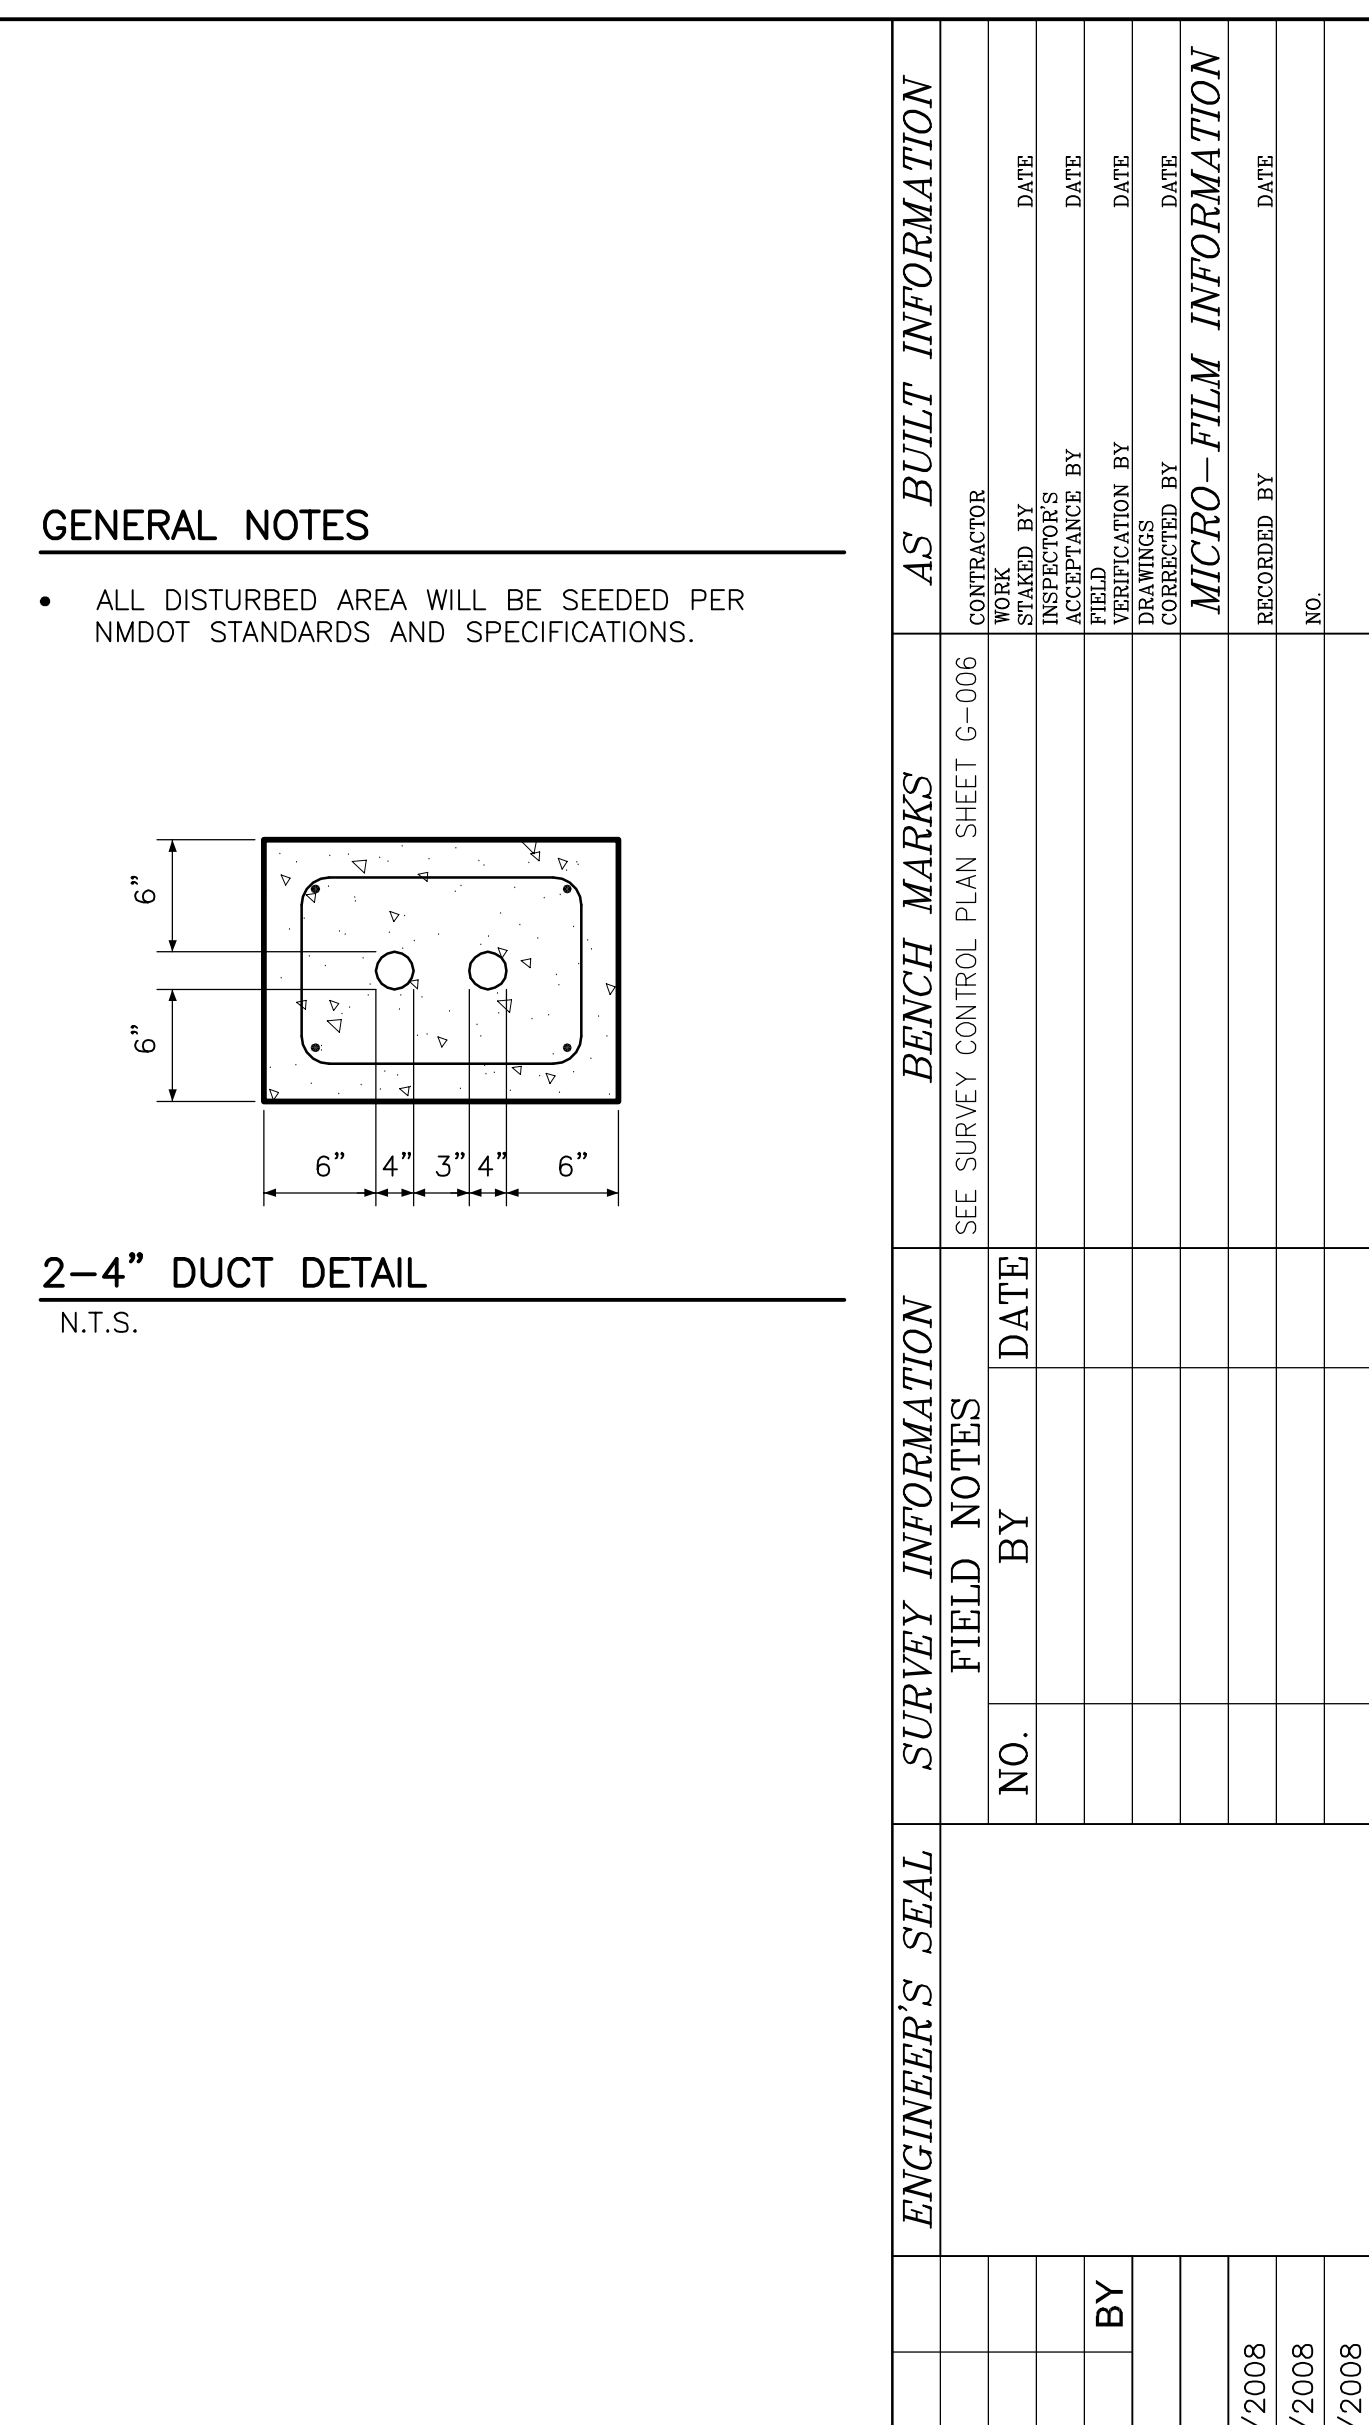

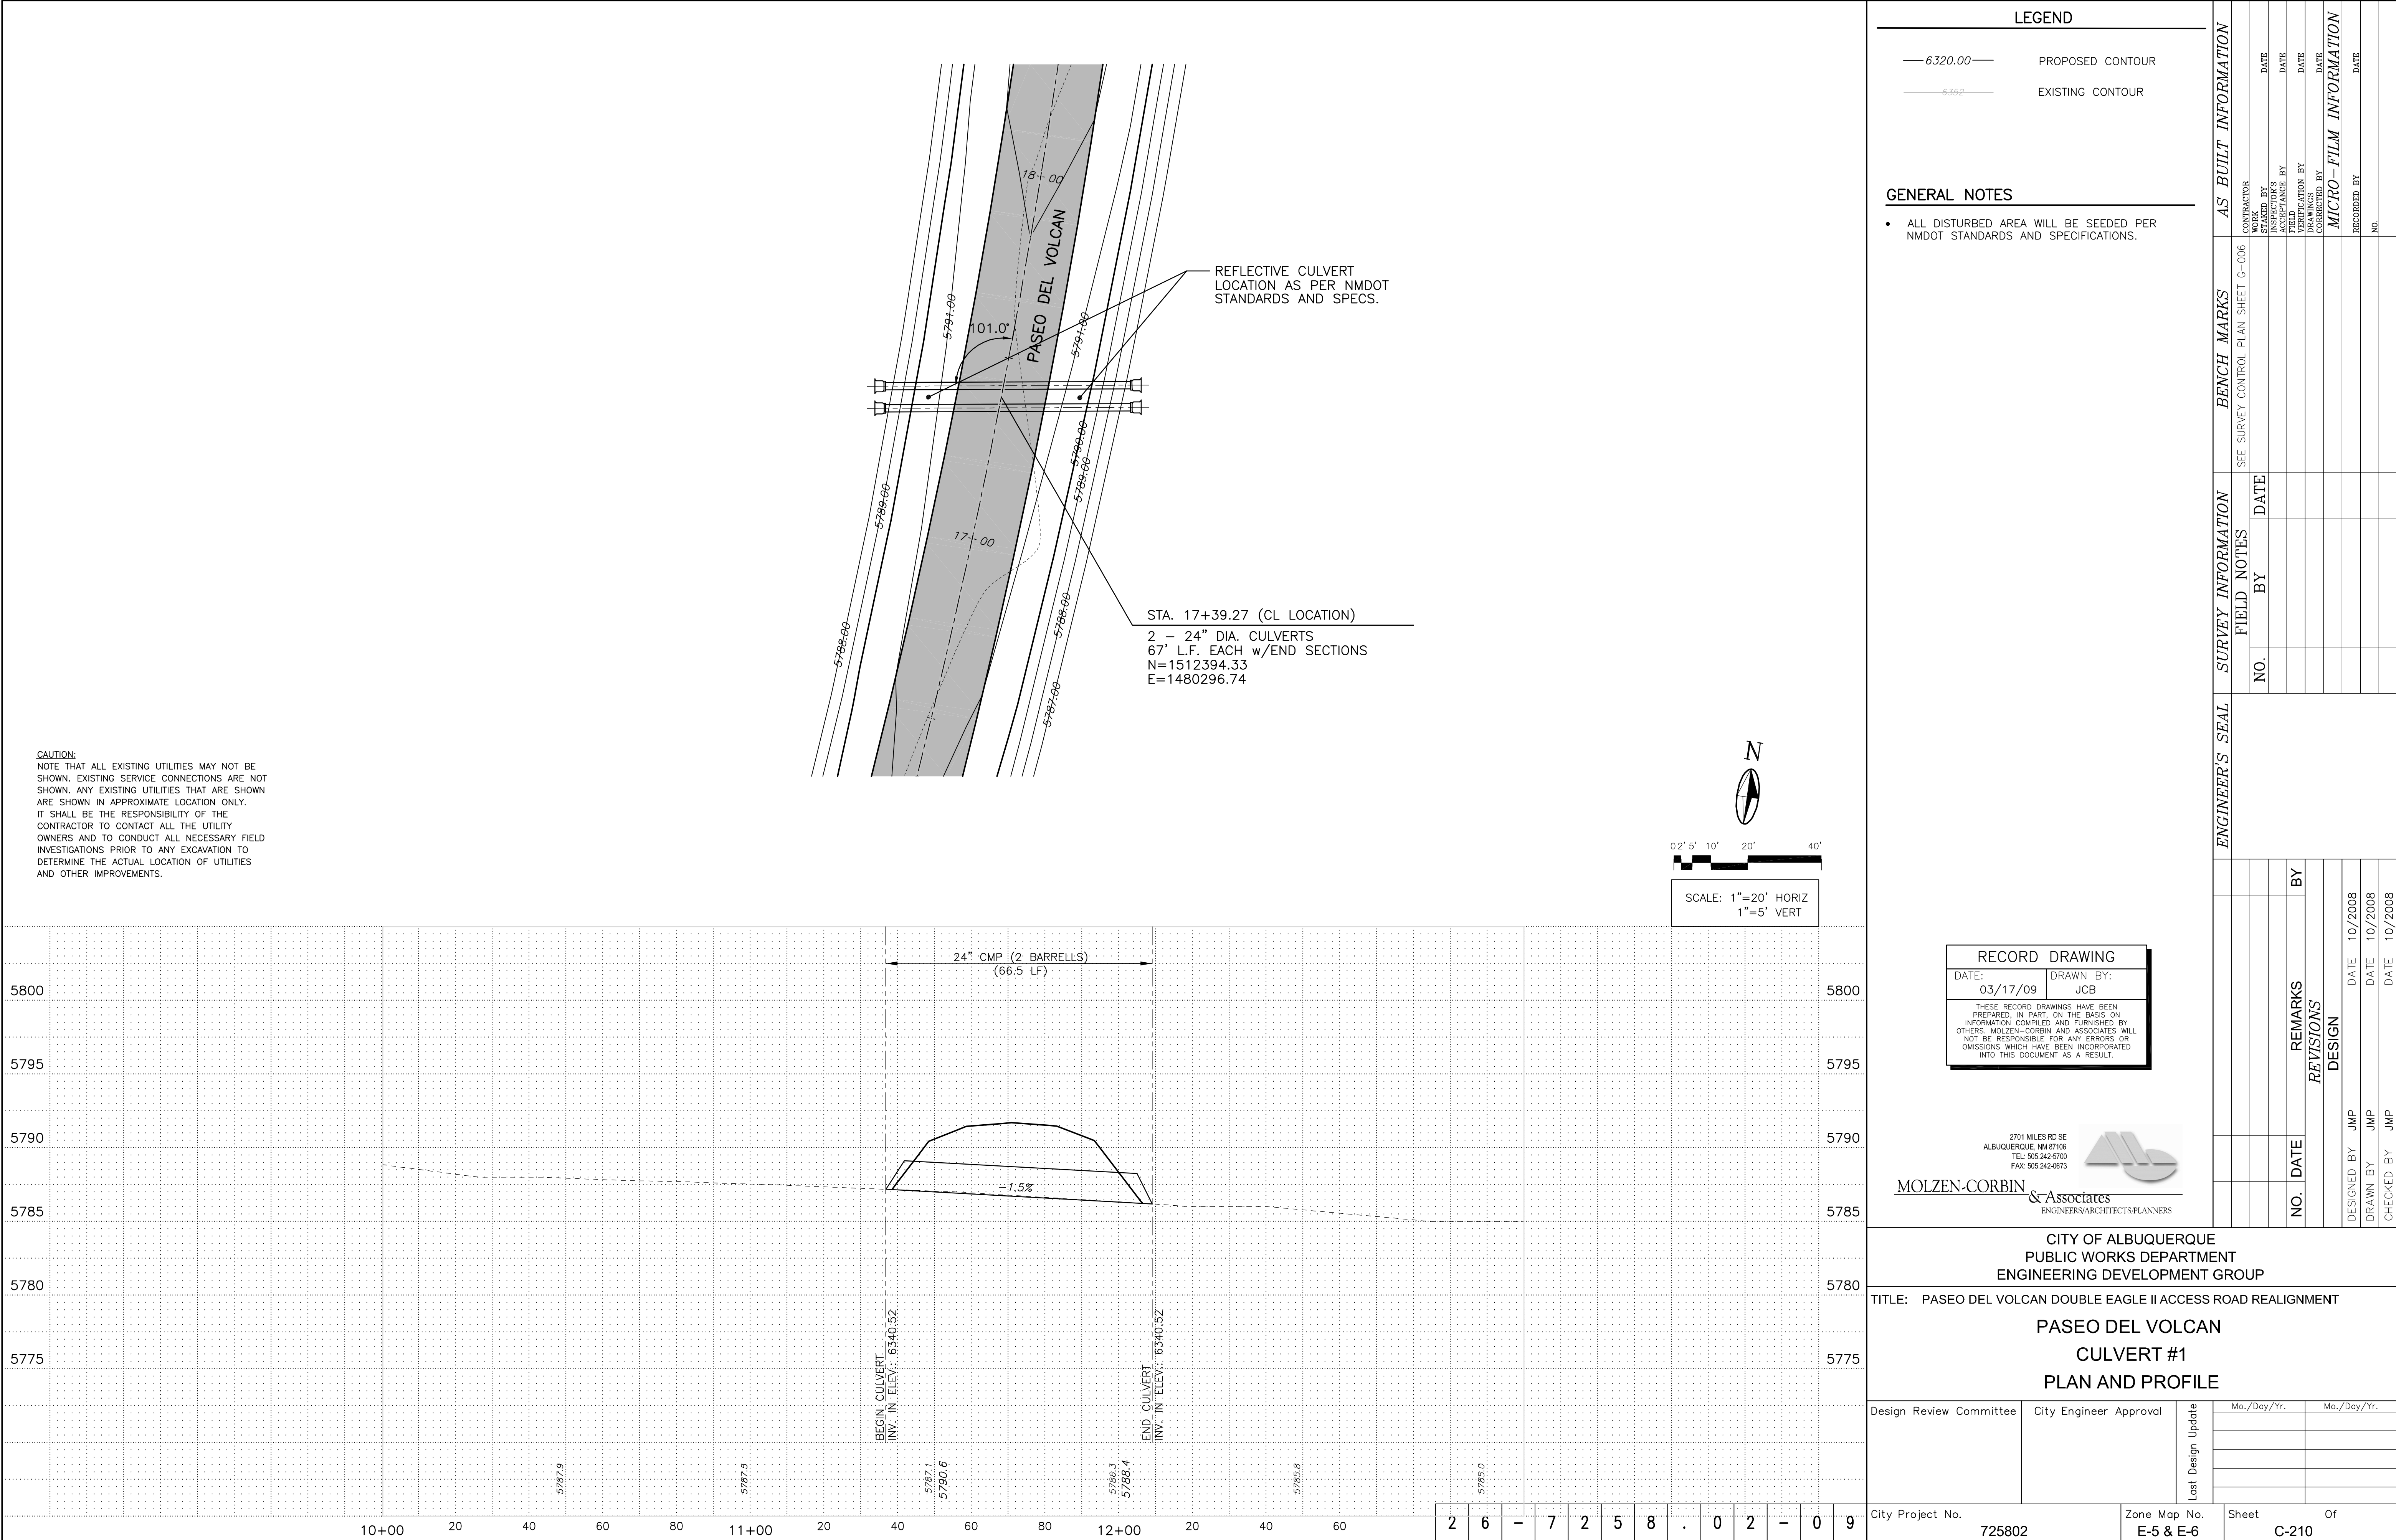

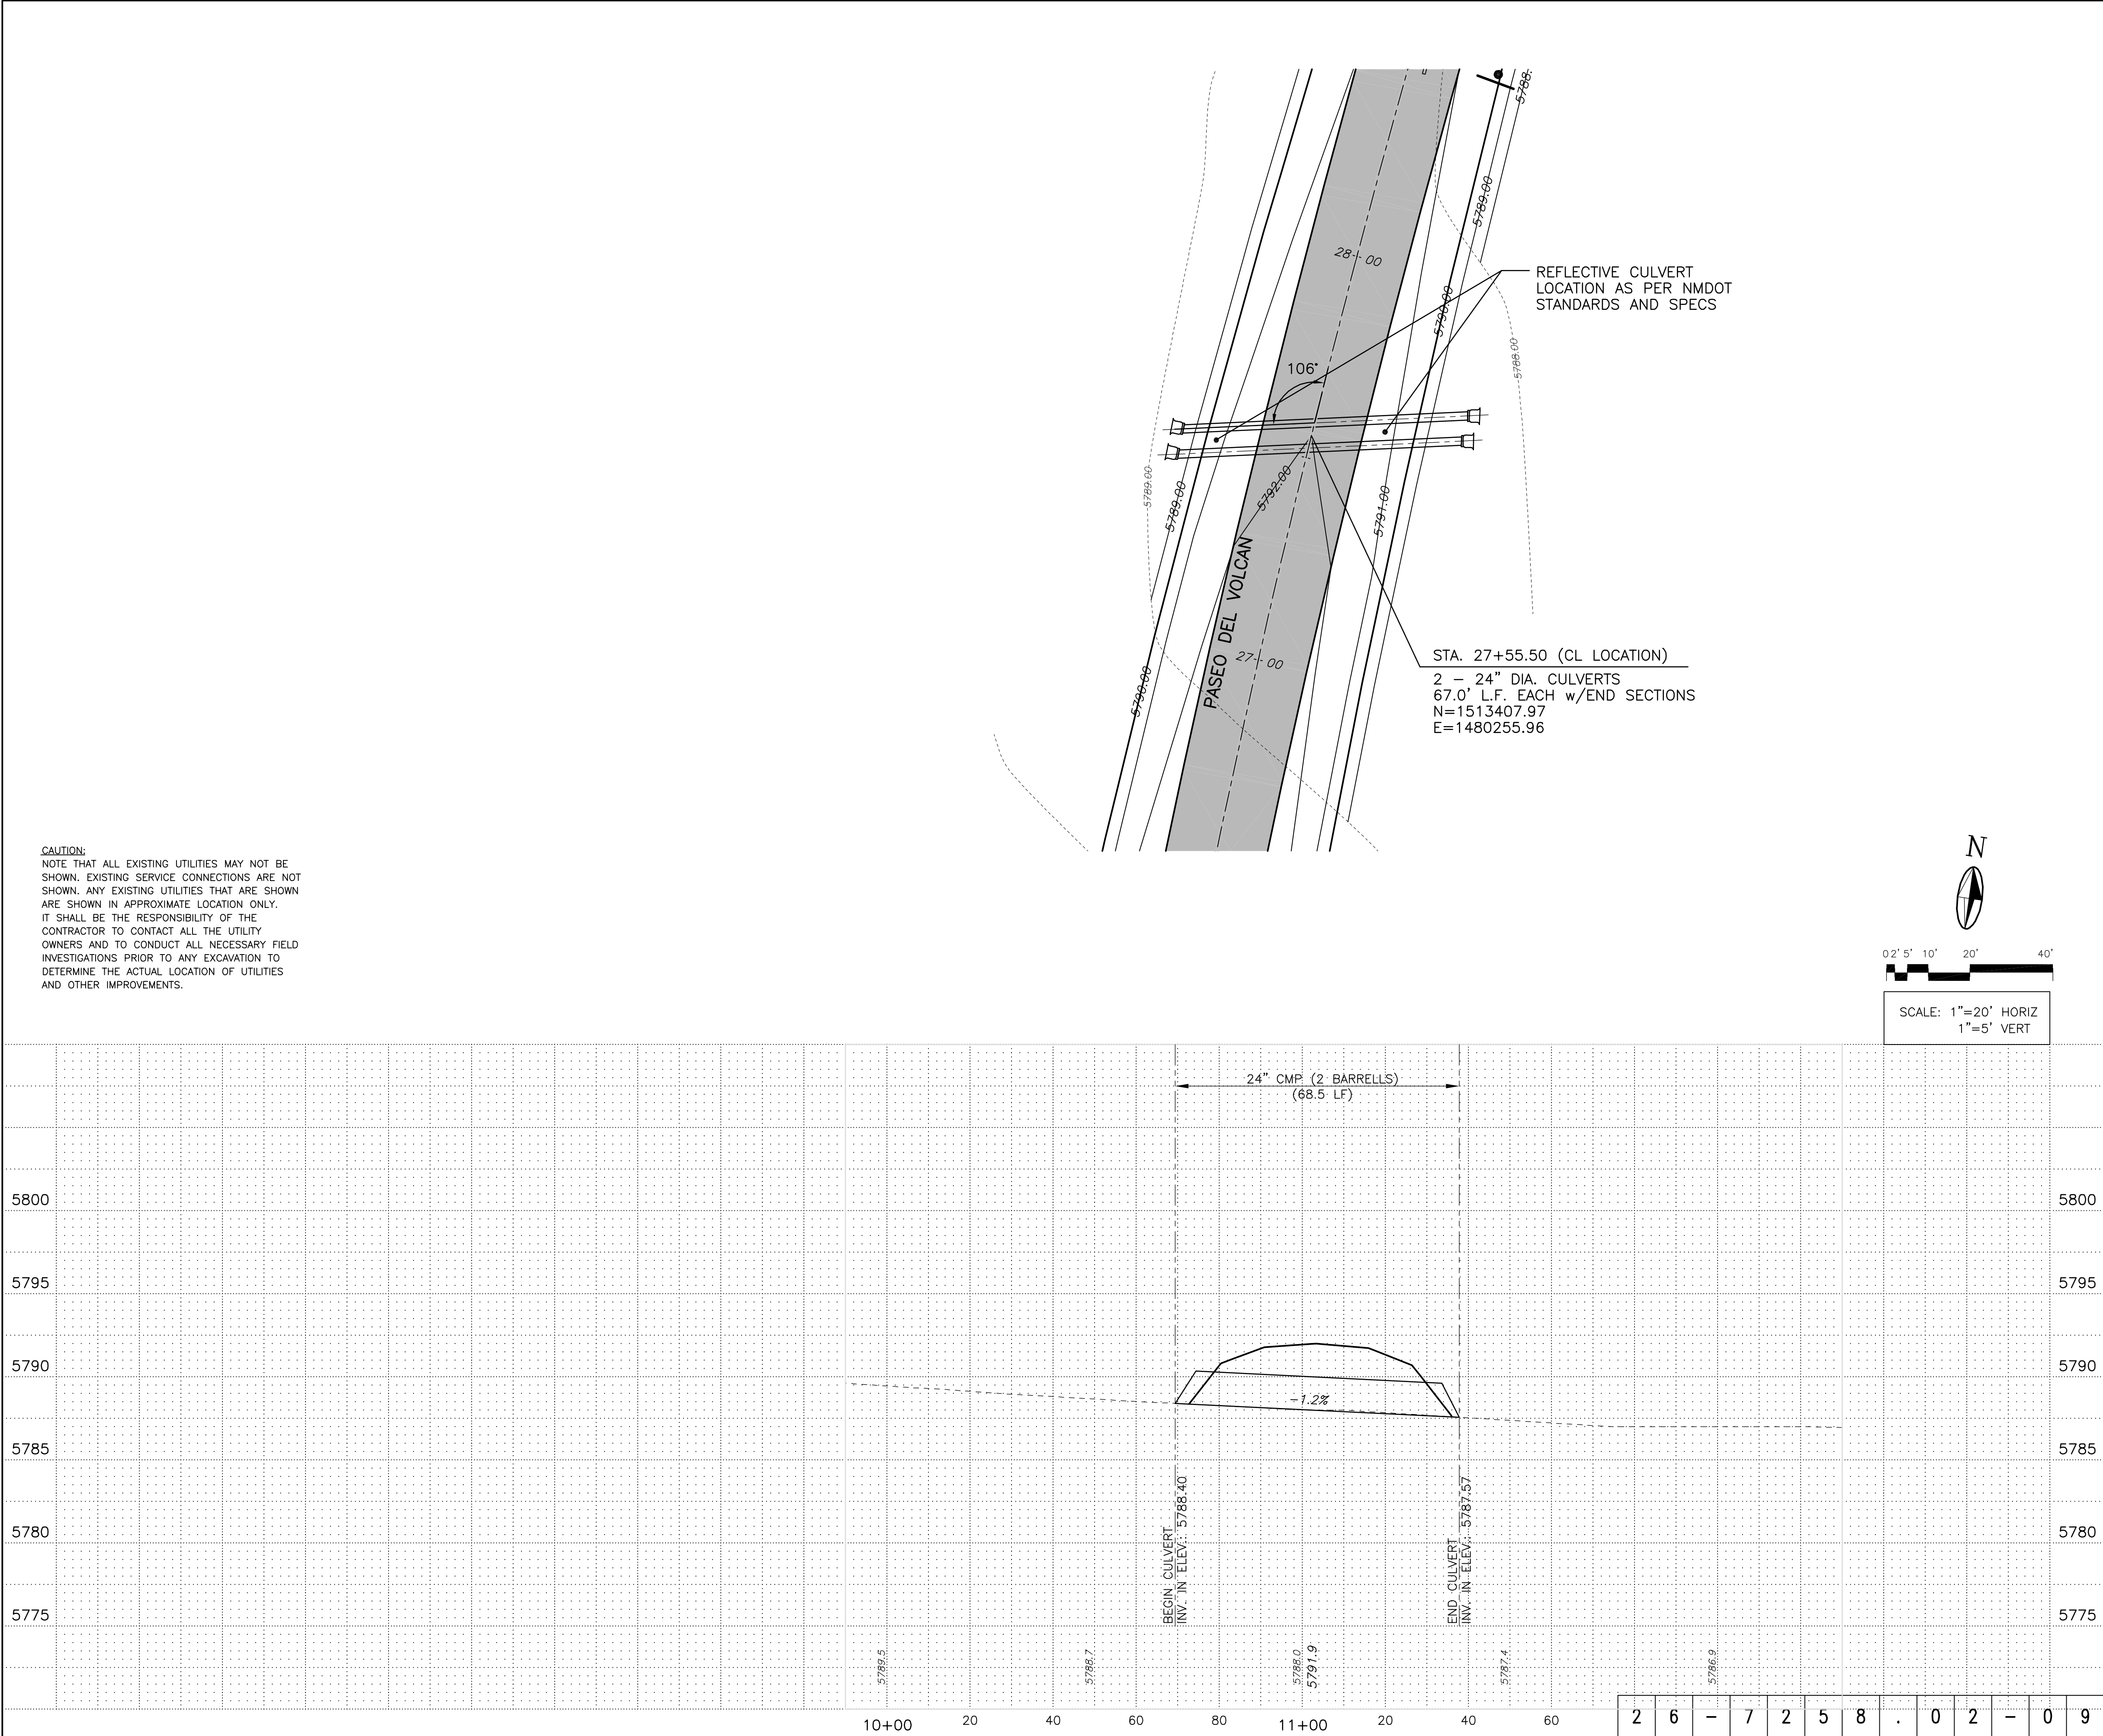

LEGEND

6320.00

PROPOSED CONTOUR

6320

EXISTING CONTOUR

GENERAL NOTES

ALL DISTURBED AREA WILL BE SEEDED PER NMDOT STANDARDS AND SPECIFICATIONS.

AS BUILT INFORMATION

CONTRACTOR

DATE

DESIGNED BY

DATE

CHECKED BY

DATE

RECORDED BY

DATE

NO.

DATE

BENCH MARKS

SEE SURVEY CONTROL PLAN SHEET C-006

SURVEY INFORMATION

FIELD NOTES

NO.

BY

DATE

ENGINEER'S SEAL

REMARKS

BY

NO.

DATE

DESIGNED BY

DATE

DRAWN BY

DATE

CHECKED BY

DATE

RECORD DRAWING

DATE: 03/17/09

DRAWN BY: JCB

THESE RECORD DRAWINGS HAVE BEEN PREPARED, IN PART, ON THE BASIS ON INFORMATION COMPILED AND FURNISHED BY OTHERS. MOLZEN-CORBIN AND ASSOCIATES WILL NOT BE RESPONSIBLE FOR ANY ERRORS OR OMISSIONS WHICH HAVE BEEN INCORPORATED INTO THIS DOCUMENT AS A RESULT.

2701 MILES RD SE
ALBUQUERQUE, NM 87106
TEL: 505.242-5700
FAX: 505.242-0673

MOLZEN-CORBIN & Associates
ENGINEERS/ARCHITECTS/PLANNERS

CITY OF ALBUQUERQUE
PUBLIC WORKS DEPARTMENT
ENGINEERING DEVELOPMENT GROUP

TITLE: PASEO DEL VOLCAN DOUBLE EAGLE II ACCESS ROAD REALIGNMENT
PASEO DEL VOLCAN
CULVERT #2
PLAN AND PROFILE

Design Review Committee

City Engineer Approval

Last Design Update

Mo./Day/Yr.

Mo./Day/Yr.

City Project No. 725802


Zone Map No. E-5 & E-6

Sheet C-211 Of

© COPYRIGHT

AB0082-11.D20

REDRAWN FOR RECORD PURPOSES

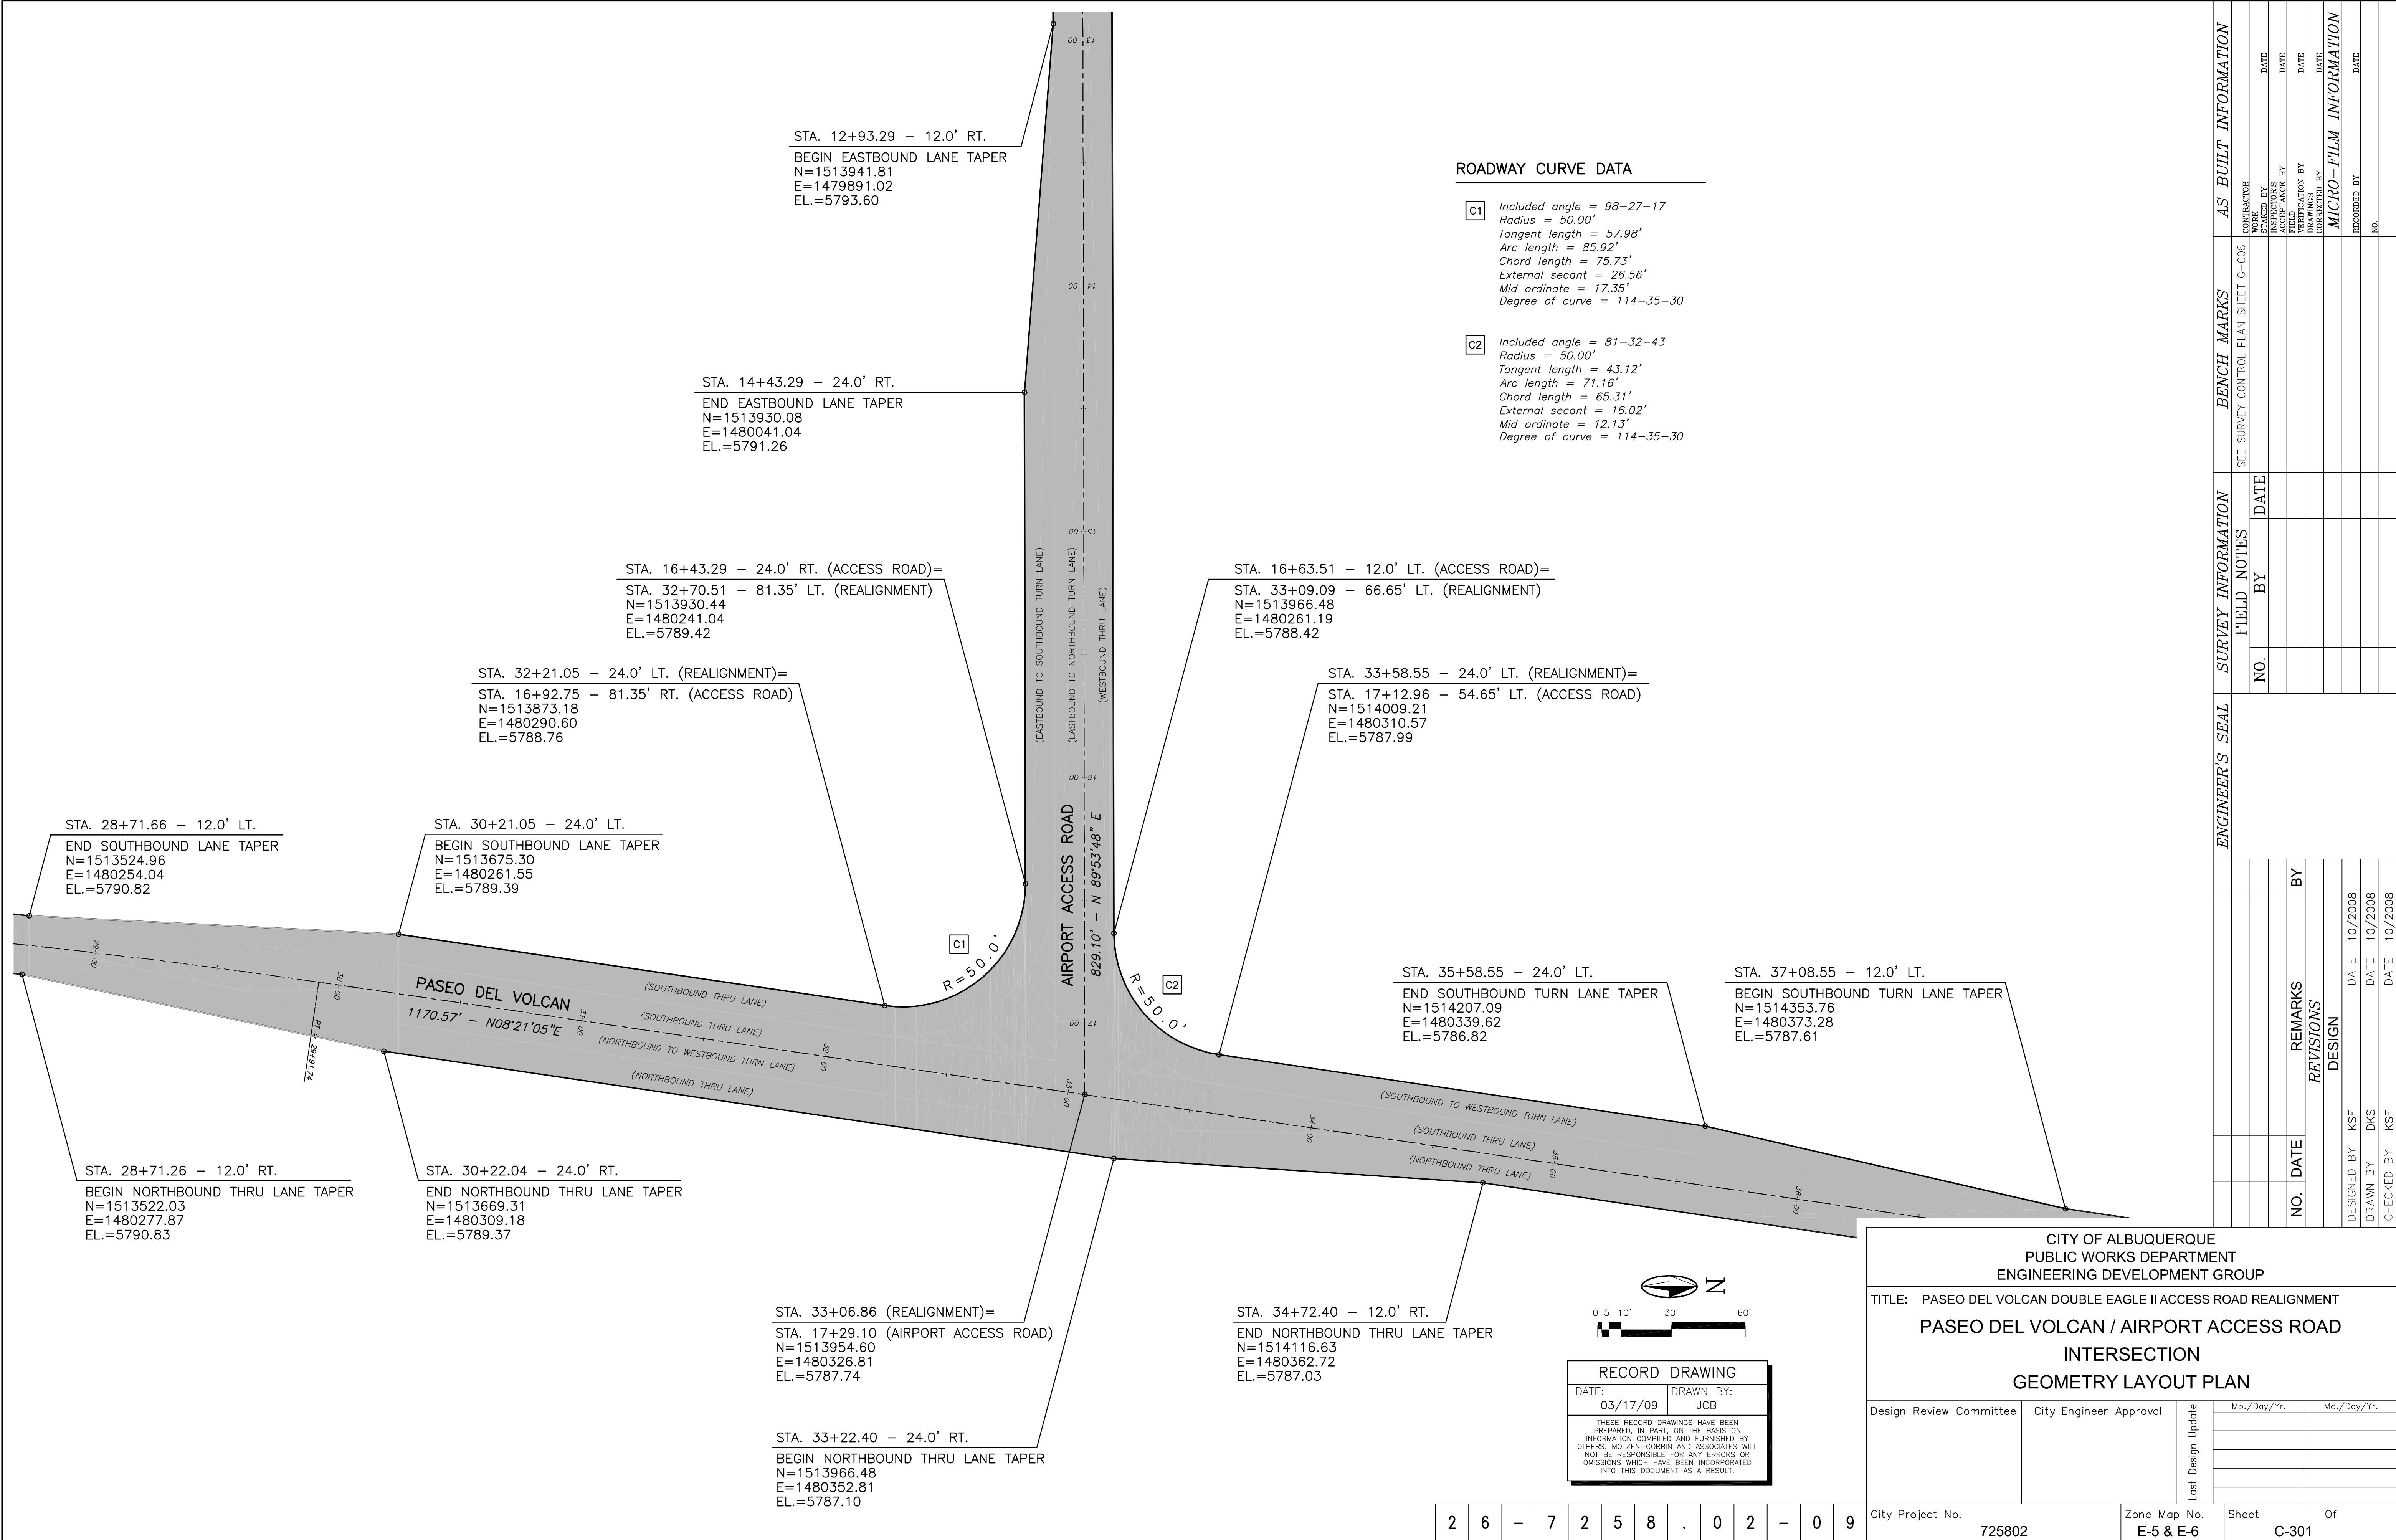

ROADWAY CURVE DATA

- C1

Included angle = 98-27-17

Radius = 50.00'

Tangent length = 57.98'

Arc length = 85.92'

Chord length = 75.73'

External secant = 26.56'

Mid ordinate = 17.35'

Degree of curve = 114-35-30
- C2

Included angle = 81-32-43

Radius = 50.00'

Tangent length = 43.12'

Arc length = 71.16'

Chord length = 65.31'

External secant = 16.02'

Mid ordinate = 12.13'

Degree of curve = 114-35-30

AS BUILT INFORMATION		BENCH MARKS		SURVEY INFORMATION		ENGINEER'S SEAL	
CONTRACTOR	DATE	SEE SURVEY CONTROL PLAN SHEET C-006		FIELD NOTES			
STAKED BY	DATE			BY	DATE		
ACCEPTANCE BY	DATE			NO.			
FIELD INSPECTION BY	DATE						
DRAWINGS CORRECTED BY	DATE						
MICRO-FILM INFORMATION							
RECORDED BY	DATE						
NO.							

0'5'10'30'60'

RECORD DRAWING

DATE: 03/17/09

DRAWN BY: JCB

THESE RECORD DRAWINGS HAVE BEEN PREPARED, IN PART, ON THE BASIS OF INFORMATION COMPILED AND FURNISHED BY OTHERS. MOLDEN-CORBIN AND ASSOCIATES WILL NOT BE RESPONSIBLE FOR ANY ERRORS OR OMISSIONS WHICH HAVE BEEN INCORPORATED INTO THIS DOCUMENT AS A RESULT.

CITY OF ALBUQUERQUE
PUBLIC WORKS DEPARTMENT
ENGINEERING DEVELOPMENT GROUP

TITLE: PASEO DEL VOLCAN DOUBLE EAGLE II ACCESS ROAD REALIGNMENT

PASEO DEL VOLCAN / AIRPORT ACCESS ROAD
INTERSECTION
GEOMETRY LAYOUT PLAN

Design Review Committee

City Engineer Approval

Last Design Update


Mo./Day/Yr.

Mo./Day/Yr.

City Project No. 725802

Zone Map No. E-5 & E-6

Sheet Of C-301

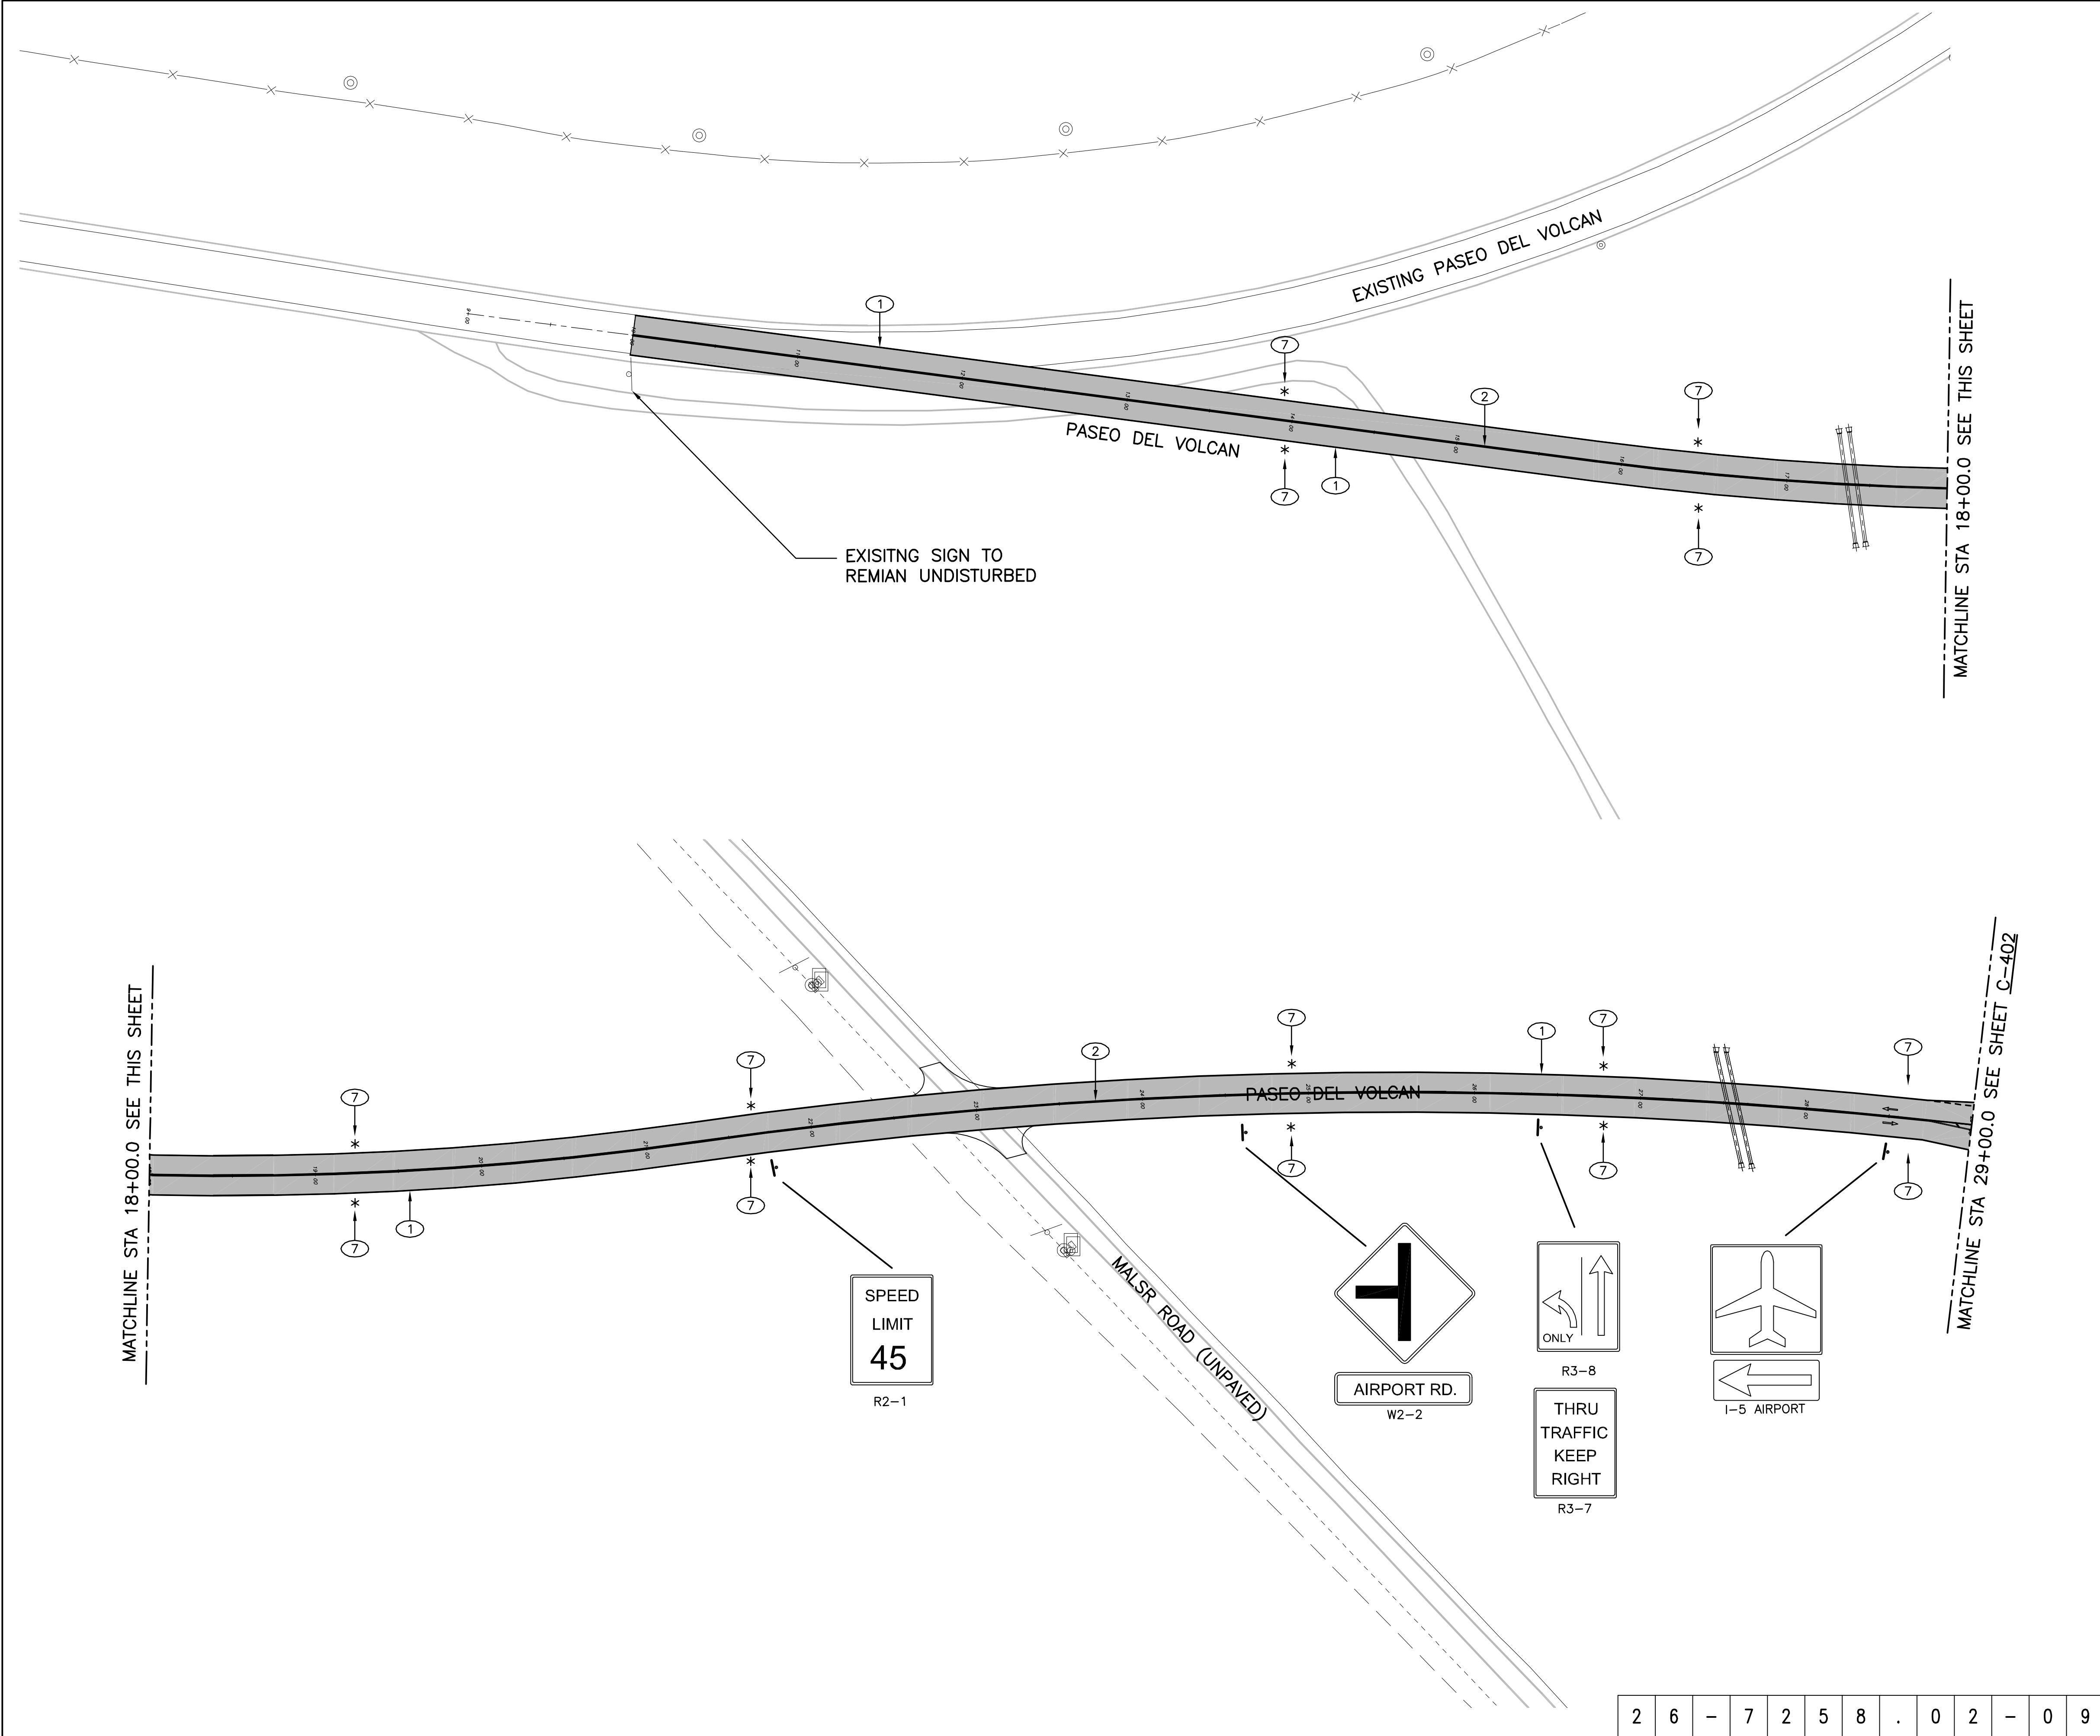

KEYED NOTES

①

4" WHITE SOLID PLASTIC LANE LINE MARKING

②

DOUBLE 4" YELLOW SOLID PLASTIC LANE LINE MARKING

⑦

REFLECTIVE CULVERT DELINEATORS PLACED AS PER NMDOT STANDARDS AND SPECIFICATIONS.

LEGEND

→

TRAFFIC SIGN

→

TRAFFIC FLOW DIRECTION

*

REFLECTIVE CULVERT DELINEATORS

GENERAL NOTES

•

ALL DISTURBED AREA WILL BE SEEDED PER NMDOT STANDARDS AND SPECIFICATIONS.

RECORD DRAWING

DATE:

03/17/09

DRAWN BY:

JCB

THESE RECORD DRAWINGS HAVE BEEN PREPARED, IN PART, ON THE BASIS OF INFORMATION COMPILED AND FURNISHED BY OTHERS. MOLZEN-CORBIN AND ASSOCIATES WILL NOT BE RESPONSIBLE FOR ANY ERRORS OR OMISSIONS WHICH HAVE BEEN INCORPORATED INTO THIS DOCUMENT AS A RESULT.

0 10' 20' 50' 100'

2701 MILES RD SE
ALBUQUERQUE, NM 87106
TEL: 505.242-5700
FAX: 505.242-0673

MOLZEN-CORBIN & Associates

ENGINEERS/ARCHITECTS/PLANNERS

CITY OF ALBUQUERQUE
PUBLIC WORKS DEPARTMENT
ENGINEERING DEVELOPMENT GROUP

TITLE: PASEO DEL VOLCAN DOUBLE EAGLE II ACCESS ROAD REALIGNMENT

SIGNING AND STRIPING PLAN

Design Review Committee

City Engineer Approval

Last Design Update

Mo./Day/Yr.

Mo./Day/Yr.

City Project No.

725802

Zone Map No.

E-5 & E-6

Sheet

C-401

Of

CONTRACTOR

DATE

STAKED BY

DATE

INSPECTED BY

DATE

FIELD

DATE

REVISIONS

DESIGN

DESIGNED BY

DATE

DRAWN BY

DATE

CHECKED BY

DATE

RECORDED BY

DATE

NO.

AS BUILT INFORMATION

BENCH MARKS

SEE SURVEY CONTROL PLAN SHEET C-006

SURVEY INFORMATION

FIELD NOTES

NO.

BY

DATE


ENGINEER'S SEAL

26-725802-009

© COPYRIGHT

AB0082-11.D20

REDRAWN FOR RECORD PURPOSES

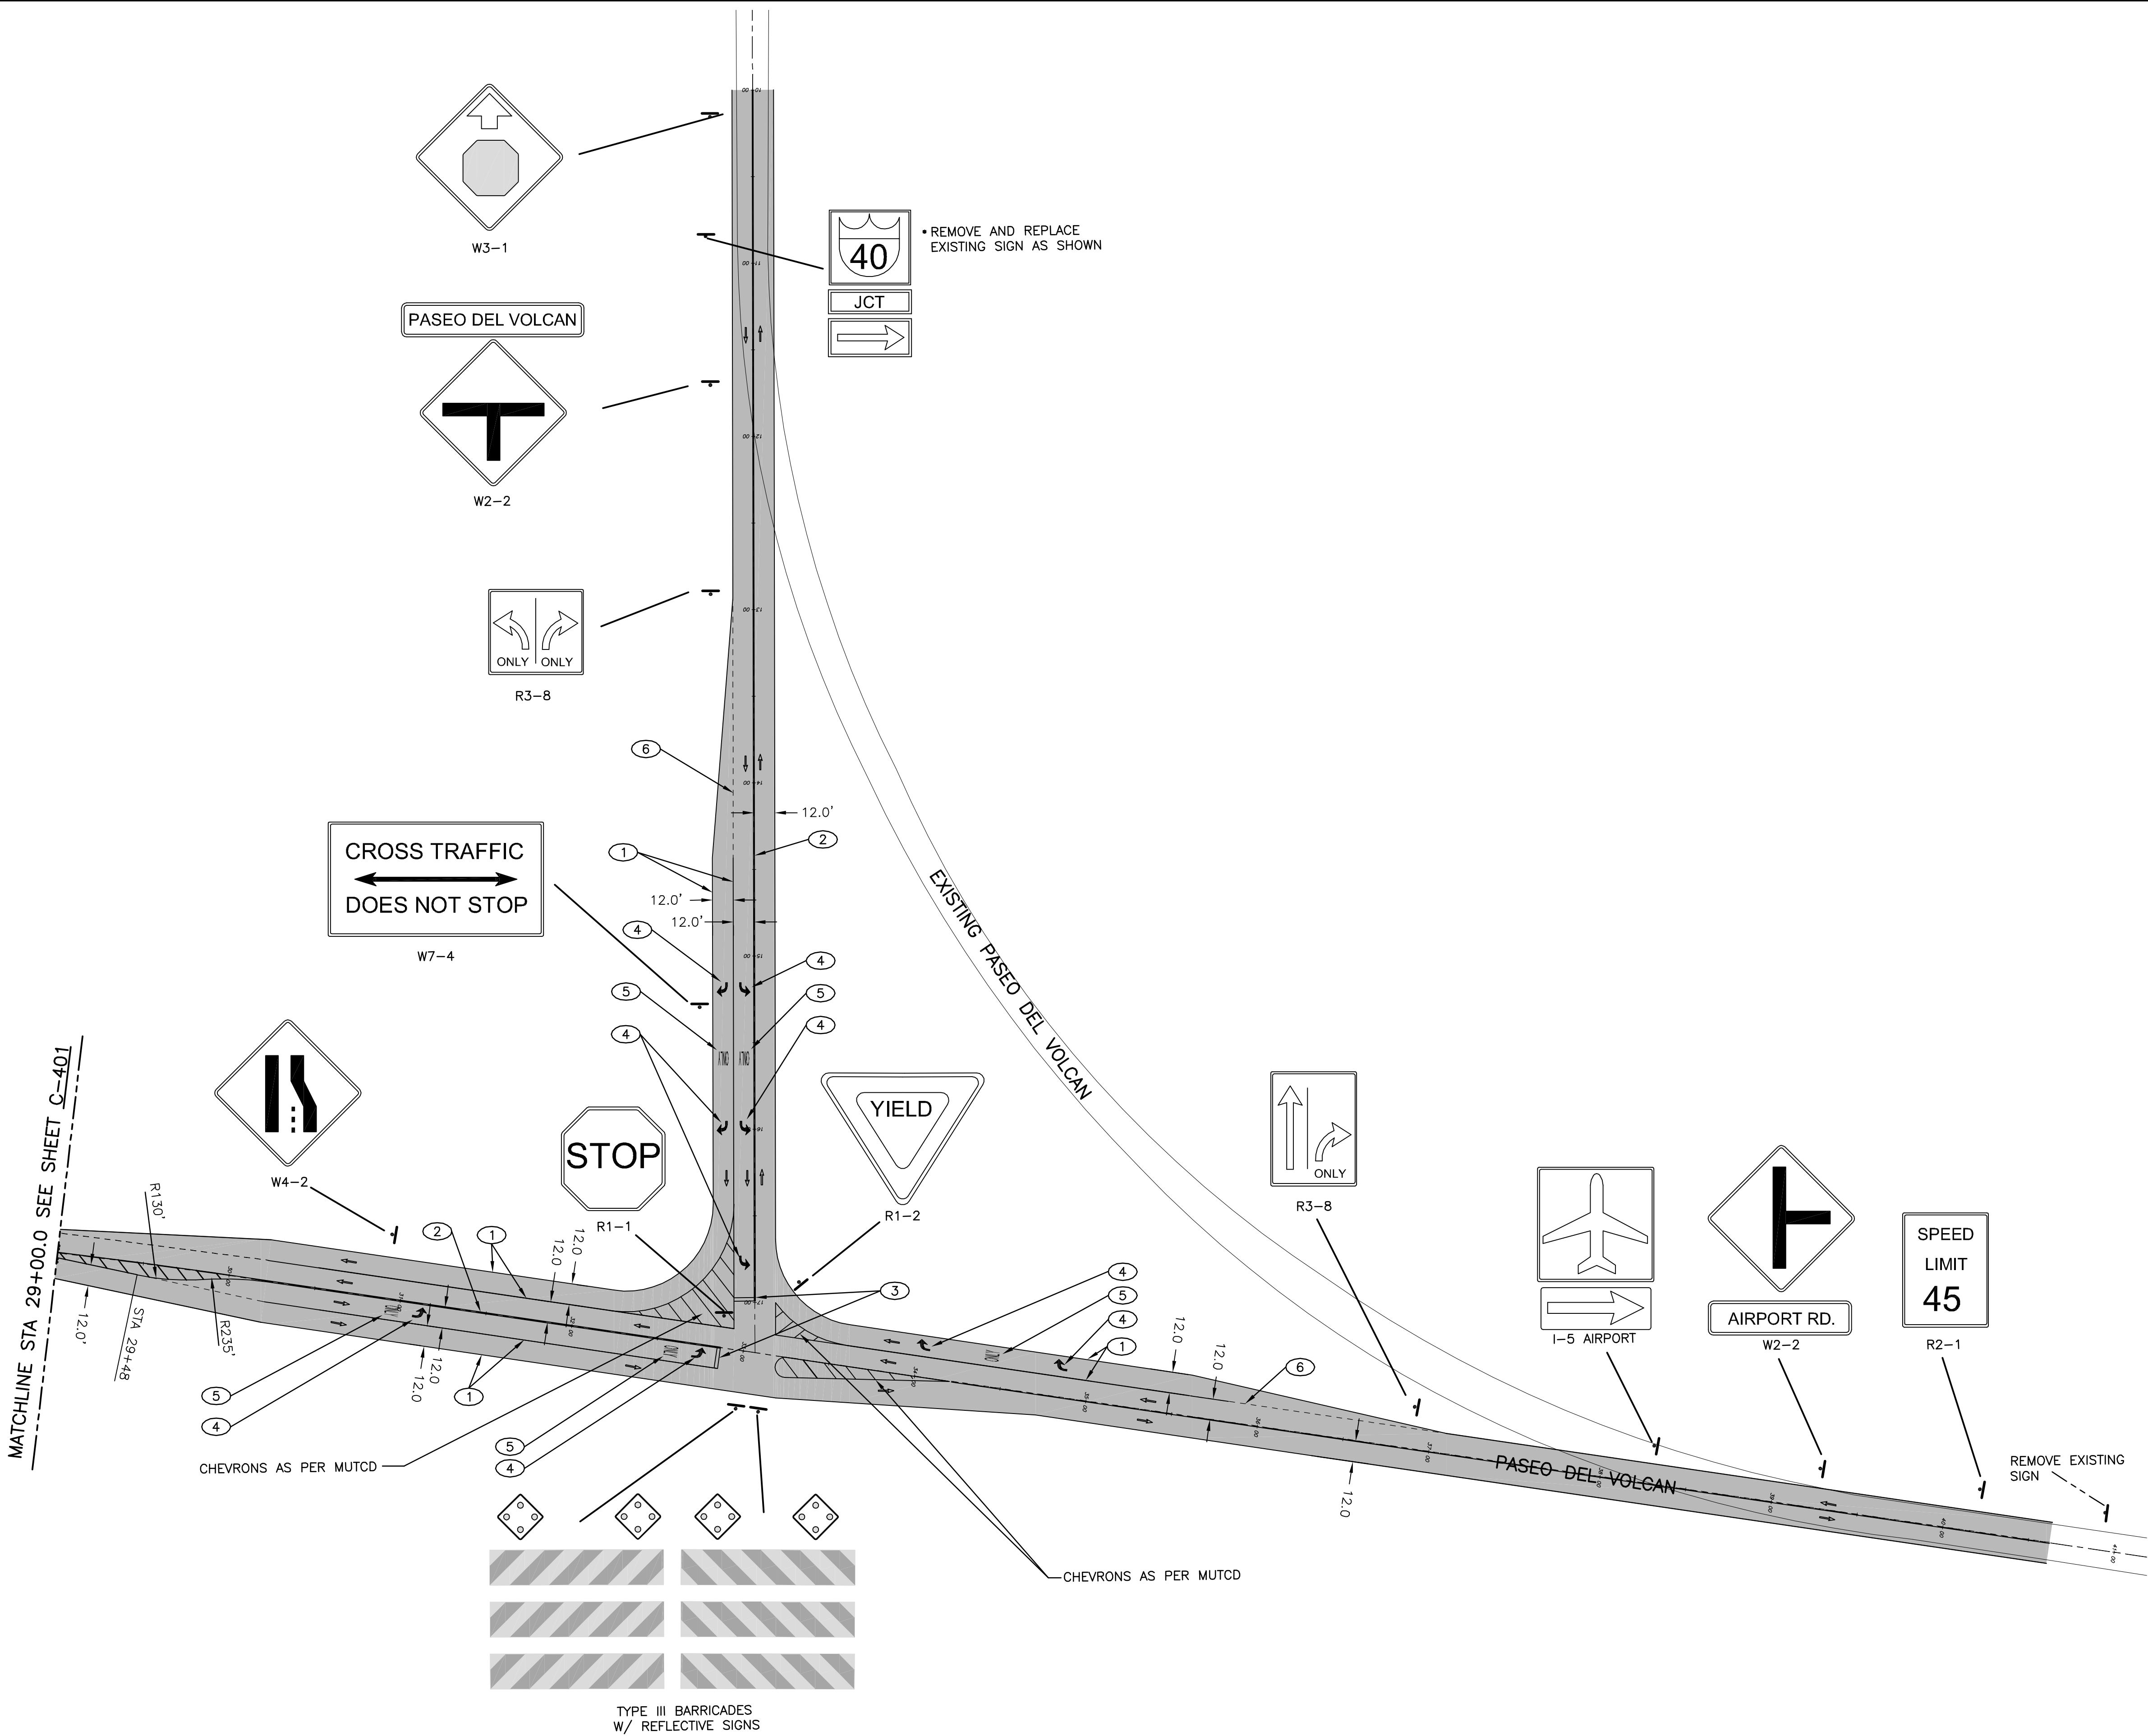

- KEYED NOTES**
- ① 4" WHITE SOLID PLASTIC LANE LINE MARKING
 - ② DOUBLE 4" YELLOW SOLID PLASTIC LANE LINE MARKING
 - ③ STOP BAR, WHITE, 12" WIDE SOLID PREFORMED PLASTIC MARKING.
 - ④ RIGHT TURN ARROW AS PER MUTCD. WHITE, SOLID PREFORMED PLASTIC MARKING.
 - ⑤ "ONLY" DESIGNATION AS PER MUTCD. WHITE, SOLID PREFORMED PLASTIC MARKING.
 - ⑥ 4" WHITE DASHED PREFORMED PLASTIC LINE MARKING.

- LEGEND**
- TRAFFIC SIGN
 - TRAFFIC FLOW DIRECTION

- GENERAL NOTES**
- ALL DISTURBED AREA WILL BE SEEDED PER NMDOT STANDARDS AND SPECIFICATIONS.

RECORD DRAWING

DATE: 03/17/09	DRAWN BY: JCB
-------------------	------------------

THESE RECORD DRAWINGS HAVE BEEN PREPARED, IN PART, ON THE BASIS OF INFORMATION COMPILED AND FURNISHED BY OTHERS. MOLZEN-CORBIN AND ASSOCIATES WILL NOT BE RESPONSIBLE FOR ANY ERRORS OR OMISSIONS WHICH HAVE BEEN INCORPORATED INTO THIS DOCUMENT AS A RESULT.

0 10' 20' 50' 100'

2701 MILES RD SE
ALBUQUERQUE, NM 87106
TEL: 505.242-5700
FAX: 505.242-0673

MOLZEN-CORBIN & Associates
ENGINEERS/ARCHITECTS/PLANNERS

CITY OF ALBUQUERQUE
PUBLIC WORKS DEPARTMENT
ENGINEERING DEVELOPMENT GROUP

TITLE: PASEO DEL VOLCAN DOUBLE EAGLE II ACCESS ROAD REALIGNMENT

SIGNING AND STRIPING PLAN

Design Review Committee	City Engineer Approval	Last Design Update	Mo./Day/Yr.	Mo./Day/Yr.
City Project No. 725802		Zone Map No. E-5 & E-6	Sheet C-402	Of