

REV.	SHEETS	CITY ENGINEER	DATE	USER DEPARTMENT	DATE	USER DEPARTMENT	DATE
		APPROVALS	ENGINEER		DATE	*****	
		DRC Chairman			APPROVED FOR CONSTRUCTION		
		Transportation					
		Water/Wastewater					
		Hydrology					
		Aviation					
		Constr. Mngnt.			City Architect		Date
					City Engineer		Date
City Project No. 7259.25			Drawing No. G001		Sheet of 1 33		

ELECTRICAL SYMBOL LEGEND			
SYMBOL	DESCRIPTION	SYMBOL	DESCRIPTION
A	2' X 4' RECESSED FLUORESCENT LUMINAIRE. "A" DENOTES LUMINAIRE TYPE.		TELEPHONE (OR INTERCOM HANDSET) OUTLET - "W" INDICATES "WALL" STYLE PHONE, 48" AFF; "P" INDICATES "PAY" STYLE PHONE, 48" AFF; NO DESIGNATION INDICATES A "DESK" STYLE PHONE, 18" AFF, OR INTERCOM WALL HANDSET, 48" AFF.
B	2' X 4' RECESSED FLUORESCENT LUMINAIRE CONNECTED TO EMERGENCY CIRCUIT. "B" DENOTES LUMINAIRE TYPE. 2-LAMPS OF 4-LAMP LUMINAIRE (OR BOTH LAMPS OF A 2-LAMP LUMINAIRE) TO BE CONNECTED AHEAD OF LOCAL SWITCHING.		FLUSH FLOOR TELEPHONE OUTLET
	RECESSED OR SURFACE DOWNLIGHT (REFER TO LIGHT FIXTURE SCHEDULE)		VOICE/DATA OUTLET, 18" AFF, U.N.O.
	WALL MOUNTED LUMINAIRE		FLUSH FLOOR VOICE/DATA OUTLET
	JUNCTION BOX	TV	VIDEO OUTLET, 18" AFF, U.N.O.
	1' X 4' FLUORESCENT LUMINAIRE. (REFER TO SCHEDULE FOR MOUNTING)		INTERCOM SYSTEM CALL SWITCH, 48" AFF, U.N.O.
	CLG. MTD. EXIT SIGN WITH DIRECTIONAL ARROW(S) AS INDICATED ON PLANS.		INTERCOM SYSTEM SPEAKER VOLUME CONTROL SWITCH, 48" AFF, U.N.O.
	WALL MTD. EXIT SIGN WITH DIRECTIONAL ARROW (S) AS INDICATED ON PLANS.		INTERCOM/FIRE EVACUATION SYSTEM SPEAKERS, WALL OR CEILING MOUNTED. SUBSCRIPT DENOTES PAGING CIRCUIT.
	DISCONNECT SWITCH		CCTV SECURITY CAMERA, WALL OR CEILING MOUNTED
	CONDUCTOR TYPE INDICATION AND CIRCUIT HOMERUN: NEUTRAL CONDUCTOR HOT OR PHASE CONDUCTOR SWITCH CONDUCTOR GROUND CONDUCTOR CIRCUIT DESIGNATION		FIRE ALARM CONTROL PANEL
	LOW PROFILE CEILING MOUNTED PHOTOCELL		FIRE ALARM SMOKE DETECTOR
	TELEPHONE/POWER POLE, AS NOTED		FIRE ALARM SPRINKLER TAMPER SWITCH
	DUPLEX GROUNDING STYLE RECEPTACLE, + 18" AFF, U.N.O.		FIRE ALARM RATE OF RISE HEAT DETECTOR
	DOUBLE DUPLEX GROUNDING STYLE RECEPTACLE, +18" AFF, U.N.O.		FIRE ALARM SPRINKLER FLOW SWITCH
	FLUSH FLOOR MOUNTED DUPLEX RECEPTACLE		FIRE ALARM DUCT SMOKE DETECTOR
	FLUSH FLOOR MOUNTED DOUBLE DUPLEX RECEPTACLE		FIRE ALARM STROBE
	DUPLEX RECEPTACLE WITH ONE SIDE SWITCHED, +18" AFF, U.N.O.		FIRE ALARM COMBINATION HORN/STROBE
	250V-2P-3W SPECIAL PURPOSE GROUNDING TYPE OUTLET. AMPACITY AS INDICATED. +18" AFF, U.N.O.		FIRE ALARM EXTERIOR WEATHERPROOF HORN
	SPECIAL PURPOSE RECEPTACLE, WITH NEMA CONFIGURATION AS INDICATED OR PER MANUFACTURER REQUIREMENTS.		FIRE ALARM MANUAL PULL STATION
	WALL MOUNTED PLUGSTRIP, LENGTH AS INDICATED, RECEPTACLES 12" O.C., +42" A.F.F., U.N.O.		FIRE FIGHTER PHONE JACK, +48" AFF, U.N.O.
EX	DENOTES "EXISTING"		FIRE ALARM DOOR HOLDER MAGNET
IG	DENOTES ISOLATED GROUND		SECURITY ALARM CONDUIT STUB UP OR RUN, CONDUIT SIZE AS INDICATED. WIRING BY OTHERS
WP	DENOTES WEATHERPROOF		TELEPHONE CONDUIT STUB UP OR RUN, CONDUIT SIZE AS INDICATED. WIRING BY OTHERS
GFCI	DENOTES GROUND FAULT CIRCUIT INTERRUPTER		VOICE/DATA CONDUIT STUB UP OR RUN, CONDUIT SIZE AS INDICATED ON DRAWINGS. WIRING BY OTHERS
	208/120V PANELBOARD, SURFACE MOUNTED		FIRE ALARM CONDUIT RUN, CONDUIT SIZE AND WIRES AS INDICATED OR REQUIRED
	208/120V PANELBOARD, FLUSH MOUNTED		INTERCOM CONDUIT RUN, CONDUIT SIZE AND WIRES AS INDICATED OR REQUIRED
	480/277V PANELBOARD, SURFACE MOUNTED		VIDEO CONDUIT STUB UP AND EXPOSED COAX CABLE RUN, CONDUIT SIZE AND CABLES AS INDICATED
	480/277V PANELBOARD, FLUSH MOUNTED		CONCEALED OR EXPOSED CONDUIT TURNED DN
	TRANSFORMER		CONCEALED OR EXPOSED CONDUIT TURNED Doup
	TERMINAL BOARD WITH GROUND, LENGTH AS INDICATED		CONDUIT RUN UNDERGROUND OR EMBEDDED IN CONCRETE
	METER		GATE PAGING AMPLIFIER
	CIRCUIT BREAKER		SECURITY ALARM CONTROL PANEL
	FUSED SWITCH		J-BOX ROUGH-IN FOR SECURITY ALARM 360° CEILING PIR
S	SINGLE POLE SWITCH, +48" AFF, U.N.O.		J-BOX ROUGH-IN FOR WALL SECURITY ALARM WALL PIR, 7'-6" AFF, U.N.O.
S <sub>3</sub>	3-WAY SWITCH, +48" AFF, U.N.O.		PUSHBUTTON CONTROL STATION FOR HANDICAP ACCESS DOORS
S <sub>D</sub>	DIMMER SWITCH, +48" AFF, U.N.O., TYPE AS NOTED	SK	J-BOX ROUGH-IN FOR SECURITY ALARM SHUNT KEY SWITCH, 48" AFF, U.N.O.
S <sub>4</sub>	4-WAY SWITCH, +48" AFF, U.N.O.	K	OVERHEAD GRILLE/WALL PANEL KEYED CONTROL STATION
S <sub>OS</sub>	OCCUPANCY SENSOR, 180° DETECTION, FIELD ADJUSTABLE, TIME SETTING (UP TO 30MIN.) WITH MANUAL SWITCH, +48" AFF, U.N.O.		DURESS ALARM PUSHBUTTON SWITCH
S <sub>T</sub>	MANUAL MOTOR STARTER WITH THERMAL OVERLOADS, +48" AFF, U.N.O.		SECURITY SYSTEM TOUCHPAD, +48" AFF, U.N.O.
S <sub>K</sub>	KEYED SINGLE POLE SWITCH, +48" AFF, U.N.O.		SECURITY SYSTEM BYPASS PUSHBUTTON, +48" AFF, U.N.O.
S <sub>KP</sub>	KEYED SINGLE POLE SWITCH W/PILOT, +48" AFF, U.N.O.		ROUGH-IN FOR SECURITY ALARM DOOR SWITCH, AT UPPER JAMB
S <sub>K</sub>	MOTION DETECTOR SWITCH W/MANUAL OVERRIDE, +48" AFF, U.N.O.		DOOR TYPE ACCESS CONTROL SYSTEM DETAIL REFERENCE
S <sub>M</sub>	MOTION DETECTOR SWITCH W/MANUAL OVERRIDE, +48" AFF, U.N.O.		MECHANICAL EQUIPMENT DESIGNATION
			ELECTRICAL KEYED NOTE DESIGNATION
			FEEDER DESIGNATION OR EQUIPMENT DESIGNATION

ELECTRICAL LEGEND GENERAL NOTES:

1. ALL DEVICE LOCATIONS AND MOUNTING HEIGHTS SHALL CONFORM TO THE AMERICANS WITH DISABILITIES ACT (ADA) REQUIREMENTS.

LIGHT FIXTURE REPLACEMENT SCHEDULE				
TYPE	LAMPS	VA	MOUNTING	DESCRIPTION
A	(1) 26W TTT 4-PIN GX24Q	33	CORD AND PLUG TRACK MOUNTED HEAD	FLUORESCENT TRACK FIXTURE, SINGLE PIECE ALUMINUM HOUSING WITH WELDED END CAPS, HD AIMING BRACKET, COLOR MATCHED LOUVER, 120V ELECTRONIC DIMMING BALLAST WITH SOUND RATING OF "A", CORD AND PLUG FOR CONNECTION TO EXISTING LIGHTING RECEPTICALS, FIXTURE CORD AND TRACK TO BE BALCK. CON-TECH # CTL15042N-P-LA-18-P.
B	(3) 54W HO TS	202	SURFACE ON CEILING	FLUORESCENT FIXTURE, HIGH-IMPACT RESISTANT REINFORCED FIBERGLASS HOUSING, INJECTION MOLDED HI IMPACT ACRYLIC LENS, WET LOCATION RATED, 277V ELECTRONIC BALLAST. LSI # EG3-3-54-SS5HO-WL-UE.
C	(1) 70W MH PULSE START LAMP	84	RECESSED IN CEILING	WIDE DISTRIBUTION MH DOWNLIGHT, MICRO BAFFLE INSERT, SANDBLASTED "SOLIT" GLASS LENS. RAMBUSCH # RS-200-70-CMH-G12-W-MOD85Q/6A-M-VERT.
D	(1) 150W MH PULSE START LAMP	180	RECESSED IN CEILING	NARROW DISTRIBUTION MH DOWNLIGHT, MICRO BAFFLE INSERT, CLEAR GLASS LENS. RAMBUSCH # RD-62-150-CMH-G12-N-MOD85Q/6A-M-VERT.
L	(1) 150W MH PULSE START LAMP WITH 150W QUARTS	180	RECESSED IN CEILING	SAME AS TYPE "D" EXCEPT WITH 150W QUARTS LAMP FOR EMERGENCY LIGHTING. RAMBUSCH#RD-62-150-CMH-G12-N-MOD85Q/6A-M-VERT/ 150Q-AUX.
K	(1) 70W MH PULSE START LAMP WITH 150W QUARTS	84	RECESSED IN CEILING	SAME AS TYPE "C" EXCEPT WITH 150W QUARTS LAMP FOR EMERGENCY LIGHTING. RAMBUSCH # RS-200-70-CMH-G12-W-MOD85Q/6A-M-VERT/150Q-AUX.
V	(2) 32W TRF	77	SURFACE ON WALL	WALL MOUNTED FLUORESCENT AREA LIGHT, DIE CAST ALUMINUM HOUSING, TEMPERED GLASS LENSES, MEDIUM THROW DISTRIBUTION, UNIVERSAL COLD WEATHER BALLAST, WET LOCATION LISTED. GARDCO # 101-MT-232TRF-UNIV-BRP.
W	(1) 150W MH PULSE START LAMP	188	SURFACE ON CEILING	MH GARAGE LIGHT, EXTRUDED ALUMINUM BRONZE ANODIZED HOUSING, TYPE V DISTRIBUTION, HEAT AND IMPACT RESISTANT TEMPERED GLASS LENS, 277V HPF BALLAST, DAMP LOCATION RATED. GARDCO # SCA14-D-Q-150MH-277-BRA.
X	(1) 150W MH PULSE START LAMP WITH 150W QUARTS	188	SURFACE ON CEILING	SAME AS TYPE "W" EXCEPT WITH 150W QUARTS LAMP FOR EMERGENCY LIGHTING. GARDCO # SCA14-D-Q-150MH-277-BRA-QS.
Y	(1) 100W MH PULSE START LAMP	110	SURFACE ON WALL	WALL MOUNTED AREA LIGHT, ALUMINUM BODY, CLEAR IMPACT RESISTANT GLASS LENS, MEDIUM SYMMETRIC DISTRIBUTION. 277V HPF PULS START BALLAST, WET LOCATION LISTED. LITHONIA # WLF2-100MHC-MPM-277-SCWA-DMB.
AB				NOT USED.
AL				NOT USED.
CC	(2) 32W TRF	77	SURFACE ON WALL	WALL MOUNTED FLUORESCENT AREA LIGHT, DIE CAST ALUMINUM HOUSING, TEMPERED GLASS LENSES, MEDIUM THROW DISTRIBUTION, UNIVERSAL COLD WEATHER BALLAST, WET LOCATION LISTED. GARDCO # 101-MT-232TRF-UNIV-BRP.

LIGHT FIXTURE SCHEDULE GENERAL NOTES:

- A. VERIFY MOUNTING HEIGHTS OF ALL WALL MOUNTED FIXTURES WITH ARCHITECT.  
B. VERIFY EXACT CATALOG NUMBER WITH MANUFACTURER TO ASSURE THAT ALL FEATURES IN FIXTURE DESCRIPTION ARE INCLUDED.

ABBREVIATIONS

CTC	CONTACTOR/LIGHTING TERMINAL CABINET
LCP	LIGHTING CONTROL PANEL
RC	RELAY CABINET
RP	RELAY PANEL





RECORD DRAWING  
This drawing, to the best of my knowledge, has been updated to include information received from the General Contractor to reflect as-built conditions. Actual installation may vary from this drawing due to changes made by the Contractor and not passed on for inclusion on the drawing.

CITY OF ALBUQUERQUE PUBLIC WORKS DEPARTMENT ENGINEERING DEVELOPMENT GROUP				
TITLE: ALBUQUERQUE INTERNATIONAL SUNPORT LIGHTING MODERNIZATION PROJECT ELECTRICAL LEGEND AND FIXTURE SCHEDULE				
Design Review Committee	City Engineer Approval	Last Design Update	Mo./Day/Yr.	Mo./Day/Yr.
City Project No. 7259.25	Zone Map No. M-16	Drawing No. EG101	Sheet 2	Of 433





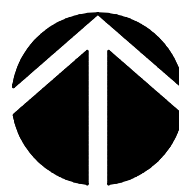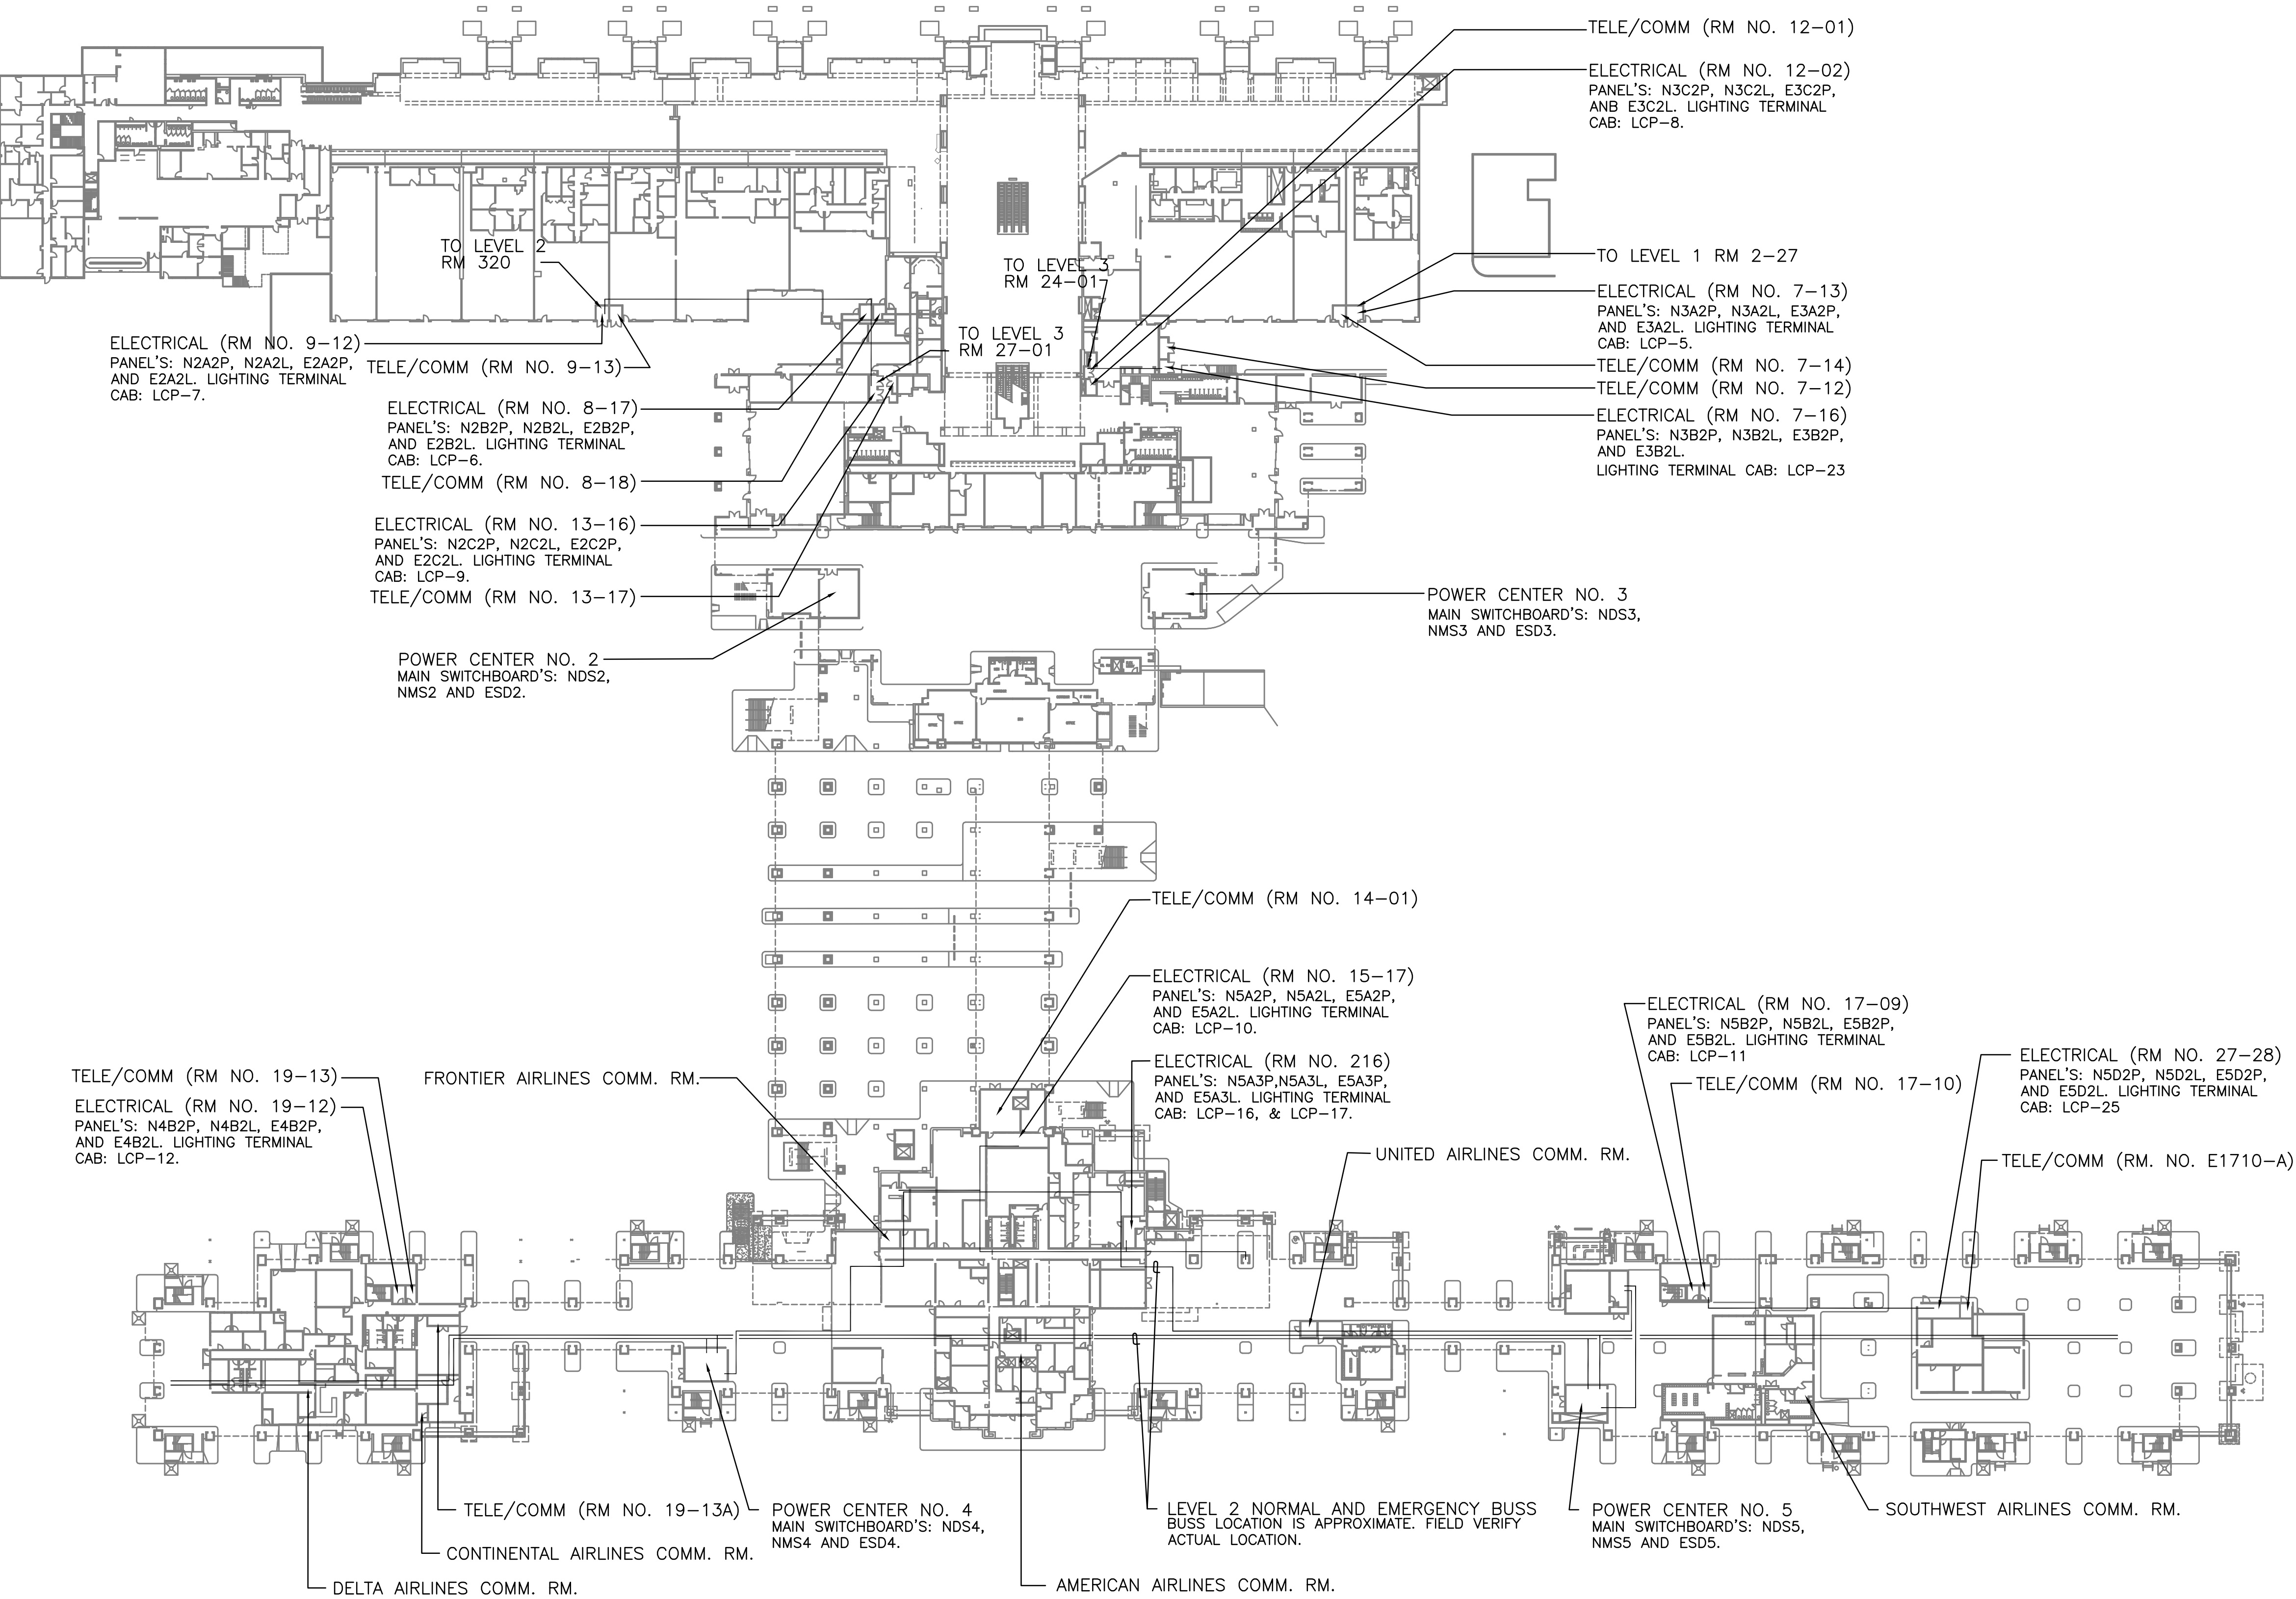

ELECTRICAL LOCATION PLAN – LEVEL 2  
SCALE: NONE



GENERAL NOTES:

- A. THE INFORMATION SHOWN ON THIS DRAWING WAS OBTAINED FROM THE RECORD DRAWINGS. FIELD VERIFY ALL EQUIPMENT LOCATIONS PRIOR TO PERFORMING ANY WORK.
- B. ALL CONDUIT SHALL BE 1/2" WITH #10 THHN COPPER CONDUCTORS UNLESS NOTED OTHERWISE.
- C. WHERE NECESSARY, THE CONTRACTOR SHALL REROUTE AND/OR RECONNECT CIRCUIT RUNS TO MAINTAIN THE CONTINUITY OF THE EXISTING CIRCUIT.
- D. ALL ELECTRICAL PENETRATIONS THROUGH FIRE RATED ASSEMBLES SHALL BE SEALED TO MAINTAIN THE RATING OF THE ASSEMBLY.
- E. FOR ENLARGED ELECTRICAL AND COMMUNICATIONS ROOMS REFER TO DRAWING E-401 THRU E-404.



I, William P. Foster, to the best of my knowledge, certify that this electronic version is identical to the original reproducible RECORD drawing signed by me on 07/22/2011.

ASCG  
INCORPORATED

ENGINEERS - ARCHITECTS - SURVEYORS - PLANNERS



6501 AMERICAS PARKWAY NE, SUITE 400  
ALBUQUERQUE, NEW MEXICO 87110-5372  
PHONE 505.247.0294 • FAX 505.242.4845

RECORD DRAWING  
This drawing, to the best of my knowledge, has been updated to include information received from the General Contractor to reflect as-built conditions. Actual installation may vary from this drawing due to changes made by the Contractor and not passed on for inclusion on the drawing.

CITY OF ALBUQUERQUE PUBLIC WORKS DEPARTMENT ENGINEERING DEVELOPMENT GROUP			
TITLE: ALBUQUERQUE INTERNATIONAL SUNPORT LIGHTING MODERNIZATION PROJECT			
ELECTRICAL LOCATION PLAN – LEVEL 2			
Design Review Committee	City Engineer Approval	Mo./Day/Yr.	Mo./Day/Yr.
Last Design Update			
City Project No. 7259.25	Zone Map No. M-16	Drawing No. EG103	Sheet 4 Of 33

26-7259.11-08



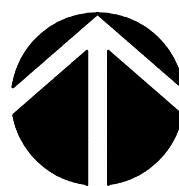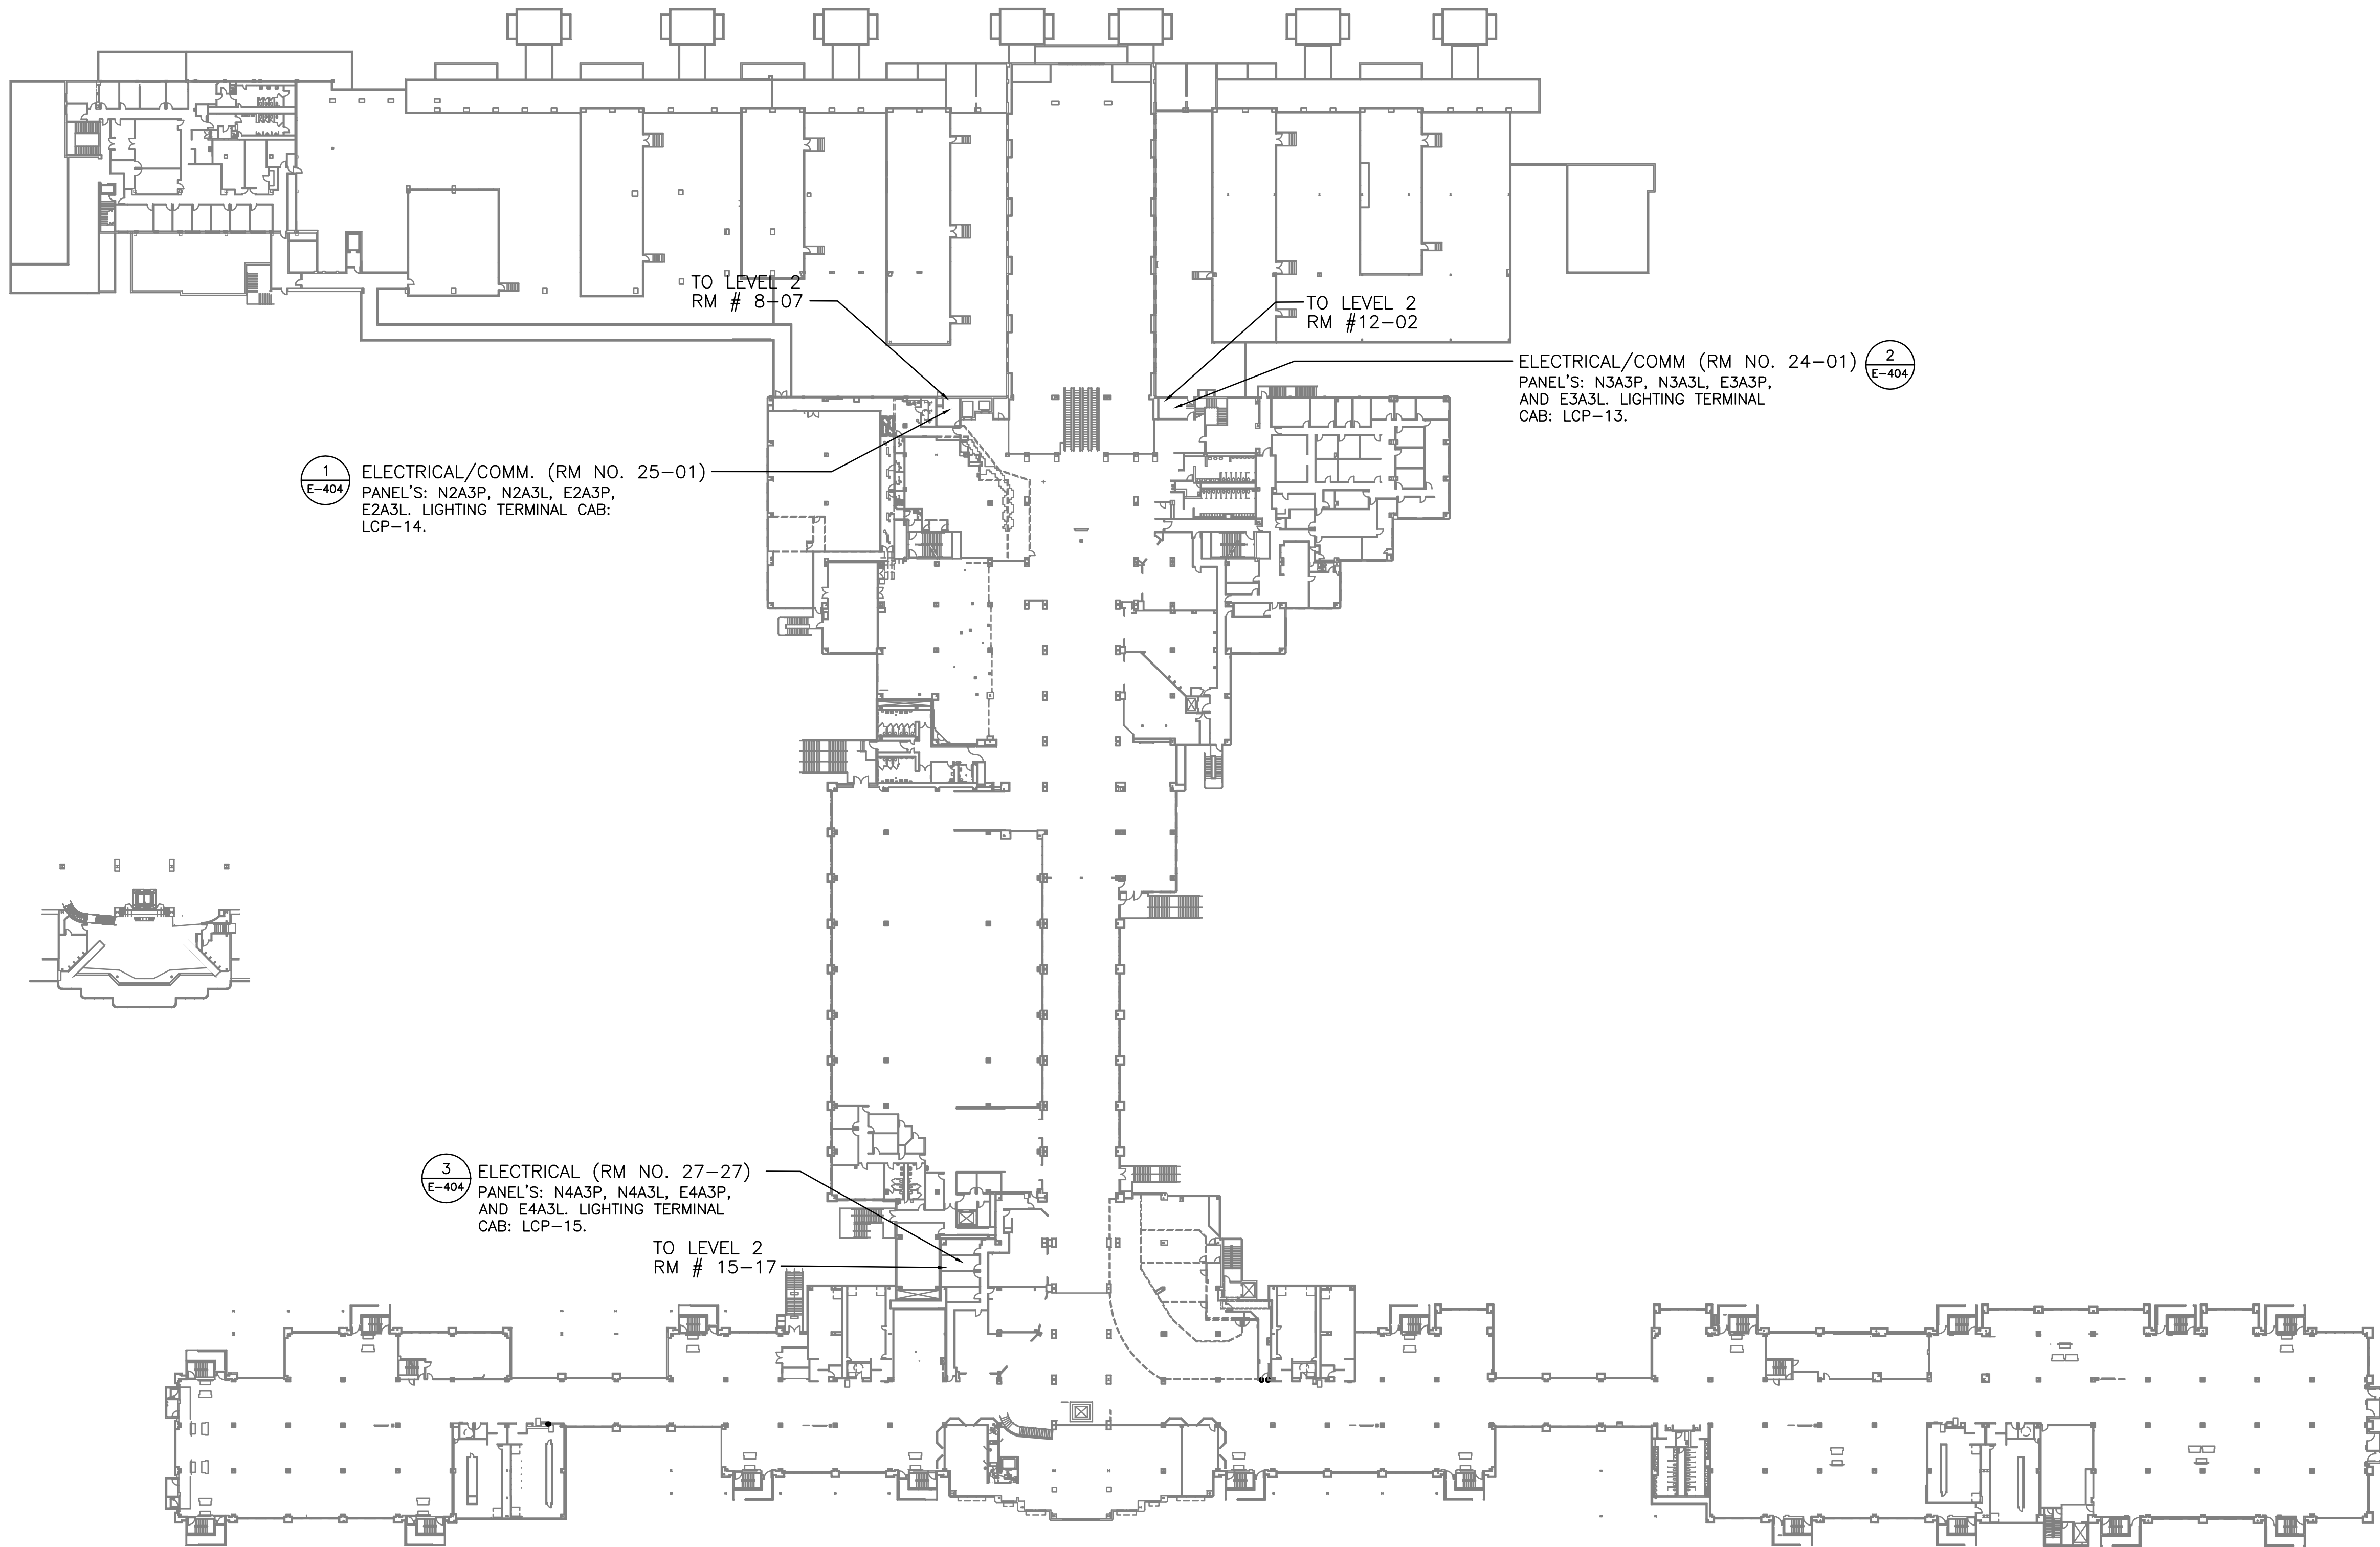

ELECTRICAL LOCATION PLAN – LEVEL 3  
SCALE: NONE



GENERAL NOTES:

- A. THE INFORMATION SHOWN ON THIS DRAWING WAS OBTAINED FROM THE RECORD DRAWINGS. FIELD VERIFY ALL EQUIPMENT LOCATIONS PRIOR TO PERFORMING ANY WORK.
- B. ALL CONDUIT SHALL BE 1/2" WITH #10 THHN COPPER CONDUCTORS UNLESS NOTED OTHERWISE.
- C. WHERE NECESSARY, THE CONTRACTOR SHALL REROUTE AND/OR RECONNECT CIRCUIT RUNS TO MAINTAIN THE CONTINUITY OF THE EXISTING CIRCUIT.
- D. ALL ELECTRICAL PENETRATIONS THROUGH FIRE RATED ASSEMBLIES SHALL BE SEALED TO MAINTAIN THE RATING OF THE ASSEMBLY.
- E. FOR ENLARGED ELECTRICAL AND COMMUNICATIONS ROOMS REFER TO DRAWING E-401 THRU E-404.

AS BUILT INFORMATION		BENCH MARKS		SURVEY INFORMATION		ENGINEER'S STAMP & SIGNATURE		REVISIONS		DESIGN	
Contractor				No.	By	<p>I, William P. Foster, to the best of my knowledge, certify that this electronic version is identical to the original reproducible RECORD drawing signed by me on 07/22/2011.</p>		No.	Date	Remarks	
Staked By											
Inspector's											
Fieldwork By											
Verification By											
Corrected By											
Recorded By											
No.											

ASCG  
INCORPORATED

ENGINEERS - ARCHITECTS - SURVEYORS - PLANNERS

6501 AMERICAS PARKWAY NE, SUITE 400  
ALBUQUERQUE, NEW MEXICO 87110-5372  
PHONE 505.247.0234 • FAX 505.242.4845

RECORD DRAWING  
This drawing, to the best of my knowledge, has been updated to include information received from the General Contractor to reflect as-built conditions. Actual installation may vary from this drawing due to changes made by the Contractor and not passed on for inclusion on the drawing.

CITY OF ALBUQUERQUE  
PUBLIC WORKS DEPARTMENT  
ENGINEERING DEVELOPMENT GROUP  
TITLE: ALBUQUERQUE INTERNATIONAL SUNPORT  
LIGHTING MODERNIZATION PROJECT  
ELECTRICAL LOCATION PLAN – LEVEL 3

Design Review Committee	City Engineer Approval	Mo./Day/Yr.	Mo./Day/Yr.

City Project No.	Zone Map No.	Drawing No.	Sheet	Of
7259.25	M-16	EG104	5	33

2 6 - 7 2 5 9 . 1 1 - 0 8

EXISTING TERMINAL BUILDING CTC CABINET SCHEDULE
PANEL NAME: <u>CTC-1</u> ①
LOCATION: <u>ELECTRICAL 2-27</u>
28 EXISTING 277V NORMAL POWER LIGHTING CONTROL POINTS. EXISTING NORMAL POWER CIRCUITS: N3A1P-2,3,4,5,6,8,10,12,13,14,15,16,17,18,19,20,21,22,23,24, 25,26,27,28,29,30,32,34.
6 EXISTING 480V NORMAL POWER LIGHTING COTROL POINTS (FOR SITE LTG). EXISTING SITE LTG CIRCUITS: N3A1P-31,33,35 N3A1P-38,40,42.
3 EXISTING 120V EMERGENCY LIGHTING CIRCUITS. EXISTING EMERGENCY CIRCUITS: E3A1L-10,12,14.

EXISTING TERMINAL BUILDING CTC CABINET SCHEDULE
PANEL NAME: <u>CTC-2</u> ①
LOCATION: <u>ELECTRICAL 3-15</u>
4 EXISTING 277V NORMAL POWER LIGHTING CONTROL POINTS. EXISTING NORMAL POWER CIRCUITS: N3B1P-1,3,4,5.
4 EXISTING 120V NORMAL POWER LIGHTING COTROL POINTS. N3B1L-21,23,33,35.
1 EXISTING 277V EMERGENCY LIGHTING CIRCUITS. EXISTING EMERGENCY CIRCUITS: E3B1P-2.

EXISTING TERMINAL BUILDING CTC CABINET SCHEDULE
PANEL NAME: <u>CTC-3</u> ①
LOCATION: <u>ELECTRICAL 3-20</u>
40 EXISTING 277V NORMAL POWER LIGHTING CONTROL POINTS. EXISTING NORMAL POWER CIRCUITS: N2B1P-1,2,3,4,5,6,7,8,9,10,11,12,13,15,19,20,21,23,24, N2A1P-11,35,36,37,38,39,40,41,44,46.
4 EXISTING 120V NORMAL POWER LIGHTING COTROL POINTS. EXISTING NORMAL POWER CIRCUITS: N2B1L-16,18,29,37.
5 EXISTING 277V EMERGENCY LIGHTING CIRCUITS. EXISTING EMERGENCY CIRCUITS: E2B1P-2,3,4,14,16.

EXISTING TERMINAL BUILDING CTC CABINET SCHEDULE
PANEL NAME: <u>CTC-4</u> ①
LOCATION: <u>ELECTRICAL 4-11</u>
30 EXISTING 277V NORMAL POWER LIGHTING CONTROL POINTS. EXISTING NORMAL POWER CIRCUITS: N2A1P-1,2,3,4,5,6,7,8,10,12,14,16,18,19,22,23,25,26,27,28,29, 30,31,32,33,34,43,45,47,65.
5 EXISTING 277V EMERGENCY LIGHTING CIRCUITS. EXISTING EMERGENCY CIRCUITS: E2A1P-2.
6 EXISTING 480V NORMAL POWER LIGHTING COTROL POINTS (FOR SITE LTG). EXISTING ROADWAY LTG CIRCUITS: N2A1P-49,51,53,55,56,58.
2 EXISTING 480V EMERGENCY POWER LIGHTING COTROL POINTS (FOR SITE LTG). EXISTING ROADWAY LTG CIRCUITS: E2A1P-13,15.
4 EXISTING 120V NORMAL POWER LIGHTING COTROL POINTS. EXISTING NORMAL POWER CIRCUITS: N2A1L-22,24,26,28.
6 EXISTING 120V EMERGENCY POWER LIGHTING COTROL POINTS. EXISTING EMERGENCY POWER CIRCUITS: E2A1L-18,20,21,22,24,26.

EXISTING TERMINAL BUILDING CTC CABINET SCHEDULE
PANEL NAME: <u>CTC-5</u> ①
LOCATION: <u>ELECTRICAL 7-13</u>
10 EXISTING 277V NORMAL POWER LIGHTING CONTROL POINTS. EXISTING NORMAL POWER CIRCUITS: N3A2P-1,2,3,4,5,6,7,9,11,14.
10 EXISTING 120V NORMAL POWER LIGHTING COTROL POINTS. EXISTING NORMAL POWER CIRCUITS: N3A2P-1,2,3,4,5,6,7,9,11,14.
3 EXISTING 480V NORMAL POWER LIGHTING COTROL POINTS (FOR SITE LTG). EXISTING RAMP LTG CIRCUITS: N3A2P-26,28,30.

EXISTING TERMINAL BUILDING CTC CABINET SCHEDULE
PANEL NAME: <u>CTC-6</u> ①
LOCATION: <u>ELECTRICAL 8-17</u>
11 EXISTING 277V NORMAL POWER LIGHTING CONTROL POINTS. EXISTING NORMAL POWER CIRCUITS: N2B2P-1,2,3,4,5,6,8,10,12,14,16.
10 EXISTING 120V NORMAL LIGHTING CIRCUITS. EXISTING NORMAL CIRCUITS: N2B2L-2,4,6,17,18,19,26,28,29,30

EXISTING TERMINAL BUILDING CTC CABINET SCHEDULE
PANEL NAME: <u>CTC-7</u> ①
LOCATION: <u>ELECTRICAL 9-12</u>
8 EXISTING 277V NORMAL POWER LIGHTING CONTROL POINTS. EXISTING NORMAL POWER CIRCUITS: N2A2P-1,2,3,4,5,6,7,9.
11 EXISTING 120V NORMAL LIGHTING CIRCUITS. EXISTING NORMAL CIRCUITS: N2A2L-2,4,6,8,10,12,21,23,31,33,35

EXISTING TERMINAL BUILDING CTC CABINET SCHEDULE
PANEL NAME: <u>CTC-8</u> ①
LOCATION: <u>ELECTRICAL 12-02</u>
7 EXISTING 277V NORMAL POWER LIGHTING CONTROL POINTS. EXISTING NORMAL POWER CIRCUITS: N3C2P-1,2,3,4,5,6
1 EXISTING 277V EMERGENCY LIGHTING CIRCUITS. EXISTING EMERGENCY CIRCUITS: E3C2P-2.
15 EXISTING 480V NORMAL POWER LIGHTING COTROL POINTS (FOR SITE LTG). EXISTING RAMP LTG CIRCUITS: N3A3P-1,3,5,2,4,6,7,9,11,8,10,12,13,15,17.
6 EXISTING 480V EMERGENCY POWER LIGHTING COTROL POINTS (FOR SITE LTG). EXISTING ROADWAY LTG CIRCUITS: E3A3P-1,3,5,2,4,6.
3 EXISTING 120V NORMAL POWER LIGHTING COTROL POINTS. EXISTING NORMAL POWER CIRCUITS: N3C2L-20,22,48.

EXISTING TERMINAL BUILDING CTC CABINET SCHEDULE
PANEL NAME: <u>CTC-9</u> ①
LOCATION: <u>ELECTRICAL 13-18</u>
10 EXISTING 277V NORMAL POWER LIGHTING CONTROL POINTS. EXISTING NORMAL POWER CIRCUITS: N2C2P-1,3,5,12,14,16,18,20,22,24.
1 EXISTING 277V EMERGENCY LIGHTING CIRCUITS. EXISTING EMERGENCY CIRCUITS: E2C2P-2.
6 EXISTING 480V NORMAL POWER LIGHTING COTROL POINTS (FOR SITE LTG). EXISTING RAMP LTG CIRCUITS: N2A3P-1,3,5,2,4,6.
6 EXISTING 480V EMERGENCY POWER LIGHTING COTROL POINTS (FOR SITE LTG). EXISTING SITE LTG CIRCUITS: E2A3P-1,3,5,2,4,6.
3 EXISTING 120V NORMAL POWER LIGHTING COTROL POINTS. EXISTING NORMAL POWER CIRCUITS: N3C2L-20,22,24.

EXISTING TERMINAL BUILDING CTC CABINET SCHEDULE
PANEL NAME: <u>CTC-10</u> ①
LOCATION: <u>ELECTRICAL 15-17</u>
3 EXISTING 277V NORMAL POWER LIGHTING CONTROL POINTS. EXISTING NORMAL POWER CIRCUITS: N5A2P-1,10,13.
12 EXISTING 480V NORMAL POWER LIGHTING COTROL POINTS (FOR SITE LTG). EXISTING RAMP LTG CIRCUITS: N4A3P-1,3,5,2,4,6,7,9,11. N5A3P-16,18,20.
6 EXISTING 480V EMERGENCY POWER LIGHTING COTROL POINTS (FOR SITE LTG). EXISTING ROADWAY LTG CIRCUITS: E4A3P-1,3,5,2,4,6.
3 EXISTING 120V NORMAL POWER LIGHTING COTROL POINTS. EXISTING NORMAL POWER CIRCUITS: N3C2L-20,22,24.

EXISTING TERMINAL BUILDING CTC CABINET SCHEDULE
PANEL NAME: <u>CTC-11</u> ①
LOCATION: <u>ELECTRICAL 17-09</u>
10 EXISTING 277V NORMAL POWER LIGHTING CONTROL POINTS. EXISTING NORMAL POWER CIRCUITS: N5B2P-6,14,16,18,19,20.
9 EXISTING 480V NORMAL POWER LIGHTING COTROL POINTS (FOR SITE LTG). EXISTING SITE LTG CIRCUITS: N5B2P-2,4,6,1,3,5,7,9,11.
3 EXISTING 480V EMERGENCY POWER LIGHTING COTROL POINTS (FOR SITE LTG). EXISTING SITE LTG CIRCUITS: E5B2P-1,3,5.
5 EXISTING 120V NORMAL POWER LIGHTING COTROL POINTS. EXISTING NORMAL POWER CIRCUITS: N5B2L-6,35,37,50,52.

EXISTING TERMINAL BUILDING CTC CABINET SCHEDULE
PANEL NAME: <u>CTC-12</u> ①
LOCATION: <u>ELECTRICAL 19-12</u>
14 EXISTING 277V NORMAL POWER LIGHTING CONTROL POINTS. EXISTING NORMAL POWER CIRCUITS: N4B2P-1,13,15,17,19,20,21,22,23.
9 EXISTING 480V NORMAL POWER LIGHTING COTROL POINTS (FOR SITE LTG). EXISTING SITE LTG CIRCUITS: N4B2P-2,4,6,7,9,11,8,10,12.
3 EXISTING 480V EMERGENCY POWER LIGHTING COTROL POINTS (FOR SITE LTG). EXISTING SITE LTG CIRCUITS: E4B2P-2,4,6.
5 EXISTING 120V NORMAL POWER LIGHTING COTROL POINTS. EXISTING NORMAL POWER CIRCUITS: N4B2L-17,35,37,40,42.

EXISTING TERMINAL BUILDING CTC CABINET SCHEDULE
PANEL NAME: <u>CTC-13</u> ①
LOCATION: <u>ELECTRICAL 19-01</u>
2 EXISTING 277V NORMAL POWER LIGHTING CONTROL POINTS. EXISTING NORMAL POWER CIRCUITS: N3A3P-14,31.
4 EXISTING 277V EMERGENCY LIGHTING CIRCUITS. EXISTING NORMAL POWER CIRCUITS: N3A3L-27,29,57,59.

EXISTING TERMINAL BUILDING CTC CABINET SCHEDULE
PANEL NAME: <u>CTC-14</u> ①
LOCATION: <u>ELECTRICAL 25-01</u>
5 EXISTING 277V NORMAL POWER LIGHTING CONTROL POINTS. EXISTING NORMAL POWER CIRCUITS: N2A3P-13,14,15,16,18.
2 EXISTING 277V EMERGENCY LIGHTING CIRCUITS. EXISTING EMERGENCY CIRCUITS: E2A3P-9,17.
4 EXISTING 120V NORMAL POWER LIGHTING COTROL POINTS. EXISTING NORMAL POWER CIRCUITS: N2A3L-2,4,6,8.

EXISTING TERMINAL BUILDING CTC CABINET SCHEDULE
PANEL NAME: <u>CTC-15</u> ①
LOCATION: <u>ELECTRICAL 27-27</u>
15 EXISTING 277V NORMAL POWER LIGHTING CONTROL POINTS. EXISTING NORMAL POWER CIRCUITS: N4A3P-13,14,15,16,17,18,19,20,21,22,23,24,26.
6 EXISTING 120V NORMAL POWER LIGHTING COTROL POINTS. EXISTING NORMAL POWER CIRCUITS: N4A3L-48,49,50,51,52,53.

EXISTING TERMINAL BUILDING CTC CABINET SCHEDULE
PANEL NAME: <u>CTC-16</u> ①
LOCATION: <u>ELECTRICAL 216</u>
9 EXISTING 277V NORMAL POWER LIGHTING CONTROL POINTS. EXISTING NORMAL POWER CIRCUITS: N5A3P-2,4,6,8,13,15,17.
3 EXISTING 480V EMERGENCY POWER LIGHTING COTROL POINTS (FOR SITE LTG). EXISTING SITE LTG CIRCUITS: E5A3P-8,10,12.
1 EXISTING 120V NORMAL POWER LIGHTING COTROL POINTS. EXISTING NORMAL POWER CIRCUITS: N5A3L-49.

EXISTING TERMINAL BUILDING CTC CABINET SCHEDULE
PANEL NAME: <u>CTC-16A</u> ①
LOCATION: <u>ELECTRICAL 216</u>
6 EXISTING 120V NORMAL POWER LIGHTING COTROL POINTS. EXISTING NORMAL POWER CIRCUITS: N5A3L-43,45,46,47,48,50.

EXISTING TERMINAL BUILDING CTC CABINET SCHEDULE
PANEL NAME: <u>CTC-17</u> ①
LOCATION: <u>ELECTRICAL 216</u>
2 EXISTING 120V NORMAL POWER LIGHTING COTROL POINTS. EXISTING NORMAL POWER CIRCUITS: N5A3L-67,69.

EXISTING TERMINAL BUILDING CTC CABINET SCHEDULE
PANEL NAME: <u>CTC-23</u> ①
LOCATION: <u>ELECTRICAL 7-18</u>
1 EXISTING 277V EMERGENCY LIGHTING CIRCUITS. EXISTING EMERGENCY CIRCUITS: E3B2P-2.
1 EXISTING 120V EMERGENCY POWER LIGHTING COTROL POINTS. EXISTING EMERGENCY POWER CIRCUITS: E3B2L-8.

EXISTING TERMINAL BUILDING CTC CABINET SCHEDULE
PANEL NAME: <u>CTC-25</u> ①
LOCATION: <u>ELECTRICAL 27-28</u>
12 EXISTING 277V NORMAL POWER LIGHTING CONTROL POINTS. EXISTING NORMAL POWER CIRCUITS: N5D2P-1,3,5,6,7,8,10,11,12,14,16,51.
6 EXISTING 480V NORMAL POWER LIGHTING COTROL POINTS (FOR SITE LTG). EXISTING SITE LTG CIRCUITS: N5D2P-2,4,6,20,22,24.
3 EXISTING 480V EMERGENCY POWER LIGHTING COTROL POINTS (FOR SITE LTG). EXISTING SITE LTG CIRCUITS: E5D2P-2,4,6.
1 EXISTING 120V NORMAL POWER LIGHTING COTROL POINTS. EXISTING NORMAL POWER CIRCUITS: N5D2L-32.

EXISTING PARKING STRUCTURE RELAY CABINET SCHEDULE
PANEL NAME: <u>RC1W</u> ①
LOCATION: <u>ELECTRICAL 108</u>
46 EXISTING 277V NORMAL POWER LIGHTING CONTROL POINTS. EXISTING NORMAL POWER CIRCUITS: (SECTION 1) L1W-1 THRU 30, (SECTION 2) L1W-33 THRU 47, 53.
CONTACTOR BLOCK BELOW RC1W: L1W-39

EXISTING PARKING STRUCTURE RELAY CABINET SCHEDULE
PANEL NAME: <u>RC1E</u> ①
LOCATION: <u>ELECTRICAL 101</u>
30 EXISTING 277V NORMAL POWER LIGHTING CONTROL POINTS. EXISTING NORMAL POWER CIRCUITS: L1E-1 THRU 30.

EXISTING PARKING STRUCTURE RELAY CABINET SCHEDULE
PANEL NAME: <u>RC2W</u> ①
LOCATION: <u>ELECTRICAL 208</u>
38 EXISTING 277V NORMAL POWER LIGHTING CONTROL POINTS. EXISTING NORMAL POWER CIRCUITS: L2W-1 THRU 38.
2 EXISTING 277V EMERGENCY LIGHTING CIRCUITS. EXISTING EMERGENCY CIRCUITS: EL2W-6, 29.

EXISTING PARKING STRUCTURE RELAY CABINET SCHEDULE
PANEL NAME: <u>RC2E</u> ①
LOCATION: <u>ELECTRICAL 201</u>
26 EXISTING 277V NORMAL POWER LIGHTING CONTROL POINTS. EXISTING NORMAL POWER CIRCUITS: L2E-1 THRU 26.

EXISTING PARKING STRUCTURE RELAY CABINET SCHEDULE
PANEL NAME: <u>RC3W</u> ①
LOCATION: <u>ELECTRICAL 308</u>
59 EXISTING 277V NORMAL POWER LIGHTING CONTROL POINTS. EXISTING NORMAL POWER CIRCUITS: (SECT. 1) L3W-1 THRU 36, (SECT. 2) L3W-37 THRU 59

EXISTING PARKING STRUCTURE RELAY CABINET SCHEDULE
PANEL NAME: <u>RC3E</u> ①
LOCATION: <u>ELECTRICAL 301</u>
43 EXISTING 277V NORMAL POWER LIGHTING CONTROL POINTS. EXISTING NORMAL POWER CIRCUITS: (SECT. 1) L3E-1 THRU 30, (SECT. 2) L3E-31 THRU 39,41,43,45,47

## EXISTING LIGHTING CONTROL SCHEDULES – REMOVAL



### GENERAL NOTES:

- THE CONTRACTOR SHALL FAMILIARIZE HIMSELF WITH THE EXISTING CONDITIONS IN ORDER TO ALLOW HIM TO SUBMIT A COMPLETE BID FOR REMOVALS WITHIN THE SCOPE OF THE DRAWINGS. ANY QUESTIONS ARISING DURING THE BID PERIOD IN REGARD TO THE INTENT OF THE DRAWINGS SHALL BE BROUGHT UP FOR CLARIFICATION WITH THE ENGINEER.
- THE ELECTRICAL CONTRACTOR SHALL BE RESPONSIBLE FOR EXISTING BLDG. CIRCUITRY. ANY DISCONNECT CIRCUIT THAT AFFECTS OTHER PORTIONS OF THE BLDG. SHALL BE RECIRCUITED AND ROUTED TO ACCOMMODATE A COMPLETE ELECTRICAL SYSTEM. PROVIDE ADDITIONAL CONDUIT, WIRING AND J-BOXES AS REQUIRED/NEEDED TO RETAIN CIRCUIT CONTINUITY.
- THE ELECTRICAL CONTRACTOR SHALL RETURN UNUSED ELECTRICAL DEVICES (I.E. PANELBOARDS, DISCONNECT SWITCHES, ETC.) TO THE OWNER. FIELD COORDINATE STORAGE LOCATION WITH THE OWNER. OWNER HAS FIRST RIGHT OF RELEASE OF ANY OWNED PROPERTY.
- CONTRACTOR SHALL REPAIR ALL DAMAGE TO WALLS, CEILING, ETC. SHOULD ANY OCCUR DURING CONSTRUCTION PERIOD. PATCH TO MATCH EXISTING.
- THE CONTRACTOR SHALL COORDINATE/SCHEDULE ANY DOWN TIME NECESSARY TO COMPLETE THE WORK INDICATED. CONTRACTOR SHALL FURNISH A SCHEDULE TO THE OWNER NOT LESS THAN FIVE (5) WORKING DAYS PRIOR TO THE INTENDED OUTAGE.

### KEYED NOTES: ☐

- DISCONNECT EXISTING LIGHTING CIRCUITS AND PULL BACK TO NEAREST WIREWAY OR J-BOX AND SPlice TO PROVIDE TEMPORARY LIGHTING DURING CABINET DEMOLITION. EXISTING CIRCUITS TO BE REUSED IN NEW CABINETS. REFER TO DRAWINGS E601 THRU E603 FOR NEW CABINET CONFIGURATIONS.

**ASCG**  
INCORPORATED

ENGINEERS • ARCHITECTS • SURVEYORS • PLANNERS

6501 AMERICAS PARKWAY NE, SUITE 400  
ALBUQUERQUE, NEW MEXICO 87110-5372  
PHONE 505.247.0294 • FAX 505.242.4845


#### RECORD DRAWING

This drawing, to the best of my knowledge, has been updated to include information received from the General Contractor to reflect as-built conditions. Actual installation may vary from this drawing due to changes made by the Contractor and not passed on for inclusion on the drawing.

CITY OF ALBUQUERQUE PUBLIC WORKS DEPARTMENT ENGINEERING DEVELOPMENT GROUP			
TITLE: ALBUQUERQUE INTERNATIONAL SUNPORT LIGHTING MODERNIZATION PROJECT			
EXISTING LTG CONTROL SCHEDULES – REMOVAL			
Design Review Committee	City Engineer Approval	Mo./Day/Yr.	Mo./Day/Yr.
Last Design Update			
City Project No. 7259.25	Zone Map No. M-16	Drawing No. ED01	Sheet 6 Of 33



2	6	-	7	2	5	9	.	1	1	-	0	8
---	---	---	---	---	---	---	---	---	---	---	---	---

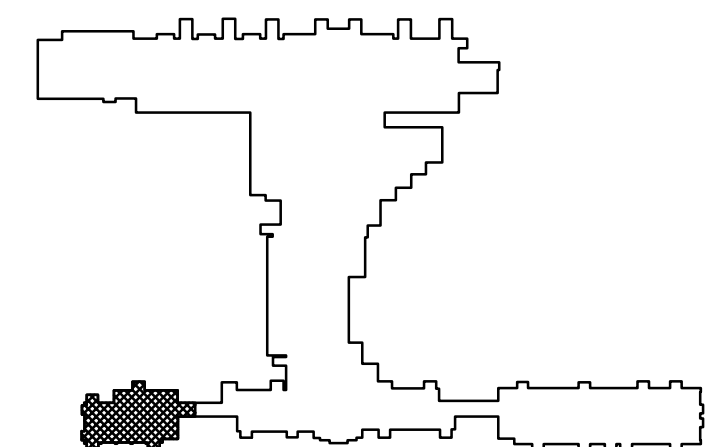


**RECORD DRAWING**  
This drawing, to the best of my knowledge, has been updated to include information received from the General Contractor to reflect as-built conditions. Actual installation may vary from this drawing due to changes made by the Contractor and not passed on for inclusion on the drawing.

Design Review Committee	City Engineer Approval	Last Design Update	Mo./Day/Yr.	Mo./Day/Yr.

City Project No. 7259.25	Zone Map No. M-16	Drawing No. E101	Sheet 7	Of 33
-----------------------------	----------------------	---------------------	------------	----------



[illegible]

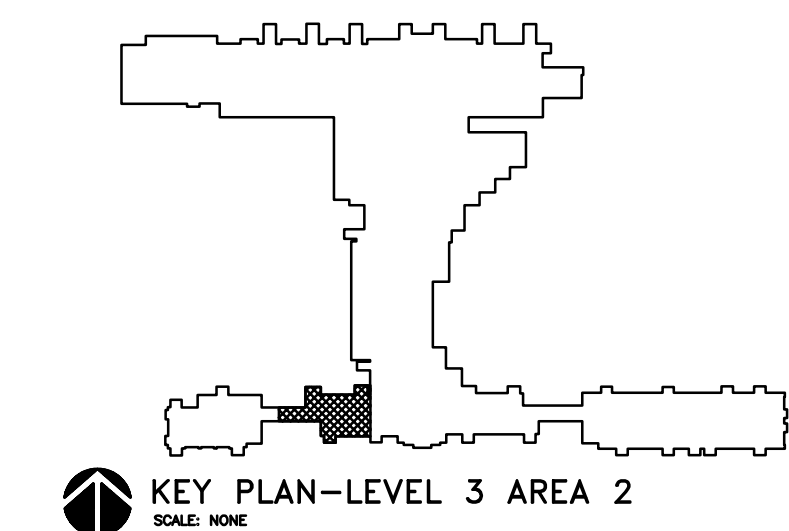

[illegible]

2	6	-	7	2	5	9	.	1	1	-	0	8
---	---	---	---	---	---	---	---	---	---	---	---	---

Design Review Committee		City Engineer Approval		Last Design Update	Mo./Day/Yr.	Mo./Day/Yr.
City Project No. <b>7259.25</b>	Zone Map No. <b>M-16</b>	Drawing No. <b>E103</b>	Sheet <b>9</b>	Of <b>33</b>		

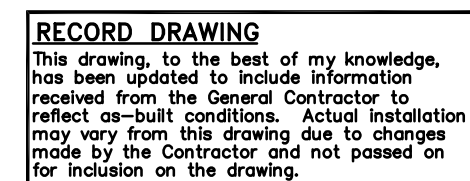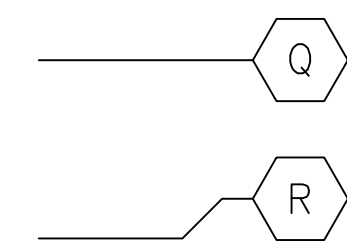

City Project No. 7259.25	Zone Map No. M-16	Drawing No. E104	Sheet 10	Of 33
-----------------------------	----------------------	---------------------	-------------	----------

[illegible]






GENERAL NOTES:

- A. WHERE NECESSARY, THE CONTRACTOR SHALL REROUTE AND/OR RECONNECT CIRCUIT RUNS TO MAINTAIN THE CONTINUITY OF THE EXISTING CIRCUIT.
- B. ALL ELECTRICAL PENETRATIONS THROUGH FIRE RATED ASSEMBLIES SHALL BE SEALED TO MAINTAIN THE RATING OF THE ASSEMBLY.

KEYED NOTES: 

1. EXISTING LIGHTING FIXTURE TO BE REPLACED. DISCONNECT EXISTING FIXTURES AND RETURN TO AVIATION. PROVIDE NEW FIXTURE AS INDICATED AND CONNECT TO EXISTING LIGHTING CIRCUIT.
2. WORK IN THIS AREA IS PART OF ALTERNATE #1. REPLACE FIXTURES IN THIS AREA. COORDINATE CEILING REMOVAL SO AS TO MINIMIZE IMPACT TO AIRPORT OPERATIONS.
3. NEW LOW PROFILE CEILING MOUNTED PHOTOCELL FOR A/B SWITCHING OF LIGHTING IN HOLD AREAS. INSTALL PER MANUFACTURERS RECOMMENDATIONS. COORDINATE SET POINTS WITH AVIATION DEPARTMENT PERSONNEL.
4. EXISTING TO REMAIN.

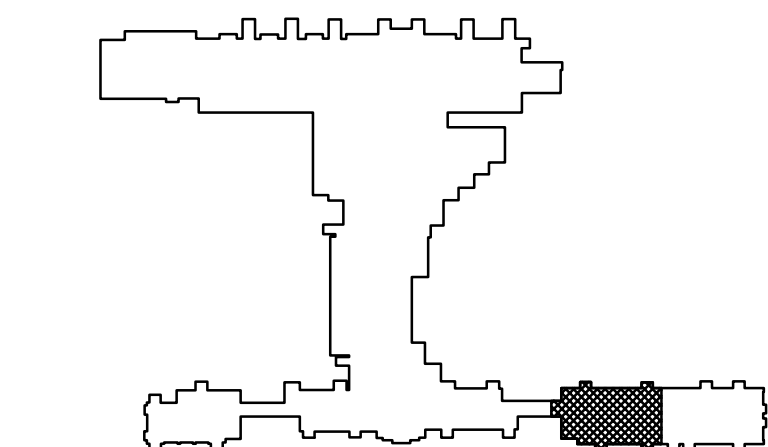

 KEY PLAN—LEVEL 3 AREA 5  
SCALE: NONE

**ASCG**  
INCORPORATED

ENGINEERS • ARCHITECTS • SURVEYORS • PLANNERS

6501 AMERICAS PARKWAY NE, SUITE 400  
ALBUQUERQUE, NEW MEXICO 87110-5372  
PHONE 505.247.0294 • FAX 505.242.4845

RECORD DRAWING

This drawing, to the best of my knowledge, has been updated to include information received from the General Contractor to reflect as-built conditions. Actual installation may vary from this drawing due to changes made by the Contractor and not passed on for inclusion on the drawing.

CITY OF ALBUQUERQUE  
PUBLIC WORKS DEPARTMENT  
ENGINEERING DEVELOPMENT GROUP

TITLE:	ALBUQUERQUE INTERNATIONAL SUNPORT LIGHTING MODERNIZATION PROJECT
--------	---


LEVEL 3 ELECTRICAL LIGHTING PLAN – AREA 5

Design Review Committee	City Engineer Approval	Last Design Update	Mo./Day/Yr.	Mo./Day/Yr.


City Project No. 7259.25	Zone Map No. M-16	Drawing No. E105	Sheet 11	Of 33
-----------------------------	----------------------	---------------------	-------------	----------

[illegible]

2	6	-	7	2	5	9	.	1	1	-	0	8
---	---	---	---	---	---	---	---	---	---	---	---	---

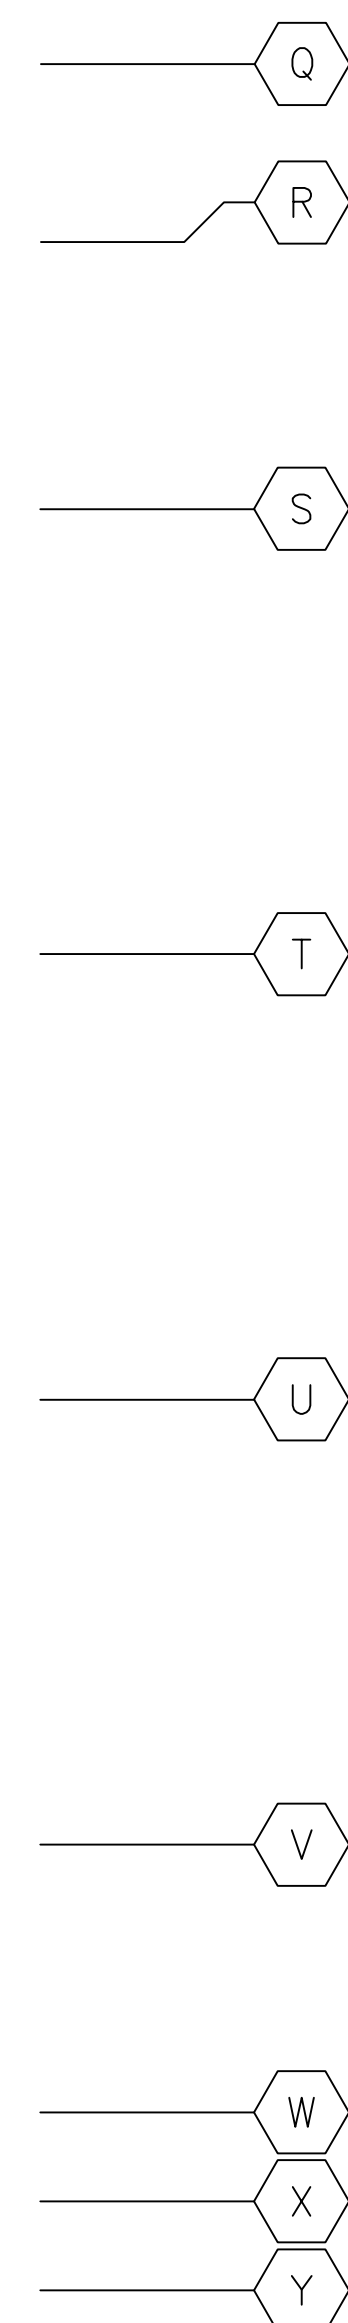
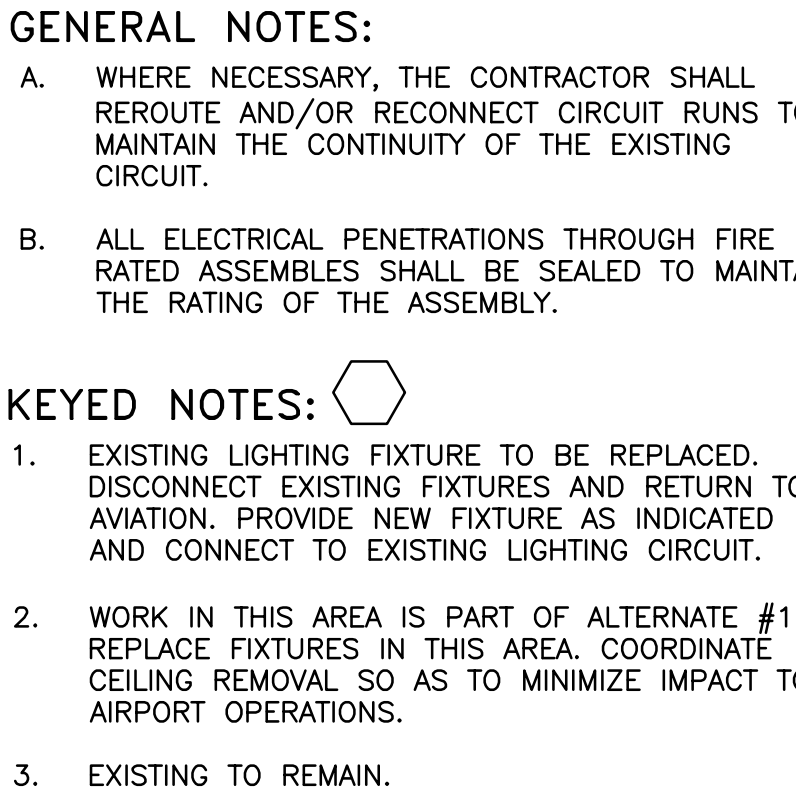
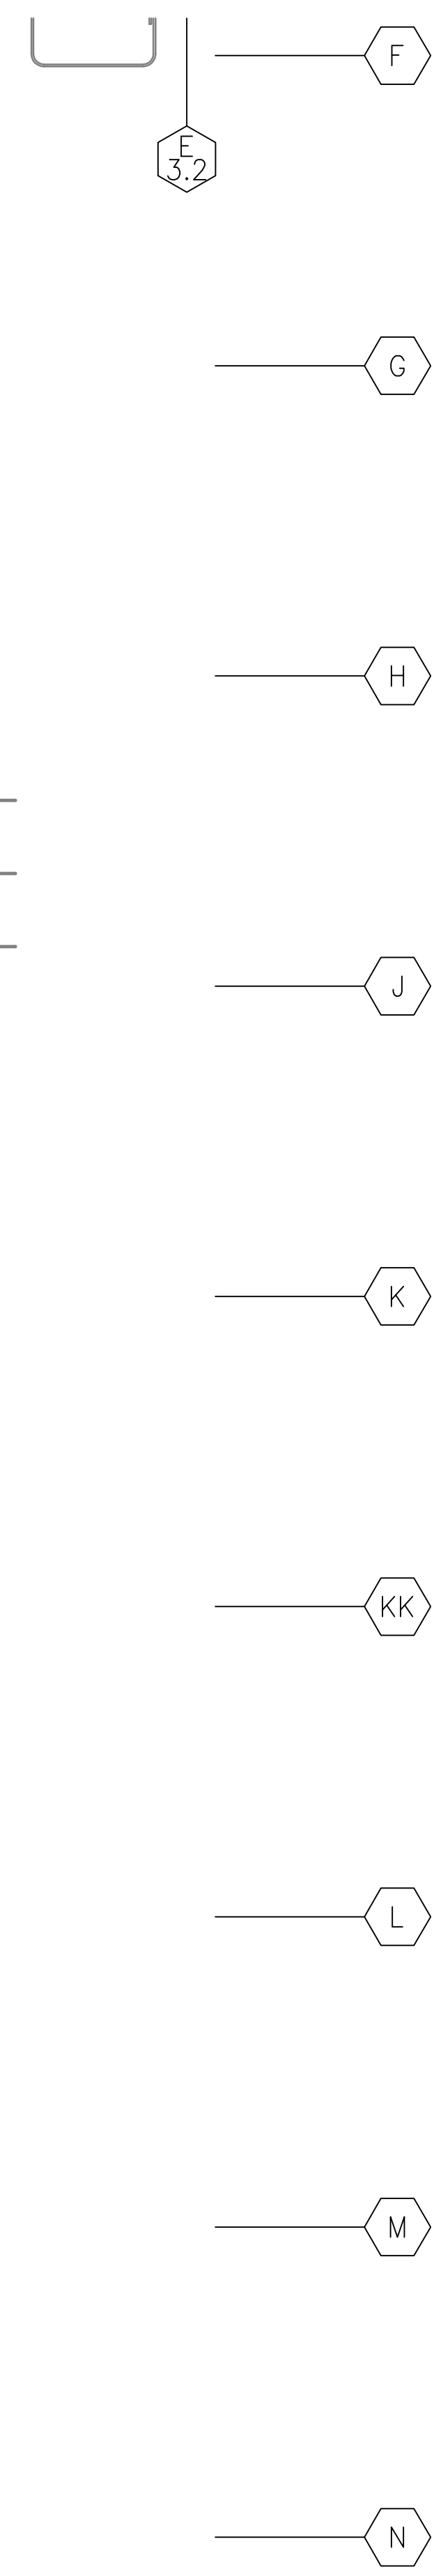


2	6	-	7	2	5	9	.	1	1	-	0	8
---	---	---	---	---	---	---	---	---	---	---	---	---

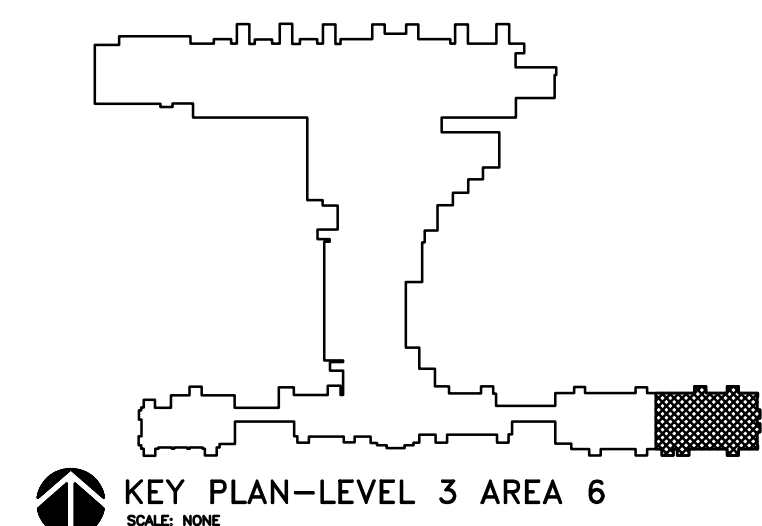

**RECORD DRAWING**  
This drawing, to the best of my knowledge, has been updated to include information received from the General Contractor to reflect as-built conditions. Actual installation may vary from this drawing due to changes made by the Contractor and not passed on for inclusion on the drawing.

[illegible]



 KEY PLAN—LEVEL 3 AREA 7  
SCALE: NONE


#### **RECORD DRAWING**


Design Review Committee	City Engineer Approval		Last Design Update	Mo./Day/Yr.	Mo./Day/Yr.
City Project No. <b>7259.25</b>	Zone Map No. <b>M-16</b>	Drawing No. <b>E107</b>	Sheet <b>13</b>	Of <b>33</b>	

City Project No. 7259.25	Zone Map No. M-16	Drawing No. F107	Sheet 13	Of 33
-----------------------------	----------------------	---------------------	-------------	----------


2	6	-	7	2	5	9	.	1	1	-	0	8
---	---	---	---	---	---	---	---	---	---	---	---	---



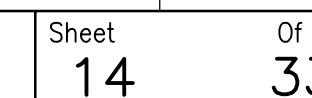

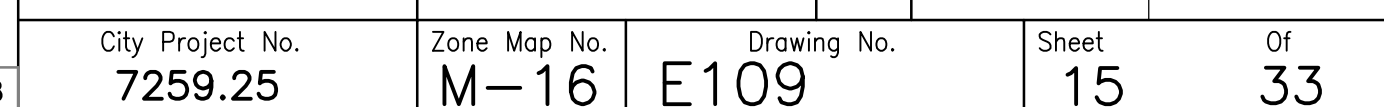



ENGINEER'S STAMP & SIGNATURE				SURVEY INFORMATION		BENCH MARKS		AS BUILT INFORMATION	
					Field Notes By				
				No.					
No.	Date	Remarks	By						
REVISIONS									
DESIGN									
Designed By: PL				Date: —					
Drawn By: CGA				Date: —					
Checked By: PL				Date: —					

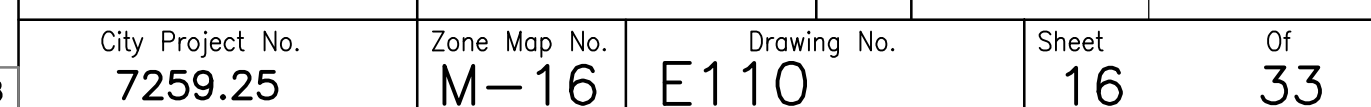[illegible]



[illegible]

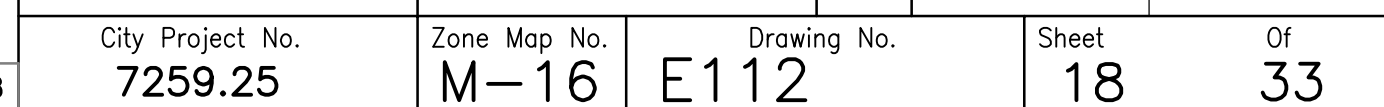
[illegible]

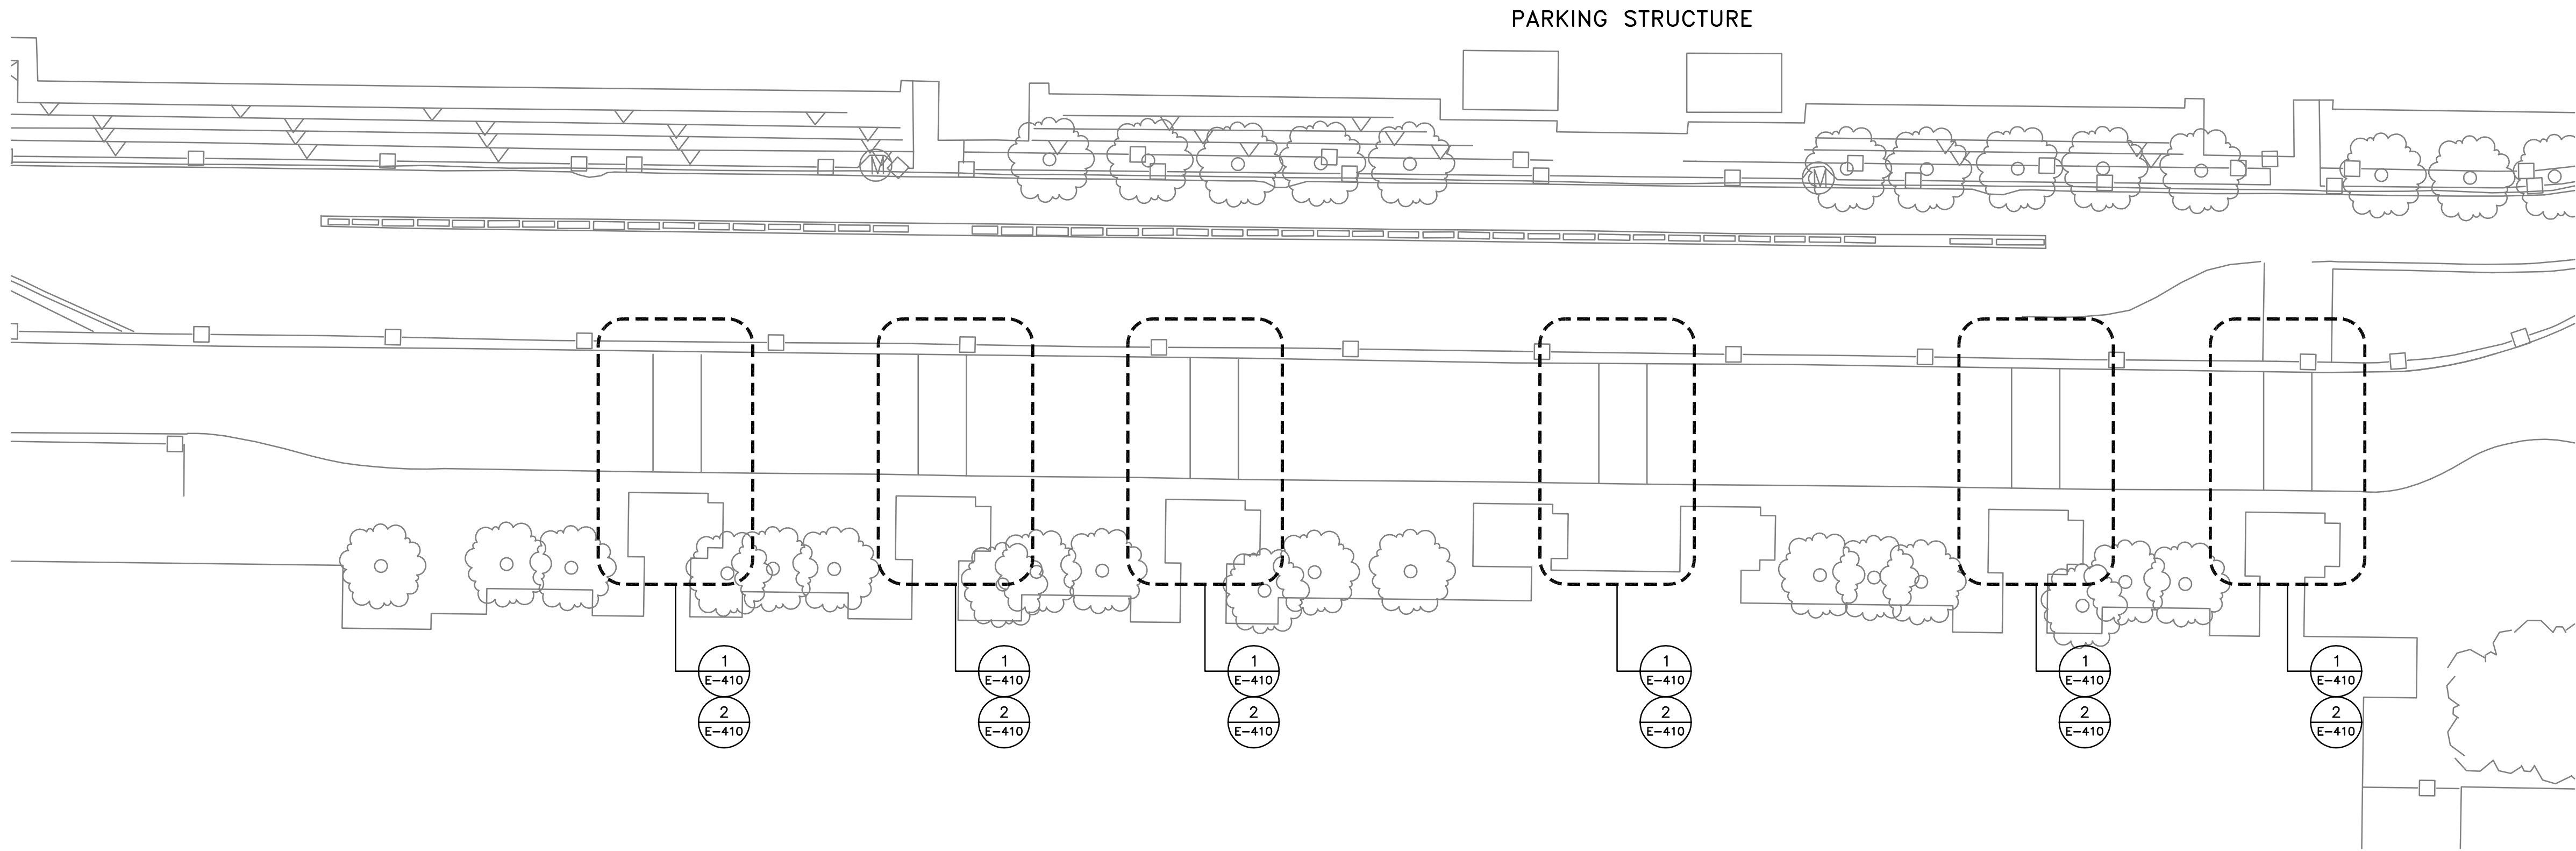

PARTIAL SITE PLAN – LEVEL 1 CROSSWALKS  
SCALE: NONE



- GENERAL NOTES:
- A. WHERE NECESSARY, THE CONTRACTOR SHALL REROUTE AND/OR RECONNECT CIRCUIT RUNS TO MAINTAIN THE CONTINUITY OF THE EXISTING CIRCUIT.
  - B. ALL ELECTRICAL PENETRATION THROUGH FIRE RATED ASSEMBLIES SHALL BE SEALED TO MAINTAIN THE RATING OF THE ASSEMBLY.

AS BUILT INFORMATION				BENCH MARKS		SURVEY INFORMATION		ENGINEER'S STAMP & SIGNATURE		REVISIONS			
Contractor	Checked By	Date		Field Notes	By	No.		<div><p>I, William P. Foster, to the best of my knowledge, certify that this electronic version is identical to the original reproducible RECORD drawing signed by me on 07/22/2011.</p></div>	By	Date	Remarks	No.	Date
Inspector's	Inspector's	Date											
Field	Field	Date											
Verification	Verification	Date											
By	By	Date											
Corrected	Corrected	Date											
By	By	Date											
Recorded	Recorded	Date											
By	By	Date											
No.	No.	Date											

**ASCG**  
INCORPORATED  
ENGINEERS • ARCHITECTS • SURVEYORS • PLANNERS  
6501 AMERICAS PARKWAY NE, SUITE 400  
ALBUQUERQUE, NEW MEXICO 87110-5372  
PHONE 505.247.0234 • FAX 505.242.4845

**RECORD DRAWING**  
This drawing, to the best of my knowledge, has been updated to include information received from the General Contractor to reflect as-built conditions. Actual installation may vary from this drawing due to changes made by the Contractor and not passed on for inclusion on the drawing.


CITY OF ALBUQUERQUE  
PUBLIC WORKS DEPARTMENT  
ENGINEERING DEVELOPMENT GROUP  
TITLE: ALBUQUERQUE INTERNATIONAL SUNPORT  
LIGHTING MODERNIZATION PROJECT  
PARTIAL SITE PLAN – LEVEL 1 CROSSWALKS

Design Review Committee	City Engineer Approval	Mo./Day/Yr.	Mo./Day/Yr.


City Project No.	Zone Map No.	Drawing No.	Sheet	Of
7259.25	M-16	E113	19	33

2 6 - 7 2 5 9 . 1 1 - 0 8




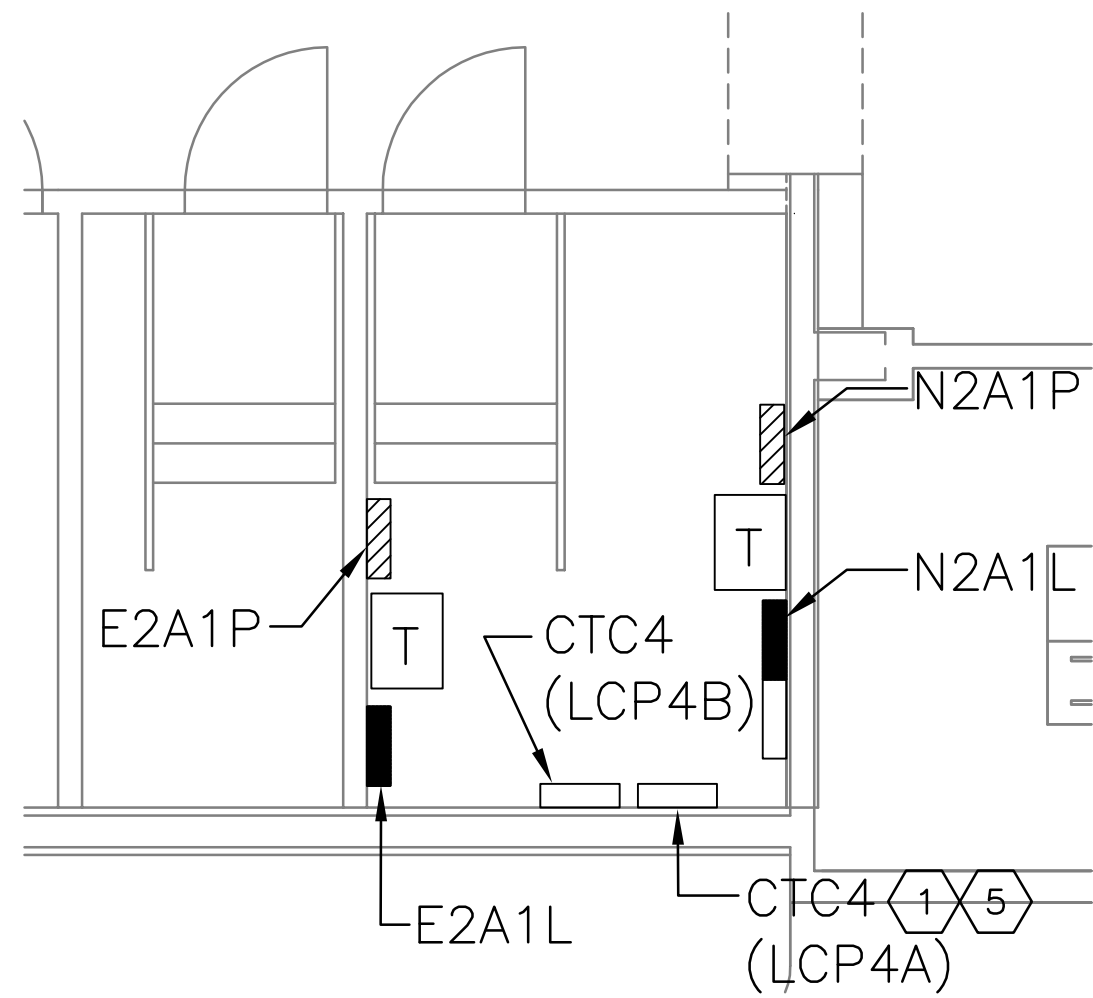


3 ENLARGED FLOOR PLAN – ELECTRICAL/COMM ROOM 4–11, 4–12  
1/4" = 1'-0"

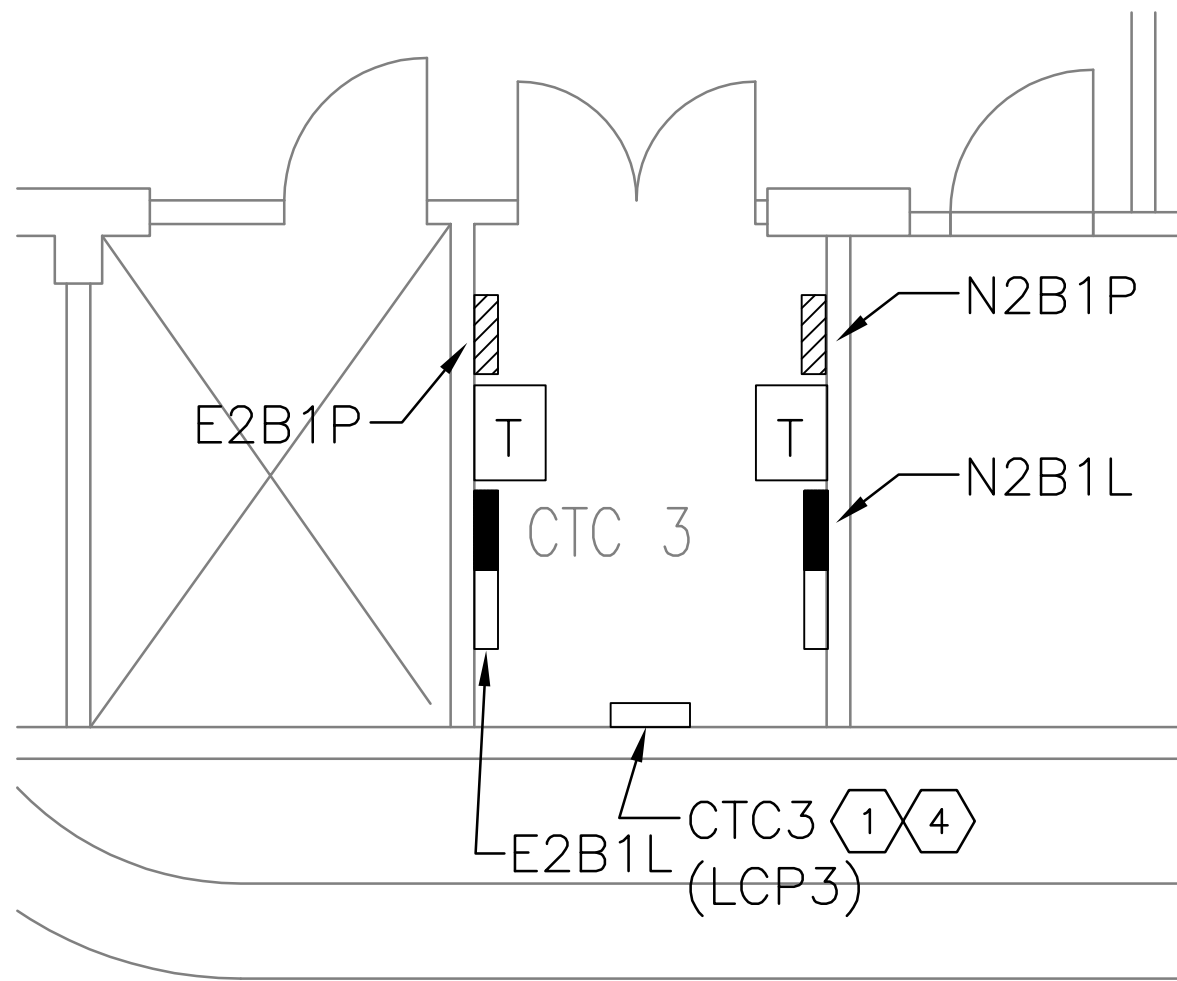

4 ENLARGED FLOOR PLAN – ELECTRICAL/COMM ROOM 3–20, 3–21  
1/4" = 1'-0"

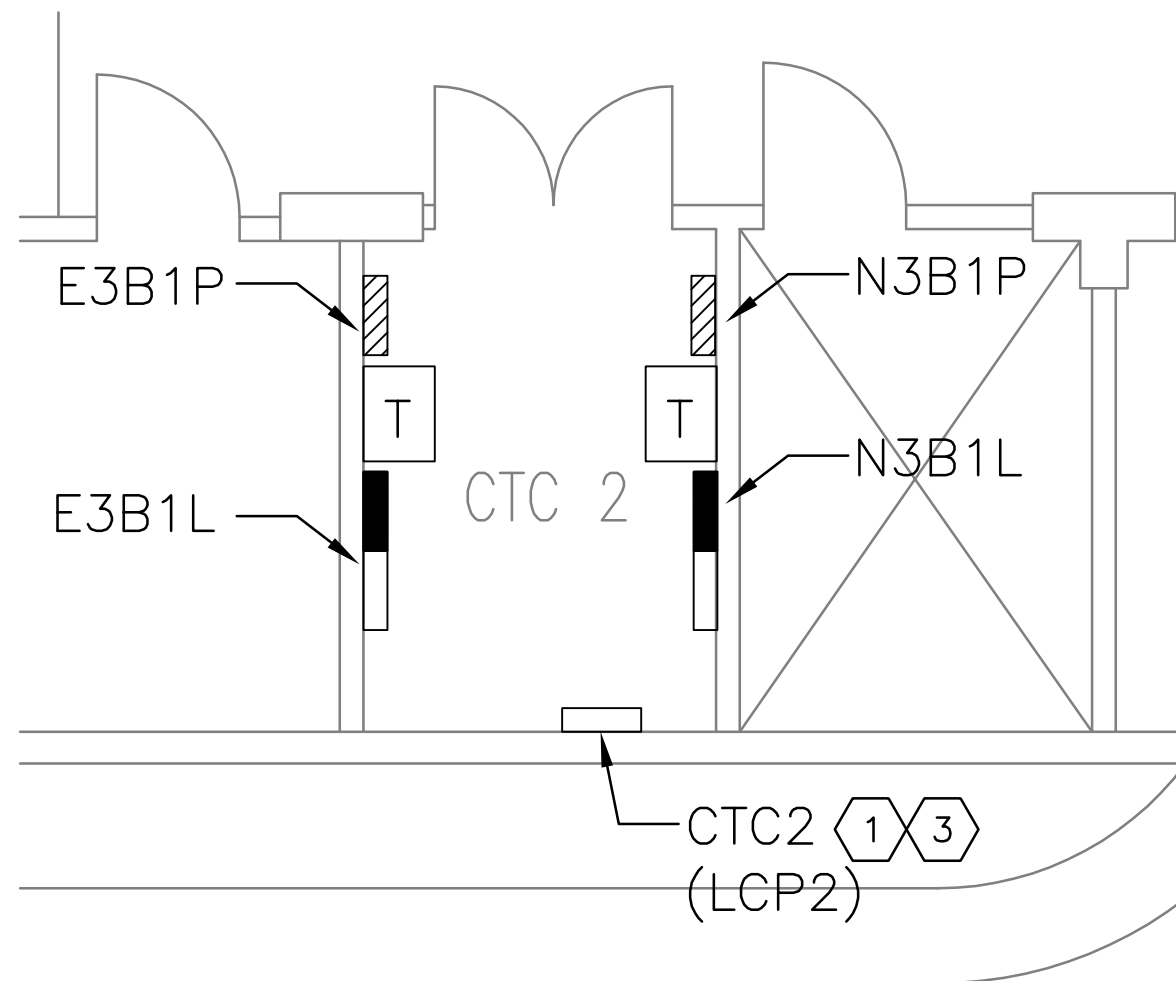

5 ENLARGED FLOOR PLAN – ELECTRICAL/COMM ROOM 3–15, 3–21  
1/4" = 1'-0"

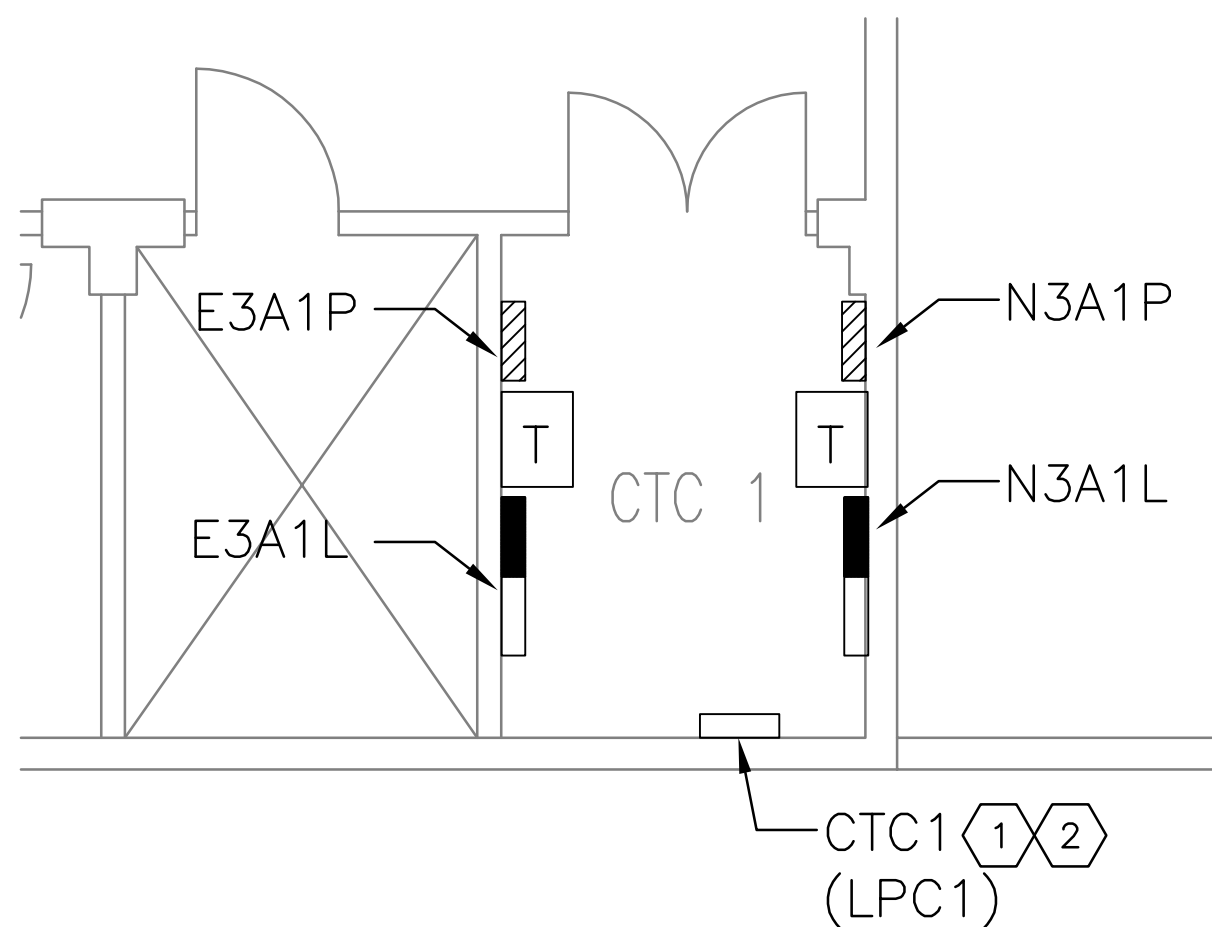

6 ENLARGED FLOOR PLAN – COMM/ELECTRICAL ROOM 2–26, 2–27  
1/4" = 1'-0"



GENERAL NOTES:

- A. WHERE NECESSARY, THE CONTRACTOR SHALL REROUTE AND/OR RECONNECT CIRCUIT RUNS TO MAINTAIN THE CONTINUITY OF THE EXISTING CIRCUIT.
- B. ALL ELECTRICAL PENETRATIONS THROUGH FIRE RATED ASSEMBLES SHALL BE SEALED TO MAINTAIN THE RATING OF THE ASSEMBLY.
- C. REFER TO DRAWING ED01 FOR EXISTING CTC CABINETS WIRING INFORMATION.
- D. REFER TO DRAWING E601 THRU E603 FOR NEW LCP CIRCUITING INFORMATION.

KEYED NOTES:

1. EXISTING CTC CABINET TO BE REPLACED. TEMPORARILY REMOVE LIGHTING CIRCUITS FROM THIS CTC CABINET AND SPLICE TO MAINTAIN CIRCUIT CONTINUITY. REMOVE EXISTING CTC CABINET AND ASSOCIATED HARDWARE IN IT'S ENTIRETY. INSTALL NEW LCP IN SAME LOCATION AND REFEED LIGHTING CIRCUIT THRU NEW RELAYS.
2. RE-LABEL CTC1 AS LCP1.
3. RE-LABEL CTC2 AS LCP2.
4. RE-LABEL CTC3 AS LCP3.
5. RE-LABEL CTC4 AS LCP4A AND LCP4B.



I, William P. Foster, to the best of my knowledge, certify that this electronic version is identical to the original reproducible RECORD drawing signed by me on 07/22/2011.

ASCG  
INCORPORATED

ENGINEERS • ARCHITECTS • SURVEYORS • PLANNERS

6501 AMERICAS PARKWAY NE, SUITE 400  
ALBUQUERQUE, NEW MEXICO 87110-5372  
PHONE 505.247.0234 • FAX 505.242.4845


RECORD DRAWING  
This drawing, to the best of my knowledge, has been updated to include information received from the General Contractor to reflect as-built conditions. Actual installation may vary from this drawing due to changes made by the Contractor and not passed on for inclusion on the drawing.

CITY OF ALBUQUERQUE  
PUBLIC WORKS DEPARTMENT  
ENGINEERING DEVELOPMENT GROUP


TITLE: ALBUQUERQUE INTERNATIONAL SUNPORT  
LIGHTING MODERNIZATION PROJECT  
ENLARGED ELECTRICAL AND COMM. ROOMS

Design Review Committee	City Engineer Approval	Last Design Update	Mo./Day/Yr.	


City Project No. 7259.25	Zone Map No. M-16	Drawing No. E-401	Sheet 20	Of 33
-----------------------------	----------------------	----------------------	-------------	----------

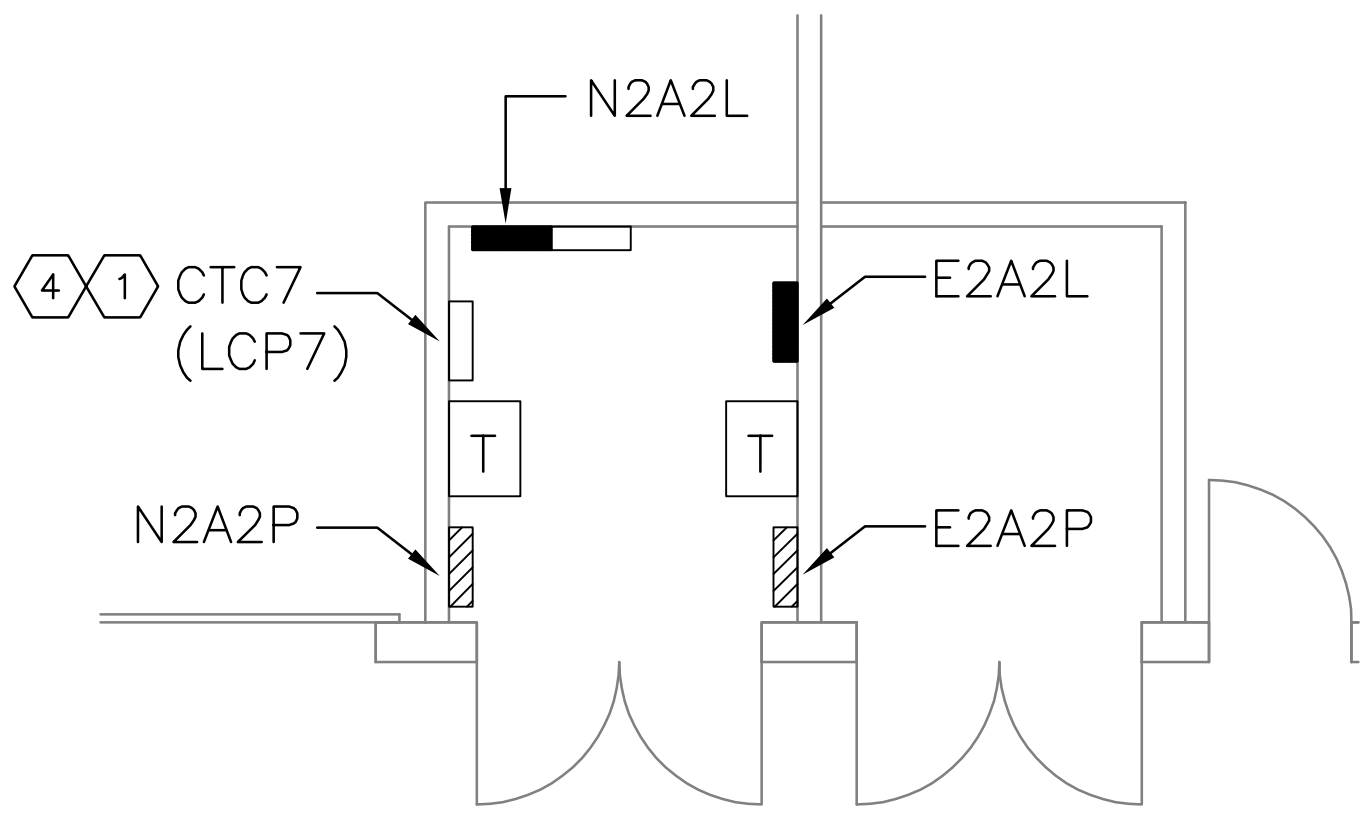


1 ENLARGED FLOOR PLAN – ELECTRICAL/COMM ROOM 9–12, 9–13  
1/4" = 1'-0"

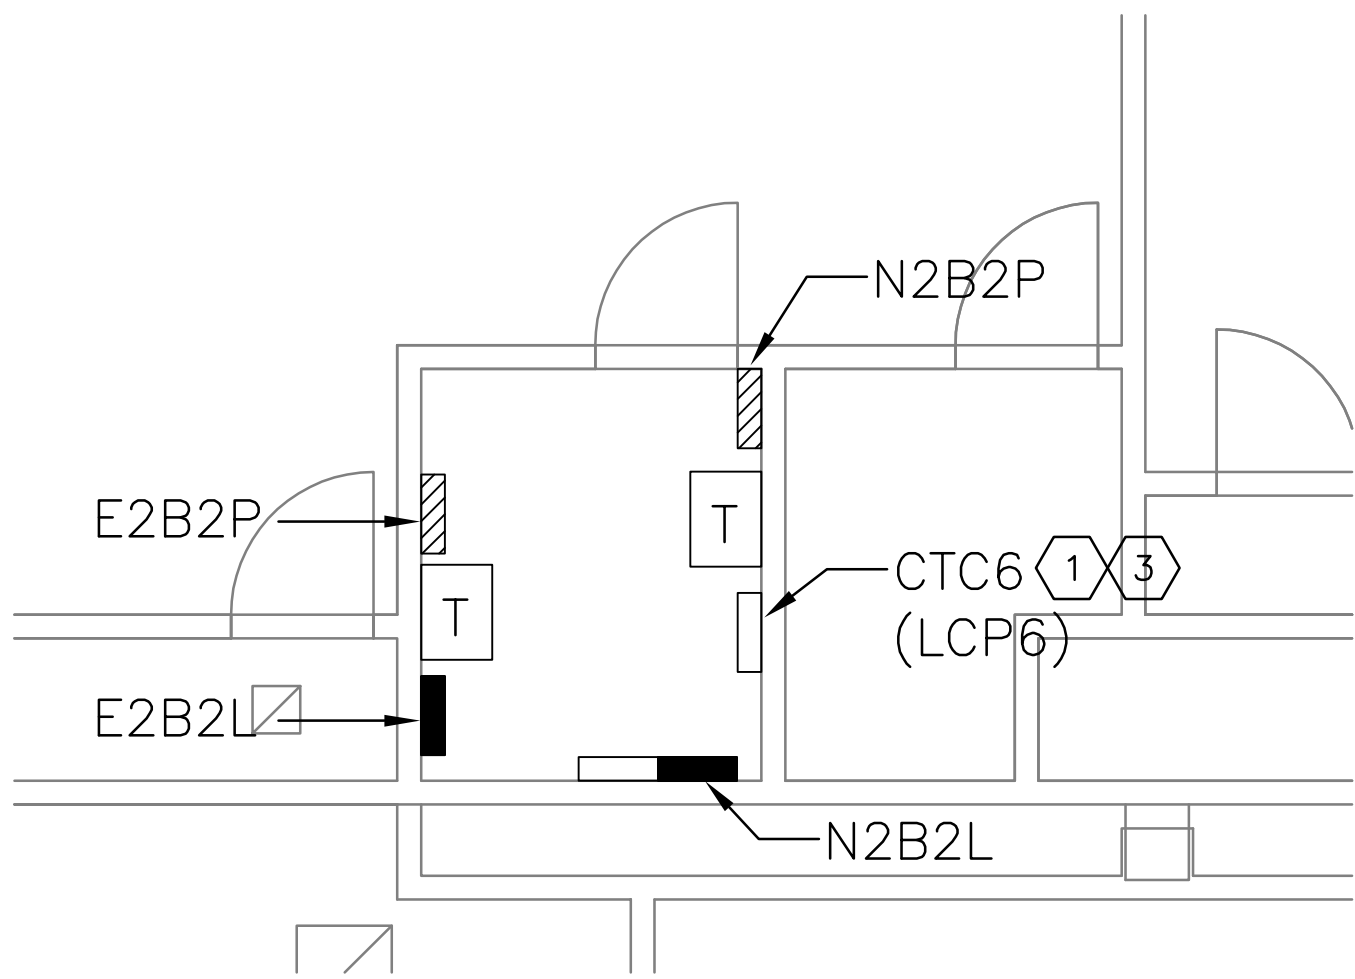


2 ENLARGED FLOOR PLAN – ELECTRICAL/COMM ROOM 8–17, 8–18  
1/4" = 1'-0"

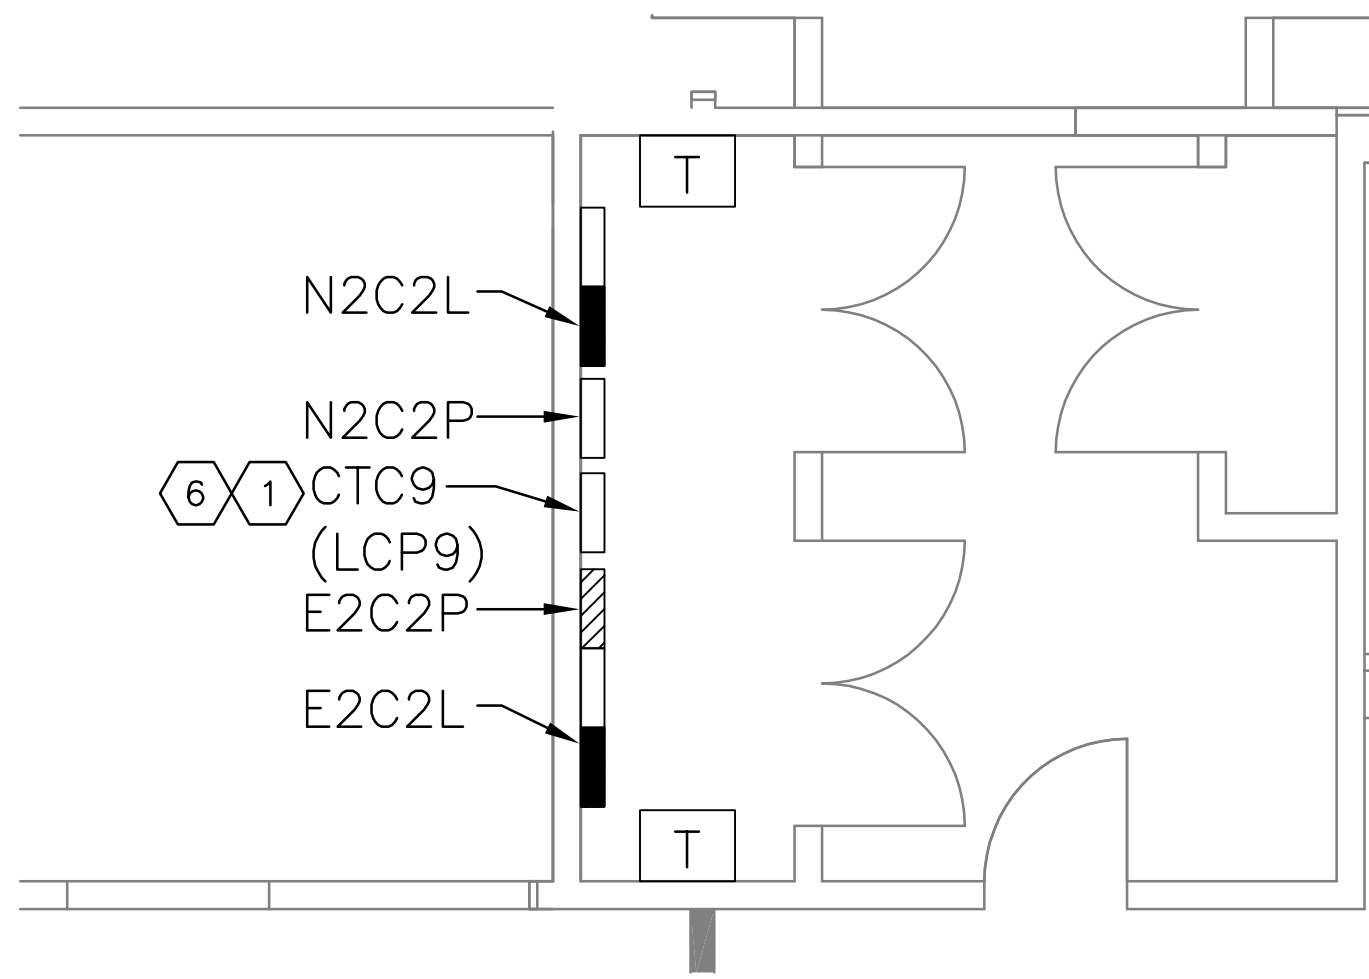


3 ENLARGED FLOOR PLAN – ELECTRICAL/COMM ROOM 13–16, 13–17  
1/4" = 1'-0"

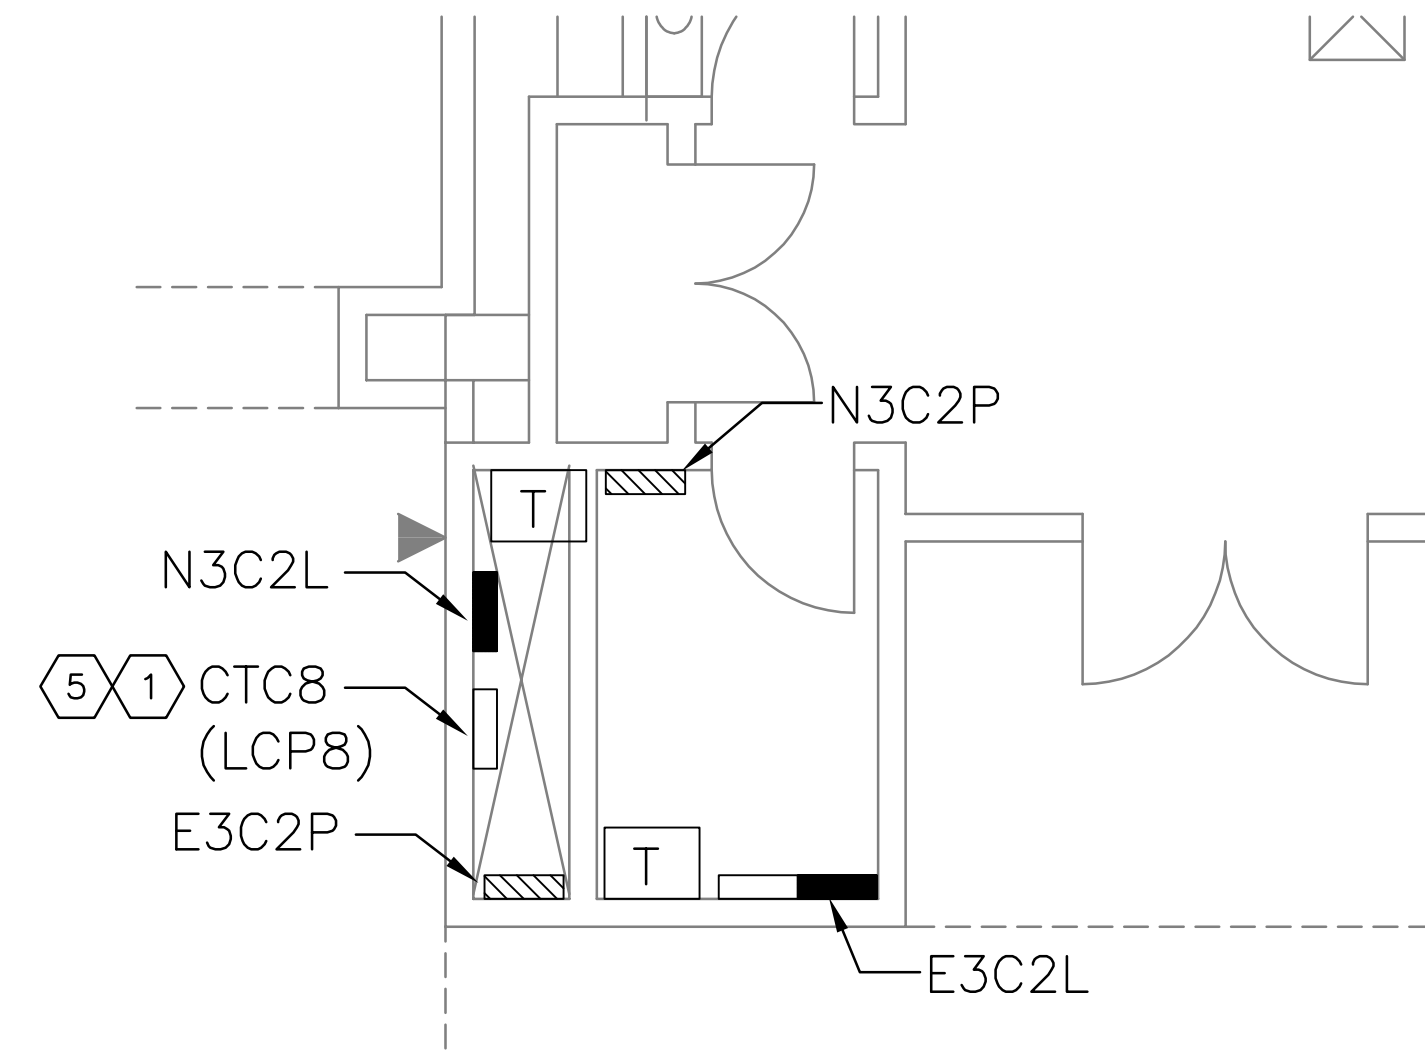

4 ENLARGED FLOOR PLAN – COMM/ELECTRICAL ROOM 12–01, 12–02  
1/4" = 1'-0"

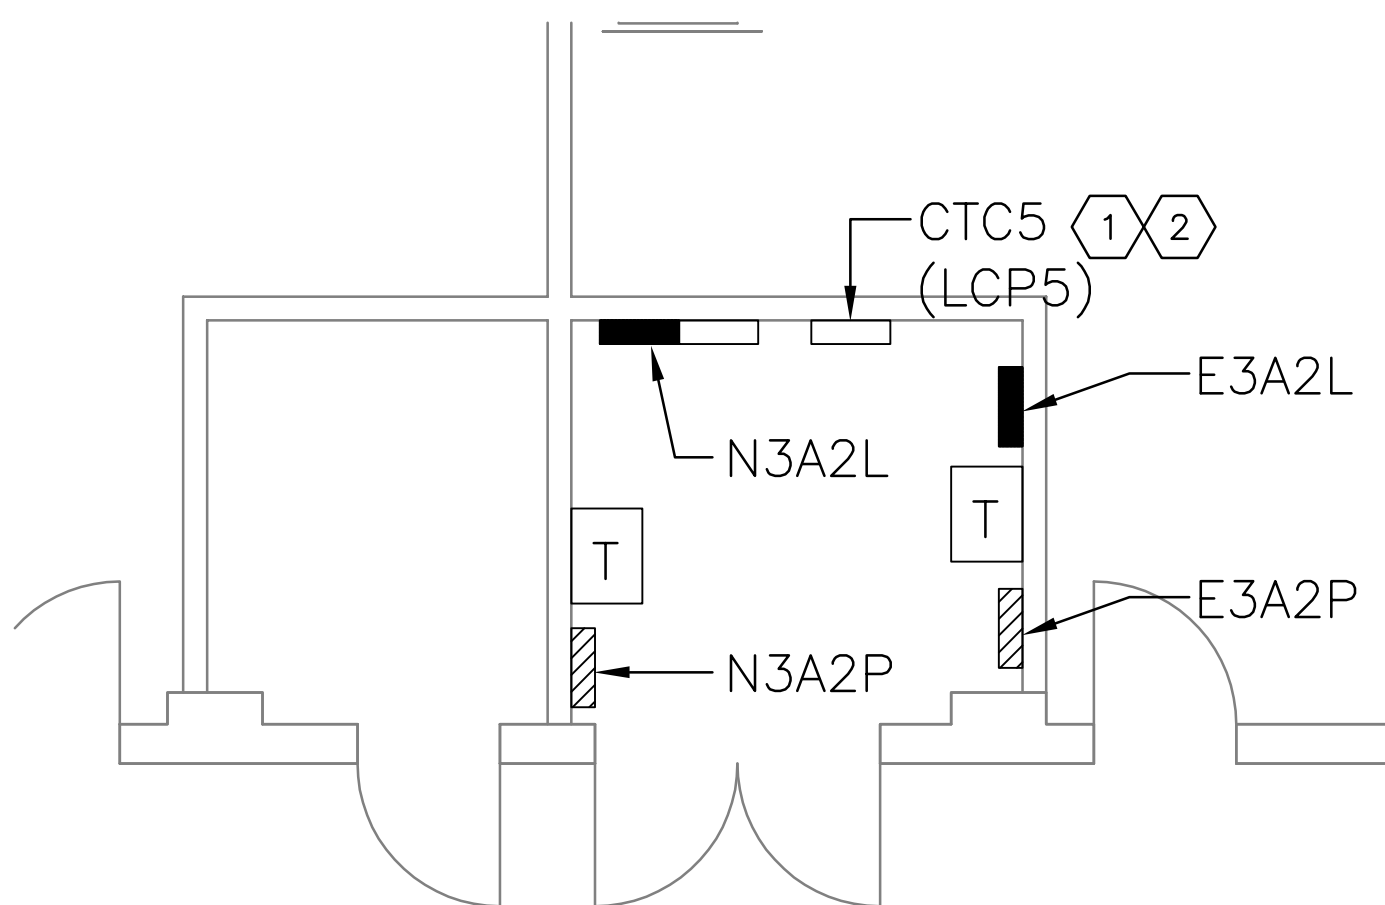

5 ENLARGED FLOOR PLAN – ELECTRICAL/COMM ROOM 7–13, 7–14  
1/4" = 1'-0"

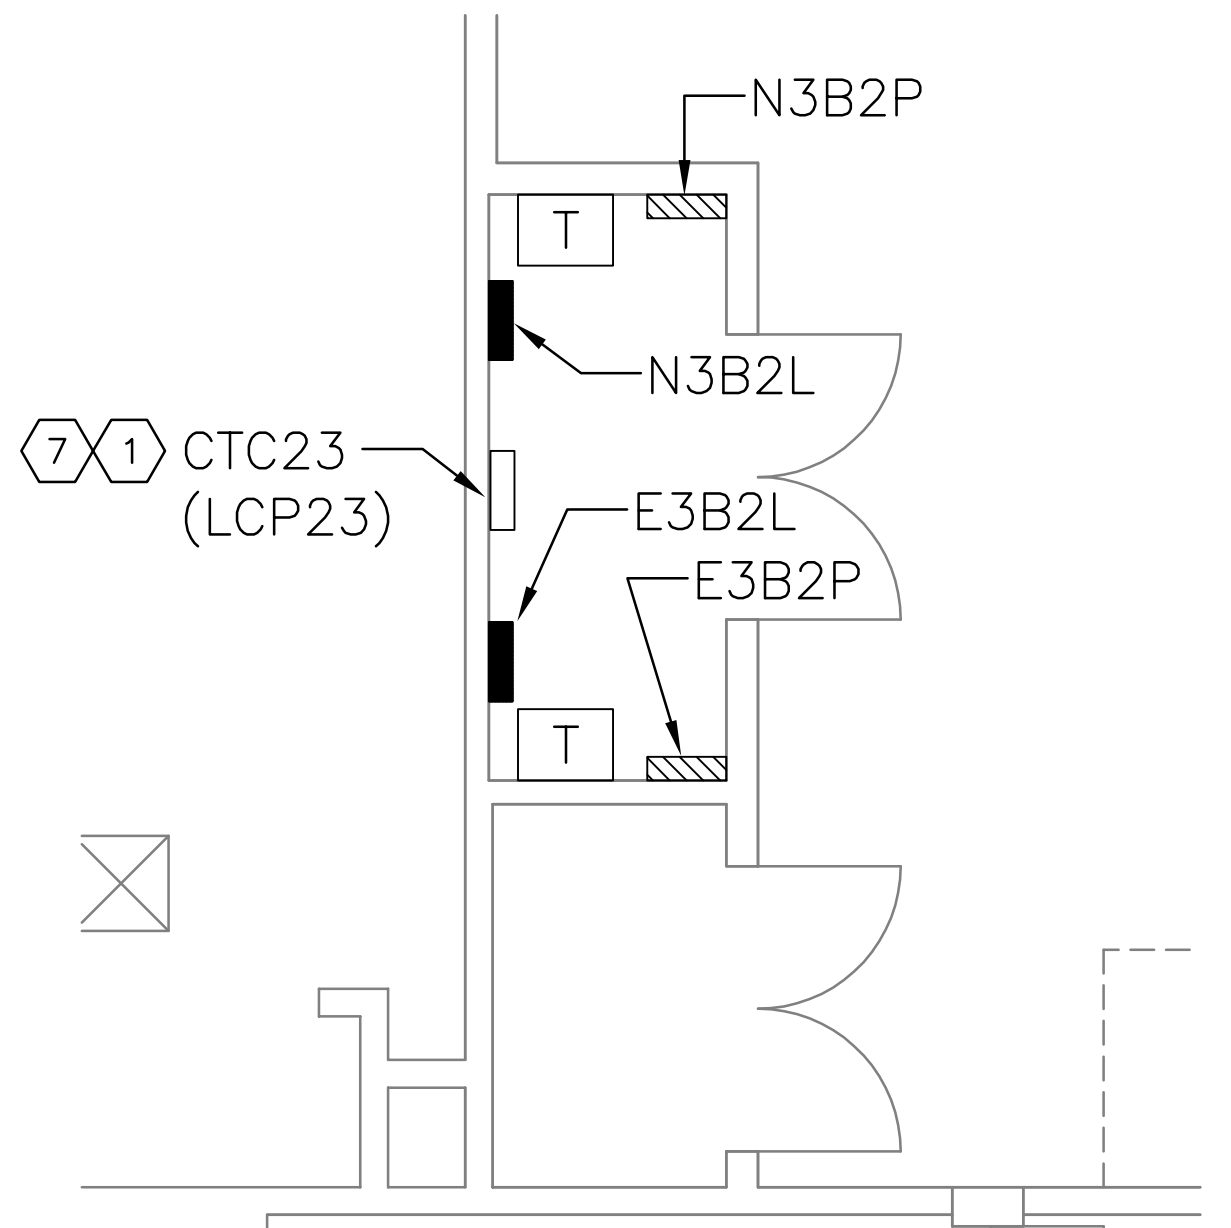

6 ENLARGED FLOOR PLAN – COMM/ELECTRICAL ROOM 7–12, 7–16  
1/4" = 1'-0"



- GENERAL NOTES:**
- A. WHERE NECESSARY, THE CONTRACTOR SHALL REROUTE AND/OR RECONNECT CIRCUIT RUNS TO MAINTAIN THE CONTINUITY OF THE EXISTING CIRCUIT.
  - B. ALL ELECTRICAL PENETRATIONS THROUGH FIRE RATED ASSEMBLIES SHALL BE SEALED TO MAINTAIN THE RATING OF THE ASSEMBLY.
  - C. REFER TO DRAWING ED01 FOR EXISTING CTC CABINETS WIRING INFORMATION.
  - D. REFER TO DRAWING E-601 THRU E-603 FOR NEW LCP CIRCUITING INFORMATION.

- KEYED NOTES:**
- 1. EXISTING CTC CABINET TO BE REPLACED. TEMPORARILY REMOVE LIGHTING CIRCUITS FROM THIS CTC CABINET AND SPLICE TO MAINTAIN CIRCUIT CONTINUITY. REMOVE EXISTING CTC CABINET AND ASSOCIATED HARDWARE IN IT'S ENTIRETY. INSTALL NEW LCP IN SAME LOCATION AND REFEED LIGHTING CIRCUIT THRU NEW RELAYS.
  - 2. RE-LABEL CTC5 AS LCP5.
  - 3. RE-LABEL CTC6 AS LCP6.
  - 4. RE-LABEL CTC7 AS LCP7.
  - 5. RE-LABEL CTC8 AS LCP8.
  - 6. RE-LABEL CTC9 AS LCP9.
  - 7. RE-LABEL CTC23 AS LCP23.



I, William P. Foster, to the best of my knowledge, certify that this electronic version is identical to the original reproducible RECORD drawing signed by me on 07/22/2011.

**ASCG**  
INCORPORATED

ENGINEERS • ARCHITECTS • SURVEYORS • PLANNERS

6501 AMERICAS PARKWAY NE, SUITE 400  
ALBUQUERQUE, NEW MEXICO 87110-5372  
PHONE 505.247.0234 • FAX 505.242.4645

**RECORD DRAWING**  
This drawing, to the best of my knowledge, has been updated to include information received from the General Contractor to reflect as-built conditions. Actual installation may vary from this drawing due to changes made by the Contractor and not passed on for inclusion on the drawing.


CITY OF ALBUQUERQUE  
PUBLIC WORKS DEPARTMENT  
ENGINEERING DEVELOPMENT GROUP

TITLE: ALBUQUERQUE INTERNATIONAL SUNPORT  
LIGHTING MODERNIZATION PROJECT  
ENLARGED ELECTRICAL AND COMM. ROOMS


Design Review Committee	City Engineer Approval	Mo./Day/Yr.	Mo./Day/Yr.

City Project No.	Zone Map No.	Drawing No.	Sheet	Of
7259.25	M-16	E-402	21	33


2 6 - 7 2 5 9 . 1 1 - 0 8

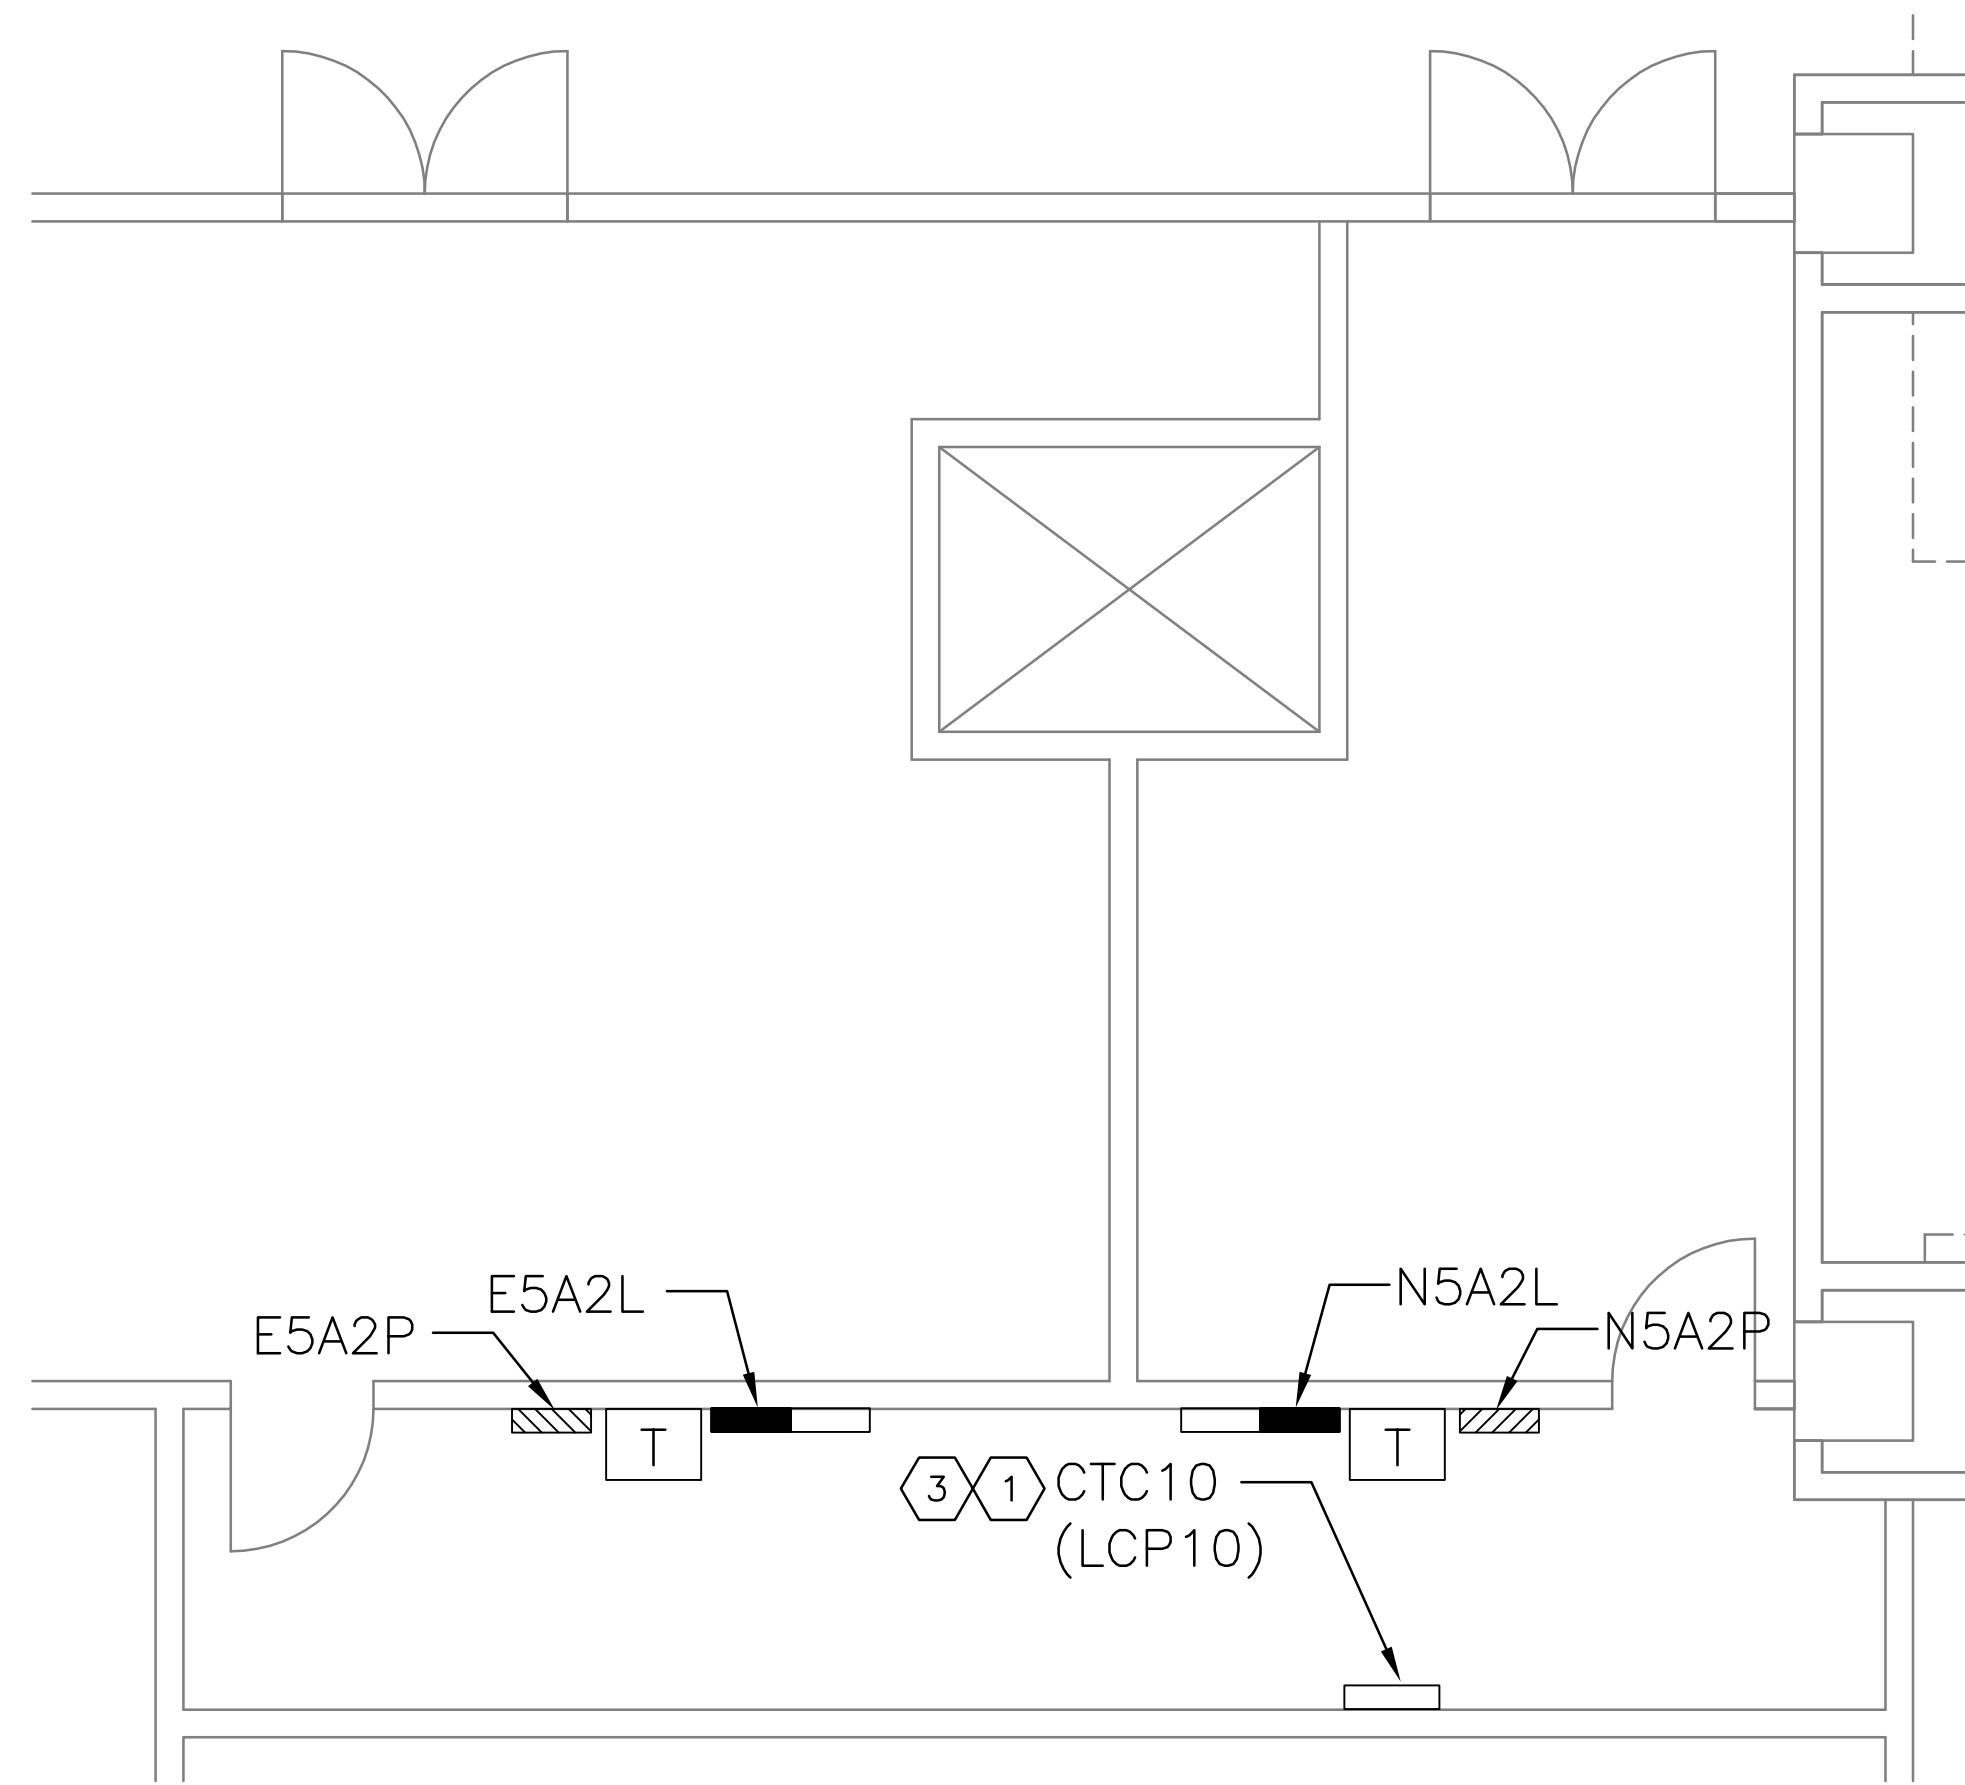


1 ENLARGED FLOOR PLAN – ELECTRICAL/COMM ROOM 14-01, 15-17  
1/4" = 1'-0"

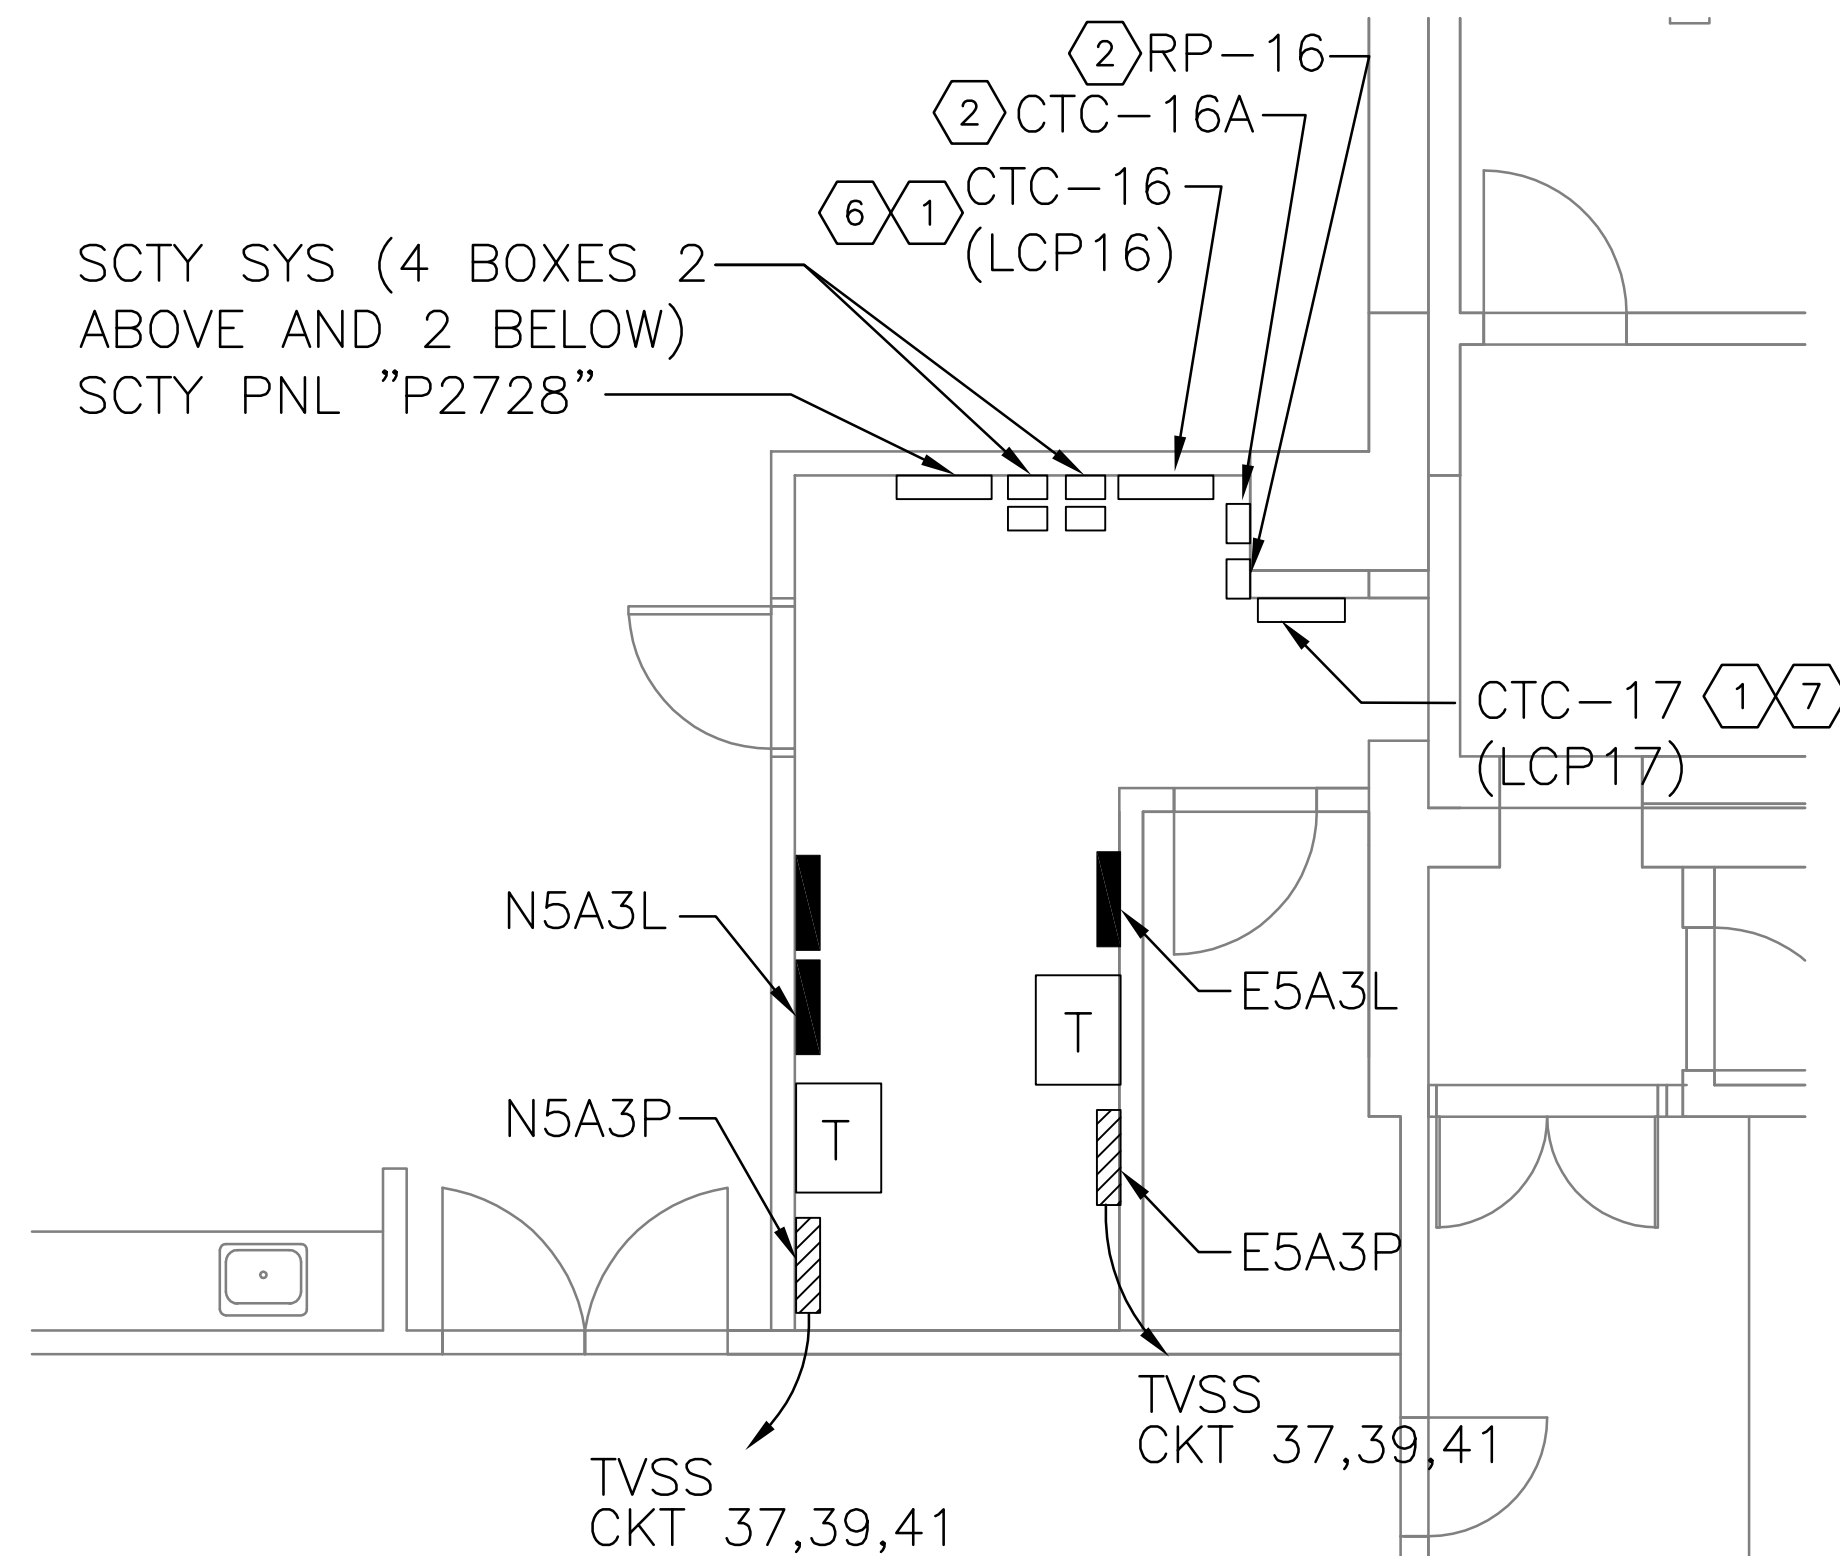


2 ENLARGED FLOOR PLAN – ELECTRICAL ROOM 216  
1/4" = 1'-0"

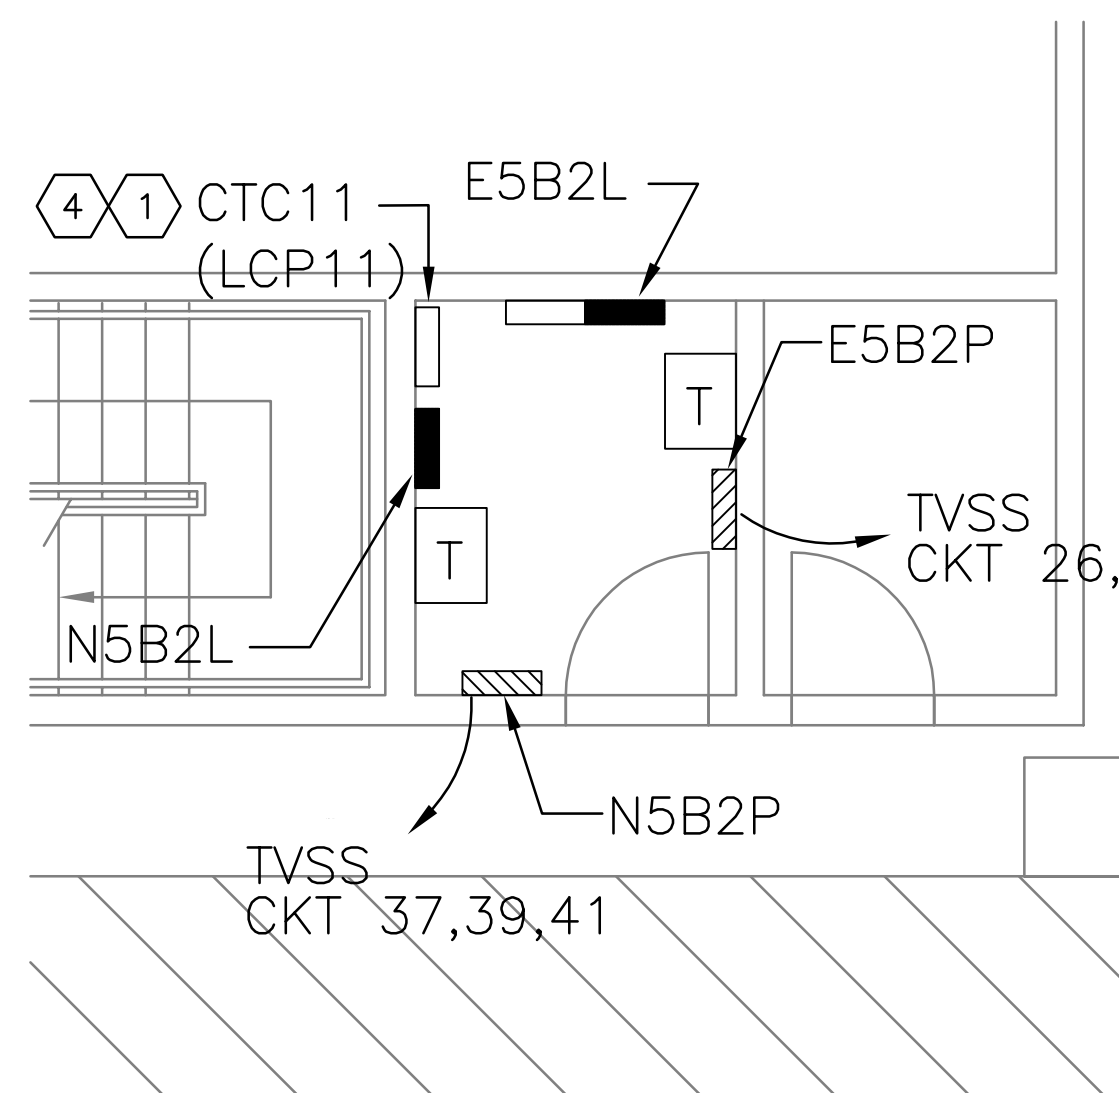

3 ENLARGED FLOOR PLAN – ELECTRICAL/COMM. ROOM 17-09, 17-10  
1/4" = 1'-0"

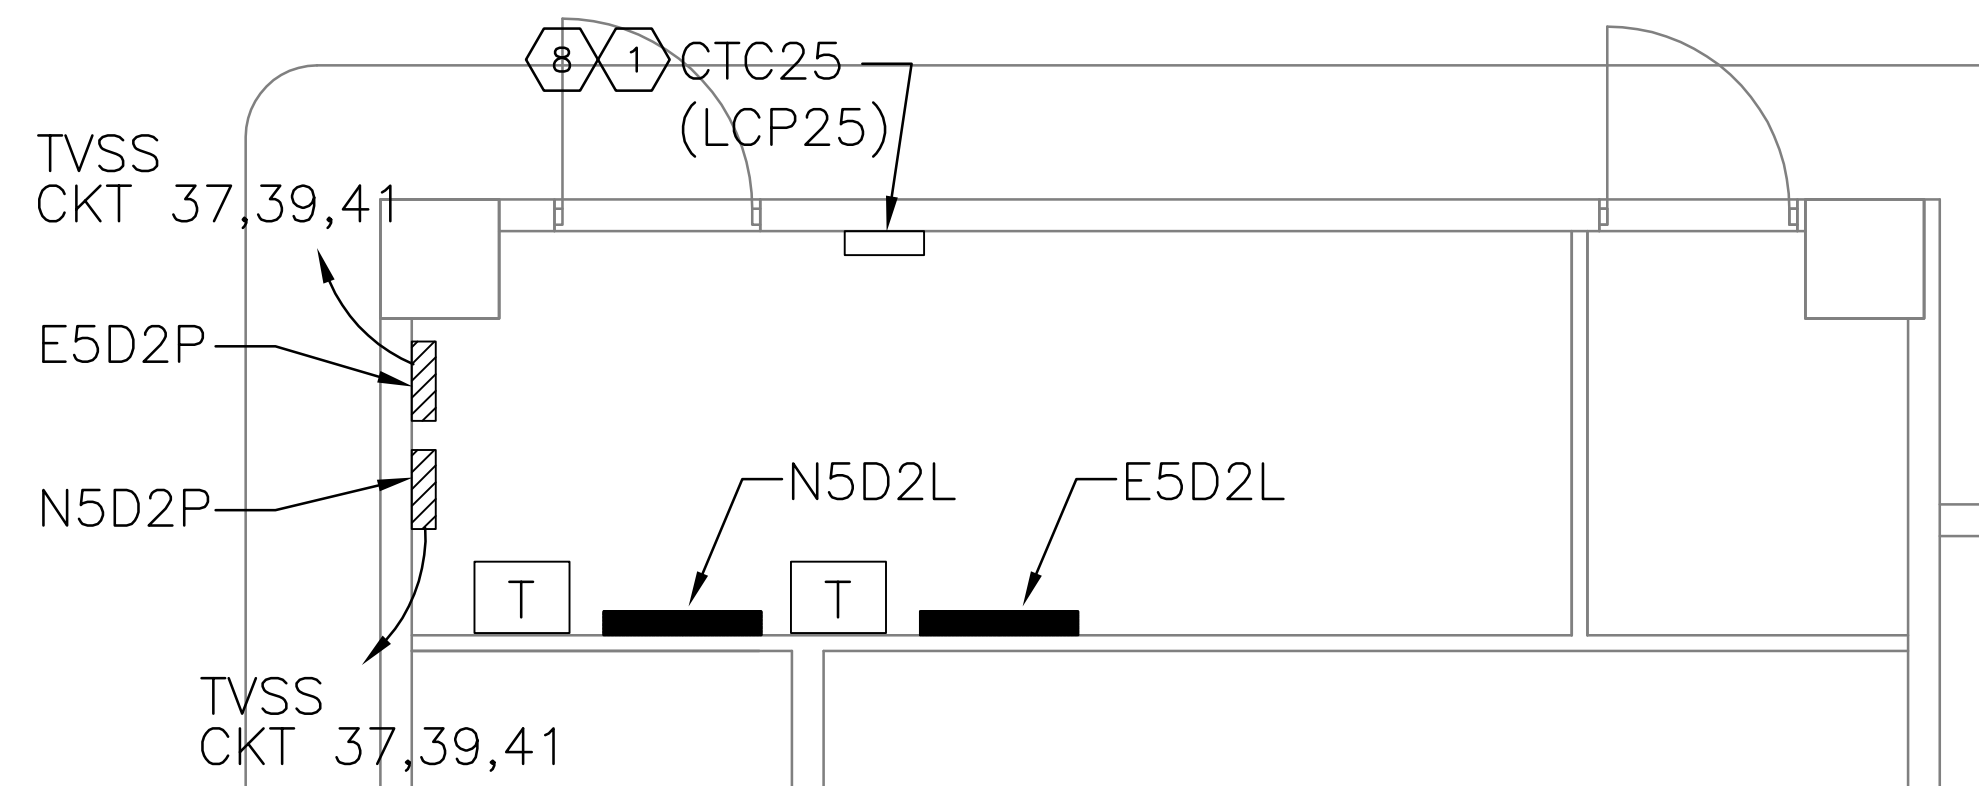

4 ENLARGED FLOOR PLAN – ELECTRICAL/COMM. ROOM 27-28, 1710-A  
1/4" = 1'-0"

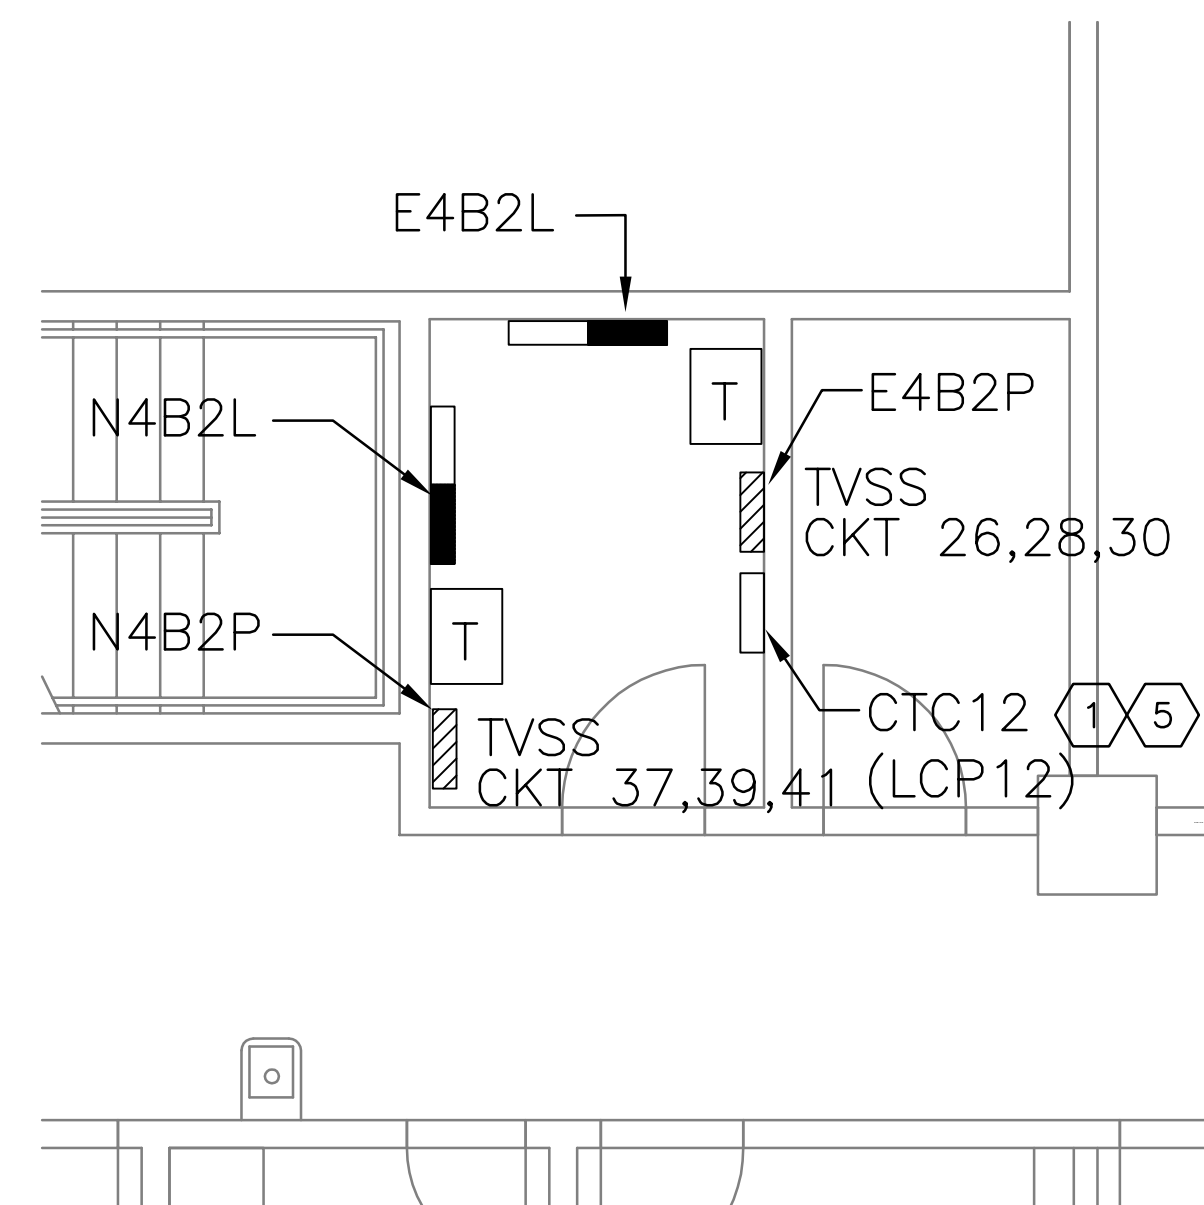

5 ENLARGED FLOOR PLAN – ELECTRICAL/COMM. ROOM 19-12, 19-13  
1/4" = 1'-0"



#### GENERAL NOTES:

- WHERE NECESSARY, THE CONTRACTOR SHALL REROUTE AND/OR RECONNECT CIRCUIT RUNS TO MAINTAIN THE CONTINUITY OF THE EXISTING CIRCUIT.
- ALL ELECTRICAL PENETRATIONS THROUGH FIRE RATED ASSEMBLIES SHALL BE SEALED TO MAINTAIN THE RATING OF THE ASSEMBLY.
- REFER TO DRAWING ED01 FOR EXISTING CTC CABINETS WIRING INFORMATION.
- REFER TO DRAWING E-601 THRU E-603 FOR NEW LCP CIRCUITING INFORMATION.

#### KEYED NOTES:

- EXISTING CTC CABINET TO BE REPLACED. TEMPORARILY REMOVE LIGHTING CIRCUITS FROM THIS CTC CABINET AND SPLICE TO MAINTAIN CIRCUIT CONTINUITY. REMOVE EXISTING CTC CABINET AND ASSOCIATED HARDWARE IN IT'S ENTIRETY. INSTALL NEW LCP IN SAME LOCATION AND REFEED LIGHTING CIRCUIT THRU NEW RELAYS.
- RELOCATE CIRCUIT ASSOCIATED WITH CTC-16A AND RP-16 TO NEW LCP16.
- RE-LABEL CTC10 AS LCP10.
- RE-LABEL CTC11 AS LCP11.
- RE-LABEL CTC12 AS LCP12.
- RE-LABEL CTC16 AS LCP16.
- RE-LABEL CTC17 AS LCP17.
- RE-LABEL CTC25 AS LCP25.

AS BUILT INFORMATION		BENCH MARKS		SURVEY INFORMATION		ENGINEER'S STAMP & SIGNATURE		REVISIONS		DESIGN	
Contractor	By	Inspector's	Date	Field	By	Signature	No.	Remarks	Date	Designed By:	Date: -
Checked By	Date	Field	Date	Notes	By	Professional Engineer				Drawn By:	Date: -
MICRO-FILM INFORMATION											
Recorded By	No.										



I, William P. Foster, to the best of my knowledge, certify that this electronic version is identical to the original reproducible RECORD drawing signed by me on 07/22/2011.

**ASCG**  
INCORPORATED

ENGINEERS - ARCHITECTS - SURVEYORS - PLANNERS

6501 AMERICAS PARKWAY NE, SUITE 400  
ALBUQUERQUE, NEW MEXICO 87110-5372  
PHONE 505.247.0234 • FAX 505.242.4845


#### RECORD DRAWING

This drawing, to the best of my knowledge, has been updated to include information received from the General Contractor to reflect as-built conditions. Actual installation may vary from this drawing due to changes made by the Contractor and not passed on for inclusion on the drawing.


CITY OF ALBUQUERQUE PUBLIC WORKS DEPARTMENT ENGINEERING DEVELOPMENT GROUP			
TITLE: ALBUQUERQUE INTERNATIONAL SUNPORT LIGHTING MODERNIZATION PROJECT ENLARGED ELECTRICAL AND COMM. ROOMS			
Design Review Committee	City Engineer Approval	Mo./Day/Yr.	Mo./Day/Yr.
Last Design Update			
City Project No. 7259.25	Zone Map No. M-16	Drawing No. E-403	Sheet 22 Of 33

26-7259.11-08




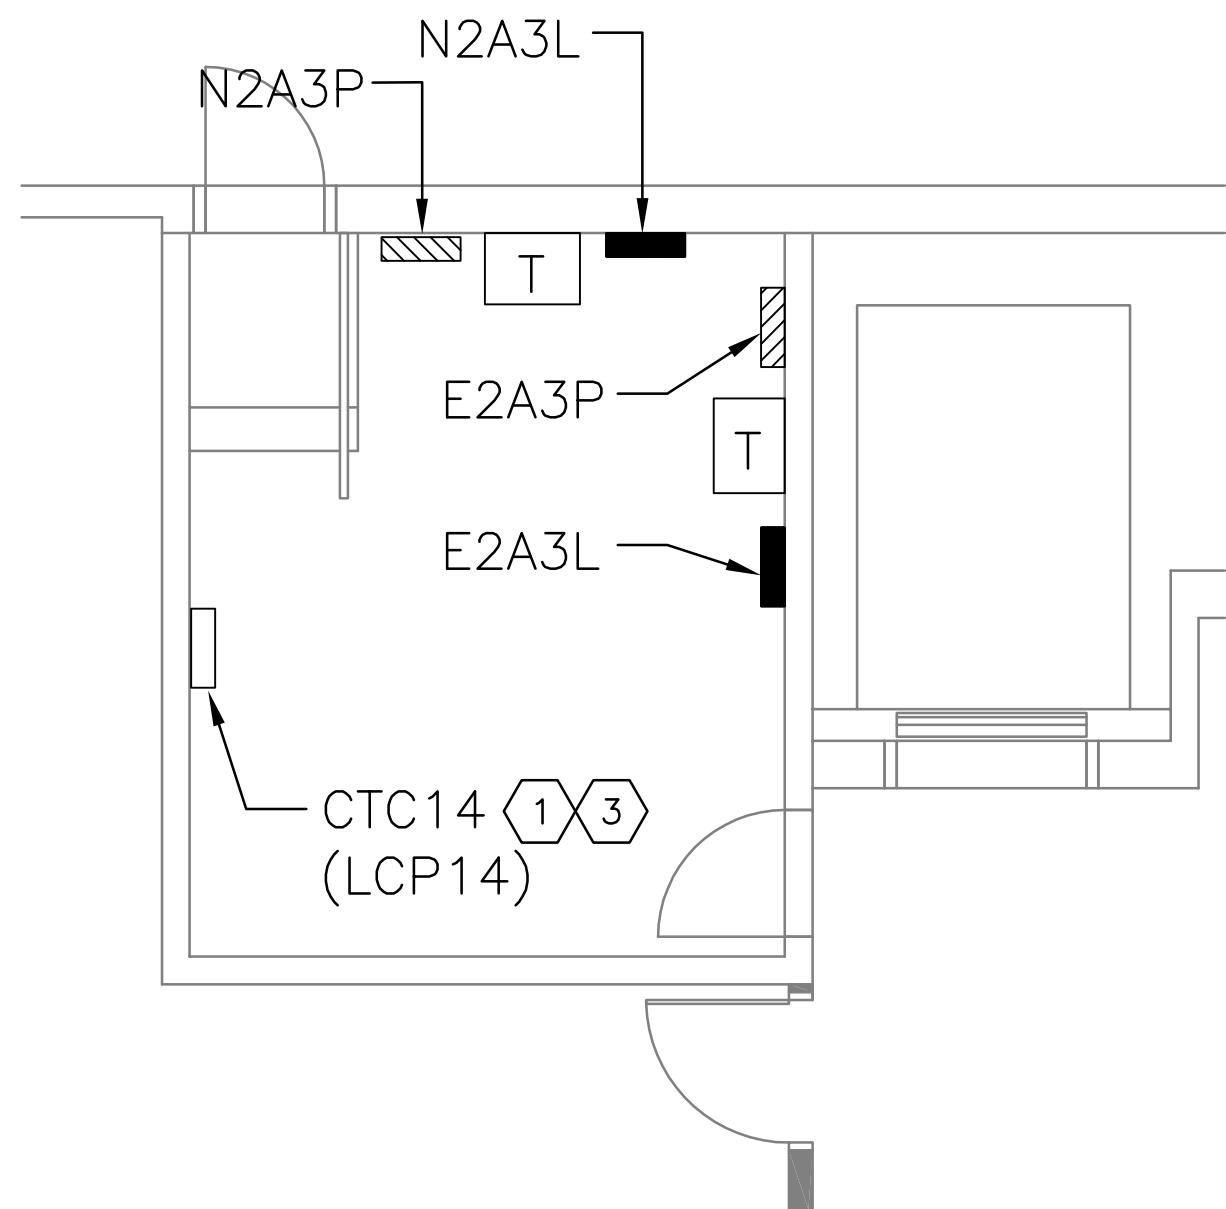

1 ENLARGED FLOOR PLAN – ELECTRICAL ROOM 25-01  
1/4" = 1'-0"

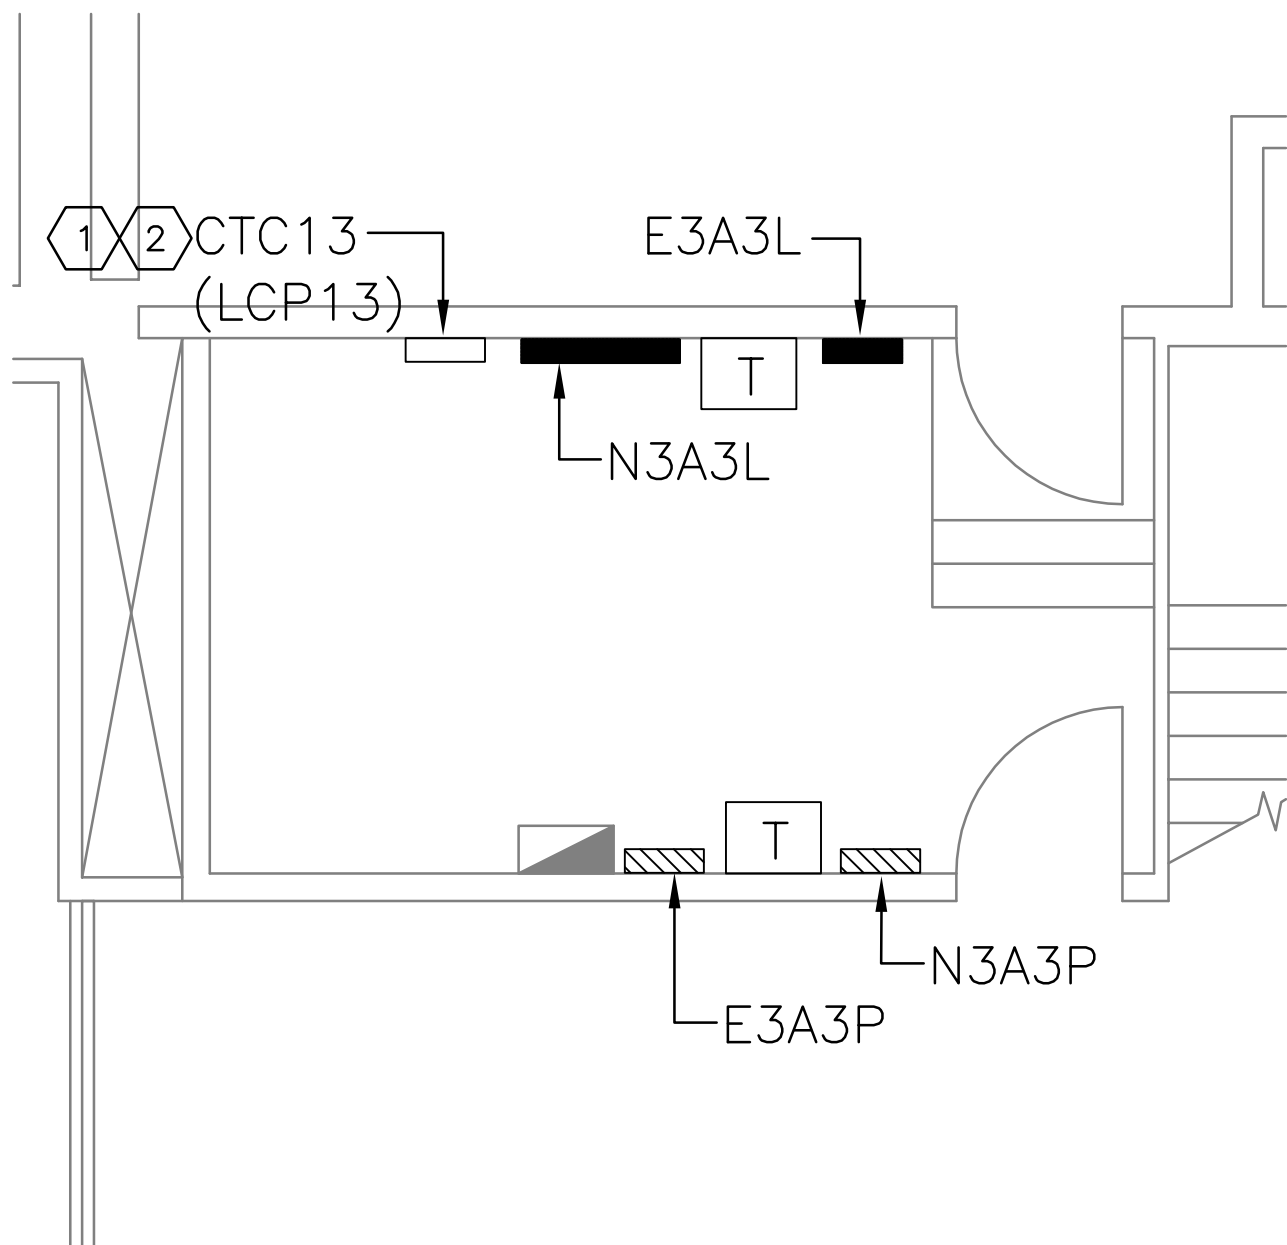

2 ENLARGED FLOOR PLAN – ELECTRICAL ROOM 24-01  
1/4" = 1'-0"

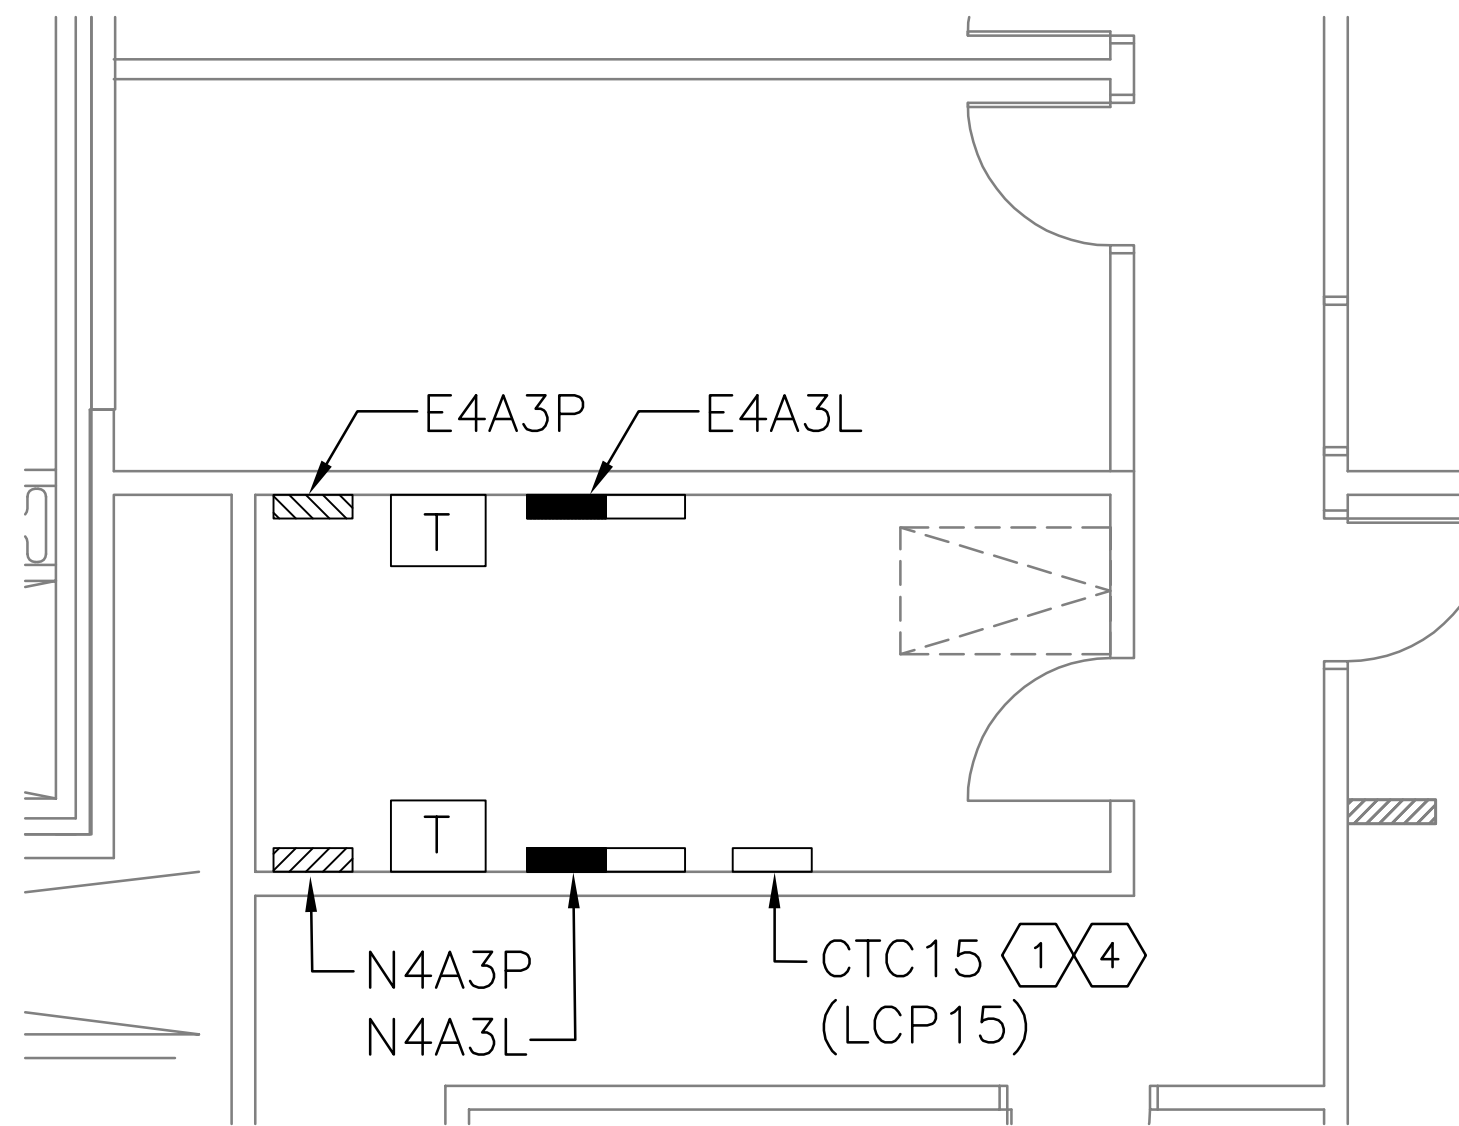

3 ENLARGED FLOOR PLAN – ELECTRICAL ROOM 27-27  
1/4" = 1'-0"




GENERAL NOTES:

- WHERE NECESSARY, THE CONTRACTOR SHALL REROUTE AND/OR RECONNECT CIRCUIT RUNS TO MAINTAIN THE CONTINUITY OF THE EXISTING CIRCUIT.
- ALL ELECTRICAL PENETRATIONS THROUGH FIRE RATED ASSEMBLES SHALL BE SEALED TO MAINTAIN THE RATING OF THE ASSEMBLY.
- REFER TO DRAWING ED01 FOR EXISTING CTC CABINETS WIRING INFORMATION.
- REFER TO DRAWING E-601 THRU E-603 FOR NEW LCP CIRCUITING INFORMATION.

KEYED NOTES:

- EXISTING CTC CABINET TO BE REPLACED. TEMPORARILY REMOVE LIGHTING CIRCUITS FROM THIS CTC CABINET AND SPLICE TO MAINTAIN CIRCUIT CONTINUITY. REMOVE EXISTING CTC CABINET AND ASSOCIATED HARDWARE IN IT'S ENTIRETY. INSTALL NEW LCP IN SAME LOCATION AND REFEED LIGHTING CIRCUIT THRU NEW RELAYS.
- RE-LABEL CTC13 AS LCP13.
- RE-LABEL CTC14 AS LCP14.
- RE-LABEL CTC15 AS LCP15.

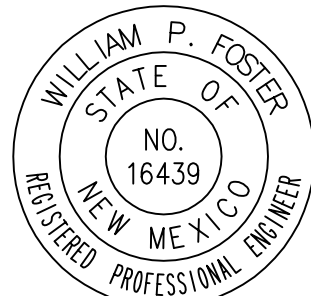

I, William P. Foster, to the best of my knowledge, certify that this electronic version is identical to the original reproducible RECORD drawing signed by me on 07/22/2011.

**ASCG**  
INCORPORATED

ENGINEERS - ARCHITECTS - SURVEYORS - PLANNERS

6501 AMERICAS PARKWAY NE, SUITE 400  
ALBUQUERQUE, NEW MEXICO 87110-5372  
PHONE 505.247.0234 • FAX 505.242.4845


**RECORD DRAWING**  
This drawing, to the best of my knowledge, has been updated to include information received from the General Contractor to reflect as-built conditions. Actual installation may vary from this drawing due to changes made by the Contractor and not passed on for inclusion on the drawing.


CITY OF ALBUQUERQUE  
PUBLIC WORKS DEPARTMENT  
ENGINEERING DEVELOPMENT GROUP

TITLE: ALBUQUERQUE INTERNATIONAL SUNPORT  
LIGHTING MODERNIZATION PROJECT  
ENLARGED ELECTRICAL AND COMM. ROOMS


Design Review Committee	City Engineer Approval	Mo./Day/Yr.	Mo./Day/Yr.

City Project No.	Zone Map No.	Drawing No.	Sheet	Of
7259.25	M-16	E-404	23	33

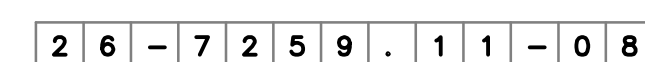


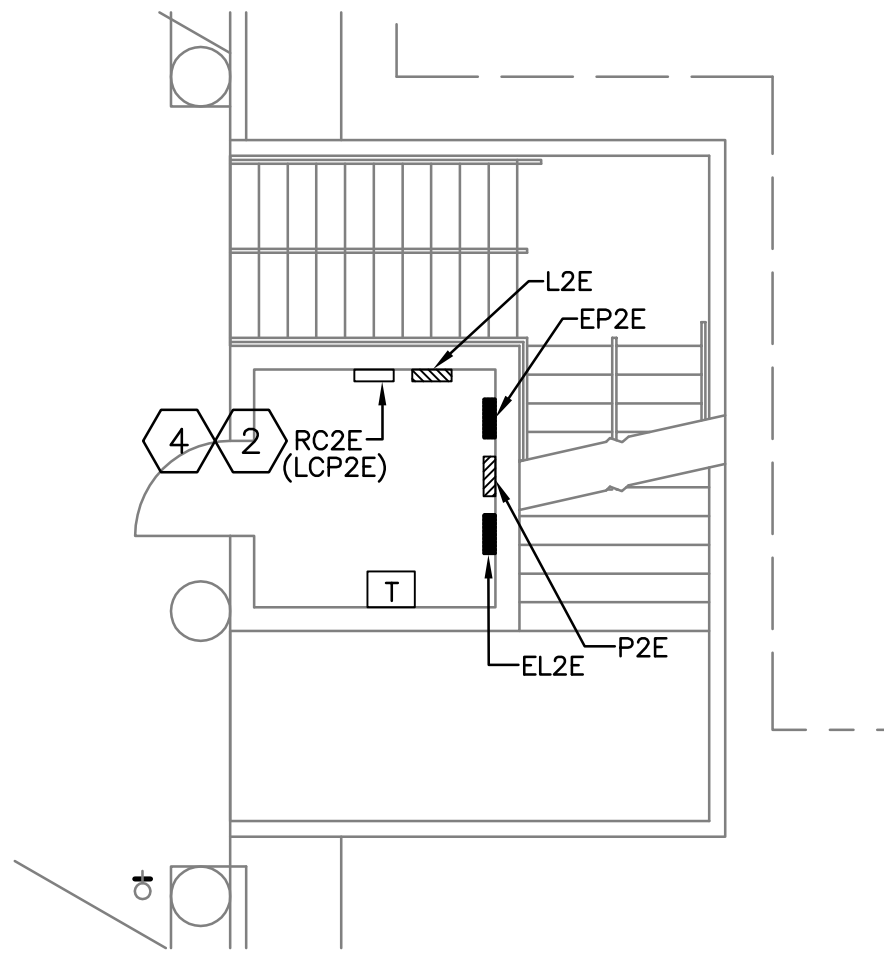


1 PARKING STRUCTURE ENLARGED PLAN – ELECTRICAL ROOM 201  
1/8" = 1'-0"

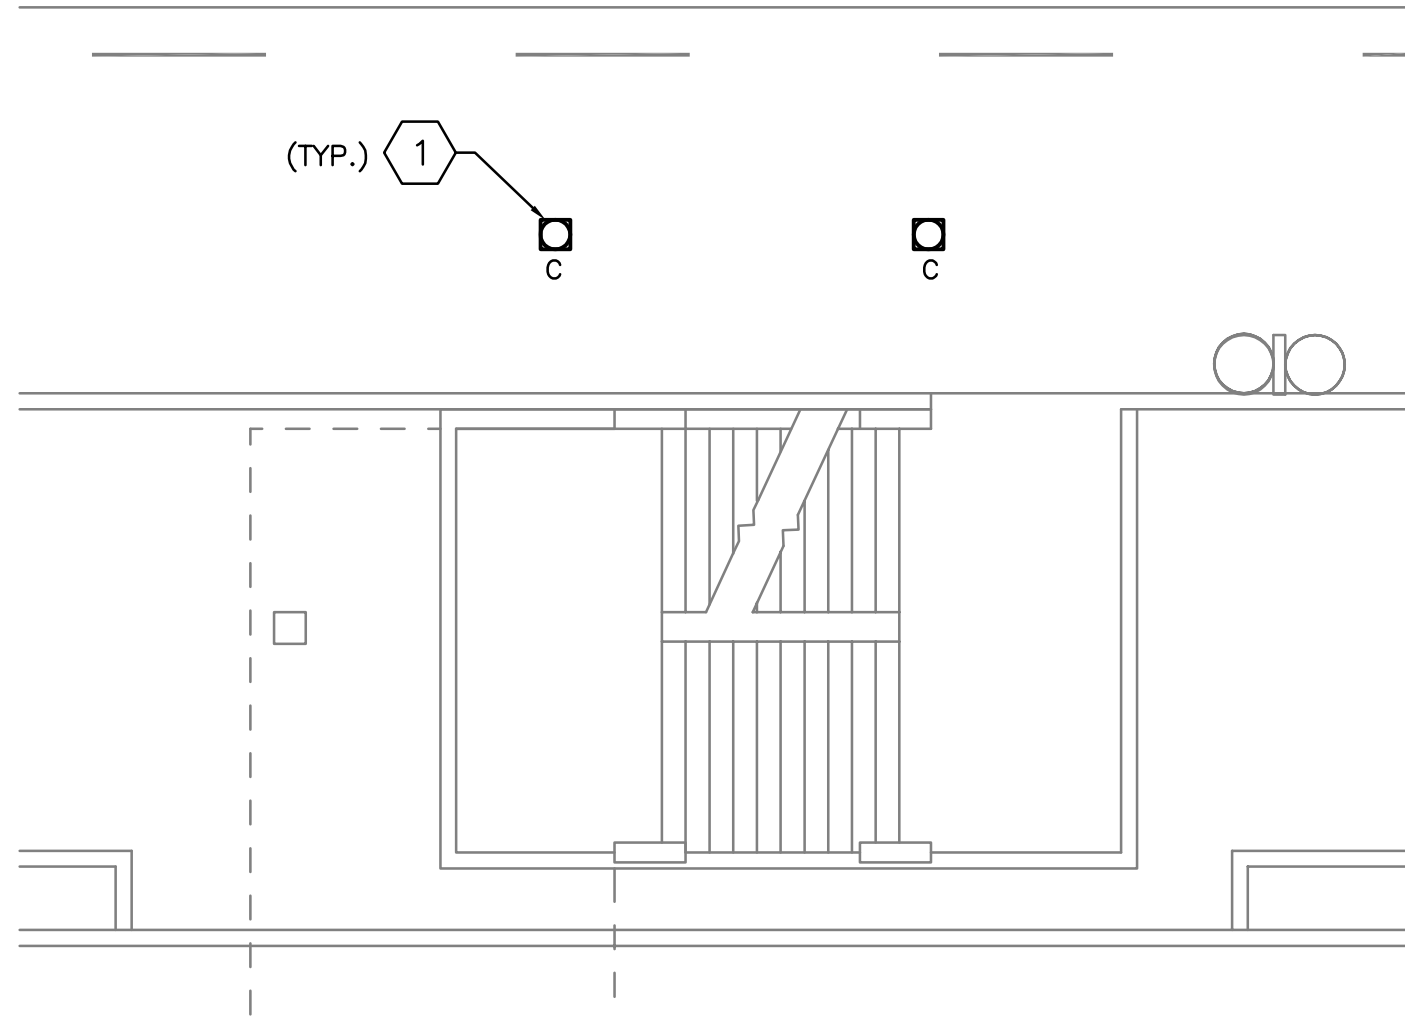


2 PARKING STRUCTURE ENLARGED PLAN – STAIR NO. 1  
1/8" = 1'-0"

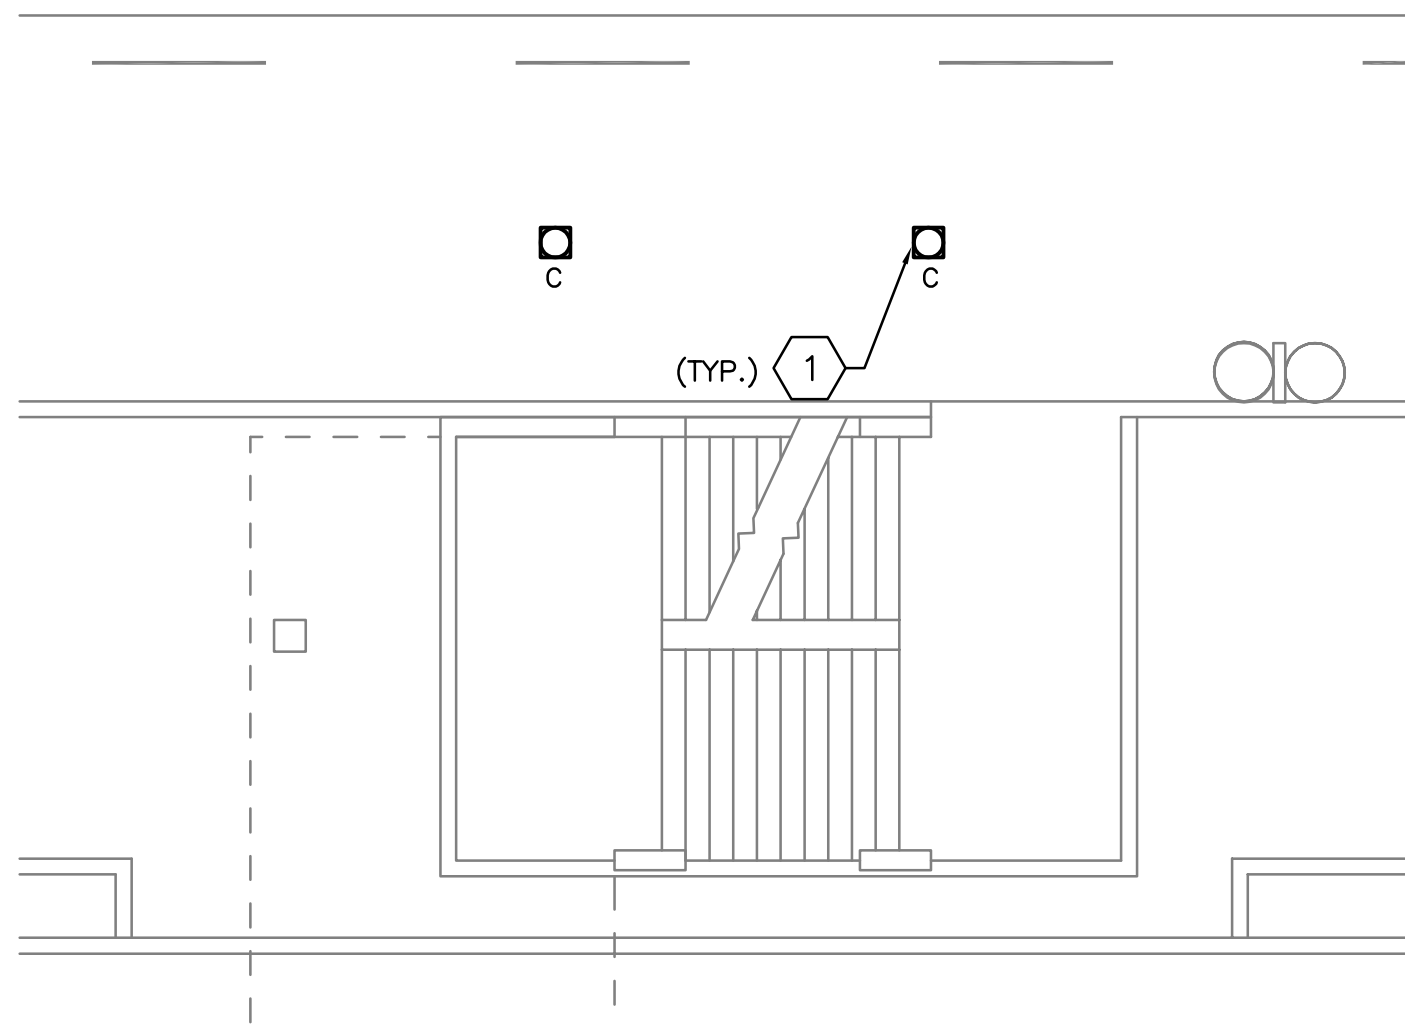

4 PARKING STRUCTURE ENLARGED PLAN – STAIR NO. 2  
1/8" = 1'-0"

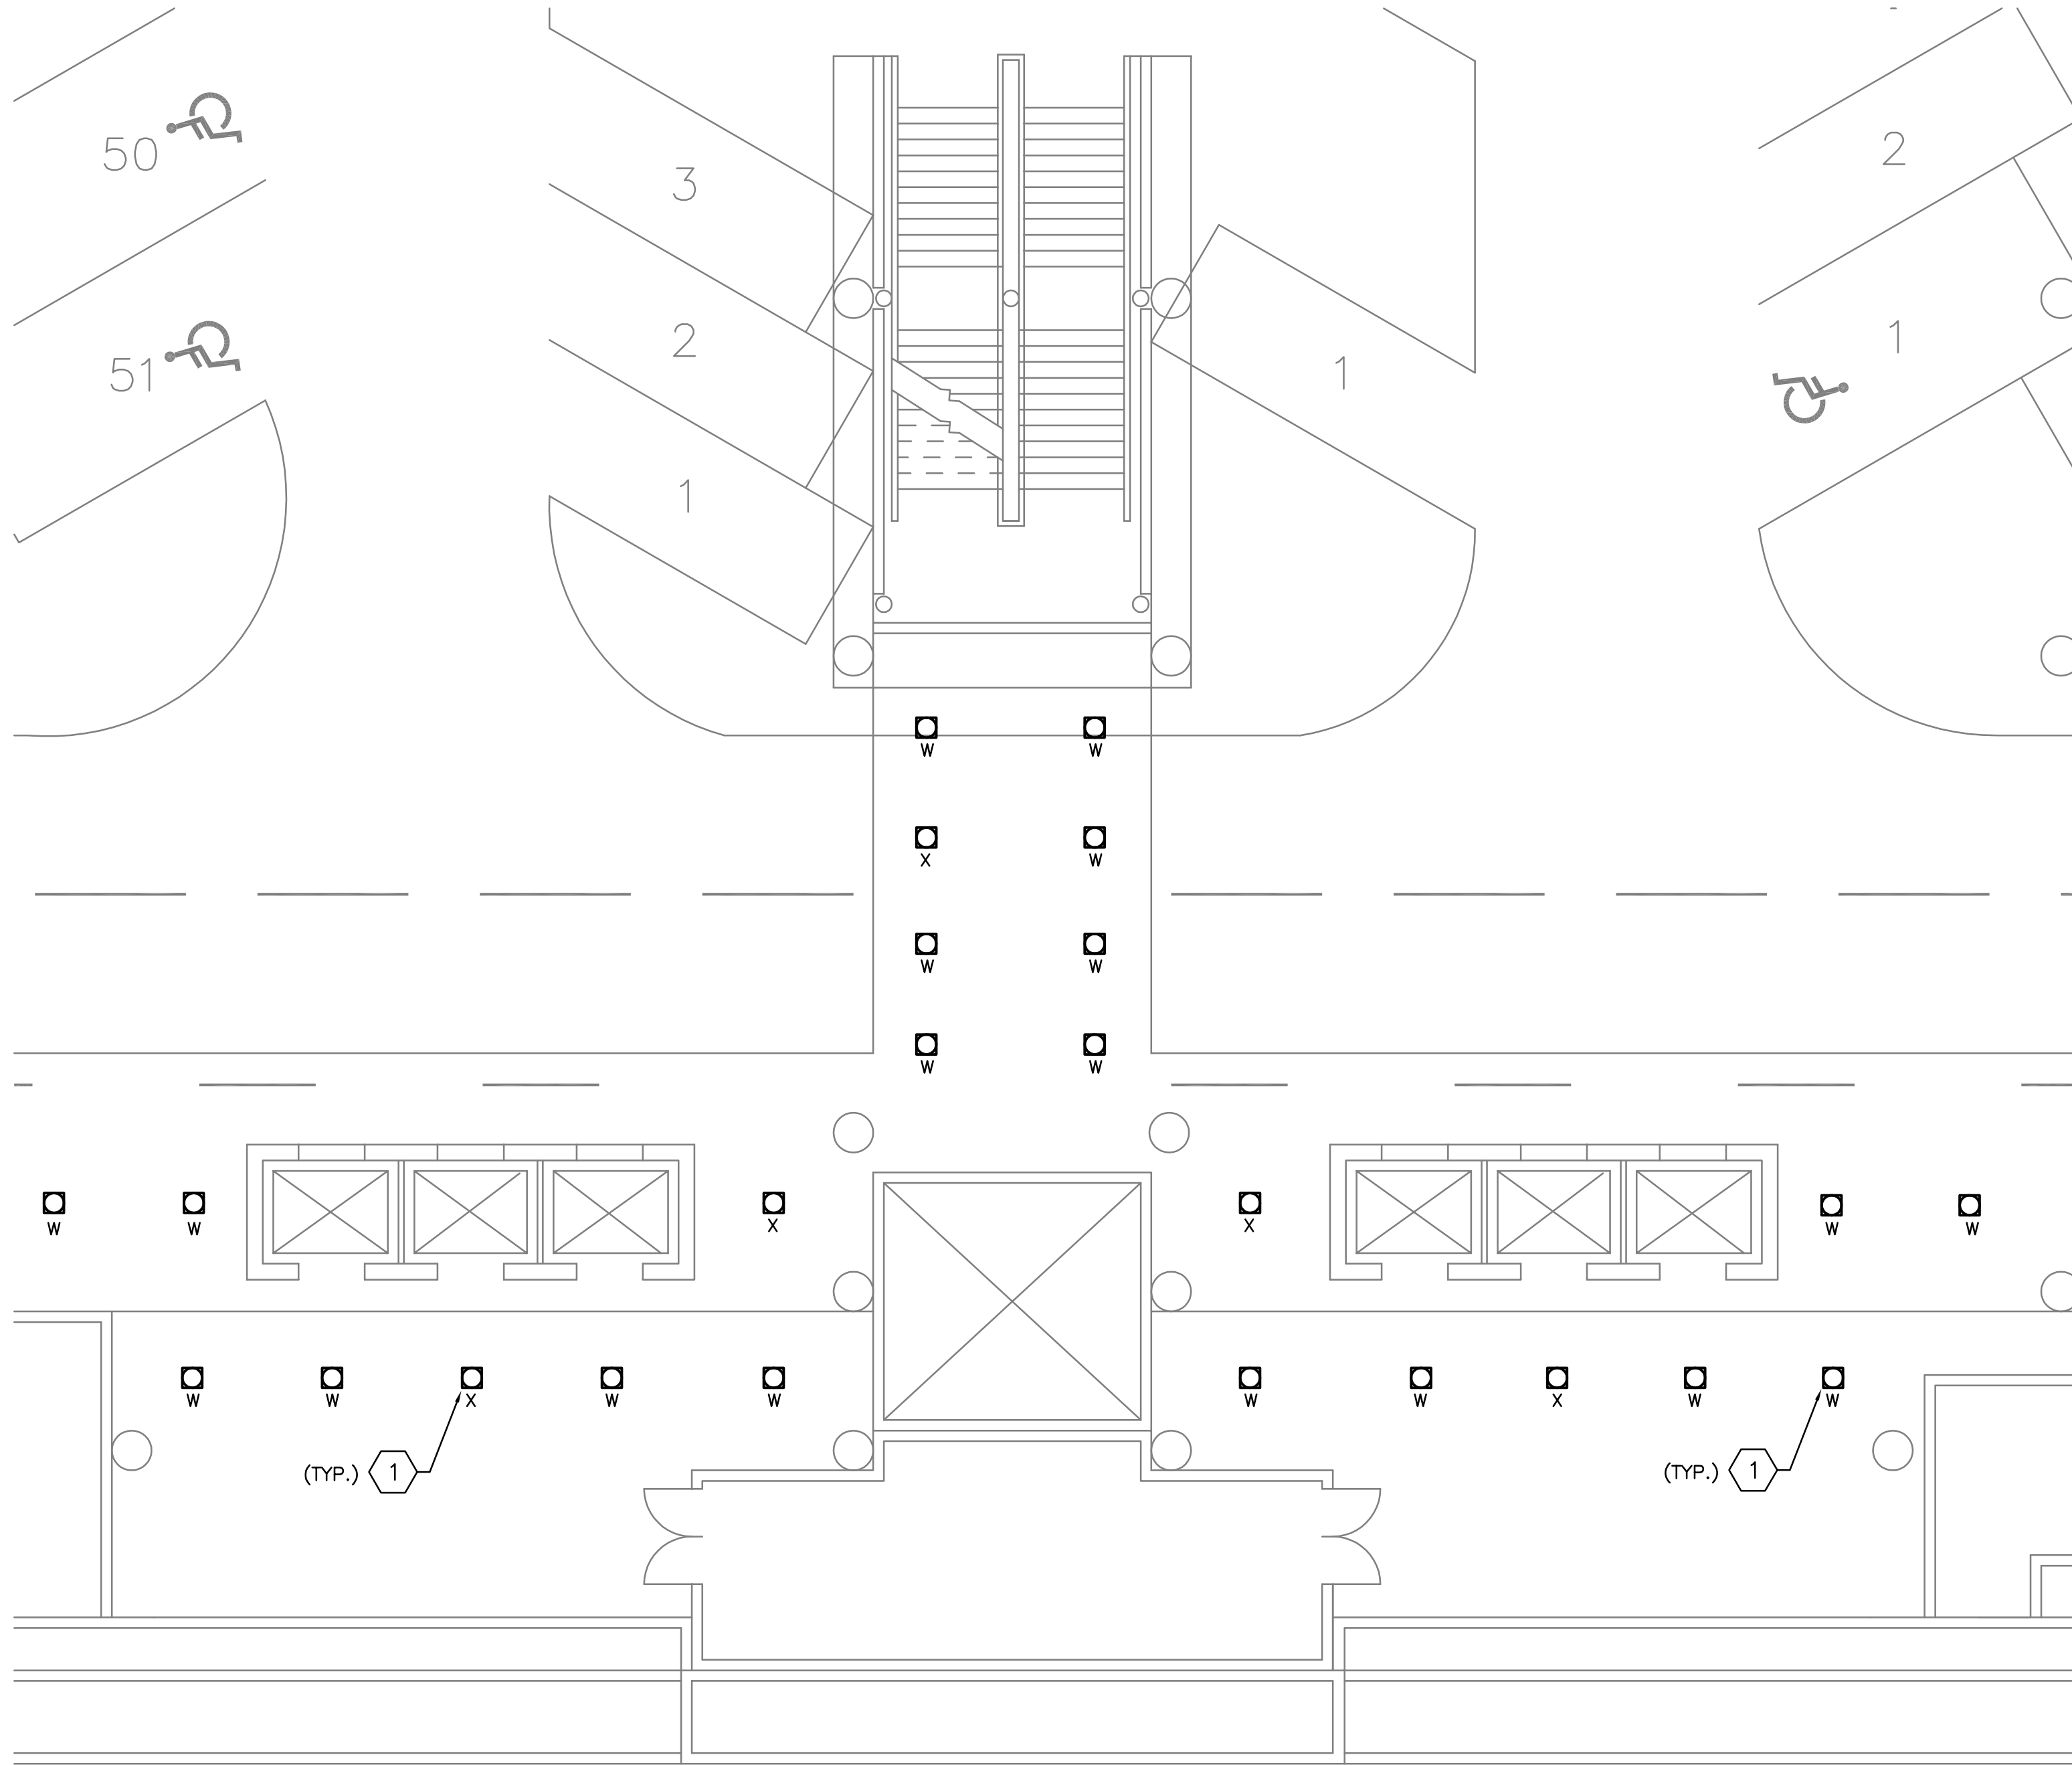

3 PARKING STRUCTURE ENLARGED PLAN – LVL 2 ELEVATOR LOBBY  
1/8" = 1'-0"

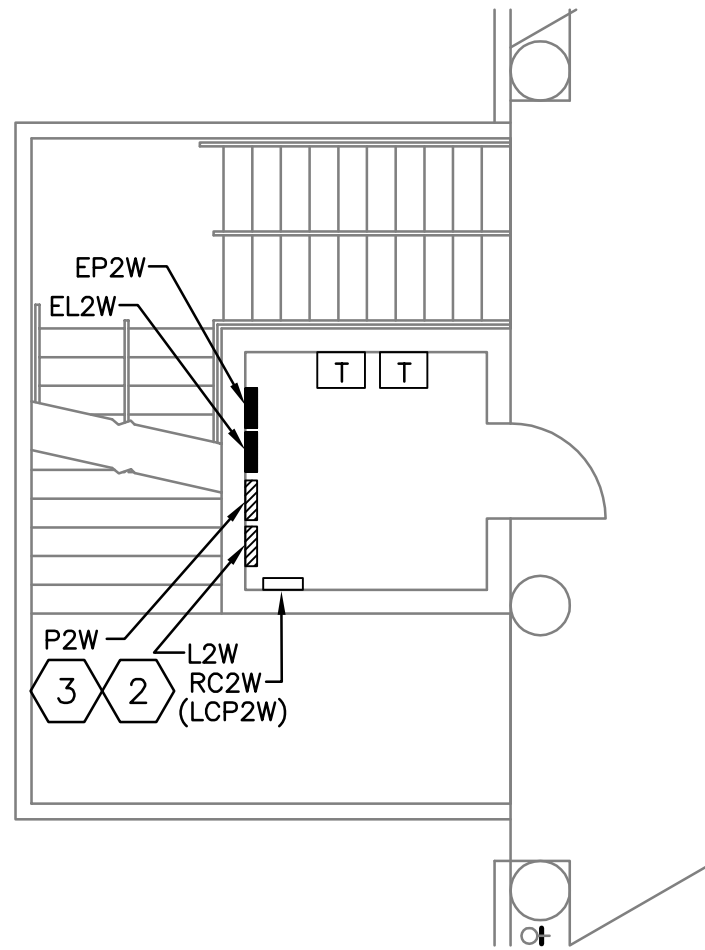

5 PARKING STRUCTURE ENLARGED PLAN – ELECTRICAL ROOM 208  
1/8" = 1'-0"



GENERAL NOTES:

- A. WHERE NECESSARY, THE CONTRACTOR SHALL REROUTE AND/OR RECONNECT CIRCUIT RUNS TO MAINTAIN THE CONTINUITY OF THE EXISTING CIRCUIT.
- B. ALL ELECTRICAL PENETRATIONS THROUGH FIRE RATED ASSEMBLIES SHALL BE SEALED TO MAINTAIN THE RATING OF THE ASSEMBLY.
- C. REFER TO DRAWING ED01 FOR EXISTING RC CABINETS WIRING INFORMATION.
- D. REFER TO DRAWING E-601 THRU E-603 FOR NEW LCP CIRCUITING INFORMATION.

KEYED NOTES:

1. EXISTING LIGHTING FIXTURE TO BE REPLACED. DISCONNECT EXISTING AND RETURN TO AVIATION. PROVIDE NEW FIXTURE AS INDICATED AND CONNECT TO EXISTING LIGHTING CIRCUIT.
2. EXISTING CTC CABINET TO BE REPLACED. TEMPORARILY REMOVE LIGHTING CIRCUITS FROM THIS RC CABINET AND SPLICE TO MAINTAIN CIRCUIT CONTINUITY. REMOVE EXISTING CTC CABINET AND ASSOCIATED HARDWARE IN IT'S ENTIRETY. INSTALL NEW LCP IN SAME LOCATION AND REFEED LIGHTING CIRCUIT THRU NEW RELAYS.
3. RE-LABEL RC2W AS LCP2W.
4. RE-LABEL RC2E AS LCP2E.



I, William P. Foster, to the best of my knowledge, certify that this electronic version is identical to the original reproducible RECORD drawing signed by me on 07/22/2011.

ASCG  
INCORPORATED

ENGINEERS - ARCHITECTS - SURVEYORS - PLANNERS

6501 AMERICAS PARKWAY NE, SUITE 400  
ALBUQUERQUE, NEW MEXICO 87110-5372  
PHONE 505.247.0234 • FAX 505.242.4845

RECORD DRAWING

This drawing, to the best of my knowledge, has been updated to include information received from the General Contractor to reflect as-built conditions. Actual installation may vary from this drawing due to changes made by the Contractor and not passed on for inclusion on the drawing.

CITY OF ALBUQUERQUE  
PUBLIC WORKS DEPARTMENT  
ENGINEERING DEVELOPMENT GROUP


TITLE: ALBUQUERQUE INTERNATIONAL SUNPORT  
LIGHTING MODERNIZATION PROJECT  
PARKING STRUCTURE ENLARGED PLANS – LVL 2

Design Review Committee	City Engineer Approval	Last Design Update	Mo./Day/Yr.	Mo./Day/Yr.


City Project No. 7259.25	Zone Map No. M-16	Drawing No. E-406	Sheet 25	Of 33
-----------------------------	----------------------	----------------------	-------------	----------

2 6 - 7 2 5 9 . 1 1 - 0 8




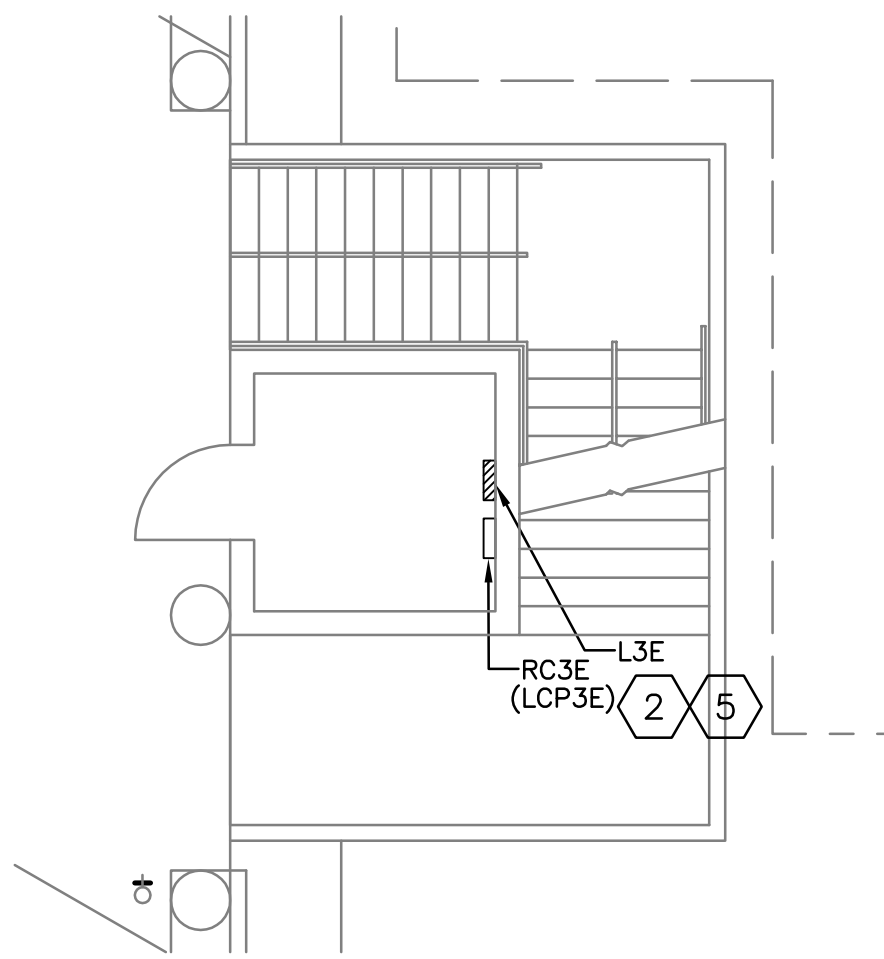


1 PARKING STRUCTURE ENLARGED PLAN – ELECTRICAL ROOM 301  
1/8" = 1'-0"

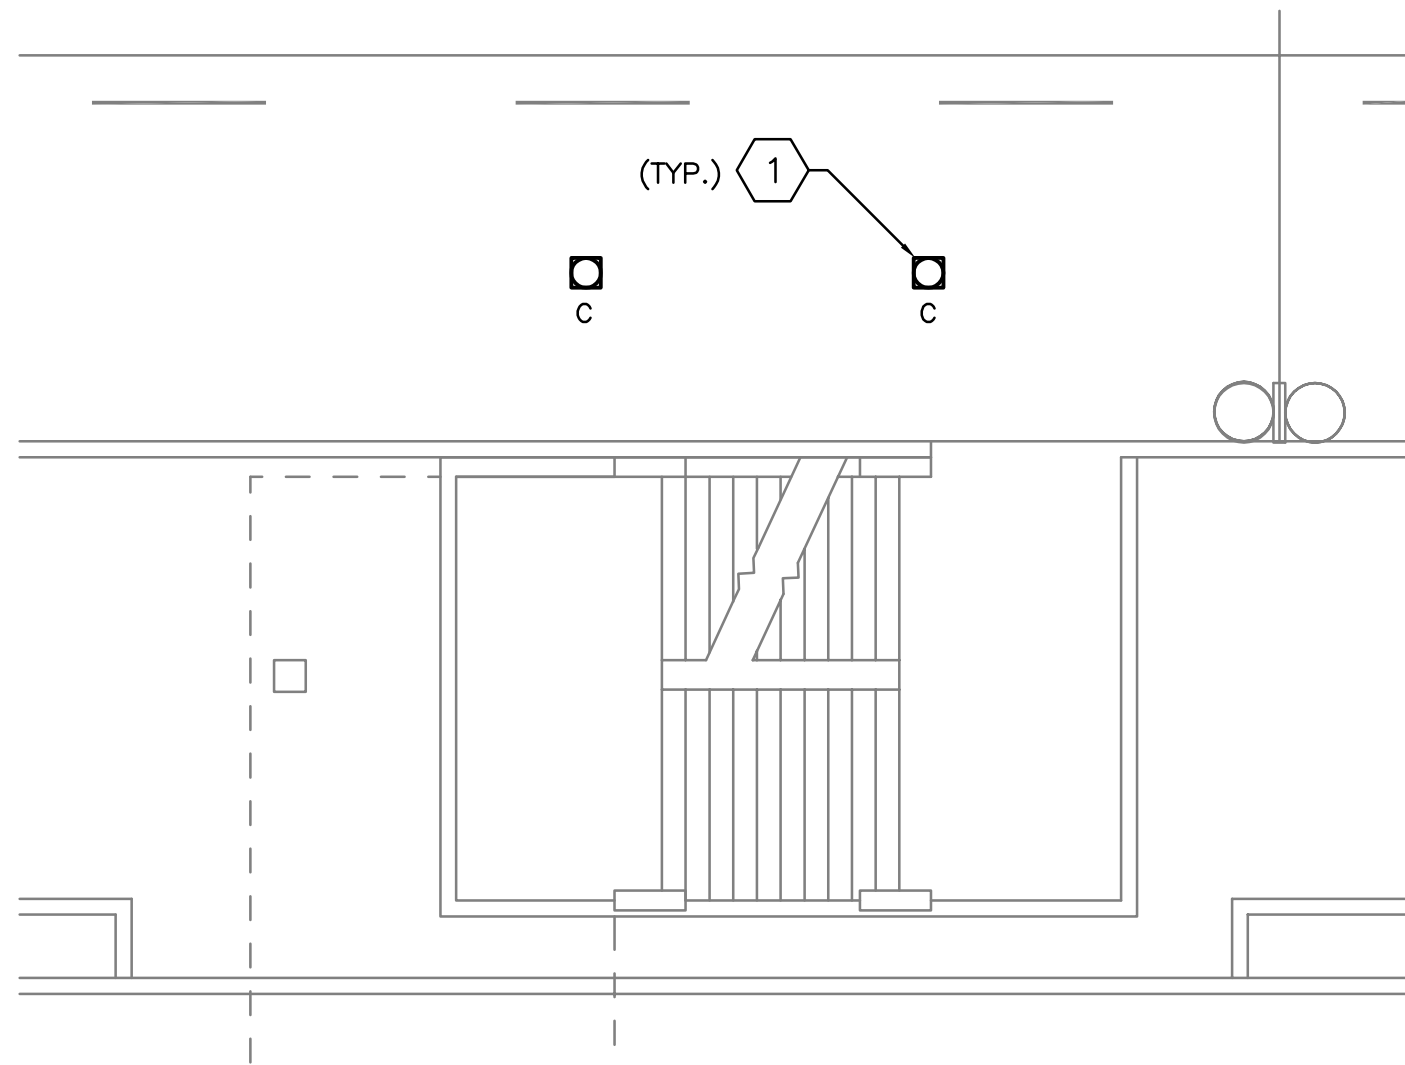


2 PARKING STRUCTURE ENLARGED PLAN – STAIR NO. 1  
1/8" = 1'-0"

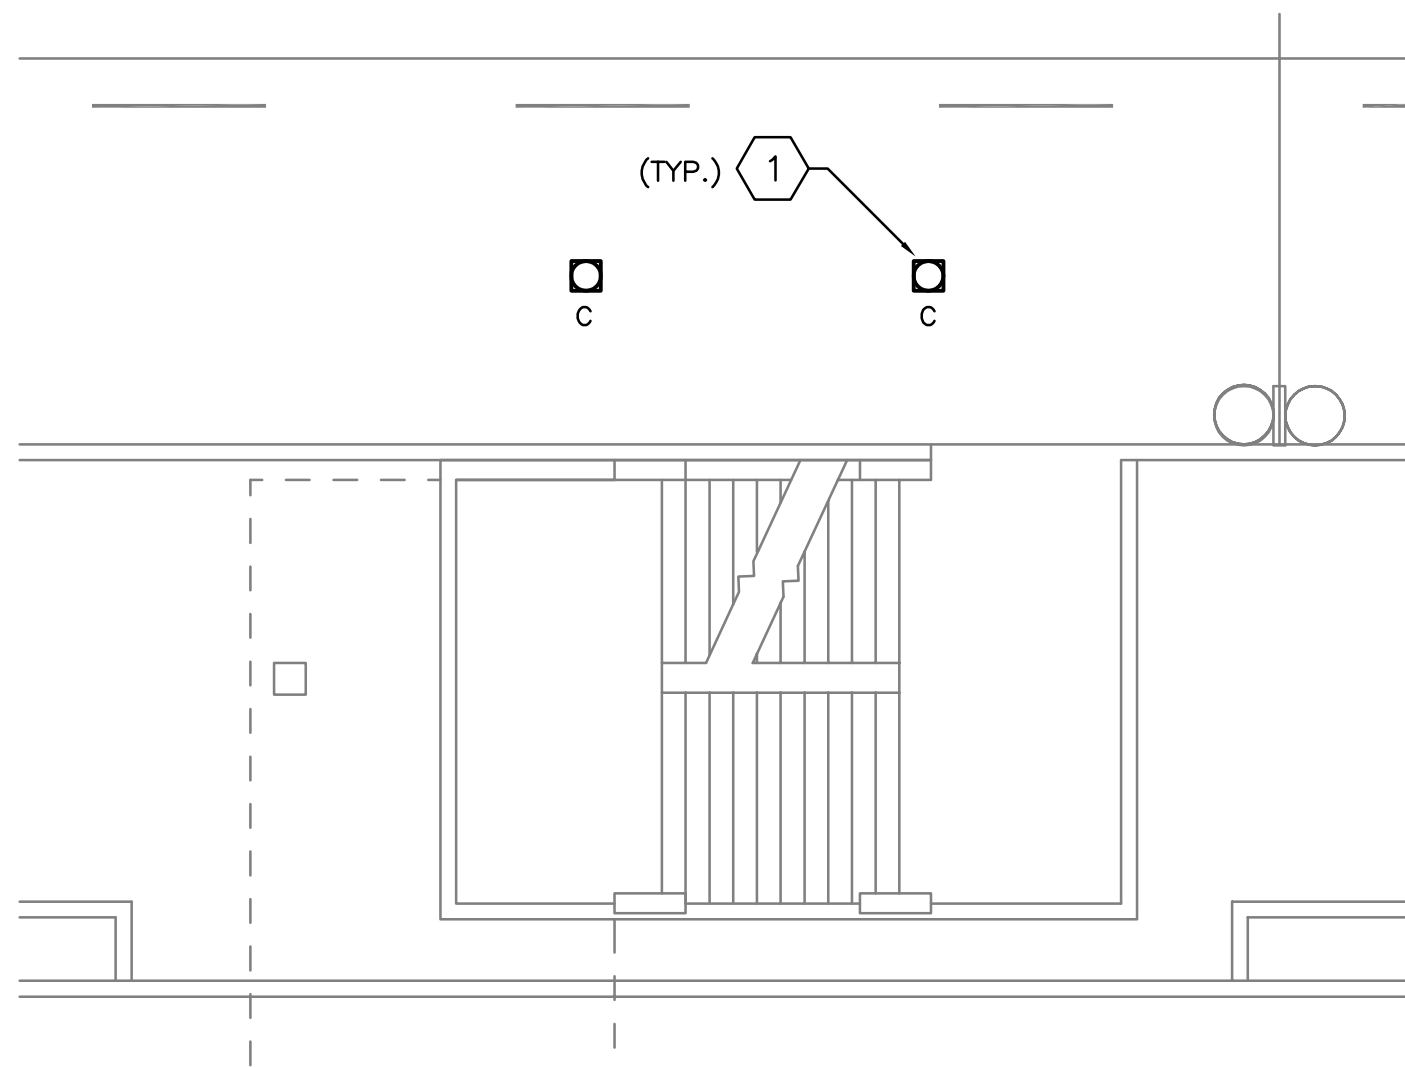

4 PARKING STRUCTURE ENLARGED PLAN – STAIR NO. 2  
1/8" = 1'-0"

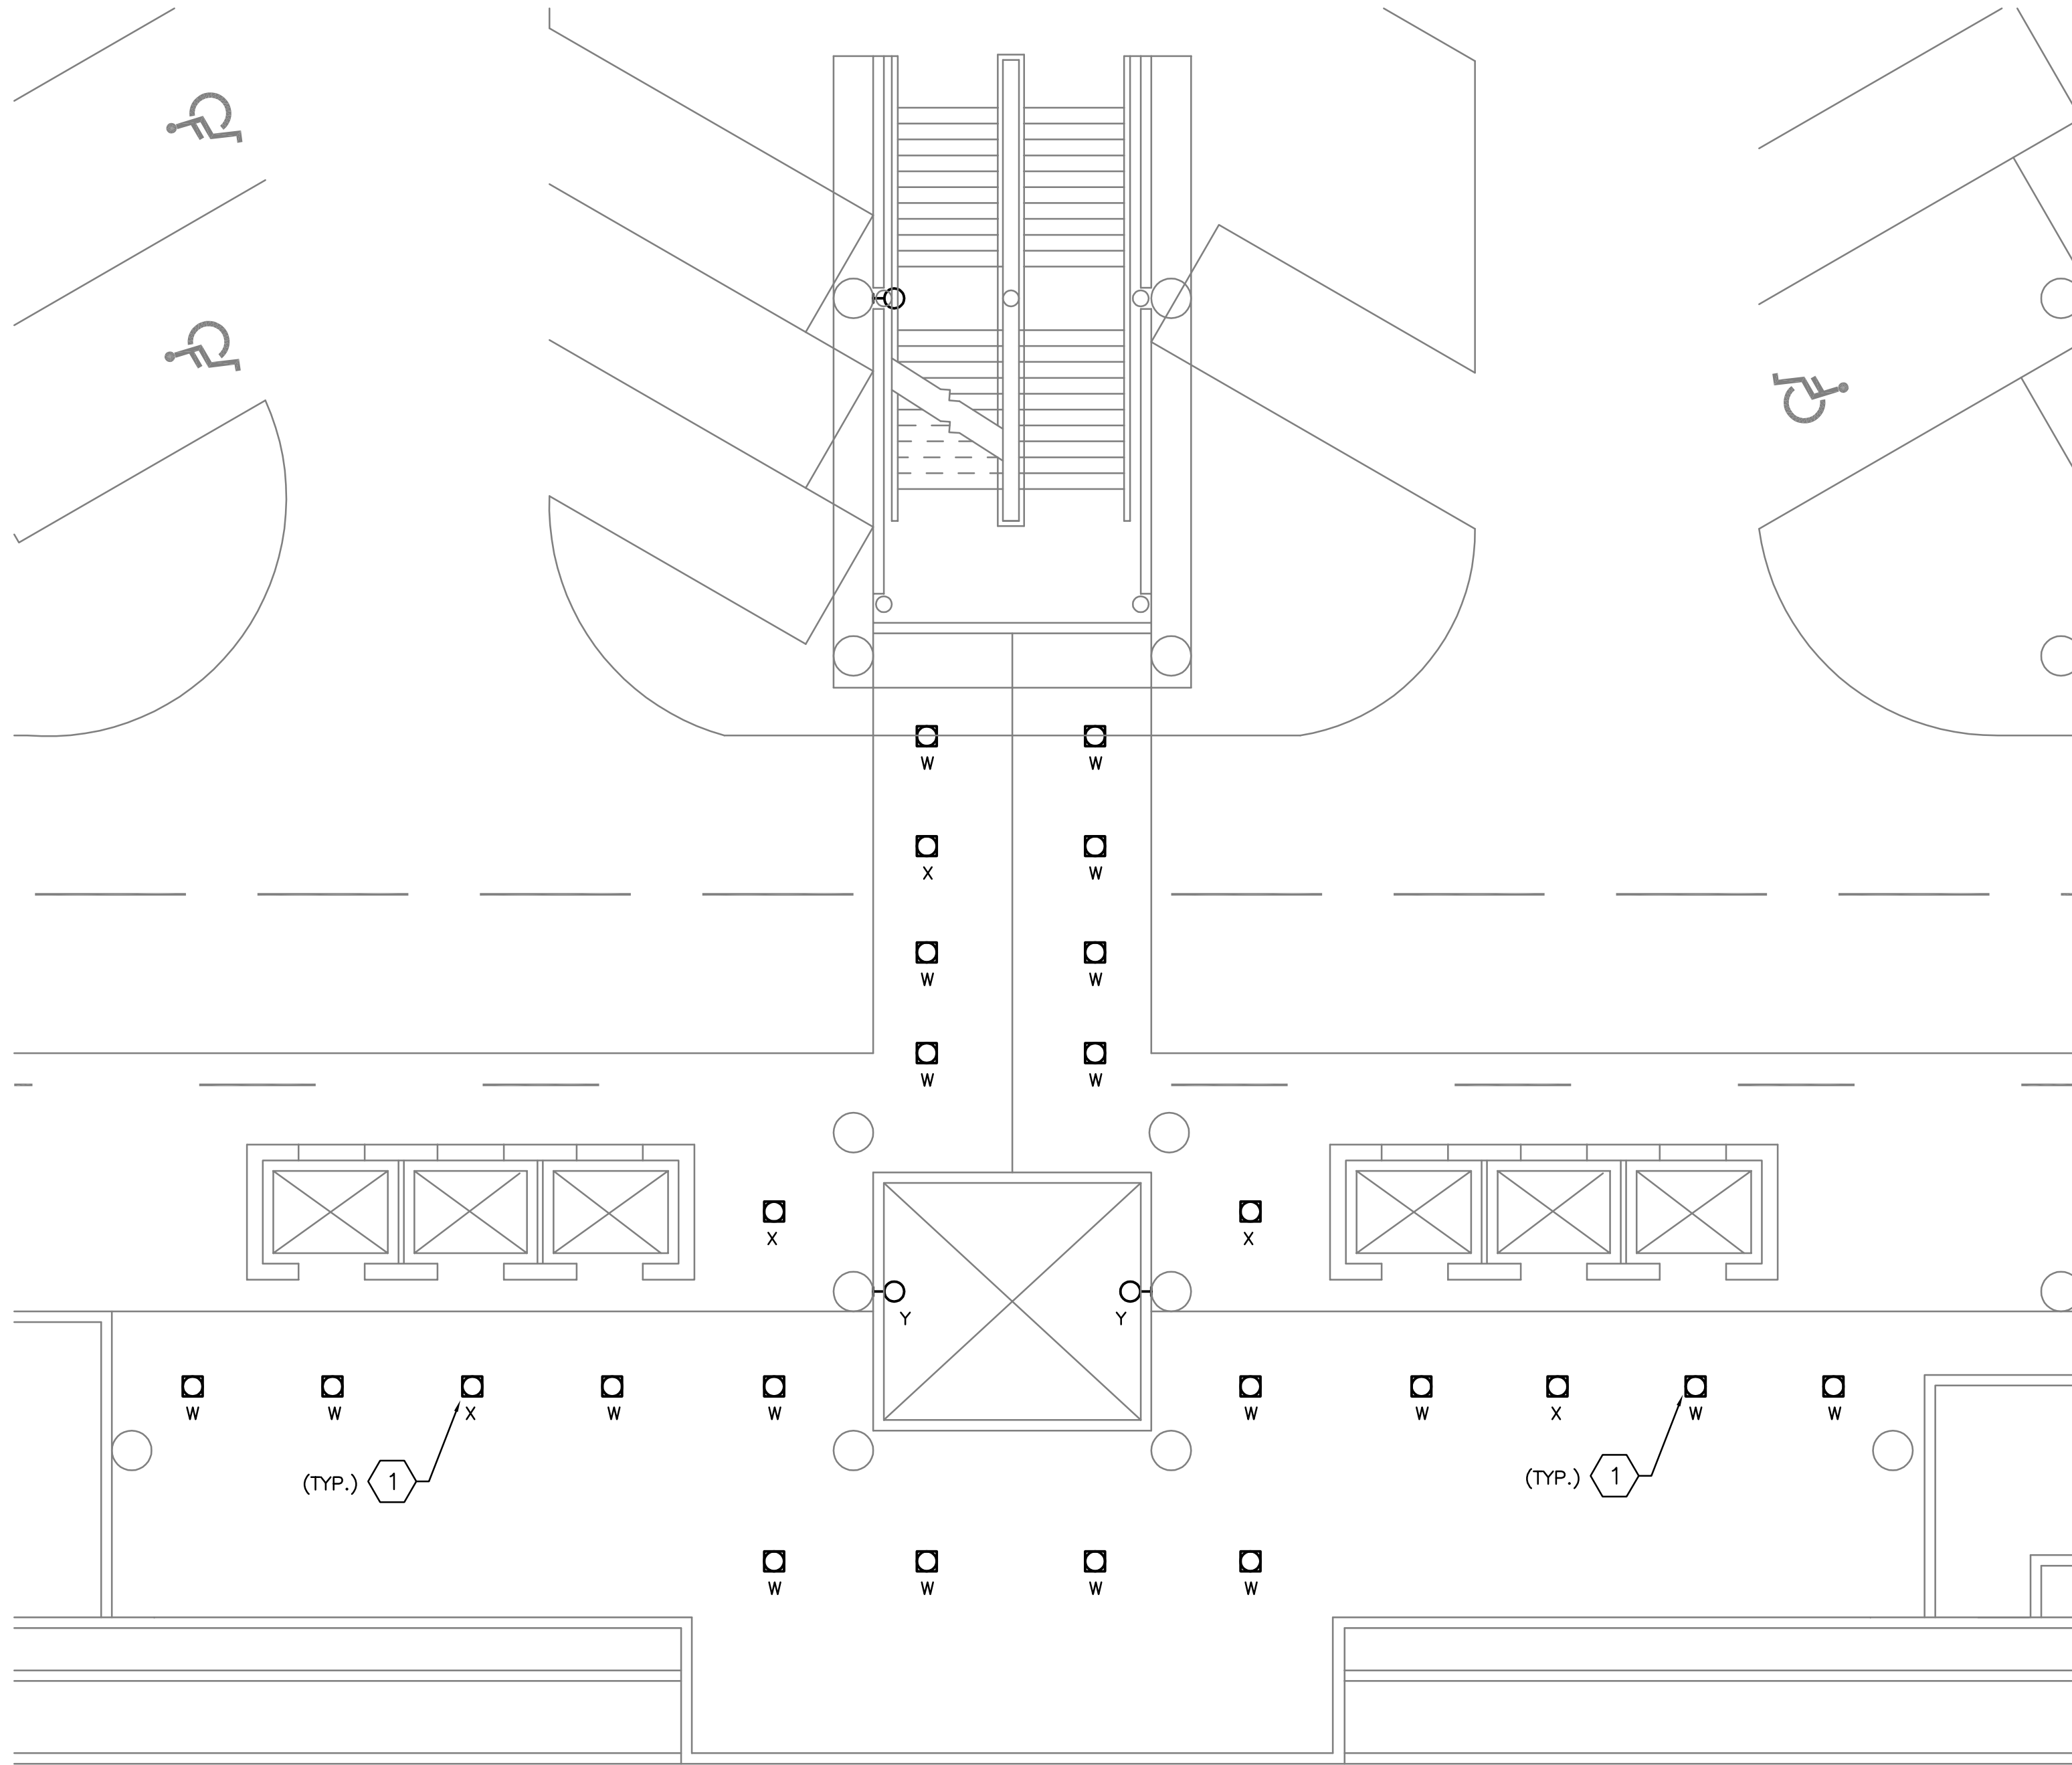

3 PARKING STRUCTURE ENLARGED PLAN – LVL 3 ELEVATOR LOBBY  
1/8" = 1'-0"

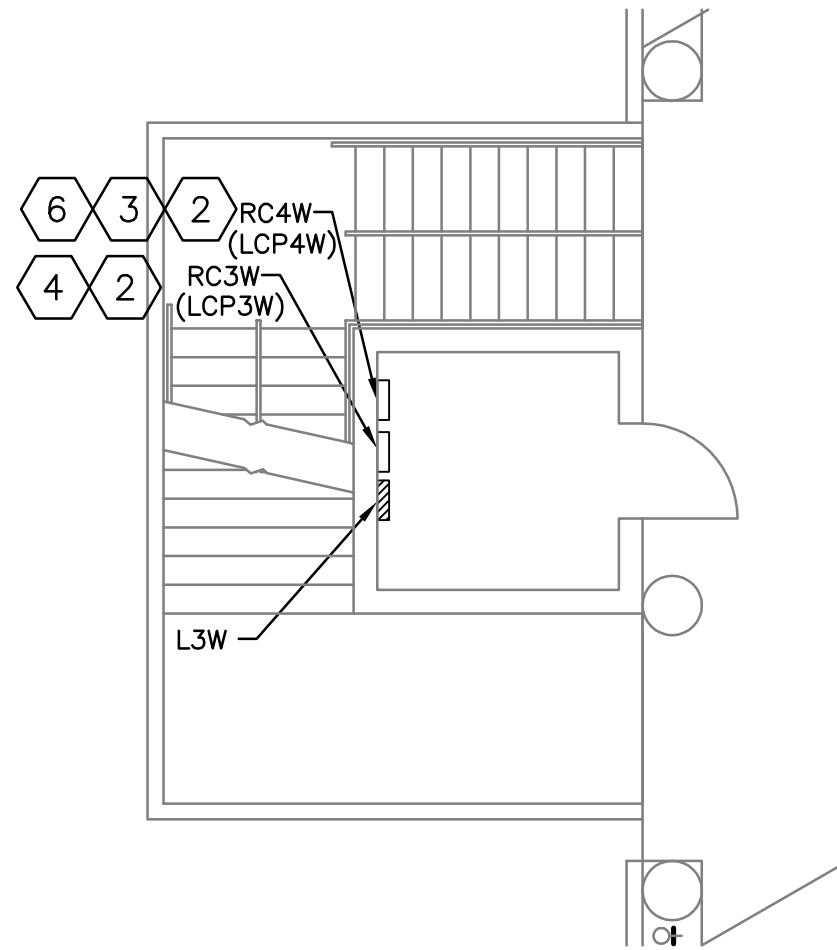

5 PARKING STRUCTURE ENLARGED PLAN – ELECTRICAL ROOM 308  
1/8" = 1'-0"




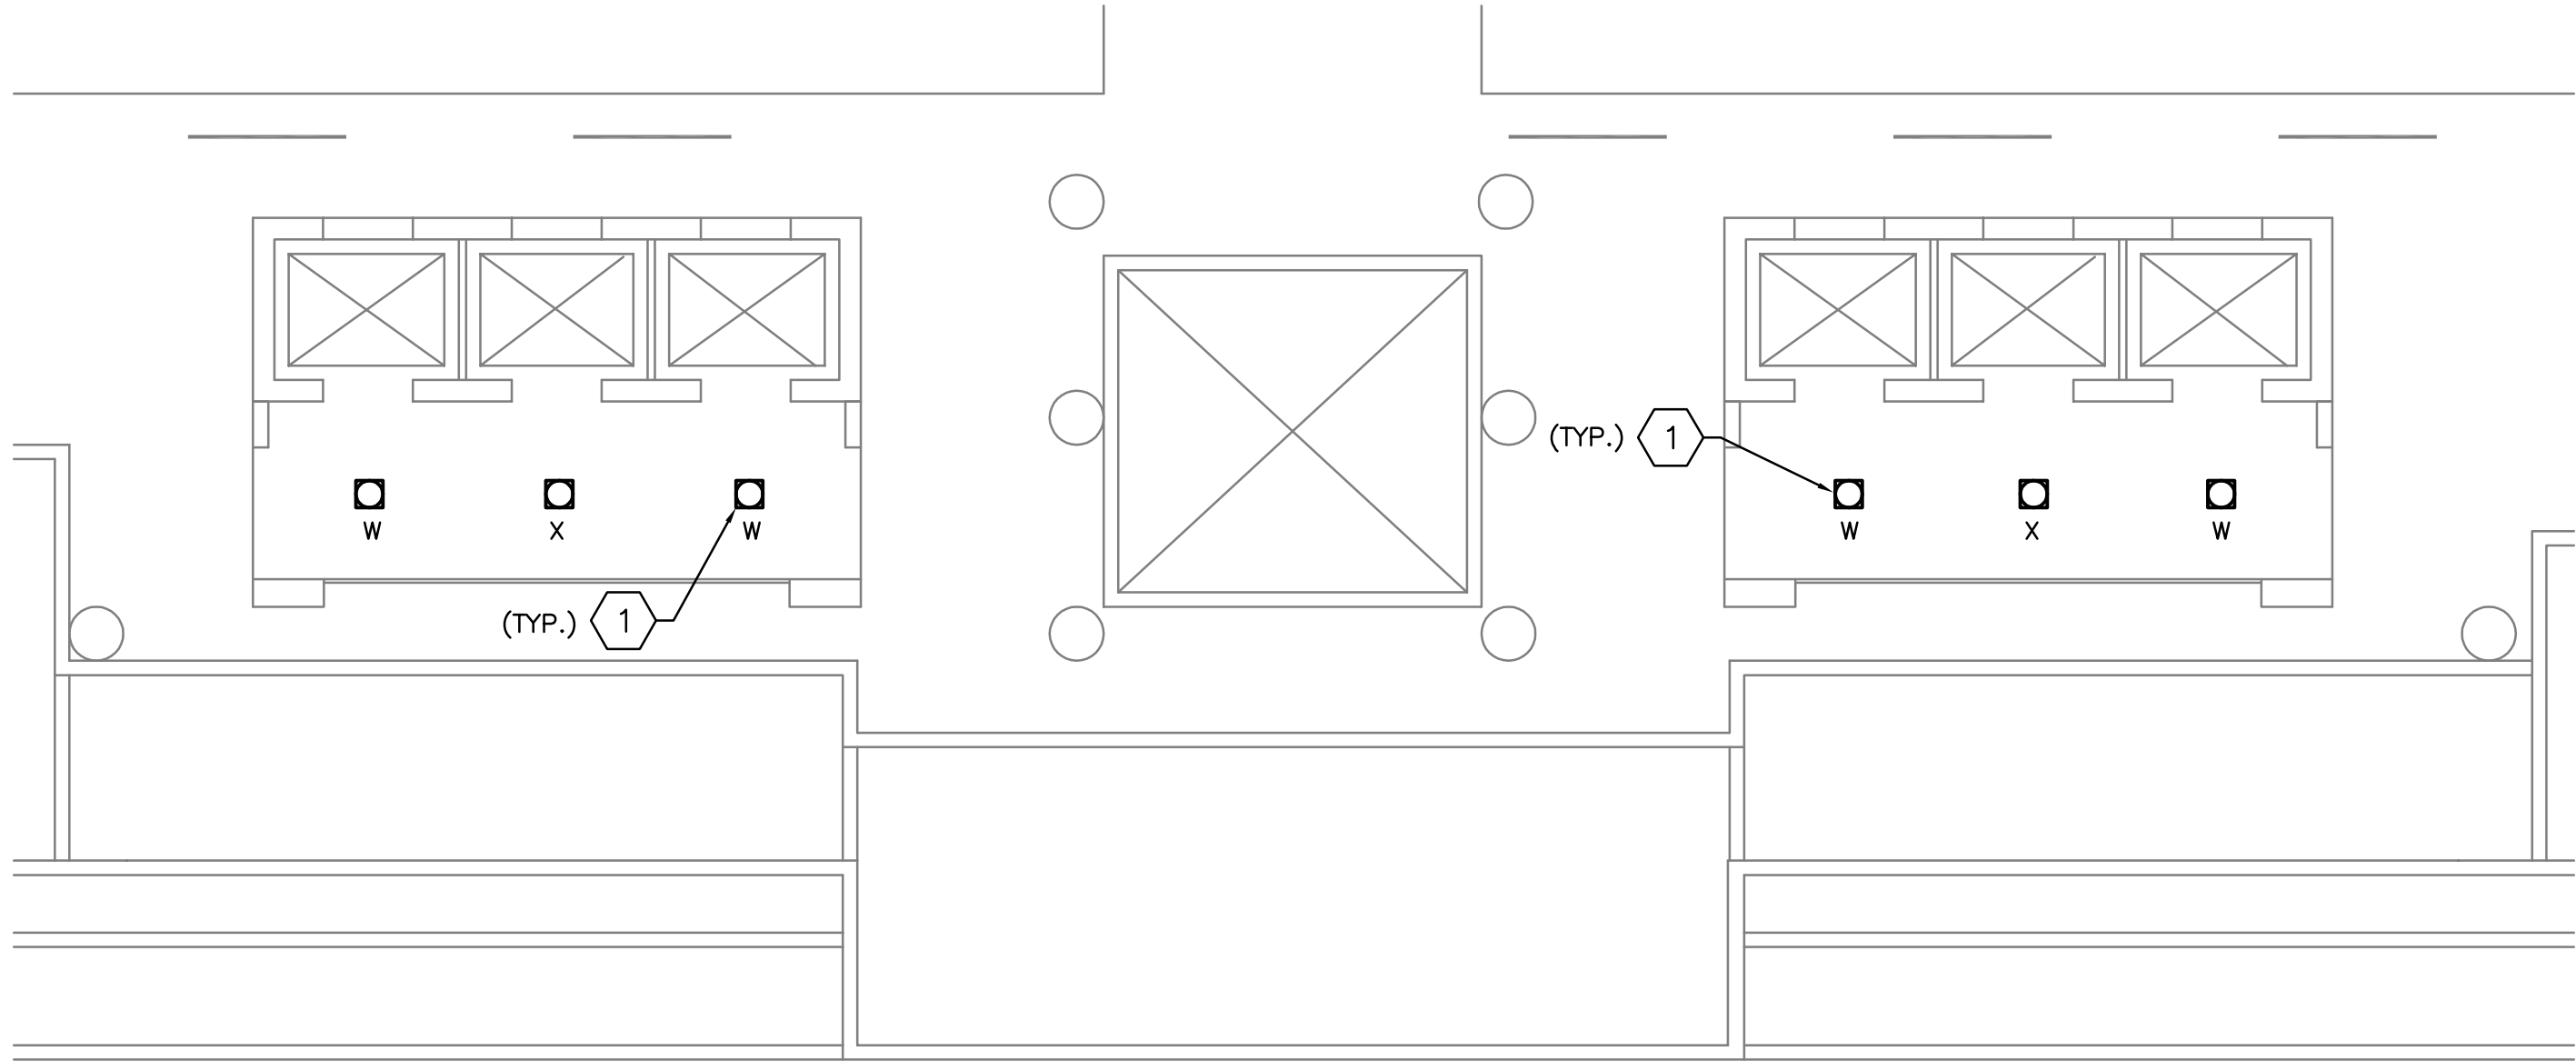
GENERAL NOTES:

- WHERE NECESSARY, THE CONTRACTOR SHALL REROUTE AND/OR RECONNECT CIRCUIT RUNS TO MAINTAIN THE CONTINUITY OF THE EXISTING CIRCUIT.
- ALL ELECTRICAL PENETRATIONS THROUGH FIRE RATED ASSEMBLIES SHALL BE SEALED TO MAINTAIN THE RATING OF THE ASSEMBLY.
- REFER TO DRAWING ED01 FOR EXISTING RC CABINETS WIRING INFORMATION.
- REFER TO DRAWING E-601 THRU E-603 FOR NEW LCP CIRCUITING INFORMATION.

KEYED NOTES:

- EXISTING LIGHTING FIXTURE TO BE REPLACED. DISCONNECT EXISTING AND RETURN TO AVIATION. PROVIDE NEW FIXTURE AS INDICATED AND CONNECT TO EXISTING LIGHTING CIRCUIT.
- EXISTING CTC CABINET TO BE REPLACED. TEMPORARILY REMOVE LIGHTING CIRCUITS FROM THIS RC CABINET AND SPLICE TO MAINTAIN CIRCUIT CONTINUITY. REMOVE EXISTING CTC CABINET AND ASSOCIATED HARDWARE IN IT'S ENTIRETY. INSTALL NEW LCP IN SAME LOCATION AND REFEED LIGHTING CIRCUIT THRU NEW RELAYS.
- PROVIDE NEW LCP FOR ROOF TOP LIGHTING CIRCUITS. RE-FEED EXISTING ROOF TOP LIGHTING CIRCUITS FROM RC1W THRU THIS LCP.
- RE-LABEL RC3W AS LCP3W.
- RE-LABEL RC3E AS LCP3E.
- RE-LABEL RC4W AS LCP4W.

ENGINEER'S STAMP & SIGNATURE		SURVEY INFORMATION		BENCH MARKS		AS BUILT INFORMATION	
<div><p>I, William P. Foster, to the best of my knowledge, certify that this electronic version is identical to the original reproducible RECORD drawing signed by me on 07/22/2011.</p></div>		Field Notes					
		No.	By				
No.	Date	Remarks					
REVISIONS							
DESIGN							
Designed By: ASCG							Date: —
Drawn By: ASCG							Date: —
Checked By: ASCG							Date: —
							</



1 PARKING STRUCTURE ENLARGED PLAN – LVL 4 ELEVATOR LOBBY  
1/8" = 1'-0"




GENERAL NOTES:

- A. WHERE NECESSARY, THE CONTRACTOR SHALL REROUTE AND/OR RECONNECT CIRCUIT RUNS TO MAINTAIN THE CONTINUITY OF THE EXISTING CIRCUIT.
- B. ALL ELECTRICAL PENETRATION THROUGH FIRE RATED ASSEMBLES SHALL BE SEALED TO MAINTAIN THE RATING OF THE ASSEMBLY.

KEYED NOTES:

1. EXISTING LIGHTING FIXTURE TO BE REPLACED. DISCONNECT EXISTING AND RETURN TO AVIATION. PROVIDE NEW FIXTURE AS INDICATED AND CONNECT TO EXISTING LIGHTING CIRCUIT.

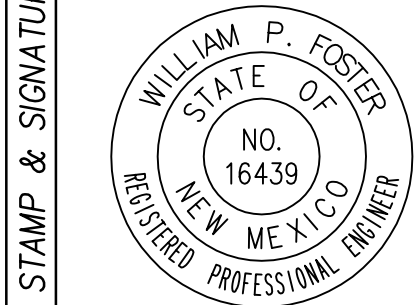

I, William P. Foster, to the best of my knowledge, certify that this electronic version is identical to the original reproducible RECORD drawing signed by me on 07/22/2011.

**ASCG**  
INCORPORATED

ENGINEERS • ARCHITECTS • SURVEYORS • PLANNERS

6501 AMERICAS PARKWAY NE, SUITE 400  
ALBUQUERQUE, NEW MEXICO 87110-5372  
PHONE 505.247.0234 • FAX 505.242.4845

RECORD DRAWING

This drawing, to the best of my knowledge, has been updated to include information received from the General Contractor to reflect as-built conditions. Actual installation may vary from this drawing due to changes made by the Contractor and not passed on for inclusion on the drawing.


CITY OF ALBUQUERQUE  
PUBLIC WORKS DEPARTMENT  
ENGINEERING DEVELOPMENT GROUP

TITLE: ALBUQUERQUE INTERNATIONAL SUNPORT  
LIGHTING MODERNIZATION PROJECT  
PARKING STRUCTURE ENLARGED PLANS – LVL 4


Design Review Committee	City Engineer Approval	Mo./Day/Yr.	Mo./Day/Yr.

City Project No. 7259.25	Zone Map No. M-16	Drawing No. E-408	Sheet 27	Of 33
-----------------------------	----------------------	----------------------	-------------	----------

2 6 - 7 2 5 9 . 1 1 - 0 8

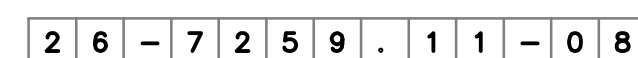



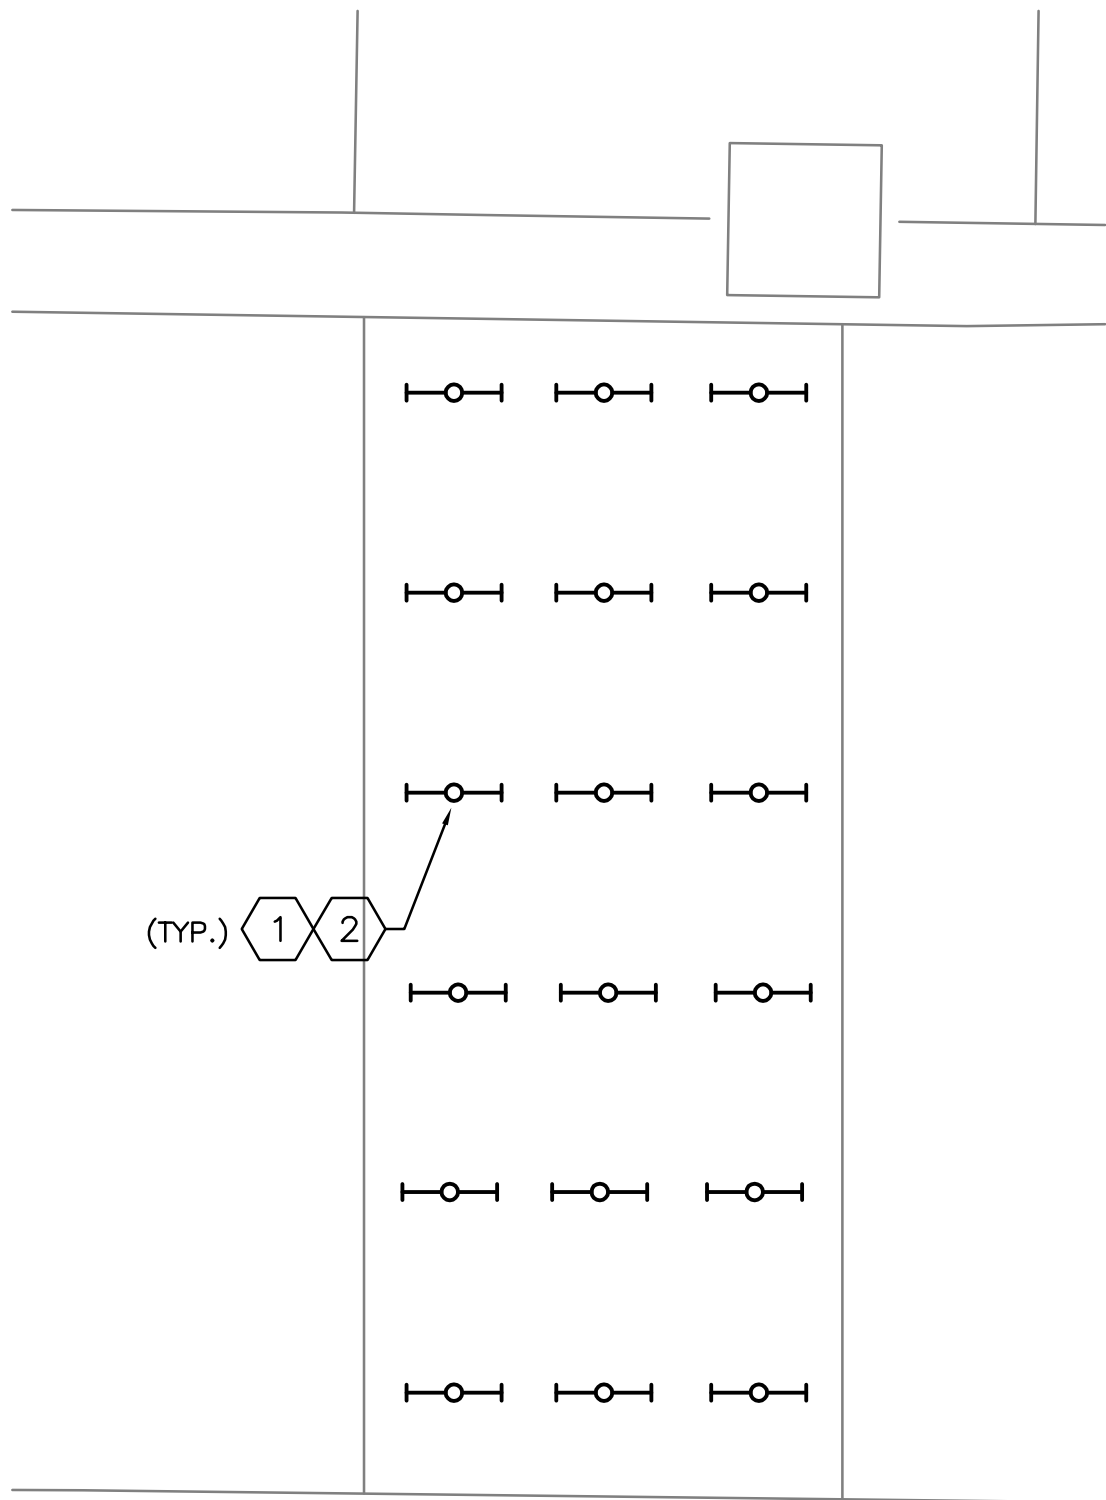


1 CROSS WALK LOWER LEVEL LIGHTING – TYPICAL DEMO  
SCALE: NONE

GENERAL DEMO NOTES:

- A. THE CONTRACTOR SHALL FAMILIARIZE HIMSELF WITH THE EXISTING CONDITIONS IN ORDER TO ALLOW HIM TO SUBMIT A COMPLETE BID FOR REMOVALS WITHIN THE SCOPE OF THE DRAWINGS. ANY QUESTIONS ARISING DURING THE BID PERIOD IN REGARD TO THE INTENT OF THE DRAWINGS SHALL BE BROUGHT UP FOR CLARIFICATION WITH THE ENGINEER.
- B. THE ELECTRICAL CONTRACTOR SHALL BE RESPONSIBLE FOR EXISTING BLDG. CIRCUITRY. ANY DISCONNECT CIRCUIT THAT AFFECTS OTHER PORTIONS OF THE BLDG. SHALL BE RECIRCUITED AND ROUTED TO ACCOMMODATE A COMPLETE ELECTRICAL SYSTEM. PROVIDE ADDITIONAL CONDUIT, WIRING AND J-BOXES AS REQUIRED/NEEDED TO RETAIN CIRCUIT CONTINUITY.
- C. THE ELECTRICAL CONTRACTOR SHALL RETURN UNUSED ELECTRICAL DEVICES (I.E. PANELBOARDS, DISCONNECT SWITCHES, ETC.) TO THE OWNER. FIELD COORDINATE STORAGE LOCATION WITH THE OWNER. OWNER HAS FIRST RIGHT OF RELEASE OF ANY OWNED PROPERTY.
- D. CONTRACTOR SHALL REPAIR ALL DAMAGE TO WALLS, CEILING, ETC. SHOULD ANY OCCUR DURING CONSTRUCTION PERIOD. PATCH TO MATCH EXISTING.
- E. THE CONTRACTOR SHALL COORDINATE/SCHEDULE ANY DOWN TIME NECESSARY TO COMPLETE THE WORK INDICATED. CONTRACTOR SHALL FURNISH A SCHEDULE TO THE OWNER NOT LESS THAN FIVE (5) WORKING DAYS PRIOR TO THE INTENDED OUTAGE.

KEYED NOTES: ⬡

- 1. DEMOLITION OF CROSS WALK LIGHTING SHALL BE DONE SO AS TO HAVE THE LEAST IMPACT ON OPERATIONS AS POSSIBLE. COORDINATE ALL LIGHTING DEMO TIMES WITH AVIATION PERSONNEL PRIOR TO PERFORMING ANY WORK.
- 2. EXISTING LIGHT FIXTURES TO BE REMOVED RETURN FIXTURE TO MAINTENANCE. DISCONNECT EXISTING LIGHTING CIRCUITS AND PULL BACK TO NEAREST J-BOX CIRCUITS TO BE EXTENDED TO NEW LIGHTING. REFER TO NEW LIGHTING LAYOUT ON THIS SHEET.

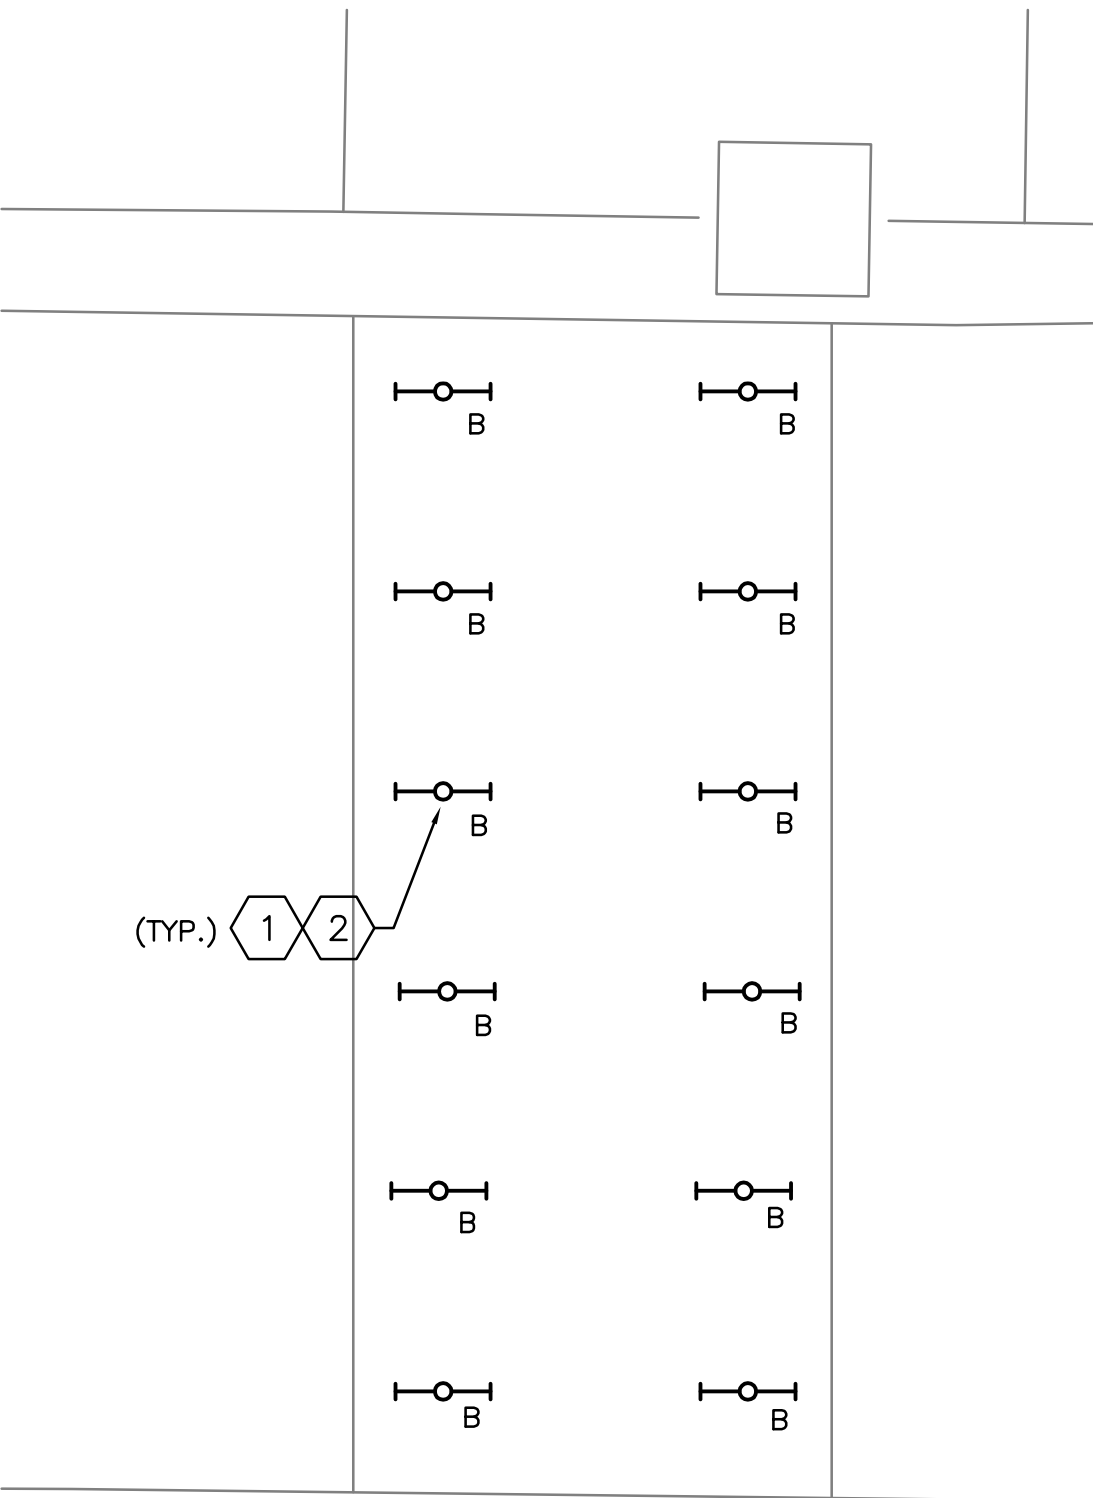

2 CROSS WALK LOWER LEVEL LIGHTING – TYPICAL NEW LIGHTING  
SCALE: NONE

GENERAL NOTES:

- A. WHERE NECESSARY, THE CONTRACTOR SHALL REROUTE AND/OR RECONNECT CIRCUIT RUNS TO MAINTAIN THE CONTINUITY OF THE EXISTING CIRCUIT.
- B. ALL ELECTRICAL PENETRATIONS THROUGH FIRE RATED ASSEMBLES SHALL BE SEALED TO MAINTAIN THE RATING OF THE ASSEMBLY.

KEYED NOTES: ⬡

- 1. NEW LIGHTING FIXTURE. CONNECT TO EXISTING LIGHTING CIRCUIT FOR THE ASSOCIATED CROSS WALK. REPAIR ANY DAMAGE TO CEILINGS.
- 2. INSTALLATION OF NEW CROSS WALK LIGHTING SHALL BE DONE SO AS TO HAVE THE LEAST IMPACT ON OPERATIONS AS POSSIBLE. COORDINATE ALL LIGHTING INSTALLATION TIMES WITH AVIATION PERSONNEL PRIOR TO PERFORMING ANY WORK.




ASCG  
INCORPORATED

ENGINEERS • ARCHITECTS • SURVEYORS • PLANNERS  
6501 AMERICAS PARKWAY NE, SUITE 400  
ALBUQUERQUE, NEW MEXICO 87110-5372  
PHONE 505.247.0234 • FAX 505.242.4845


RECORD DRAWING  
This drawing, to the best of my knowledge, has been updated to include information received from the General Contractor to reflect as-built conditions. Actual installation may vary from this drawing due to changes made by the Contractor and not passed on for inclusion on the drawing.

CITY OF ALBUQUERQUE PUBLIC WORKS DEPARTMENT ENGINEERING DEVELOPMENT GROUP				
TITLE: ALBUQUERQUE INTERNATIONAL SUNPORT LIGHTING MODERNIZATION PROJECT ENLARGED CROSS WALK LOWER LVL – LIGHTING				
Design Review Committee	City Engineer Approval	Last Design Update	Mo./Day/Yr.	Mo./Day/Yr.
City Project No. 7259.25	Zone Map No. M-16	Drawing No. E-410	Sheet 29	Of 33

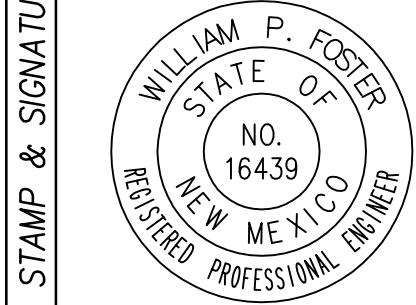


I, William P. Foster, to the best of my knowledge, certify that this electronic version is identical to the original reproducible RECORD drawing signed by me on 07/22/2011.

AS BUILT INFORMATION		BENCH MARKS		SURVEY INFORMATION		ENGINEERS STAMP & SIGNATURE	
Contractor	Staked By	Inspector's	Date	Field	By	REVISIONS DESIGN	Remarks
			Date				
			Date				
			Date				
MICRO-FILM INFORMATION		Recorded By		No.		Date: --	
						Date: --	
						Date: --	

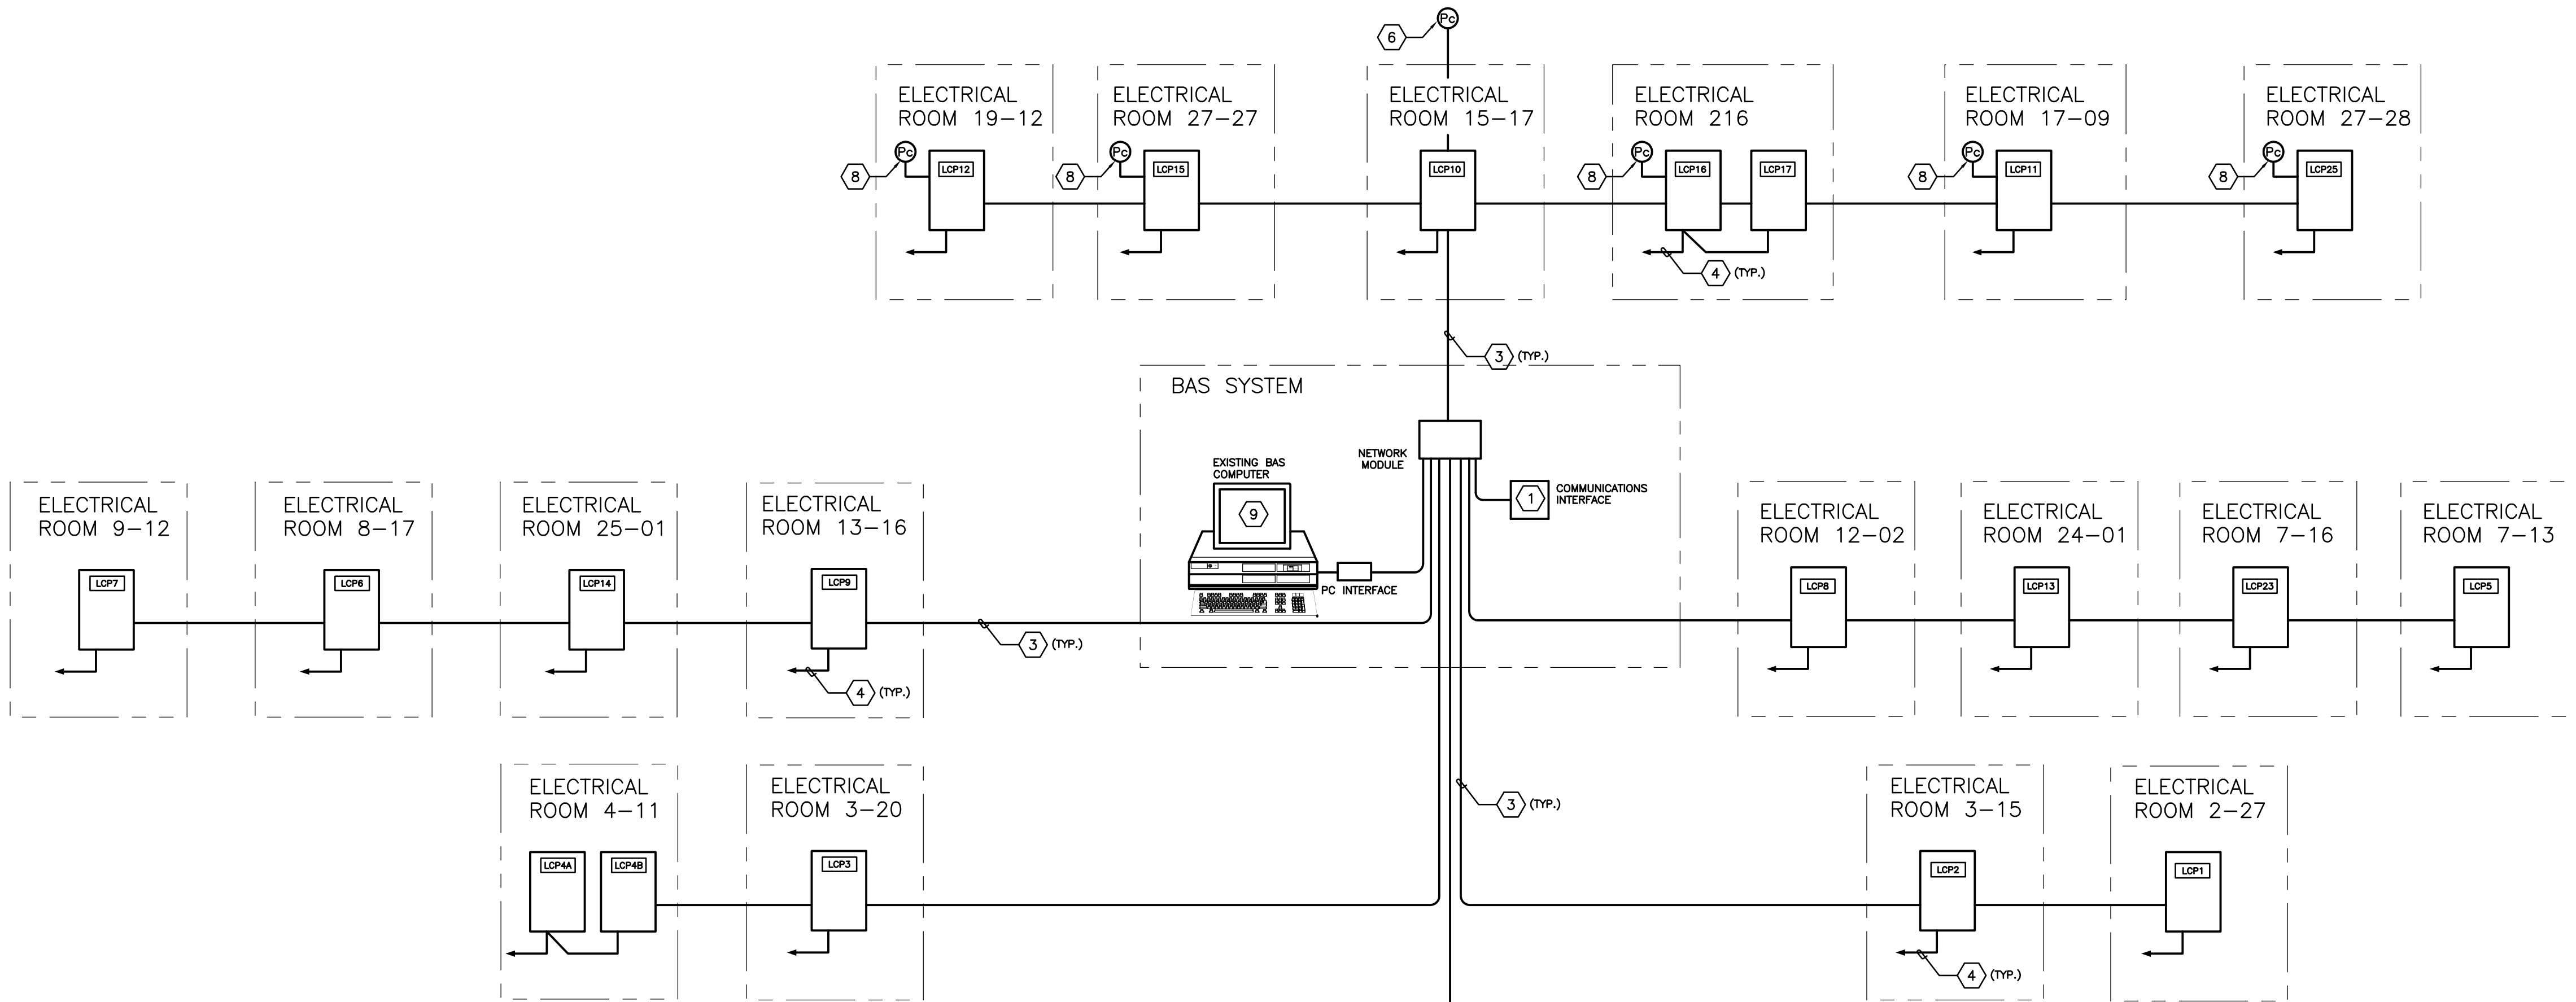

LIGHTING CONTROL DIAGRAM TERMINAL BUILDING  
SCALE: NONE

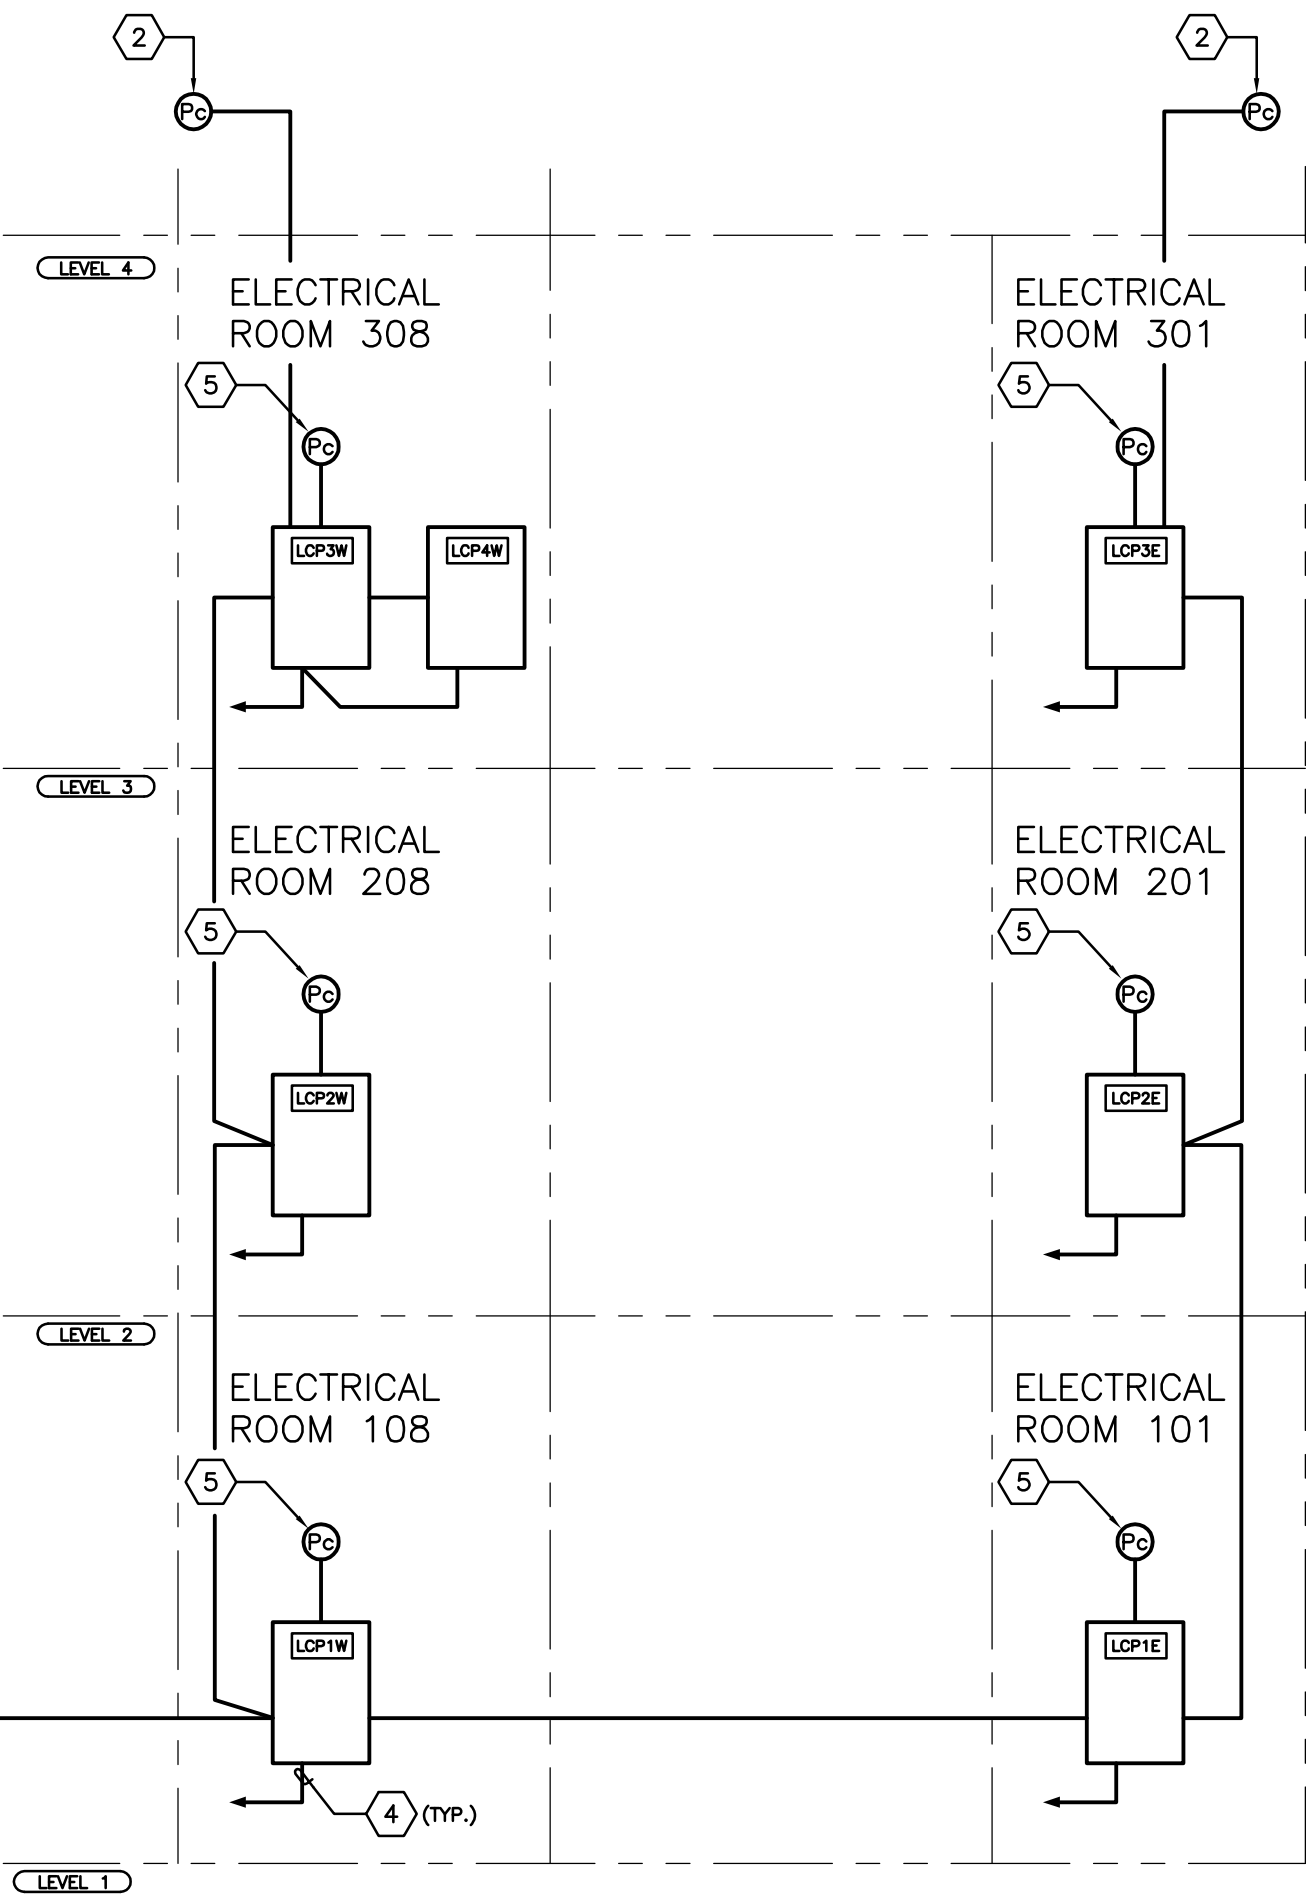

LIGHTING CONTROL DIAGRAM PARKING STRUCTURE  
SCALE: NONE



GENERAL NOTES:

- NOT ALL DEVICES ARE SHOWN. REFER TO PLANS FOR EXACT LOCATIONS AND QUANTITIES.
- REFER TO DRAWINGS E-601 THROUGH E-603 FOR LIGHTING CONTROL PANEL SCHEDULES.
- NETWORK CONNECTION ARE DEPICTED DIAGRAMMATICALLY.
- LIGHTING CONTROL PANELS SHALL INTERFACE WITH EXISTING BAS SYSTEM.

KEYED NOTES:

- PROVIDE REMOTE COMMUNICATIONS INTERFACE WITH LOCAL PHONE CONTROL VIA ACCESS CODES.
- FIELD VERIFY EXISTING PHOTOCELL LOCATIONS AND REPLACE EXISTING PHOTOCELL(S) WITH NEW H.D. PHOTOCELL TO CONTROL CANOPY AND SITE LIGHTING. INSTALL AT SAME LOCATION AS EXISTING PHOTOCELLS.
- COMMUNICATION DATA BUS. WIRING AS REQUIRED BY SYSTEM MANUFACTURE.
- EXISTING LIGHTING CONTROL POWER CONNECTION. EXTEND TO NEW LCP FOR CONTROL POWER.
- FIELD VERIFY LOCATION OF EXISTING PERIMETER LIGHTING PHOTOCELLS AND REPLACE WITH NEW H.D. PHOTOCELL(S). INSTALL AT SAME LOCATION.
- PHOTOCELL INPUT FOR CONTROL OF PERIMETER LIGHTING AND ROAD WAY LIGHTING.
- FIELD VERIFY EXISTING PHOTOCELL LOCATIONS AND REPLACE EXISTING PHOTOCELL(S) WITH NEW H.D. PHOTOCELL TO CONTROL SITE LIGHTING. INSTALL AT SAME LOCATION AS EXISTING FACING NORTH.
- PROVIDE NEW H.D. LOW PROFILE CEILING MOUNTED PHOTOCELLS IN HOLD AREAS FOR "a,b" SWITCHING OF LIGHTING. REFER TO PLANS FOR LOCATIONS AND QUANTITIES.
- PROVIDE GRAPHIC INTERFACE FOR BAS SYSTEM. COORDINATE OPTIONS AND CONFIGURATION WITH AVIATION DEPARTMENT PERSONNEL.

**ASCG**  
INCORPORATED

ENGINEERS - ARCHITECTS - SURVEYORS - PLANNERS

6501 AMERICAS PARKWAY NE, SUITE 400  
ALBUQUERQUE, NEW MEXICO 87110-5372  
PHONE 505.247.0234 • FAX 505.242.4845

RECORD DRAWING


This drawing, to the best of my knowledge, has been updated to include information reflected from the General Contractor to reflect as-built conditions. Actual installation may vary from this drawing due to changes made by the Contractor and not passed on for inclusion on the drawing.

CITY OF ALBUQUERQUE  
PUBLIC WORKS DEPARTMENT  
ENGINEERING DEVELOPMENT GROUP

TITLE: ALBUQUERQUE INTERNATIONAL SUNPORT  
LIGHTING MODERNIZATION PROJECT  
LIGHTING CONTROL DIAGRAMS

Design Review Committee	City Engineer Approval	Mo./Day/Yr.	Mo./Day/Yr.

City Project No. 7259.25	Zone Map No. M-16	Drawing No. E-501	Sheet 30	Of 33
-----------------------------	----------------------	----------------------	-------------	----------

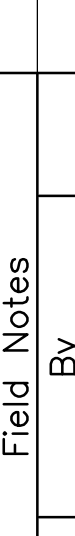AS BUILT INFORMATION				BENCH MARKS				SURVEY INFORMATION				ENGINEER'S STAMP & SIGNATURE			
Contractor Work By: _____ Inspector's _____ Acceptance By _____ Date _____ Date _____ Date _____ Date _____ Drawings _____ Corrected By _____ Date _____ <b>MICRO-FILM INFORMATION</b> Recorded By _____ Date _____				Field Notes By _____ No. _____				<div><p>I, William P. Foster, to the best of my knowledge, certify that this electronic version is identical to the original reproducible RECORD drawing signed by me on 07/22/2011.</p></div>							

LCP CABINET SCHEDULE				
PANEL NAME: LCP-1				
LOCATION: ELECTRICAL 2-27		TRANS. VOLTAGE 120V		
RELAY NO.	CIRCUIT	RELAY VOLTAGE	DESCRIPTION	NOTES
1	N3A1P-2	277V	EXISTING BLDG LTG.	
2	N3A1P-3	277V	EXISTING BLDG LTG.	
3	N3A1P-4	277V	EXISTING BLDG LTG.	
4	N3A1P-5	277V	EXISTING BLDG LTG.	
5	N3A1P-6	277V	EXISTING BLDG LTG.	
6	N3A1P-8	277V	EXISTING BLDG LTG.	
7	N3A1P-10	277V	EXISTING BLDG LTG.	
8	N3A1P-12	277V	EXISTING BLDG LTG.	
9	N3A1P-13	277V	EXISTING BLDG LTG.	
10	N3A1P-14	277V	EXISTING BLDG LTG.	
11	N3A1P-15	277V	EXISTING BLDG LTG.	
12	N3A1P-16	277V	EXISTING BLDG LTG.	
13	N3A1P-17	277V	EXISTING BLDG LTG.	
14	N3A1P-18	277V	EXISTING BLDG LTG.	
15	N3A1P-19	277V	EXISTING BLDG LTG.	
16	N3A1P-20	277V	EXISTING BLDG LTG.	
17	N3A1P-21	277V	EXISTING BLDG LTG.	
18	N3A1P-22	277V	EXISTING BLDG LTG.	
19	N3A1P-23	277V	EXISTING BLDG LTG.	
20	N3A1P-24	277V	EXISTING BLDG LTG.	
21	N3A1P-25	277V	EXISTING BLDG LTG.	
22	N3A1P-26	277V	EXISTING BLDG LTG.	
23	N3A1P-27	277V	EXISTING BLDG LTG.	
24	N3A1P-28	277V	EXISTING BLDG LTG.	
25	N3A1P-29	277V	EXISTING BLDG LTG.	
26	N3A1P-30	277V	EXISTING BLDG LTG.	
27	N3A1P-32	277V	EXISTING BLDG LTG.	
28	N3A1P-34	277V	EXISTING BLDG LTG.	
29	N3A1P-31		EXISTING SITE LTG.	PC CONTROL
30	N3A1P-33	480V	EXISTING SITE LTG.	PC CONTROL
31	N3A1P-35		EXISTING SITE LTG.	PC CONTROL
32	N3A1P-38		EXISTING SITE LTG.	PC CONTROL
33	N3A1P-40	480V	EXISTING SITE LTG.	PC CONTROL
34	N3A1P-42		EXISTING SITE LTG.	PC CONTROL
35	E3A1L-10	120V	EXISTING EM LTG	
36	E3A1L-12	120V	EXISTING EM LTG	
37	E3A1L-14	120V	EXISTING EM LTG	
38	SPARE	277V		
39	SPARE	277V		
40	SPARE	277V		
41	SPARE	277V		
42	SPARE	277V		
43	SPARE	277V		
44	SPARE	277V		
45	SPARE	277V		
46	SPARE			
47	SPARE			
48	SPARE			

LCP CABINET SCHEDULE				
PANEL NAME: LCP-5				
LOCATION: ELECTRICAL 7-13		TRANS. VOLTAGE 120V		
RELAY NO.	CIRCUIT	RELAY VOLTAGE	DESCRIPTION	NOTES
1	N3A2P-1	277V	EXISTING BLDG LTG.	
2	N3A2P-2	277V	EXISTING BLDG LTG.	
3	N3A2P-3	277V	EXISTING BLDG LTG.	
4	N3A2P-4	277V	EXISTING BLDG LTG.	
5	N3A2P-5	277V	EXISTING BLDG LTG.	
6	N3A2P-6	277V	EXISTING BLDG LTG.	
7	N3A2P-7	277V	EXISTING BLDG LTG.	
8	N3A2P-9	277V	EXISTING BLDG LTG.	
9	N3A2P-11	277V	EXISTING BLDG LTG.	
10	N3A2P-14	277V	EXISTING BLDG LTG.	
11	N3A2P-26		EXISTING SITE LTG.	PC CONTROL
12	N3A2P-28	480V	EXISTING SITE LTG.	PC CONTROL
13	N3A2P-30		EXISTING SITE LTG.	PC CONTROL
14	N3A2L-1	120V	EXISTING BLDG LTG.	
15	N3A2L-2	120V	EXISTING BLDG LTG.	
16	N3A2L-3	120V	EXISTING BLDG LTG.	
17	N3A2L-4	120V	EXISTING BLDG LTG.	
18	N3A2L-5	120V	EXISTING BLDG LTG.	
19	N3A2L-6	120V	EXISTING BLDG LTG.	
20	N3A2L-7	120V	EXISTING BLDG LTG.	
21	N3A2L-9	120V	EXISTING BLDG LTG.	
22	N3A2L-11	120V	EXISTING BLDG LTG.	
23	N3A2L-14	120V	EXISTING BLDG LTG.	
24	SPARE	120V		
25	SPARE	120V		
26	SPARE	277V		
27	SPARE	277V		
28	SPARE	277V		
29	SPARE	277V		
30	SPARE	277V		
31	SPACE			
32	SPACE			
LCP CABINET SCHEDULE				
PANEL NAME: LCP-2				
LOCATION: ELECTRICAL 3-15		TRANS. VOLTAGE 120V		
RELAY NO.	CIRCUIT	RELAY VOLTAGE	DESCRIPTION	NOTES
1	N3B1P-1	277V	EXISTING BLDG LTG.	
2	N3B1P-3	277V	EXISTING BLDG LTG.	
3	N3B1P-4	277V	EXISTING BLDG LTG.	
4	N3B1P-5	277V	EXISTING BLDG LTG.	
5	E3B1P-2	277V	EXISTING EM LTG.	
6	N3B1L-21	120V	EXISTING BLDG LTG.	
7	N3B1L-23	120V	EXISTING BLDG LTG.	
8	N3B1L-33	120V	EXISTING BLDG LTG.	
9	N3B1L-35	120V	EXISTING BLDG LTG.	
10	SPARE	277V		
11	SPARE	277V		
12	SAPRE	277V		
13	SPARE	277V		
14	SPARE	277V		
15	SPARE	277V		
16	SPARE	277V		
17	SPARE	277V		
18	SPARE	277V		
19	SPACE			
20	SPACE			
LCP CABINET SCHEDULE				
PANEL NAME: LCP-3				
LOCATION: ELECTRICAL 3-20		TRANS. VOLTAGE 120V		
RELAY NO.	CIRCUIT	RELAY VOLTAGE	DESCRIPTION	NOTES
1	N2B1P-1	277V	EXISTING BLDG LTG.	
2	N2B1P-2	277V	EXISTING BLDG LTG.	
3	N2B1P-3	277V	EXISTING BLDG LTG.	
4	N2B1P-4	277V	EXISTING BLDG LTG.	
5	N2B1P-5	277V	EXISTING BLDG LTG.	
6	N2B1P-6	277V	EXISTING BLDG LTG.	
7	N2B1P-7	277V	EXISTING BLDG LTG.	
8	N2B1P-8	277V	EXISTING BLDG LTG.	
9	N2B1P-9	277V	EXISTING BLDG LTG.	
10	N2B1P-10	277V	EXISTING BLDG LTG.	
11	N2B1P-11	277V	EXISTING BLDG LTG.	
12	N2B1P-12	277V	EXISTING BLDG LTG.	
13	N2B1P-13	277V	EXISTING BLDG LTG.	
14	N2B1P-15	277V	EXISTING BLDG LTG.	
15	N2B1P-19	277V	EXISTING BLDG LTG.	
16	N2B1P-20	277V	EXISTING BLDG LTG.	
17	N2B1P-21	277V	EXISTING BLDG LTG.	
18	N2B1P-23	277V	EXISTING BLDG LTG.	
19	N2B1P-24	277V	EXISTING BLDG LTG.	
20	N2A1P-11	277V	EXISTING BLDG LTG.	
21	N2A1P-35	277V	EXISTING BLDG LTG.	
22	N2A1P-36	277V	EXISTING BLDG LTG.	
23	N2A1P-37	277V	EXISTING BLDG LTG.	
24	N2A1P-38	277V	EXISTING BLDG LTG.	
25	N2A1P-39	277V	EXISTING BLDG LTG.	
26	N2A1P-40	277V	EXISTING BLDG LTG.	
27	N2A1P-41	277V	EXISTING BLDG LTG.	
28	N2A1P-44	277V	EXISTING BLDG LTG.	
29	N2A1P-46	277V	EXISTING BLDG LTG.	
30	N2B1L-16	120V	EXISTING BLDG LTG.	
31	N2B1L-18	120V	EXISTING BLDG LTG.	
32	N2B1L-29	120V	EXISTING BLDG LTG.	
33	N2B1L-37	120V	EXISTING BLDG LTG.	
34	E2B1P-2	277V	EXISTING EM LTG.	
35	E2B1P-3	277V	EXISTING EM LTG.	
36	E2B1P-4	277V	EXISTING EM LTG.	
37	E2B1P-14	277V	EXISTING EM LTG.	
38	E2B1P-16	277V	EXISTING EM LTG.	
39	SPARE	277V		
40	SPARE	277V		
41	SPARE	277V		
42	SPARE	277V		
43	SPARE	277V		
44	SPARE	277V		
45	SPARE	277V		
46	SPARE	120V		
47	SPARE	120V		
48	SPARE	120V		

LCP CABINET SCHEDULE				
PANEL NAME: LCP-4A				
LOCATION: ELECTRICAL 4-11		TRANS. VOLTAGE 120V		
RELAY NO.	CIRCUIT	RELAY VOLTAGE	DESCRIPTION	NOTES
1	N2A1P-1	277V	EXISTING BLDG LTG.	
2	N2A1P-2	277V	EXISTING BLDG LTG.	
3	N2A1P-3	277V	EXISTING BLDG LTG.	
4	N2A1P-4	277V	EXISTING BLDG LTG.	
5	N2A1P-5	277V	EXISTING BLDG LTG.	
6	N2A1P-6	277V	EXISTING BLDG LTG.	
7	N2A1P-7	277V	EXISTING BLDG LTG.	
8	N2A1P-8	277V	EXISTING BLDG LTG.	
9	N2A1P-10	277V	EXISTING BLDG LTG.	
10	N2A1P-12	277V	EXISTING BLDG LTG.	
11	N2A1P-14	277V	EXISTING BLDG LTG.	
12	N2A1P-16	277V	EXISTING BLDG LTG.	
13	N2A1P-18	277V	EXISTING BLDG LTG.	
14	N2A1P-19	277V	EXISTING BLDG LTG.	
15	N2A1P-22	277V	EXISTING BLDG LTG.	
16	N2A1P-23	277V	EXISTING BLDG LTG.	
17	N2A1P-25	277V	EXISTING BLDG LTG.	
18	N2A1P-26	277V	EXISTING BLDG LTG.	
19	N2A1P-27	277V	EXISTING BLDG LTG.	
20	N2A1P-28	277V	EXISTING BLDG LTG.	
21	N2A1P-29	277V	EXISTING BLDG LTG.	
22	N2A1P-30	277V	EXISTING BLDG LTG.	
23	N2A1P-31	277V	EXISTING BLDG LTG.	
24	N2A1P-32	277V	EXISTING BLDG LTG.	
25	N2A1P-33	277V	EXISTING BLDG LTG.	
26	N2A1P-34	277V	EXISTING BLDG LTG.	
27	N2A1P-43	277V	EXISTING BLDG LTG.	
28	N2A1P-45	277V	EXISTING BLDG LTG.	
29	N2A1P-47	277V	EXISTING BLDG LTG.	
30	N2A1P-65	277V	EXISTING BLDG LTG.	
31	N2A1P-49		EXISTING SITE LTG.	PC CONTROL
32	N2A1P-51	480V	EXISTING SITE LTG.	PC CONTROL
33	SPARE			
34	N2A1P-53		EXISTING SITE LTG.	PC CONTROL
35	N2A1P-55	480V	EXISTING SITE LTG.	PC CONTROL
36	SPARE			
37	N2A1P-56		EXISTING SITE LTG.	PC CONTROL
38	N2A1P-58	480V	EXISTING SITE LTG.	PC CONTROL
39	SPARE			
40	N2A1L-22	120V	EXISTING BLDG LTG.	
41	N2A1L-24	120V	EXISTING BLDG LTG.	
42	N2A1L-26	120V	EXISTING BLDG LTG.	
43	N2A1L-28	120V	EXISTING BLDG LTG.	
44	SPARE	120V		
45	SPARE	120V		
46	SPARE	277V		
47	SPARE	277V		
48	SPARE	277V		

LCP CABINET SCHEDULE				
PANEL NAME: <u>LCP-4B</u>				
LOCATION: <u>ELECTRICAL 4-11</u>		TRANS. VOLTAGE <u>120V</u>		
RELAY NO.	CIRCUIT	RELAY VOLTAGE	DESCRIPTION	NOTES
1	E2A1P-2	277V	EXISTING EM LTG.	
2	E2A1L-18	120V	EXISTING BLDG LTG.	
3	E2A1L-20	120V	EXISTING BLDG LTG.	
4	E2A1L-21	120V	EXISTING BLDG LTG.	
5	E2A1L-22	120V	EXISTING BLDG LTG.	
6	E2A1L-24	120V	EXISTING BLDG LTG.	
7	E2A1L-26	120V	EXISTING BLDG LTG.	
8	E2A1P-13	480V	EXISTING EM SITE LTG.	PC CONTROL
9	E2A1P-15		EXISTING EM SITE LTG.	PC CONTROL
10	SPARE	277V		
11	SPARE	277V		
12	SPARE	277V		
13	SPARE	277V		
14	SPARE	277V		
15	SPARE	277V		
16	SPARE	277V		
17	SPARE	277V		
18	SPARE	277V		
19	SPARE	277V		
20	SPARE	277V		
21	SPARE	277V		
22	SPARE	120V		
23	SPARE	120V		
24	SPARE	120V		
25	SPACE			
26	SPACE			
LCP CABINET SCHEDULE				
PANEL NAME: LCP-10				
LOCATION: ELECTRICAL 15-17		TRANS. VOLTAGE 120V		
RELAY NO.	CIRCUIT	RELAY VOLTAGE	DESCRIPTION	NOTES
1	N5A2P-1	277V	EXISTING SITE LTG.	
2	N5A2P-10	277V	EXISTING BLDG LTG.	
3	N5A2P-13	277V	EXISTING BLDG LTG.	
4	N4A3P-1	480V	EXISTING SITE LTG.	PC CONTROL
5	N4A3P-3		EXISTING SITE LTG.	PC CONTROL
6	N4A3P-5		EXISTING SITE LTG.	PC CONTROL
7	N4A3P-2	480V	EXISTING SITE LTG.	PC CONTROL
8	N4A3P-4		EXISTING SITE LTG.	PC CONTROL
9	N4A3P-6		EXISTING SITE LTG.	PC CONTROL
10	N4A3P-7	480V	EXISTING SITE LTG.	PC CONTROL
11	N4A3P-9		EXISTING SITE LTG.	PC CONTROL
12	N4A3P-11		EXISTING SITE LTG.	PC CONTROL
13	N5A3P-16	480V	EXISTING SITE LTG.	PC CONTROL
14	N5A3P-18		EXISTING SITE LTG.	PC CONTROL
15	N5A3P-20		EXISTING SITE LTG.	PC CONTROL
16	N3C2L-20	120V	EXISTING BLDG LTG.	
17	N3C2L-22	120V	EXISTING BLDG LTG.	
18	N3C2L-24	120V	EXISTING BLDG LTG.	
19	E4A3P-1	480V	EXISTING SITE LTG.	PC CONTROL
20	E4A3P-3		EXISTING SITE LTG.	PC CONTROL
21	E4A3P-5		EXISTING SITE LTG.	PC CONTROL
22	E4A3P-2	480V	EXISTING SITE LTG.	PC CONTROL
23	E4A3P-4		EXISTING SITE LTG.	PC CONTROL
24	E4A3P-6		EXISTING SITE LTG.	PC CONTROL
25	SPARE	277V		
26	SPARE	277V		
27	SPARE	277V		
28	SPARE	277V		
29	SPARE	277V		
30	SPARE	277V		
31	SPARE	120V		
32	SPARE	120V		
33	SPACE			
34	SPACE			
LCP CABINET SCHEDULE				
PANEL NAME: LCP-15				
LOCATION: ELECTRICAL 27-27		TRANS. VOLTAGE 120V		
RELAY NO.	CIRCUIT	RELAY VOLTAGE	DESCRIPTION	NOTES
1	N4A3P-13	277V	EXISTING BLDG LTG.	
2	N4A3P-14	277V	EXISTING BLDG LTG.	
3	N4A3P-15	277V	EXISTING BLDG LTG.	
4	N4A3P-16	277V	EXISTING BLDG LTG.	
5	N4A3P-17	277V	EXISTING BLDG LTG.	
6	N4A3P-18	277V	EXISTING BLDG LTG.	
7	N4A3P-19	277V	EXISTING BLDG LTG.	
8	N4A3P-19	277V	EXISTING BLDG LTG.	JUMPER FROM 7
9	N4A3P-20	277V	EXISTING BLDG LTG.	
10	N4A3P-21	277V	EXISTING BLDG LTG.	
11	N4A3P-21	277V	EXISTING BLDG LTG.	JUMPER FROM 10
12	N4A3P-22	277V	EXISTING BLDG LTG.	
13	N4A3P-23	277V	EXISTING BLDG LTG.	
14	N4A3P-24	277V	EXISTING BLDG LTG.	
15	N4A3P-26	277V	EXISTING BLDG LTG.	
16	N4A3L-48	120V	EXISTING BLDG LTG.	
17	N4A3L-49	120V	EXISTING BLDG LTG.	
18	N4A3L-50	120V	EXISTING BLDG LTG.	
19	N4A3L-51	120V	EXISTING BLDG LTG.	
20	N4A3L-52	120V	EXISTING BLDG LTG.	
21	N4A3L-53	120V	EXISTING BLDG LTG.	
22	SPARE	277V		
23	SPARE	277V		
24	SPARE	277V		
25	SPARE	277V		
26	SPARE	277V		
27	SPARE	277V		
28	SPARE	277V		
29	SPARE	120V		
30	SPARE	120V		
31	SPACE	120V		
32	SPACE			
33	SPACE			
LCP CABINET SCHEDULE				
PANEL NAME: LCP-11				
LOCATION: ELECTRICAL 17-09		TRANS. VOLTAGE 120V		
RELAY NO.	CIRCUIT	RELAY VOLTAGE	DESCRIPTION	NOTES
1	N5B2P-6	277V	EXISTING BLDG LTG.	
2	N5B2P-14	277V	EXISTING BLDG LTG.	
3	N5B2P-16	277V	EXISTING BLDG LTG.	
4	N5B2P-16	277V	EXISTING BLDG LTG.	JUMPER FROM 3
5	N5B2P-16	277V	EXISTING BLDG LTG.	JUMPER FROM 4
6	N5B2P-18	277V	EXISTING BLDG LTG.	
7	N5B2P-18	277V	EXISTING BLDG LTG.	JUMPER FROM 6
8	N5B2P-19	277V	EXISTING BLDG LTG.	
9	N5B2P-20	277V	EXISTING BLDG LTG.	
10	N5B2P-20	277V	EXISTING BLDG LTG.	JUMPER FROM 10
11	N5B2P-2	480V	EXISTING SITE LTG.	PC CONTROL
12	N5B2P-4		EXISTING BLDG LTG.	PC CONTROL
13	N5B2P-6		EXISTING BLDG LTG.	PC CONTROL
14	N5B2P-1	480V	EXISTING BLDG LTG.	PC CONTROL
15	N5B2P-3		EXISTING BLDG LTG.	PC CONTROL
16	N5B2P-5		EXISTING BLDG LTG.	PC CONTROL
17	N5B2P-7	480V	EXISTING BLDG LTG.	PC CONTROL
18	N5B2P-9		EXISTING BLDG LTG.	PC CONTROL
19	N5B2P-11		EXISTING BLDG LTG.	PC CONTROL
20	N5B2L-6	120V	EXISTING BLDG LTG.	
21	N5B2L-35	120V	EXISTING BLDG LTG.	
22	N5B2L-37	120V	EXISTING BLDG LTG.	
23	N5B2L-50	120V	EXISTING BLDG LTG.	
24	N5B2L-52	120V	EXISTING BLDG LTG.	
25	E5B2P-1	480V	EXISTING EM SITE LTG.	PC CONTROL
26	E5B2P-3		EXISTING EM SITE LTG.	PC CONTROL
27	E5B2P-5		EXISTING EM SITE LTG.	PC CONTROL
28	SPARE	277V		
29	SPARE	277V		
30	SPARE	277V		
31	SPARE	277V		
32	SPARE	277V		
33	SPARE	277V		
34	SPARE	120V		
35	SPARE	120V		
36	SPACE			
37	SPACE			
LCP CABINET SCHEDULE				
PANEL NAME: LCP-16				
LOCATION: ELECTRICAL 216		TRANS. VOLTAGE 120V		
RELAY NO.	CIRCUIT	RELAY VOLTAGE	DESCRIPTION	NOTES
1	NSA3P-2	277V	EXISTING BLDG LTG.	
2	NSA3P-4	277V	EXISTING BLDG LTG.	
3	NSA3P-4	277V	EXISTING BLDG LTG.	JUMPER FROM 2
4	NSA3P-6	277V	EXISTING BLDG LTG.	
5	NSA3P-8	277V	EXISTING BLDG LTG.	
6	NSA3P-8	277V	EXISTING BLDG LTG.	JUMPER FROM 5
7	NSA3P-13	277V	EXISTING BLDG LTG.	
8	NSA3P-15	277V	EXISTING BLDG LTG.	
9	NSA3P-17	277V	EXISTING BLDG LTG.	
10	NSA3L-43	120V	EXISTING BLDG LTG.	FROM CTC16A
11	NSA3L-45	120V	EXISTING BLDG LTG.	FROM CTC16A
12	NSA3L-46	120V	EXISTING BLDG LTG.	FROM CTC16A
13	NSA3L-47	120V	EXISTING BLDG LTG.	FROM CTC16A
14	NSA3L-48	120V	EXISTING BLDG LTG.	FROM CTC16A
15	NSA3L-49	120V	EXISTING BLDG LTG.	
16	NSA3L-50	120V	EXISTING BLDG LTG.	FROM CTC16A
17	ESA3P-8	480V	EXISTING SITE LTG.	PC CONTROL
18	ESA3P-10		EXISTING SITE LTG.	PC CONTROL
19	ESA3P-12		EXISTING SITE LTG.	PC CONTROL
20	SPARE	277V		
21	SPARE	277V		
22	SPARE	277V		
23	SPARE	277V		
24	SPARE	277V		
25	SPARE	277V		
26	SPARE	120V		
27	SPARE	120V		
28	SPARE	120V		
29	SPACE			
30	SPACE			
LCP CABINET SCHEDULE				
PANEL NAME: LCP-12				
LOCATION: ELECTRICAL 19-12		TRANS. VOLTAGE 120V		
RELAY NO.	CIRCUIT	RELAY VOLTAGE	DESCRIPTION	NOTES
1	N4B2P-1	277V	EXISTING BLDG LTG.	
2	N4B2P-1	277V	EXISTING BLDG LTG.	JUMPER FROM 1
3	N4B2P-13	277V	EXISTING BLDG LTG.	
4	N4B2P-15	277V	EXISTING BLDG LTG.	
5	N4B2P-15	277V	EXISTING BLDG LTG.	JUMPER FROM 4
6	N4B2P-17	277V	EXISTING BLDG LTG.	
7	N4B2P-17	277V	EXISTING BLDG LTG.	JUMPER FROM 6
8	N4B2P-19	277V	EXISTING BLDG LTG.	
9	N4B2P-20	277V	EXISTING BLDG LTG.	
10	N4B2P-21	277V	EXISTING BLDG LTG.	
11	N4B2P-21	277V	EXISTING BLDG LTG.	JUMPER FROM 10
12	N4B2P-22	277V	EXISTING BLDG LTG.	
13	N4B2P-23	277V	EXISTING BLDG LTG.	
14	N4B2P-23	277V	EXISTING BLDG LTG.	JUMPER FROM 13
15	N4B2P-2	480V	EXISTING SITE LTG.	PC CONTROL
16	N4B2P-4		EXISTING SITE LTG.	PC CONTROL
17	N4B2P-6		EXISTING SITE LTG.	PC CONTROL
18	N4B2P-7	480V	EXISTING SITE LTG.	PC CONTROL
19	N4B2P-9		EXISTING SITE LTG.	PC CONTROL
20	N4B2P-11		EXISTING SITE LTG.	PC CONTROL
21	N4B2P-8	480V	EXISTING SITE LTG.	PC CONTROL
22	N4B2P-10		EXISTING SITE LTG.	PC CONTROL
23	N4B2P-12		EXISTING SITE LTG.	PC CONTROL
24	N4B2L-17	120V	EXISTING BLDG LTG.	
25	N4B2L-35	120V	EXISTING BLDG LTG.	
26	N4B2L-37	120V	EXISTING BLDG LTG.	
27	N4B2L-40	120V	EXISTING BLDG LTG.	
28	N4B2L-42	120V	EXISTING BLDG LTG.	
29	E4B2P-2	480V	EXISTING EM SITE LTG.	PC CONTROL
30	E4B2P-4		EXISTING EM SITE LTG.	PC CONTROL
31	E4B2P-6		EXISTING EM SITE LTG.	PC CONTROL
32	SPARE	277V		
33	SPARE	277V		
34	SPARE	277V		
35	SPARE	277V		
36	SPARE	277V		
37	SPARE	277V		
38	SPARE	120V		
39	SPARE	120V		
40	SPARE	120V		
41	SPACE			
42	SPACE			
43	SPACE			
44	SPACE			
45	SPACE			
46	SPACE			
47	SPACE			
48	SPACE			

LCP CABINET SCHEDULE				
PANEL NAME: LCP-17				
LOCATION: ELECTRICAL 216		TRANS. VOLTAGE 120V		
RELAY NO.	CIRCUIT	RELAY VOLTAGE	DESCRIPTION	NOTES
1	NSA3L-67	120V	EXISTING BLDG LTG.	
2	NSA3L-69	120V	EXISTING BLDG LTG.	
3	SPARE	120V		
4	SPARE	120V		
5	SPARE	277V		
6	SPARE	277V		
7	SPARE	277V		
8	SPARE	277V		

LCP CABINET SCHEDULE				
PANEL NAME: LCP-13				
LOCATION: ELECTRICAL 24-01		TRANS. VOLTAGE 120V		
RELAY NO.	CIRCUIT	RELAY VOLTAGE	DESCRIPTION	NOTES
1	N3A3P-14	277V	EXISTING BLDG LTG.	
2	N3A3P-31	277V	EXISTING BLDG LTG.	
3	N3A3L-27	120V	EXISTING BLDG LTG.	
4	N3A3L-29	120V	EXISTING BLDG LTG.	
5	N3A3L-57	120V	EXISTING BLDG LTG.	
6	N3A3L-59	120V	EXISTING BLDG LTG.	
7	SPARE	277V		
8	SPARE	277V		
9	SPARE	277V		
10	SPARE	277V		
11	SPARE	120V		
12	SPARE	120V		
13	SPACE			
14	SPACE			
