


SCANNED BY
PLANNING

1 2 3 4 5 6 7 8 9 10 11 12 13 14 15
26-7270.80-2013

GENERAL NOTES:

- ALL WORK DETAILED ON THESE PLANS TO BE PERFORMED UNDER CONTRACT SHALL, EXCEPT AS OTHERWISE STATED OR PROVIDED FOR HEREON, BE CONSTRUCTED IN ACCORDANCE WITH THE CITY OF ALBUQUERQUE STANDARD SPECIFICATIONS FOR PUBLIC WORKS CONSTRUCTION 1986 EDITION WITH UPDATE NO. 3 ~~INCLUDING AMENDMENT No. 1~~
- ALL WORK ON THIS PROJECT SHALL BE PERFORMED IN ACCORDANCE WITH APPLICABLE FEDERAL, STATE, AND LOCAL LAWS, RULES, AND REGULATIONS CONCERNING CONSTRUCTION SAFETY AND HEALTH.
- PRIOR TO CONSTRUCTION, THE CONTRACTOR SHALL EXCAVATE & VERIFY THE HORIZONTAL AND VERTICAL LOCATIONS OF ALL OBSTRUCTIONS. SHOULD A CONFLICT EXIST, THE CONTRACTOR SHALL NOTIFY THE ENGINEER SO THAT THE CONFLICT CAN BE RESOLVED WITH MINIMUM DELAY.
- TWO (2) WORKING DAYS PRIOR TO ANY EXCAVATION, CONTRACTOR MUST CONTACT NEW MEXICO ONE CALL SYSTEM, INC. @ 260-1990 FOR LOCATION OF EXISTING UTILITIES.
- CONTRACTOR SHALL CONDUCT HIS OPERATIONS IN A MANNER WHICH WILL MINIMIZE INTERFERENCE WITH LOCAL TRAFFIC. CONTRACTOR SHALL COMPLY WITH ALL APPLICABLE LAWS, ORDINANCES, RULES, REGULATIONS, AND ORDERS OF ANY PUBLIC BODY HAVING JURISDICTION FOR THE SAFETY OF PERSONS OR PROPERTY, AND TO PROTECT THEM FROM DAMAGE, INJURY, OR LOSS. CONTRACTOR SHALL ERECT AND MAINTAIN, AS REQUIRED BY THE CONDITIONS AND PROGRESS OF THE WORK, ALL NECESSARY SAFEGUARDS FOR SAFETY CONTINUOUSLY AND NOT LIMITED TO NORMAL WORKING HOURS, THROUGHOUT THE DURATION OF THE PROJECT. CONTRACTOR SHALL ADHERE TO SECTION 19 OF THE GENERAL CONDITIONS OF THE CITY OF ALBUQUERQUE STANDARD SPECIFICATIONS FOR PUBLIC WORKS CONSTRUCTION, 1986, AS AMENDED WITH UPDATE NO. 3 ~~as per~~
- THE CONTRACTOR AGREES THAT HE SHALL ASSUME THE SOLE AND COMPLETE RESPONSIBILITY FOR THE JOB SITE CONDITIONS DURING THE COURSE OF CONSTRUCTION OF THIS PROJECT. INCLUDING SAFETY OF ALL PERSONS AND PROPERTY; THAT THIS REQUIREMENT SHALL APPLY CONTINUOUSLY AND NOT BE LIMITED TO NORMAL WORKING HOURS; AND THAT THE CONTRACTOR SHALL DEFEND, INDEMNIFY, AND HOLD HARMLESS THE OWNER & ENGINEER FROM ANY AND ALL LIABILITY REAL OR ALLEGED, IN CONNECTION WITH THE PERFORMANCE OF WORK ON THIS PROJECT, EXCEPTING LIABILITY ARISING FROM THE SOLE NEGLIGENCE OF THE OWNER OR ENGINEER.
- TRAFFIC CONTROL: SEVEN (7) WORKING DAYS PRIOR TO BEGINNING CONSTRUCTION, THE CONTRACTOR SHALL SUBMIT TO THE CONSTRUCTION COORDINATION DIVISION A DETAILED CONSTRUCTION SCHEDULE. TWO (2) WORKING DAYS PRIOR TO CONSTRUCTION, THE CONTRACTOR SHALL OBTAIN A BARRICADE PERMIT FROM THE CONSTRUCTION COORDINATION DIVISION. CONTRACTOR SHALL NOTIFY BARRICADE ENGINEER (924-3400) PRIOR TO OCCUPYING AN INTERSECTION. SEE SECTION 19 OF THE SPECIFICATIONS. ALL STREET STRIPING ALTERED OR DESTROYED SHALL BE REPLACED WITH PLASTIC REFLECTORIZED PAVEMENT MARKINGS BY CONTRACTOR TO LOCATION AS EXISTING OR AS SHOWN IN THIS PLAN SET.
- WHEN ABUTTING EXISTING PAVEMENT TO NEW, SAWCUT EXISTING PAVEMENT TO A STRAIGHT EDGE AND AT A RIGHT ANGLE, OR AS APPROVED BY THE FIELD ENGINEER. REMOVAL OF BROKEN OR CRACKED PAVEMENT WILL ALSO BE REQUIRED. CUTS SHALL BE ORTHOGONAL TO TRAFFIC DIRECTION.
- EXISTING CURB AND GUTTER NOT TO BE REMOVED UNDER THE CONTRACT WHICH IS DAMAGED OR DISPLACED BY THE CONTRACTOR SHALL BE REMOVED AND REPLACED BY THE CONTRACTOR AT HIS EXPENSE.
- ALL BACKFILL FOR TRENCHES SHALL BE COMPACTED TO A MINIMUM 95% MAXIMUM DENSITY PER ASTM D-1557 AND AS DIRECTED BY SECTION 701.14.2 AND STANDARD DRAWING NUMBER 2465.
- THE CONTRACTOR SHALL PROMPTLY CLEAN UP ANY MATERIAL EXCAVATED WITHIN THE PUBLIC RIGHT-OF-WAY OR PRIVATE ROADWAY EASEMENTS SO THAT THE EXCAVATED MATERIAL IS NOT SUSCEPTIBLE TO BEING WASHED DOWN THE STREET OR INTO ANY PUBLIC DRAINAGE FACILITY.
- ALL SANITARY SEWER LINE STATIONING REFERS TO SANITARY SEWER CENTERLINE STATIONING.
- ALL FITTINGS ON WATERLINES SHALL HAVE RESTRAINED JOINTS AS NOTED ON THE PLANS.
- CONTRACTOR SHALL SUPPORT ALL EXISTING, UNDERGROUND UTILITY LINES WHICH BECOME EXPOSED DURING CONSTRUCTION. PAYMENT FOR SUPPORTING WORK SHALL BE INCIDENTAL TO WATERLINE AND/OR SEWERLINE COSTS.
- CONTRACTOR SHALL ASSIST THE ENGINEER/INSPECTOR IN THE RECORDING OF DATA ON ALL UTILITY LINES AND ACCESSORIES AS REQUIRED BY THE CITY OF ALBUQUERQUE FOR THE PREPARATION OF RECORD DRAWINGS. CONTRACTOR SHALL NOT COVER UTILITY LINES AND ACCESSORIES UNTIL ALL DATA HAS BEEN RECORDED.
- THE CONTRACTOR SHALL NOTIFY THE CITY SURVEYOR NOT LESS THAN SEVEN (7) DAYS PRIOR TO STARTING WORK IN ORDER THAT THE CITY SURVEYOR MAY TAKE NECESSARY MEASURES TO INSURE THE PRESERVATION OF SURVEY MONUMENTS. CONTRACTOR SHALL NOT DISTURB PERMANENT SURVEY MONUMENTS WITHOUT THE CONSENT OF THE CITY SURVEYOR AND SHALL NOTIFY THE CITY SURVEYOR AND BEAR THE EXPENSE OF REPLACING ANY THAT MAY BE DISTURBED WITHOUT PERMISSION. REPLACEMENT SHALL BE DONE ONLY BY THE CITY SURVEYOR. WHEN A CHANGE IS MADE IN THE FINISHED ELEVATIONS OF THE PAVEMENT OF ANY ROADWAY IN WHICH A PERMANENT SURVEY MONUMENT IS LOCATED, CONTRACTOR SHALL, AT HIS OWN EXPENSE, ADJUST THE MONUMENT COVER TO THE NEW GRADE UNLESS OTHERWISE SPECIFIED. REFER TO SECTION 4.4 OF THE GENERAL CONDITIONS OF THE STANDARD SPECIFICATIONS.
- PNM WILL PROVIDE AT NO COST TO THE CITY OR THE CONTRACTOR THE REQUIRED PERSONNEL FOR INSPECTION OR OBSERVATION DEEMED NECESSARY BY PNM WHILE THE CONTRACTOR IS EXPOSING PNM'S CABLES. HOWEVER, THE CONTRACTOR SHALL BE CHARGED THE TOTAL COST ASSOCIATED WITH REPAIRS TO ANY DAMAGED CABLES OR FOR ANY COST ASSOCIATED WITH SUPPORTING OR RELOCATING THE POLES AND CABLES DURING CONSTRUCTION.
- WARNING--EXISTING UTILITY LINE LOCATIONS ARE SHOWN IN AN APPROXIMATE MANNER ONLY, AND SUCH LINES MAY EXIST WHERE NONE ARE SHOWN. THE LOCATION OF ANY SUCH EXISTING LINES IS BASED UPON INFORMATION PROVIDED BY THE UTILITY COMPANY, THE OWNER, OR BY OTHERS, AND THE INFORMATION MAY BE INCOMPLETE OR MAY BE OBSOLETE BY THE TIME CONSTRUCTION COMMENCES. THE ENGINEER HAS UNDERTAKEN NO FIELD VERIFICATION OF THE LOCATION, DEPTH, SIZE, OR TYPE OF EXISTING UNDERGROUND UTILITY LINES, MAKES NO REPRESENTATION PERTAINING THERETO, AND ASSUMES NO RESPONSIBILITY OR LIABILITY THEREFOR. THE CONTRACTOR SHALL INFORM ITSELF OF THE LOCATION OF ANY UTILITY LINE IN OR NEAR THE AREA OF THE WORK IN ADVANCE OF AND DURING EXCAVATION WORK. THE CONTRACTOR IS FULLY RESPONSIBLE FOR ANY AND ALL DAMAGE CAUSED BY ITS FAILURE TO LOCATE, IDENTIFY, AND PRESERVE ANY AND ALL EXISTING UTILITIES. THE CONTRACTOR SHALL COMPLY WITH STATE STATUTES, MUNICIPAL AND LOCAL ORDINANCES, RULES AND REGULATIONS PERTAINING TO THE LOCATION OF THESE LINES AND FACILITIES, IN PLANNING AND CONDUCTING EXCAVATION, WHETHER BY CALLING OR NOTIFYING THE UTILITIES, COMPLYING WITH "BLUE STAKES" PROCEDURES, OR OTHERWISE.
- ANY WORK OCCURRING WITHIN AN ARTERIAL ROADWAY REQUIRES 24 HR. CONSTRUCTION.
- ALL EXCAVATION, TRENCHING AND SHORING ACTIVITIES MUST BE ACCOMPLISHED IN ACCORDANCE WITH OSHA 29CFR 1926.650 SUBPART P.
- CONTRACTOR SHALL MAINTAIN THE WORK SITE. CONTRACTOR SHALL PROMPTLY REMOVE ANY AND ALL GRAFFITI FROM EQUIPMENT, WHETHER PERMANENT OR TEMPORARY.
- RCP SHALL BE INSTALLED SO THAT THE JOINT GAP AT THE HOME POSITION SHALL CONFORM TO THE APPROVED MANUFACTURER'S RECOMMENDATIONS. MANUFACTURER'S RECOMMENDED JOINT GAP TOLERANCES FOR EACH PIPE SIZE AND TYPE SHALL BE SUBMITTED TO THE ENGINEER FOR APPROVAL PRIOR TO PLACEMENT OF PIPE. RCP JOINTS SHALL NOT BE GROUTED UNLESS DIRECTED BY THE ENGINEER AFTER CITY APPROVAL.
- AN SO 19 PERMIT IS REQUIRED TO PLACE ANY MATERIAL ON OR AROUND A STORM DRAIN INLET IN THE CITY RIGHT-OF-WAY THAT WOULD INTERFERE WITH THE INLET RECEIVING STORM WATER PER THE ENGINEER'S DESIGN. CITY PERSONNEL MAY REMOVE THIS MATERIAL AT ANY TIME WITHOUT NOTICE. THE PREFERRED BMP IS TO REMOVE SEDIMENT/POLLUTANTS ON THE PROPERTY WHERE CONSTRUCTION ACTIVITY IS OCCURRING.
- CONTRACTOR SHALL BE RESPONSIBLE FOR PROVIDING & MAINTAINING ALL CONSTRUCTION SIGNING UNTIL PROJECT HAS BEEN ACCEPTED BY THE COA.

CITY OF ALBUQUERQUE PLANS FOR CONSTRUCTION

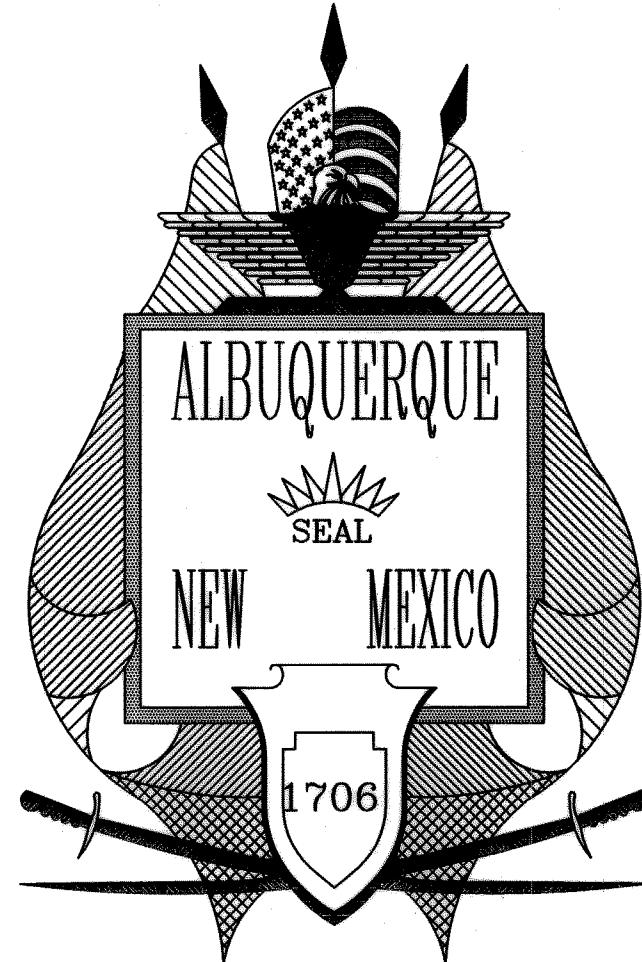



SUNDORO UNIT 9 SUBDIVISION INDEX OF SHEETS

SHEET #	DESCRIPTION
1	TITLE SHEET
2	PLAT
3	GRADING & DRAINAGE PLAN
4	TYPICAL SECTIONS
5	OVERALL PAVING LAYOUT
6	ENDEE ROAD PAVING PLAN & PROFILE
7	ZIMINA DR.-SILICA AVE. PAVING PLAN & PROFILE
8	EKARMA DR. PAVING PLAN & PROFILE
9	94TH STREET PAVING PLAN & PROFILE
10	OVERALL UTILITY LAYOUT
11	ZIMINA DR.-SILICA AVE. UTILITY PLAN & PROFILE
12	EKARMA DR. UTILITY PLAN & PROFILE

SURVEYORS CERTIFICATION

I, Russ P. Hugg, New Mexico Professional Surveyor Number 9750, hereby certify that the as-built information shown hereon is the result of an actual field survey performed by me or under my direct supervision and that the same is true and correct to the best of my knowledge and belief.

Russ P. Hugg
NMPs No. 9750
2/27 2013

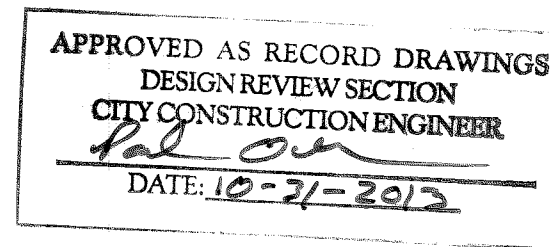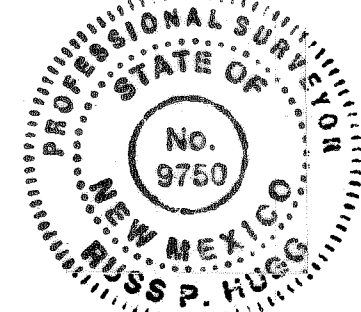

DRB NO. 1003612

VICINITY
MAP




ZONE ATLAS MAP J-9-Z

I, DAVID SOULE, NMPE 14522, OF THE FIRM RIO GRANDE ENGINEERING, HEREBY CERTIFY THAT TO THE BEST OF MY KNOWLEDGE AND BELIEF, THE INFRASTRUCTURE INSTALLED AS A PART OF THIS PROJECT HAS BEEN INSPECTED BY ME OR A QUALIFIED PERSON UNDER MY DIRECT SUPERVISION AND HAS BEEN CONSTRUCTED IN ACCORDANCE WITH THE PLANS AND SPECIFICATIONS APPROVED BY THE CITY AND ABCWUA ENGINEER AND THAT THE ORIGINAL DESIGN INTENT HAS BEEN MET, EXCEPT AS NOTED BY ME OR PERSONNEL UNDER MY DIRECTION AND SURVEY INFORMATION PROVIDED BY SURV-TEK NMPs 9750.




ALL SWPPP SHALL BE OUTSIDE OF ROW
PRIOR TO COA ACCEPTANCE.

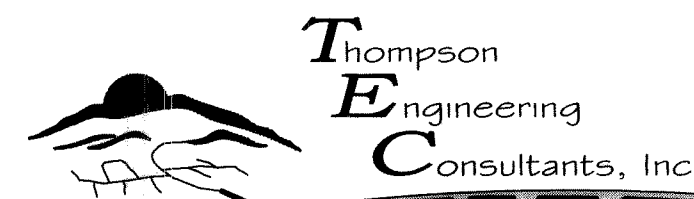

P.O. BOX 65760
ALBUQUERQUE, NM 87193
PHONE: (505) 271-2199
FAX: (505) 830-9246

REV.	SHEETS	CITY ENGINEER	DATE	USER DEPARTMENT	DATE	USER DEPARTMENT	DATE
ENGINEERS STAMP & SIGNATURE		APPROVED	ENGINEER	DATE	APPROVED FOR CONSTRUCTION		
		DRC Chairman	<i>David Soule</i>	7/13/11			
		Transportation	<i>David Soule</i>	7/13/11			
		Water/Wastewater	<i>David Soule</i>	7/13/11			
		Hydrology	<i>David Soule</i>	7/13/11			
		CIP	<i>David Soule</i>	7/13/11			
AMAFCA		6/5/2013					
Constr. Coord.		CITY ENGINEER DATE					
PROJECT NUMBER		DRAWING NO. 1 OF 12					
7270.80							

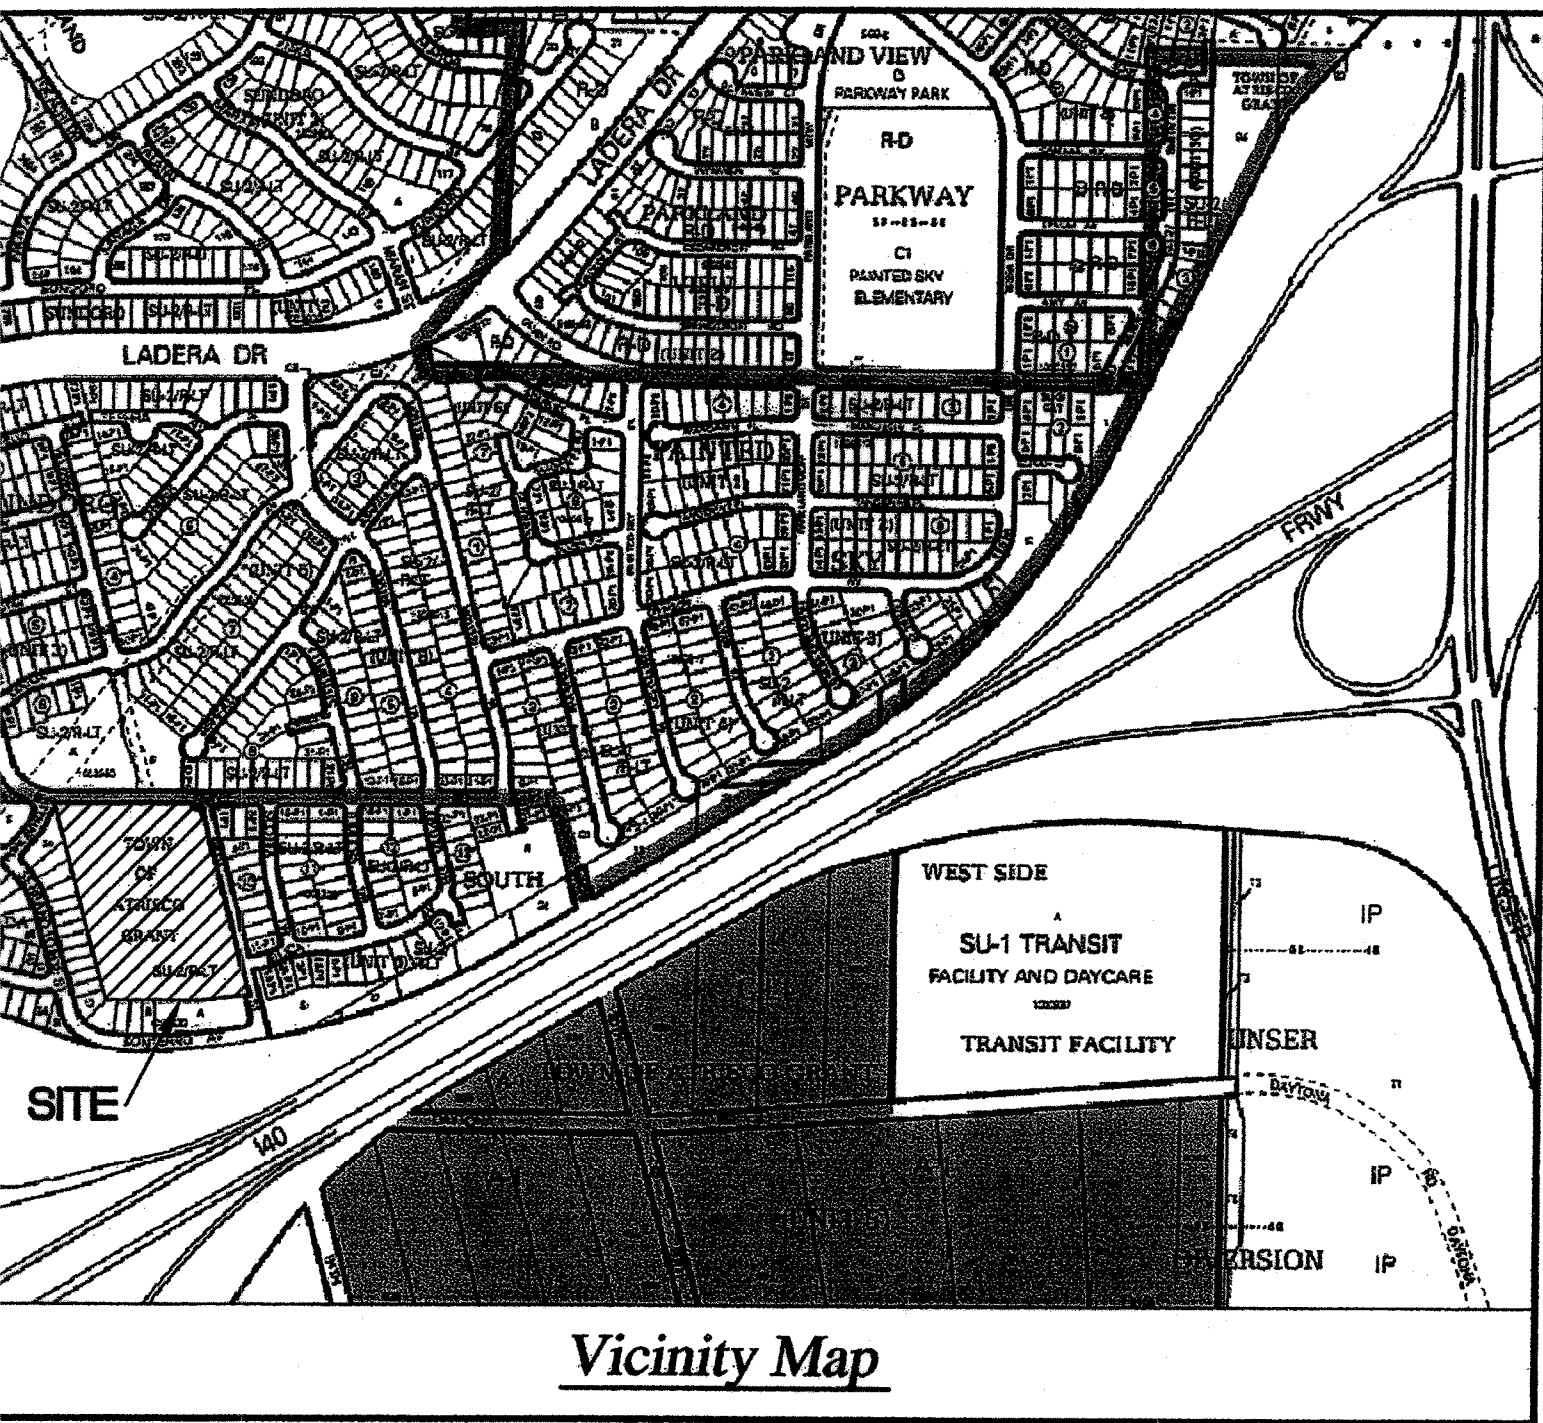

Vicinity Map

Easement Notes

- A** 10' P.U.E. GRANTED WITH THE FILING OF THIS PLAT
- B** EXISTING TEMPORARY DRAINAGE EASEMENT (10/30/06, 2006C-332)
- C** EXISTING 2' PRIVATE DRAINAGE EASEMENT (9/13/05, 2005C-302)
- D** EXISTING PUBLIC SIDEWALK EASEMENT 20' RADIUS (5/15/06, 2006C-152)

Benchmark

ACS MONUMENT "REWARD" HAVING AN ELEVATION OF 5319.688 (NAVD 88).

Legend

N 90°00'00" E	MEASURED BEARING AND DISTANCES
●	FOUND MONUMENT AS INDICATED
▲	SET CENTERLINE MONUMENT
⊙	FOUND CENTERLINE MONUMENT
⊙	UNLESS INDICATED OTHERWISE
1-P1	LOT NUMBER


L1	14.78'	S 14°59'14" E
L2	31.08'	N 89°48'35" W
L3	30.32'	N 83°24'11" E
L4	0.29'	S 14°59'14" E
L5	24.83'	N 00°11'55" E
L6	9.00'	N 00°11'55" E
L7	14.00'	N 40°31'34" E
L8	28.69'	N 81°13'42" E
L9	38.33'	N 06°14'47" E
L10	23.15'	N 00°11'55" E
L11	9.00'	N 00°11'55" E
L12	20.73'	N 15°11'39" W
L13	9.32'	S 15°11'39" E
L14	4.25'	S 15°11'39" E
L15	5.30'	N 15°11'39" W
L16	20.90'	S 15°11'39" E
L17	6.66'	S 83°45'13" E
L18	14.21'	N 89°40'09" W
L19	8.07'	S 89°40'09" E
L20	23.65'	N 81°13'42" E
L21	23.75'	N 83°24'11" E
L22	6.57'	N 83°24'11" E
L23	2.04'	N 81°13'42" E
L24	2.04'	N 81°13'42" E

CURVE	LENGTH	RADIUS	DELTA	CHORD	BEARING
C1	40.30'	150.00'	15°23'34"	40.18'	S 07°29'52" E
C2	44.87'	75.00'	34°16'47"	44.21'	S 32°20'02" E
C3	89.74'	75.00'	68°33'34"	84.48'	S 49°28'26" E
C4	44.87'	75.00'	34°16'47"	44.21'	S 66°36'49" E
C5	20.81'	477.00'	2°30'00"	20.81'	S 89°00'19" E
C6	54.13'	477.00'	6°30'06"	54.10'	S 87°00'16" E
C7	33.32'	477.00'	4°00'06"	33.31'	S 85°45'16" E
C8	37.16'	250.00'	8°30'59"	37.13'	N 85°29'12" E
C9	56.13'	150.00'	21°26'26"	55.80'	N 04°28'26" W
C10	40.30'	150.00'	15°23'34"	40.18'	S 07°29'52" E
C11	7.05'	25.00'	16°08'56"	7.02'	S 82°07'06" W
C12	32.56'	25.00'	74°36'47"	30.30'	N 52°30'02" W
C13	17.65'	25.00'	40°27'18"	17.29'	N 05°02'00" E
C14	104.35'	40.00'	149°28'10"	77.18'	S 49°28'26" E
C15	17.65'	25.00'	40°27'18"	17.29'	S 76°01'08" W
C16	56.74'	500.00'	6°30'06"	56.71'	S 87°00'16" E
C17	32.75'	25.00'	75°03'40"	30.46'	N 52°43'29" W
C18	33.74'	227.00'	8°30'59"	33.71'	N 85°29'12" E
C19	40.22'	25.00'	92°10'34"	36.02'	S 44°10'02" E
C20	51.68'	173.00'	17°06'54"	51.49'	N 06°38'12" W
C21	44.42'	25.00'	101°47'58"	38.80'	S 35°42'20" W
C22	32.56'	25.00'	74°36'47"	30.30'	N 52°30'02" W
C23	36.91'	127.00'	16°39'15"	36.79'	N 06°52'02" W
C24	41.36'	25.00'	94°47'12"	36.80'	N 48°51'12" E
C25	62.22'	52.00'	68°33'34"	58.58'	S 49°28'26" E
C26	45.98'	25.00'	105°23'13"	39.77'	S 37°29'58" W
C27	33.39'	173.00'	11°03'28"	33.34'	N 09°39'55" W
C28	18.29'	173.00'	6°03'26"	18.28'	N 01°06'28" W
C29	7.92'	25.00'	18°09'37"	7.89'	N 06°06'51" W
C30	9.73'	25.00'	22°17'41"	9.67'	N 14°06'49" E
C31	35.94'	40.00'	51°29'10"	34.75'	S 00°28'56" E
C32	21.70'	40.00'	31°04'53"	21.43'	S 41°45'58" E
C33	22.55'	40.00'	32°17'58"	22.25'	S 73°27'23" E
C34	24.16'	40.00'	34°36'09"	23.79'	N 73°05'34" E
C35	1.16'	500.00'	0°07'58"	1.16'	S 83°49'11" E
C36	54.13'	500.00'	6°12'12"	54.11'	S 86°59'16" E
C37	1.45'	500.00'	0°09'57"	1.45'	N 89°49'40" E

Disclosure Statement

THE PURPOSE OF THIS PLAT IS TO:

1. CREATE 53 RESIDENTIAL LOTS.
2. DEDICATE ADDITIONAL RIGHT-OF-WAY FOR 94TH STREET N.W. AND ENDEE ROAD, N.W..
3. DEDICATE RIGHT OF WAY FOR EKARMA DRIVE., NW, ZIMINA DRIVE., NW, AND SILICA AVENUE, NW.
4. GRANT EASEMENTS.
5. VACATE A PORTION OF 94TH STREET N.W.
6. LOT LINES TO BE ELIMINATED SHOWN AS THUS... ..

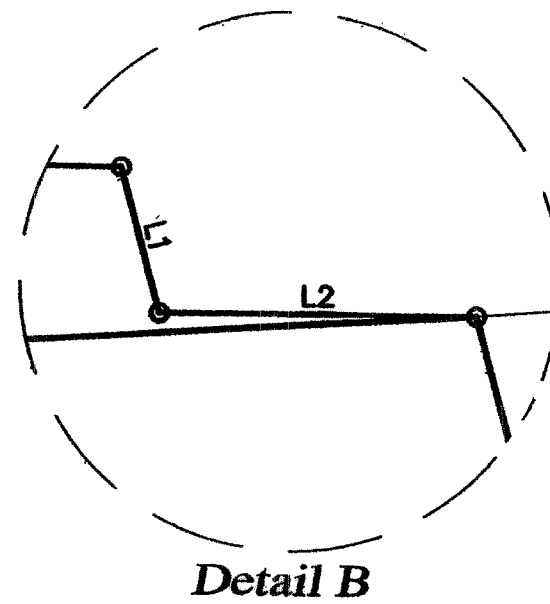

Detail B

Preliminary Plat

Sundoro Unit 9

within
Projected Section 16, Township 10 North, Range 2 East, NMPM
Town of Atrisco Grant
City of Albuquerque, Bernalillo County, New Mexico
March 2011

ACS Monument "3_H10"
NAD 1983 CENTRAL ZONE
X=1497135.488
Y=1493985.681
Z=5196.151 (NAVD 1988)
G-G=0.999678906
Mapping Angle=-0°16'31.81"

Legal

A CERTAIN TRACT OF LAND WITHIN PROJECTED SECTION 16, TOWNSHIP 10 NORTH, RANGE 2 EAST, NMPM, TOWN OF ATRISCO GRANT, TOGETHER WITH A VACATED PORTION OF 94TH STREET, N.W., COUNTY OF BERNALILLO, CITY OF ALBUQUERQUE NEW MEXICO AND BEING DESCRIBED BY METES AND BOUNDS AS FOLLOWS:

BEGINNING AT A POINT ON THE SOUTHERLY RIGHT OF WAY OF ENDEE ROAD, N.W., WHENCE A TIE TO THE ACS MONUMENT "3_H10" BEARS, N 39°07'50" E, A DISTANCE OF 6832.80 FEET;

THENCE, S 14°59'14" E, A DISTANCE OF 14.78 FEET TO AN ANGLE POINT;

THENCE, S 89°48'35" E, A DISTANCE OF 31.08 FEET TO AN ANGLE POINT;

THENCE, S 14°59'14" E, A DISTANCE OF 619.32 FEET TO AN ANGLE POINT;


THENCE, S 83°24'11" W, A DISTANCE OF 30.32 FEET TO AN ANGLE POINT;

THENCE, N 14°59'14" W, A DISTANCE OF 0.29 FEET TO AN ANGLE POINT;

THENCE, N 89°40'09" W, A DISTANCE OF 467.57 FEET TO AN ANGLE POINT, BEING THE SOUTHWEST CORNER OF THE HEREIN DESCRIBED TRACT;

THENCE, N 15°11'39" W, A DISTANCE OF 636.99 FEET TO THE NORTHWEST CORNER OF THE HEREIN DESCRIBED TRACT;


THENCE, S 89°48'26" E, A DISTANCE OF 469.64 FEET TO THE POINT OF BEGINNING, CONTAINING 7.0386 ACRES (306,601 SQ. FT.) MORE OR LESS.

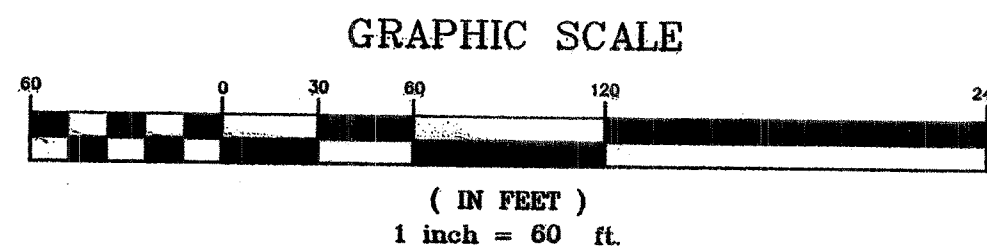

Record Drawing

CARTESIAN SURVEYS INC.





P.O. BOX 44414 RIO RANCHO, N.M. 87174
Phone (505) 896-3050 Fax (505) 891-0244

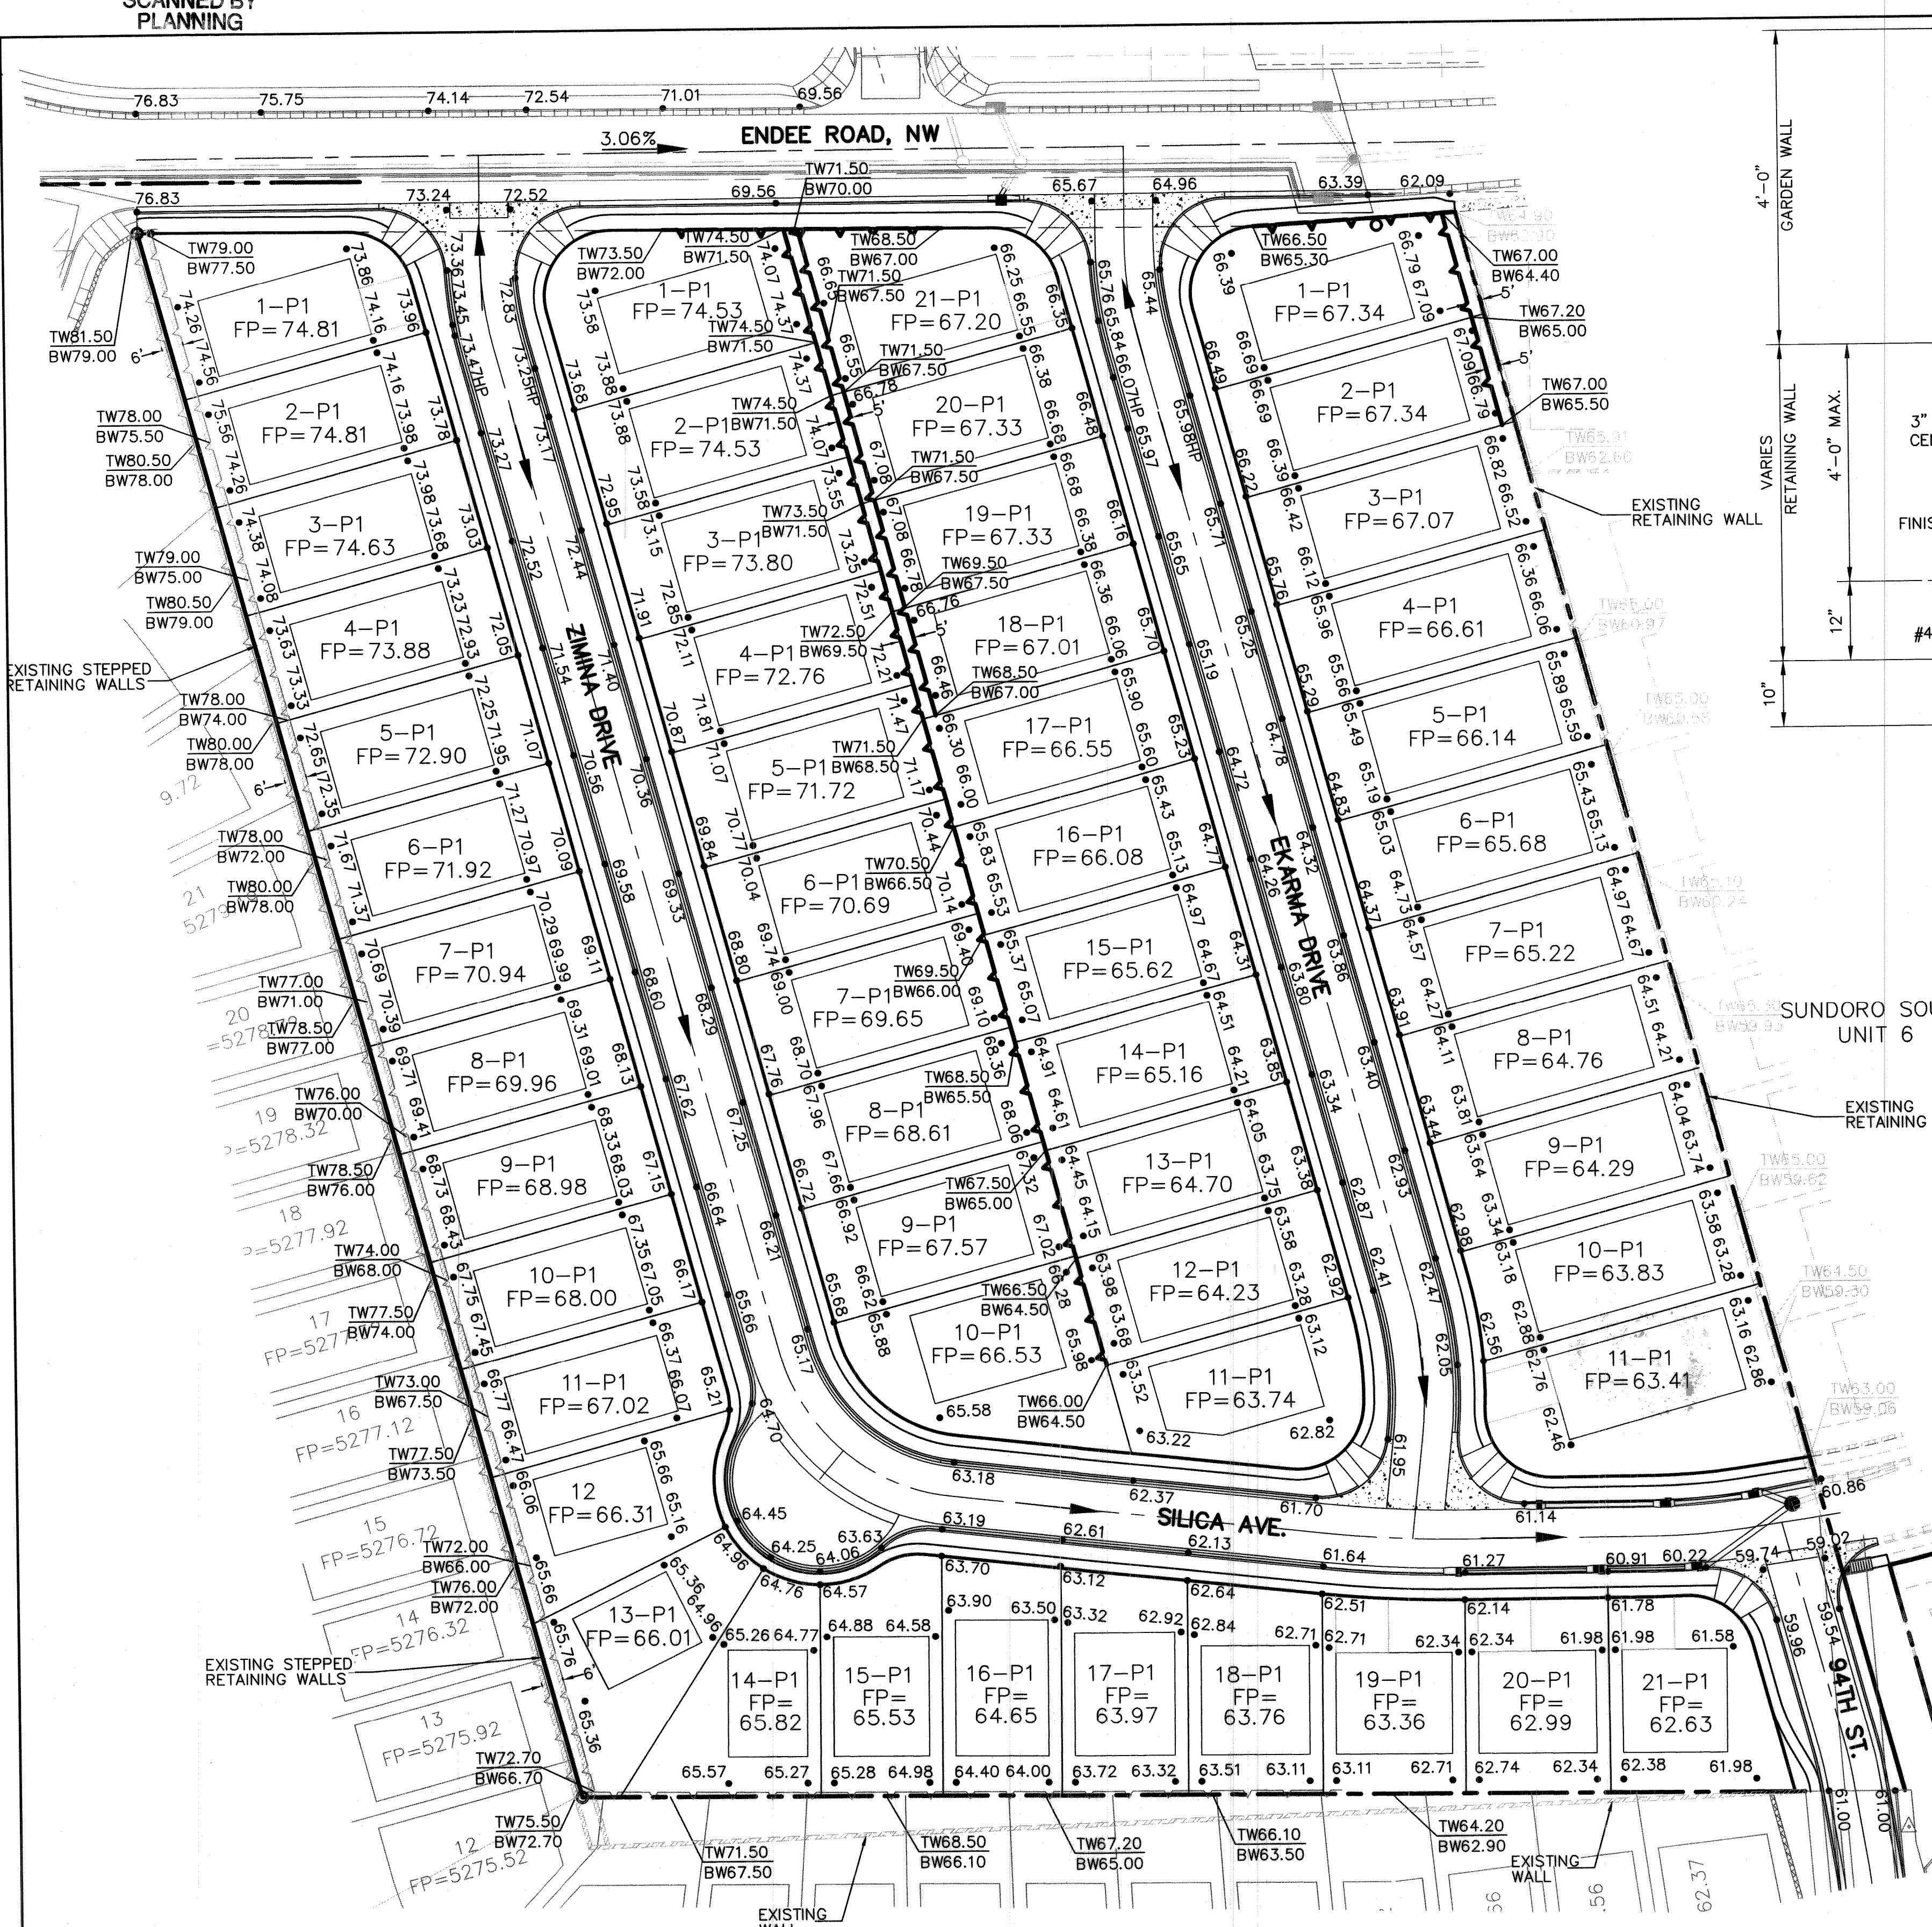

LEGEND

FP=09.07	FINISHED PAD SITE ELEVATION	●	PROPOSED MANHOLE
60.23	PROPOSED SPOT ELEVATION	—	PROPOSED STORM DRAIN
TC=12.51	TOP OF CURB AND FLOWLINE ELEVATIONS	—	PROPOSED STANDARD CURB AND GUTTER
FL=11.84		—	PROPOSED MOUNTABLE CURB AND GUTTER
	EXISTING MAJOR CONTOUR	—	PROPOSED BASIN BOUNDARY
	EXISTING MINOR CONTOUR	—	PROPOSED INLET
	PROPOSED BASIN NUMBER	100	PROPOSED WHEEL CHAIR RAMPS
	PROPOSED RETAINING WALL		

NOTE:
THE TOTAL HEIGHT OF ANY WALL, INCLUDING RETAINING WALL, SHALL NOT EXCEED 8 FEET.

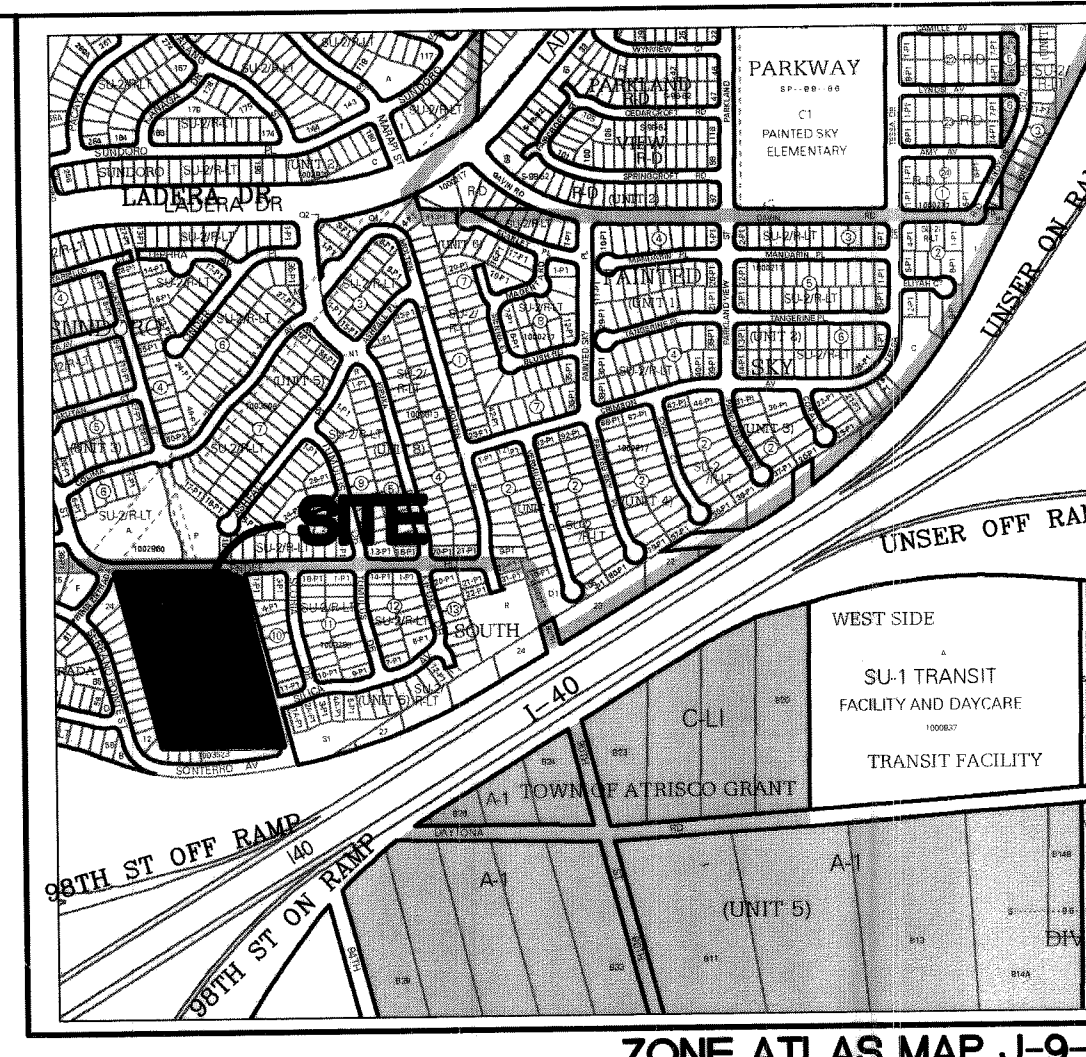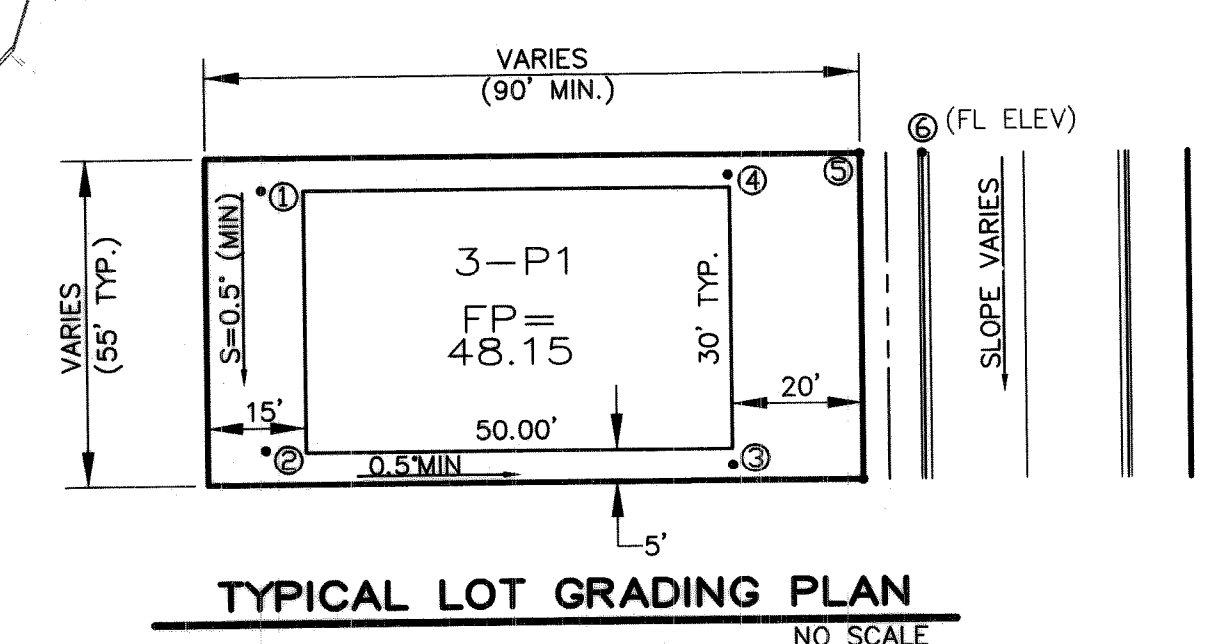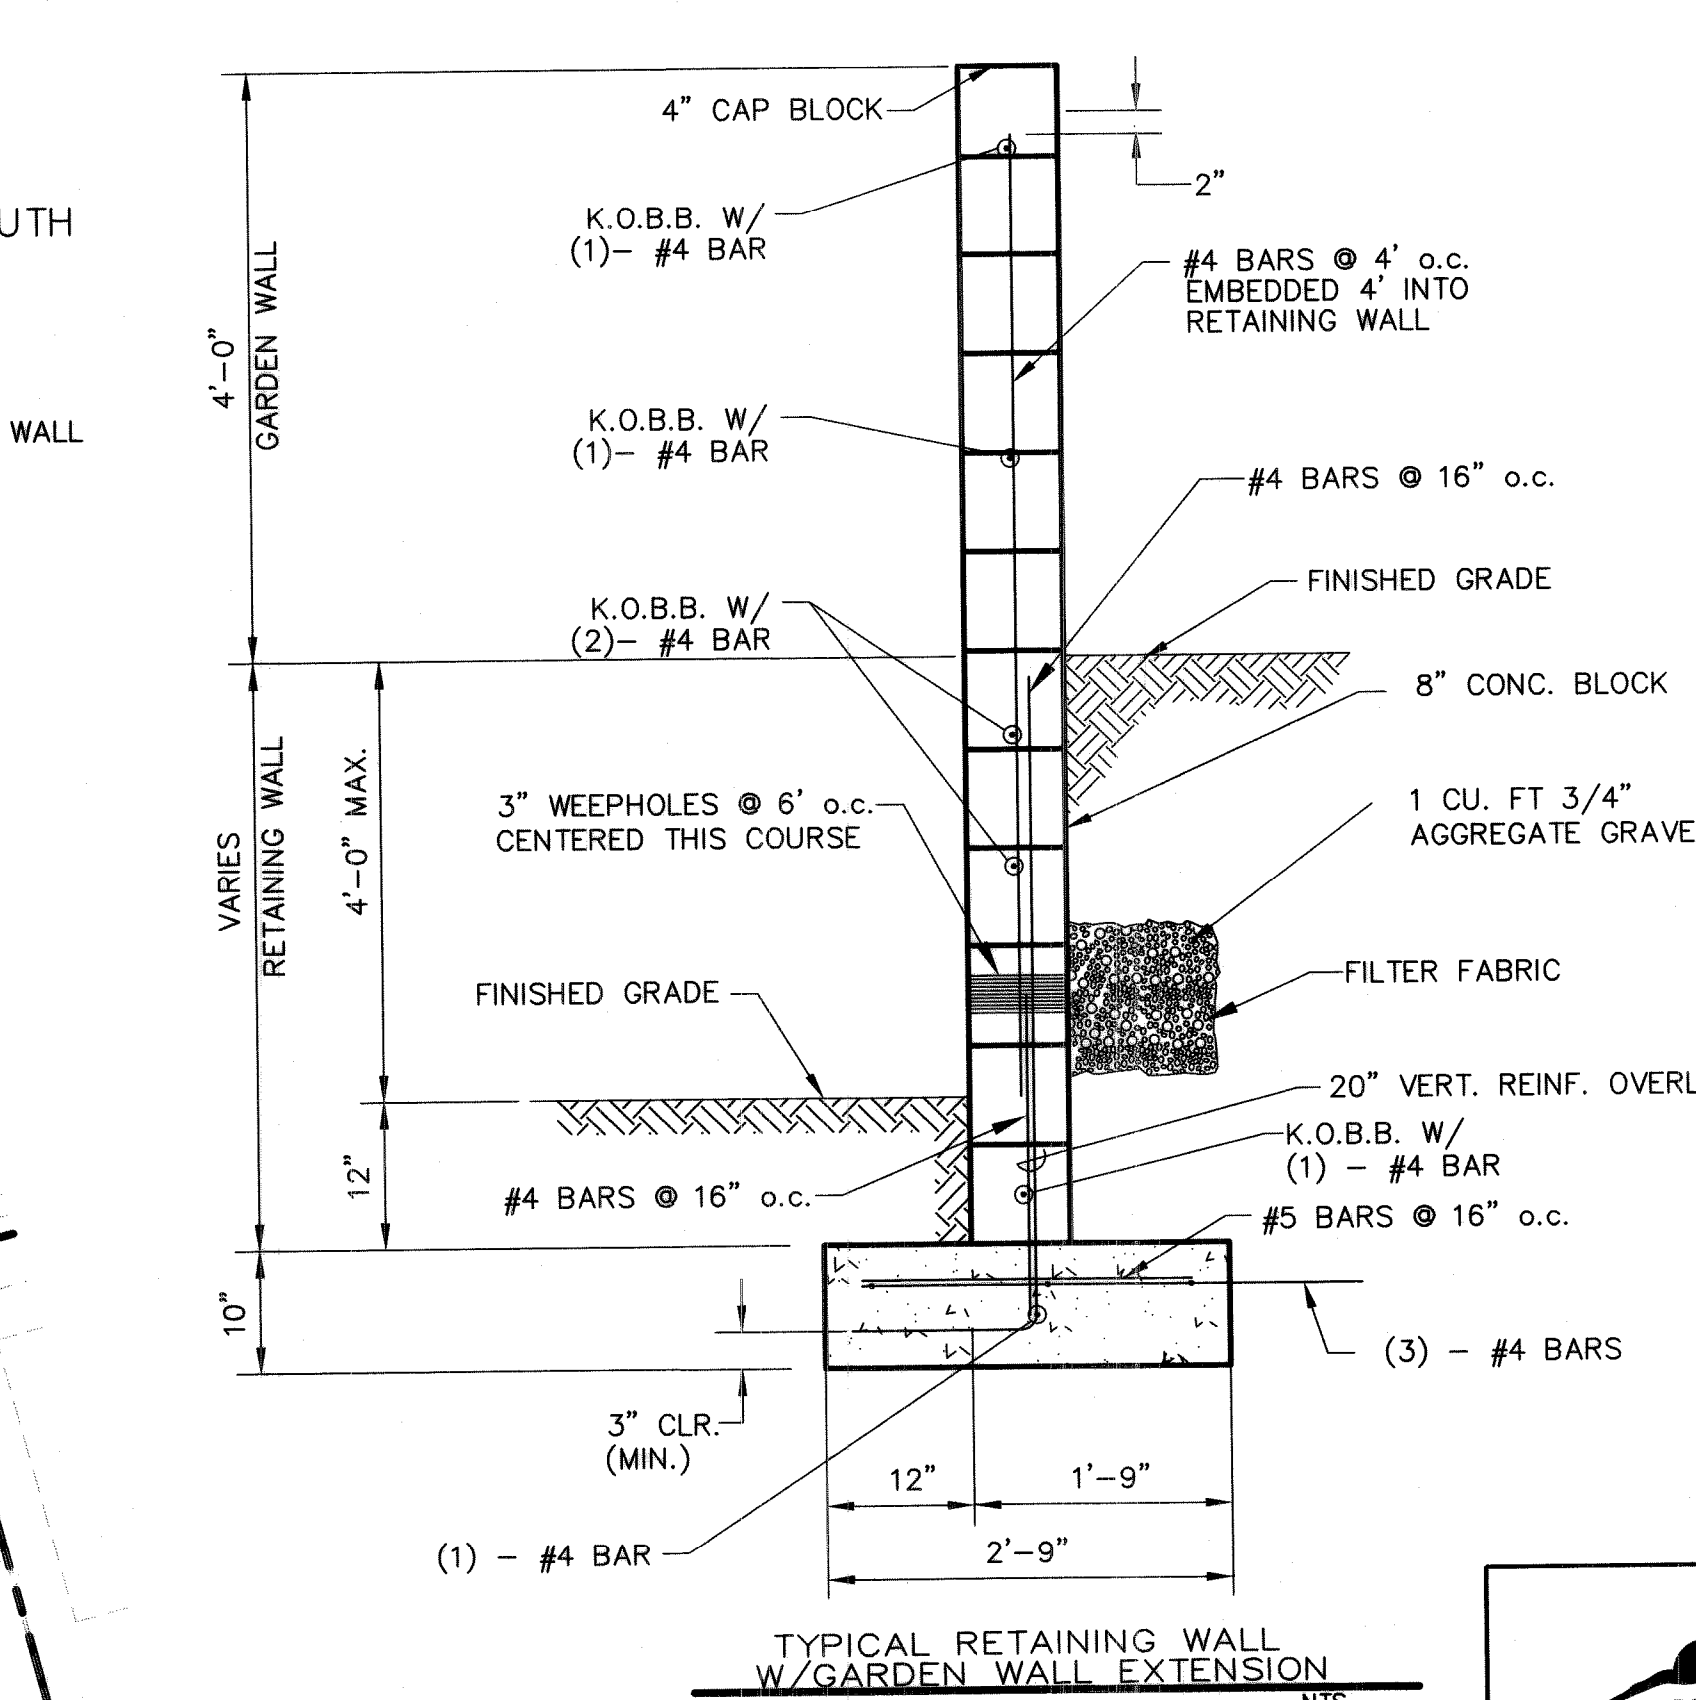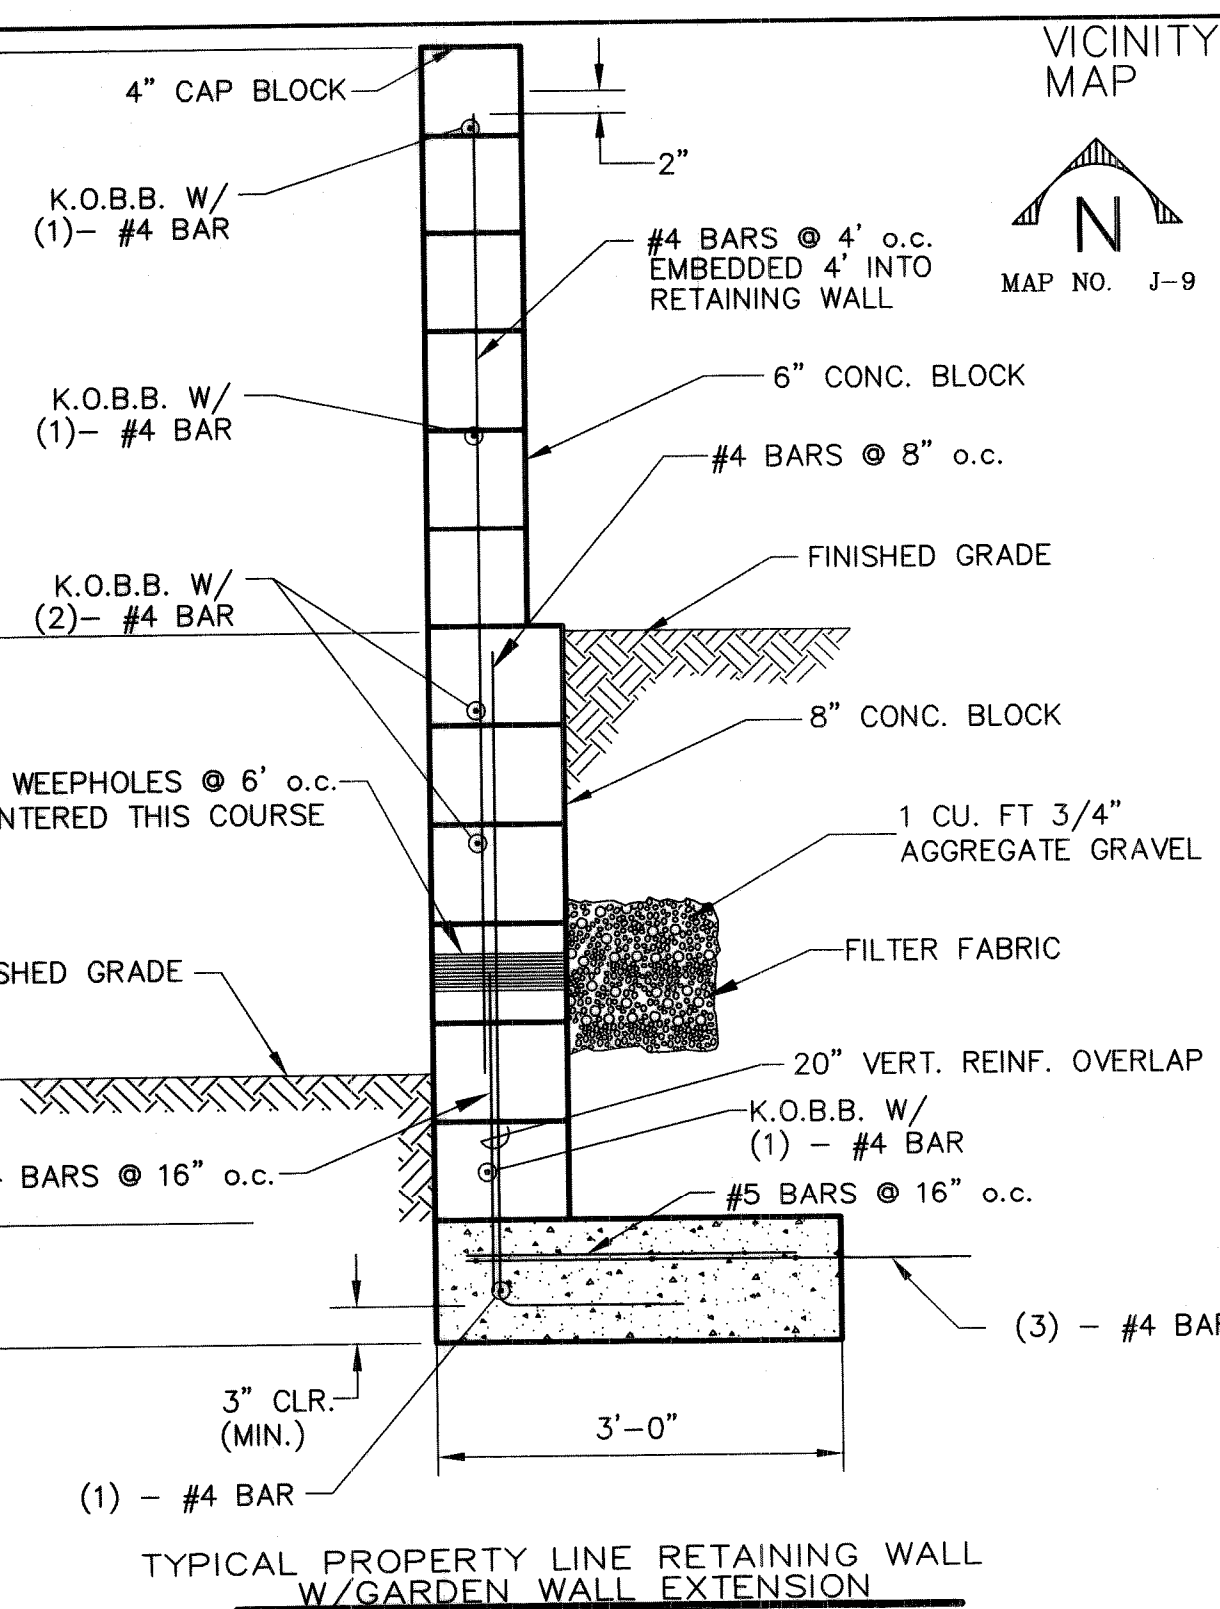

Record Drawing

SCALE: 1"=40'

Thompson Engineering Consultants, Inc.
P.O. BOX 65760 ALBUQUERQUE, NM 87193
PHONE: (505) 271-2199 FAX: (505) 650-9428
tec@thompsoneng.com

CITY OF ALBUQUERQUE PUBLIC WORKS DEPARTMENT TRANSPORTATION DEVELOPMENT		SUNDORO UNIT 9 GRADING AND DRAINAGE PLAN	
DESIGN REVIEW COMMITTEE	CITY ENGINEER APPROVAL	MO./DAY/YR.	MO./DAY/YR.
FOR INFORMATION ONLY			
City Project No. 7270.80	Zone Map No. J-9-Z	SHEET 3	OF 12

AS BUILT INFORMATION		BENCH MARKS		SURVEY INFORMATION		ENGINEER'S SEAL		REMARKS		DESIGN	
CONTRACTOR	DATE	NGS MONUMENT	DATE	NO.	BY	NO.	DATE	NO.	DATE	NO.	DATE
SALES	DATE	350994.85	DATE								
SALES	DATE	1487501.42	DATE								
SALES	DATE	Ground to Grid Factor:	DATE								
SALES	DATE	0.99867114	DATE								
SALES	DATE	Δg = -00' 17" 11"	DATE								
SALES	DATE	NMSP CENTRAL ZONE	DATE								
SALES	DATE	NAD 1927	DATE								
SALES	DATE	ELEVATION=5316.95 (NGVD 29)	DATE								

MOUNTABLE CURB & GUTTER (TYP) PER COA STD DWG 2415A

12"

LIP OF GUTTER

12"

ROADWAY SUBGRADE

12"

1-1/2" ASPHALTIC SURFACE COURSE (TYPE C)

TACK COAT BETWEEN LIFTS (IF REQ'D)

1-1/2" ASPHALTIC BASE COURSE (TYPE C)

1' SUBGRADE SOIL, R-VALUE ≥ 50

COMPACTED TO 95%. SOIL NOT HAVING THE MINIMUM R-VALUE OF 50 SHALL BE REMOVED TO A DEPTH OF 2 FT. AND REPLACED, BY THE CONTRACTOR, WITH SUITABLE MATERIAL OR A PAVEMENT SECTION SHALL BE DESIGNED BY CONSULTANT ACCOMMODATING THE EXISTING R-VALUE PER COA STANDARD SPECIFICATIONS.



SUBGRADE COMPACTED TO 90%

Diagram illustrating the proposed 46' R/W (Right-of-Way) cross-section. The layout includes:


- 46' R/W (Total Right-of-Way)
- 26' F-F (Face-to-Face) section
- 13' DRIVE LANE (each side)
- 4' SIDE WALK (each side)
- 2% cross-slope for all outer edges

PAVING SECTION SEE STD
PER DETAIL ON THIS SHEET


PROPOSED 4" THICK P.C.C. SIDEWALK
PER COA STD DWG# 2430 OVER
12" SUBGRADE COMPACTED TO 95% MIN.
AND PER SECTION 301.4.1.2
RB & GUTTER
DWG# 2415A (TYP)

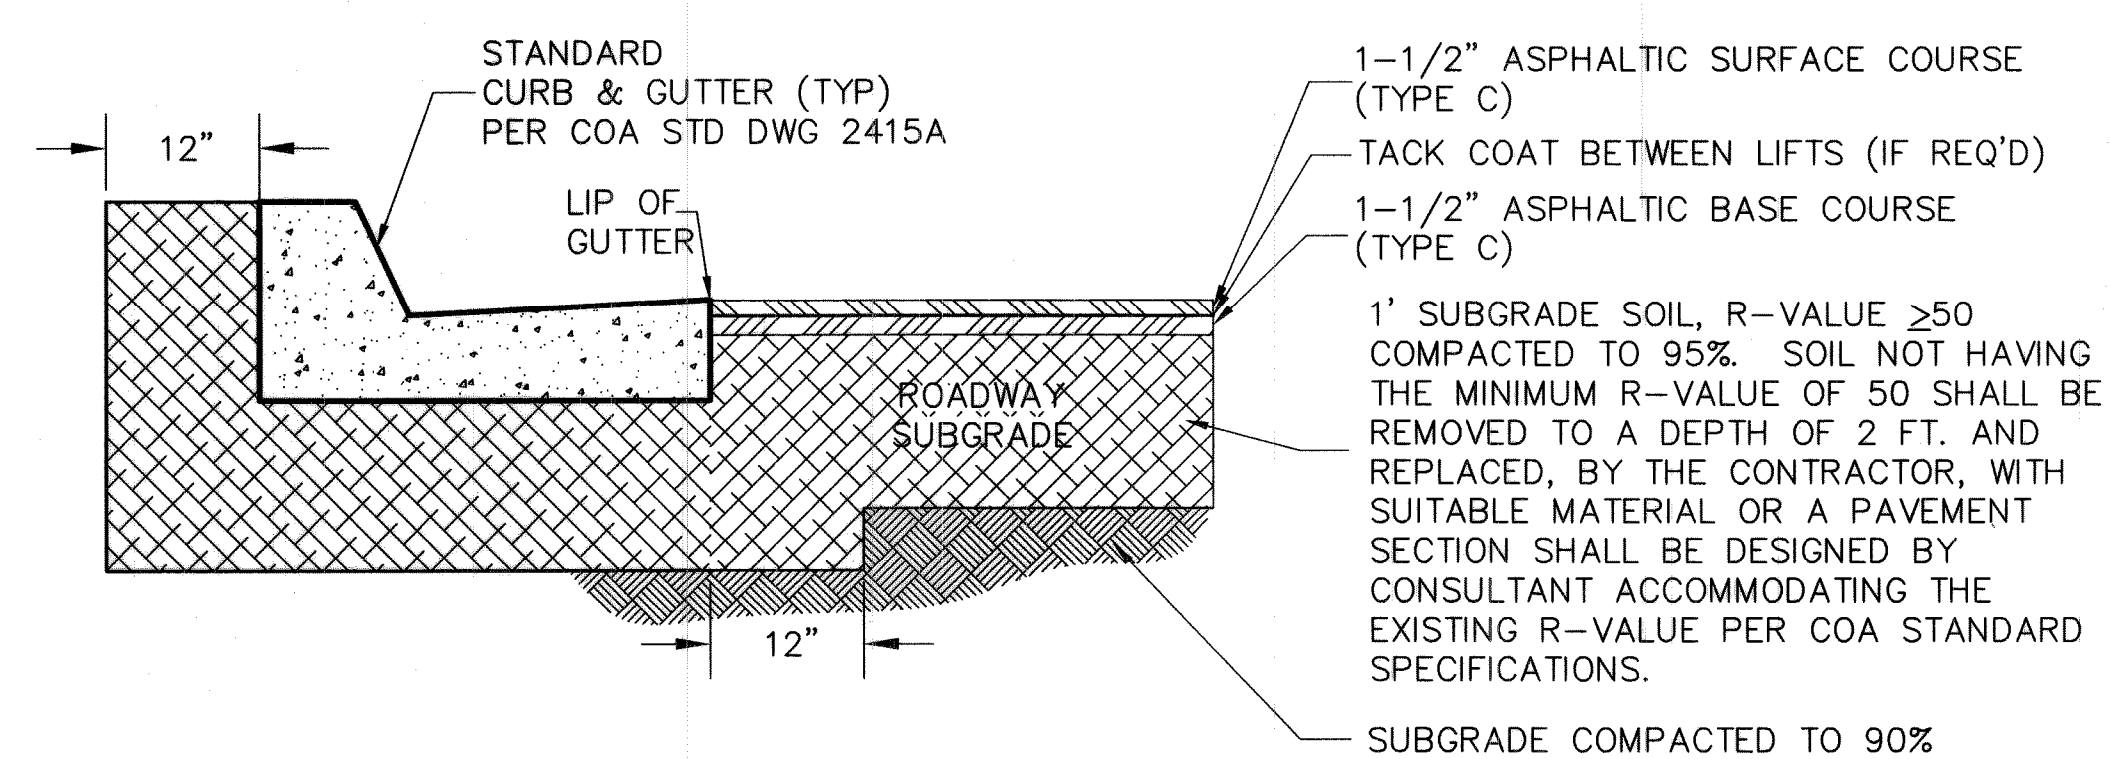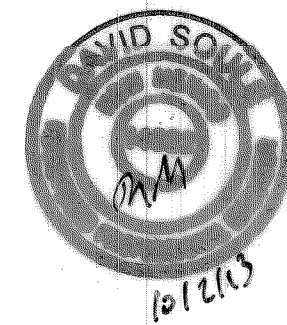


SEE STD
PAVING SECTION
PER DETAIL ON THIS SHEET

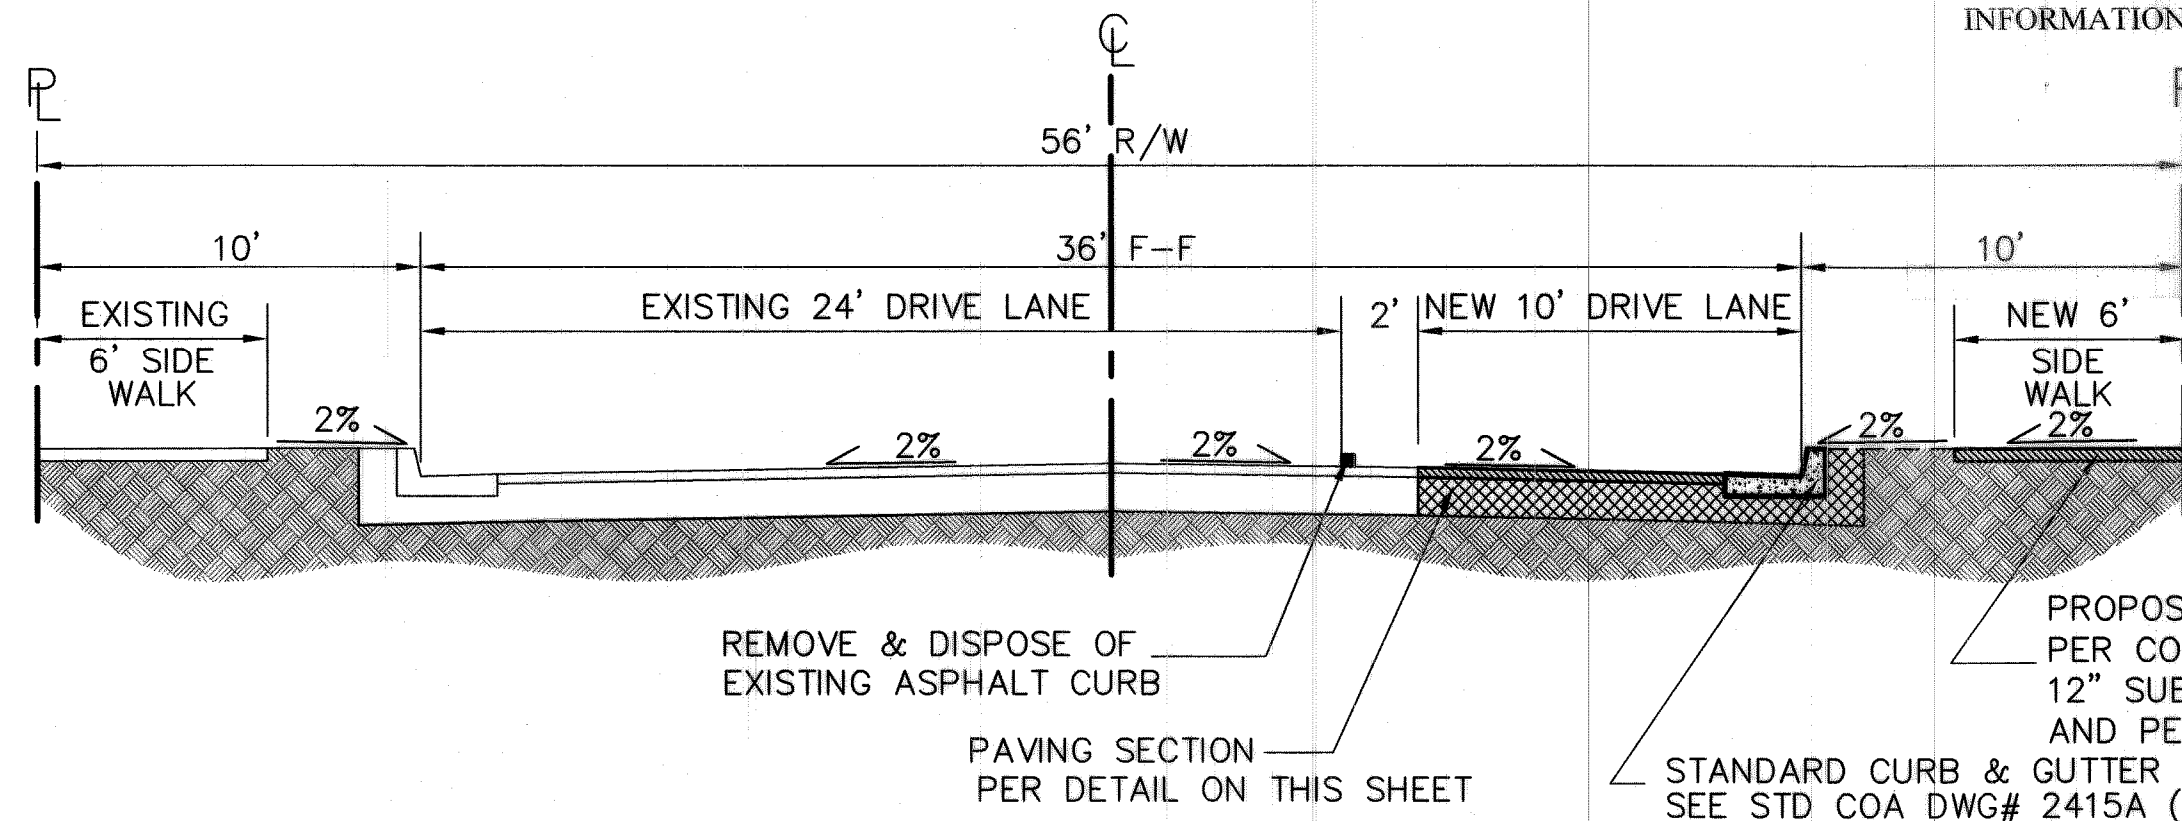


NTS

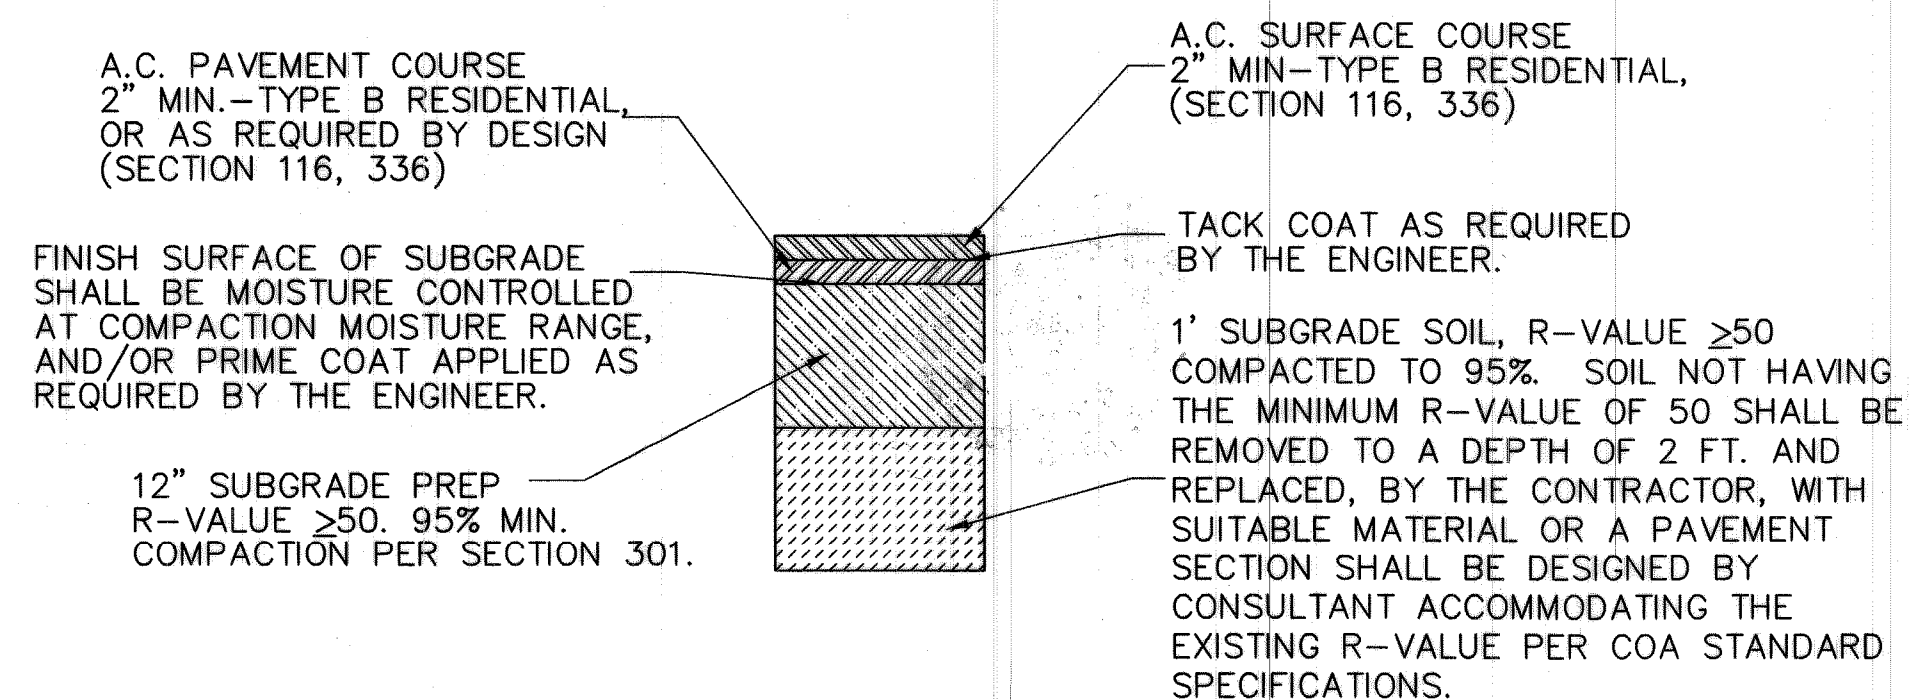

ENDEE ROAD PAVEMENT SECTION (COA STD DWG 2405B)
SEE COA PROJECT 7270.81 NTS

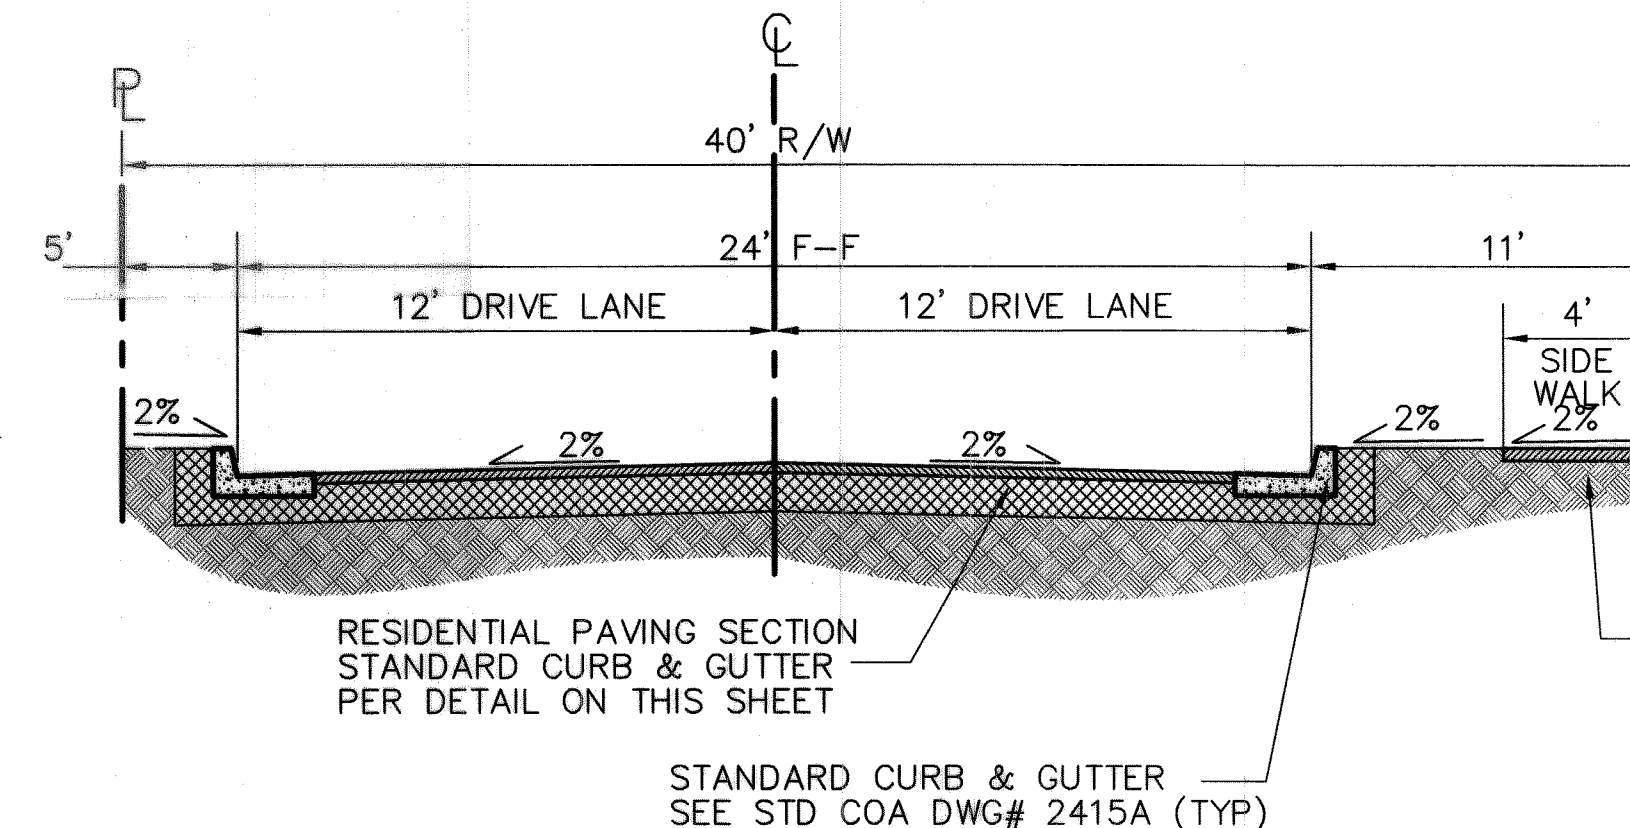

NTS

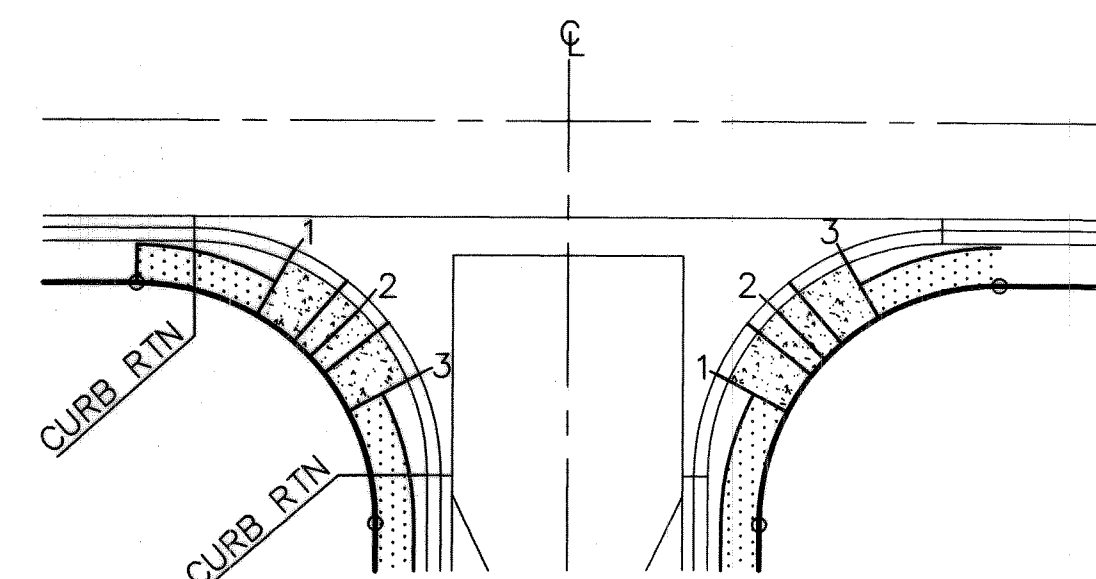

NOTE:
QUARTER POINT GRADES ARE REFERENCED AS 1, 2, & 3
ALONG THE FACE OF CURB IN A CLOCKWISE DIRECTION.

NTS

[illegible]

EXISTING CONDITIONS
SEE SUNDORO SOUTH -UNITS 1 & 3
COA PROJECT 727081

SAWCUT NICE NEAT LINE
REMOVE & DISPOSE OF 10'
EXISTING ASPHALT AND C&G
REPLACE W/10' PAVEMENT
AND STANDARD C&G
MATCH TO EXISTING PVMT SECTION
SEE TYPICAL SECTION SHEET 4

PROPOSED 6' VALLEY GUTTER
SEE COA STD DWG 2420

PROPOSED 6' SIDEWALK
SEE COA STD DWG 2430

PROPOSED HANDICAP RAMP
CASE II (W/TRUNCATED DOME)
TRANSITION FROM MOUNTABLE TO
STANDARD CURB AS PER 2418

PROPOSED 6' SIDEWALK
SEE COA STD DWG 2430

PROPOSED HANDICAP RAMP
CASE II (W/TRUNCATED DOME)
TRANSITION FROM MOUNTABLE TO
STANDARD CURB AS PER 2418

SAWCUT NICE NEAT LINE
REMOVE & DISPOSE OF 10'
EXISTING ASPHALT AND C&G
REPLACE W/10' PAVEMENT
AND STANDARD C&G
MATCH TO EXISTING PVMT SECTION
SEE TYPICAL SECTION SHEET 4

EXISTING CONDITIONS
SEE SUNDORO SOUTH -UNIT 5
COA PROJECT 727084

PROPOSED 6' SIDEWALK
SEE COA STD DWG 2430

PROPOSED STANDARD C & G
SEE COA STD DWG 2415A

PROPOSED HANDICAP RAMP
CASE II (W/TRUNCATED DOME)
TRANSITION FROM MOUNTABLE TO
STANDARD CURB AS PER 2418

DEFERRED 4' SIDEWALK
SEE COA STD DWG 2430

PROPOSED MOUNTABLE C & G
SEE COA STD DWG 2415A

PRIMA ENTRADA SUBDIVISION
SEE COA PROJECT #784481

PROPOSED 4' VALLEY GUTTER
SEE COA STD DWG 2421

I DAVID SOULE, NMPE 14522, OF THE FIRM RIO GRANDE ENGINEERING, HEREBY
CERTIFY THAT TO THE BEST OF MY KNOWLEDGE AND BELIEF, THE INFRASTRUCTURE
INSTALLED AS A PART OF THIS PROJECT HAS BEEN INSPECTED BY ME OR A
QUALIFIED PERSON UNDER MY DIRECT SUPERVISION AND HAS BEEN CONSTRUCTED
IN ACCORDANCE WITH THE PLANS AND SPECIFICATIONS APPROVED BY THE CITY
AND ABCWUA ENGINEER AND THAT THE ORIGINAL DESIGN INTENT HAS BEEN MET,
EXCEPT AS NOTED BY ME OR PERSONNEL UNDER MY DIRECTION AND SURVEY
INFORMATION PROVIDED BY SURV-TEK NMPS 9750.

NOTE:

- FOR TYPICAL SECTIONS
SEE SHEET 4 OF THIS PLANSET
- USE ALL C.O.A. STANDARDS UNLESS
OTHERWISE NOTED.
- TRUNCATED DOMES (DETECTABLE WARNING SURFACE)
DESIGN PER ADA GUIDELINES. SUBMIT SPEC.'S TO
CONSTRUCTION ENGINEER FOR EVALUATION PRIOR
TO CONSTRUCTION.



PRIMA ENTRADA SUBDIVISION
SEE COA PROJECT #784481

CL OF 94TH ST.
SEE TYP. SEC. SHT 4

GRAPHIC SCALE



NOTE:

- ① 18' DRIVE PADS ARE SHOWN FOR LOCATION ONLY.
REMAINDER DRIVE PADS TO BE 20' OTHERWISE
NOTED. CONSTRUCTION OF DRIVE PADS ARE NOT
INCLUDED IN WORK ORDER.

LEGEND

- PROPOSED STORM DRAIN
- PROPOSED STORM DRAIN MANHOLE
- PROPOSED STORM INLETS
- PROPOSED STREET LIGHT LOCATION
- CENTERLINE OF STREET
- PROPOSED PROPERTY BOUNDARY
- PROPOSED MOUNTABLE CURB & GUTTER
SEE COA STD DWG 2415A
- PROPOSED STANDARD CURB & GUTTER
SEE COA STD DWG 2415A
- PROPOSED SIDEWALK
SEE COA STD DWG 2430
- DEFERRED SIDEWALK
SEE COA STD DWG 2430
- PROPOSED VALLEY GUTTER
SEE COA STD DWG 2420
- PROPOSED CROWN TO
NO CROWN TRANSITION
SEE COA STD DWG 2401
- PROPOSED HANDICAP RAMP
CASE II (W/TRUNCATED DOME)
SEE COA STD DWG 2441
- EXISTING CURB & GUTTER
- REMOVE & DISPOSE OF EXISTING
ASPHALT CURB REPLACE W/10'
PROPOSED PAVEMENT AND STANDARD
CURB & GUTTER (RESIDENTIAL)
SEE ENDEE TYPICAL SECTION SHEET 4
- REMOVE & DISPOSE OF EXISTING
PAVEMENT & CURB & GUTTER
REPLACE W/PROPOSED PAVEMENT
AND STANDARD CURB & GUTTER
SEE RESIDENTIAL TYPICAL SECTION SHEET 4
- REMOVE & DISPOSE OF EXISTING
PAVEMENT REPLACE W/PROPOSED
PAVEMENT PER COA STD DWG 2465
(MAJOR LOCAL)

Tompson Engineering Consultants, Inc.
tecnm@yahoo.com

P.O. BOX 65760 ALBUQUERQUE, NM 87193 PHONE: (505) 271-2199 FAX: (505) 630-9426

**CITY OF ALBUQUERQUE
PUBLIC WORKS DEPARTMENT
TRANSPORTATION DEVELOPMENT**

**SUNDORO SOUTH UNIT 9
OVERALL PAVING LAYOUT**

DESIGN REVIEW COMMITTEE
APPROVED
SEP 23 2011
DESIGN REVIEW COMMITTEE

CITY ENGINEER APPROVAL
APPROVED
CITY ENGINEER


MO./DAY/YR. MO./DAY/YR.

City Project No. 7270.80 Zone Map No. J-9-Z Sheet 5 Of 12

AS BUILT INFORMATION		BENCH MARK		SURVEY INFORMATION		ENGINEER'S SEAL		REMARKS		DESIGN		CHECKED BY DBT	
CONTRACTOR	DATE	NGS MONUMENT	"REWARD"	NO.	DATE	BY	DATE	NO.	DATE	BY	DATE	DESIGNED BY DBT	CHECKED BY DBT
WORK BY: <i>Surftek Inc.</i>	DATE: <i>5/13/11</i>	X = 350994.85	Y = 1487301.42										
SAVED BY: <i>Surftek Inc.</i>	DATE: <i>5/13/11</i>												
ACCEPTANCE BY: <i>Surftek Inc.</i>	DATE: <i>5/13/11</i>												
VERIFICATION BY: <i>Surftek Inc.</i>	DATE: <i>5/13/11</i>												
CORRECTED BY: <i>Surftek Inc.</i>	DATE: <i>5/13/11</i>												
RECORDED BY: <i>Surftek Inc.</i>	DATE: <i>5/13/11</i>												
MICRO-FILM INFORMATION		NAD 1927		ELEVATION = 5316.95 (NGVD 29)									

MO./DAY/YR.	MO./DAY/YR.

Sheet	Of
6	12

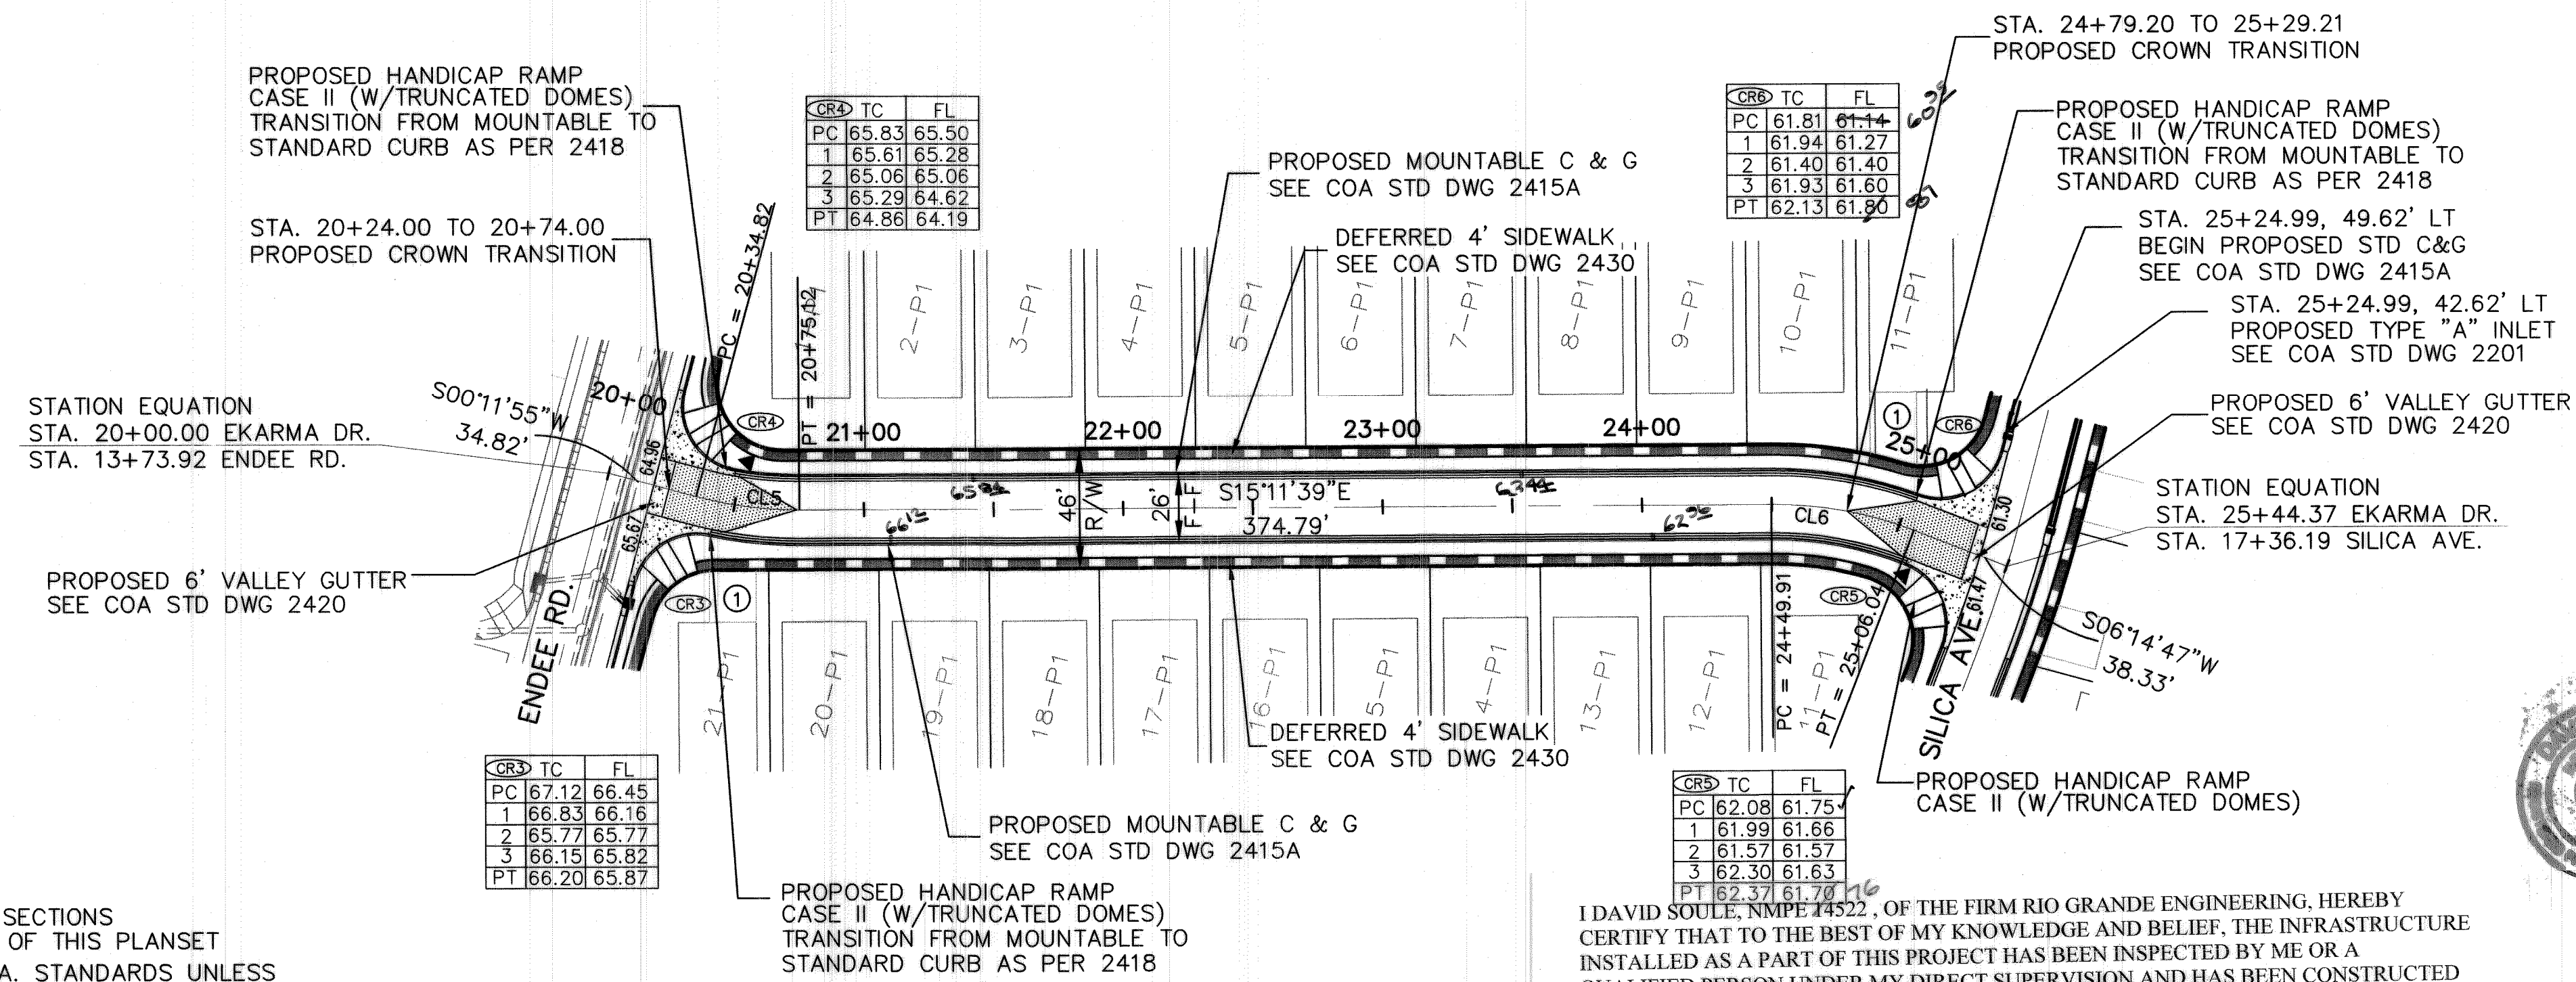


NOTE:

1. FOR TYPICAL SECTIONS
SEE SHEET 4 OF THIS PLANSET
2. USE ALL C.O.A. STANDARDS UNLESS
OTHERWISE NOTED.
3. TRUNCATED DOMES (DETECTABLE WARNING SURFACE)
DESIGN PER ADA GUIDELINES. SUBMIT SPEC.'S TO
CONSTRUCTION ENGINEER FOR EVALUATION PRIOR
TO CONSTRUCTION.

DAVID SOUTER, NMPS #4522, OF THE FIRM RIO GRANDE ENGINEERING, HEREBY CERTIFY THAT TO THE BEST OF MY KNOWLEDGE AND BELIEF, THE INFRASTRUCTURE INSTALLED AS A PART OF THIS PROJECT HAS BEEN INSPECTED BY ME OR A QUALIFIED PERSON UNDER MY DIRECT SUPERVISION AND HAS BEEN CONSTRUCTED IN ACCORDANCE WITH THE PLANS AND SPECIFICATIONS APPROVED BY THE CITY AND ABCWUA ENGINEER AND THAT THE ORIGINAL DESIGN INTENT HAS BEEN MET, EXCEPT AS NOTED BY ME OR PERSONNEL UNDER MY DIRECTION AND SURVEY INFORMATION PROVIDED BY SURV-TEK NMPS 9750.

SCALE
1" = 50' (HOR)
1" = 5' (VER)

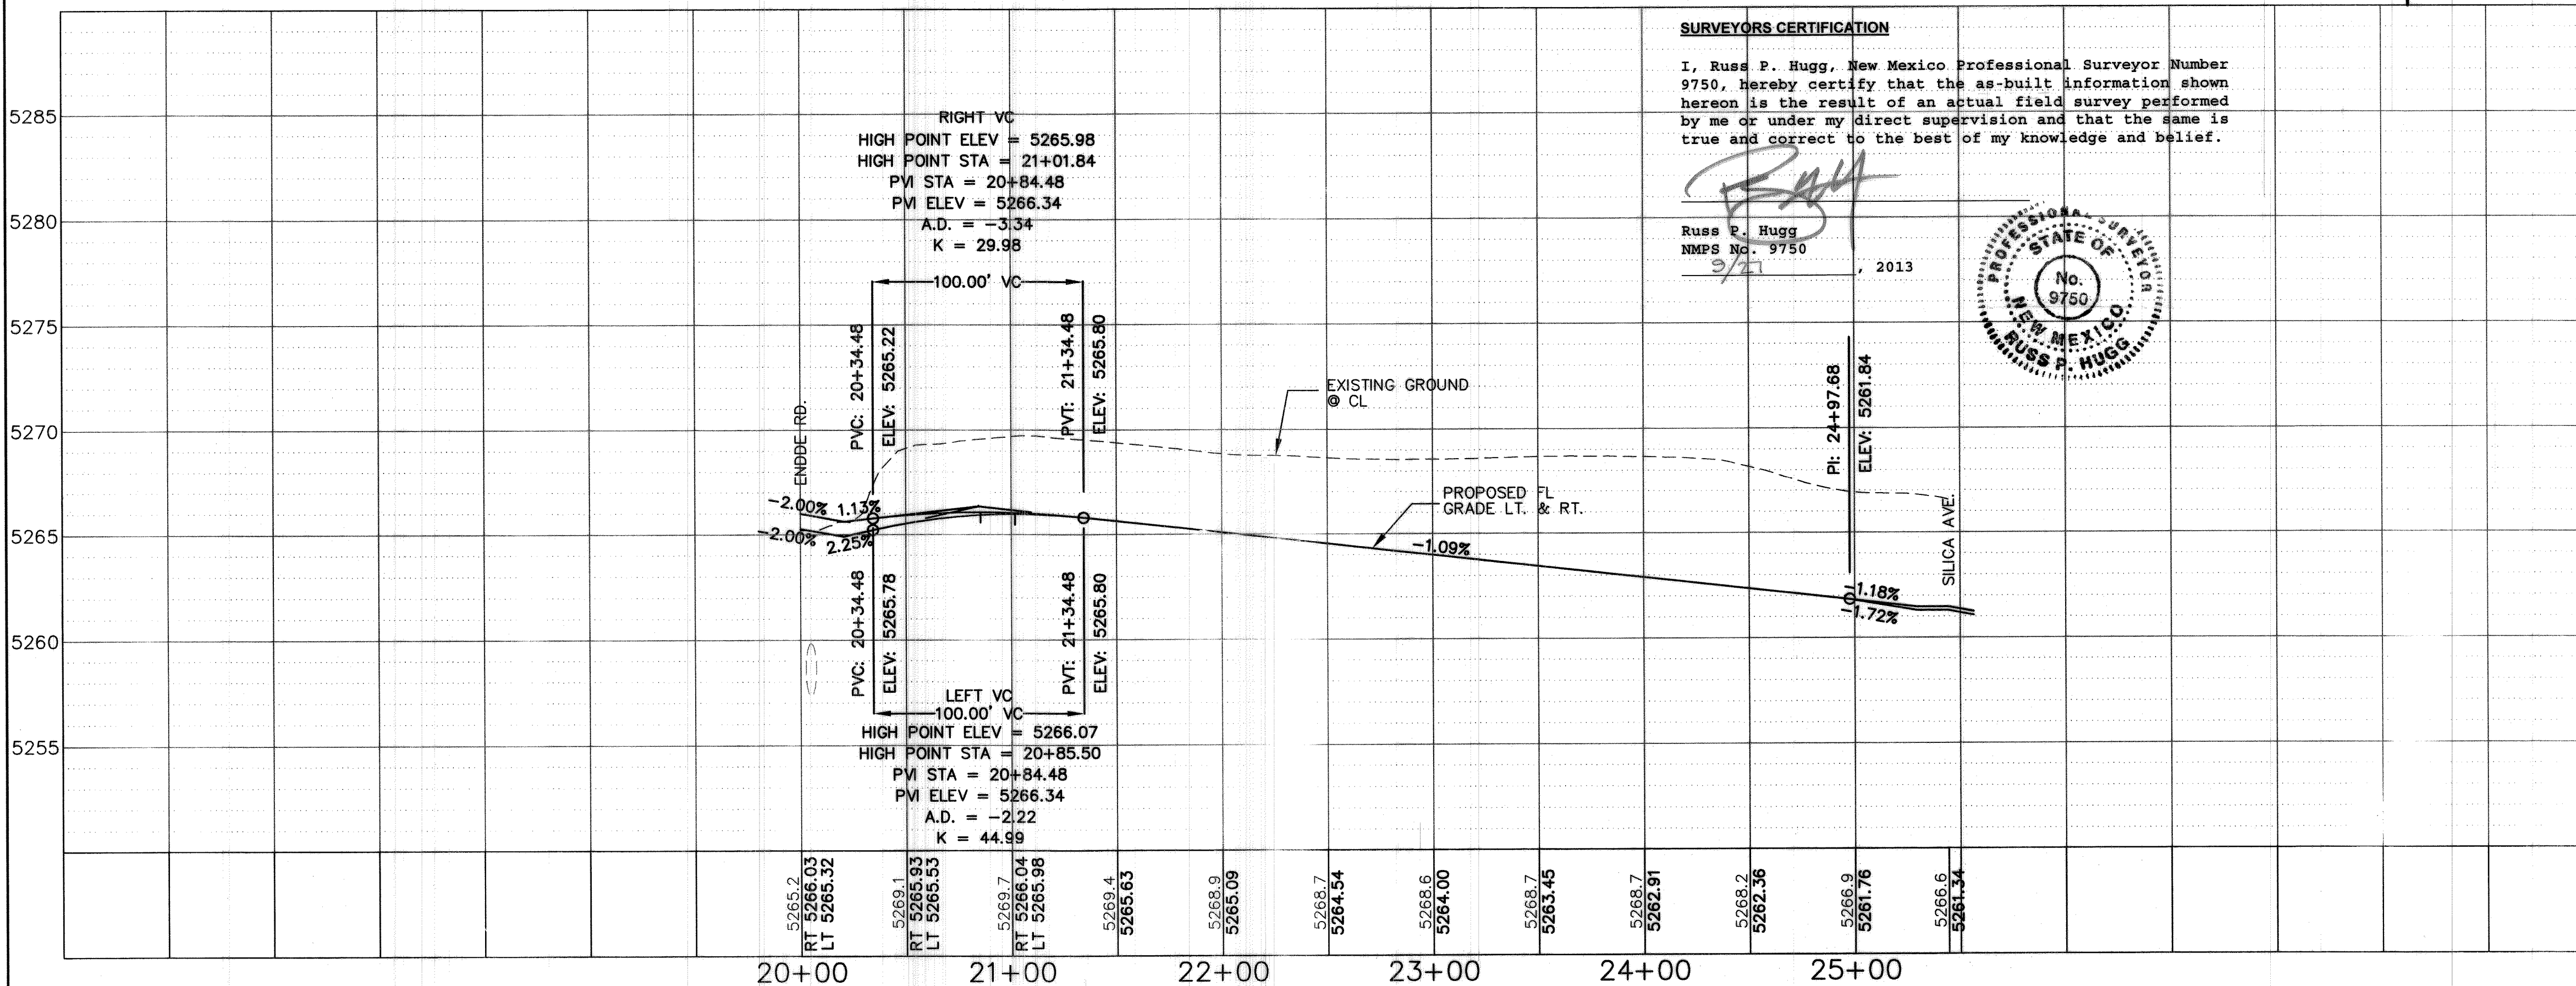


SURVEYORS CERTIFICATION


I, Russ P. Hugg, New Mexico Professional Surveyor Number 9750, hereby certify that the as-built information shown hereon is the result of an actual field survey performed by me or under my direct supervision and that the same is true and correct to the best of my knowledge and belief.

Russ P. Hugg
NMPS No. 9750

2013

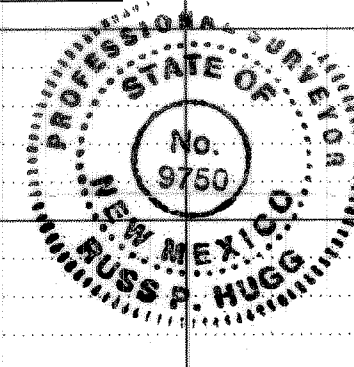

LEGEND

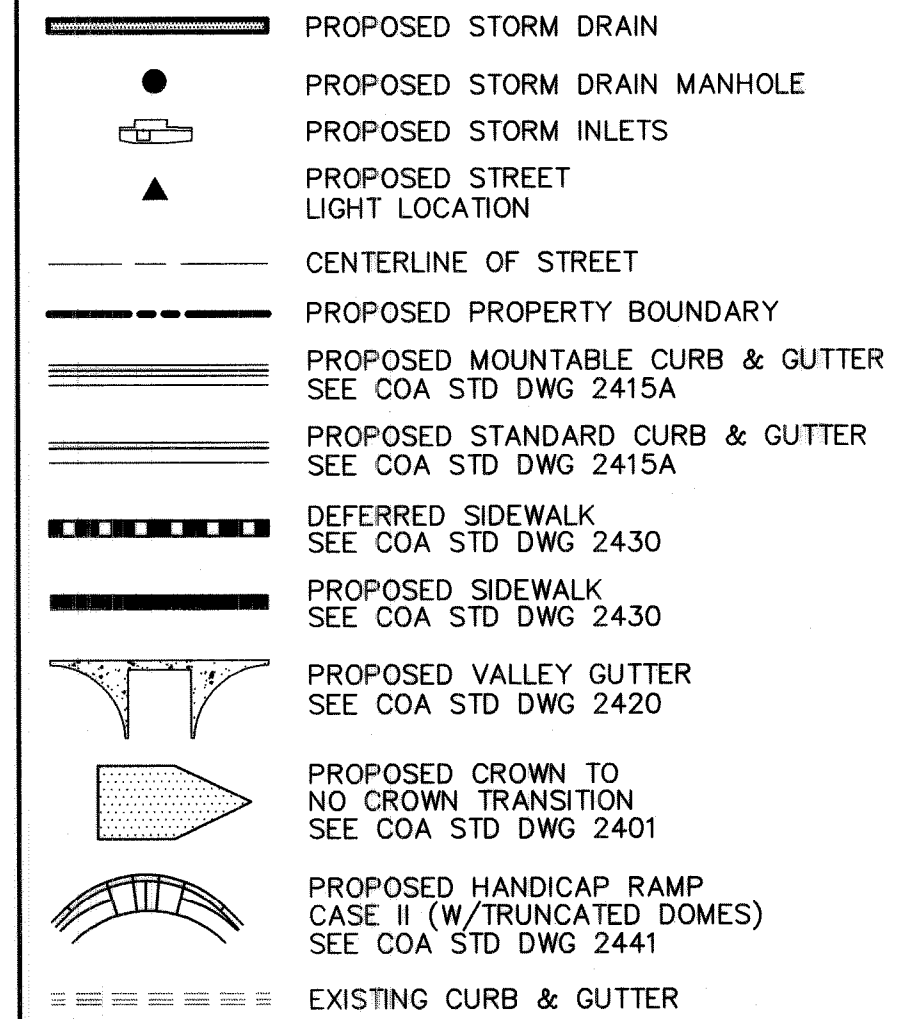

CENTERLINE CURVE DATA TABLE

<u>CURVE #</u>	<u>DELTA</u>	<u>RADIUS</u>	<u>TAN</u>	<u>LENGTH</u>
CL5	15°23'34"	150.00	20.27	40.30
CL6	21°26'26"	150.00	28.40	56.13

CURVE DATA TABLE

<u>CURVE #</u>	<u>DELTA</u>	<u>RADIUS</u>	<u>TAN</u>	<u>LENGTH</u>
CR3	87°12'52"	25.00	23.81	38.05
CR4	94°40'46"	25.00	27.13	41.31
CR7	79°16'36"	25.00	20.71	34.59
CR8	92°28'10"	20.00	20.88	32.28

NOTE:

- ① 18' DRIVE PADS ARE SHOWN FOR LOCATION ONLY. REMAINDER DRIVE PADS TO BE 20' OTHERWISE NOTED. CONSTRUCTION OF DRIVE PADS ARE NOT INCLUDED IN WORK ORDER.



Thompson
Engineering
Consultants, Inc.

tecnm@yahoo.com

P.O. BOX 65760 PHONE: (505) 271-2199
ALBUQUERQUE, NM 87193 FAX: (505) 830-9248

CITY OF ALBUQUERQUE
PUBLIC WORKS DEPARTMENT
TRANSPORTATION DEVELOPMENT

SUNDORO SOUTH UNIT 9

EKARMA DRIVE PAVING PLAN & PROFILE

DESIGN REVIEW COMMITTEE

APPROVE

SEP 23 2011

DESIGN
REVIEW COMMITTEE


A rectangular stamp with a double border. The top text reads "CITY ENGINEER APPROVAL" and the bottom text reads "CITY ENGINEER". In the center, there is a date stamp that reads "JUN 05 2013".

MO./DAY/YR.	MO./DAY/YR.


City Project No.
7270.80

Zone Map No.
J-9-Z

Sheet	Of
8	12

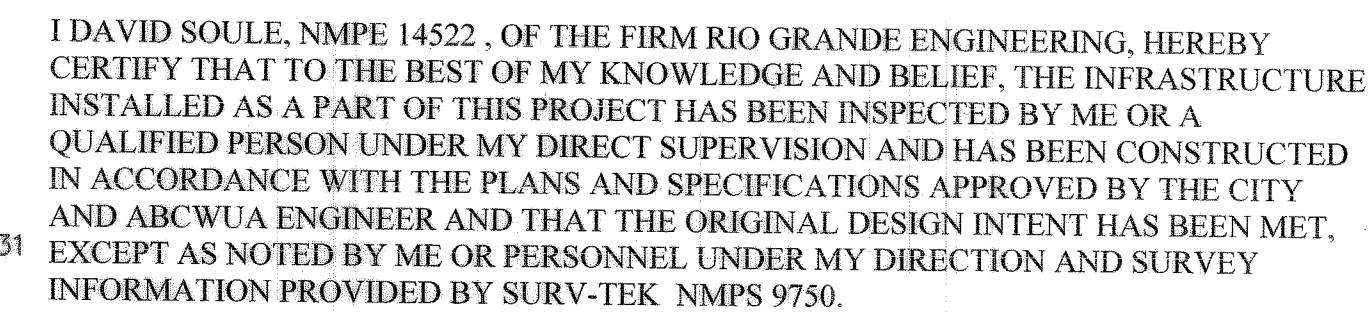


I, Russ P. Hugg, New Mexico Professional Surveyor Number 9750, hereby certify that the as-built information shown hereon is the result of an actual field survey performed by me or under my direct supervision and that the same is true and correct to the best of my knowledge and belief.

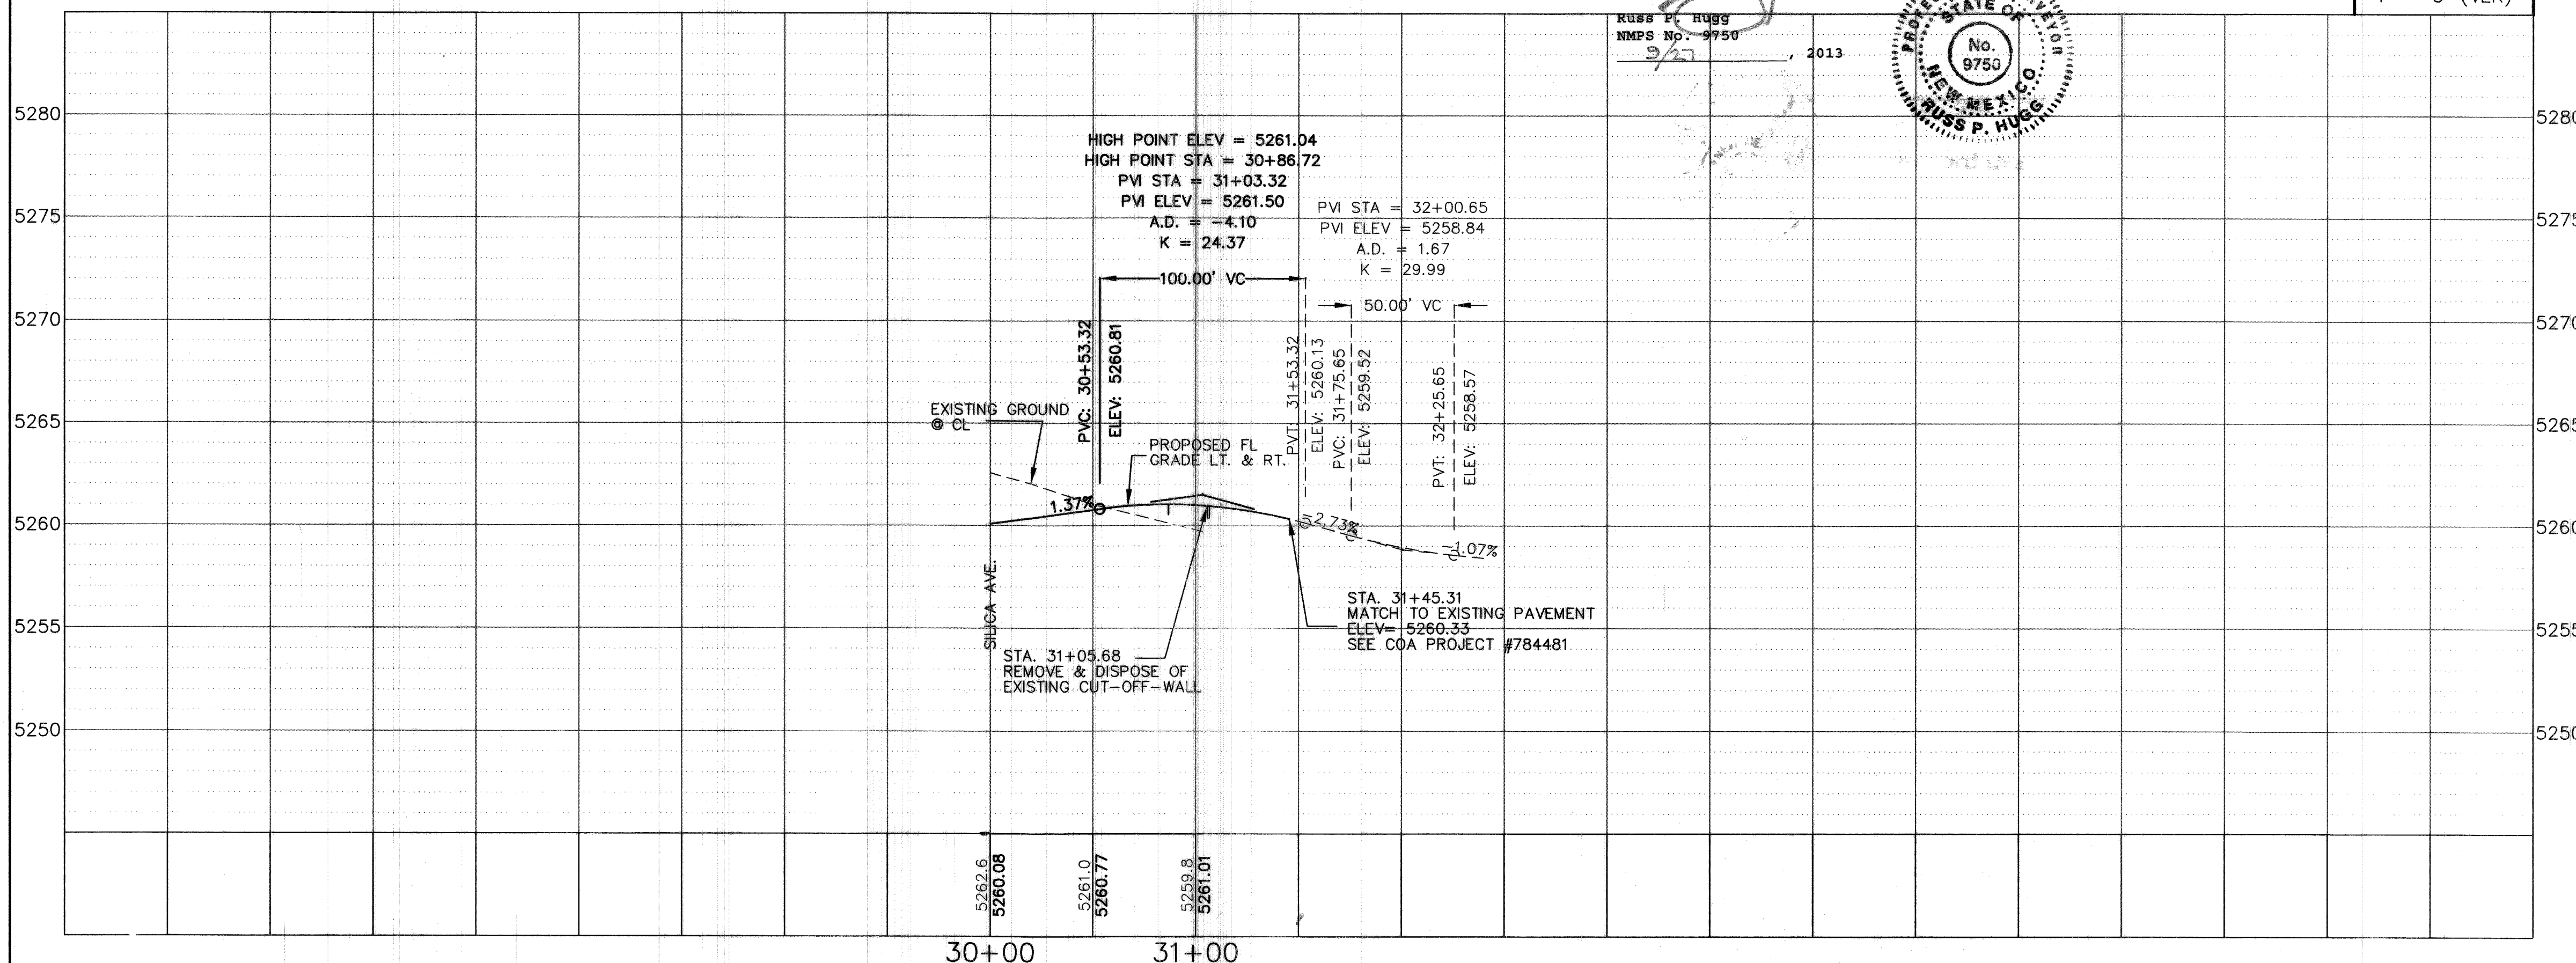

SCALE
1" = 50' (HOR)
1" = 5' (VER)

LEGEND

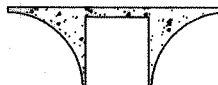	PROPOSED STORM DRAIN
	PROPOSED STORM DRAIN MANHOLE
	PROPOSED STORM INLETS
	PROPOSED STREET LIGHT LOCATION
	CENTERLINE OF STREET
	PROPOSED PROPERTY BOUNDARY
	PROPOSED MOUNTABLE CURB & GUTTER SEE COA STD DWG 2415A
	PROPOSED STANDARD CURB & GUTTER SEE COA STD DWG 2415A
	DEFERRED SIDEWALK SEE COA STD DWG 2430
	PROPOSED SIDEWALK SEE COA STD DWG 2430
	PROPOSED VALLEY GUTTER SEE COA STD DWG 2420
	PROPOSED CROWN TO NO CROWN TRANSITION SEE COA STD DWG 2401
	PROPOSED HANDICAP RAMP CASE II (W/TRUNCATED DOMES) SEE COA STD DWG 2441
	EXISTING CURB & GUTTER
	REMOVE AND DISPOSE OF EXISTING PAVEMENT & CURB & GUTTER REPLACE W/PROPOSED PAVEMENT AND STANDARD CURB & GUTTER SEE RESIDENTIAL TYPICAL SECTION SHEET 4

CENTERLINE CURVE DATA				
CURVE #	DELTA	RADIUS	TAN	LENGTH
CL1	05°32'47"	120.00	5.81	11.62
CL2	05°01'19"	120.00	5.26	10.52

CURVE #	DELTA	RADIUS	TAN	LENGTH
CR7	79°16'36"	25.00	20.71	34.59
CR8	92°28'10"	20.00	20.88	32.28

Record Drawing



Thompson
Engineering
Consultants, Inc.

tecni@yahoo.com

P.O. BOX 65760 PHONE: (505) 271-2199
ALBUQUERQUE, NM 87193 FAX: (505) 830-9248

CITY OF ALBUQUERQUE
PUBLIC WORKS DEPARTMENT
TRANSPORTATION DEVELOPMENT

SUNDORO SOUTH UNIT 9

DESIGN REVIEW COMMITTEE

DESIGN REVIEW COMMITTEE

APPROVE

MOVIE

SEP 23 2011

DESIGN:

DESIGN
REVIEW COMMITTEE

ity Project No.

CITY ENGINEER APPROV _____

CITY ENGINEER APPROV

100

1270 113

CITY ENGINE

OFF ENGINE

Zone

City Project No. 7270.80

Zone Map No.
J-9-Z


Sheet	Of
9	12

UTILITY NOTES:

- CONTRACTOR RESPONSIBLE FOR LOCATION OF ALL EXISTING UTILITIES PRIOR TO WORK.
- PROPOSED 6" & 8" WL HAS 3' MIN. COVER
- ALL PROPOSED MANHOLE LIDS TO MATCH WITH PROPOSED PAVEMENT
- CITY STANDARDS TO BE USED ON ALL UTILITIES UNLESS OTHERWISE NOTED.
- ELECTRONIC MARKER SPHERES (EMS'S) MUST BE INSTALLED ON WATER LINE AND SANITARY SEWER LINE APPURTENANCES AS PER CITY SPEC. SECTION 170.
- ALL WATER SERVICE LINES AND WATER METERS SHALL BE 3/4".
- MANHOLE STEPS SHALL NOT BE INSTALLED IN SANITARY SEWER MANHOLES

SUPPLEMENTAL WATER VALVE BOX DETAIL

WATER AUTHORITY DWG 2326 JANUARY 2010

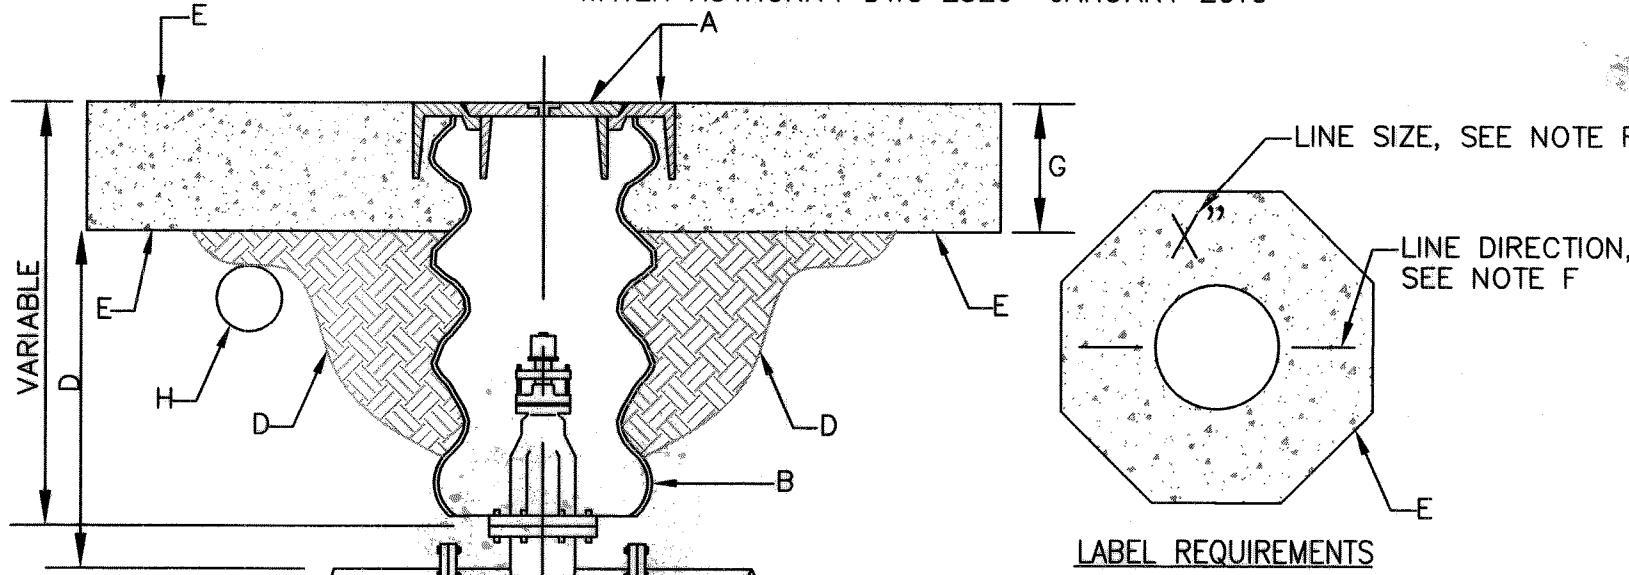

CONSTRUCTION NOTES:

- VALVE BOX RING AND COVER PER C.O.A. STD. DWG. 2328.
- 12" DIAMETER CORRUGATED METAL PIPE (CMP), TAR COATED.
- NEW OR EXISTING VALVE.
- SUPPLEMENTAL SPEC COMPACTED BACKFILL, SOIL OR BASE COURSE MATERIAL (95% COMPACTION). ASTM ID 1557
- CONCRETE COLLAR PER C.O.A. STD. DWG. 2461.
- TOP OF CONCRETE COLLAR SHALL BE STAMPED WITH LINE SIZE AND DIRECTION. MINIMUM LETTER SIZE SHALL BE 3" IN HEIGHT. ADD "FL" FOR VALVES ON FIRE LINES.
- MIN. 6" OR MATCH EXISTING.
- ELECTRONIC MARKER SPHERE (EMS), SEE COA STANDARD SPECIFICATION SECTION 170.

I DAVID SOULE, NMPE #4522, OF THE FIRM RIO GRANDE ENGINEERING, HEREBY CERTIFY THAT TO THE BEST OF MY KNOWLEDGE AND BELIEF, THE INFRASTRUCTURE INSTALLED AS A PART OF THIS PROJECT HAS BEEN INSPECTED BY ME OR A QUALIFIED PERSON UNDER MY DIRECT SUPERVISION AND HAS BEEN CONSTRUCTED IN ACCORDANCE WITH THE PLANS AND SPECIFICATIONS APPROVED BY THE CITY AND ABCWUA ENGINEER AND THAT THE ORIGINAL DESIGN INTENT HAS BEEN MET, EXCEPT AS NOTED BY ME OR PERSONNEL UNDER MY DIRECTION AND SURVEY INFORMATION PROVIDED BY SURV-TEK NMPS 9750.

SUNDORO SOUTH
UNIT 6
COA PROJECT
#727085

Record Draw

WATER SHUT OFF PLAN:

- THE CONTRACTOR SHALL COORDINATE WITH THE WATER AUTHORITY SEVEN (7) DAYS IN ADVANCE OR PERFORMING WORK THAT WILL AFFECT THE PUBLIC WATER OR SANITARY SEWER INFRASTRUCTURE. WORK REQUIRING SHUTOFF OF FACILITIES DESIGNATED AS MASTER PLAN FACILITIES MUST BE COORDINATED WITH THE WATER AUTHORITY 14 DAYS IN ADVANCE OF PERFORMING SUCH WORK. ONLY WATER AUTHORITY CREWS ARE AUTHORIZED TO OPERATE PUBLIC VALVES. SHUTOFF REQUESTS MUST BE MADE ON-LINE AT <http://abcqua.org/contnt/view/463/729>.
- VALVES SHALL BE OPERATED BY ABCWUA ONLY.
- MAKE A PRESSURE CONNECTION IN ENDEE RD AT NORTH BOUNDARY.
- MAKE NON-PRESSURE CONNECTION IN SILICA AVE. AT EAST BOUNDARY BY SHUTTING OFF EXISTING GATE VALVE #811 AND #873.

RESTRAINED JOINTS LENGTHS, L_r,
FOR REDUCERS, (FT.)
ALL JOINTS AT THE TEE MUST BE RESTRAINED.

SIZE	RUN	BRANCH
10x10x6	4	16
6x6x6	6	20

RESTRAINED JOINTS LENGTHS, L_r,
FOR HORIZONTAL BENDS, VALVES,
AND DEAD ENDS, (FT)

SIZE	90°	45°	22 1/2°	11 1/4°
10	26	11	5	3
6	17	7	3	2

BLOCK 1 SAS SERVICE HOOK-UP				WATER MAIN LINE SPUR		
LOT	STATION	OFFSET	ELEV.	STATION	OFFSET	TYPE
1	20+93.59	23.00 LT	60.69	20+98.59	23.00 LT	DOUBLE
2	21+36.09	23.00 LT	60.09	21+02.59	23.00 LT	DOUBLE
3	21+78.59	23.00 LT	59.49	21+83.59	23.00 LT	DOUBLE
4	22+21.09	23.00 LT	58.89	21+87.59	23.00 LT	DOUBLE
5	22+63.59	23.00 LT	58.29	22+68.59	23.00 LT	DOUBLE
6	23+06.09	23.00 LT	57.69	22+72.59	23.00 LT	DOUBLE
7	23+48.59	23.00 LT	57.09	23+53.59	23.00 LT	DOUBLE
8	23+91.09	23.00 LT	56.49	23+57.59	23.00 LT	DOUBLE
9	24+33.59	23.00 LT	55.89	24+38.59	23.00 LT	DOUBLE
10	24+63.12	23.00 LT	55.47	24+42.59	23.00 LT	DOUBLE
11	25+03.91	25.75 LT	55.16	24+86.80	23.00 LT	SINGLE


BLOCK 2 SAS SERVICE HOOK-UP				WATER MAIN LINE SPUR		
LOT	STATION	OFFSET	ELEV.	STATION	OFFSET	TYPE
1	10+98.35	23.00 LT	67.99	11+03.35	23.00 LT	DOUBLE
2	11+43.35	23.00 LT	67.08	11+07.35	23.00 LT	DOUBLE
3	11+88.35	23.00 LT	66.17	11+93.35	23.00 LT	DOUBLE
4	12+33.35	23.00 LT	65.27	11+97.35	23.00 LT	DOUBLE
5	13+78.35	23.00 LT	64.36	12+83.35	23.00 LT	DOUBLE
6	13+23.35	23.00 LT	63.45	12+87.35	23.00 LT	DOUBLE
7	13+68.35	23.00 LT	62.54	13+73.35	23.00 LT	DOUBLE
8	14+13.35	23.00 LT	61.63	13+77.35	23.00 LT	DOUBLE
9	14+58.35	23.00 RT	60.72	14+63.35	23.00 RT	DOUBLE
10	14+84.72	23.00 RT	60.19	14+67.35	23.00 RT	DOUBLE
11	24+53.15	23.00 RT	55.61	24+47.66	23.00 RT	SINGLE
12	24+35.66	23.00 RT	55.86	24+05.16	23.00 RT	DOUBLE
13	23+96.16	23.00 RT	56.42	24+01.16	23.00 RT	DOUBLE
14	23+50.66	23.00 RT	57.07	23+20.16	23.00 RT	DOUBLE
15	23+11.16	23.00 RT	57.63	23+16.16	23.00 RT	DOUBLE
16	22+65.66	23.00 RT	58.28	22+35.16	23.00 RT	DOUBLE
17	22+26.16	23.00 RT	58.84	22+31.16	23.00 RT	DOUBLE
18	21+80.66	23.00 RT	59.49	21+50.16	23.00 RT	DOUBLE
19	21+41.16	23.00 RT	60.05	21+46.16	23.00 RT	DOUBLE
20	20+95.66	23.41 RT	60.70	20+66.76	23.41 RT	DOUBLE
21	20+58.74	24.04 RT	61.22	20+62.76	23.41 RT	DOUBLE

BLOCK 3 SAS SERVICE HOOK-UP				WATER MAIN LINE SPUR		
LOT	STATION	OFFSET	ELEV.	STATION	OFFSET	TYPE
1	10+57.24	24.24 RT	68.68	10+61.24	23.00 RT	DOUBLE
2	10+96.89	23.00 RT	67.89	10+65.24	23.00 RT	DOUBLE
3	11+39.39	23.00 RT	67.04	11+44.39	23.00 RT	DOUBLE
4	11+81.89	23.00 RT	66.19	11+48.39	23.00 RT	DOUBLE
5	12+24.39	23.00 RT	65.34	12+29.39	23.00 RT	DOUBLE
6	12+66.89	23.00 RT	64.49	12+33.39	23.00 RT	DOUBLE
7	13+09.39	23.00 RT	63.64	13+14.39	23.00 RT	DOUBLE
8	13+51.89	23.00 RT	62.79	13+18.39	23.00 RT	DOUBLE
9	13+94.39	23.00 RT	61.44	13+99.39	23.00 RT	DOUBLE
10	14+36.89	23.00 RT	61.10	14+03.39	23.00 RT	DOUBLE
11	14+77.32	23.00 RT	60.29	14+80.45	25.49 RT	DOUBLE
12	15+02.04	49.27 RT	60.35	14+83.82	51.74 RT	DOUBLE
13	15+10.20	53.27 RT	60.18	15+17.48	51.74 RT	DOUBLE
14	15+28.70	49.48 RT	59.61	15+19.86	53.57 RT	DOUBLE
15	15+54.06	23.35 RT	58.58	15+57.41	23.00 RT	DOUBLE
16	16+00.06	23.00 RT	57.47	15+61.41	23.00 RT	DOUBLE
17	16+45.75	23.00 RT	56.36	16+50.75	23.00 RT	DOUBLE
18	17+02.06	23.00 RT	55.00	16+54.75	23.00 RT	DOUBLE
19	17+43.20	23.00 RT	53.82	17+40.47	23.00 RT	SINGLE
20	17+97.37	23.00 RT	52.51	17+94.77	23.00 RT	SINGLE
21	18+37.08	23.37 RT	51.67	18+34.72	23.16 RT	SINGLE

LEGEND

- EXISTING SAS MANHOLE
- EXISTING WATER VALVE
- EXISTING FIRE HYDRANT
- EXISTING STORM DRAIN MANHOLE
- EXISTING WATER LINE
- EXISTING SAS LINE
- PROPOSED SANITARY SEWER
- PROPOSED SAS & SD MANHOLE PER COA STD DWG 2102
- PROPOSED SANITARY SEWER SERVICE LINE PER COA STD DWGS
- PROPOSED WATER LINE
- PROPOSED FIRE HYDRANT PER COA STD DWG 2340
- PROPOSED GATE VALVE PER COA STD DWGS
- PROPOSED CROSS, TEE, OR ELBOW PER COA STD DWGS
- PROPOSED DOUBLE 3/4" METER, WATER SERVICE LINES PER COA STD DWGS


GRAPHIC SCALE

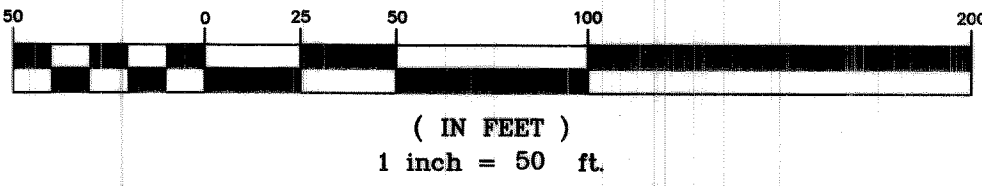


AS BUILT INFORMATION			
CONTRACTOR	Sailor & Taylor	DATE	7/13/2011
WORK BY	Surf-Tek	DATE	7/13/2011
INSPECTOR'S	ABCWUA	DATE	7/13/2011
ACCEPTANCE BY	ABCWUA	DATE	7/13/2011
VERIFICATION BY	Surf-Tek	DATE	7/13/2011
DRAWINGS	Surf-Tek	DATE	7/13/2011
REVISIONS	Surf-Tek	DATE	7/13/2011
MICRO-FILM INFORMATION			
RECORDED BY	NAD	DATE	1927
NO.			

BENCH MARK			
NGS MONUMENT "REWARD"			
x =	350994.85		
y =	1487301.42		
Ground to Grid Factor:	0.99967114		
Δα =	-00' 17" 11"		
NMSP CENTRAL ZONE			
NAD 1927			
ELEVATION=5316.95 (NGVD 29)			



SURVEY INFORMATION			
FIELD NOTES			
DATE			
BY			
NO.			

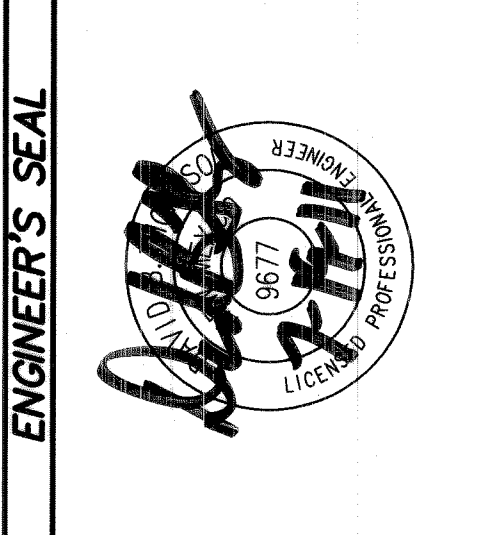


ENGINEER'S SEAL			
NO.			
DATE			
BY			

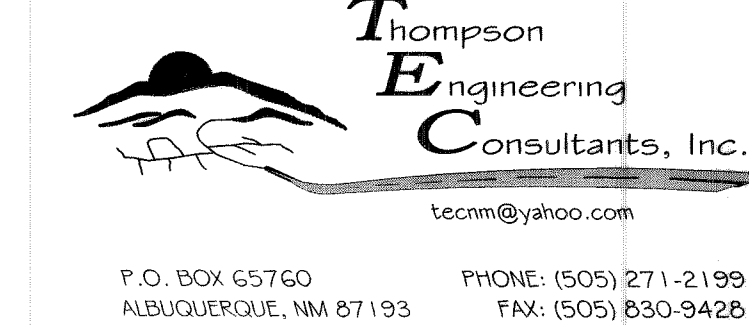


CITY OF ALBUQUERQUE PUBLIC WORKS DEPARTMENT TRANSPORTATION DEVELOPMENT			
SUNDORO SOUTH UNIT 9 OVERALL UTILITY LAYOUT			
DESIGN REVIEW COMMITTEE	CITY ENGINEER APPROVAL	MO./DAY/YR.	MO./DAY/YR.
APPROVE SEP 23 2011	APPROVE		
DESIGN REVIEW COMMITTEE	CITY ENGINEER		
City Project No. 7270.80	Zone Map No. J-9-Z	Sheet 10	Of 12

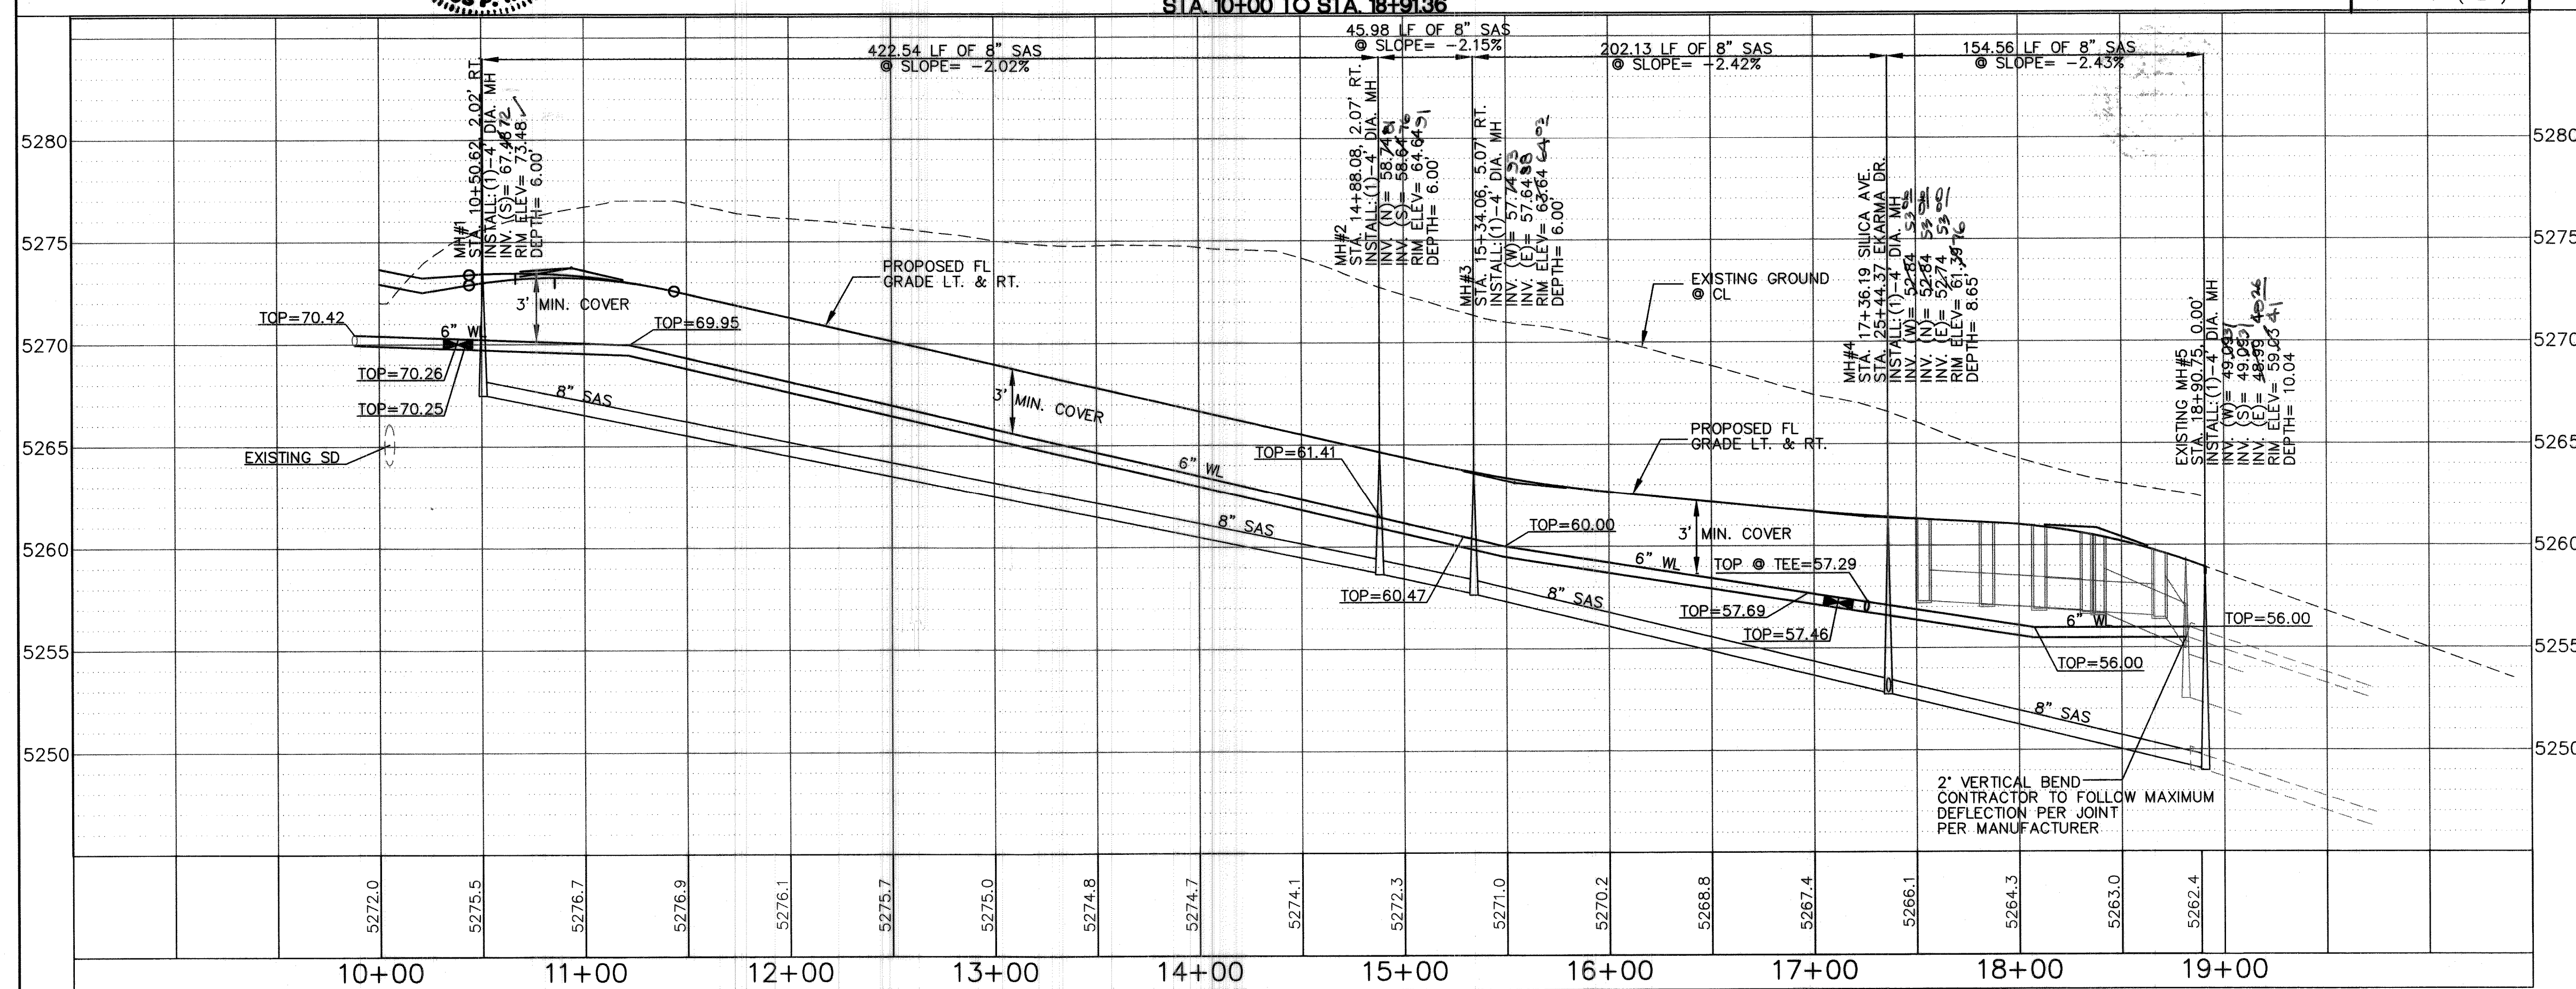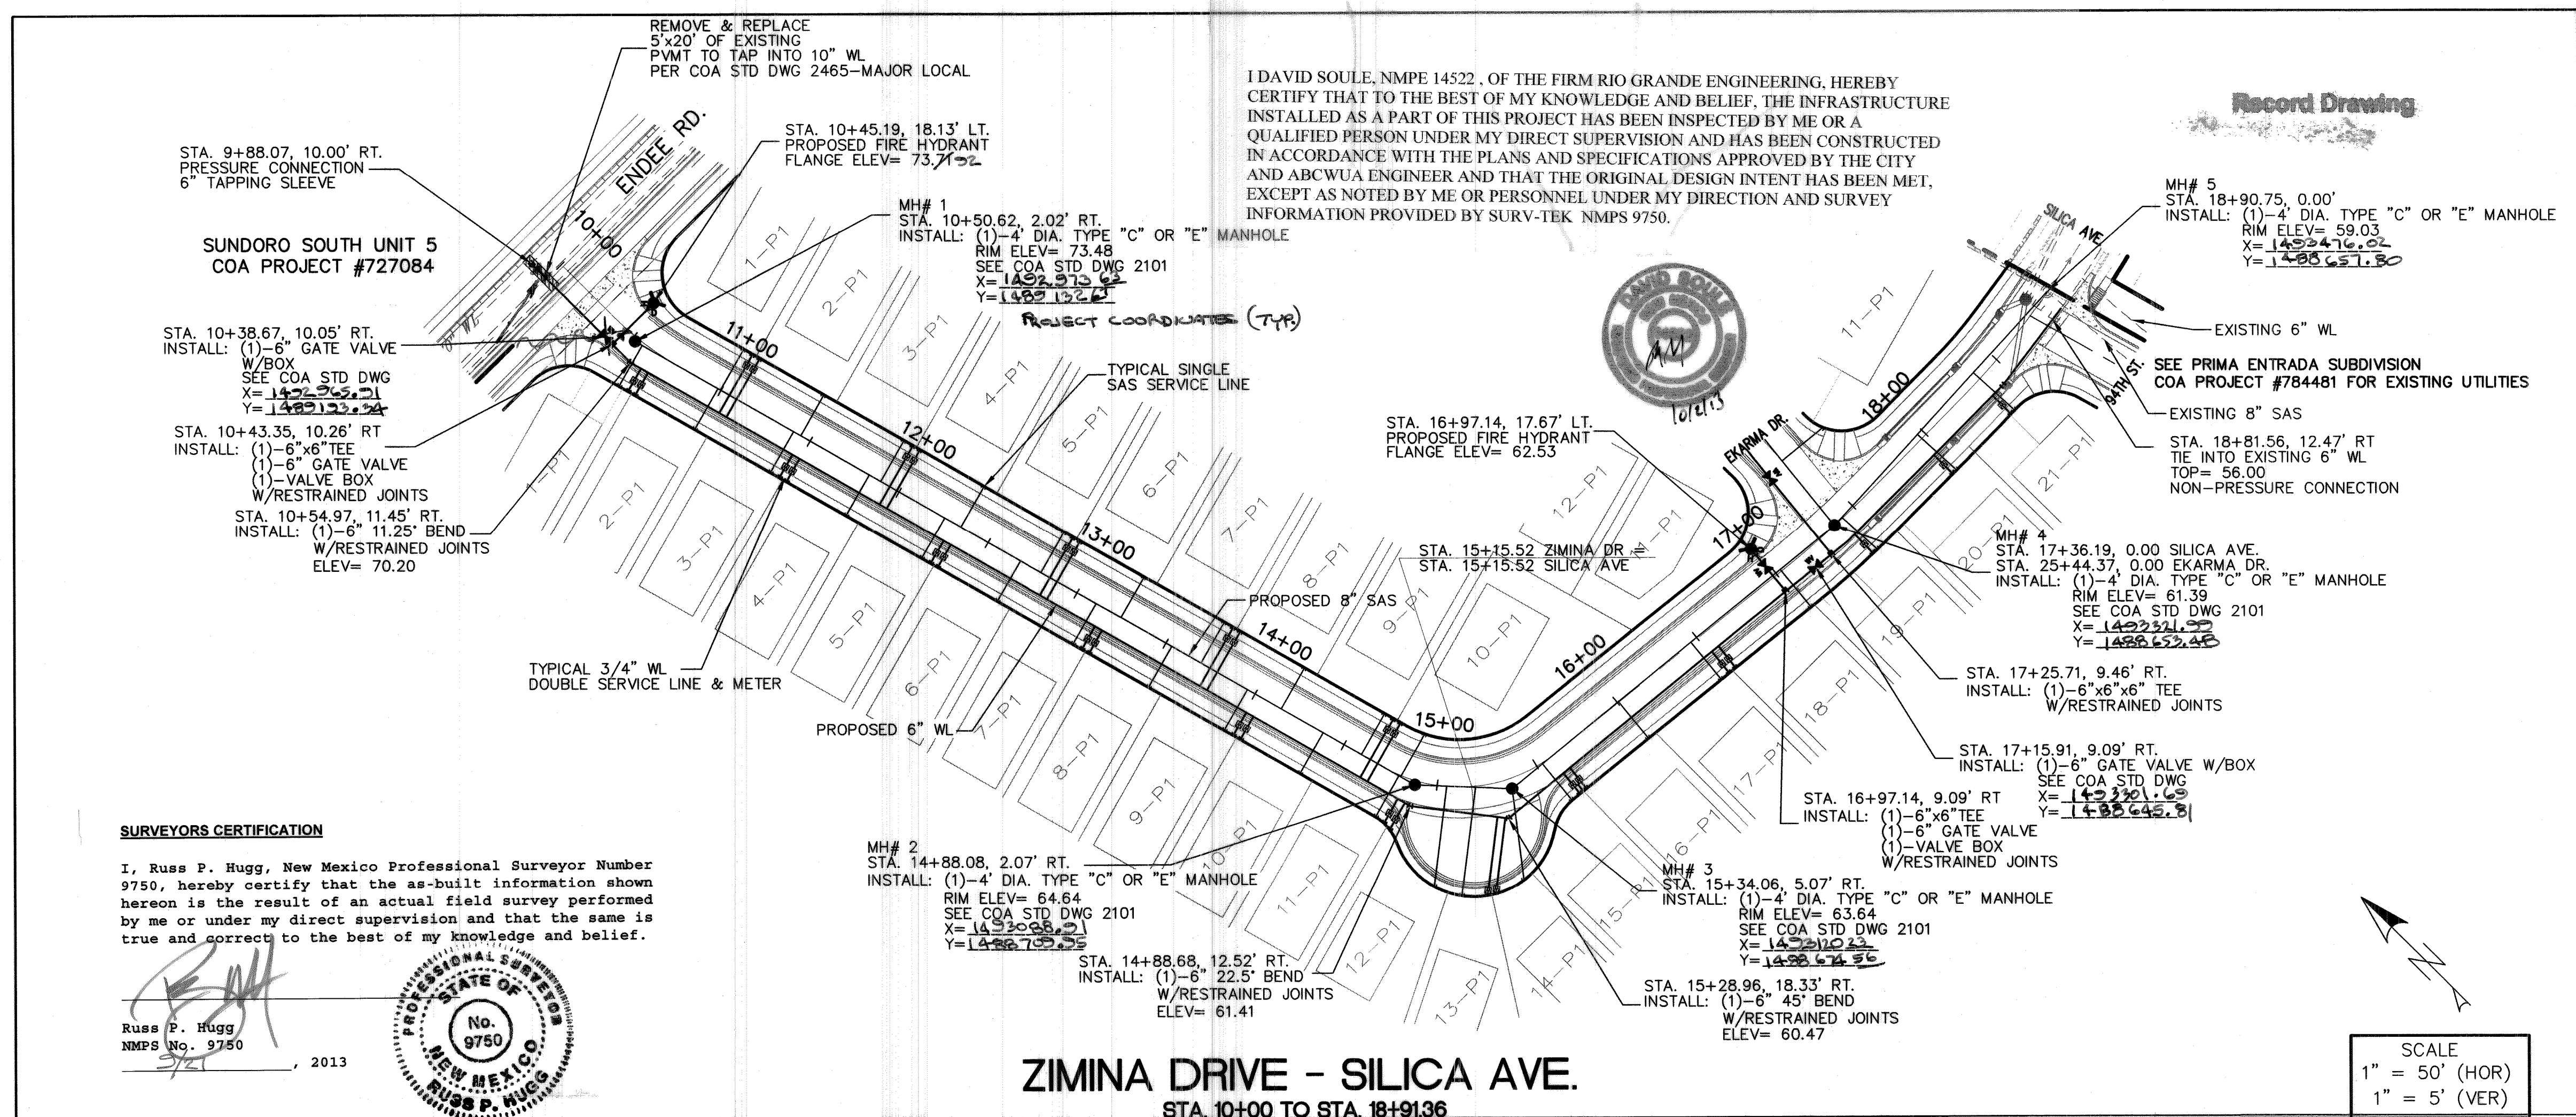

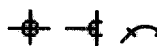- | | |
|---|---|
|  | EXISTING SAS MANHOLE |
|  | EXISTING WATER VALVE |
|  | EXISTING FIRE HYDRANT |
|  | EXISTING STORM DRAIN MANHOLE |
| WL - - - - | EXISTING WATER LINE |
| SAS - - - - | EXISTING SAS LINE |
|  | PROPOSED SANITARY SEWER |
|  | PROPOSED SAS MANHOLE
PER COA STD DWG 2101 |
|  | PROPOSED SANITARY SEWER
SERVICE LINE
PER COA STD DWGS |
|  | PROPOSED WATER LINE |
|  | PROPOSED FIRE HYDRANT
PER COA STD DWG 2340 |
|  | PROPOSED GATE VALVE
PER COA STD DWGS |
|  | PROPOSED CROSS, TEE, OR
ELBOW
PER COA STD DWGS |
|  | PROPOSED SINGLE 3/4"
SEWER WATER SERVICE LINES
PER COA STD DWGS |
|  | PROPOSED DOUBLE 3/4"
SEWER WATER SERVICE LINES
PER COA STD DWGS |

- UTILITY NOTES:**
1. CONTRACTOR RESPONSIBLE FOR LOCATION OF ALL EXISTING UTILITIES PRIOR TO WORK.
 2. PROPOSED 6" WL HAS 3' MIN. COVER
 3. ALL PROPOSED MANHOLE LIDS TO MATCH WITH PROPOSED PAVEMENT
 4. CITY STANDARDS TO BE USED ON ALL UTILITIES UNLESS OTHERWISE NOTED.
 5. DO NOT INSTALL STEPS IN SAS MANHOLES.

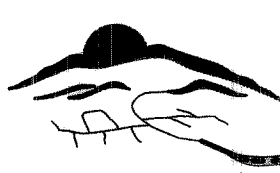

Thompson
Engineering
Consultants, Inc.

tecmm@yahoo.com

P.O. BOX 65760
ALBUQUERQUE, NM 87193

PHONE: (505) 271-2199
FAX: (505) 830-3248

CITY OF ALBUQUERQUE
PUBLIC WORKS DEPARTMENT
TRANSPORTATION DEVELOPMENT

SUNDORO SOUTH UNIT 9
ZIMINA DR-SILICA AVE. UTILITY PLAN & PROFILE


[illegible]

City Project No. 7270.80	Zone Map No. J-9-Z	Sheet 11	Of 12
-----------------------------	-----------------------	-------------	----------

SURVEY INFORMATION			BENCH MARK	AS BUILT INFORMATION
FIELD NOTES				
NO.	BY	DATE		
			NCS MONUMENT "REWARD"	
	x		350994.85	CONTRACTOR <u>S. J. Leathers</u>
	y		1487301.42	STARTED BY <u>SUN-Tek</u> <u>6/19</u> DATE
			Ground to Grid Factor:	ADJUSTANCE BY <u>R & R</u> <u>10/19</u> DATE
			0.999671114	FIELD VERIFICATION BY <u>SUN-Tek</u> <u>9/19</u> DATE
			$\Delta\alpha = -00^{\circ} 17' 11''$	CORRECTED BY <u>SUN-Tek</u> <u>1/19</u> DATE
			NMSP CENTRAL ZONE	MICRO-FILM INFORMATION
			NAD 1927	RECORDED BY
			ELEVATION—531.95 (NGVD 20)	NO

A circular professional engineer seal for David A. B. (DA B.). The seal features the text "DA B." in large, bold, stylized letters across the center. Below this, the number "9677" is printed. The outer ring of the seal contains the words "PROFESSIONAL ENGINEER" at the top and "LICENSED" at the bottom. The seal is stamped in black ink on a white background.[illegible]


Record Drawing

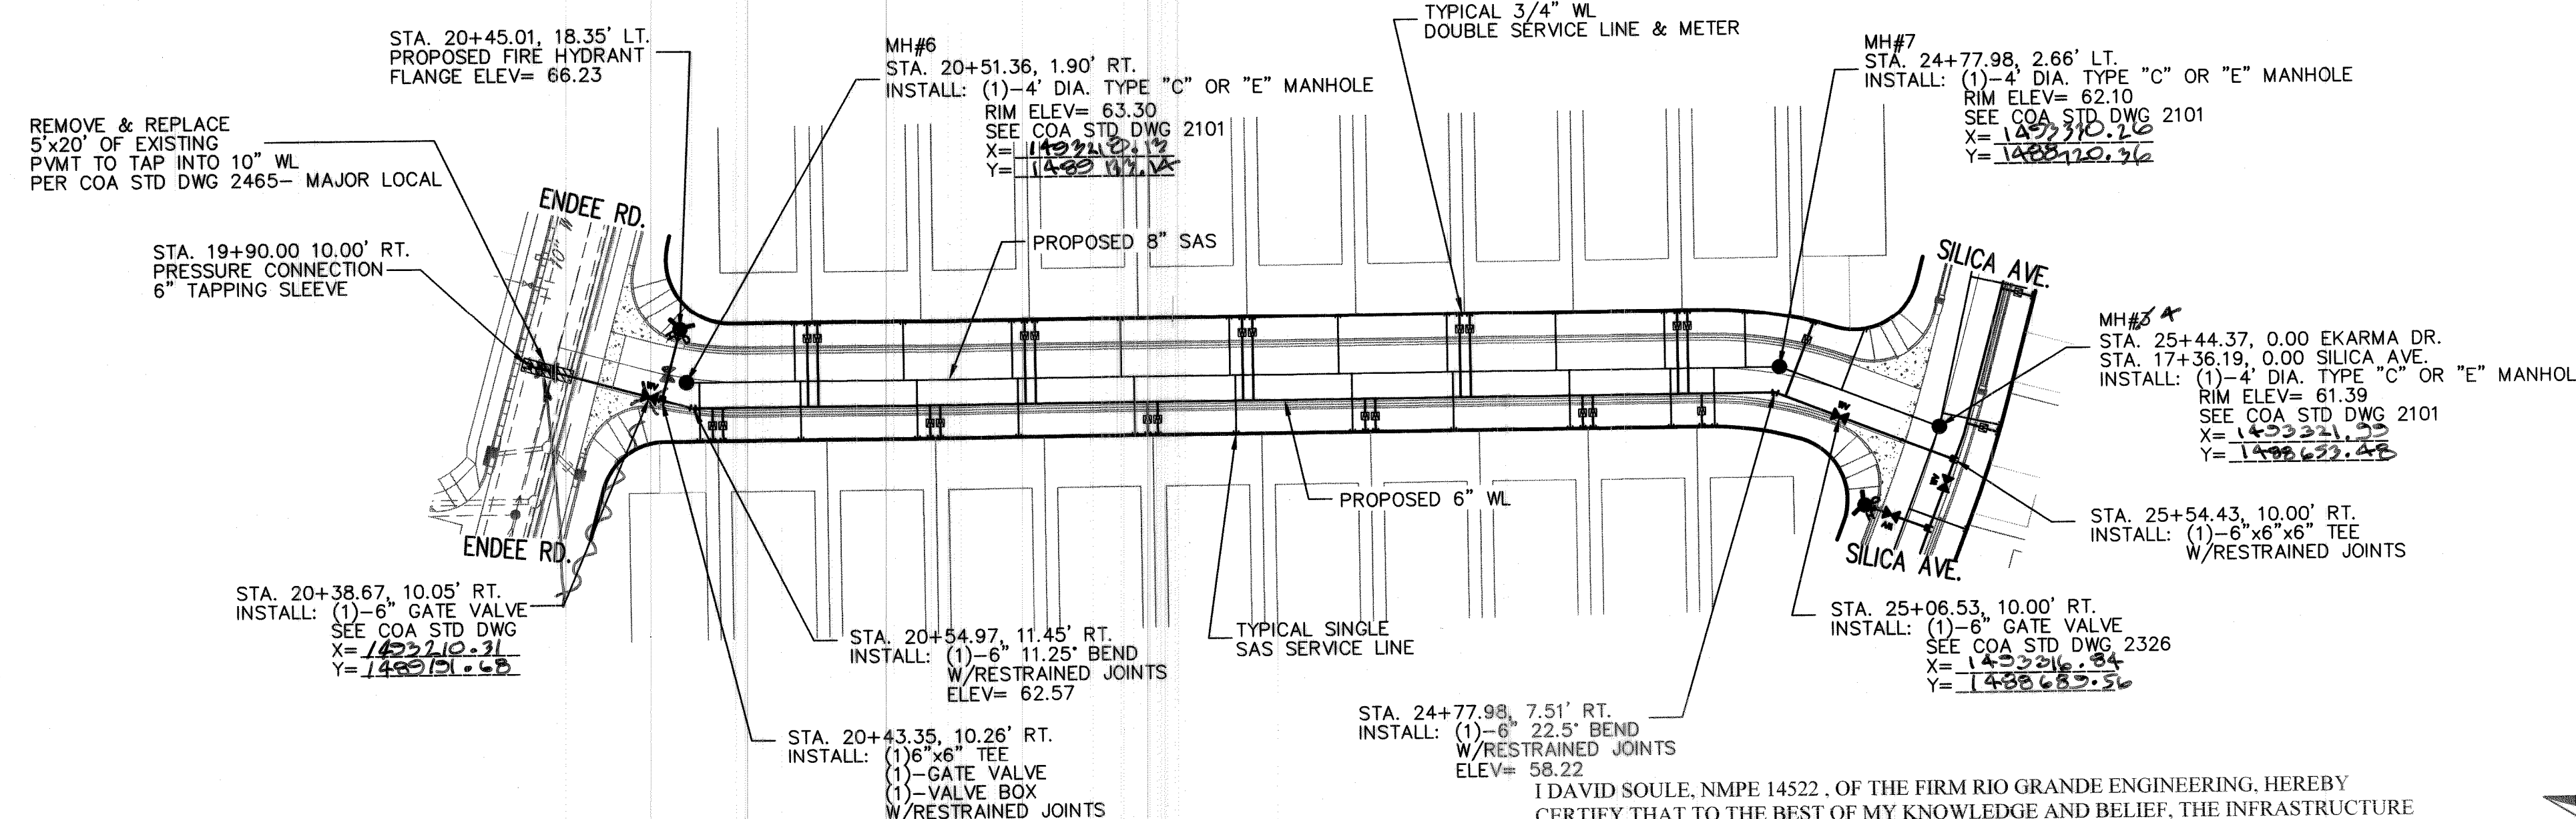

SURVEYORS CERTIFICATION

I, Russ P. Hugg, New Mexico Professional Surveyor Number 9750, hereby certify that the as-built information shown hereon is the result of an actual field survey performed by me or under my direct supervision and that the same is true and correct to the best of my knowledge and belief.


Russ P. Hugg
NMPS No. 9750
9/27/2013

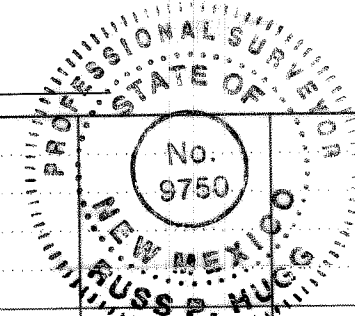

EKARMA DRIVE STA. 20+00 TO STA. 25+44.37

I DAVID SOULE, NMPE 14522, OF THE FIRM RIO GRANDE ENGINEERING, HEREBY CERTIFY THAT TO THE BEST OF MY KNOWLEDGE AND BELIEF, THE INFRASTRUCTURE INSTALLED AS A PART OF THIS PROJECT HAS BEEN INSPECTED BY ME OR A QUALIFIED PERSON UNDER MY DIRECT SUPERVISION AND HAS BEEN CONSTRUCTED IN ACCORDANCE WITH THE PLANS AND SPECIFICATIONS APPROVED BY THE CITY AND ABCWUA ENGINEER AND THAT THE ORIGINAL DESIGN INTENT HAS BEEN MET, EXCEPT AS NOTED BY ME OR PERSONNEL UNDER MY DIRECTION AND SURVEY INFORMATION PROVIDED BY SURV-TEK NMPS 9750.

SCALE
1" = 50' (HOR)
1" = 5' (VER)

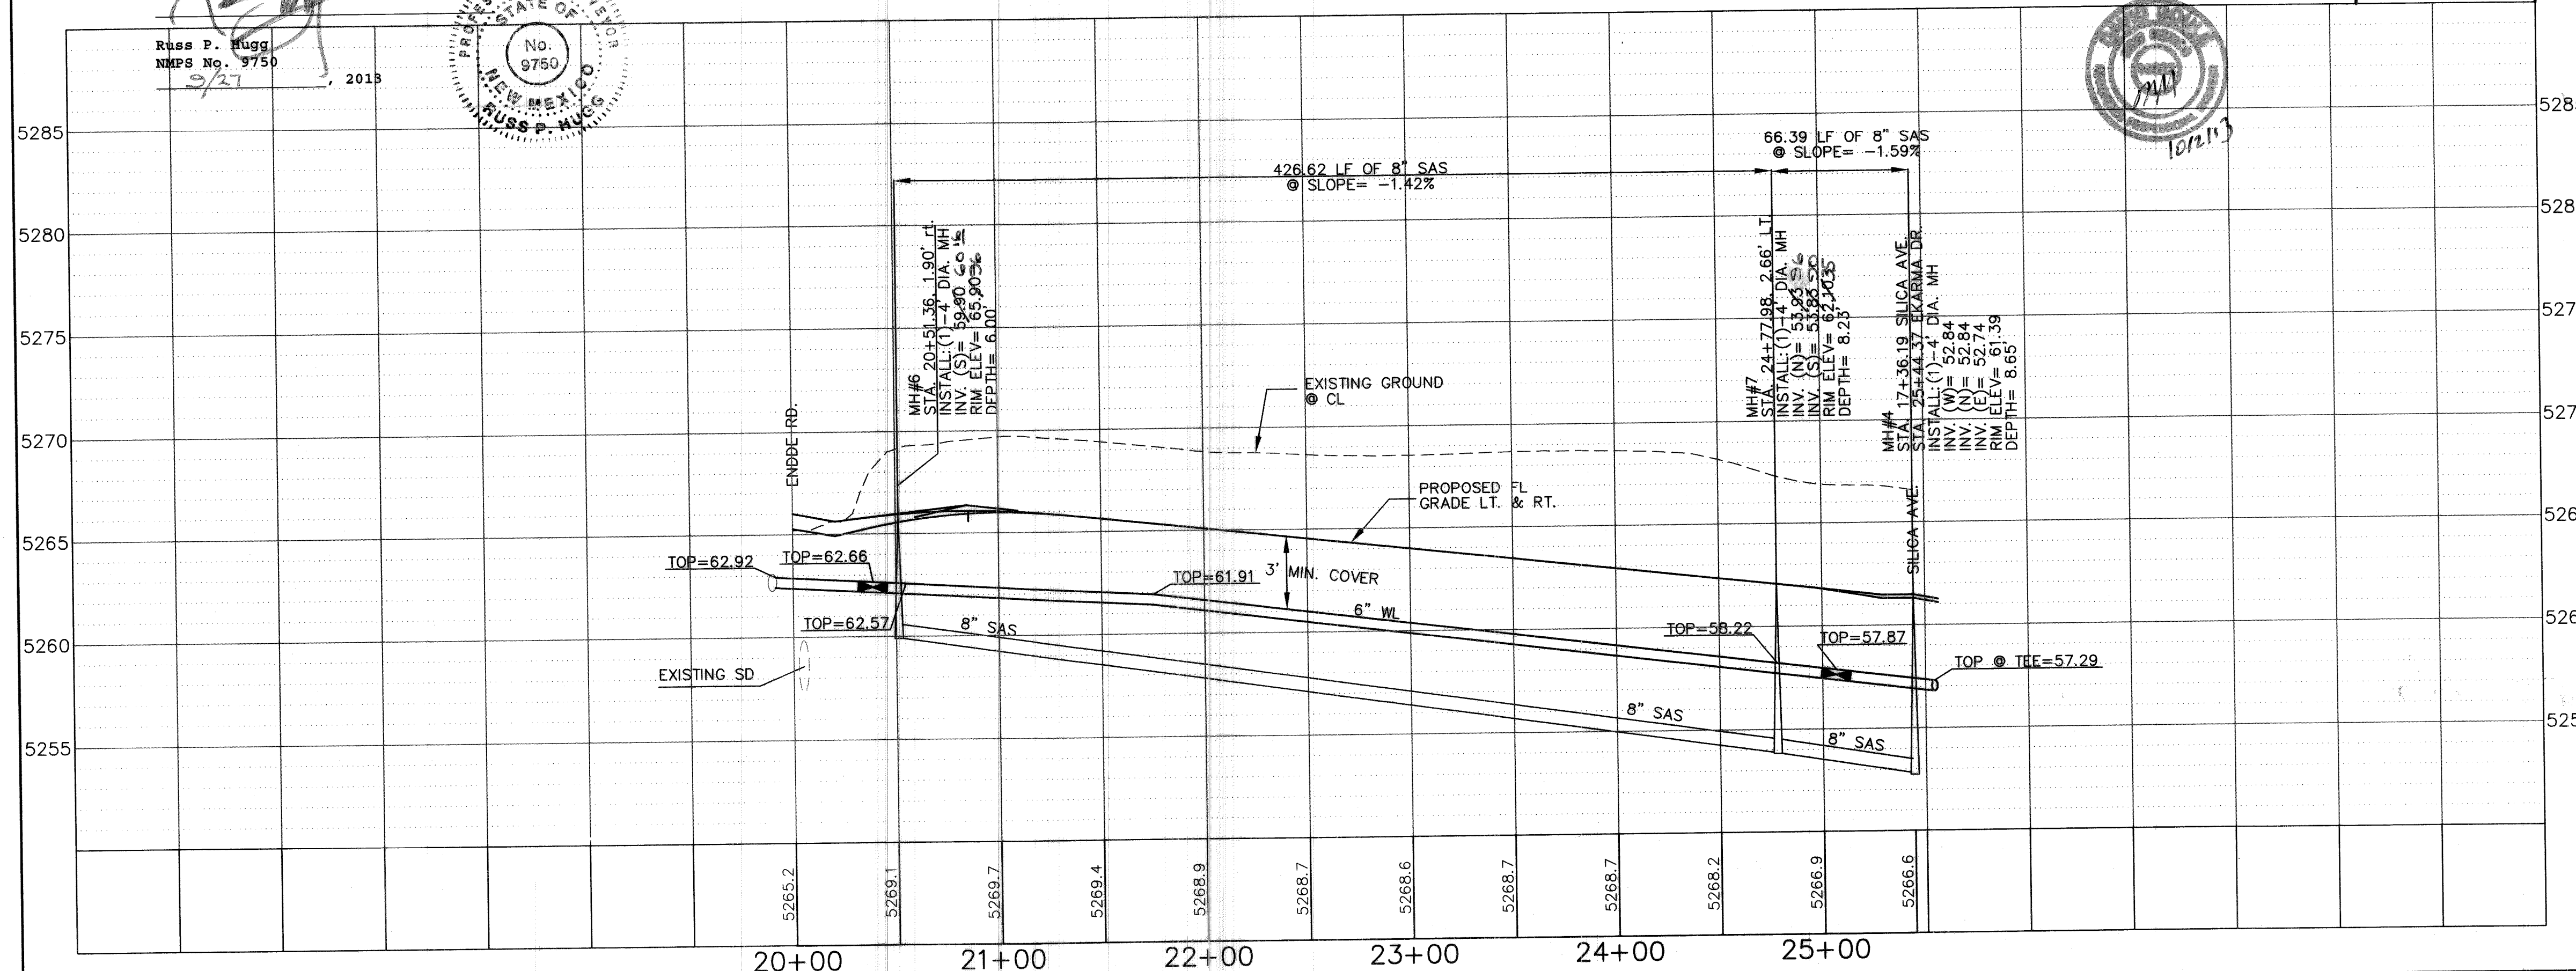


LEGEND

- EXISTING SAS MANHOLE
- EXISTING WATER VALVE
- EXISTING FIRE HYDRANT
- EXISTING STORM DRAIN MANHOLE
- EXISTING WATER LINE
- EXISTING SAS LINE
- PROPOSED SANITARY SEWER
- PROPOSED SAS MANHOLE PER COA STD DWG 2102
- PROPOSED SANITARY SEWER SERVICE LINE PER COA STD DWGS
- PROPOSED WATER LINE
- PROPOSED FIRE HYDRANT PER COA STD DWG 2340
- PROPOSED GATE VALVE PER COA STD DWGS
- PROPOSED CROSS, TEE, OR ELBOW PER COA STD DWGS
- PROPOSED SINGLE 3/4" METER, WATER SERVICE LINE PER COA STD DWGS
- PROPOSED DOUBLE 3/4" METER, WATER SERVICE LINES PER COA STD DWGS

UTILITY NOTES:

- CONTRACTOR RESPONSIBLE FOR LOCATION OF ALL EXISTING UTILITIES PRIOR TO WORK.
- PROPOSED 6" WL HAS 3' MIN. COVER
- ALL PROPOSED MANHOLE LIDS TO MATCH WITH PROPOSED PAVEMENT
- CITY STANDARDS TO BE USED ON ALL UTILITIES UNLESS OTHERWISE NOTED.
- DO NOT INSTALL STEPS IN SAS MANHOLES.

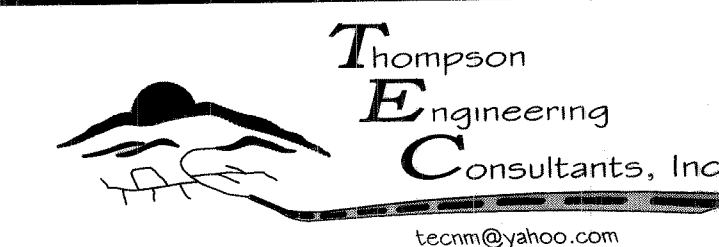

P.O. BOX 65760 ALBUQUERQUE, NM 87193
PHONE: (505) 271-2199 FAX: (505) 830-9248
tecnm@yahoo.com

**CITY OF ALBUQUERQUE
PUBLIC WORKS DEPARTMENT
TRANSPORTATION DEVELOPMENT**

SUNDORO SOUTH UNIT 9 EKARMA DRIVE UTILITY PLAN & PROFILE

DESIGN REVIEW COMMITTEE	CITY ENGINEER APPROVAL	MO./DAY/YR.	MO./DAY/YR.
APPROVE SEP 28 2011 DESIGN REVIEW COMMITTEE	APPROVE SEP 28 2011 CITY ENGINEER		
City Project No. 7270.80	Zone Map No. J-9-Z	Sheet 12	Of 12