

SCANNED BY
PLANNING

CONSTRUCTION PLANS FOR *SUNDORO SOUTH SUBDIVISION* UNIT 5

ALBUQUERQUE, NEW MEXICO

2 3 4 5 6 7 8 9 10 11 12 13 14 15
26-7270-84 0611

SURVEYOR'S CERTIFICATION

I, WILL PLOTNER JR., A DULY QUALIFIED, REGISTERED, PROFESSIONAL LAND SURVEYOR UNDER THE LAWS OF THE STATE OF NEW MEXICO, DO HEREBY CERTIFY THAT THE 'AS-BUILT' INFORMATION SHOWN ON THESE DRAWINGS WAS OBTAINED FROM FIELD CONSTRUCTION AND 'AS-BUILT' SURVEYS PERFORMED BY ME OR UNDER MY SUPERVISION, THAT THE 'AS-BUILT' INFORMATION SHOWN ON THESE DRAWINGS WAS ADDED BY ME OR UNDER MY SUPERVISION, AND THAT THIS 'AS-BUILT' INFORMATION IS TRUE AND CORRECT TO THE BEST OF MY KNOWLEDGE AND BELIEF. CARTESIAN SURVEYS IS NOT RESPONSIBLE FOR ANY OF THE DESIGN CONCEPTS, CALCULATIONS, ENGINEERING, OR INTENT OF THE RECORD DRAWINGS.

WILL PLOTNER JR., NMPS 14271

3/6/06



INDEX TO DRAWINGS

SHEET NO.	SHEET
1	TITLE SHEET
2-4	PLAT
5A-5B	GRADING & DRAINAGE PLAN
6-7	MASTER PAVING PLAN
8-16	PAVING IMPROVEMENTS
17-18	MASTER UTILITY PLAN
19-27	UTILITY IMPROVEMENTS


CERTIFICATE OF SUBSTANTIAL COMPLIANCE ON PLANS

I, Diane Hoelzer, NMPE 11967, of the firm Mark Goodwin & Associates, P.A., a Registered Professional Engineer in the State of New Mexico, do hereby certify, to the best of my knowledge and belief, that the infrastructure installed as part of this project has been inspected by me or by a qualified person under my direct supervision, and has been constructed in accordance with the plans and specifications approved by the City Engineer and that the original design intent of the approved plans has been met, except as noted by me on the as-built construction drawings. This Certification is based on site inspections by me or personnel under my direction, and survey information provided by Will Plotner, NMPS number 14271.

Diane Hoelzer 6-7-06
Diane Hoelzer NMPE 11967



DRB NO. 1003606

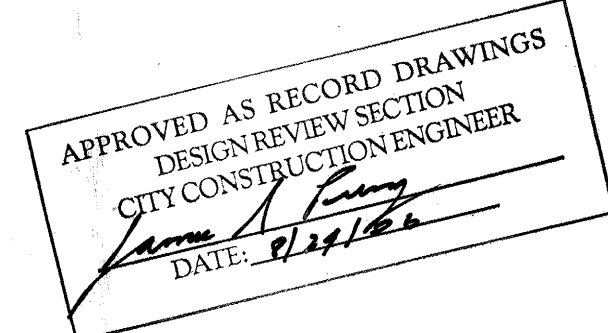


CAUTION:

NOTE THAT ALL EXISTING UTILITIES MAY NOT BE SHOWN. ALL EXISTING SERVICE CONNECTIONS ARE NOT SHOWN. ANY EXISTING UTILITIES THAT ARE SHOWN ARE APPROXIMATE LOCATION ONLY. IT SHALL BE THE SOLE RESPONSIBILITY OF THE CONTRACTOR TO CONTACT ALL THE UTILITY OWNERS AND TO CONDUCT ALL NECESSARY FIELD INVESTIGATIONS PRIOR TO ANY EXCAVATIONS TO DETERMINE THE ACTUAL LOCATION OF UTILITIES AND OTHER IMPROVEMENTS.

dmg D. MARK GOODWIN & ASSOCIATES, P.A.
CONSULTING ENGINEERS
P. O. BOX 90606
ALBUQUERQUE, NEW MEXICO 87199
(505) 828-2200, FAX (505) 797-9539

REV.	SHEETS	CITY ENGINEER	DATE	USER DEPARTMENT	DATE	USER DEPARTMENT	DATE
ENGINEERS STAMP & SIGNATURE		APPROVALS		ENGINEER		DATE	
		DRC CHAIRMAN		6-21-05		APPROVED FOR CONSTRUCTION	
		TRANSPORTATION		5/6/05			
		WATER/WASTEWATER		5/09/05			
		HYDROLOGY		5/6/05			
		CIP		5/6/05			
CONSTR. MGMT.		7-15-05		CITY ENGINEER		DATE	
CONSTR. COORD.		7-15-05					
CITY PROJECT NO.		727084		SHEET		OF	
				1		27	

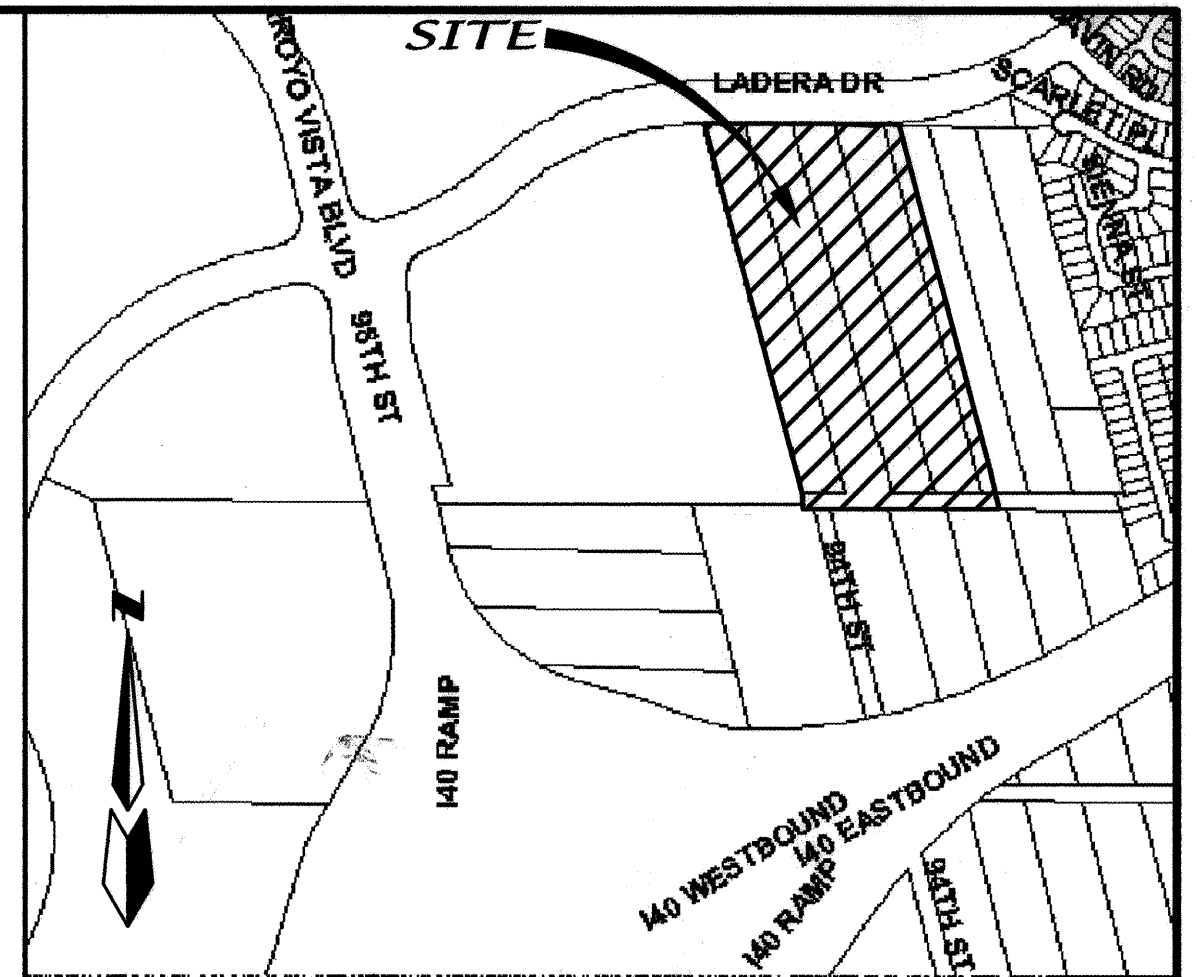

VICINITY MAP ZONE ATLAS: J-8/9-Z
SCALE: NONE


GENERAL NOTES

NOTICE TO CONTRACTORS

- AN EXCAVATION/CONSTRUCTION PERMIT WILL BE REQUIRED BEFORE BEGINNING ANY WORK WITHIN THE CITY RIGHT-OF-WAY.
- ALL WORK DETAILED ON THESE PLANS TO BE PERFORMED UNDER CONTRACT SHALL, EXCEPT AS OTHERWISE STATED OR PROVIDED FOR HEREON, BE CONSTRUCTED IN ACCORDANCE WITH THE CITY OF ALBUQUERQUE STANDARD SPECIFICATIONS FOR PUBLIC WORKS CONSTRUCTION, 1986 EDITION AS REVISED THROUGH UPDATE #7.
- TWO WORKING DAYS PRIOR TO ANY EXCAVATION, THE CONTRACTOR MUST CONTACT NEW MEXICO ONE CALL SYSTEM (260-1990) FOR LOCATION OF EXISTING UTILITIES.
- PRIOR TO CONSTRUCTION, THE CONTRACTOR SHALL EXCAVATE AND VERIFY THE HORIZONTAL AND VERTICAL LOCATIONS OF ALL OBSTRUCTIONS. SHOULD A CONFLICT EXIST, THE CONTRACTOR SHALL NOTIFY THE ENGINEER IMMEDIATELY SO THAT THE CONFLICT CAN BE RESOLVED WITH A MINIMUM AMOUNT OF DELAY.
- FIVE (5) WORKING DAYS PRIOR TO BEGINNING OF CONSTRUCTION, THE CONTRACTOR SHALL SUBMIT TO CONSTRUCTION COORDINATION DIVISION A DETAILED CONSTRUCTION SCHEDULE. TWO (2) WORKING DAYS PRIOR TO THE START OF CONSTRUCTION, THE CONTRACTOR SHALL OBTAIN A BARRICADE PERMIT FROM THE CONSTRUCTION COORDINATION DIVISION. CONTRACTOR SHALL NOTIFY THE CONSTRUCTION COORDINATION ENGINEER (924-3400) PRIOR TO OCCUPYING AN INTERSECTION. REFER TO SECTION 19 OF THE GENERAL CONDITIONS OF THE STANDARD SPECIFICATIONS.
- ALL WORK AFFECTING ARTERIAL ROADWAYS REQUIRES TWENTY-FOUR HOUR CONSTRUCTION.
- ALL STREET STRIPING ALTERED OR DESTROYED SHALL BE REPLACED WITH PLASTIC REFLECTORIZED PAVEMENT MARKING BY CONTRACTOR TO THE SAME LOCATION AS WAS EXISTING, OR AS INDICATED BY THIS PLAN SET.
- CONTRACTOR SHALL NOTIFY THE ENGINEER NOT LESS THAN SEVEN (7) DAYS PRIOR TO STARTING WORK IN ORDER THAT THE CITY SURVEYOR MAY TAKE NECESSARY MEASURES TO INSURE THE PRESERVATION OF SURVEY MONUMENTS. CONTRACTOR SHALL NOT DISTURB PERMANENT SURVEY MONUMENTS WITHOUT THE CONSENT OF THE CITY SURVEYOR AND SHALL NOTIFY THE CITY SURVEYOR AND BEAR THE EXPENSE OF REPLACING ANY THAT MAY BE DISTURBED WITHOUT PERMISSION. REPLACEMENT SHALL BE DONE ONLY BY THE CITY SURVEYOR. WHEN A CHANGE IS MADE IN THE FINISHED ELEVATIONS OF ANY ROADWAY IN WHICH A PERMANENT SURVEY MONUMENT IS LOCATED, CONTRACTOR SHALL, AT HIS OWN EXPENSE, ADJUST THE MONUMENT TO COVER THE NEW GRADE UNLESS OTHERWISE SPECIFIED. REFER TO SECTION 4.4 OF THE GENERAL CONDITIONS OF THE STANDARD SPECIFICATIONS.
- CONTRACTOR SHALL RECORD DATA ON ALL UTILITY LINES AND ACCESSORIES AS REQUIRED BY THE CITY OF ALBUQUERQUE FOR THE PREPARATION OF "AS CONSTRUCTED" DRAWINGS. CONTRACTOR SHALL NOT COVER UTILITY LINES AND ACCESSORIES UNTIL ALL DATA HAVE BEEN RECORDED.
- CONTRACTOR SHALL MAINTAIN A GRAFFITI-FREE WORK SITE. CONTRACTOR SHALL PROMPTLY REMOVE ANY GRAFFITI FROM ALL EQUIPMENT, WHETHER PERMANENT OR TEMPORARY.
- CONTRACTOR SHALL COORDINATE WITH THE CITY OF ALBUQUERQUE WATER SYSTEMS DIVISION (857-8200) SEVEN (7) WORKING DAYS IN ADVANCE OF ANY WORK THAT MAY AFFECT EXISTING PUBLIC WATER OR SEWER UTILITIES. EXISTING VALVES TO BE OPERATED BY CITY PERSONNEL ONLY. CONTRACTOR SHALL CONTACT THE WATER SYSTEMS DIVISION SEVEN (7) WORKING DAYS PRIOR TO NEEDING VALVES TURNED ON OR OFF.
- FOR STORM DRAIN CONSTRUCTION, RCP JOINTS SHALL NOT BE GROUTED PRIOR TO FINAL INSPECTION. FINAL INSPECTION WILL DETERMINE JOINTS TO BE GROUTED FOR FINAL ACCEPTANCE OF THE CONSTRUCTION.

THE FOLLOWING NOTES ALSO APPLY WHEN CHECKED

- ☒ ALL UTILITIES AND UTILITY SERVICE LINES SHALL BE INSTALLED PRIOR TO PAVING.
- ☒ BACKFILL COMPACTION SHALL BE ACCORDING TO SPECIFIED STREET USE.
- ☒ TACK COAT REQUIREMENTS SHALL BE DETERMINED BY THE ENGINEER.
- ☒ SIDEWALK AND WHEELCHAIR RAMPS WITHIN THE CURB RETURNS SHALL BE CONSTRUCTED WHEREVER A NEW CURB RETURN IS CONSTRUCTED.
- ☒ IF CURB IS DEPRESSED FOR A DRIVEPAD, THE DRIVEPAD SHALL BE CONSTRUCTED PRIOR TO ACCEPTANCE OF CURB AND GUTTER.
- ☒ ALL STORM DRAINAGE FACILITIES SHALL BE COMPLETED PRIOR TO FINAL ACCEPTANCE.

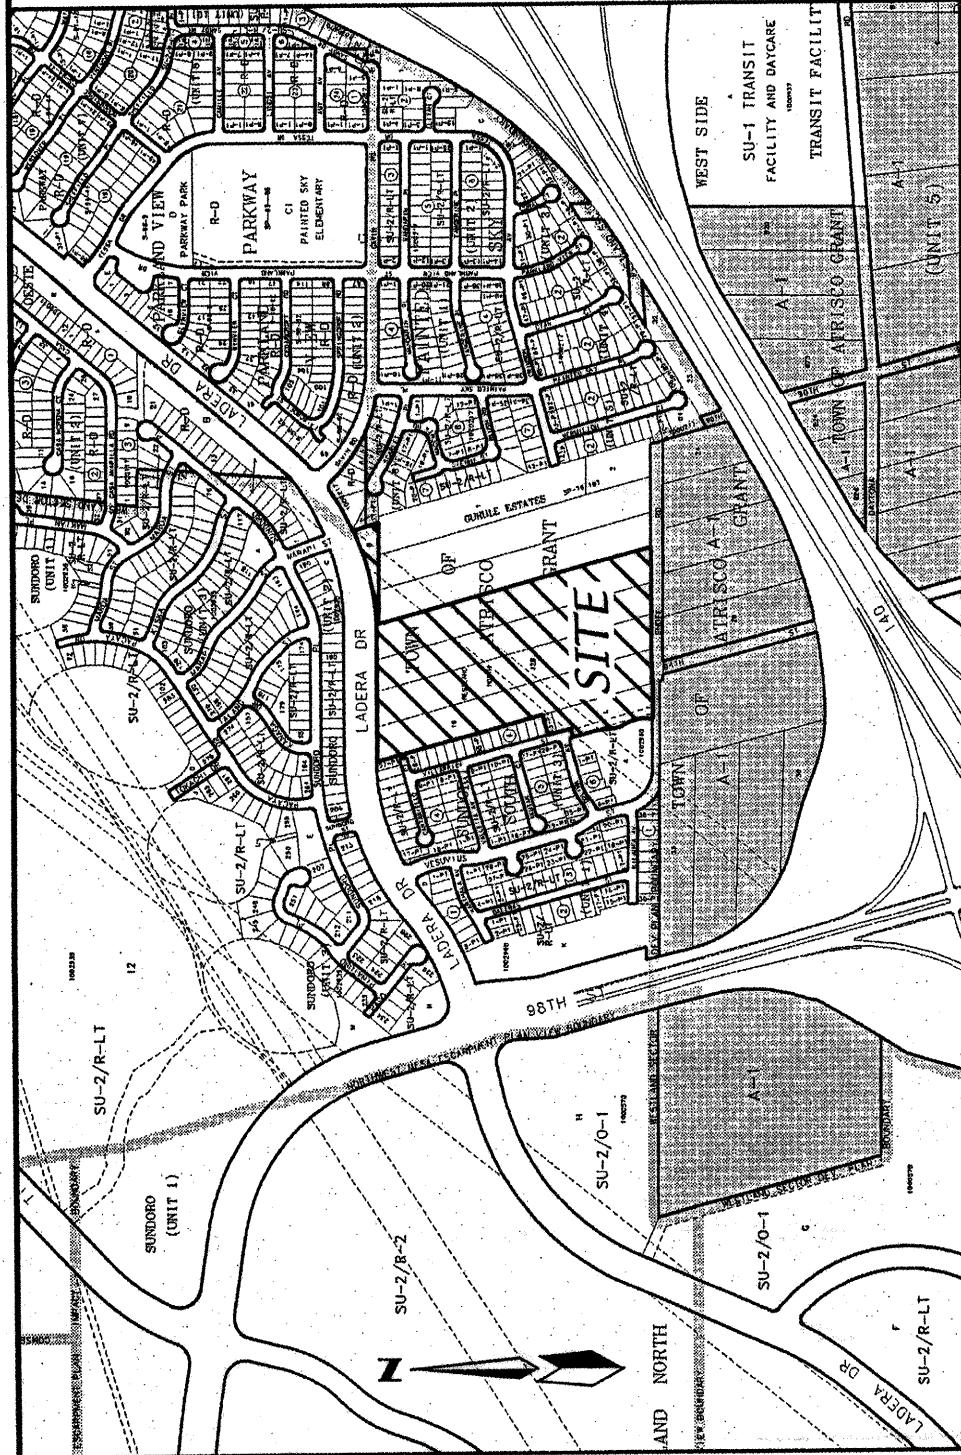

LOCATION MAP

ZONE ATLAS J-8-Z
SCALE: NONE

SUBDIVISION DATA

Gross acreage..... 22.2542 AC
Zone Atlas No..... J-8-Z & J-9-Z
No. of existing Lots/Tracts/Parcels..... 1 Lot/2 Tracts/1 Parcel
No. of Lots/Tracts created..... 123 Lots/ 5 Tracts
No. of Lots/Tracts/Parcels eliminated..... 1 Lot/2 Tracts/1 Parcel
Miles of full width streets created..... 0.73
Right-of-way area vacated..... 0.0139 AC
RW Area dedicated to the City of Albuquerque..... 4.2387 AC
Public Park Area dedicated to the City of Albuquerque..... 1.0684 AC
Date of Survey..... July, 2004
Utility Control Location System Log Number..... 2004-360021
Zoning..... SU-2 for RLt

FREE CONSENT AND DEDICATION:

The subdivision hereon described is with the free consent and in accordance with the desires of the undersigned owner(s) and/or proprietor(s) thereof and said owner(s) and/or proprietor(s) do hereby dedicate all streets and public right-of-ways shown hereon to the City of Albuquerque in fee simple with warranty covenants and do hereby grant: all access, utility and drainage easements shown hereon including the right to construct, operate, inspect, and maintain facilities therein; and all public utility easements shown hereon for the common and joint use of gas, electrical power and communication services for buried distribution lines, conduits, and underground utilities where shown or indicated, and including the right of ingress and egress for construction and maintenance, and the right to trim interfering trees and shrubs. Said owner(s) and/or proprietor(s) do hereby consent to all of the foregoing and do hereby certify that this subdivision is their free act and deed. Said owner(s) warrant that they hold among them complete and indefeasible title in fee simple to the land subdivided.

Owner: Westland Development Co., Inc.
BY: Barbara Page
President & C.E.O., Westland Development Co., Inc.

OWNER'S ACKNOWLEDGMENT

STATE OF NEW MEXICO
COUNTY OF BERNALILLO
SS

This instrument was acknowledged before me on
By: Barbara Page, President & C.E.O., Westland Development Co., Inc. A New Mexico Corporation on behalf of said corporation

NOTARY PUBLIC

MY COMMISSION EXPIRES

LEGAL DESCRIPTION

A tract of land situate within the Town of Atrisco Grant, projected Section 16, Township 10 North, Range 2 East, New Mexico Principal Meridian, City of Albuquerque, Bernalillo County, New Mexico being all of PARCEL J-2-B, WESTLAND NORTH, as the same is shown and designated on said plat filed for record in the office of the County Clerk of Bernalillo County, New Mexico on September 17, 2003, Book 2003C, Page 283 and all of LOT-43-P1, BLOCK 4 and all of TRACT L, SUNDORO SOUTH SUBDIVISION, UNIT 1 as the same is shown and designated on said plat filed for record in the office of the County Clerk of Bernalillo County, New Mexico on July 28, 2004 in Book 2004C, Page 220 and all of TRACT B, PAINTED SKY SUBDIVISION, UNIT 1 as the same is shown and designated on said plat filed for record in the office of the County clerk of Bernalillo County, New Mexico on August 10, 2001 in Book 2001C, Page 231, together with an undesignated TRACT OF LAND as the same is shown and described in a WARRANTY DEED filed for record in the office of the County Clerk of Bernalillo County, New Mexico on December 18, 2003, in Book A70, Page 4355 and a TRACT OF LAND as the same is described in a WARRANTY DEED filed for record in the office of the County Clerk of Bernalillo County, New Mexico on January 4, 2002, in Book A30, Page 1967, together with an undesignated TRACT OF LAND as the same is described in a WARRANTY DEED filed for record in the office of the County Clerk of Bernalillo County, New Mexico on January 30, 1997, as document No. 97043091, together with a portion of ENDEE ROAD N.W. and containing 22.2542 acres, more or less.

PURPOSE OF PLAT

- Create 123 residential lots and 5 tracts
- Dedicate new Right-of-way as shown hereon.
- Grant easements as shown hereon.
- Vacate Public Right-of-way and easement as shown hereon.

NOTES
SEE SHEET 3
PUBLIC UTILITY EASEMENTS
PUBLIC UTILITY EASEMENTS shown on this plat are granted for the common and joint use of:

- The PNM Electric Services Division for the installation, maintenance and service of underground electrical lines, transformers, poles and any other equipment, fixtures, structures and related facilities reasonably necessary to provide electrical service.
- The PNM Gas Services Division for installation, maintenance, and service of natural gas lines, valves and any other equipment and facilities reasonably necessary to provide natural gas.
- Qwest for installation, maintenance and service of such underground lines, cable and other related equipment and facilities reasonably necessary to provide communication services, including but not limited to above ground pedestals and closures.
- Comcast cable for installation, maintenance and service of such underground lines, cable and other related facilities reasonably necessary to provide Cable TV service.

Included, is the right to build, rebuild, construct, reconstruct, locate, Relocate, change, remove, modify, renew, operate and maintain facilities for the purposes described above, together with the free access to, from and over said easement, including sufficient working area space for electric transformers, with the right and privilege to trim and remove trees, shrubs or bushes which interfere with the purposes set forth herein. No building, sign, pool (above ground or subsurface), hot tub, concrete or wood pool decking or other structure shall be erected or constructed on said easements, nor shall any well be drilled or operated thereon. Property owners shall be solely responsible for correcting any violations of National Electrical Safety Code caused by construction of pools, decking or any structures adjacent to within or near easements shown on this plat.

In approving this plat, the utility companies did not conduct a Title Search of the properties shown hereon. Consequently, the utility companies do not waive or release any easement or easement rights which may have been granted by prior plat, replat or other document and which are not shown on this plat.

Easements for electric transformers/switchgears, as installed, shall extend ten feet (10') in front of transformer/switchgear doors and five feet (5') on each side.

PLAT FOR
SUNDORO SOUTH SUBDIVISION UNIT 5

WITHIN THE
TOWN OF ATRISCO GRANT
PROJECTED SECTION 16
TOWNSHIP 10 NORTH, RANGE 2 EAST, NM 17
CITY OF ALBUQUERQUE
BERNALILLO COUNTY, NEW MEXICO
MARCH, 2005

APPROVED AND ACCEPTED BY:

APPROVAL AND CONDITIONAL ACCEPTANCE as specified by the Albuquerque subdivision Ordinance, Chapter 14 Article 14 of the Revised Ordinances of Albuquerque, New Mexico, 1994.

Project Number: 1003606

Application Number: _____

PLAT APPROVAL


Utility Approvals:

PNM Electric Services	Date
PNM Gas Services	Date
Qwest	Date
Comcast	Date
City Approvals:	
City Surveyor	Date
Real Property Division	Date
Traffic Engineering, Transportation Division	Date
Utilities Development	Date
Parks and Recreation Department	Date
AMAFCA	Date
City Engineer	Date
DRB Chairperson, Planning Department	Date

SURVEYOR'S CERTIFICATION

"I, Timothy Aldrich, a duly qualified Registered Professional Land Surveyor under the laws of the State of New Mexico, do hereby certify that this plat and description were prepared by me or under my supervision, shows all easements as shown on the plat of record or made known to me by the owners and/or proprietors of the subdivision shown hereon, utility companies and other parties expressing an interest and meets the minimum requirements for monumentation and surveys of the Albuquerque Subdivision Ordinance, and further, meets the Minimum Standards for Land Surveying in the State of New Mexico, and is true and correct to the best of my knowledge and belief."

Timothy Aldrich P.S. No. 7719

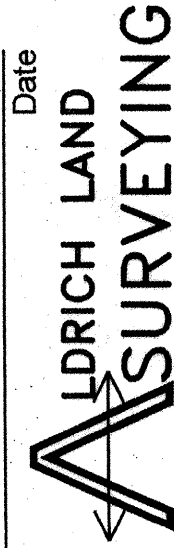

P.O. BOX 30701, ALBU., N.M. 87190
505-884-1990

Dwg: US-FPS1.dwg	Drawn: RICHARD	Checked: ALS	Sheet 1 of 6
Scale: AS NOTED	Date: 03/22/05	Job: A04046 (A03070)	

PLAT FOR
SUNDORO SOUTH SUBDIVISION
UNIT 5

WITHIN THE
TOWN OF ATRISCO GRANT
PROJECTED SECTION 16
TOWNSHIP 10 NORTH, RANGE 2 EAST, NM 17
CITY OF ALBUQUERQUE
BERNALILLO COUNTY, NEW MEXICO
FEBRUARY, 2005

EASEMENTS

- EXISTING 100' PNM EASEMENT (04-12-56, BK. MSC. D348, PGS. 43-47)
- EXISTING 30' PUBLIC SANITARY SEWER AND STORM SEWER EASEMENT (07-28-04, 04C-220)
- EXISTING 10' PUBLIC UTILITY EASEMENT (07-28-04, 04C-220)
- EXISTING 2' PRIVATE DRAINAGE EASEMENT (07-28-04, 04C-220) TYP.
- EXISTING PUBLIC DRAINAGE EASEMENT (03-30-04, BK. A75, PG.1221)
- EXISTING 38' TEMPORARY PUBLIC ACCESS EASEMENT (07-28-04, 04C-220)

PROPERTY CORNERS

- SET 5/8" REBAR WITH CAP "ALS LS 7719"
- FOUND 5/8" REBAR WITH CAP "ALS LS 7719"
- FOUND 5/8" REBAR WITH CAP "LS 11983"
- FOUND 5/8" REBAR WITH CAP "LS 10464"

SITE BENCHMARK


ACS MONUMENT
"BH-40"
ELEVATION=5305.43
(SLD 1929)

LEGEND

- 1-P1 LOT NUMBER
- ▲ CENTER LINE MONUMENT
- △ EXIST. CENTER LINE MONUMENT
- R/W RIGHT-OF-WAY
- (HATCHED AREA) STREET RIGHT-OF-WAY VACATED = 0.0139 AC V# 04DRB-01689

NUMBER	DIRECTION	DISTANCE
L1	S 00°38'54" W	6.92' (6.97)
L2	S 89°21'06" E	47.44'
L3	S 15°16'29" E	1353.58' (1353.79)
L4	S 89°59'28" E	442.34' (S 89°57'54" E)
L5	S 88°27'22" W	157.90'
L6	N 89°48'05" W	245.49'
L14	N 15°20'22" W	127.25'
L15	N 74°39'38" E	44.00'
L16	N 15°20'22" W	113.00'
L17	N 74°39'38" E	100.00'
L18	N 15°20'22" W	824.25'
L19	S 89°59'57" E	611.68'
L20	S 15°20'06" E	125.23'
L21	N 89°21'06" W	472.96'

NUMBER	DELTA	ANGLE	RADIUS	ARC LENGTH	TANGENT	CHORD	CHORD LENGTH
C2	93°23'02"		20.00'	32.63'	21.25'	N 43°27'24" E	29.13'
C3	23°28'51"		278.00'	113.93'	57.78'	N 15°01'32" W	113.13'
C4	24°57'45"		202.00'	88.01'	44.71'	N 14°17'05" W	87.31'
C5	13°32'10"		158.00'	37.33'	18.75'	N 08°34'17" W	37.24'
C6	00°30'03"		1047.00'	9.15'	4.58'	N 89°45'02" E	9.15'
C7	24°59'38"		1153.00'	502.97'	255.55'	N 77°30'14" E	498.99'

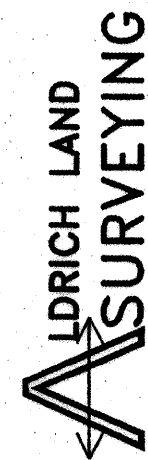


P.O. BOX 30701, ALBU., N.M. 87190
505-884-1990

Dwg: US-FPS2-3.DWG	Drawn: RICHARD	Checked: ALS	Sheet 2 of 6
Scale: 1"=100'	Date: 02/18/05	Job: A04046	

PLAT FOR
**SUNDORO SOUTH SUBDIVISION
UNIT 5**

WITHIN THE
TOWN OF ATRISCO GRANT
PROJECTED SECTION 16
TOWNSHIP 10 NORTH, RANGE 2 EAST, NMPM
CITY OF ALBUQUERQUE
BERNALILLO COUNTY, NEW MEXICO
MARCH, 2005

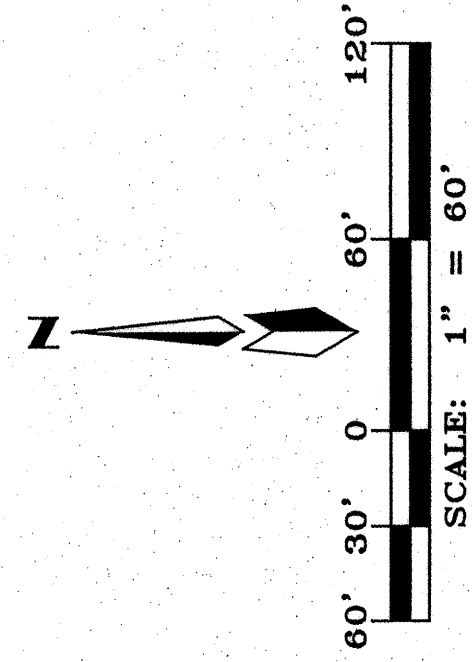

PRIVATE DRAINAGE EASEMENTS

- 1' PRIVATE DRAINAGE EASEMENT
CENTERED ON LOT LINE
(SEE NOTE SHEET 6)
- 2' PRIVATE DRAINAGE EASEMENT
ON LOW SIDE OF LOT LINE
(SEE NOTE SHEET 6)

NEW EASEMENTS

- 38' TEMPORARY PUBLIC
ACCESS EASEMENT GRANTED
TO COA WITH THIS PLAT
- 20' PUBLIC WATERLINE
EASEMENT GRANTED TO THE
COA WITH THIS PLAT
- HOA WALL & LANDSCAPING
EASEMENT (HP)
SEE DETAIL SHEET 4



MONUMENTATION

- SET 5/8" REBAR WITH CAP
*ALS LS 7719" (TYP.)
- FOUND 5/8" REBAR WITH CAP
*LS 11983" (TYP.)
- FOUND N.M.S.H.C. BRASS CAP
*ALS LS 7719" (TYP.)
- EXISTING CENTERLINE MONUMENT
*ALS LS 7719" (TYP.)

ALL STREETS SHOWN
HEREON ARE HEREBY
DEDICATED IN FEE
SIMPLE AS PUBLIC
RIGHT-OF-WAY

Limits of FEMA Floodplain

Until such time that the LOMR is issued by FEMA to remove the floodplain, this area and any future lots that develop in this area, flood insurance may be required by the mortgage company.

**ALDRICH LAND
SURVEYING**

P.O. BOX 30701, ALBU., N.M. 87190
505-884-1990

SEE SHEET 6 FOR LINE AND CURVE DATA

Dwg:	US-FRASE-DWG	Scale:	1"=60'
Drawn:	RICHARD	Date:	03/22/05
Checked:	ALS	Job:	A04046
Sheet	5	of	6

F:\A04046\SS\FINAL PLATS\US-FRASE-DWG\02-18-05 RDQ

F:\A04046\SS\FINAL PLATS\US-FRASE-DWG\02-18-05 RDQ


PLAT FOR
**SUNDORO SOUTH SUBDIVISION
UNIT 5**

WITHIN THE
TOWN OF ATRISCO GRANT
PROJECTED SECTION 16
TOWNSHIP 10 NORTH, RANGE 2 EAST, NMPM
CITY OF ALBUQUERQUE
BERNALILLO COUNTY, NEW MEXICO
FEBRUARY, 2005

PRIVATE DRAINAGE EASEMENTS

2' wide private drainage easements are located in some side yards as shown hereon. Where the difference in elevation between the two adjacent pads is 0.8' or less the easement is centered on the lot line. Where the difference is more than 0.8' but less than 1.4' the easement is entirely on the low side of the lot line and immediately adjacent to that lot owner. Where the easement is centered on the lot line it is for the mutual benefit of both lot owners and is to be jointly maintained. Where the easement is entirely on the low side of the lot line the easement is for the benefit of the adjacent "high side" lot owner and shall be maintained by the underlying "low side" lot owner. Neither lot owner is allowed to change the planned grade within the 2' wide private drainage easement, nor shall either lot owner place any loose material adjacent to the easement that has the potential to be moved into the drainage easement or in any other way block drainage in any portion of the easement, except that a fence or block wall may be centered on the lot line. Under no circumstances shall the grade adjacent to the easement on either side of the easement be changed except by a structurally sound retaining wall, as designed by a registered professional engineer or architect. Where no easement is shown on the plat each lot owner must construct, operate and maintain his own separate swale all the way to the street and cross lot drainage will be prevented by some combination of walls and berms on the common lot line to be jointly maintained by both lot owners.

CURVE	LENGTH	RADIUS	DELTA	TANGENT	CHORD BRG	CHORD
C1	13.71	477.00	191.00°	80.61	N39°29'36"E	158.96
C2	28.28	523.00	305°53'	14.14	S47°32'10"W	28.27
C3	45.12	523.00	4°56'37"	22.58	S43°30'55"W	45.11
C4	20.71	523.00	2°16'22"	10.37	S39°54'26"W	20.74
C5	94.15	523.00	10°18'51"	47.20	S43°55'40"W	94.02
C6	24.26	1023.00	1°21'32"	12.13	S38°05'29"W	24.26
C7	107.76	1023.00	4°20'25"	54.15	S35°55'16"W	107.72
C8	101.76	1023.00	5°41'58"	50.92	S35°55'16"W	101.72
C9	78.83	157.00	28°49'21"	31.69	N44°28'57"E	62.12
C10	34.91	157.00	51°35'20"	16.88	N58°51'57"E	32.14
C11	41.96	25.00	90°00'00"	20.98	S55°20'22"E	32.14
C12	31.94	25.00	90°00'00"	16.88	S32°44'37"W	32.14
C13	29.04	203.00	8°11'48"	14.55	N77°43'53"E	29.02
C14	33.97	203.00	9°35'18"	17.03	N61°38'42"E	33.93
C15	34.64	203.00	9°46'35"	17.36	N61°38'42"E	34.60
C16	4.51	203.00	1°16'23"	2.26	N40°42'34"E	4.51
C17	169.20	203.00	47°45'20"	89.86	N56°56'57"E	164.34
C18	40.68	977.00	2°23'09"	20.35	S44°15'52"W	40.68
C19	45.05	977.00	2°38'37"	22.53	S36°46'42"W	45.05
C20	11.44	977.00	0°40'16"	5.72	S38°28'07"W	11.44
C21	97.18	977.00	5°41'58"	48.63	S35°55'16"W	97.14
C22	33.57	477.00	4°01'57"	16.79	S40°47'13"W	33.57
C23	45.27	477.00	5°28'14"	22.65	S40°47'13"W	45.25
C24	7.03	477.00	0°50'38"	3.51	S48°39'46"W	7.03
C25	85.87	477.00	1°01'51"	43.05	S43°55'40"W	85.75
C26	38.40	523.00	4°12'23"	19.21	N46°58'54"E	38.39
C27	45.07	523.00	4°58'16"	22.53	S44°15'52"W	45.06
C28	45.04	523.00	4°58'04"	22.53	N37°28'25"E	45.03
C29	1.25	523.00	0°08'12"	0.62	N28°58'12"E	1.25
C30	175.11	523.00	191°00'00"	88.38	N39°29'36"E	174.29
C31	35.80	477.00	4°18'01"	17.91	S37°32'03"W	35.79
C32	44.81	477.00	4°18'01"	22.07	S37°32'03"W	44.79
C33	33.05	477.00	9°35'55"	16.88	S34°42'03"W	33.05
C34	79.91	477.00	7°15'46"	40.05	S44°42'03"W	79.82
C35	35.11	277.00	7°15'46"	17.58	S68°31'57"W	35.09
C36	46.06	277.00	9°31'40"	23.08	S51°31'37"W	46.01
C37	18.15	277.00	3°45'17"	9.08	S58°29'12"E	18.15
C38	38.68	25.00	88°38'36"	24.41	N75°37'58"W	38.63
C39	96.66	289.00	19°09'45"	48.78	S40°53'33"E	96.21
C40	39.25	323.00	6°57'44"	19.65	S39°28'56"W	39.22
C41	2.57	323.00	0°27'20"	1.28	S24°14'24"W	2.57
C42	41.82	323.00	7°25'04"	20.84	S27°43'16"W	41.79
C43	37.46	277.00	7°44'51"	18.76	N27°43'08"E	37.43
C44	74.82	277.00	7°44'51"	37.53	N35°37'48"E	74.65
C45	35.80	277.00	15°29'17"	17.91	S35°37'48"E	35.79
C46	14.82	25.00	33°58'21"	7.64	S56°29'12"E	14.61
C47	24.03	40.00	34°25'14"	12.39	S56°29'12"E	23.67
C48	90.09	40.00	129°02'36"	47.79	N39°50'09"E	72.22
C49	69.92	40.00	100°08'47"	47.79	N39°50'09"E	61.35
C50	31.66	25.00	49°38'16"	11.56	S14°40'53"W	20.99
C51	184.03	40.00	263°36'37"	44.73	S58°19'56"E	59.63
C52	39.27	25.00	90°00'00"	25.00	S09°29'59"E	35.36
C53	87.31	323.00	15°29'17"	43.92	N31°45'23"E	87.05
C54	42.82	203.00	12°05'04"	21.49	N44°27'27"W	42.74
C55	40.37	203.00	11°42'42"	20.25	N32°43'03"W	40.31
C56	41.69	203.00	11°42'59"	20.92	N21°08'12"W	41.62
C57	17.54	157.00	28°50'48"	8.78	N36°04'35"W	17.53
C58	49.27	157.00	6°23'59"	25.00	N08°12'12"W	49.27
C59	39.27	25.00	90°00'00"	25.00	N60°15'13"W	35.36
C60	35.95	315.00	3°09'47"	17.99	S71°28'38"W	35.93
C61	47.39	315.00	3°09'47"	26.73	S69°53'44"W	47.39
C62	53.34	315.00	9°42'06"	26.73	S69°53'44"W	53.27
C63	39.27	25.00	90°00'00"	25.00	N08°12'12"W	35.36
C64	41.69	203.00	11°42'59"	20.92	N21°08'12"W	41.62
C65	17.54	157.00	28°50'48"	8.78	N36°04'35"W	17.53
C66	49.27	157.00	6°23'59"	25.00	N08°12'12"W	49.27
C67	39.27	25.00	90°00'00"	25.00	N60°15'13"W	35.36
C68	35.95	315.00	3°09'47"	17.99	S71°28'38"W	35.93
C69	47.39	315.00	3°09'47"	26.73	S69°53'44"W	47.39
C70	53.34	315.00	9°42'06"	26.73	S69°53'44"W	53.27
C71	39.27	25.00	90°00'00"	25.00	N08°12'12"W	35.36
C72	41.69	203.00	11°42'59"	20.92	N21°08'12"W	41.62
C73	17.54	157.00	28°50'48"	8.78	N36°04'35"W	17.53
C74	49.27	157.00	6°23'59"	25.00	N08°12'12"W	49.27
C75	39.27	25.00	90°00'00"	25.00	N60°15'13"W	35.36
C76	35.95	315.00	3°09'47"	17.99	S71°28'38"W	35.93
C77	47.39	315.00	3°09'47"	26.73	S69°53'44"W	47.39
C78	53.34	315.00	9°42'06"	26.73	S69°53'44"W	53.27
C79	39.27	25.00	90°00'00"	25.00	N08°12'12"W	35.36
C80	41.69	203.00	11°42'59"	20.92	N21°08'12"W	41.62
C81	17.54	157.00	28°50'48"	8.78	N36°04'35"W	17.53
C82	49.27	157.00	6°23'59"	25.00	N08°12'12"W	49.27
C83	39.27	25.00	90°00'00"	25.00	N60°15'13"W	35.36
C84	35.95	315.00	3°09'47"	17.99	S71°28'38"W	35.93
C85	47.39	315.00	3°09'47"	26.73	S69°53'44"W	47.39
C86	53.34	315.00	9°42'06"	26.73	S69°53'44"W	53.27
C87	39.27	25.00	90°00'00"	25.00	N08°12'12"W	35.36
C88	41.69	203.00	11°42'59"	20.92	N21°08'12"W	41.62
C89	17.54	157.00	28°50'48"	8.78	N36°04'35"W	17.53
C90	49.27	157.00	6°23'59"	25.00	N08°12'12"W	49.27
C91	39.27	25.00	90°00'00"	25.00	N60°15'13"W	35.36
C92	35.95	315.00	3°09'47"	17.99	S71°28'38"W	35.93
C93	47.39	315.00	3°09'47"	26.73	S69°53'44"W	47.39
C94	53.34	315.00	9°42'06"	26.73	S69°53'44"W	53.27
C95	39.27	25.00	90°00'00"	25.00	N08°12'12"W	35.36
C96	41.69	203.00	11°42'59"	20.92	N21°08'12"W	41.62
C97	17.54	157.00	28°50'48"	8.78	N36°04'35"W	17.53
C98	49.27	157.00	6°23'59"	25.00	N08°12'12"W	49.27
C99	39.27	25.00	90°00'00"	25.00	N60°15'13"W	35.36
C100	35.95	315.00	3°09'47"	17.99	S71°28'38"W	35.93
C101	47.39	315.00	3°09'47"	26.73	S69°53'44"W	47.39
C102	53.34	315.00	9°42'06"	26.73	S69°53'44"W	53.27
C103	39.27	25.00	90°00'00"	25.00	N08°12'12"W	35.36
C104	41.69	203.00	11°42'59"	20.92	N21°08'12"W	41.62
C105	17.54	157.00	28°50'48"	8.78	N36°04'35"W	17.53
C106	49.27	157.00	6°23'59"	25.00	N08°12'12"W	49.27
C107	39.27	25.00	90°00'00"	25.00	N60°15'13"W	35.36
C108	35.95	315.00	3°09'47"	17.99	S71°28'38"W	35.93
C109	47.39	315.00	3°09'47"	26.73	S69°53'44"W	47.39
C110	53.34	315.00	9°42'06"	26.73	S69°53'44"W	53.27
C111	39.27	25.00	90°00'00"	25.00	N08°12'12"W	35.36
C112	41.69	203.00	11°42'59"	20.92	N21°08'12"W	41.62
C113	17.54	157.00	28°50'48"	8.78	N36°04'35"W	17.53
C114	49.27	157.00	6°23'59"	25.00	N08°12'12"W	49.27
C115	39.27	25.00	90°00'00"	25.00	N60°15'13"W	35.36
C116	35.95	315.00	3°09'47"	17.99	S71°28'38"W	35.93
C117	47.39	315.00	3°09'47"	26.73	S69°53'44"W	47.39
C118	53.34	315.00	9°42'06"	26.73	S69°53'44"W	53.27
C119	39.27	25.00	90°00'00"	25.00	N08°12'12"W	35.36
C120	41.69	203.00	11°42'59"	20.92	N21°08'12"W	41.62
C121	17.54	157.00	28°50'48"	8.78	N36°04'35"W	17.53
C122	49.27	157.00	6°23'59"	25.00	N08°12'12"W	49.27
C123	39.27	25.00	90°00'00"	25.00	N60°15'13"W	35.36
C124	35.95	315.00	3°09'47"	17.99	S71°28'38"W	35.93
C125	47.39	315.00	3°09'47"	26.73	S69°53'44"W	47.39
C126	53.34	315.00	9°42'06"	26.73	S69°53'44"W	53.27
C127	39.27	25.00	90°00'00"	25.00	N08°12'12"W	35.36
C128	41.69	203.00	11°42'59"	20.92	N21°08'12"W	41.62
C129	17.54	157.00	28°50'48"	8.78	N36°04'35"W	17.53
C130	49.27	157.00	6°23'59"	25.00	N08°12'12"W	49.27

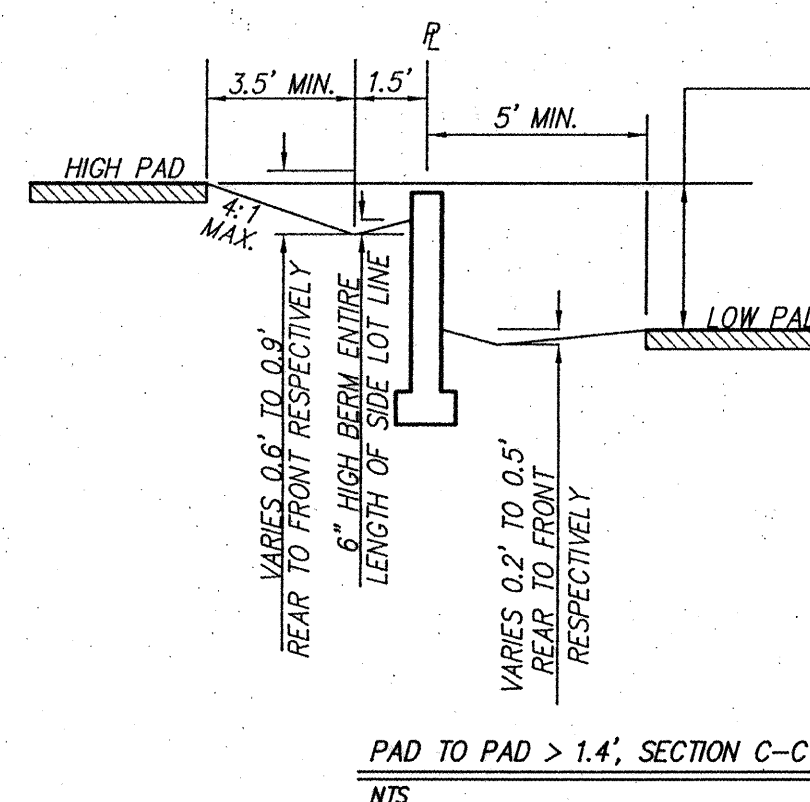

NOTE:


WHERE THE DIFFERENCE IN ELEVATION BETWEEN THE ADJACENT PADS IS 1.4' OR MORE A RETAINING WALL MUST BE CONSTRUCTED BETWEEN THE LOTS AS SHOWN ON THE PLAN AND THERE WILL BE NO PRIVATE DRAINAGE EASEMENT. EACH LOT OWNER MUST CONSTRUCT, OPERATE, AND MAINTAIN HIS OWN SEPARATE DRAINAGE SWALE ALL THE WAY TO THE STREET AND CROSS LOT DRAINAGE WILL BE PREVENTED BY SOME COMBINATION OF WALLS AND BERMS ON THE COMMON LOT LINE TO BE JOINTLY MAINTAINED BY BOTH LOT OWNERS.

	PROPOSED STANDARD CURB & GUTTER
	PROPOSED MOUNTABLE CURB & GUTTER
	PROPOSED SIDEWALK
$.45.50$	PROPOSED SPOT ELEVATION
$FP = 50.0$	PROPOSED FINISHED PAD ELEVATION
	PROPOSED DIRECTION OF FLOW
	PROPOSED SLOPE
	PROPOSED RETAINING WALL
	PROPERTY LINE
	WATER BLOCK

APPROVED ROUGH GRADING $\pm 18"$

CITY HYDROLOGY

A04JOBS/A4046SS/Unit 5/4046-GD50 2-15-05 TAS

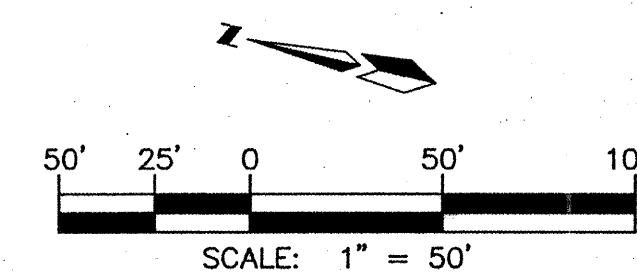


dmg MARK GOODWIN & ASSOCIATES, P.A.
CONSULTING ENGINEERS
P.O. BOX 90606
ALBUQUERQUE, NEW MEXICO 87199
(505) 828-2200, FAX (505) 797-9539

 CITY OF ALBUQUERQUE
PUBLIC WORKS DEPARTMENT

TITLE: *SUNDORO SOUTH
GRADING & DRAINAGE PLAN*

DESIGN REVIEW COMMITTEE	CITY ENGINEER APPROVAL	LAST DESIGN UPDATE	MO./DAY/YR.	MO./DAY/YR.	
For Information Only					
CITY PROJECT NO.	727084	ZONE MAP NO.	1-8/9	SHEET	5A 27

SURVEY INFORMATION			BENCH MARKS		AS BUILT INFORMATION			
NO.	FIELD NOTES		STATION "REWARD IS LOCATED ABOUT 5 MILES WEST OF DOWNTOWN ALBUQUERQUE. TO REACH THE STATION FROM INTERSECTION OF CENTRAL AVE. AND STATE RD. #48 GO WEST ON CENTRAL 1.8 MI. TO MOLASCO RD. ON RT. (90TH ST. ON LT), THEN NORTH ALONG NOLASCO RD. CROSSING OVER US I-4Q, 1.0 MI. TO TRACK RD. LEFT (SW). THEN TAKE TRACK ROAD 0.1 MI. TO Pylon #68 AND STATION TO LEFT. STATION IS STANDARD U.S.G.A.S BRASS TARGET STAMPED "REWARD 1969". SET IN TOP OF A CONCRETE POST PROTRUDING 0.3 FT. ABOVE GROUND X = 350,944.85 Y = 1,487,301.42 ELEV=5316.951 (NGD)		CONTRACTOR	WORK ORDER NO.	DATE	
	BY			INSPECTOR'S ACCEPTANCE BY	CORRELATION SURVEYS INC.	FEB 01		
				DRAWN & VERIFIED BY	CORRELATION SURVEYS INC.	FEB 01		
				CORRELATED BY		DATE		
				RECORDED BY	MICRO-FILM INFORMATION			
				NO.	DATE			

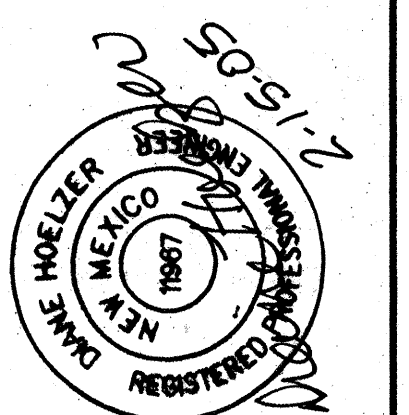[illegible]

SCANNED BY
PLANNING


LEGEND

- PROPOSED STANDARD CURB & GUTTER
- PROPOSED MOUNTABLE CURB & GUTTER
- PROPOSED SIDEWALK
- PROPOSED SPOT ELEVATION
- PROPOSED FINISHED PAD ELEVATION
- PROPOSED DIRECTION OF FLOW
- PROPOSED SLOPE
- PROPOSED RETAINING WALL
- PROPOSED GARDEN WALL
- WATER BLOCK

FUTURE SUNDORO UNIT 9





PAINTED SKY
EXISTING
UNIT 5

FUTURE UNIT 7

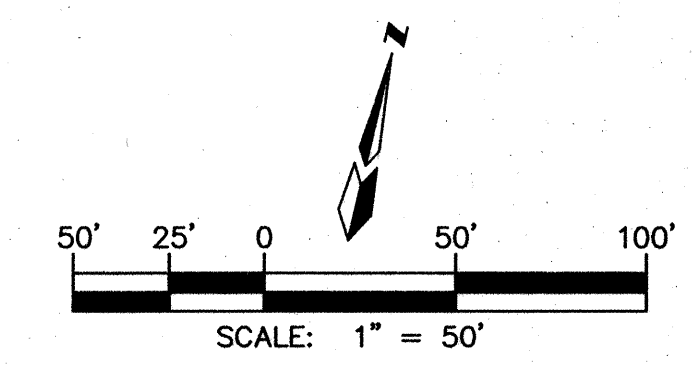

WALL AND GRADE ELEVATION

1 62.20TG 60.70BG	2 63.00TG 60.60BG	3 66.00TG 64.26TBG 60.26BG	4 66.00TG 62.55TBG 58.55BG	5 66.00TG 62.05TBG 58.05BG
6 66.00TG 60.75TBG 56.75BG	7 66.00TG 60.30TBG 56.30BG	8 66.00TG 60.07TBG 54.05BG	9 60.00TG 53.55BG	10 52.60 59.00TG 53.60BG

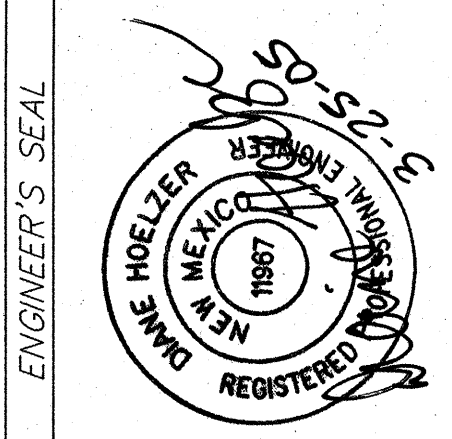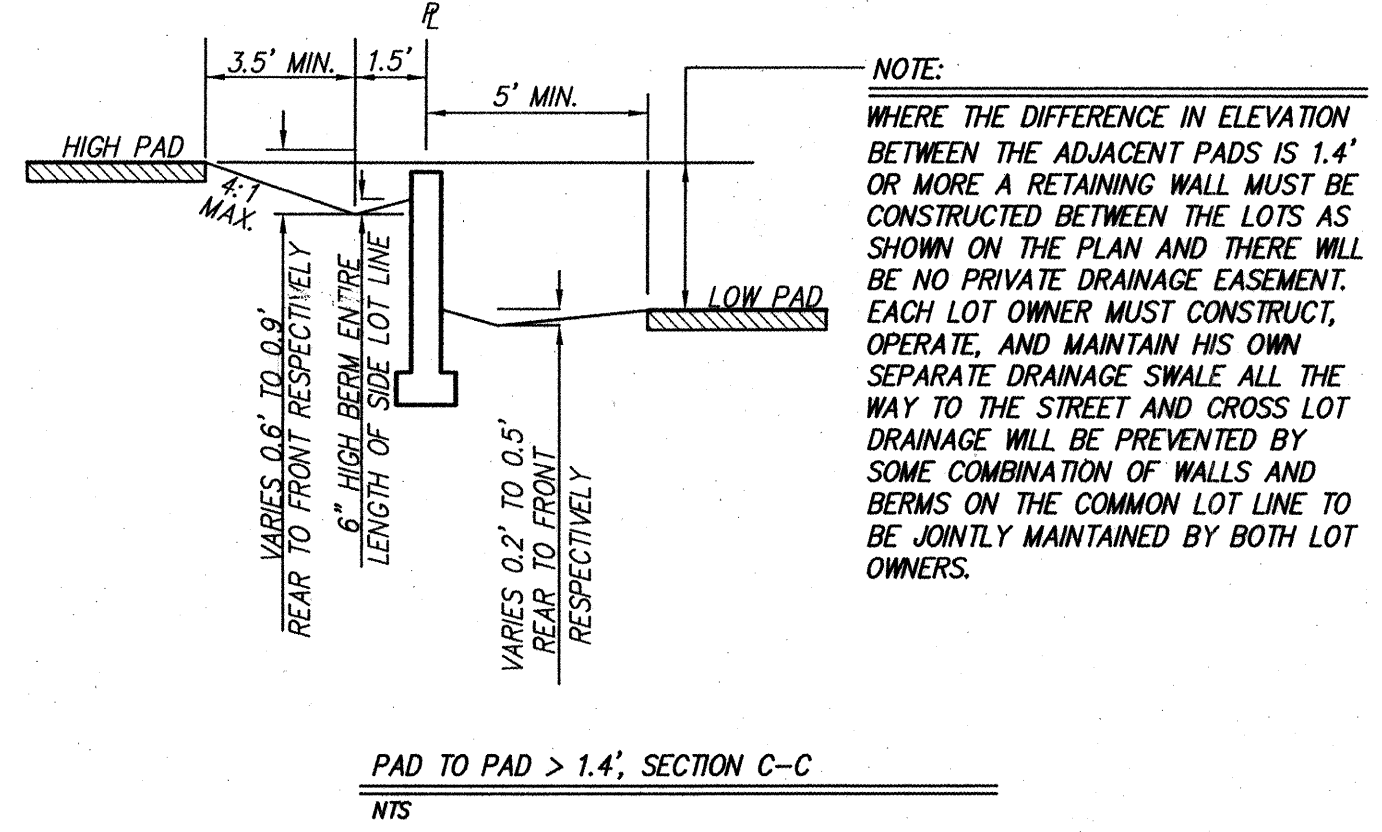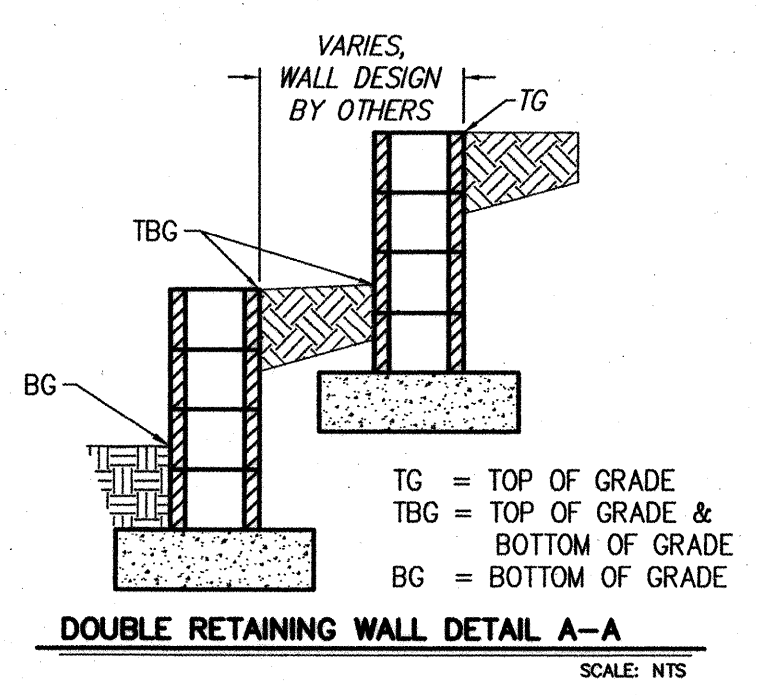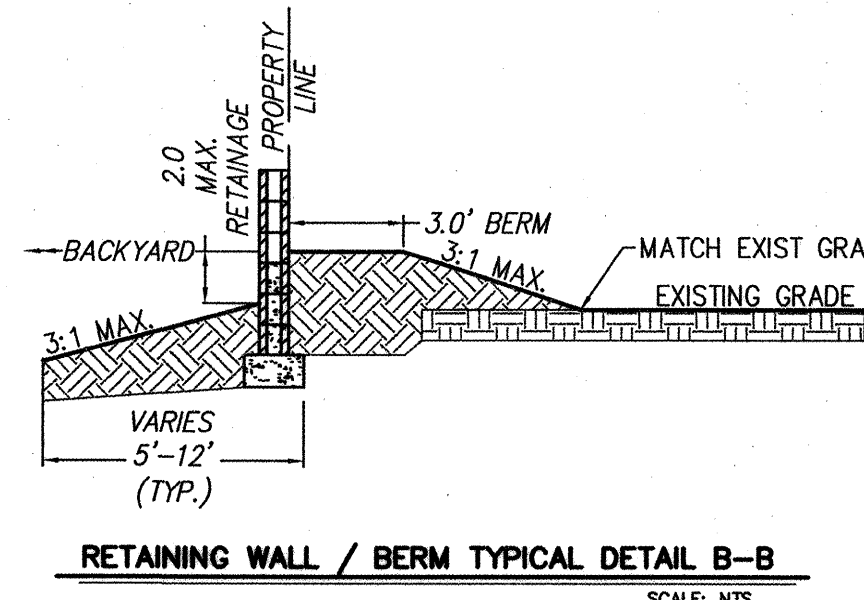

dmg MARK GOODWIN & ASSOCIATES, P.A.
CONSULTING ENGINEERS
P.O. BOX 90606
ALBUQUERQUE, NEW MEXICO 87199
(505) 828-2200, FAX (505) 797-9539

CITY OF ALBUQUERQUE
PUBLIC WORKS DEPARTMENT

TITLE: **SUNDORO SOUTH
GRADING & DRAINAGE PLAN**

DESIGN REVIEW COMMITTEE CITY ENGINEER APPROVAL
For Information Only

CITY PROJECT NO. **727084** ZONE MAP NO. **J-8/9** SHEET **5B 27**

AS BUILT INFORMATION		BENCH MARKS		SURVEY INFORMATION		ENGINEER'S SEAL		REVISIONS		DESIGNED BY		DRAWN BY		CHECKED BY	
CONTRACTOR	DATE	STATION	MARK	NO.	BY	NO.	DATE	NO.	DATE	NO.	DATE	NO.	DATE	NO.	DATE
STATION "REWARD" IS LOCATED ABOUT 5 MILES WEST OF DOWNTOWN ALBUQUERQUE. TO REACH THE STATION FROM INTERSECTION OF CENTRAL AVE. AND STATE RD. 448 GO WEST ON CENTRAL 1.8 MI. TO NOLASCO RD. ON RT. 98TH ST. ON LT. THEN NORTH ALONG NOLASCO RD. CROSSING OVER US 1-40. 1.0 MI. TO PLYM. #68 AND STATION TO LEFT. STATION IS TRACK ROAD 0.1 MI. TO PLYM. #68 AND STATION TO LEFT. STATION IS TRACK ROAD USCAR'S BRASS TABLET STAMPED "REWARD 1987". SET IN TOP OF A CONCRETE POST PROJECTING 0.3 FT. ABOVE GROUND.	DATE	DATE	DATE	DATE	DATE	DATE	DATE	DATE	DATE	DATE	DATE	DATE	DATE	DATE	DATE
STATION "REWARD" IS LOCATED ABOUT 5 MILES WEST OF DOWNTOWN ALBUQUERQUE. TO REACH THE STATION FROM INTERSECTION OF CENTRAL AVE. AND STATE RD. 448 GO WEST ON CENTRAL 1.8 MI. TO NOLASCO RD. ON RT. 98TH ST. ON LT. THEN NORTH ALONG NOLASCO RD. CROSSING OVER US 1-40. 1.0 MI. TO PLYM. #68 AND STATION TO LEFT. STATION IS TRACK ROAD 0.1 MI. TO PLYM. #68 AND STATION TO LEFT. STATION IS TRACK ROAD USCAR'S BRASS TABLET STAMPED "REWARD 1987". SET IN TOP OF A CONCRETE POST PROJECTING 0.3 FT. ABOVE GROUND.	DATE	DATE	DATE	DATE	DATE	DATE	DATE	DATE	DATE	DATE	DATE	DATE	DATE	DATE	DATE

SCANNED BY
PLANNING


CERTIFICATE OF SUBSTANTIAL COMPLIANCE ON PLANS
I, Diane Hoelzer, NMPE 11967, of the firm Mark Goodwin & Associates, P.A., a Registered Professional Engineer in the State of New Mexico, do hereby certify, to the best of my knowledge and belief, that the infrastructure installed as part of this project has been inspected by me or by a qualified person under my direct supervision, and has been constructed in accordance with the plans and specifications approved by the City Engineer and that the original design intent of the approved plans has been met, except as noted by me on the as-built construction drawings. This Certification is based on site inspections by me or personnel under my direction, and survey information provided by Will Plotner, NMPS number 14271.
Diane Hoelzer 6-7-06
Diane Hoelzer NMPE 11967



- NOTES**
1. ALL 4" VALLEY GUTTERS PER CITY OF ALBUQUERQUE STANDARD DRAWING 2421 AT KNUCKLES AND 6" VALLEY GUTTERS PER CITY OF ALBUQUERQUE STANDARD DRAWING 2420 AT ALL INTERSECTIONS AND ALL 10" VALLEY GUTTERS PER COA STD DWG 2422.
 2. ALL 4" INTERIOR SIDEWALKS ARE DEFERRED.
 3. ALL HANDICAP RAMPS TO BE PER CITY STD DWG 2441 CASE II.
 4. TRANSITION FROM MOUNTABLE CURB TO STANDARD CURB SHALL BE 10' PER COA STD DWG 2418.
 5. TRANSITION SECTION FROM FULL CROWN TO NO CROWN TO BE A MINIMUM OF 50', PER COA STD DWG 2401.
 6. ALL SIDEWALKS PER COA STD DWG 2430.
 7. UNI-DIRECTIONAL CURB ACCESS RAMP PER COA STD DWG 2426.
 8. ASHALL PLACE PAVING FROM END OF CUL-DE-SAC TO STA 14+86 USE (2 LIFTS) 1-1/2" A.C. (TYPE "C") AND FROM STA 14+86 TO STA 19+28 USE (2 LIFTS) 2" A.C. (TYPE "B").
 9. BUILD CURB RETURNS WITH 6" VALLEY GUTTER AND PROVIDE TYPE III BARRICADE, IF NECESSARY.

Certification
THE CHANGES SHOWN HEREON ARE BASED UPON A FIELD SURVEY CONDUCTED BY ME OR UNDER MY SUPERVISION AND REFLECT THE LOCATIONS (VERTICALLY AND HORIZONTALLY) TO THE BEST OF MY KNOWLEDGE AND BELIEF.

Will Plotner

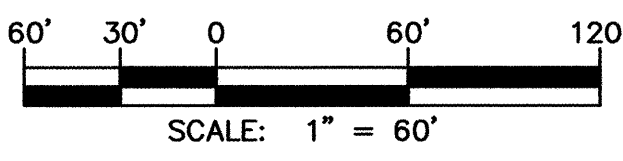

- LEGEND**
- | | |
|--|----------------------------------|
| | NEW MOUNTABLE CURB AND GUTTER |
| | FUTURE MOUNTABLE CURB AND GUTTER |
| | NEW STANDARD CURB AND GUTTER |
| | FUTURE STANDARD CURB AND GUTTER |
| | EXISTING WALL |
| | SIDEWALK THIS PROJECT |
| | DEFERRED SIDEWALK |
| | LOT LINE |
| | RIGHT-OF-WAY LINE |
| | CENTERLINE |
- EXIST NEW**
- | | |
|--|--|
| | STORM DRAIN INLET THIS PROJECT |
| | STREET LIGHT |
| | WHEEL CHAIR RAMP |
| | 50' CROWN TRANSITION SEE NOTE 5 |
| | 25' CROWN TRANSITION SEE NOTE 5 |
| | PROPOSED DRIVEWAY LOCATION (BY OTHERS) |
| | REMOVE & DISPOSE EXISTING PAVEMENT |
| | UNIT PHASE LINE |
| | NEW WATER BLOCK |
| | POWER POLES |
| | RED PATTERNED CONC. PER COA STD. DWG. 2408 |

AS-BUILT INFORMATION				BENCH MARKS				SURVEY INFORMATION			
CONTRACTOR	DATE	BY	NO.	STATION	TO REACH THE STATION FROM INTERSECTION OF CENTRAL AVE. AND STATE RD. 448 GO WEST ON CENTRAL 1.0 MI. TO MOLASCO RD. ON RT. 68TH ST. ON LT., THEN NORTH ALONG MOLASCO RD. CROSSING OVER US 1-40, 1.0 MI. TO TRACK RD. LEFT (SW), THEN TAKE TRACK ROAD 0.1 MI. TO PILEON #PM 68 AND STATION TO LEFT. STATION IS STANDARD USCAR'S BRASS TABLET STAMPED "NEWARK 1969", SET IN TOP OF A CONCRETE POST PROJECTIONS 0.3 FT. ABOVE GROUND.	DATE	BY	NO.	DATE	BY	NO.
MARK GOODWIN & ASSOCIATES, P.A.
CONSULTING ENGINEERS
P.O. BOX 90606
ALBUQUERQUE, NEW MEXICO 87199
(505) 828-2200, FAX (505) 797-9539



**CITY OF ALBUQUERQUE
PUBLIC WORKS DEPARTMENT**

TITLE: **SUNDORO SOUTH UNIT 5
MASTER PAVING PLAN**

DESIGN REVIEW COMMITTEE	CITY ENGINEER APPROVAL	MO./DAY/YR.	MO./DAY/YR.
APPROVE JUN 21 2005	APPROVE JUL 15 2005		
DESIGN REVIEW COMMITTEE	CITY ENGINEER	DATE	DATE
		DLH 01/05	TAS 01/05
CITY PROJECT NO.	ZONE MAP NO.	SHEET	OF
727084	J-8/9	6	27

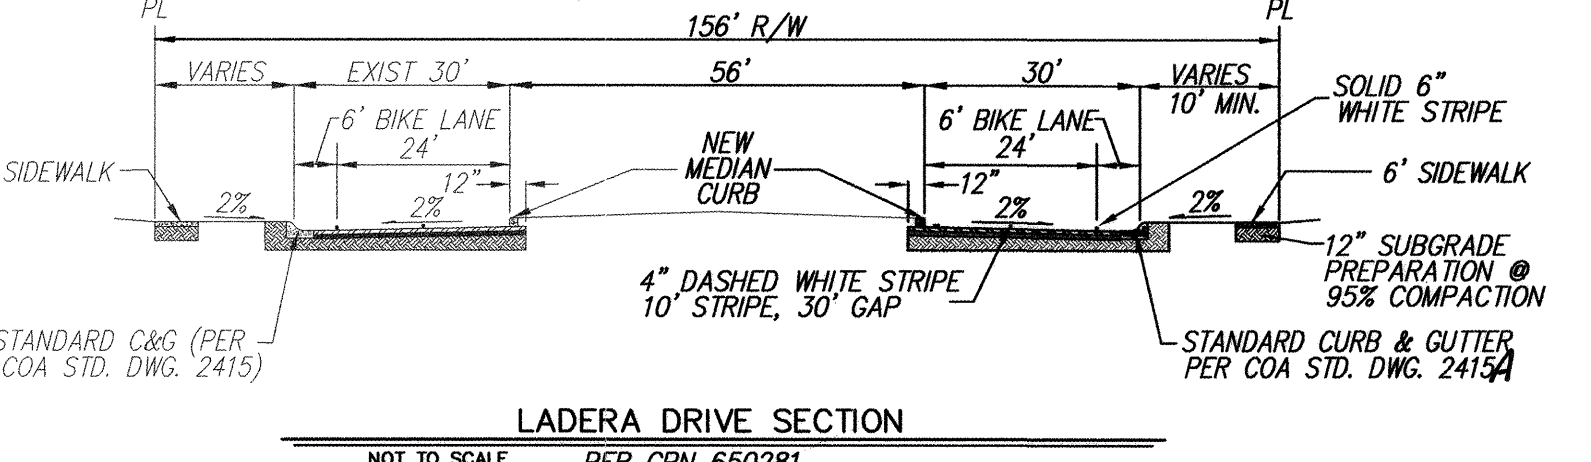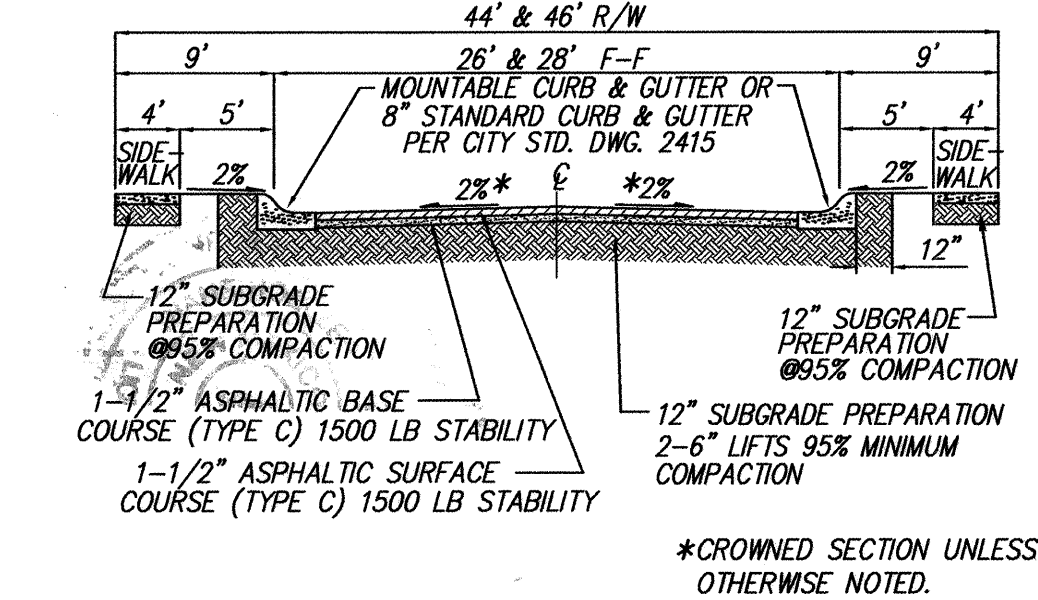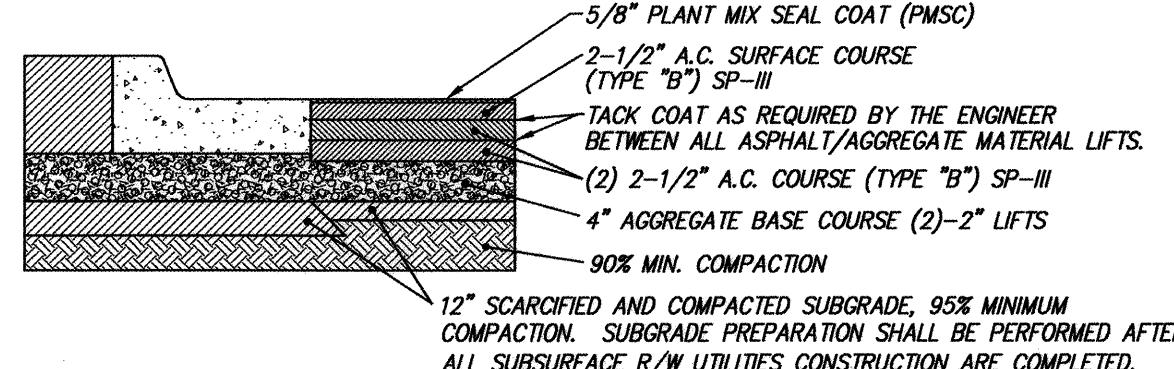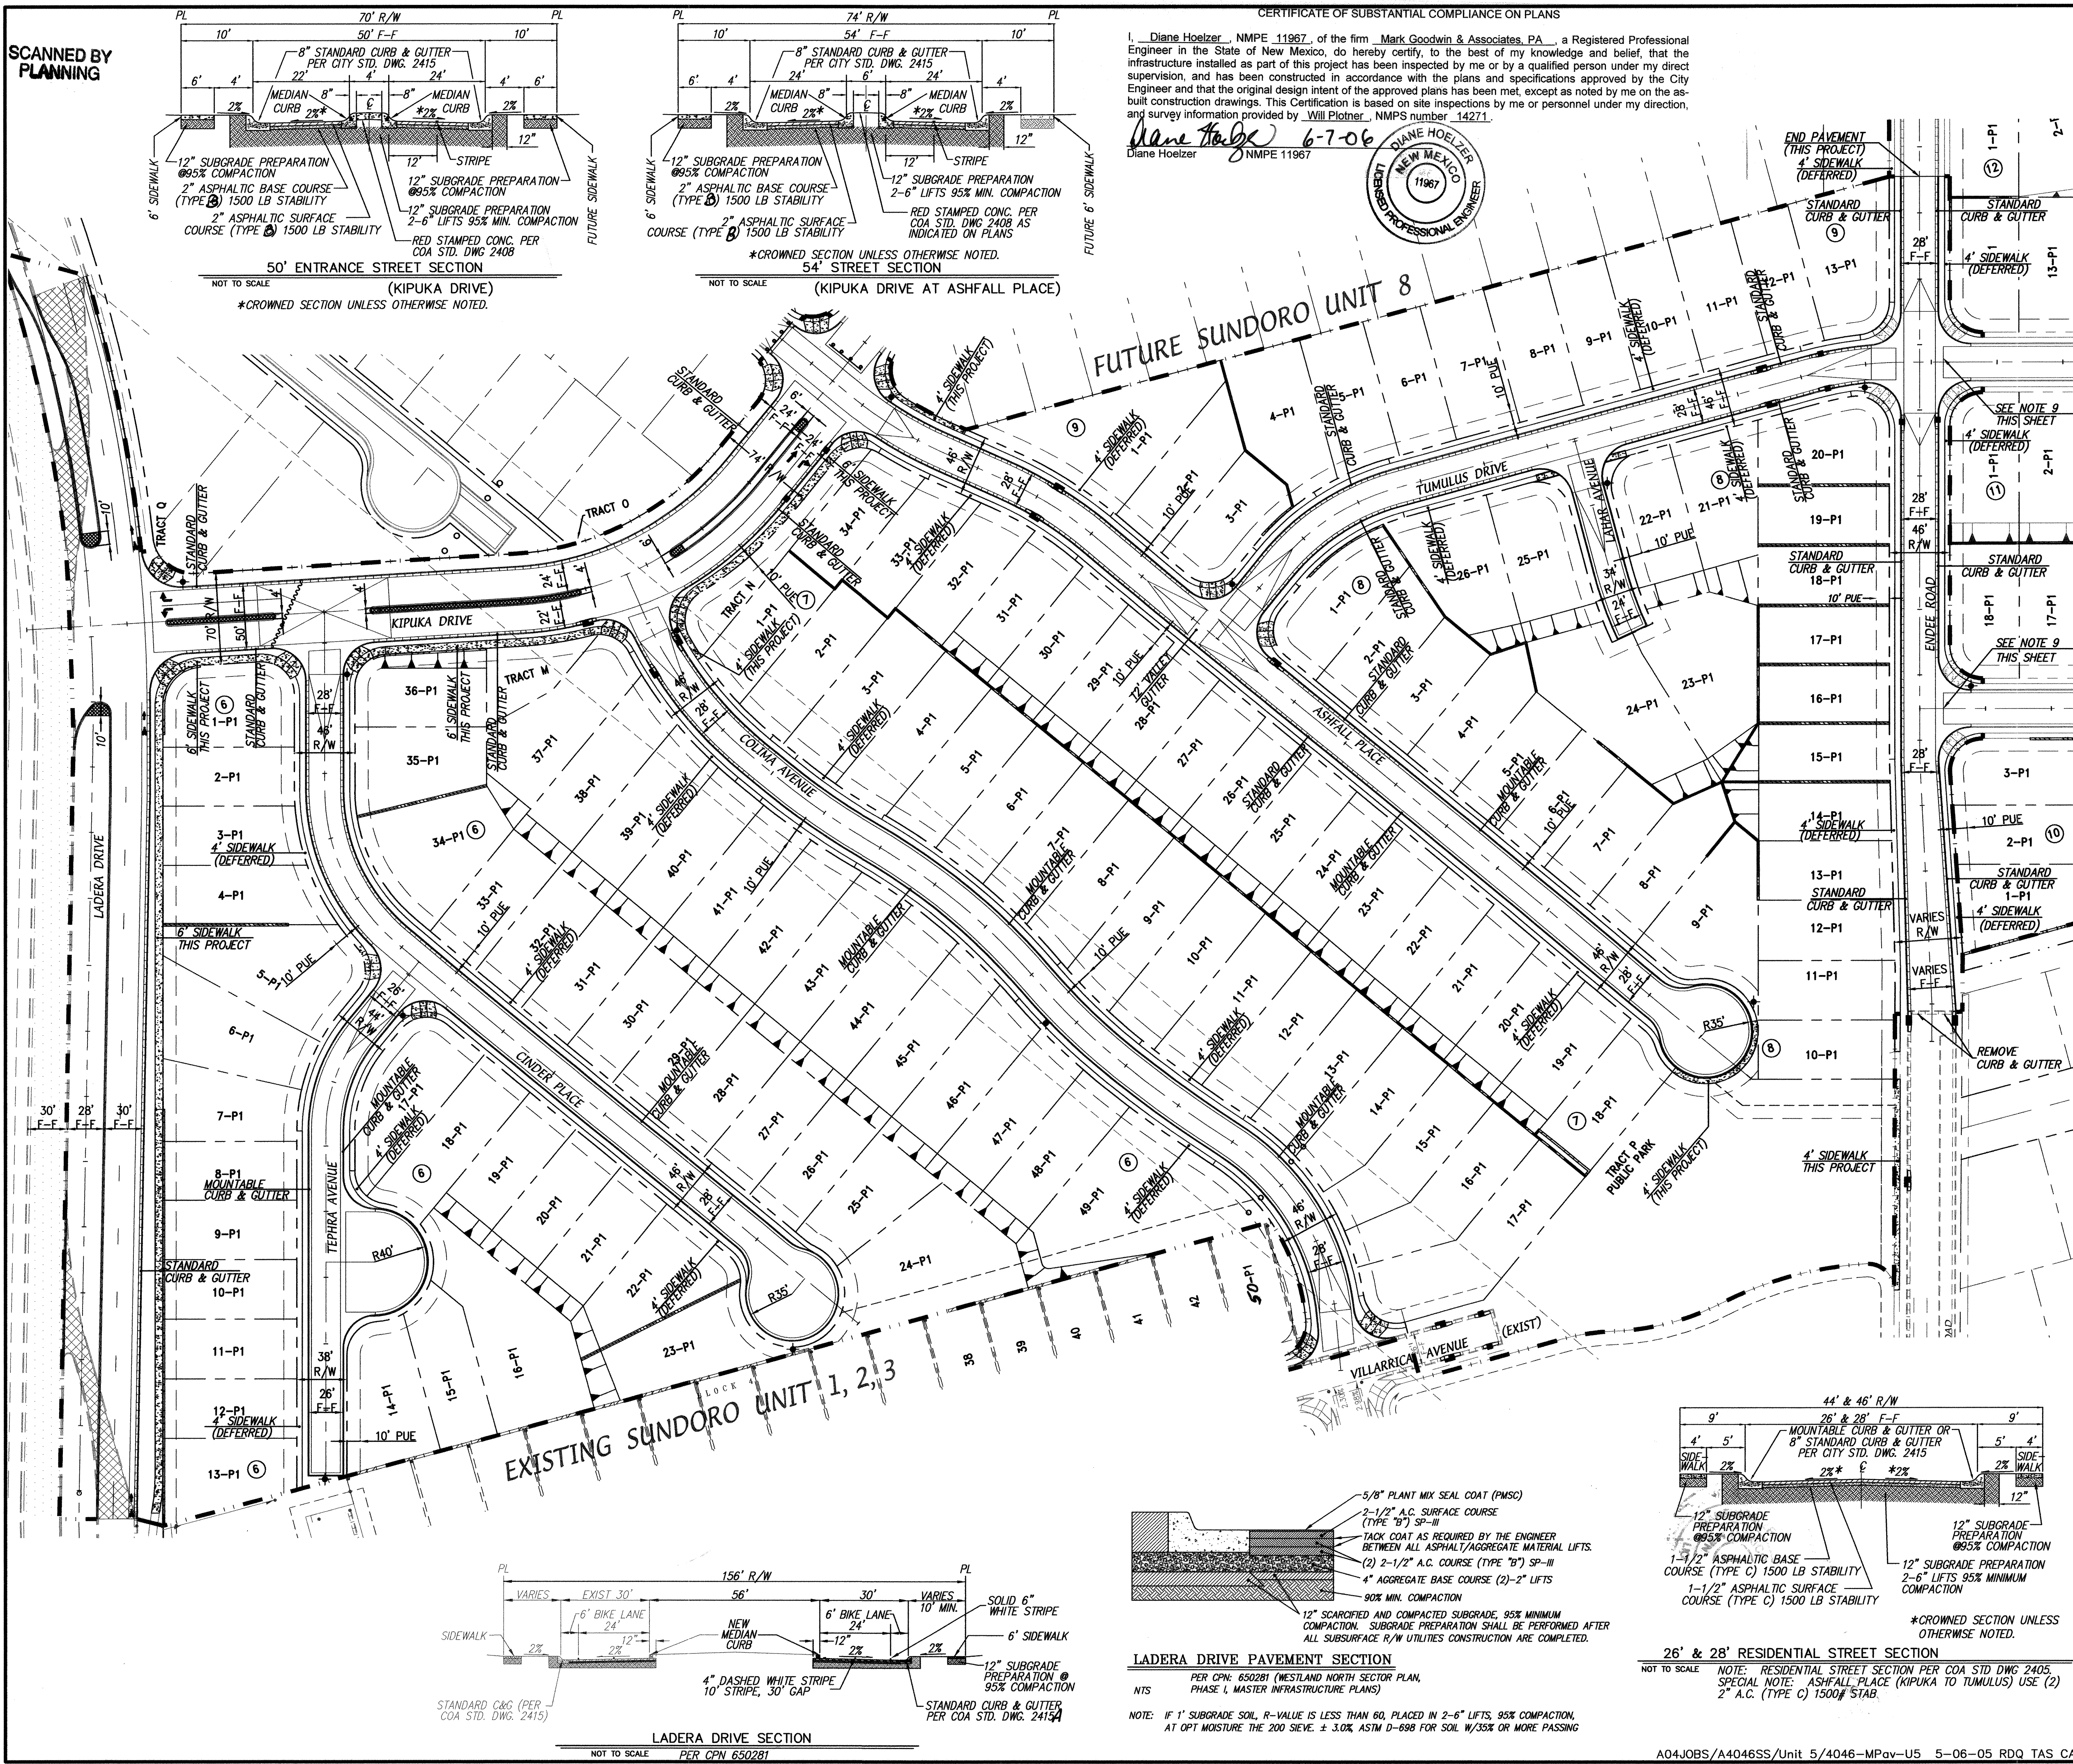

SCANNED BY
PLANNING

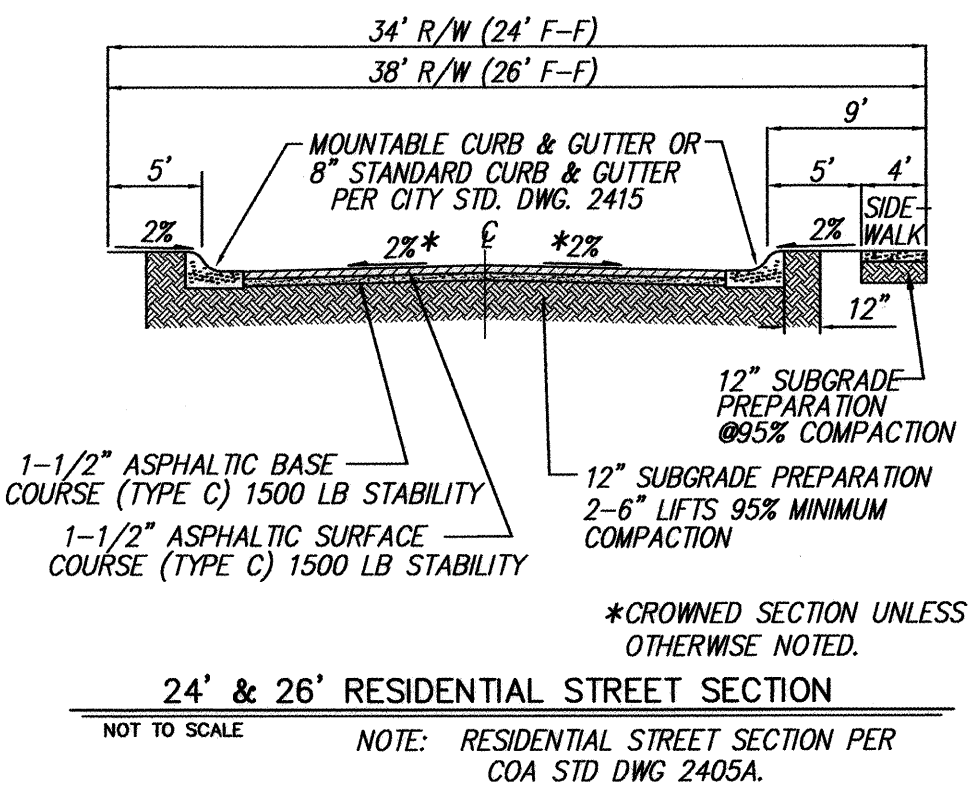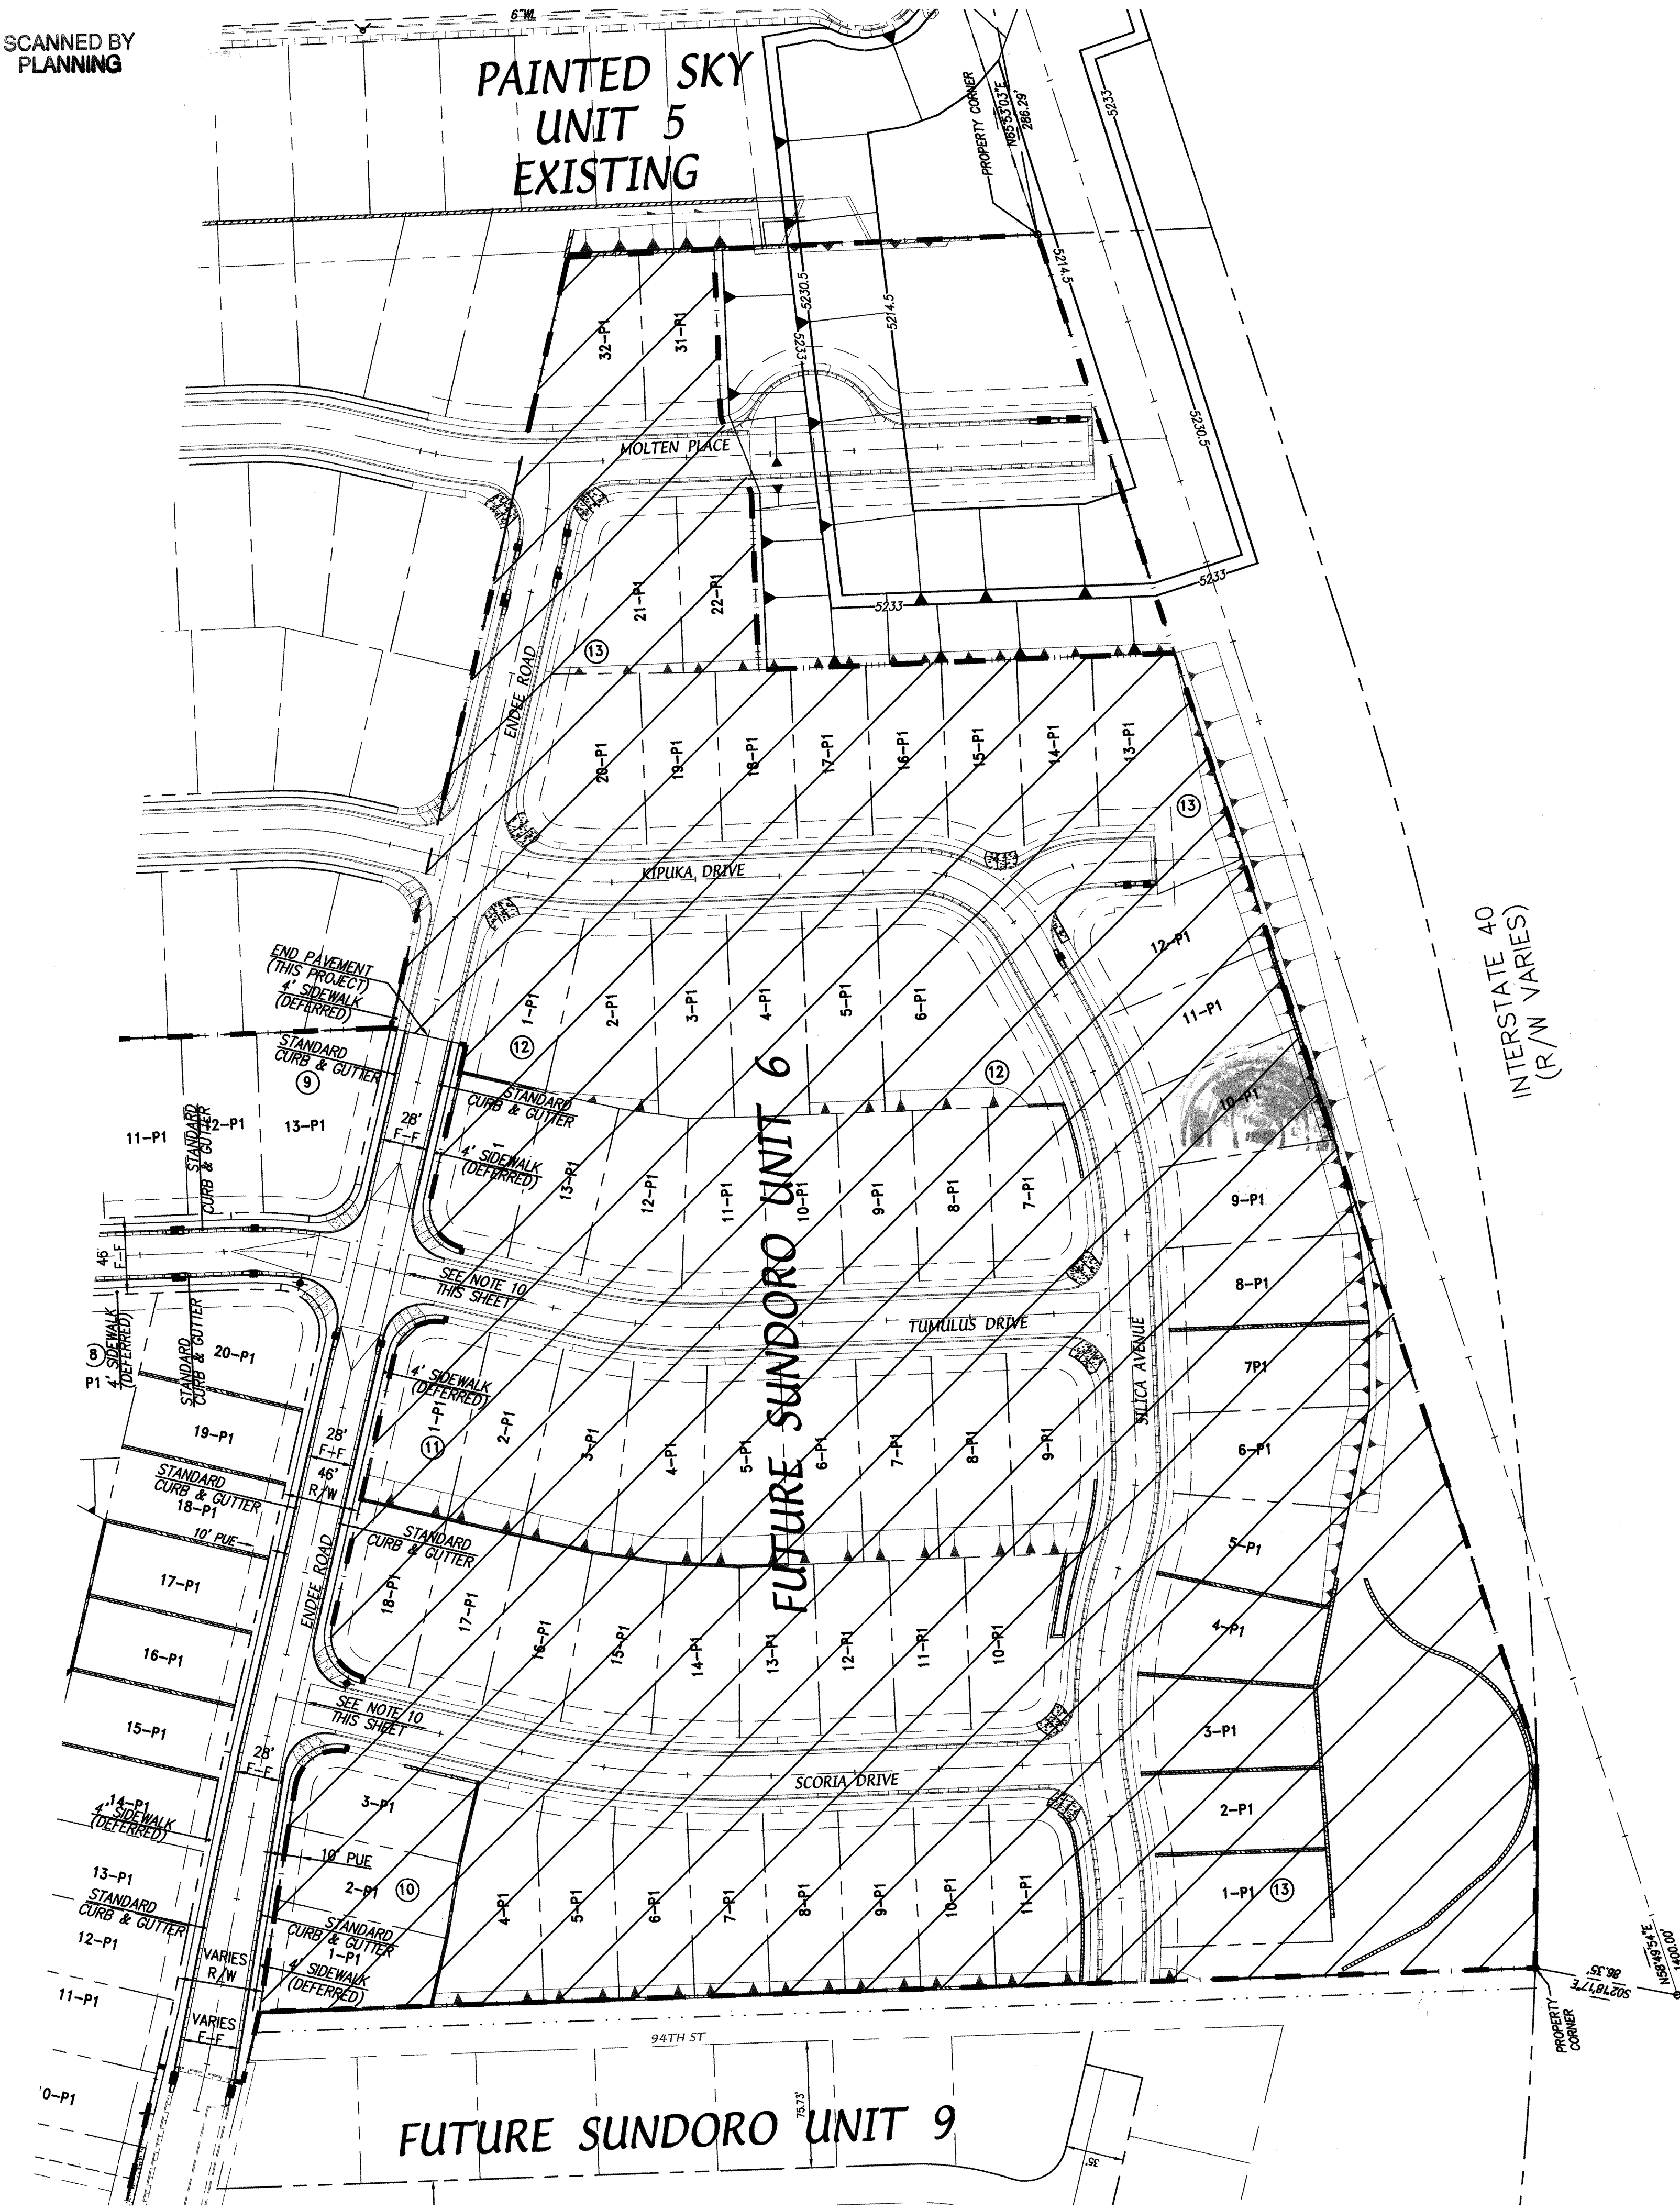

NOTES

1. ALL 4' VALLEY GUTTERS PER CITY OF ALBUQUERQUE STANDARD DRAWING 2421 AT KNUCKLES AND 6' VALLEY GUTTERS PER CITY OF ALBUQUERQUE STANDARD DRAWING 2420 AT ALL INTERSECTIONS AND ALL 10' VALLEY GUTTERS PER COA STD DWG 2422.
2. ALL 4' INTERIOR SIDEWALKS ARE DEFERRED.
3. ALL HANDICAP RAMPS PER COA STD DWG 2441, UNLESS OTHERWISE NOTED.
4. TRANSITION FROM MOUNTABLE CURB TO STANDARD CURB SHALL BE 10' PER COA STD DWG 2418.
5. TRANSITION SECTION FROM FULL CROWN TO NO CROWN TO BE A MINIMUM OF 50', PER COA STD DWG 2401.
6. ALL SIDEWALKS PER COA STD DWG 2430.
7. SOIL NOT HAVING A MINIMUM R-VALUE OF 50 WHERE INDICATED ON SECTIONS OF 2 FEET AND REPLACED BY THE CONTRACTOR WITH A SUITABLE MATERIAL OR PAVEMENT SECTION SHALL BE DESIGNED BY THE CONSULTANT ACCOMMODATING THE EXISTING R-VALUE PER COA STANDARD SPECIFICATIONS.
8. UNI-DIRECTIONAL CURB ACCESS RAMP PER COA STD DWG 2426.
9. ASHPALL PLACE PAVING FROM END OF CUL-DE-SAC TO STA 14+86 USE (2 LIFTS) 1-1/2\"/>



LEGEND

- NEW MOUNTABLE CURB AND GUTTER
- FUTURE MOUNTABLE CURB AND GUTTER
- NEW STANDARD CURB AND GUTTER
- FUTURE STANDARD CURB AND GUTTER
- EXISTING WALL
- SIDEWALK THIS PROJECT AS PER COA STD DWG 2430
- DEFERRED SIDEWALK
- LOT LINE
- RIGHT-OF-WAY LINE
- CENTERLINE
- EXIST NEW
- STORM DRAIN INLET THIS PROJECT
- STREET LIGHT
- WHEEL CHAIR RAMP
- 50' CROWN TRANSITION SEE NOTE 5
- 25' CROWN TRANSITION SEE NOTE 5
- PROPOSED DRIVEWAY LOCATION (BY OTHERS)
- NEW OFFSITE PAVING THIS PROJECT
- REMOVE & DISPOSE EXISTING PAVEMENT
- UNIT PHASE LINE
- NEW WATER BLOCK
- POWER POLES

CERTIFICATE OF SUBSTANTIAL COMPLIANCE ON PLANS

I, Diane Hoelzer, NMPE 11967, of the firm Mark Goodwin & Associates, P.A., a Registered Professional Engineer in the State of New Mexico, do hereby certify, to the best of my knowledge and belief, that the infrastructure installed as part of this project has been inspected by me or by a qualified person under my direct supervision, and has been constructed in accordance with the plans and specifications approved by the City Engineer and that the original design intent of the approved plans has been met, except as noted by me on the as-built construction drawings. This Certification is based on site inspections by me or personnel under my direction, and survey information provided by Will Plotner, NMPS number 14271.

Diane Hoelzer 6-7-06
Diane Hoelzer NMPE 11967

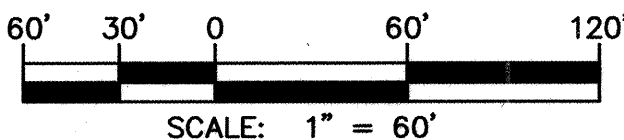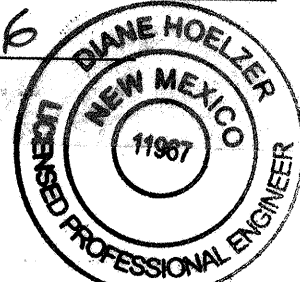

MARK GOODWIN & ASSOCIATES, P.A.
CONSULTING ENGINEERS
P.O. BOX 90606
ALBUQUERQUE, NEW MEXICO 87199
(505) 828-2200, FAX (505) 797-9539



CITY OF ALBUQUERQUE
PUBLIC WORKS DEPARTMENT

TITLE: SUNDORO SOUTH UNIT 5
MASTER PAVING PLAN


DESIGN REVIEW COMMITTEE
APPROVE
JUN 21 2005
DESIGN REVIEW COMMITTEE

CITY ENGINEER APPROVAL
APPROVE
JUL 15 2005
CITY ENGINEER

LAST DESIGN UPDATE
MO./DAY/YR.
MO./DAY/YR.

CITY PROJECT NO. 727084 ZONE MAP NO. J-8/9 SHEET 7 OF 27



SCANNED BY
PLANNING

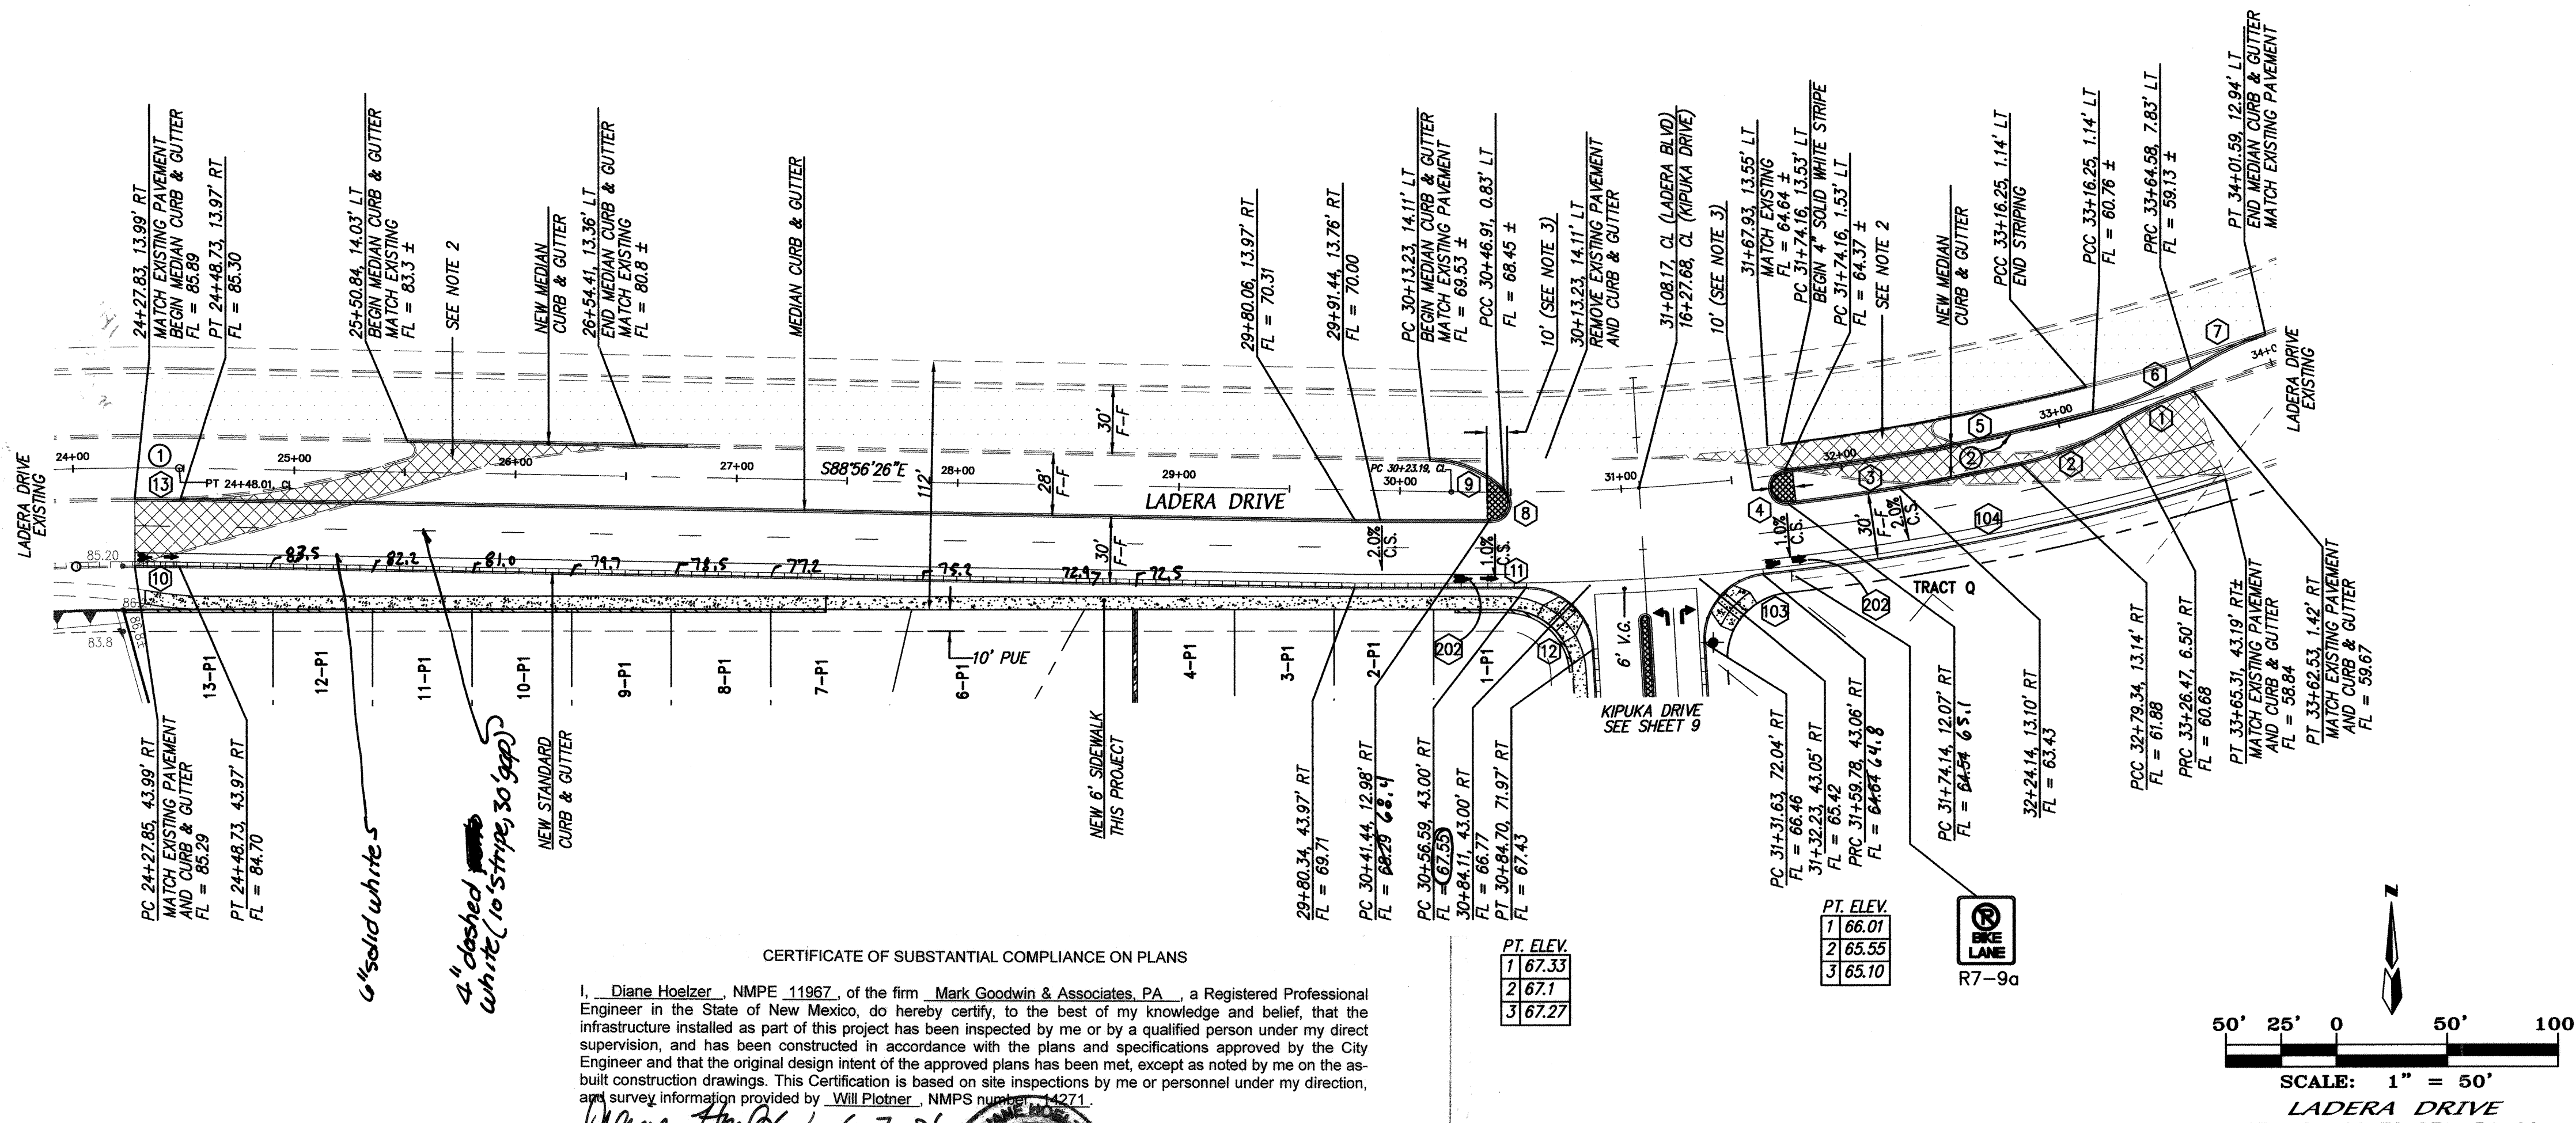

CERTIFICATE OF SUBSTANTIAL COMPLIANCE ON PLANS

I, Diane Hoelzer, NMPE 11987, of the firm Mark Goodwin & Associates, P.A., a Registered Professional Engineer in the State of New Mexico, do hereby certify, to the best of my knowledge and belief, that the infrastructure installed as part of this project has been inspected by me or by a qualified person under my direct supervision, and has been constructed in accordance with the plans and specifications approved by the City Engineer and that the original design intent of the approved plans has been met, except as noted by me on the as-built construction drawings. This Certification is based on site inspections by me or personnel under my direction, and survey information provided by Will Plotner, NMPS number 14271.


Diane Hoelzer 6-7-06
Diane Hoelzer NMPE 11987

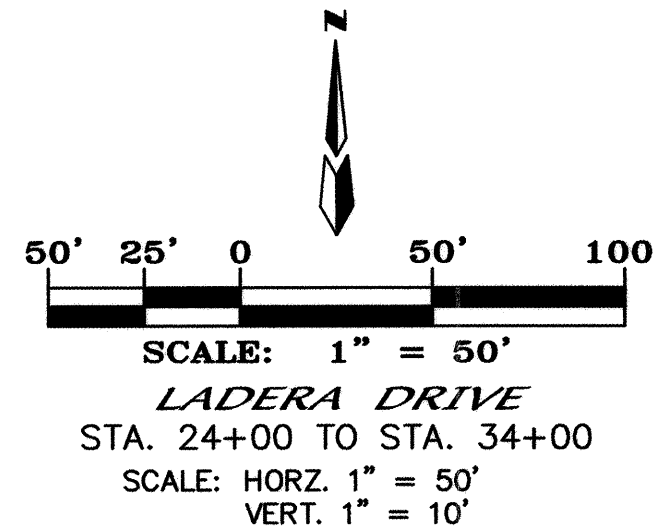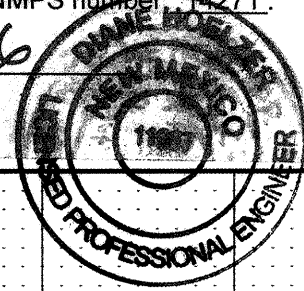

- NOTES
1. ALL STATIONING IS CENTERLINE STATIONING.
 2. REMOVE EXISTING TEMPORARY PAVEMENT AND TEMPORARY CURB & GUTTER. (*)
 3. INSTALL RED STAMPED CONCRETE AND PAINT NOSE YELLOW PER COA STD DWG 2408.
- (*) REMOVED 9" PERMANENT ASPHALT AND CONCRETE MEDIAN CURB.

CURVE DATA - DESCRIBES CENTERLINE

- | | |
|---|--|
| ① $\Delta = 0103'01"$
$R = 1100.00'$
$L = 20.16'$
$T = 10.08'$ | ② $\Delta = 51'33'19"$
$R = 1100.00'$
$L = 989.79'$
$T = 531.23'$ |
|---|--|

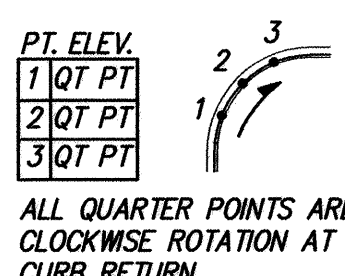


CURVE DATA - DESCRIBES FACE OF CURB RETURNS

- | | | |
|---|--|--|
| ① $\Delta = 13'59'32"$
$R = 150.00'$
$T = 18.41'$
$L = 36.63'$ | ② $\Delta = 18'25'10"$
$R = 150.00'$
$T = 24.32'$
$L = 48.22'$ | ③ $\Delta = 5'28'47"$
$R = 1113.04'$
$T = 53.26'$
$L = 106.45'$ |
| ④ $\Delta = 180'00'00"$
$R = 7.30'$
$T = 50.00'$
$L = 22.94'$ | ⑤ $\Delta = 7'26'04"$
$R = 1093.77'$
$T = 71.06'$
$L = 141.93'$ | ⑥ $\Delta = 18'38'26"$
$R = 150.00'$
$T = 24.62'$
$L = 48.80'$ |
| ⑦ $\Delta = 14'10'36"$
$R = 150.00'$
$T = 18.65'$
$L = 37.11'$ | ⑧ $\Delta = 136'37'53"$
$R = 8.00'$
$T = 20.12'$
$L = 19.08'$ | ⑨ $\Delta = 42'18'51"$
$R = 50.00'$
$T = 19.35'$
$L = 36.93'$ |
| ⑩ $\Delta = 1'05'20"$
$R = 1056.00'$
$T = 10.04'$
$L = 20.07'$ | ⑪ $\Delta = 0'52'44"$
$R = 1143.00'$
$T = 8.77'$
$L = 17.53'$ | ⑫ $\Delta = 87'16'39"$
$R = 30.00'$
$T = 28.61'$
$L = 45.70'$ |
| ⑬ $\Delta = 1'05'20"$
$R = 1086.00'$
$T = 10.32'$
$L = 20.64'$ | ⑭ $\Delta = 87'20'51"$
$R = 30.00'$
$T = 28.61'$
$L = 45.70'$ | ⑮ $\Delta = 10'42'38"$
$R = 1143.04'$
$T = 107.15'$
$L = 213.67'$ |

Certification
THE CHANGES SHOWN HEREON ARE BASED UPON A FIELD SURVEY CONDUCTED BY ME OR UNDER MY SUPERVISION AND REFLECT THE LOCATIONS (VERTICALLY AND HORIZONTALLY) TO THE BEST OF MY KNOWLEDGE AND BELIEF.

Will Plotner

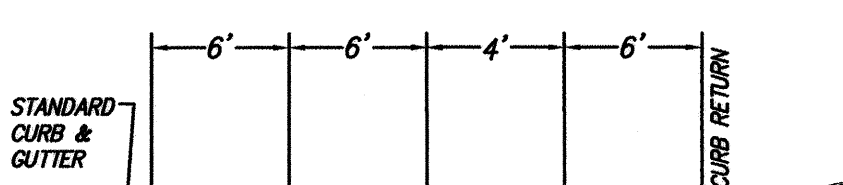

6" SOLID WHITE REFLECTORIZED PAINTED STRIPING PER THE MUTCD.

BIKE LANE MARKING
N.T.S. USE PREFORMED REFLECTORIZED TAPE FOR ARROW & BIKE SYMBOL.

MARK GOODWIN & ASSOCIATES, P.A.
CONSULTING ENGINEERS
P.O. BOX 90606
ALBUQUERQUE, NEW MEXICO 87199
(505) 828-2200, FAX (505) 797-9539





CITY OF ALBUQUERQUE PUBLIC WORKS DEPARTMENT	
TITLE: SUNDORO SOUTH - UNIT 5 LADERA DRIVE PAVING IMPROVEMENTS	
DESIGN REVIEW COMMITTEE APPROVED JUN 21 2005 DESIGN REVIEW COMMITTEE	CITY ENGINEER APPROVAL APPROVED JUL 15 2005 CITY ENGINEER
LAST DESIGN UPDATE	MO./DAY/YR.
CITY PROJECT NO. 727084	ZONE MAP NO. J-8/9
SHEET 8 OF 27	

SCANNED BY
PLANNING

CERTIFICATE OF SUBSTANTIAL COMPLIANCE ON PLANS

I, **Diane Hoelzer**, NMPE 11967, of the firm **Mark Goodwin & Associates, P.A.**, a Registered Professional Engineer in the State of New Mexico, do hereby certify, to the best of my knowledge and belief, that the infrastructure installed as part of this project has been inspected by me or by a qualified person under my direct supervision and that the construction of the project has been in accordance with the approved plans and specifications. I am not responsible for any errors or omissions in the plans or specifications or for any consequences arising from the use of the plans or specifications. This Certificate is based on site inspections by me or personnel under my direction, and survey information provided by **Will Pletcher**, NMPS number, 14271.

Diane Hoelzer NMPE 11967
Will Pletcher NMPS 14271

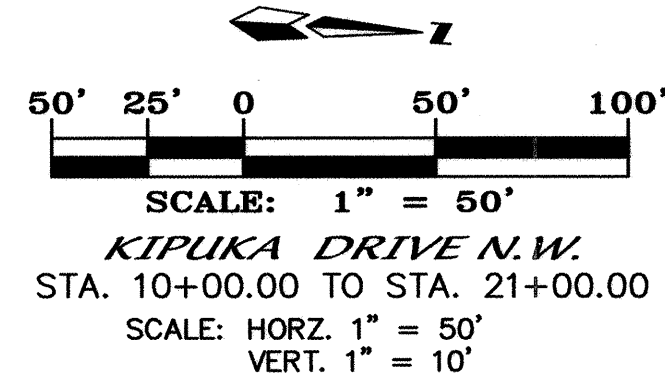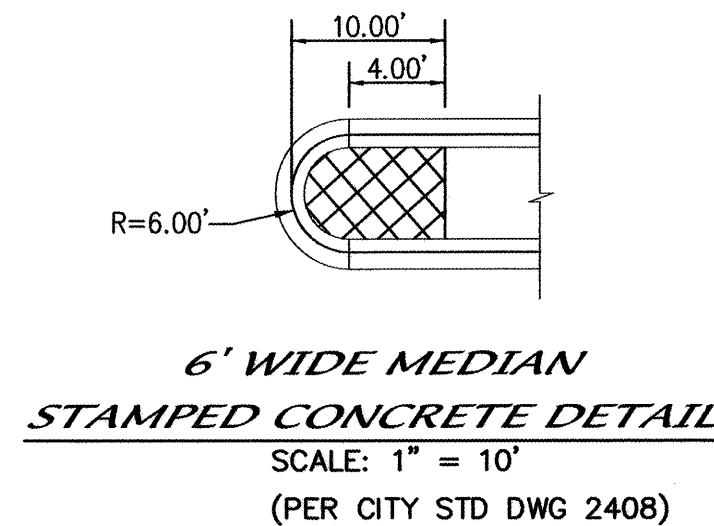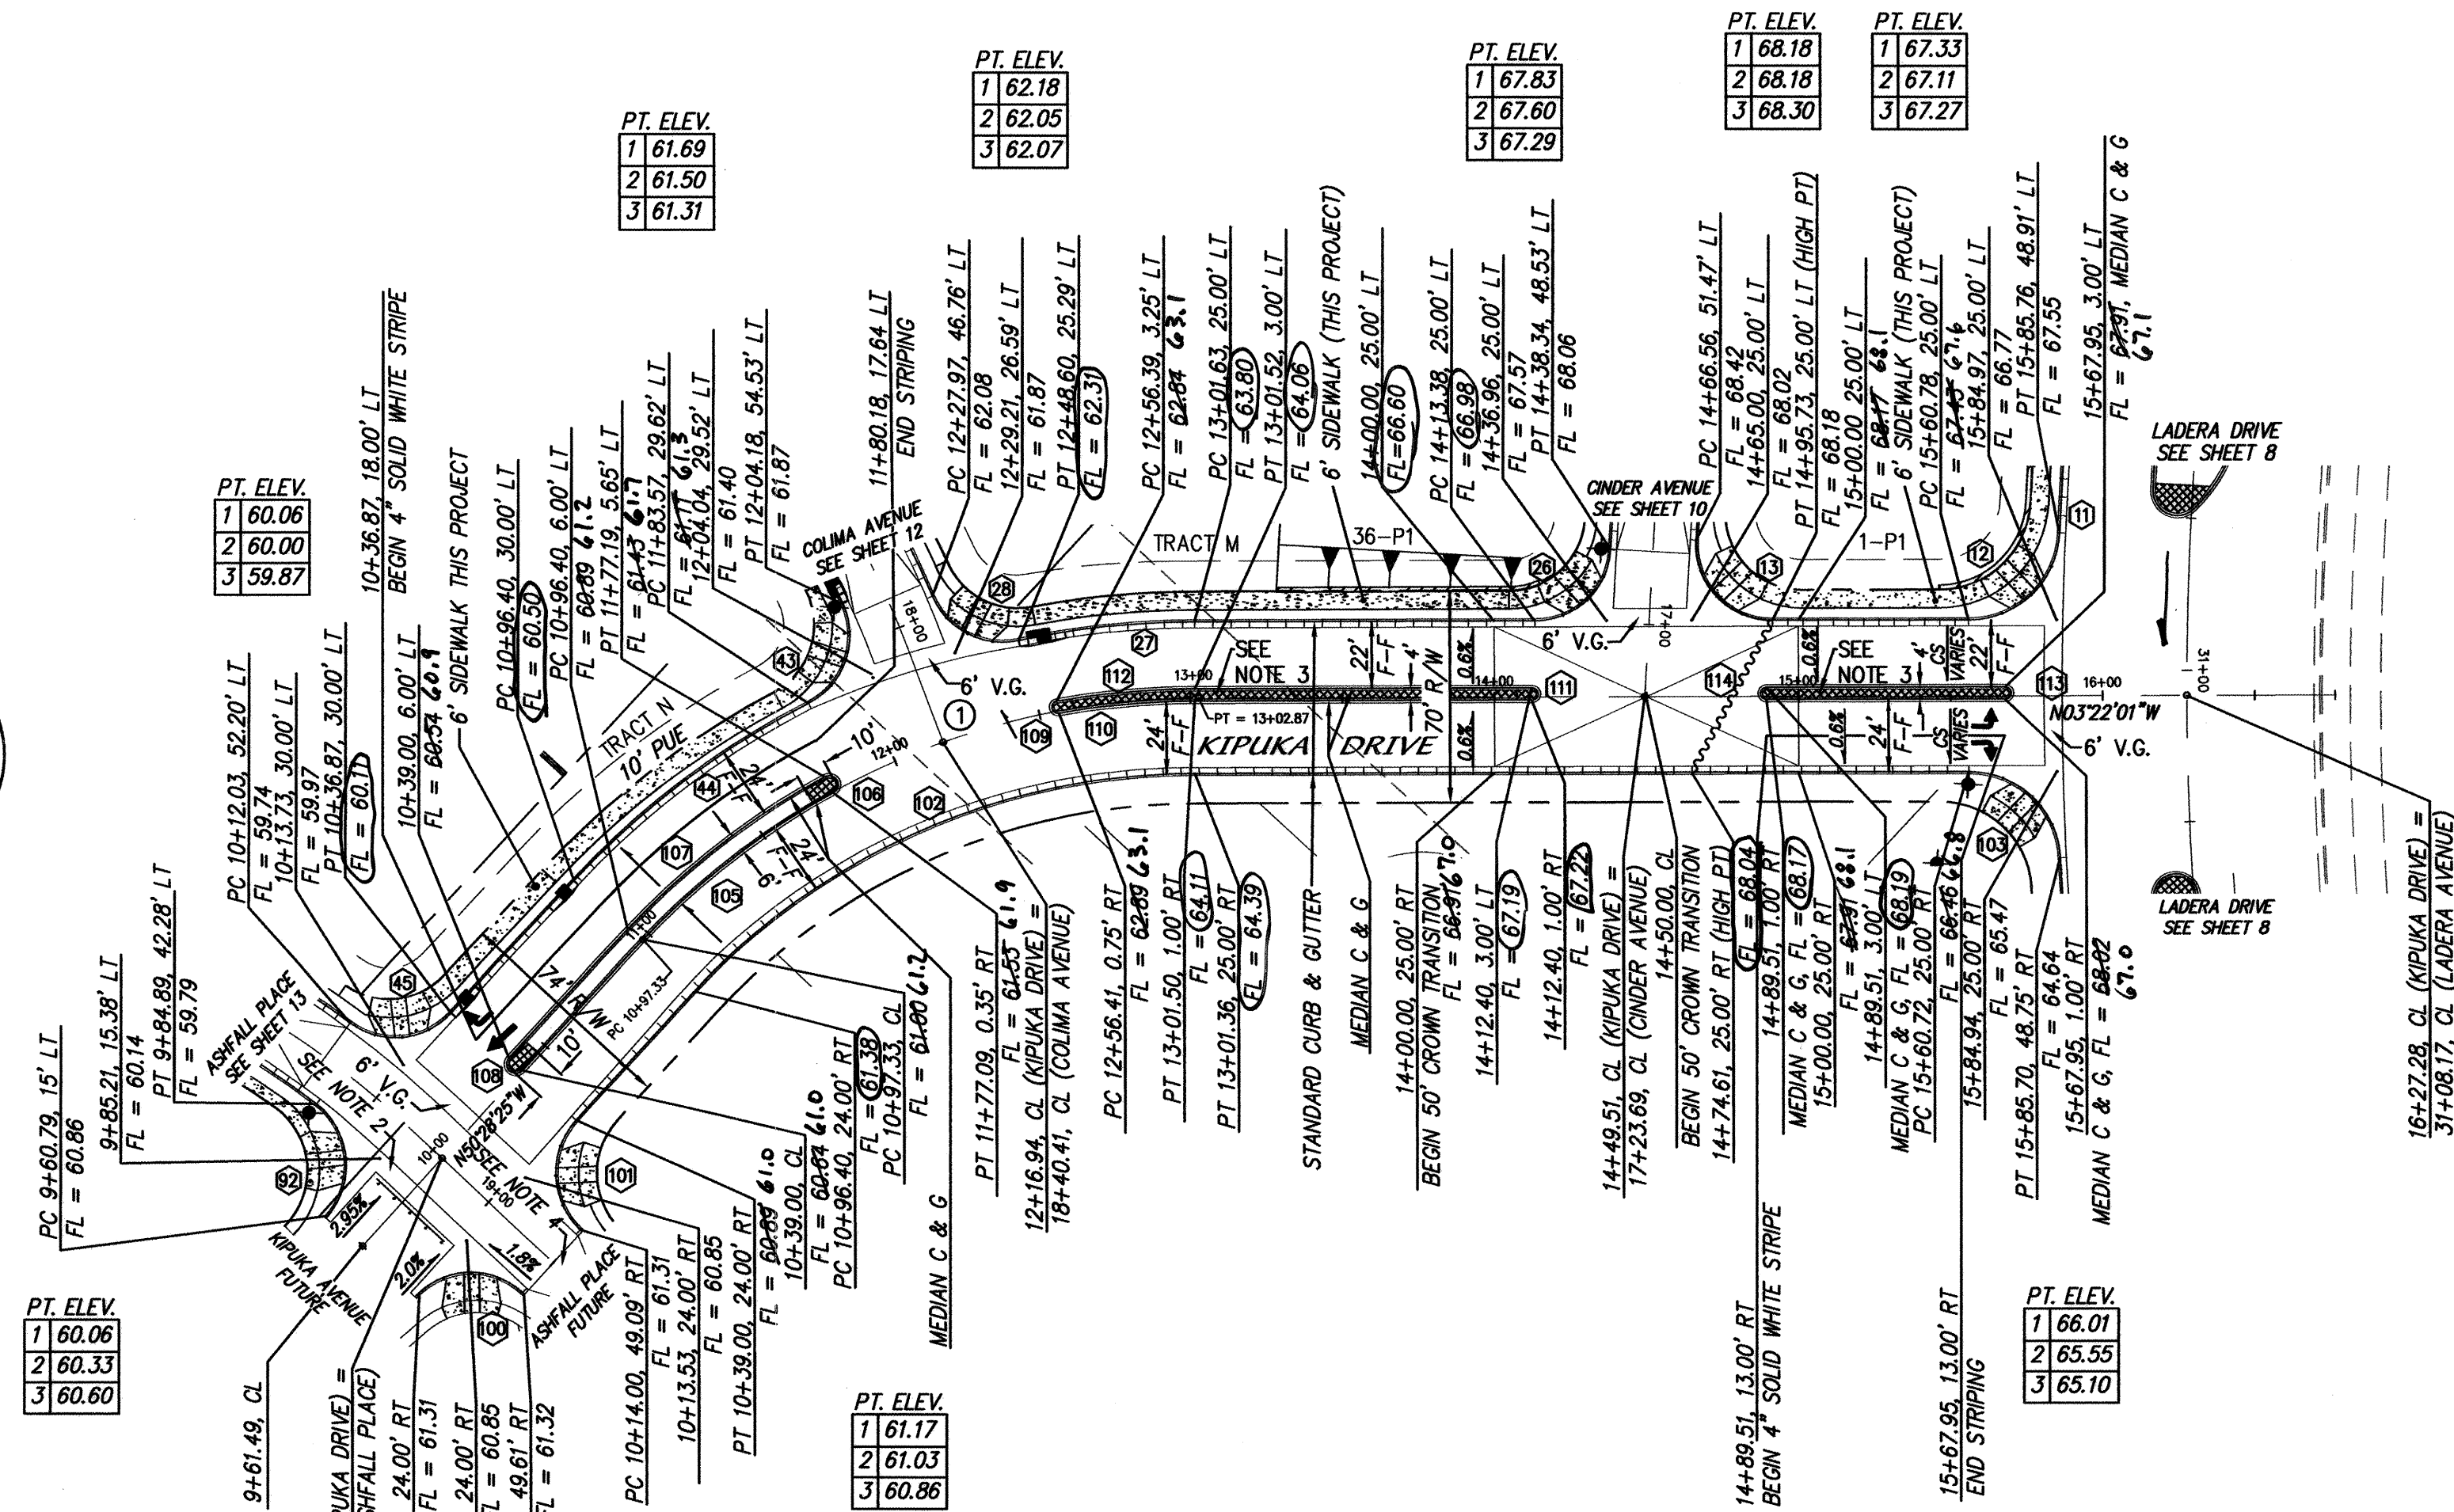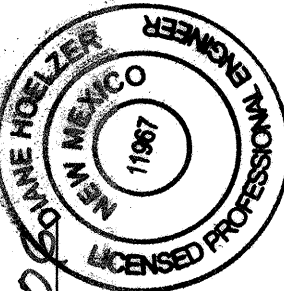


NOTES

1. ALL STATIONING IS CENTERLINE STATIONING.
2. CONSTRUCT CURB RETURN AND VALLEY GUTTERS ONLY AND PLACE TEMPORARY TYPE III BARRICADE.
3. INSTALL RED STAMPED CONCRETE AND PAINT NOSE YELLOW.
4. CONSTRUCT CUT OFF WALL ACROSS PAVEMENT AND PLACE TEMP TYPE III BARRICADES, IF NECESSARY.

CURVE DATA - DESCRIBES CENTERLINE

- ① $\Delta = 47^{\circ}06'24''$
 $R = 250.00'$
 $L = 205.54'$
 $T = 108.98'$

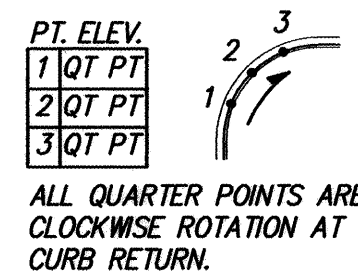

CURVE DATA - DESCRIBES FACE OF CURB RETURNS

- | | | |
|---|--|--|
| ⑪ $\Delta = 0^{\circ}52'44''$
$R = 1143.00$
$T = 8.77$
$L = 17.53$ | ⑫ $\Delta = 87^{\circ}16'39''$
$R = 30.00$
$T = 28.61$
$L = 45.70$ | ⑬ $\Delta = 93^{\circ}21'49''$
$R = 25.00$
$T = 26.51$
$L = 40.74$ |
| ⑭ $\Delta = 86^{\circ}38'11''$
$R = 25.00$
$T = 23.57$
$L = 37.80$ | ⑮ $\Delta = 12^{\circ}09'36''$
$R = 275.00$
$T = 29.29$
$L = 58.36$ | ⑯ $\Delta = 79^{\circ}15'54''$
$R = 25.00$
$T = 20.71$
$L = 34.59$ |
| ⑰ $\Delta = 87^{\circ}39'12''$
$R = 25.00$
$T = 24.00$
$L = 38.25$ | ⑱ $\Delta = 20^{\circ}00'48''$
$R = 279.00$
$T = 49.23$
$L = 97.45$ | ⑲ $\Delta = 83^{\circ}34'04''$
$R = 25.00$
$T = 22.34$
$L = 36.46$ |
| ⑳ $\Delta = 93^{\circ}13'14''$
$R = 25.00$
$T = 28.45$
$L = 40.68$ | ㉑ $\Delta = 86^{\circ}37'20''$
$R = 30.00$
$T = 23.57$
$L = 37.80$ | ㉒ $\Delta = 90^{\circ}12'18''$
$R = 25.00$
$T = 25.09$
$L = 39.36$ |
| ㉓ $\Delta = 47^{\circ}06'24''$
$R = 225.00$
$T = 98.08$
$L = 184.99$ | ㉔ $\Delta = 87^{\circ}20'51''$
$R = 30.00$
$T = 28.64$
$L = 45.74$ | ㉕ $\Delta = 18^{\circ}33'19''$
$R = 249.00$
$T = 40.68$
$L = 80.64$ |
| ㉖ $\Delta = 180^{\circ}00'00''$
$R = 3.00$
$T = N/A$
$L = 9.43$ | ㉗ $\Delta = 18^{\circ}34'18''$
$R = 255.00$
$T = 41.69$
$L = 82.65$ | ㉘ $\Delta = 180^{\circ}00'00''$
$R = 3.00$
$T = N/A$
$L = 9.42$ |
| ㉙ $\Delta = 180^{\circ}00'12''$
$R = 2.00$
$T = N/A$
$L = 6.28$ | ㉚ $\Delta = 9^{\circ}53'05''$
$R = 260.42$
$T = 22.52$
$L = 44.93$ | ㉛ $\Delta = 180^{\circ}00'00''$
$R = 2.00$
$T = N/A$
$L = 6.28$ |
| ㉜ $\Delta = 9^{\circ}54'05''$
$R = 284.40$
$T = 22.90$
$L = 45.69$ | ㉝ $\Delta = 180^{\circ}00'00''$
$R = 2.00$
$T = N/A$
$L = 6.28$ | ㉞ $\Delta = 180^{\circ}00'00''$
$R = 2.00$
$T = N/A$
$L = 6.28$ |

Certification
THE CHANGES SHOWN HEREON ARE BASED UPON A FIELD SURVEY CONDUCTED BY ME OR UNDER MY SUPERVISION AND REFLECT THE LOCATIONS (VERTICALLY AND HORIZONTALLY) TO THE BEST OF MY KNOWLEDGE AND BELIEF.

Will Pletcher

dmg MARK GOODWIN & ASSOCIATES, P.A.
CONSULTING ENGINEERS
P.O. BOX 90606
ALBUQUERQUE, NEW MEXICO 87199
(505) 828-2200, FAX (505) 797-9539

**CITY OF ALBUQUERQUE
PUBLIC WORKS DEPARTMENT**

TITLE: **SUNDORO SOUTH - UNIT 5
KIPUKA DRIVE
PAVING IMPROVEMENTS**

DESIGN REVIEW COMMITTEE
APPROVED
JUN 21 2005
DESIGN REVIEW COMMITTEE

CITY ENGINEER APPROVAL
APPROVED
JUL 15 2005
CITY ENGINEER

MO./DAY/YR.
MO./DAY/YR.
LAST DESIGN UPDATE

CITY PROJECT NO. **727084** ZONE MAP NO. **J-8/9** SHEET **9** OF **27**

CERTIFICATE OF SUBSTANTIAL COMPLIANCE ON PLANS

I, Diane Hoelzer, NMPE 11967, of the firm Mark Goodwin & Associates, PA, a Registered Professional Engineer in the State of New Mexico, do hereby certify, to the best of my knowledge and belief, that the infrastructure installed as part of this project has been inspected by me or by a qualified person under my direct supervision, and has been constructed in accordance with the plans and specifications approved by the City Engineer and that the original design intent of the approved plans has been met, except as noted by me on the as-built construction drawings. This Certification is based on site inspections by me or personnel under my direction, and survey information provided by Vincent Plotner, NMPS number 14271.

Diane Hoelzer 6-7-06
Diane Hoelzer NMPE 11967

PT. ELEV.

1	72.63
2	72.44
3	72.43

PT. ELEV.

1	71.77
2	72.03
3	72.16

PT. ELEV.

1	67.83
2	67.60
3	67.29

PT. ELEV.


1	68.18
2	68.18
3	68.30

I, Diane Hoelzer, NMPE 11967, of the firm Mark Goodwin & Associates, PA, a Registered Professional Engineer in the State of New Mexico, do hereby certify, to the best of my knowledge and belief, that the information contained as part of this project has been inspected by me or by a qualified person under my direct supervision, and has been prepared in accordance with the rules and specifications approved by the City Engineer and that the original design intent of the approved plans has been met, except as noted by me on the as-built construction drawings. This Certification is based on site inspections by me or personnel under my direction, and survey information provided by Will Plotner, NMPS number 14271.

Diane Hoelzer 6-7-06

Diane Hoelzer NMPE 11967

DIANE HOELZER
NM MEPE 11967

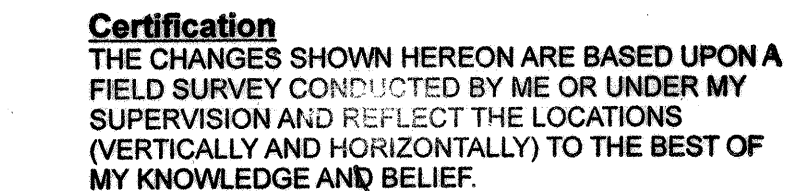

Certification
THE CHANGES SHOWN HEREON ARE BASED UPON A
FIELD SURVEY CONDUCTED BY ME OR UNDER MY
SUPERVISION AND REFLECT THE LOCATIONS
(VERTICALLY AND HORIZONTALLY) TO THE BEST OF
MY KNOWLEDGE AND BELIEF.

Will Flaherty

NOTES

1. ALL STATIONING IS CENTERLINE STATIONING.

CURVE DATA - DESCRIBES CENTERLINE

①

$\Delta = 50^{\circ}29'47''$
 $R = 150.00'$
 $L = 132.20'$
 $T = 70.74'$

PT. ELEV.
1 Q/P PT
2 Q/P PT
3 Q/P PT

1

2

3

ALL QUARTER POINTS ARE
CLOCKWISE ROTATION AT
CURB RETURN.

CURVE DATA - DESCRIBES FACE OF CURB RETURNS

⑬

$\Delta = 93^{\circ}21'49''$
 $R = 25.00$
 $T = 26.51$
 $L = 40.74$

⑭

$\Delta = 45^{\circ}38'24''$
 $R = 164.00$
 $T = 69.01$
 $L = 130.64$

⑮

$\Delta = 85^{\circ}08'38''$
 $R = 25.00$
 $T = 22.97$
 $L = 37.15$

⑰

$\Delta = 90^{\circ}00'00''$
 $R = 25.00$
 $T = 25.00$
 $L = 39.27$

⑱

$\Delta = 66^{\circ}19'39''$
 $R = 25.00$
 $T = 16.34$
 $L = 28.94$

⑲

$\Delta = 272^{\circ}22'01''$
 $R = 35.00$
 $T = 33.58$
 $L = 166.38$

⑳

$\Delta = 26^{\circ}02'21''$
 $R = 25.00$
 $T = 5.76$
 $L = 11.36$

㉑

$\Delta = 50^{\circ}29'47''$
 $R = 156.00$
 $T = 64.14$
 $L = 119.86$



㉒

$\Delta = 86^{\circ}38'11''$
 $R = 25.00$
 $T = 23.57$
 $L = 37.80$

Certification

THE CHANGES SHOWN HEREON ARE BASED UPON A
FIELD SURVEY CONDUCTED BY ME OR UNDER MY
SUPERVISION AND REFLECT THE LOCATIONS
(VERTICALLY AND HORIZONTALLY) TO THE BEST OF
MY KNOWLEDGE AND BELIEF.

SCANNED BY
PLANNING

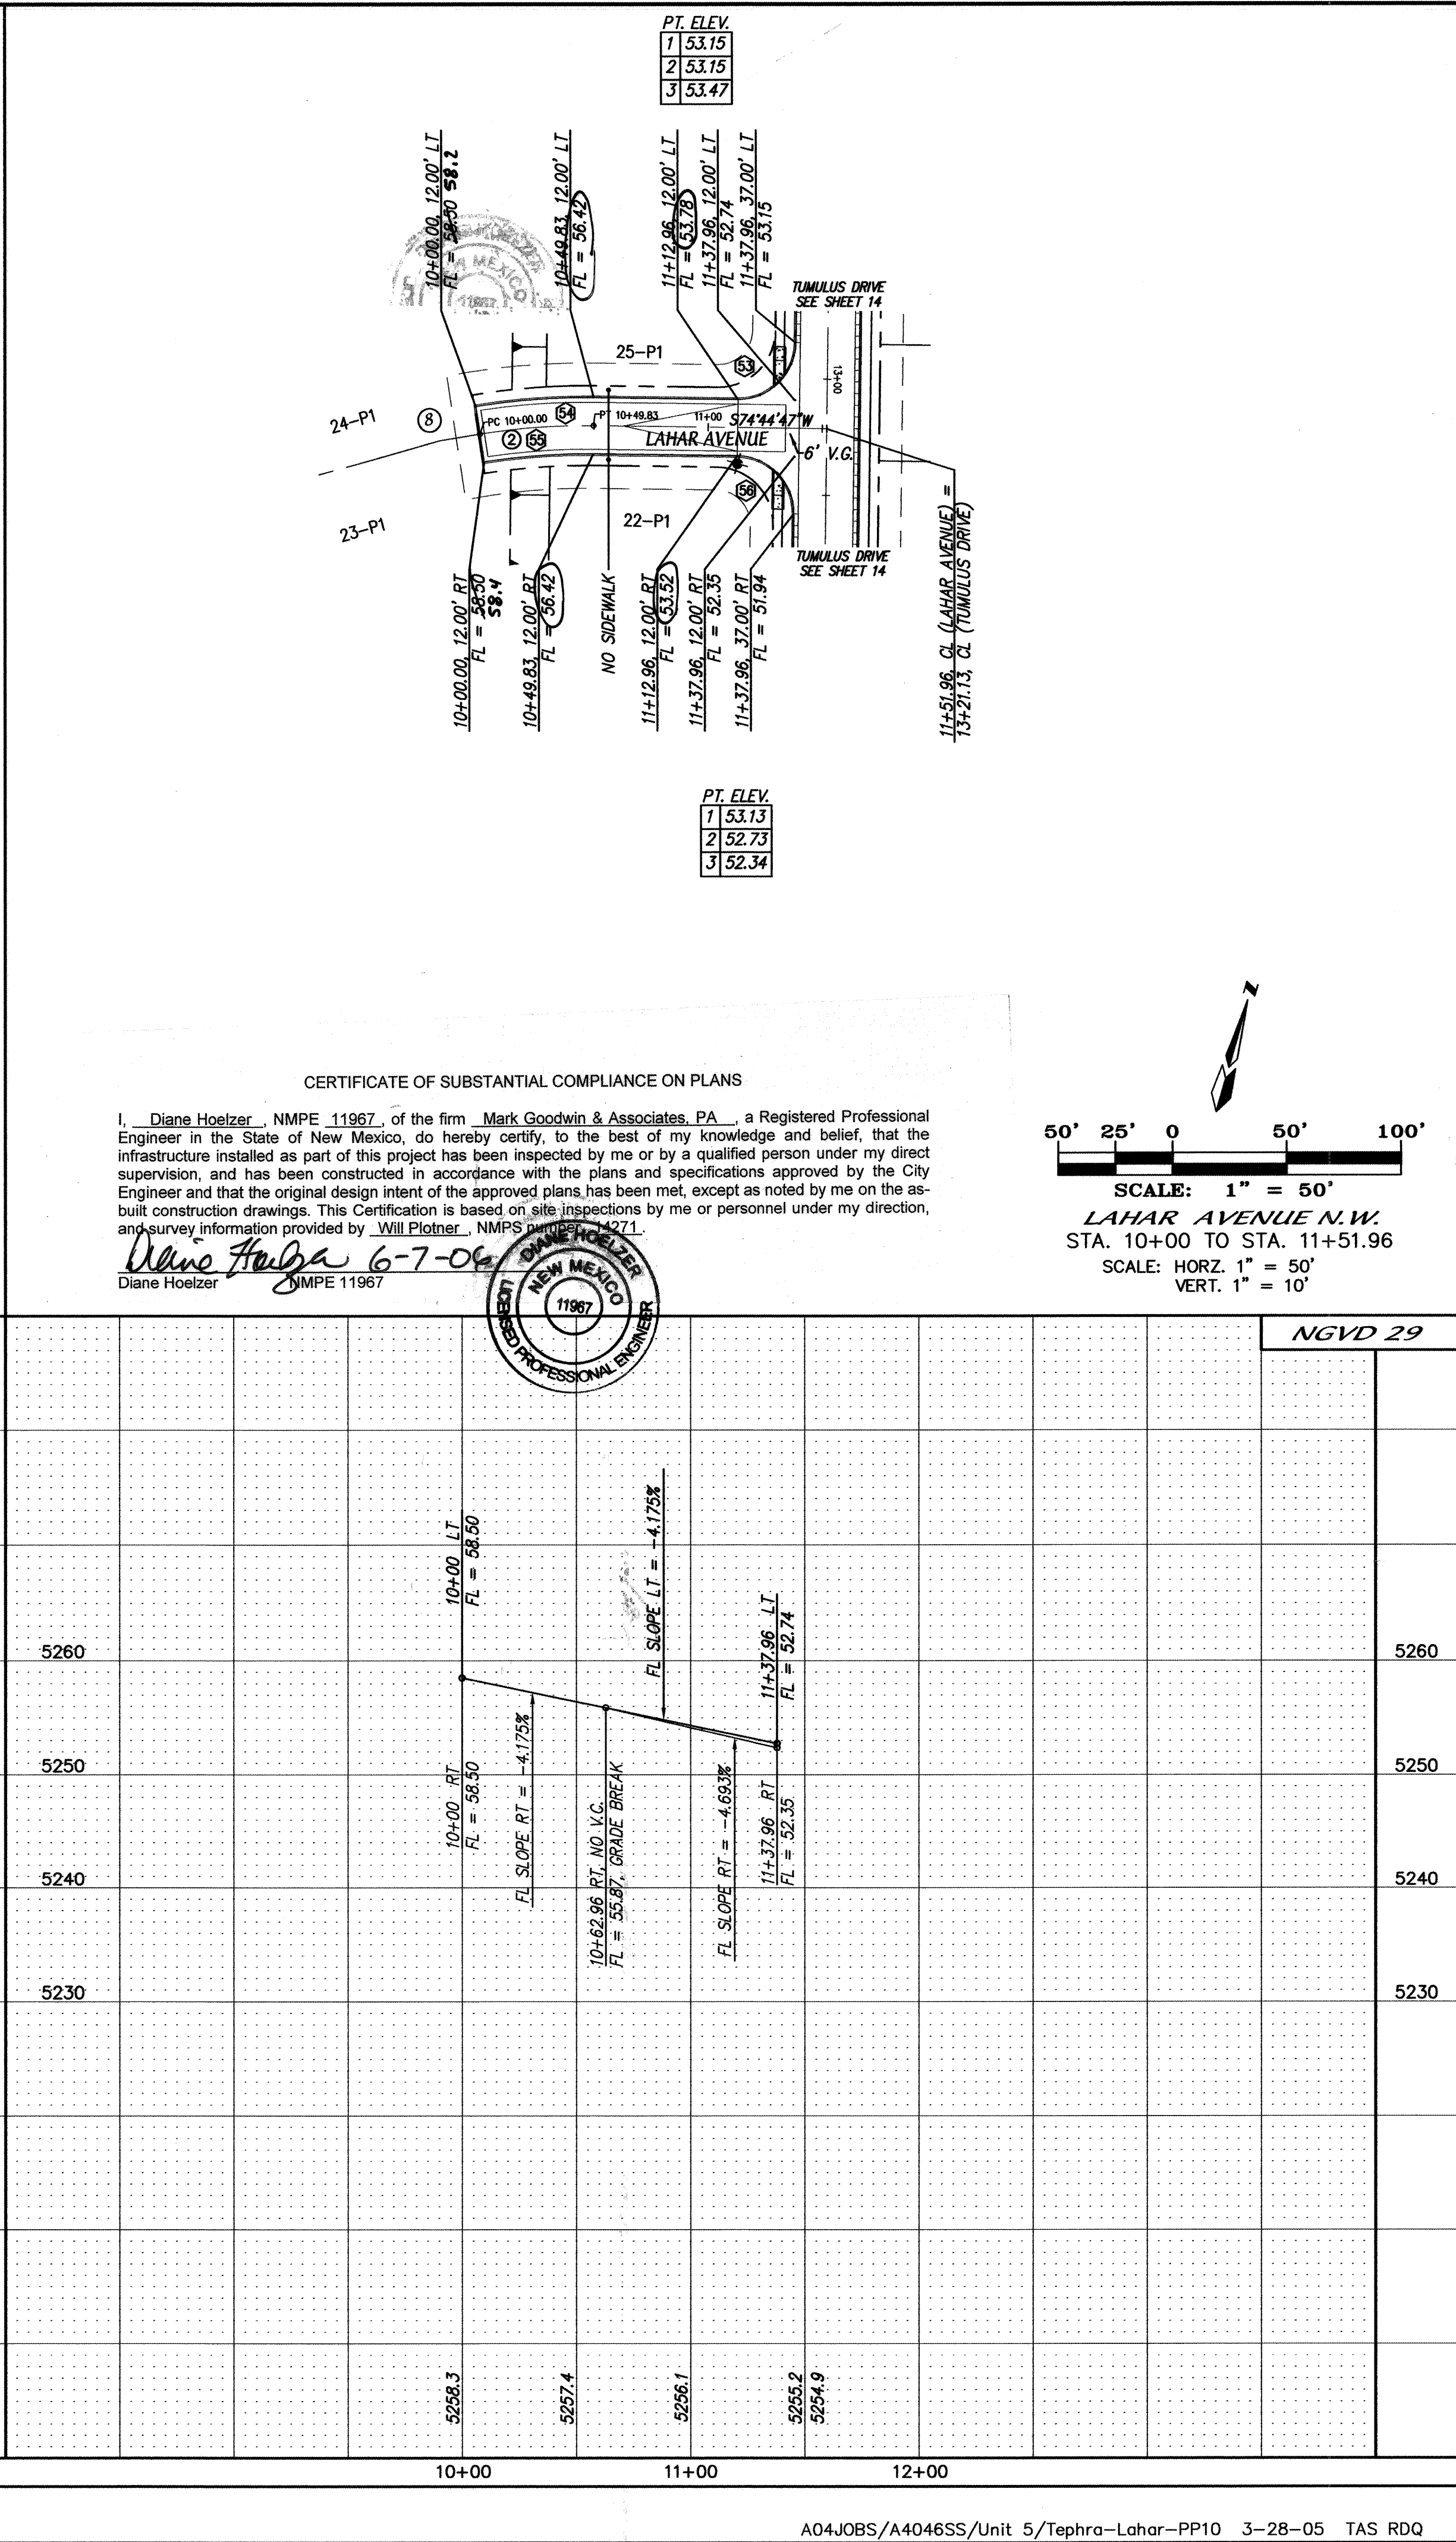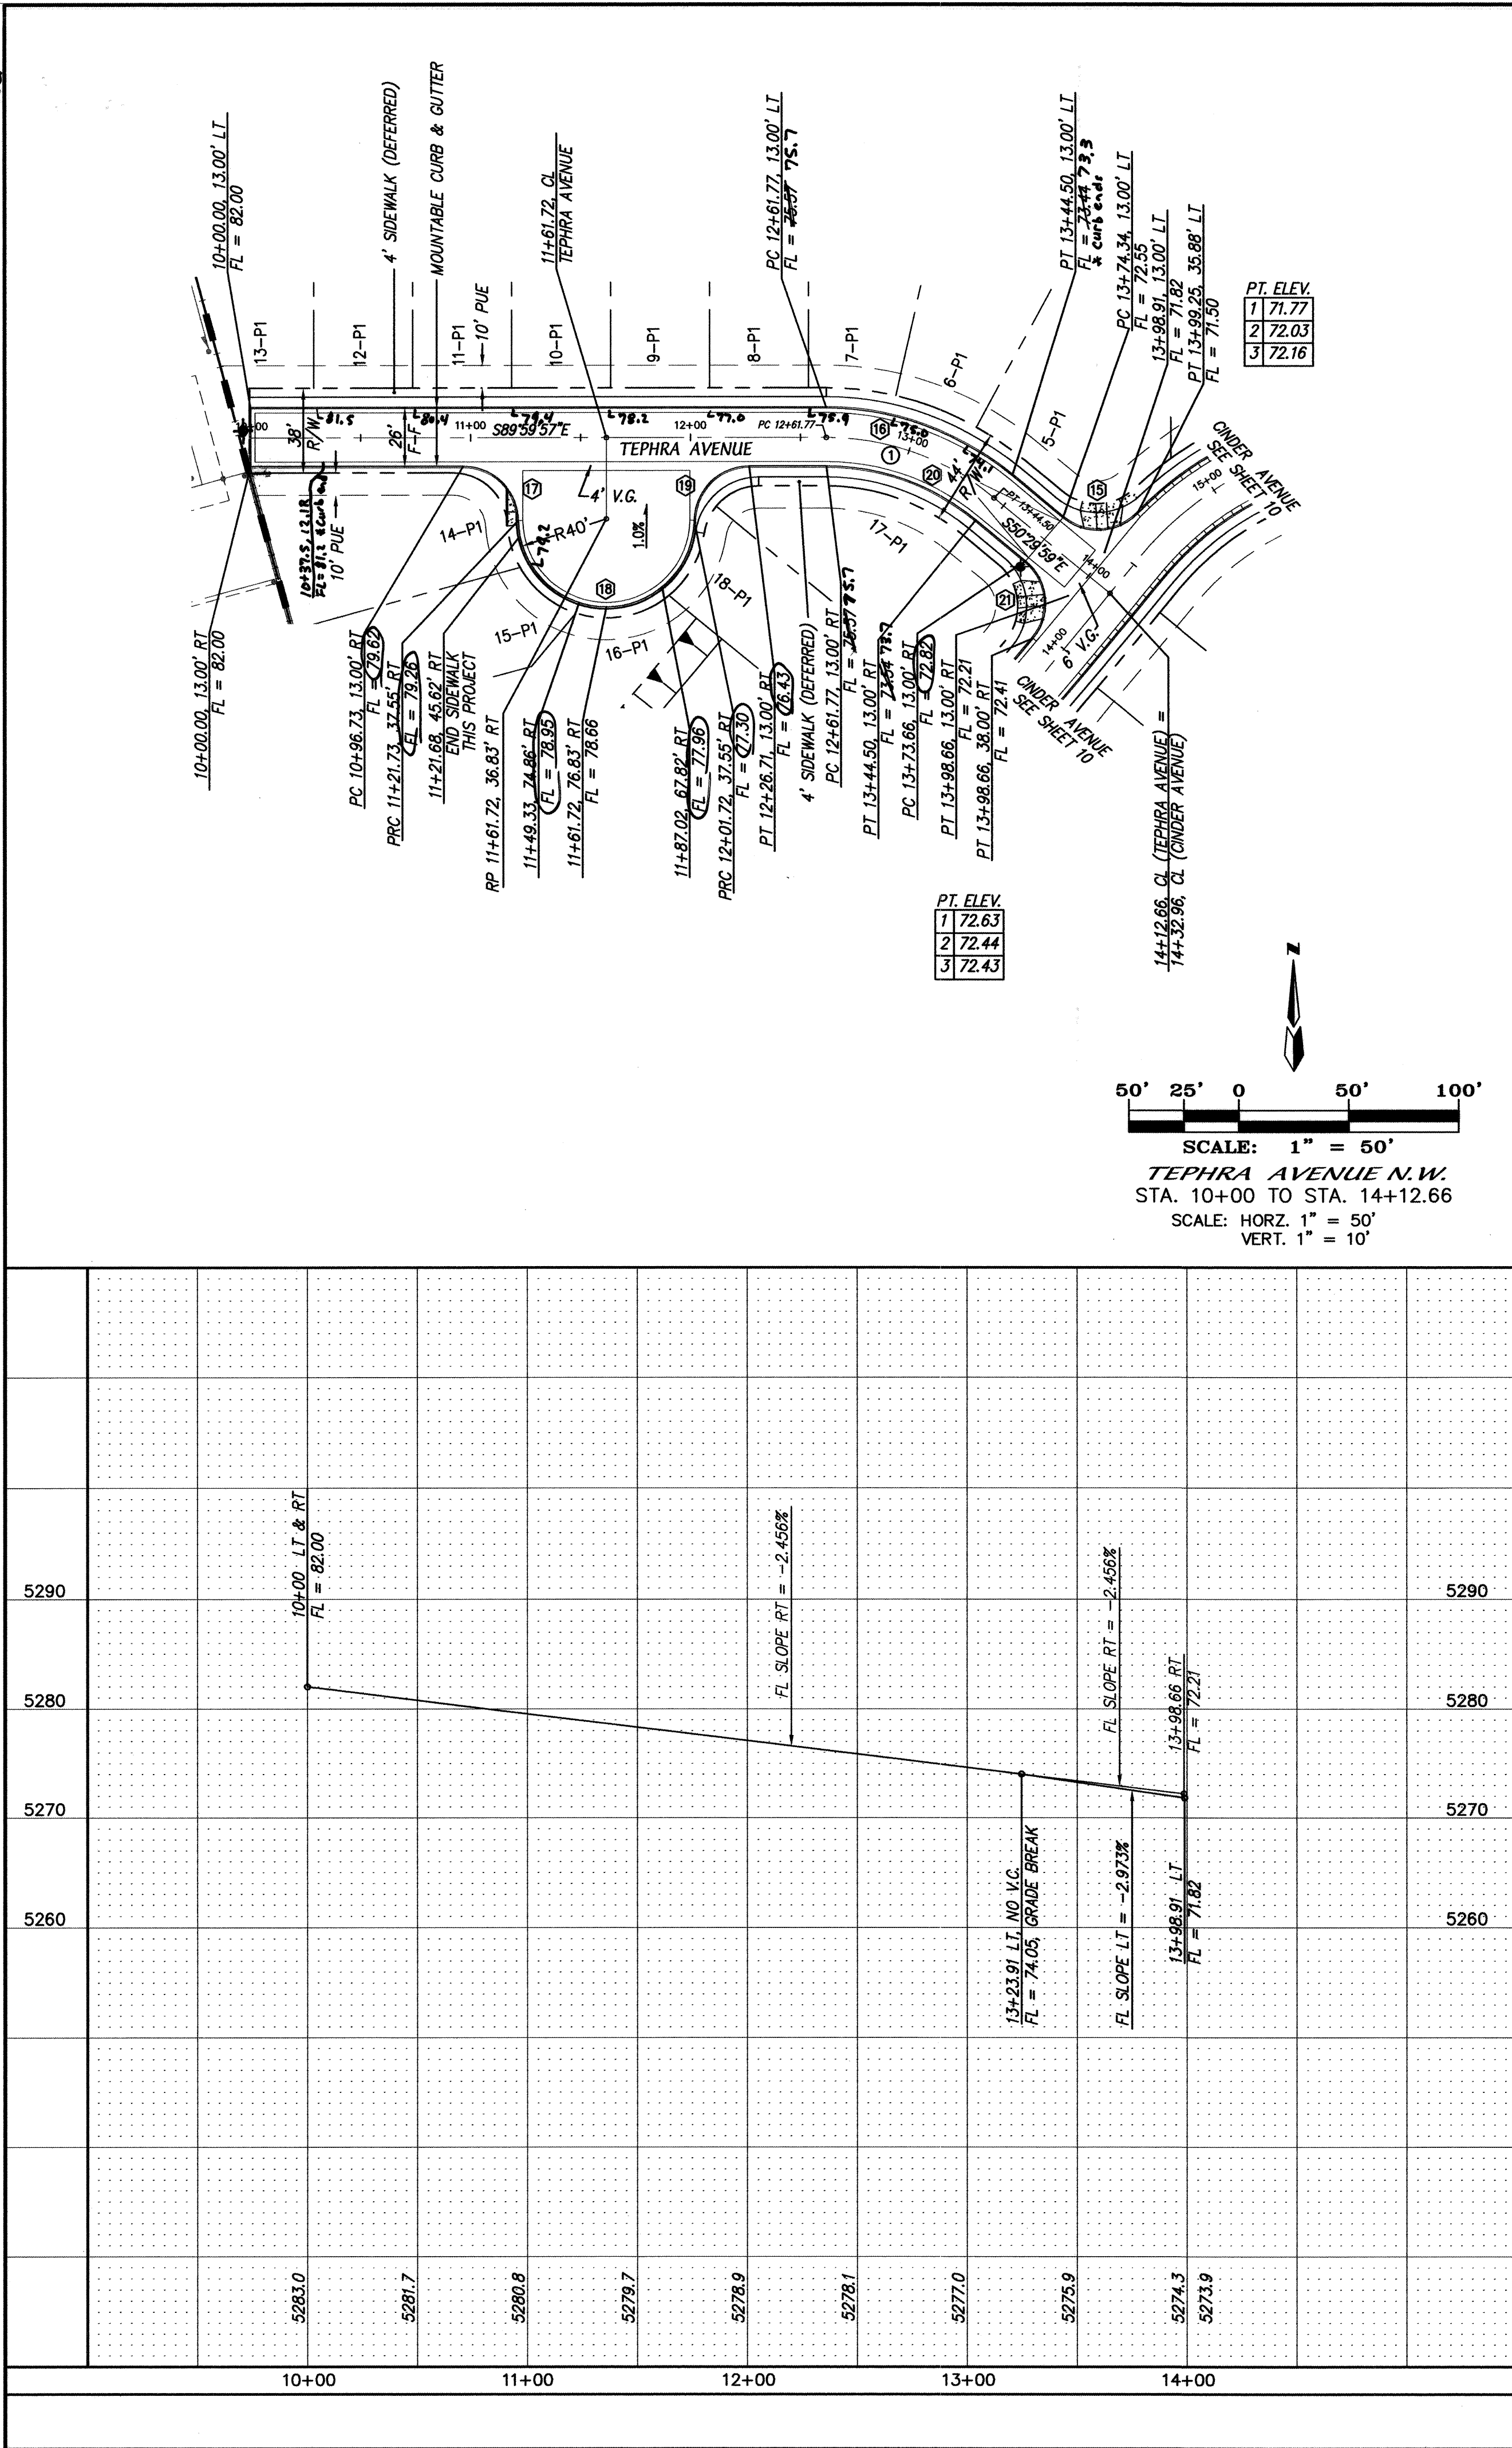

NOTES

1. ALL STATIONING IS CENTERLINE STATIONING.

CURVE DATA - DESCRIBES CENTERLINE

① $\Delta = 39^{\circ}29'58''$ $R = 120.00'$ $L = 82.73'$ $T = 43.08'$	② $\Delta = 09^{\circ}43'53''$ $R = 298.00'$ $L = 49.83'$ $T = 24.97'$
---	---

CURVE DATA - DESCRIBES FACE OF CURB RETURNS

⑬ $\Delta = 85^{\circ}08'38''$ $R = 25.00'$ $L = 22.97'$ $T = 37.15'$	⑭ $\Delta = 39^{\circ}29'58''$ $R = 133.00'$ $T = 47.75'$ $L = 91.69'$	⑮ $\Delta = 88^{\circ}58'01''$ $R = 25.00'$ $T = 24.55'$ $L = 38.82'$
⑯ $\Delta = 177^{\circ}56'03''$ $R = 40.00'$ $L = 2218.42'$ $T = 124.22'$	⑰ $\Delta = 88^{\circ}58'01''$ $R = 25.00'$ $T = 24.55'$ $L = 38.82'$	⑱ $\Delta = 39^{\circ}29'58''$ $R = 107.00'$ $T = 38.42'$ $L = 73.77'$
⑳ $\Delta = 90^{\circ}00'00''$ $R = 25.00'$ $L = 39.27'$	㉑ $\Delta = 90^{\circ}00'00''$ $R = 25.00'$ $L = 39.27'$	㉒ $\Delta = 9^{\circ}35'11''$ $R = 309.01'$ $T = 25.91'$ $L = 51.70'$
㉓ $\Delta = 9^{\circ}34'42''$ $R = 284.00'$ $T = 23.79'$ $L = 47.48'$	㉔ $\Delta = 90^{\circ}00'00''$ $R = 25.00'$ $T = 25.00'$ $L = 39.27'$	

CERTIFICATION
THE CHANGES SHOWN HEREON ARE BASED UPON A FIELD SURVEY MADE OR UNDER MY SUPERVISION AND LOCATIONS (VERTICALLY AND HORIZONTALLY) TO THE BEST OF MY KNOWLEDGE AND BELIEF.

Will + [Signature]

**CITY OF ALBUQUERQUE
PUBLIC WORKS DEPARTMENT**

TITLE: **SUNDORO SOUTH - UNIT 5
TEPHRA AVENUE N.W. / LAHAR AVENUE N.W.
PAVING IMPROVEMENTS**



DESIGN REVIEW COMMITTEE: **APPROVED JUN 21 2005**
CITY ENGINEER APPROVAL: **APPROVED JUL 15 2005**

LAST DESIGN UPDATE: **MO./DAY/YR.**
CITY PROJECT NO. **727084**
ZONE MAP NO. **J-8/9**
SHEET **11** OF **27**

PT. ELEV.	
1	73.37
2	73.21
3	73.24

I, Diane Hoelzer, NMPE 11967, of the firm Mark Goodwin & Associates, PA, a Registered Professional Engineer in the State of New Mexico, do hereby certify, to the best of my knowledge and belief, that the infrastructure installed as part of this project has been inspected by me or by a qualified person under my direct supervision, and has been constructed in accordance with the plans and specifications approved by the City Engineer and that the original design intent of the approved plans has been met, except as noted by me on the as-built construction drawings. This Certification is based on site inspections by me or personnel under my direction, and survey information provided by Will Plotner, NMPS 10640, 1271.

Diane Hoelzer NMPE 11967

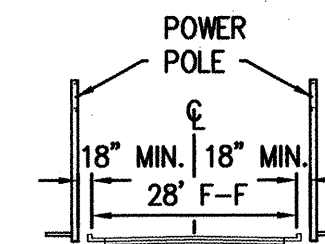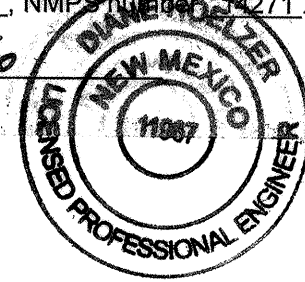

POWER POLE CROSS SECTION A-A
NTS

1. ALL STATIONING IS CENTERLINE STATIONING.

① $\Delta = 51^{\circ}35'20''$
 $R = 180.00''$
 $L = 162.07''$
 $T = 86.99''$

② $\Delta = 05^{\circ}41'58''$
 $R = 1000.00''$
 $L = 99.47''$
 $T = 49.78''$

③ $\Delta = 101^{\circ}18'51''$
 $R = 500.00''$
 $L = 90.01''$
 $T = 45.13''$

④ $\Delta = 19^{\circ}11'00''$
 $R = 500.00''$
 $L = 167.41''$
 $T = 84.49''$

⑤ $\Delta = 59^{\circ}35'55''$
 $R = 500.00''$
 $L = 83.76''$
 $T = 41.98''$

⑥ $\Delta = 26^{\circ}39'38''$
 $R = 300.00''$
 $L = 139.59''$
 $T = 71.08''$

26 $\Delta = 79'15''54''$
 $R = 25.00$
 $T = 20.71$
 $L = 34.59$

29 $\Delta = 214''41''16''$
 $R = 34.00$
 $T = 67.42$
 $L = 132.83$

30 $\Delta = 9'35''55''$
 $R = 514.00$
 $T = 43.16$
 $L = 86.11$

31 $\Delta = 1971''00''$
 $R = 486.00$
 $T = 82.13$
 $L = 162.72$

32 $\Delta = 1078''51''$
 $R = 514.00$
 $T = 46.39$
 $L = 92.53$

33 $\Delta = 5''41''58''$
 $R = 1014.00$
 $T = 50.47$
 $L = 100.87$

34 $\Delta = 51''35''20''$
 $R = 166.00$
 $T = 80.23$
 $L = 149.47$

35 $\Delta = 8070''00''$
 $R = 25.00$
 $T = 20.98$
 $L = 34.91$

36 $\Delta = 98'48''01''$
 $R = 25.00$
 $T = 29.17$
 $L = 43.11$

37 $\Delta = 5023''12''$
 $R = 194.00$
 $T = 91.26$
 $L = 170.61$

38 $\Delta = 541''58''$
 $R = 986.00$
 $T = 49.08$
 $L = 98.08$

39 $\Delta = 1078''51''$
 $R = 486.00$
 $T = 43.86$
 $L = 87.49$

40 $\Delta = 1971''00''$
 $R = 514.00$
 $T = 86.86$
 $L = 172.09$

41 $\Delta = 9'35''55''$
 $R = 486.00$
 $T = 40.80$
 $L = 81.42$

42 $\Delta = 2223''10''$
 $R = 286.00$
 $T = 56.59$
 $L = 111.74$

43 $\Delta = 8739''12''$
 $R = 25.00$
 $T = 24.00$
 $L = 38.25$

106 $\Delta = 180''00''00''$
 $R = 3.00$
 $T = 50.00$
 $L = 94.43$

109 $\Delta = 180''00''12''$
 $R = 2.00$
 $T = 50.00$
 $L = 6.28$

PT. ELEV.	
1	QT PT
2	QT PT
3	QT PT

PT. ELEV.

1	QT	PT
2	QT	PT
3	QT	PT



ALL QUARTER POINTS ARE
CLOCKWISE ROTATION AT
CURB RETURN.

Certification
THE CHANGES SHOWN HEREON ARE BASED UPON A
FIELD SURVEY CONDUCTED BY ME OR UNDER MY
SUPERVISION AND REFLECT THE LOCATIONS
(VERTICALLY AND HORIZONTALLY) TO THE BEST OF
MY KNOWLEDGE AND BELIEF.

Will Drake

dmg MARK GOODWIN & ASSOCIATES, P.A.
CONSULTING ENGINEERS
P.O. BOX 90606
ALBUQUERQUE, NEW MEXICO 87199
(505) 828-2200, FAX (505) 797-9539

 CITY OF ALBUQUERQUE
PUBLIC WORKS DEPARTMENT

TITLE: *SUNDORO SOUTH - UNIT 5
COLIMA AVENUE
PAVING IMPROVEMENTS*

DESIGN REVIEW COMMITTEE

APPROVE

JUN 21 2005

DESIGN REVIEW COMMITTEE

CITY ENGINEER APPROVAL
APPROVED
JUL 15 2005
CITY ENGINEER

LAST DESIGN UPDATE	MO./DAY/YR.	MO./DAY/YR.

CITY PROJECT NO.	727084	ZONE MAP NO.	1-8/9	SHEET	OF	12	27
------------------	--------	--------------	-------	-------	----	----	----

A04JOBS/A4046SS/Unit 5/COLIMA-PP11 3-28-05 TAS RDQ

SCANNED BY
PLANNING

SEE NOTE 3
FOR PAVEMENT SECTION

SEE NOTE 3
FOR PAVEMENT SECTION

PT. ELEV.
1 60.06
2 60.00
3 59.87

PT. ELEV.
1 61.17
2 61.03
3 60.86

PT. ELEV.
1 60.06
2 60.00
3 59.87

PT. ELEV.
1 60.06
2 60.33
3 60.60

PT. ELEV.
1 61.21
2 61.11
3 61.22

NOTES

1. ALL STATIONING IS CENTERLINE STATIONING.
2. BUILD VALLEY GUTTER AND CURB RETURNS ONLY. PLACE TEMPORARY TYPE III BARRICADES, IF NECESSARY.
3. FROM END OF CUL-DE-SAC TO STA 14+86 USE (2) 1 1/2" A.C. (TYPE "B") AND FROM STA 14+86 TO STA 19+28 USE (2) 2" A.C. (TYPE "B"). SEE MASTER PAVING FOR MORE DETAIL.
4. CONSTRUCT CUT OFF WALL ACROSS PAVEMENT EDGE AND PLACE TEMPORARY TYPE III BARRICADES, IF NECESSARY.

CURVE DATA - DESCRIBES CENTERLINE


- ① $\Delta = 152^{\circ}17'$
 $R = 300.00'$
 $L = 81.10'$
 $T = 40.80'$
- ② $\Delta = 190^{\circ}55'$
 $R = 300.00'$
 $L = 81.23'$
 $T = 40.87'$

PT. ELEV.
1 101.07
2 101.07
3 101.07

ALL QUARTER POINTS ARE
CLOCKWISE ROTATION AT
CURB RETURN.

CURVE DATA - DESCRIBES FACE OF CURB RETURNS

- ④5 $\Delta = 83^{\circ}34'04''$
 $R = 25.00$
 $T = 22.34$
 $L = 36.46$
- ④6 $\Delta = 09^{\circ}04'54''$
 $R = 314.00$
 $T = 24.94$
 $L = 49.77$
- ④7 $\Delta = 152^{\circ}17'$
 $R = 286.00$
 $T = 38.89$
 $L = 77.31$
- ④8 $\Delta = 41^{\circ}32'29''$
 $R = 25.00$
 $T = 9.48$
 $L = 18.13$
- ④9 $\Delta = 278^{\circ}04'11''$
 $R = 35.00$
 $T = 30.39$
 $L = 169.86$
- ⑤0 $\Delta = 56^{\circ}31'42''$
 $R = 25.00$
 $T = 13.44$
 $L = 24.67$
- ⑤1 $\Delta = 90^{\circ}00'00''$
 $R = 25.00$
 $T = 27.30$
 $L = 41.46$
- ⑤2 $\Delta = 95^{\circ}01'35''$
 $R = 25.00$
 $T = 25.00$
 $L = 39.27$
- ⑤3 $\Delta = 102^{\circ}56'50''$
 $R = 286.00$
 $T = 28.15$
 $L = 52.15$
- ⑤4 $\Delta = 152^{\circ}17'$
 $R = 314.00$
 $T = 42.70$
 $L = 84.88$
- ⑤5 $\Delta = 90^{\circ}00'00''$
 $R = 25.00$
 $T = 25.00$
 $L = 39.27$
- ⑤6 $\Delta = 90^{\circ}00'00''$
 $R = 25.00$
 $T = 25.00$
 $L = 39.27$

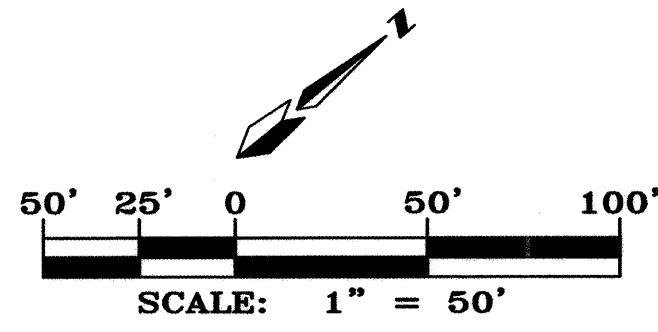


ASHFALL PLACE
STA. 10+00.00 TO STA. 21+00.00
SCALE: HORZ. 1" = 50'
VERT. 1" = 10'

CERTIFICATE OF SUBSTANTIAL COMPLIANCE ON PLANS

I, Diane Hoelzer, NMPE 11967, of the firm Mark Goodwin & Associates, P.A., a Registered Professional Engineer in the State of New Mexico, do hereby certify, to the best of my knowledge and belief, that the infrastructure installed as part of this project has been inspected by me or by a qualified person under my direct supervision, and has been constructed in accordance with the plans and specifications approved by the City Engineer and that the original design intent of the approved plans has been met, except as noted by me on the as-built construction drawings. This Certification is based on site inspections by me or personnel under my direction, and survey information provided by Will Plotner, NMPS number 14274.

Diane Hoelzer 6-7-06
Diane Hoelzer NMPE 11967

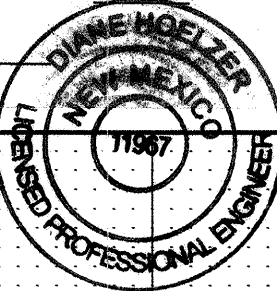

Certification
THE CHANGES SHOWN HEREON ARE BASED UPON A
FIELD SURVEY CONDUCTED BY ME OR UNDER MY
SUPERVISION AND REFLECT THE LOCATIONS
(VERTICALLY AND HORIZONTALLY) TO THE BEST OF
MY KNOWLEDGE AND BELIEF.

Will Plotner

dmg MARK GOODWIN & ASSOCIATES, P.A.
CONSULTING ENGINEERS
P.O. BOX 90606
ALBUQUERQUE, NEW MEXICO 87199
(505) 828-2200, FAX (505) 797-9539



CITY OF ALBUQUERQUE
PUBLIC WORKS DEPARTMENT

TITLE: **SUNDORO SOUTH - UNIT 5
ASHFALL PLACE
PAVING IMPROVEMENTS**


DESIGN REVIEW COMMITTEE
APPROVED
JUN 21 2005

CITY ENGINEER APPROVAL
APPROVED
JUL 15 2005
CITY ENGINEER


FILE NO./DAY/YR.
MO./DAY/YR.

CITY PROJECT NO. **727084** ZONE MAP NO. **J-8/9** SHEET **13** OF **27**

SCANNED BY
PLANNING

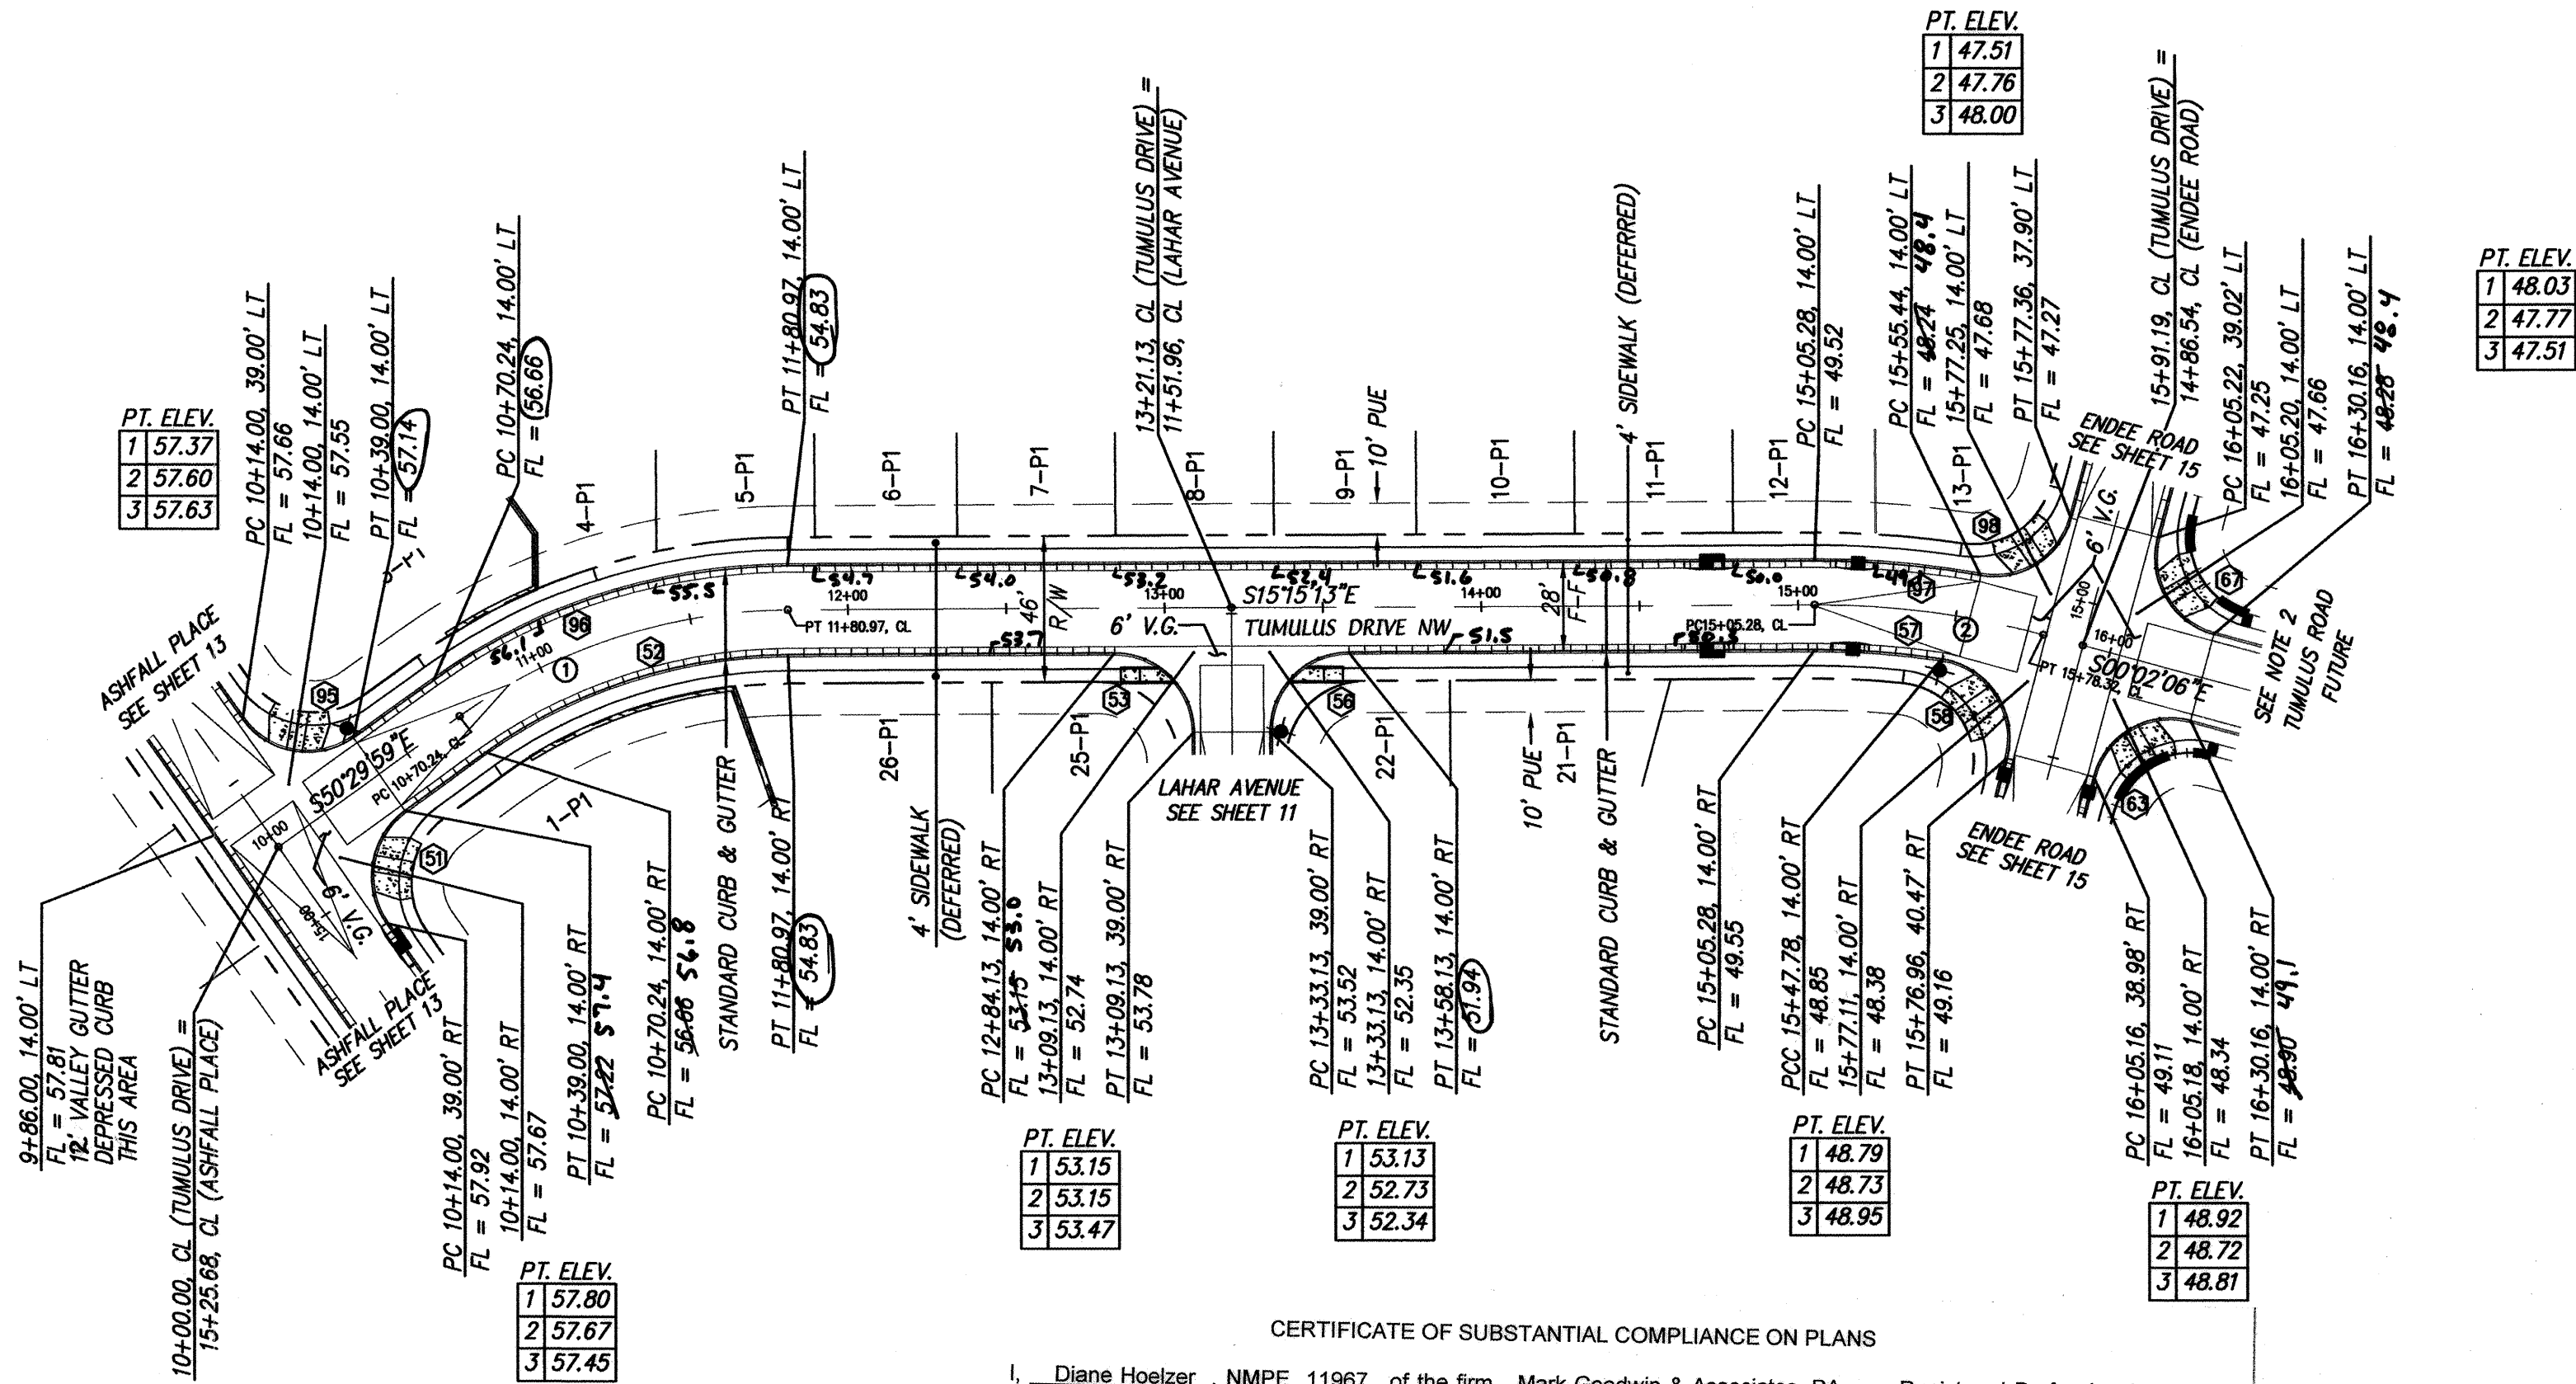

CERTIFICATE OF SUBSTANTIAL COMPLIANCE ON PLANS
I, Diane Hoelzer, NMPE 11967, of the firm Mark Goodwin & Associates, P.A., a Registered Professional Engineer in the State of New Mexico, do hereby certify, to the best of my knowledge and belief, that the infrastructure installed as part of this project has been inspected by me or by a qualified person under my direct supervision, and has been constructed in accordance with the plans and specifications approved by the City Engineer and that the original design intent of the approved plans has been met, except as noted by me on the as-built construction drawings. This Certification is based on site inspections by me or personnel under my direction, and survey information provided by Will Plotner, NMPS number 14271.
Diane Hoelzer NMPE 11967

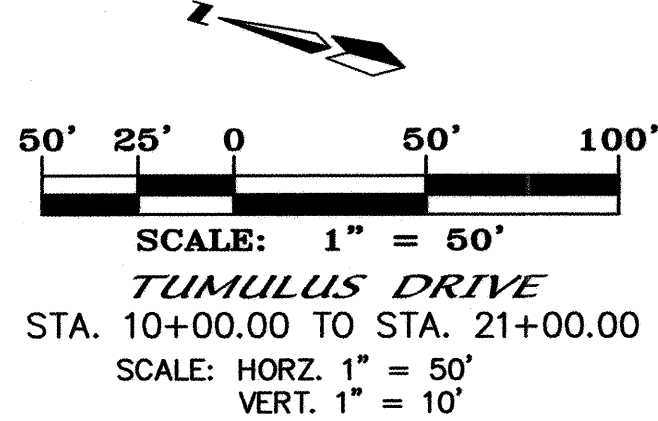

NOTES

1. ALL STATIONING IS CENTERLINE STATIONING.
2. BUILD VALLEY GUTTER AND CURB RETURNS ONLY AND PLACE TEMP. TYPE III BARRICADE IF NECESSARY.

CURVE DATA - DESCRIBES CENTERLINE

- | | |
|---|---|
| ① $\Delta = 35^{\circ}14'26''$
$R = 180.00'$
$L = 110.23'$
$T = 111.67'$ | ② $\Delta = 15^{\circ}13'07''$
$R = 275.00'$
$L = 73.04'$
$T = 36.74'$ |
|---|---|

PT. ELEV.
1 57.81
2 57.60
3 57.63

ALL QUARTER POINTS ARE
CLOCKWISE ROTATION AT
CURB RETURN.

CURVE DATA - DESCRIBES FACE OF CURB RETURNS

- | | | |
|--|--|--|
| ⑤① $\Delta = 90^{\circ}00'00''$
$R = 25.00$
$T = 25.00$
$L = 39.27$ | ⑤② $\Delta = 35^{\circ}14'46''$
$R = 166.00$
$T = 52.73$
$L = 102.12$ | ⑤③ $\Delta = 90^{\circ}00'00''$
$R = 25.00$
$T = 25.00$
$L = 39.27$ |
| ⑤④ $\Delta = 90^{\circ}00'00''$
$R = 25.00$
$T = 25.00$
$L = 39.27$ | ⑤⑤ $\Delta = 8^{\circ}51'13''$
$R = 281.00$
$T = 20.21$
$L = 40.33$ | ⑤⑥ $\Delta = 96^{\circ}24'32''$
$R = 25.00$
$T = 27.97$
$L = 42.07$ |
| ⑤⑦ $\Delta = 89^{\circ}57'22''$
$R = 25.00$
$T = 24.98$
$L = 39.25$ | ⑤⑧ $\Delta = 90^{\circ}02'31''$
$R = 25.00$
$T = 25.00$
$L = 39.29$ | ⑤⑨ $\Delta = 90^{\circ}00'00''$
$R = 25.00$
$T = 25.00$
$L = 39.27$ |
| ⑤⑩ $\Delta = 35^{\circ}14'46''$
$R = 194.00$
$T = 61.63$
$L = 119.34$ | ⑤⑪ $\Delta = 10^{\circ}27'00''$
$R = 289.00$
$T = 26.43$
$L = 52.71$ | ⑤⑫ $\Delta = 85^{\circ}11'15''$
$R = 25.00$
$T = 22.98$
$L = 37.17$ |

Certification

THE CHANGES SHOWN HEREON ARE BASED UPON A
FIELD SURVEY CONDUCTED BY ME OR UNDER MY
SUPERVISION AND REFLECT THE LOCATIONS
(VERTICALLY AND HORIZONTALLY) TO THE BEST OF
MY KNOWLEDGE AND BELIEF.

Will Plotner

dmg MARK GOODWIN & ASSOCIATES, P.A.
CONSULTING ENGINEERS
P.O. BOX 90606
ALBUQUERQUE, NEW MEXICO 87199
(505) 828-2200, FAX (505) 797-9539



CITY OF ALBUQUERQUE
PUBLIC WORKS DEPARTMENT

TITLE: **SUNDORO SOUTH - UNIT 5
TUMULUS DRIVE
PAVING IMPROVEMENTS**

DESIGN REVIEW COMMITTEE
APPROVE
JUN 21 2005
DESIGN REVIEW COMMITTEE

CITY ENGINEER APPROVAL
APPROVE
JUL 15 2005
CITY ENGINEER


MO./DAY/YR. MO./DAY/YR.
LAST DESIGN UPDATE
DATE DATE
DATE DATE

CITY PROJECT NO. **727084**

ZONE MAP NO. **J-8/9**

SHEET **14** OF **27**



SCANNED BY
PLANNING

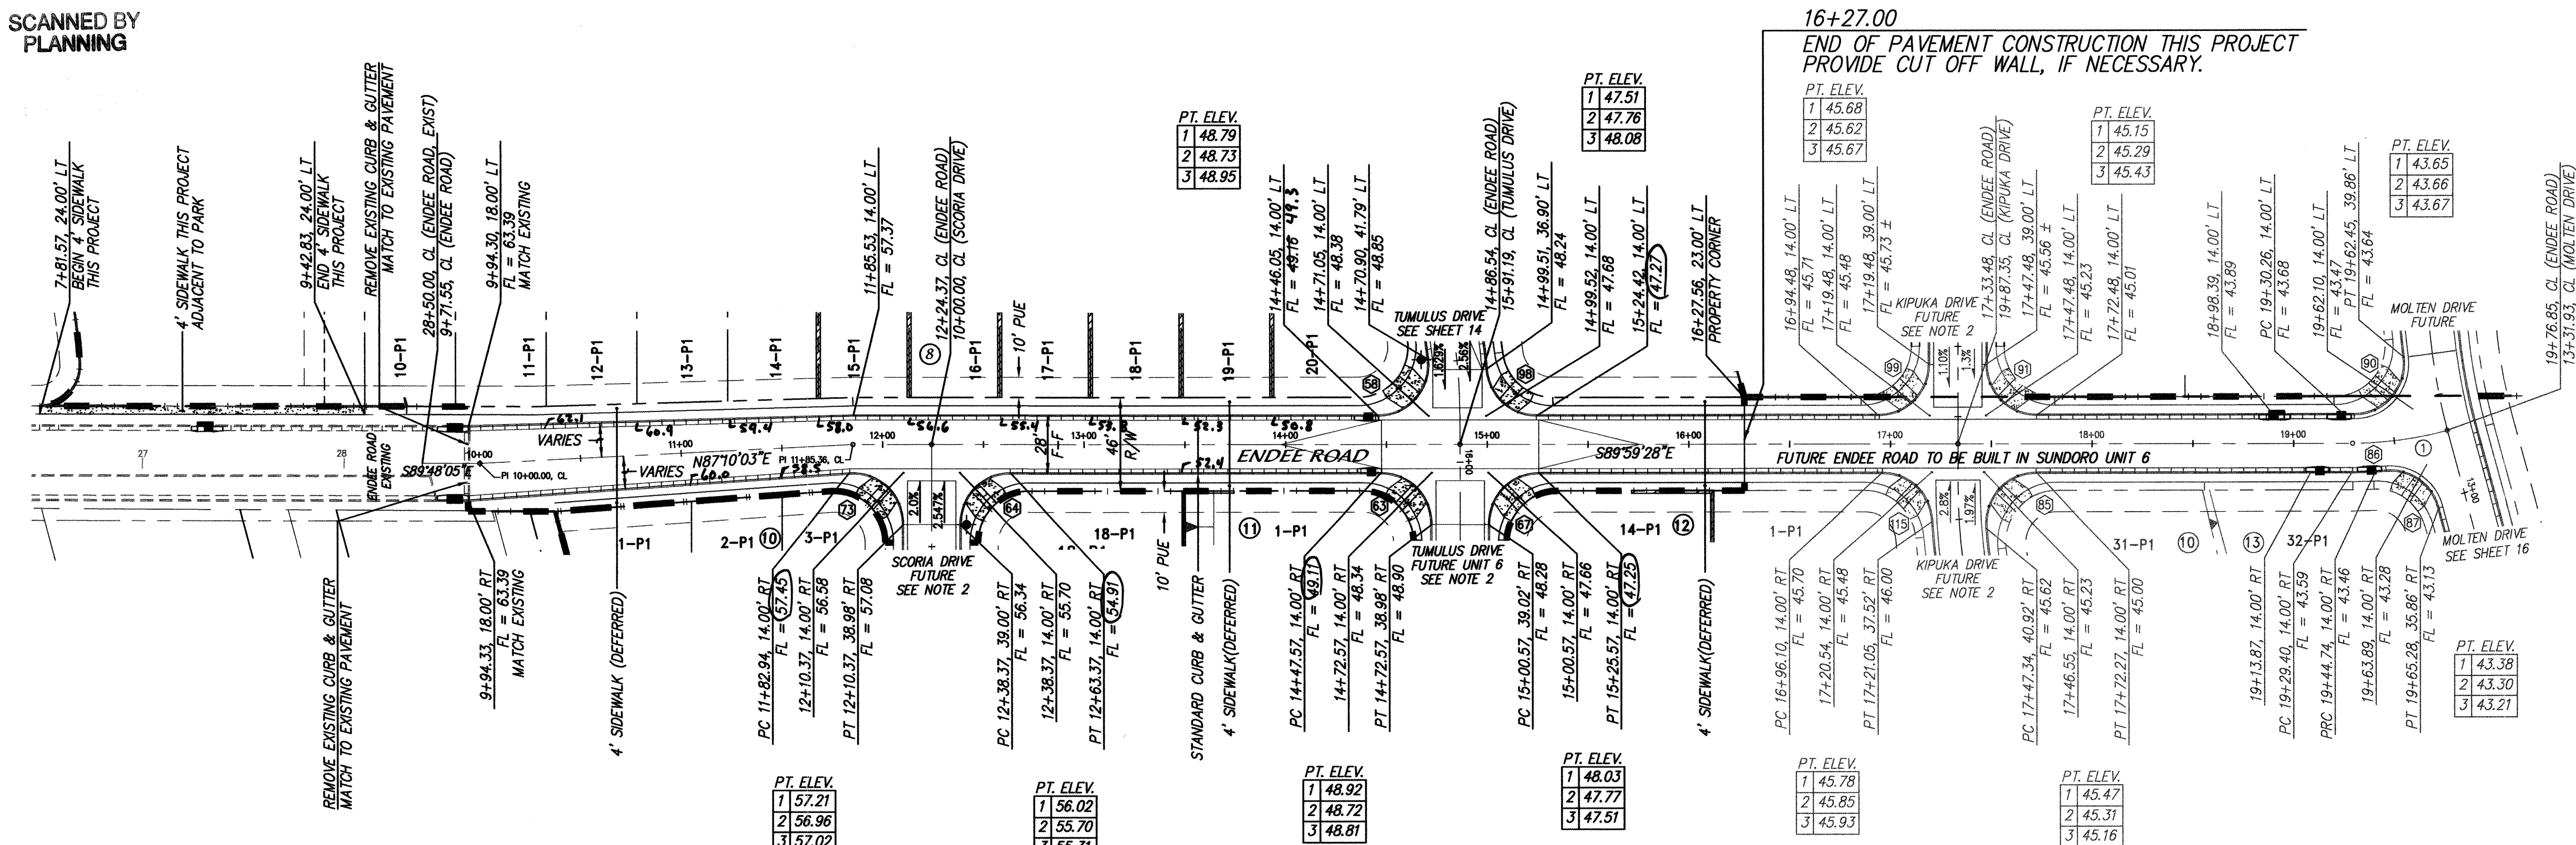


CERTIFICATE OF SUBSTANTIAL COMPLIANCE ON PLANS

I, Diane Hoelzer, NMPE 11967, of the firm Mark Goodwin & Associates, P.A., a Registered Professional Engineer in the State of New Mexico, do hereby certify, to the best of my knowledge and belief, that the infrastructure installed as part of this project has been inspected by me or by a qualified person under my direct supervision, and has been constructed in accordance with the plans and specifications approved by the City Engineer and that the original design intent of the approved plans has been met, except as noted by me on the as-built construction drawings. This Certification is based on site inspections by me or personnel under my direction, and survey information provided by Will Plotner, NMPS number 14271.

Diane Hoelzer
Diane Hoelzer
NMPE 11967
6-7-06

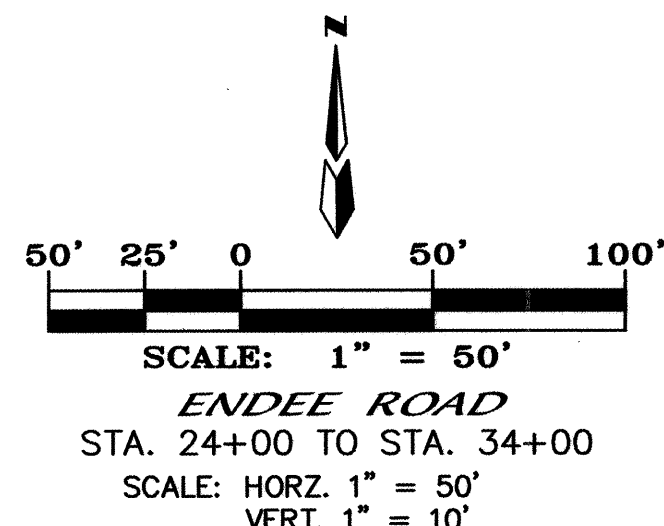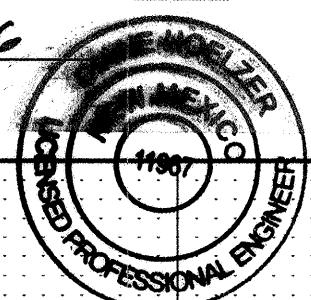

FUTURE PAVEMENT WITH SUNDORO UNIT 6

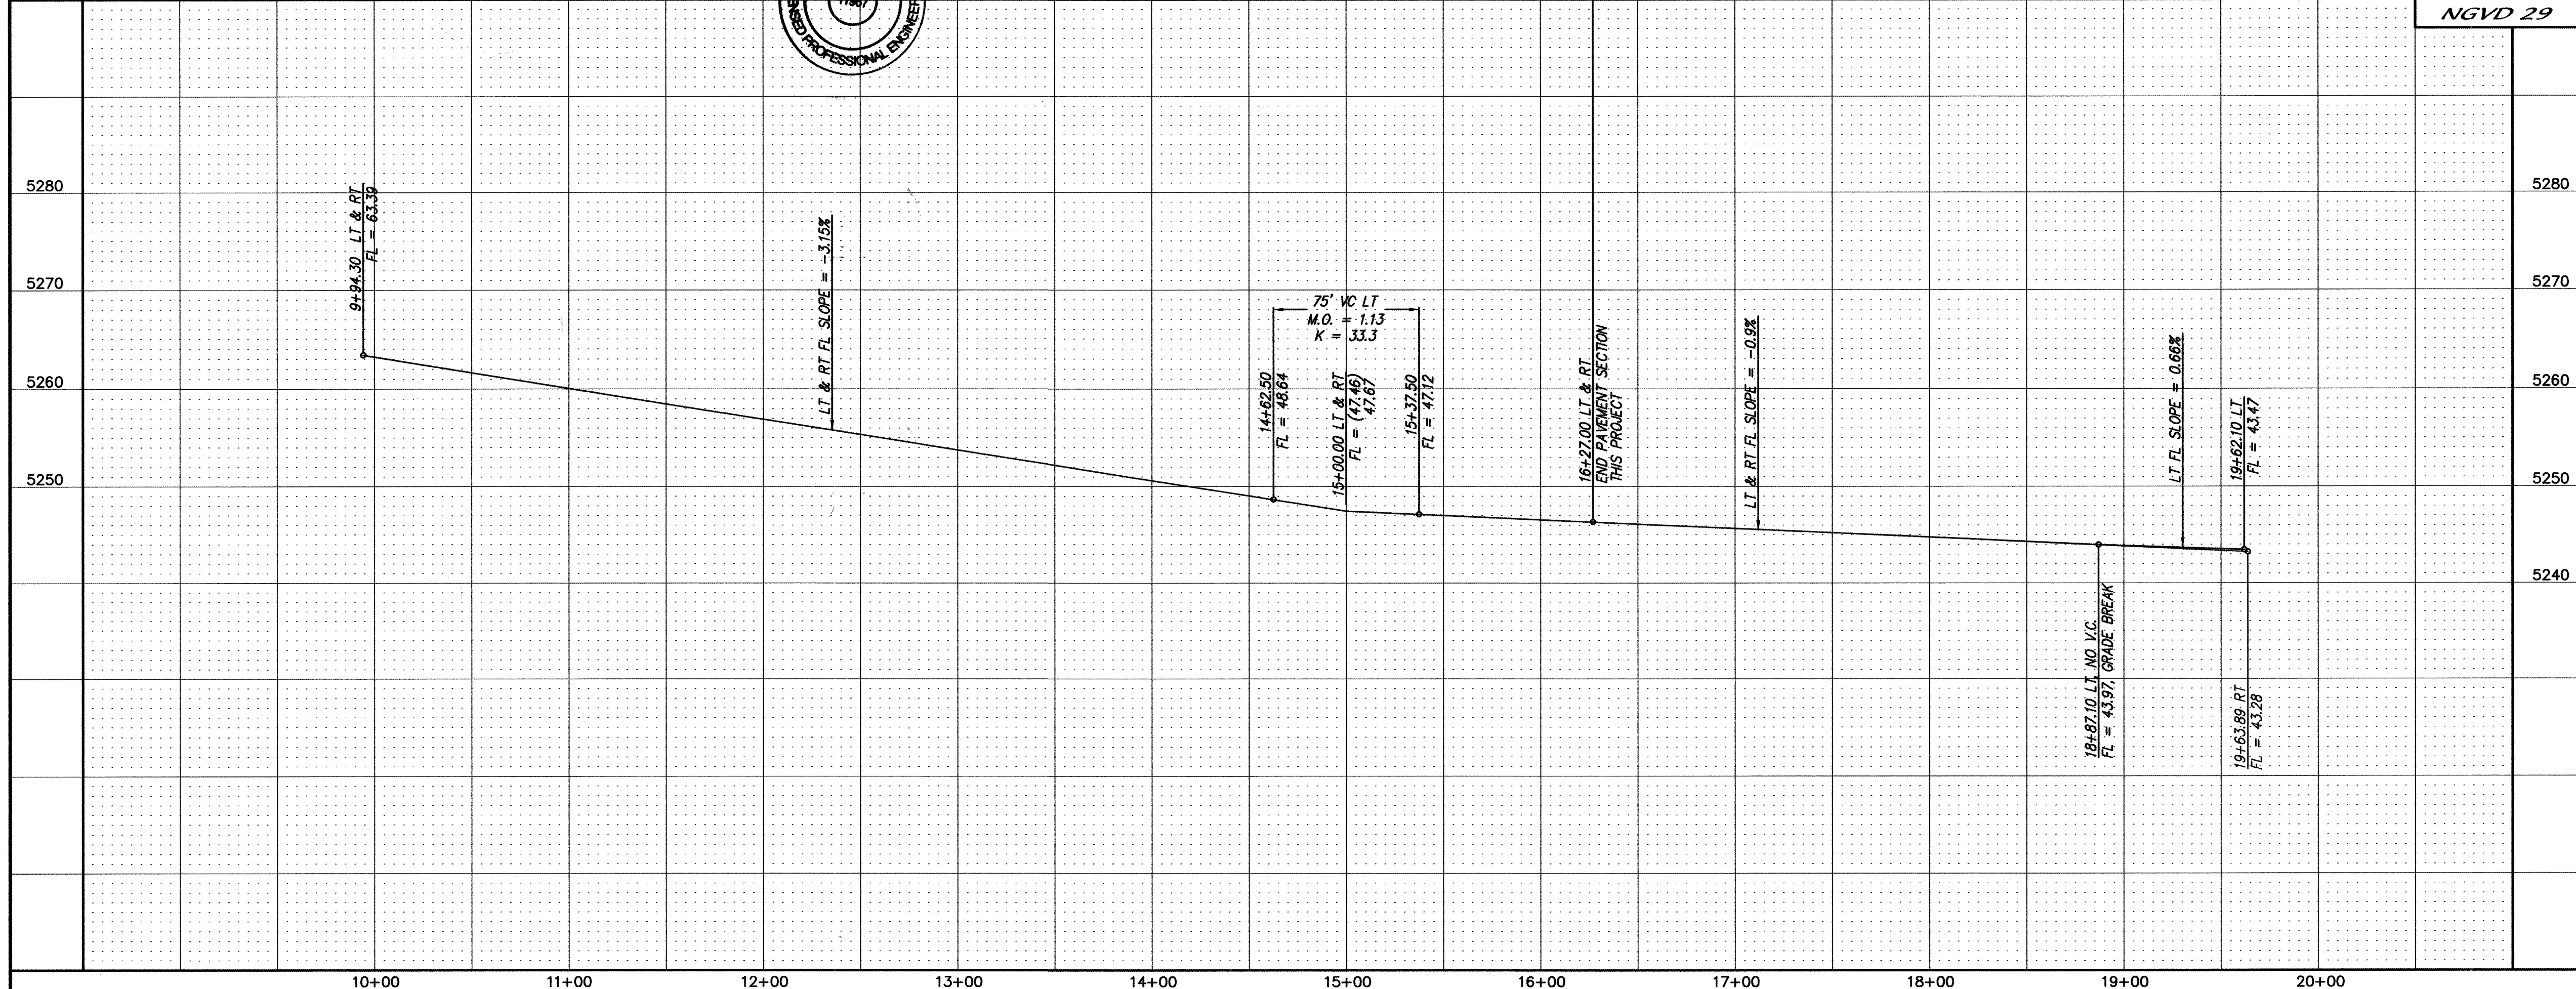


NOTES

1. ALL STATIONING IS CENTERLINE STATIONING.
2. BUILD VALLEY CUTTER & CURB RETURNS ONLY AND INSTALL TEMPORARY TYPE III BARRICADES, IF NECESSARY.

CURVE DATA - DESCRIBES CENTERLINE

- ① $\Delta = 1506'10''$
 $R = 180.00'$
 $L = 47.45'$
 $T = 23.86'$

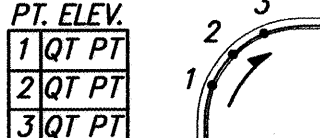

ALL QUARTER POINTS ARE
CLOCKWISE ROTATION AT
CURB RETURN.

CURVE DATA - DESCRIBES FACE OF CURB RETURNS

- | | | |
|---|---|---|
| ⑤8 $\Delta = 96'24'32''$
$R = 25.00$
$T = 27.97$
$L = 42.07$ | ⑤3 $\Delta = 89'57'22''$
$R = 25.00$
$T = 24.98$
$L = 39.25$ | ⑤4 $\Delta = 90'02'38''$
$R = 25.00$
$T = 25.02$
$L = 39.29$ |
| ⑤7 $\Delta = 90'02'31''$
$R = 25.00$
$T = 25.02$
$L = 39.29$ | ⑤3 $\Delta = 83'55'16''$
$R = 25.00$
$T = 26.77$
$L = 40.98$ | ⑤5 $\Delta = 94'21'23''$
$R = 25.01$
$T = 26.99$
$L = 41.19$ |
| ⑤6 $\Delta = 4'52'51''$
$R = 194.00$
$T = 8.27$
$L = 16.53$ | ⑤7 $\Delta = 79'32'13''$
$R = 25.00$
$T = 20.81$
$L = 34.70$ | ⑤0 $\Delta = 97'26'07''$
$R = 25.00$
$T = 28.47$
$L = 42.51$ |
| ⑤1 $\Delta = 89'58'56''$
$R = 25.00$
$T = 24.99$
$L = 39.26$ | ⑤8 $\Delta = 85'11'15''$
$R = 25.00$
$T = 22.98$
$L = 37.17$ | ⑤9 $\Delta = 90'01'04''$
$R = 25.00$
$T = 25.01$
$L = 39.28$ |
| ⑤15 $\Delta = 180'00'00''$
$R = 24.99$
$T = 23.57$
$L = 37.79$ | | |

Certification

THE CHANGES SHOWN HEREON ARE BASED UPON A
FIELD SURVEY CONDUCTED BY ME OR UNDER MY
SUPERVISION AND REFLECT THE LOCATIONS
(VERTICALLY AND HORIZONTALLY) TO THE BEST OF
MY KNOWLEDGE AND BELIEF.

Will Plotner




MARK GOODWIN & ASSOCIATES, P.A.
CONSULTING ENGINEERS
P.O. BOX 90606
ALBUQUERQUE, NEW MEXICO 87199
(505) 828-2200, FAX (505) 797-9539




CITY OF ALBUQUERQUE
PUBLIC WORKS DEPARTMENT

TITLE: **SUNDORO SOUTH - UNIT 5
ENDEE ROAD
PAVING IMPROVEMENTS**

DESIGN REVIEW COMMITTEE

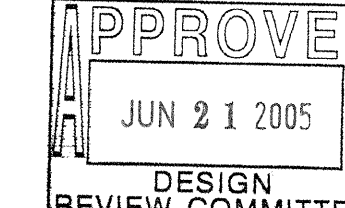

CITY ENGINEER APPROVAL

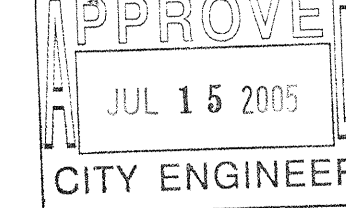

LAST DESIGN UPDATE

MO./DAY/YR.

CITY PROJECT NO.

727084

ZONE MAP NO.

J-8/9

SHEET

OF

15

27

[illegible]

I, Diane Hoesler, NMPE 11967, of the firm Mark Goodwin & Associates, PA, a Registered Professional Engineer in the State of New Mexico, do hereby certify, to the best of my knowledge and belief, that the infrastructure installed as part of this project has been inspected by me or by a qualified person under my direct supervision and has been found to be in accordance with the plans and specifications approved by the City Engineer and that the original design intent was followed. I have signed and sealed this certificate, net, except as noted by me on the as-built construction drawings. This Certification is based on site inspections by me or personnel under my direction, and survey information provided by Vill Plotner, NMPS number 14821.

Diane Hoesler NMPE 11967
Date _____
6-7-06

MADE IN MEXICO
REGISTERED PROFESSIONAL ENGINEER
STATE OF NEW MEXICO
Diane Hoesler
11967



SCALE: 1" = 50'
MOLTEN PLACE N.W.
 STA. 10+00.00 TO STA. 17+00.00
 SCALE: HORIZ. 1" = 50'
 VERT. 1" = 10'

NOTES

CURVE DATA - DESCRIBES CENTERLINE

$$\begin{aligned} \textcircled{1} \quad \Delta &= 14^{\circ}49'14'' \\ R &= 300.00' \\ L &= 77.60' \\ T &= 39.02' \end{aligned}$$

PT. ELEV.	
1	QT PT
2	QT PT
3	QT PT

ALL QUARTER POINTS ARE
CLOCKWISE ROTATION AT
CURB RETURN.

CURVE DATA - DESCRIBES FACE OF CURB RETURNS

87 $\Delta = 79^{\circ}32'13''$
 $R = 25.00$
 $T = 20.81$
 $L = 34.70$

88 $\Delta = 14^{\circ}46'53''$
 $R = 286.76$
 $T = 37.20$
 $L = 73.98$

89 $\Delta = 72^{\circ}27'08''$
 $R = 313.99$
 $T = 20.45$
 $L = 40.84$

90 $\Delta = 89^{\circ}26'10''$
 $R = 25.00$
 $T = 28.47$
 $L = 42.51$

116 $\Delta = 61^{\circ}50'42''$
 $R = 25.00$
 $T = 14.98$
 $L = 26.99$

117 $\Delta = 123^{\circ}41'25''$
 $R = 40.00$
 $T = 74.74$
 $L = 86.35$

118 $\Delta = 61^{\circ}50'42''$
 $R = 25.00$
 $T = 14.98$
 $L = 26.99$


Certification
THE CHANGES SHOWN HEREON ARE BASED UPON A
FIELD SURVEY CONDUCTED BY ME OR UNDER MY
SUPERVISION AND REFLECT THE LOCATIONS
(VERTICALLY AND HORIZONTALLY) TO THE BEST OF
MY KNOWLEDGE AND BELIEF.

dmg MARK GOODWIN & ASSOCIATES, P.A.
CONSULTING ENGINEERS
P.O. BOX 90606
ALBUQUERQUE, NEW MEXICO 87199
(505) 828-2200, FAX (505) 797-9539



**CITY OF ALBUQUERQUE
PUBLIC WORKS DEPARTMENT**

***SUNDORO SOUTH - UNIT 5
MOLTEN PLACE N.W.
PAVING IMPROVEMENTS***

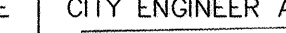DESIGN REVIEW COMMITTEE	CITY ENGINEER APPROVAL	LAST DESIGN UPDATE MO./DAY/YR.	MO./DAY/YR.
			

CITY PROJECT NO.	727084	ZONE MAP NO.	1-8/9	SHEET	OF	16	27
------------------	--------	--------------	-------	-------	----	----	----


ENGINEER'S SEAL

SURVEY INFORMATION			FIELD NOTES		BENCH MARKS		AS BUILT INFORMATION			
NO.	BY	DATE	STATION		REMARKS		CONTRACTOR	WORKS STATED BY	DATE	DATE
			STATION		REMARKS		CONTRACTOR	WORKS STATED BY	DATE	DATE
			ALBUQUERQUE		TO REACH THE STATION FROM INTERSECTION OF CENTRAL AVE. AND STATE RD. 448 GO WEST ON CENTRAL 1.8 MI. TO NOLASCO RD. ON RT. (98TH ST. ON L.T.), THEN NORTH ALONG NOLASCO RD. CROSSING OVER US I-40, 1.0 MI. TO TRACK RD. LEFT (SW), THEN TAKE TRACK ROAD 0.1 MI. TO Pylon #48 AND STATION TO LEFT. STATION IS STANDARD US2X6S BRASS TARGET STAMPED "REMARK 1989". SET IN TOP OF A CONCRETE POST PROJECTING 0.3 FT. ABOVE GROUND		CHRISTIAN SURVEYS INC.	CHRISTIAN SURVEYS INC.	DATE	DATE
			X = 350,944.85 Y = 1,487,301.42 (NAD1983)		ELEV=5316.951 (NGD)					




F:\A04\JOBS\A4046SS\Unit 5\4046-U5 M-UTIL.dwg, 5/31/2005 11:23:22 AM, charles

SCANNED BY
PLANNING

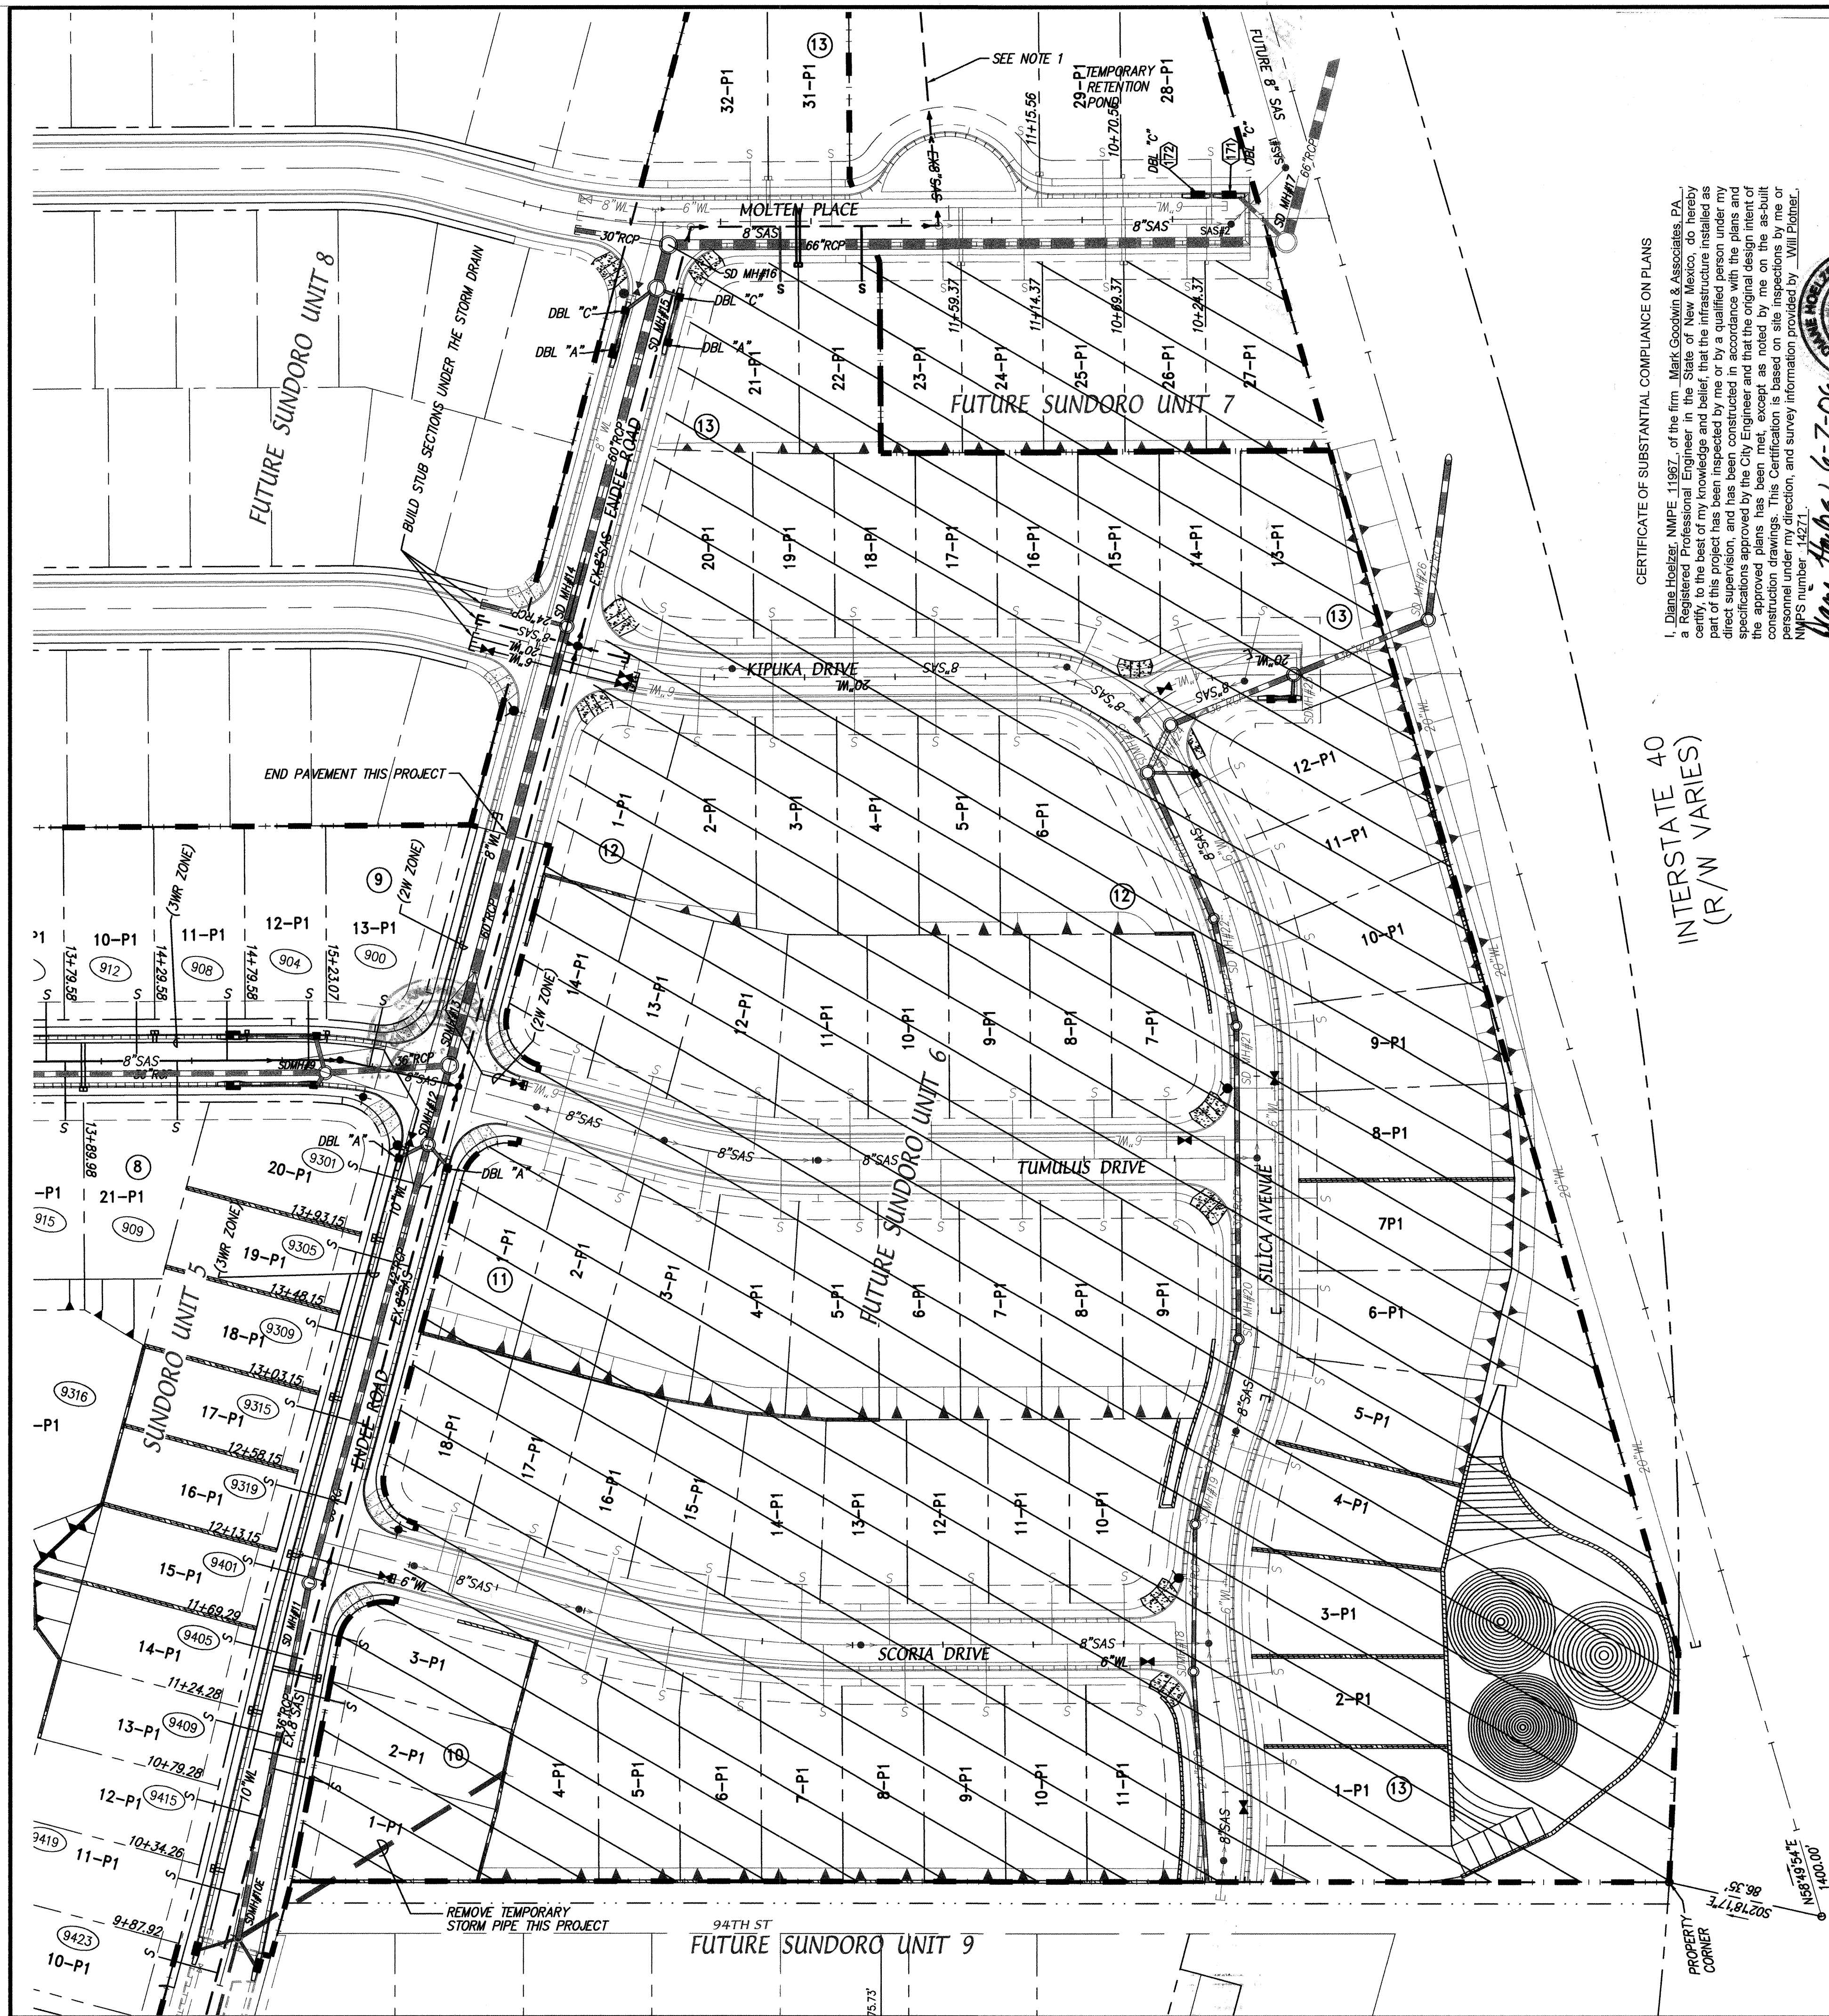

CERTIFICATE OF SUBSTANTIAL COMPLIANCE ON PLANS
I, Diane Hoelzer, NMPE 11957, of the firm, Mark Goodwin & Associates, P.A., a Registered Professional Engineer in the State of New Mexico, do hereby certify, to the best of my knowledge and belief, that the infrastructure installed as part of this project has been inspected by me or by a qualified person under my direct supervision, and has been constructed in accordance with the plans and the approved plans. This Certification is based on the information provided by the construction personnel under my direction, and survey information provided by NMPE number 14271.
Diane Hoelzer 6-7-06
NMPE 11957
REGISTERED PROFESSIONAL ENGINEER
NEW MEXICO

INTERSTATE 40
(R/W VARIES)

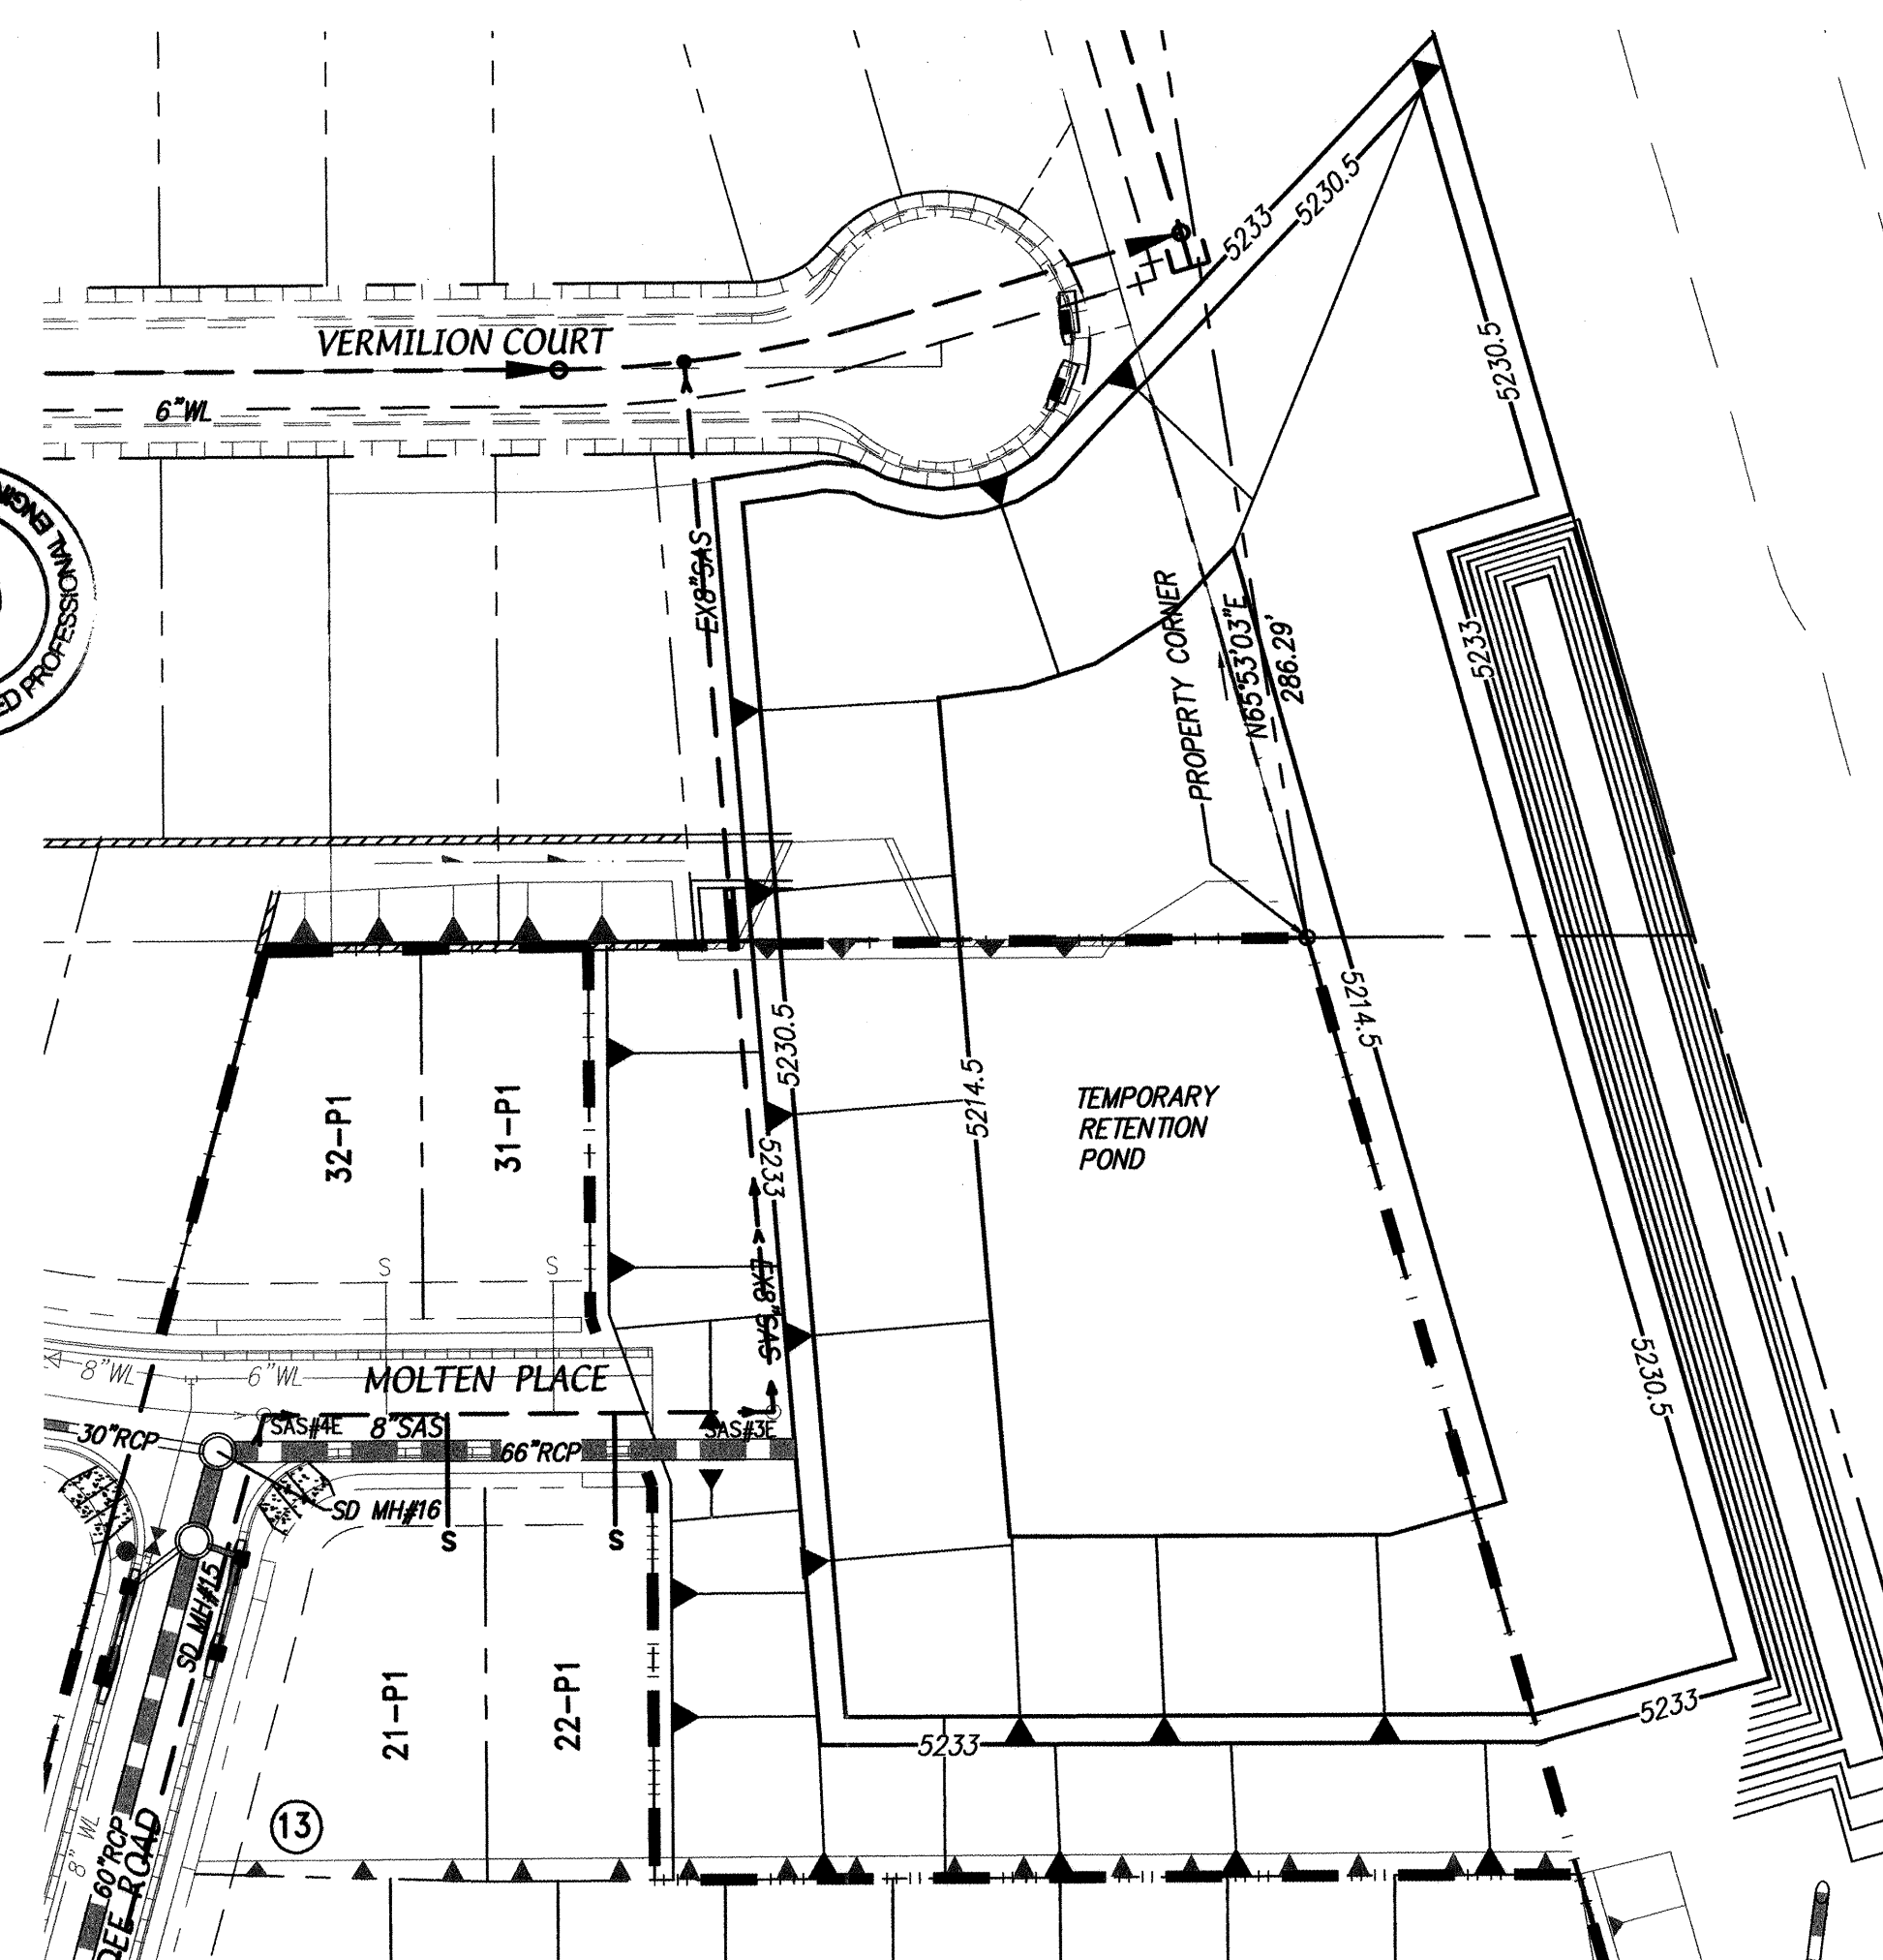

NOTES

- THIS IS A TEMPORARY EXISTING SANITARY SEWER CONNECTION. THIS WILL BE USED AS LONG AS TEMPORARY POND IS REQUIRED. WHEN POND IS FILLED IN, THE PERMANENT SAS LINE TO THE SOUTH & EAST WILL BE CONSTRUCTED TO A NEW OUTFALL LOCATION.
- ALL SAS PIPE IS SDR35 PVC UNLESS NOTED OTHERWISE.
- ALL WATER LINES PIPE IS C-900 SERIES PVC PIPE UNLESS NOTED OTHERWISE.
- ALL STORM DRAIN PIPE IS CLASS III RCP UNLESS NOTED OTHERWISE.

RESTRAINED JOINT LENGTH FOR BENDS, VALVES, DEAD ENDS (FT.)					
PIPE SIZE	90°	45°	22.5°	11.25°	VALVE
4"	12'	5'	2'	1'	32'
6"	17'	7'	3'	2'	46'
12"	30'	12'	6'	3'	85'

LENGTH OF RESTRAINED PIPE ON EACH SIDE OF THE BEND. RESTRAIN BRANCH AT FITTING ONLY MINIMUM ATTACHED PIPE LENGTH, RUN SIDE OF TEE: 10.00 FEET.

RESTRAINED JOINT LENGTHS FOR REDUCERS (FT.)		
PIPE SIZE	LARGE SIDE	SMALL SIDE
6" X 4"	24'	85'
12" X 6"	62'	121'

RESTRAINED JOINT LENGTH FOR TEES (FT.)		
PIPE SIZE	RUN	BRANCH
12"x12"x12"	18'	3'
6"x6"x6"	10'	2'
6"x6"x4"	24'	85'

LEGEND

- NEW MOUNTABLE CURB AND GUTTER
- NEW STANDARD CURB AND GUTTER
- LOT LINE
- RIGHT-OF-WAY LINE
- CENTERLINE
- DRIVEWAY
- STORM DRAIN INLET THIS PROJECT
- EXISTING STORM DRAIN INLET
- EXISTING STORM SEWER
- NEW ADDRESS
- NEW STREET LIGHT LOCATION
- NEW STORM DRAIN LINE
- NEW STORM DRAIN MANHOLE
- NEW SANITARY SEWER LINE
- NEW SANITARY SEWER MANHOLE
- EXISTING SAS
- NEW WATERLINE
- NEW WATERLINE CROSS
- NEW WATERLINE TEE
- NEW WATERLINE REDUCER
- NEW WATERLINE CAP
- NEW WATERLINE BEND
- NEW FIRE HYDRANT
- NEW GATE VALVE

dmg MARK GOODWIN & ASSOCIATES, P.A.
CONSULTING ENGINEERS
P.O. BOX 90606
ALBUQUERQUE, NEW MEXICO 87199
(505) 828-2200, FAX (505) 797-9539

**CITY OF ALBUQUERQUE
PUBLIC WORKS DEPARTMENT**

TITLE: **SUNDORO SOUTH - UNIT 5
SUNDORO SOUTH
MASTER UTILITY PLAN**

DESIGN REVIEW COMMITTEE
APPROVED
JUN 21 2005
DESIGN REVIEW COMMITTEE

CITY ENGINEER APPROVAL
APPROVED
JUL 15 2005
CITY ENGINEER

MO./DAY/YR.
LAST DESIGN UPDATE
MO./DAY/YR.




CITY PROJECT NO. **727084** ZONE MAP NO. **J-8/9** SHEET **18** OF **27**

SCANNED BY
PLANNING

CERTIFICATE OF SUBSTANTIAL COMPLIANCE ON PLANS

I, Diane Hoelzer, NMPE 11967, of the firm Mark Goodwin & Associates, P.A., a Registered Professional Engineer in the State of New Mexico, do hereby certify, to the best of my knowledge and belief, that the infrastructure installed as part of this project has been inspected by me or by a qualified person under my direct supervision, and has been constructed in accordance with the plans and specifications approved by the City Engineer and that the original design intent of the approved plans has been met, except as noted by me on the as-built construction drawings. This Certification is based on site inspections by me or personnel under my direction, and survey information provided by Will Plotner, NMPS number 14271.

Diane Hoelzer NMPE 11967

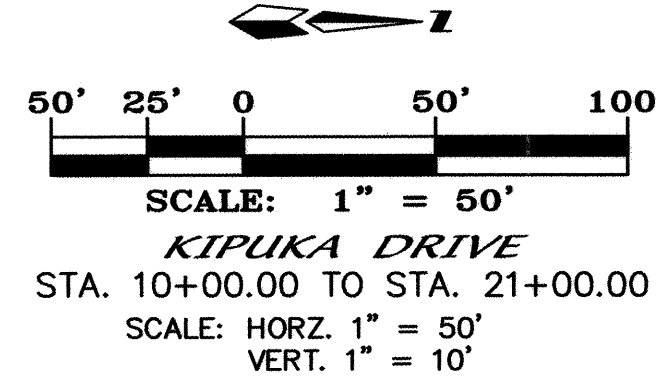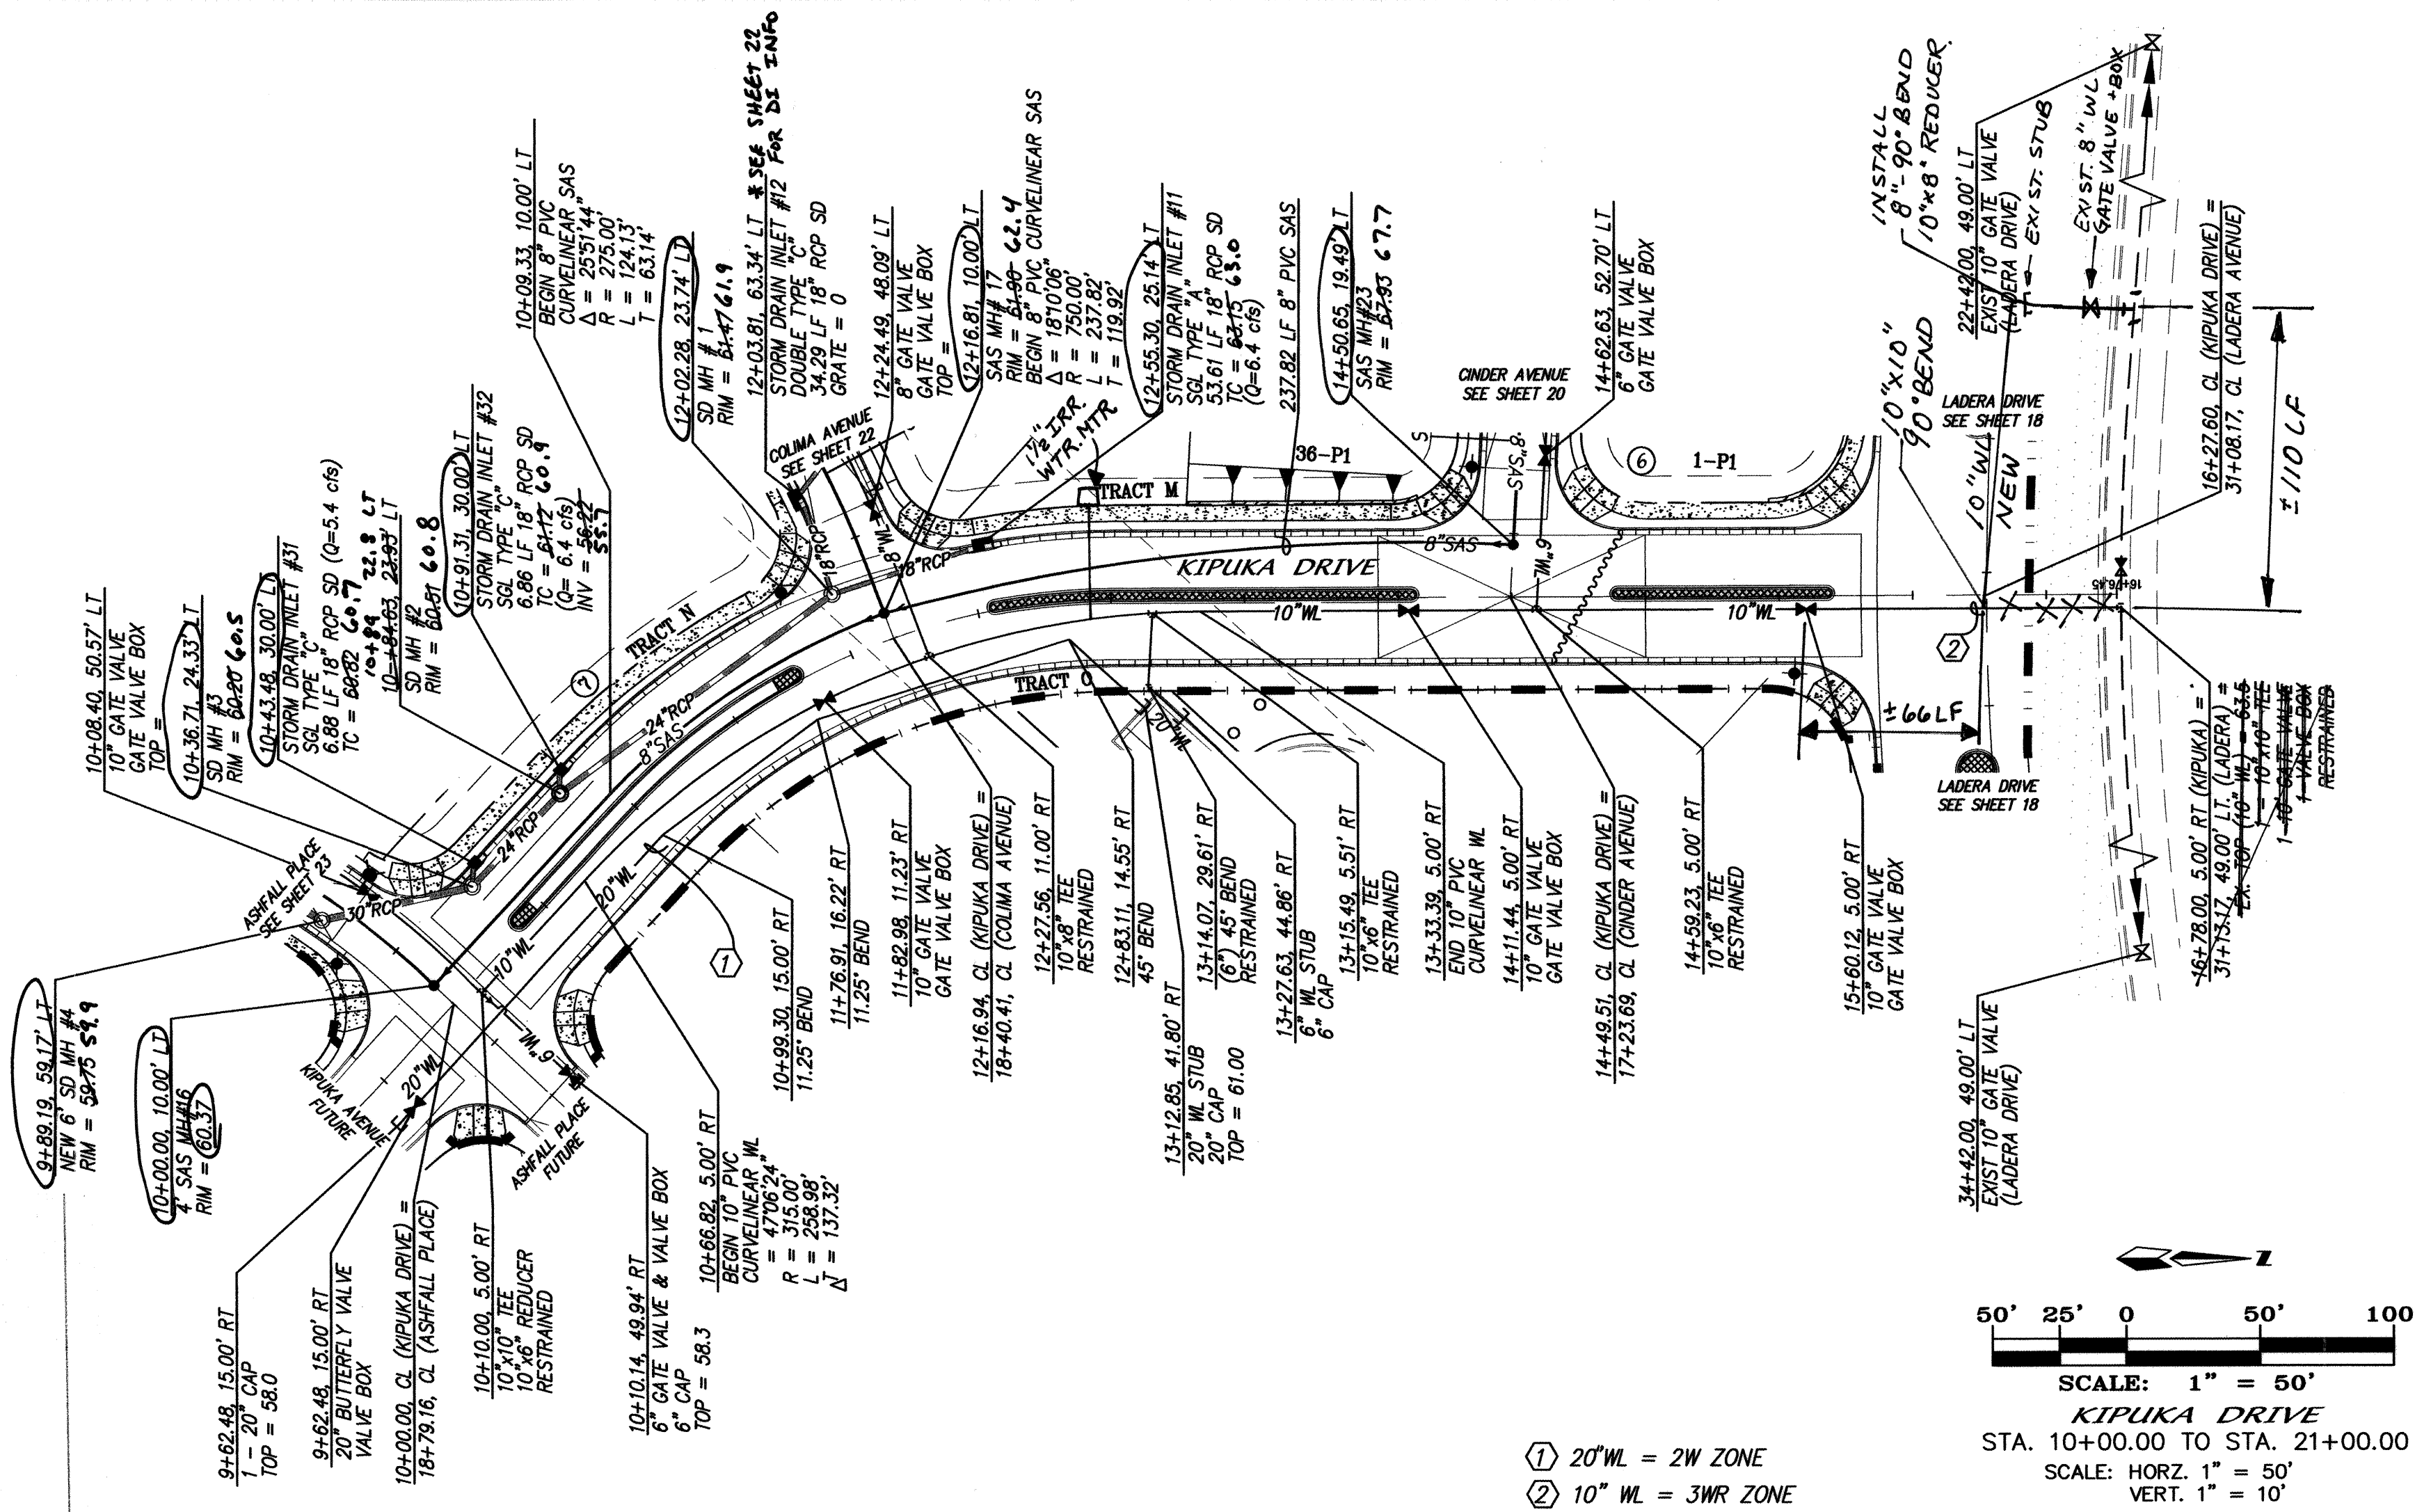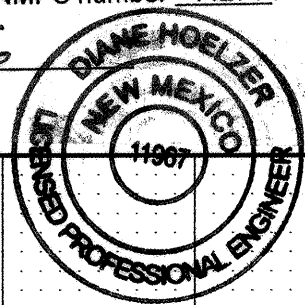

- ① 20" WL = 2W ZONE
- ② 10" WL = 3WR ZONE


NOTES

1. ALL STATIONING IS CENTERLINE STATIONING.
2. ALL SAS PIPE IS SDR35 PVC UNLESS NOTED OTHERWISE.
3. ALL WATER LINES PIPE IS C-900 SERIES PVC PIPE UNLESS NOTED OTHERWISE.
4. ALL STORM DRAIN PIPE IS CLASS III RCP UNLESS NOTED OTHERWISE.

STORM DRAIN SUMMARY TABLE			
LOCATION	INVERT	GRD. ELEV.	HGL
MH 4	52.97	59.75	57.05
MH 3	53.37	60.20	57.31
MH 2	54.25	60.73	58.66
MH 1	55.90	61.47	59.77

Certification
THE CHANGES SHOWN HEREON ARE BASED UPON A FIELD SURVEY CONDUCTED BY ME OR UNDER MY SUPERVISION AND REFLECT THE LOCATIONS (VERTICALLY AND HORIZONTALLY) TO THE BEST OF MY KNOWLEDGE AND BELIEF.

Will Plotner

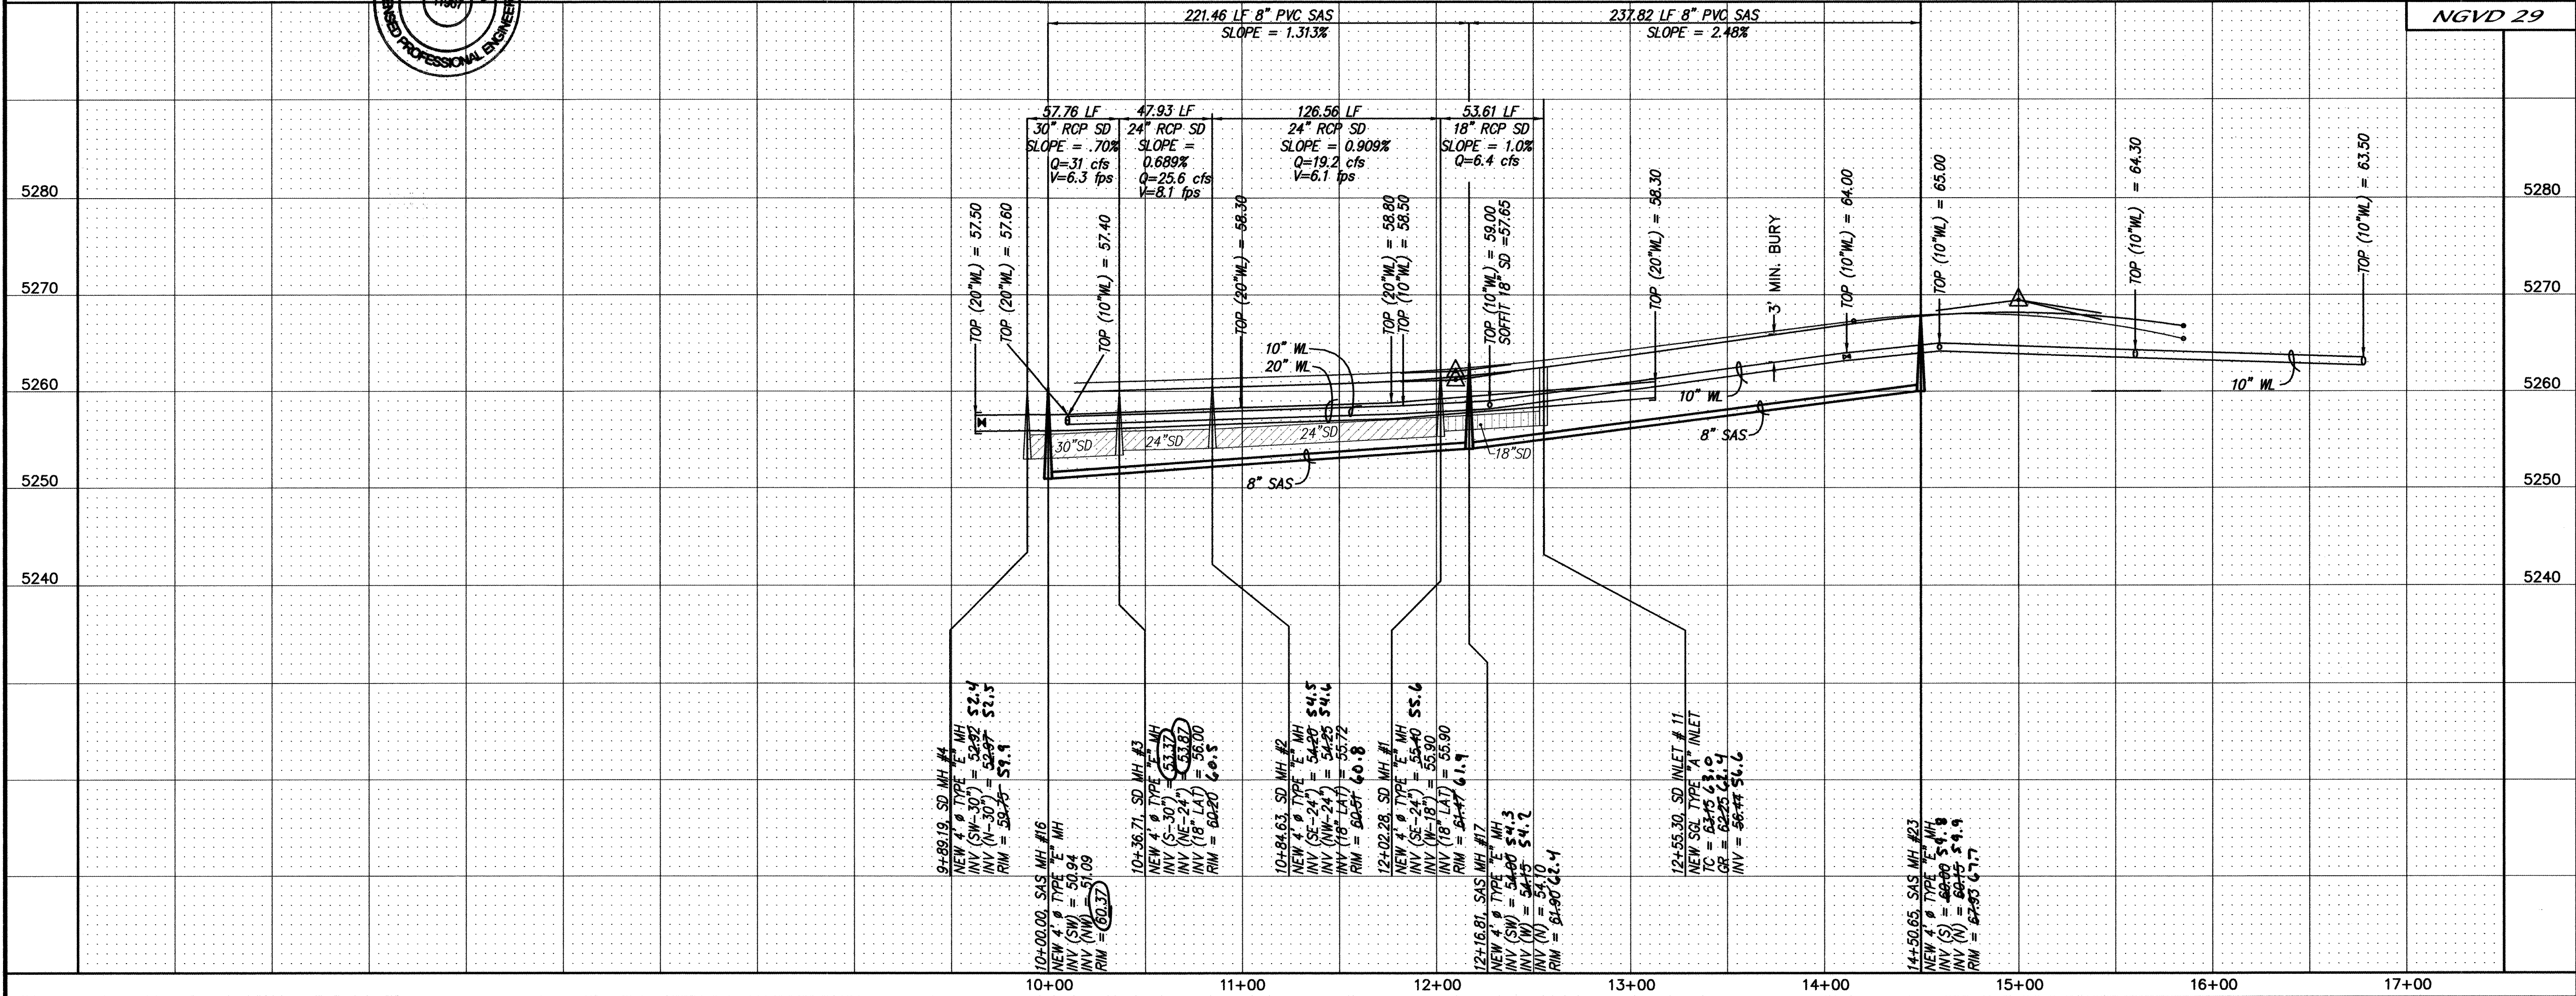


dmg MARK GOODWIN & ASSOCIATES, P.A.
CONSULTING ENGINEERS
P.O. BOX 90606
ALBUQUERQUE, NEW MEXICO 87199
(505) 828-2200, FAX (505) 797-9539




CITY OF ALBUQUERQUE
PUBLIC WORKS DEPARTMENT

TITLE: **SUNDORO SOUTH - UNIT 5
KIPUKA DRIVE
UTILITY IMPROVEMENTS**

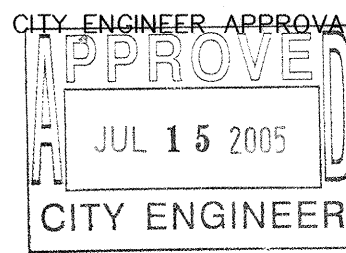

MO./DAY/YR.	MO./DAY/YR.

CITY PROJECT NO. **727084** ZONE MAP NO. **J-8/9** SHEET **19** OF **27**

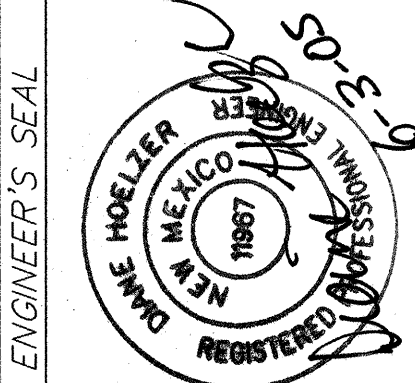

ENGINEER'S SEAL

NO.	DATE	REVISIONS	BY

DESIGNED BY **DLH** DATE **3/05**
DRAWN BY **TAS** DATE **3/05**
CHECKED BY **DWG** DATE **3/05**

SURVEY INFORMATION

FIELD NOTES

DATE

BY

NO.

STATION

REMARKS

TO REACH THE STATION FROM INTERSECTION OF CENTRAL AVE. AND STATE RD. 448 GO WEST ON CENTRAL 1.8 MI. TO NOLASCO RD. ON RT. (98TH ST. ON LT.), THEN NORTH ALONG NOLASCO RD. CROSSING OVER US 1-40, 1.0 MI. TO TRACK RD. LEFT (SW), THEN TAKE TRACK ROAD 0.1 MI. TO Pylon #88 AND STATION TO LEFT. STATION IS STANDARD USCAR'S BRASS TABLET STAMPED "REWARD 1989". SET IN TOP OF A CONCRETE POST PROTRUDING 0.3 FT. ABOVE GROUND.

CONTRACTOR

WORK

STATIONED BY

DATE

DATE

DATE

DATE


DATE

DATE

DATE

DATE

A circular professional engineer seal for Diane Hoelzer, New Mexico. The outer ring contains the text "DIANE HOELZER" at the top and "LICENSED PROFESSIONAL ENGINEER" at the bottom. The inner circle contains the text "NEW MEXICO" at the top and "11967" at the bottom.

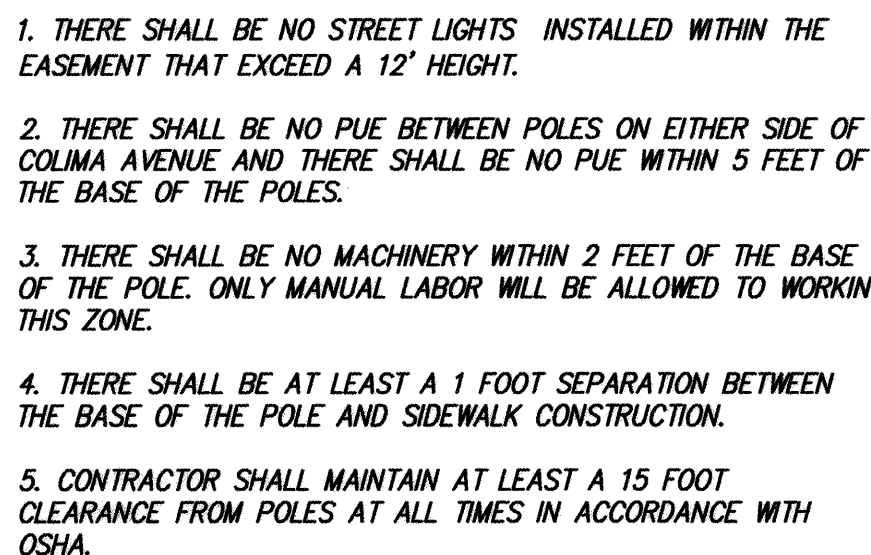

CITY PROJECT NO.	ZONE MAP NO.	SHEET	OF
727084	1-8/9	20	21


A04JOBS/A4046SS/Unit 5/CINDER-UP20 5-11-05 SPS, TAS CAR, JCC

727084	J-8/9	21 27
--------	-------	-------

SCANNED BY
PLANNING

SPECIAL CONSTRUCTION NOTES
WITHIN 100' PNM EASEMENT

1. THERE SHALL BE NO STREET LIGHTS INSTALLED WITHIN THE EASEMENT THAT EXCEED A 12' HEIGHT.
2. THERE SHALL BE NO PUE BETWEEN POLES ON EITHER SIDE OF COLIMA AVENUE AND THERE SHALL BE NO PUE WITHIN 5 FEET OF THE BASE OF THE POLES.
3. THERE SHALL BE NO MACHINERY WITHIN 2 FEET OF THE BASE OF THE POLE. ONLY MANUAL LABOR WILL BE ALLOWED TO WORKIN THIS ZONE.
4. THERE SHALL BE AT LEAST A 1 FOOT SEPARATION BETWEEN THE BASE OF THE POLE AND SIDEWALK CONSTRUCTION.
5. CONTRACTOR SHALL MAINTAIN AT LEAST A 15 FOOT CLEARANCE FROM POLES AT ALL TIMES IN ACCORDANCE WITH OSHA.

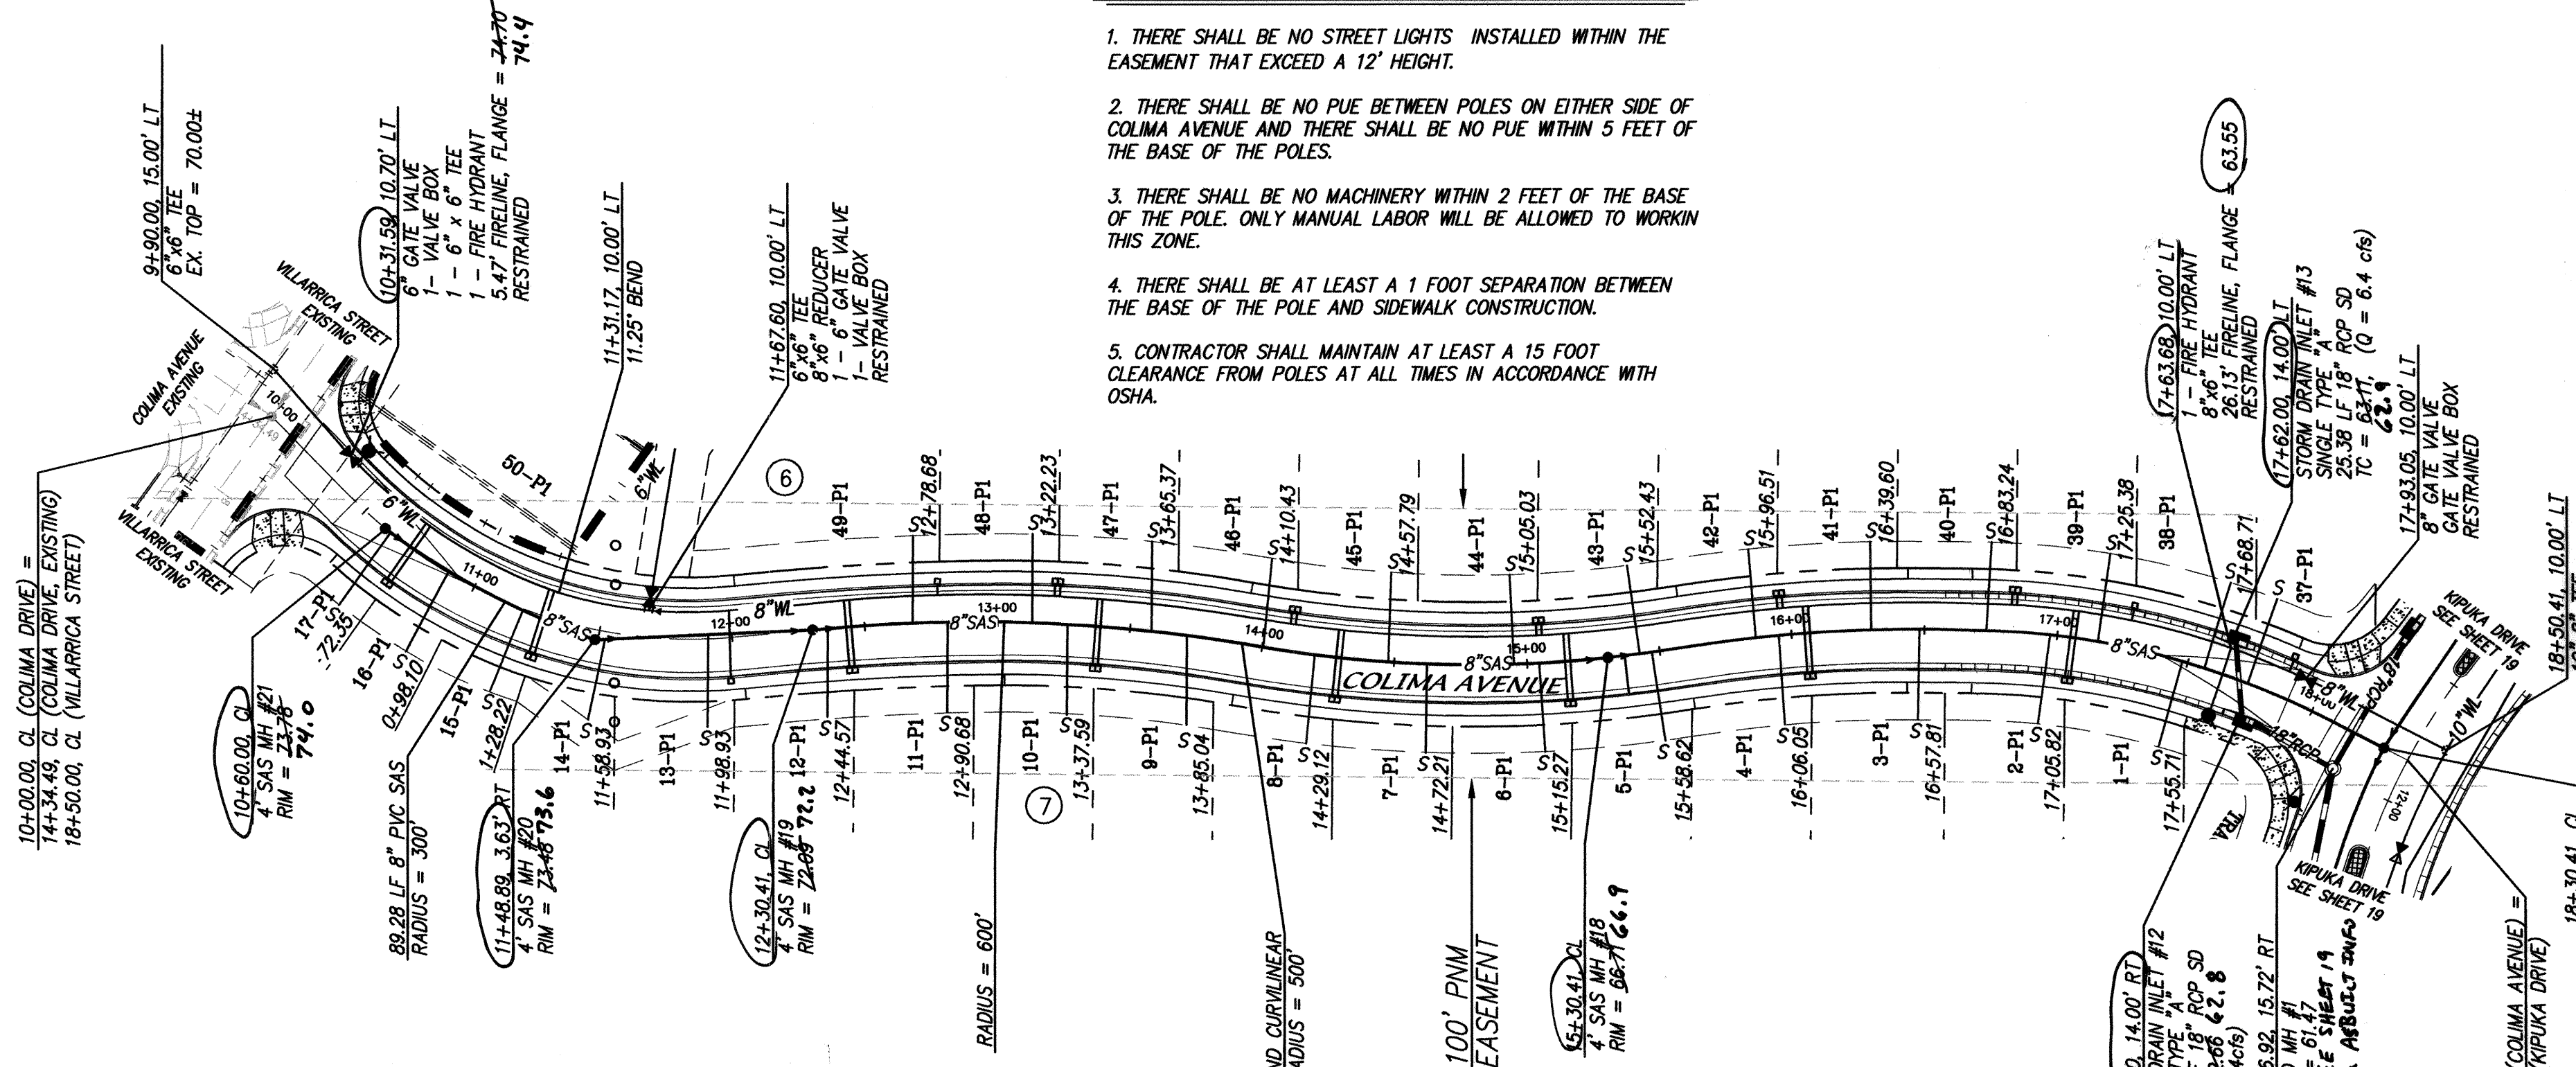

CERTIFICATE OF SUBSTANTIAL COMPLIANCE ON PLANS

I, Diane Hoelzer, NMPE 11967, of the firm Mark Goodwin & Associates, PA, a Registered Professional Engineer in the State of New Mexico, do hereby certify, to the best of my knowledge and belief, that the infrastructure installed as part of this project has been inspected by me or by a qualified person under my direct supervision, and has been constructed in accordance with the plans and specifications approved by the City Engineer and that the original design intent of the approved plans has been met, except as noted by me on the as-built construction drawings. This Certification is based on site inspections by me or personnel under my direction, and survey information provided by Will Plotner, NMPS number 14271.

Diane Hoelzer 6-7-06
Diane Hoelzer NMPE 11967



SANITARY SEWER SERVICES					SHT 22-
BLOCK	LOT	STATION AT PUE	INV. ELEV AT PUE	LENGTH AT PUE	
7	1-P1	17+47.87	57.53	32.81'	
7	2-P1	16+97.26	58.44	33.00'	
7	3-P1	16+48.10	59.32	33.17'	
7	4-P1	15+95.15	60.27	32.77'	
7	5-P1	15+47.06	61.13	33.10'	
7	6-P1	15+04.00	61.90	33.00'	
7	7-P1	14+62.28	62.65	33.00'	
7	8-P1	14+20.00	63.40	33.00'	
7	9-P1	13+71.30	64.27	33.26'	
7	10-P1	13+26.18	65.08	33.44'	
7	11-P1	12+81.15	65.89	33.19'	
7	12-P1	12+36.05	66.69	32.19'	
7	13-P1	11+90.93	67.50	34.05'	
7	14-P1	11+52.50	68.19	30.24'	
7	15-P1	11+20.14	68.67	31.93'	
7	16-P1	10+88.67	68.80	33.82'	
7	17-P1	10+62.41	68.66	33.17'	

NOTES

1. ALL SAS PIPE IS SDR35 PVC UNLESS NOTED OTHERWISE.
2. ALL WATER LINES PIPE IS C-900 SERIES PVC PIPE UNLESS NOTED OTHERWISE.
3. ALL STORM DRAIN PIPE IS CLASS III RCP UNLESS NOTED OTHERWISE.

Certification
THE CHANGES SHOWN HEREON ARE BASED UPON A FIELD SURVEY CONDUCTED BY ME OR UNDER MY SUPERVISION AND REFLECT THE LOCATIONS (VERTICALLY AND HORIZONTALLY) TO THE BEST OF MY KNOWLEDGE AND BELIEF.

SANITARY SEWER SERVICES				
BLOCK	LOT	STATION AT PUE	INV. ELEV AT PUE	LENGTH AT PUE
7	1-P1	17+47.87	59.32	32.81'
7	2-P1	16+97.26	60.08	33.00'
7	3-P1	16+48.10	60.82	33.17'
7	4-P1	15+95.15	61.62	32.77'
7	5-P1	15+47.06	62.34	33.10'
7	6-P1	15+04.00	62.62	33.00'
7	7-P1	14+62.28	61.95	33.00'
7	8-P1	14+20.00	61.20	33.00'
7	9-P1	13+71.30	60.60	33.26'
7	10-P1	13+26.18	59.78	33.44'
7	11-P1	12+81.15	59.04	33.19'
7	12-P1	12+36.05	58.31	32.19'
7	13-P1	11+90.93	68.59	34.05'
7	14-P1	11+52.50	69.13	30.24'
7	15-P1	11+20.14	69.79	31.93'
7	16-P1	10+88.67	70.33	33.82'
7	17-P1	10+62.41	70.74	33.17'

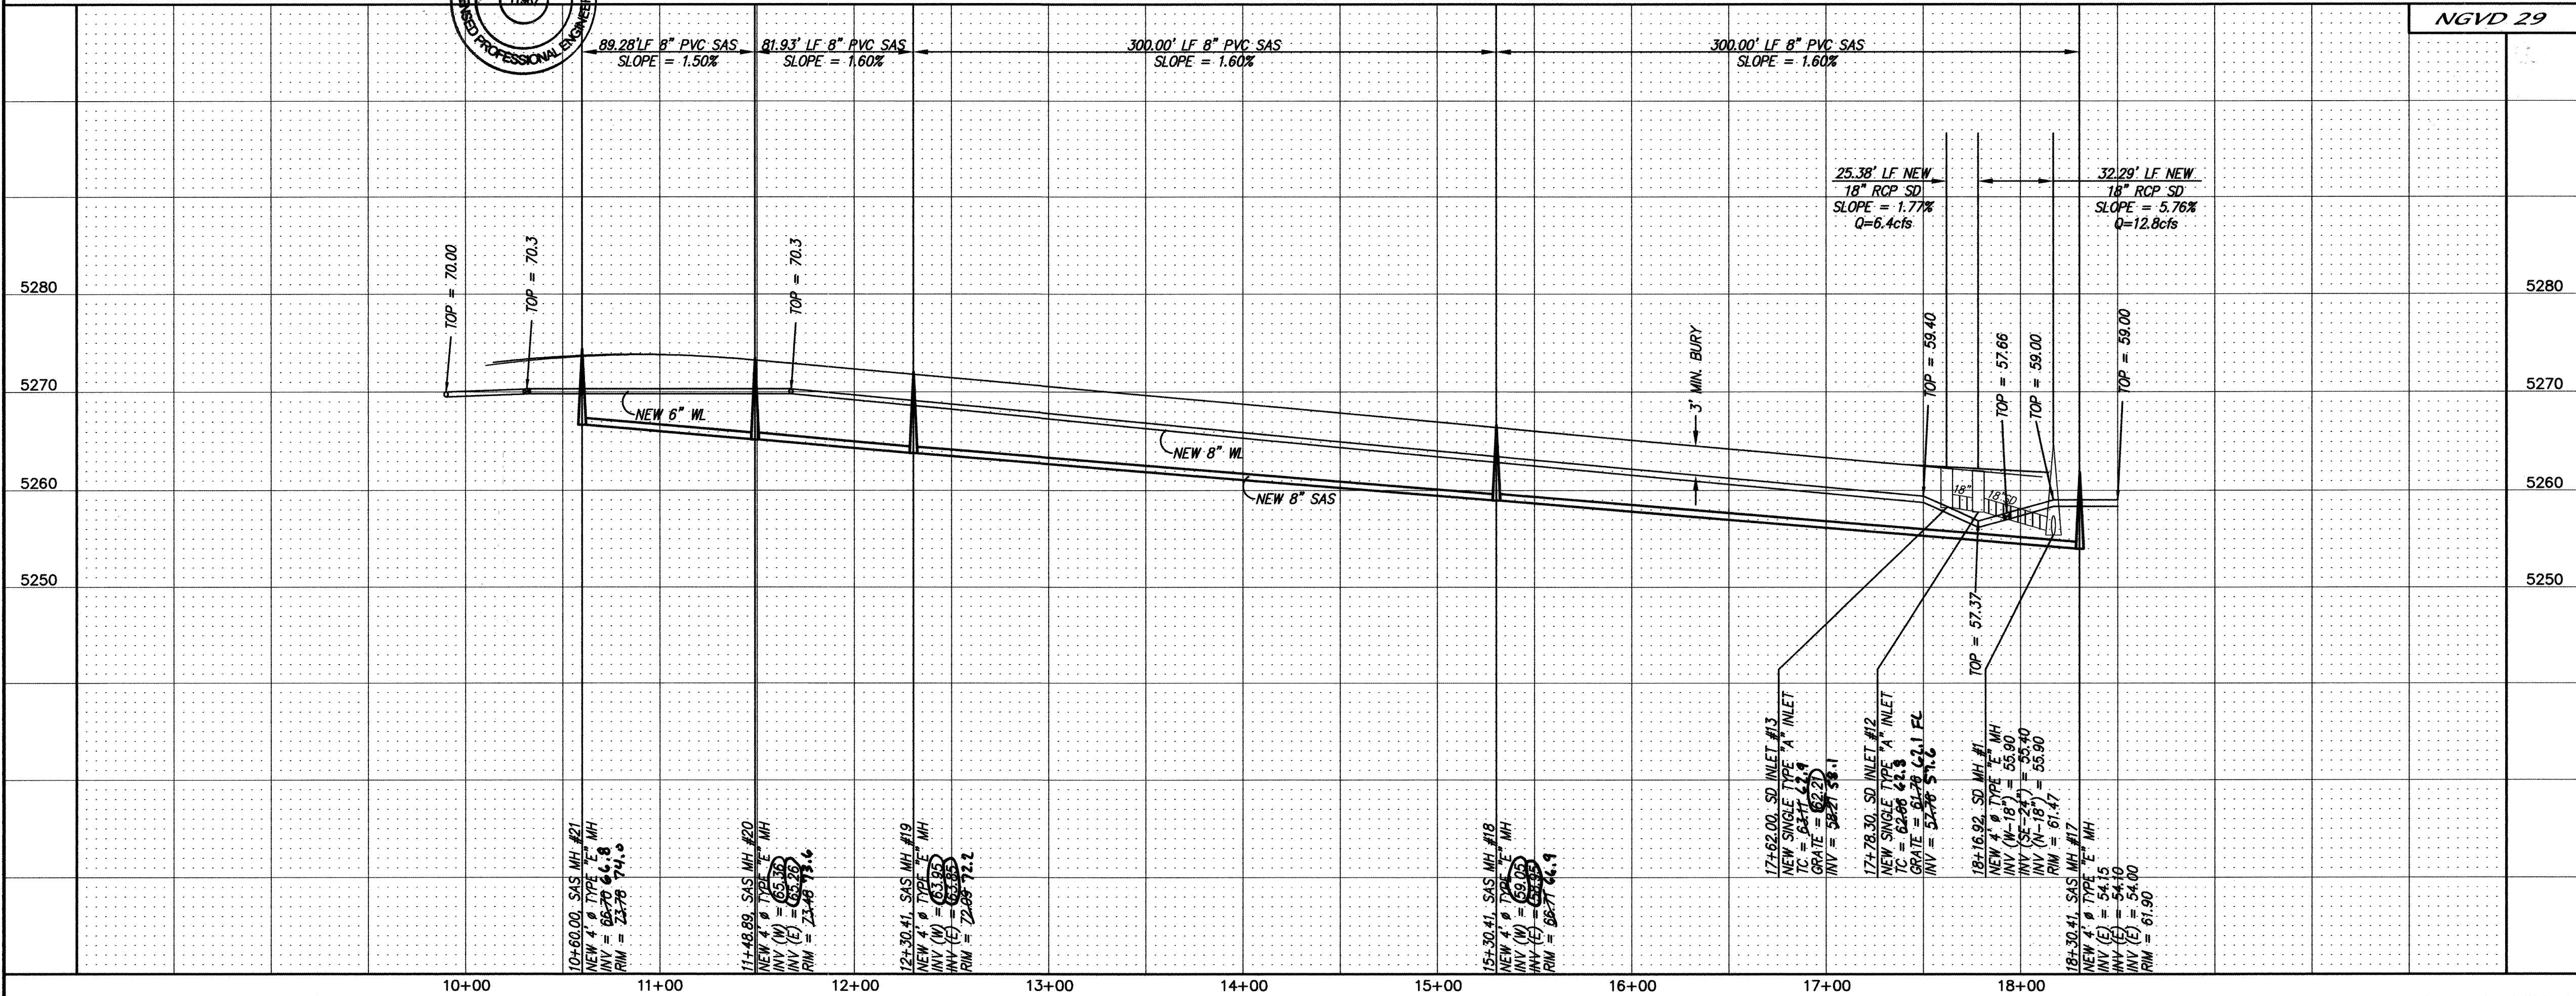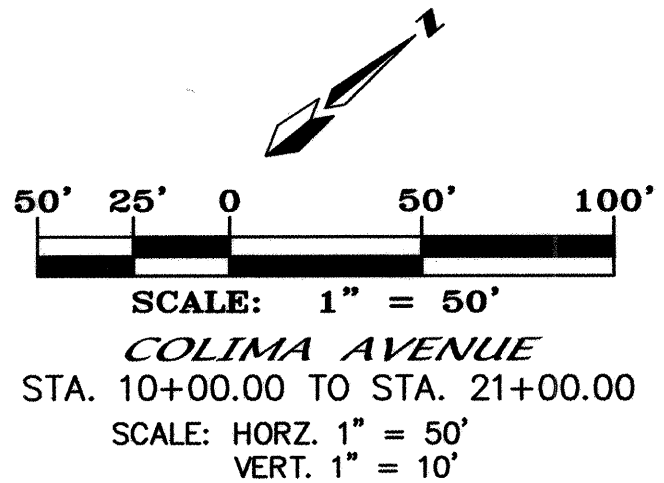

dmg MARK GOODWIN & ASSOCIATES, P.A.
CONSULTING ENGINEERS
P.O. BOX 90606
ALBUQUERQUE, NEW MEXICO 87199
(505) 828-2200, FAX (505) 797-9539



CITY OF ALBUQUERQUE
PUBLIC WORKS DEPARTMENT

TITLE: **SUNDORO SOUTH - UNIT 5
COLIMA AVENUE
UTILITY IMPROVEMENTS**


DESIGN REVIEW COMMITTEE
APPROVED
JUN 21 2005
DESIGN REVIEW COMMITTEE

CITY ENGINEER APPROVAL
APPROVED
JUL 15 2005
CITY ENGINEER

CITY PROJECT NO. **727084** ZONE MAP NO. **J-8/9** SHEET **22** OF **27**

AS-BUILT INFORMATION			
CONTRACTOR	WORK	DATE	DATE
Christian Surinco, Inc.	STATIONED BY	DA	FEB 0 6
Christian Surinco, Inc.	ACCEPTANCE BY	DATE	DATE
Christian Surinco, Inc.	FIELD	DATE	DATE
Christian Surinco, Inc.	REVISIONS	DATE	DATE
Christian Surinco, Inc.	DESIGN	DATE	DATE
Christian Surinco, Inc.	CHECKED BY	DATE	DATE
Christian Surinco, Inc.	RECORDED BY	DATE	DATE
Christian Surinco, Inc.	NO.	DATE	DATE

SURVEY INFORMATION			
STATION	REMARKS	DATE	DATE
ALBUQUERQUE	TO REACH THE STATION FROM INTERSECTION OF CENTRAL	DATE	DATE
ALBUQUERQUE	TO REACH THE STATION FROM INTERSECTION OF CENTRAL	DATE	DATE
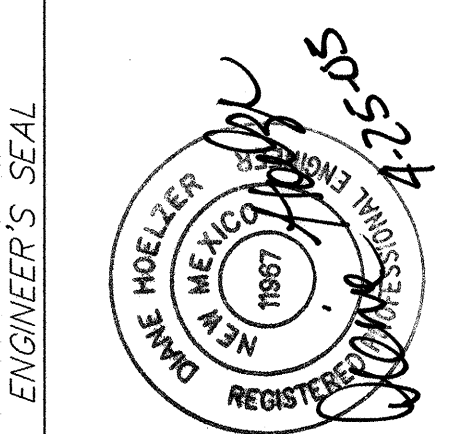

SCANNED BY
PLANNING


SHT. 23

BLOCK	LOT	STATION	INV. ELEV.	LENGTH
8	1-P1	14+57.73	53.21	33.00'
8	2-P1	14+37.73	53.02	33.00'
8	3-P1	13+92.73	54.13	33.00'
8	4-P1	13+47.73	54.84	33.00'
8	5-P1	13+02.73	55.52	33.00'
8	6-P1	12+57.73	56.26	33.00'
8	7-P1	12+12.73	56.97	33.00'
8	8-P1	11+67.73	57.68	33.00'
8	9-P1	11+22.73	58.39	33.00'
7	18-P1	10+89.44	58.92	33.00'
7	19-P1	11+34.34	58.21	33.00'
7	20-P1	11+79.34	57.50	33.00'
7	21-P1	12+24.34	56.79	33.00'
7	22-P1	12+69.34	56.08	33.00'
7	23-P1	13+14.34	55.37	33.00'
7	24-P1	13+59.34	54.65	33.00'

BLOCK	LOT	STATION	INV. ELEV.	LENGTH
7	25-P1	14+04.34	53.94	33.00'
7	26-P1	14+49.34	53.12	33.00'
7	27-P1	14+94.34	52.89	33.00'
7	28-P1	15+39.34	52.40	33.00'
7	29-P1	15+84.34	52.60	33.00'
7	30-P1	16+29.34	53.05	33.00'
7	31-P1	16+74.34	53.46	33.00'
7	32-P1	17+19.34	53.80	33.00'
7	33-P1	17+64.34	54.15	33.00'
7	34-P1	18+09.34	54.49	33.00'
9	1-P1*	16+54.54	53.50	33.00'
9	2-P1*	16+09.54	53.10	33.00'
9	3-P1*	15+74.54	52.75	33.00'

* SAS SERVICES INSTALLED UNDER STORM DRAIN.


- ① 20" WATERLINE = 2W WATER ZONE
② 10" WATERLINE = 3WR WATER ZONE

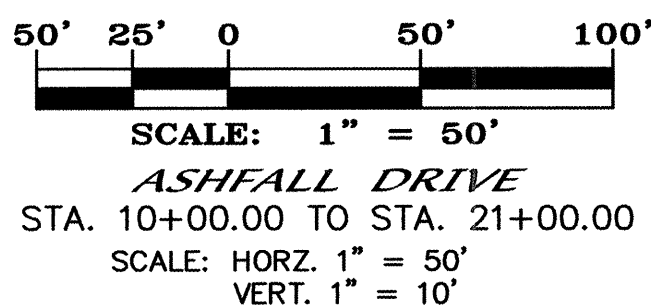

CERTIFICATE OF SUBSTANTIAL COMPLIANCE ON PLANS

I, Diane Hoelzer, NMPE 11967, of the firm Mark Goodwin & Associates, P.A., a Registered Professional Engineer in the State of New Mexico, do hereby certify, to the best of my knowledge and belief, that the infrastructure installed as part of this project has been inspected by me or by a qualified person under my direct supervision, and has been constructed in accordance with the plans and specifications approved by the City Engineer and that the original design intent of the approved plans has been met, except as noted by me on the as-built construction drawings. This Certification is based on site inspections by me or personnel under my direction, and survey information provided by Will Plotner, NMPS number 11984.

Diane Hoelzer NMPE 11967

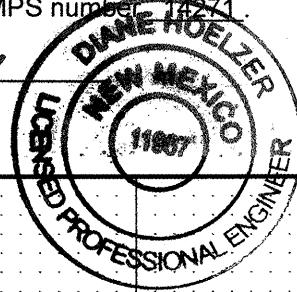

NOTES

1. ALL SAS PIPE IS SDR35 PVC UNLESS NOTED OTHERWISE.
2. ALL WATER LINES PIPE IS C-900 SERIES PVC PIPE UNLESS NOTED OTHERWISE.
3. ALL STORM DRAIN PIPE IS CLASS III RCP UNLESS NOTED OTHERWISE.

LOCATION	INVERT	GRD ELEV	HGL
MH 6	50.79	57.67	53.81
MH 5	51.97	58.74	56.14
MH 4	52.97	59.75	57.05
MH 3	53.37	60.20	57.31

SANITARY SEWER SERVICES

BLOCK	LOT	STATION	INV. ELEV.	LENGTH
8	1-P1	14+57.73	51.46	33.00'
8	2-P1	14+37.73	51.08	33.00'
8	3-P1	13+92.73	50.22	33.00'
8	4-P1	13+47.73	49.35	33.00'
8	5-P1	13+02.73	48.49	33.00'
8	6-P1	12+57.73	47.63	33.00'
8	7-P1	12+12.73	46.76	33.00'
8	8-P1	11+67.73	45.90	33.00'
8	9-P1	11+22.73	45.04	33.00'
7	18-P1	10+89.44	44.40	33.00'
7	19-P1	11+34.34	43.26	33.00'
7	20-P1	11+79.34	46.12	33.00'
7	21-P1	12+24.34	46.99	33.00'
7	22-P1	12+69.34	47.85	33.00'
7	23-P1	13+14.34	48.71	33.00'
7	24-P1	13+59.34	49.58	33.00'
7	25-P1	14+04.34	50.44	33.00'
7	26-P1	14+49.34	51.30	33.00'
7	27-P1	14+94.34	52.17	33.00'
7	28-P1	15+39.34	52.87	33.00'
7	29-P1	15+84.34	52.97	33.00'
7	30-P1	16+29.34	53.24	33.00'
7	31-P1	16+74.34	53.51	33.00'
7	32-P1	17+19.34	53.81	33.00'
7	33-P1	17+64.34	54.10	33.00'
7	34-P1	18+09.34	54.39	33.00'
9	1-P1*	16+54.54	50.89	33.00'
9	2-P1*	16+09.54	50.61	33.00'
9	3-P1*	15+74.54	50.40	33.00'

* SAS SERVICES INSTALLED UNDER STORM DRAIN.

Certification

THE CHANGES SHOWN HEREON ARE BASED UPON A FIELD SURVEY CONDUCTED BY ME OR UNDER MY SUPERVISION AND PERFECT THE LOCATIONS (VERTICALLY AND HORIZONTALLY) TO THE BEST OF MY KNOWLEDGE AND BELIEF.

Will Plotner




MARK GOODWIN & ASSOCIATES, P.A.
CONSULTING ENGINEERS
P.O. BOX 90606
ALBUQUERQUE, NEW MEXICO 87199
(505) 828-2200, FAX (505) 797-9539



CITY OF ALBUQUERQUE
PUBLIC WORKS DEPARTMENT

TITLE: SUNDORO SOUTH - UNIT 5
ASHFALL DRIVE
UTILITY IMPROVEMENTS

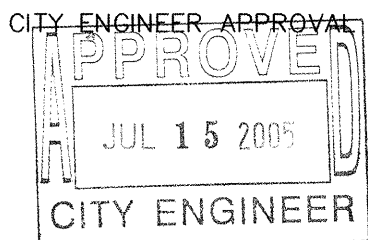

LAST DESIGN UPDATE

MO./DAY/YR.

MO./DAY/YR.

CITY PROJECT NO.

727084


ZONE MAP NO.

J-8/9

SHEET

OF 23 27

A circular professional engineer seal for Diane Hoelzer, New Mexico. The outer ring contains the text "DIANE HOELZER" at the top and "LICENSED PROFESSIONAL ENGINEER" at the bottom. The inner ring contains "NEW MEXICO". The center of the seal contains the license number "11967".

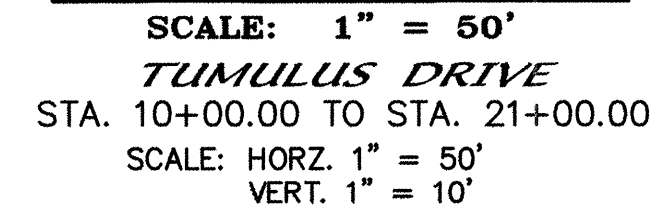

10" WATERLINE IN TUMULUS= .3WR WATER ZONE

LOCATION	INVERT	GRD ELEV	HGL
MH 13	40.94	48.00	44.55
MH 9	41.80	49.25	46.23
MH 8	48.28	55.40	50.03
MH 7	49.25	56.31	51.06
MH 6	50.79	57.67	53.81

SANITARY SEWER SERVICES				
BLOCK	LOT	STATION	INV. AT ELEV. PUE	LENGTH AT PUE
8	26-P1*	12+35.29	47.38	33.00'
8	25-P1*	12+75.29	46.98	33.00'
8	22-P1*	13+79.98	44.87	33.00'
8	24-P1*	14+11.94	44.25	33.00'
9	4-P1	11+35.92	49.56	32.59'
9	5-P1	12+79.56	47.94	33.00'
9	6-P1	12+79.56	47.49	33.00'
9	7-P1	12+74.26	46.99	33.00'
9	8-P1	13+24.58	46.49	33.00'
9	9-P1	13+69.58	44.97	33.00'
9	10-P1	14+19.58	44.47	33.00'
9	11-P1	14+69.58	43.97	33.00'
9	12-P1	15+14.55	43.52	33.80'
9	13-P1	15+48.35	42.20	33.00'

* SAS SERVICES CONSTRUCTED UNDER STORM DRAIN.

Certification
THE CHANGES SHOWN HEREON ARE BASED UPON A
FIELD SURVEY CONDUCTED BY ME OR UNDER MY
SUPERVISION AND REFLECT THE LOCATIONS
(VERTICALLY AND HORIZONTALLY) TO THE BEST OF
MY KNOWLEDGE AND BELIEF.

SANITARY SEWER SERVICES				SHT 24
BLOCK	LOT	STATION	INV. ELEV. AT PUE	LENGTH AT PUE
8	26-P1*	12+35.29	48.94	33.00'
8	25-P1*	12+75.29	48.99	33.00'
8	22-P1*	13+79.98	46.59	33.00'
8	21-P1*	14+41.94	45.58	33.00'
9	4-P1	11+35.92	50.56	32.59'
9	5-P1	11+79.58	49.85	33.00'
9	6-P1	12+24.58	49.12	33.00'
9	7-P1	12+74.58	48.30	33.00'
9	8-P1	13+24.58	47.49	33.00'
9	9-P1	13+69.58	46.76	33.00'
9	10-P1	14+19.58	45.94	33.00'
9	11-P1	14+69.58	45.13	33.00'
9	12-P1	15+14.55	44.28	33.80'
9	13-P1	15+49.35	43.41	33.40'

* SAS SERVICES CONSTRUCTED UNDER STORM DRAIN.

MARK GOODWIN & ASSOCIATES, P.A.
CONSULTING ENGINEERS
P.O. BOX 90606
ALBUQUERQUE, NEW MEXICO 87199
(505) 828-2200, FAX (505) 797-9539

CITY OF ALBUQUERQUE
PUBLIC WORKS DEPARTMENT

TITLE: ***SUNDORO SOUTH - UNIT 5
TUMULUS DRIVE
UTILITY IMPROVEMENTS***

CITY ENGINEER APPROVAL

APPROVED

JUL 15 2005

CITY ENGINEER

CITY PROJECT NO.

MAP NO.

SHEET

OF

1

F:\A04JOBS\A4046SS\Unit 5\TUMULUS-UP24.dwg 4/21/2005 10:01:18 AM MST


A04JOBS/A4046SS/Unit 5/TUMULUS-UP24 4-22-05 TAS CAR

727084

MAP NO.
J-8/9

SHEET OF
24 27

SCANNED BY
PLANNING

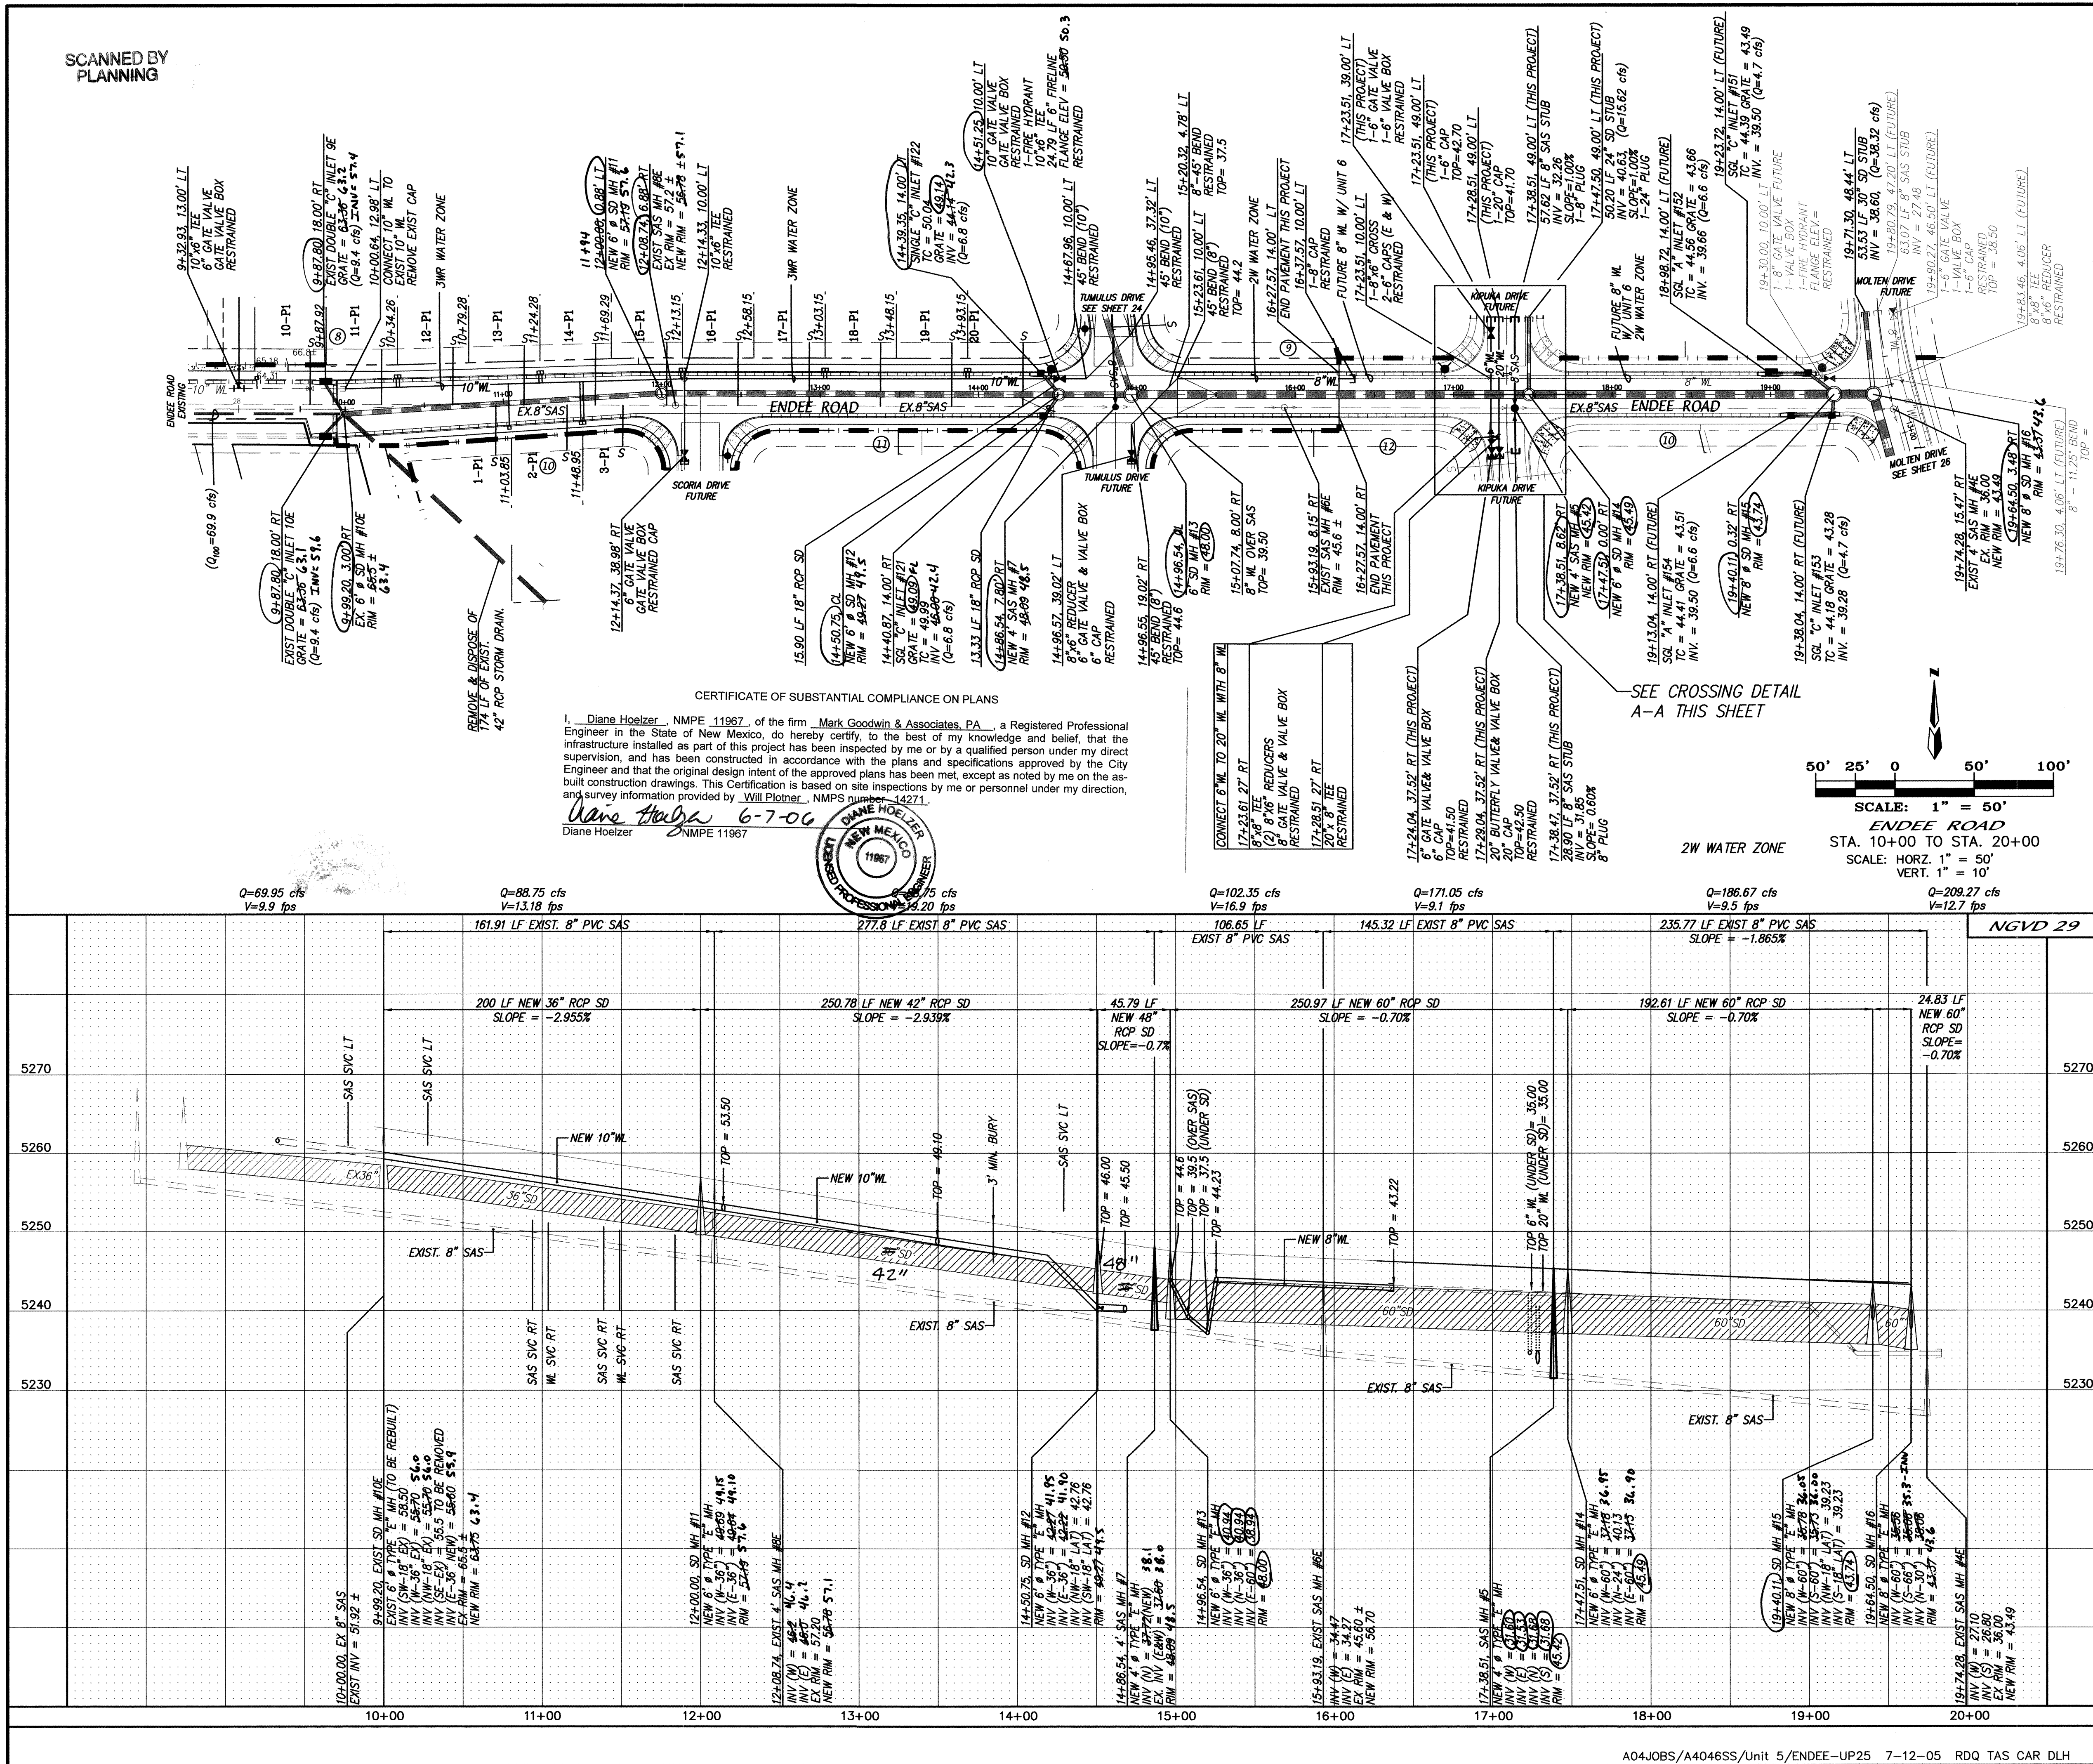

NOTES

- ALL STATIONING IS CENTERLINE STATIONING.
- ALL SAS PIPE IS SDR35 PVC UNLESS NOTED OTHERWISE.
- ALL WATER LINES PIPE IS C-9000 SERIES PVC PIPE UNLESS NOTED OTHERWISE.
- ALL STORM DRAIN PIPE IS CLASS III RCP UNLESS NOTED OTHERWISE.

SANITARY SEWER SERVICES SHT25

BLOCK	LOT	STATION AT PUE	INV. ELEV. AT PUE	LENGTH AT PUE
8	10-P1	9+77.92	61.58	34.88
8	11-P1	10+24.26	60.00	34.93
8	12-P1	10+69.28	59.15	36.30
8	13-P1	11+14.28	58.55	37.67
8	14-P1	11+59.29	57.50	38.98
8	15-P1	12+03.15	56.26	39.86
8	16-P1	12+48.15	54.76	39.91
8	17-P1	12+93.15	53.21	40.21
8	18-P1	13+38.15	51.71	40.36

STORM DRAIN SUMMARY TABLE

LOCATION	INVERT	GRD. ELEV.	HGL
MH 10E	55.70	63.75	61.22
MH 11	48.78	57.19	50.63
MH 12	40.76	49.27	42.51
MH 13	39.94	48.00	44.55
MH 14	37.18	45.49	42.47
MH 15	35.78	43.74	41.01
MH 16	35.56	43.37	39.39

8	19-P1	13+83.15	50.40	40.51
8	20-P1	14+28.07	49.01	40.51
10	1-P1	10+93.85	58.81	32.10
10	2-P1	11+38.95	58.02	28.83
10	3-P1	11+74.85	57.20	26.27

* SAS SERVICES INSTALLED UNDER STORM DRAIN.


Certification
THE CHANGES SHOWN HEREON ARE BASED UPON A FIELD SURVEY CONDUCTED BY ME OR UNDER MY SUPERVISION AND REFLECT THE LOCATIONS (VERTICALLY AND HORIZONTALLY) TO THE BEST OF MY KNOWLEDGE AND BELIEF.

Will Plotner

SANITARY SEWER SERVICES

BLOCK	LOT	STATION AT PUE	INV. ELEV. AT PUE	LENGTH AT PUE
8	10-P1	9+77.92	58.86	34.88
8	11-P1	10+24.26	57.50	34.93
8	12-P1	10+69.28	56.03	36.30
8	13-P1	11+14.28	55.05	37.67
8	14-P1	11+59.29	49.52	38.98
8	15-P1	12+03.15	48.27	39.86
8	16-P1	12+48.15	46.96	39.91
8	17-P1	12+93.15	45.60	40.21
8	18-P1	13+38.15	44.23	40.36
8	19-P1	13+83.15	42.86	40.51
8	20-P1	14+28.07	41.53	40.61
10	1-P1	10+93.85	55.25	32.10
10	2-P1	11+38.95	53.84	28.83
10	3-P1	11+74.85	52.42	26.27

* SAS SERVICES INSTALLED UNDER STORM DRAIN.

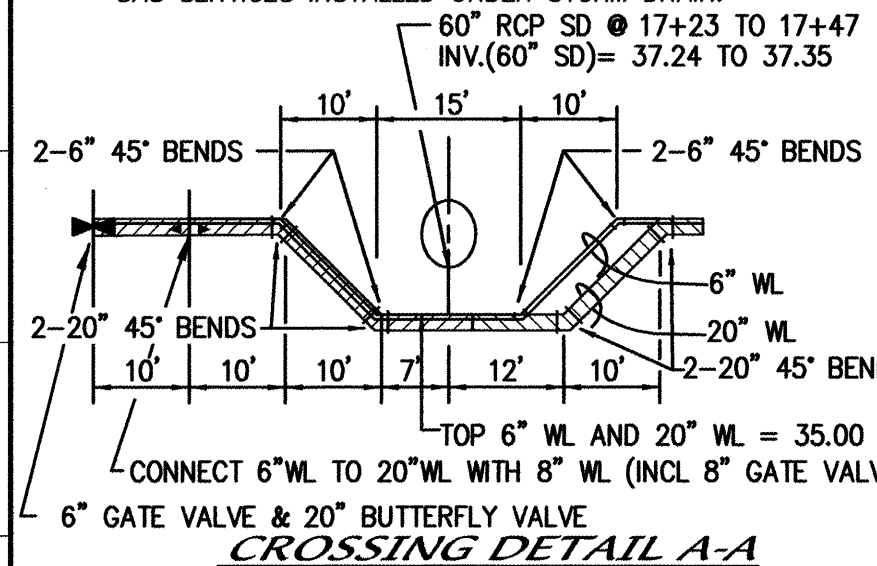

MARK GOODWIN & ASSOCIATES, P.A.
CONSULTING ENGINEERS
P.O. BOX 90606
ALBUQUERQUE, NEW MEXICO 87199
(505) 828-2200, FAX (505) 797-9539

**CITY OF ALBUQUERQUE
PUBLIC WORKS DEPARTMENT**

TITLE: **SUNDORO SOUTH - UNIT 5
ENDEE ROAD
UTILITY IMPROVEMENTS**

DESIGN REVIEW COMMITTEE: **APPROVE**
JUL 13 2005

CITY ENGINEER APPROVAL: **APPROVE**
JUL 15 2005

DESIGNED BY: **DLH**
DRAWN BY: **TAS**
CHECKED BY: **DMG**

MO./DAY/YR.: **7/27/05**

CITY PROJECT NO.: **727084**

ZONE MAP NO.: **J-8/9**

SHEET **25** OF **27**

CONTRACTOR
WORKED BY: **Carroll Survey Inc.**
INSPECTED BY: **DATE**
ACCEPTANCE BY: **DATE**
VERIFICATION BY: **DATE**
DRAWINGS BY: **DATE**
MICRO-FILM INFORMATION
RECORDED BY: **DATE**
NO.


STATION REWARD IS LOCATED ABOUT 5 MILES WEST OF DOWNTOWN ALBUQUERQUE. TO REACH THE STATION FROM INTERSECTION OF CENTRAL AVE. AND STATE RD. 448 GO WEST ON CENTRAL 1.8 MI. TO NOLASCO RD. ON RT. (98TH ST. ON LT.), THEN NORTH ALONG NOLASCO RD. CROSSING OVER US-140, 1.0 MI. TO TRACK RD. LEFT (SW), THEN TAKE TRACK ROAD 0.1 MI. TO PLYMOUTH RD. AND STATION TO LEFT. STATION IS STANDARD USGS BRASS TABLE STAMPED REWARD 1969". SET IN TOP OF A CONCRETE POST PROJECTING 0.3 FT. ABOVE GROUND
X = 850,944.85 Y = 1,487,301.42 (NAD83) ELEV = 5316.91 (NGVD)

ENGINEER'S SEAL
Diane Hoelzer
NEW MEXICO
11967
REGISTERED PROFESSIONAL ENGINEER

REVISIONS

NO.	DATE	REMARKS
1	7/10/05	DESIGN
2	7/10/05	DESIGN
3	7/10/05	DESIGN

SCANNED BY
PLANNING

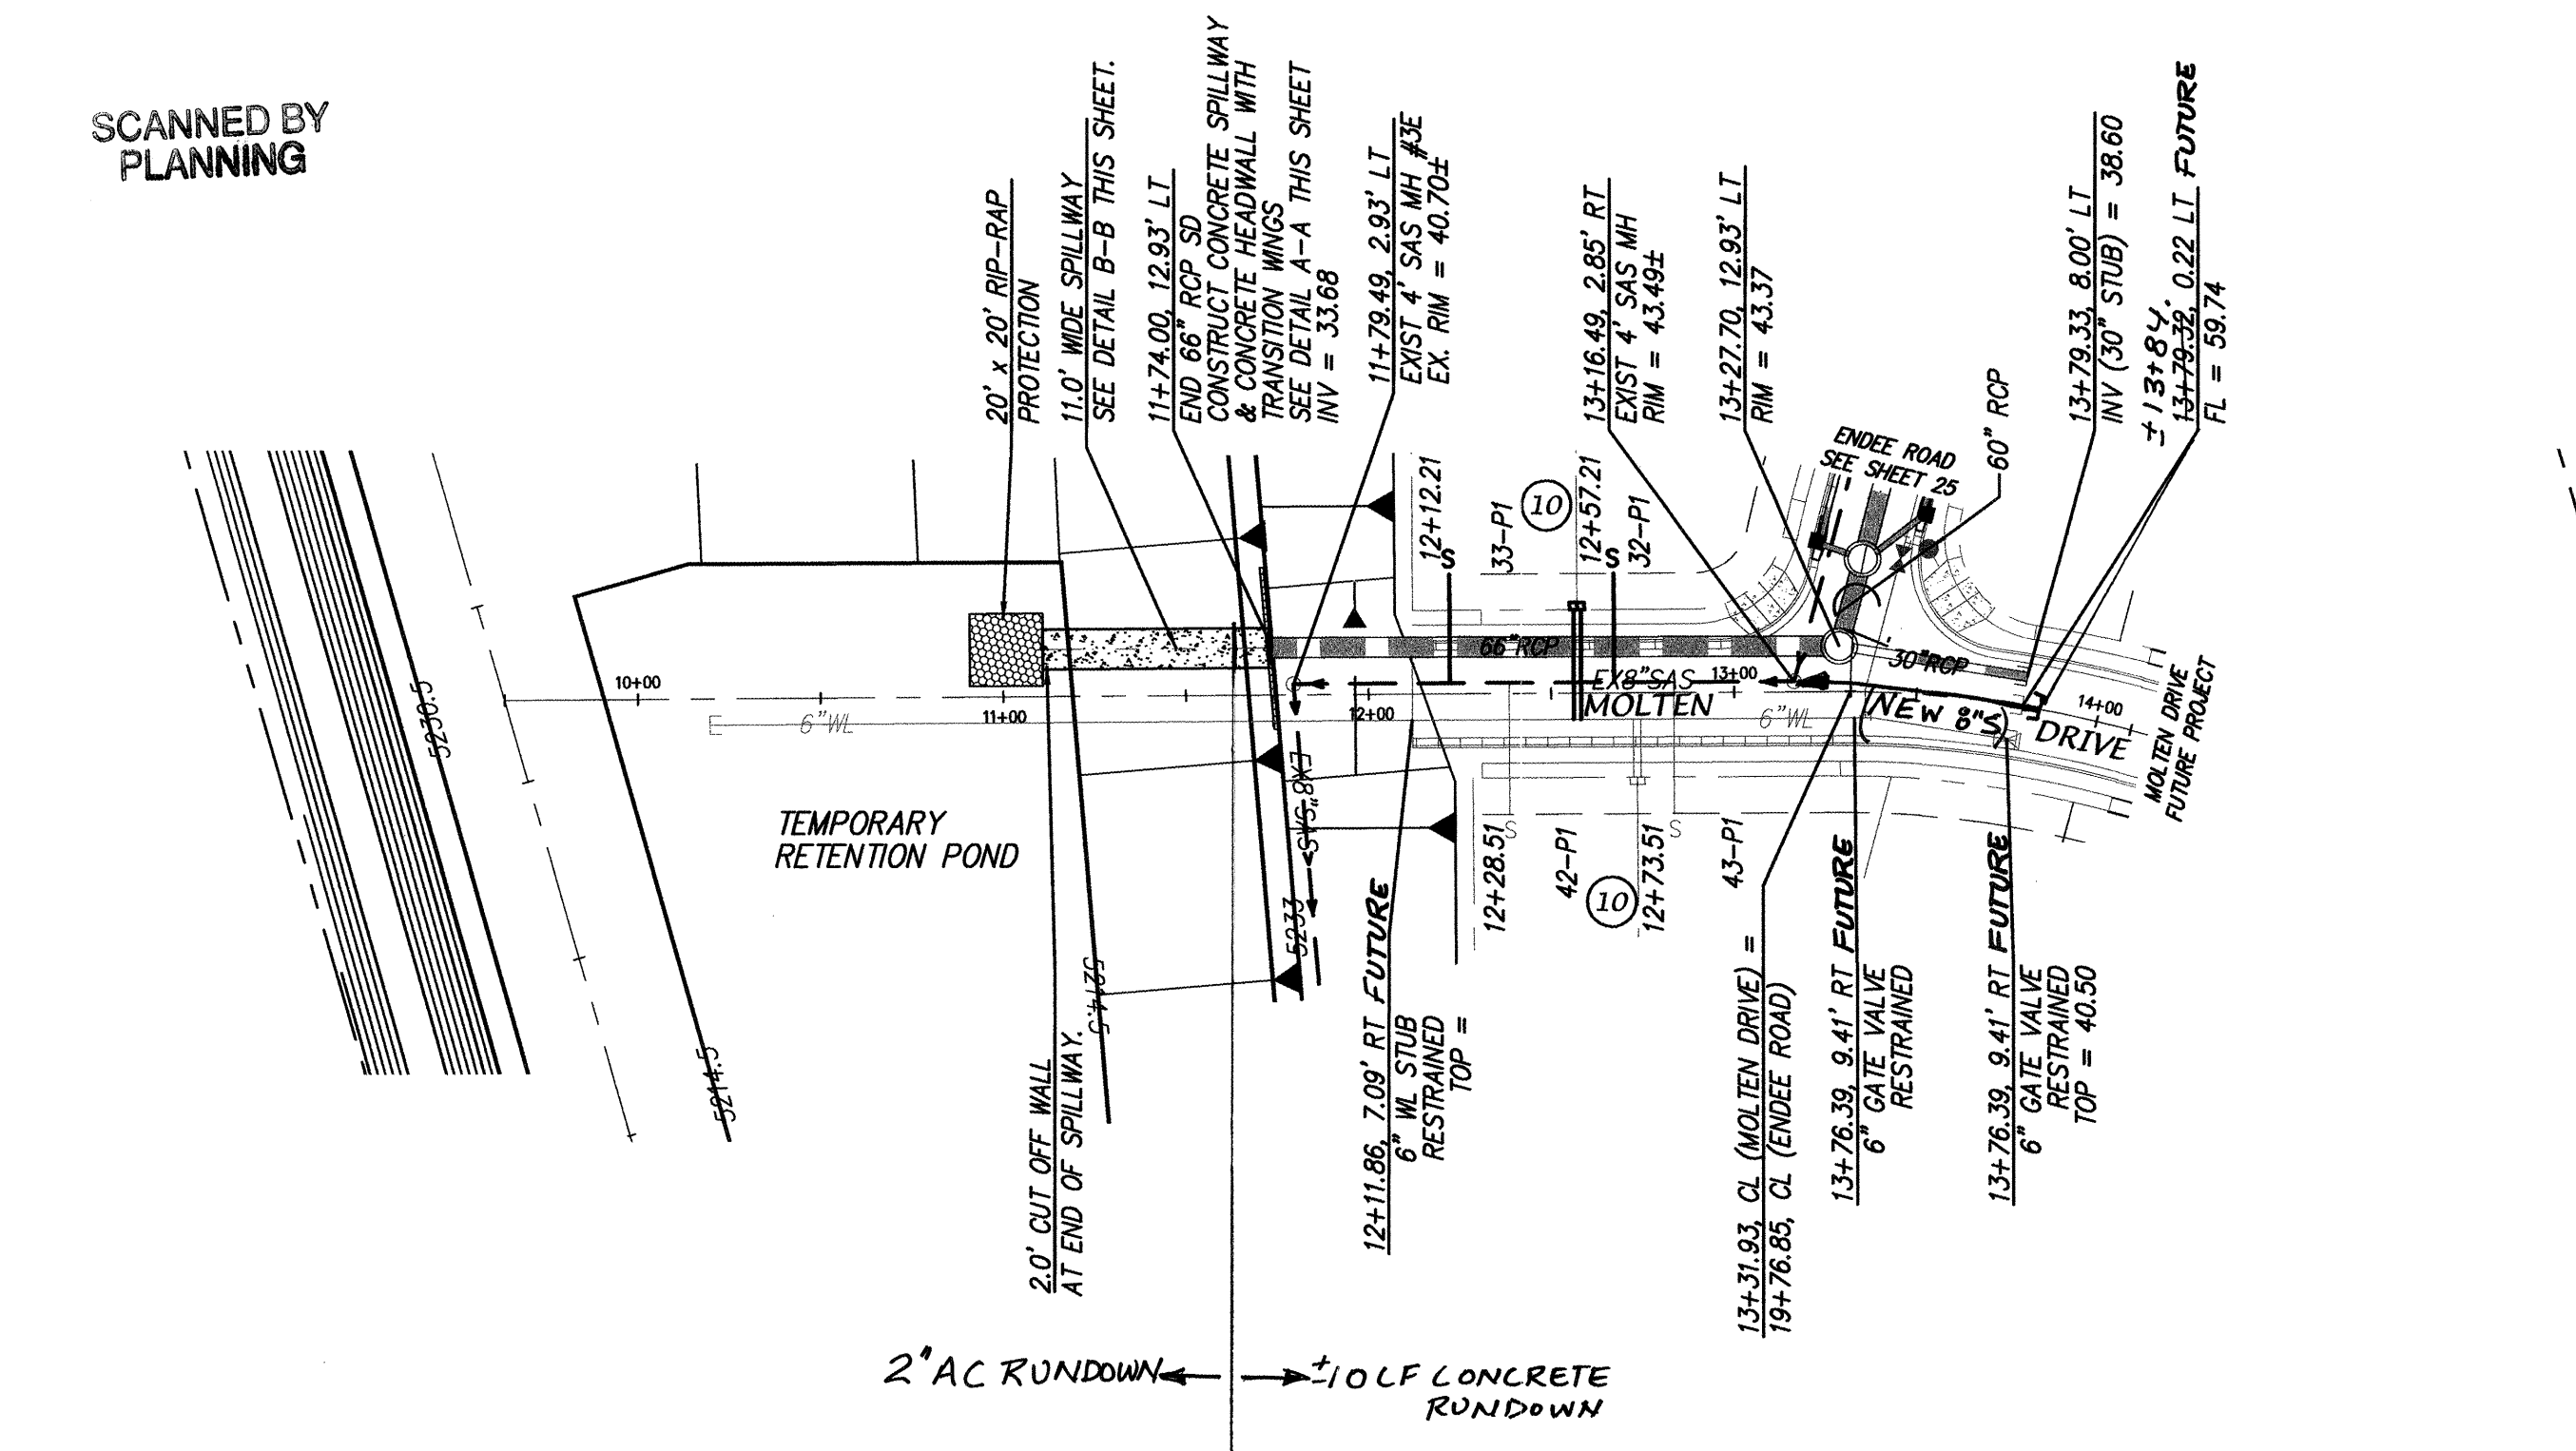

**STORM DRAIN AND TEMPORARY RETENTION POND ONLY
TEMPORARY CONDITION - THIS PROJECT (UNIT 5 CONSTRUCTION)**

CERTIFICATE OF SUBSTANTIAL COMPLIANCE ON PLANS



I, Diane Hoelzer, NMPE 11967, of the firm Mark Goodwin & Associates, P.A., a Registered Professional Engineer in the State of New Mexico, do hereby certify, to the best of my knowledge and belief, that the infrastructure installed as part of this project has been inspected by me or by a qualified person under my direct supervision, and has been constructed in accordance with the plans and specifications approved by the City Engineer and that the original design intent of the approved plans has been met, except as noted by me on the as-built construction drawings. This Certification is based on site inspections by me or personnel under my direction, and survey information provided by Will Plotner, NMPS number 14271.

Diane Hoelzer 6-7-06
Diane Hoelzer NMPE 11967

NOTE:
CONSTRUCTED SAS SERVICE AND WATERLINE SERVICE CONNECTS
UNDER THE STORM DRAIN FOR LOTS 32 AND 33. USE RISERS ON
SAS SERVICE CONNECTIONS.

SAS SERVICE TABLE			
LOT 32	12+67.19	33.32	30.13"
LOT 33	12+22.19	32.98	30.10"

**FOR INFORMATION ONLY - FULL BUILD OUT DESIGN
(NOT PART OF THIS PROJECT)**

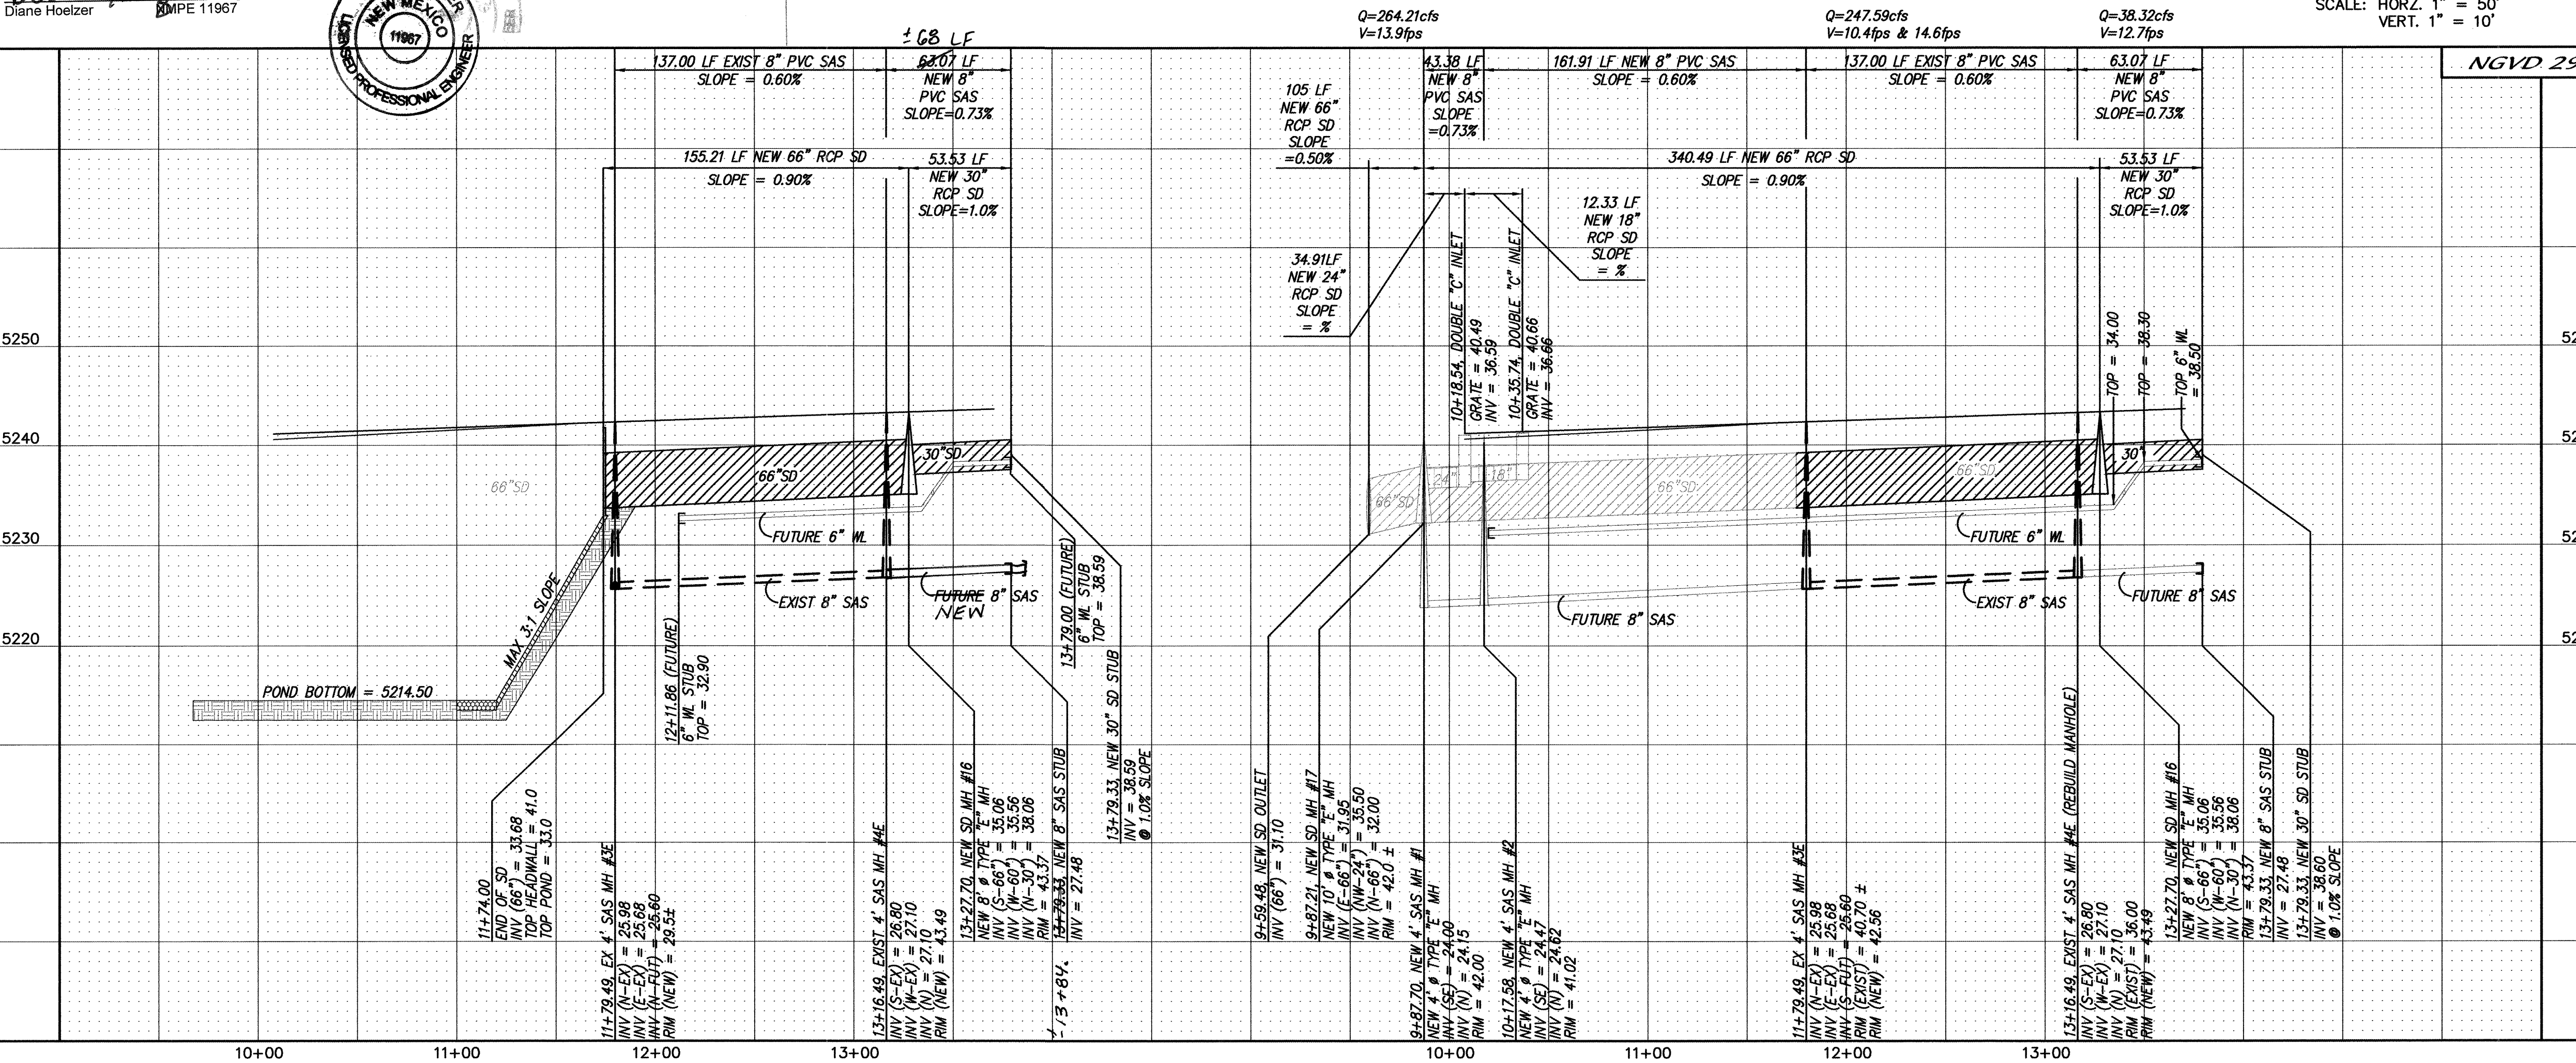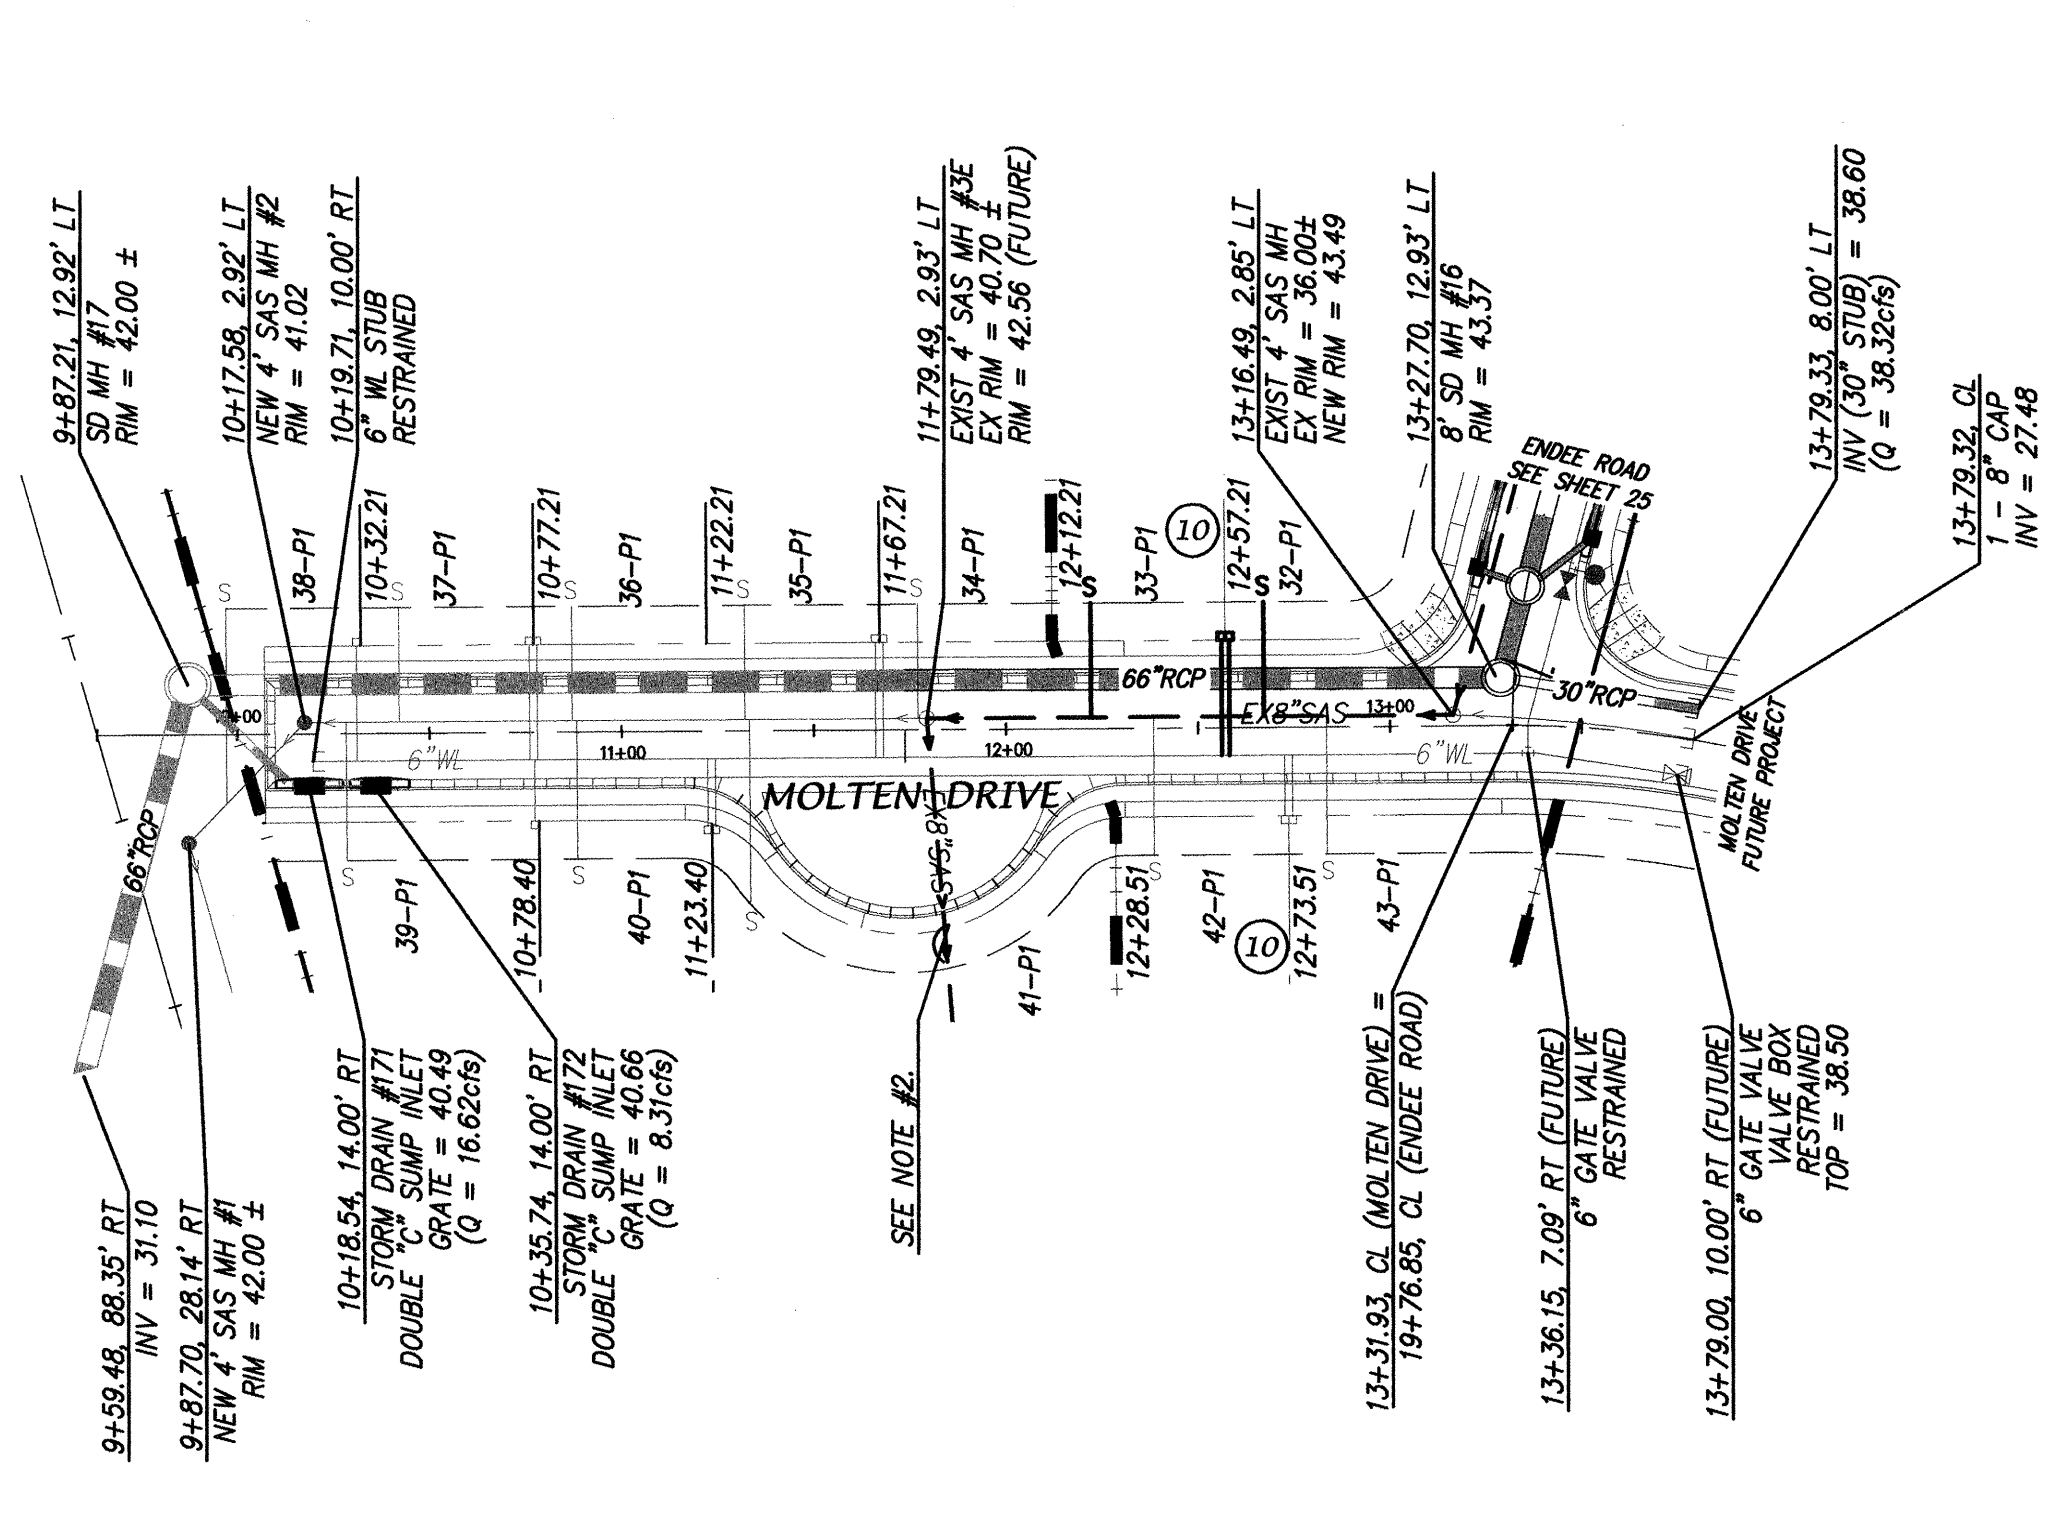


NOTES


1. ALL STATIONING IS CENTERLINE STATIONING.
2. THIS IS A TEMPORARY EXISTING SANITARY SEWER CONNECTION. THIS WILL BE USED AS LONG AS TEMPORARY POND IS REQUIRED. WHEN POND IS FILLED IN, THE PERMANENT SAS LINE TO THE SOUTH & EAST WILL BE CONSTRUCTED TO A NEW OUTFALL LOCATION.
3. ALL SAS PIPE IS SDR35 PVC UNLESS NOTED OTHERWISE.
4. ALL WATER LINES PIPE IS C-900 SERIES PVC PIPE UNLESS NOTED OTHERWISE.
5. ALL STORM DRAIN PIPE IS CLASS III RCP UNLESS NOTED OTHERWISE.

STORM DRAIN SUMMARY TABLE			
LOCATION	INVERT	GRD. ELEV	HGL
OUTFALL	31.10	36.10	35.13
MH 17	32.00	42.00	37.59
MH 16	35.56	43.37	39.39

Certification
THE CHANGES SHOWN HEREON ARE BASED UPON A
FIELD SURVEY CONDUCTED BY ME OR UNDER MY
SUPERVISION AND REFLECT THE LOCATIONS
(VERTICALLY AND HORIZONTALLY) TO THE BEST OF
MY KNOWLEDGE AND BELIEF.

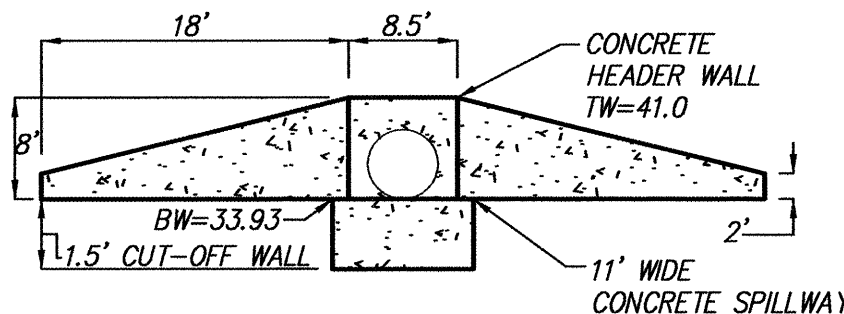

HEADWALL DETAIL A-A

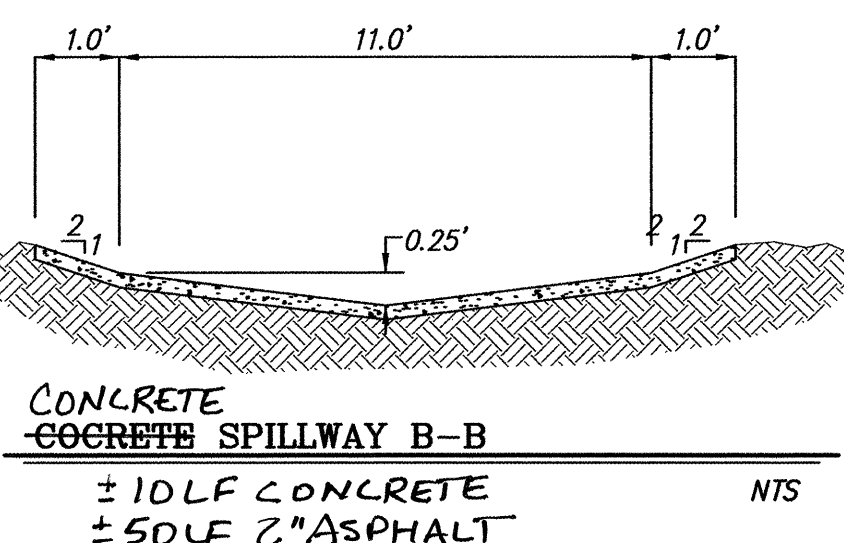

CONCRETE
CONCRETE SPILLWAY B-B
± 10' LF CONCRETE
± 50' LF 2\"/>

dmg MARK GOODWIN & ASSOCIATES, P.A.
CONSULTING ENGINEERS
P.O. BOX 90606
ALBUQUERQUE, NEW MEXICO 87199
(505) 828-2200, FAX (505) 797-9539

**CITY OF ALBUQUERQUE
PUBLIC WORKS DEPARTMENT**

TITLE: **SUNDORO SOUTH - UNIT 5 (UNIT 6)
MOLTEN DRIVE STORM DRAIN
UTILITY IMPROVEMENTS**


DESIGN REVIEW COMMITTEE
APPROVE
JUN 21 2005
DESIGN REVIEW COMMITTEE

CITY ENGINEER APPROVAL
APPROVE
JUL 15 2005
CITY ENGINEER

LAST DESIGN UPDATE
MO./DAY/YR.
MO./DAY/YR.

DESIGNED BY **DLH** DATE **3/05**
DRAWN BY **TAS** DATE **3/05**
CHECKED BY **DWG** DATE **3/05**

CITY PROJECT NO. **727084** ZONE MAP NO. **J-8/9** SHEET **26** OF **27**

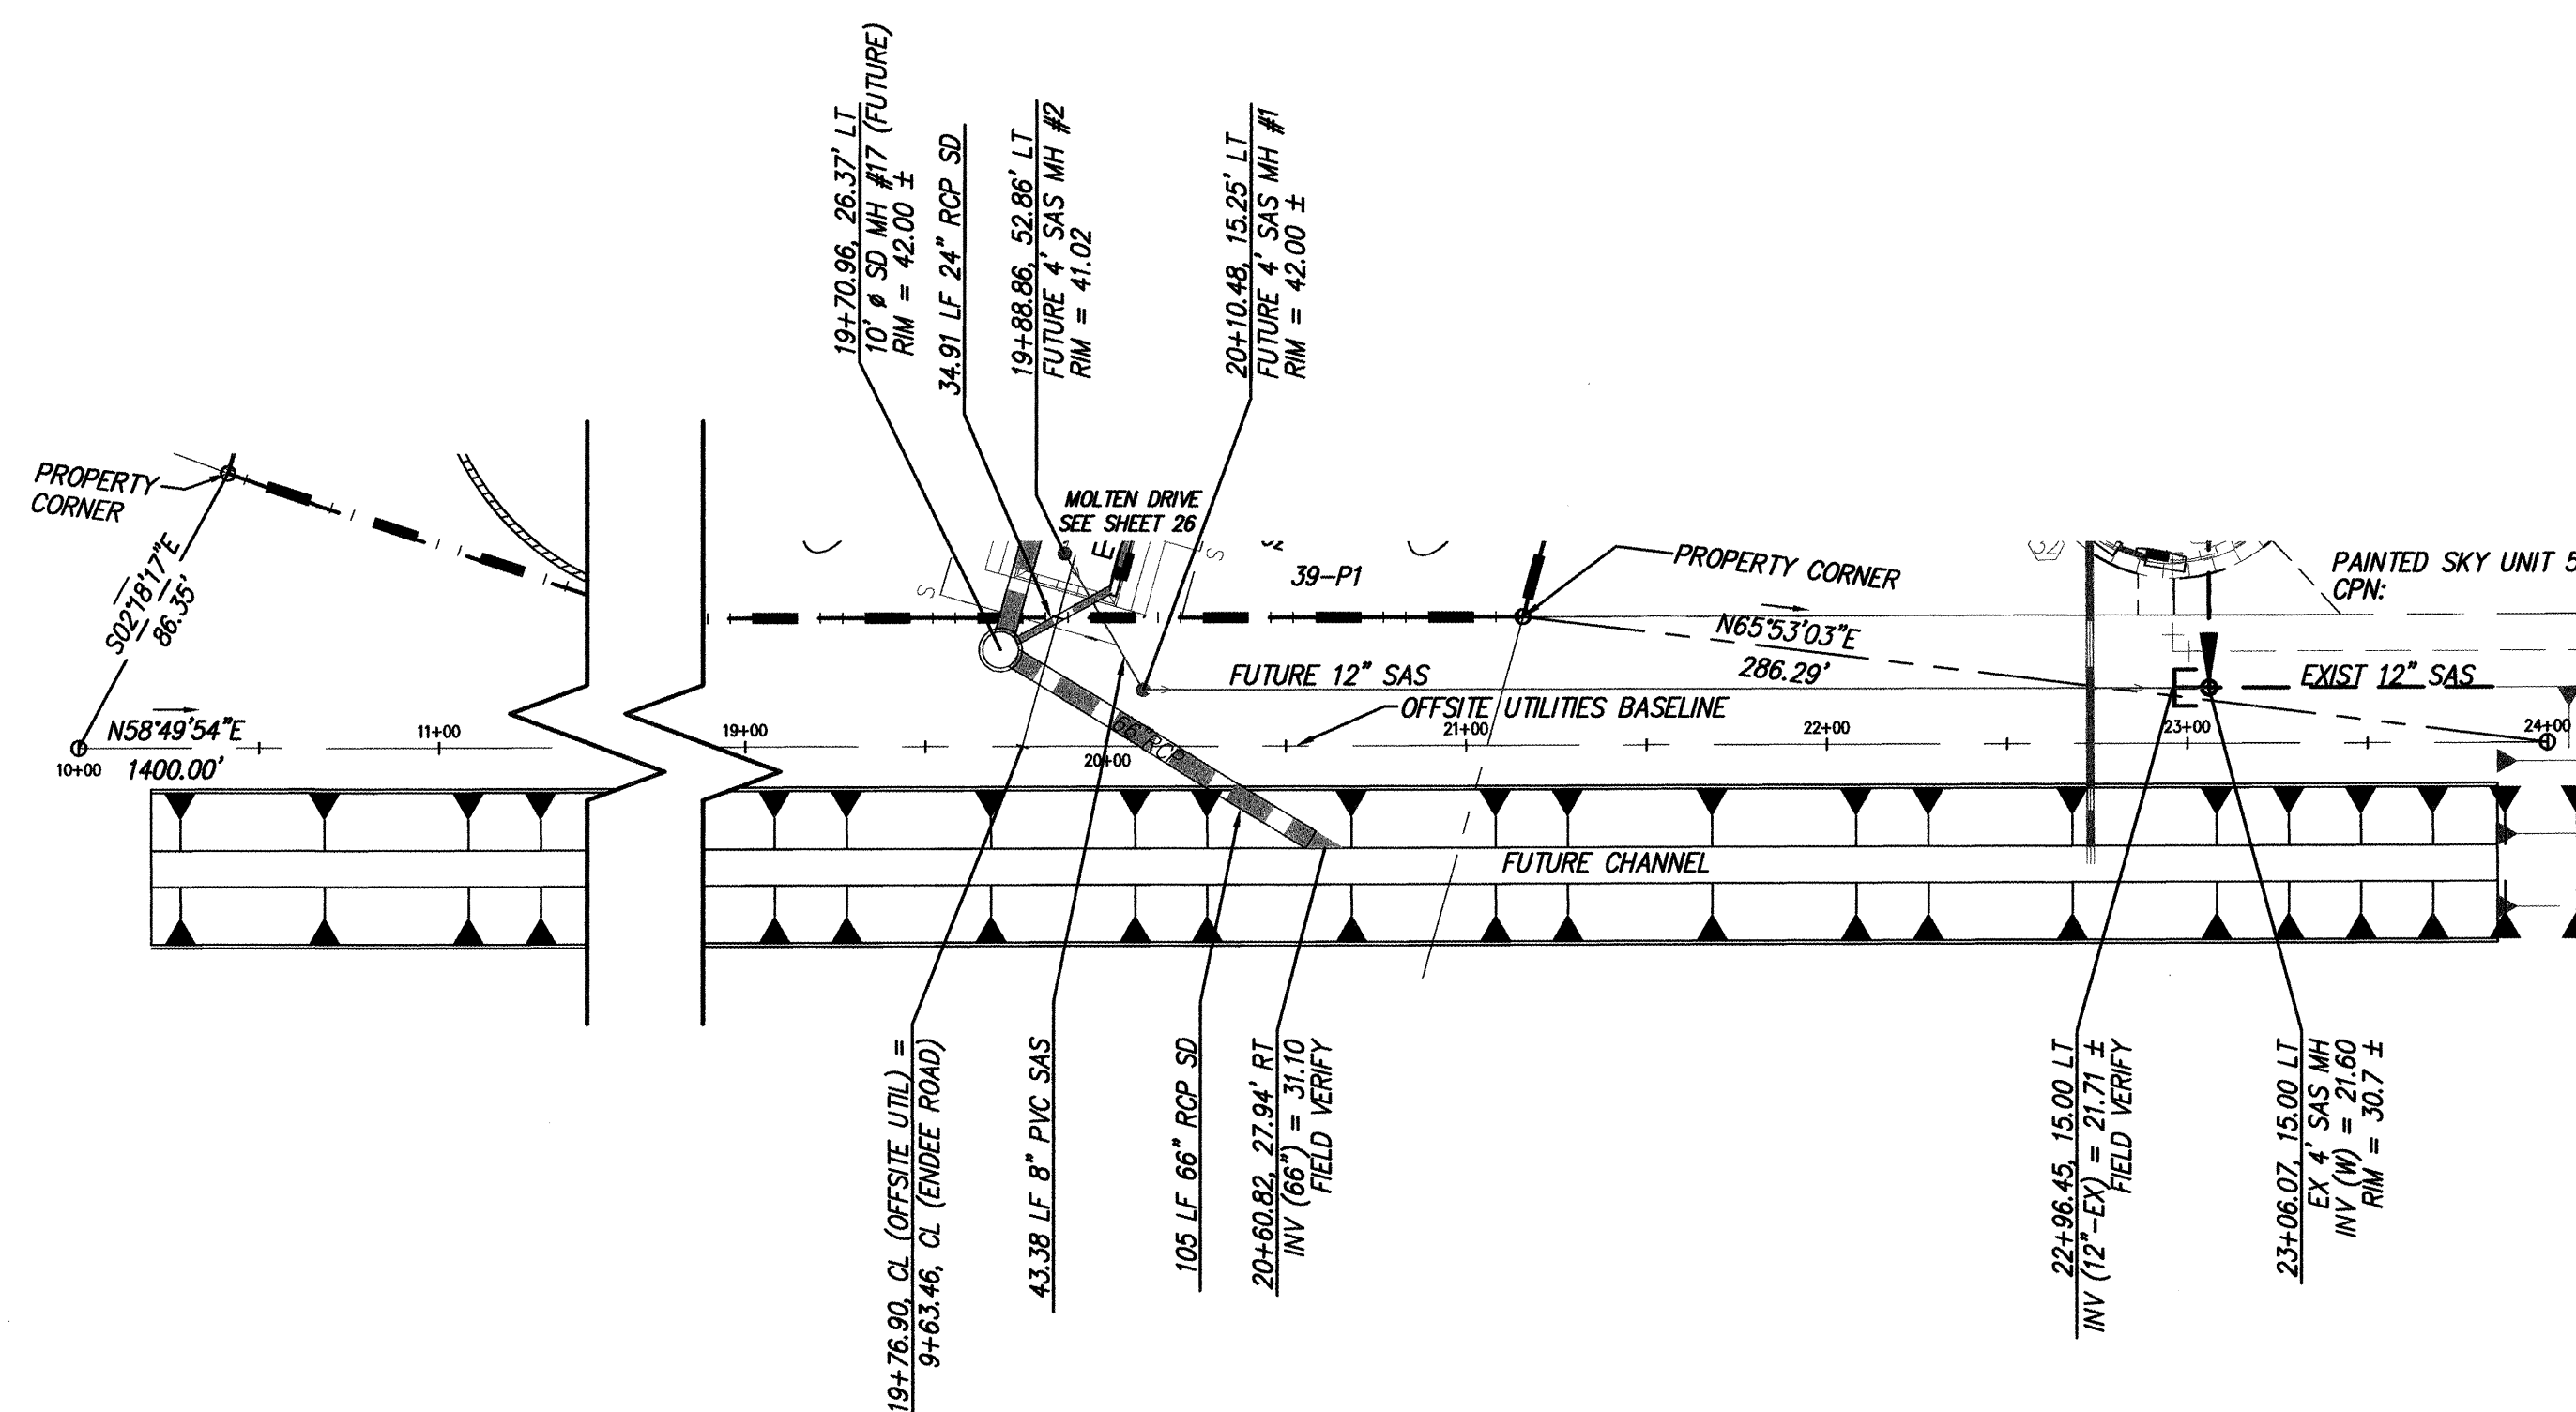


CERTIFICATE OF SUBSTANTIAL COMPLIANCE ON PLANS

I, Diane Hoelzer, NMPE 11967, of the firm Mark Goodwin & Associates, PA, a Registered Professional Engineer in the State of New Mexico, do hereby certify, to the best of my knowledge and belief, that the infrastructure installed as part of this project has been inspected by me or by a qualified person under my direct supervision, and has been constructed in accordance with the plans and specifications approved by the City Engineer and that the original design intent of the approved plans has been met, except as noted by me on the as-built construction drawings. This Certification is based on site inspections by me or personnel under my direction, and survey information provided by Will Plotner, NMPS number 14271.

Diane Hoelzer
Diane Hoelzer NMPE 119677

FOR INFORMATION ONLY

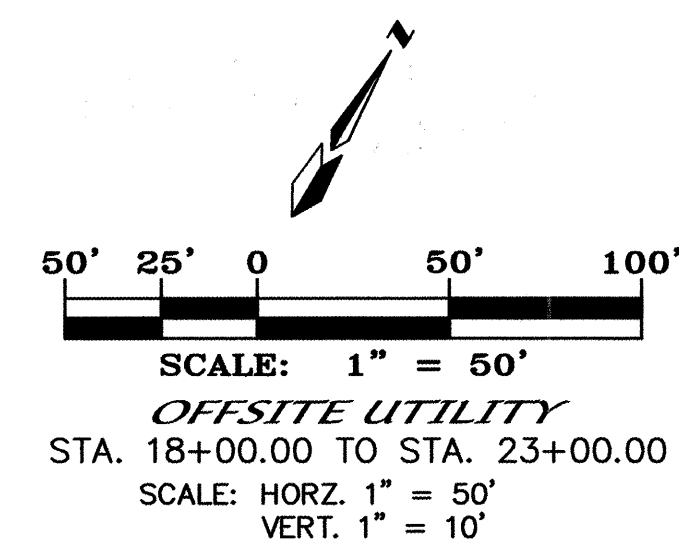

NOTES

1. STATIONING IS BASELINE STATIONING FOR OFFSITE UTILITIES AND AMAFCA CHANNEL.
2. ALL SAS PIPE IS SDR35 PVC UNLESS NOTED OTHERWISE.
3. ALL WATER LINES PIPE IS C-900 SERIES PVC PIPE UNLESS NOTED OTHERWISE.
4. ALL STORM DRAIN PIPE IS CLASS III RCP UNLESS NOTED OTHERWISE.

Certification

THE CHANGES SHOWN HEREON ARE BASED UPON A FIELD SURVEY CONDUCTED BY ME OR UNDER MY SUPERVISION AND REFLECT THE LOCATIONS (VERTICALLY AND HORIZONTALLY) TO THE BEST OF MY KNOWLEDGE AND BELIEF.

Will Phares

[illegible]

dm

MARK GOODWIN & ASSOCIATES, P.A.
CONSULTING ENGINEERS
P.O. BOX 90606
ALBUQUERQUE, NEW MEXICO 87199
(505) 828-2200, FAX (505) 797-9539



CITY OF ALBUQUERQUE
PUBLIC WORKS DEPARTMENT

TITLE	
-------	--

**SUNDORO SOUTH - UNIT 5 (UNIT 6)
OFFSITE UTILITY PLAN
UTILITY IMPROVEMENTS**

DESIGN REVIEW COMMITTEE

APPROVE

JUN 21 2005

DESIGN
REVIEW COMMITTEE

CITY ENGINEER APPROVA
APPROVE
JUL 15 2005
CITY ENGINEER

FAST DESIGN UPDATE

MO. /

AY/Y

R.

MC

/DA*

CITY PROJECT NO

ZONE MAP NO.

SHEET 01