


2 3 4 5 6 7 8 9 10 11 12 13 14 15  
8/6-7/6/74 181-1071

# BERNALILLO COUNTY PUBLIC WORKS DIVISION

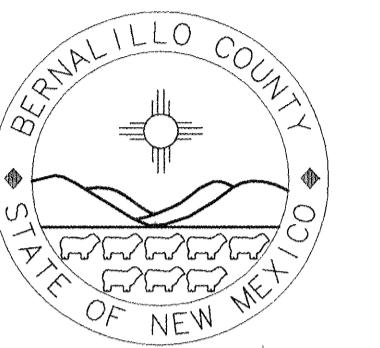

## CONSTRUCTION PLANS FOR CORDERO MESA PHASE I INFRASTRUCTURE ALBUQUERQUE, NEW MEXICO

### INDEX

SHEET NUMBER	DESCRIPTION	SHEET NUMBER	DESCRIPTION
1	COVER SHEET	12	STORM WATER CHANNEL HORIZONTAL CONTROL PLAN
2	PLAT	13	TEMPUR PEDIC PARKWAY STORM DRAIN OUTFALL PLAN & PROFILE STA 43+00 TO STA 55+00
3	OVERALL GRADING & DRAINAGE MGT. PLAN	14	MISCELLANEOUS DETAILS
4	OVERALL PAVING & UTILITY PLAN	14A	MISCELLANEOUS DETAILS
5	PAVING DETAILS	15	CHANNEL TYPICAL SECTIONS
5A	SIGNING & CONSTRUCTION TRAFFIC CONTROL STANDARDS	16	PASEO DEL VOLCAN TRAFFIC CONTROL PLAN
6-11	PLAN AND PROFILE SHEETS		

#### CONSTRUCTION NOTES:

- THE CONTRACTOR SHALL ABIDE BY ALL LOCAL, STATE, AND FEDERAL LAWS, RULES AND REGULATIONS WHICH APPLY TO THE CONSTRUCTION OF THESE IMPROVEMENTS.
- TACK COAT FOR SURFACE COURSE REQUIREMENTS WILL BE DETERMINED BY THE ENGINEER.
- ALL ELECTRICAL, TELEPHONE, CABLE TV, GAS AND OTHER UTILITY LINES, CABLES AND APPURTENANCES ENCOUNTERED DURING CONSTRUCTION THAT REQUIRE RELOCATION, SHALL BE COORDINATED WITH THAT UTILITY. THE CONTRACTOR SHALL BE RESPONSIBLE FOR COORDINATION OF ALL NECESSARY UTILITY ADJUSTMENTS. NO ADDITIONAL COMPENSATION WILL BE ALLOWED FOR DELAYS OR INCONVENIENCES CAUSED BY UTILITY COMPANY WORK CREWS. THE CONTRACTOR MAY BE REQUIRED TO RESCHEDULE HIS ACTIVITIES TO ALLOW UTILITY CREWS TO PERFORM THEIR REQUIRED WORK.
- DISPOSAL SITE FOR ALL EXCESS EXCAVATION MATERIAL, AND UNSUITABLE MATERIAL SHALL BE OBTAINED BY THE CONTRACTOR IN COMPLIANCE WITH APPLICABLE ENVIRONMENTAL REGULATIONS AND APPROVED BY THE CONSTRUCTION OBSERVER. ALL COSTS INCURRED IN OBTAINING A DISPOSAL SITE AND HAUL THERETO SHALL BE CONSIDERED INCIDENTAL TO THE PROJECT AND NO SEPARATE MEASUREMENT OR PAYMENT SHALL BE MADE.
- THE CONTRACTOR IS RESPONSIBLE FOR PROTECTING THE EXISTING UTILITY LINES WITHIN THE CONSTRUCTION AREA. ANY DAMAGE TO EXISTING FACILITIES CAUSED BY CONSTRUCTION ACTIVITY SHALL BE REPAIRED OR REPLACED AT THE CONTRACTOR'S EXPENSE AND APPROVED BY THE CONSTRUCTION OBSERVER.
- CONSTRUCTION ACTIVITY SHALL BE LIMITED TO THE PROPERTY AND/OR PROJECT LIMITS. ANY DAMAGE TO ADJACENT PROPERTIES RESULTING FROM THE CONSTRUCTION PROCESS IS THE RESPONSIBILITY OF THE CONTRACTOR. ANY COSTS INCURRED FOR REPAIRS SHALL BE THE COST OF THE CONTRACTOR.
- OVERNIGHT PARKING OF CONSTRUCTION EQUIPMENT SHALL BE ONLY IN "CONSTRUCTION STAGING AREA".
- THE CONTRACTOR SHALL OBTAIN ALL THE NECESSARY PERMITS FOR THE PROJECT PRIOR TO COMMENCING CONSTRUCTION (I.E. BARRICAADING, SURFACE DISTURBANCE)
- THE CONTRACTOR SHALL BE RESPONSIBLE TO REPLACE AT HIS EXPENSE ANY AND ALL PROPERTY CORNERS DESTROYED DURING CONSTRUCTION. ALL PROPERTY CORNERS MUST BE RESET BY A REGISTERED LAND SURVEYOR.
- ALL PERMANENT PAVEMENT MARKING AND TRAFFIC SIGNING SHALL BE FURNISHED BY THE CONTRACTOR PER PLAN.


- THE CONTRACTOR SHALL FOLLOW THE CONSTRUCTION TRAFFIC CONTROL AND SIGNING PLAN PROVIDED HEREIN. THE CONTRACTOR SHALL COORDINATE WITH THE BERNALILLO COUNTY TRAFFIC ENGINEER (848-1540), PRIOR TO BEGINNING ANY CONSTRUCTION WORK ON OR ADJACENT TO EXISTING STREETS.
- ALL BARRICADES AND CONSTRUCTION SIGNING SHALL CONFORM TO APPLICABLE SECTIONS OF THE "MANUAL OF UNIFORM TRAFFIC CONTROL DEVICES" (MUTCD), U.S. DEPARTMENT OF TRANSPORTATION, LATEST EDITION.
- THE CONTRACTOR SHALL MAINTAIN ALL CONSTRUCTION BARRICADES AND SIGNING AT ALL TIMES. THE CONTRACTOR SHALL VERIFY THE PROPER LOCATION OF ALL BARRICADES AT THE END AND BEGINNING OF EACH DAY.
- ALL SAWCUT PAVEMENT SHALL HAVE A UNIFORM EDGE AND BE SPRAYED WITH TACK.
- WHEN ABUTTING NEW CURB AND GUTTER TO EXISTING PAVEMENT, A 1' WIDE SECTION OF EXISTING PAVEMENT ADJACENT TO THE CURB AND GUTTER SHALL BE SAWCUT, REMOVED, AND REPLACED AS PER THE STANDARD SPECIFICATIONS.
- THE CONTRACTOR SHALL ASSUME RESPONSIBILITY FOR ANY DAMAGE TO EXISTING PAVEMENTS, PAVEMENT MARKINGS, CURB & GUTTER, DRIVE PADS, WHEELCHAIR RAMPS, AND SIDEWALK DURING CONSTRUCTION, APART FROM THOSE SECTIONS INDICATED FOR REMOVAL ON THE PLANS AND SHALL REPAIR OR REPLACE PER COA STANDARDS, AT HIS OWN EXPENSE.
- FILL MATERIALS FROM EXCAVATION OR BORROW WHICH REQUIRE MORE THAN ONE HANDLING PRIOR TO FINAL PLACEMENT, INCLUDING STOCKPILING AND BLENDING TO MEET GRADATION REQUIREMENTS OR STOCKPILING FOR LATER DISPOSAL, WILL BE CONSIDERED INCIDENTAL TO THE CONTRACT UNIT PRICE FOR "FILL CONSTRUCTION". NO SEPARATE PAYMENT SHALL BE MADE FOR MULTIPLE HANDLING AND FINAL PAYMENT SHALL BE MADE ON THE BASIS OF QUANTITIES REMOVED FROM THE ORIGINAL LOCATION.

**SURVEYOR'S CERTIFICATION**


I, Robert Gromatzky, a duly qualified licensed Professional Surveyor under the laws of the State of New Mexico, do hereby certify that the "as-built" information shown on these drawings was obtained from field construction and "as-built" surveys performed by me or under my supervision; that the "as-built" information shown on these drawings was added by me or under my supervision; and that this "as-built" information is true and correct to the best of my knowledge, belief, and belief. I am not responsible for any of the design concepts, calculations, engineering, or intent of the record drawings.

*Robert Gromatzky*  
Robert Gromatzky, NMPSP 16469  
Date: 2-7-07

#### CERTIFICATE OF SUBSTANTIAL COMPLIANCE ON PLANS

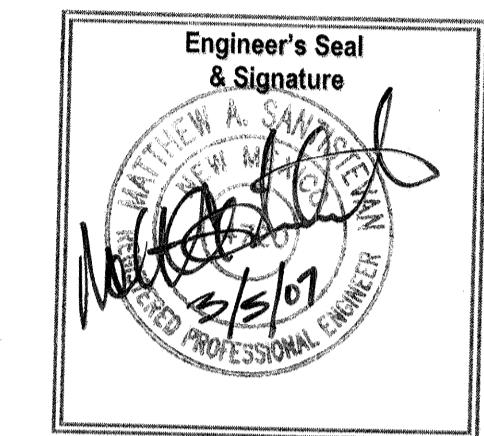


I, Matthew A. Santistevan, of the firm of Bohannan Huston, Inc., a Registered Professional Engineer in the State of New Mexico, do hereby certify, to the best of my knowledge and belief, that the infrastructure installed as part of this project (Cordero Mesa Phase 1 Infrastructure) has been inspected by me or by a qualified person under my direct supervision and has been constructed in accordance with the plans and specifications approved by the City of Albuquerque and that the original design intent of the approved plans has been met, except as noted by me on the as-built construction drawings. This Certification is based on site inspections by me or personnel under my direction and survey information provided by the contractor, Star Paving, and their surveyor, Robert Gromatzky, NMPSP 16469.

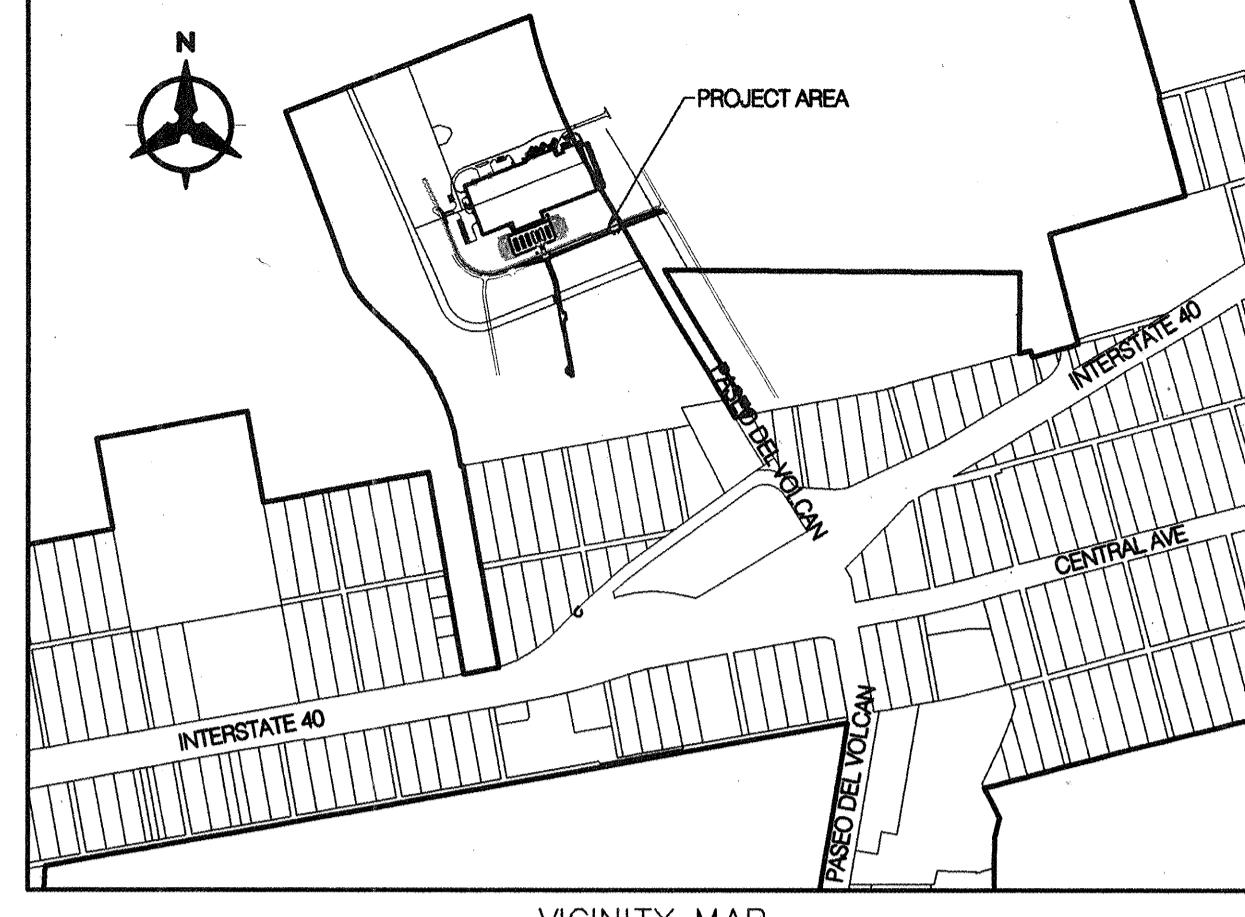

VICINITY MAP  
ZONE ATLAS MAP K6, K7, L6, L7

#### NOTICE TO CONTRACTORS

- AN EXCAVATION/CONSTRUCTION PERMIT WILL BE REQUIRED BEFORE BEGINNING ANY WORK WITHIN THE CITY OR COUNTY RIGHT-OF-WAY.
- ALL WORK DETAILED ON THESE PLANS TO BE PERFORMED UNDER CONTRACT SHALL, EXCEPT AS OTHERWISE STATED OR PROVIDED FOR HEREON, BE CONSTRUCTED IN ACCORDANCE WITH THE CITY OF ALBUQUERQUE STANDARD SPECIFICATIONS FOR PUBLIC WORKS CONSTRUCTION, 1986 EDITION AS REVISED THROUGH UPDATE No.7.
- TWO WORKING DAYS PRIOR TO ANY EXCAVATION, THE CONTRACTOR MUST CONTACT NEW MEXICO ONE CALL SYSTEM (260-1990) FOR LOCATION OF EXISTING UTILITIES.
- PRIOR TO CONSTRUCTION, THE CONTRACTOR SHALL EXCAVATE AND VERIFY THE HORIZONTAL AND VERTICAL LOCATIONS OF ALL OBSTRUCTIONS. SHOULD A CONFLICT EXIST, THE CONTRACTOR SHALL NOTIFY THE ENGINEER OR SURVEYOR IMMEDIATELY SO THAT THE CONFLICT CAN BE RESOLVED WITH A MINIMUM AMOUNT OF DELAY.
- FIVE (5) WORKING DAYS PRIOR TO BEGINNING CONSTRUCTION, THE CONTRACTOR SHALL SUBMIT, TO THE BERNALILLO CO. PUBLIC WORKS DIVISION, A DETAILED CONSTRUCTION SCHEDULE. TWO (2) WORKING DAYS PRIOR TO CONSTRUCTION, THE CONTRACTOR SHALL OBTAIN A BARRICAADING PERMIT FROM THE BERNALILLO CO. PUBLIC WORKS DIVISION. CONTRACTOR SHALL NOTIFY BCPWD TRAFFIC ENGINEER (848-1540) PRIOR TO OCCUPYING AN INTERSECTION. REFER TO SECTION 19 OF THE GENERAL CONDITIONS OF THE STANDARD SPECIFICATIONS.
- ALL WORK AFFECTING ARTERIAL ROADWAYS REQUIRES TWENTY-FOUR HOUR CONSTRUCTION.
- ALL STREET STRIPING ALTERED OR DESTROYED SHALL BE REPLACED W/ PLASTIC REFLECTORIZED PAVEMENT MARKING BY CONTRACTOR TO THE SAME LOCATION AS EXISTING, OR AS INDICATED BY THIS PLAN SET.
- CONTRACTOR SHALL NOTIFY THE ENGINEER NOT LESS THAN SEVEN (7) DAYS PRIOR TO STARTING WORK IN ORDER THAT THE CITY SURVEYOR MAY TAKE NECESSARY MEASURES TO ENSURE THE PRESERVATION OF SURVEY MONUMENTS. CONTRACTOR SHALL NOT DISTURB PERMANENT SURVEY MONUMENTS WITHOUT THE CONSENT OF THE CITY SURVEYOR AND SHALL NOTIFY THE CITY SURVEYOR AND BEAR THE EXPENSE OF REPLACING ANY THAT MAY BE DISTURBED WITHOUT PERMISSION. REPLACEMENT SHALL BE DONE ONLY BY THE CITY SURVEYOR. WHEN A CHANGE IS MADE IN THE FINISHED ELEVATIONS OF THE PAVEMENT OF ANY ROADWAY IN WHICH A PERMANENT SURVEY MONUMENT IS LOCATED, CONTRACTOR SHALL, AT HIS OWN EXPENSE, ADJUST THE MONUMENT COVER TO THE NEW GRADE UNLESS OTHERWISE SPECIFIED. REFER TO SECTION 4.4 OF THE GENERAL CONDITIONS OF THE STANDARD SPECIFICATIONS.
- CONTRACTOR SHALL RECORD DATA ON ALL UTILITY LINES AND ACCESSORIES AS REQUIRED BY THE CITY OF ALBUQUERQUE FOR THE PREPARATION OF "AS CONSTRUCTED" DRAWINGS. CONTRACTOR SHALL NOT COVER UTILITY LINES AND ACCESSORIES UNTIL ALL DATA HAS BEEN RECORDED.
- CONTRACTOR SHALL MAINTAIN A GRAFFITI-FREE WORK SITE. CONTRACTOR SHALL PROMPTLY REMOVE ANY GRAFFITI FROM ALL EQUIPMENT, WHETHER PERMANENT OR TEMPORARY.
- CONTRACTOR SHALL COORDINATE WITH THE CITY OF ALBUQUERQUE WATER SYSTEMS DIVISION (857-8200) FIVE WORKING DAYS IN ADVANCE OF ANY WORK THAT MAY AFFECT EXISTING PUBLIC WATER OR SEWER UTILITIES. EXISTING VALVES TO BE OPERATED BY CITY PERSONNEL ONLY. CONTRACTOR SHALL CONTACT THE WATER SYSTEMS DIVISION THREE (3) DAYS PRIOR TO NEEDING VALVES TURNED ON OR OFF.
- THE CONTRACTOR WILL BE RESPONSIBLE FOR DISPOSING OF ALL DEBRIS, INCLUDING, NOT LIMITED TO HAZARDOUS WASTE AT DISPOSAL SITES APPROVED BY GOVERNMENTAL AGENCIES REGULATING THE DISPOSAL OF SUCH MATERIALS.
- PERMANENT PAVEMENT STRIPING AND MARKINGS WILL BE PLACED BY THE CONTRACTOR. THE ROAD SHALL NOT BE OPENED TO THE TRAFFIC UNTIL IT IS STRIPED. ALL STRIPING, PAVEMENT MARKINGS INCLUDING CROSSWALKS, ARROWS AND LINE MARKINGS ARE TO BE CONSTRUCTED OF HOT PLASTIC OR COLD PLASTIC IN ACCORDANCE WITH THE MANUAL OF UNIFORM TRAFFIC CONTROL DEVICES.

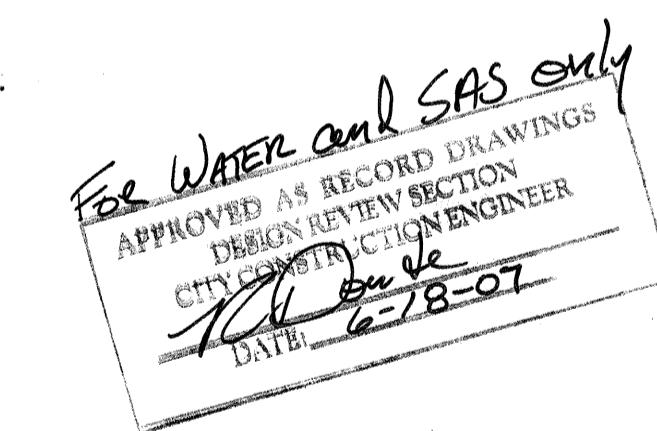

1-2007 AS-BUILT & CERTIFY DLM  
SHEET 14A ADDED


*Bernardo* 6/20/07  
BERN. CO. PDW DATE

ENGINEERS STAMP & SIGNATURE	APPROVALS	ENGINEER	DATE
<i>Bruce L Stidham</i> BERN. CO. PDW 145-1600 PROFESSIONAL ENGINEER	DRC Chairman Transportation Water/Wastewater Hydrology Parks Const. Mngmt.	<i>John C. Cole</i>	6-18-07
<i>William J. Malach</i> 6/20/07	PWCO		
<i>Robert Gromatzky</i> 6/15/07	Drawing No.		
	Sheet		
	of		
	60011		
		1	16

CPN 707481

BHI JOB NO. 060238



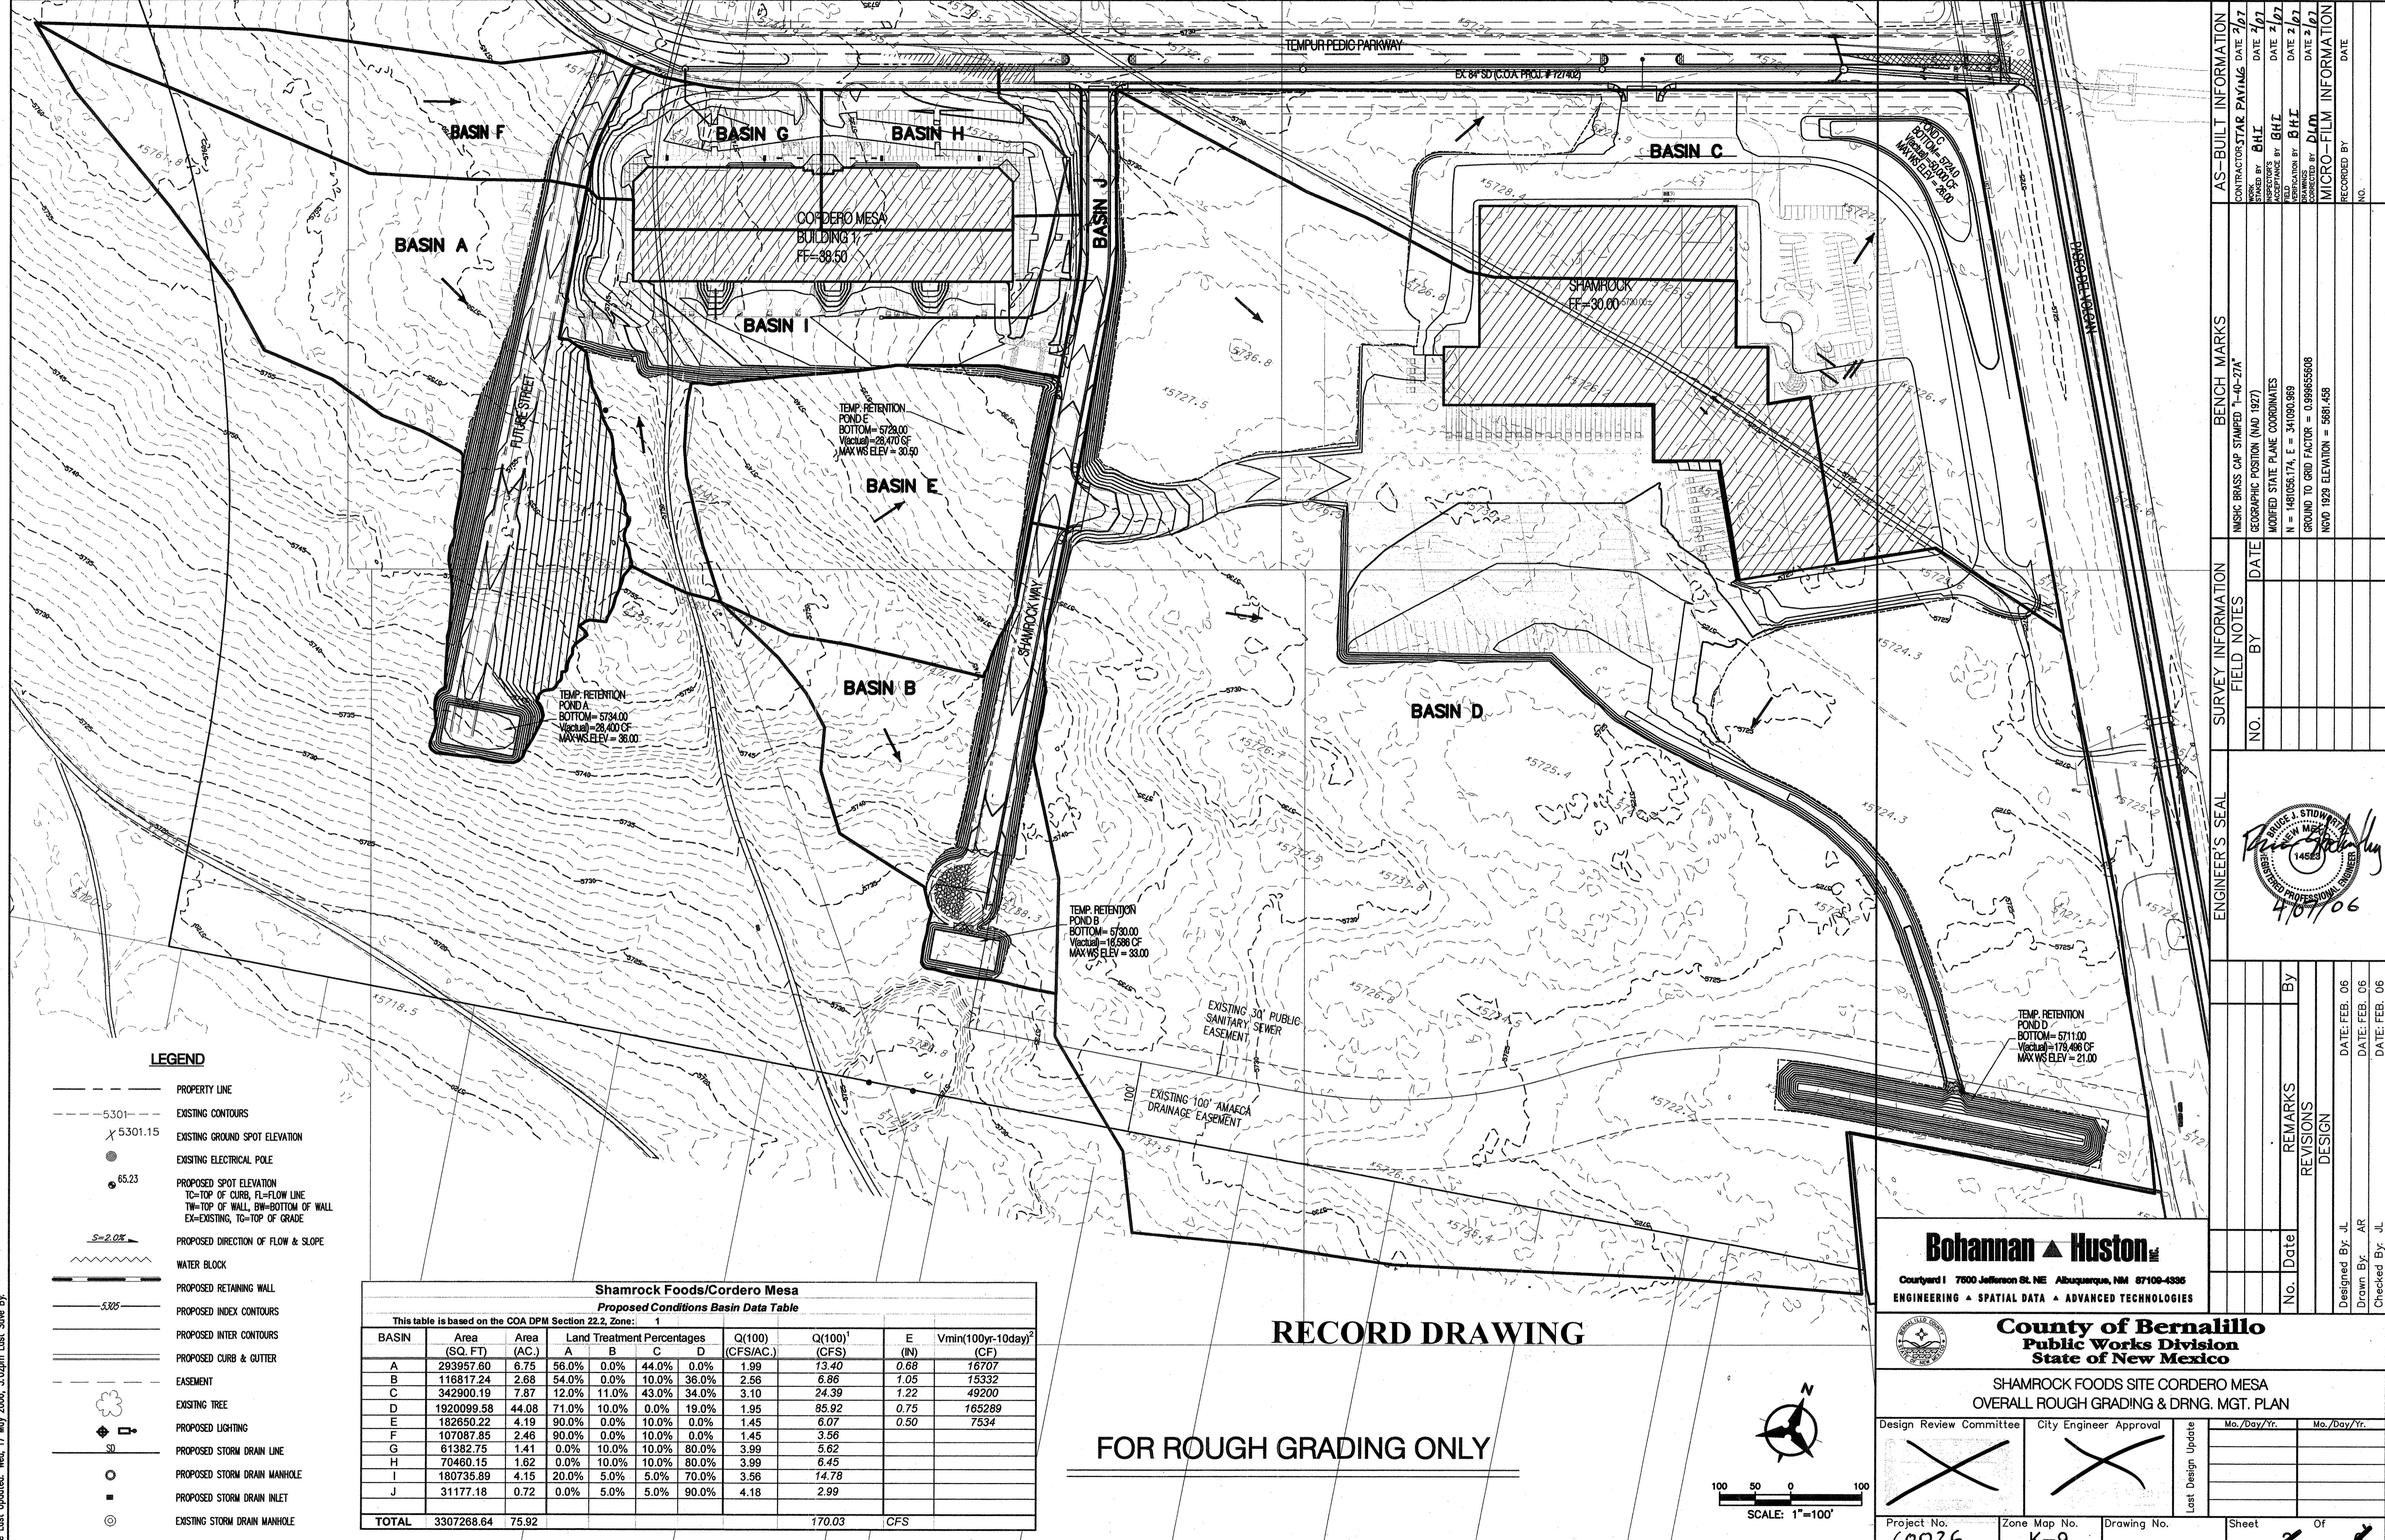

P:\060238\cdp\general\007\_008\_ShamrockGrading\060238grading.dwg  
Thu, 25 May 2006 - 4:13:40pm, Plotted by: AROMERO  
File Last Updated: Wed, 17 May 2006, 5:02pm Last Save By:

# RECORD DRAWING

# FOR ROUGH GRADING ONLY



100      50      0      100


SCALE: 1"=100'

-PN 727481

BHI JOB NO. 060238

For Reference Only

3 16

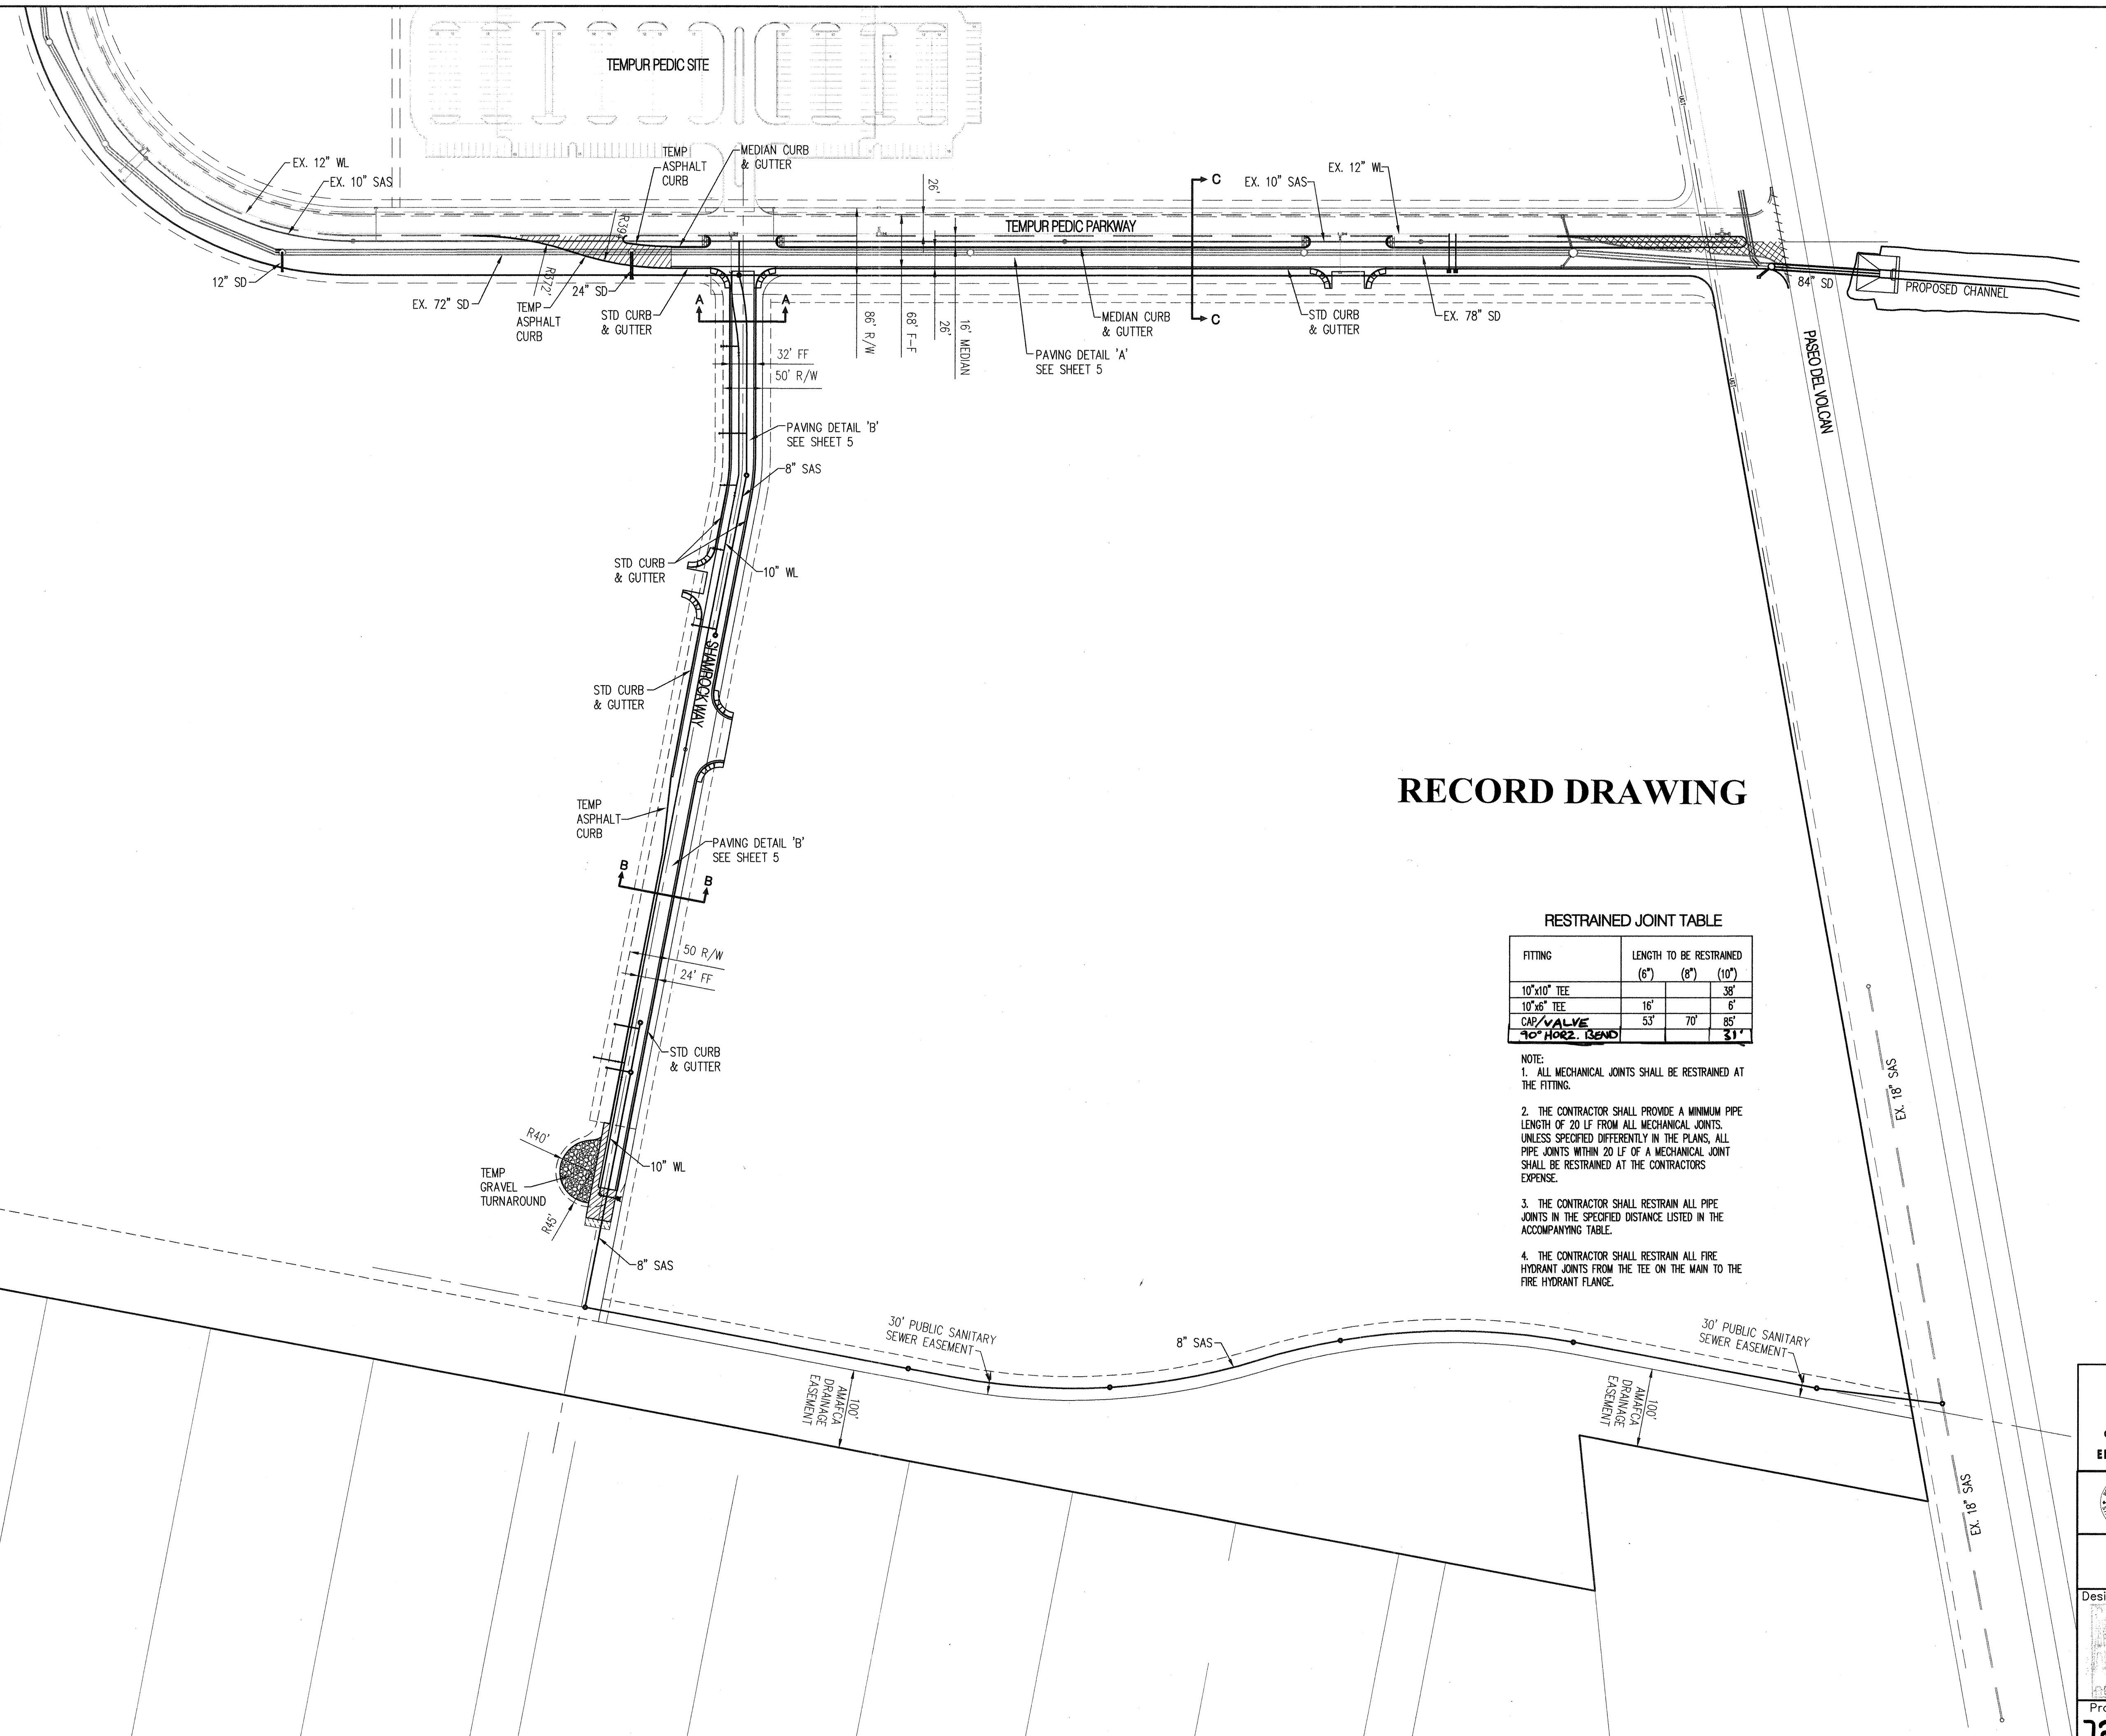

AS-BUILT INFORMATION		CONTRACTOR STAR DRAWING DATE 2/6/07	
RECORDED BY	DATE	RECORDED BY	DATE
BHI	2/6/07	BHI	2/6/07
INSPECTOR'S ACCEPTANCE BY	BHI	ELD DRAWINGS BY	BHI
PROPOSED BY	DLM	DRAWINGS CORRECTED BY	DLM
MICRO-FILM INFORMATION		DRAWN BY DATE	

BENCH MARKS		INSTRUMENT BRASS CAP STAMPED "I-40-21A"	
NO.	FIELD NOTES	DATE	GEOPHIC POSITION (NAD 1927)
			MODIFIED STATE PLANE COORDINATES
			N = 141056.174, E = 341090.989
			GROUND TO GRID FACTOR = 0.999655008
			NGVD 1929 ELEVATION = 5681.458

LEGEND	
EXISTING R/W LINE	INSTRUMENT BRASS CAP STAMPED "I-40-21A"
EXISTING CURB & GUTTER	MODIFIED STATE PLANE COORDINATES
PROPOSED R/W LINE	N = 141056.174, E = 341090.989
PROPERTY LINE	GROUND TO GRID FACTOR = 0.999655008
PROPOSED STANDARD CURB & GUTTER	NGVD 1929 ELEVATION = 5681.458
PROPOSED MOUNTABLE CURB & GUTTER	
PROPOSED SUBDIVISION BOUNDARY	
EASEMENT	
★	PROPOSED STREET LIGHT
○	PROPOSED STORM DRAIN MANHOLE
●	PROPOSED STORM DRAIN INLET
▲	PROPOSED FIRE HYDRANT
◆	PROPOSED MAIN VALVE
■	PROPOSED SAS MANHOLE
◆	PROPOSED CURB RAMP
◆	PROPOSED UNIDIRECTIONAL CURB RAMP
◆	PROPOSED SIGN (PER M.U.T.C.D MILLENNIUM EDITION)
◆	TEMPORARY PAVEMENT
◆	EX. PAVEMENT REMOVAL

Bohannan Huston Inc.  
County of Bernalillo  
Public Works Division  
State of New Mexico  
CORDERO MESA, PHASE I INFRASTRUCTURE  
OVERALL PAVING & UTILITY PLAN  
Design Review Committee Engineer Approval  
Mo./Day/Yr. Mo./Day/Yr.  
Last Design Update  
Project No. CPN Zone Map No. Drawing No. Sheet 4 Of 16  
727481


100 50 0 100  
SCALE: 1"=100'



## CONSTRUCTION TRAFFIC CONTROL GENERAL NOTES



1. PROJECT IS SUBJECT TO THE REQUIREMENTS OF COUNTY ORDINANCE NO. 95-12 AND COUNTY ORDINANCE NO. 96-3. THE CONTRACTOR IS RESPONSIBLE FOR ACQUIRING ALL PERMITS NECESSARY. CONTRACTOR SHALL CALL 848-1504 FOR MORE INFORMATION.
2. THE CONTRACTOR SHALL SUBMIT A TRAFFIC CONTROL PLAN TO THE COUNTY TRAFFIC CONTROL ADMINISTRATOR AT LEAST 72 HOURS PRIOR TO COMMENCEMENT OF WORK. TRAFFIC CONTROL PLANS SHALL BE PREPARED IN ACCORDANCE WITH THE MANUAL ON UNIFORM TRAFFIC CONTROL DEVICES (MUTCD), LATEST EDITION AND BY CERTIFIED PERSONNEL AND MUST BE APPROVED PRIOR TO COMMENCEMENT OF WORK ON THE PROJECT. CALL 848-1504 FOR FURTHER INFORMATION.
3. A DAILY TRAFFIC CONTROL LOG SHALL BE MAINTAINED BY THE CONTRACTOR REFLECTING THE TYPES AND LOCATIONS OF ALL TRAFFIC CONTROL DEVICES, SIGNS, BARRICADES, ETC. BEING USED ON THE PROJECT IN COMPLIANCE WITH THE APPROVED TRAFFIC CONTROL PLAN. THIS LOG SHALL BE SUBMITTED TO THE BERNALILLO COUNTY TRAFFIC CONTROL ADMINISTRATOR UPON COMPLETION OF THE PROJECT CONSTRUCTION OR WHEN SO REQUESTED BY THE PROJECT MANAGER OR THE BERNALILLO COUNTY TRAFFIC CONTROL ADMINISTRATOR.
4. CONTRACTOR SHALL PROVIDE A WEEKLY CONSTRUCTION ACTIVITY SCHEDULE TO BERNALILLO COUNTY PUBLIC WORKS DIVISION ATTN: PROJECT MANAGER
5. THE CONTRACTOR SHALL FILE A WEEKLY WRITTEN REPORT TO THE TRAFFIC CONTROL ADMINISTRATOR DESCRIBING THE TRAFFIC CONTROL PLAN THAT WILL BE IN EFFECT FOR THE FOLLOWING WEEK.
6. SUBJECT TO THE APPROVED TRAFFIC CONTROL PLAN, AT LEAST ONE LANE SHALL BE OPEN TO TRAFFIC AT ALL TIMES. CONTRACTOR SHALL PROVIDE PROPER SIGNAGE AND FLAGMAN AND SHALL MAINTAIN THE TRAFFIC LANE IN SUCH A MANNER AS TO ASSURE PROPER SAFETY TO THE TRAVELING PUBLIC AT ALL TIMES, EXCEPT WHEN GRADING, EXCAVATION AND BACKFILL OPERATIONS ARE BEING CONDUCTED IMMEDIATELY IN FRONT OF THE PROPERTY, IN WHICH CASE ACCESS WILL NOT BE DENIED FOR MORE THAN 4 HOURS WITHOUT APPROVAL BY THE COUNTY.
7. TRAFFIC LANES PROVIDED DURING CONSTRUCTION SHALL BE MAINTAINED, IN SUCH A CONDITION UNDER ALL WEATHER CONDITIONS, SO AS TO PERMIT THE REASONABLE PASSAGE OF PASSENGER VEHICLES, AND SHALL BE KEPT GRADED AND SMOOTH, AND WATERED SEVERAL TIMES DAILY TO CONTROL DUST.
8. TYPICAL TRAFFIC CONTROL PLANS DO NOT REFLECT THE EXISTING TOPOGRAPHY SUCH AS DRIVEWAYS, LANE WIDTHS, AND BUSINESS/RESIDENTIAL ACCESSES. EVERY LOCATION THAT REQUIRES CONSTRUCTION TRAFFIC CONTROL SHALL HAVE A DETAILED TRAFFIC CONTROL PLAN SHOWING ALL EXISTING TOPOGRAPHY.
9. CONSTRUCTION SHALL NOT BEGIN UNLESS A TRAFFIC CONTROL PLAN HAS BEEN APPROVED AND VERIFIED BY BERNALILLO COUNTY TRAFFIC ENGINEERING.
10. ALL CONSTRUCTION TRAFFIC CONTROL DEVICES SHALL COMPLY WITH THE MANUAL ON UNIFORM TRAFFIC CONTROL DEVICES (MUTCD), LATEST EDITION. IT IS THE RESPONSIBILITY OF THE CONTRACTOR TO INSTALL, SERVICE AND MAINTAIN ALL TRAFFIC CONTROL DEVICES. TRAFFIC CONTROL DEVICES SHALL NOT BE REMOVED OR ALTERED IN ANY WAY WITHOUT THE APPROVAL OF THE COUNTY TRAFFIC CONTROL ADMINISTRATOR, PER SECTION 6A-4 OF THE MUTCD, LATEST EDITION.
11. THE CONSTRUCTION TRAFFIC CONTROL INITIAL SET-UP FOR EACH PHASE SHALL BE BY AN AMERICAN TRAFFIC SAFETY SERVICES ASSOCIATION (ATSSA) CERTIFIED WORKSITE TRAFFIC SUPERVISOR. THE MAINTENANCE AND SERVICING SHALL ALSO BE DONE BY AN ATSSA CERTIFIED WORKSITE TRAFFIC SUPERVISOR OR EQUIVALENT.
12. CONTRACTOR IS RESPONSIBLE TO MAINTAIN AND SERVICE ALL TRAFFIC CONTROL DEVICES 24 HOURS A DAY, 7 DAYS A WEEK THROUGHOUT LENGTH OF PROJECT. CONTRACTOR IS RESPONSIBLE THAT ALL TRAFFIC CONTROL DEVICES COMPLY WITH THE MUTCD, LATEST EDITION.
13. ALL ADVANCE WARNING SIGNS SHALL BE DOUBLE INDICATED WHENEVER THERE ARE MULTI-LANE TRAFFIC IN ANY ONE GIVEN DIRECTION AND THERE IS SUFFICIENT MEDIAN SPACE.
14. ALL BARRICADES IN ALL TAPERS AND TANGENTS SHALL BE PLACED APART, A DISTANCE MEASURED IN FEET, EQUAL TO THAT OF THE POSTED SPEED LIMIT. NO EXCEPTIONS UNLESS APPROVED BY BERNALILLO COUNTY TRAFFIC ENGINEERING PER MUTCD SECTION 6A-4.
15. ALL WORK IN ARTERIAL ROADWAYS SHALL BE ON A CONTINUOUS 24 HOUR PER DAY BASIS UNTIL COMPLETED.
16. EQUIPMENT OR MATERIALS SHALL NOT BE STORED WITHIN 15 FEET OF A TRAVELED TRAFFIC LANE DURING NON-WORKING HOURS WITHOUT THE APPROVAL OF BERNALILLO COUNTY TRAFFIC ENGINEERING.

17. CONTRACTOR SHALL PROVIDE AND MAINTAIN A SAFE AND ADEQUATE MEANS OF CHANNELIZING PEDESTRIAN TRAFFIC AROUND AND THROUGH THE CONSTRUCTION AREA.
18. CONTRACTOR IS RESPONSIBLE FOR OBLITERATION OF ANY CONFLICTING STRIPING AND RESPONSIBLE FOR ALL TEMPORARY STRIPING.
19. CONTRACTOR SHALL MAINTAIN ACCESS TO ALL FACILITIES, BUSINESSES AND/OR RESIDENTS AT ALL TIMES.
20. CONTRACTOR SHALL PROVIDE ACCESS SIGNS FOR BUSINESSES LOCATED WITHIN THE CONSTRUCTION AREA UNDER THE SUPERVISION OF BERNALILLO COUNTY TRAFFIC ENGINEERING. EACH ACCESS SIGN SHALL HAVE 5 INCH, WHITE LETTERING ON BLUE BACKGROUND. SHOPPING CENTERS AND MALLS SHALL BE LISTED AS SUCH.
21. 48 HOURS PRIOR TO OCCUPYING OR CLOSING OF A RIGHT-OF-WAY, CONTRACTOR SHALL NOTIFY: POLICE, FIRE DEPARTMENT, SCHOOLS, HOSPITALS, TRANSIT AUTHORITY, BUSINESSES AND/OR RESIDENTS THAT WILL BE AFFECTED BY THE CONSTRUCTION.
22. ANY FIELD ADJUSTMENTS SHALL BE APPROVED BY BERNALILLO COUNTY TRAFFIC ENGINEERING.
23. EXCAVATIONS SHALL BE PLATED, TEMPORARILY PATCHED OR RESURFACED PRIOR TO OPENING OF TRAFFIC. A MINIMUM OF 11 FEET, SHALL BE PROVIDED FOR TRAFFIC IN ANY GIVEN DIRECTION. CONTRACTOR IS RESPONSIBLE FOR ANY WORK INVOLVED IN SATISFYING THESE REQUIREMENTS.
24. THE CONTRACTOR SHALL CONTACT BERNALILLO COUNTY TRAFFIC ENGINEER (848-1575) BEFORE REMOVING AND/OR INSTALLING ANY TRAFFIC SIGNS OR PERMANENT STRIPING AND MARKINGS. ALL STRIPING, PAVEMENT MARKINGS INCLUDING CROSSWALKS, LEGENDS AND SYMBOLS ARE TO BE CONSTRUCTED OF INTERSECTION GRADE COLD PLASTIC AND LINE MARKINGS ARE TO BE CONSTRUCTED OF DURABLE PAINT IN ACCORDANCE WITH THE MANUAL ON UNIFORM TRAFFIC CONTROL DEVICES (MUTCD) LATEST EDITION. ANY PAVEMENT MARKINGS AND SIGNS REMOVED OR DAMAGED DURING CONSTRUCTION SHALL BE REPLACED AT EXISTING LOCATIONS. SUCH WORK SHALL BE CONSIDERED INCIDENTAL TO CONSTRUCTION OF THE PROJECT.

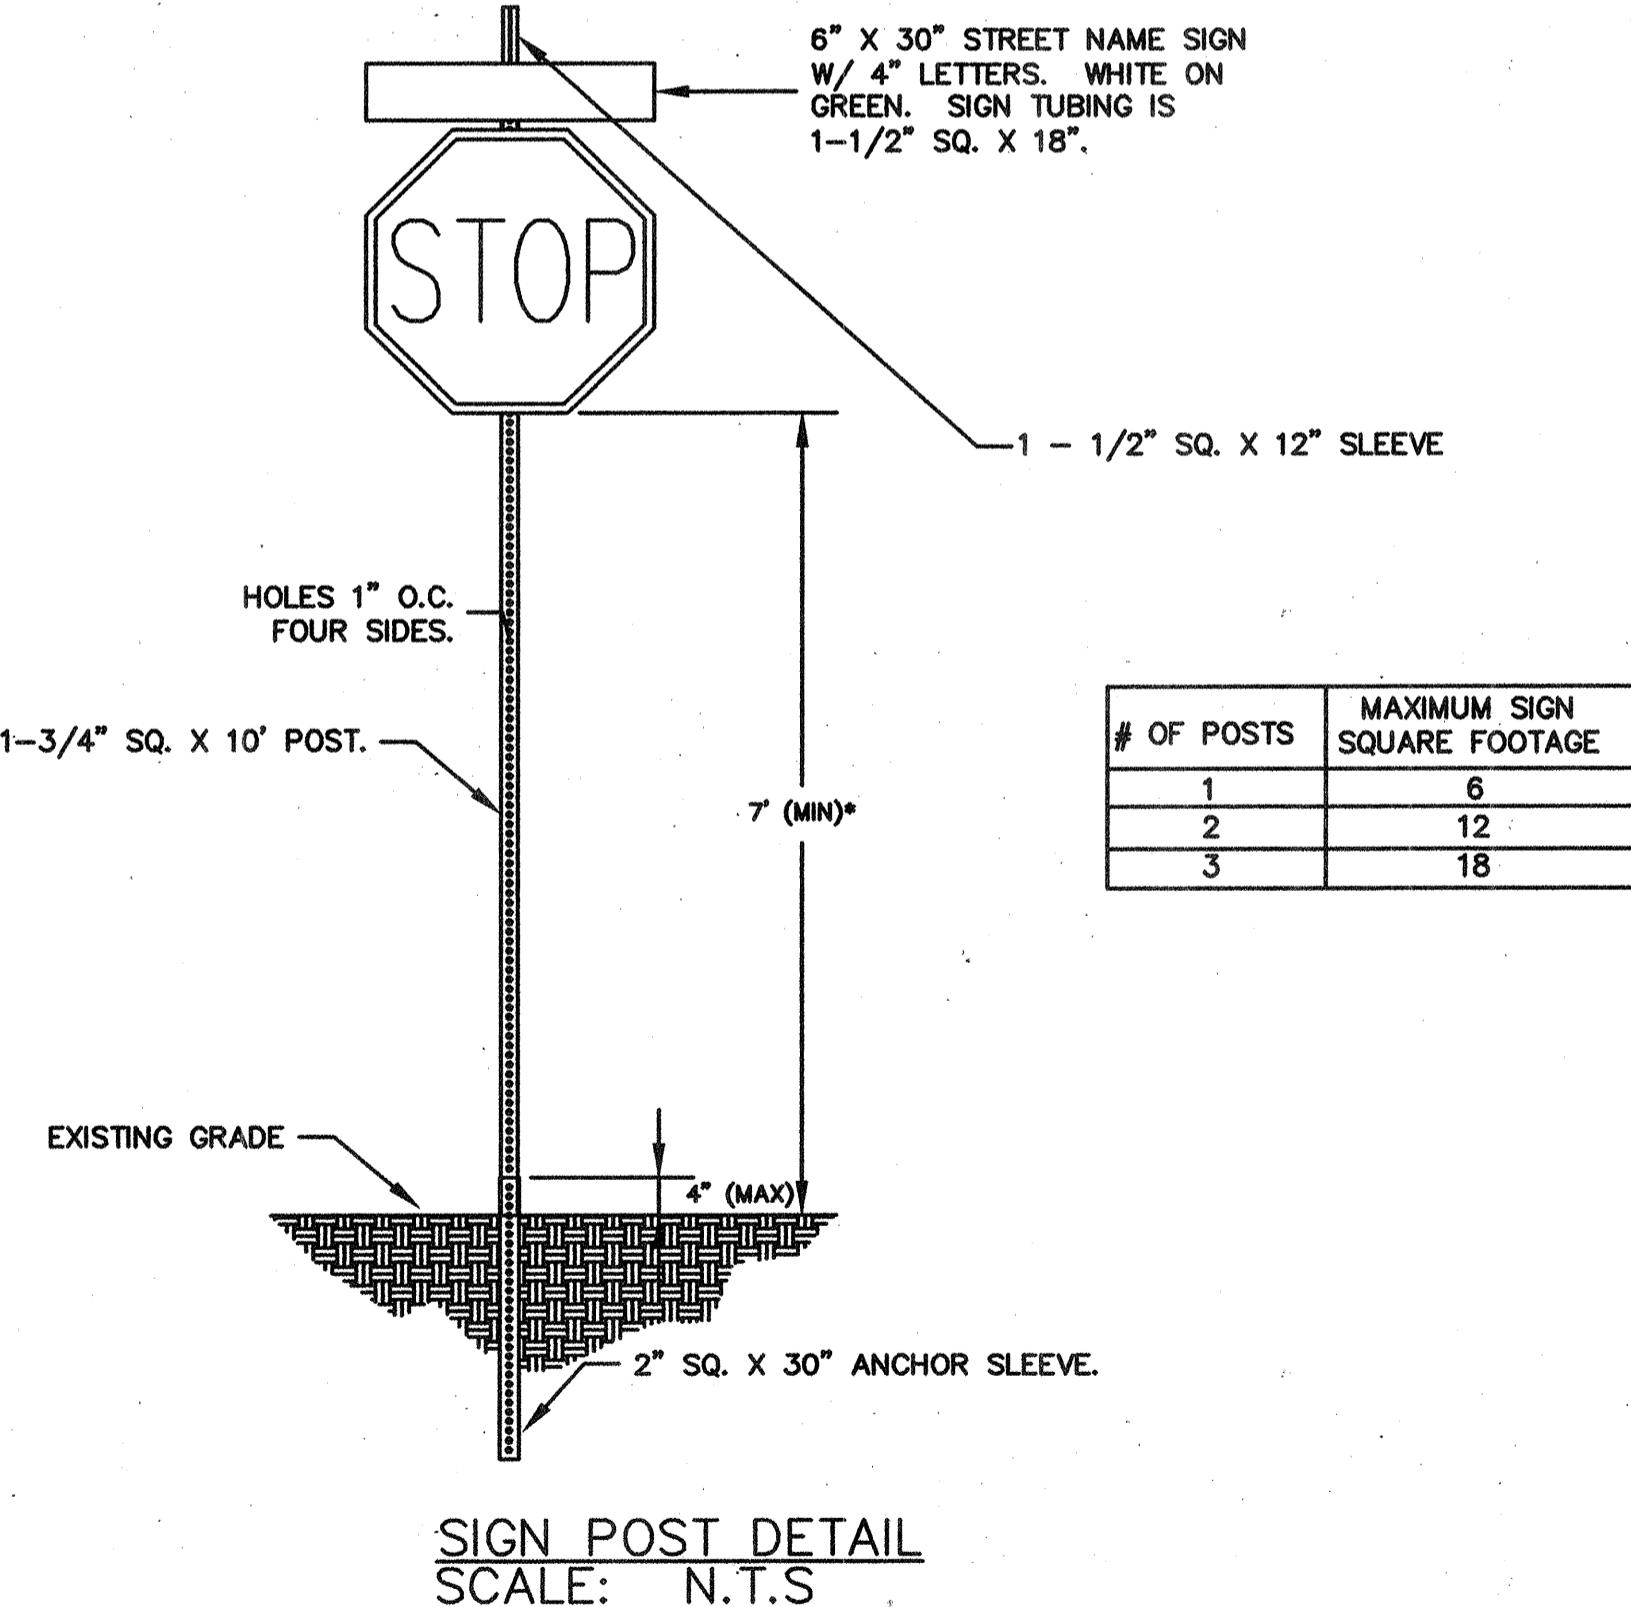

\*SEE MUTCD FOR MINIMUM MOUNTING HEIGHT IN RURAL AREAS

## SIGN FACE DETAILS

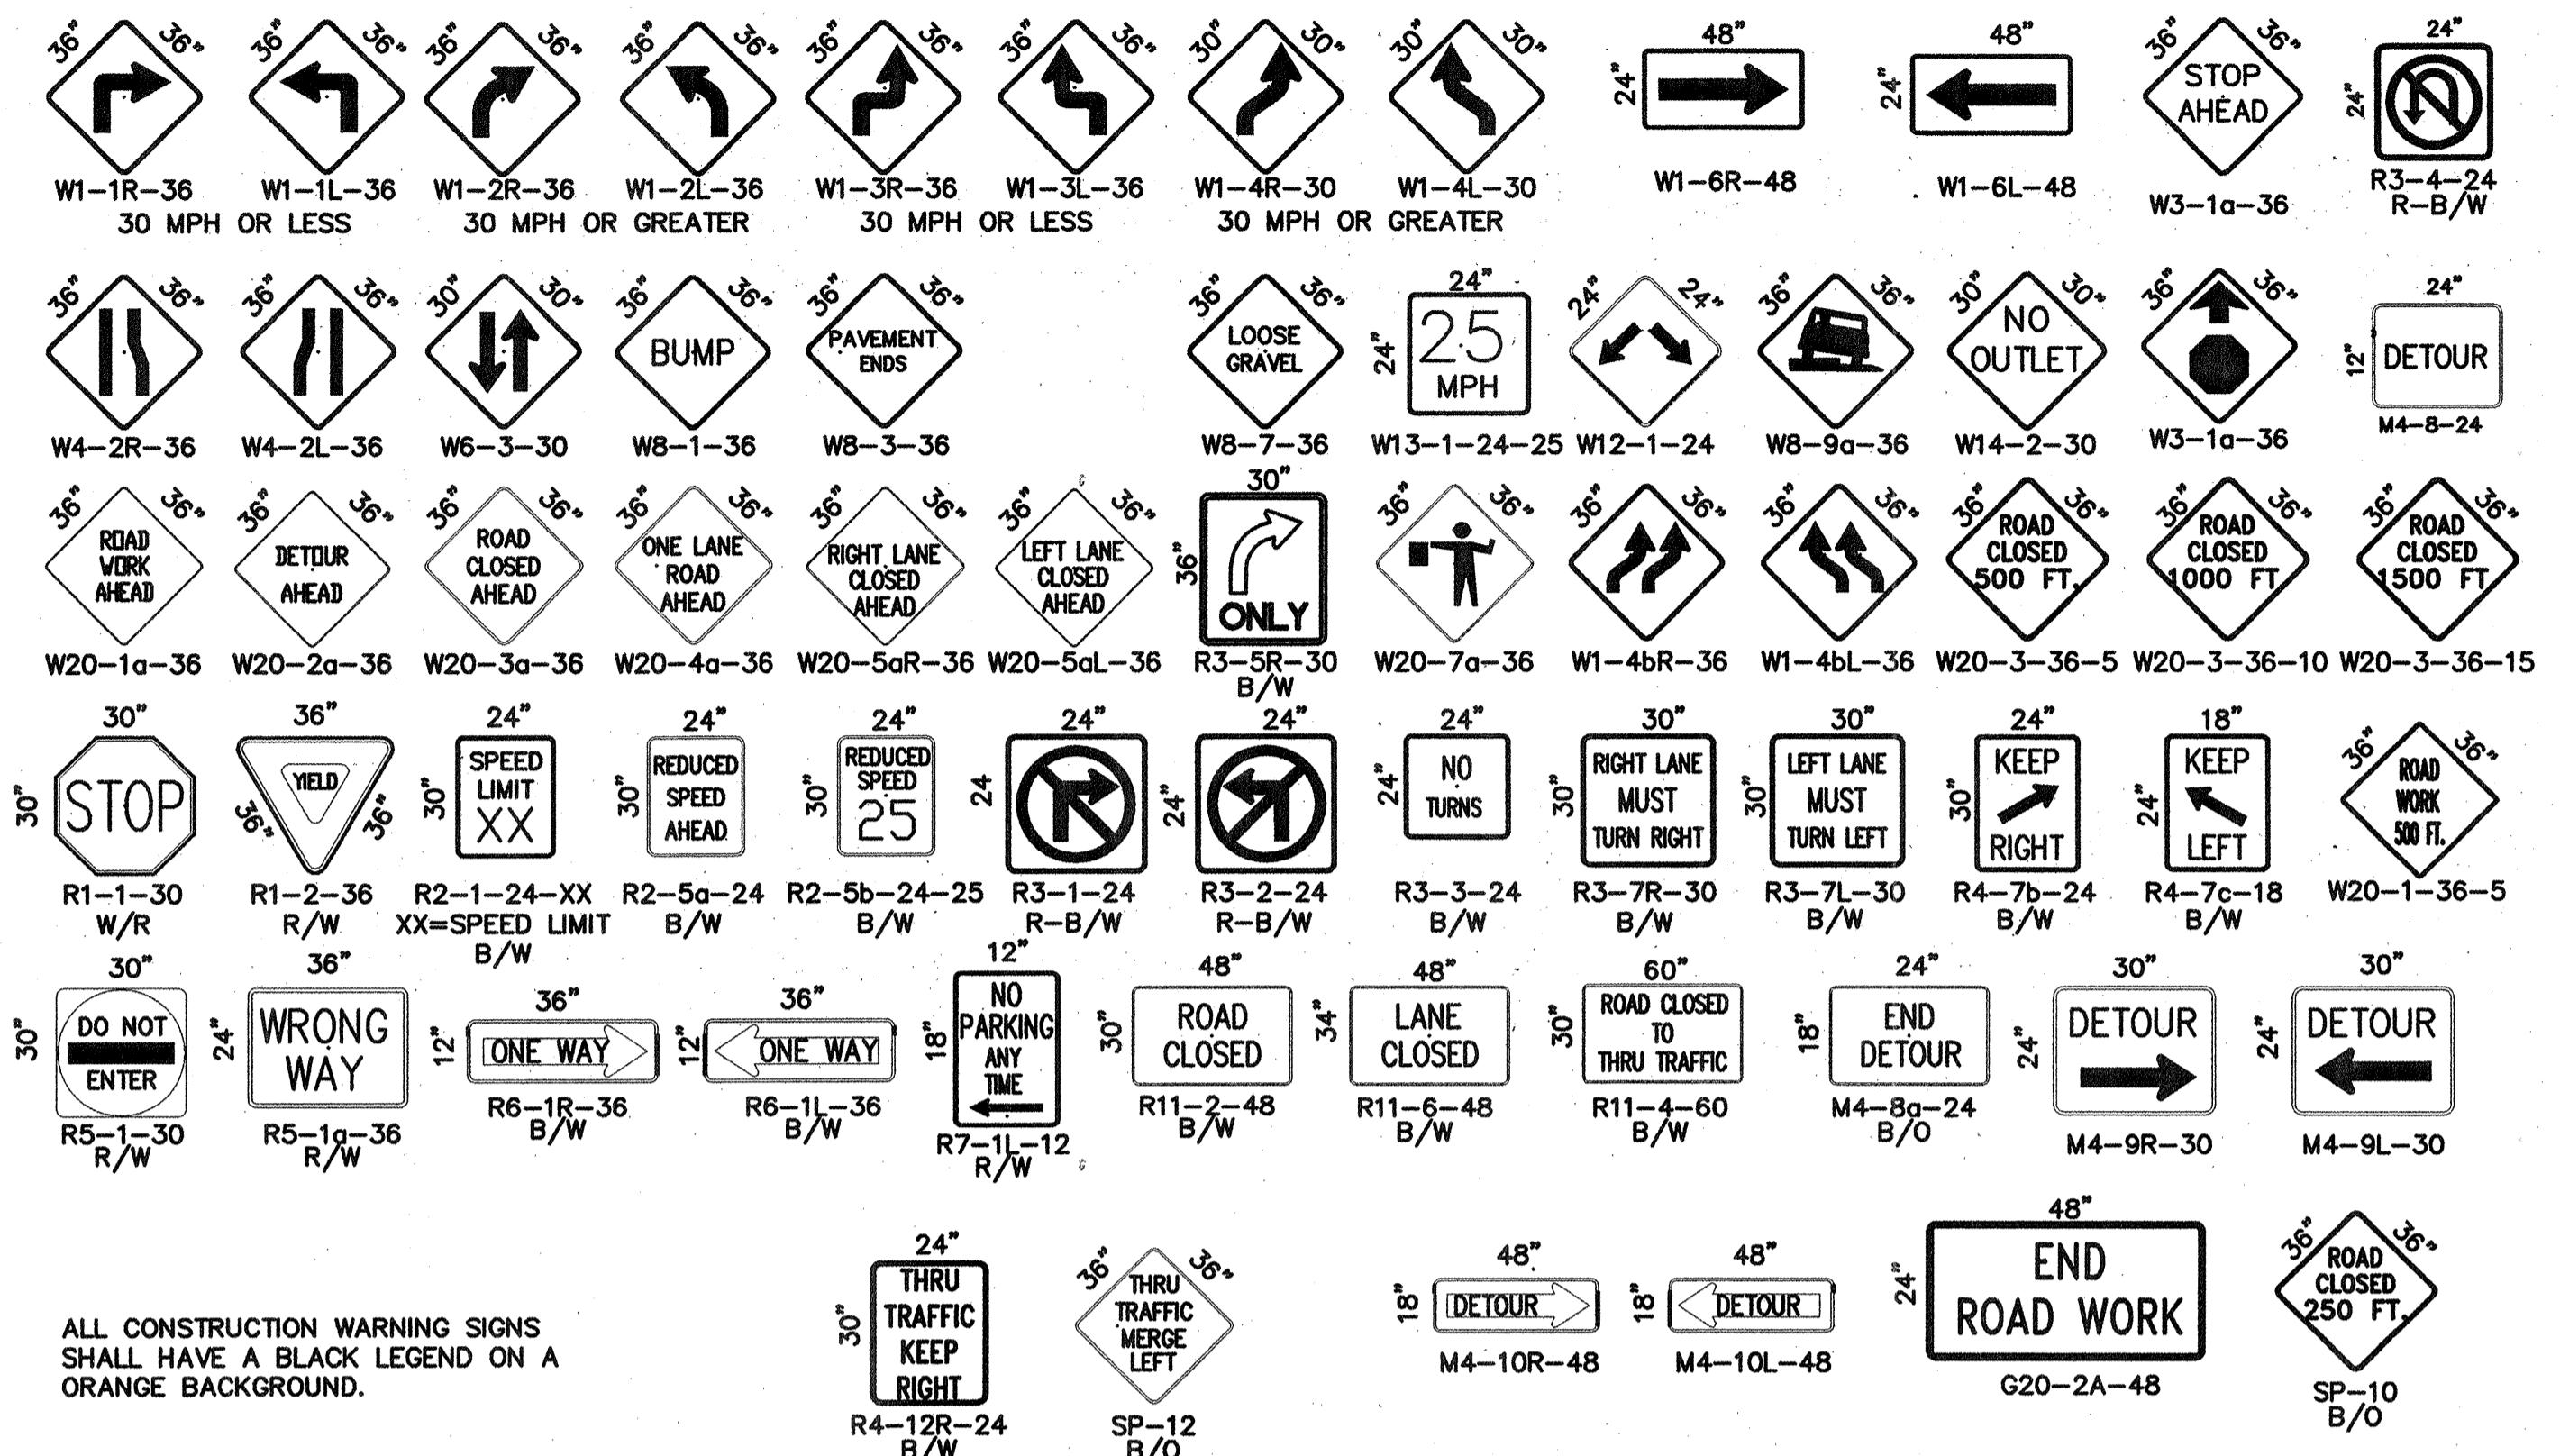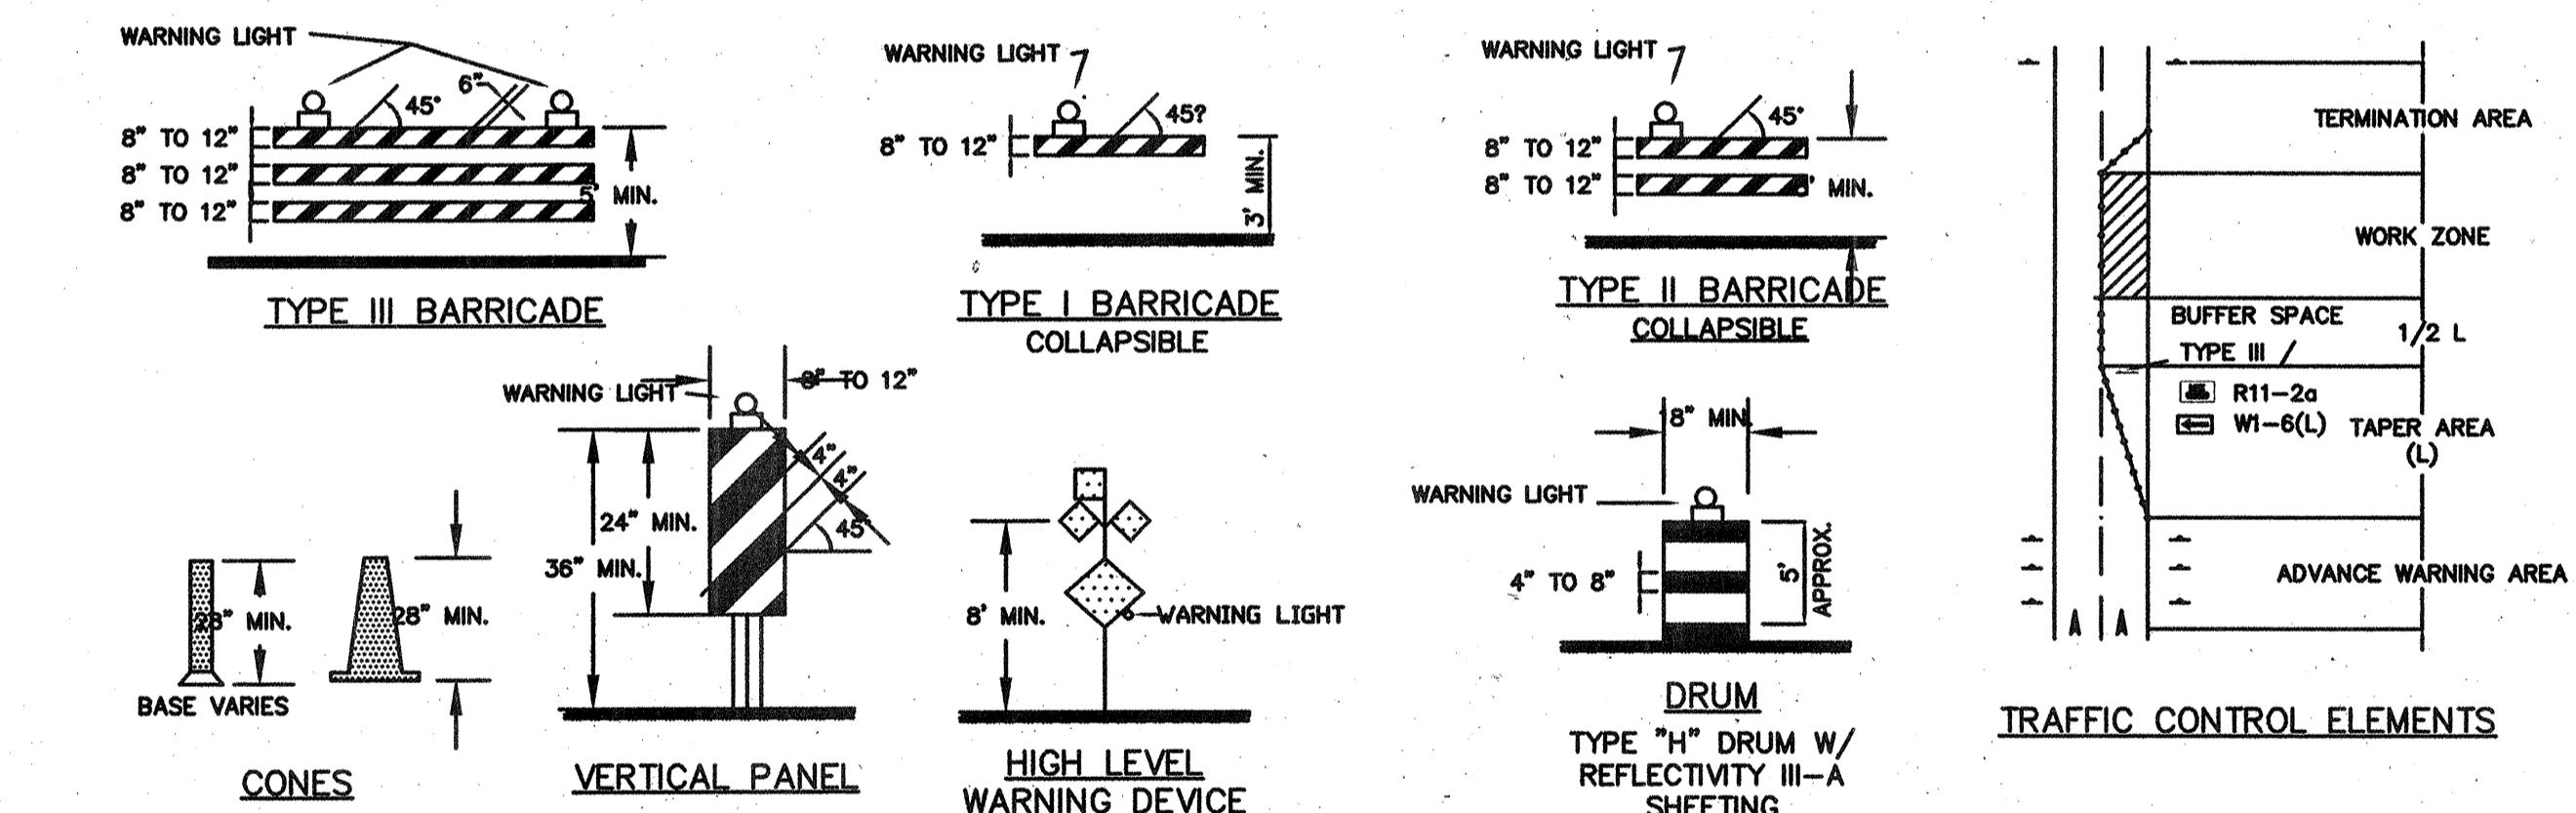ALL CONSTRUCTION WARNING SIGNS  
SHALL HAVE A BLACK LEGEND ON A  
ORANGE BACKGROUND.

## RECORD DRAWING

## LEGEND

- WORK AREA
- BARRICADE - TYPE I, TYPE II, OR TYPE "H" DRUM W/  
REFLECTIVITY III-A SHEETING
- BARRICADE - TYPE III
- VERTICAL PANEL
- WARNING SIGN
- DISTANCE BETWEEN SIGNS - A DISTANCE MEASURED IN FEET EQUAL  
TO A VALUE OF TEN TIMES THE SPEED LIMIT OF THE STREET
- FLAGMAN POSITION
- SPACING BETWEEN BARRICADES- A DISTANCE MEASURED IN FEET  
EQUAL TO THE SPEED LIMIT OF THE STREET
- TAPER LENGTH - SEE CHART BELOW

THE TANGENT LENGTH IS EQUAL TO THE TAPER LENGTH FOR A GIVEN STREET.


**Bohanan ▲ Huston**Courtyard | 7800 Jefferson St. NE | Albuquerque, NM 87108-4335  
ENGINEERING ▲ SPATIAL DATA ▲ ADVANCED TECHNOLOGIES

NO.	DESCRIPTION	DATE	BY
REVISIONS			
COUNTY OF BERNALILLO			
CORDERO MESA PHASE I			
INFRASTRUCTURE			
SIGNING & CONSTRUCTION			
TRAFFIC CONTROL STANDARDS			
PROJECT NO. CPN	DRAWN:	DATE:	
727481			
CHECKED:	SCALE:		



## CONSTRUCTION TRAFFIC CONTROL GENERAL NOTES

1. PROJECT IS SUBJECT TO THE REQUIREMENTS OF COUNTY ORDINANCE NO. 95-12 AND COUNTY ORDINANCE NO. 96-3. THE CONTRACTOR IS RESPONSIBLE FOR ACQUIRING ALL PERMITS NECESSARY. CONTRACTOR SHALL CALL 848-1504 FOR MORE INFORMATION.
2. THE CONTRACTOR SHALL SUBMIT A TRAFFIC CONTROL PLAN TO THE COUNTY TRAFFIC CONTROL ADMINISTRATOR AT LEAST 72 HOURS PRIOR TO COMMENCEMENT OF WORK. TRAFFIC CONTROL PLANS SHALL BE PREPARED IN ACCORDANCE WITH THE MANUAL ON UNIFORM TRAFFIC CONTROL DEVICES (MUTCD), LATEST EDITION AND BY CERTIFIED PERSONNEL AND MUST BE APPROVED PRIOR TO COMMENCEMENT OF WORK ON THE PROJECT. CALL 848-1504 FOR FURTHER INFORMATION.
3. A DAILY TRAFFIC CONTROL LOG SHALL BE MAINTAINED BY THE CONTRACTOR REFLECTING THE TYPES AND LOCATIONS OF ALL TRAFFIC CONTROL DEVICES, SIGNS, BARRICADES, ETC. BEING USED ON THE PROJECT IN COMPLIANCE WITH THE APPROVED TRAFFIC CONTROL PLAN. THIS LOG SHALL BE SUBMITTED TO THE BERNALILLO COUNTY TRAFFIC CONTROL ADMINISTRATOR UPON COMPLETION OF THE PROJECT CONSTRUCTION OR WHEN SO REQUESTED BY THE PROJECT MANAGER OR THE BERNALILLO COUNTY TRAFFIC CONTROL ADMINISTRATOR.
4. CONTRACTOR SHALL PROVIDE A WEEKLY CONSTRUCTION ACTIVITY SCHEDULE TO BERNALILLO COUNTY PUBLIC WORKS DIVISION ATTN: PROJECT MANAGER
5. THE CONTRACTOR SHALL FILE A WEEKLY WRITTEN REPORT TO THE TRAFFIC CONTROL ADMINISTRATOR DESCRIBING THE TRAFFIC CONTROL PLAN THAT WILL BE IN EFFECT FOR THE FOLLOWING WEEK.
6. SUBJECT TO THE APPROVED TRAFFIC CONTROL PLAN, AT LEAST ONE LANE SHALL BE OPEN TO TRAFFIC AT ALL TIMES. CONTRACTOR SHALL PROVIDE PROPER SIGNAGE AND FLAGMAN AND SHALL MAINTAIN THE TRAFFIC LANE IN SUCH A MANNER AS TO ASSURE PROPER SAFETY TO THE TRAVELING PUBLIC AT ALL TIMES, EXCEPT WHEN GRADING, EXCAVATION AND BACKFILL OPERATIONS ARE BEING CONDUCTED IMMEDIATELY IN FRONT OF THE PROPERTY, IN WHICH CASE ACCESS WILL NOT BE DENIED FOR MORE THAN 4 HOURS WITHOUT APPROVAL BY THE COUNTY.
7. TRAFFIC LANES PROVIDED DURING CONSTRUCTION SHALL BE MAINTAINED IN SUCH A CONDITION UNDER ALL WEATHER CONDITIONS, SO AS TO PERMIT THE REASONABLE PASSAGE OF PASSENGER VEHICLES, AND SHALL BE KEPT GRADED AND SMOOTH, AND WATERED SEVERAL TIMES DAILY TO CONTROL DUST.
8. TYPICAL TRAFFIC CONTROL PLANS DO NOT REFLECT THE EXISTING TOPOGRAPHY SUCH AS DRIVEWAYS, LANE WIDTHS, AND BUSINESS/RESIDENTIAL ACCESSES. EVERY LOCATION THAT REQUIRES CONSTRUCTION TRAFFIC CONTROL SHALL HAVE A DETAILED TRAFFIC CONTROL PLAN SHOWING ALL EXISTING TOPOGRAPHY.
9. CONSTRUCTION SHALL NOT BEGIN UNLESS A TRAFFIC CONTROL PLAN HAS BEEN APPROVED AND VERIFIED BY BERNALILLO COUNTY TRAFFIC ENGINEERING.
10. ALL CONSTRUCTION TRAFFIC CONTROL DEVICES SHALL COMPLY WITH THE MANUAL ON UNIFORM TRAFFIC CONTROL DEVICES (MUTCD), LATEST EDITION. IT IS THE RESPONSIBILITY OF THE CONTRACTOR TO INSTALL, SERVICE AND MAINTAIN ALL TRAFFIC CONTROL DEVICES. TRAFFIC CONTROL DEVICES SHALL NOT BE REMOVED OR ALTERED IN ANY WAY WITHOUT THE APPROVAL OF THE COUNTY TRAFFIC CONTROL ADMINISTRATOR, PER SECTION 6A-4 OF THE MUTCD, LATEST EDITION.
11. THE CONSTRUCTION TRAFFIC CONTROL INITIAL SET-UP FOR EACH PHASE SHALL BE BY AN AMERICAN TRAFFIC SAFETY SERVICES ASSOCIATION (ATSSA) CERTIFIED WORKSITE TRAFFIC SUPERVISOR. THE MAINTENANCE AND SERVICING SHALL ALSO BE DONE BY AN ATSSA CERTIFIED WORKSITE TRAFFIC SUPERVISOR OR EQUIVALENT.
12. CONTRACTOR IS RESPONSIBLE TO MAINTAIN AND SERVICE ALL TRAFFIC CONTROL DEVICES 24 HOURS A DAY, 7 DAYS A WEEK THROUGHOUT LENGTH OF PROJECT. CONTRACTOR IS RESPONSIBLE THAT ALL TRAFFIC CONTROL DEVICES COMPLY WITH THE MUTCD, LATEST EDITION.
13. ALL ADVANCE WARNING SIGNS SHALL BE DOUBLE INDICATED WHENEVER THERE ARE MULTI-LANE TRAFFIC IN ANY ONE GIVEN DIRECTION AND THERE IS SUFFICIENT MEDIAN SPACE.
14. ALL BARRICADES IN ALL TAPERS AND TANGENTS SHALL BE PLACED APART, A DISTANCE MEASURED IN FEET, EQUAL TO THAT OF THE POSTED SPEED LIMIT. NO EXCEPTIONS UNLESS APPROVED BY BERNALILLO COUNTY TRAFFIC ENGINEERING PER MUTCD SECTION 6A-4.
15. ALL WORK IN ARTERIAL ROADWAYS SHALL BE ON A CONTINUOUS 24 HOUR PER DAY BASIS UNTIL COMPLETED.
16. EQUIPMENT OR MATERIALS SHALL NOT BE STORED WITHIN 15 FEET OF A TRAVELED TRAFFIC LANE DURING NON-WORKING HOURS WITHOUT THE APPROVAL OF BERNALILLO COUNTY TRAFFIC ENGINEERING.

17. CONTRACTOR SHALL PROVIDE AND MAINTAIN A SAFE AND ADEQUATE MEANS OF CHANNELIZING PEDESTRIAN TRAFFIC AROUND AND THROUGH THE CONSTRUCTION AREA.
18. CONTRACTOR IS RESPONSIBLE FOR OBLITERATION OF ANY CONFLICTING STRIPING AND RESPONSIBLE FOR ALL TEMPORARY STRIPING.
19. CONTRACTOR SHALL MAINTAIN ACCESS TO ALL FACILITIES, BUSINESSES AND/OR RESIDENTS AT ALL TIMES.
20. CONTRACTOR SHALL PROVIDE ACCESS SIGNS FOR BUSINESSES LOCATED WITHIN THE CONSTRUCTION AREA UNDER THE SUPERVISION OF BERNALILLO COUNTY TRAFFIC ENGINEERING. EACH ACCESS SIGN SHALL HAVE 5 INCH, WHITE LETTERING ON BLUE BACKGROUND. SHOPPING CENTERS AND MALLS SHALL BE LISTED AS SUCH.
21. 48 HOURS PRIOR TO OCCUPYING OR CLOSING OF A RIGHT-OF-WAY, CONTRACTOR SHALL NOTIFY: POLICE, FIRE DEPARTMENT, SCHOOLS, HOSPITALS, TRANSIT AUTHORITY, BUSINESSES AND/OR RESIDENTS THAT WILL BE AFFECTED BY THE CONSTRUCTION.
22. ANY FIELD ADJUSTMENTS SHALL BE APPROVED BY BERNALILLO COUNTY TRAFFIC ENGINEERING.
23. EXCAVATIONS SHALL BE PLATED, TEMPORARILY PATCHED OR RESURFACED PRIOR TO OPENING OF TRAFFIC. A MINIMUM OF 11 FEET, SHALL BE PROVIDED FOR TRAFFIC IN ANY GIVEN DIRECTION. CONTRACTOR IS RESPONSIBLE FOR ANY WORK INVOLVED IN SATISFYING THESE REQUIREMENTS.
24. THE CONTRACTOR SHALL CONTACT BERNALILLO COUNTY TRAFFIC ENGINEER (848-1575) BEFORE REMOVING AND/OR INSTALLING ANY TRAFFIC SIGNS OR PERMANENT STRIPING AND MARKINGS. ALL STRIPING, PAVEMENT MARKINGS INCLUDING CROSSWALKS, LEGENDS AND SYMBOLS ARE TO BE CONSTRUCTED OF DURABLE PAINT IN ACCORDANCE WITH THE MANUAL ON UNIFORM TRAFFIC CONTROL DEVICES (MUTCD) LATEST EDITION. ANY PAVEMENT MARKINGS AND SIGNS REMOVED OR DAMAGED DURING CONSTRUCTION SHALL BE REPLACED AT EXISTING LOCATIONS. SUCH WORK SHALL BE CONSIDERED INCIDENTAL TO CONSTRUCTION OF THE PROJECT.

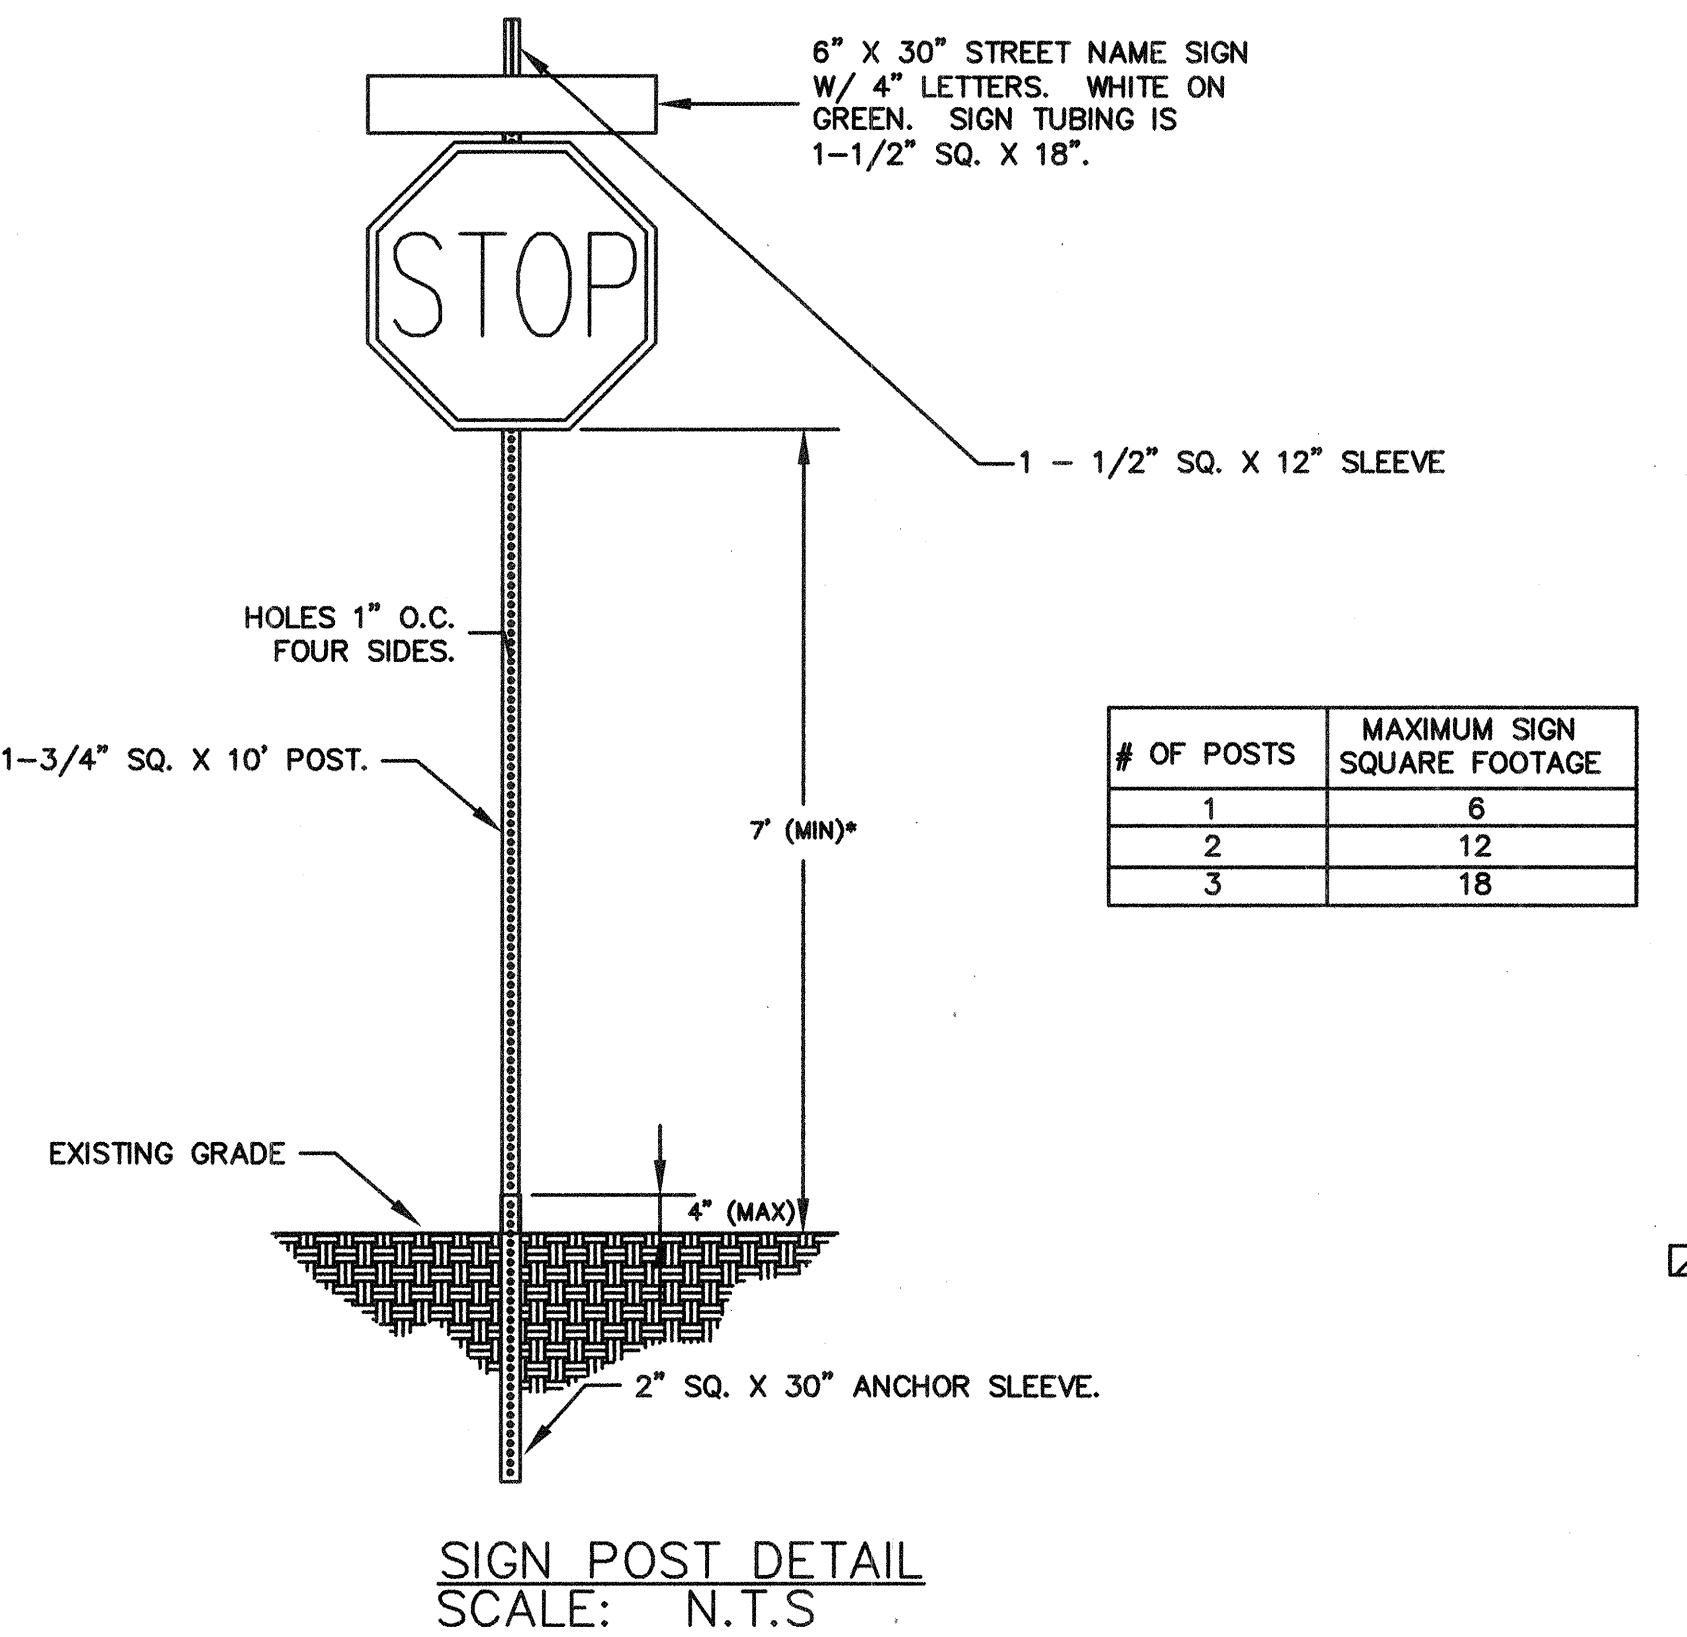

\*SEE MUTCD FOR MINIMUM MOUNTING HEIGHT IN RURAL AREAS

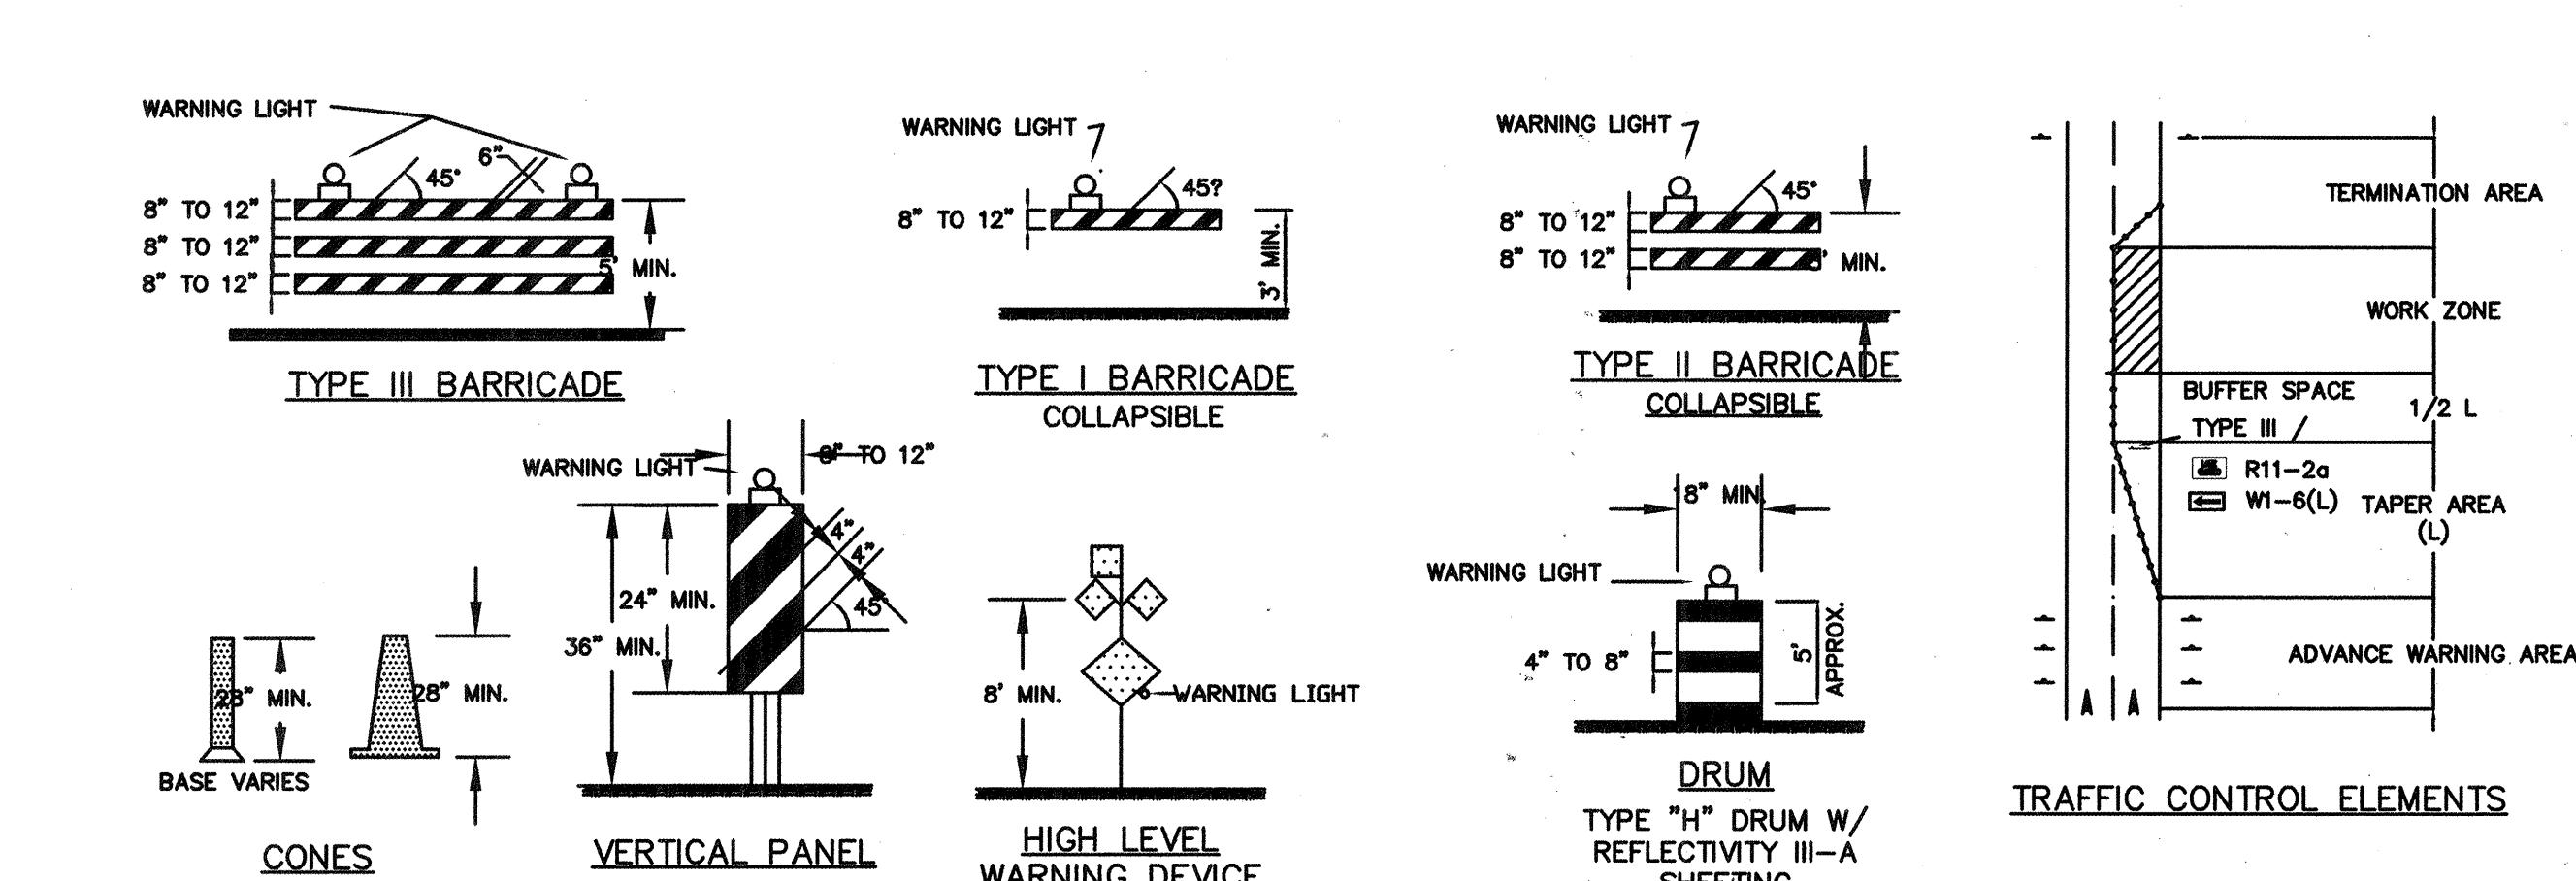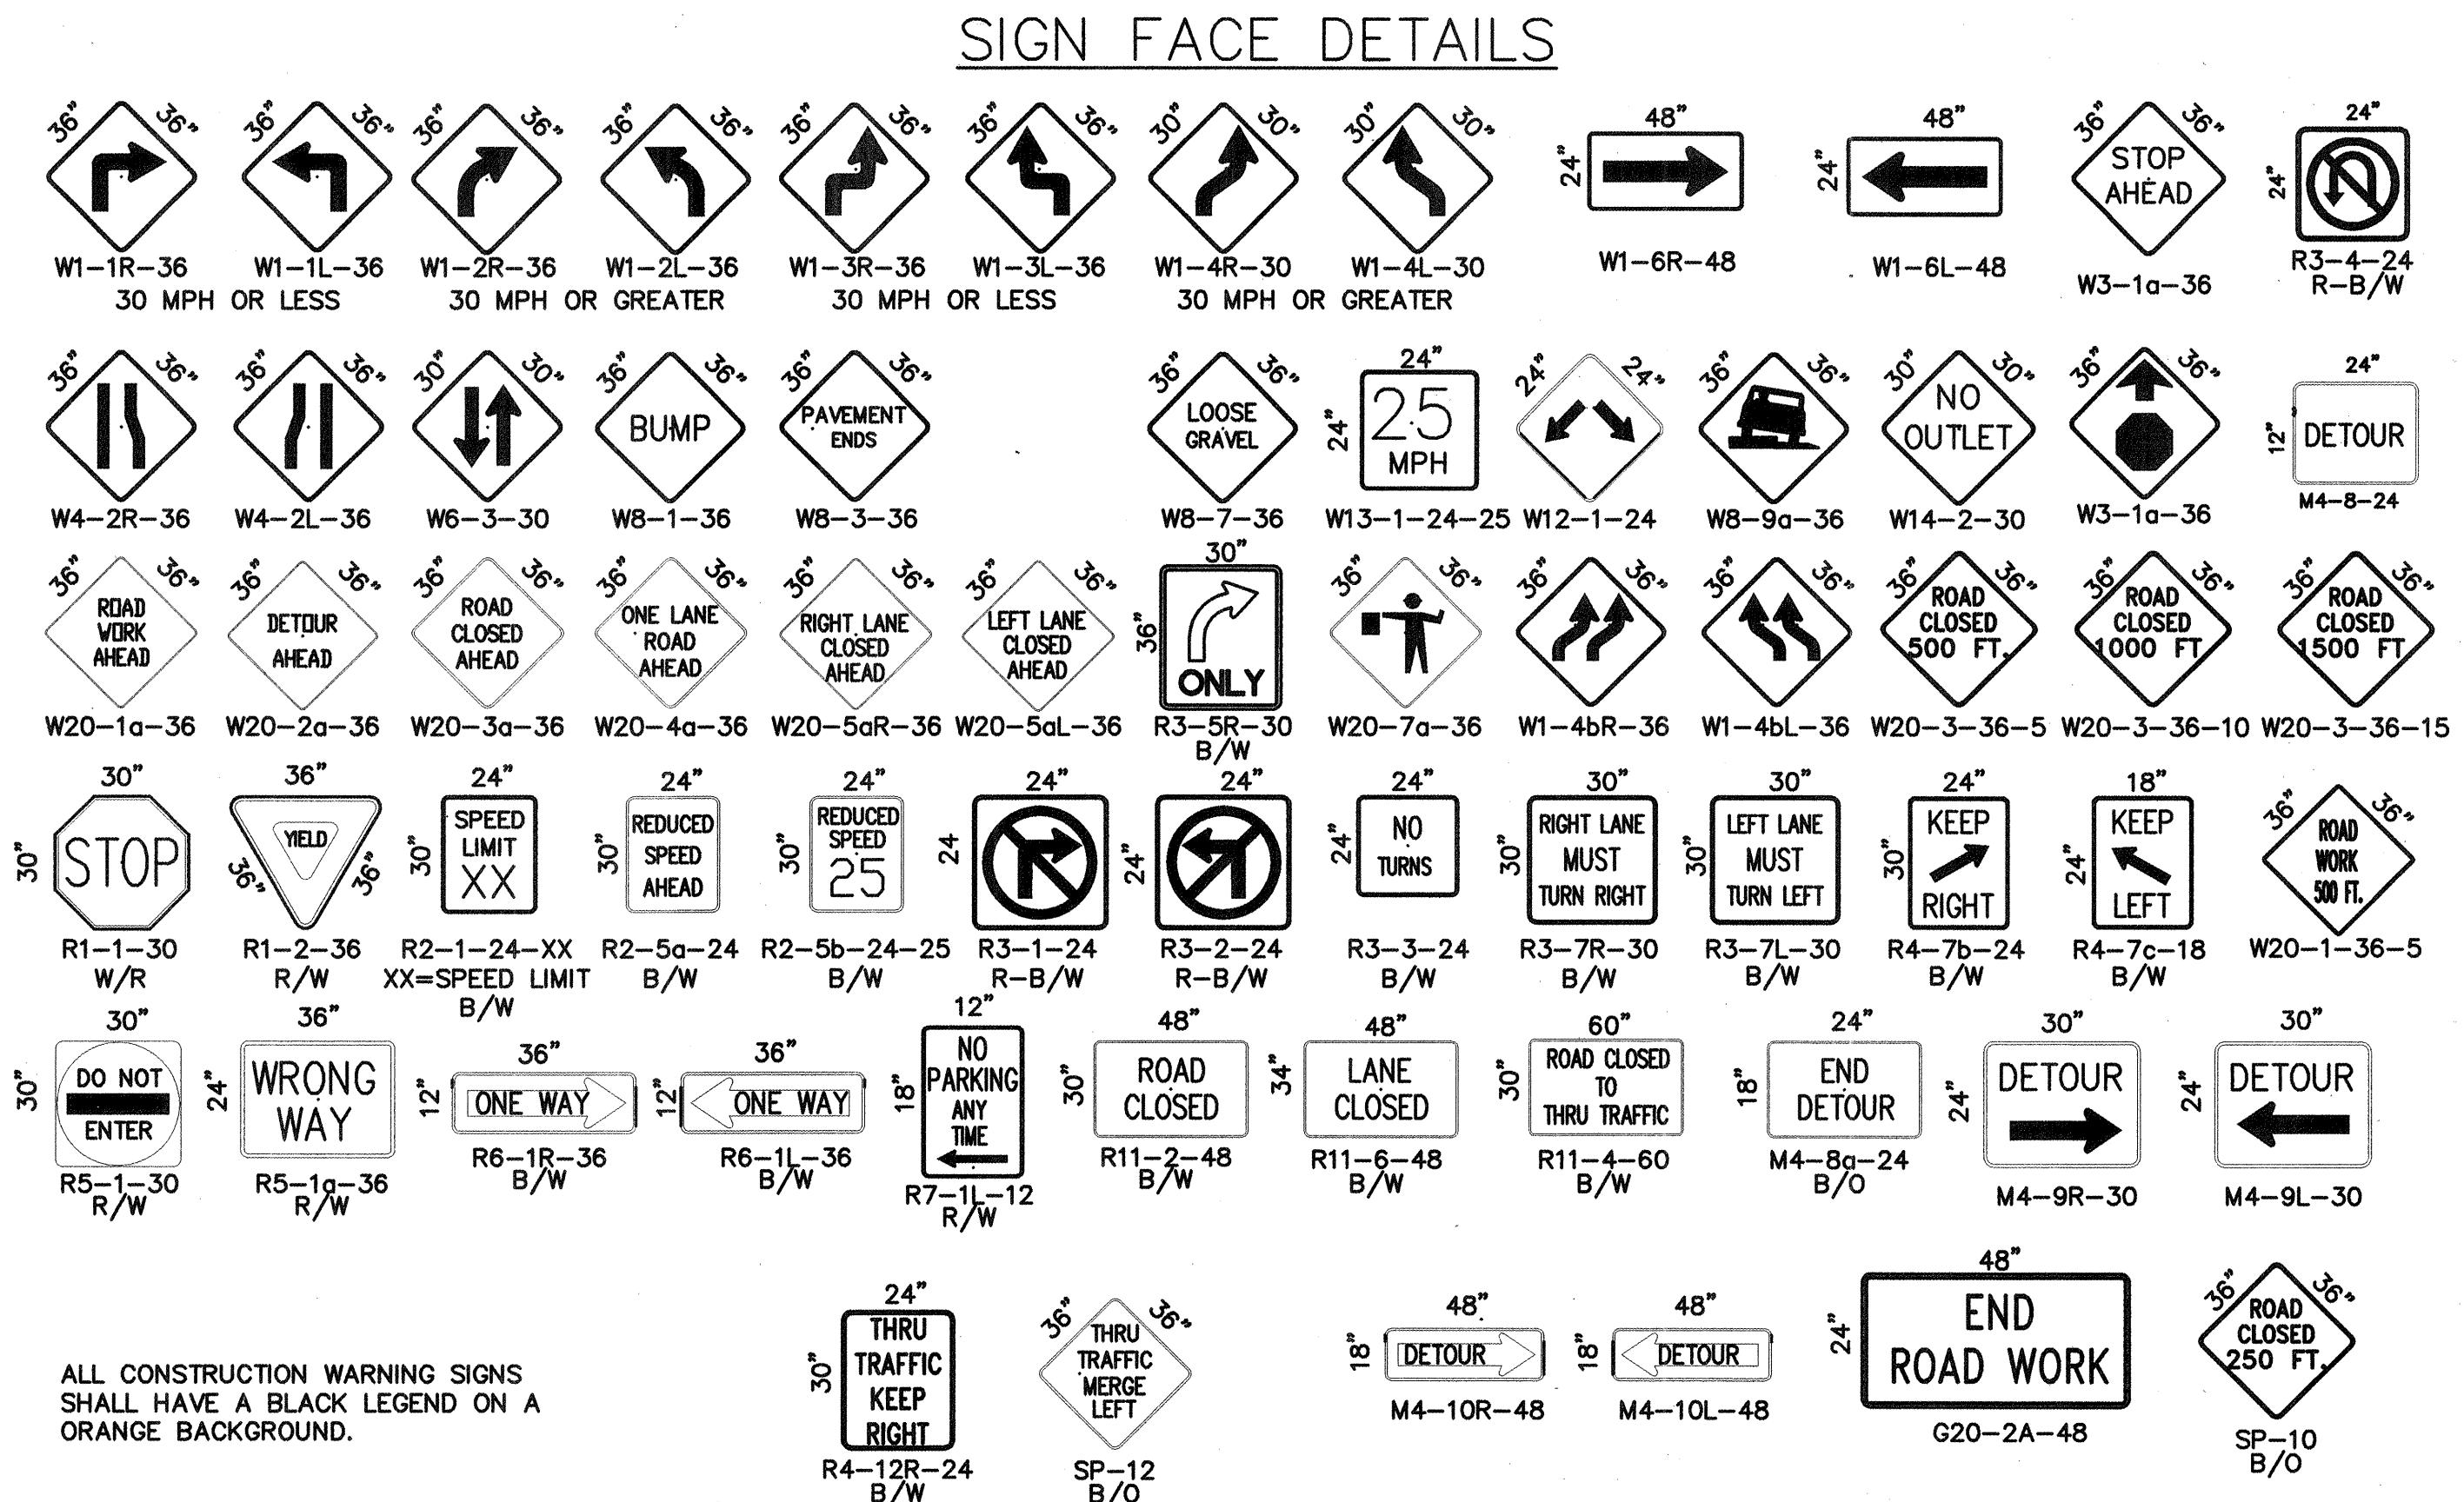

## RECORD DRAWING


### LEGEND

- WORK AREA
- BARRICADE - TYPE I, TYPE II, OR TYPE "H" DRUM W/ REFLECTIVITY III-A SHEETING
- BARRICADE - TYPE III
- VERTICAL PANEL
- △ WARNING SIGN
- D DISTANCE BETWEEN SIGNS - A DISTANCE MEASURED IN FEET EQUAL TO A VALUE OF TEN TIMES THE SPEED LIMIT OF THE STREET
- FLAGMAN POSITION
- S SPACING BETWEEN BARRICADES - A DISTANCE MEASURED IN FEET EQUAL TO THE SPEED LIMIT OF THE STREET
- L TAPER LENGTH - SEE CHART BELOW

THE TAPER LENGTH IS EQUAL TO THE TAPER LENGTH FOR A GIVEN STREET.

NO.	DESCRIPTION	DATE	BY
REVISIONS			
COUNTY OF BERNALILLO			
CORDERO MESA PHASE I INFRASTRUCTURE SIGNING & CONSTRUCTION TRAFFIC CONTROL STANDARDS			
PROJECT NO.	CPN	DRAWN:	DATE:
727481		CHECKED:	SCALE:



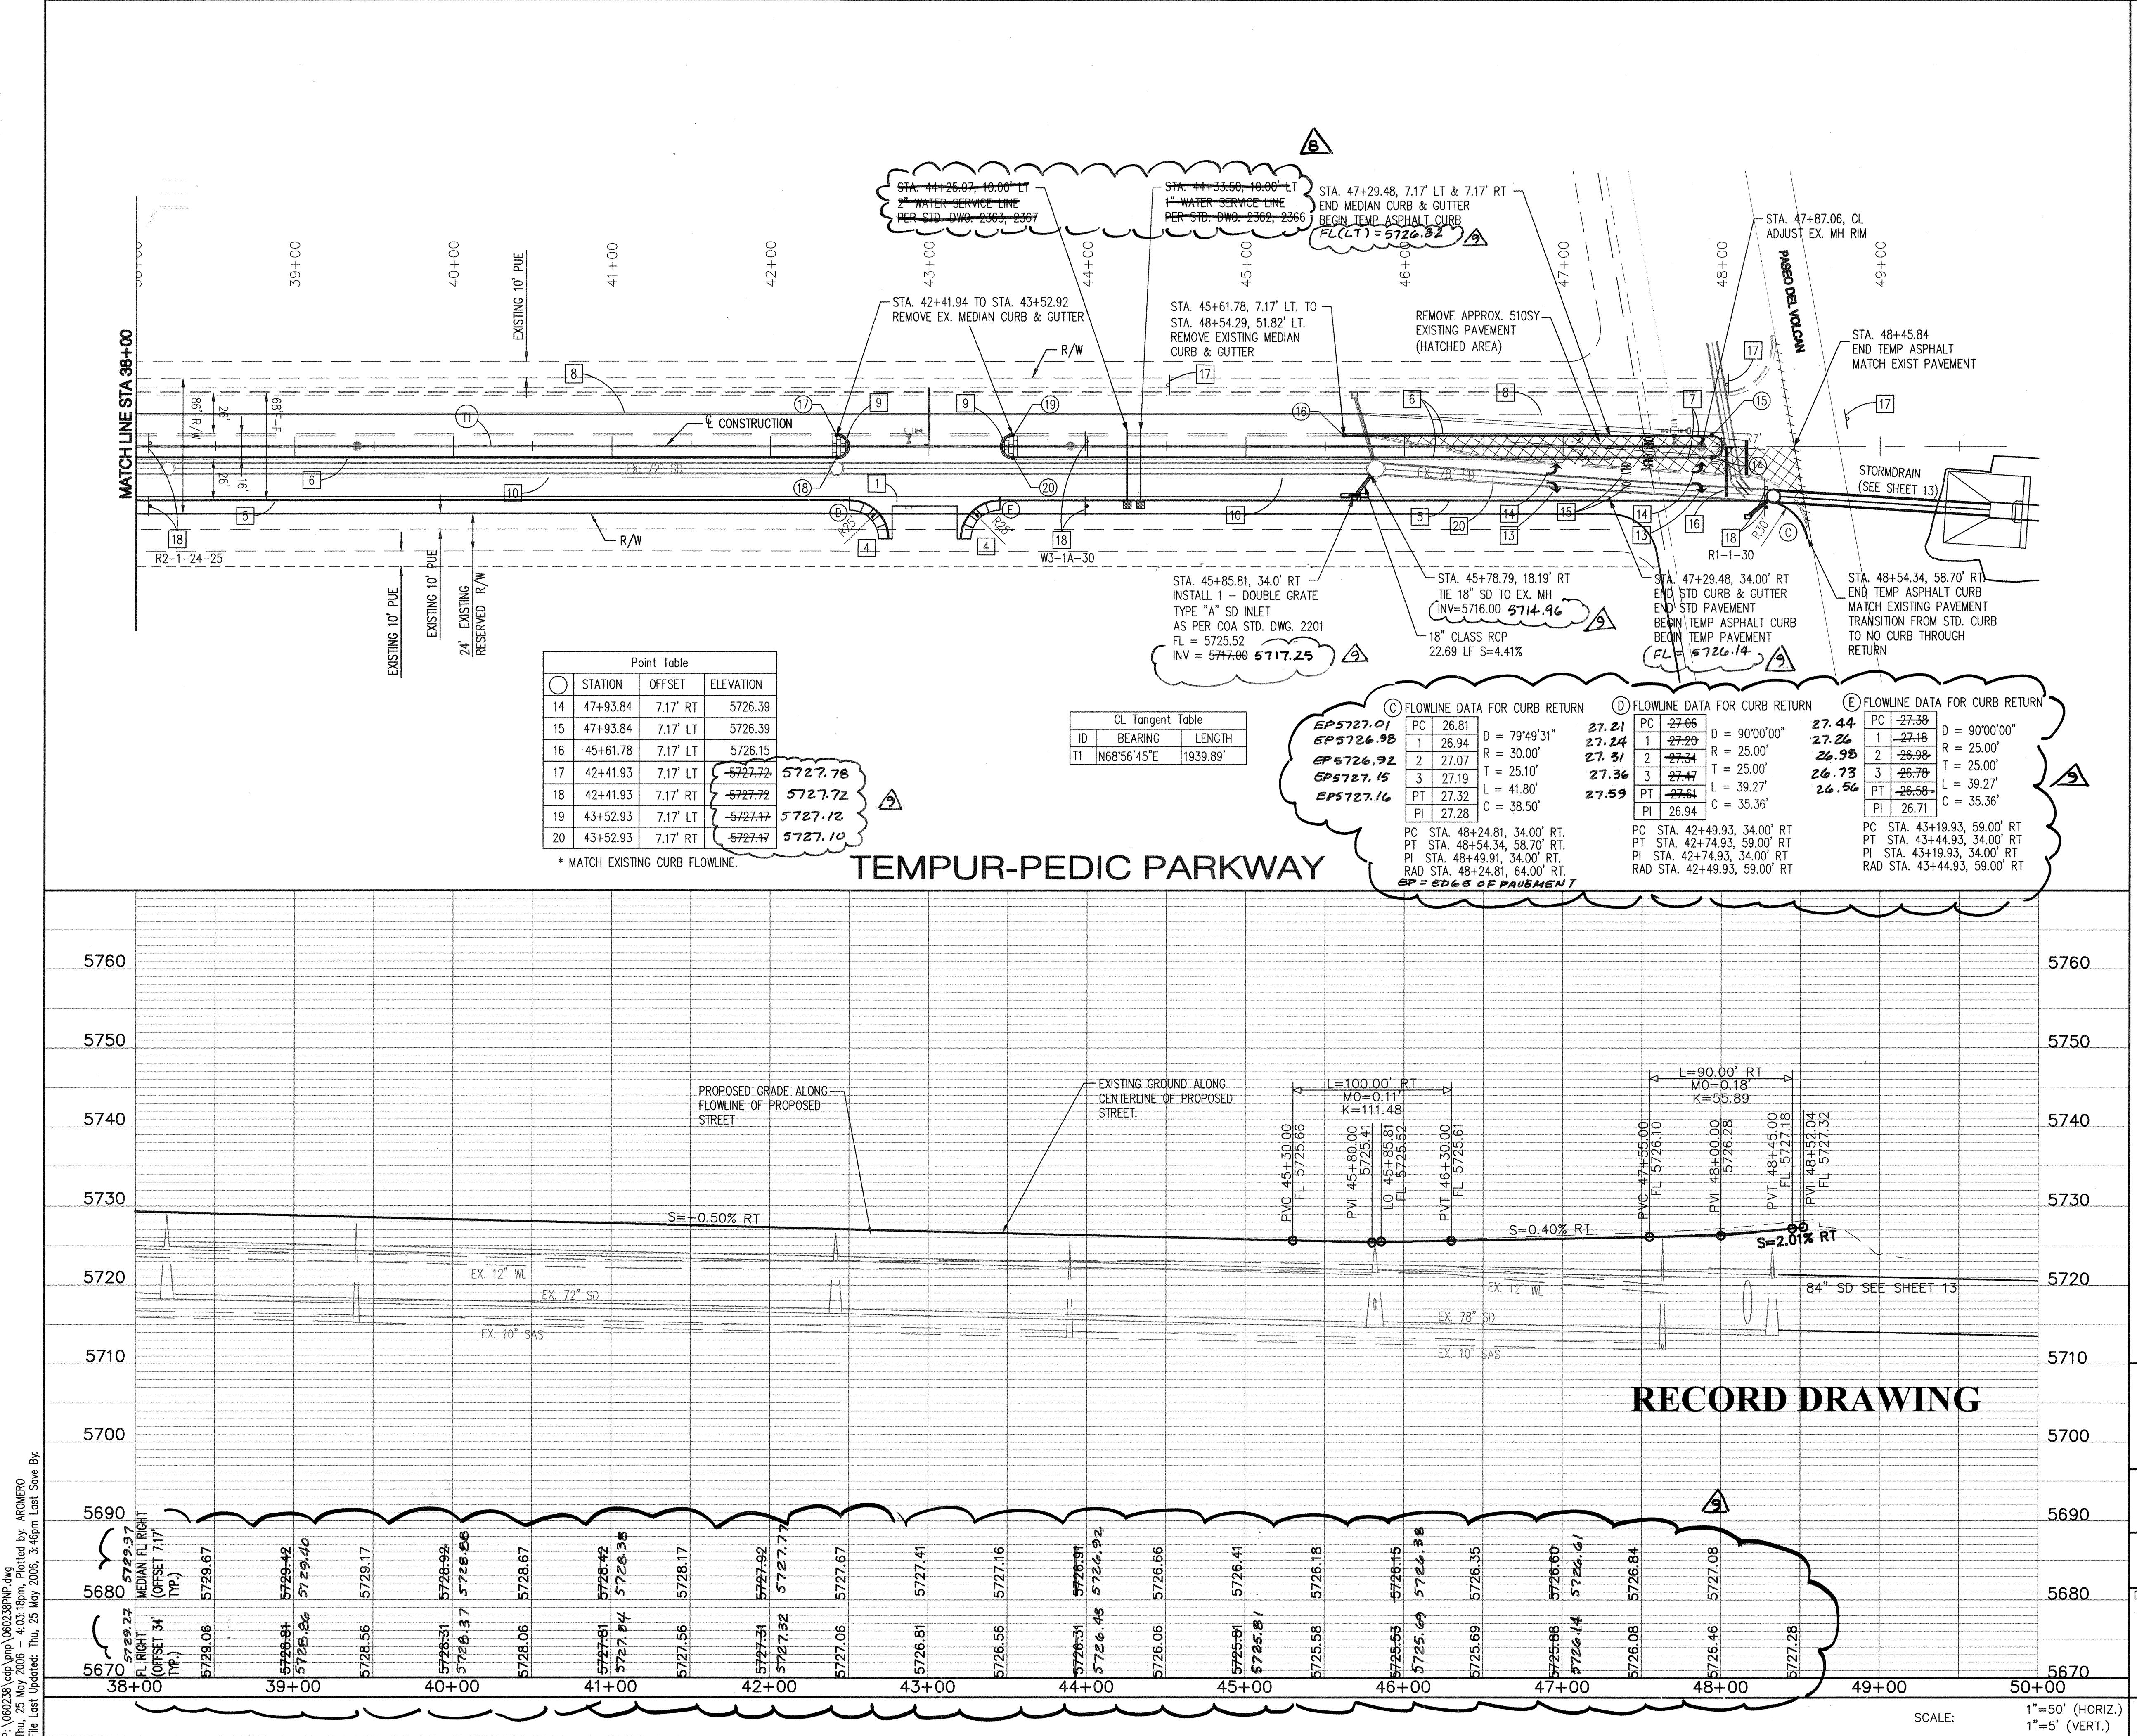


**NOTES**

1. THE CONTRACTOR SHALL FIELD VERIFY ALL EXISTING UTILITY LOCATIONS AND NOTIFY THE ENGINEER IMMEDIATELY OF ANY DISCREPANCIES.
2. ALL CURB RETURN RADII SHALL BE 30' UNLESS OTHERWISE SPECIFIED.
3. ALL CURVE DATA AND DIMENSIONS REFER TO FACE OF CURB UNLESS OTHERWISE SPECIFIED.
4. GRADE ELEVATIONS, WHERE NOTED, ARE FOR TOP OF STANDARD CURB UNLESS OTHERWISE SPECIFIED.
5. CONTRACTOR IS TO INSTALL A 4"x 4"x 5' POST AND EMD AT THE END OF EACH SANITARY SEWER SERVICE.
6. CONTRACTOR IS RESPONSIBLE FOR REPAIR AND/OR REPLACEMENT OF ALL UTILITY CONDUITS AND EXISTING LINES.
7. ANY ADDITIONAL GRADING REQUIRED TO MATCH PROPOSED STREET GRADES SHALL BE INCIDENTAL TO PAVING ITEMS.
8. CONTRACTOR SHALL PROVIDE THE INSPECTORS (CITY AND PRIVATE) WITH THE PROPOSED HYDROSTATIC TESTING PLAN. THE PLAN MUST BE APPROVED BEFORE TESTING OPERATIONS BEGIN.
9. CONTRACTOR SHALL PARK EQUIPMENT AND VEHICLES AS NOT TO INTERFERE WITH NORMAL ACTIVITIES OF RESIDENTS OR OTHER CONTRACTORS ON SITE.
10. ANY DAMAGE TO THE EXISTING FACILITIES (CURB & GUTTER, PAVEMENT, CONDUITS, LANDSCAPING, UTILITY LINES ETC.) DURING CONSTRUCTION SHALL BE REPLACED AT THE CONTRACTORS' EXPENSE.
11. REMOVAL OF THE EXISTING CURB & GUTTER SHALL BE AS PER COA STD. DWG. 2415 (SAWC ONLY).
12. WHEELCHAIR RAMPS SHALL BE CONSTRUCTED PRIOR TO ACCEPTANCE OF CURB & GUTTER.
13. STRIPING ERADICATION SHALL BE ACCOMPLISHED BY WATER BLASTING OR SURFACE PLANING OF THE ROADWAY, TO A MAX. DEPTH OF 1/4" AND A WIDTH EQUAL TO TWICE THE WIDTH OF THE STRIPE OR MARKING TO BE REMOVED.
14. ELECTRONIC MARKER DISKS (EMD) WILL BE PLACED ACCORDING TO SECTION 170 OF THE CITY OF ALBUQUERQUE STANDARD SPECIFICATIONS FOR PUBLIC WORKS CONSTRUCTION, 1986 EDITION AS REVISED THROUGH UPDATE #7.
15. ALL WATER VALVE BOXES MANHOLES IN THE STREET CONSTRUCTION ARE TO BE ADJUSTED TO FINISH GRADE AND WILL BE MEASURED AND PAID PER EACH.

**KEY NOTES**

1. INSTALL 6' CONCRETE VALLEY GUTTER AS PER STD. DWG. 2420
2. INSTALL 4' CONCRETE VALLEY GUTTER AS PER STD. DWG. 2421
3. INSTALL 12' CONCRETE VALLEY GUTTER AS PER STD. DWG. 2422
4. INSTALL WHEELCHAIR RAMP AS PER DETAIL SHEET 5
5. STD. CURB & GUTTER AS PER STD. DWG. 2415A
6. MEDIAN CURB & GUTTER AS PER STD. DWG. 2415B
7. TEMPORARY ASPHALT CURB AS PER STD. DWG. 2415B
8. INSTALL NEW 4" DASHED WHITE REFLECTORIZED PAINTED MARKING (10' LINE, 30' SPACE) STA 34+83 TO STA 47+93
9. BUILD 4' TEXTURED MEDIAN PAVEMENT FROM MEDIAN NOSE TO 10' FROM NOSE. MEDIAN NOSES SHALL BE PAINTED YELLOW TO APPROX. 6' BEHIND PC/P.T. FOR COA STD DWG 2408
10. INSTALL NEW 4" DASHED WHITE REFLECTORIZED PAINTED MARKING (10' LINE, 30' SPACE) STA 34+41 TO STA 45+93
11. INSTALL NEW 4" SOLID YELLOW REFLECTORIZED PAINTED MARKING (20' APART, 45° ANGLE)
12. INSTALL NEW 4" SOLID YELLOW REFLECTORIZED PAINTED MARKING (20' APART, 45° ANGLE)
13. INSTALL NEW REFLECTIVE PREFORMED PLASTIC PAVEMENT MARKING RIGHT ARROW
14. INSTALL NEW REFLECTIVE PREFORMED PLASTIC PAVEMENT MARKING LEFT ARROW
15. INSTALL NEW REFLECTIVE PREFORMED PLASTIC PAVEMENT MARKING ONLY
16. 12' SOLID WHITE REFLECTIVE STOP BAR STRIPE
17. EXISTING SIGN TO ROMAN
18. RELOCATE EXISTING SIGN
19. INSTALL NEW PI-1-30 STOP SIGN SEE DETAIL SHEET 5
20. INSTALL NEW 4" SOLID WHITE REFLECTORIZED PAINTED MARKING STA 45+93 TO STA 47+93

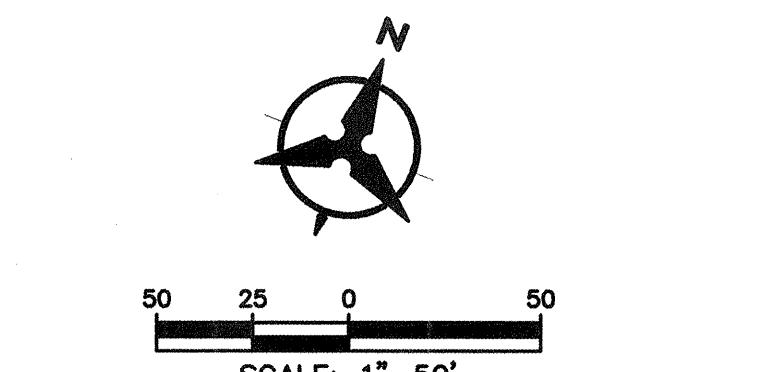

**Bohannan Huston Inc.**  
Courtyard I 7500 Jefferson St. NE Albuquerque, NM 87109-4335  
ENGINEERING □ SPATIAL DATA □ ADVANCED TECHNOLOGIES

**County of Bernalillo Public Works Division State of New Mexico**

CORDERO MESA, PHASE I INFRASTRUCTURE  
PAVING PLAN & PROFILE

TEMPUR-PEDIC PARKWAY STA 38+00 TO EOP




Design Review Committee	Engineer Approval
APPROVED	SIGNED

City Engineer



RECEIVED

RECEIVED</




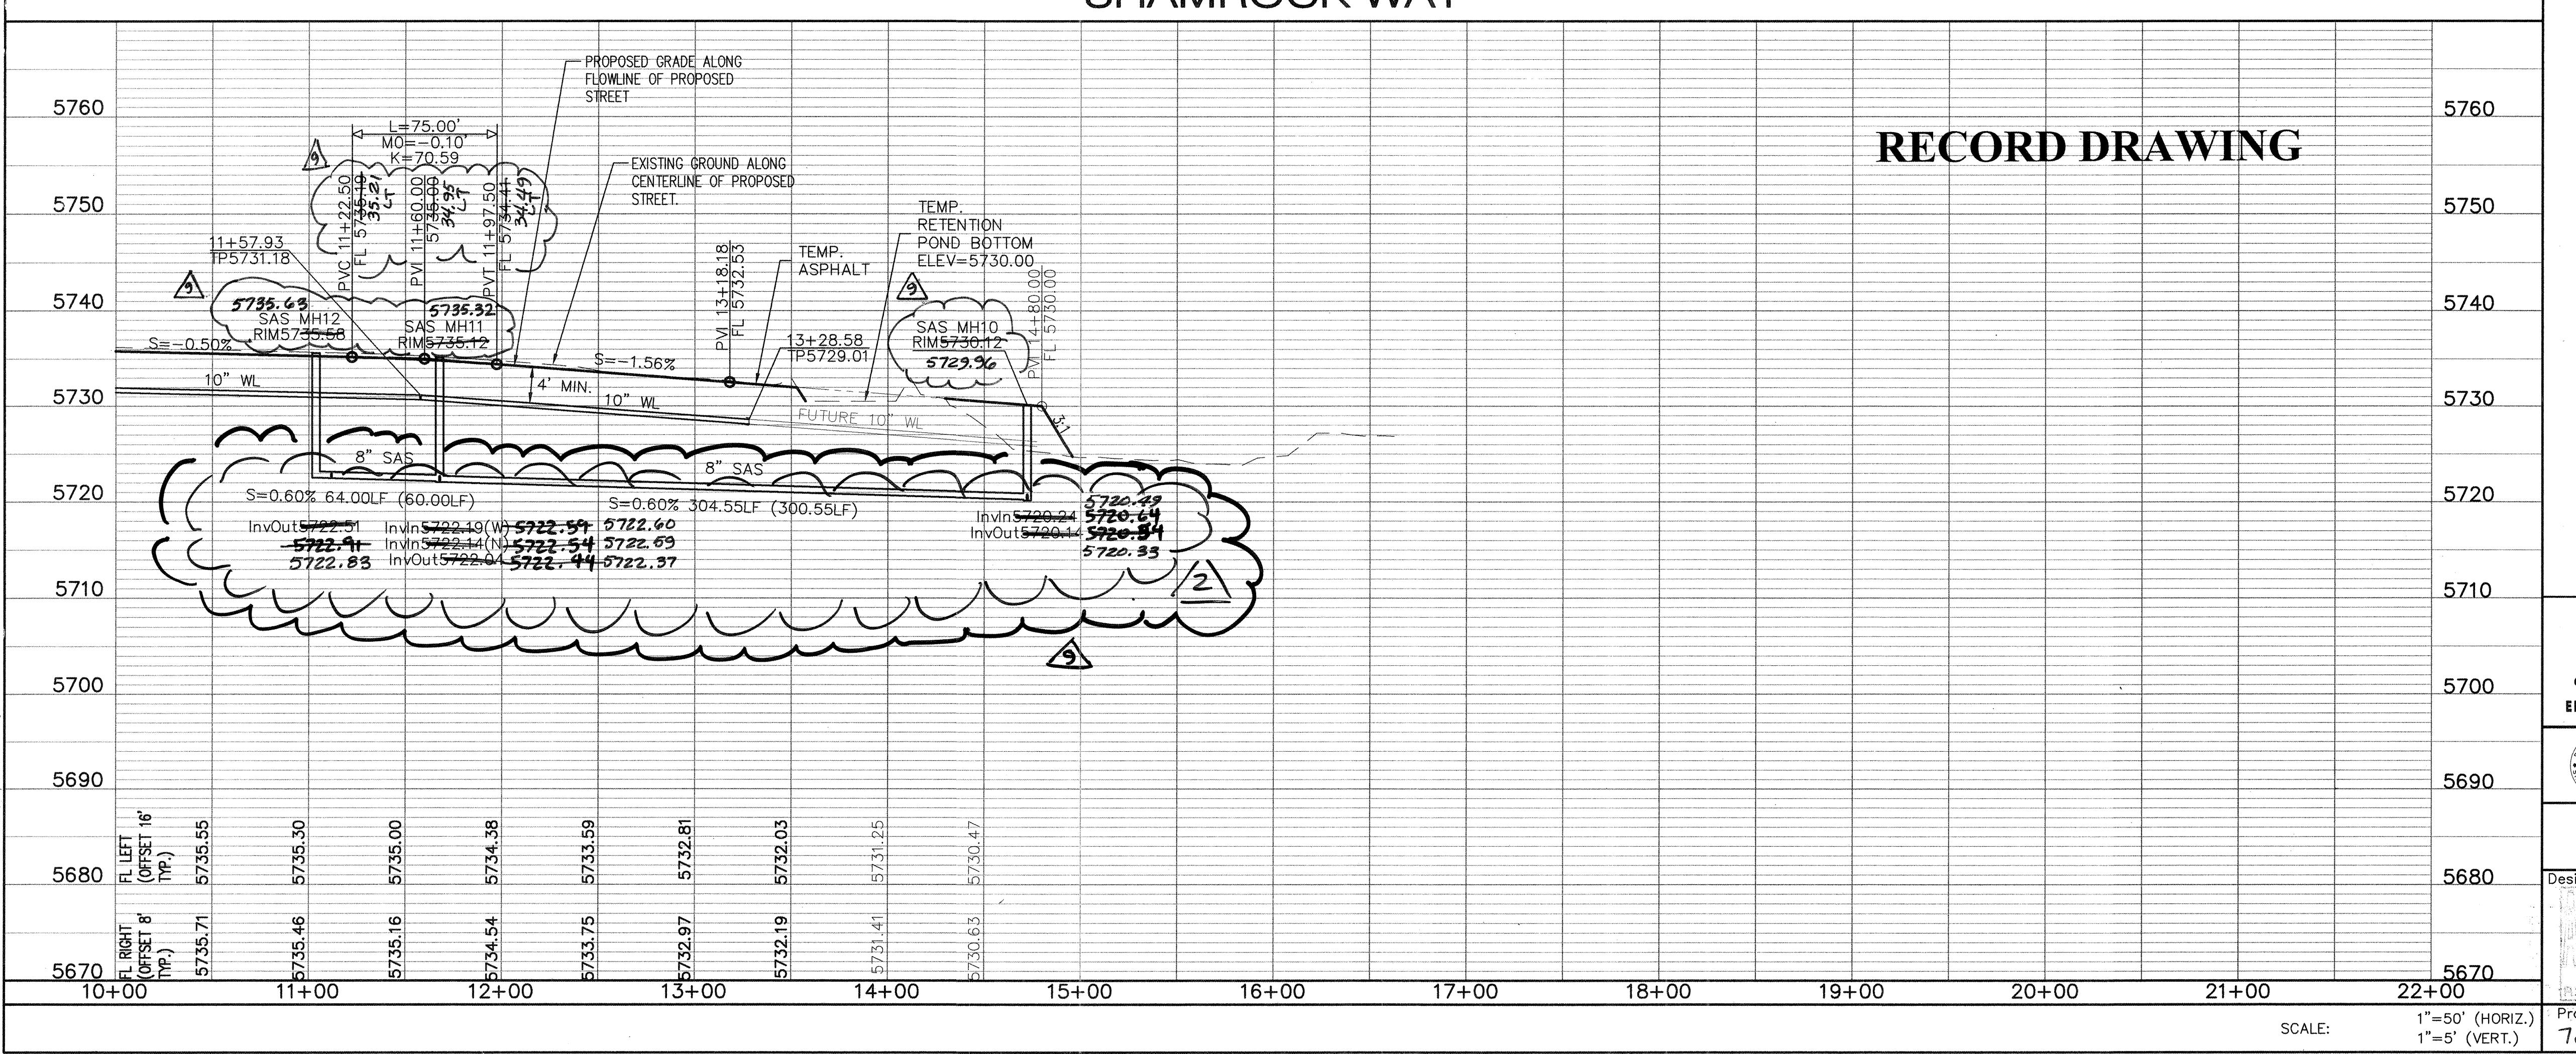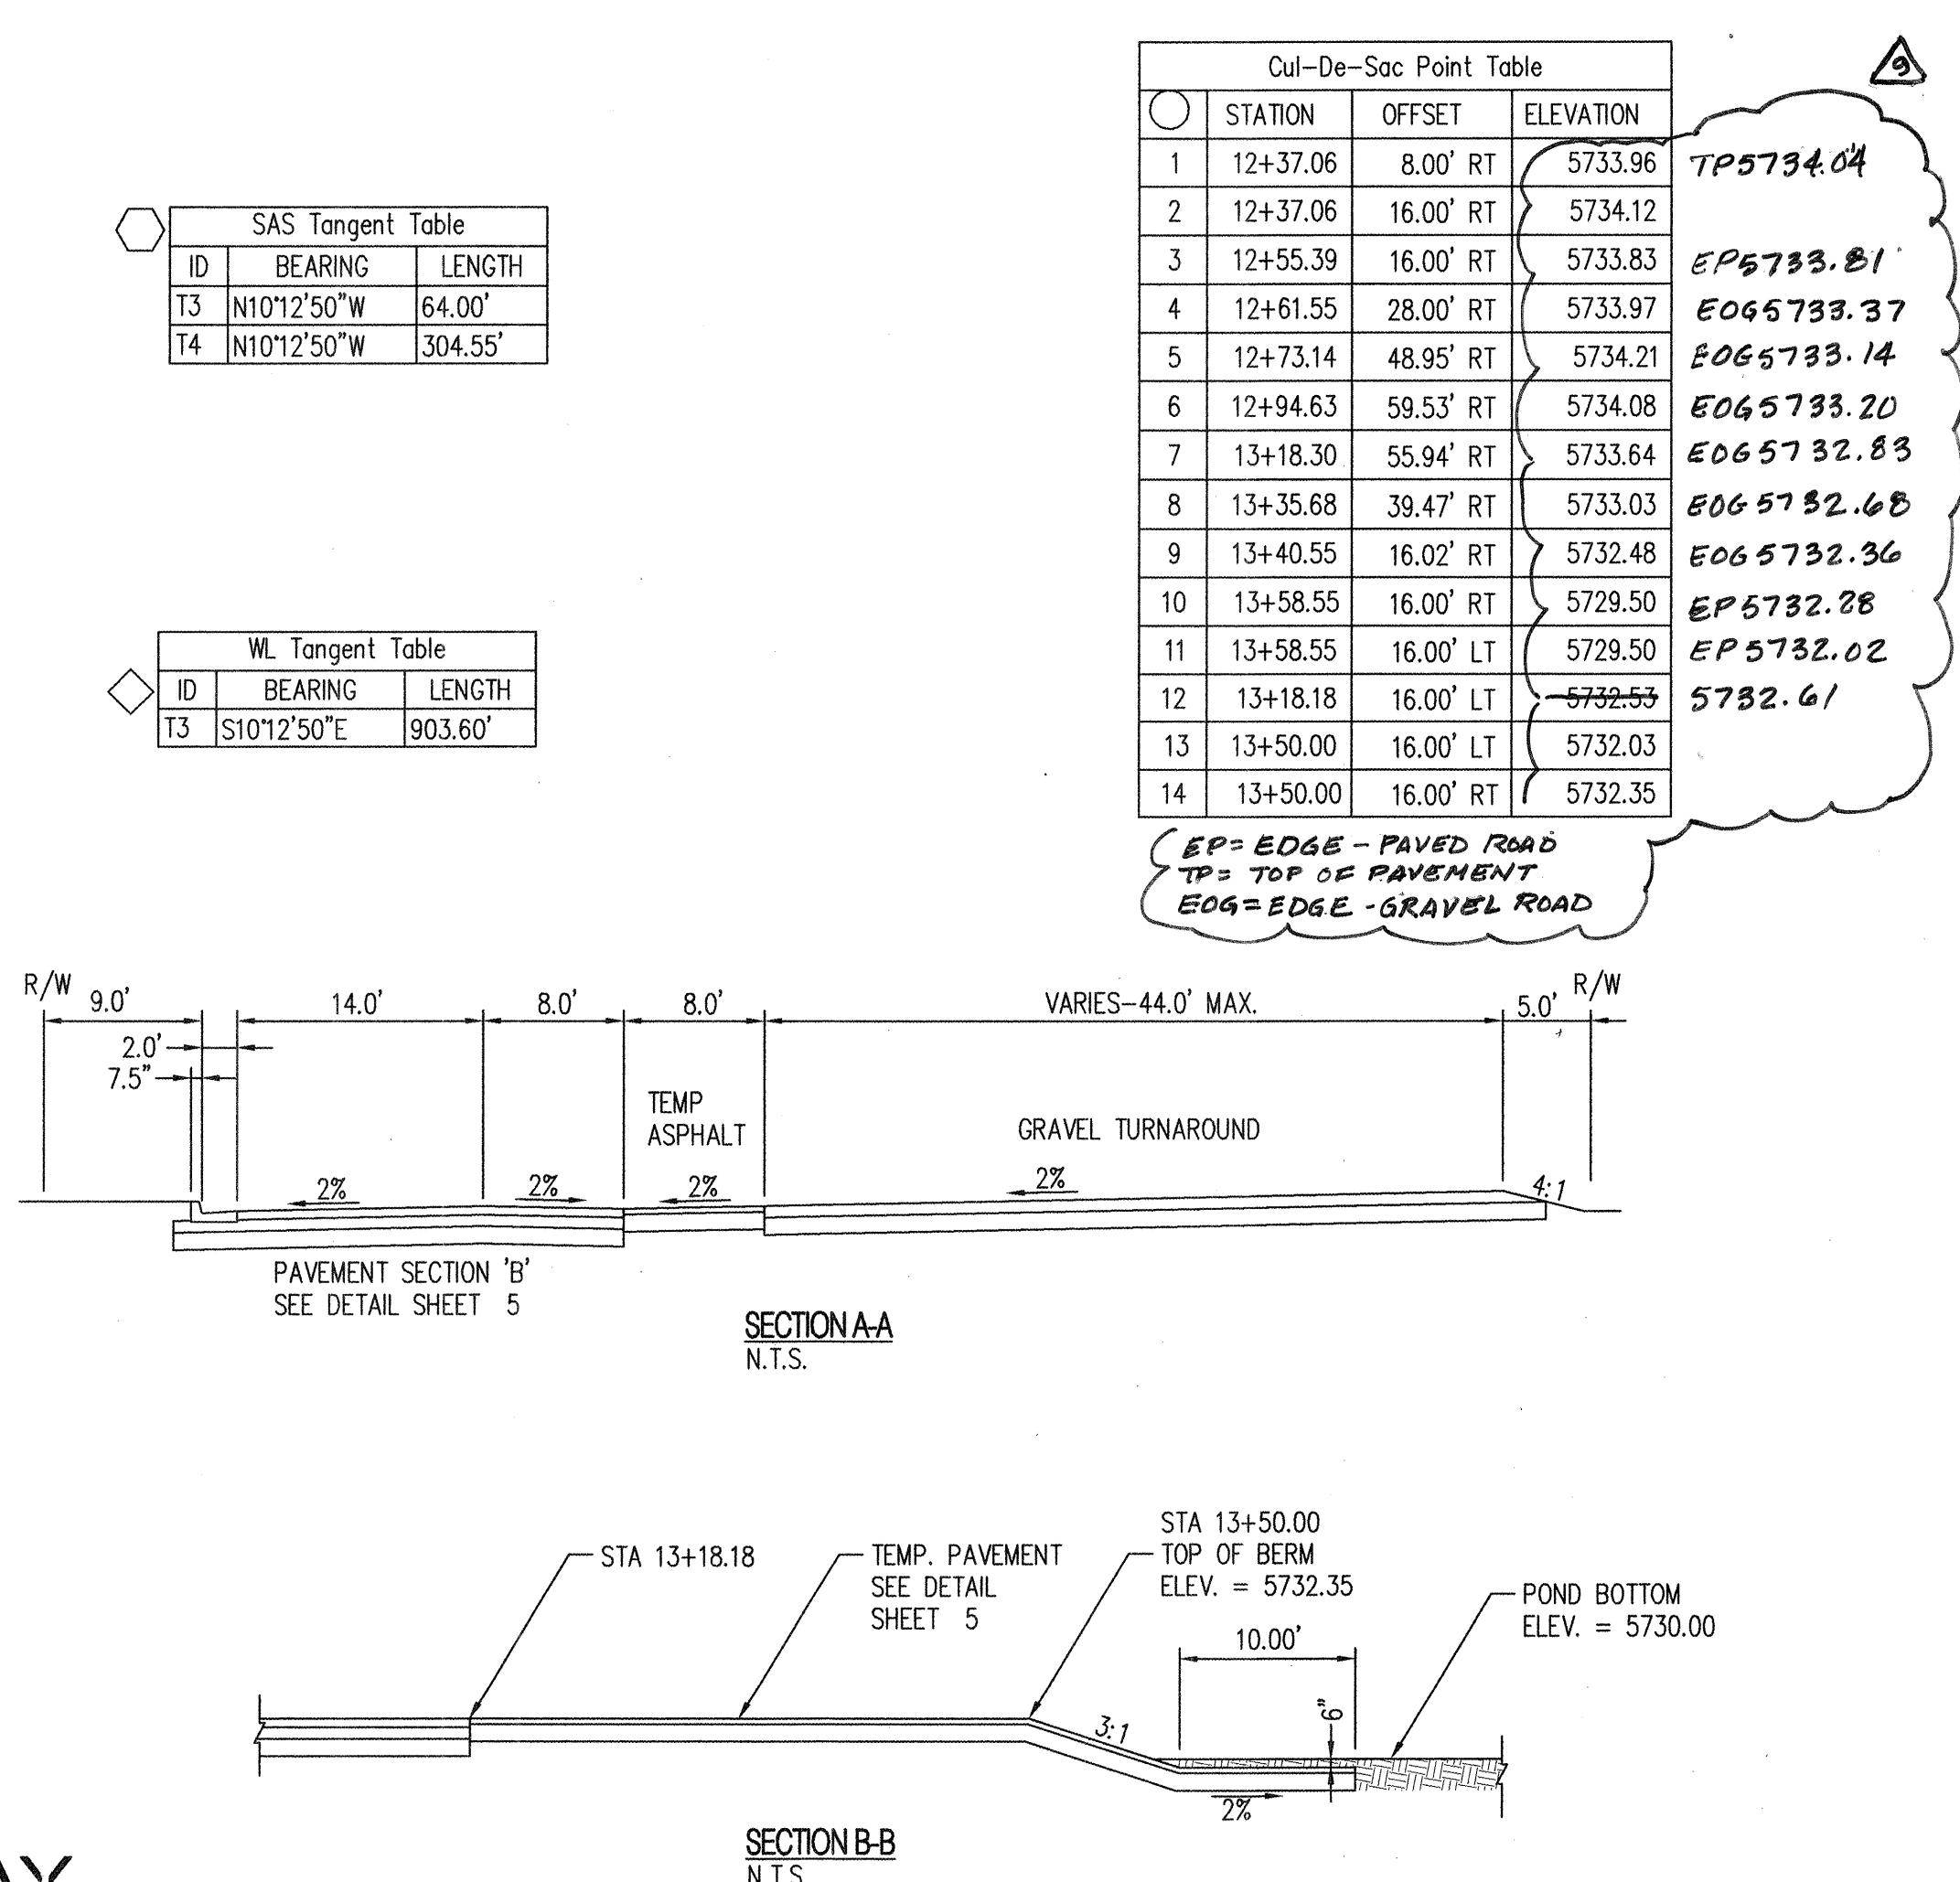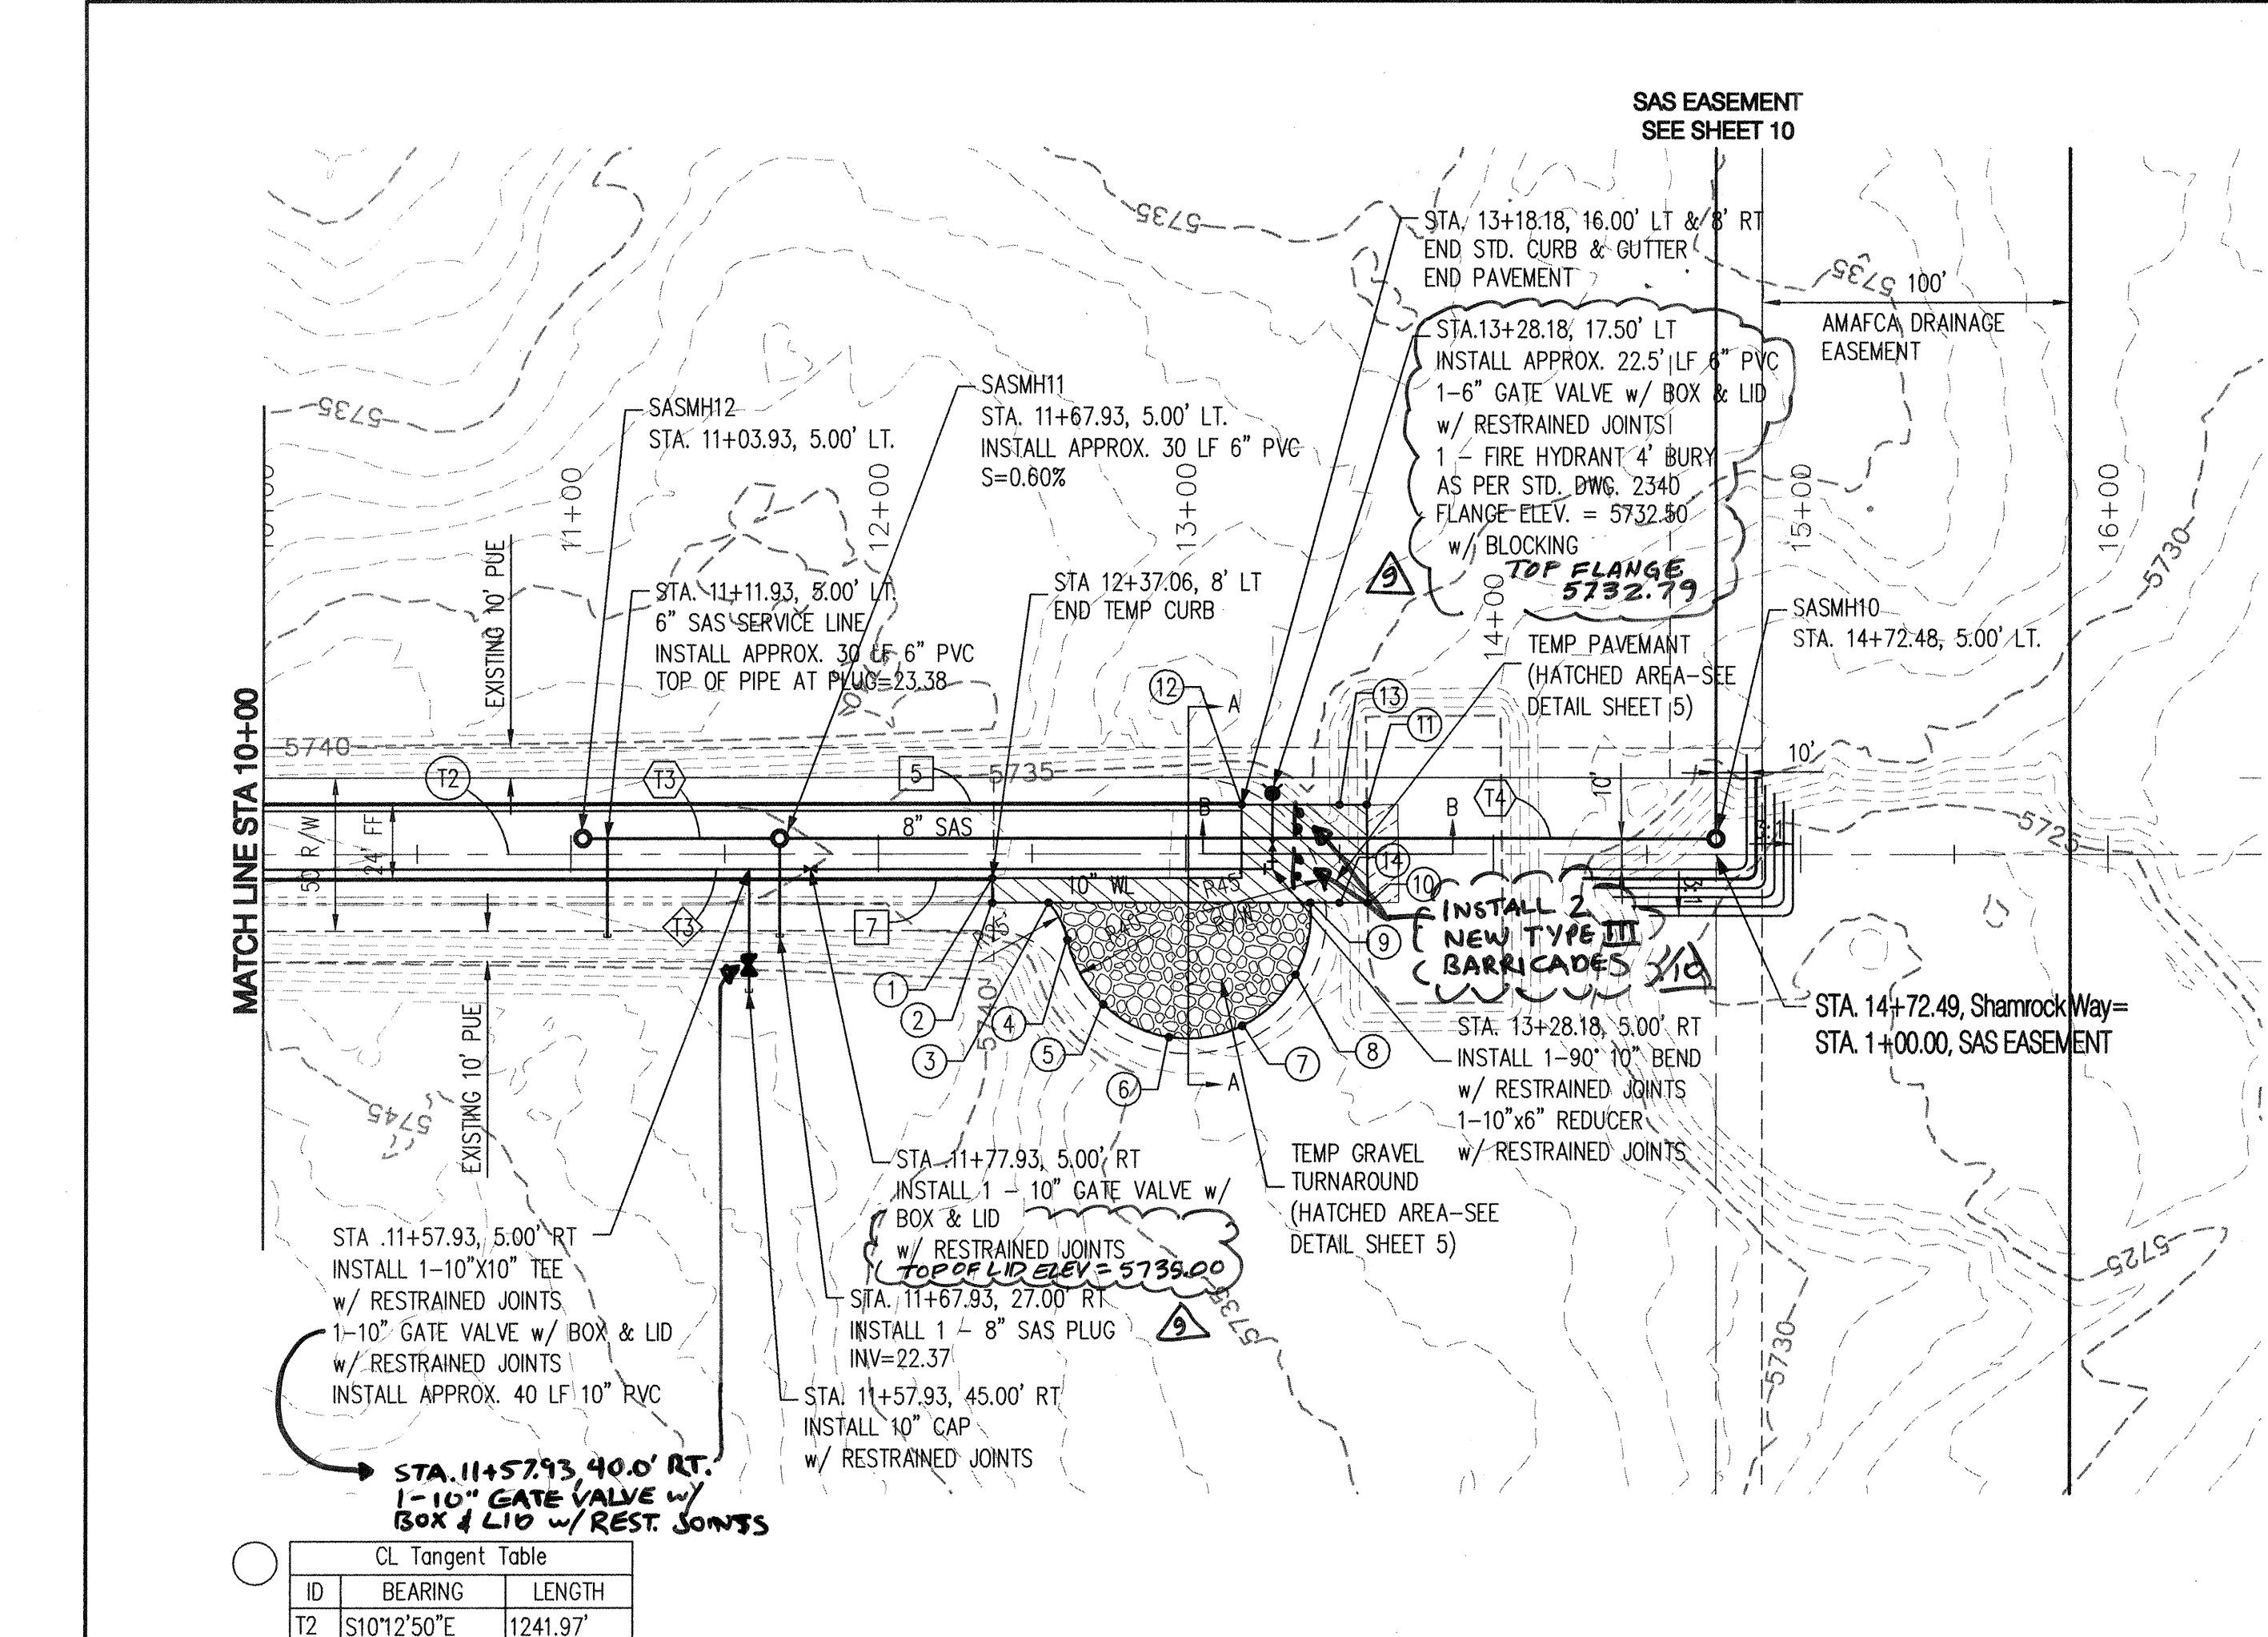


AS-BUILT INFORMATION			BENCH MARKS		
CONTRACTOR: <b>BHI</b>	PERIOD: <b>May 2006</b>	DATE: <b>2/17</b>	NO.:	BY:	DATE:
INSPECTOR: <b>BHI</b>	PERIOD: <b>May 2006</b>	DATE: <b>2/17</b>	NO.:	BY:	DATE:
FIELD COORDINATOR: <b>BHI</b>	PERIOD: <b>May 2006</b>	DATE: <b>2/17</b>	NO.:	BY:	DATE:
RECORDED BY: <b>BHI</b>	PERIOD: <b>May 2006</b>	DATE: <b>2/17</b>	NO.:	BY:	DATE:
MICRO-FILM INFORMATION			RECORDED BY: <b>BHI</b>		

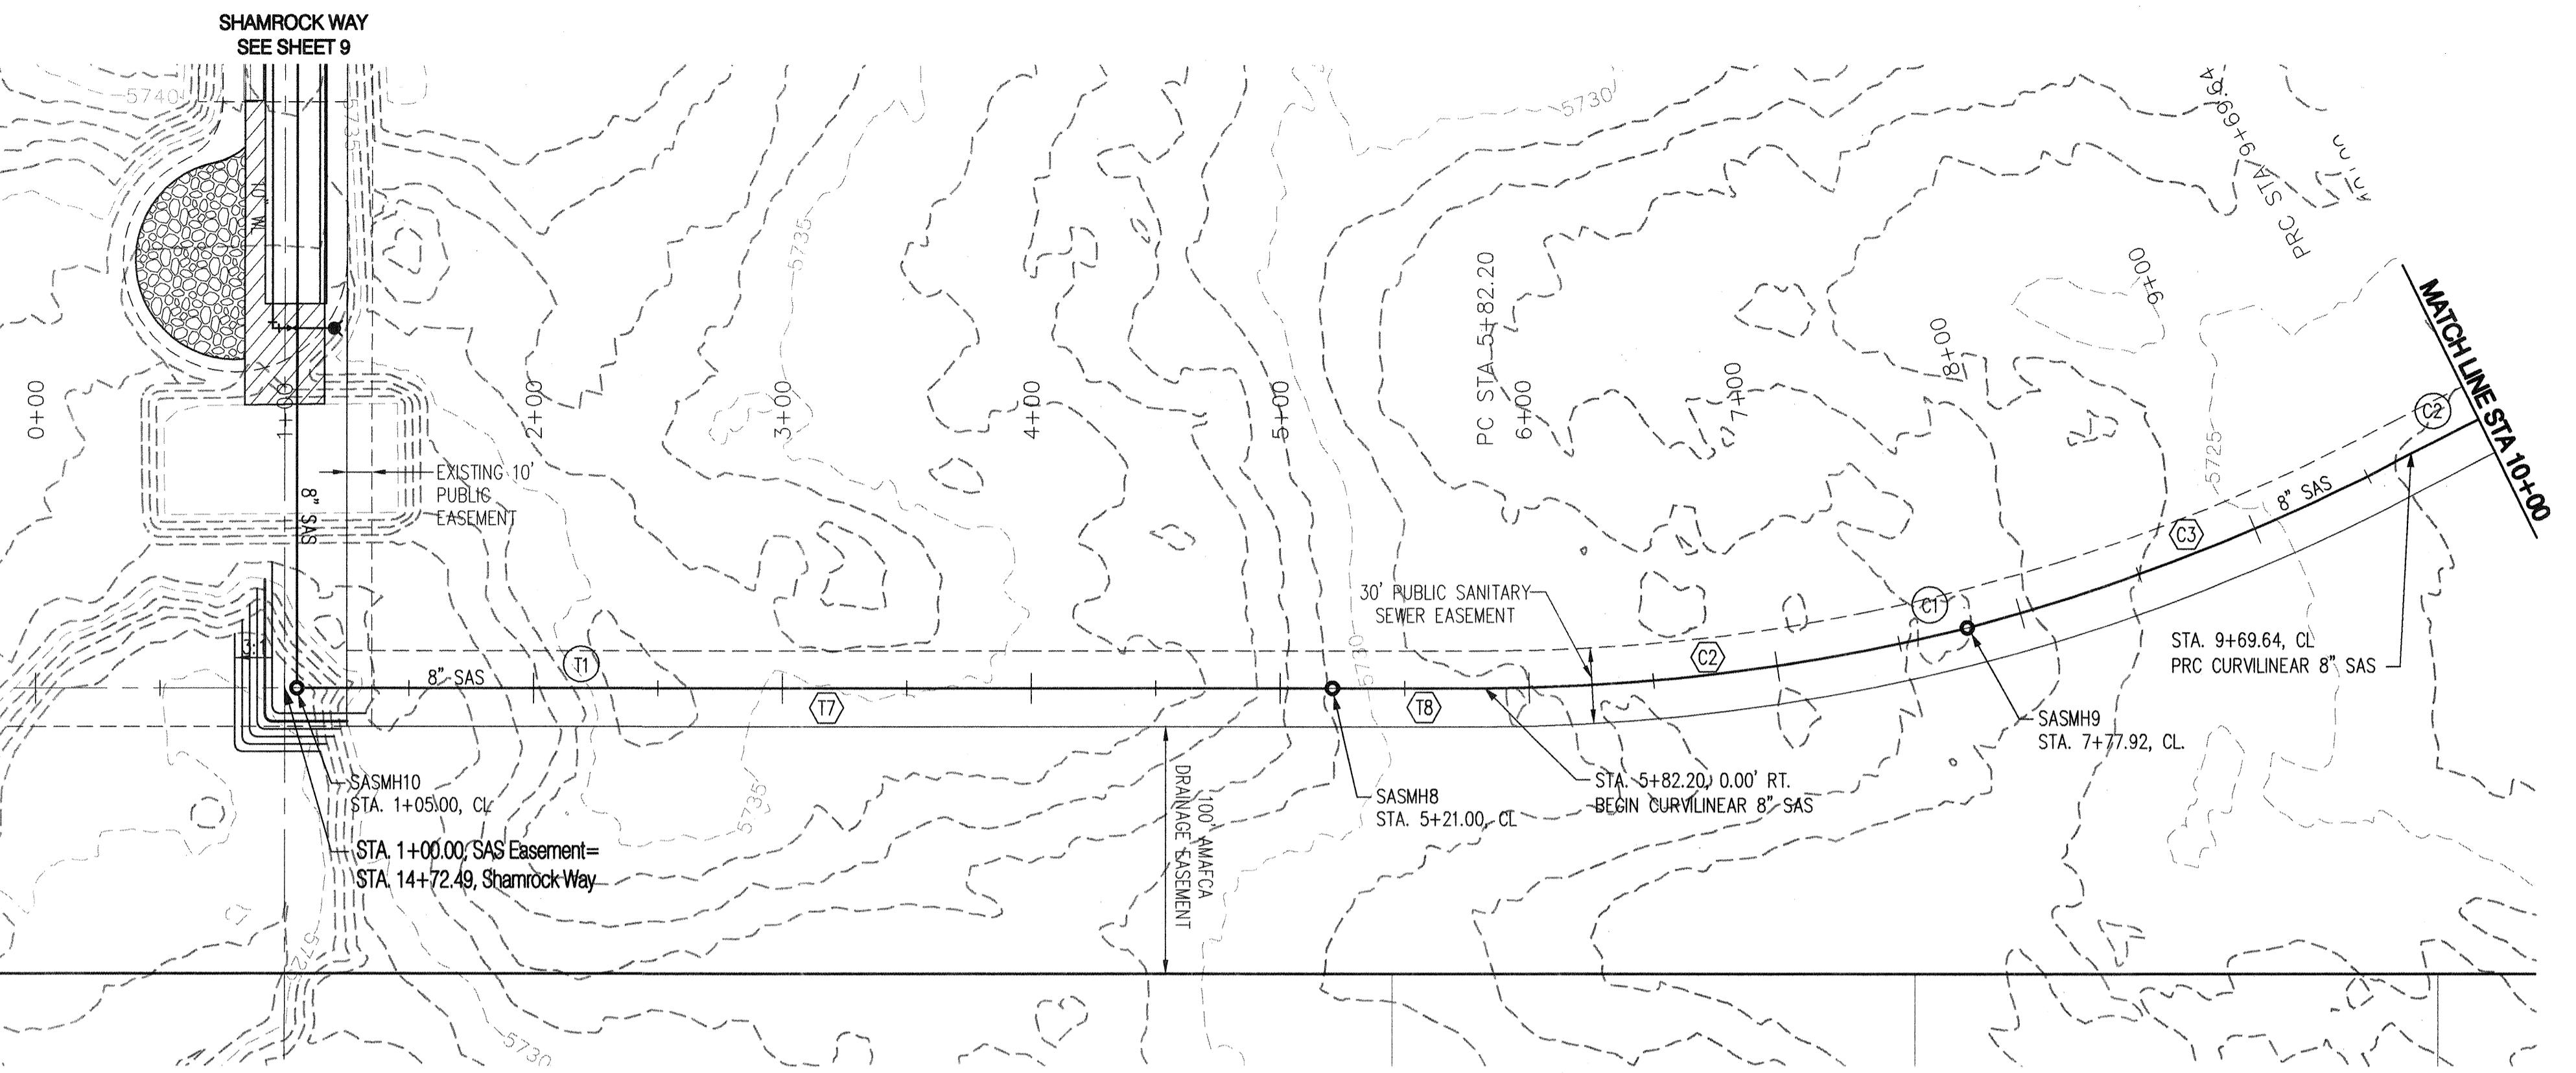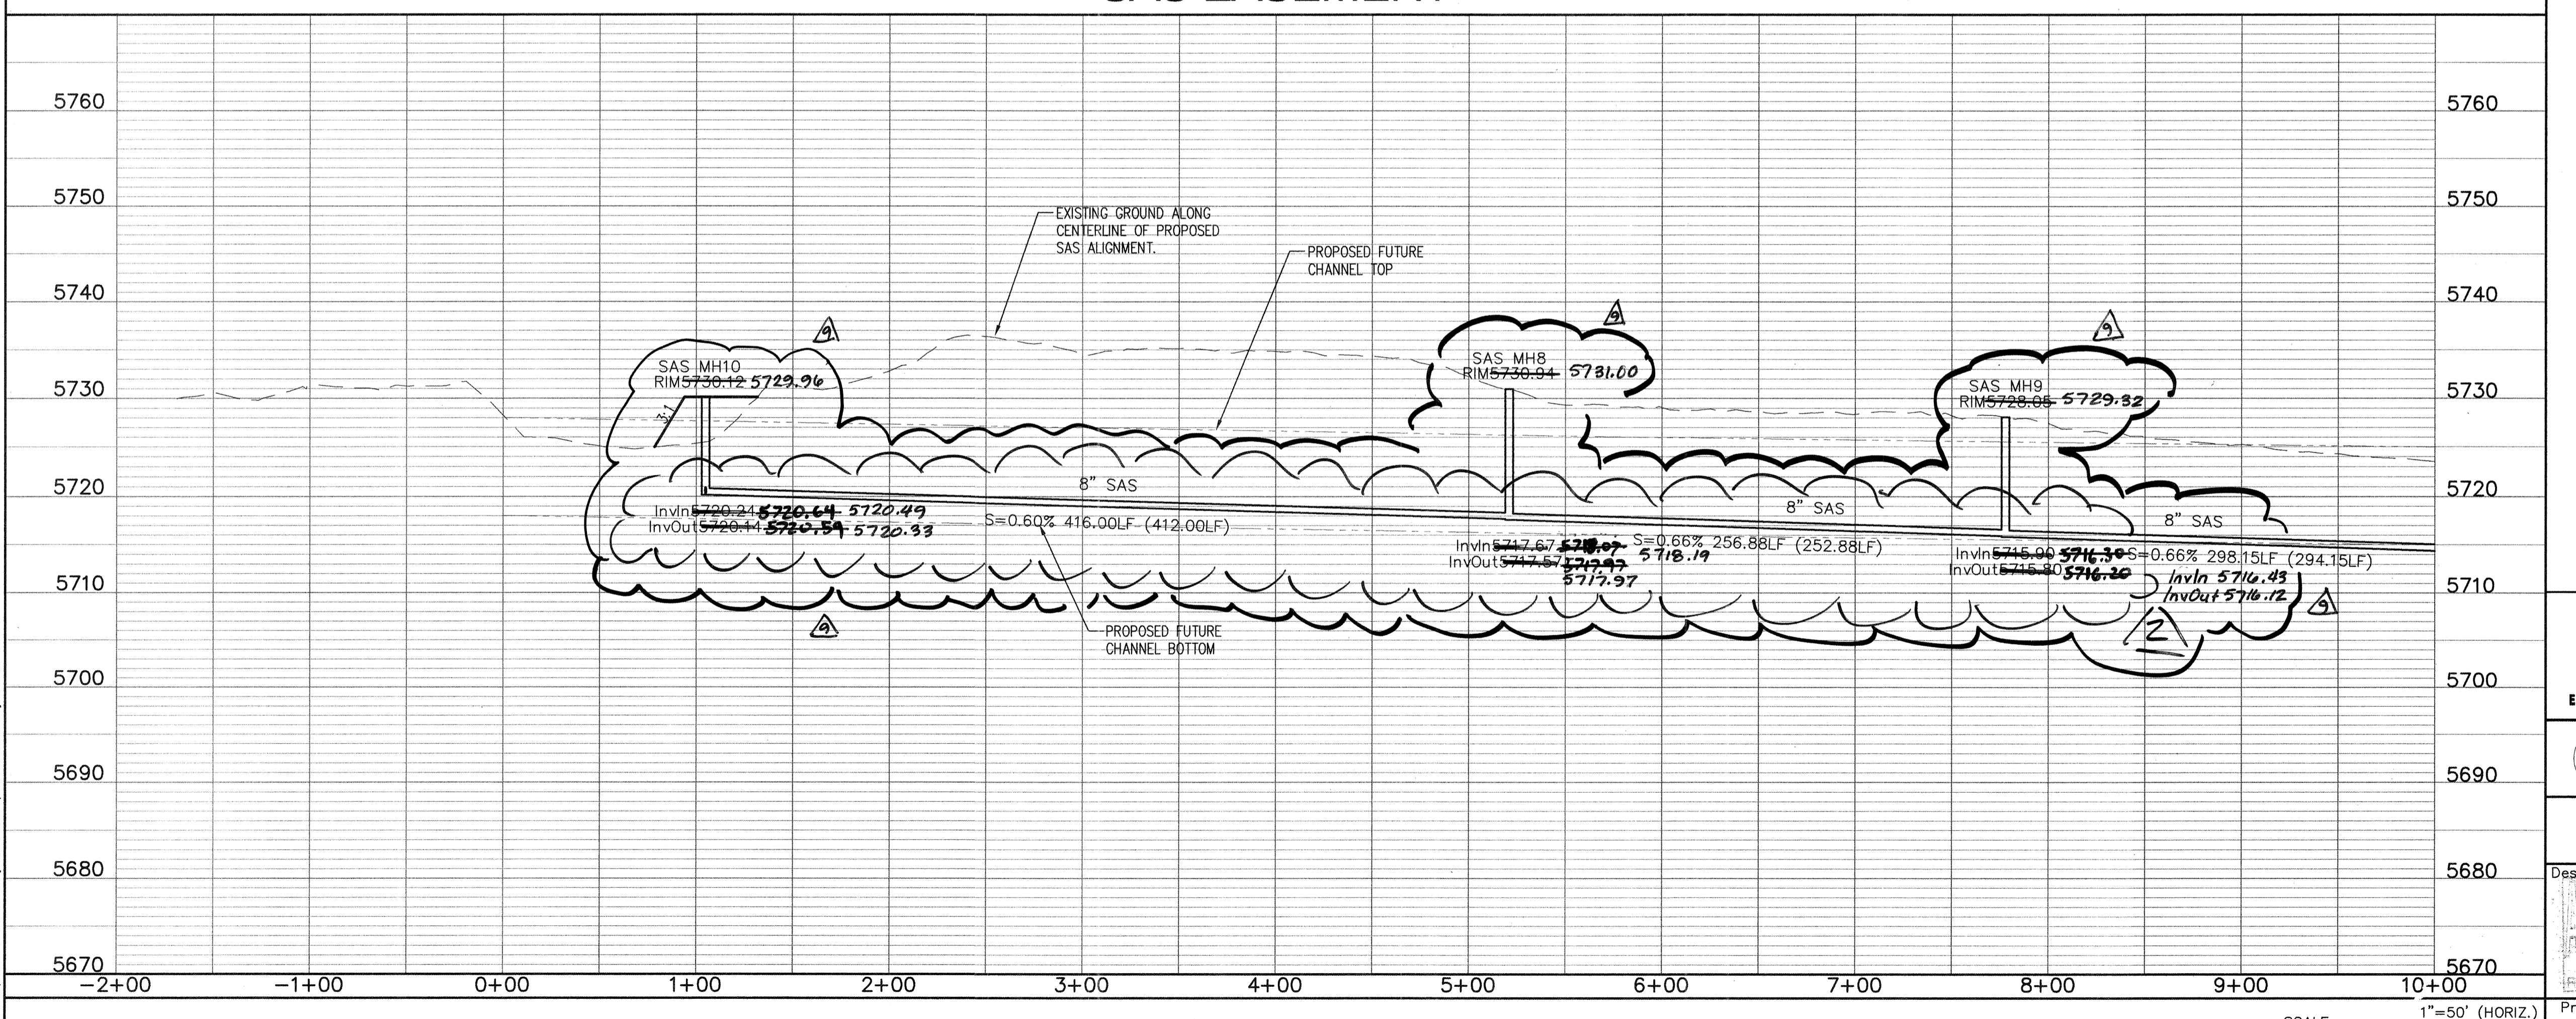
**SAS EASEMENT****RECORD DRAWING**

NOTES		AS-BUILT INFORMATION	
1. THE CONTRACTOR SHALL FIELD VERIFY ALL EXISTING UTILITY LOCATIONS AND NOTIFY THE ENGINEER IMMEDIATELY OF ANY DISCREPANCIES.		CONTRACTOR BY <b>B/H</b>	DATE <b>2/27</b>
2. ALL CURB RETURN RADII SHALL BE 30' UNLESS OTHERWISE SPECIFIED.		INSPECTOR BY <b>FBI</b>	DATE <b>2/27</b>
3. ALL CURVE DATA AND DIMENSIONS REFER TO FACE OF CURB UNLESS OTHERWISE SPECIFIED.		FEEDBACK BY <b>B/H</b>	DATE <b>2/27</b>
4. GRADE ELEVATIONS, WHERE NOTED, ARE FOR TOP OF STANDARD CURB UNLESS OTHERWISE SPECIFIED.		BRANCHES BY <b>B/H</b>	DATE <b>2/27</b>
5. CONTRACTOR IS TO INSTALL A 4"x 4"x 5' POST AND END AT THE END OF EACH SANITARY SEWER SERVICE.		MICRO-FILM INFORMATION	RECORDED BY NO.
6. CONTRACTOR IS RESPONSIBLE FOR REPAIR AND/OR REPLACEMENT OF ALL UTILITY CONDUITS AND EXISTING LINES.			
7. ANY ADDITIONAL GRADING REQUIRED TO MATCH PROPOSED STREET GRADES SHALL BE INCIDENTAL TO PAVING ITEMS.			
8. CONTRACTOR SHALL PROVIDE THE INSPECTORS, (COUNTY AND PRIVATE) WITH THE PROPOSED HYDROSTATIC TESTING PLAN. THE PLAN MUST BE APPROVED BEFORE TESTING OPERATIONS BEGIN.			
9. CONTRACTOR SHALL PARK EQUIPMENT AND VEHICLES AS NOT TO INTERFERE WITH NORMAL ACTIVITIES OF RESIDENTS OR OTHER CONTRACTORS ON SITE.			
10. ANY DAMAGE TO THE EXISTING FACILITIES (CURB & GUTTER, PAVEMENT, CONDUITS, LANDSCAPING, UTILITY LINES ETC.) DURING CONSTRUCTION SHALL BE REPLACED AT THE CONTRACTOR'S EXPENSE.			
11. REMOVAL OF THE EXISTING CURB & GUTTER SHALL BE AS PER COA STD. DWG. 2415 (SAWCUT ONLY).			
12. WHEELCHAIR RAMPS SHALL BE CONSTRUCTED PRIOR TO ACCEPTANCE OF CURB & GUTTER.			
13. STRIPING ERADICATION SHALL BE ACCOMPLISHED BY WATER BLASTING OR SURFACE PLANING OF THE ROADWAY, TO A MAX. DEPTH OF 1/4" AND A WIDTH EQUAL TO TWICE THE WIDTH OF THE STRIPE OR MARKING TO BE REMOVED.			
14. ELECTRONIC MARKER DISKS (EMD) WILL BE PLACED ACCORDING TO SECTION 170 OF THE CITY OF ALBUQUERQUE STANDARD SPECIFICATIONS FOR PUBLIC WORKS CONSTRUCTION, 1986 EDITION AS REVISED THROUGH UPDATE #7.			
15. ALL WATER VALVE BOXES MANHOLES IN THE STREET CONSTRUCTION ARE TO BE ADJUSTED TO FINISH GRADE AND WILL BE MEASURED AND PAID PER EACH.			

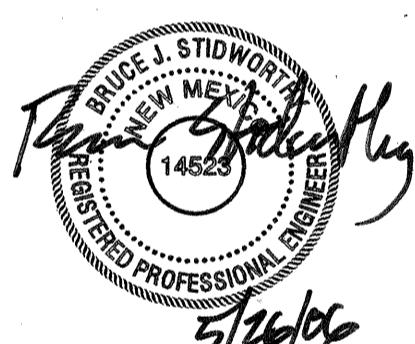

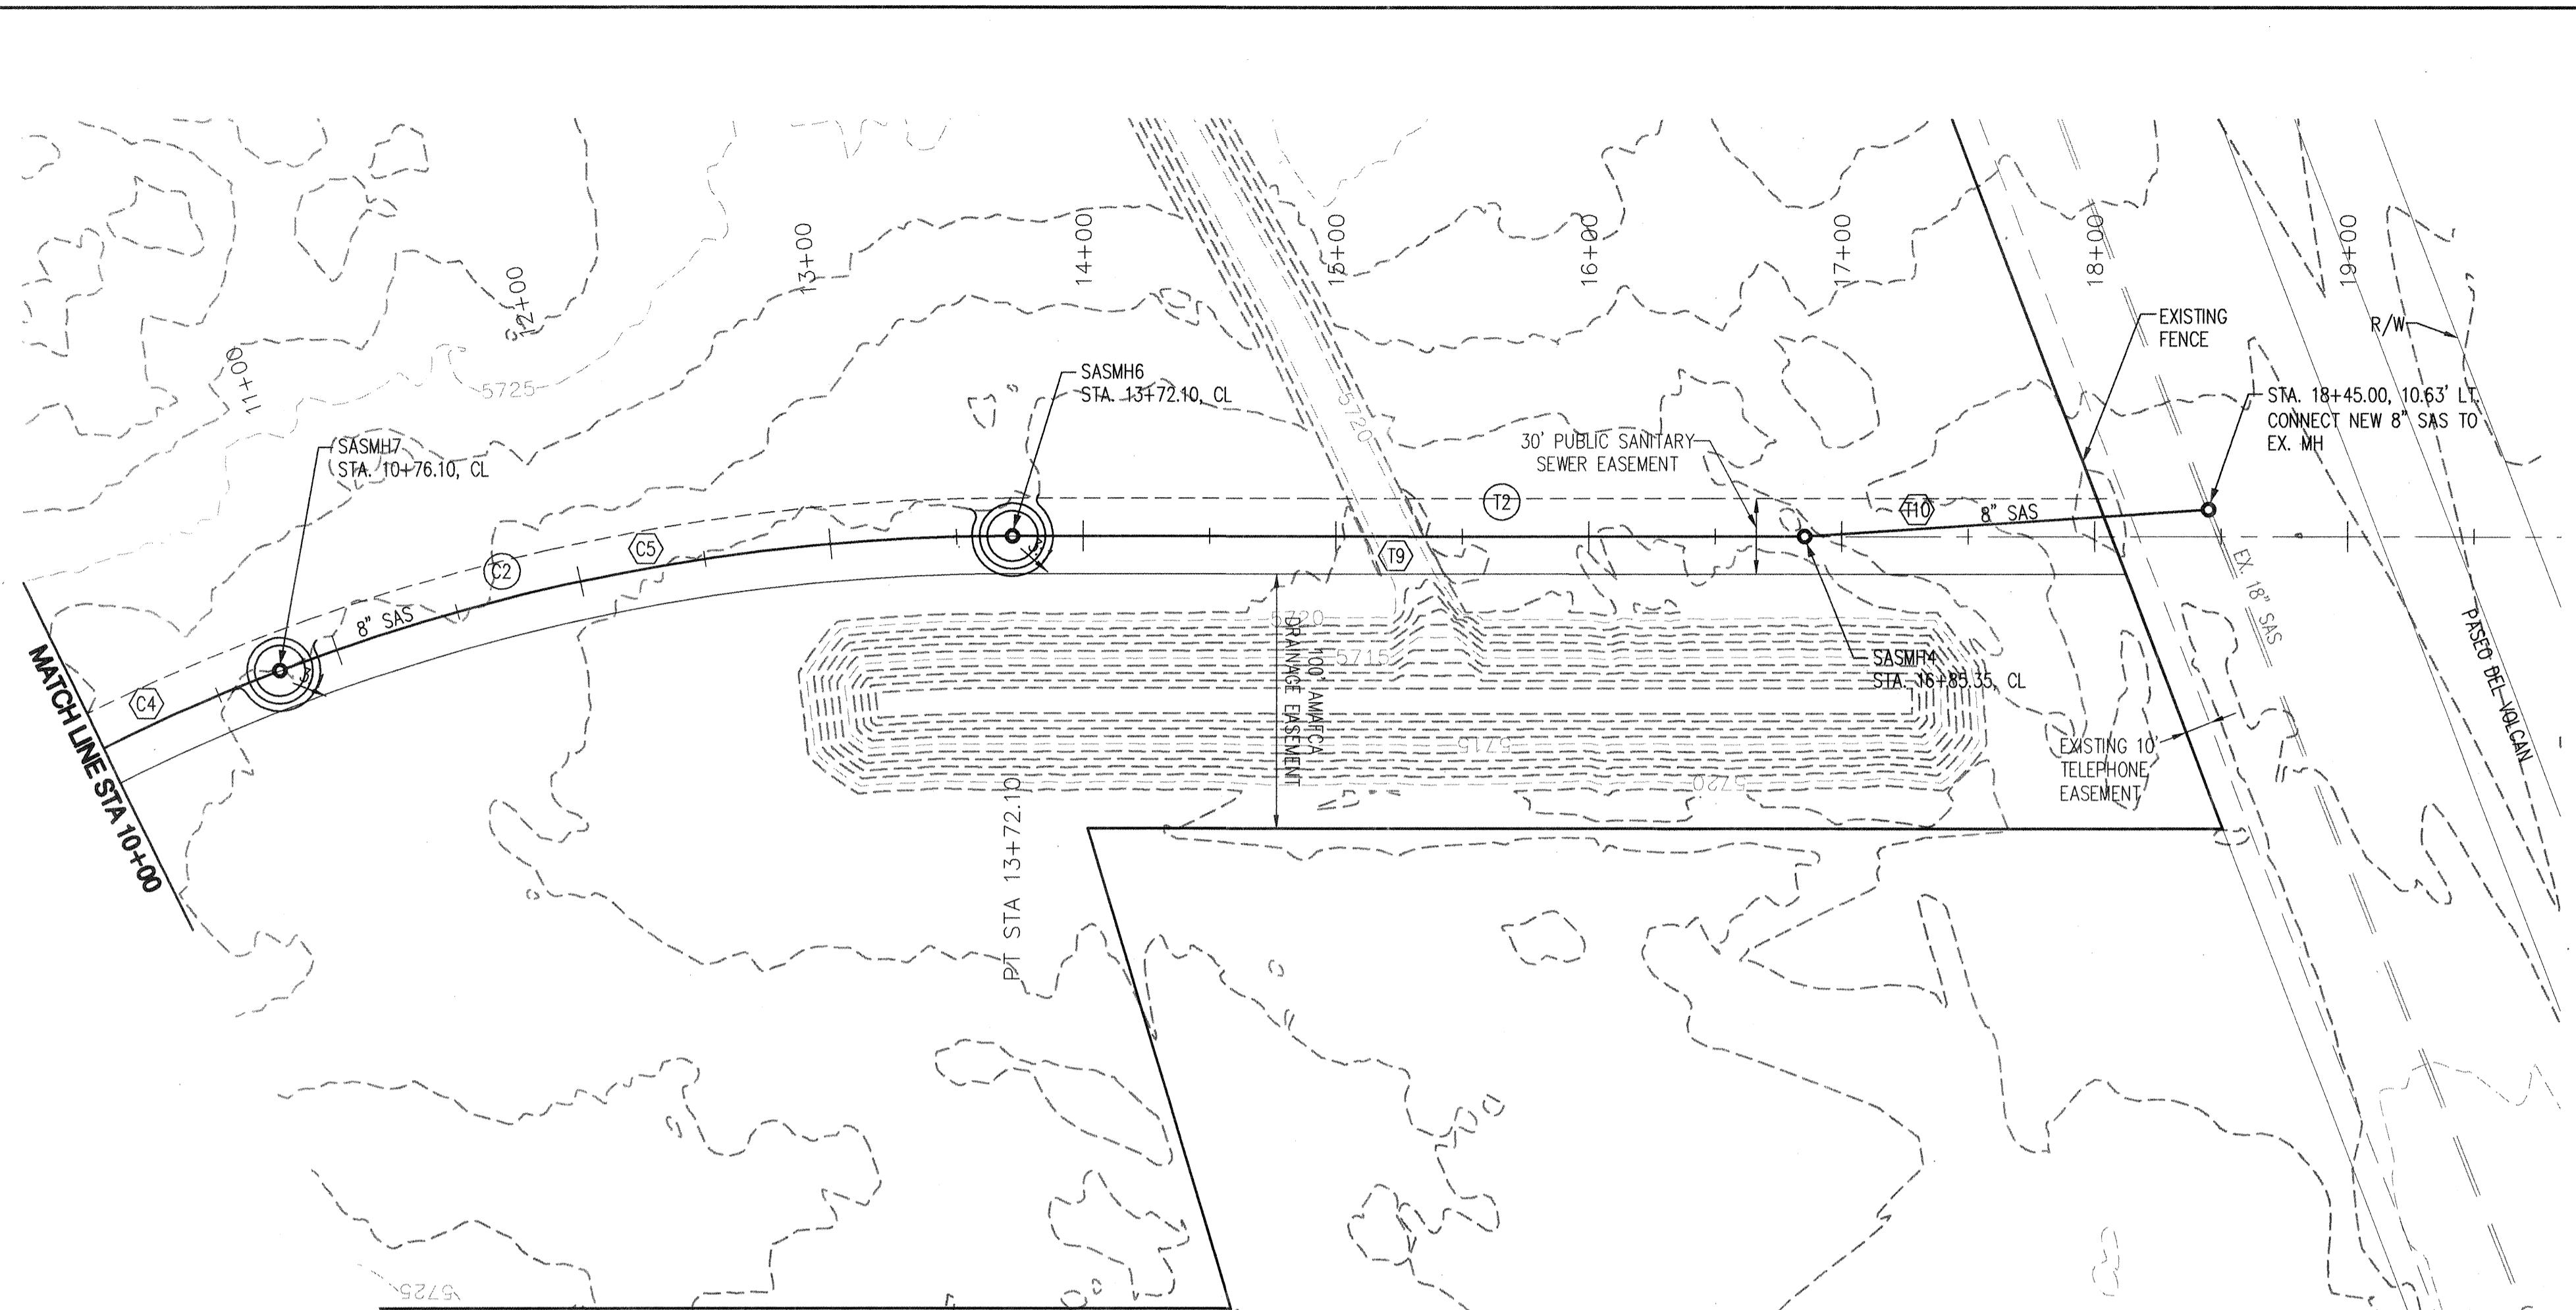

## SAS EASEMENT

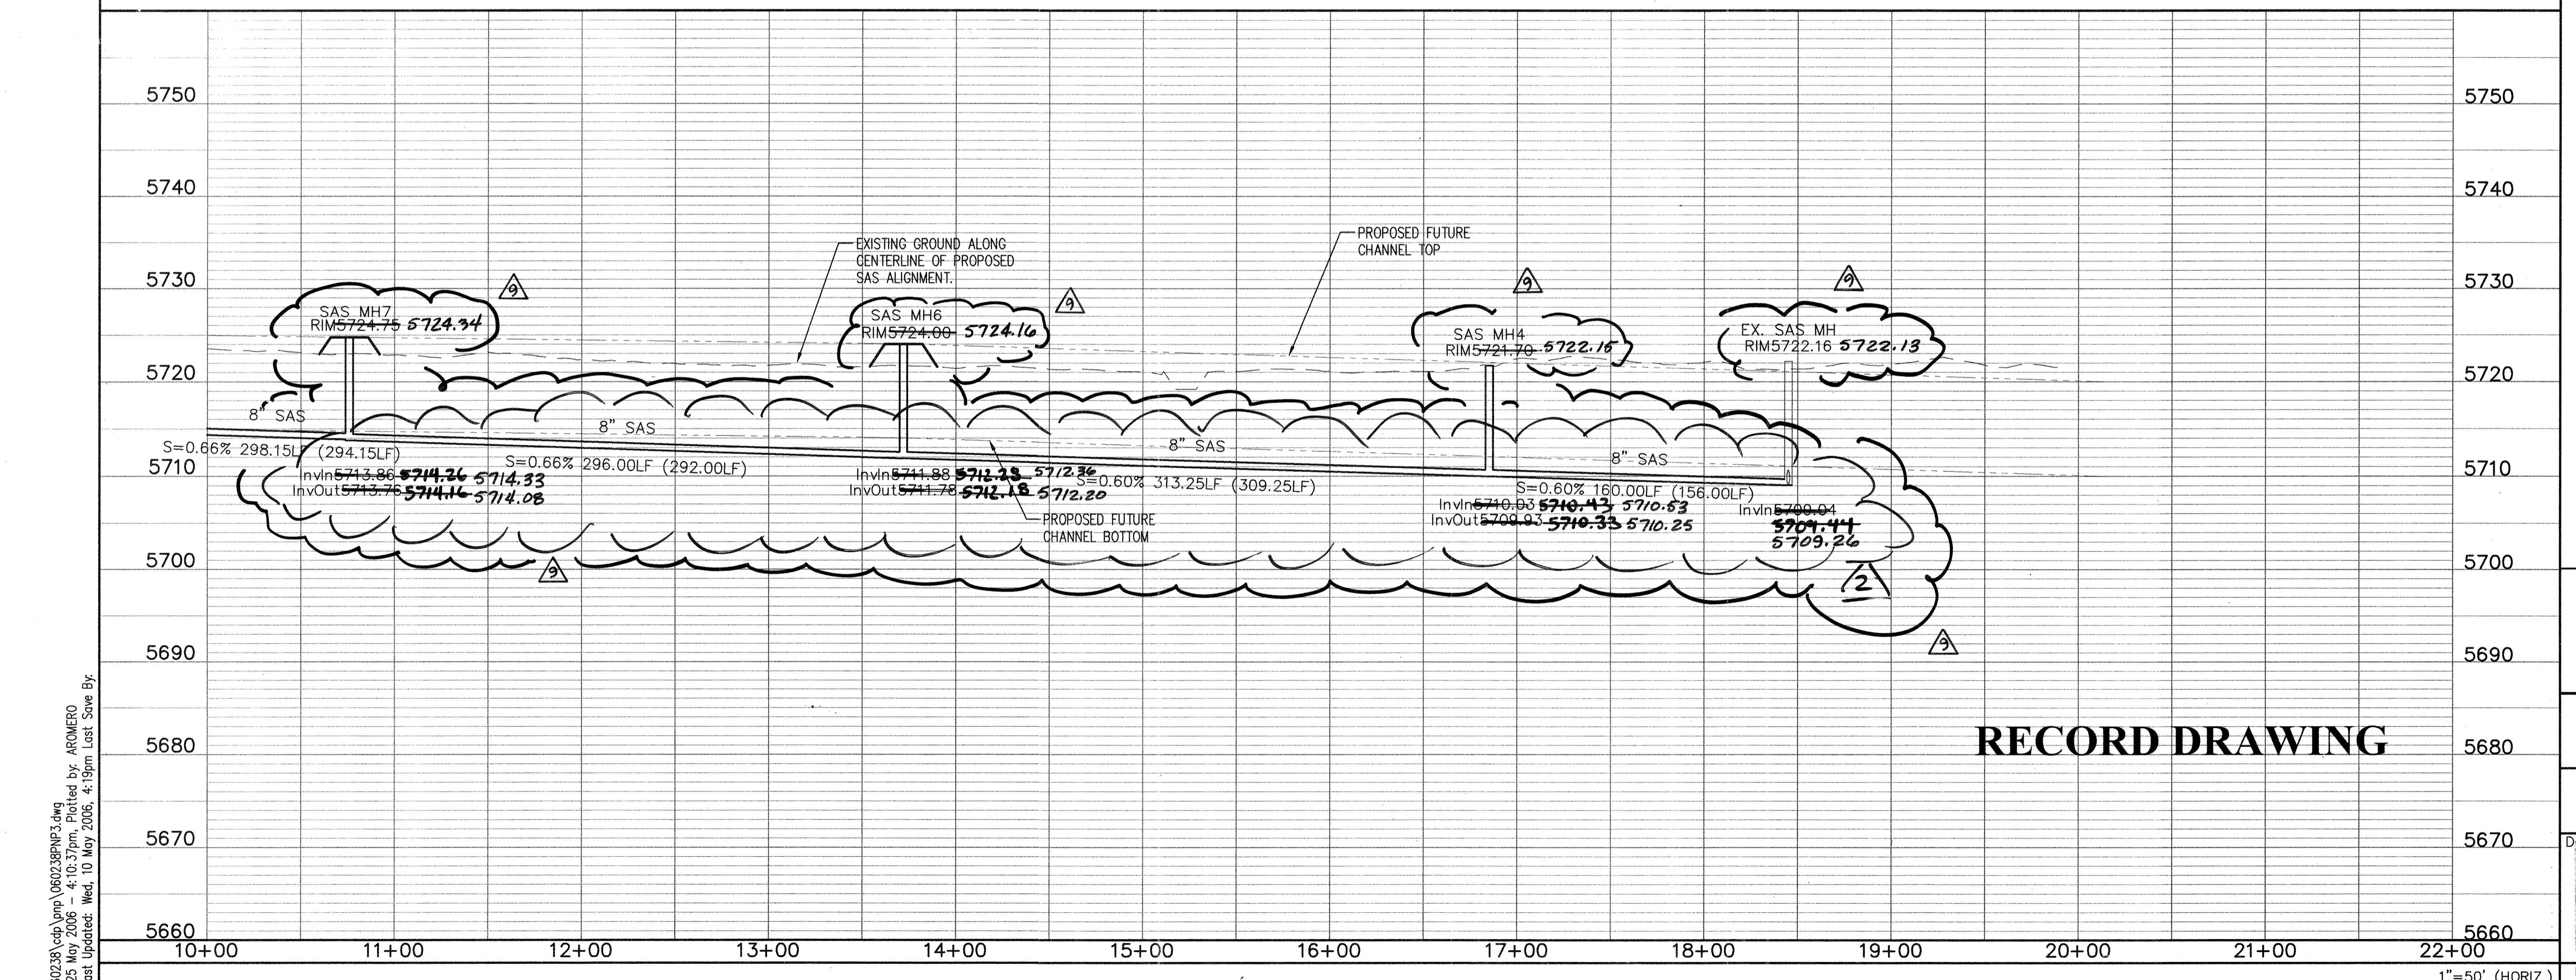

# RECORD DRAWING

P:\060238\cdp\pnp\060238PNP3.dwg  
Thu, 25 May 2006 - 4:10:37pm, Plotted by: AROMERO  
File Last Updated: Wed, 10 May 2006, 4:19pm Last Save By:

## NOTES

- THE CONTRACTOR SHALL FIELD VERIFY ALL EXISTING UTILITY LOCATIONS AND NOTIFY THE ENGINEER IMMEDIATELY OF ANY DISCREPANCIES.

ALL CURB RETURN RADII SHALL BE 30' UNLESS OTHERWISE SPECIFIED.

ALL CURVE DATA AND DIMENSIONS REFER TO FACE OF CURB UNLESS OTHERWISE SPECIFIED.

GRADE ELEVATIONS, WHERE NOTED, ARE FOR TOP OF STANDARD CURB UNLESS OTHERWISE SPECIFIED.

CONTRACTOR IS TO INSTALL A 4"x 4"x 5' POST AND EMD AT THE END OF EACH SANITARY SEWER SERVICE.

CONTRACTOR IS RESPONSIBLE FOR REPAIR AND/OR REPLACEMENT OF ALL UTILITY CONDUITS AND EXISTING LINES.

ANY ADDITIONAL GRADING REQUIRED TO MATCH PROPOSED STREET GRADES SHALL BE INCIDENTAL TO PAVING ITEMS.

CONTRACTOR SHALL PROVIDE THE INSPECTORS, (COUNTY AND PRIVATE) WITH THE PROPOSED HYDROSTATIC TESTING PLAN. THE PLAN MUST BE APPROVED BEFORE TESTING OPERATIONS BEGIN.

CONTRACTOR SHALL PARK EQUIPMENT AND VEHICLES AS NOT TO INTERFERE WITH NORMAL ACTIVITIES OF RESIDENTS OR OTHER CONTRACTORS ON SITE.

D. ANY DAMAGE TO THE EXISTING FACILITIES (CURB & GUTTER, PAVEMENT, CONDUITS, LANDSCAPING, UTILITY LINES ETC.) DURING CONSTRUCTION SHALL BE REPLACED AT THE CONTRACTORS' EXPENSE.

E. REMOVAL OF THE EXISTING CURB & GUTTER SHALL BE AS PER COAD. DWG. 2415 (SAWCUT ONLY).

F. WHEELCHAIR RAMPS SHALL BE CONSTRUCTED PRIOR TO ACCEPTANCE OF CURB & GUTTER.

G. STRIPING ERADICATION SHALL BE ACCOMPLISHED BY WATER BLASTING OR SURFACE PLANING OF THE ROADWAY, TO A MAX. DEPTH OF 1/4" AND WIDTH EQUAL TO TWICE THE WIDTH OF THE STRIPE OR MARKING TO BE REMOVED.

H. ELECTRONIC MARKER DISKS (EMD) WILL BE PLACED ACCORDING TO SECTION 170 OF THE CITY OF ALBUQUERQUE STANDARD SPECIFICATIONS FOR PUBLIC WORKS CONSTRUCTION, 1986 EDITION AS REVISED THROUGH UPDATE #7.

I. ALL WATER VALVE BOXES MANHOLES IN THE STREET CONSTRUCTION ARE TO BE ADJUSTED TO FINISH GRADE AND WILL BE MEASURED AND PAID PER EACH.

# **Hannan Huston Inc.**

# **County of Bernalillo Public Works Division State of New Mexico**

**ORDERO MESA, PHASE I INFRASTRUCTURE  
SANITARY SEWER PLAN & PROFILE  
SAS EASEMENT STA 10+00 TO EOP**

Committee	Engineer Approval	Mo./Day/yr.

						
---	---	---	---	---	---	---

SCALE: 1"=5' (V)


RT.) 7274

31

## L6,L7

—  
—

100

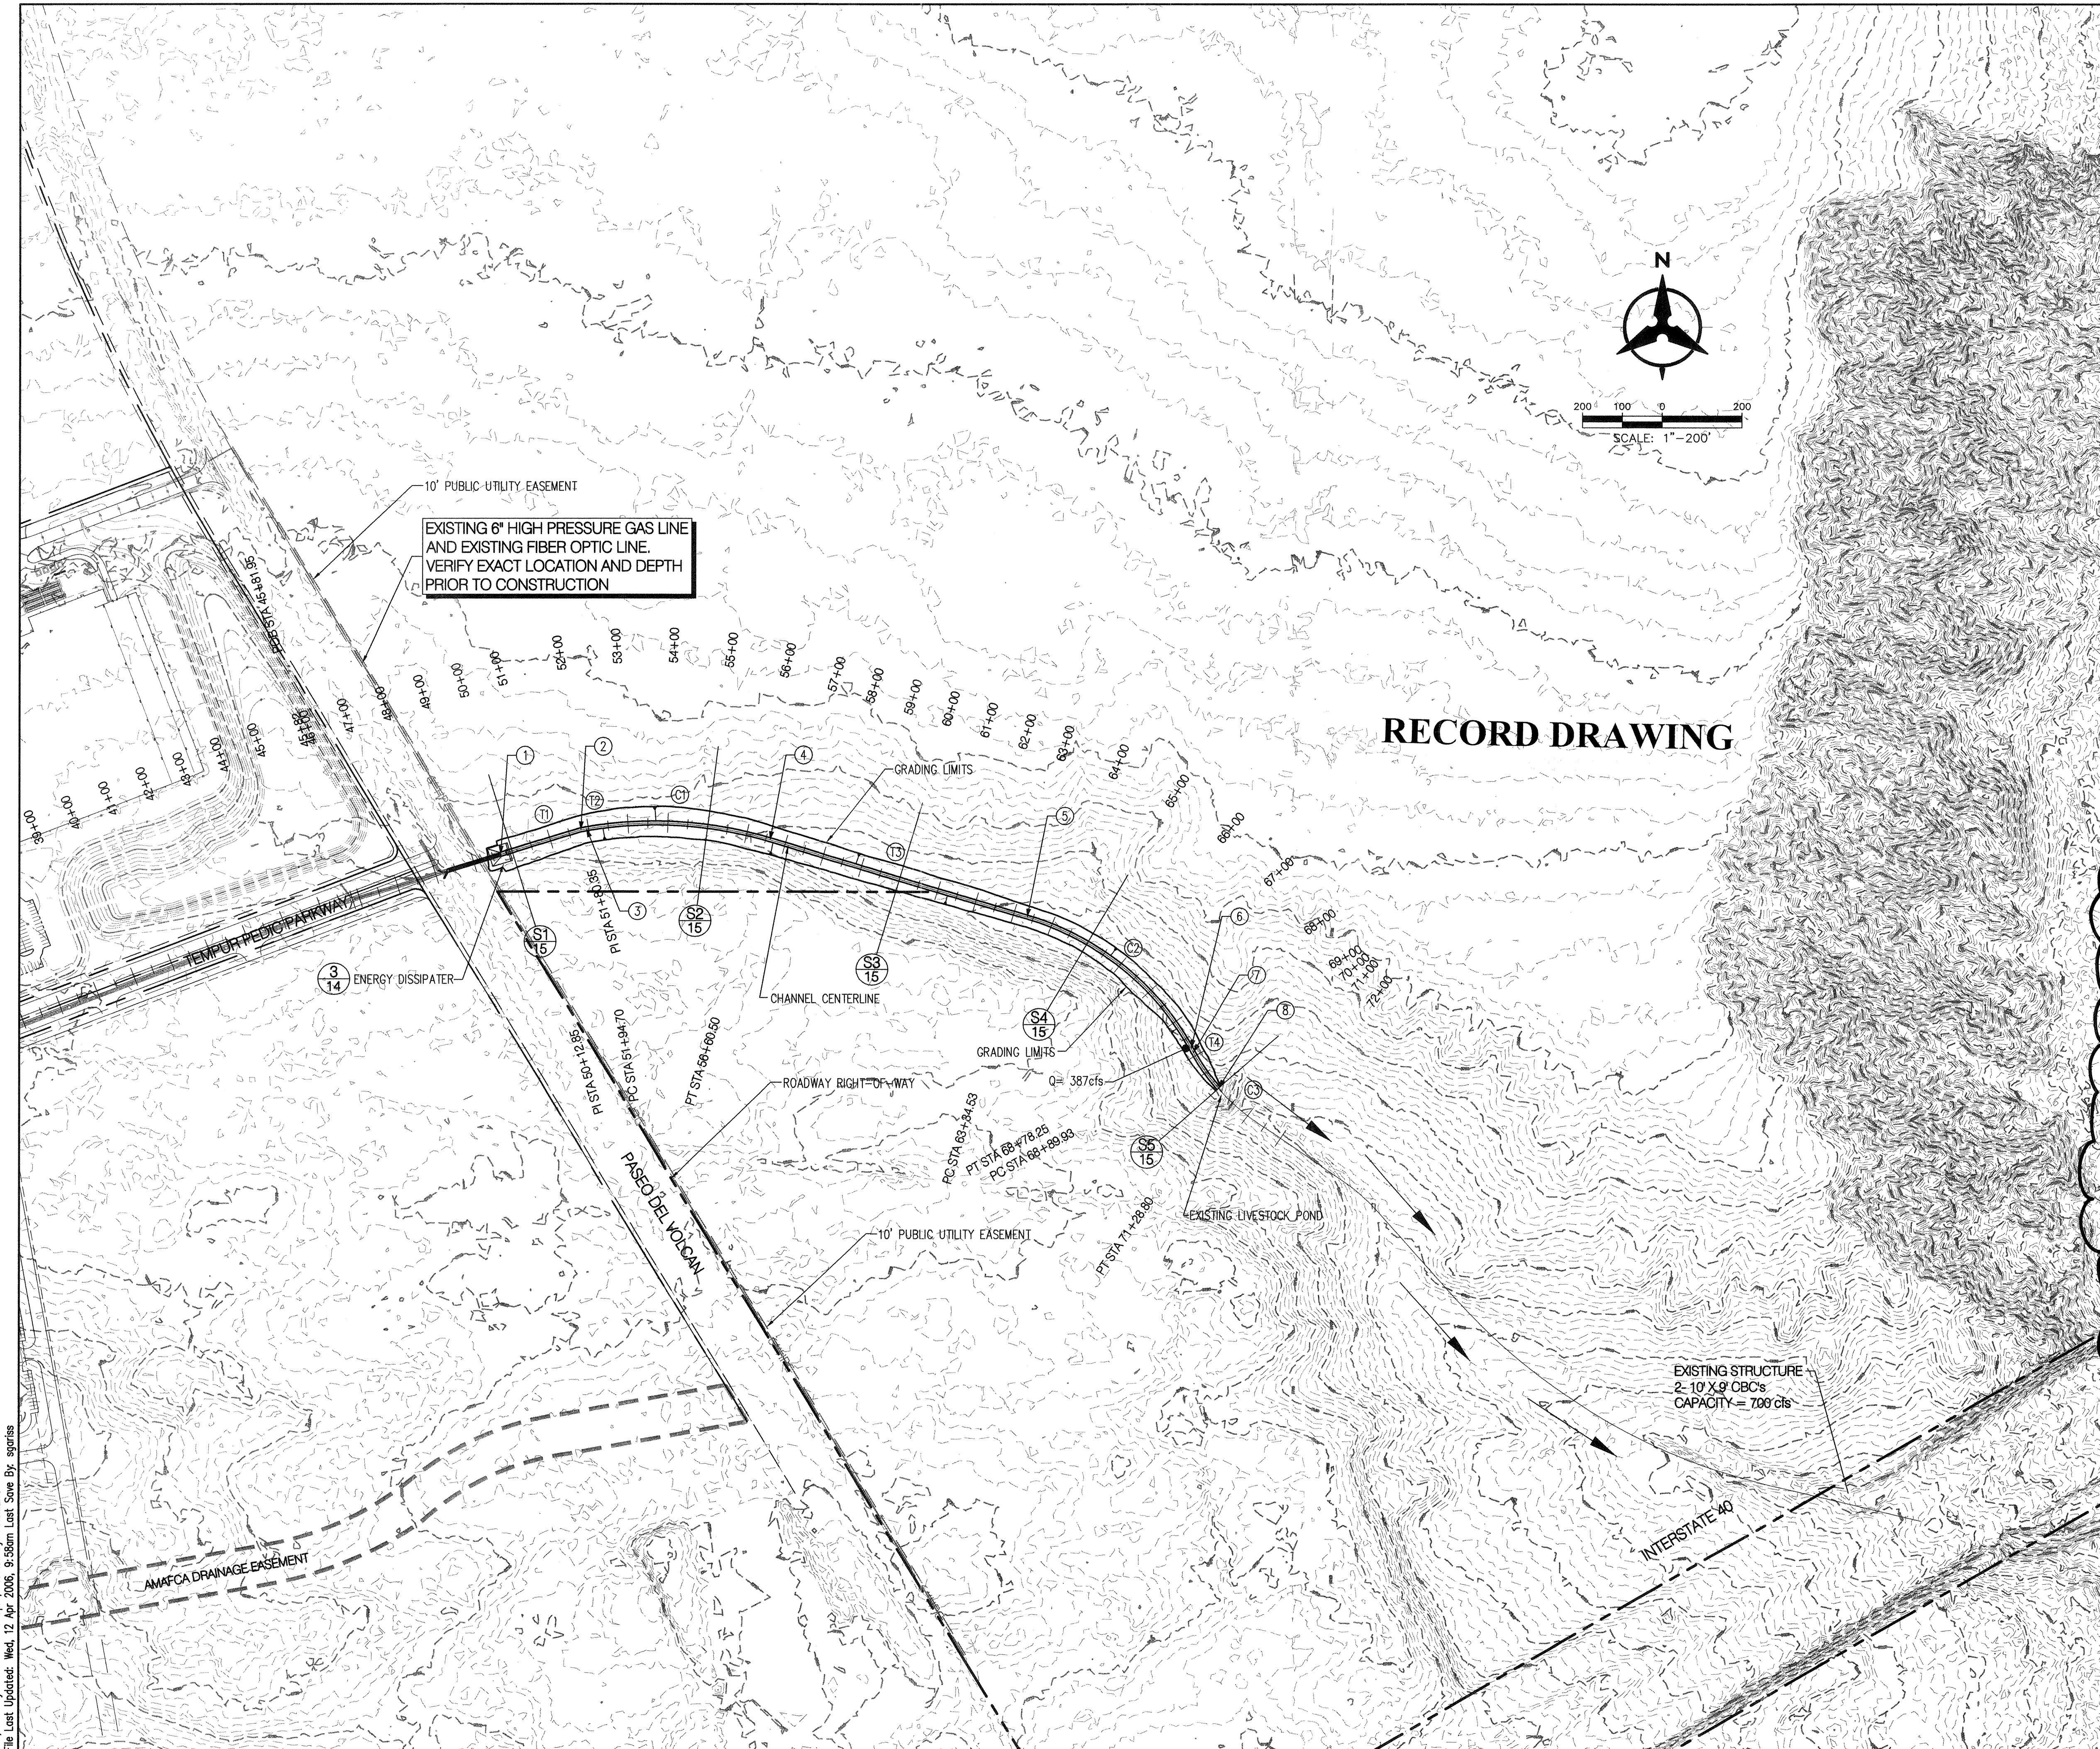

Curve Table				
ID	ARC	RADIUS	DELTA	TANGENT
C1	465.80'	1000.00'	26°41'18"	237.20'
C2	543.72'	700.00'	44°30'15"	286.41'
C3	238.86'	500.00'	27°22'17"	121.76'

Tangent Table		
ID	BEARING	LENGTH
T1	N72°57'53"E	167.50'
T2	N80°03'59"E	14.35'
T3	S73°14'43"E	674.03'
T4	S28°44'28"E	11.69'

Point Table		
	EASTING	NORTHING
1	337833.83	1482779.19
2	338034.82	1482840.86
3	338048.95	1482843.33
4	338509.73	1482815.87
5	339155.15	1482621.57
6	339567.12	1482287.88
7	339572.74	1482277.63
8	339635.81	1482187.77

CHANNEL Point Table			CHANNEL Point Table		
STATION	OFFSET	ELEVATION	STATION	OFFSET	ELEVATION
51+00	31.68' LT	5722.29	62+00	27.04' LT	5716.2
51+00	CL	5712.60	62+00	CL	5708.1
51+00	36.16' RT	5723.68	62+00	21.33' RT	5714.3
51+94	33.23' LT	5722.57	63+34	22.81' LT	5713.9
51+94	CL	5712.44	63+34	CL	5707.9
51+94	31.70' RT	5722.08	63+34	20.51' RT	5713.1
52+99	38.76' LT	5723.55	64+00	23.33' LT	5713.8
52+99	CL	5711.77	64+00	CL	5707.4
52+99	31.41' RT	5721.25	64+00	21.00' RT	5712.8
54+00	37.78' LT	5723.07	65+00	19.94' LT	5712.6
54+00	CL	5711.34	65+00	CL	5707.4
54+00	31.27' RT	5720.91	65+00	19.76' RT	5712.2
55+00	34.90' LT	5721.78	66+00	21.13' LT	5712.4
55+00	CL	5711.35	66+00	CL	5706.9
55+00	29.92' RT	5720.43	66+00	20.73' RT	5712.1
56+59	31.53' LT	5719.77	67+00	20.89' LT	5711.6
56+59	CL	5710.54	67+00	CL	5706.4
56+59	33.07' RT	5719.84	67+00	21.92' RT	5712.5
57+00	30.55' LT	5719.23	68+00	23.75' LT	5712.2
57+00	CL	5710.67	68+00	CL	5706.2
57+00	32.18' RT	5719.74	68+00	14.78' RT	5709.2
58+00	28.87' LT	5718.54	68+78	15.88' LT	5709.34
58+00	CL	5710.34	68+78	CL	5706.1
58+00	28.65' RT	5718.05	68+78	12.59' RT	5708.43
59+00	28.71' LT	5717.58	68+89	15.27' LT	5708.88
59+00	CL	5709.94	68+89	CL	5705.95
59+00	26.11' RT	5717.09	68+89	11.28' RT	5707.97
60+00	30.11' LT	5717.67	69+60	9.12' LT	5706.63
60+00	CL	5709.18	69+60	CL	5705.07
60+00	26.12' RT	5716.46	69+60	8.22' RT	5705.96
61+00	27.38' LT	5716.50	71+50	35.79' LT	5703.54
61+00	CL	5708.95	71+49	29.84' LT	5703.65
61+00	23.75' RT	5715.41	71+48	22.07' LT	5704.0


**Bohannan Huston** INC.  
P.O. Box 1000 • 7500 Jefferson St. NE • Albuquerque, NM 87109-4335  
TELEPHONE: (505) 247-1000 • FAX: (505) 247-1001  
E-mail: [bh@bhinc.com](mailto:bh@bhinc.com)

**County of Bernalillo  
Public Works Division  
State of New Mexico**


# CORDERO MESA STORM DRAIN STORM WATER CHANNEL HORIZONTAL CONTROL PLAN

Mo./Da.

APPROVED	APPROVED	Mo./Day/Year	Mo./Day/Year
JUN 28 2008	SUPERVISOR		
DESIGN REVIEW COMMITTEE	SEAL		
SILVY-ENGINEERS			
Project No.	Zone Map No.	Drawing No.	Sheet      Of
<b>060238</b>	<b>K-5,K-6,L-6,L-7</b>	<b>G2</b>	<b>12</b> <b>16</b>
		Last Design Update	

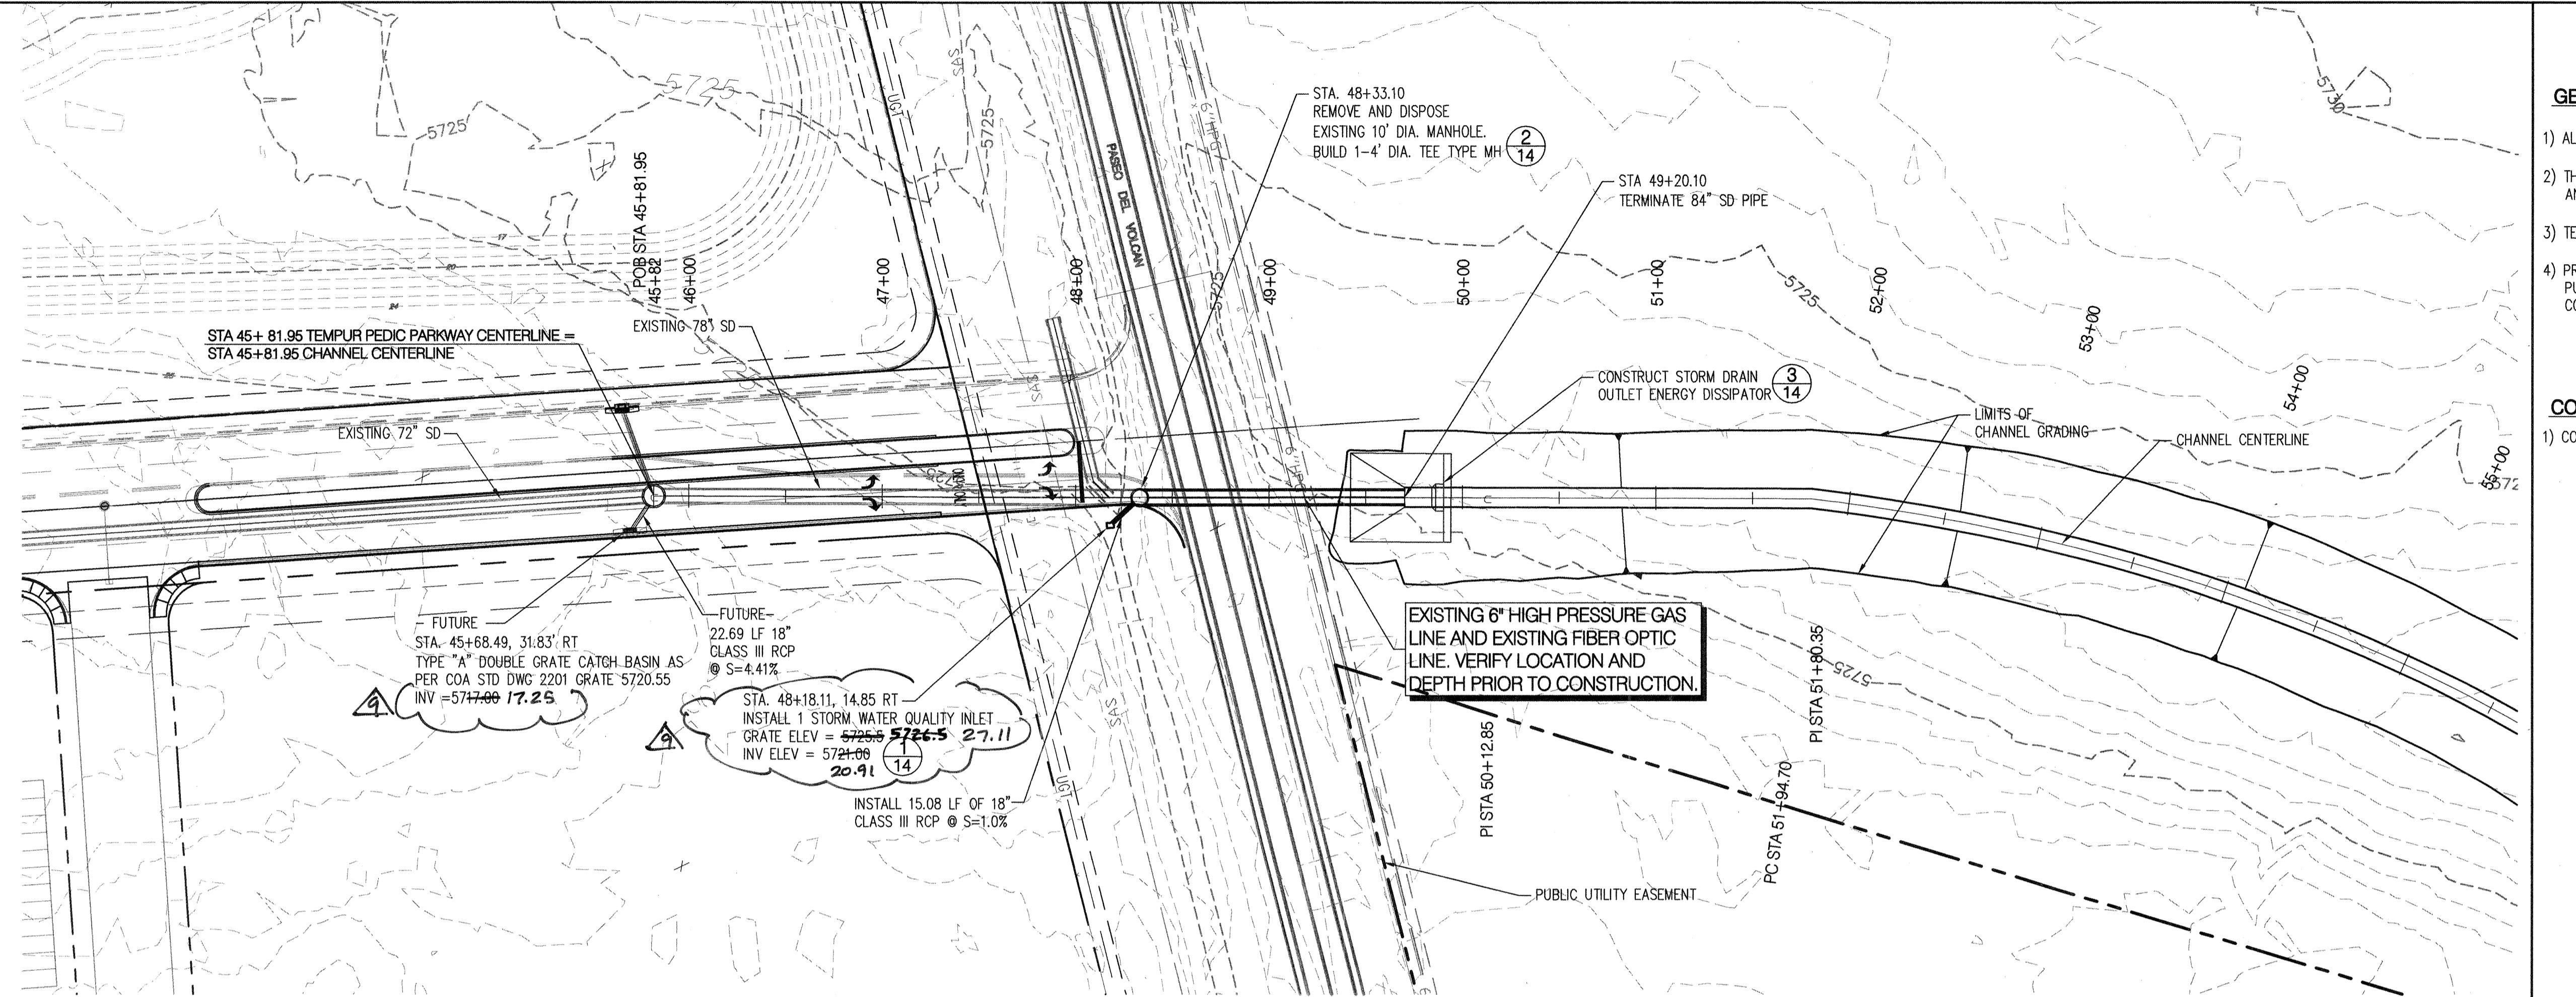

## TEMPUR PEDIC PARKWAY STORM DRAIN OUTFALL

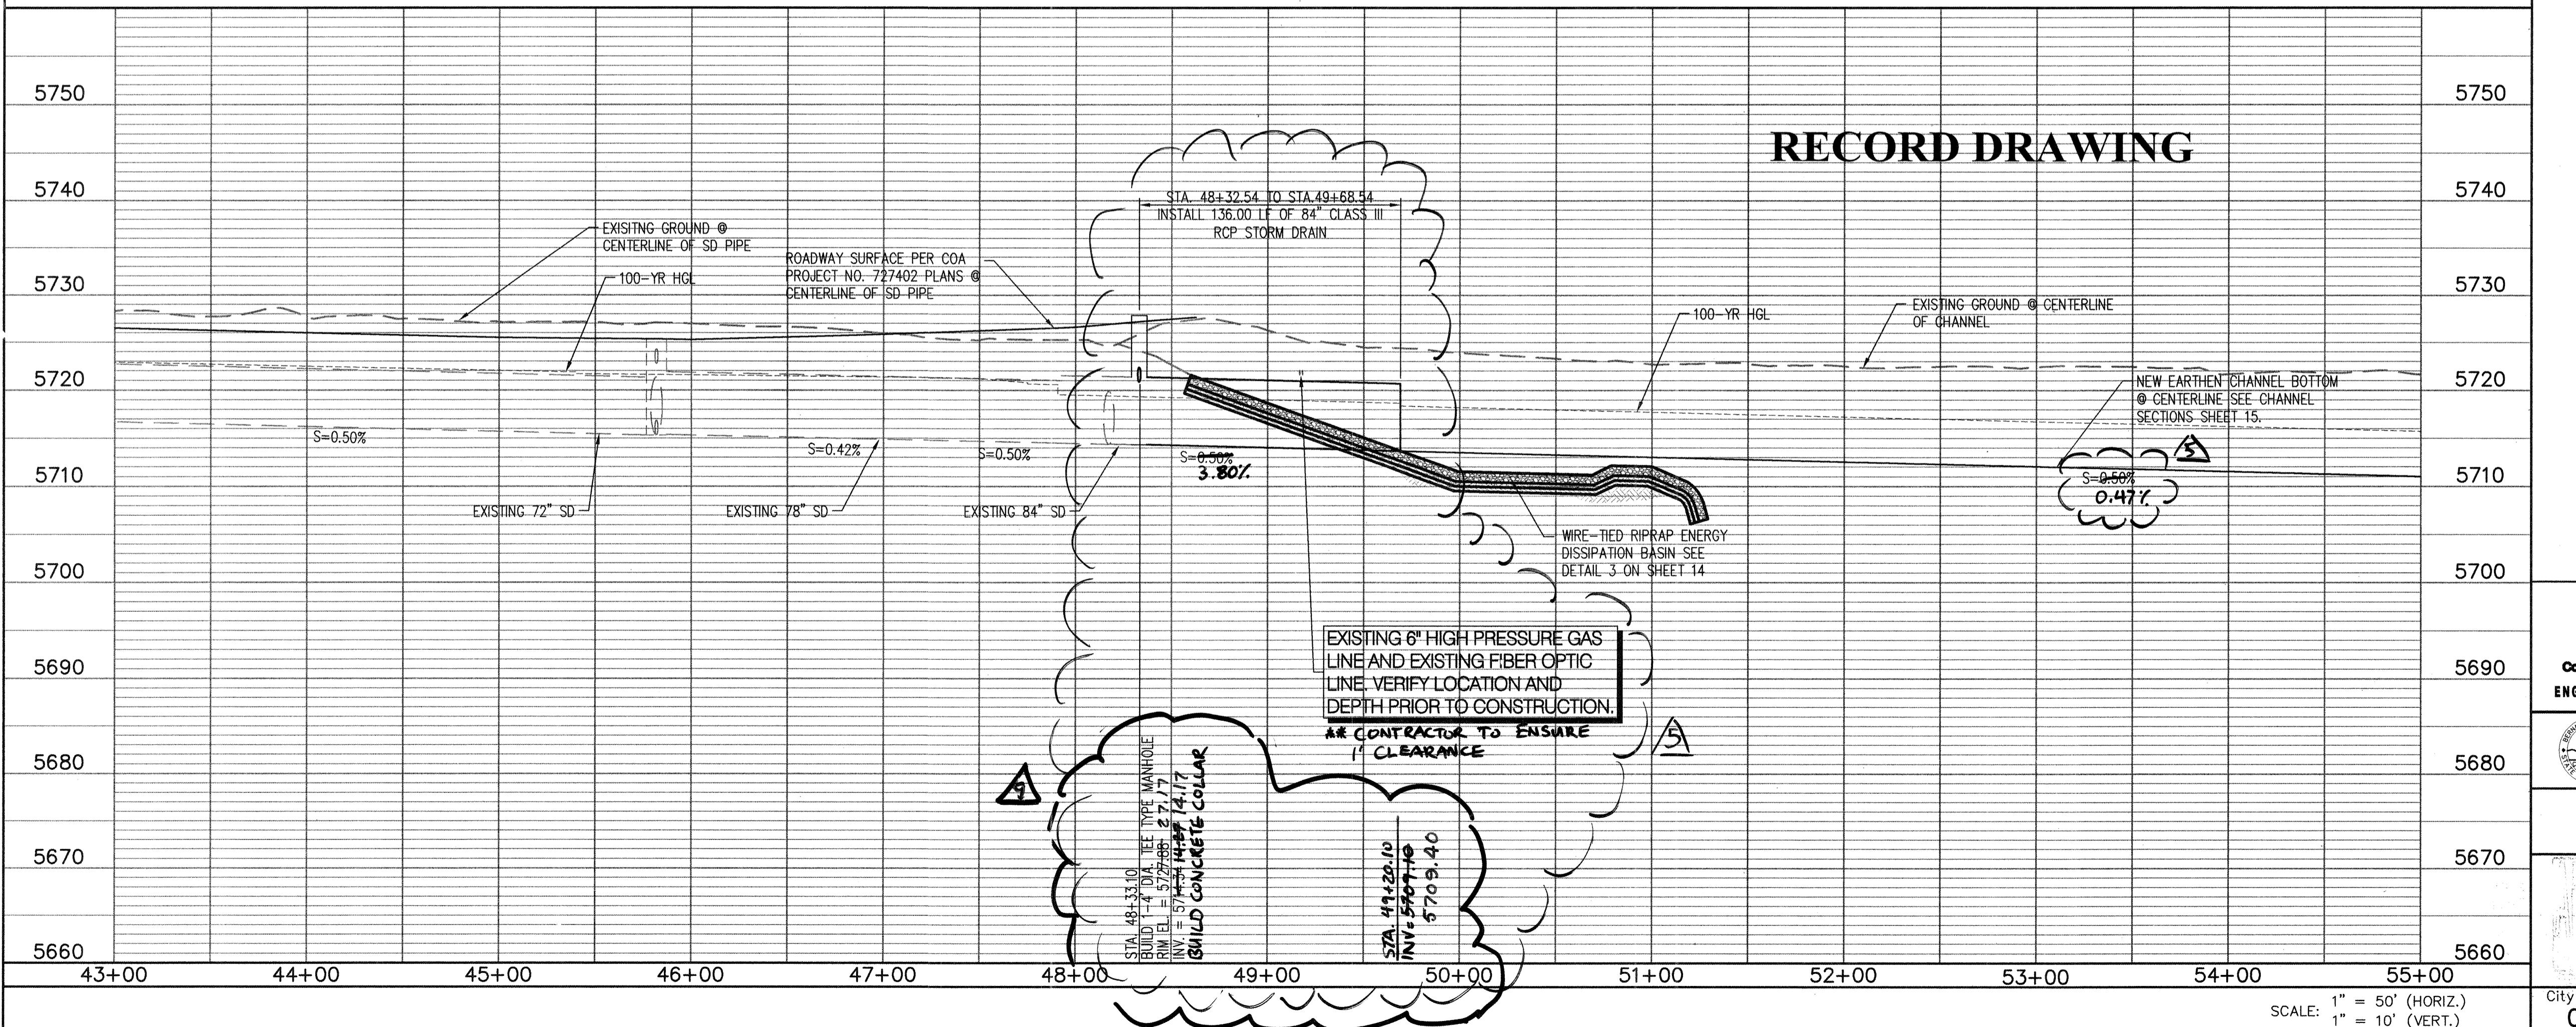

# RECORD DRAWING

**phannan** ▲ **Huston**,  
INC.

**7500 Jefferson St. NE Albuquerque, NM 87109-4335**

**County of Bernalillo  
Public Works Division  
State of New Mexico**

**CORDERO MESA  
PUR PEDIC PARKWAY STORM DRAIN OUTFALL  
PLAN AND PROFILE STA 43+00 TO STA 55+00**

P:\060238\WR\design\plans\060238SD-PNP01.dwg  
Thu, 25 May 2006 - 4:52:37pm, Plotted by: AROMERO  
File Last Updated: Thu, 27 Apr 2006, 3:45pm Last Save By: ssariss

## GENERAL NOTES

- ALL STORM DRAIN PIPE SHALL BE CLASS III RCP.

THE CONTRACTOR SHALL FIELD VERIFY ALL UTILITY LOCATIONS AND NOTIFY THE ENGINEER OF ANY DISCREPANCIES.

TEE MANHOLE SHALL BE CONSTRUCTED PER DETAIL 1, SHEET 4.




PROTECT ALL EXISTING UTILITIES. ANY DAMAGE TO EXISTING PUBLIC OR PRIVATE UTILITIES SHALL BE REPAIRED AT CONTRACTORS EXPENSE.

## **CONSTRUCTION NOTES**


- CONTRACTOR SHALL VERIFY ALL ELEVATIONS IN THE FIELD.

FIELD NOTES		CONTRACTOR'S STAKEOUT NO. DATE 2/07	
DATE	NMSHC BRASS CAP STAMPED "I-40-27A"	WORK STAKED BY	DATE 2/07
	GEOGRAPHIC POSITION (NAD 1927)	INSPECTOR'S ACCEPTANCE BY	DATE 2/07
	MODIFIED STATE PLANE COORDINATES	FIELD VERIFICATION BY	DATE 2/07
	N = 1481056.174, E = 341090.969	DRAWINGS CORRECTED BY	DATE 2/07
	GROUND TO GRID FACTOR = 0.999655608		
	NGVD 1929 ELEVATION = 5681.458	MICRO-FILM INFORMATION	
		RECORDED BY	DATE
		NO.	


SEE SHEET 14A FOR DETAIL 3

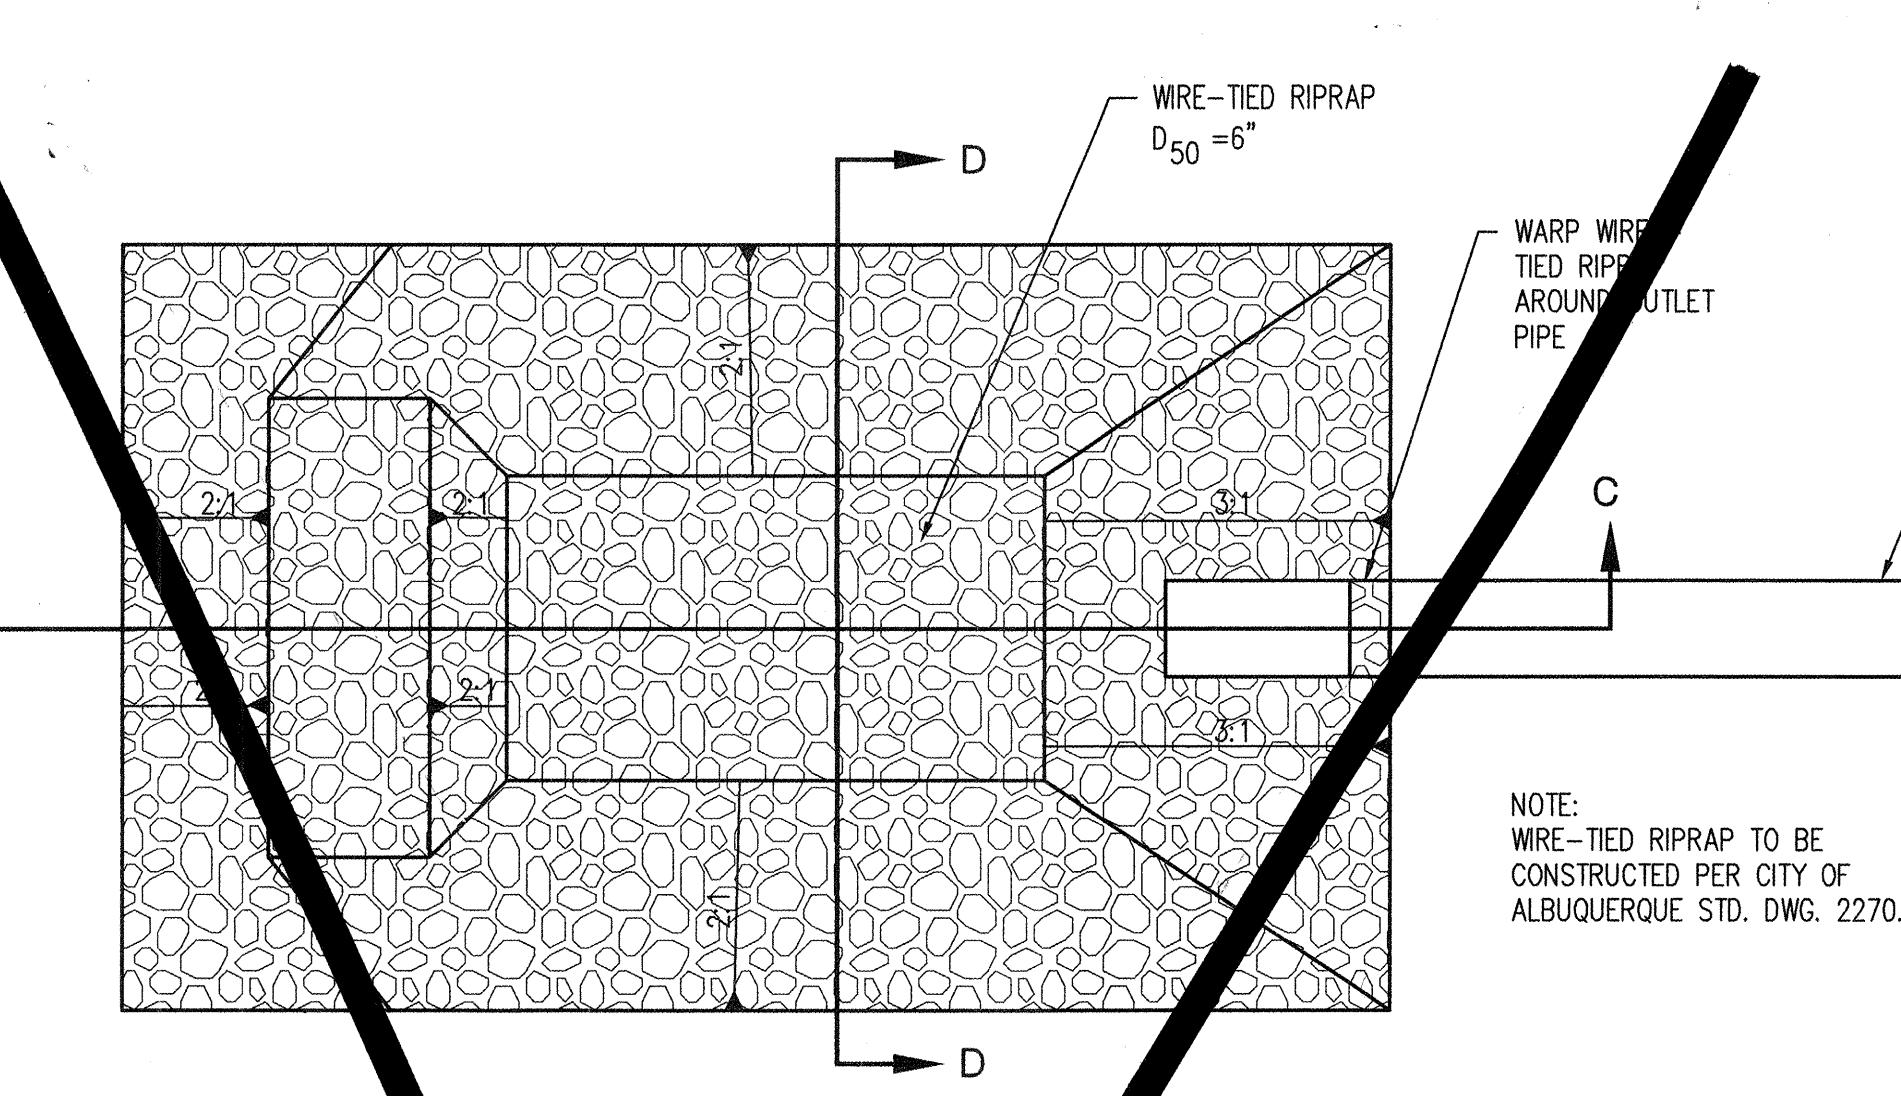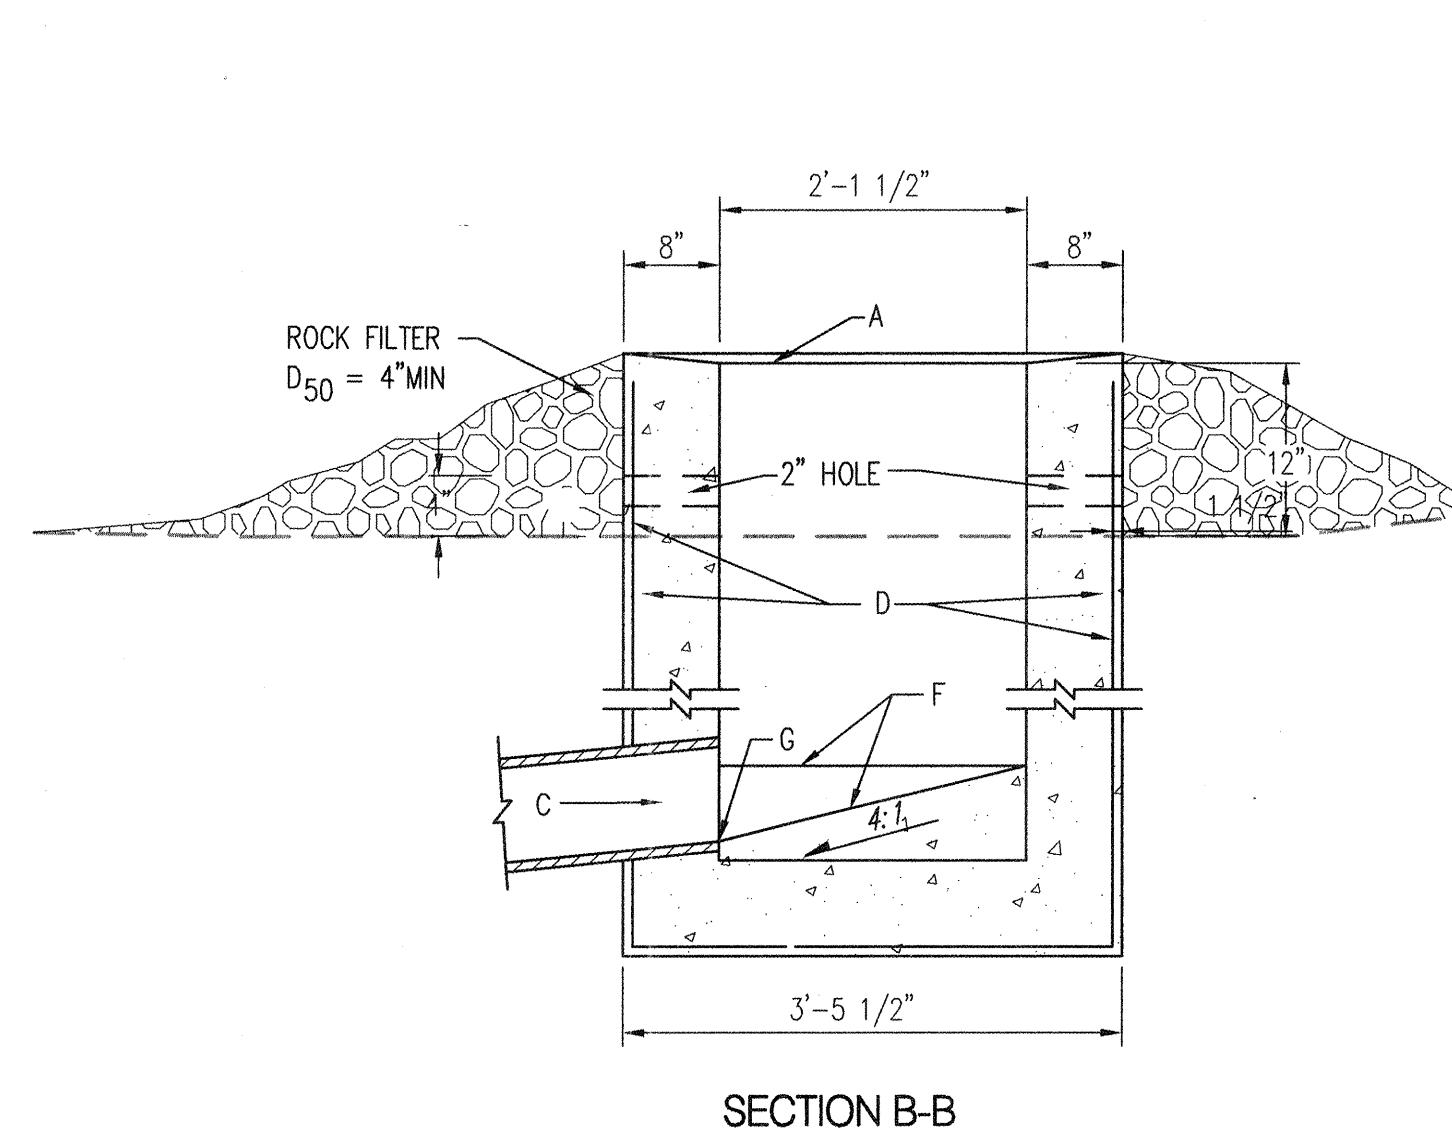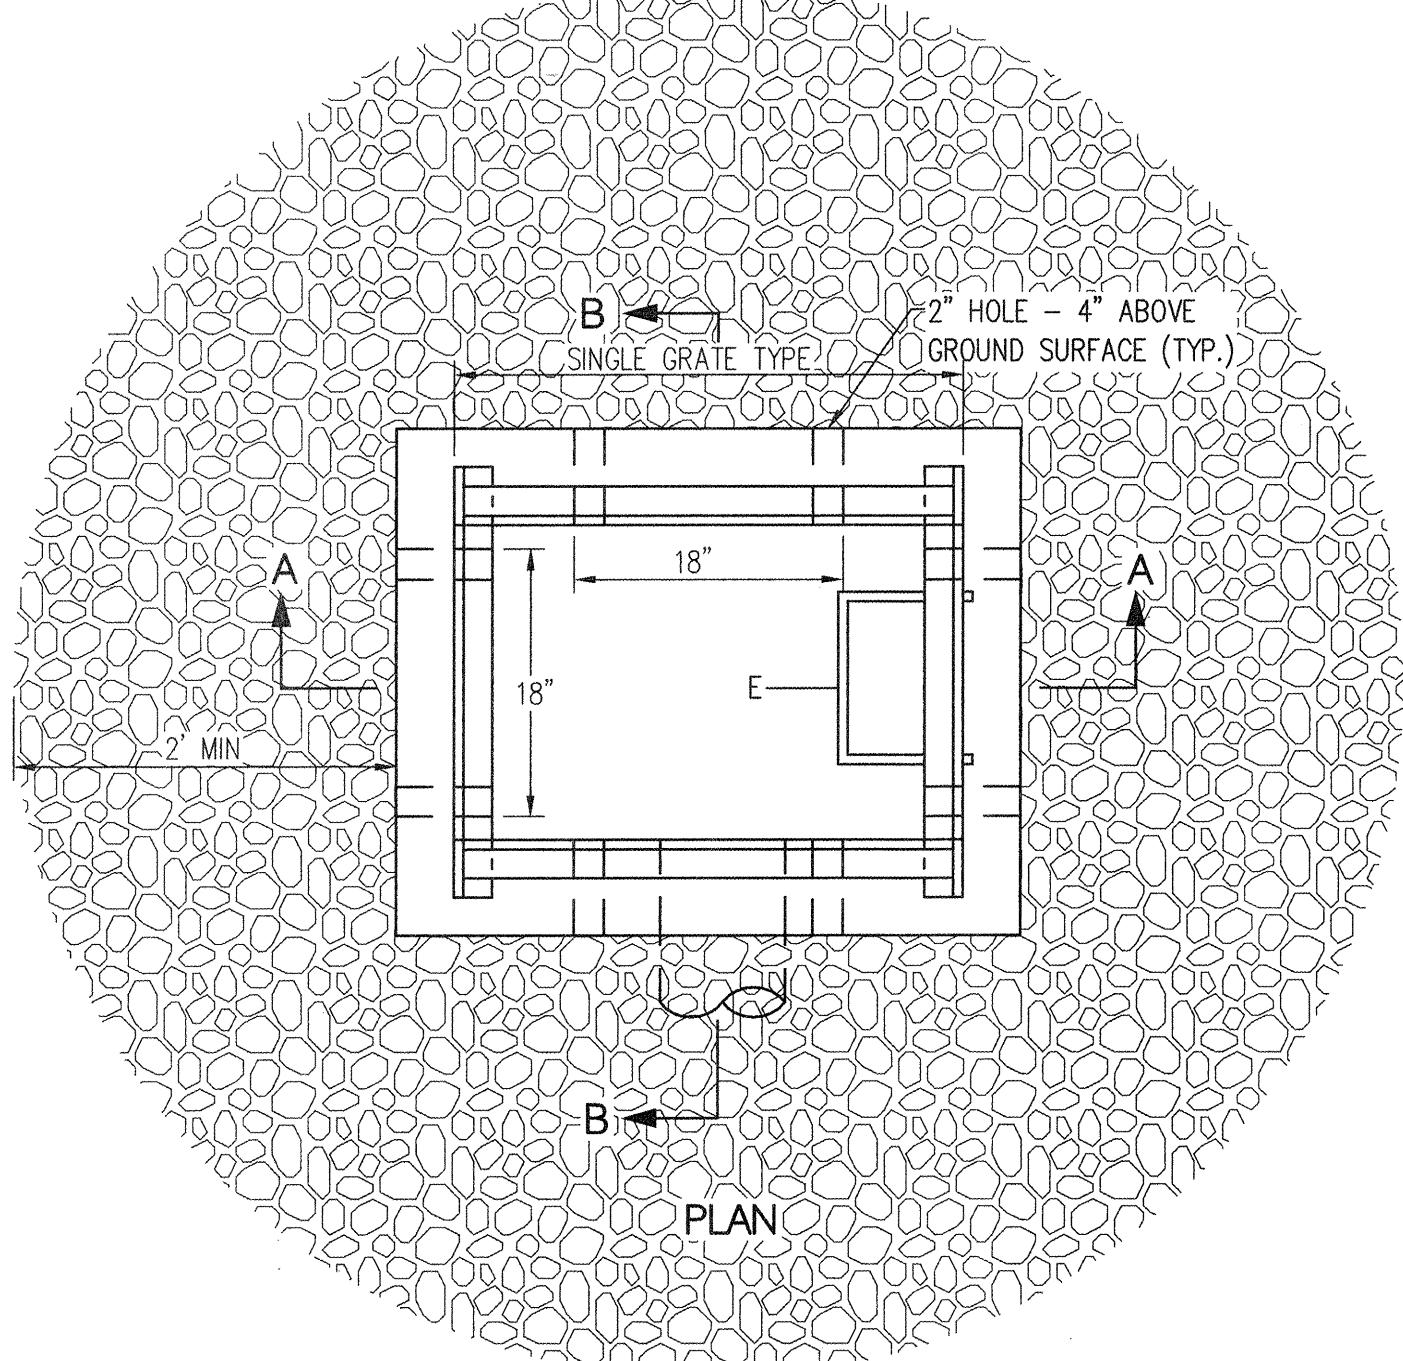

# RECORD DRAWING

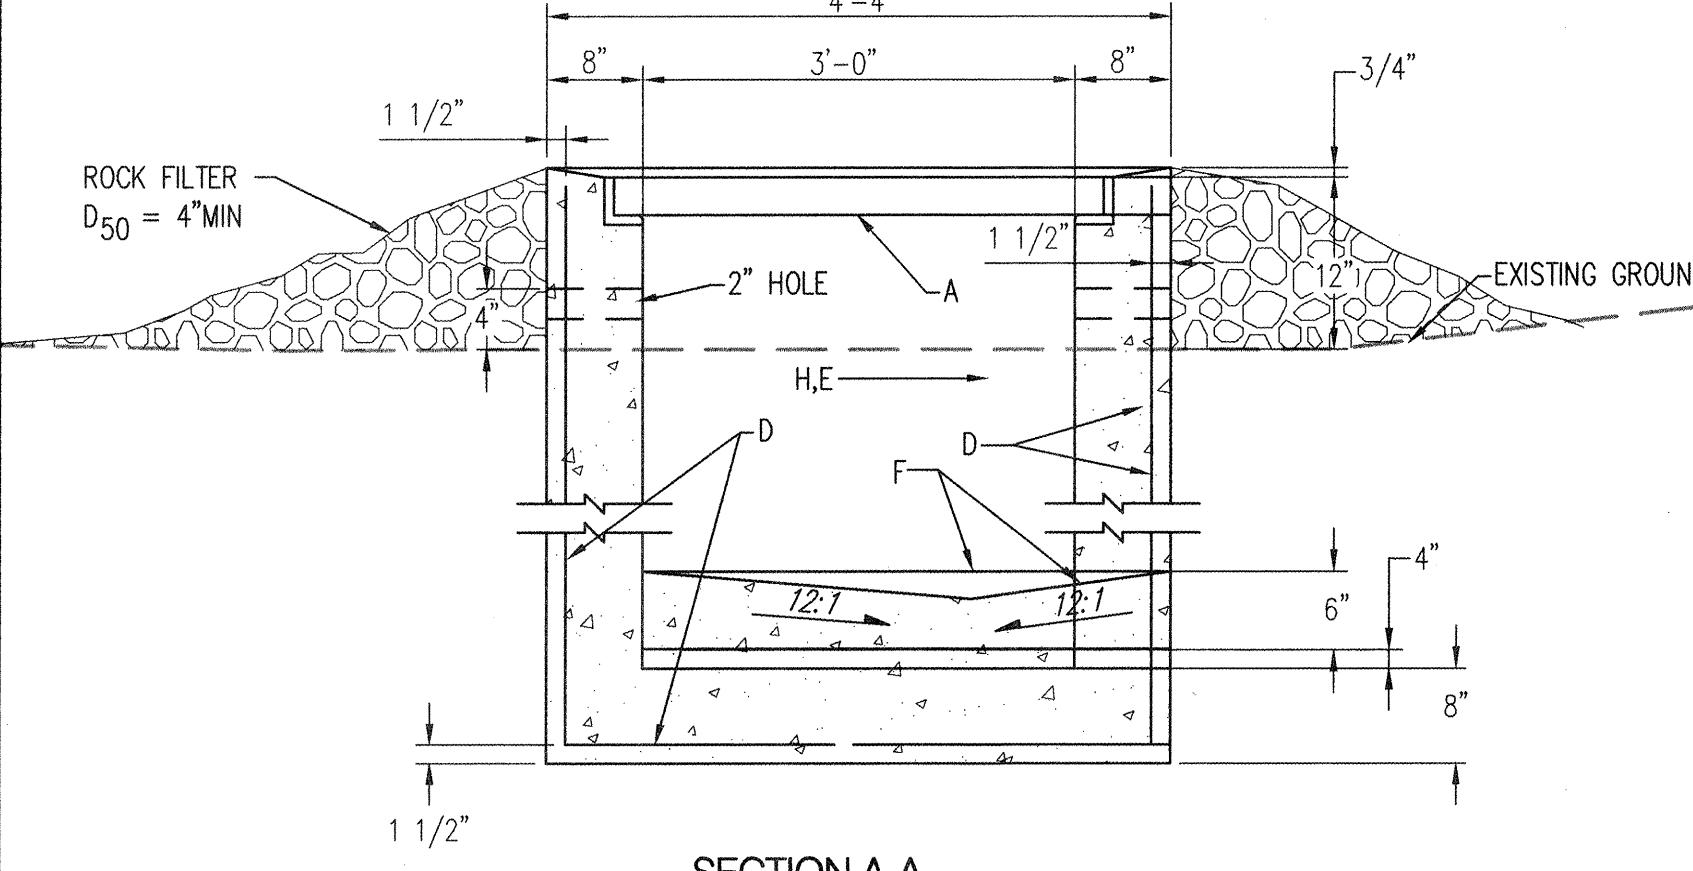

**1** STORM WATER QUALITY INLE  
3 7 SCALE: N.T.S.

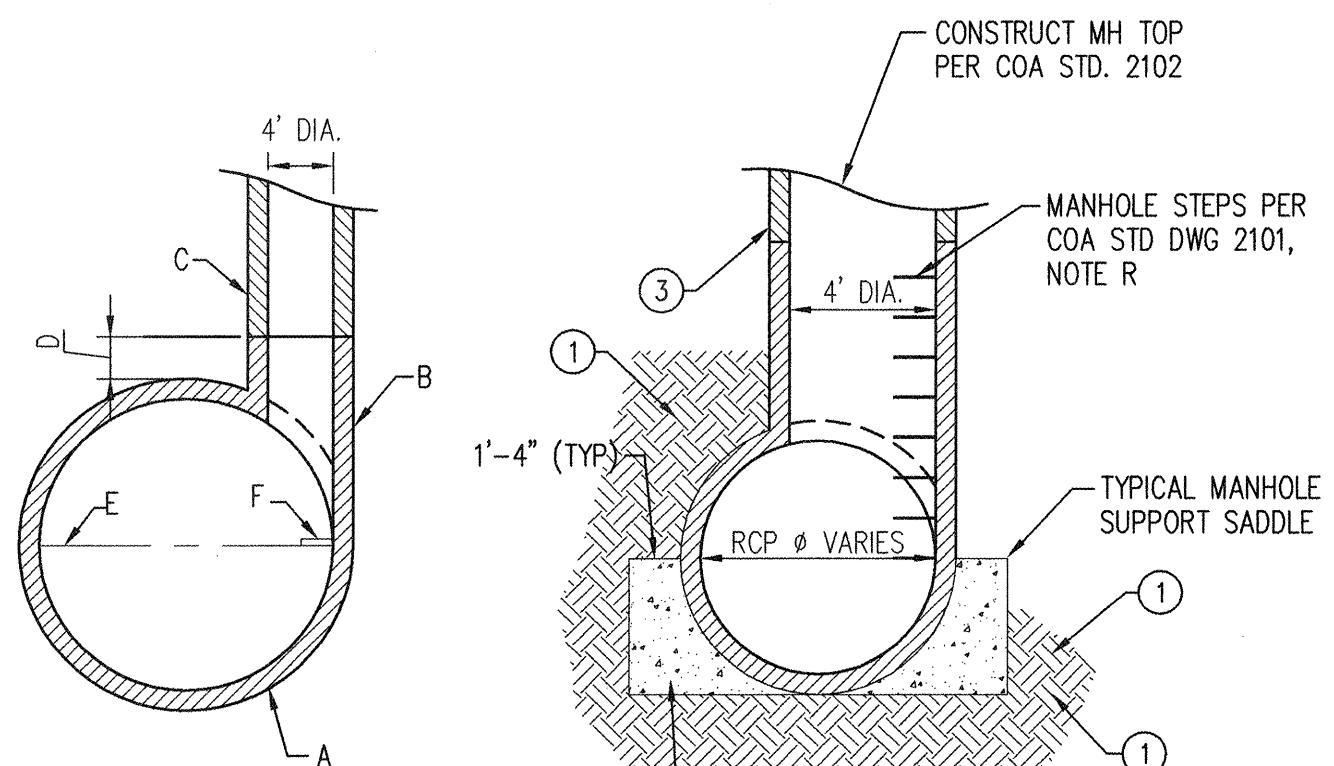


2 TEE TYPE MANHOLE  
3 7 SCALE: N.T.S.

## GENERAL NOTE


1. FOR FRAME & GRATING, SEE COA STD. 2216  
2220 & 2221.

## CONSTRUCTION NOTE

- A. FRAME & GRATE.
  - B. \_\_\_\_\_
  - C. CUT ONE HORIZONTAL AND ONE VERTICAL BAR MAX. AT PIPE OPENING.
  - D. NO. 4 BARS AT 6" O.C. EACH WAY.
  - E. USE STANDARD STEPS, SEE COA STD. 2229.
  - F. CONC. FILL, SEE NOTE C COA STD. 2201.
  - G. INVERT PFR DESIGN

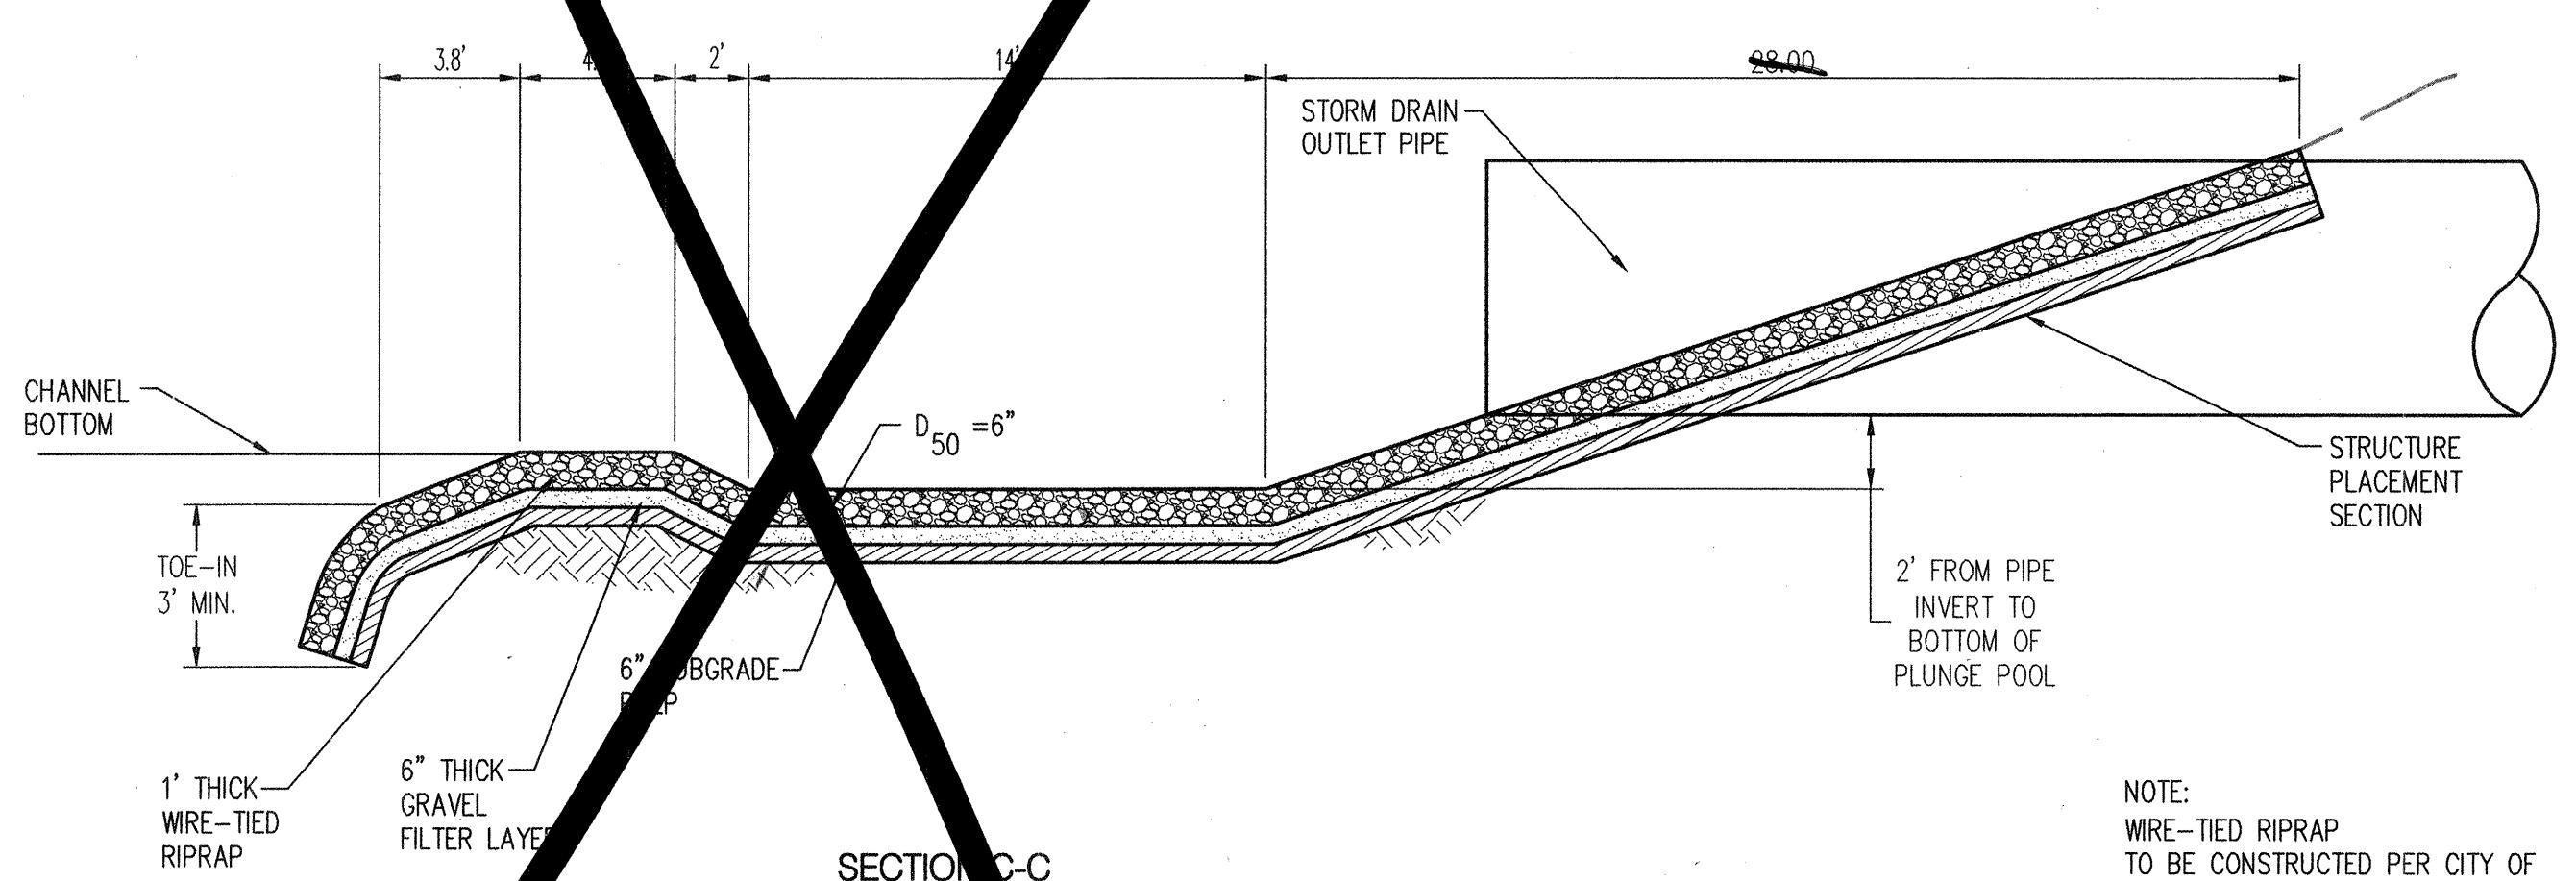

TE:  
RE-TIED RIPRAP  
BE CONSTRUCTED PER CITY OF  
BUQUEROLLE STD. DWG. 2270

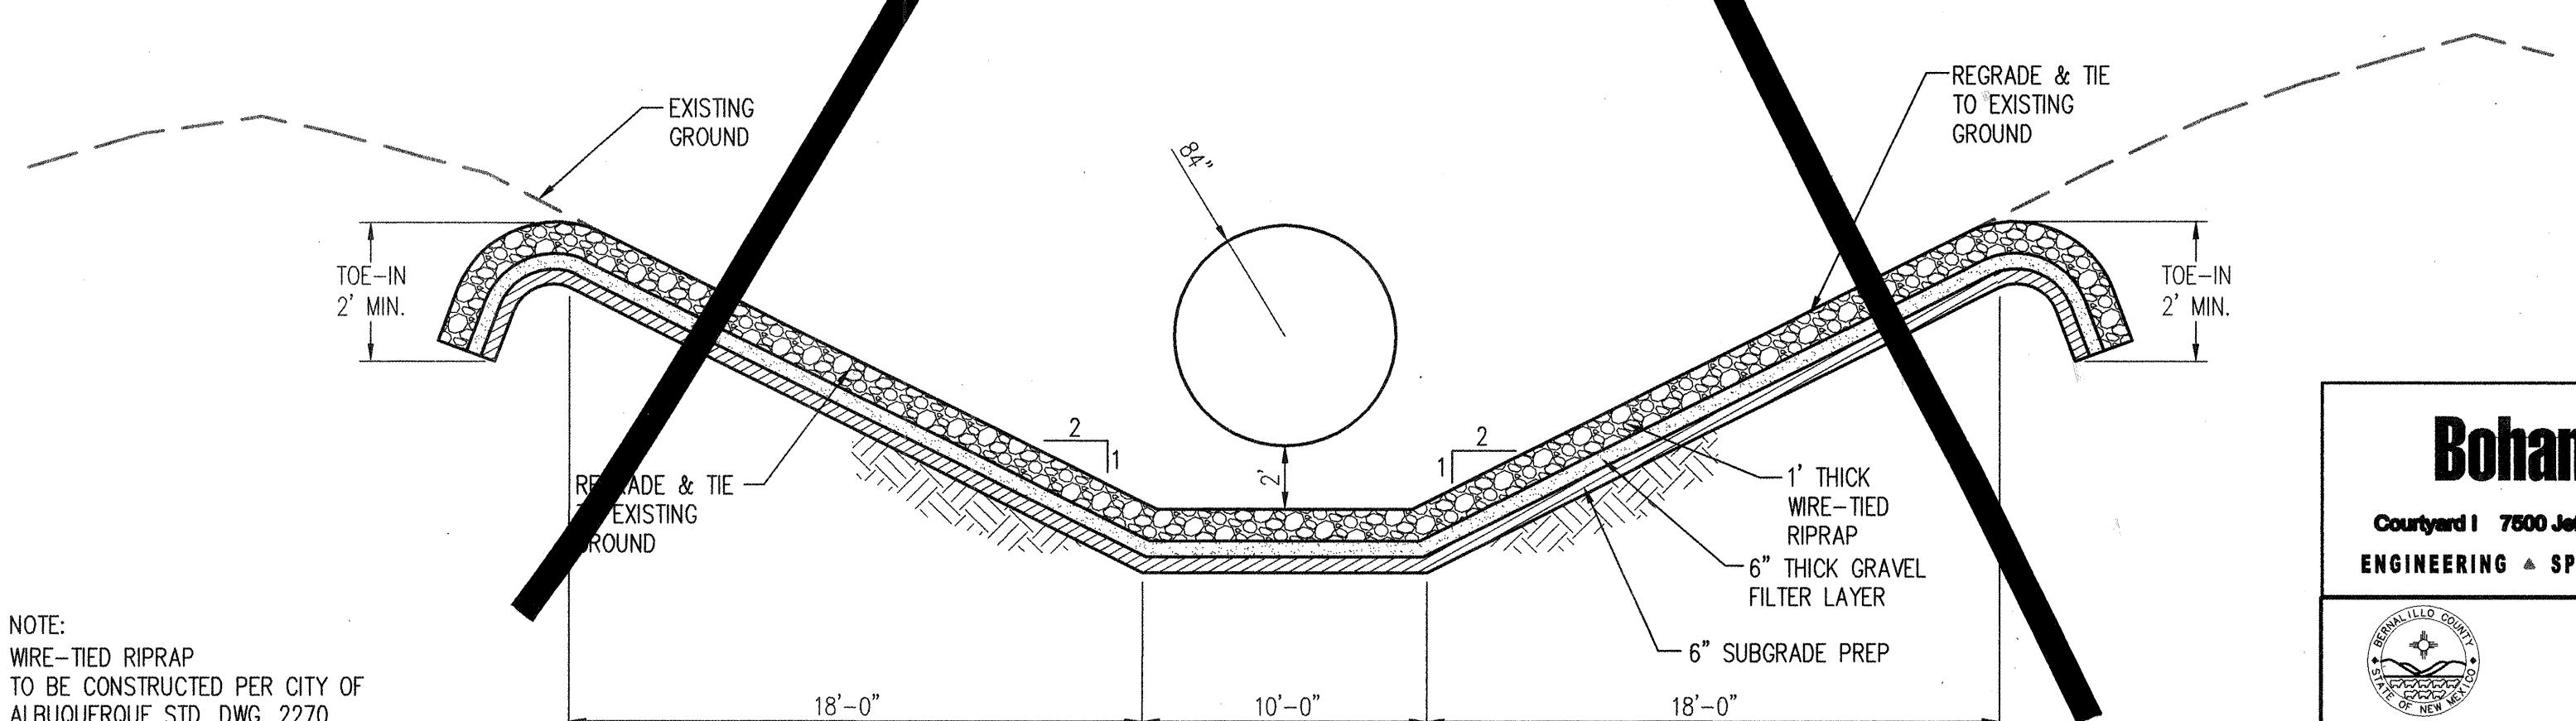


SECTION D-D




# **County of Bernalillo Public Works Division State of New Mexico**


# CORDERO MESA STORM DRAIN MISCELLANEOUS DETAILS





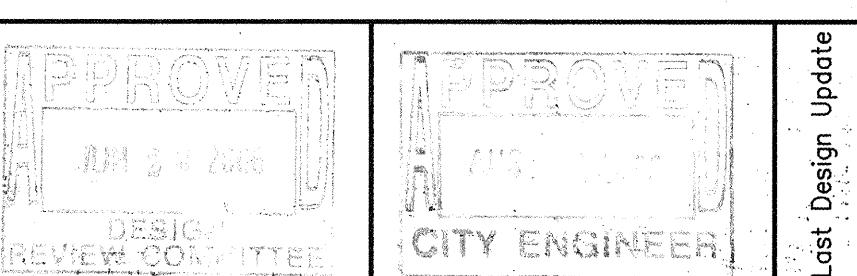


Project No. 060238 Zone Map No. K-5,K-6,L-6,L-7 Drawing No. C2 Sheet 14 Of 16

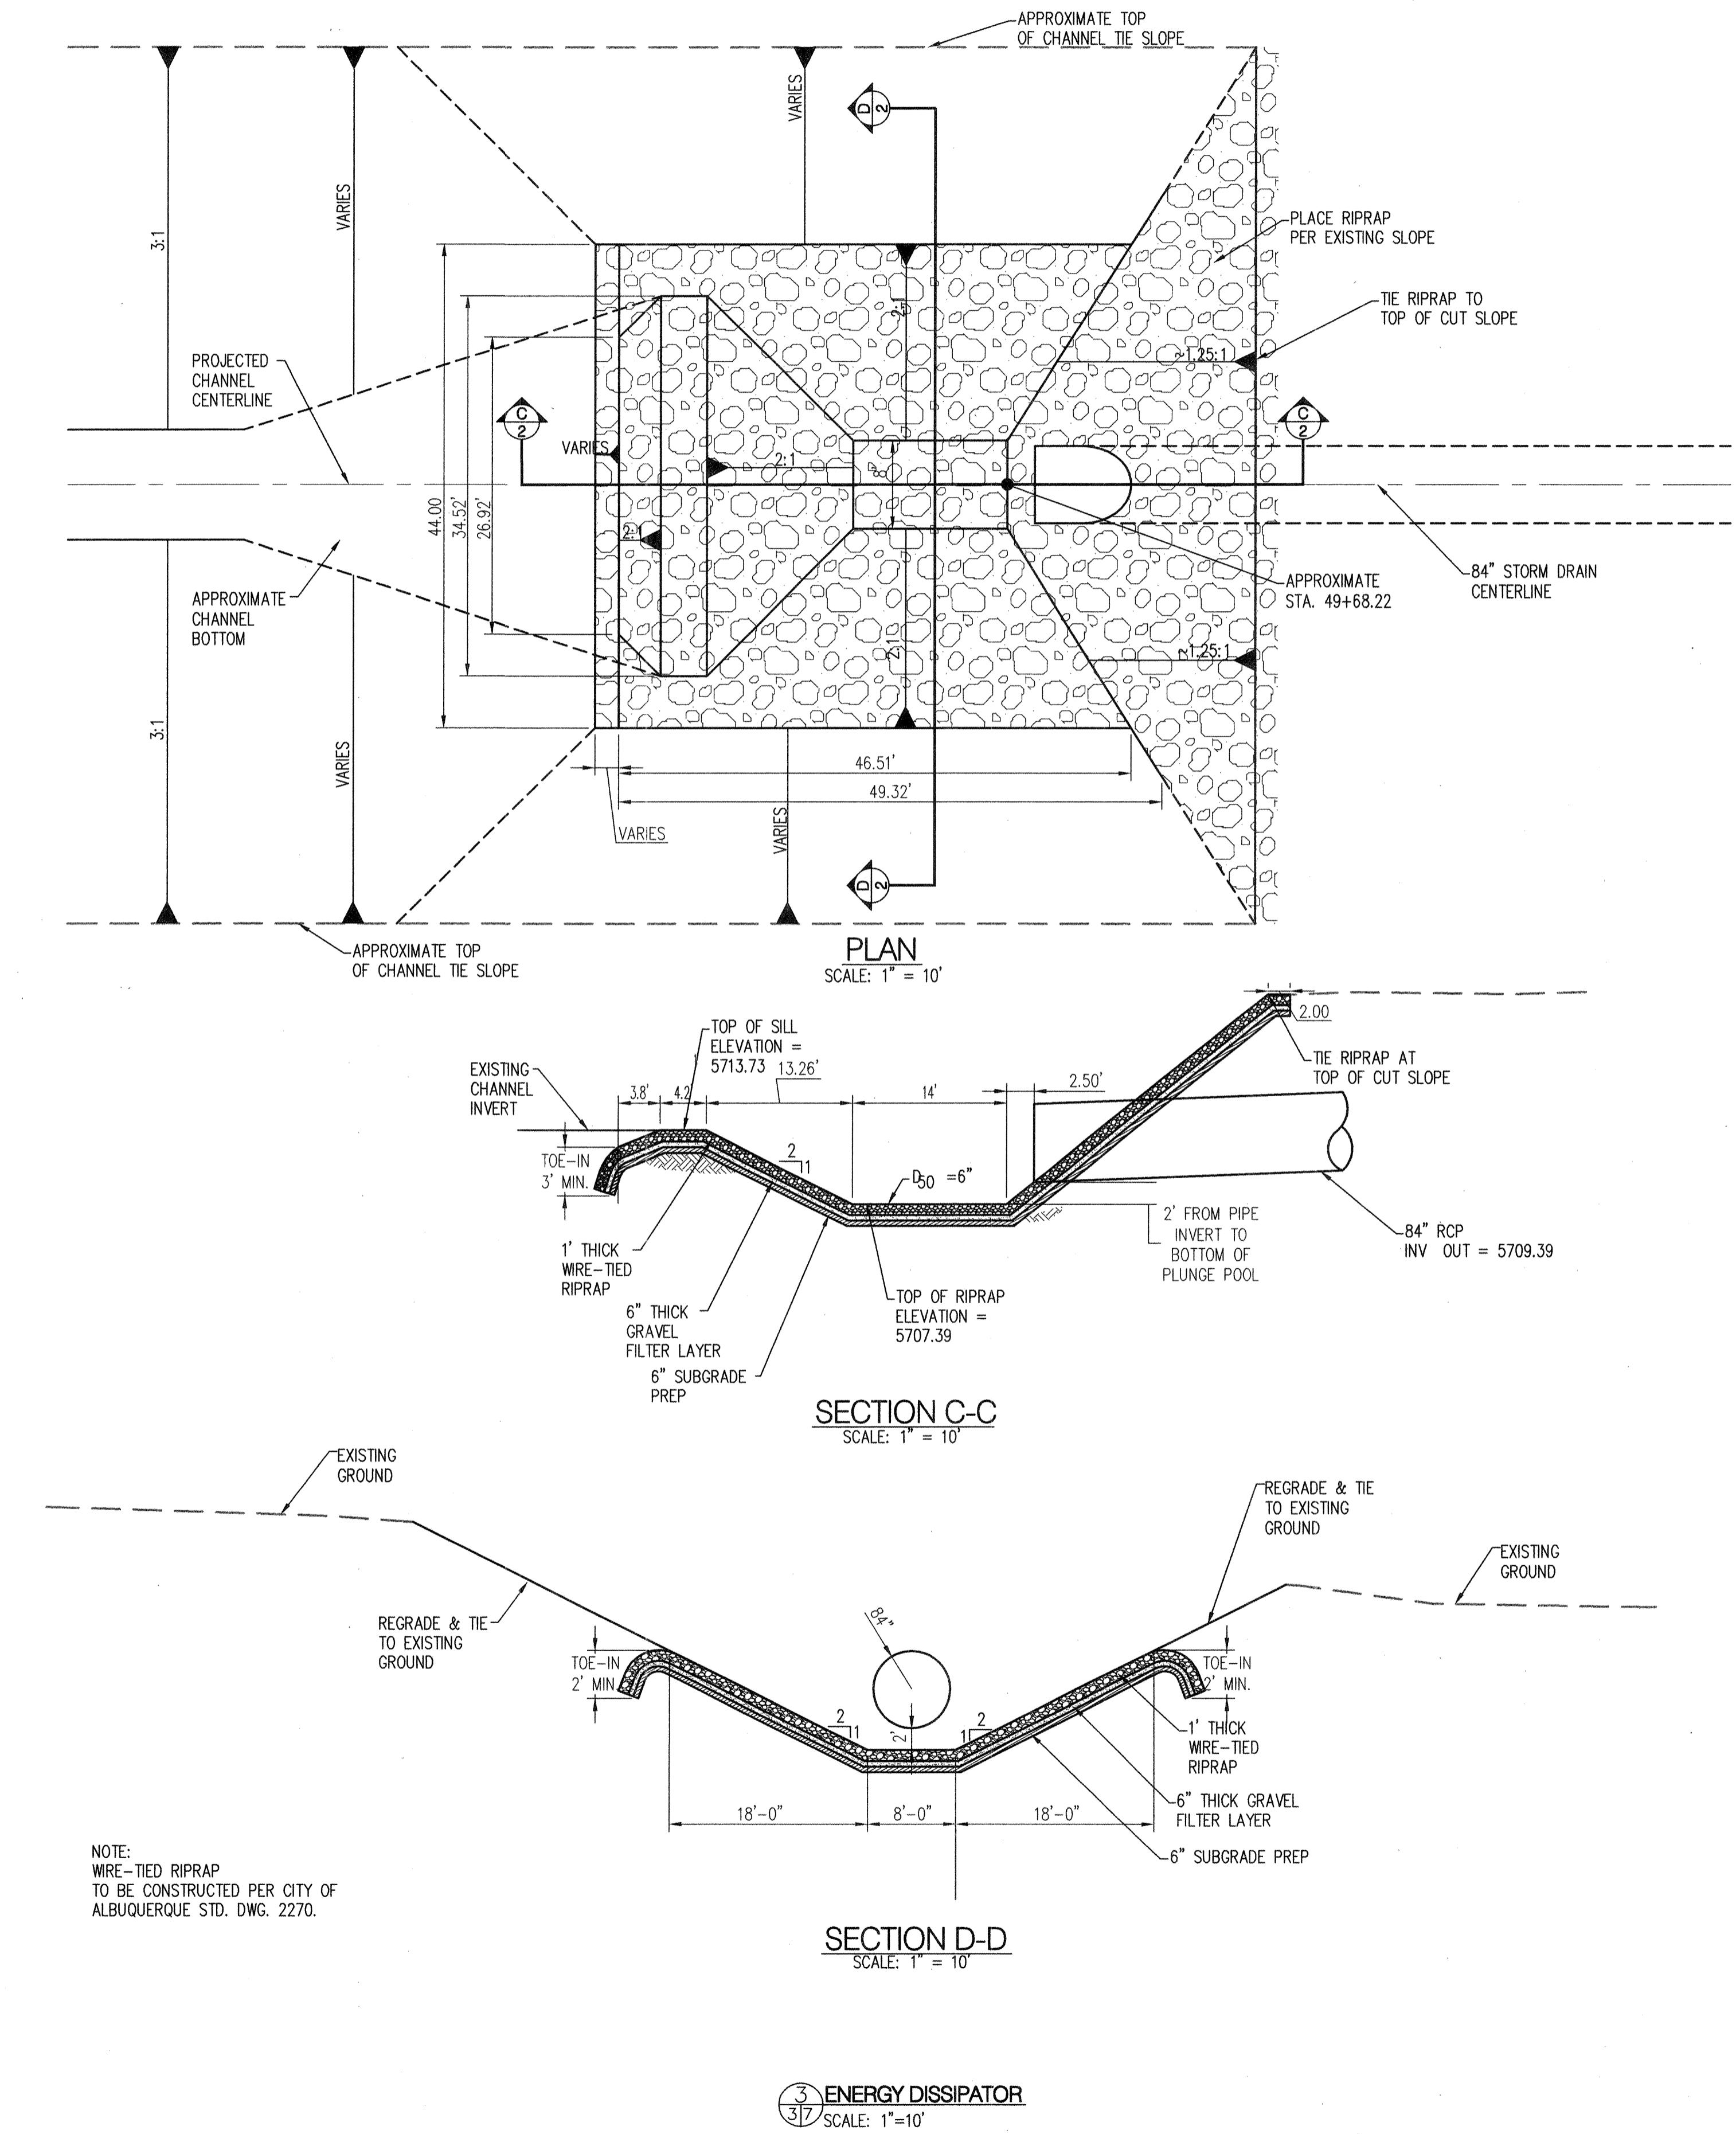



# RECORD DRAWING

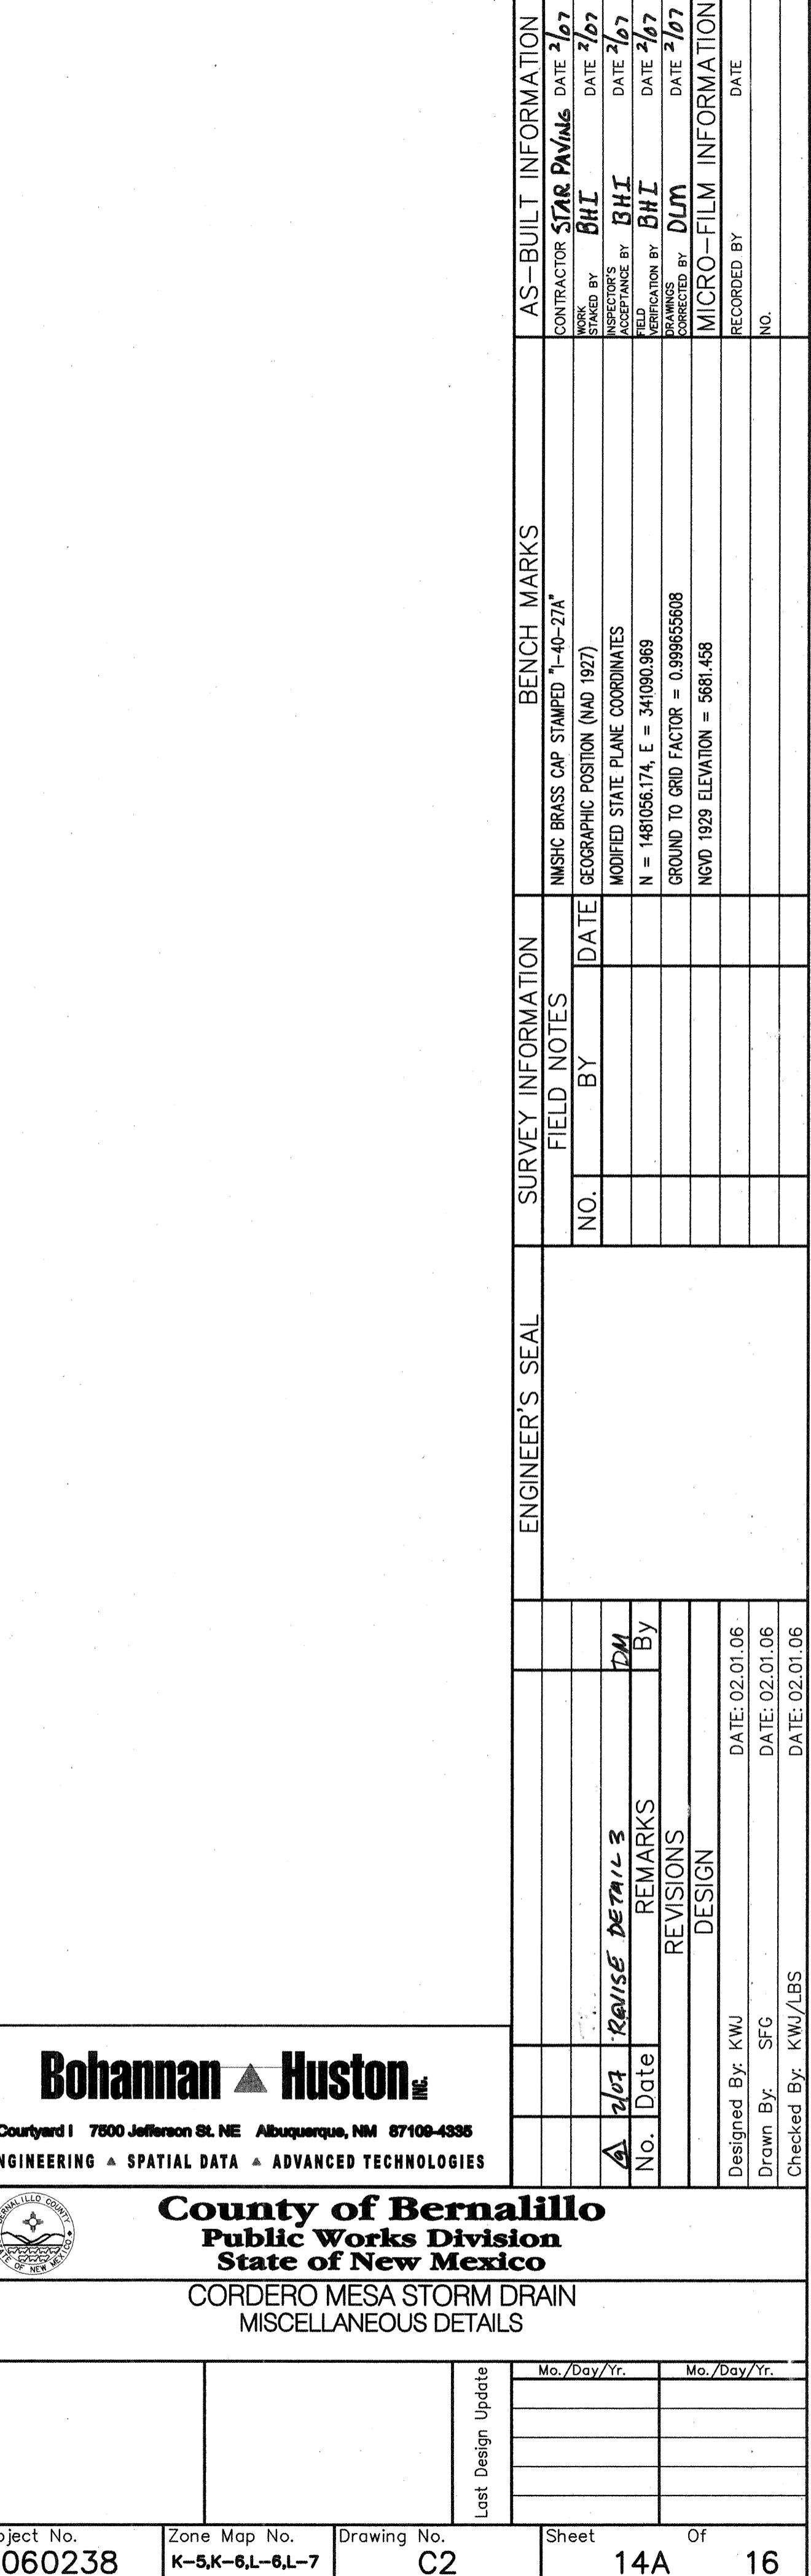

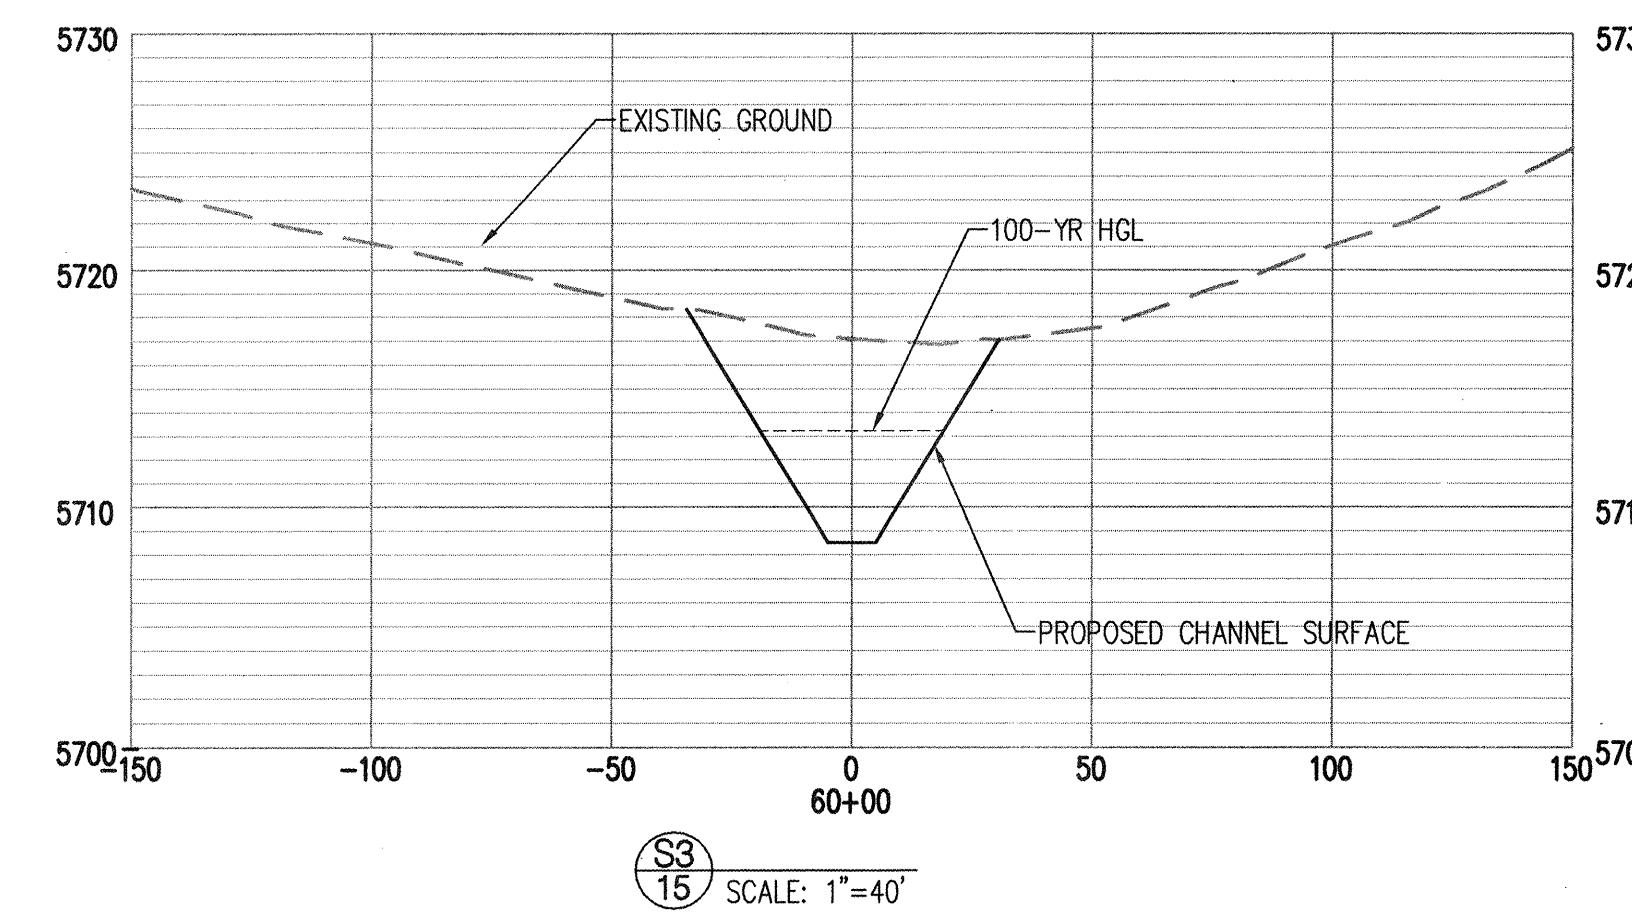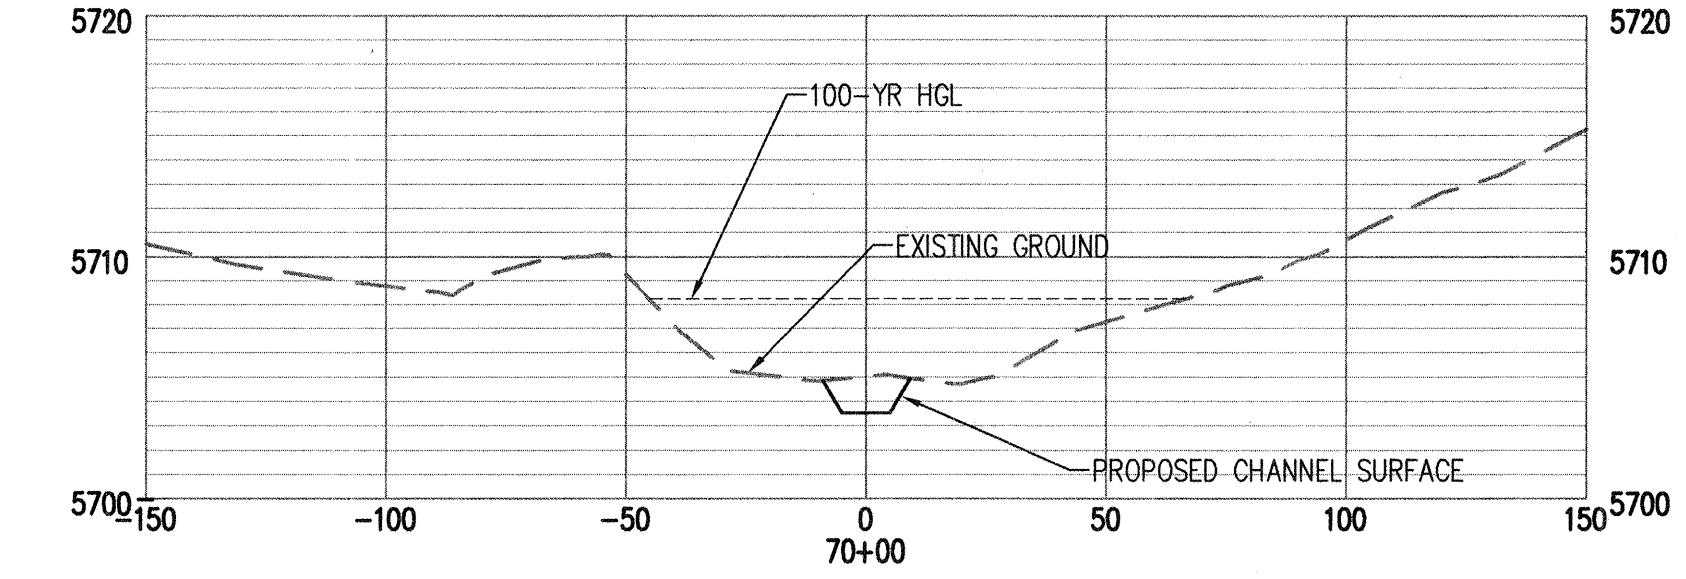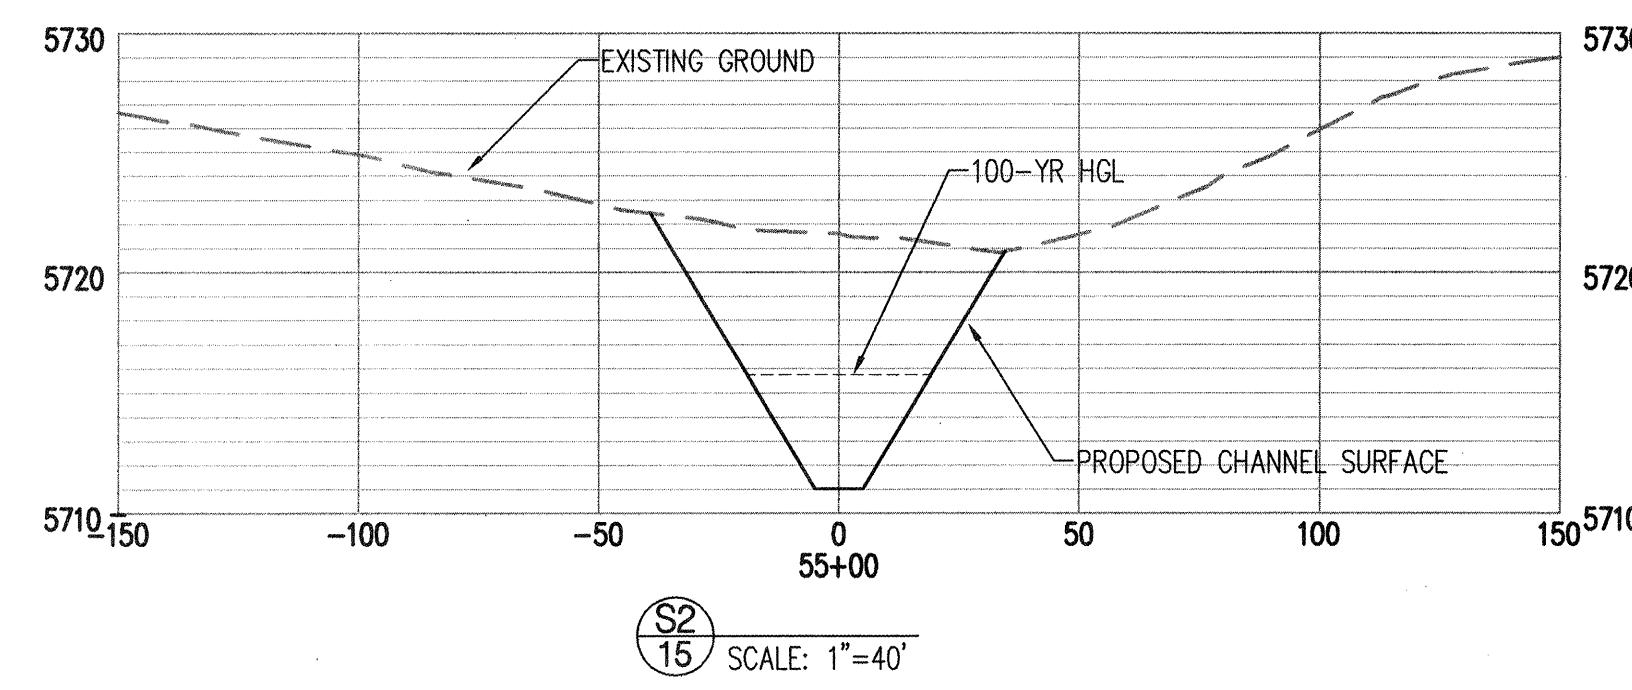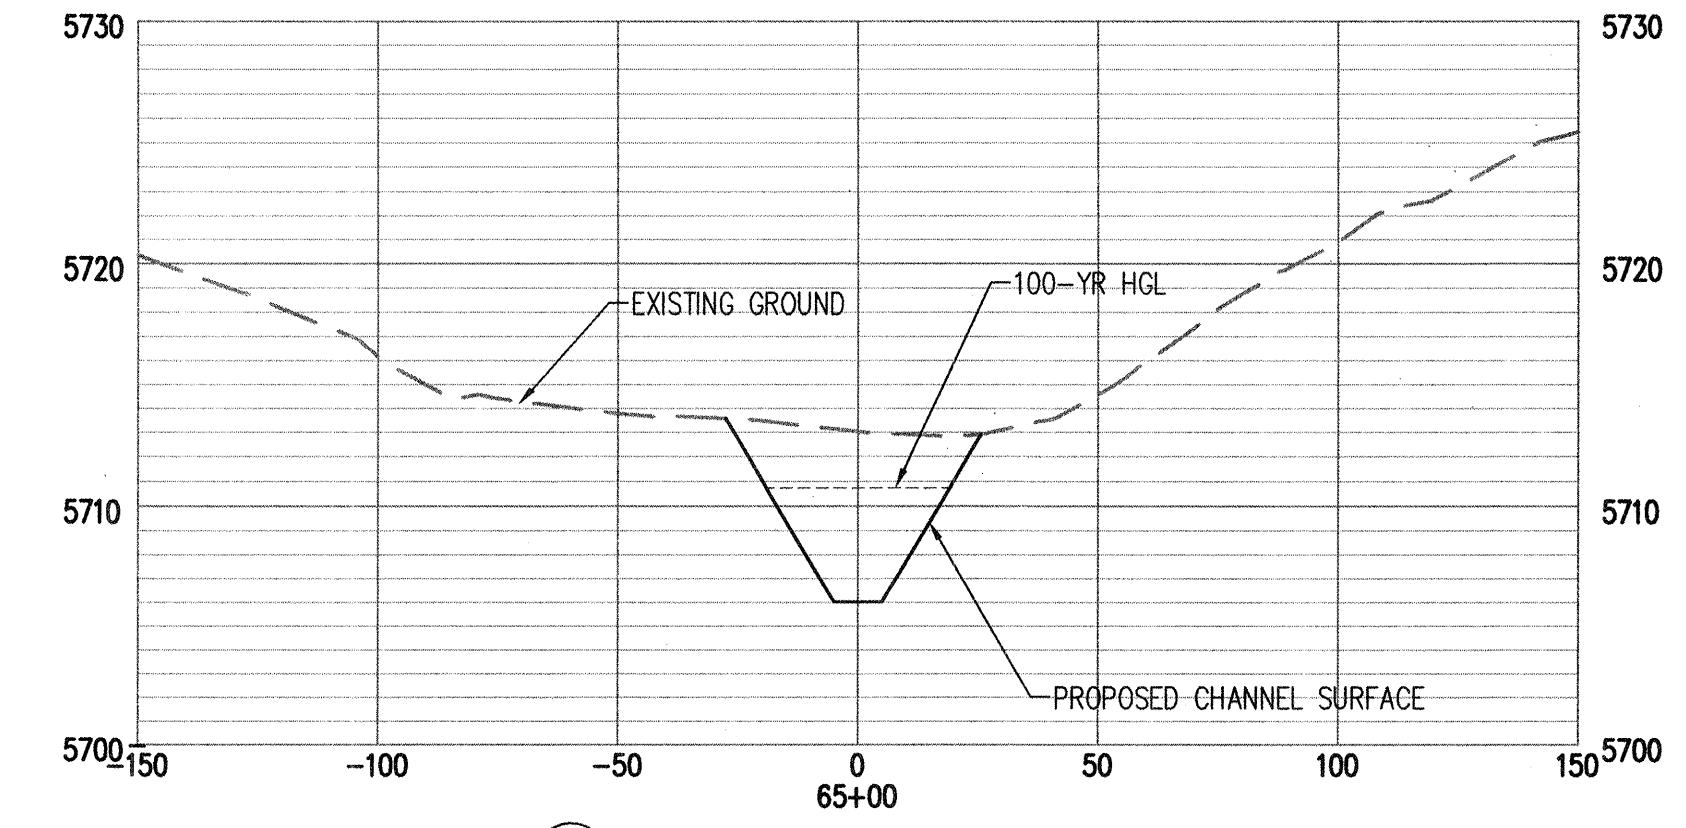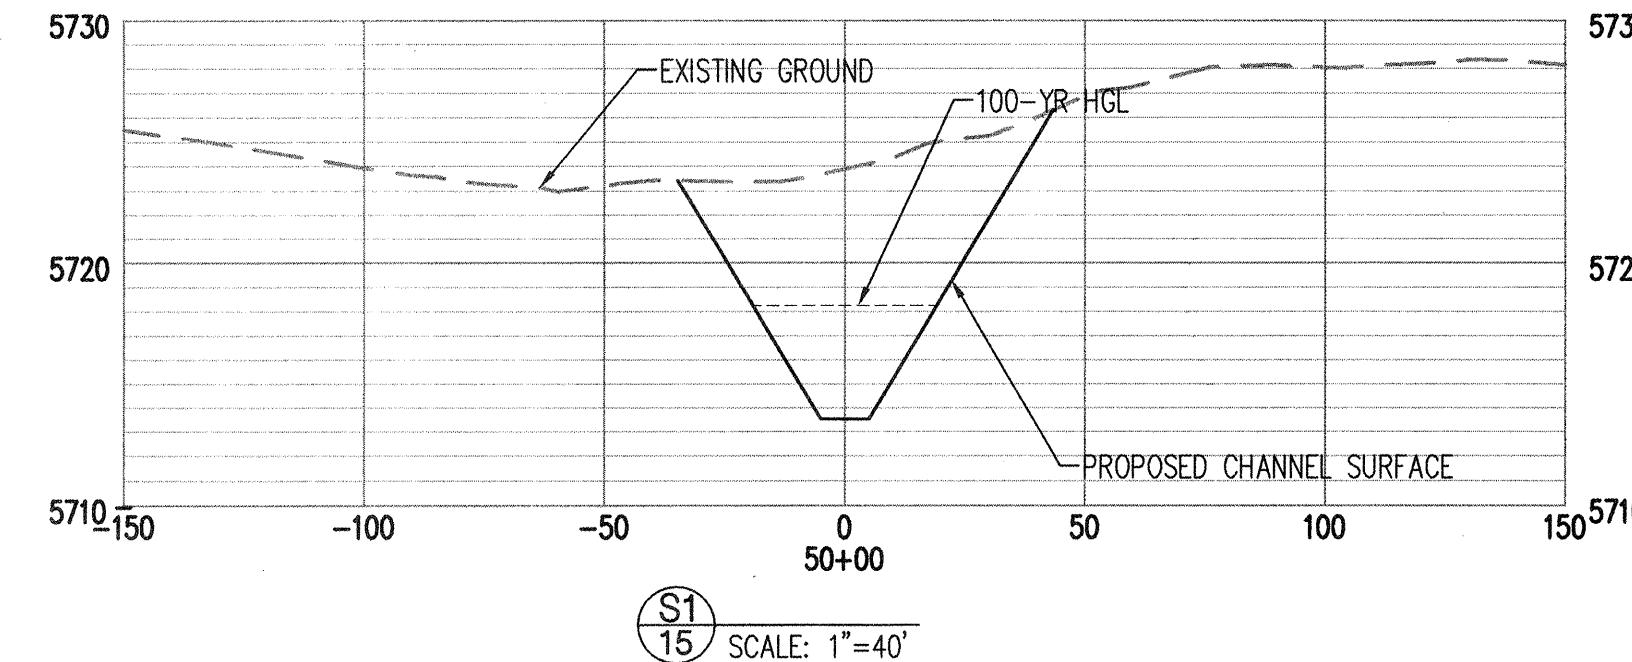

# RECORD DRAWING

CHANNEL Point Table			CHANNEL Point Table		
STATION	OFFSET	ELEVATION	STATION	OFFSET	ELEVATION
51+00	31.68' LT	5722.29	62+00	27.04' LT	5716.22
51+00	CL	5712.60	62+00	CL	5708.16
51+00	36.16' RT	5723.68	62+00	21.33' RT	5714.38
51+94	33.23' LT	5722.57	63+34	22.81' LT	5713.94
51+94	CL	5712.44	63+34	CL	5707.91
51+94	31.70' RT	5722.08	63+34	20.51' RT	5713.11
52+99	38.76' LT	5723.55	64+00	23.33' LT	5713.81
52+99	CL	5711.77	64+00	CL	5707.41
52+99	31.41' RT	5721.25	64+00	21.00' RT	5712.80
54+00	37.78' LT	5723.07	65+00	19.94' LT	5712.65
54+00	CL	5711.34	65+00	CL	5707.48
54+00	31.27' RT	5720.91	65+00	19.76' RT	5712.22
55+00	34.90' LT	5721.78	66+00	21.13' LT	5712.41
55+00	CL	5711.35	66+00	CL	5706.96
55+00	29.92' RT	5720.43	66+00	20.73' RT	5712.10
56+59	31.53' LT	5719.77	67+00	20.89' LT	5711.63
56+59	CL	5710.54	67+00	CL	5706.46
56+59	33.07' RT	5719.84	67+00	21.92' RT	5712.52
57+00	30.55' LT	5719.23	68+00	23.75' LT	5712.25
57+00	CL	5710.67	68+00	CL	5706.29
57+00	32.18' RT	5719.74	68+00	14.78' RT	5709.27
58+00	28.87' LT	5718.54	68+78	15.88' LT	5709.34
58+00	CL	5710.34	68+78	CL	5706.11
58+00	28.65' RT	5718.05	68+78	12.59' RT	5708.43
59+00	28.71' LT	5717.58	68+89	15.27' LT	5708.88
59+00	CL	5709.94	68+89	CL	5705.95
59+00	26.11' RT	5717.09	68+89	11.28' RT	5707.97
60+00	30.11' LT	5717.67	69+60	9.12' LT	5706.63
60+00	CL	5709.18	69+60	CL	5705.07
60+00	26.12' RT	5716.46	69+60	8.22' RT	5705.96
61+00	27.38' LT	5716.50	71+50	35.79' LT	5703.54
61+00	CL	5708.95	71+49	29.84' LT	5703.65
61+00	23.75' RT	5715.41	71+48	22.07' LT	5704.01

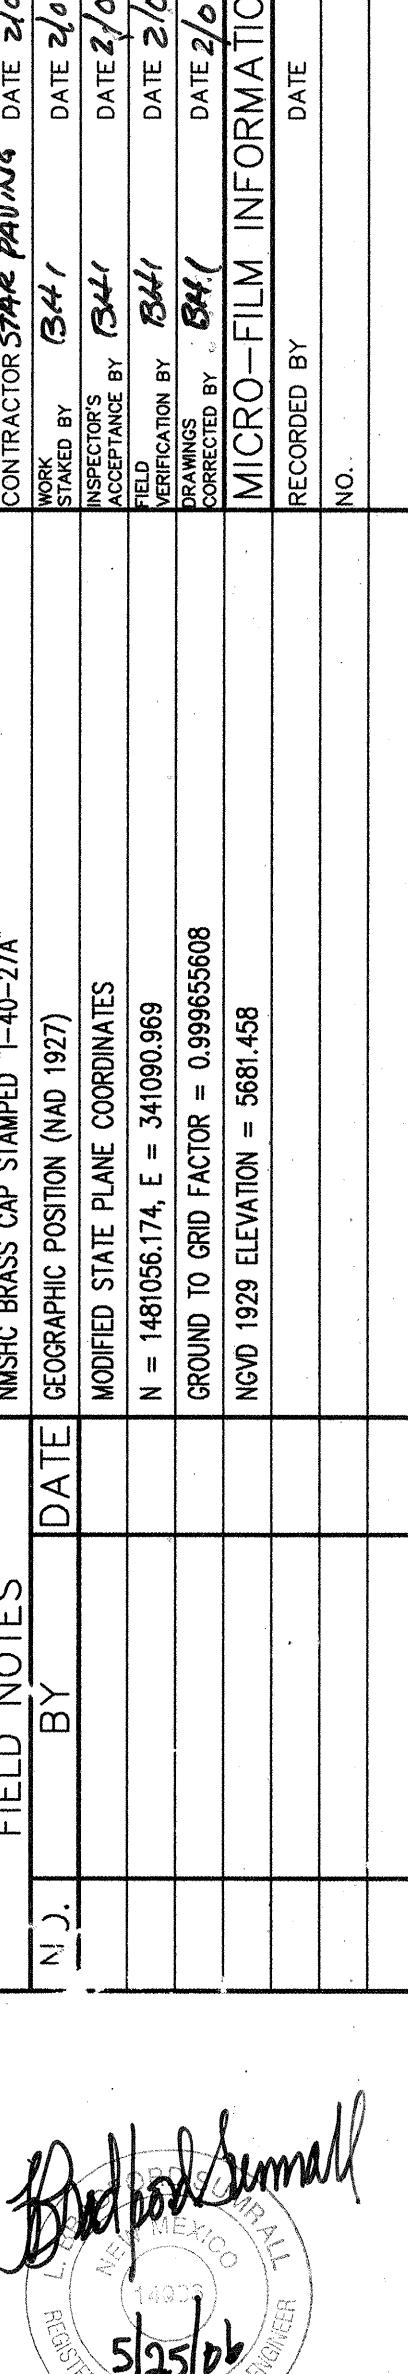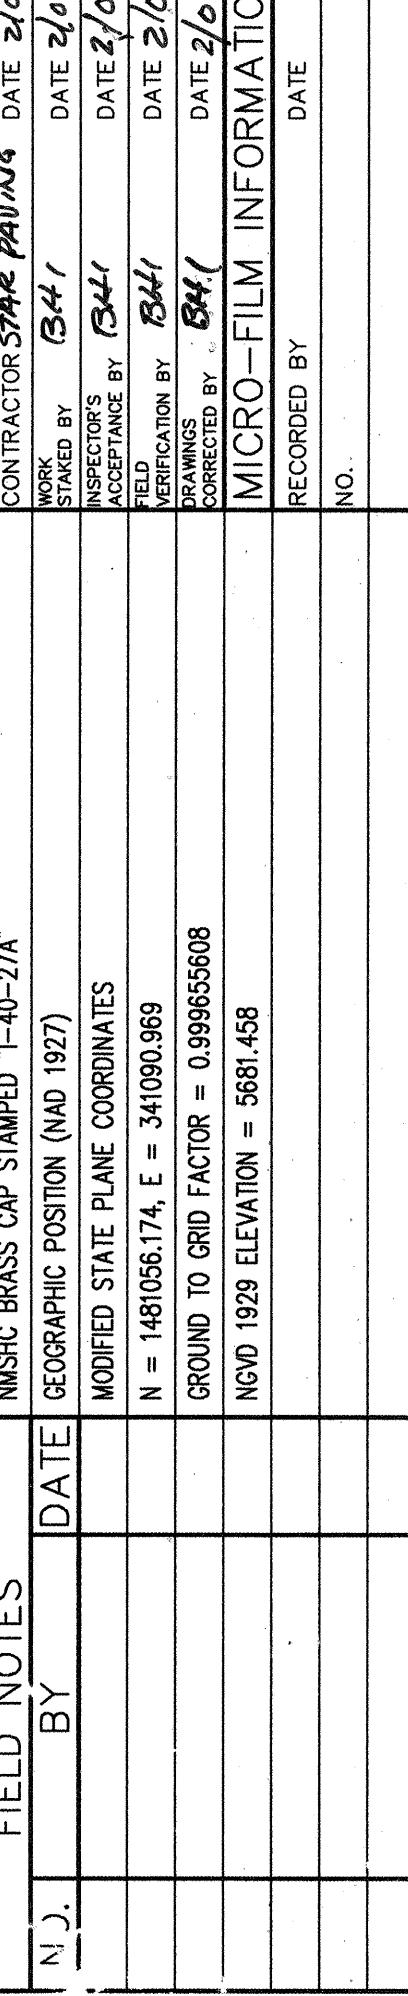

**and I 7500 Jefferson St. NE Albuquerque, NM 87109-4335**  
**ERING ▲ SPATIAL DATA ▲ ADVANCED TECHNOLOGIES**

**County of Bernalillo  
Public Works Division  
State of New Mexico**

# **ORDERO MESA STORM DRAIN CHANNEL TYPICAL SECTIONS**

**ORDERO MESA STORM DRAIN  
CHANNEL  
TYPICAL SECTIONS**

## TYPICAL SECTIONS

Updated: 2024-01-15


design


Digitized by Google

Map No. Drawing No. Sheet



K-6,L-6,L-7	C3	
-------------	----	--

Date: 03.29.06

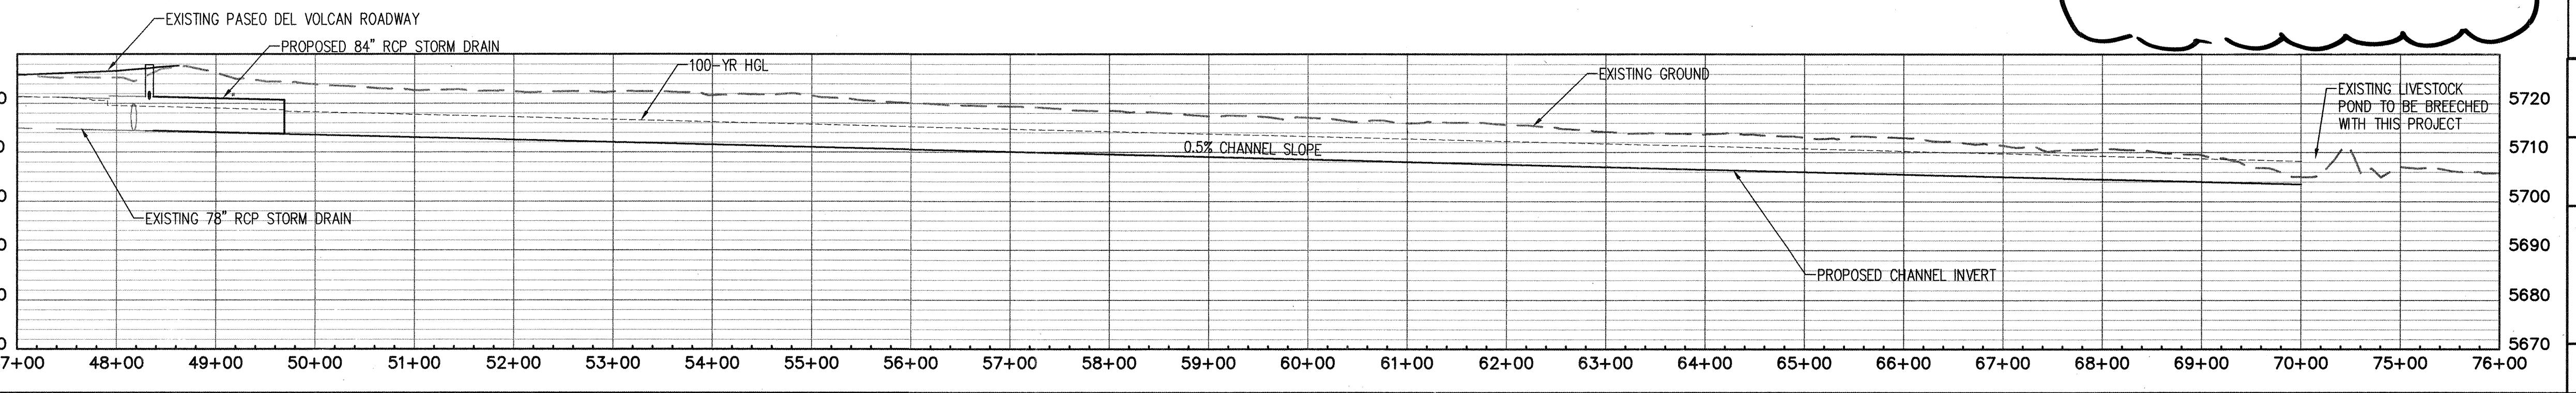

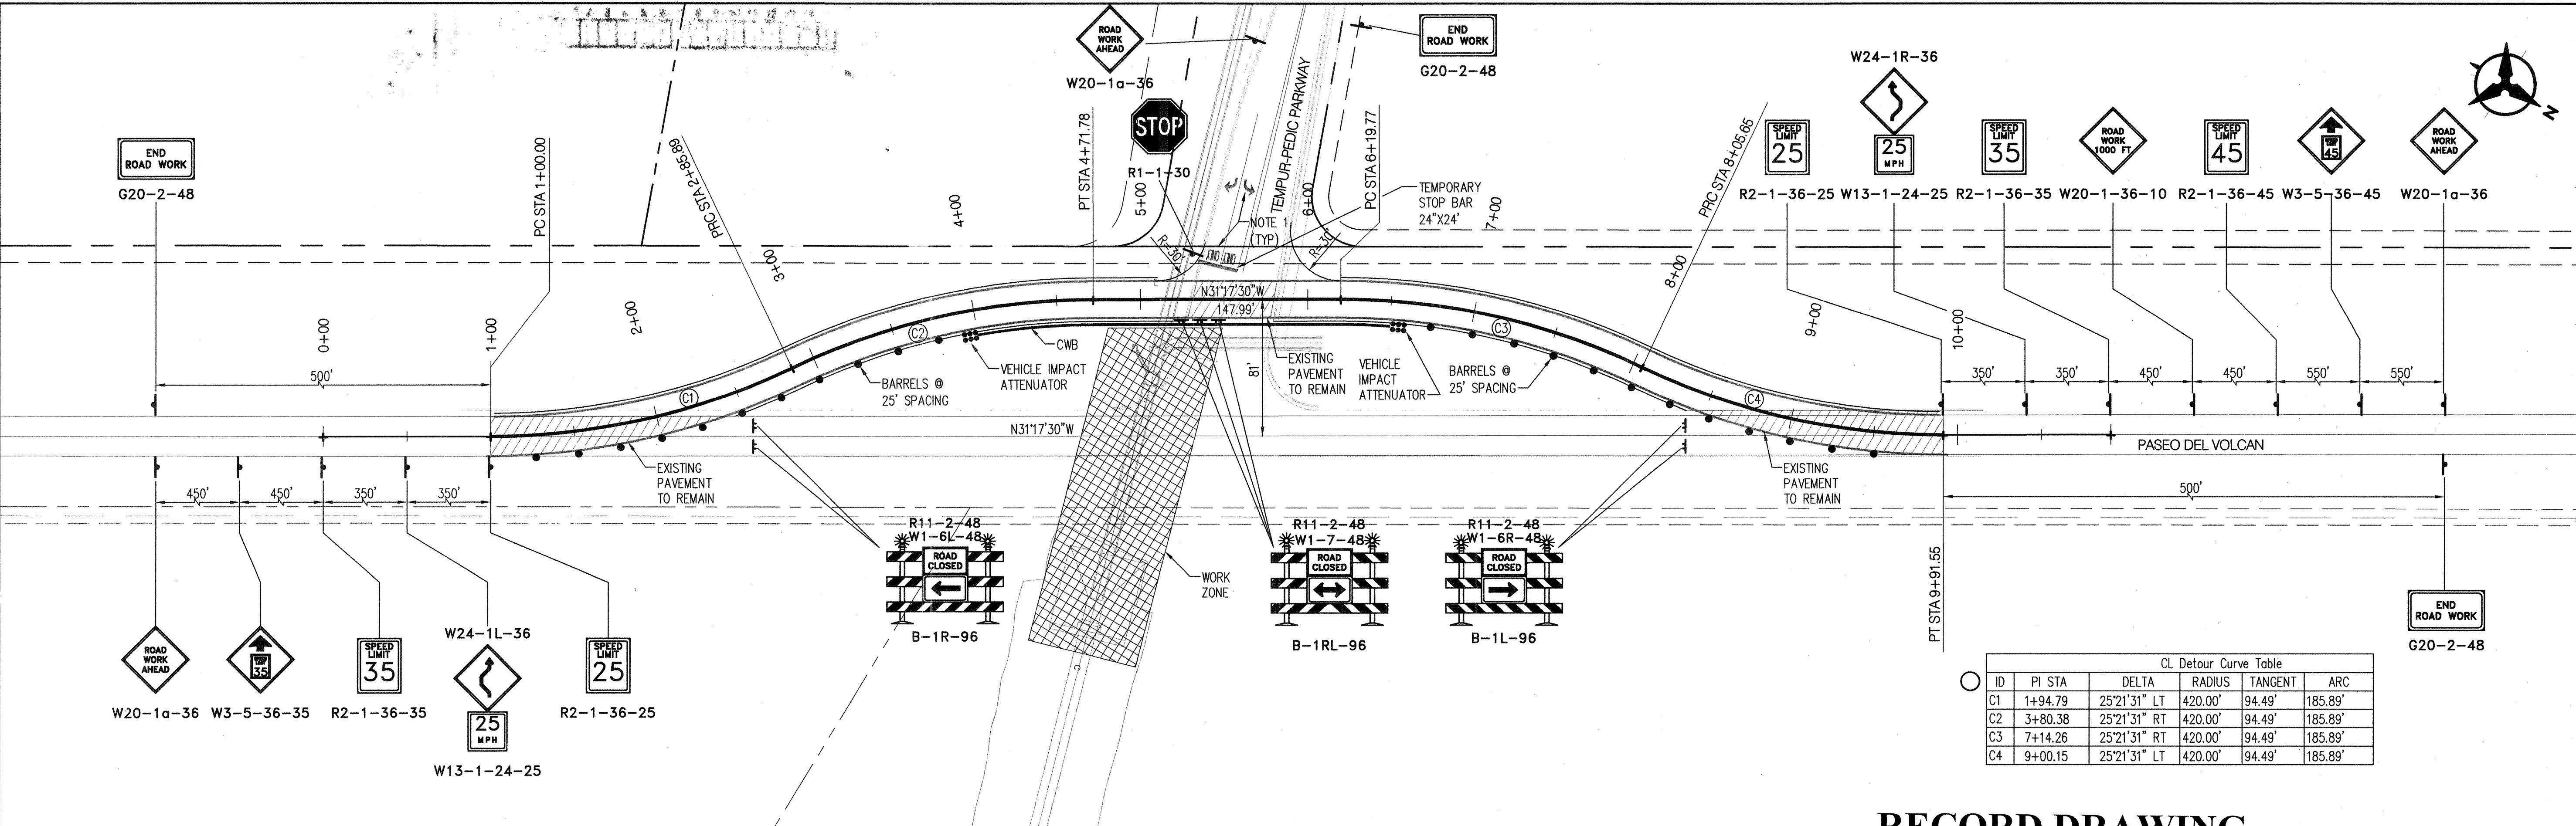

## RECORD DRAWING

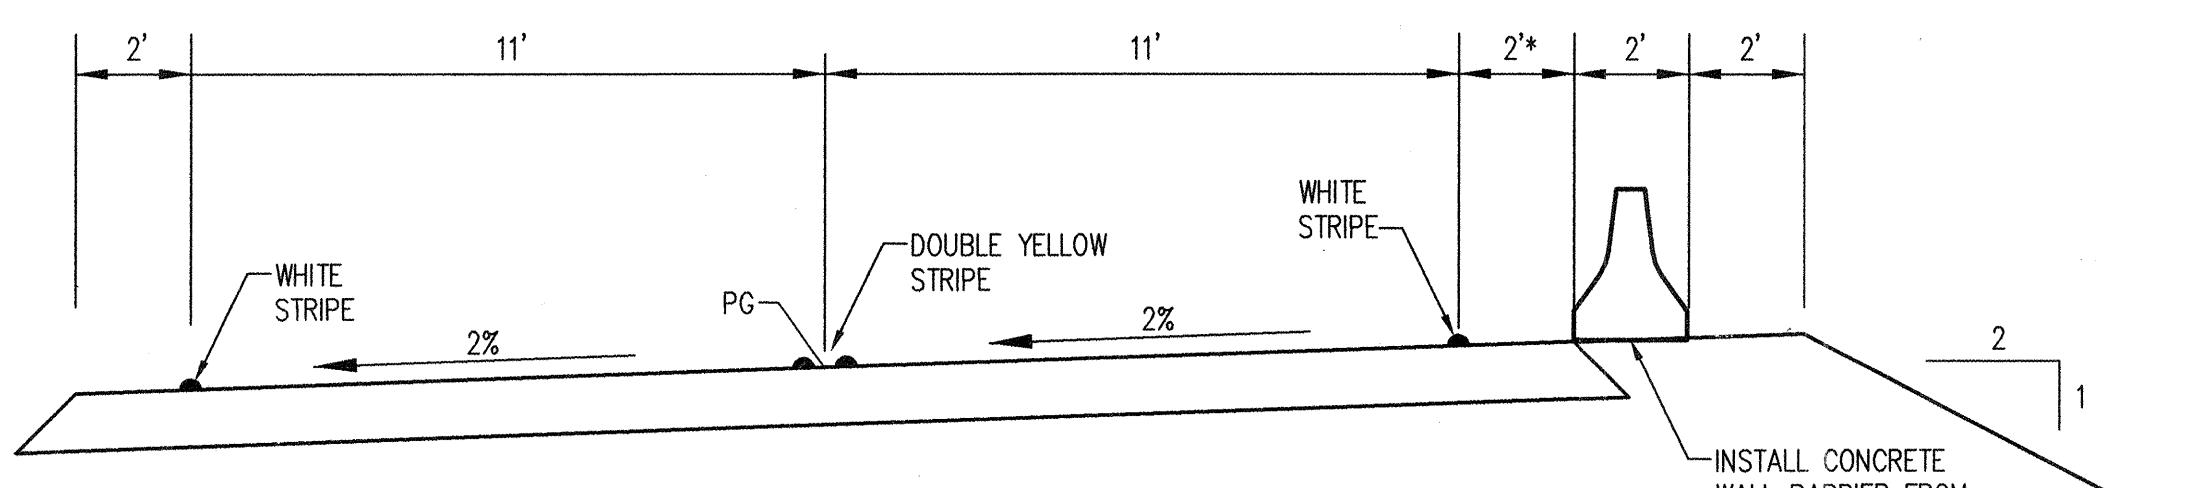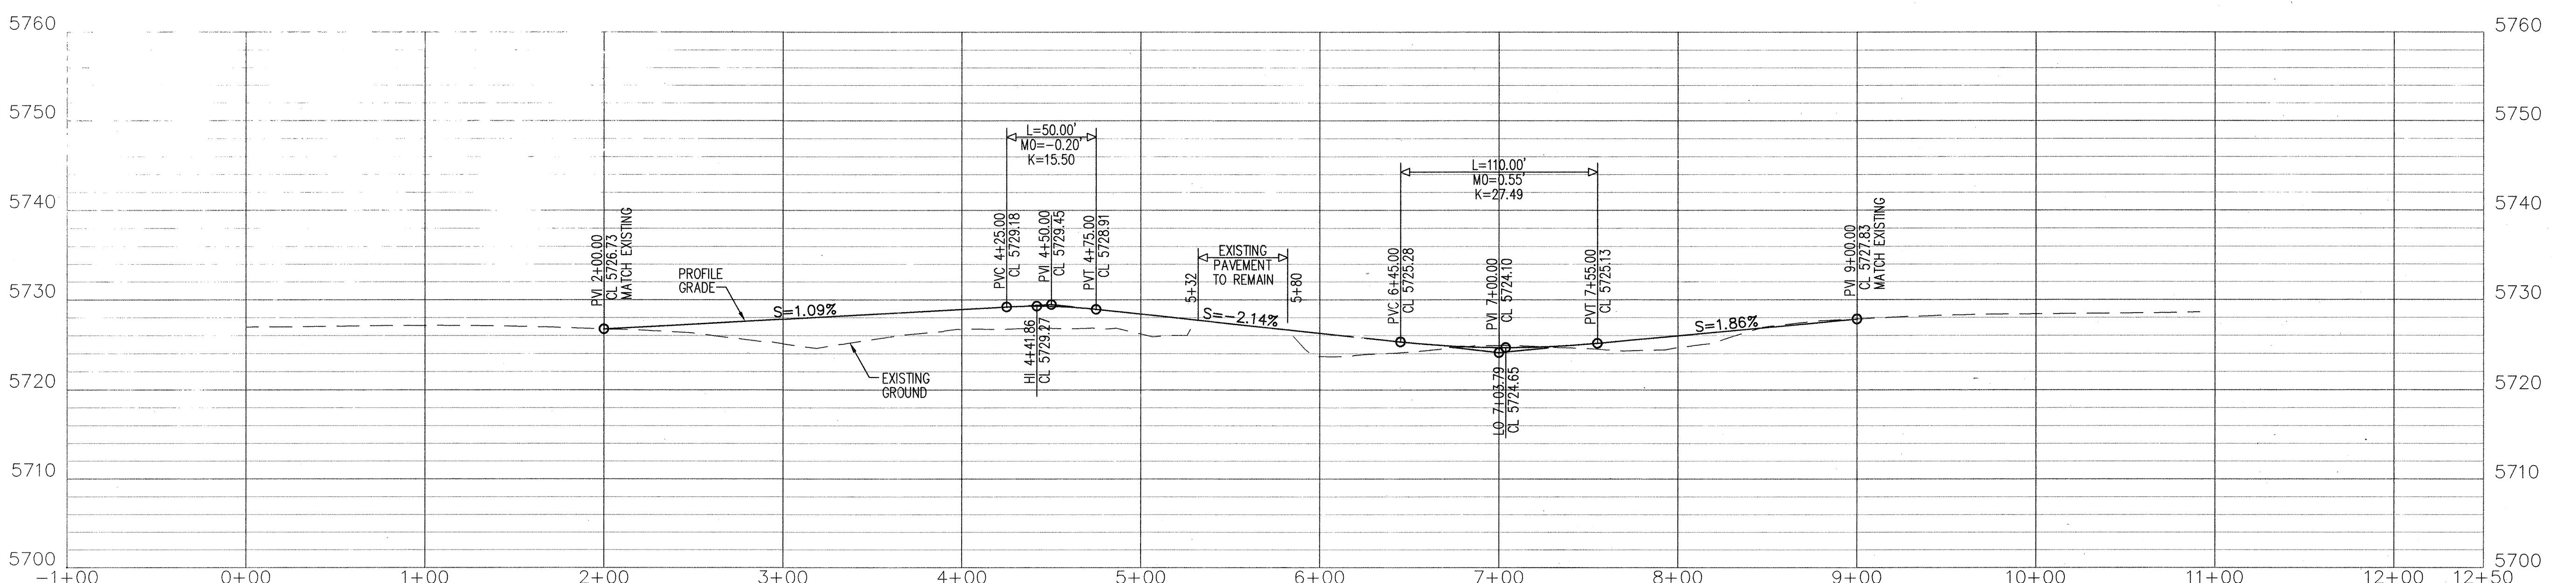

**TYPICAL SECTION**  
NTS

\* INCREASE OFFSET TO CWB TO 4' FROM STA 5+20 TO STA 5+50  
TO FACILITATE INSTALLATION OF TYPE III BARRICADES. CWB SHALL  
BE PLACED CONTINUOUS THROUGH TRANSITION TO/FROM 4' OFFSET.

### NOTES

- CONTRACTOR SHALL OBLITERATE ALL CONFLICTING PAVEMENT MARKINGS AND REMOVE OR COVER CONFLICTING SIGNS. PAVEMENT MARKINGS AND SIGNS SHALL BE RESTORED TO THE PRE-CONSTRUCTION CONDITIONS UPON COMPLETION OF THE WORK.
- CONTRACTOR SHALL REMOVE EXISTING CURB & GUTTER ON TEMPUR-PEDIC PARKWAY AS NEEDED TO CONSTRUCT THE TEMPORARY INTERSECTION. CURB & GUTTER SHALL BE RECONSTRUCTED TO PRE-CONSTRUCTION CONDITIONS UPON COMPLETION OF THE WORK. AN ESTIMATED 130 LF OF CURB & GUTTER WILL NEED TO BE REMOVED AND RECONSTRUCTED (60 LF OF MEDIAN C&G ON THE SOUTH SIDE AND 70 LF OF STANDARD C&G ON THE NORTH SIDE).
- ALL TRAFFIC CONTROL DEVICES AND ELEMENTS SHALL CONFORM TO THE MANUAL ON UNIFORM TRAFFIC CONTROL DEVICES (MUTCD) LATEST EDITION.
- ALL WORK NECESSARY TO INSTALL, MAINTAIN & REMOVE TRAFFIC CONTROL DEVICES, AND RESTORE ROADWAY TO PRE-CONSTRUCTION CONDITIONS INCLUDING, BUT NOT LIMITED TO EARTHWORK, REMOVALS, PAVING, TRAFFIC CONTROL DEVICES, SIGNING, STRIPING AND CURB & GUTTER SHALL BE INCLUDED IN THE LUMP SUM ITEM FOR TRAFFIC CONTROL.

**Bohannan Huston**

Courtyard I 7500 Jefferson St. NE Albuquerque, NM 87109-4335  
ENGINEERING □ SPATIAL DATA □ ADVANCED TECHNOLOGIES

**County of Bernalillo**  
**Public Works Division**  
**State of New Mexico**

CORDERO MESA STORM DRAIN  
TEMPUR PEDIC PARKWAY  
TRAFFIC CONTROL PLAN

Mo./Day/Yr.	Mo./Day/Yr.
DEE GUNN COMMITTEE	CITY OF ALBUQUERQUE
Project No. 060238	Zone Map No. K-5,K-6,L-6,L-7
Drawing No. 16	Sheet 16 of 16
Last Design Update	