

SCANNED BY
PLANNING

1 2 3 4 5 6 7 8 9 10 11 12 13 14 15
24-77290-12-08

CONSTRUCTION PLANS FOR COSTCO PUBLIC INFRASTRUCTURE ALBUQUERQUE, NEW MEXICO

INDEX

SHEET NUMBER	DESCRIPTION
1	COVER SHEET
2	PLAT
2A	NMDOT PERMANENT SIGNING/STRIPING, TRAFFIC CONTROL, & MATERIAL REQUIREMENT NOTES
3	GENERAL NOTES
4	HORIZONTAL CONTROL PLAN
5	OVERALL PAVING PLAN, SIGNING & STRIPING PLAN, & KEY MAP
5A	PEDESTRIAN TRAIL ALONG ARROYO DE LAS CALABACILLAS
6	EAGLE RANCH RD - DEMOLITION & PAVING PLAN
7	COORS BYPASS - DEMOLITION & PAVING PLAN
8	COORS BYPASS - DEMOLITION & PAVING PLAN
9	COORS BYPASS - DEMOLITION & PAVING PLAN
10	COORS BLVD - DEMOLITION & PAVING PLAN
11	COORS BLVD - DEMOLITION & PAVING PLAN
12	IRVING BLVD - DEMOLITION & PAVING PLAN
13	COORS BLVD - DEMOLITION PLAN
14	EAGLE RANCH RD & COORS BYPASS - SIGNING & STRIPING PLAN
15	COORS BYPASS - SIGNING & STRIPING PLAN
16	COORS BLVD - SIGNING & STRIPING PLAN
17	IRVING BLVD & COORS BLVD - SIGNING & STRIPING PLAN
18	PAVEMENT SECTIONS AND DETAILS
18A-18C	NMDOT STANDARD DETAILS
19	COORS BOULEVARD/COORS BYPASS TRAFFIC SIGNAL NOTES AND ESTIMATED QUANTITIES
20	COORS BOULEVARD/COORS BYPASS SIGNAL MODIFICATION PLAN
21	COORS BOULEVARD/EAGLE RANCH ROAD SIGNAL MODIFICATION PLAN
22	COORS BYPASS/EAGLE RANCH ROAD SIGNAL MODIFICATION PLAN

SURVEYORS CERTIFICATION

I, Russ P. Hugg, New Mexico Professional Surveyor Number 9750, hereby certify that the as-built information shown hereon is the result of an actual field survey performed by me or under my direct supervision and that the same is true and correct to the best of my knowledge and belief;

Russ P. Hugg
NMPS No. 9750
12-13, 2007



CONSTRUCTION NOTES:

- THE CONTRACTOR SHALL ABIDE BY ALL LOCAL, STATE, AND FEDERAL LAWS, RULES AND REGULATIONS WHICH APPLY TO THE CONSTRUCTION OF THESE IMPROVEMENTS.
- PRIOR TO CONSTRUCTION, CONTRACTOR SHALL EXCAVATE AND VERIFY THE HORIZONTAL AND VERTICAL LOCATIONS OF ALL POTENTIAL OBSTRUCTIONS. SHOULD A CONFLICT EXIST, THE CONTRACTOR SHALL NOTIFY THE ENGINEER OR CONSTRUCTION OBSERVER SO THAT THE CONFLICT CAN BE RESOLVED WITH A MINIMUM AMOUNT OF DELAY.
- ALL ELECTRICAL, TELEPHONE, CABLE TV, GAS AND OTHER UTILITY LINES, CABLES AND APPURTENANCES ENCOUNTERED DURING CONSTRUCTION THAT REQUIRE RELOCATION, SHALL BE COORDINATED WITH THAT UTILITY. THE CONTRACTOR SHALL BE RESPONSIBLE FOR COORDINATION OF ALL NECESSARY UTILITY ADJUSTMENTS. NO ADDITIONAL COMPENSATION WILL BE ALLOWED FOR DELAYS OR INCONVENIENCES CAUSED BY UTILITY COMPANY WORK CREWS. THE CONTRACTOR MAY BE REQUIRED TO RESCHEDULE HIS ACTIVITIES TO ALLOW UTILITY CREWS TO PERFORM THEIR REQUIRED WORK.
- DISPOSAL SITE FOR ALL EXCESS EXCAVATION MATERIAL, AND UNSUITABLE MATERIAL SHALL BE OBTAINED BY THE CONTRACTOR IN COMPLIANCE WITH APPLICABLE ENVIRONMENTAL REGULATIONS AND APPROVED BY THE CONSTRUCTION OBSERVER. ALL COSTS INCURRED IN OBTAINING A DISPOSAL SITE AND HAUL THERE TO SHALL BE CONSIDERED INCIDENTAL TO THE PROJECT AND NO SEPARATE MEASUREMENT OR PAYMENT SHALL BE MADE.




- THE CONTRACTOR IS RESPONSIBLE FOR PROTECTING THE EXISTING UTILITY LINES WITHIN THE CONSTRUCTION AREA. ANY DAMAGE TO EXISTING FACILITIES CAUSED BY CONSTRUCTION ACTIVITY SHALL BE REPAIRED OR REPLACED AT THE CONTRACTOR'S EXPENSE AND APPROVED BY THE CONSTRUCTION OBSERVER.
- CONSTRUCTION ACTIVITY SHALL BE LIMITED TO THE PROPERTY AND/OR PROJECT LIMITS. ANY DAMAGE TO ADJACENT PROPERTIES RESULTING FROM THE CONSTRUCTION PROCESS IS THE RESPONSIBILITY OF THE CONTRACTOR. ANY COSTS INCURRED FOR REPAIRS SHALL BE THE COST OF THE CONTRACTOR.
- OVERNIGHT PARKING OF CONSTRUCTION EQUIPMENT SHALL NOT OBSTRUCT DRIVEWAYS OR DESIGNATED TRAFFIC LANES. THE CONTRACTOR SHALL NOT STORE ANY EQUIPMENT OR MATERIAL WITHIN THE PUBLIC RIGHT-OF-WAY.
- THE CONTRACTOR SHALL OBTAIN ALL THE NECESSARY PERMITS FOR THE PROJECT PRIOR TO COMMENCING CONSTRUCTION (I.E. BARRICADING, SURFACE DISTURBANCE, EXCAVATION PERMITS, EPA STORM WATER PERMITS ETC.)
- THE CONTRACTOR SHALL BE RESPONSIBLE TO REPLACE AT HIS EXPENSE ANY AND ALL PROPERTY CORNERS DESTROYED DURING CONSTRUCTION. ALL PROPERTY CORNERS MUST BE RESET BY A REGISTERED LAND SURVEYOR.
- ALL PERMANENT PAVEMENT MARKING AND TRAFFIC SIGNING SHALL BE FURNISHED BY THE CONTRACTOR PER PLAN.

- THE CONTRACTOR SHALL PREPARE A CONSTRUCTION TRAFFIC CONTROL AND SIGNING PLAN. THE CONTRACTOR SHALL COORDINATE WITH THE CITY OF ALBUQUERQUE, TRAFFIC ENGINEERING DEPARTMENT, (NMDOT WITHIN COORS BLVD. ROW) PRIOR TO BEGINNING ANY CONSTRUCTION WORK ON OR ADJACENT TO EXISTING STREETS.
- ALL BARRICADES AND CONSTRUCTION SIGNING SHALL CONFORM TO APPLICABLE SECTIONS OF THE "MANUAL OF UNIFORM TRAFFIC CONTROL DEVICES" (MUTCD), U.S. DEPARTMENT OF TRANSPORTATION, LATEST EDITION.
- THE CONTRACTOR SHALL MAINTAIN ALL CONSTRUCTION BARRICADES AND SIGNING AT ALL TIMES. THE CONTRACTOR SHALL VERIFY THE PROPER LOCATION OF ALL BARRICADING AT THE END AND BEGINNING OF EACH DAY.
- ALL SAWCUT PAVEMENT SHALL HAVE A UNIFORM EDGE AND BE SPRAYED WITH TACK COAT.
- WHEN ABUTTING NEW CURB AND GUTTER TO EXISTING PAVEMENT, A 1' WIDE SECTION OF EXISTING PAVEMENT ADJACENT TO THE CURB AND CUTTER SHALL BE SAWCUT, REMOVED, AND REPLACED AS PER THE STANDARD SPECIFICATIONS.
- THE CONTRACTOR SHALL ASSUME RESPONSIBILITY FOR ANY DAMAGE TO EXISTING PAVEMENTS, PAVEMENT MARKINGS, CURB & GUTTER, DRIVE PADS, WHEELCHAIR RAMPS, AND SIDEWALK DURING CONSTRUCTION, APART FROM THOSE SECTIONS INDICATED FOR REMOVAL ON THE PLANS AND SHALL REPAIR OR REPLACE PER COA STANDARDS, AT HIS OWN EXPENSE.

- ALL EXCAVATION, TRENCHING, AND SHORING ACTIVITIES MUST BE CARRIED-OUT IN ACCORDANCE WITH OSHA 29 CFR 1926.650 SUBPART P.
- IF A PAVEMENT DROP-OFF IS CREATED DURING CONSTRUCTION, THE CONTRACTOR SHALL INITIATE PROTECTIVE MEASURES TO PREVENT ABRUPT PAVEMENT CHANGES. THIS WORK SHALL BE CONSIDERED INCIDENTAL TO CONSTRUCTION.
- CONTRACTOR SHALL BE RESPONSIBLE FOR PROVIDING AND MAINTAINING ALL CONSTRUCTION SIGNING UNTIL PROJECT HAS BEEN ACCEPTED BY THE CITY OF ALBUQUERQUE.
- WHEELCHAIR RAMPS TO BE BUILT PER CITY OF ALBUQUERQUE STANDARD DRAWINGS. THE DESIGN MUST COMPLY WITH CURRENT ADA GUIDELINES AND MUST INCLUDE TRUNCATED DOMES. SUBMIT SPECIFICATIONS TO CITY OF ALBUQUERQUE CONSTRUCTION ENGINEER FOR EVALUATION PRIOR TO CONSTRUCTION.
- CONTRACTOR TO GET AN NMDOT TOP PERMIT BEFORE ANY WORK IS DONE ON COORS BLVD.

CERTIFICATE OF SUBSTANTIAL COMPLIANCE ON PLANS

I, Matthew A. Santistevan of the firm of Bohannon & Huston, Inc., a Registered Professional Engineer in the State of New Mexico, do hereby certify, to the best of my knowledge and belief, that the infrastructure completed as shown on these drawings (Costco Public Infrastructure) has been inspected by me or by a qualified person under my direct supervision and has been constructed in accordance with the plans and specifications and that the original design intent of the approved plans has been met, except as noted by me on the as-built construction drawings. This Certification is based on site inspections by me or personnel under my direction and survey information provided by the contractor, Robinson Construction Co., (their field sub-contractor, Star Paving Co.) and their surveyor, Russ Hugg, NMPS 9750.

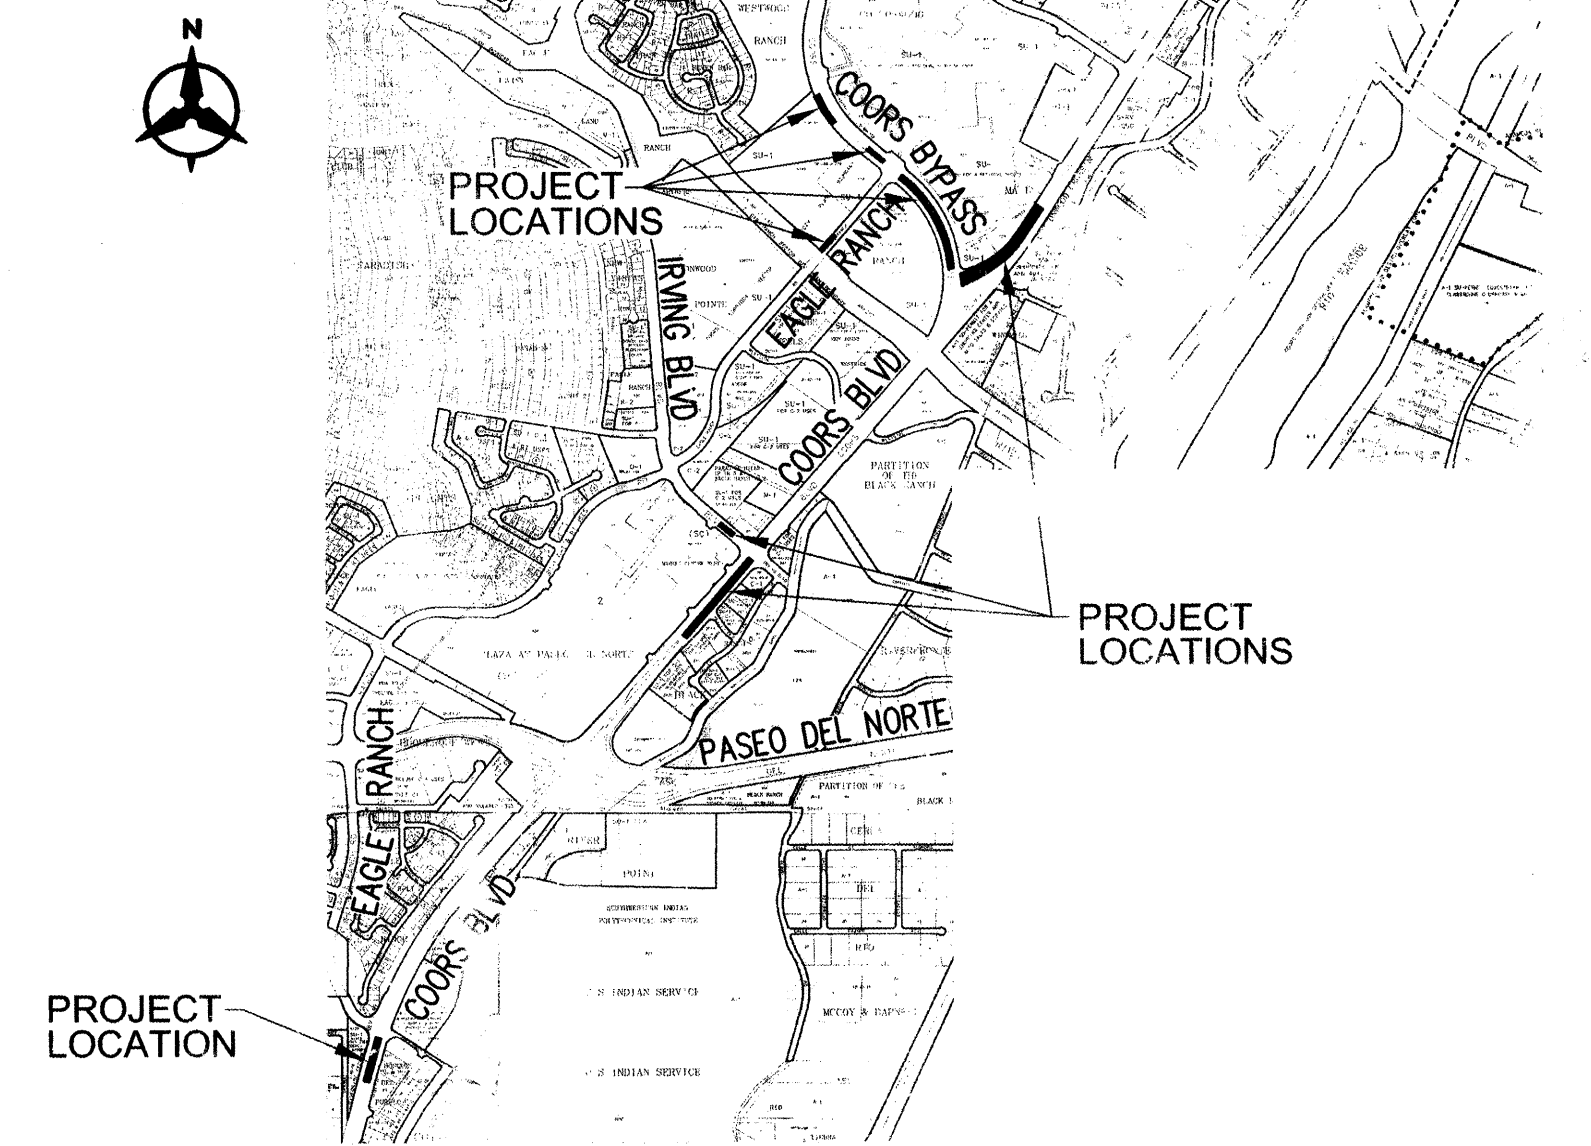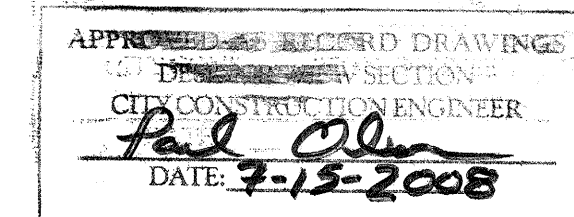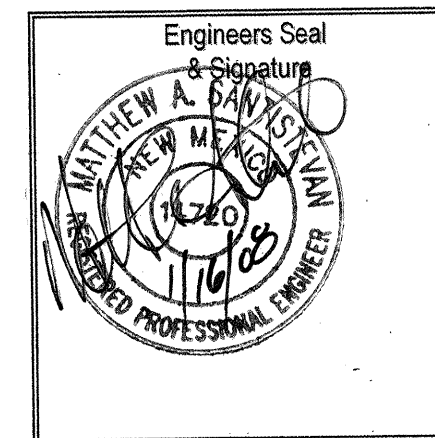

VICINITY MAP
ONE MAP NO. B-13, B-14, C-13, & D-13

NOTICE TO CONTRACTORS

- AN EXCAVATION/CONSTRUCTION PERMIT WILL BE REQUIRED BEFORE BEGINNING ANY WORK WITHIN THE RIGHT-OF-WAY.
- ALL WORK DETAILED ON THESE PLANS (EXCEPT COORS BLVD. SOUTH OF IRVING BLVD.) TO BE PERFORMED UNDER CONTRACT SHALL BE EXCEPT AS OTHERWISE STATED OR PROVIDED FOR HEREON, BE CONSTRUCTED IN ACCORDANCE WITH THE CITY OF ALBUQUERQUE STANDARD SPECIFICATIONS FOR PUBLIC WORKS CONSTRUCTION, 1986 EDITION AS REVISED THROUGH UPDATE #7 INCLUDING AMENDMENT #1 DATED 8/19/05. ALL WORK WITHIN THE RIGHT OF WAY SHALL BE IN ACCORDANCE WITH NMDOT STANDARD SPECIFICATIONS FOR HIGHWAY AND BRIDGE CONSTRUCTION (CURRENT EDITION).
- TWO WORKING DAYS PRIOR TO ANY EXCAVATION, THE CONTRACTOR MUST CONTACT NEW MEXICO ONE CALL SYSTEM (260-1990) FOR EXISTING UTILITIES.
- PRIOR TO CONSTRUCTION, THE CONTRACTOR SHALL EXCAVATE AND VERIFY THE HORIZONTAL AND VERTICAL LOCATIONS OF ALL UTILITIES. SHOULD A CONFLICT EXIST, THE CONTRACTOR SHALL NOTIFY THE ENGINEER IMMEDIATELY SO THAT THE CONFLICT CAN BE RESOLVED WITH A MINIMUM AMOUNT OF DELAY.
- FIVE (5) WORKING DAYS PRIOR TO BEGINNING CONSTRUCTION, THE CONTRACTOR SHALL SUBMIT TO CONSTRUCTION COORDINATION DIVISION A DETAILED CONSTRUCTION SCHEDULE. TWO (2) WORKING DAYS PRIOR TO THE START OF CONSTRUCTION, THE CONTRACTOR SHALL SUBMIT A PAVING PERMIT FROM THE CONSTRUCTION COORDINATION DIVISION. CONTRACTOR SHALL NOTIFY THE CONSTRUCTION COORDINATION ENGINEER (924-3434) PRIOR TO OCCUPYING AN INTERSECTION. REFER TO SECTION 19 OF THE GENERAL CONDITIONS OF THE STANDARD SPECIFICATIONS.
- ALL WORK EFFECTING ARTERIAL ROADWAYS REQUIRES TWENTY-FOUR HOUR CONSTRUCTION.
- ALL STREET STRIPING ALTERED OR DESTROYED SHALL BE REPLACED WITH PLASTIC REFLECTORIZED PAVEMENT MARKING TO MATCH EXISTING LOCATION AS WAS EXISTING, OR AS INDICATED BY THIS PLAN SET.
- CONTRACTOR SHALL NOTIFY THE ENGINEER NOT LESS THAN SEVEN (7) DAYS PRIOR TO STARTING WORK IN ORDER THAT THE ENGINEER MAY TAKE NECESSARY MEASURES TO INSURE THE PRESERVATION OF SURVEY MONUMENTS. CONTRACTOR SHALL NOT DISTURB SURVEY MONUMENTS WITHOUT THE CONSENT OF THE CITY SURVEYOR AND SHALL NOTIFY THE CITY SURVEYOR AND BEAR THE EXPENSE OF REPLACING ANY MONUMENTS THAT ARE DISTURBED WITHOUT PERMISSION. REPLACEMENT SHALL BE DONE ONLY BY THE CITY SURVEYOR. WHEN A CHANGE IS MADE TO THE FINISHED ELEVATIONS OF THE PAVEMENT OF ANY ROADWAY IN WHICH A PERMANENT SURVEY MONUMENT IS LOCATED, CONTRACTOR SHALL, AT HIS OWN EXPENSE, ADJUST THE MONUMENT COVER TO THE NEW GRADE UNLESS OTHERWISE SPECIFIED. REFER TO SECTION 4.4 OF THE GENERAL CONDITIONS OF THE STANDARD SPECIFICATIONS.
- CONTRACTOR SHALL RECORD DATA ON ALL UTILITY LINES AND ACCESSORIES AS REQUIRED BY THE CITY OF ALBUQUERQUE FOR THE SEPARATION OF "AS CONSTRUCTED" DRAWINGS. CONTRACTOR SHALL NOT COVER UTILITY LINES AND ACCESSORIES UNTIL ALL DATA HAS BEEN RECORDED.
- CONTRACTOR SHALL MAINTAIN A GRAFFITI-FREE WORK SITE. CONTRACTOR SHALL PROMPTLY REMOVE ANY GRAFFITI FROM ALL EQUIPMENT, WHETHER PERMANENT OR TEMPORARY.
- CONTRACTOR SHALL COORDINATE WITH NEW MEXICO UTILITIES, INC. (NMUI) (888-2861) THREE (3) WORKING DAYS IN ADVANCE OF ANY WORK MAY AFFECT EXISTING PUBLIC WATER OR SEWER UTILITIES. EXISTING VALVES TO BE OPERATED BY NMUI PERSONNEL ONLY.

THE FOLLOWING NOTES ALSO APPLY WHEN CHECKED

- ☒ ALL UTILITIES AND UTILITY SERVICE LINES SHALL BE INSTALLED PRIOR TO PAVING.
- ☒ BACKFILL COMPACTION SHALL BE ACCORDING TO SPECIFIED STREET USE.
- ☒ TACK COAT REQUIREMENTS SHALL BE DETERMINED BY THE ENGINEER.
- ☒ SIDEWALKS AND WHEELCHAIR RAMPS WITHIN THE CURB RETURNS SHALL BE CONSTRUCTED WHEREVER A NEW CURB RETURN IS CONSTRUCTED.
- ☒ IF CURB IS DEPRESSIONED FOR A DRIVEPAD, THE DRIVEPAD SHALL BE CONSTRUCTED PRIOR TO ACCEPTANCE OF CURB AND GUTTER.
- ☒ ALL STORM DRAINAGE FACILITIES SHALL BE COMPLETED PRIOR TO FINAL ACCEPTANCE.
- ☒ THE REQUESTOR OR DEVELOPER SHALL BE RESPONSIBLE FOR REPAIR OR REPLACEMENT OF CURB AND GUTTER OR SIDEWALK DAMAGED AFTER APPROVAL BY THE CITY ENGINEER OF WORK COMPLETED BY THE CONTRACTOR.

REV.	SHEETS	CITY ENGINEER	DATE	USER DEPARTMENT	DATE	USER DEPARTMENT	DATE
		APPROVALS		ENGINEER		DATE	
		DRC Chairman		S. Woodard		9/25/07	
		Transportation				8/30/07	
		Water/Wastewater		M. Hugg		8/31/07	
		Hydrology				8-2-07	
		Parks					
		Const. Mngmt.					
		NMDOT					
		City Project No.		729082		Sneet	
				1		22	

DRB NO. 1005133

Bohannon & Huston
Court yard 1 7500 Jefferson St. NE Albuquerque, NM 87109-4335
ENGINEERING • SPATIAL DATA • ADVANCED TECHNOLOGIES





Location Map
Zone Atlas Map No. B-13-Z

Subdivision Data:

SHRINKAGE ADJUSTMENT: 1.0000
ALL OF TRACTS CREATED: 3
MILE OF FULL-WIDTH STREETS CREATED: 0
DATE OF SURVEY: MARCH 2007

Disclosure Statement:

THE PLAT AND THE RECORDING OF THIS PLAT ARE SUBJECT TO THE CITY OF ALBUQUERQUE, NEW MEXICO, AND TO THE RECORDING OF THIS PLAT.


Notes:

1. THE PLAT SHOWS EXISTING RECORDS AND APPROPRIATE EASEMENTS AS NOTED.
2. THE PLAT SHOWS EXISTING RECORDS AND APPROPRIATE EASEMENTS AS NOTED.
3. THE PLAT SHOWS EXISTING RECORDS AND APPROPRIATE EASEMENTS AS NOTED.
4. THE PLAT SHOWS EXISTING RECORDS AND APPROPRIATE EASEMENTS AS NOTED.
5. THE PLAT SHOWS EXISTING RECORDS AND APPROPRIATE EASEMENTS AS NOTED.
6. THE PLAT SHOWS EXISTING RECORDS AND APPROPRIATE EASEMENTS AS NOTED.

Easements:

1. THE PLAT SHOWS EXISTING RECORDS AND APPROPRIATE EASEMENTS AS NOTED.
2. THE PLAT SHOWS EXISTING RECORDS AND APPROPRIATE EASEMENTS AS NOTED.
3. THE PLAT SHOWS EXISTING RECORDS AND APPROPRIATE EASEMENTS AS NOTED.
4. THE PLAT SHOWS EXISTING RECORDS AND APPROPRIATE EASEMENTS AS NOTED.
5. THE PLAT SHOWS EXISTING RECORDS AND APPROPRIATE EASEMENTS AS NOTED.
6. THE PLAT SHOWS EXISTING RECORDS AND APPROPRIATE EASEMENTS AS NOTED.

THE PLAT SHOWS EXISTING RECORDS AND APPROPRIATE EASEMENTS AS NOTED.

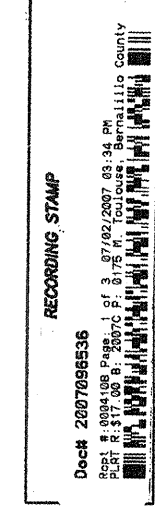

Legal Description

THE PLAT SHOWS EXISTING RECORDS AND APPROPRIATE EASEMENTS AS NOTED.

THE PLAT SHOWS EXISTING RECORDS AND APPROPRIATE EASEMENTS AS NOTED.

Free Consent and Dedication

THE PLAT SHOWS EXISTING RECORDS AND APPROPRIATE EASEMENTS AS NOTED.

Acknowledgment

THE PLAT SHOWS EXISTING RECORDS AND APPROPRIATE EASEMENTS AS NOTED.

THE PLAT SHOWS EXISTING RECORDS AND APPROPRIATE EASEMENTS AS NOTED.

Plat of
Tracts N-1-B-2-A, N-1-B-2-B and N-1-B-2-C
Seven-Bar Ranch
Albuquerque, Bernalillo County, New Mexico
March 2007

Project No. 1005133

Application No. 07DRB-00852

Utility Approvals

THE PLAT SHOWS EXISTING RECORDS AND APPROPRIATE EASEMENTS AS NOTED.

City Approvals

THE PLAT SHOWS EXISTING RECORDS AND APPROPRIATE EASEMENTS AS NOTED.

Tracts N-1-B-2-A, N-1-B-2-B and N-1-B-2-C

Tracts N-1-B-2-A, N-1-B-2-B and N-1-B-2-C

UTILITY CONTACTS

Business	Name	Phone
PNM Electric Co. Mail Stop ES61 4201 Edith Blvd. NW Albuquerque, NM 87107	Blauwkamp, Roland	Office phone: (505) 241-3606 Cell phone: (505) 401-7516 Office fax: (505) 241-0559 rblauwk@pnm.com
New Mexico Utilities 4700 Irving Blvd. NW Suite 201 Albuquerque, NM 87114	Bates, Steve	Office phone: (505) 898-2661 ext.48 Office fax: (505) 898-6379 sbates@coresources.com
PNM Gas Co. Mail Stop GS66 4625 Edith Blvd. NE Albuquerque, NM 87107	Bouska, Kelly	Office Phone: (505) 241-7752 Office Fax: (505) 241-7753 kbouska@pnm.com
BGC Assets 505 Marquette Ave NW Suite LL-110A Albuquerque, NM 87102	Brown, John	Office Phone: (505) 314-0890 Office Fax: (505) 314-0891 john@bgcassets.com
AT&T Resources Supervisor 111 3rd Street NW Albuquerque, NM 87103	Crowel, David	Office Phone: (505) 842-2911 Office Fax: (505) 842-2890 dcrowel@att.com
MCI Worldcom Operations Manager 6001 Midway Park NE Albuquerque, NM 87109	Darnell, Andy	Office Phone: (505) 346-4470 Office Fax: (505) 348-8666 andy.darnell@mci.com
Time Warner Telecom Plant Manager 3830 Singer Blvd. NE Suite 1000 Albuquerque, NM 87109	Harrison, Royal	Office Phone: (505) 938-7339 Office Fax: (505) 938-7380 royal.harrison@ttelecom.com
Qwest Manager-Engineering NM Engineering/Planning 400 Tijeras NW, Room 710 Albuquerque, NM 87102	Jaramillo, Rita	Office Phone: (505) 245-8352 Cell Phone: (505) 385-4472 Office Fax: (505) 245-6733 rjarami@qwest.com
Qwest Long Distance Sr. Operations Tech 400 Tijeras Ave NW Suite 570 Albuquerque, NM 87102	Kelly, Larry	Office Phone: (505) 246-0501 Cell Phone: (505) 270-3442 Office Fax: (505) 246-0479 larry.kelly@qwest.com
Comcast Project Manager 4611 Montbel Place NE Albuquerque, NM	Mortus, Mike	Office Phone: (505) 761-6235 Cell Phone: (505) 269-4006 Office Fax: (505) 761-0599 mike_mortus@cable.comcast.com
McLeod USA Supervisor of Outside Techs. 505 Marquette NW (Compass Bank) Suite 1600 Albuquerque, NM 87102	Mueller, Rick	Office Phone: (505) 244-3161 Cell Phone: (505) 228-3329 Office Fax: (505) 244-0094 rdmueller@mcleodusa.com

GENERAL NOTES

1. THE CONTRACTOR SHALL ABIDE BY ALL LOCAL, STATE, AND FEDERAL LAWS, RULES AND REGULATIONS WHICH APPLY TO THE CONSTRUCTION OF THESE IMPROVEMENTS, INCLUDING EPA REQUIREMENTS WITH RESPECT TO STORM WATER DISCHARGE. CONTRACTOR IS RESPONSIBLE FOR PREPARING THE SWPPP DOCUMENTS AND MAKING ALL APPLICATIONS. CONTRACTOR IS ALSO REQUIRED TO INSTALL & MAINTAIN ALL BMP'S THROUGHOUT THE PROJECT.
2. CONSTRUCTION ACTIVITY SHALL BE LIMITED TO THE PROPERTY AND/OR PROJECT LIMITS. ANY DAMAGE TO ADJACENT PROPERTIES RESULTING FROM THE CONSTRUCTION PROCESS SHALL BE REPAIRED OR REPLACED AT THE CONTRACTOR'S EXPENSE.
3. OVERNIGHT PARKING OF CONSTRUCTION EQUIPMENT SHALL NOT OBSTRUCT DRIVEWAYS OR DESIGNATED TRAFFIC LANES. THE CONTRACTOR SHALL NOT STORE ANY EQUIPMENT OR MATERIAL WITHIN THE PUBLIC RIGHT-OF-WAY.
4. THE CONTRACTOR SHALL TAKE ALL STEPS NECESSARY TO CONFORM WITH EPA REQUIREMENTS, INCLUDING COMPLIANCE WITH NPDES PHASE 2 REQUIREMENTS.
5. LANE CLOSURE ON COORS BLVD. WILL BE ALLOWED FROM 9:00 AM TO 3:30 PM.
6. CONTRACTOR TO SUBMIT AND OBTAIN APPROVAL FOR A TRAFFIC CONTROL PERMIT FROM NMDOT FOR ALL WORK WITHIN COORS RIGHT OF WAY.
7. CONTRACTOR SHALL SUBMIT A TRAFFIC CONTROL PLAN TO NMDOT FOR REVIEW AND APPROVAL FOR ANY WORK PERFORMED WITHIN COORS RIGHT OF WAY. THE TRAFFIC CONTROL PLAN SHALL BE PREPARED ON AN 11"x17" SHEET - NO "HAND DRAWN" TRAFFIC CONTROL PLANS WILL BE ACCEPTED.

DEMOLITION NOTES

1. CONTRACTOR SHALL PROTECT ALL EXISTING SITE IMPROVEMENTS (UTILITIES, CURBS, WALLS, ETC.) THAT ARE TO REMAIN, FROM DAMAGE DURING ALL PROJECT WORK. MEANS AND METHODS USED TO PROTECT EXISTING IMPROVEMENTS ARE THE CONTRACTOR'S SOLE RESPONSIBILITY. ANY CONTRACTOR-CAUSED DAMAGE TO EXISTING SITE IMPROVEMENTS SHALL BE REPAIRED/REPLACED BY THE CONTRACTOR AT HIS EXPENSE.
2. ALL UTILITY COMPANY FACILITIES AND UNDERGROUND UTILITY LINES, WHETHER INDICATED OR NOT INDICATED ON THE DRAWING, SHALL BE REMOVED AS REQUIRED FOR NEW CONSTRUCTION AND CAPPED. CONTRACTOR TO COORDINATE THIS WORK WITH UTILITY COMPANIES.
3. DEMOLITION PHASING SHALL PROCEED ONLY WITH THE PHASING OF THE CONSTRUCTION WORK SO THAT DEMOLITION DOES NOT OCCUR UNTIL CONSTRUCTION IS IMMINENT.
4. ALL SIGNS SHALL BE STOCKPILED FOR RE-USE. ITEMS TO BE RE-USED SHALL BE IN GOOD CONDITION, AS APPROVED BY OWNER'S REPRESENTATIVE.
5. CONTRACTOR SHALL COORDINATE WORK INDICATED ON THE SITE DEMOLITION PLANS WITH THE CONSTRUCTION PLANS TO DETERMINE SPECIFIC REMOVAL LIMITS.
6. CONTRACTOR IS RESPONSIBLE FOR ALL VEHICULAR AND PEDESTRIAN TRAFFIC CONTROL. CONTRACTOR SHALL COORDINATE WITH CITY OF ALBUQUERQUE FOR WORK WITHIN THE PUBLIC RIGHT OF WAY AND WITH OWNER'S REPRESENTATIVE FOR WORK ON-SITE. OWNER'S REPRESENTATIVE SHALL APPROVE ALL PLANS PRIOR TO IMPLEMENTATION.
7. CONTRACTOR IS RESPONSIBLE FOR DRAINAGE MANAGEMENT AND EROSION CONTROL AT ALL TIMES DURING THE CONSTRUCTION PERIOD. CONTRACTOR SHALL PREPARE AND IMPLEMENT THE REQUIRED SWPPP IN ACCORDANCE WITH EPA REQUIREMENTS.
8. EXISTING SIGNS WHICH ARE REMOVED DURING CONSTRUCTION SHALL BE STOCKPILED IN A LOCATION DESIGNATED BY THE OWNER'S REPRESENTATIVE.
9. CONTRACTOR SHALL BE RESPONSIBLE FOR ALL DEMOLITION AND UTILITY TRENCHING NECESSARY TO PERFORM THE WORK SHOWN ON THE UTILITY AND ELECTRICAL PLANS.
10. CONTRACTOR SHALL CLEAR, GRUB, SCARIFY, AND REMOVE ROOTS AS NEEDED.

GRADING NOTES

1. EXCEPT AS PROVIDED HEREIN, GRADING SHALL BE PERFORMED AT THE ELEVATIONS AND IN ACCORDANCE WITH THE DETAILS SHOWN IN THESE PLANS.
2. THE COST FOR REQUIRED CONSTRUCTION DUST AND EROSION CONTROL MEASURES SHALL BE INCIDENTAL TO THE PROJECT COST.
3. EARTH SLOPES SHALL NOT EXCEED 3 HORIZONTAL TO 1 VERTICAL UNLESS SHOWN OTHERWISE.
4. IT IS THE INTENT OF THESE PLANS THAT THIS CONTRACTOR SHALL NOT PERFORM ANY WORK OUTSIDE OF THE PROPERTY BOUNDARIES EXCEPT AS REQUIRED BY THIS PLAN.
5. THE CONTRACTOR IS TO ENSURE THAT NO SOIL ERODES FROM THE SITE ONTO ADJACENT PROPERTY OR PUBLIC RIGHT-OF-WAY. THIS SHOULD BE ACHIEVED BY CONSTRUCTING TEMPORARY BERMS OR SILT FENCE AT THE PROPERTY LINES AND NETTING THE SOIL TO PROTECT IT FROM WIND EROSION.
6. PAVING AND ROADWAY GRADES SHALL BE +/- 0.1' FROM PLAN ELEVATIONS.
7. VERIFY ALL ELEVATIONS SHOWN ON PLAN FROM BASIS OF ELEVATION CONTROL STATION PRIOR TO BEGINNING CONSTRUCTION.
8. ALL EXISTING MANHOLES, VALVE COVERS & OTHER UTILITY APPURTENANCES WHICH ARE TO REMAIN SHALL BE ADJUSTED TO NEW GRADE AS REQUIRED.

SIGNING & STRIPING NOTES

1. ALL SIGNING & STRIPING SHALL BE INSTALLED IN ACCORDANCE WITH MUTCD LATEST EDITION. ALL SIGNS SHALL BE COVERED WITH AN ANTI-GRAFFITI COATING.
2. MEDIAN NOSES SHALL BE PAINTED YELLOW FROM THE PC TO THE PT.
3. ERADICATION OF STRIPING TO BE ACCOMPLISHED BY WATER BLASTING ONLY.
4. CONTRACTOR SHALL OBLITERATE ANY CONFLICTING STRIPING.
5. ALL PAVEMENT MARKINGS SHALL BE PERFORMED WITH THERMO-PLASTIC.

LANDSCAPE & IRRIGATION NOTES

1. CONTRACTOR SHALL PROVIDE TEMPORARY IRRIGATION WATER TO ALL UNDISTURBED TREES, SHRUBS, GRASS, AND GROUND COVER WHICH HAVE IRRIGATION SERVICE INTERRUPTED DUE TO THE CONSTRUCTION.
2. CONTRACTOR SHALL VERIFY THAT THE REMAINING IRRIGATION SYSTEM IS OPERATIONAL UPON COMPLETION OF MEDIAN RECONSTRUCTION.
3. THE CONTRACTOR SHALL PROTECT EXISTING TREES TO REMAIN.
4. THE CONTRACTOR SHALL INSTALL A SCH 40 PVC SLEEVE FOR ALL IRRIGATION DISTRIBUTION LINES LOCATED WITHIN PAVED AREAS.




Bohannon & Huston
Court yard | 7800 Jefferson St. NE Albuquerque, NM 87108-4336
ENGINEERING • SPATIAL DATA • ADVANCED TECHNOLOGIES



CITY OF ALBUQUERQUE
DEPARTMENT OF
MUNICIPAL DEVELOPMENT

COSTCO PUBLIC INFRASTRUCTURE
GENERAL NOTES

DESIGN REVIEW COMMITTEE APPROVED SEP 26 2007 DESIGN REVIEW COMMITTEE	CITY ENGINEER APPROVAL SEP 26 2007 DESIGN REVIEW COMMITTEE	LAST DESIGN UPDATE	MO./DAY/YR.	MO./DAY/YR.
CITY PROJECT NO. 729082	ZONE MAP NO. B-13, B-14, C-13, D-13	SHEET 3	OF 22	

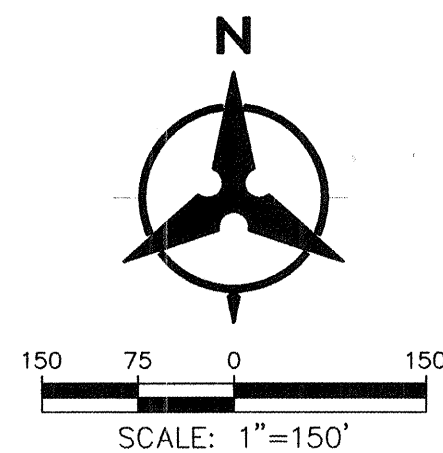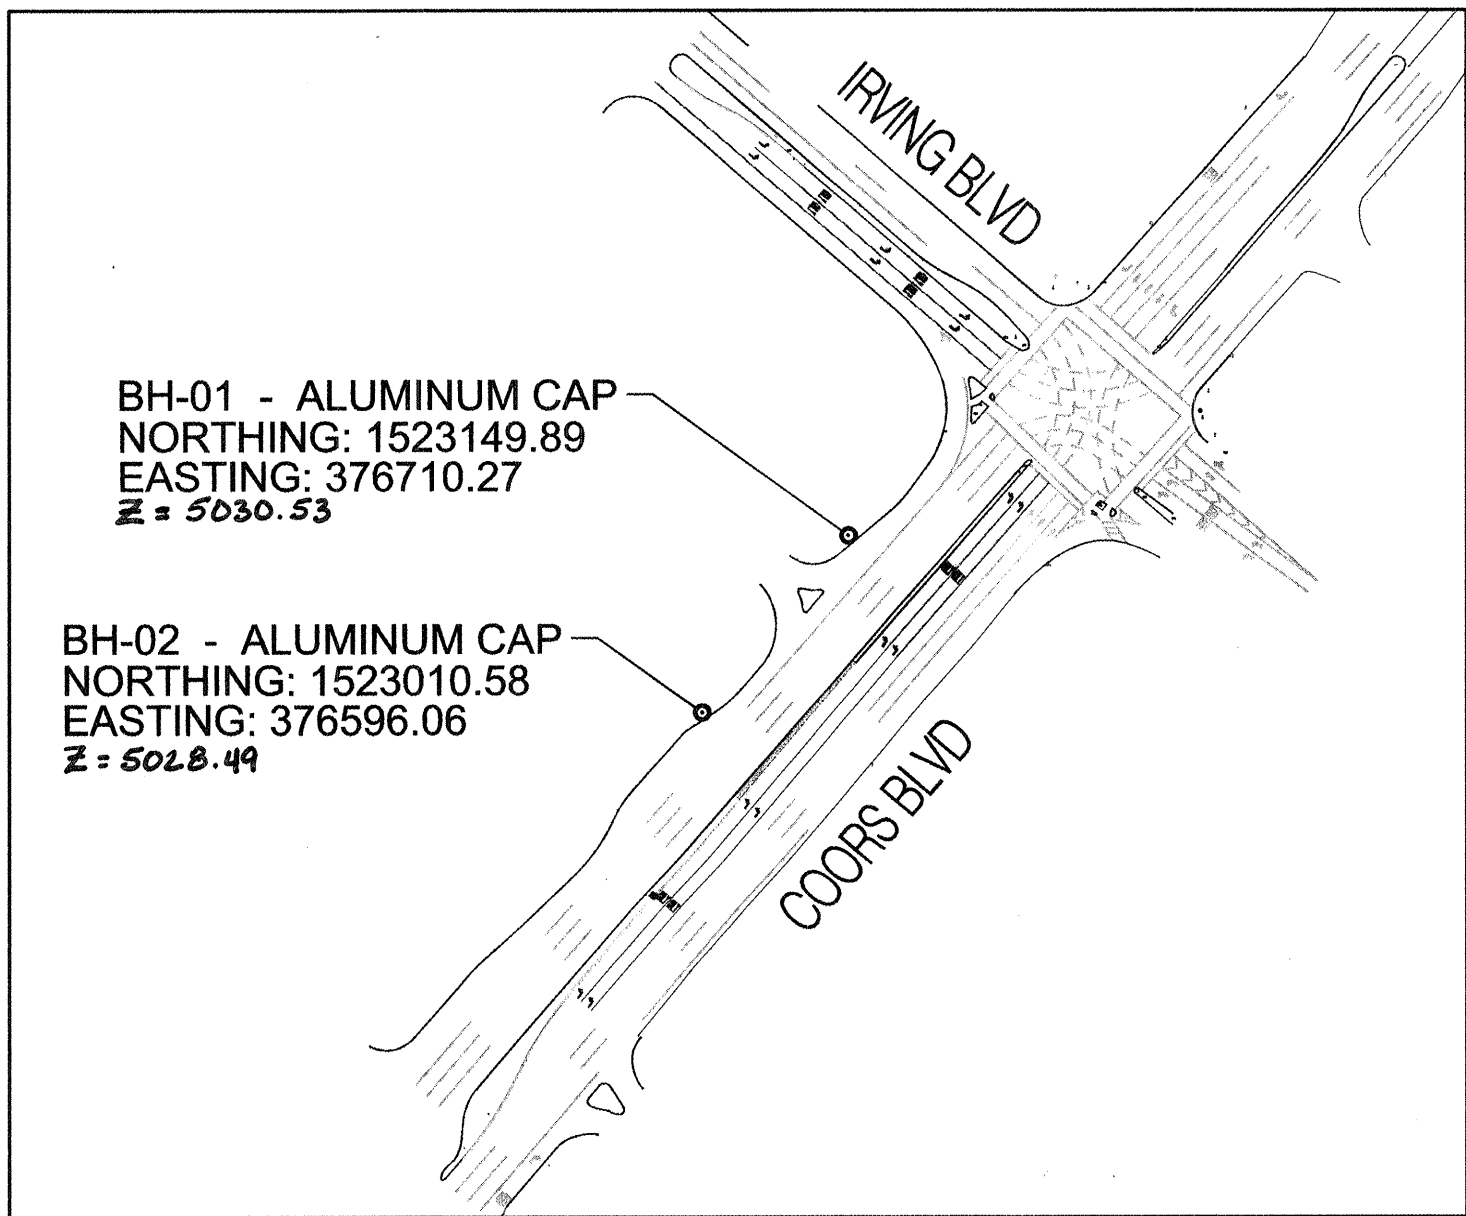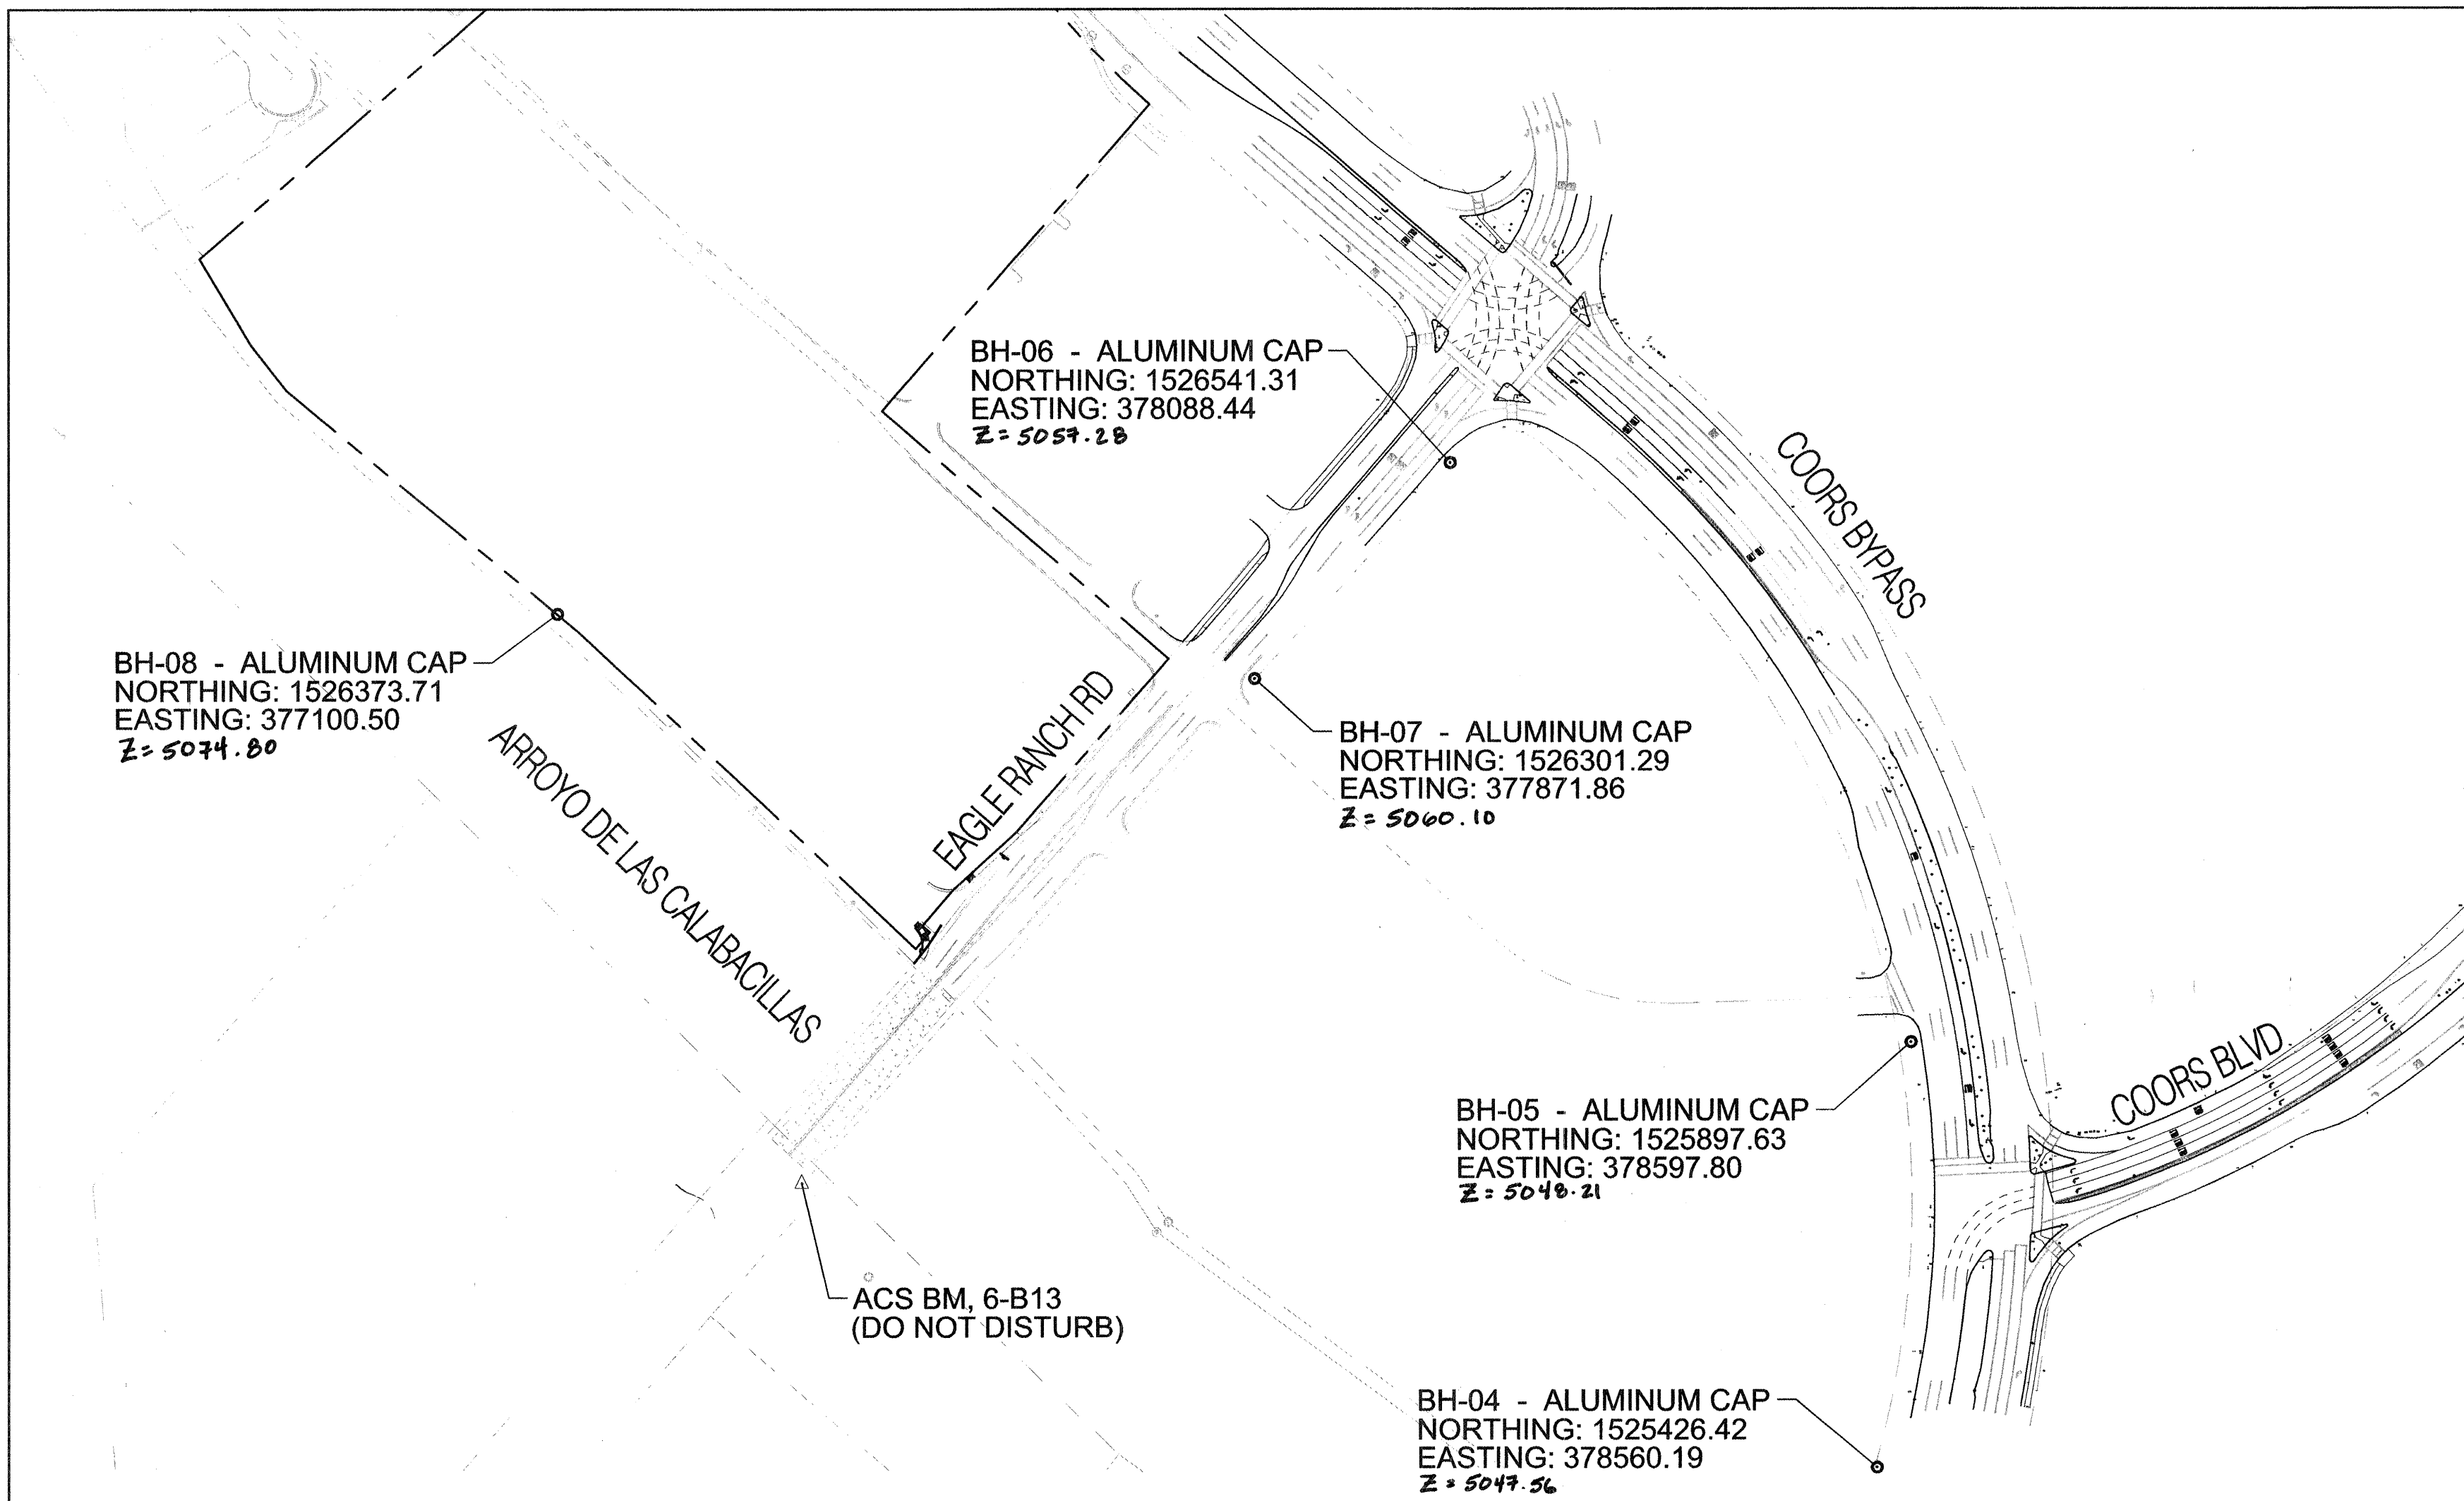

HORIZONTAL CONTROL POINTS:
BH-01, BH-02, BH-04, BH-05,
BH-06, BH-07, & BH-08
(AS SHOWN ON THIS SHEET)

AS-BUILT INFORMATION		BENCH MARKS		SURVEY INFORMATION		ENGINEER'S SEAL		REMARKS		REVISIONS		DESIGN		DATE	
CONTRACTOR	Bohannon & Huston	NO.	DATE	NO.	DATE			NO.	DATE	NO.	DATE	NO.	DATE	NO.	DATE
INSPECTOR'S	Robinson, Tek	ACS CONTROL MONUMENT	DATE	BY	DATE			REMARKS	DATE	REVISIONS	DATE	DESIGN	DATE	CHECKED BY	DATE
STAKED BY	Sacru - Tek	1 3/4" ALUMINUM DISK STAMPED "ACS BM 6-B13"													
INSPECTION	DATE 1-2008	LOCATED ON TOP OF CONCRETE BRIDGE SLEEPER SLAB, FIELD													
VERIFICATION	DATE 1-2008	SOUTHEASTLY QUADRANT OF EAGLE RANCH RD NW CORNER													
CORRECTION	DATE 1-2008	AND THE CALABASILLAS ARROYO													
MICRO-FILM INFORMATION		ELEVATION = 5085.637 FT. (NGVD 1929)													
RECORDED BY															
NO.															




Bohannon & Huston
Court yard | 7800 Jefferson St. NE Albuquerque, NM 87109-4335
ENGINEERING • SPATIAL DATA • ADVANCED TECHNOLOGIES

CITY OF ALBUQUERQUE
DEPARTMENT OF
MUNICIPAL DEVELOPMENT

COSTCO PUBLIC INFRASTRUCTURE
HORIZONTAL CONTROL PLAN

DESIGN REVIEW COMMITTEE	CITY ENGINEER APPROVAL	MO./DAY/YR.	MO./DAY/YR.
APPROVED	APPROVED		
SEP 25 2007			
DESIGN REVIEW COMMITTEE	DESIGN REVIEW COMMITTEE		

CITY PROJECT NO.	729082	ZONE MAP NO.	B-13, B-14, C-13, D-13	SHEET	4	OF	22
------------------	--------	--------------	------------------------	-------	---	----	----

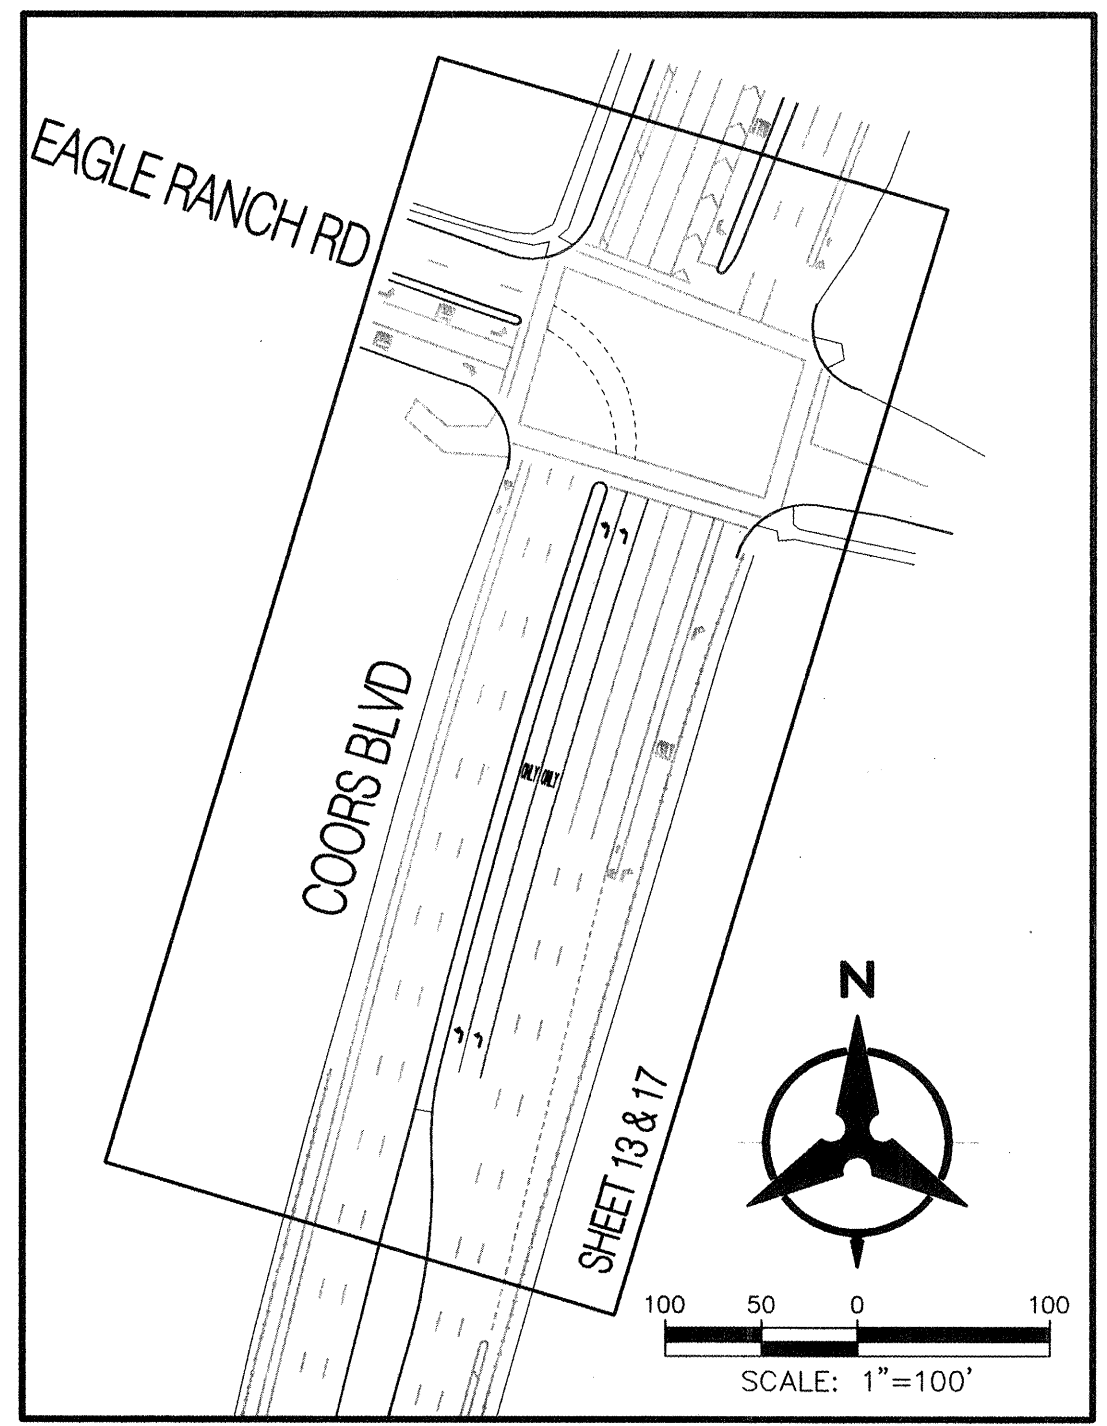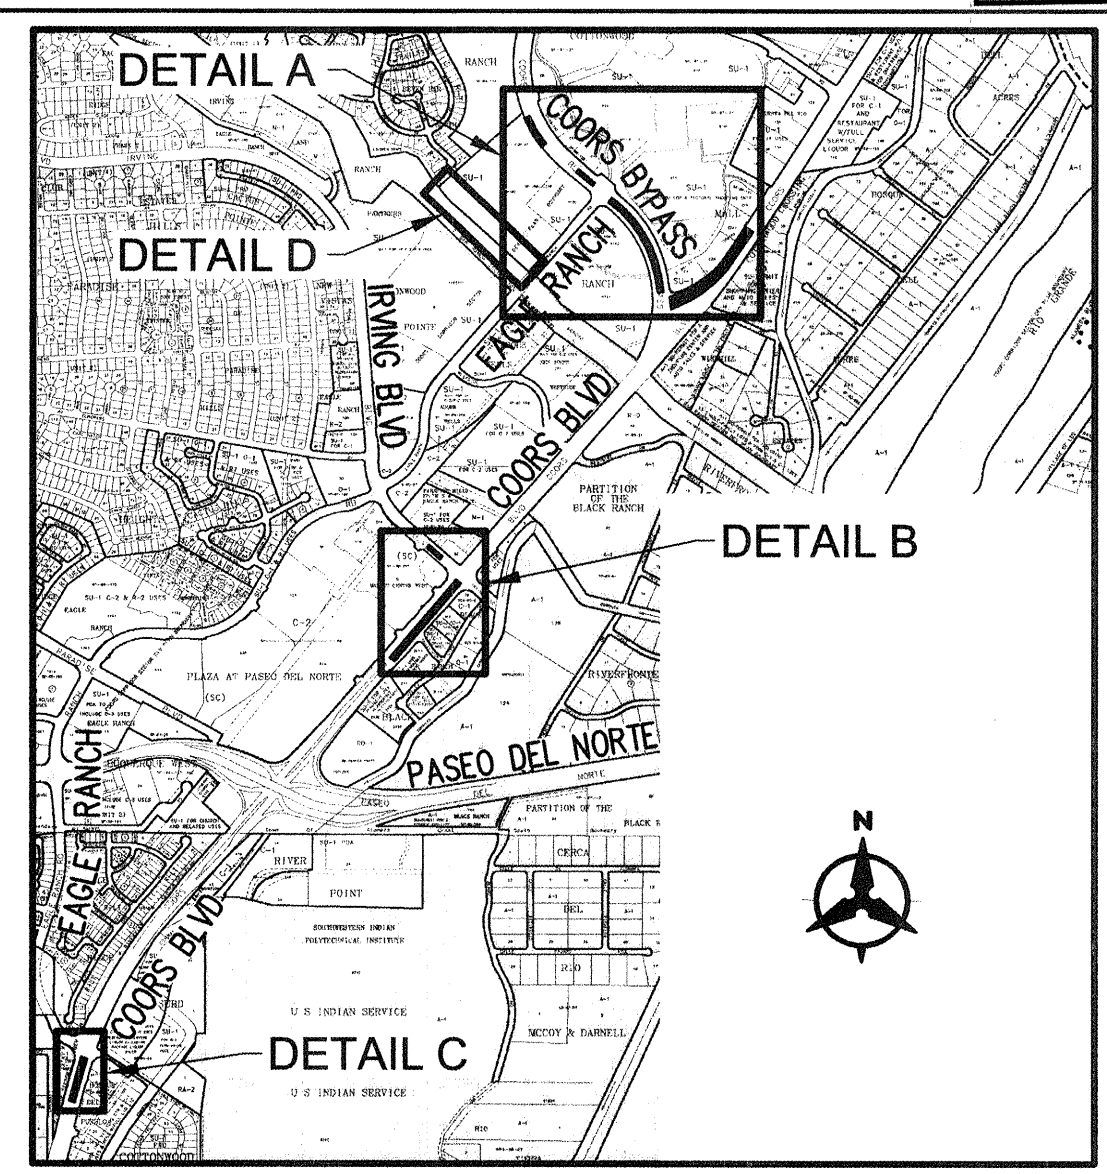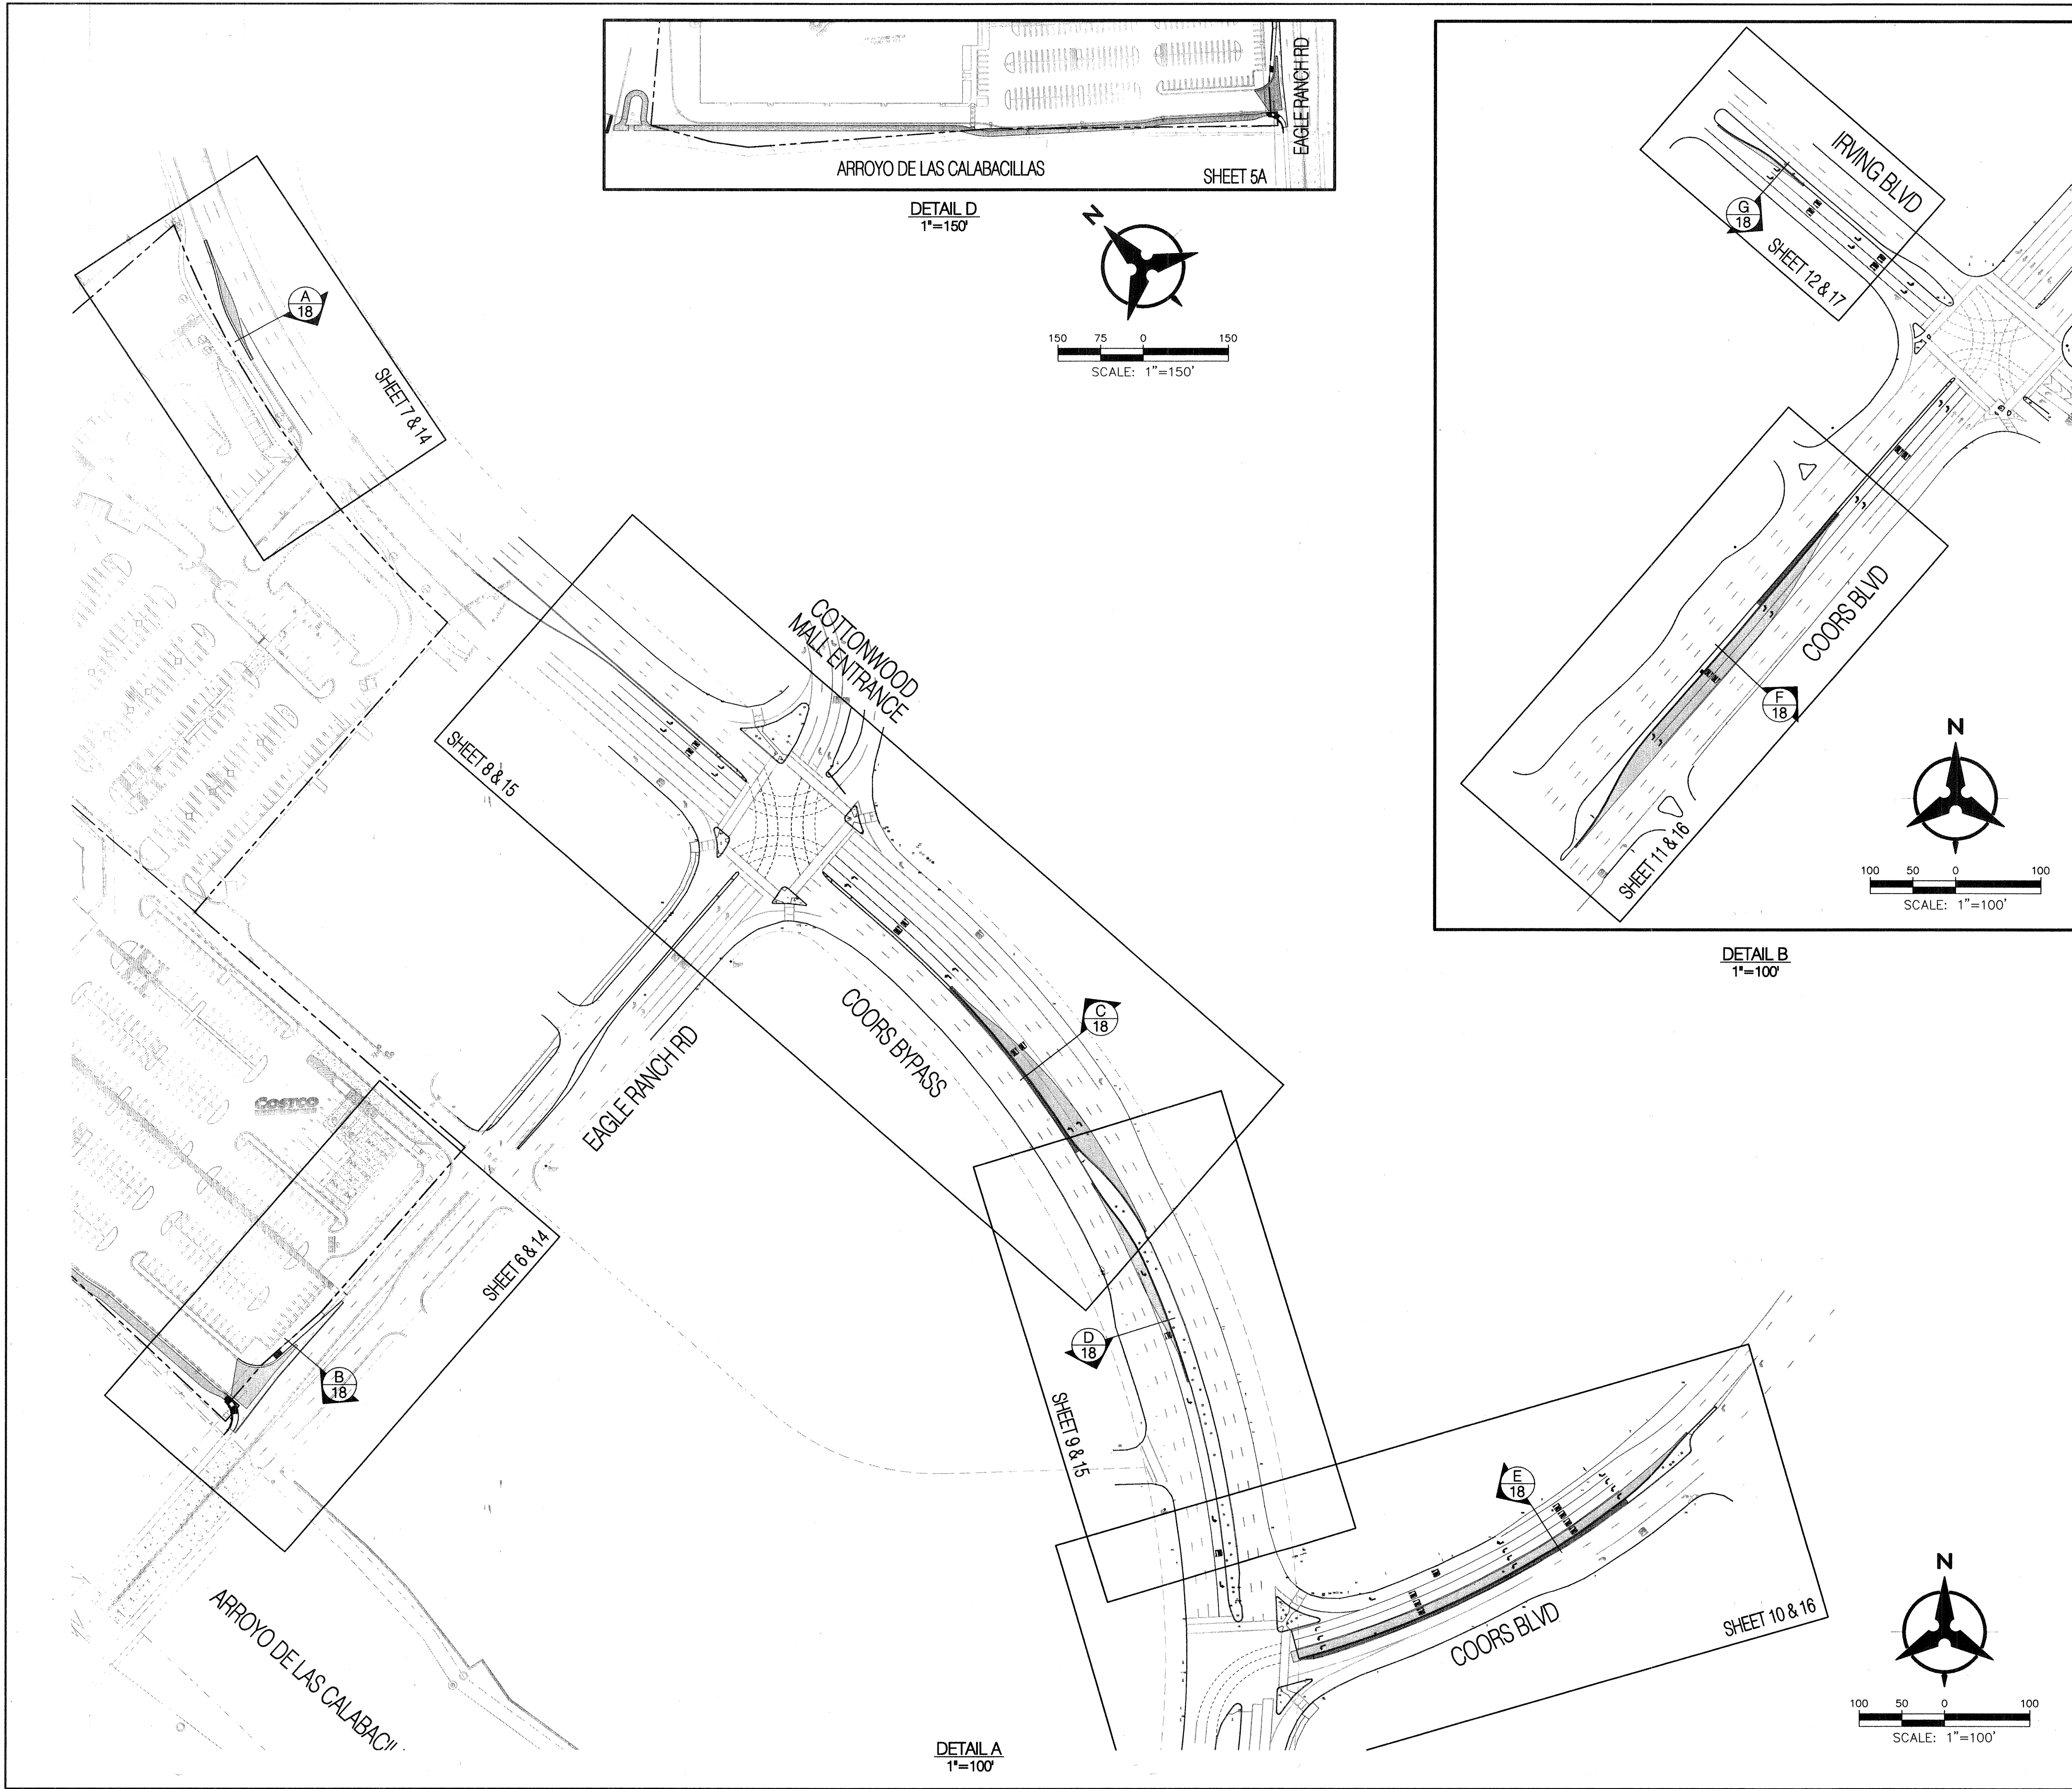




Bohannon & Huston
 Courtyard 1 7500 Jefferson St. NE Albuquerque, NM 87109-4395
 ENGINEERING & SPATIAL DATA & ADVANCED TECHNOLOGIES

CITY OF ALBUQUERQUE
 DEPARTMENT OF
 MUNICIPAL DEVELOPMENT

COSTCO PUBLIC INFRASTRUCTURE
 OVERALL PAVING PLAN, SIGNING & STRIPING PLAN,
 & KEY MAP

CITY PROJECT NO. 729082 ZONE MAP NO. B-13, B-14, C-13, D-13 SHEET 5 OF 22

AS-BUILT INFORMATION		BENCH MARKS		SURVEY INFORMATION		ENGINEER'S SEAL		REVISIONS		DESIGN		DATE	
CONTRACTOR	Bohannon & Huston	DATE	2-2007	NO.	BY	DATE	BY	NO.	DATE	NO.	DATE	NO.	DATE
WORK	STANDARD	DATE	2-2007	NO.	BY	DATE	BY	NO.	DATE	NO.	DATE	NO.	DATE
ACCEPTANCE	BY B.H.T.	DATE	2-2007	NO.	BY	DATE	BY	NO.	DATE	NO.	DATE	NO.	DATE
DRAWINGS	BY Bohannon & Huston	DATE	2-2007	NO.	BY	DATE	BY	NO.	DATE	NO.	DATE	NO.	DATE
CORRECTIONS	BY B.H.T.	DATE	2-2007	NO.	BY	DATE	BY	NO.	DATE	NO.	DATE	NO.	DATE
MICRO-FILM INFORMATION												RECORDED BY	DATE
												NO.	DATE
												NO.	DATE

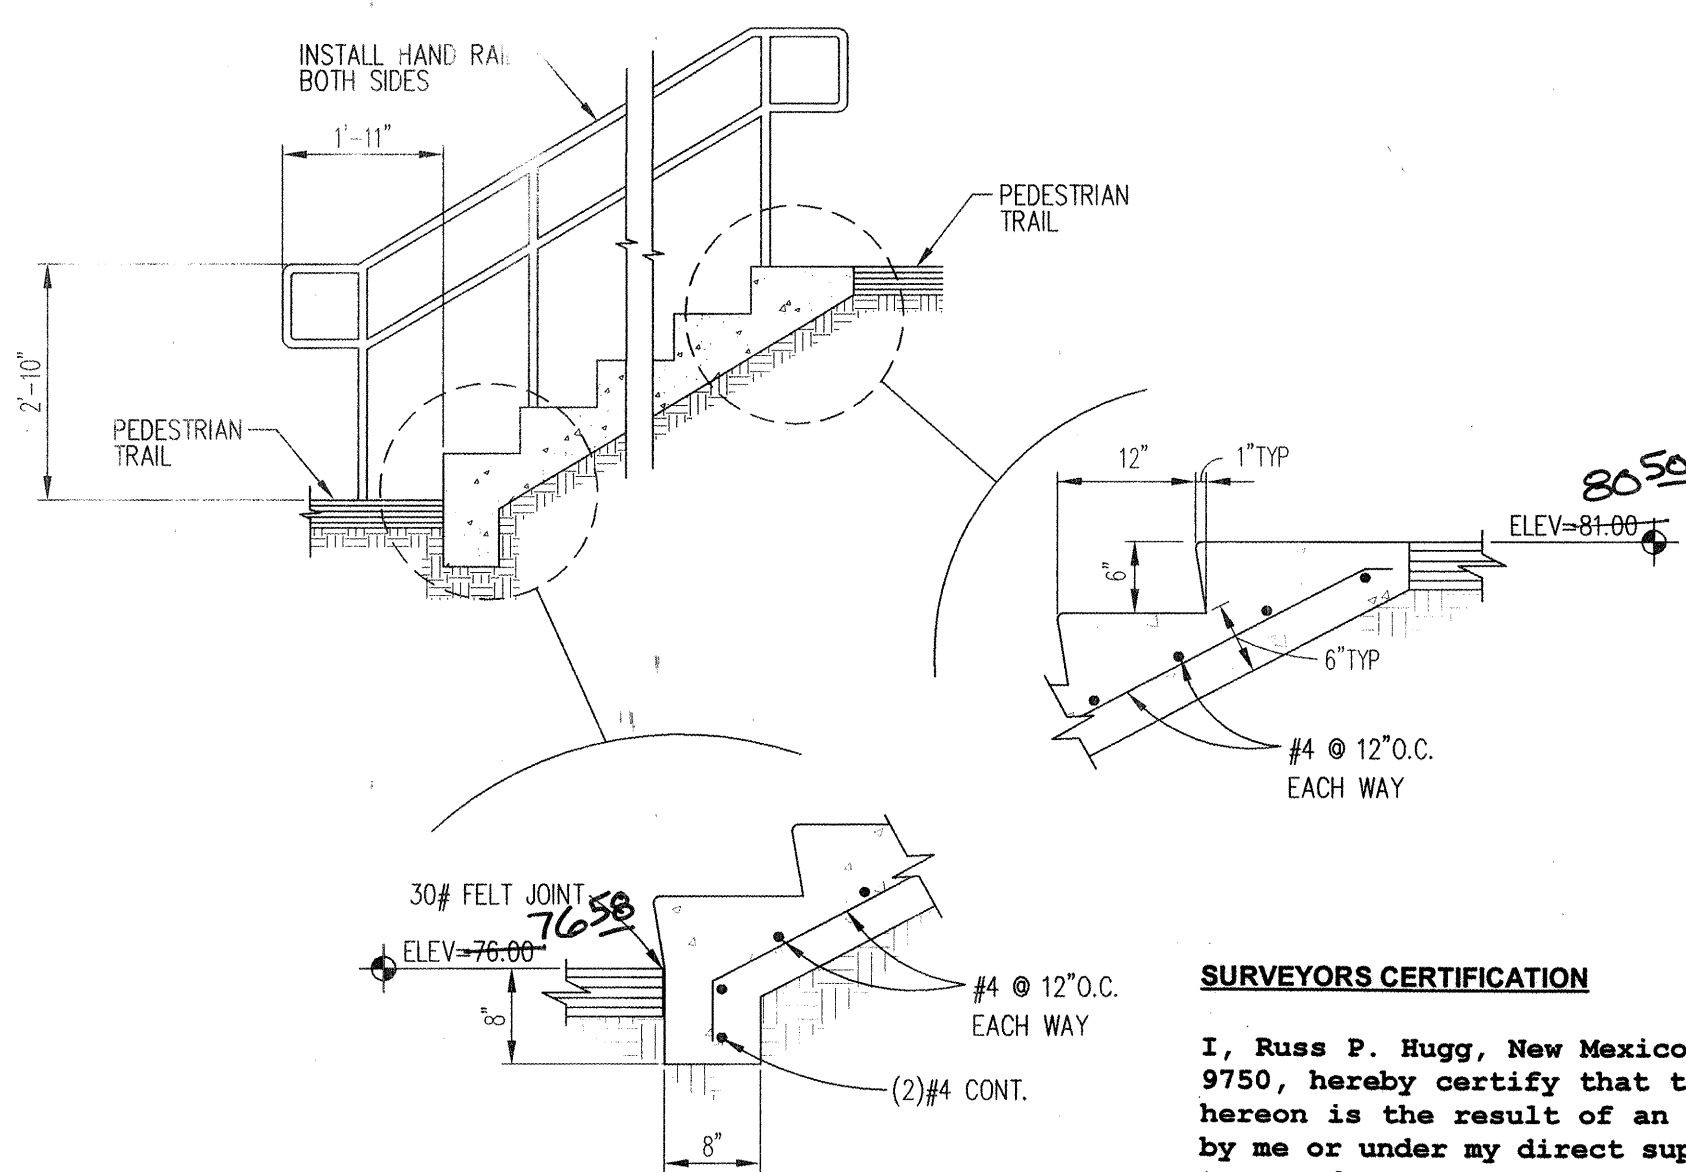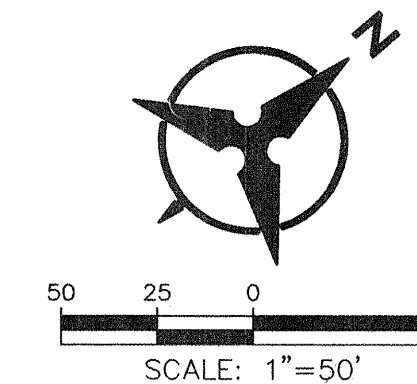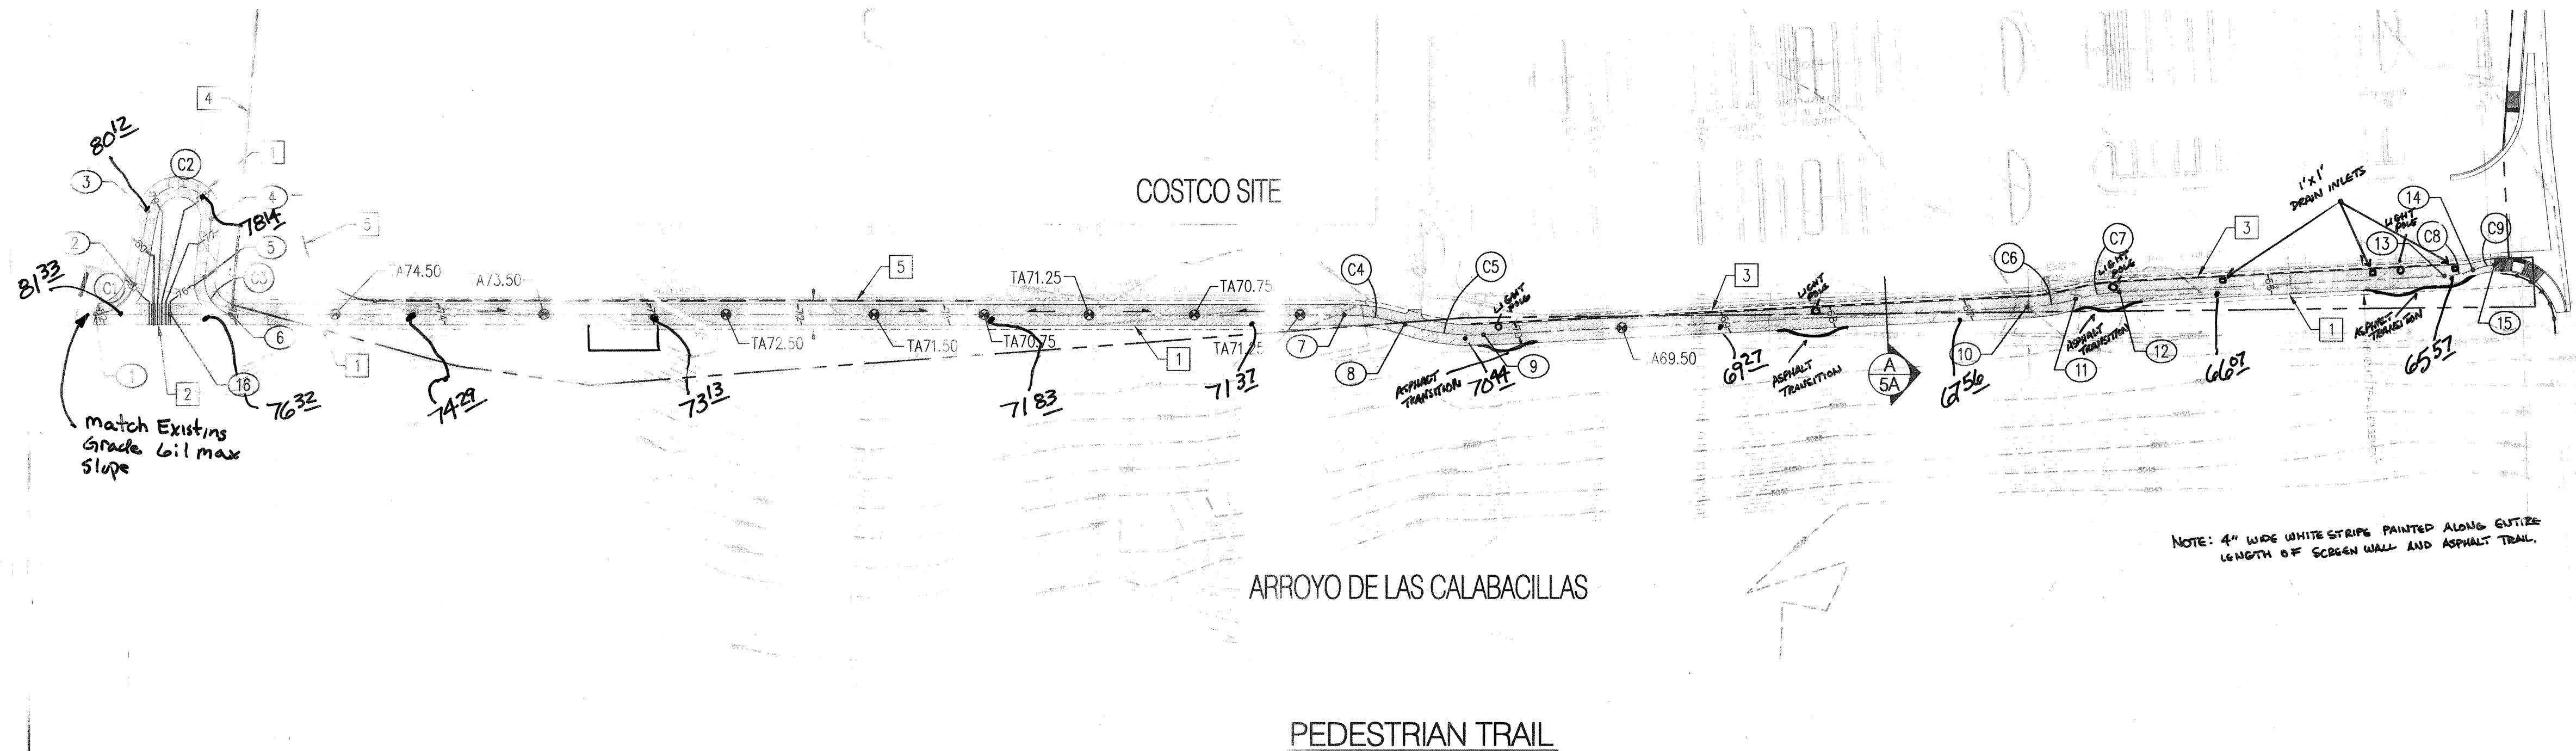


1 CONCRETE STEPS & HANDRAIL
NOT TO SCALE


SURVEYORS CERTIFICATION

I, Russ P. Hugg, New Mexico Professional Surveyor Number 9750, hereby certify that the as-built information shown hereon is the result of an actual field survey performed by me or under my direct supervision and that the same is true and correct to the best of my knowledge and belief;

Russ P. Hugg
NMPS No. 9750
12.13, 2007

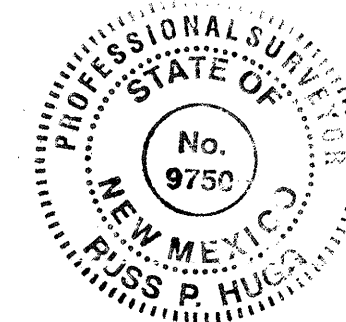

CURB & GUTTER
TO BE CONSTRUCTED
W/ ONSITE DRAWINGS

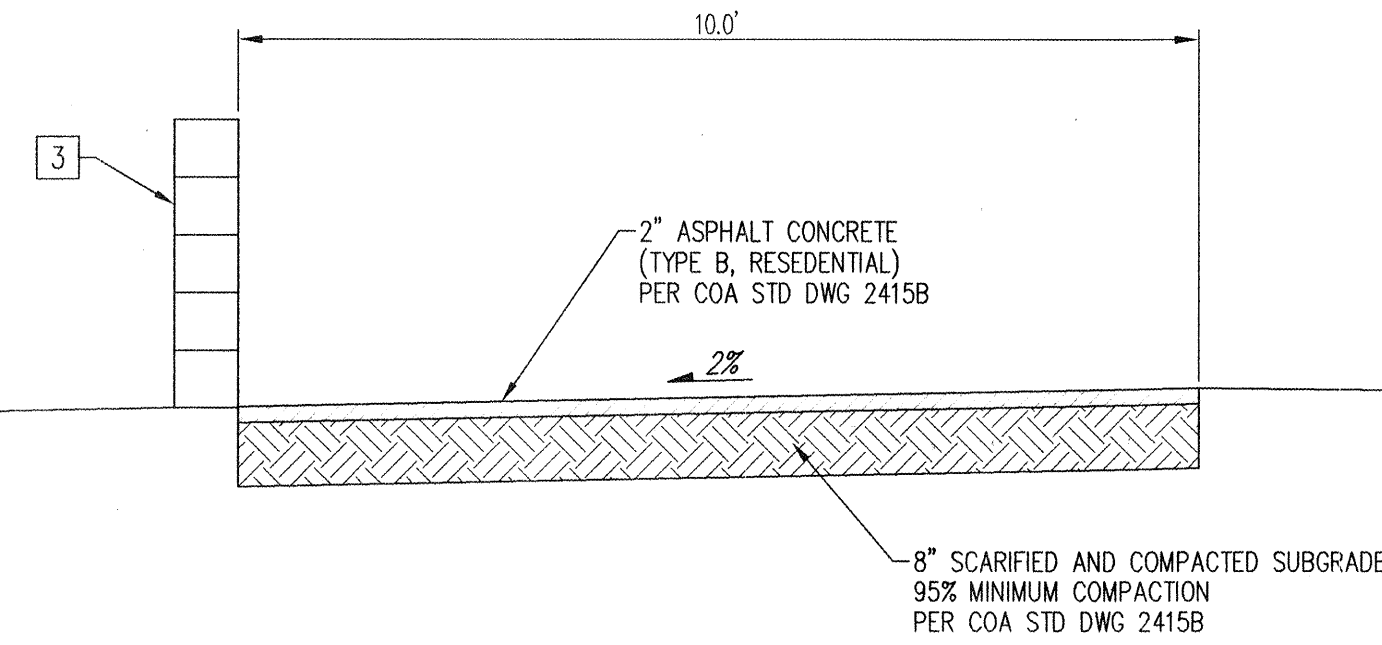

A PEDESTRIAN TRAIL SECTION
NOT TO SCALE

PEDESTRIAN TRAIL KEYED NOTES.

- 10' WIDE PEDESTRIAN TRAIL PER COA STD DWG 2415B
- CONSTRUCT 10' WIDE CONCRETE STEPS WITH HANDRAIL PER DETAIL 1 THIS SHEET
- 3' HIGH CMU SCREEN WALL WITH VERTICAL MORTAR JOINT AT BOTTOM COURSE TO BE OMITTED @ 6' O.C. FOR DRAINAGE. SCREEN WALL TO BE CONSTRUCTED WITH ONSITE DRAWINGS.
- 6' HIGH CMU SCREEN WALL TO BE CONSTRUCTED WITH ONSITE DRAWINGS.
- RETAINING WALL TO BE CONSTRUCTED WITH ONSITE DRAWINGS

Point Table			
	NORTHING	EASTING	ELEVATION
1	1526809.72	376654.37	5082.13
2	1526807.19	376677.61	5080.93
3	1526828.13	376706.80	5079.25
4	1526804.34	376726.06	5077.43
5	1526786.32	376704.34	5076.01
6	1526764.90	376700.72	5075.05
7	1526394.26	377083.99	5071.04
8	1526370.72	377101.75	5070.67
9	1526341.05	377125.35	5070.26
10	1526169.89	377321.61	5066.85
11	1526156.47	377341.01	5066.85
12	1526144.45	377358.39	5066.85
13	1526042.09	377475.76	5065.72
14	1526034.65	377487.60	5065.61
15	1526029.31	377496.84	5065.46
16	1526784.91	376680.02	5076.00

Curve Table			
ID	RADIUS	ARC	TANGENT
C1	19.91'	24.99'	71°55'08"
C2	15.39'	45.00'	167°29'55"
C3	16.65'	23.67'	81°26'55"
C4	95.01'	29.61'	175°1'15"
C5	105.01'	38.12'	20°48'06"
C6	105.50'	23.64'	12°50'19"
C7	94.50'	21.18'	12°50'19"
C8	45.00'	14.04'	175°2'15"
C9	45.00'	10.70'	13°37'23"

NOTE: ALL POINT & CURVE DATA ARE TO CENTERLINE OF TRAIL

LEGEND

- PEDESTRIAN TRAIL
- SCREEN WALL BY OTHERS
- RETAINING WALL BY OTHERS

Bohannon & Huston
Court yard | 7500 Jefferson St. NE Albuquerque, NM 87109-4336
ENGINEERING • SPATIAL DATA • ADVANCED TECHNOLOGIES



CITY OF ALBUQUERQUE
DEPARTMENT OF
MUNICIPAL DEVELOPMENT


COSTCO PUBLIC INFRASTRUCTURE
PEDESTRIAN TRAIL ALONG
ARROYO DE LAS CALABACILLAS

DESIGN REVIEW COMMITTEE	CITY ENGINEER APPROVAL	MO./DAY/YR.	MO./DAY/YR.
DESIGN REVIEW COMMITTEE	DESIGN REVIEW COMMITTEE		
DESIGN REVIEW COMMITTEE	DESIGN REVIEW COMMITTEE		


CITY PROJECT NO. 729082 ZONE MAP NO. B-13, B-14, C-13, D-13 SHEET 5A OF 22

RECORD DRAWING

NOTE: CONTRACTOR SHALL COORDINATE ALL DEMOLITION WORK WITH THE PAVING PLANS TO DETERMINE EXACT LIMITS OF REMOVAL.

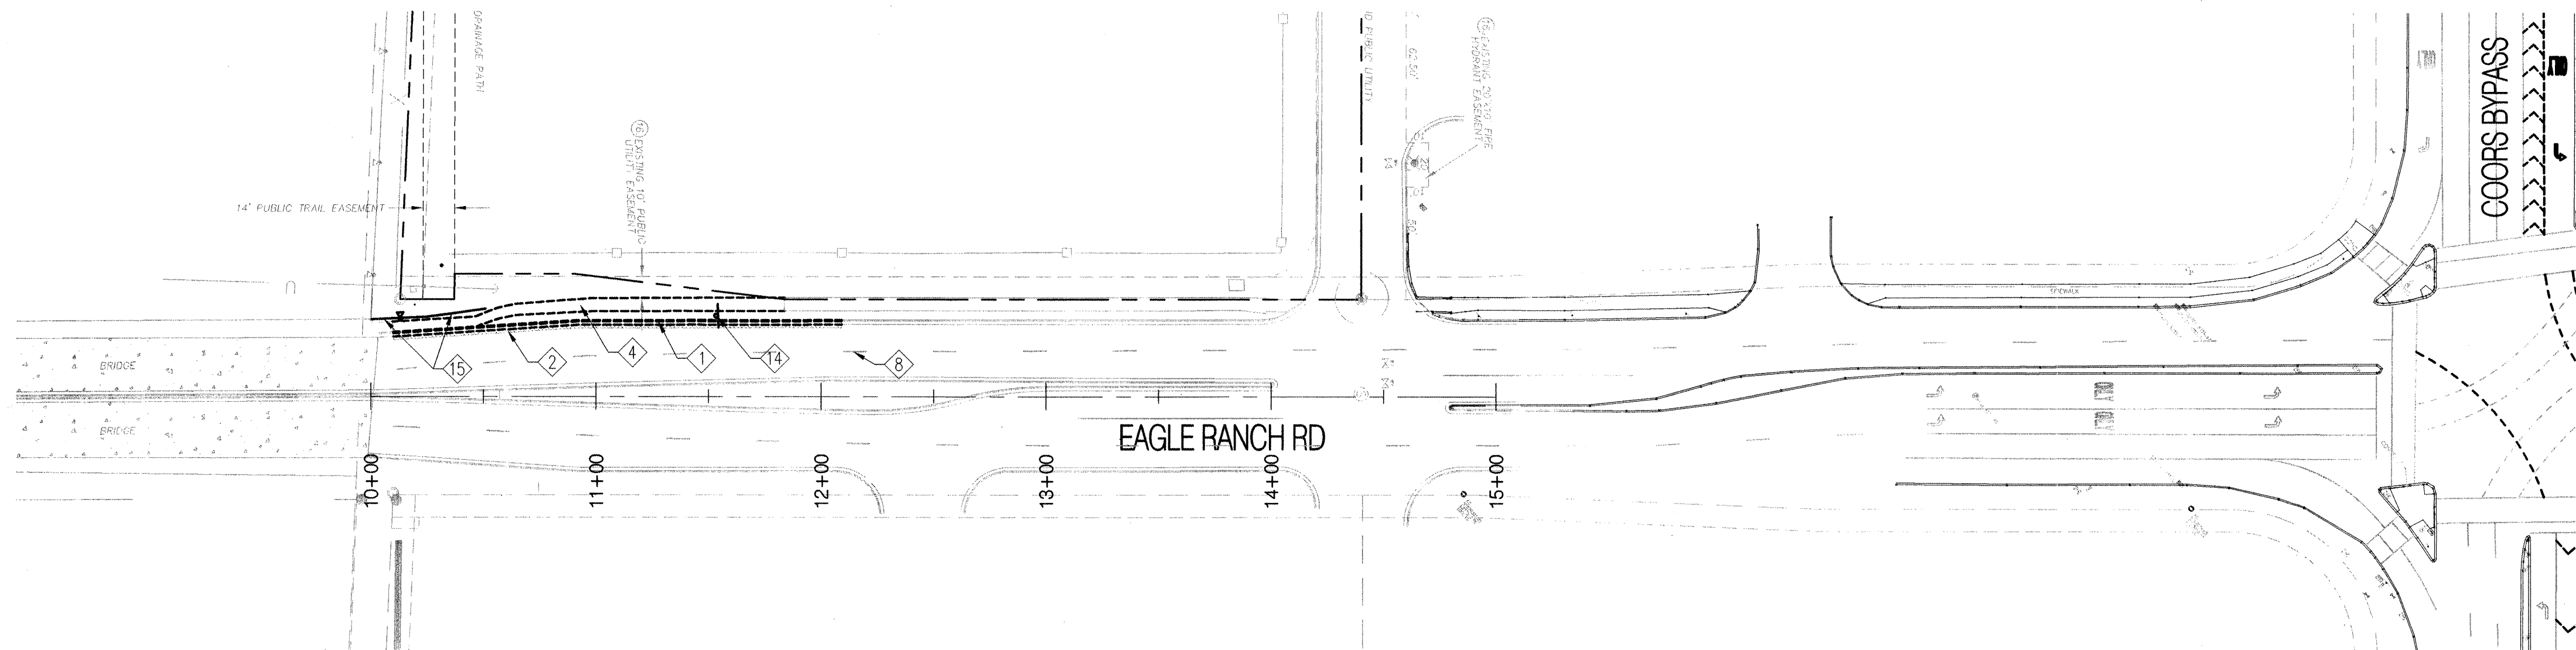


DEMOLITION PLAN

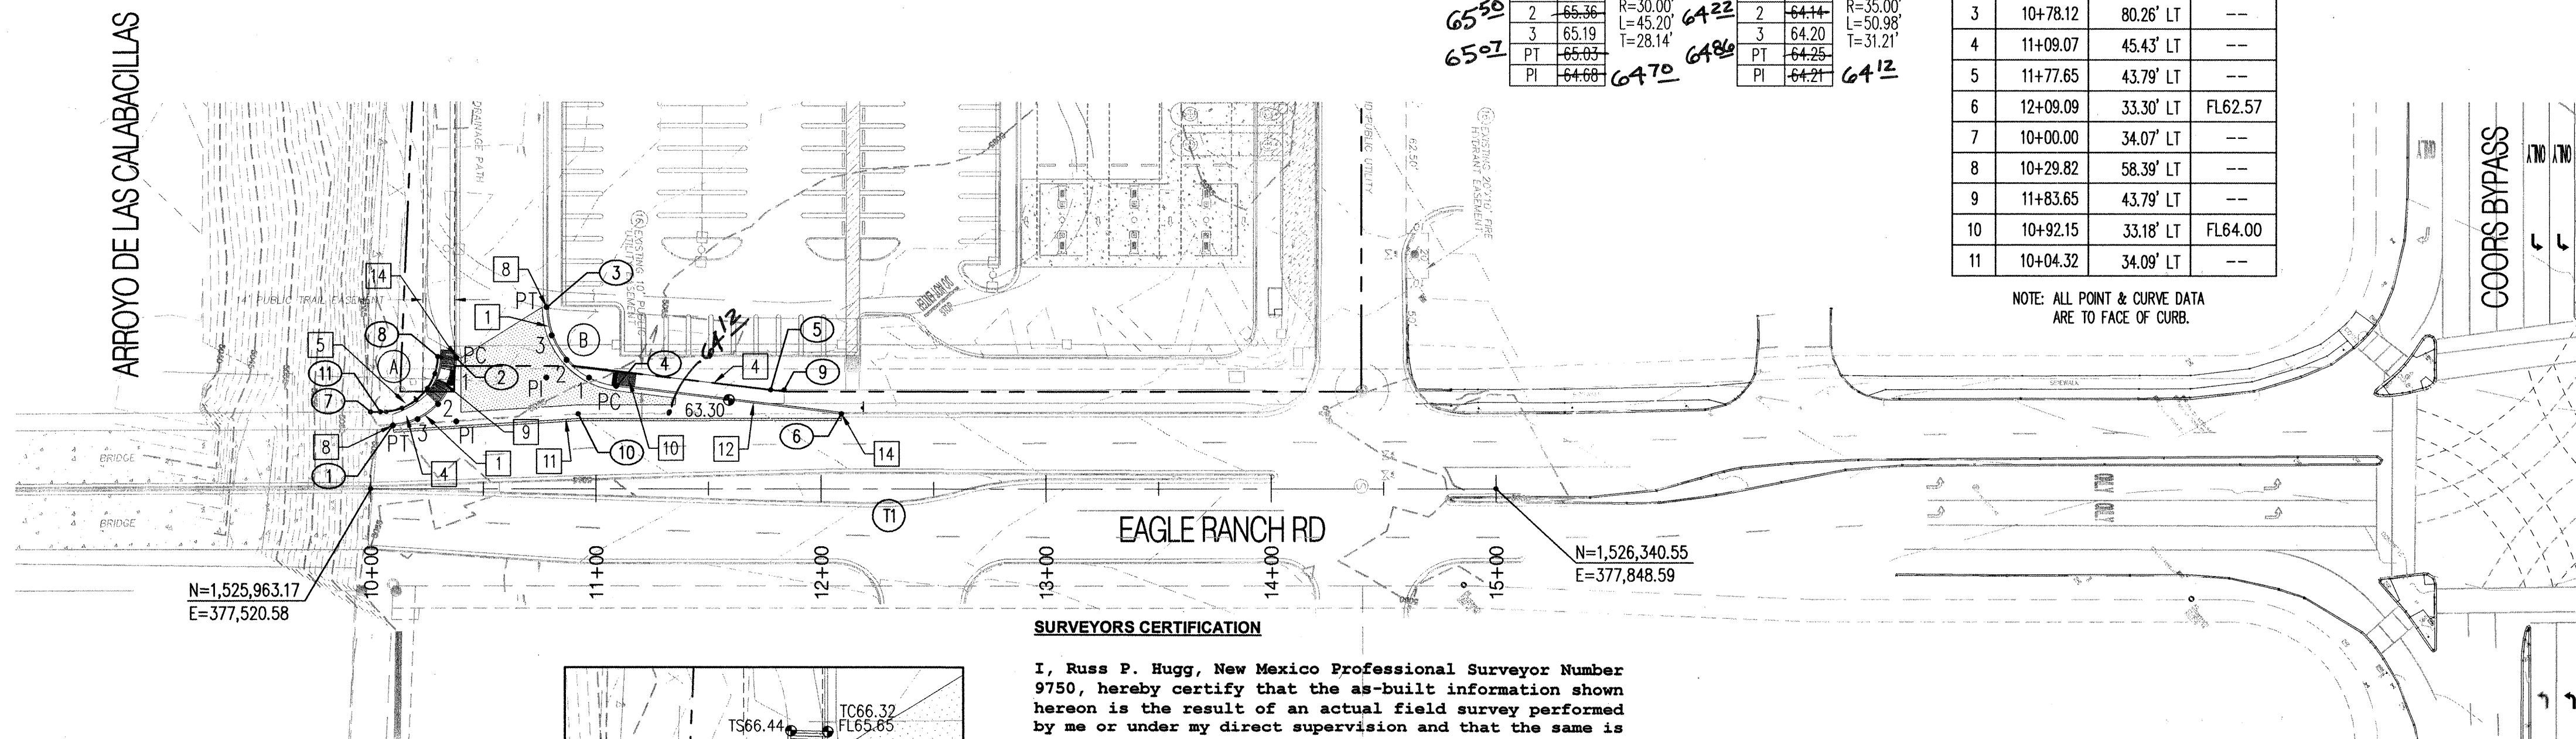

SURVEYORS CERTIFICATION

I, Russ P. Hugg, New Mexico Professional Surveyor Number 9750, hereby certify that the as-built information shown hereon is the result of an actual field survey performed by me or under my direct supervision and that the same is true and correct to the best of my knowledge and belief;

Russ P. Hugg
NMPS No. 9750
12.13, 2007

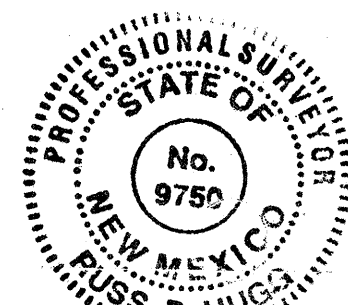

PAVING PLAN

NOTE: FLOWLINE ELEVATIONS SHOWN FOR CURB & GUTTER SHALL BE FIELD VERIFIED AGAINST EXISTING CROSS SLOPES & TYPICAL SECTIONS PROVIDED. ANY DISCREPANCIES SHALL BE BROUGHT TO THE IMMEDIATE ATTENTION OF THE ENGINEER.

Point Table			
STATION	OFFSET	ELEVATION	
1	10+09.95	28.07' LT	---
2	10+38.08	57.97' LT	---
3	10+78.12	80.26' LT	---
4	11+09.07	45.43' LT	---
5	11+77.65	43.79' LT	---
6	12+09.09	33.30' LT	FL62.57
7	10+00.00	34.07' LT	---
8	10+29.82	58.39' LT	---
9	11+83.65	43.79' LT	---
10	10+92.15	33.18' LT	FL64.00
11	10+04.32	34.09' LT	---

NOTE: ALL POINT & CURVE DATA ARE TO FACE OF CURB.

Centerline Tangent Table		
ID	BEARING	LENGTH
T1	N40°59'46"E	500.00'

DEMOLITION KEYED NOTES

1. REMOVE & DISPOSE OF EXISTING CURB & GUTTER.
2. REMOVE & DISPOSE 1' STRIP OF EXISTING ASPHALT PAVEMENT. SAW-CUT TO A STRAIGHT CLEAN EDGE.
3. REMOVE & DISPOSE OF EXISTING CONCRETE MEDIAN PAVEMENT.
4. REMOVE & DISPOSE OF EXISTING CONCRETE SIDEWALK.
5. OBLITERATE EXISTING PAVEMENT MARKING BY WATER BLASTING.
6. EXISTING CURB & GUTTER TO REMAIN.
7. EXISTING SIDEWALK TO REMAIN.
8. EXISTING PAVEMENT MARKING TO REMAIN.
9. EXISTING STORM INLET TO REMAIN.
10. EXISTING LIGHT POLE TO REMAIN.
11. EXISTING MEDIAN PAVEMENT TO REMAIN.
12. RELOCATE EXISTING SIGN TO NEW MEDIAN.
13. REMOVE & DISPOSE OF EXISTING TREES & SHRUBS. IRRIGATION SYSTEM FOR MEDIAN LANDSCAPING TO REMAIN IN SERVICE.
14. RELOCATE EXISTING SPEED LIMIT SIGN TO STA. 12+18.00.
15. REMOVE & DISPOSE OF EXISTING GUARD RAIL. END TREATMENT TO BE REUSED ON NEW GUARD RAIL.
16. REMOVE & DISPOSE OF EXISTING ASPHALT CURB.
17. EXISTING ASPHALT CURB TO REMAIN.
18. REMOVE & DISPOSE OF EXISTING PULL BOX, SEE SHEET 20.
19. REMOVE & DISPOSE OF EXISTING INTERSECTION LANE CONTROL SIGN. RELOCATE EXISTING HOSPITAL SIGN TO NEW INTERSECTION LANE CONTROL SIGN POST AT STA. 14+90.00.
20. RELOCATE EXISTING TRAFFIC SIGNAL PULL BOX BEHIND BACK OF PROPOSED CURB & ADJUST CONDUIT AS NECESSARY.
21. REMOVE & STOCKPILE EXISTING LANDSCAPE MATERIAL IN MEDIAN. CONTRACTOR TO COORDINATE WITH CITY OF ALBUQUERQUE REGARDING PLACEMENT OF EXISTING LANDSCAPE MATERIAL WITHIN NEW MEDIAN.
22. EXISTING SIGN TO REMAIN.
23. EXISTING "448 SOUTH" SIGN TO REMAIN. REPLACE EXISTING STRAIGHT ARROW WITH LEFT POINTING ARROW. SEE SHEET 16.
24. REMOVE AND DISPOSE OF EXISTING RIO RANCHO SIGN. BIKE ROUTE SIGN AND ARROW TO REMAIN.
25. EXISTING TREE TO REMAIN.


PAVING KEYED NOTES

1. CONSTRUCT STANDARD CURB & GUTTER PER COA STD DWG 2415-A.
2. CONSTRUCT MEDIAN CURB & GUTTER PER COA STD DWG 2415-B.
3. INSTALL CONCRETE MEDIAN PAVEMENT PER COA STD DWG 2408 & 2502 (NOTES 3 & 4).
4. CONSTRUCT 6" WIDE CONCRETE SIDEWALK PER COA STD DWG 2430.
5. INSTALL GUARD RAIL PER NEW MEXICO DEPARTMENT OF TRANSPORTATION STANDARD DRAWINGS, (R-25). SEE SHEETS 18A-18C. INSTALL TYPE 'B' END ANCHORAGE PER DETAIL ON SHEET 18C.
6. ADJUST EXISTING MANHOLE FRAME & COVER TO FINISHED GRADE.
7. ADJUST EXISTING WATER VALVE BOX TO FINISHED GRADE.
8. BEGIN CONSTRUCTION OF CURB & GUTTER. MATCH EXISTING CURB HORIZONTALLY & VERTICALLY.
9. CONSTRUCT CURB RAMP WITH DETECTABLE WARNING SURFACE PER DETAIL 1/18.
10. CONSTRUCT CURB RAMP WITH DETECTABLE WARNING SURFACE PER DETAIL 2/18.
11. CONSTRUCT 6" WIDE CONCRETE VALLEY GUTTER PER COA STD DWG 2420.
12. CONSTRUCT STANDARD CURB & GUTTER PER COA STD DWG 2415-A W/ DEPRESSED GUTTER.
13. CONSTRUCT MEDIAN CURB & GUTTER W/ DEPRESSED GUTTER PER DETAIL ON SHEET 18.
14. END CONSTRUCTION OF CURB & GUTTER. MATCH EXISTING CURB HORIZONTALLY & VERTICALLY.
15. RELOCATED TRAFFIC SIGNAL PULL BOX.

HATCHING LEGEND

- PROPOSED ASPHALT PAVEMENT. SEE SHEET 18 FOR TYPICAL ROAD & PAVEMENT SECTIONS
- ASPHALT PAVEMENT REMOVAL
- CONCRETE MEDIAN PAVEMENT PER COA STD DWG 2408 & 2502

Bohannon & Huston
 Courtyard I 7500 Jefferson St. NE Albuquerque, NM 87109-4335
 ENGINEERING & SPATIAL DATA & ADVANCED TECHNOLOGIES

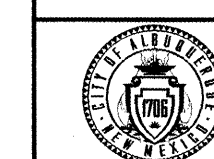


CITY OF ALBUQUERQUE
 DEPARTMENT OF
 MUNICIPAL DEVELOPMENT

COSTCO PUBLIC INFRASTRUCTURE
 EAGLE RANCH RD DEMOLITION & PAVING PLAN



DESIGN REVIEW COMMITTEE	CITY ENGINEER APPROVAL	MO. DAY/YR.	MO. DAY/YR.
SEP 25 2007	SEP 25 2007		
DESIGN REVIEW COMMITTEE	DESIGN REVIEW COMMITTEE	LAST DESIGN UPDATE	

CITY PROJECT NO.	ZONE MAP NO.	SHEET	OF
729082	B-13, B-14, C-13, D-13	6	22

NOTE: CONTRACTOR SHALL COORDINATE ALL DEMOLITION WORK WITH THE PAVING PLANS TO DETERMINE EXACT LIMITS OF REMOVAL.

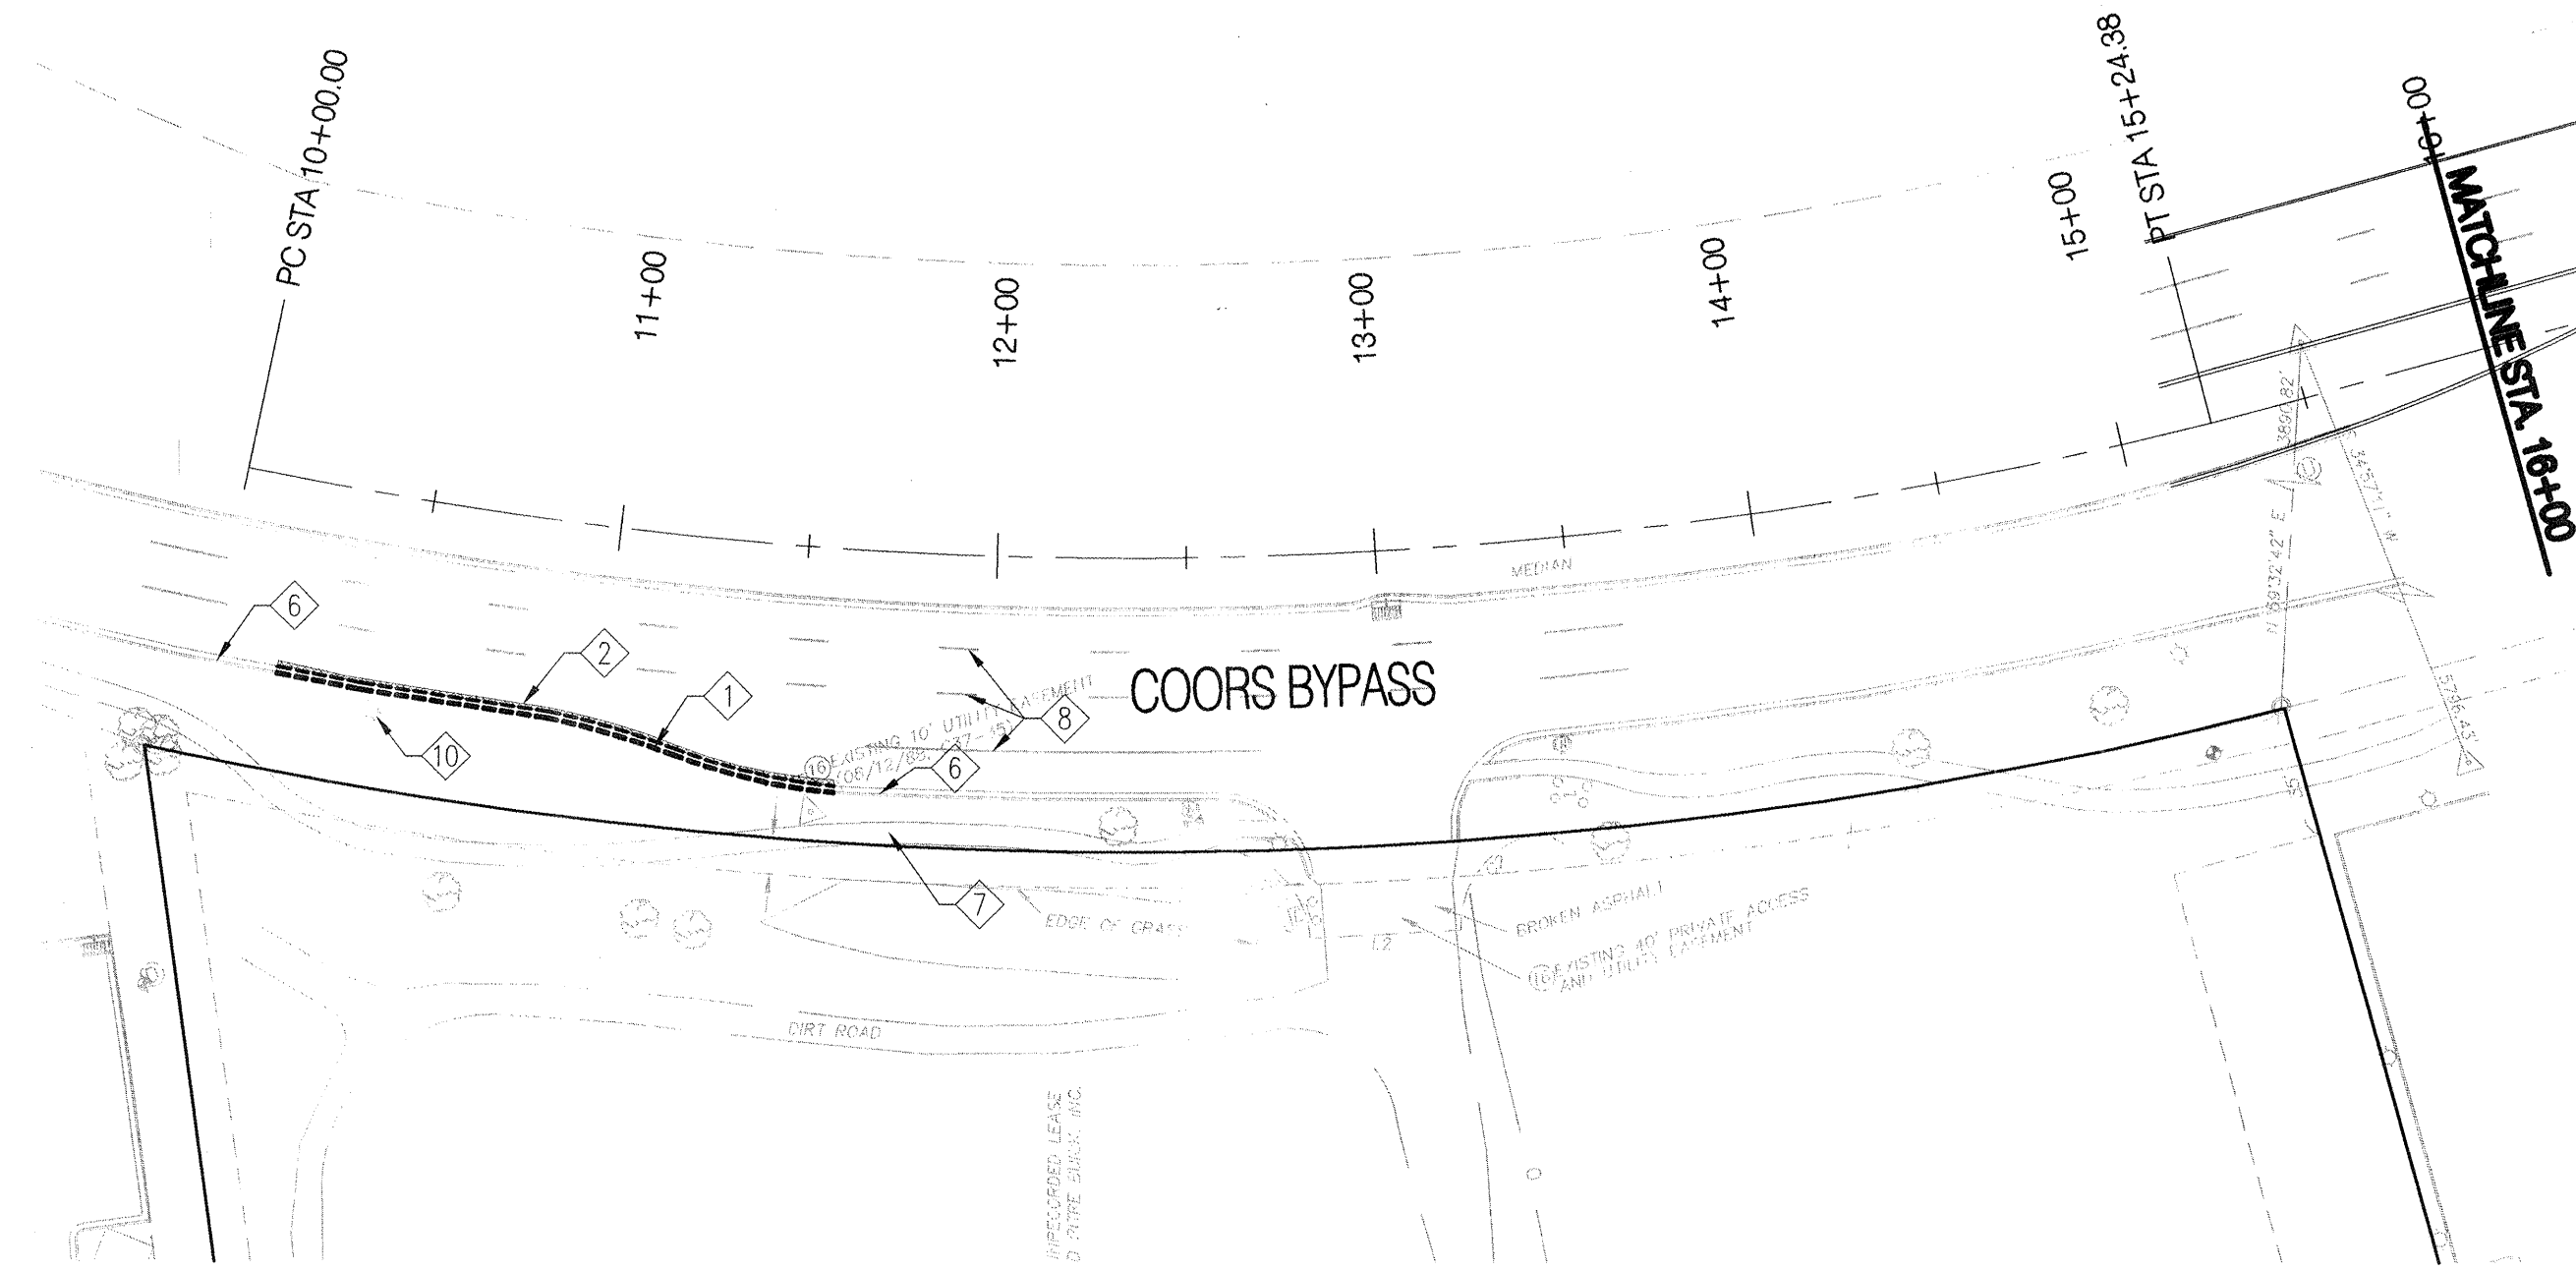

DEMOLITION PLAN

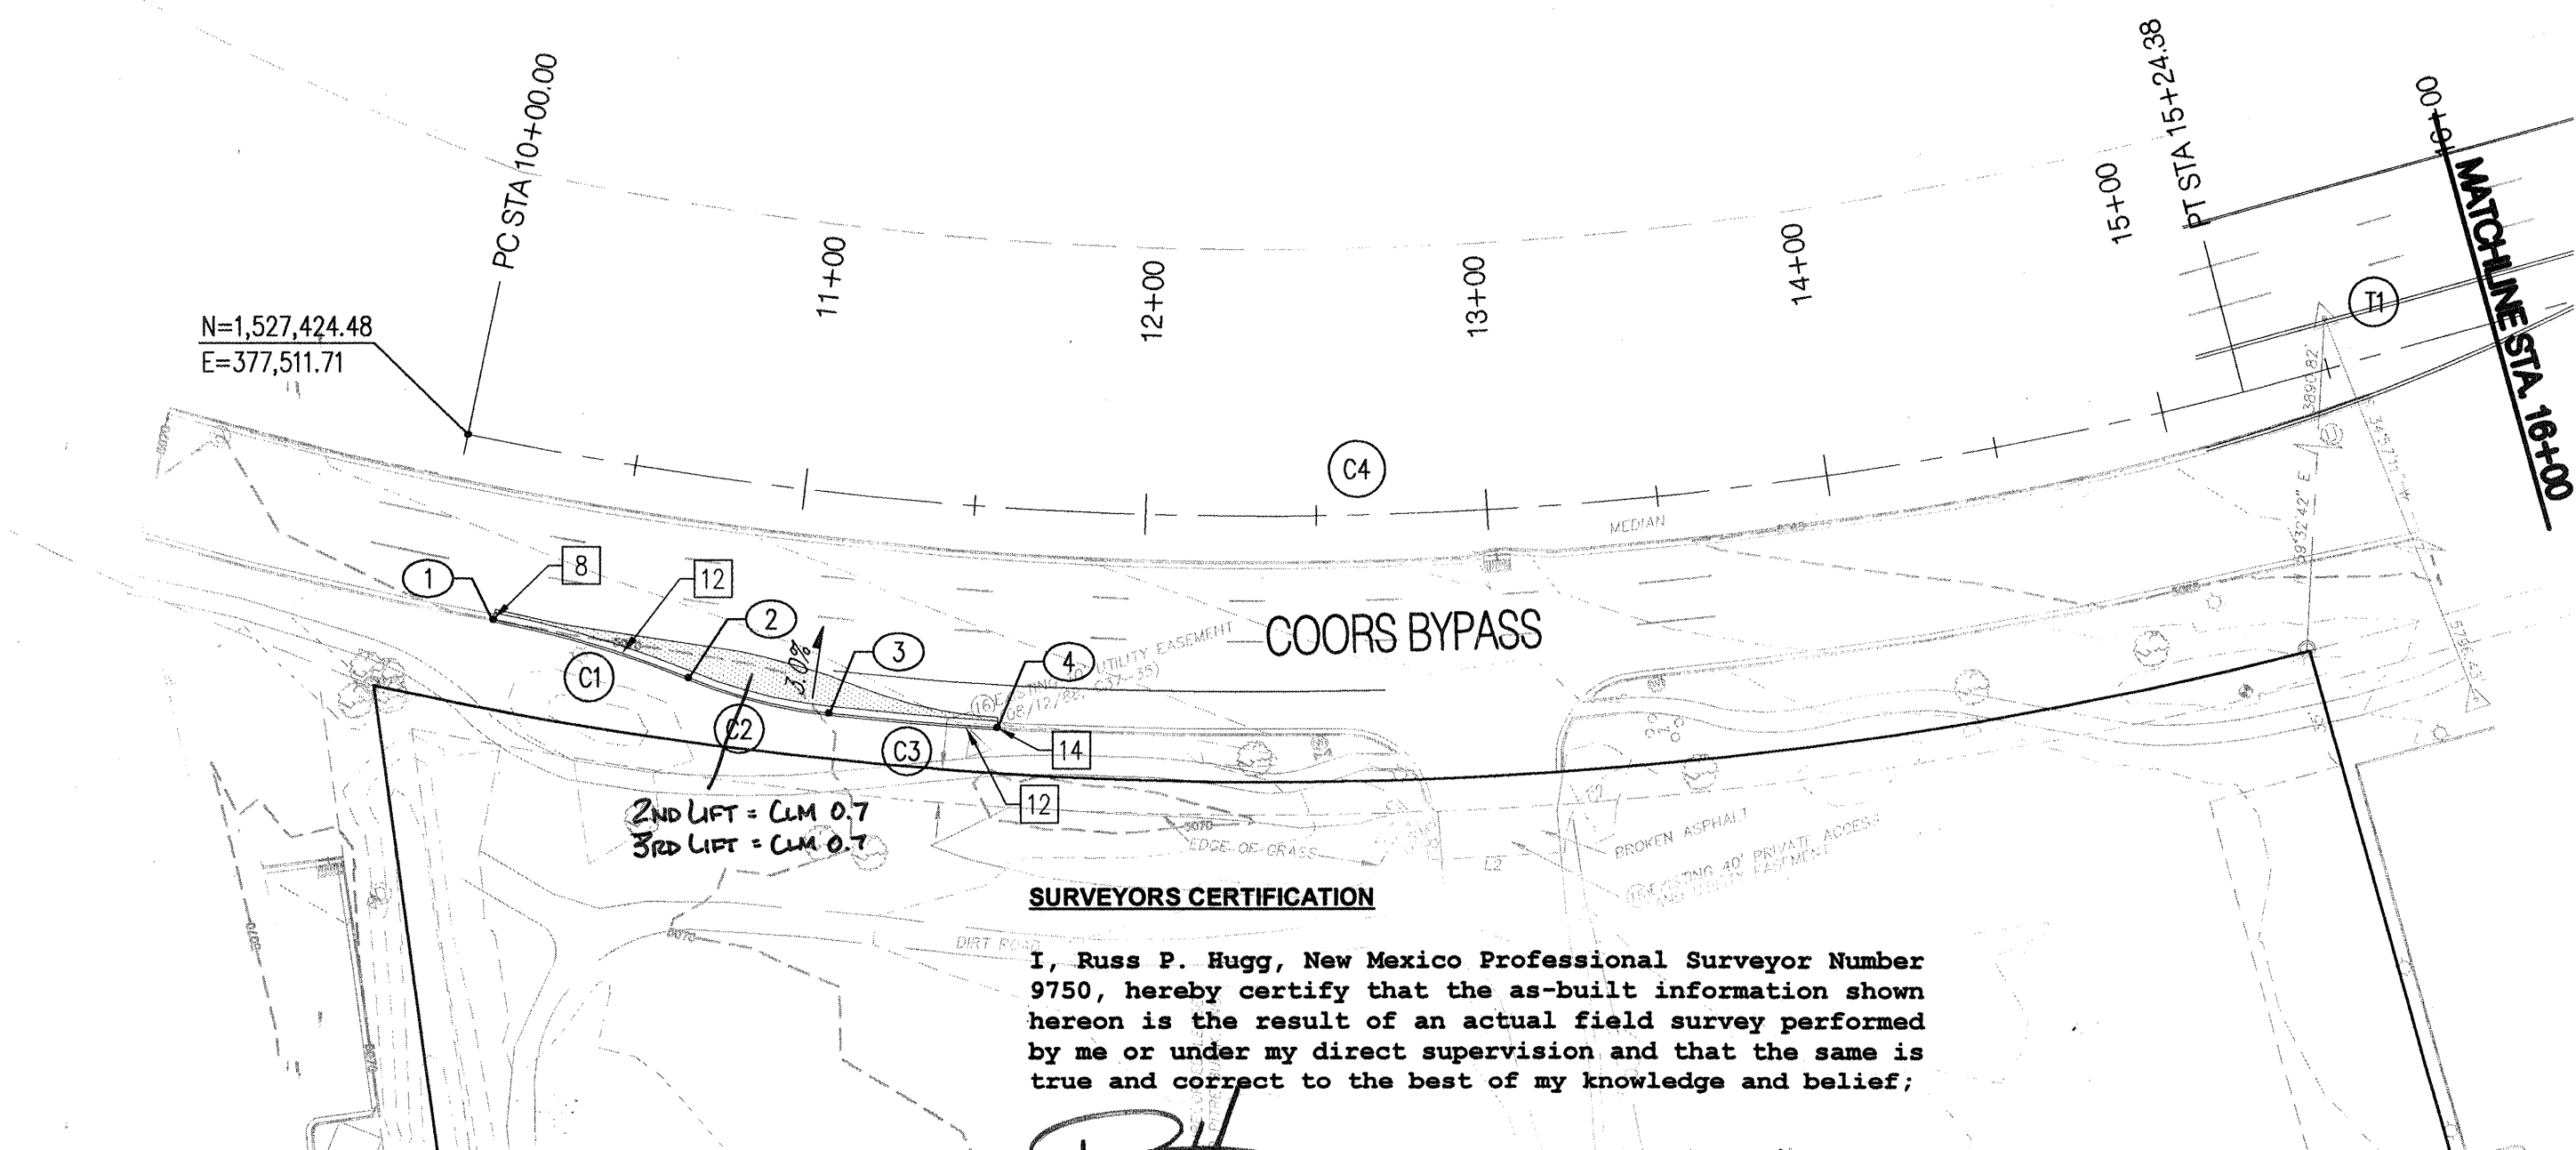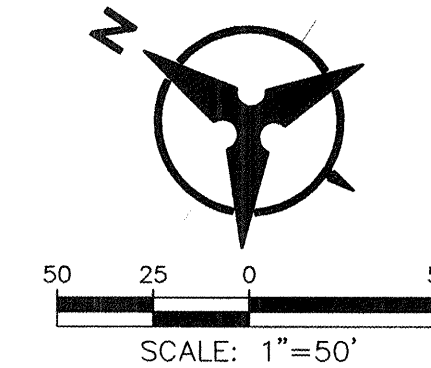

SURVEYORS CERTIFICATION


I, Russ P. Hugg, New Mexico Professional Surveyor Number 9750, hereby certify that the as-built information shown hereon is the result of an actual field survey performed by me or under my direct supervision and that the same is true and correct to the best of my knowledge and belief;

[Signature]
Russ P. Hugg
NMPS No. 9750
12-13, 2007



PAVING PLAN

NOTE: FLOWLINE ELEVATIONS SHOWN FOR CURB & GUTTER SHALL BE FIELD VERIFIED AGAINST EXISTING CROSS SLOPES & TYPICAL SECTIONS PROVIDED. ANY DISCREPANCIES SHALL BE BROUGHT TO THE IMMEDIATE ATTENTION OF THE ENGINEER.

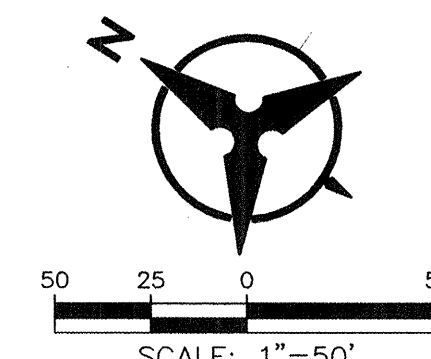

Centerline Tangent Table		
ID	BEARING	LENGTH
T1	S48°58'30"E	639.70'

Centerline Curve Table				
ID	RADIUS	ARC	DELTA	TANGENT
C4	1146.00'	524.38'	26°13'01"	266.86'

Point Table		
STATION	OFFSET	ELEVATION
1 10+17.50	52.01' RT	FL69.91
2 10+73.97	59.45' RT	FL69.71
3 11+13.88	64.73' RT	FL69.50
4 11+60.72	64.64' RT	FL68.86

Curve Table				
ID	RADIUS	ARC	DELTA	TANGENT
C1	300.00'	59.77'	11°24'53"	29.98'
C2	150.00'	42.55'	16°15'09"	21.42'
C3	1100.96'	49.48'	02°34'30"	24.74'

NOTE: ALL POINT & CURVE DATA ARE TO FACE OF CURB.

NOTE: NOT ALL KEYED NOTES MAY APPLY TO THIS SHEET.

DEMOLITION KEYED NOTES

- REMOVE & DISPOSE OF EXISTING CURB & GUTTER.
- REMOVE & DISPOSE 1' STRIP OF EXISTING ASPHALT PAVEMENT. SAW-CUT TO A STRAIGHT CLEAN EDGE.
- REMOVE & DISPOSE OF EXISTING CONCRETE MEDIAN PAVEMENT.
- REMOVE & DISPOSE OF EXISTING CONCRETE SIDEWALK.
- OBTERATE EXISTING PAVEMENT MARKING BY WATER BLASTING.
- EXISTING CURB & GUTTER TO REMAIN.
- EXISTING SIDEWALK TO REMAIN.
- EXISTING PAVEMENT MARKING TO REMAIN.
- EXISTING STORM INLET TO REMAIN.
- EXISTING LIGHT POLE TO REMAIN.
- EXISTING MEDIAN PAVEMENT TO REMAIN.
- RELOCATE EXISTING SIGN TO NEW MEDIAN.
- REMOVE & DISPOSE OF EXISTING TREES & SHRUBS. IRRIGATION SYSTEM FOR MEDIAN LANDSCAPING TO REMAIN IN SERVICE.
- RELOCATE EXISTING SPEED LIMIT SIGN TO STA. 12+18.00.
- REMOVE & DISPOSE OF EXISTING GUARD RAIL. END TREATMENT TO BE REUSED ON NEW GUARD RAIL.
- REMOVE & DISPOSE OF EXISTING ASPHALT CURB.
- EXISTING ASPHALT CURB TO REMAIN.
- REMOVE & DISPOSE OF EXISTING PULL BOX, SEE SHEET 20.
- REMOVE & DISPOSE OF EXISTING INTERSECTION LANE CONTROL SIGN. RELOCATE EXISTING HOSPITAL SIGN TO NEW INTERSECTION LANE CONTROL SIGN POST AT STA. 14+90.00.
- RELOCATE EXISTING TRAFFIC SIGNAL PULL BOX BEHIND BACK OF PROPOSED CURB & ADJUST CONDUIT AS NECESSARY.
- REMOVE & STOCKPILE EXISTING LANDSCAPE MATERIAL IN MEDIAN. CONTRACTOR TO COORDINATE WITH CITY OF ALBUQUERQUE REGARDING PLACEMENT OF EXISTING LANDSCAPE MATERIAL WITHIN NEW MEDIAN.
- EXISTING SIGN TO REMAIN.
- EXISTING "448 SOUTH" SIGN TO REMAIN. REPLACE EXISTING STRAIGHT ARROW WITH LEFT POINTING ARROW. SEE SHEET 16.
- REMOVE AND DISPOSE OF EXISTING RIO RANCHO SIGN. BIKE ROUTE SIGN AND ARROW TO REMAIN.
- EXISTING TREE TO REMAIN.


PAVING KEYED NOTES

- CONSTRUCT STANDARD CURB & GUTTER PER COA STD DWG 2415-A.
- CONSTRUCT MEDIAN CURB & GUTTER PER COA STD DWG 2415-B.
- INSTALL CONCRETE MEDIAN PAVEMENT PER COA STD DWG 2408 & 2502 (NOTES 3 & 4).
- CONSTRUCT 6' WIDE CONCRETE SIDEWALK PER COA STD DWG 2430.
- INSTALL GUARD RAIL PER NEW MEXICO DEPARTMENT OF TRANSPORTATION STANDARD DRAWINGS, (R=25'). SEE SHEETS 18A-18C. INSTALL TYPE 'B' END ANCHORAGE PER DETAIL ON SHEET 18C.
- ADJUST EXISTING MANHOLE FRAME & COVER TO FINISHED GRADE.
- ADJUST EXISTING WATER VALVE BOX TO FINISHED GRADE.
- BEGIN CONSTRUCTION OF CURB & GUTTER. MATCH EXISTING CURB HORIZONTALLY & VERTICALLY.
- CONSTRUCT CURB RAMP WITH DETECTABLE WARNING SURFACE PER DETAIL 1/18.
- CONSTRUCT CURB RAMP WITH DETECTABLE WARNING SURFACE PER DETAIL 2/18.
- CONSTRUCT 6' WIDE CONCRETE VALLEY GUTTER PER COA STD DWG 2420.
- CONSTRUCT STANDARD CURB & GUTTER PER COA STD DWG 2415-A W/ DEPRESSED GUTTER.
- CONSTRUCT MEDIAN CURB & GUTTER W/ DEPRESSED GUTTER PER DETAIL ON SHEET 18.
- END CONSTRUCTION OF CURB & GUTTER. MATCH EXISTING CURB HORIZONTALLY & VERTICALLY.
- RELOCATED TRAFFIC SIGNAL PULL BOX.

HATCHING LEGEND

- PROPOSED ASPHALT PAVEMENT, SEE SHEET 18 FOR TYPICAL ROAD & PAVEMENT SECTIONS
- ASPHALT PAVEMENT REMOVAL
- CONCRETE MEDIAN PAVEMENT PER COA STD DWG 2408 & 2502

Bohannon & Huston
Court yard | 7500 Jefferson St. NE Albuquerque, NM 87109-4395
ENGINEERING • SPATIAL DATA • ADVANCED TECHNOLOGIES

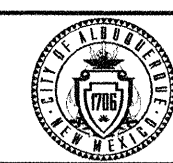


CITY OF ALBUQUERQUE
DEPARTMENT OF MUNICIPAL DEVELOPMENT


COSTCO PUBLIC INFRASTRUCTURE
COORS BYPASS DEMOLITION & PAVING PLAN

DESIGN REVIEW COMMITTEE	CITY ENGINEER APPROVAL	MO./DAY/YR.	MO./DAY/YR.
APPROVED	APPROVED		
DESIGN REVIEW COMMITTEE	DESIGN REVIEW COMMITTEE		

CITY PROJECT NO.	ZONE MAP NO.	SHEET	OF
729082	B-13, B-14, C-13, D-13	7	22

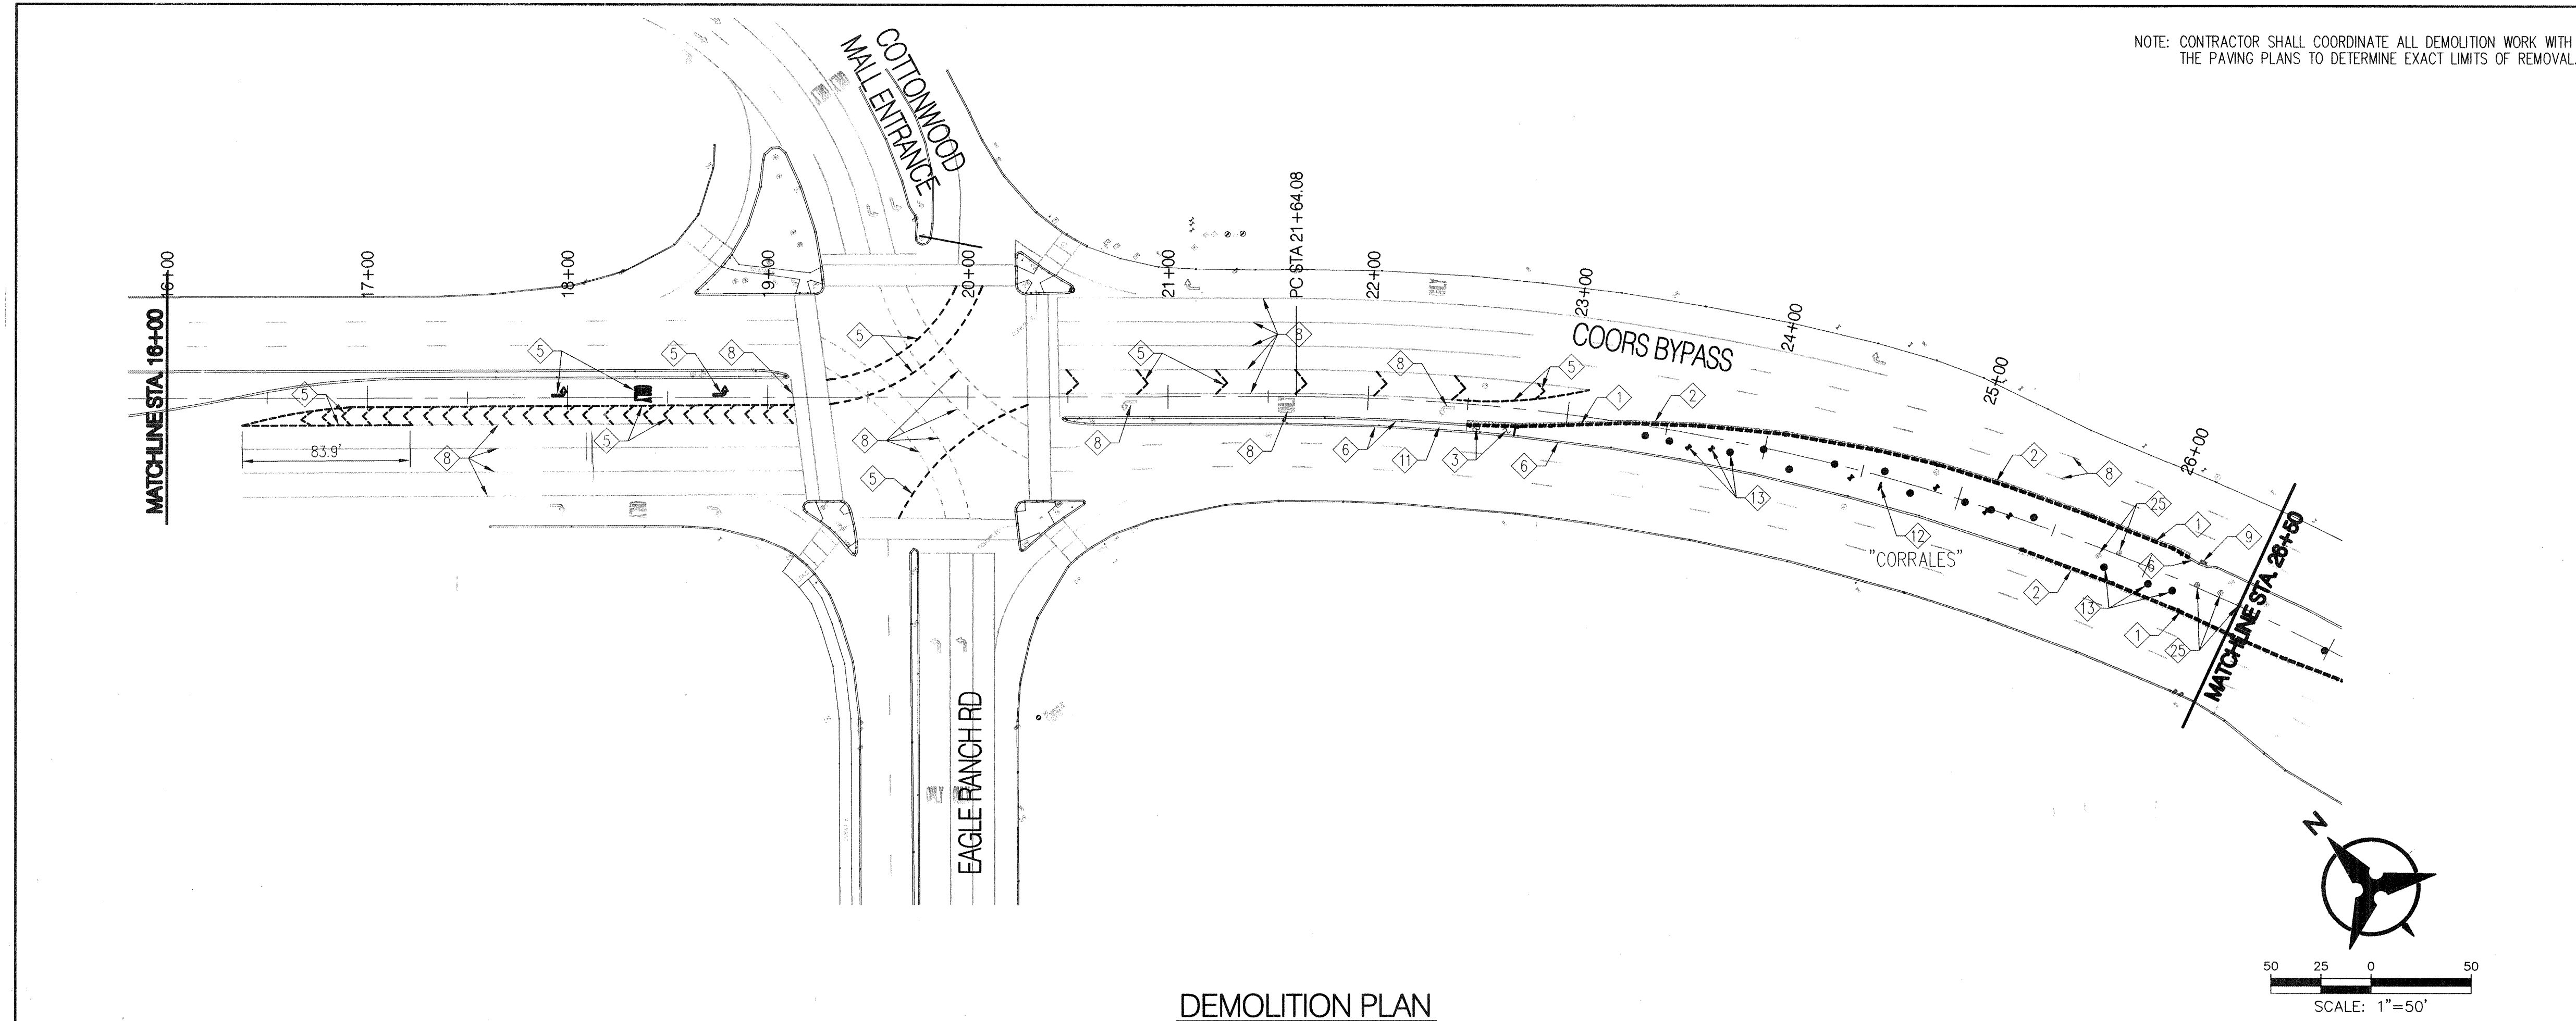

DEMOLITION PLAN

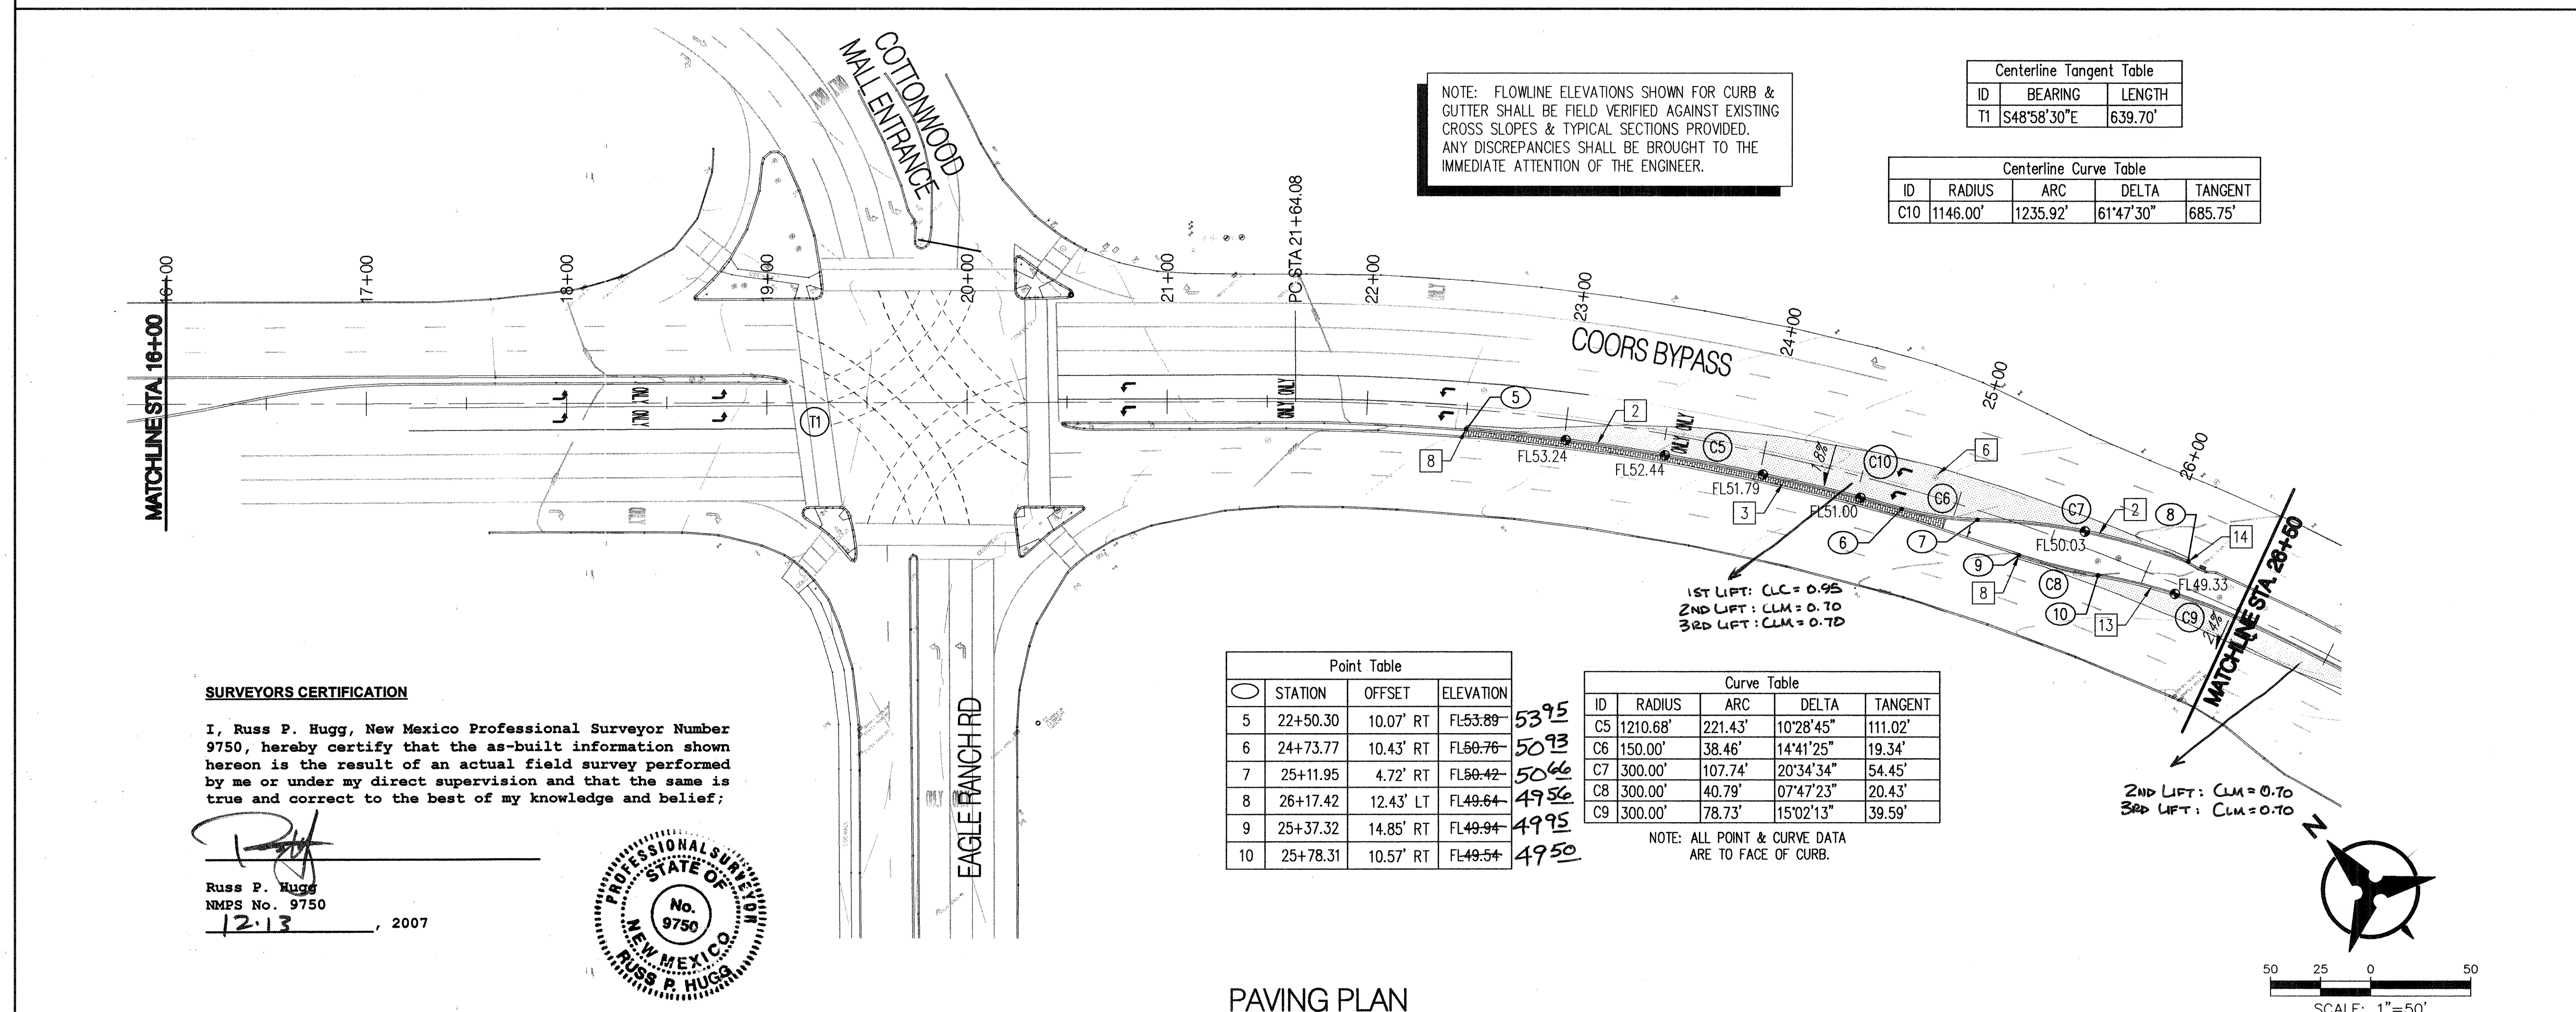

PAVING PLAN

NOTE: NOT ALL KEYED NOTES MAY APPLY TO THIS SHEET.

DEMOLITION KEYED NOTES

- REMOVE & DISPOSE OF EXISTING CURB & GUTTER.
- REMOVE & DISPOSE OF 1' STRIP OF EXISTING ASPHALT PAVEMENT. SAW-CUT TO A STRAIGHT CLEAN EDGE.
- REMOVE & DISPOSE OF EXISTING CONCRETE MEDIAN PAVEMENT.
- REMOVE & DISPOSE OF EXISTING CONCRETE SIDEWALK.
- OBTERATE EXISTING PAVEMENT MARKING BY WATER BLASTING.
- EXISTING CURB & GUTTER TO REMAIN.
- EXISTING SIDEWALK TO REMAIN.
- EXISTING PAVEMENT MARKING TO REMAIN.
- EXISTING STORM INLET TO REMAIN.
- EXISTING LIGHT POLE TO REMAIN.
- EXISTING MEDIAN PAVEMENT TO REMAIN.
- RELOCATE EXISTING SIGN TO NEW MEDIAN.
- REMOVE & DISPOSE OF EXISTING TREES & SHRUBS. IRRIGATION SYSTEM FOR MEDIAN LANDSCAPING TO REMAIN IN SERVICE.
- RELOCATE EXISTING SPEED LIMIT SIGN TO STA. 12+18.00.
- REMOVE & DISPOSE OF EXISTING GUARD RAIL. END TREATMENT TO BE REUSED ON NEW GUARD RAIL.
- REMOVE & DISPOSE OF EXISTING ASPHALT CURB.
- EXISTING ASPHALT CURB TO REMAIN.
- REMOVE & DISPOSE OF EXISTING PULL BOX. SEE SHEET 20.
- REMOVE & DISPOSE OF EXISTING INTERSECTION LANE CONTROL SIGN. RELOCATE EXISTING HOSPITAL SIGN TO NEW INTERSECTION LANE CONTROL SIGN POST AT STA. 14+90.00.
- RELOCATE EXISTING TRAFFIC SIGNAL PULL BOX BEHIND BACK OF PROPOSED CURB & ADJUST CONDUIT AS NECESSARY.
- REMOVE & STOCKPILE EXISTING LANDSCAPE MATERIAL IN MEDIAN. CONTRACTOR TO COORDINATE WITH CITY OF ALBUQUERQUE REGARDING PLACEMENT OF EXISTING LANDSCAPE MATERIAL WITHIN NEW MEDIAN.
- EXISTING SIGN TO REMAIN.
- EXISTING "448 SOUTH" SIGN TO REMAIN. REPLACE EXISTING STRAIGHT ARROW WITH LEFT POINTING ARROW. SEE SHEET 16.
- REMOVE AND DISPOSE OF EXISTING RIO RANCHO SIGN. BIKE ROUTE SIGN AND ARROW TO REMAIN.
- EXISTING TREE TO REMAIN.

PAVING KEYED NOTES

- CONSTRUCT STANDARD CURB & GUTTER PER COA STD DWG 2415-A.
- CONSTRUCT MEDIAN CURB & GUTTER PER COA STD DWG 2415-B.
- INSTALL CONCRETE MEDIAN PAVEMENT PER COA STD DWG 2408 & 2502 (NOTES 3 & 4). TO MATCH EXISTING PATTERN & COLOR.
- CONSTRUCT 6' WIDE CONCRETE SIDEWALK PER COA STD DWG 2430.
- INSTALL GUARD RAIL PER NEW MEXICO DEPARTMENT OF TRANSPORTATION STANDARD DRAWINGS. (R=25'). SEE SHEETS 18A-18C. INSTALL TYPE 'B' END ANCHORAGE PER DETAIL ON SHEET 18C.
- ADJUST EXISTING MANHOLE FRAME & COVER TO FINISHED GRADE.
- ADJUST EXISTING WATER VALVE BOX TO FINISHED GRADE.
- BEGIN CONSTRUCTION OF CURB & GUTTER. MATCH EXISTING CURB HORIZONTALLY & VERTICALLY.
- CONSTRUCT CURB RAMP WITH DETECTABLE WARNING SURFACE PER DETAIL 1/18.
- CONSTRUCT CURB RAMP WITH DETECTABLE WARNING SURFACE PER DETAIL 2/18.
- CONSTRUCT 6' WIDE CONCRETE VALLEY GUTTER PER COA STD DWG 2420.
- CONSTRUCT STANDARD CURB & GUTTER PER COA STD DWG 2415-A W/ DEPRESSED GUTTER.
- CONSTRUCT MEDIAN CURB & GUTTER W/ DEPRESSED GUTTER PER DETAIL ON SHEET 18.
- END CONSTRUCTION OF CURB & GUTTER. MATCH EXISTING CURB HORIZONTALLY & VERTICALLY.
- RELOCATED TRAFFIC SIGNAL PULL BOX.

HATCHING LEGEND

- PROPOSED ASPHALT PAVEMENT. SEE SHEET 18 FOR TYPICAL ROAD & PAVEMENT SECTIONS
- ASPHALT PAVEMENT REMOVAL
- CONCRETE MEDIAN PAVEMENT PER COA STD DWG 2408 & 2502


Bohannon & Huston
Engineering & Spatial Data & Advanced Technologies
7500 Jefferson St. NE Albuquerque, NM 87109-4336

CITY OF ALBUQUERQUE
DEPARTMENT OF MUNICIPAL DEVELOPMENT
COSTCO PUBLIC INFRASTRUCTURE
COORS BYPASS DEMOLITION & PAVING PLAN


DESIGN REVIEW COMMITTEE	CITY ENGINEER APPROVAL	MO./DAY/YR.	MO./DAY/YR.
DESIGN REVIEW COMMITTEE	CITY ENGINEER APPROVAL		

CITY PROJECT NO. 729082 ZONE MAP NO. B-13, B-14, C-13, D-13 SHEET 8 OF 22


NOTE: CONTRACTOR SHALL COORDINATE ALL DEMOLITION WORK WITH THE PAVING PLANS TO DETERMINE EXACT LIMITS OF REMOVAL.

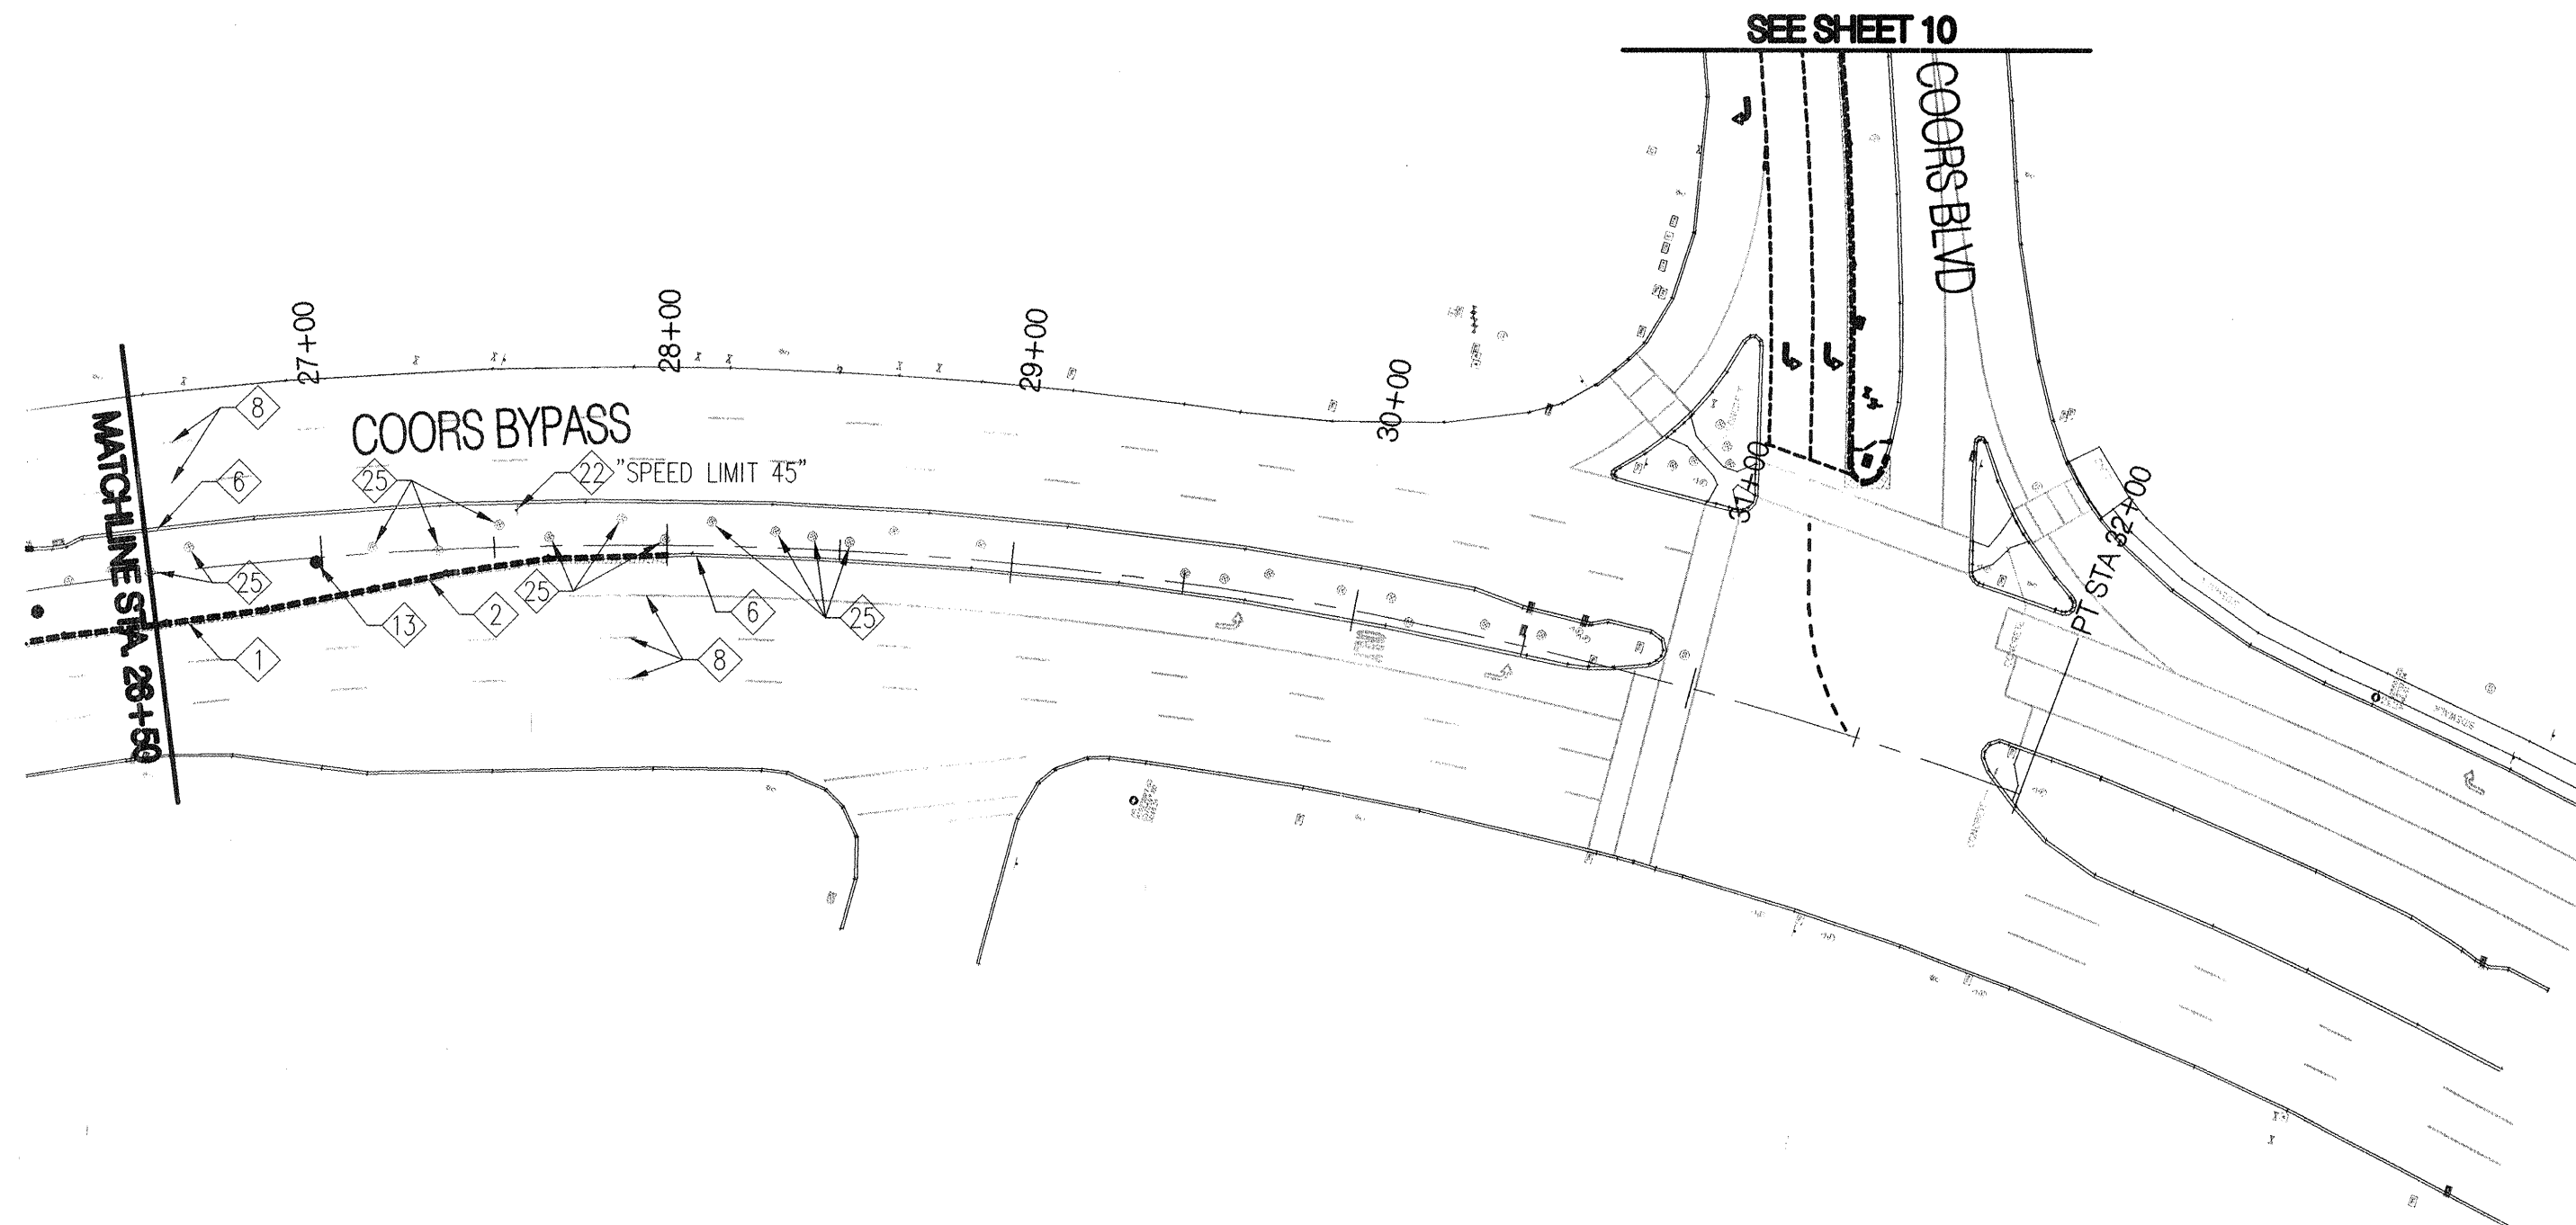

DEMOLITION PLAN

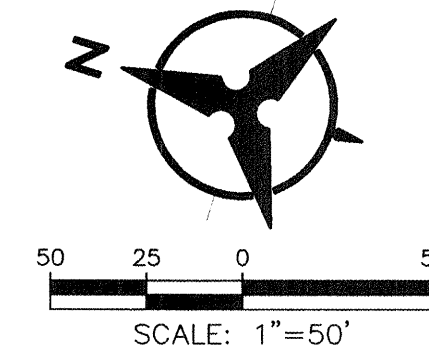

NOTE: FLOWLINE ELEVATIONS SHOWN FOR CURB & GUTTER SHALL BE FIELD VERIFIED AGAINST EXISTING CROSS SLOPES & TYPICAL SECTIONS PROVIDED. ANY DISCREPANCIES SHALL BE BROUGHT TO THE IMMEDIATE ATTENTION OF THE ENGINEER.

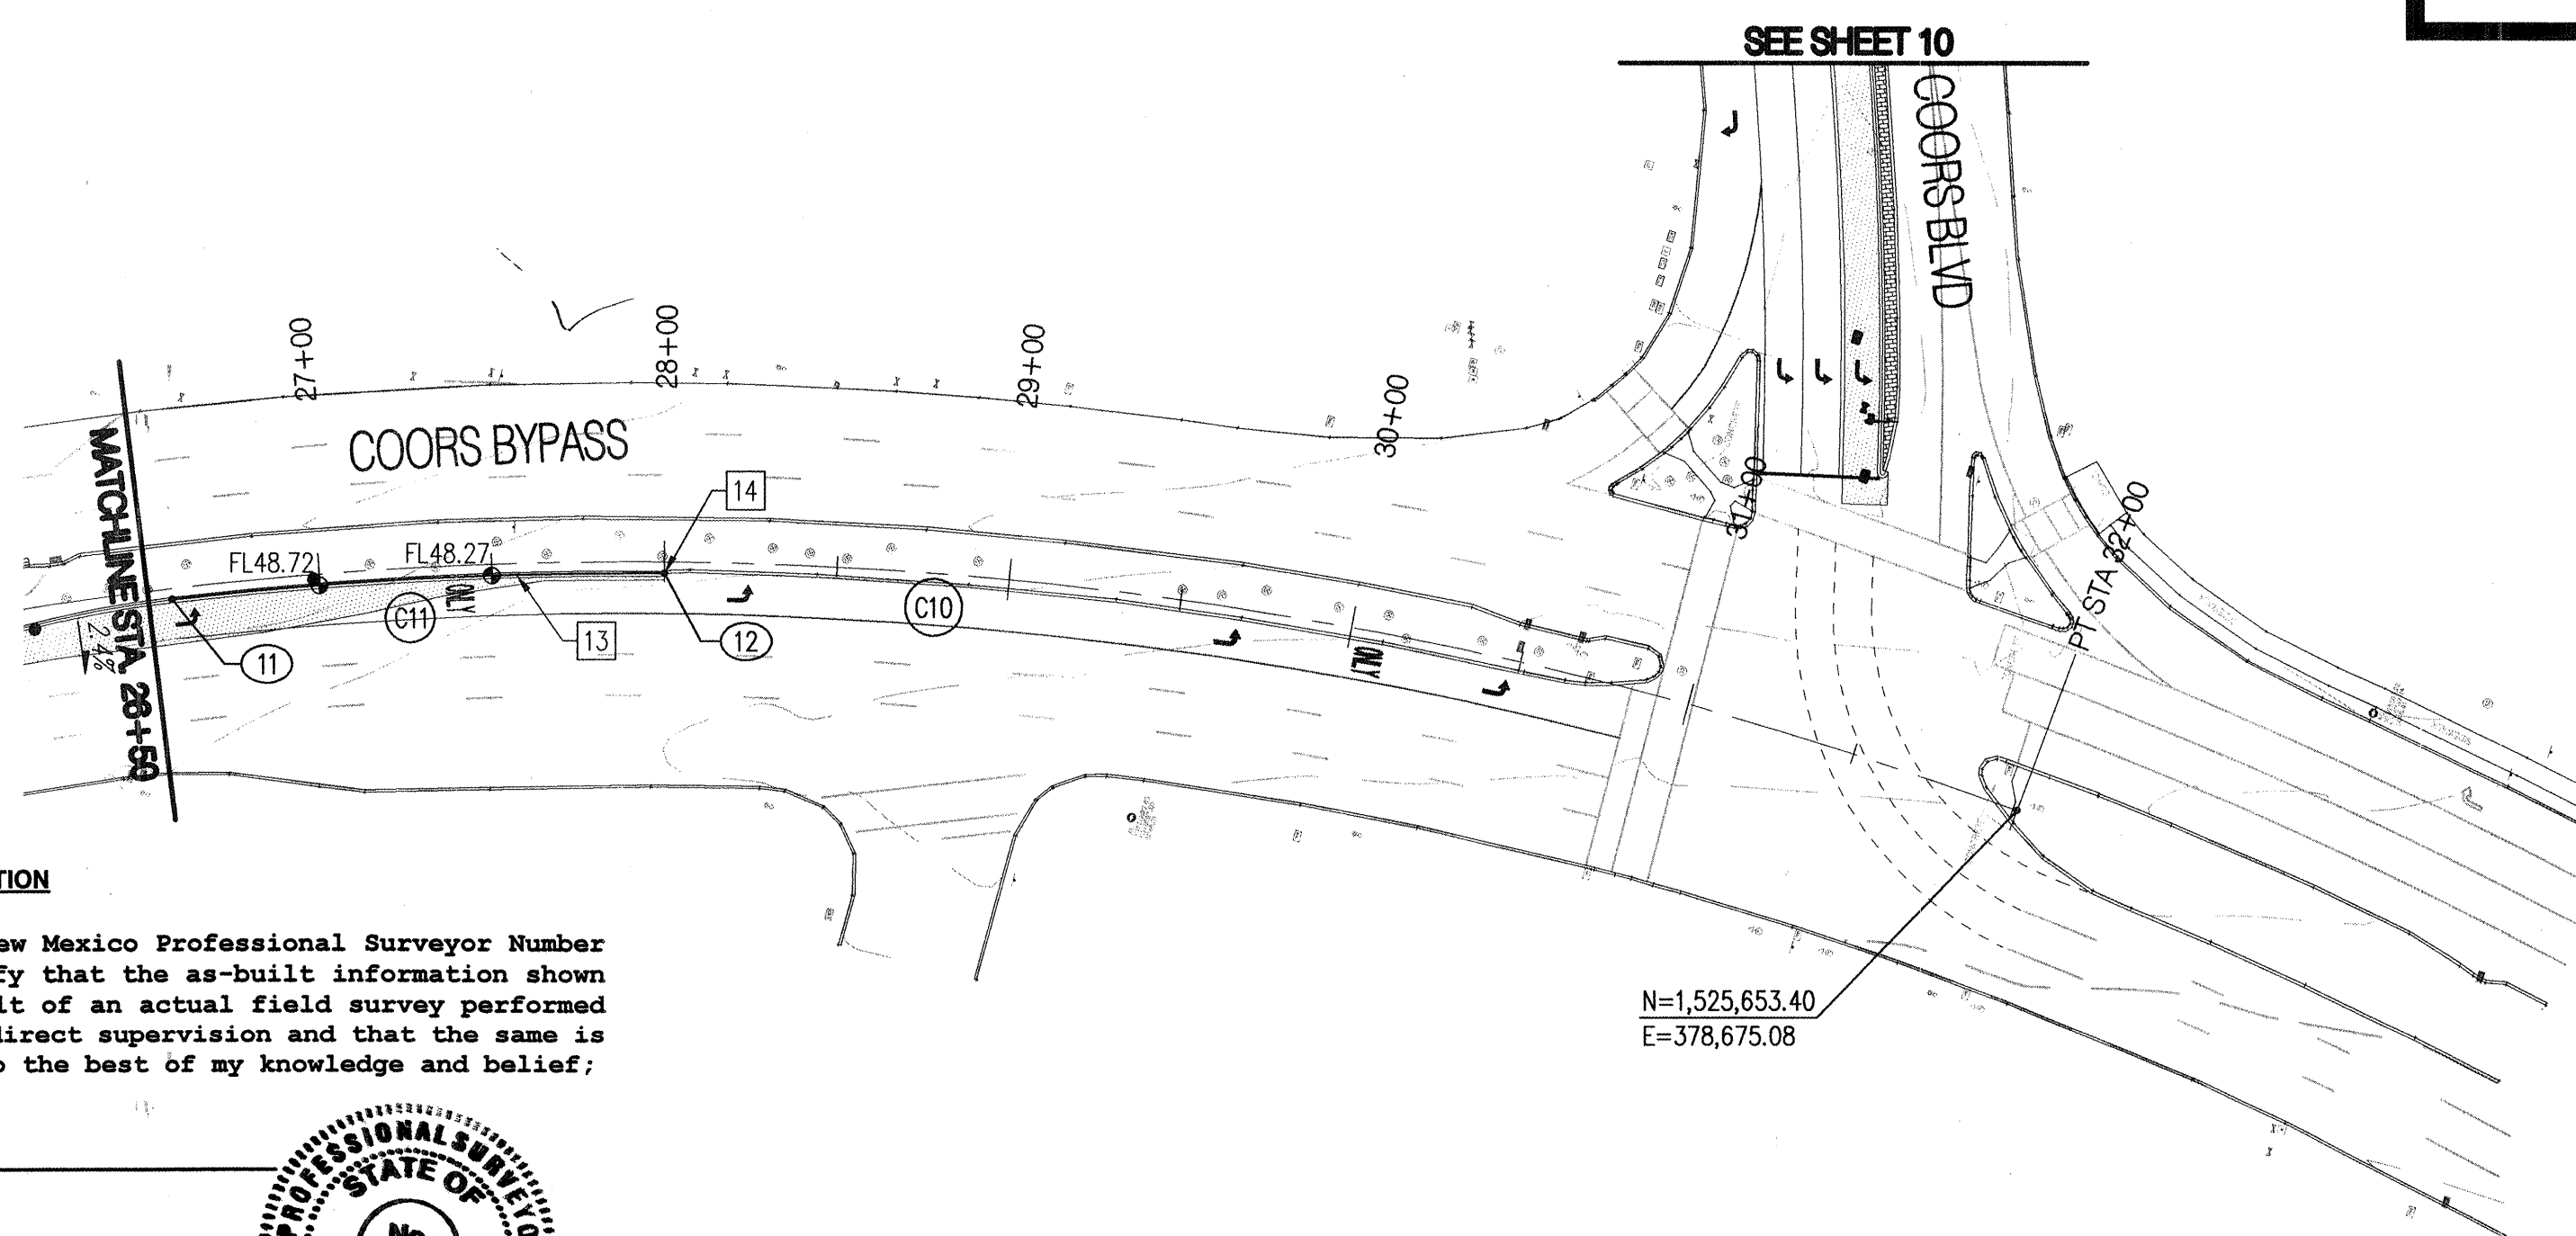


PAVING PLAN

SURVEYORS CERTIFICATION

I, Russ P. Hugg, New Mexico Professional Surveyor Number 9750, hereby certify that the as-built information shown hereon is the result of an actual field survey performed by me or under my direct supervision and that the same is true and correct to the best of my knowledge and belief;

[Signature]
Russ P. Hugg
NMPS No. 9750
12.13, 2007

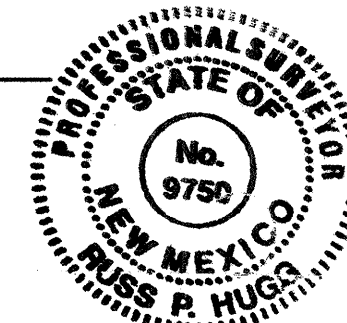


Centerline Curve Table				
ID	RADIUS	ARC	DELTA	TANGENT
C10	1146.00'	1235.92'	61°47'30"	685.75'

Point Table			
STATION	OFFSET	ELEVATION	
11	26+56.96	3.19' RT	FL49.04
12	28+00.04	3.43' RT	FL48.08

Curve Table				
ID	RADIUS	ARC	DELTA	TANGENT
C11	1163.25'	142.66'	07°01'36"	71.42'

NOTE: ALL POINT & CURVE DATA ARE TO FACE OF CURB.

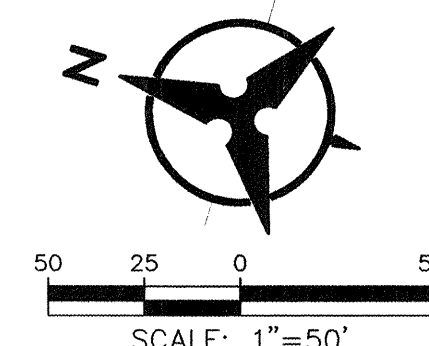

NOTE: NOT ALL KEYED NOTES MAY APPLY TO THIS SHEET.

DEMOLITION KEYED NOTES

1. REMOVE & DISPOSE OF EXISTING CURB & GUTTER.
2. REMOVE & DISPOSE 1" STRIP OF EXISTING ASPHALT PAVEMENT. SAW-CUT TO A STRAIGHT CLEAN EDGE.
3. REMOVE & DISPOSE OF EXISTING CONCRETE MEDIAN PAVEMENT.
4. REMOVE & DISPOSE OF EXISTING CONCRETE SIDEWALK.
5. OBLITERATE EXISTING PAVEMENT MARKING BY WATER BLASTING.
6. EXISTING CURB & GUTTER TO REMAIN.
7. EXISTING SIDEWALK TO REMAIN.
8. EXISTING PAVEMENT MARKING TO REMAIN.
9. EXISTING STORM INLET TO REMAIN.
10. EXISTING LIGHT POLE TO REMAIN.
11. EXISTING MEDIAN PAVEMENT TO REMAIN.
12. RELOCATE EXISTING SIGN TO NEW MEDIAN.
13. REMOVE & DISPOSE OF EXISTING TREES & SHRUBS. IRRIGATION SYSTEM FOR MEDIAN LANDSCAPING TO REMAIN IN SERVICE.
14. RELOCATE EXISTING SPEED LIMIT SIGN TO STA. 12+18.00.
15. REMOVE & DISPOSE OF EXISTING GUARD RAIL. END TREATMENT TO BE REUSED ON NEW GUARD RAIL.
16. REMOVE & DISPOSE OF EXISTING ASPHALT CURB.
17. EXISTING ASPHALT CURB TO REMAIN.
18. REMOVE & DISPOSE OF EXISTING PULL BOX, SEE SHEET 20.
19. REMOVE & DISPOSE OF EXISTING INTERSECTION LANE CONTROL SIGN. RELOCATE EXISTING HOSPITAL SIGN TO NEW INTERSECTION LANE CONTROL SIGN POST AT STA. 14+90.00.
20. RELOCATE EXISTING TRAFFIC SIGNAL PULL BOX BEHIND BACK OF PROPOSED CURB & ADJUST CONDUIT AS NECESSARY.
21. REMOVE & STOCKPILE EXISTING LANDSCAPE MATERIAL IN MEDIAN. CONTRACTOR TO COORDINATE WITH CITY OF ALBUQUERQUE REGARDING PLACEMENT OF EXISTING LANDSCAPE MATERIAL WITHIN NEW MEDIAN.
22. EXISTING SIGN TO REMAIN.
23. EXISTING "448 SOUTH" SIGN TO REMAIN. REPLACE EXISTING STRAIGHT ARROW WITH LEFT POINTING ARROW. SEE SHEET 16.
24. REMOVE AND DISPOSE OF EXISTING RIO RANCHO SIGN. BIKE ROUTE SIGN AND ARROW TO REMAIN.
25. EXISTING TREE TO REMAIN.

PAVING KEYED NOTES

1. CONSTRUCT STANDARD CURB & GUTTER PER COA STD DWG 2415-A.
2. CONSTRUCT MEDIAN CURB & GUTTER PER COA STD DWG 2415-B.
3. INSTALL CONCRETE MEDIAN PAVEMENT PER COA STD DWG 2408 & 2502 (NOTES 3 & 4).
4. CONSTRUCT 6' WIDE CONCRETE SIDEWALK PER COA STD DWG 2430.
5. INSTALL GUARD RAIL PER NEW MEXICO DEPARTMENT OF TRANSPORTATION STANDARD DRAWINGS, (R=25). SEE SHEETS 18A-18C. INSTALL TYPE 'B' END ANCHORAGE PER DETAIL ON SHEET 18C.
6. ADJUST EXISTING MANHOLE FRAME & COVER TO FINISHED GRADE.
7. ADJUST EXISTING WATER VALVE BOX TO FINISHED GRADE.
8. BEGIN CONSTRUCTION OF CURB & GUTTER. MATCH EXISTING CURB HORIZONTALLY & VERTICALLY.
9. CONSTRUCT CURB RAMP WITH DETECTABLE WARNING SURFACE PER DETAIL 1/18.
10. CONSTRUCT CURB RAMP WITH DETECTABLE WARNING SURFACE PER DETAIL 2/18.
11. CONSTRUCT 6' WIDE CONCRETE VALLEY GUTTER PER COA STD DWG 2420.
12. CONSTRUCT STANDARD CURB & GUTTER PER COA STD DWG 2415-A W/ DEPRESSED GUTTER.
13. CONSTRUCT MEDIAN CURB & GUTTER W/ DEPRESSED GUTTER PER DETAIL ON SHEET 18.
14. END CONSTRUCTION OF CURB & GUTTER. MATCH EXISTING CURB HORIZONTALLY & VERTICALLY.
15. RELOCATED TRAFFIC SIGNAL PULL BOX.

HATCHING LEGEND

- PROPOSED ASPHALT PAVEMENT, SEE SHEET 18 FOR TYPICAL ROAD & PAVEMENT SECTIONS
- ASPHALT PAVEMENT REMOVAL
- CONCRETE MEDIAN PAVEMENT PER COA STD DWG 2408 & 2502

Bohannon & Huston
 Courtyard I 7500 Jefferson St. NE Albuquerque, NM 87109-4395
 ENGINEERING & SPATIAL DATA & ADVANCED TECHNOLOGIES





CITY OF ALBUQUERQUE
DEPARTMENT OF MUNICIPAL DEVELOPMENT

COSTCO PUBLIC INFRASTRUCTURE
COORS BYPASS DEMOLITION & PAVING PLAN

DESIGN REVIEW COMMITTEE	CITY ENGINEER APPROVAL	MO./DAY/YR.	MO./DAY/YR.
<i>[Signature]</i>	<i>[Signature]</i>		
DESIGN REVIEW COMMITTEE	DESIGN REVIEW COMMITTEE	LAST DESIGN UPDATE	

CITY PROJECT NO.	ZONE MAP NO.	SHEET	OF
729082	B-13, B-14, C-13, D-13	9	22

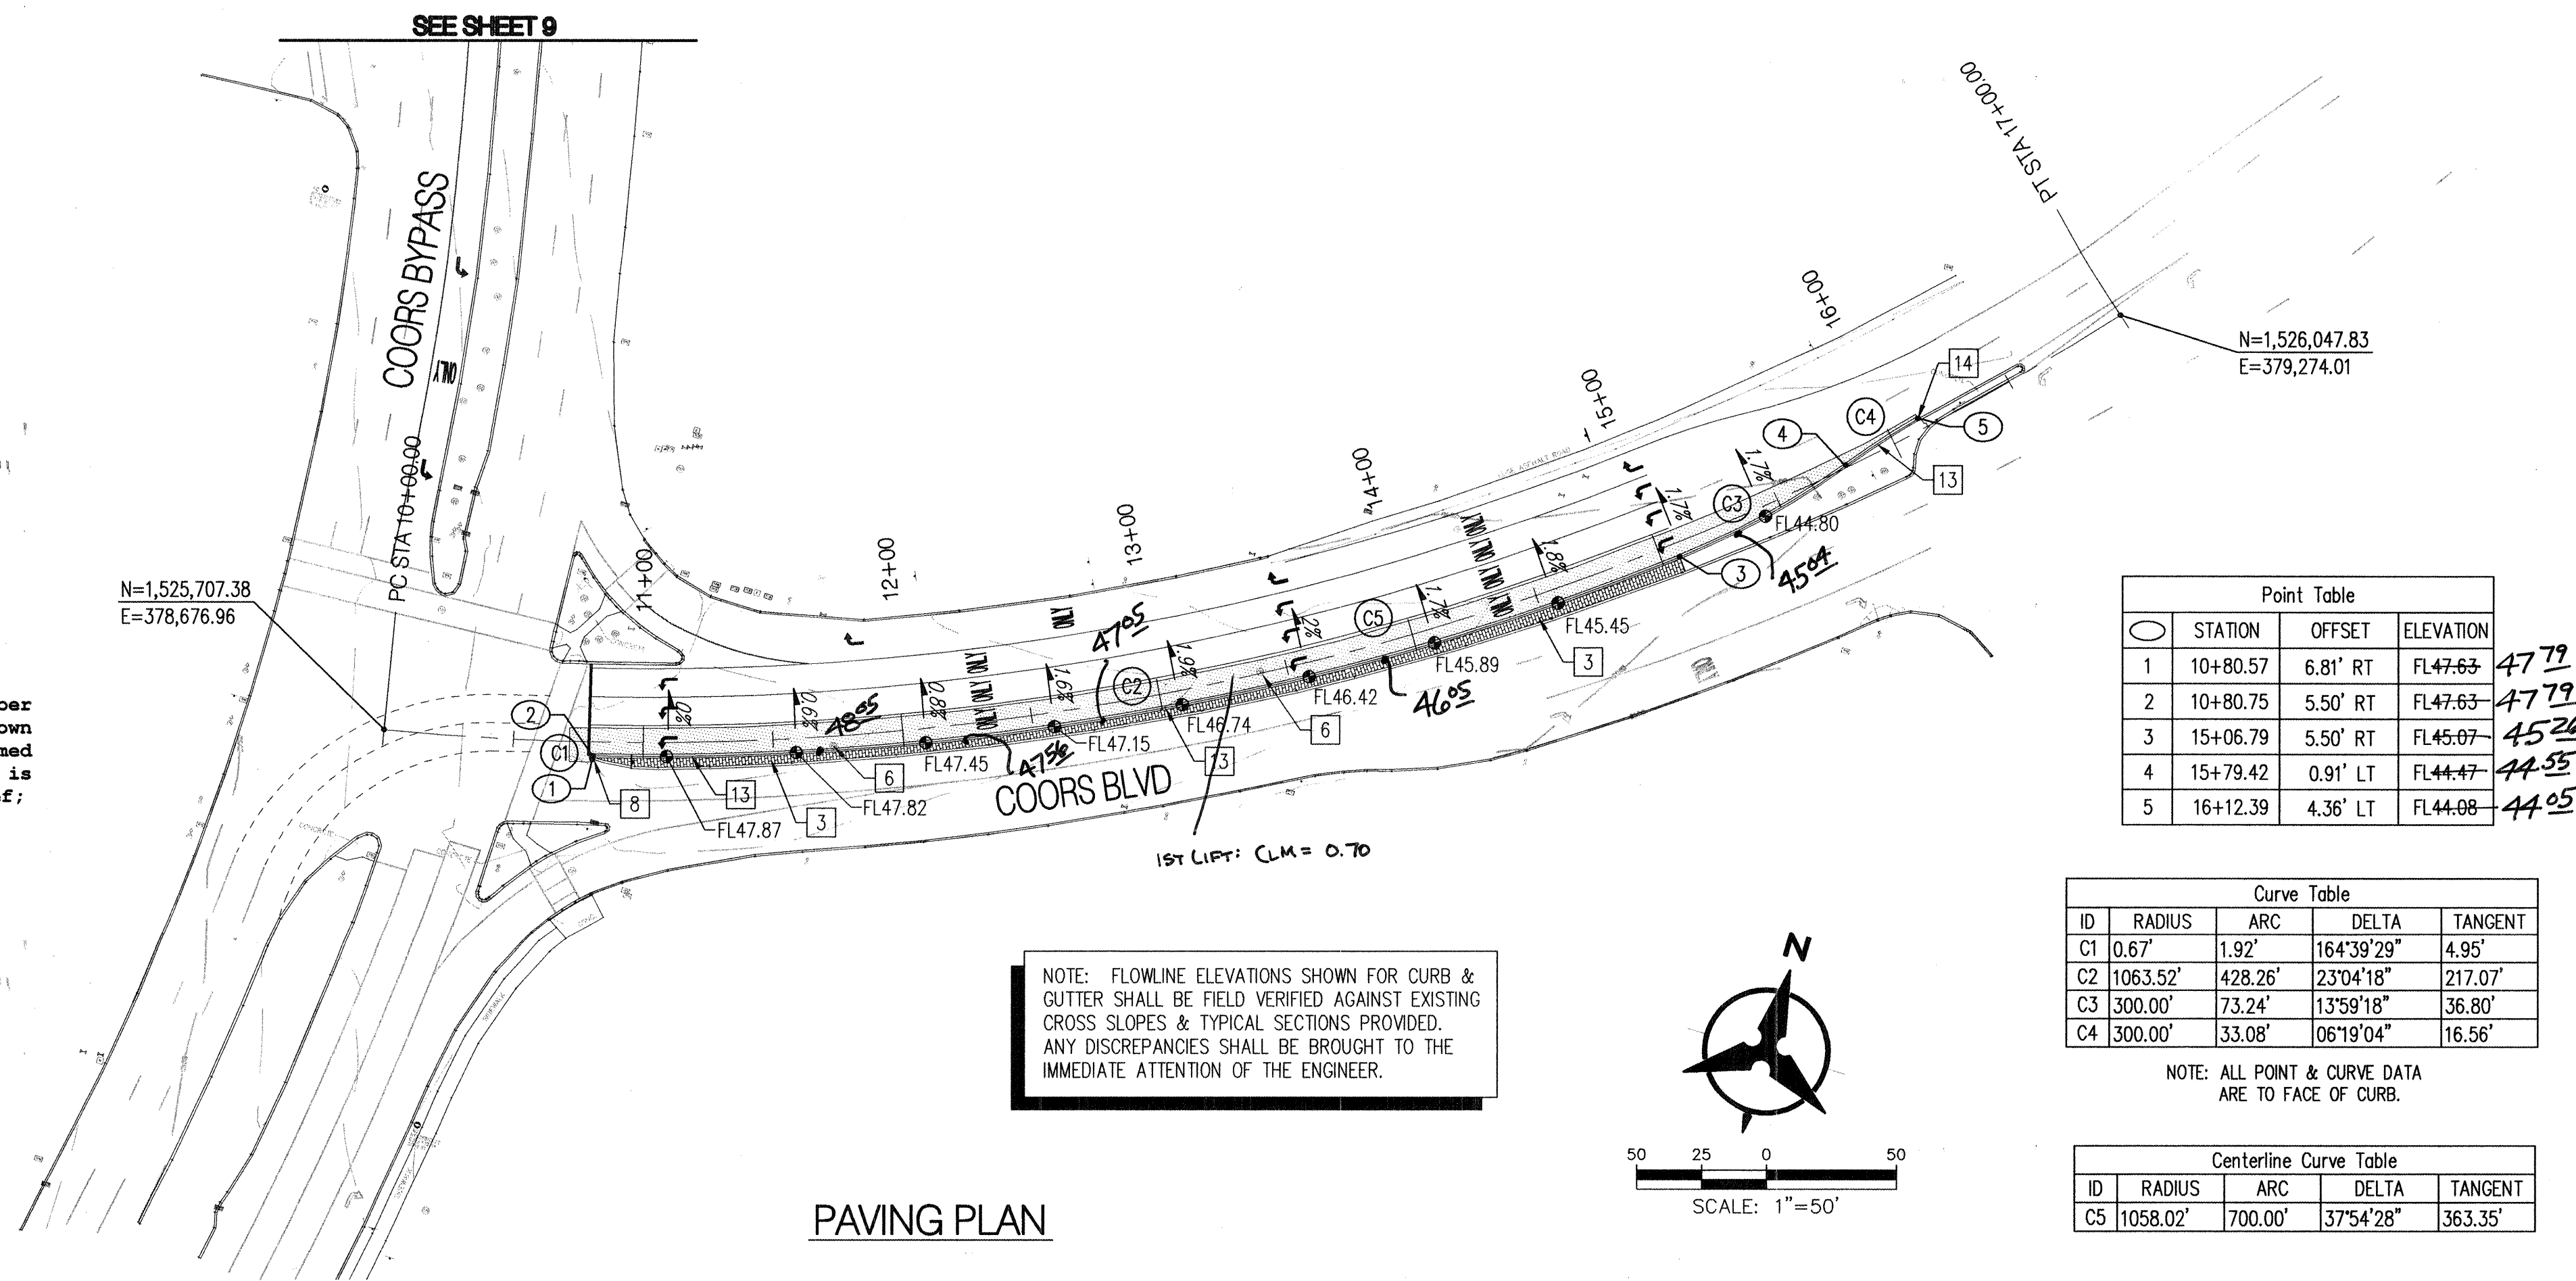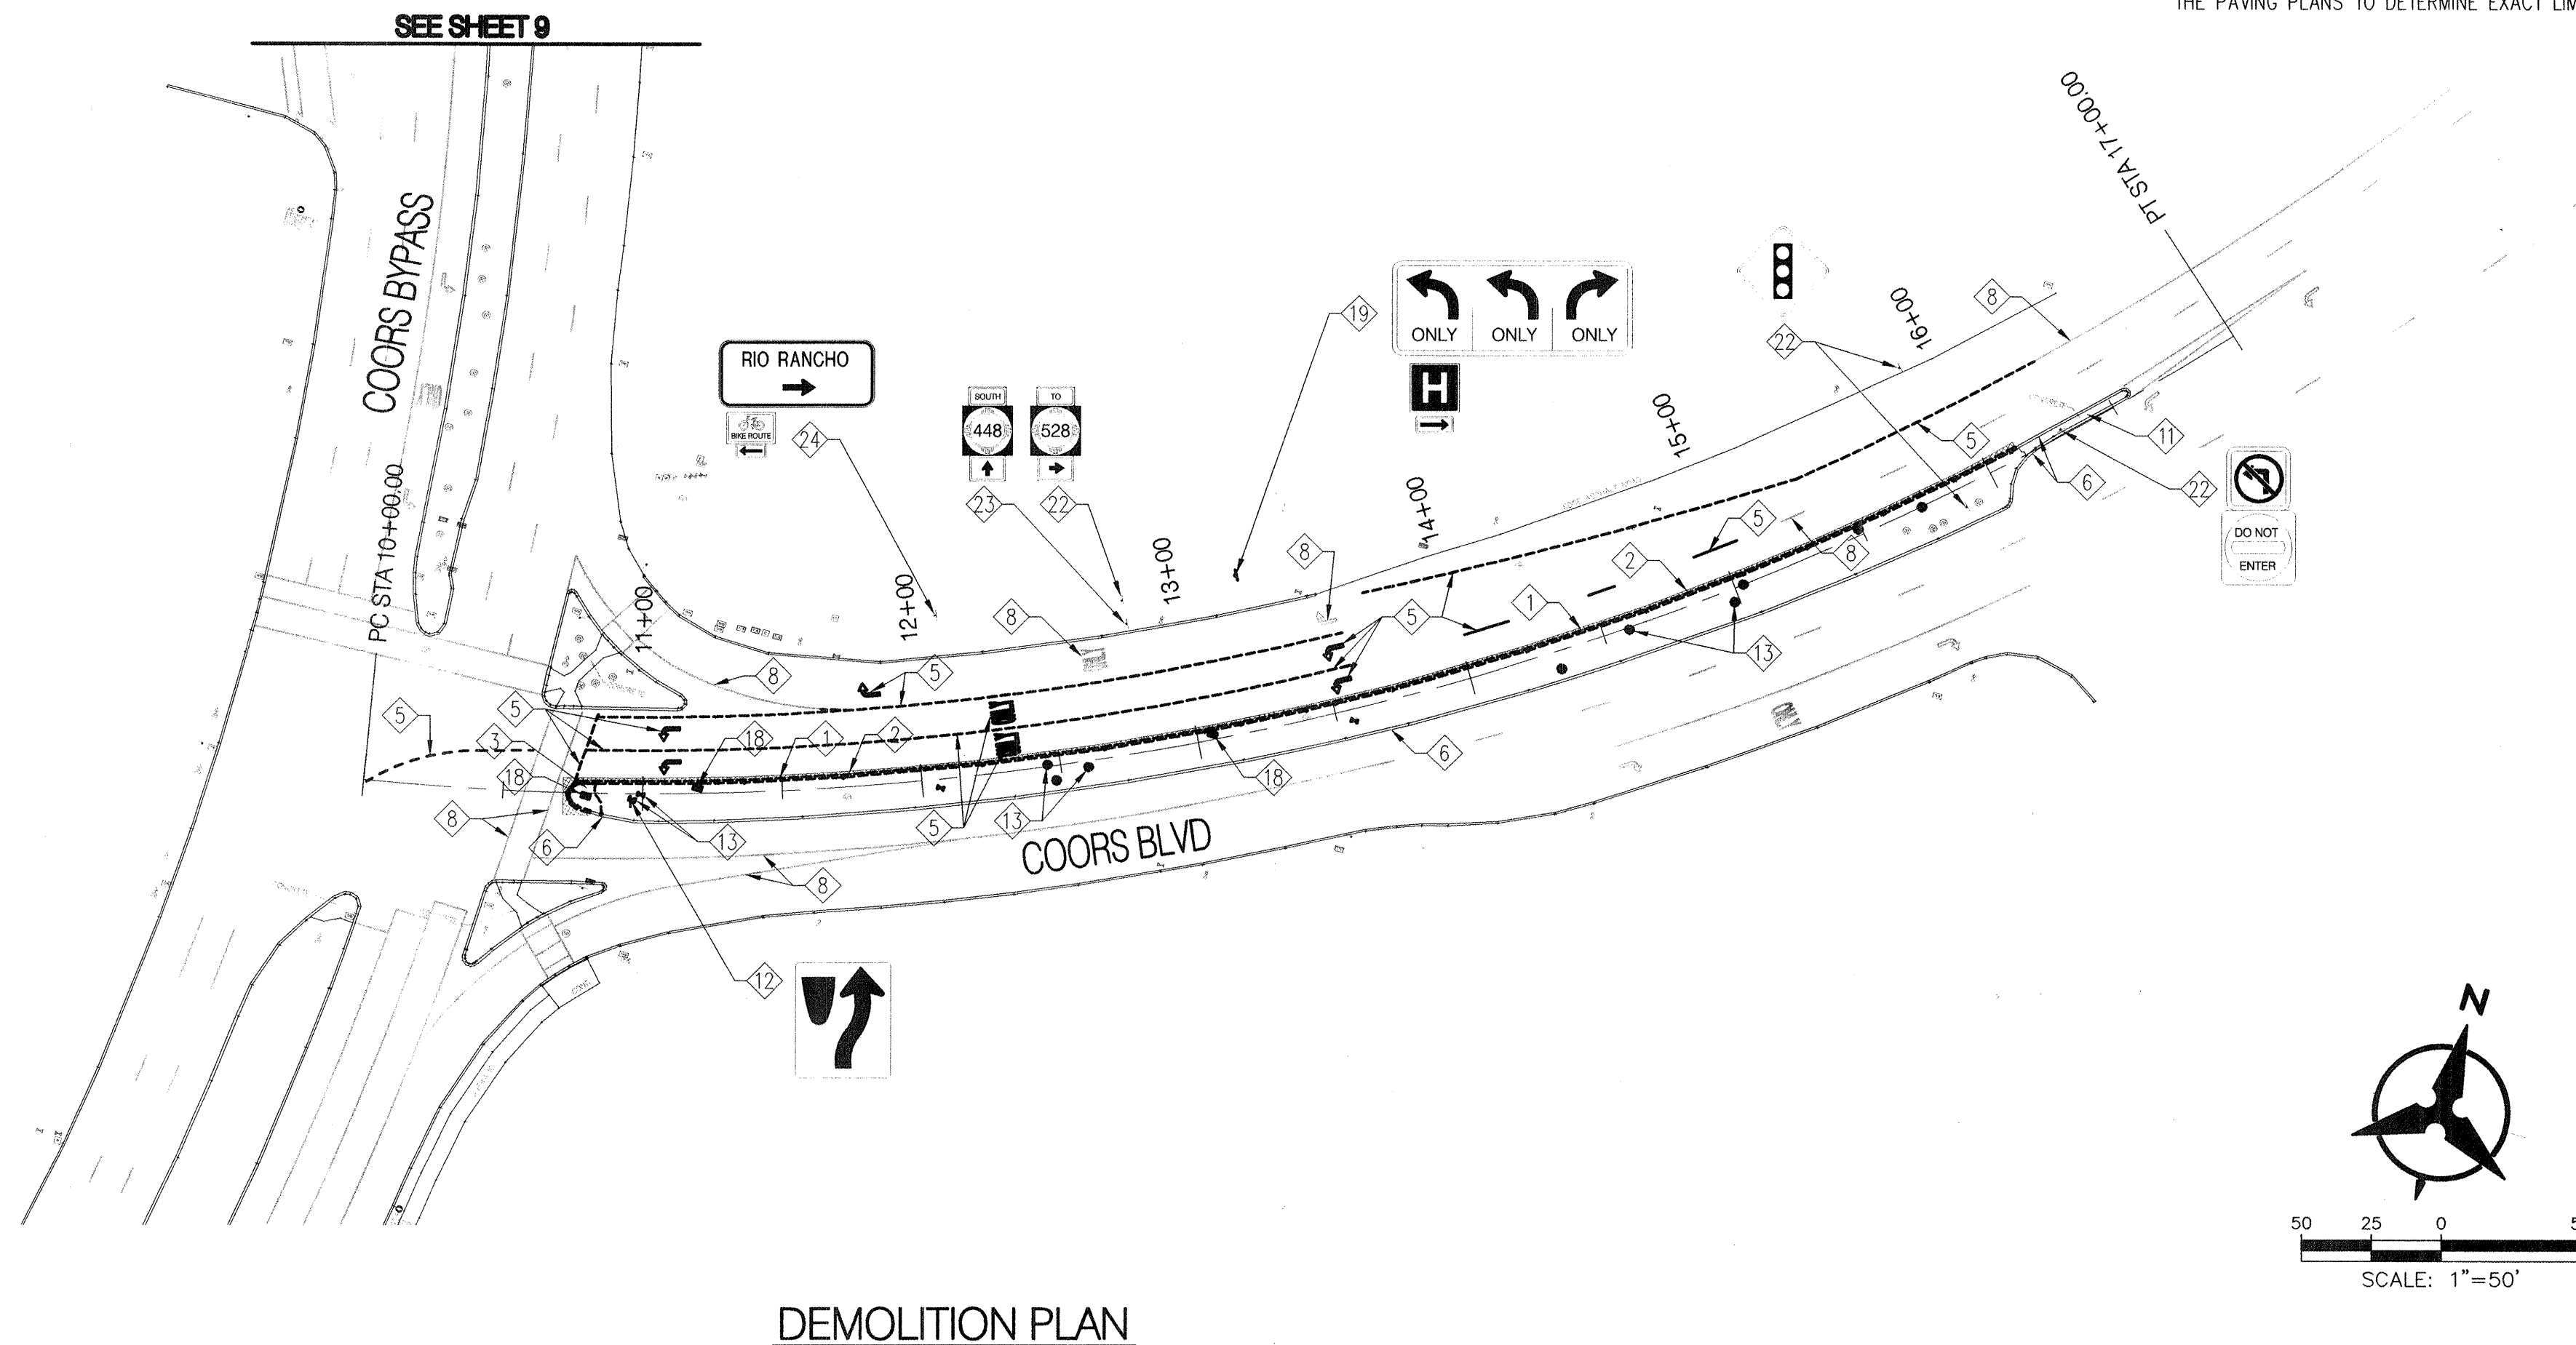

SURVEYORS CERTIFICATION

I, Russ P. Hugg, New Mexico Professional Surveyor Number 9750, hereby certify that the as-built information shown hereon is the result of an actual field survey performed by me or under my direct supervision and that the same is true and correct to the best of my knowledge and belief;

Russ P. Hugg
NMPS No. 9750
12/13, 2007



Point Table		
STATION	OFFSET	ELEVATION
1 10+80.57	6.81' RT	FL47.63
2 10+80.75	5.50' RT	FL47.63
3 15+06.79	5.50' RT	FL45.07
4 15+79.42	0.91' LT	FL44.47
5 16+12.39	4.36' LT	FL44.08

Curve Table				
ID	RADIUS	ARC	DELTA	TANGENT
C1	0.67'	1.92'	164°39'29"	4.95'
C2	1063.52'	428.26'	23°04'18"	217.07'
C3	300.00'	73.24'	13°59'18"	36.80'
C4	300.00'	33.08'	06°19'04"	16.56'

NOTE: ALL POINT & CURVE DATA ARE TO FACE OF CURB.

Centerline Curve Table				
ID	RADIUS	ARC	DELTA	TANGENT
C5	1058.02'	700.00'	37°54'28"	363.35'

NOTE: NOT ALL KEYED NOTES MAY APPLY TO THIS SHEET.

DEMOLITION KEYED NOTES

- REMOVE & DISPOSE OF EXISTING CURB & GUTTER.
- REMOVE & DISPOSE OF EXISTING ASPHALT PAVEMENT. SAW-CUT TO A STRAIGHT CLEAN EDGE.
- REMOVE & DISPOSE OF EXISTING CONCRETE MEDIAN PAVEMENT.
- REMOVE & DISPOSE OF EXISTING CONCRETE SIDEWALK.
- OBLITERATE EXISTING PAVEMENT MARKING BY WATER BLASTING.
- EXISTING CURB & GUTTER TO REMAIN.
- EXISTING SIDEWALK TO REMAIN.
- EXISTING PAVEMENT MARKING TO REMAIN.
- EXISTING STORM INLET TO REMAIN.
- EXISTING LIGHT POLE TO REMAIN.
- EXISTING MEDIAN PAVEMENT TO REMAIN.
- RELOCATE EXISTING SIGN TO NEW MEDIAN.
- REMOVE & DISPOSE OF EXISTING TREES & SHRUBS. IRRIGATION SYSTEM FOR MEDIAN LANDSCAPING TO REMAIN IN SERVICE.
- RELOCATE EXISTING SPEED LIMIT SIGN TO STA. 12+18.00.
- REMOVE & DISPOSE OF EXISTING GUARD RAIL. END TREATMENT TO BE REUSED ON NEW GUARD RAIL.
- REMOVE & DISPOSE OF EXISTING ASPHALT CURB.
- EXISTING ASPHALT CURB TO REMAIN.
- REMOVE & DISPOSE OF EXISTING PULL BOX, SEE SHEET 20.
- REMOVE & DISPOSE OF EXISTING INTERSECTION LANE CONTROL SIGN. RELOCATE EXISTING HOSPITAL SIGN TO NEW INTERSECTION LANE CONTROL SIGN POST AT STA. 14+90.00.
- RELOCATE EXISTING TRAFFIC SIGNAL PULL BOX BEHIND BACK OF PROPOSED CURB & ADJUST CONDUIT AS NECESSARY.
- REMOVE & STOCKPILE EXISTING LANDSCAPE MATERIAL IN MEDIAN. CONTRACTOR TO COORDINATE WITH CITY OF ALBUQUERQUE REGARDING PLACEMENT OF EXISTING LANDSCAPE MATERIAL WITHIN NEW MEDIAN.
- EXISTING SIGN TO REMAIN.
- EXISTING "448 SOUTH" SIGN TO REMAIN. REPLACE EXISTING STRAIGHT ARROW WITH LEFT POINTING ARROW. SEE SHEET 16.
- REMOVE AND DISPOSE OF EXISTING RIO RANCHO SIGN. BIKE ROUTE SIGN AND ARROW TO REMAIN.
- EXISTING TREE TO REMAIN.

PAVING KEYED NOTES

- CONSTRUCT STANDARD CURB & GUTTER PER COA STD DWG 2415-A.
- CONSTRUCT MEDIAN CURB & GUTTER PER COA STD DWG 2415-B.
- INSTALL CONCRETE MEDIAN PAVEMENT PER COA STD DWG 2408 & 2502 (NOTES 3 & 4).
- CONSTRUCT 6' WIDE CONCRETE SIDEWALK PER COA STD DWG 2430.
- INSTALL GUARD RAIL PER NEW MEXICO DEPARTMENT OF TRANSPORTATION STANDARD DRAWINGS (R-25). SEE SHEETS 18A-18C. INSTALL TYPE 'B' END ANCHORAGE PER DETAIL ON SHEET 18C.
- ADJUST EXISTING MANHOLE FRAME & COVER TO FINISHED GRADE.
- ADJUST EXISTING WATER VALVE BOX TO FINISHED GRADE.
- BEGIN CONSTRUCTION OF CURB & GUTTER. MATCH EXISTING CURB HORIZONTALLY & VERTICALLY.
- CONSTRUCT CURB RAMP WITH DETECTABLE WARNING SURFACE PER DETAIL 1/18.
- CONSTRUCT CURB RAMP WITH DETECTABLE WARNING SURFACE PER DETAIL 2/18.
- CONSTRUCT 6' WIDE CONCRETE VALLEY GUTTER PER COA STD DWG 2420.
- CONSTRUCT STANDARD CURB & GUTTER PER COA STD DWG 2415-A W/ DEPRESSED GUTTER.
- CONSTRUCT MEDIAN CURB & GUTTER W/ DEPRESSED GUTTER PER DETAIL ON SHEET 18.
- END CONSTRUCTION OF CURB & GUTTER. MATCH EXISTING CURB HORIZONTALLY & VERTICALLY.
- RELOCATED TRAFFIC SIGNAL PULL BOX.

HATCHING LEGEND

- PROPOSED ASPHALT PAVEMENT. SEE SHEET 18 FOR TYPICAL ROAD & PAVEMENT SECTIONS
- ASPHALT PAVEMENT REMOVAL
- CONCRETE MEDIAN PAVEMENT PER COA STD DWG 2408 & 2502

Bohannon & Huston

Courtyard | 7500 Jefferson St. NE Albuquerque, NM 87109-4335
ENGINEERING • SPATIAL DATA • ADVANCED TECHNOLOGIES




CITY OF ALBUQUERQUE
DEPARTMENT OF MUNICIPAL DEVELOPMENT

COSTCO PUBLIC INFRASTRUCTURE
COORS BLVD DEMOLITION & PAVING PLAN


DESIGN REVIEW COMMITTEE	CITY ENGINEER APPROVAL	LAST DESIGN UPDATE	MO./DAY/YR.	MO./DAY/YR.
X	X			

CITY PROJECT NO.	729082	ZONE MAP NO.	B-13, B-14, C-13, D-13	SHEET	10	OF	22
------------------	--------	--------------	------------------------	-------	----	----	----

NOTE: CONTRACTOR SHALL COORDINATE ALL DEMOLITION WORK WITH THE PAVING PLANS TO DETERMINE EXACT LIMITS OF REMOVAL.

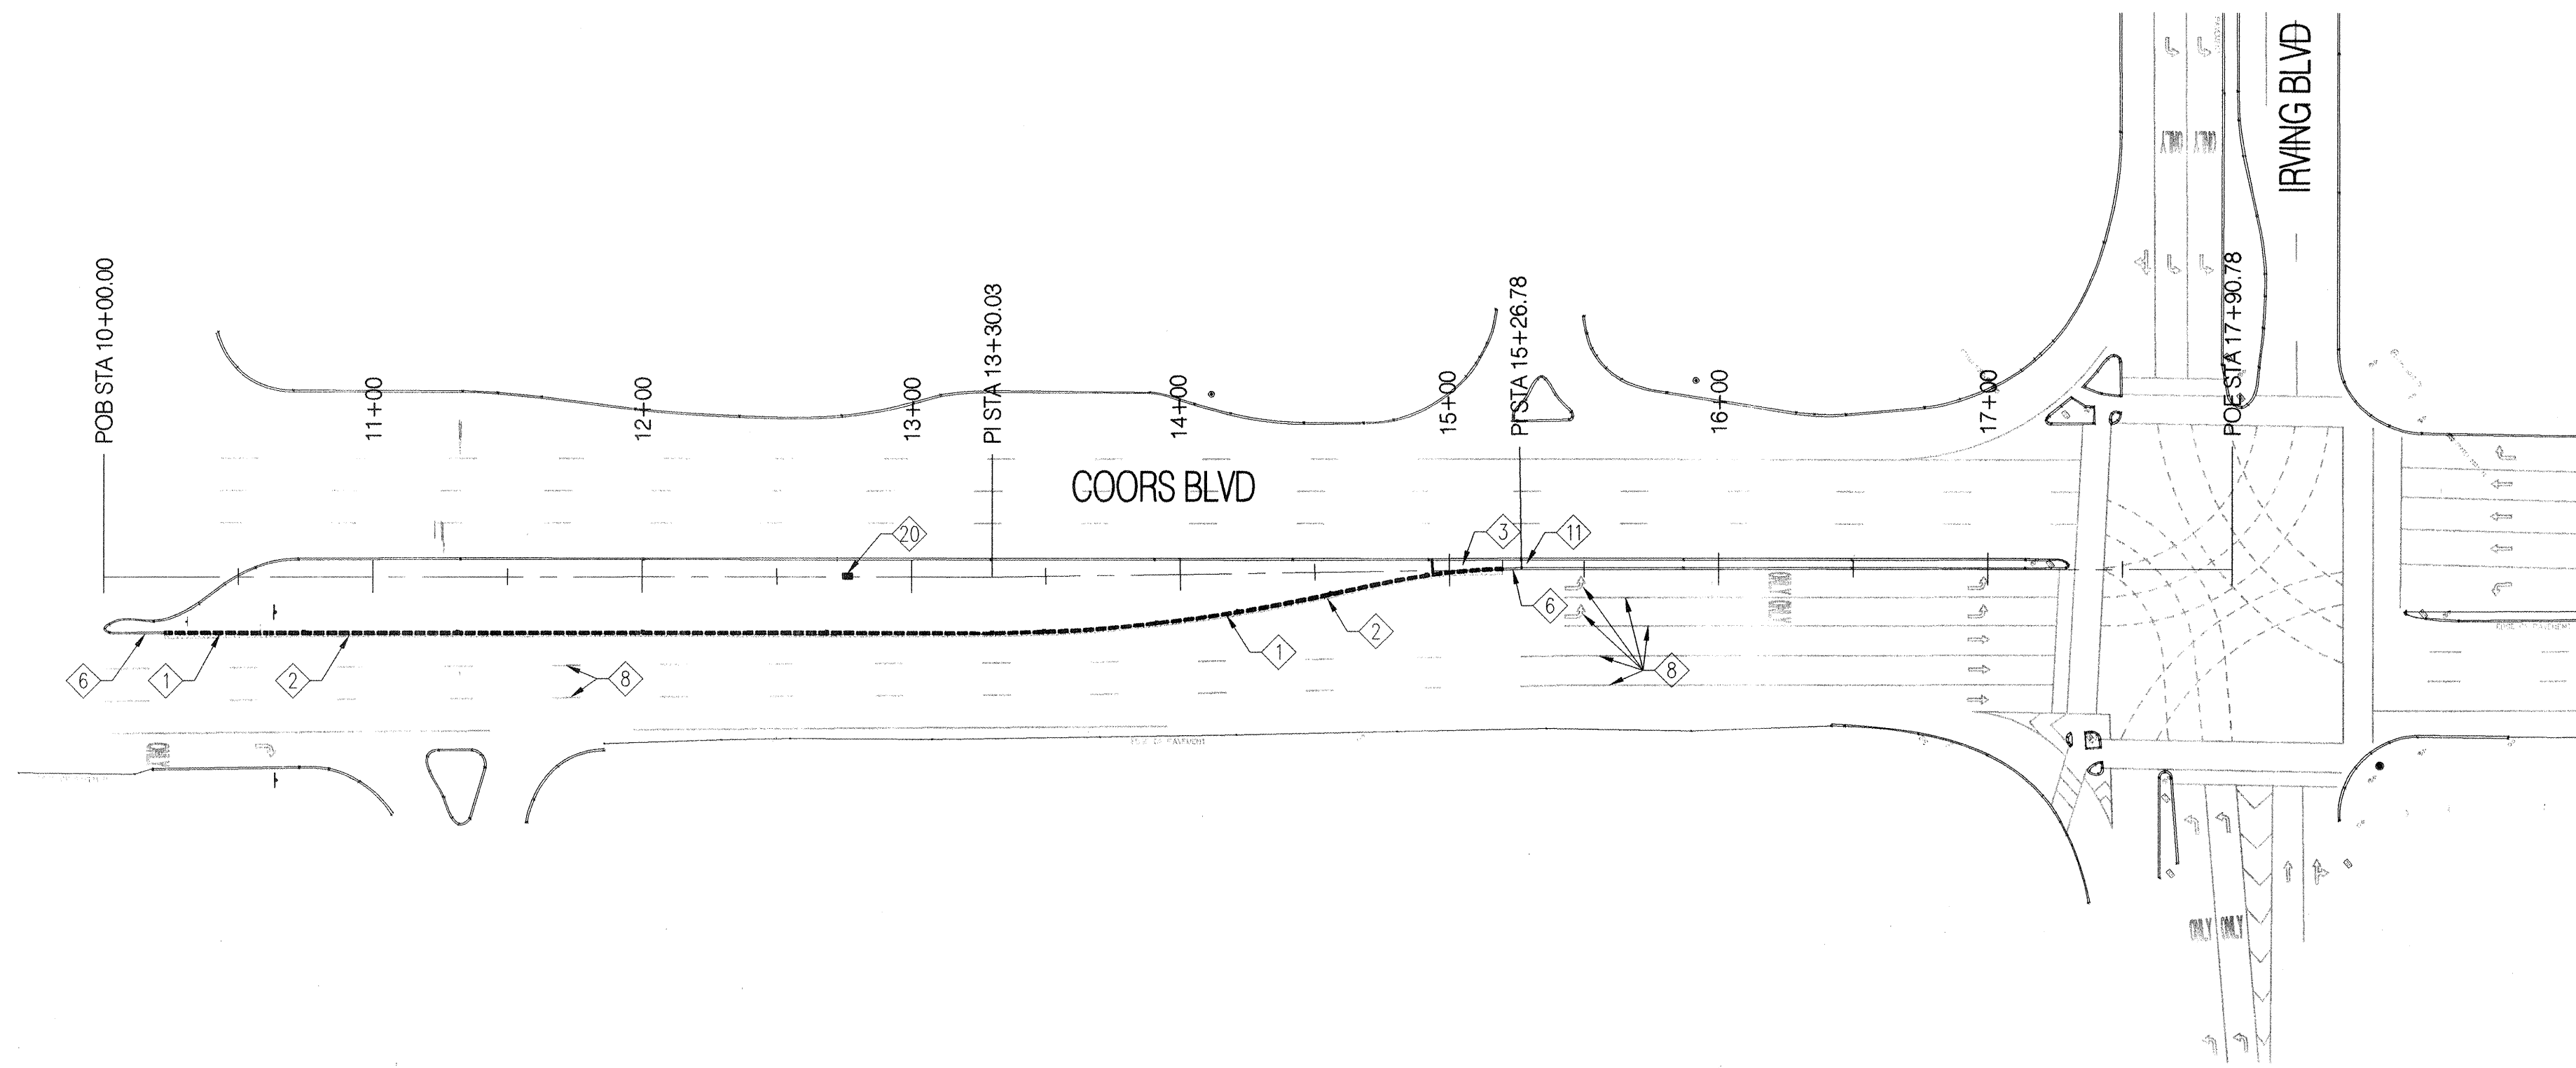

DEMOLITION PLAN

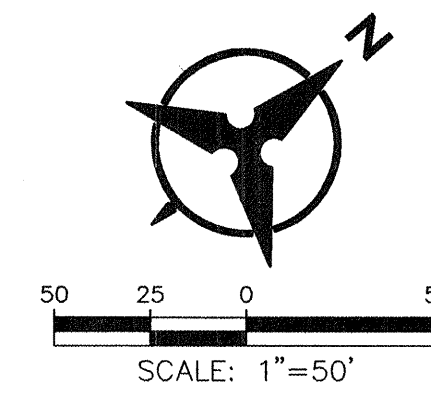

NOTE: NOT ALL KEYED NOTES MAY APPLY TO THIS SHEET.

DEMOLITION KEYED NOTES

1. REMOVE & DISPOSE OF EXISTING CURB & GUTTER.
2. REMOVE & DISPOSE 1' STRIP OF EXISTING ASPHALT PAVEMENT. SAW-CUT TO A STRAIGHT CLEAN EDGE.
3. REMOVE & DISPOSE OF EXISTING CONCRETE MEDIAN PAVEMENT.
4. REMOVE & DISPOSE OF EXISTING CONCRETE SIDEWALK.
5. OBLITERATE EXISTING PAVEMENT MARKING BY WATER BLASTING.
6. EXISTING CURB & GUTTER TO REMAIN.
7. EXISTING SIDEWALK TO REMAIN.
8. EXISTING PAVEMENT MARKING TO REMAIN.
9. EXISTING STORM INLET TO REMAIN.
10. EXISTING LIGHT POLE TO REMAIN.
11. EXISTING MEDIAN PAVEMENT TO REMAIN.
12. RELOCATE EXISTING SIGN TO NEW MEDIAN.
13. REMOVE & DISPOSE OF EXISTING TREES & SHRUBS. IRRIGATION SYSTEM FOR MEDIAN LANDSCAPING TO REMAIN IN SERVICE.
14. RELOCATE EXISTING SPEED LIMIT SIGN TO STA. 12+18.00.
15. REMOVE & DISPOSE OF EXISTING GUARD RAIL. END TREATMENT TO BE REUSED ON NEW GUARD RAIL.
16. REMOVE & DISPOSE OF EXISTING ASPHALT CURB.
17. EXISTING ASPHALT CURB TO REMAIN.
18. REMOVE & DISPOSE OF EXISTING PULL BOX, SEE SHEET 20.
19. REMOVE & DISPOSE OF EXISTING INTERSECTION LANE CONTROL SIGN. RELOCATE EXISTING HOSPITAL SIGN TO NEW INTERSECTION LANE CONTROL SIGN POST AT STA. 14+90.00.
20. RELOCATE EXISTING TRAFFIC SIGNAL PULL BOX BEHIND BACK OF PROPOSED CURB & ADJUST CONDUIT AS NECESSARY.
21. REMOVE & STOCKPILE EXISTING LANDSCAPE MATERIAL IN MEDIAN. CONTRACTOR TO COORDINATE WITH CITY OF ALBUQUERQUE REGARDING PLACEMENT OF EXISTING LANDSCAPE MATERIAL WITHIN NEW MEDIAN.
22. EXISTING SIGN TO REMAIN.
23. EXISTING "448 SOUTH" SIGN TO REMAIN. REPLACE EXISTING STRAIGHT ARROW WITH LEFT POINTING ARROW. SEE SHEET 16.
24. REMOVE AND DISPOSE OF EXISTING RIO RANCHO SIGN. BIKE ROUTE SIGN AND ARROW TO REMAIN.
25. EXISTING TREE TO REMAIN.

PAVING KEYED NOTES

1. CONSTRUCT STANDARD CURB & GUTTER PER COA STD DWG 2415-A.
2. CONSTRUCT MEDIAN CURB & GUTTER PER COA STD DWG 2415-B.
3. INSTALL CONCRETE MEDIAN PAVEMENT PER COA STD DWG 2408 & 2502 (NOTES 3 & 4.)
4. CONSTRUCT 6' WIDE CONCRETE SIDEWALK PER COA STD DWG 2430.
5. INSTALL GUARD RAIL PER NEW MEXICO DEPARTMENT OF TRANSPORTATION STANDARD DRAWINGS (R-25). SEE SHEETS 18A-18C. INSTALL TYPE 'B' END ANCHORAGE PER DETAIL ON SHEET 18C.
6. ADJUST EXISTING MANHOLE FRAME & COVER TO FINISHED GRADE.
7. ADJUST EXISTING WATER VALVE BOX TO FINISHED GRADE.
8. BEGIN CONSTRUCTION OF CURB & GUTTER. MATCH EXISTING CURB HORIZONTALLY & VERTICALLY.
9. CONSTRUCT CURB RAMP WITH DETECTABLE WARNING SURFACE PER DETAIL 1/18.
10. CONSTRUCT CURB RAMP WITH DETECTABLE WARNING SURFACE PER DETAIL 2/18.
11. CONSTRUCT 6' WIDE CONCRETE VALLEY GUTTER PER COA STD DWG 2420.
12. CONSTRUCT STANDARD CURB & GUTTER PER COA STD DWG 2415-A W/ DEPRESSED GUTTER.
13. CONSTRUCT MEDIAN CURB & GUTTER W/ DEPRESSED GUTTER PER DETAIL ON SHEET 18.
14. END CONSTRUCTION OF CURB & GUTTER. MATCH EXISTING CURB HORIZONTALLY & VERTICALLY.
15. RELOCATED TRAFFIC SIGNAL PULL BOX.

HATCHING LEGEND

- PROPOSED ASPHALT PAVEMENT. SEE SHEET 18 FOR TYPICAL ROAD & PAVEMENT SECTIONS
- ASPHALT PAVEMENT REMOVAL
- CONCRETE MEDIAN PAVEMENT PER COA STD DWG 2408 & 2502


Bohannon & Huston
 Courtyard I 7500 Jefferson St NE Albuquerque, NM 87109-4335
 ENGINEERING • SPATIAL DATA • ADVANCED TECHNOLOGIES

CITY OF ALBUQUERQUE
 DEPARTMENT OF MUNICIPAL DEVELOPMENT
 COSTCO PUBLIC INFRASTRUCTURE
 COORS BLVD DEMOLITION & PAVING PLAN


DESIGN REVIEW COMMITTEE	CITY ENGINEER APPROVAL	MO./DAY/YR.	MO./DAY/YR.
X	X		

CITY PROJECT NO. 729082 ZONE MAP NO. B-13, B-14, C-13, D-13 SHEET 11 OF 22

DESIGNED BY G. BROUGHTON DATE 07/2007
 DRAWN BY B. ORTEGA DATE 07/2007
 CHECKED BY G. BROUGHTON DATE 07/2007

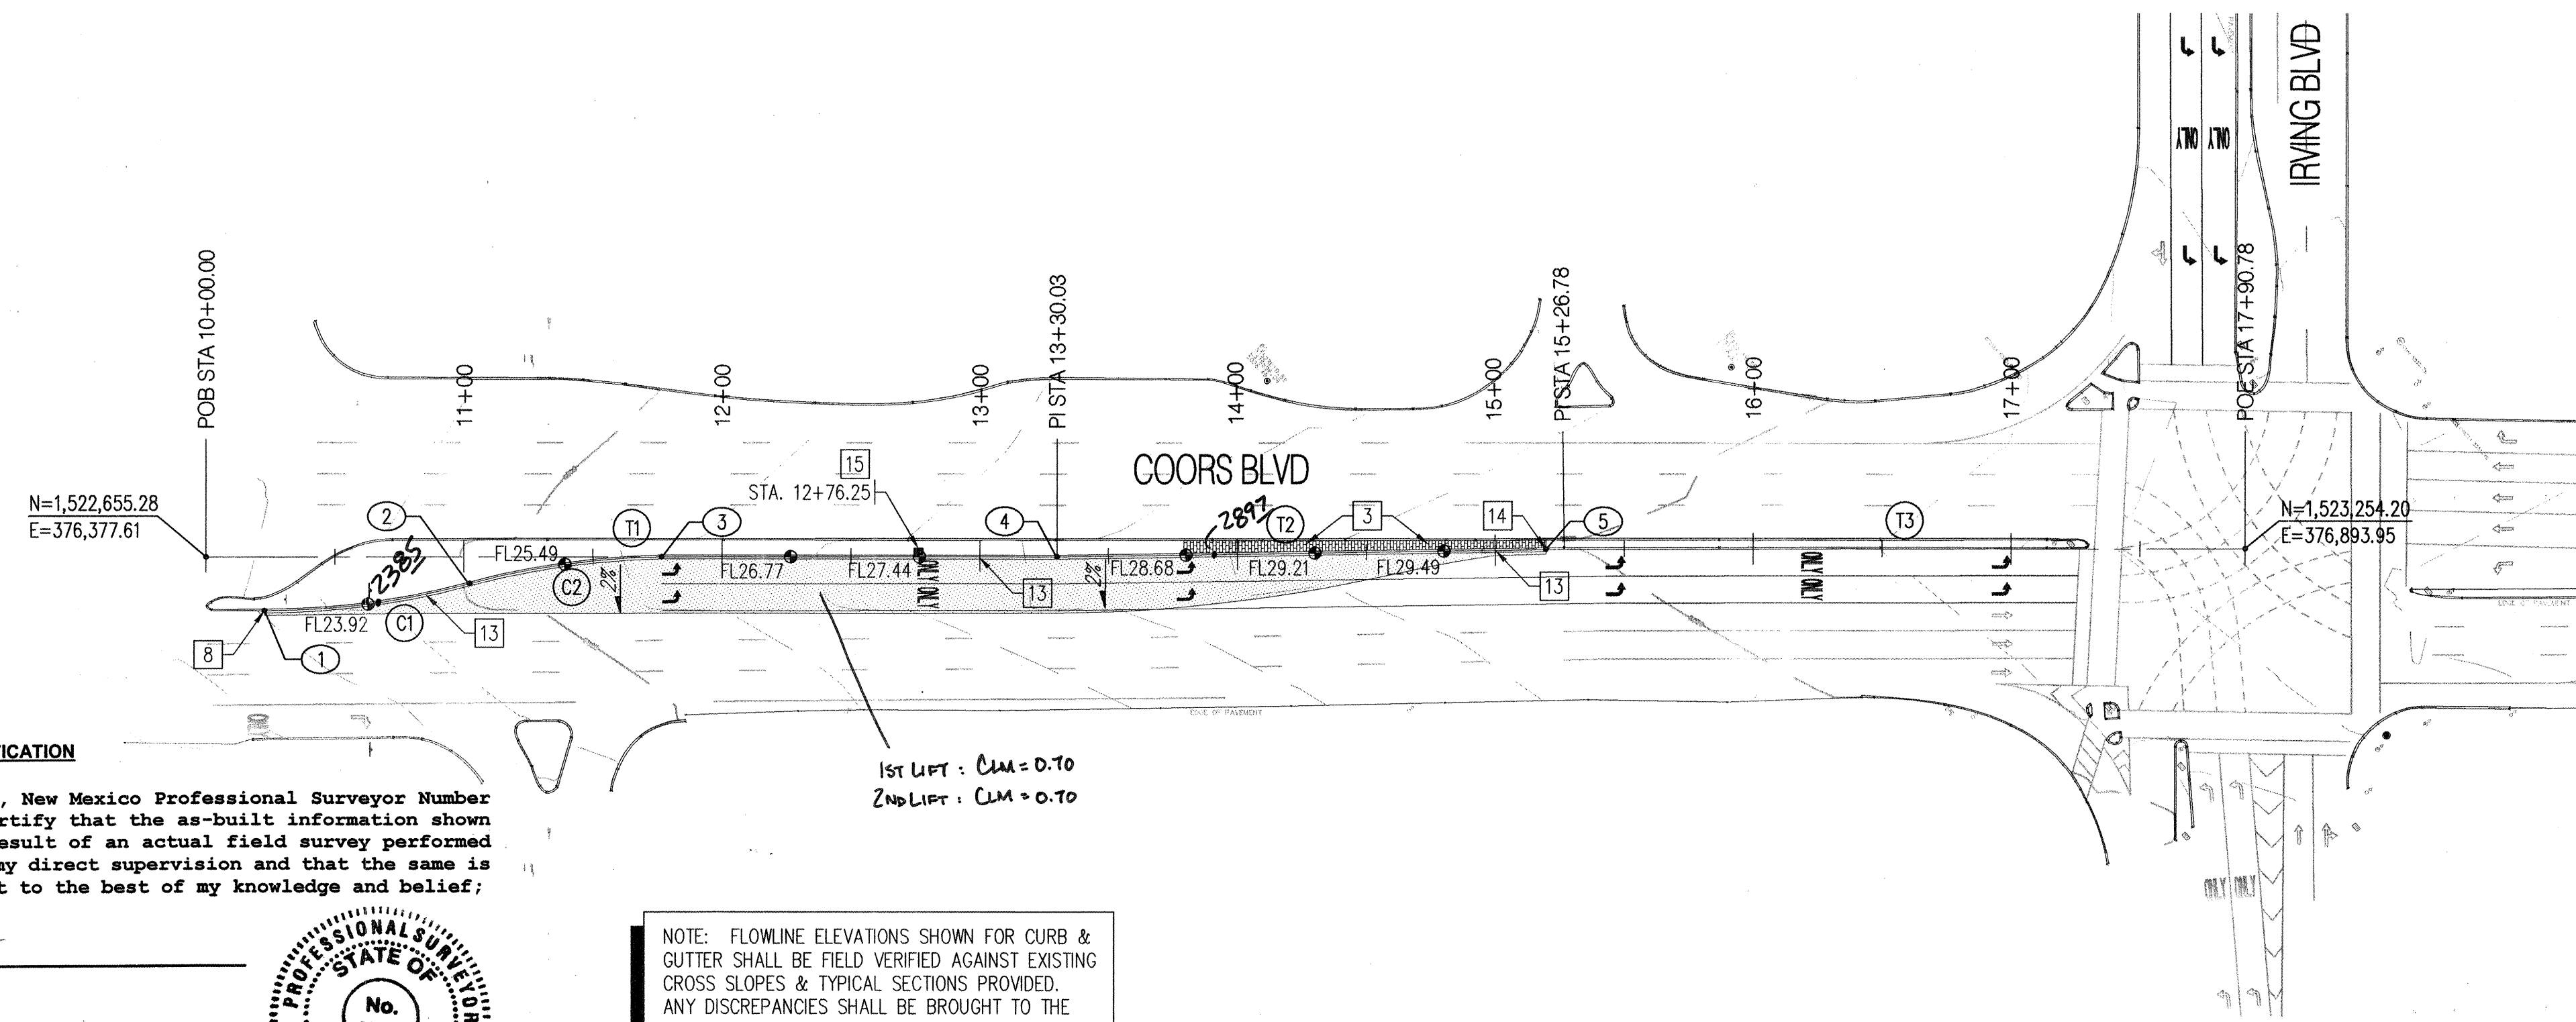

PAVING PLAN

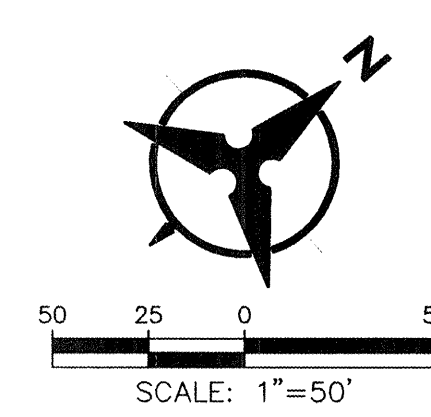

SURVEYORS CERTIFICATION


I, Russ P. Hugg, New Mexico Professional Surveyor Number 9750, hereby certify that the as-built information shown hereon is the result of an actual field survey performed by me or under my direct supervision and that the same is true and correct to the best of my knowledge and belief;

Russ P. Hugg
 NMPS No. 9750
 12.13, 2007



PROFESSIONAL SURVEYOR
 No. 9750
 NEW MEXICO
 RUSS P. HUGG

NOTE: FLOWLINE ELEVATIONS SHOWN FOR CURB & GUTTER SHALL BE FIELD VERIFIED AGAINST EXISTING CROSS SLOPES & TYPICAL SECTIONS PROVIDED. ANY DISCREPANCIES SHALL BE BROUGHT TO THE IMMEDIATE ATTENTION OF THE ENGINEER.

NOTE: CONTRACTOR SHALL COORDINATE ALL DEMOLITION WORK WITH THE PAVING PLANS TO DETERMINE EXACT LIMITS OF REMOVAL.

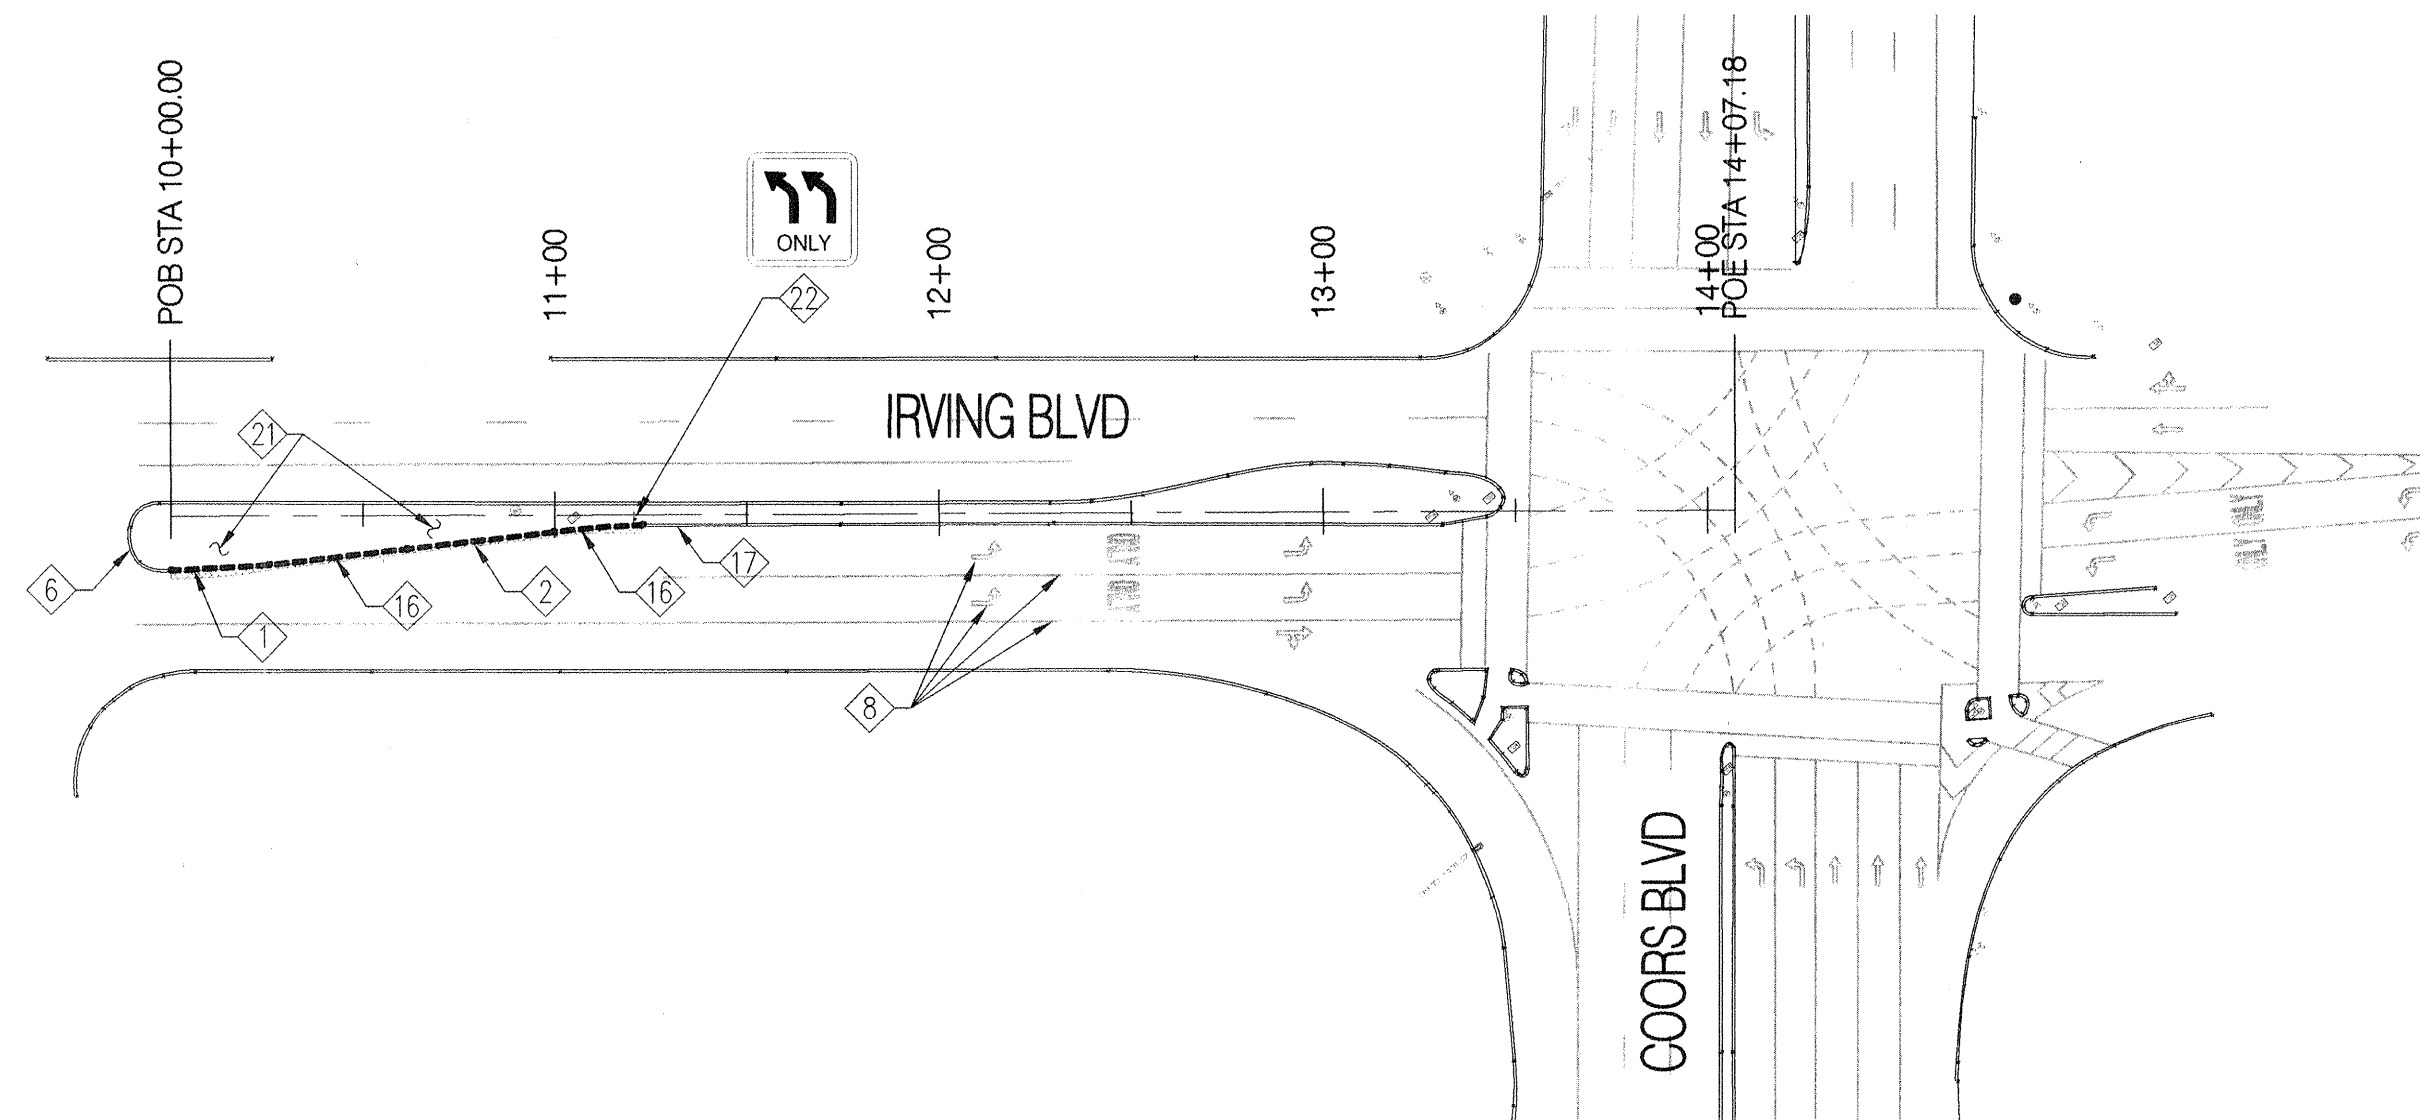


DEMOLITION PLAN

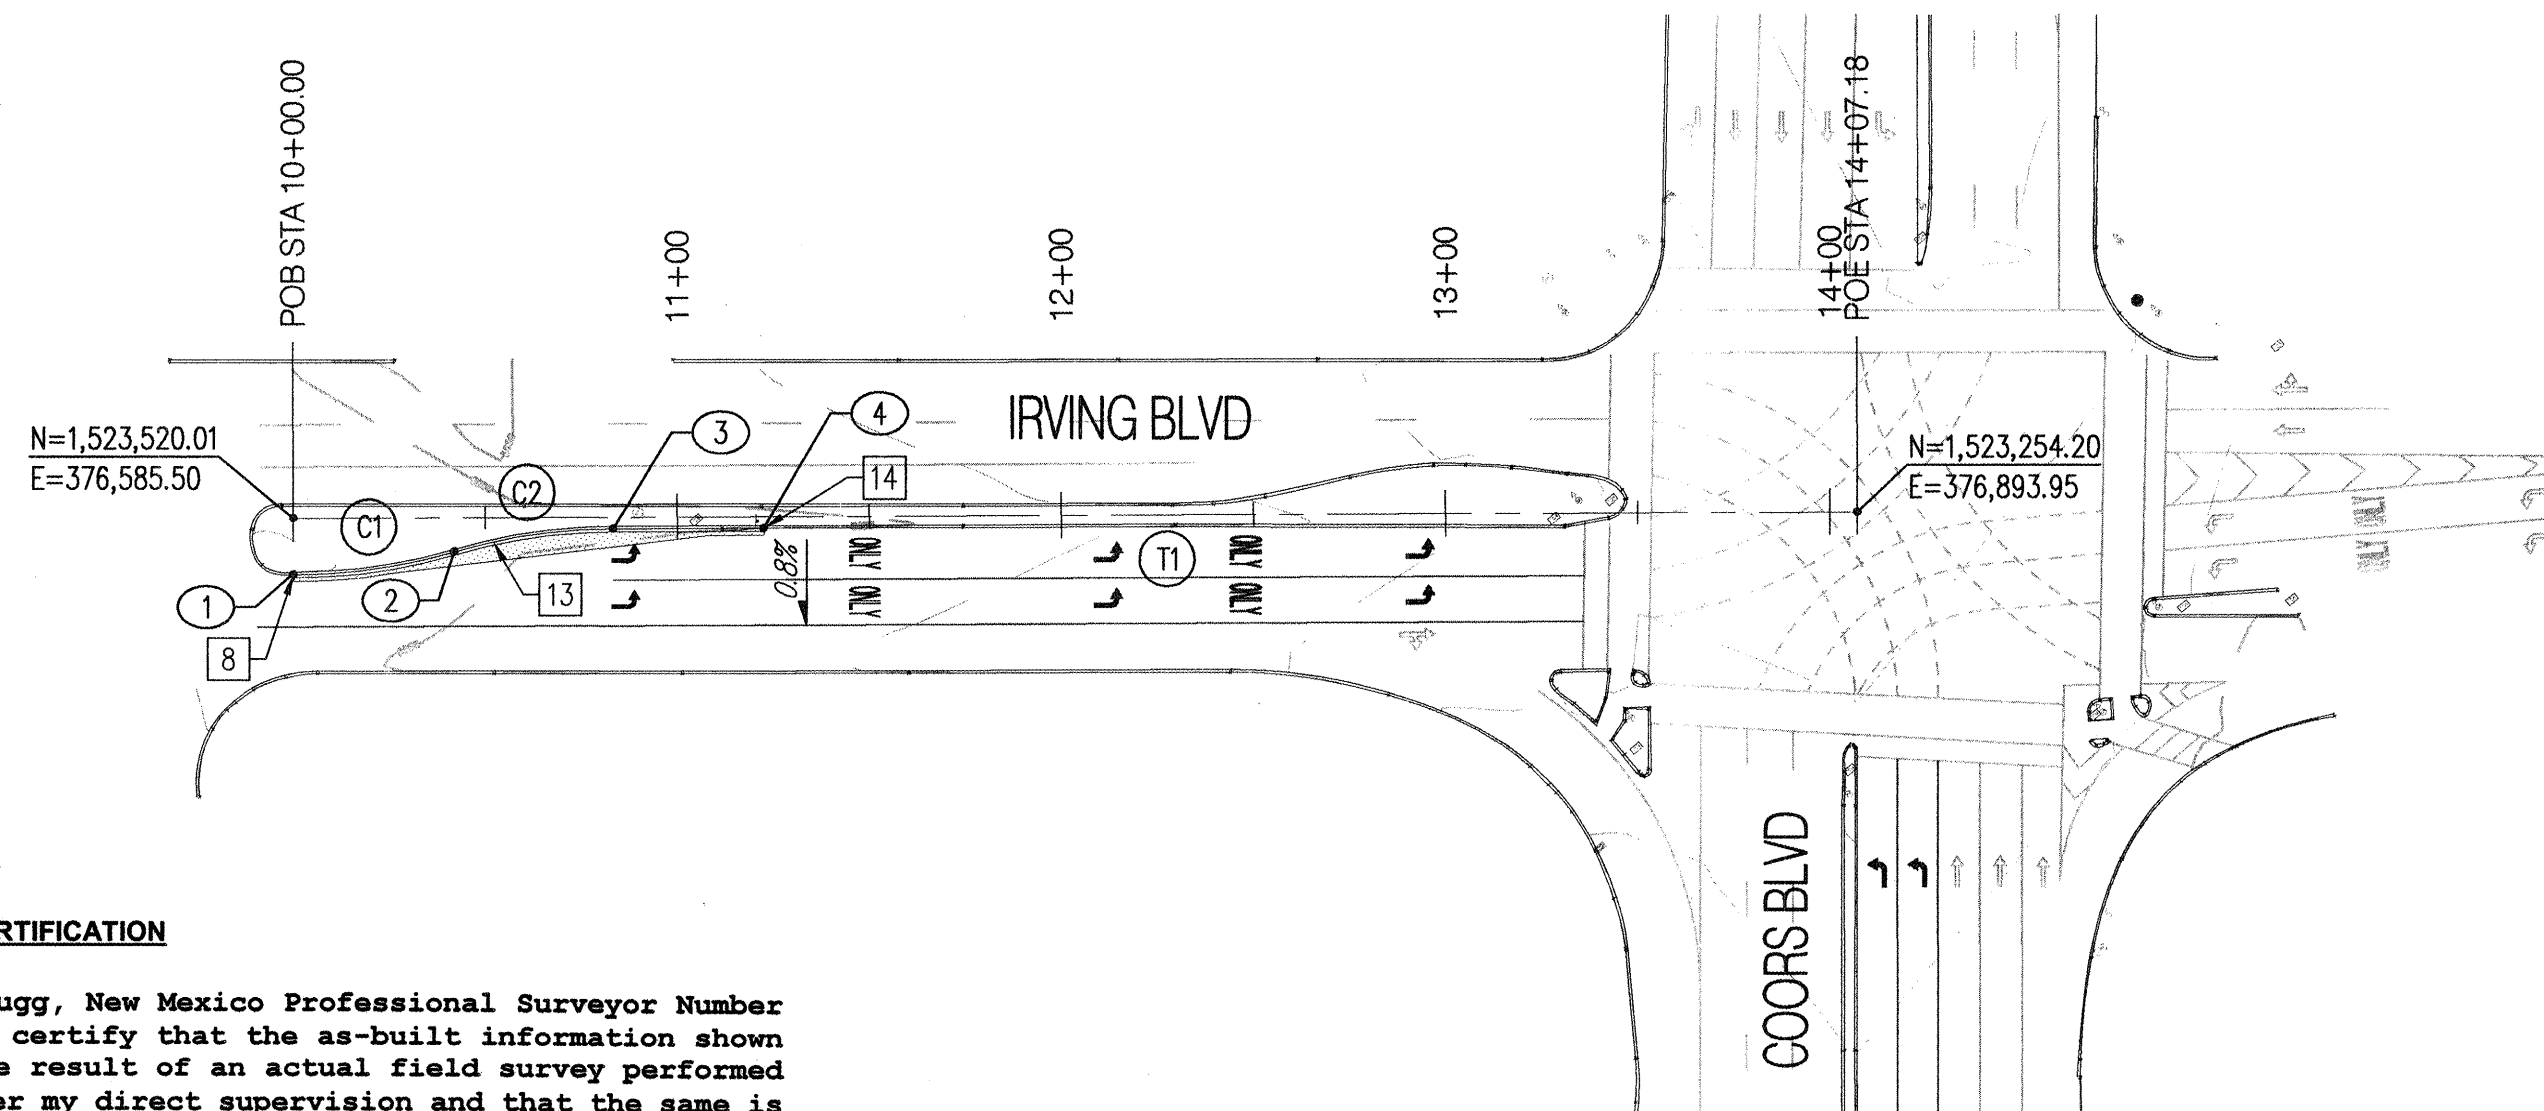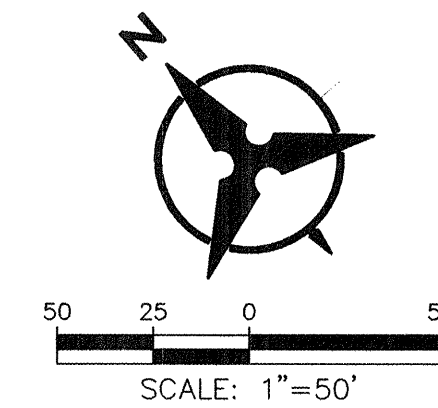

SURVEYORS CERTIFICATION


I, Russ P. Hugg, New Mexico Professional Surveyor Number 9750, hereby certify that the as-built information shown hereon is the result of an actual field survey performed by me or under my direct supervision and that the same is true and correct to the best of my knowledge and belief;

Russ P. Hugg
NMPS No. 9750
12.13, 2007

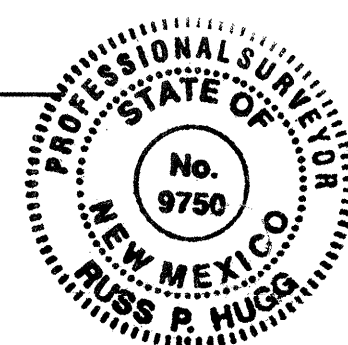

PAVING PLAN

NOTE: FLOWLINE ELEVATIONS SHOWN FOR CURB & GUTTER SHALL BE FIELD VERIFIED AGAINST EXISTING CROSS SLOPES & TYPICAL SECTIONS PROVIDED. ANY DISCREPANCIES SHALL BE BROUGHT TO THE IMMEDIATE ATTENTION OF THE ENGINEER.

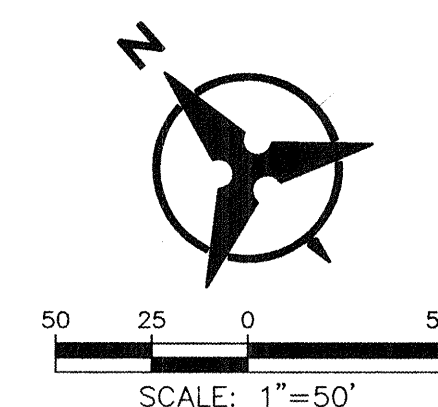

Point Table		
STATION	OFFSET	ELEVATION
1 10+00.00	14.63' RT	FL36.62
2 10+41.94	8.81' RT	FL35.21
3 10+83.29	3.00' RT	FL34.88
4 11+22.55	3.00' RT	FL34.68

Curve Table			
ID	RADIUS	ARC	DELTA
C1	150.00'	42.48'	16°13'33"
C2	150.00'	41.90'	16°00'14"

NOTE: ALL POINT & CURVE DATA ARE TO FACE OF CURB.

Centerline Tangent Table		
ID	BEARING	LENGTH
T1	S49°14'43"E	407.18'

NOTE: NOT ALL KEYED NOTES MAY APPLY TO THIS SHEET.

DEMOLITION KEYED NOTES

1. REMOVE & DISPOSE OF EXISTING CURB & GUTTER.
2. REMOVE & DISPOSE 1' STRIP OF EXISTING ASPHALT PAVEMENT. SAW-CUT TO A STRAIGHT CLEAN EDGE.
3. REMOVE & DISPOSE OF EXISTING CONCRETE MEDIAN PAVEMENT.
4. REMOVE & DISPOSE OF EXISTING CONCRETE SIDEWALK.
5. OBLITERATE EXISTING PAVEMENT MARKING BY WATER BLASTING.
6. EXISTING CURB & GUTTER TO REMAIN.
7. EXISTING SIDEWALK TO REMAIN.
8. EXISTING PAVEMENT MARKING TO REMAIN.
9. EXISTING STORM INLET TO REMAIN.
10. EXISTING LIGHT POLE TO REMAIN.
11. EXISTING MEDIAN PAVEMENT TO REMAIN.
12. RELOCATE EXISTING SIGN TO NEW MEDIAN.
13. REMOVE & DISPOSE OF EXISTING TREES & SHRUBS. IRRIGATION SYSTEM FOR MEDIAN LANDSCAPING TO REMAIN IN SERVICE.
14. RELOCATE EXISTING SPEED LIMIT SIGN TO STA. 12+18.00.
15. REMOVE & DISPOSE OF EXISTING GUARD RAIL. END TREATMENT TO BE REUSED ON NEW GUARD RAIL.
16. REMOVE & DISPOSE OF EXISTING ASPHALT CURB.
17. EXISTING ASPHALT CURB TO REMAIN.
18. REMOVE & DISPOSE OF EXISTING PULL BOX, SEE SHEET 20.
19. REMOVE & DISPOSE OF EXISTING INTERSECTION LANE CONTROL SIGN. RELOCATE EXISTING HOSPITAL SIGN TO NEW INTERSECTION LANE CONTROL SIGN POST AT STA. 14+90.00.
20. RELOCATE EXISTING TRAFFIC SIGNAL PULL BOX BEHIND BACK OF PROPOSED CURB & ADJUST CONDUIT AS NECESSARY.
21. REMOVE & STOCKPILE EXISTING LANDSCAPE MATERIAL IN MEDIAN. CONTRACTOR TO COORDINATE WITH CITY OF ALBUQUERQUE REGARDING PLACEMENT OF EXISTING LANDSCAPE MATERIAL WITHIN NEW MEDIAN.
22. EXISTING SIGN TO REMAIN.
23. EXISTING "448 SOUTH" SIGN TO REMAIN. REPLACE EXISTING STRAIGHT ARROW WITH LEFT POINTING ARROW. SEE SHEET 16.
24. REMOVE AND DISPOSE OF EXISTING RIO RANCHO SIGN. BIKE ROUTE SIGN AND ARROW TO REMAIN.
25. EXISTING TREE TO REMAIN.


PAVING KEYED NOTES

1. CONSTRUCT STANDARD CURB & GUTTER PER COA STD DWG 2415-A.
2. CONSTRUCT MEDIAN CURB & GUTTER PER COA STD DWG 2415-B.
3. INSTALL CONCRETE MEDIAN PAVEMENT PER COA STD DWG 2408 & 2502 (NOTES 3 & 4.)
4. CONSTRUCT 6' WIDE CONCRETE SIDEWALK PER COA STD DWG 2430.
5. INSTALL GUARD RAIL PER NEW MEXICO DEPARTMENT OF TRANSPORTATION STANDARD DRAWINGS, (R-25). SEE SHEETS 18A-18C. INSTALL TYPE 'B' END ANCHORAGE PER DETAIL ON SHEET 18C.
6. ADJUST EXISTING MANHOLE FRAME & COVER TO FINISHED GRADE.
7. ADJUST EXISTING WATER VALVE BOX TO FINISHED GRADE.
8. BEGIN CONSTRUCTION OF CURB & GUTTER. MATCH EXISTING CURB HORIZONTALLY & VERTICALLY.
9. CONSTRUCT CURB RAMP WITH DETECTABLE WARNING SURFACE PER DETAIL 1/18.
10. CONSTRUCT CURB RAMP WITH DETECTABLE WARNING SURFACE PER DETAIL 2/18.
11. CONSTRUCT 6' WIDE CONCRETE VALLEY GUTTER PER COA STD DWG 2420.
12. CONSTRUCT STANDARD CURB & GUTTER PER COA STD DWG 2415-A W/ DEPRESSED GUTTER.
13. CONSTRUCT MEDIAN CURB & GUTTER W/ DEPRESSED GUTTER PER DETAIL ON SHEET 18.
14. END CONSTRUCTION OF CURB & GUTTER. MATCH EXISTING CURB HORIZONTALLY & VERTICALLY.
15. RELOCATED TRAFFIC SIGNAL PULL BOX.

HATCHING LEGEND

- PROPOSED ASPHALT PAVEMENT. SEE SHEET 18 FOR TYPICAL ROAD & PAVEMENT SECTIONS
- ASPHALT PAVEMENT REMOVAL
- CONCRETE MEDIAN PAVEMENT PER COA STD DWG 2408 & 2502

Bohannon & Huston
Courtney | 7500 Jefferson St. NE Albuquerque, NM 87109-4335
ENGINEERING • SPATIAL DATA • ADVANCED TECHNOLOGIES

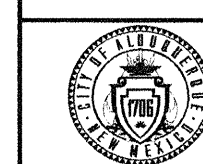


CITY OF ALBUQUERQUE
DEPARTMENT OF
MUNICIPAL DEVELOPMENT

COSTCO PUBLIC INFRASTRUCTURE
IRVING BLVD DEMOLITION & PAVING PLAN



DESIGN REVIEW COMMITTEE	CITY ENGINEER APPROVAL	MO./DAY/YR.	MO./DAY/YR.
APPROVE DATE: 12/13/2007	DESIGN REVIEW COMMITTEE		
DESIGN REVIEW COMMITTEE	DESIGN REVIEW COMMITTEE		
CITY PROJECT NO. 729082	ZONE MAP NO. B-13, B-14, C-13, D-13	SHEET 12	OF 22




OF

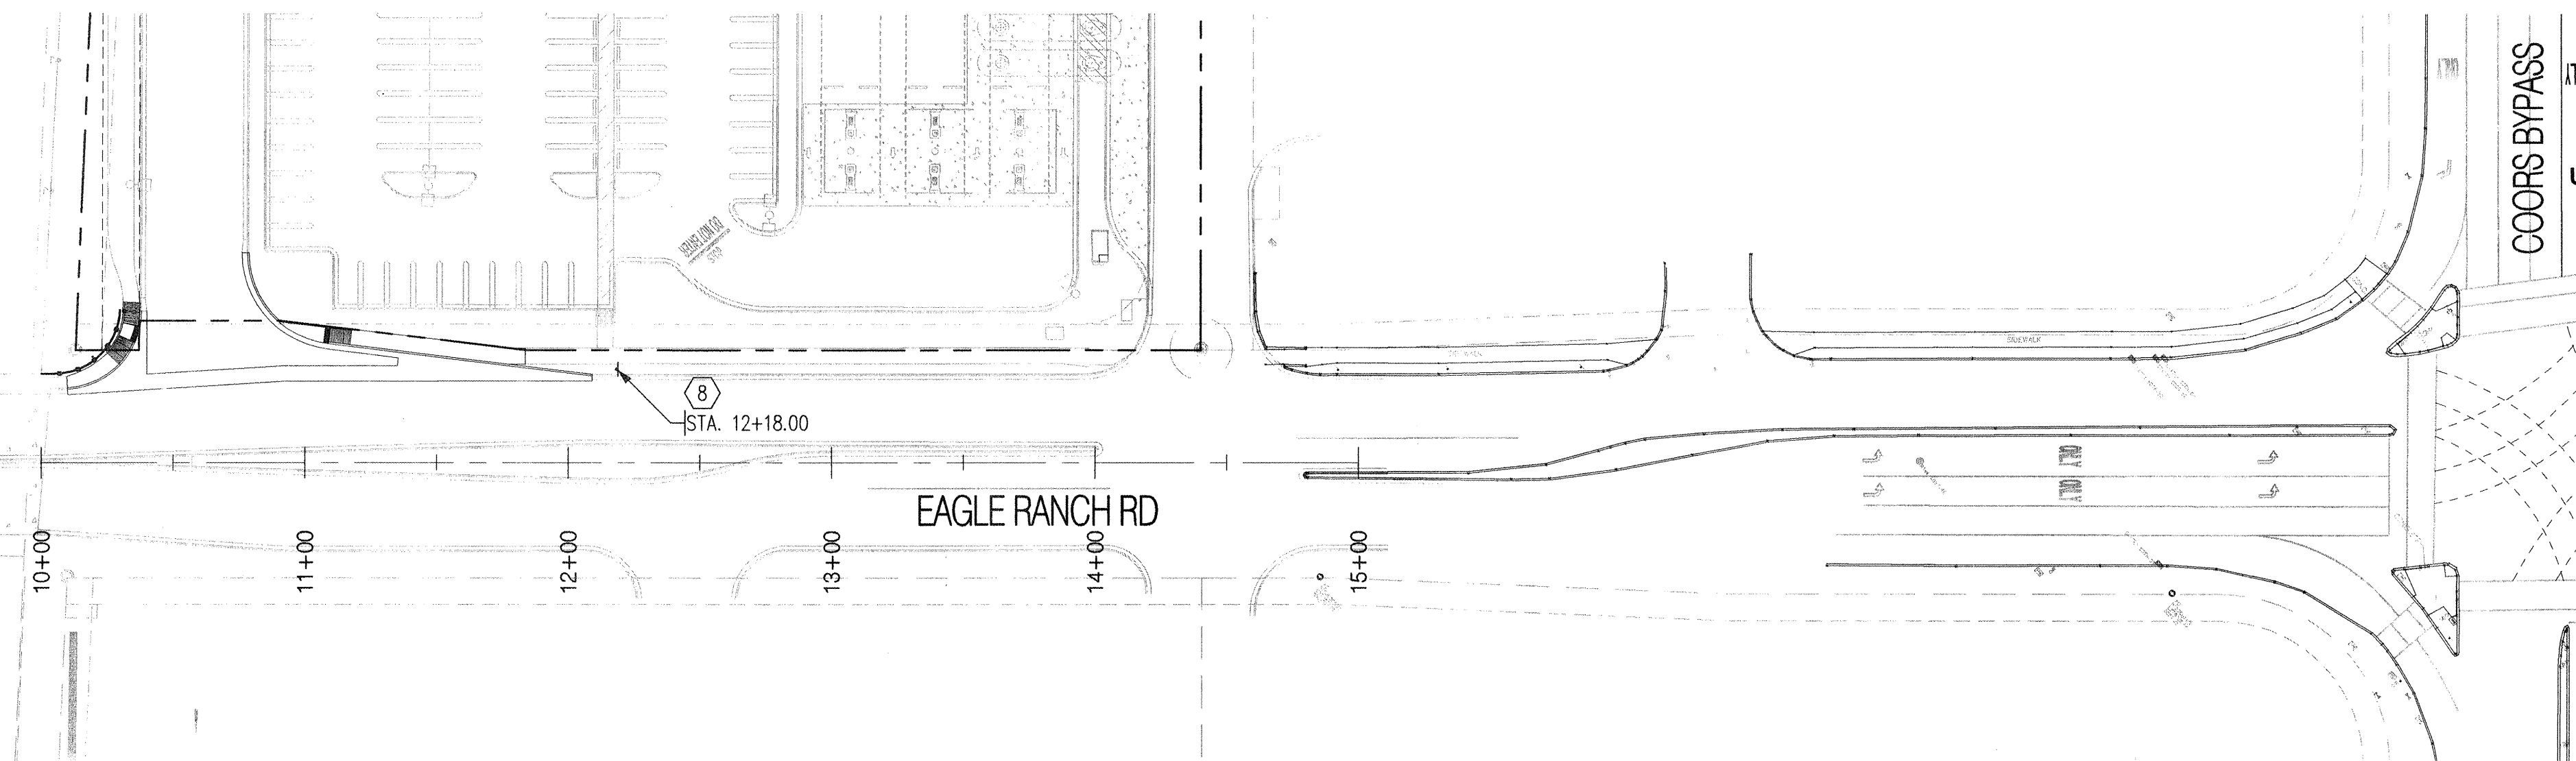

EAGLE RANCH RD
SIGNING & STRIPING PLAN

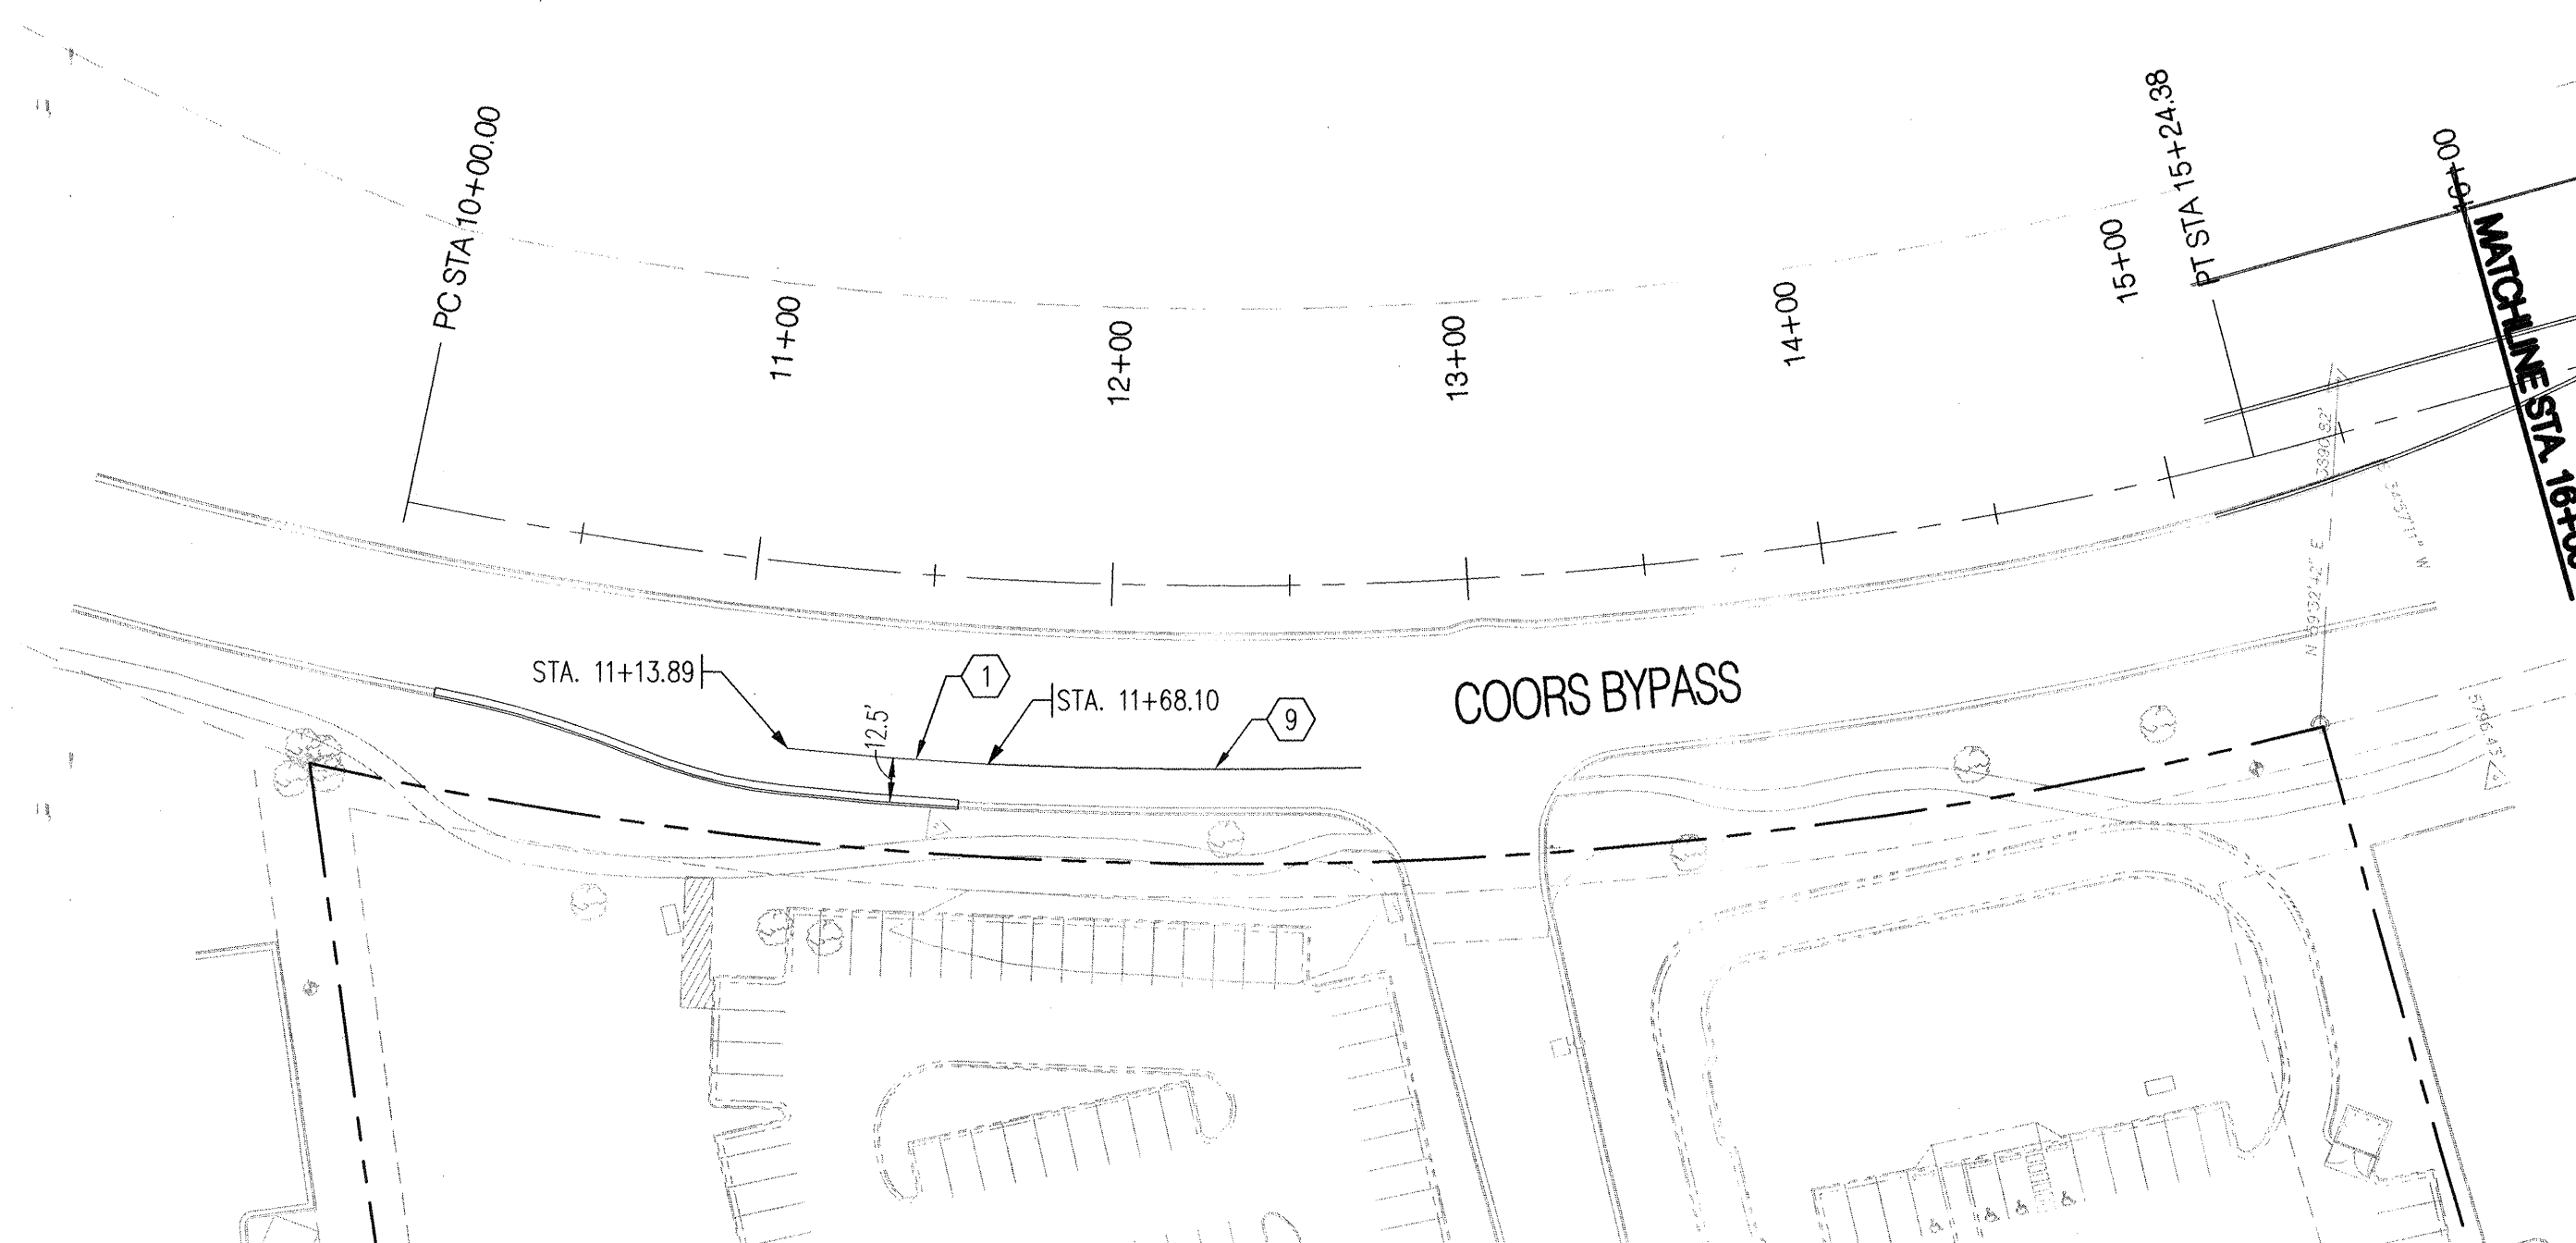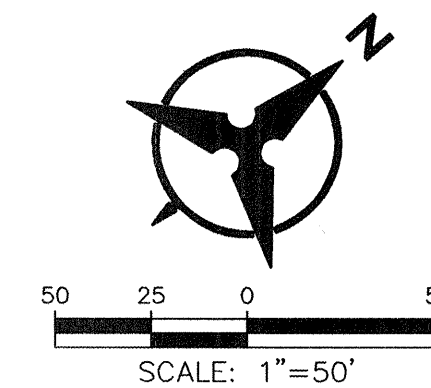

COORS BYPASS
SIGNING & STRIPING PLAN

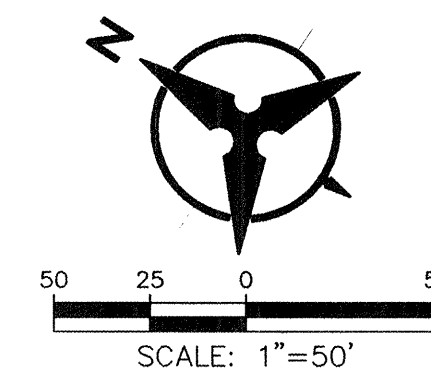

2. INSTALL NEW 4" SOLID WHITE REFLECTORIZED THERMO-PLASTIC MARKING.
2. INSTALL NEW 24" SOLID WHITE REFLECTORIZED THERMO-PLASTIC MARKING.
3. PAINT MEDIAN NOSE YELLOW.
4. INSTALL NEW RETROREFLECTIVE PREFORMED THERMO-PLASTIC PAVEMENT MARKING, LEFT TURN ARROW.
5. INSTALL NEW RETROREFLECTIVE PREFORMED THERMO-PLASTIC PAVEMENT MARKING, WORD, ONLY.
6. PAINT CURB FACE YELLOW (REFLECTORIZED PAVEMENT MARKING).
7. INSTALL NEW 4" WHITE REFLECTORIZED THERMO-PLASTIC MARKING DOTTED LINE (2' LINE, 4' SPACE).
8. RELOCATED SPEED LIMIT SIGN.
9. INSTALL NEW 4" SOLID WHITE REFLECTORIZED THERMO-PLASTIC MARKING OVER EXISTING STRIPE.
10. INSTALL NEW 4" WHITE REFLECTORIZED THERMO-PLASTIC MARKING DOTTED LINE OVER EXISTING.
11. INSTALL NEW RETROREFLECTIVE PREFORMED THERMO-PLASTIC PAVEMENT MARKING, LEFT TURN ARROW, OVER EXISTING.
12. INSTALL NEW RETROREFLECTIVE PREFORMED THERMO-PLASTIC PAVEMENT MARKING, WORD, ONLY, OVER EXISTING.
13. RELOCATED "CORRALES" SIGN.
14. RELOCATED SIGN.
15. INSTALL NEW RETROREFLECTIVE PREFORMED THERMO-PLASTIC PAVEMENT MARKING, RIGHT TURN ARROW, OVER EXISTING.
16. INSTALL NEW "IRVING BLVD" SIGN (D3-2), SEE DETAIL ON SHEET 16.
17. INSTALL NEW INTERSECTION LANE CONTROL SIGN (R3-5), SEE DETAIL ON SHEET 16. ATTACH EXISTING HOSPITAL SIGN TO NEW SIGN POST.
18. INSTALL NEW 4" YELLOW REFLECTORIZED THERMO-PLASTIC MARKING DOTTED LINE (2' LINE, 4' SPACE).
19. EXISTING "448 SOUTH" SIGN WITH NEW LEFT ARROW (M6-1L) PER DETAIL ON SHEET 16.
20. EXISTING BIKE ROUTE SIGN & ARROW TO REMAIN.
21. INSTALL NEW RETROREFLECTIVE PREFORMED THERMO-PLASTIC PAVEMENT MARKING, RIGHT TURN ARROW.
22. INSTALL NEW 4" YELLOW REFLECTORIZED THERMO-PLASTIC MARKING DOTTED LINE (2' LINE, 4' SPACE).

[illegible]


Bohannon ▲ Huston INC.
Courtyard I 7500 Jefferson St. NE Albuquerque, NM 87109-4335
ENGINEERING ▲ SPATIAL DATA ▲ ADVANCED TECHNOLOGIES

 **CITY OF ALBUQUERQUE**
DEPARTMENT OF
MUNICIPAL DEVELOPMENT


COSTCO PUBLIC INFRASTRUCTURE
EAGLE RANCH RD & COORS BYPASS SIGNING & STRIPING PLAN

DESIGN REVIEW COMMITTEE	CITY ENGINEER APPROVAL	LAST DESIGN UPDATE	MO./DAY/YR.	MO./DAY/YR.
DESIGN REVIEW COMMITTEE	DESIGN REVIEW COMMITTEE			

CITY PROJECT NO.	729082	ZONE MAP NO.	B-13, B-14, C-13, D-13	SHEET	14	OF	22
------------------	--------	--------------	------------------------	-------	----	----	----

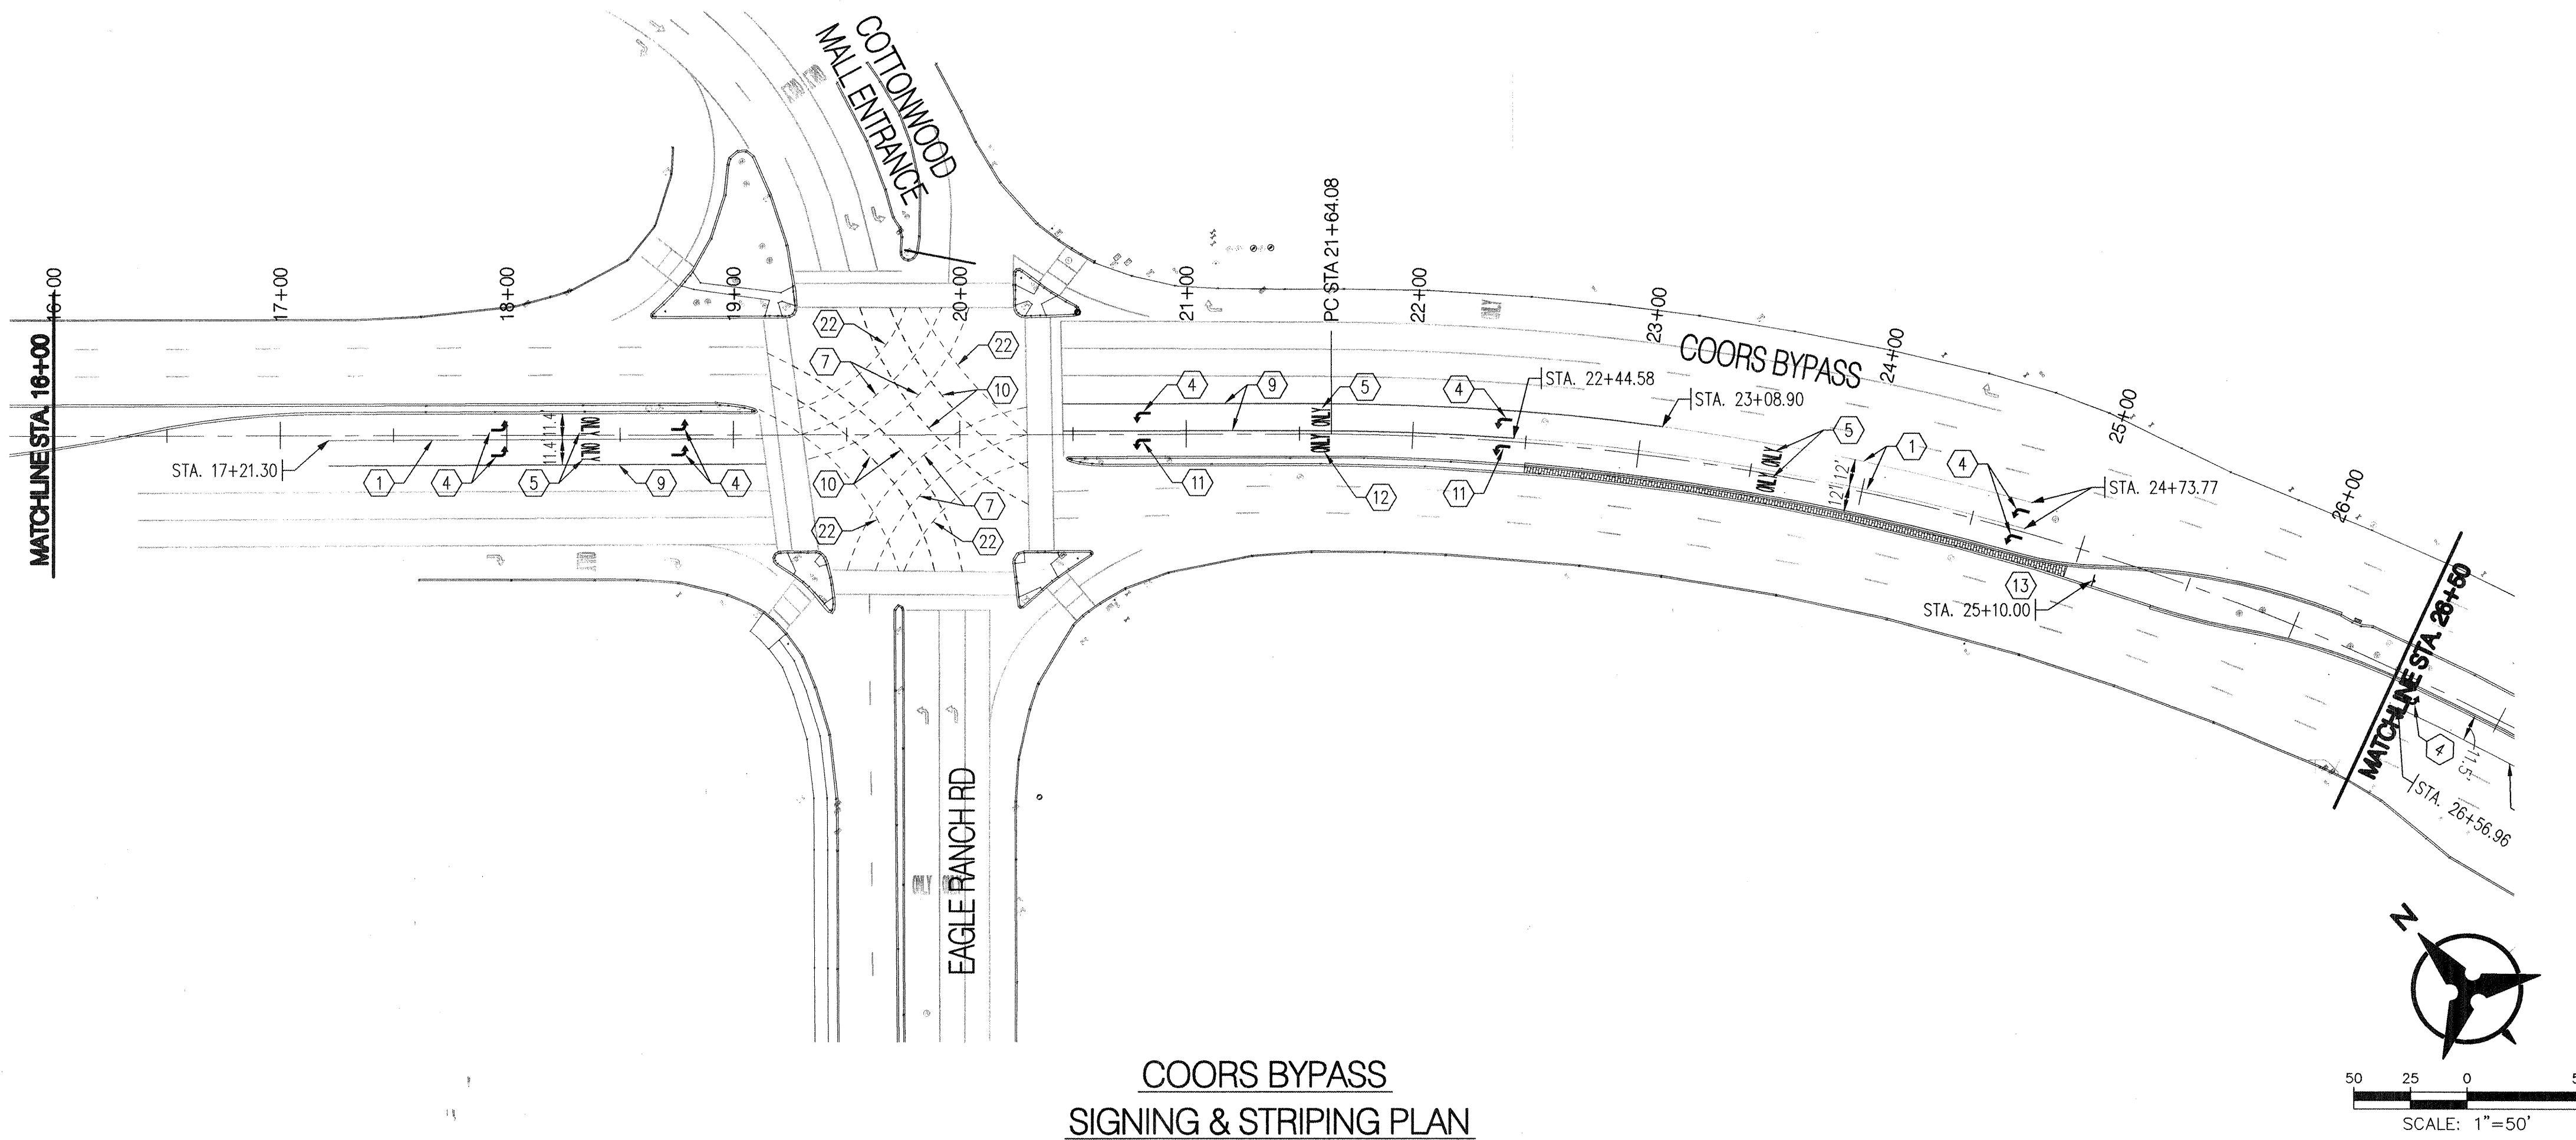

COORS BYPASS
SIGNING & STRIPING PLAN

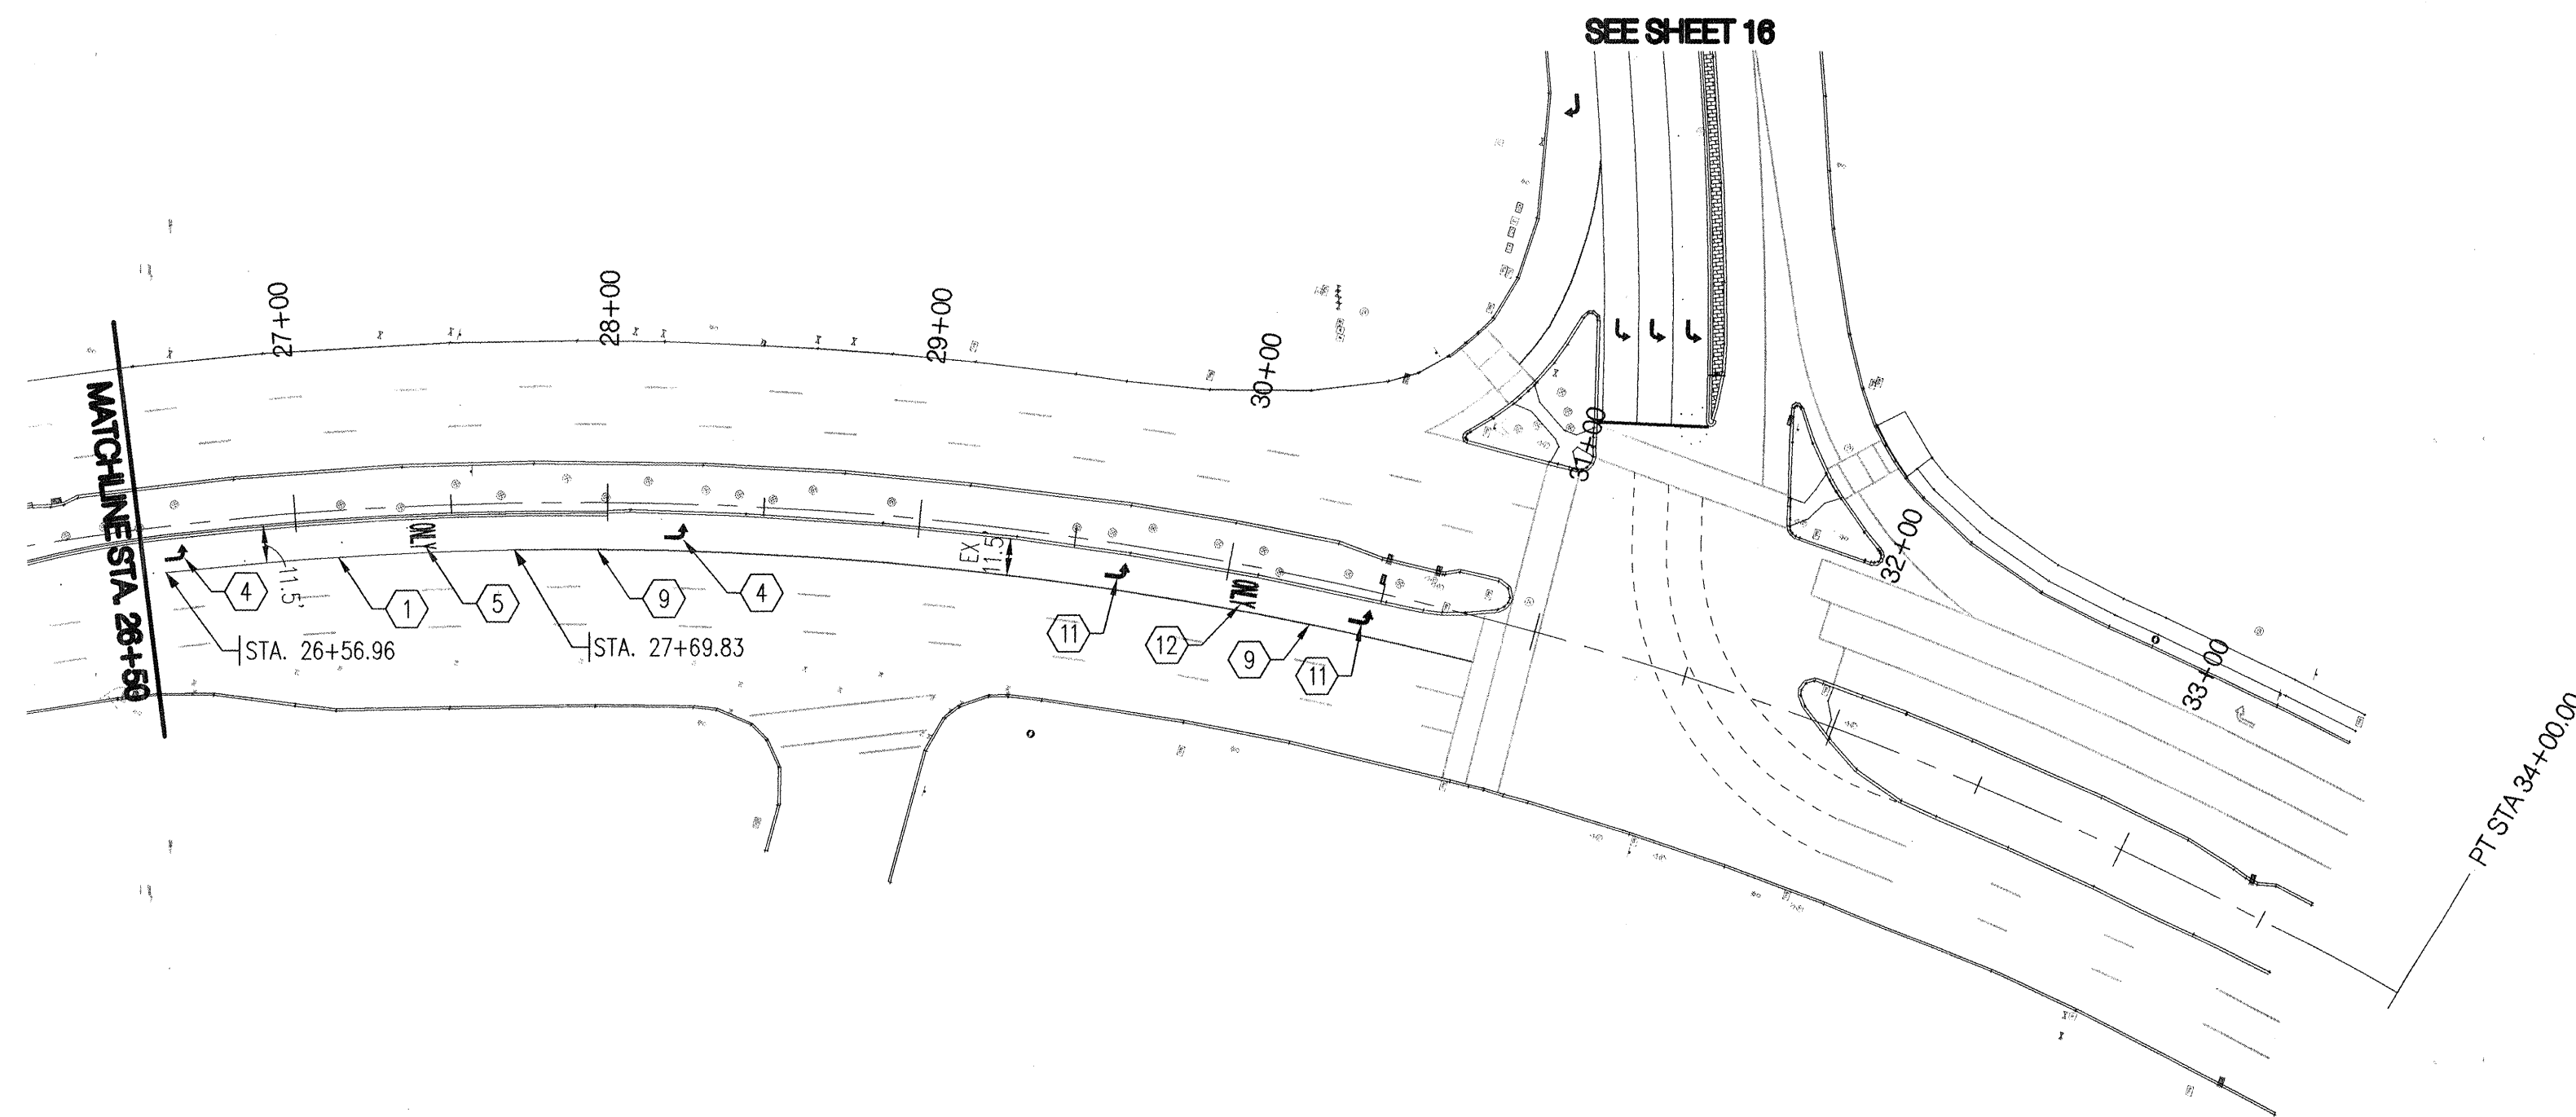


COORS BYPASS
SIGNING & STRIPING PLAN

NOTE: NOT ALL KEYED NOTES MAY APPLY TO THIS SHEET.

SIGNING & STRIPING KEYED NOTES

1. INSTALL NEW 4" SOLID WHITE REFLECTORIZED THERMO-PLASTIC MARKING.
2. INSTALL NEW 24" SOLID WHITE REFLECTORIZED THERMO-PLASTIC MARKING.
3. PAINT MEDIAN NOSE YELLOW.
4. INSTALL NEW RETROFLECTIVE PREFORMED THERMO-PLASTIC PAVEMENT MARKING, LEFT TURN ARROW.
5. INSTALL NEW RETROFLECTIVE PREFORMED THERMO-PLASTIC PAVEMENT MARKING, WORD, ONLY.
6. PAINT CURB FACE YELLOW (REFLECTORIZED PAVEMENT MARKING).
7. INSTALL NEW 4" WHITE REFLECTORIZED THERMO-PLASTIC MARKING DOTTED LINE (2' LINE, 4' SPACE).
8. RELOCATED SPEED LIMIT SIGN.
9. INSTALL NEW 4" SOLID WHITE REFLECTORIZED THERMO-PLASTIC MARKING OVER EXISTING STRIPE.
10. INSTALL NEW 4" WHITE REFLECTORIZED THERMO-PLASTIC MARKING DOTTED LINE OVER EXISTING.
11. INSTALL NEW RETROFLECTIVE PREFORMED THERMO-PLASTIC PAVEMENT MARKING, LEFT TURN ARROW, OVER EXISTING.
12. INSTALL NEW RETROFLECTIVE PREFORMED THERMO-PLASTIC PAVEMENT MARKING, WORD, ONLY, OVER EXISTING.
13. RELOCATED "CORRALES" SIGN.
14. RELOCATED SIGN.
15. INSTALL NEW RETROFLECTIVE PREFORMED THERMO-PLASTIC PAVEMENT MARKING, RIGHT TURN ARROW, OVER EXISTING.
16. INSTALL NEW "IRVING BLVD" SIGN (D3-2), SEE DETAIL ON SHEET 16.
17. INSTALL NEW INTERSECTION LANE CONTROL SIGN (R3-5), SEE DETAIL ON SHEET 16. ATTACH EXISTING HOSPITAL SIGN TO NEW SIGN POST.
18. INSTALL NEW 4" YELLOW REFLECTORIZED THERMO-PLASTIC MARKING DOTTED LINE (2' LINE, 4' SPACE).
19. EXISTING "448 SOUTH" SIGN WITH NEW LEFT ARROW (M6-1L) PER DETAIL ON SHEET 16.
20. EXISTING BIKE ROUTE SIGN & ARROW TO REMAIN.
21. INSTALL NEW RETROFLECTIVE PREFORMED THERMO-PLASTIC PAVEMENT MARKING, RIGHT TURN ARROW.
22. INSTALL NEW 4" YELLOW REFLECTORIZED THERMO-PLASTIC MARKING DOTTED LINE (2' LINE, 4' SPACE).

AS-BUILT INFORMATION		BENCH MARKS		SURVEY INFORMATION		ENGINEER'S SEAL		REVISIONS		DESIGN		DATE	
CONTRACTOR	Bohannon & Huston	DATE	1-2008	NO.	BY	DATE	DATE	NO.	DATE	BY	DATE	NO.	DATE
INSPECTOR	Robinson	DATE	1-2008	NO.	BY	DATE	DATE	NO.	DATE	BY	DATE	NO.	DATE
ACCEPTANCE BY	Robinson	DATE	1-2008	NO.	BY	DATE	DATE	NO.	DATE	BY	DATE	NO.	DATE
VERIFICATION BY	Robinson	DATE	1-2008	NO.	BY	DATE	DATE	NO.	DATE	BY	DATE	NO.	DATE
DESIGNED BY	B.H.T.	DATE	1-2008	NO.	BY	DATE	DATE	NO.	DATE	BY	DATE	NO.	DATE
DRAWN BY	B.H.T.	DATE	1-2008	NO.	BY	DATE	DATE	NO.	DATE	BY	DATE	NO.	DATE
CHECKED BY	B.H.T.	DATE	1-2008	NO.	BY	DATE	DATE	NO.	DATE	BY	DATE	NO.	DATE
RECORDED BY	B.H.T.	DATE	1-2008	NO.	BY	DATE	DATE	NO.	DATE	BY	DATE	NO.	DATE
ELEVATION	5065.637 FT. (NAD 1929)	DATE	1-2008	NO.	BY	DATE	DATE	NO.	DATE	BY	DATE	NO.	DATE

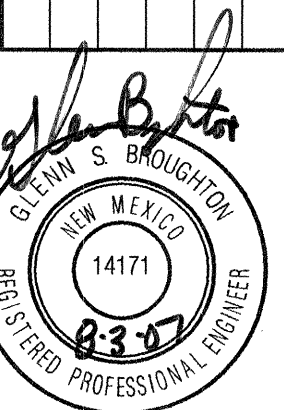


Bohannon & Huston
 Courtyard 1 7600 Jefferson St. NE Albuquerque, NM 87109-4336
 ENGINEERING • SPATIAL DATA • ADVANCED TECHNOLOGIES

CITY OF ALBUQUERQUE
 DEPARTMENT OF
 MUNICIPAL DEVELOPMENT


COSTCO PUBLIC INFRASTRUCTURE
 COORS BYPASS SIGNING & STRIPING PLAN

DESIGN REVIEW COMMITTEE	CITY ENGINEER APPROVAL	MO./DAY/YR.	MO./DAY/YR.
APPROVED	APPROVED		
DESIGN REVIEW COMMITTEE	DESIGN REVIEW COMMITTEE		
LAST DESIGN UPDATE			

CITY PROJECT NO.	729082	ZONE MAP NO.	B-13, B-14, C-13, D-13	SHEET	15	OF	22
------------------	--------	--------------	------------------------	-------	----	----	----

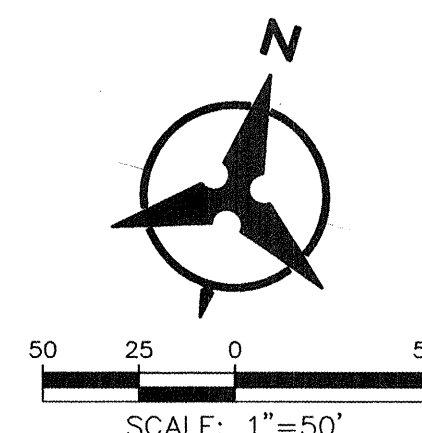

COORS BLVD
SIGNING & STRIPING PLAN

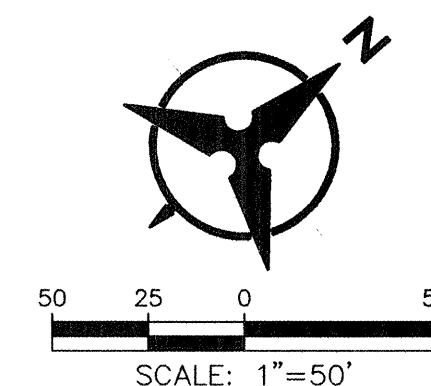

SIGNING & STRIPING KEYED NOTES

1. INSTALL NEW 4" SOLID WHITE REFLECTORIZED THERMO-PLASTIC MARKING.
2. INSTALL NEW 24" SOLID WHITE REFLECTORIZED THERMO-PLASTIC MARKING.
3. PAINT MEDIAN NOSE YELLOW.
4. INSTALL NEW RETROREFLECTIVE PREFORMED THERMO-PLASTIC PAVEMENT MARKING, LEFT TURN ARROW.
5. INSTALL NEW RETROREFLECTIVE PREFORMED THERMO-PLASTIC PAVEMENT MARKING, WORD, ONLY.
6. PAINT CURB FACE YELLOW (REFLECTORIZED PAVEMENT MARKING).
7. INSTALL NEW 4" WHITE REFLECTORIZED THERMO-PLASTIC MARKING DOTTED LINE (2' LINE, 4' SPACE).
8. RELOCATED SPEED LIMIT SIGN.
9. INSTALL NEW 4" SOLID WHITE REFLECTORIZED THERMO-PLASTIC MARKING OVER EXISTING STRIPE.
10. INSTALL NEW 4" WHITE REFLECTORIZED THERMO-PLASTIC MARKING DOTTED LINE OVER EXISTING.
11. INSTALL NEW RETROREFLECTIVE PREFORMED THERMO-PLASTIC PAVEMENT MARKING, LEFT TURN ARROW, OVER EXISTING.
12. INSTALL NEW RETROREFLECTIVE PREFORMED THERMO-PLASTIC PAVEMENT MARKING, WORD, ONLY, OVER EXISTING.
13. RELOCATED "CORRALES" SIGN.
14. RELOCATED SIGN.
15. INSTALL NEW RETROREFLECTIVE PREFORMED THERMO-PLASTIC PAVEMENT MARKING, RIGHT TURN ARROW, OVER EXISTING.
16. INSTALL NEW "IRVING BLVD" SIGN (D3-2), SEE DETAIL ON SHEET 16.
17. INSTALL NEW INTERSECTION LANE CONTROL SIGN (R3-5), SEE DETAIL ON SHEET 16. ATTACH EXISTING HOSPITAL SIGN TO NEW SIGN POST.
18. INSTALL NEW 4" YELLOW REFLECTORIZED THERMO-PLASTIC MARKING DOTTED LINE (2' LINE, 4' SPACE).
19. EXISTING "448 SOUTH" SIGN WITH NEW LEFT ARROW (M6-1L) PER DETAIL ON SHEET 16.
20. EXISTING BIKE ROUTE SIGN & ARROW TO REMAIN.
21. INSTALL NEW RETROREFLECTIVE PREFORMED THERMO-PLASTIC PAVEMENT MARKING, RIGHT TURN ARROW.
22. INSTALL NEW 4" YELLOW REFLECTORIZED THERMO-PLASTIC MARKING DOTTED LINE (2' LINE, 4' SPACE).

																																																																																																																																																																																																																																																																																																																																																																																																																																																																																																																																																																																																																																																																																																																																																																																																																																																																																																																																																																																																																																																																																																																																																																																																																																																																																																																																																																																																																																				</
--	--	----

Bohannon ▲ Huston, INC.


Courtyard I 7500 Jefferson St. NE Albuquerque, NM 87109-4335
ENGINEERING ▴ SPATIAL DATA ▴ ADVANCED TECHNOLOGIES





CITY OF ALBUQUERQUE
DEPARTMENT OF
MUNICIPAL DEVELOPMENT

COSTCO PUBLIC INFRASTRUCTURE
COORS BLVD SIGNING & STRIPING PLAN


DESIGN REVIEW COMMITTEE		CITY ENGINEER APPROVAL		LAST DESIGN UPDATE	MO./DAY/YR.	MO./DAY/YR.
						
CITY PROJECT NO.		ZONE MAP NO.		SHEET		OF
729082		B-13, B-14, C-13, D-13		16		22

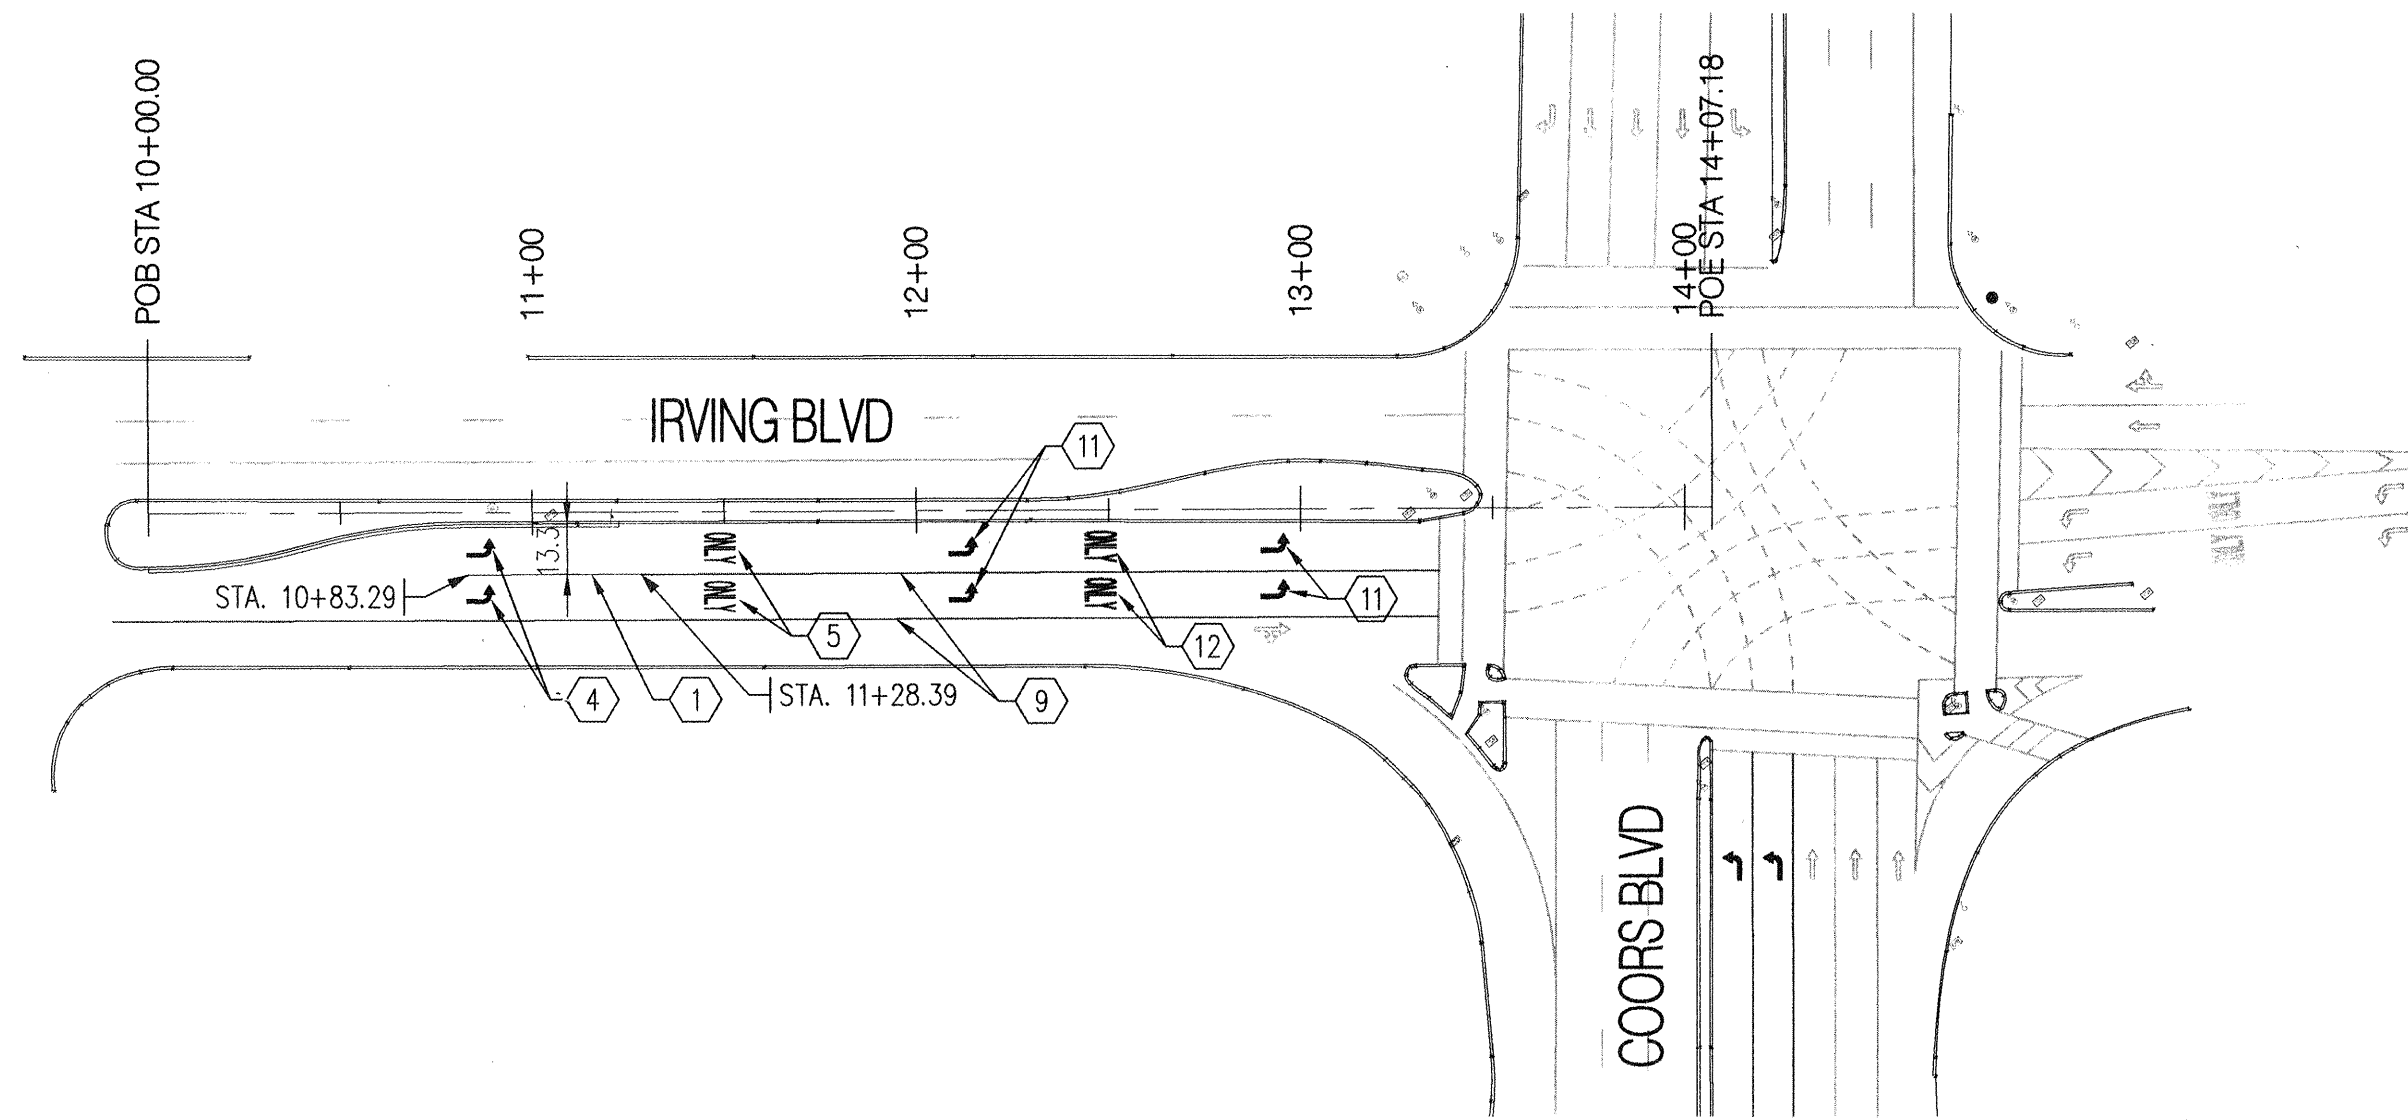

IRVING BLVD
SIGNING & STRIPING PLAN

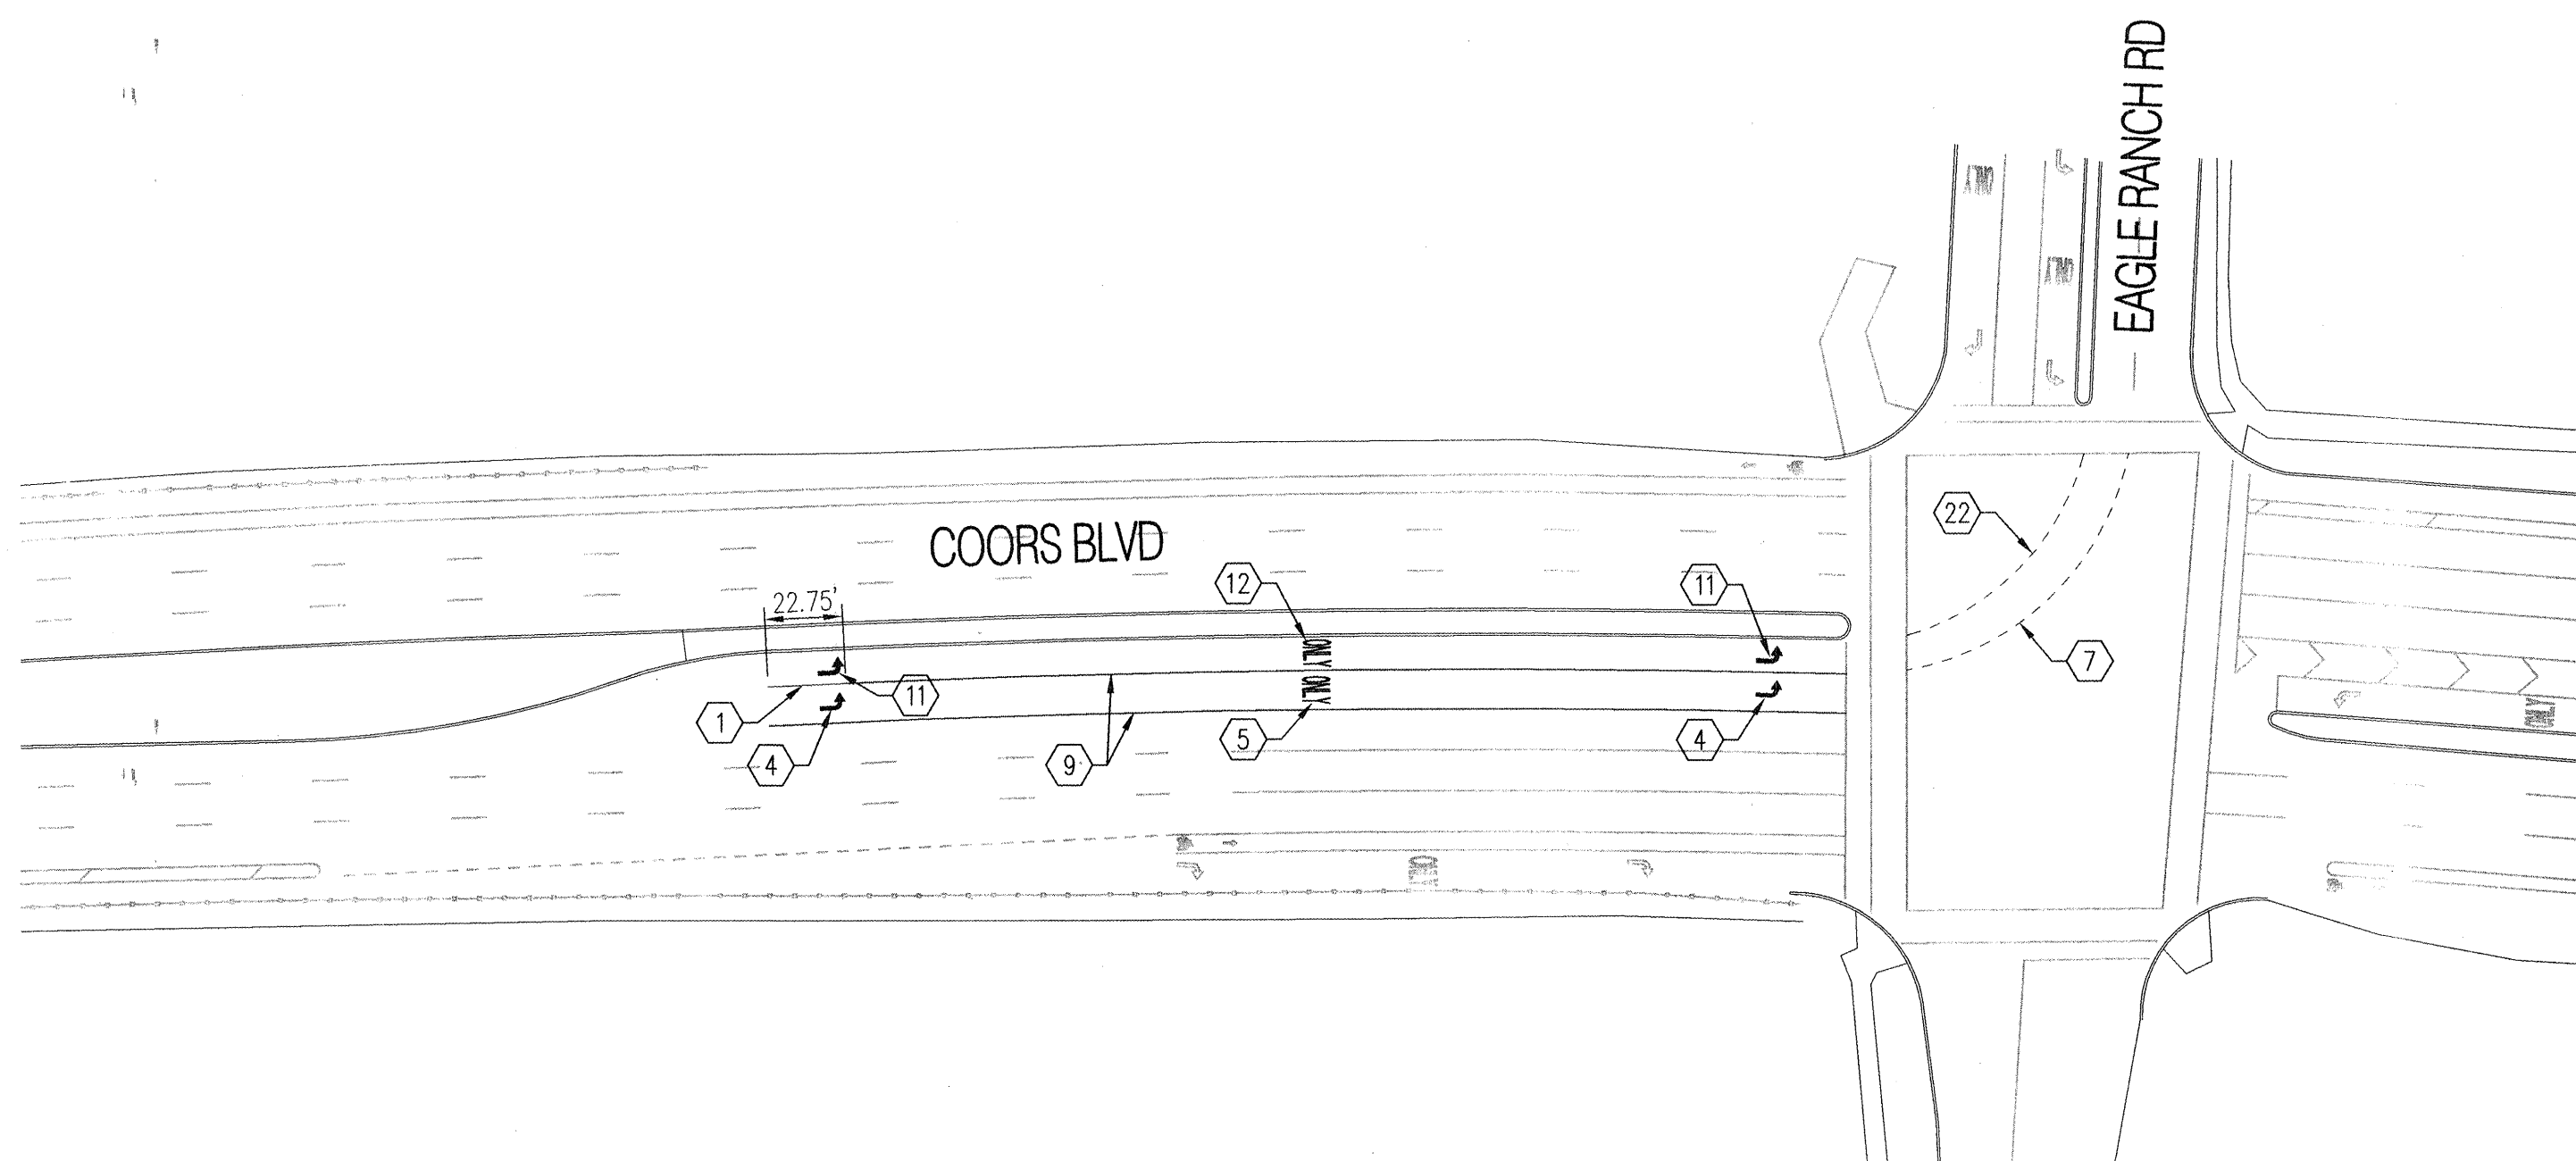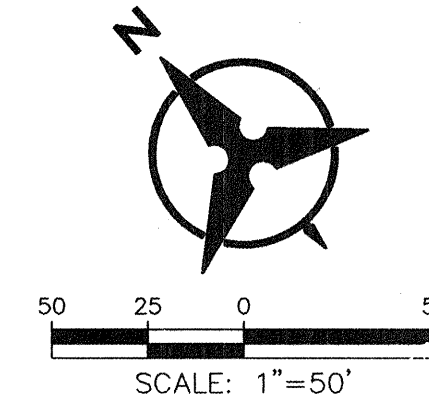

COORS BLVD
SIGNING & STRIPING PLAN

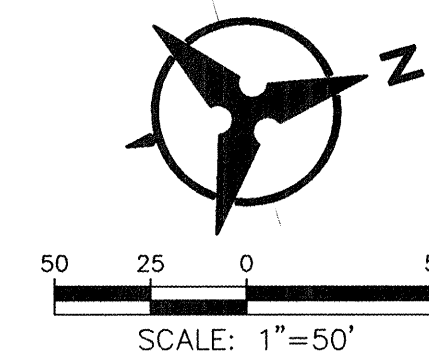

NOTE: NOT ALL KEYED NOTES MAY APPLY TO THIS SHEET.

SIGNING & STRIPING KEYED NOTES

1. INSTALL NEW 4" SOLID WHITE REFLECTORIZED THERMO-PLASTIC MARKING.
2. INSTALL NEW 24" SOLID WHITE REFLECTORIZED THERMO-PLASTIC MARKING.
3. PAINT MEDIAN NOSE YELLOW.
4. INSTALL NEW RETROFLECTIVE PREFORMED THERMO-PLASTIC PAVEMENT MARKING, LEFT TURN ARROW.
5. INSTALL NEW RETROFLECTIVE PREFORMED THERMO-PLASTIC PAVEMENT MARKING, WORD, ONLY.
6. PAINT CURB FACE YELLOW (REFLECTORIZED PAVEMENT MARKING).
7. INSTALL NEW 4" WHITE REFLECTORIZED THERMO-PLASTIC MARKING DOTTED LINE (2' LINE, 4' SPACE).
8. RELOCATED SPEED LIMIT SIGN.
9. INSTALL NEW 4" SOLID WHITE REFLECTORIZED THERMO-PLASTIC MARKING OVER EXISTING STRIPE.
10. INSTALL NEW 4" WHITE REFLECTORIZED THERMO-PLASTIC MARKING DOTTED LINE OVER EXISTING.
11. INSTALL NEW RETROFLECTIVE PREFORMED THERMO-PLASTIC PAVEMENT MARKING, LEFT TURN ARROW, OVER EXISTING.
12. INSTALL NEW RETROFLECTIVE PREFORMED THERMO-PLASTIC PAVEMENT MARKING, WORD, ONLY, OVER EXISTING.
13. RELOCATED "CORRALES" SIGN.
14. RELOCATED SIGN.
15. INSTALL NEW RETROFLECTIVE PREFORMED THERMO-PLASTIC PAVEMENT MARKING, RIGHT TURN ARROW, OVER EXISTING.
16. INSTALL NEW "IRVING BLVD" SIGN (D3-2), SEE DETAIL ON SHEET 16.
17. INSTALL NEW INTERSECTION LANE CONTROL SIGN (R3-5), SEE DETAIL ON SHEET 16. ATTACH EXISTING HOSPITAL SIGN TO NEW SIGN POST.
18. INSTALL NEW 4" YELLOW REFLECTORIZED THERMO-PLASTIC MARKING DOTTED LINE (2' LINE, 4' SPACE).
19. EXISTING "448 SOUTH" SIGN WITH NEW LEFT ARROW (M6-1L) PER DETAIL ON SHEET 16.
20. EXISTING BIKE ROUTE SIGN & ARROW TO REMAIN.
21. INSTALL NEW RETROFLECTIVE PREFORMED THERMO-PLASTIC PAVEMENT MARKING, RIGHT TURN ARROW.
22. INSTALL NEW 4" YELLOW REFLECTORIZED THERMO-PLASTIC MARKING DOTTED LINE (2' LINE, 4' SPACE).

AS-BUILT INFORMATION		BENCH MARKS		SURVEY INFORMATION		ENGINEER'S SEAL	
CONTRACTOR	Robinson Construction	NO.	DATE	NO.	DATE		
INSPECTOR	Survey-Tek	NO.	DATE	NO.	DATE		
ACCEPTANCE BY	BHT	NO.	DATE	NO.	DATE	REMARKS	BY
VERIFICATION BY	Robinson	NO.	DATE	NO.	DATE	REVISIONS	BY
DRAWN BY	BHT	NO.	DATE	NO.	DATE	DESIGN	BY
CHECKED BY	BHT	NO.	DATE	NO.	DATE	DESIGNED BY	DATE
RECORDED BY		NO.	DATE	NO.	DATE	DRAWN BY	DATE
		NO.	DATE	NO.	DATE	CHECKED BY	DATE

Bohannon & Huston
 Courtyard | 7800 Jefferson St. NE Albuquerque, NM 87109-4395
 ENGINEERING • SPATIAL DATA • ADVANCED TECHNOLOGIES


CITY OF ALBUQUERQUE
 DEPARTMENT OF
 MUNICIPAL DEVELOPMENT

COSTCO PUBLIC INFRASTRUCTURE
 IRVING BLVD & COORS BLVD SIGNING & STRIPING PLAN


DESIGN REVIEW COMMITTEE	CITY ENGINEER APPROVAL	MO./DAY/YR.	MO./DAY/YR.
APPROVED DATE: 8/13/07 REVIEW BY: [Signature]	APPROVED DATE: 8/13/07 DESIGNED BY: [Signature]		
LAST DESIGN UPDATE			

CITY PROJECT NO.	729082	ZONE MAP NO.	B-13, B-14, C-13, D-13	SHEET	17	OF	22
------------------	--------	--------------	------------------------	-------	----	----	----


SCANNED BY
PLANNING

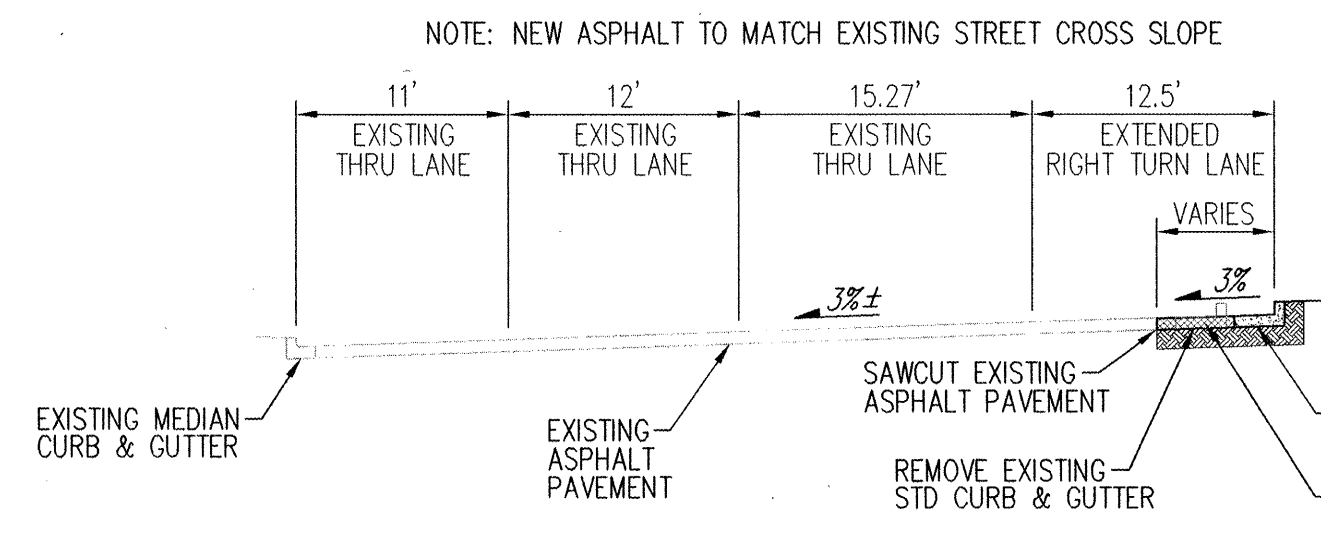


A PAVEMENT SECTION - COORS BYPASS
NTS

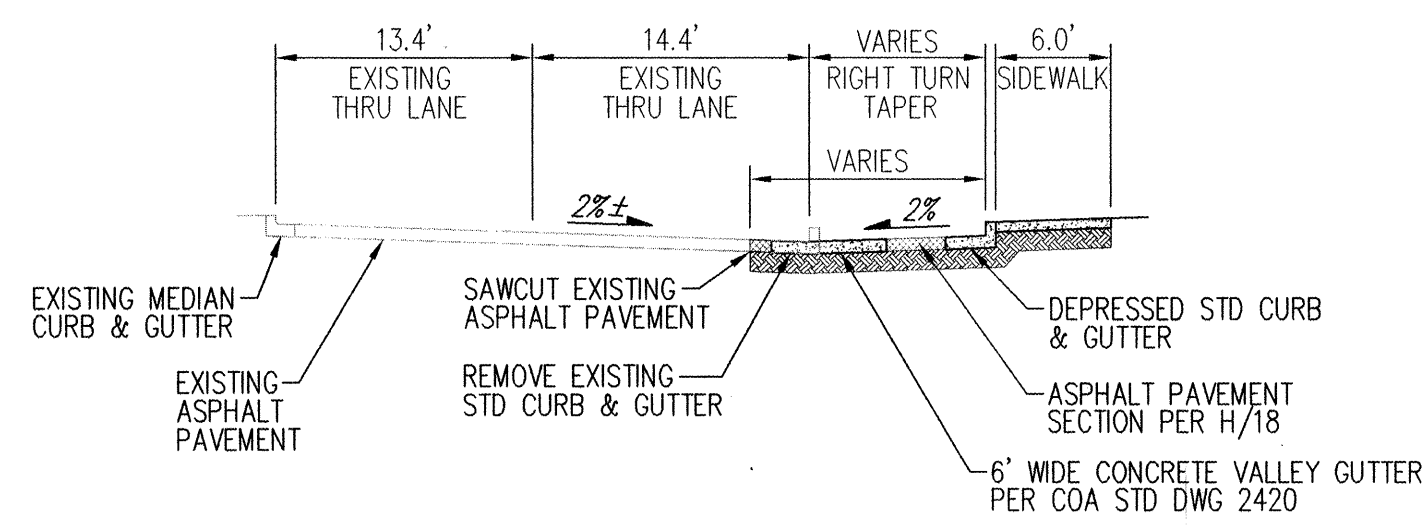


B PAVEMENT SECTION - EAGLE RANCH ROAD
NTS

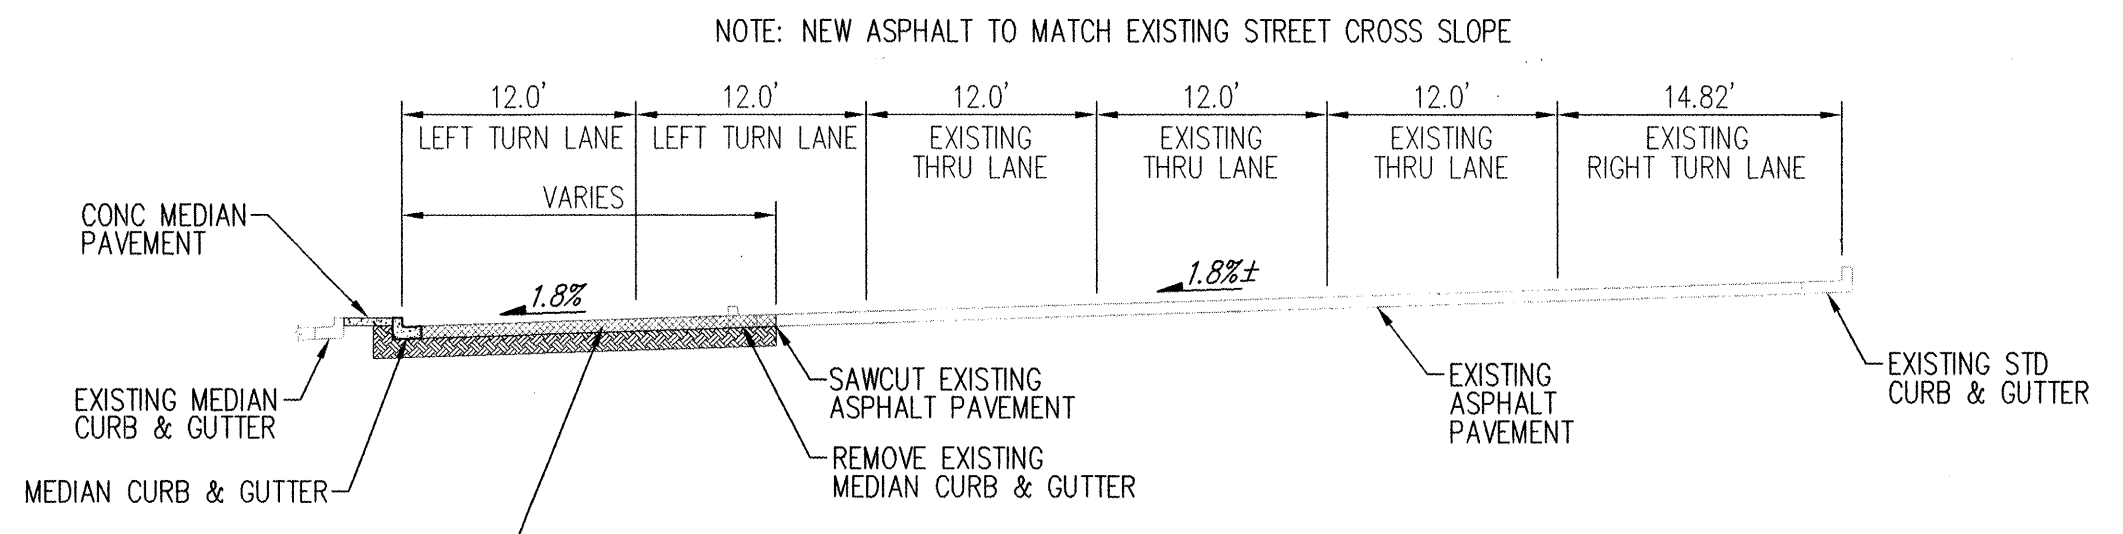


C PAVEMENT SECTION - COORS BYPASS
NTS

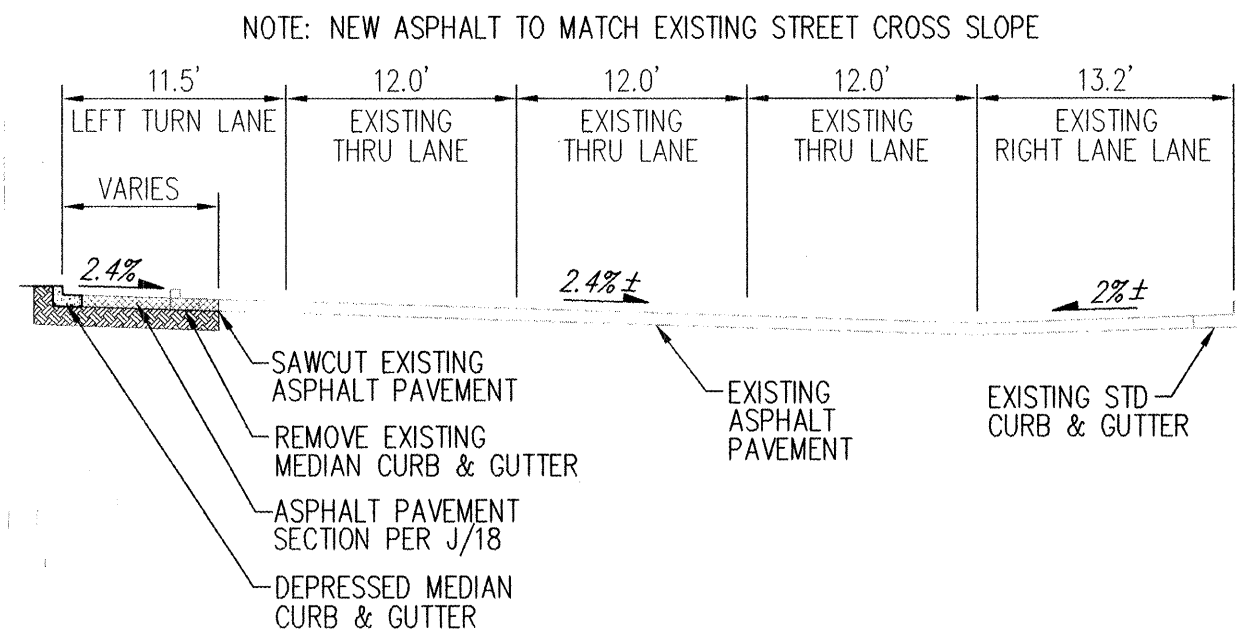


D PAVEMENT SECTION - COORS BYPASS
NTS

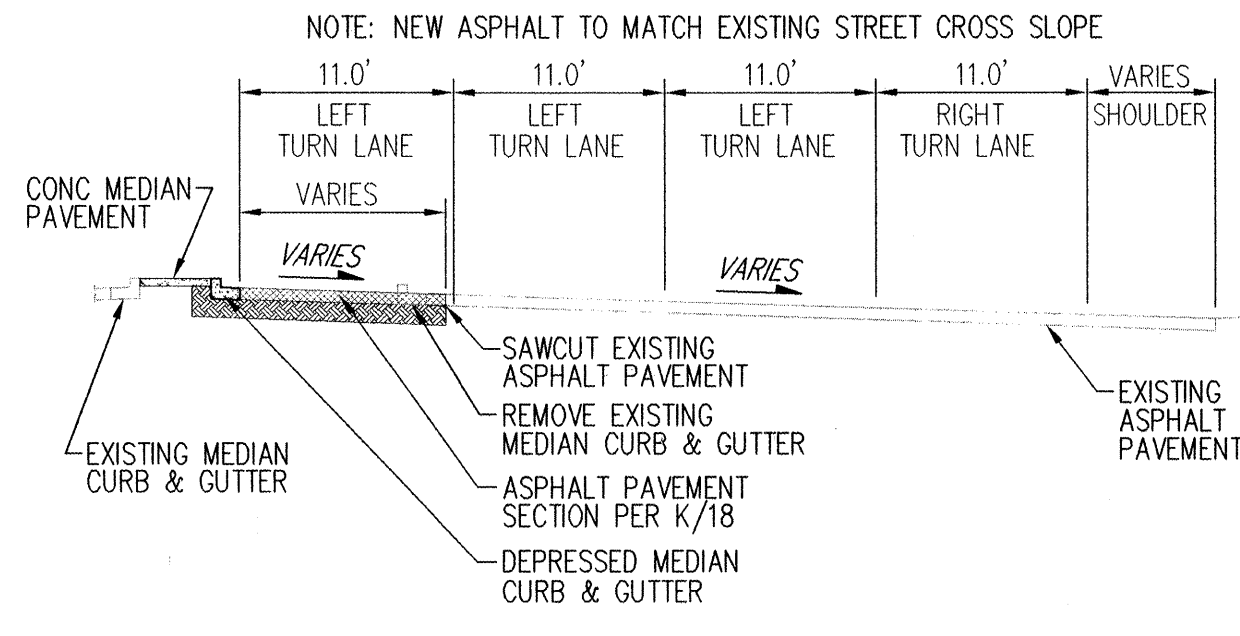


E PAVEMENT SECTION - COORS BLVD
NTS

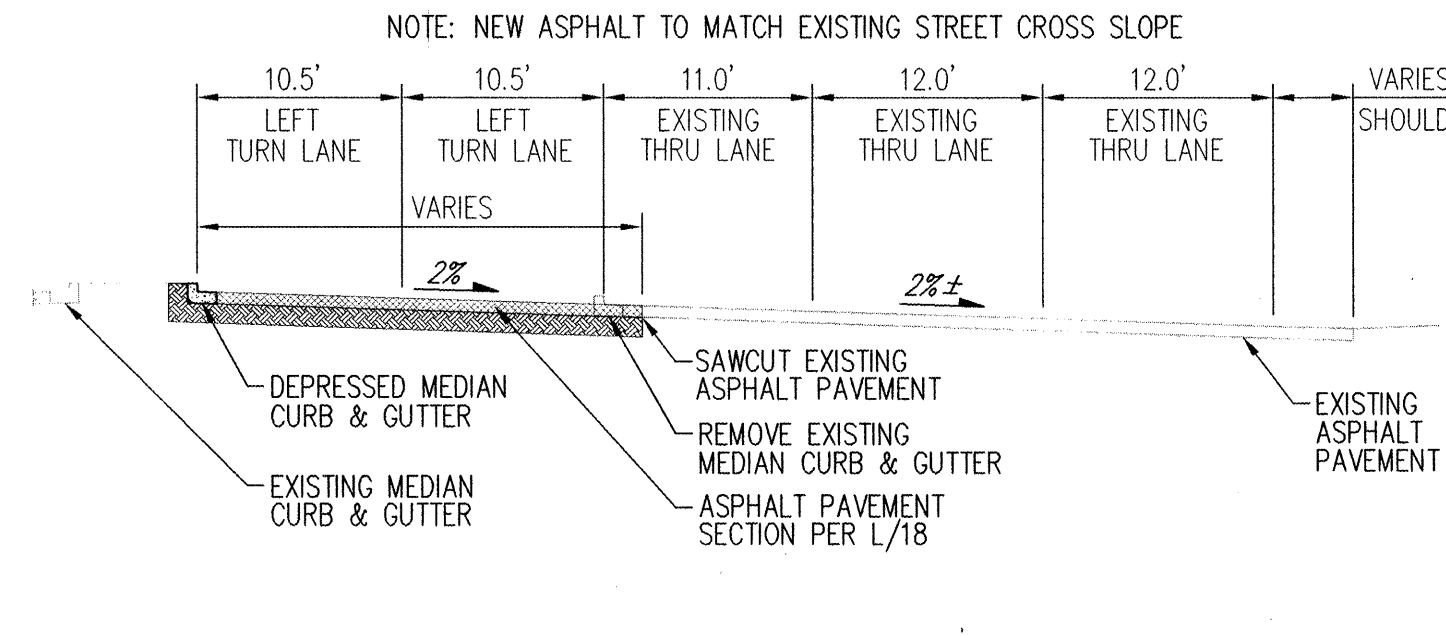


F PAVEMENT SECTION - COORS BLVD
NTS

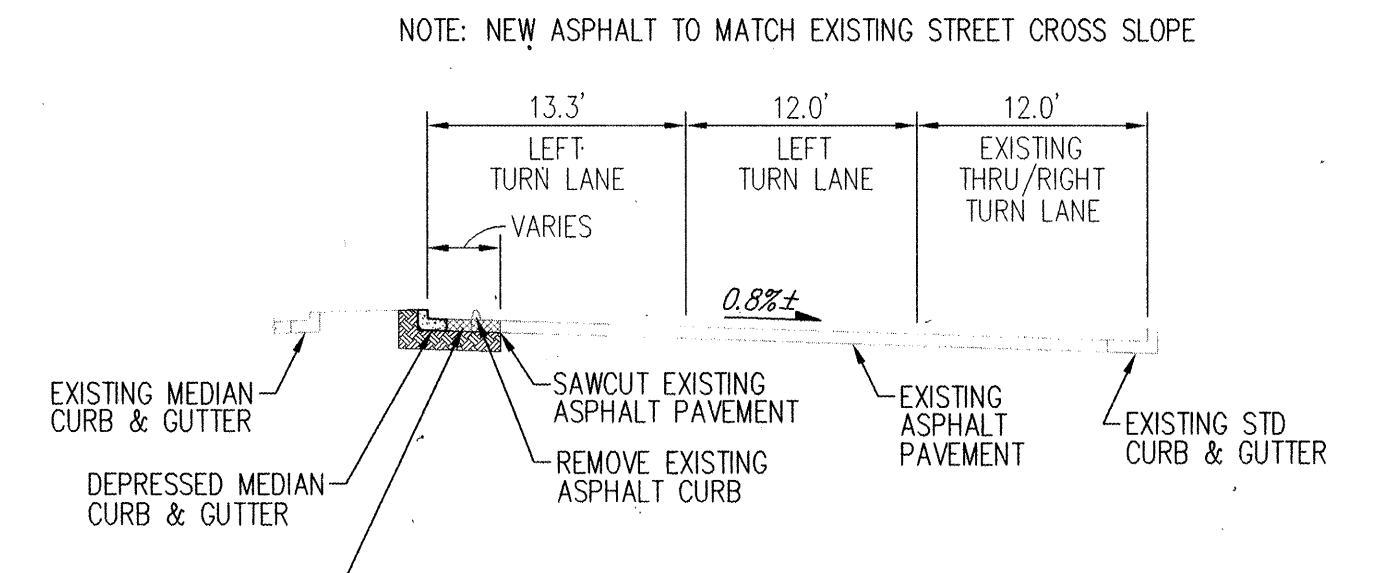


G PAVEMENT SECTION - IRVING BLVD
NTS

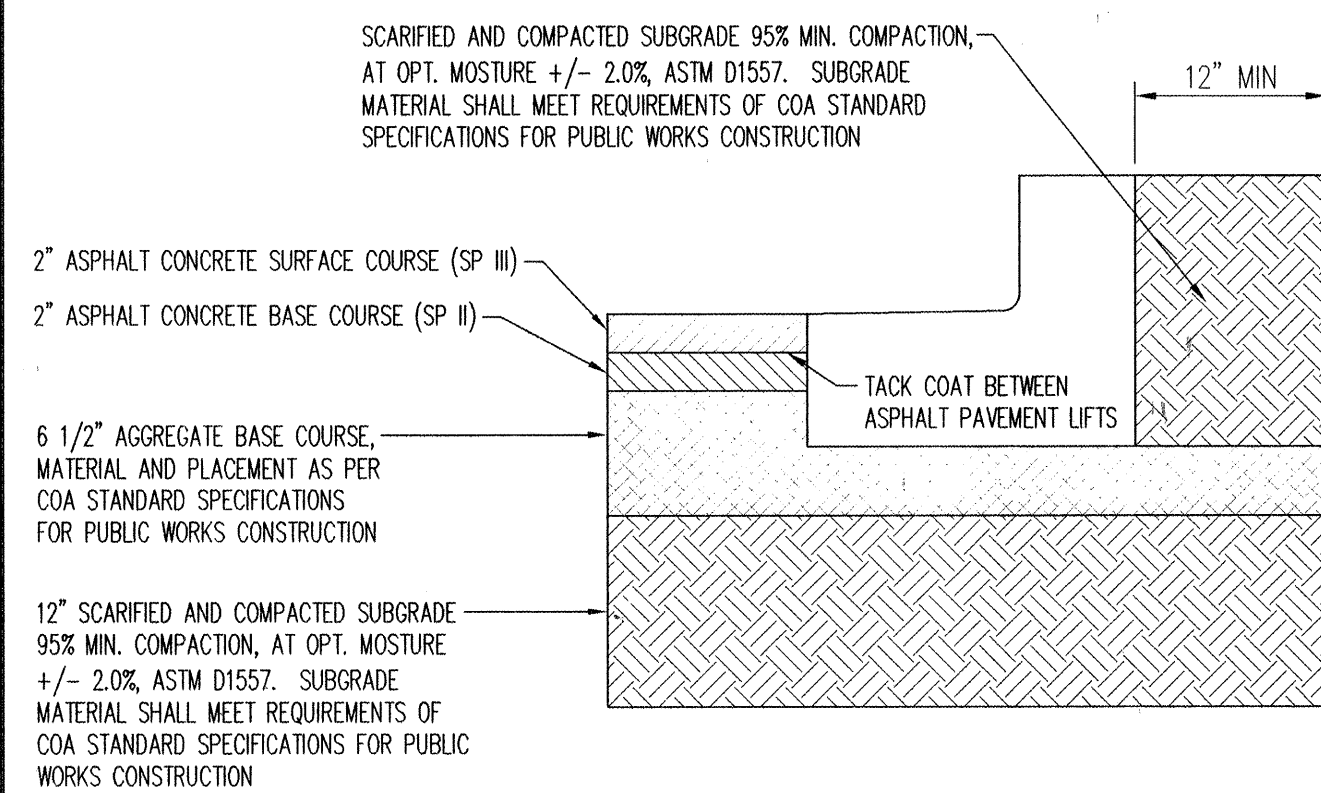


NOTE: CONTRACTOR TO TEST SUBGRADE R-VALUE PRIOR TO CONSTRUCTION.
* IN THE EVENT THE R-VALUE IS LESS THAN 50, REMOVE 2" OF SUB-GRADE MATERIAL AND IMPORT MATERIAL WITH R VALUE GREATER THAN 50 OR CONTACT THE ENGINEER IMMEDIATELY SO THE PAVEMENT SECTION CAN BE MODIFIED.

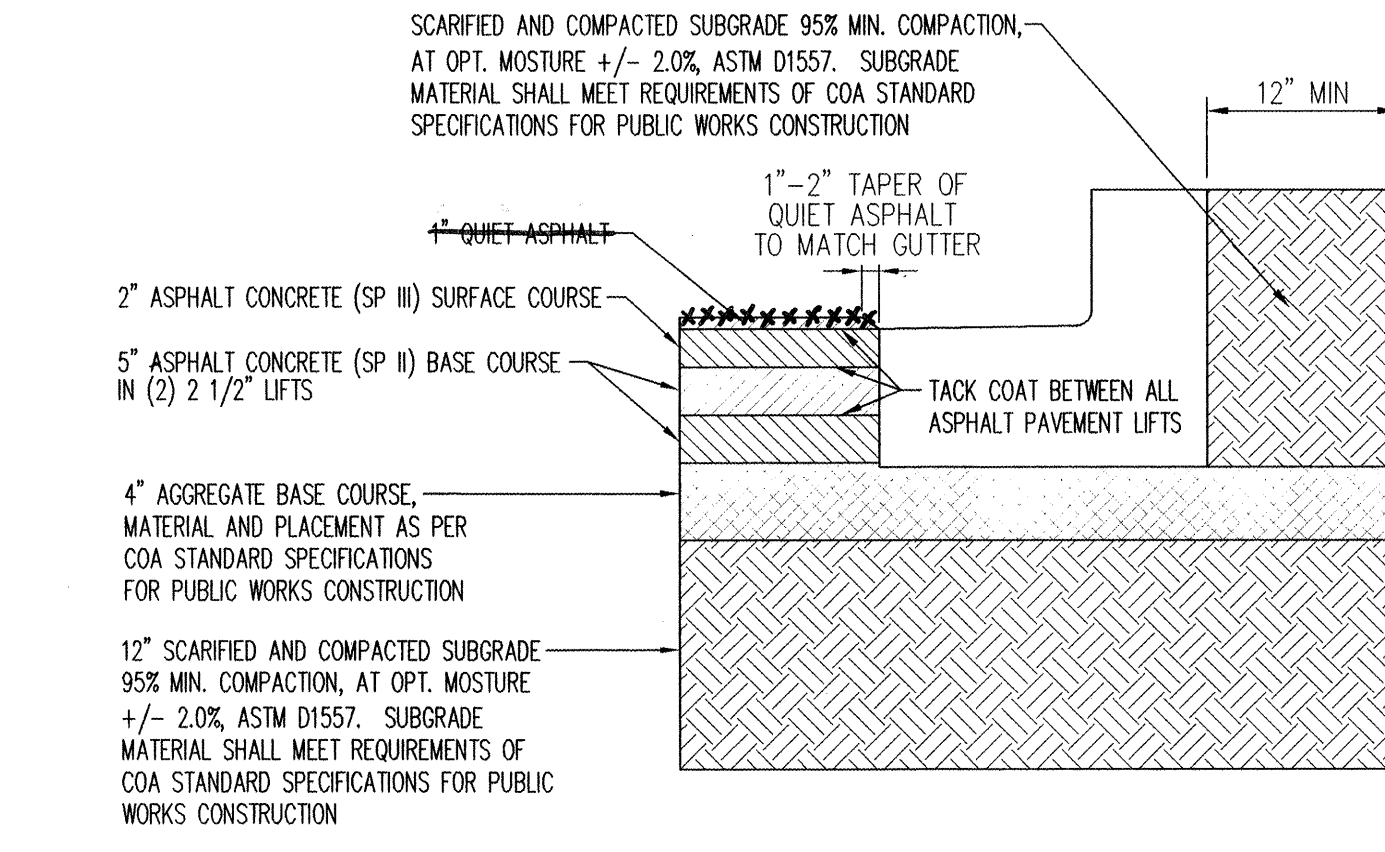

NOTE: CONTRACTOR TO TEST SUBGRADE R-VALUE PRIOR TO CONSTRUCTION.
* IN THE EVENT THE R-VALUE IS LESS THAN 50, REMOVE 2" OF SUB-GRADE MATERIAL AND IMPORT MATERIAL WITH R VALUE GREATER THAN 50 OR CONTACT THE ENGINEER IMMEDIATELY SO THE PAVEMENT SECTION CAN BE MODIFIED.

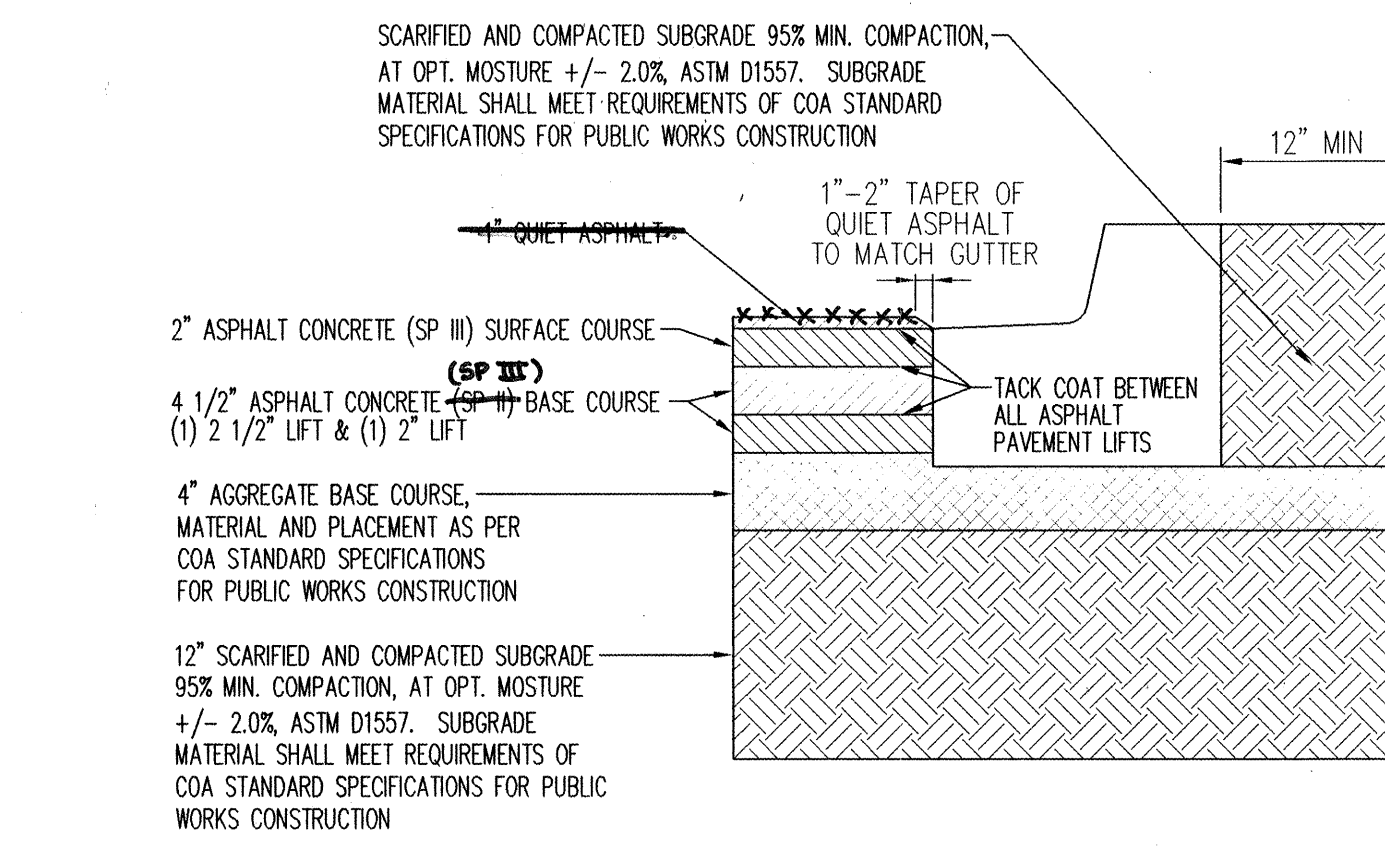


NOTE: CONTRACTOR TO TEST SUBGRADE R-VALUE PRIOR TO CONSTRUCTION.
* IN THE EVENT THE R-VALUE IS LESS THAN 50, REMOVE 2" OF SUB-GRADE MATERIAL AND IMPORT MATERIAL WITH R VALUE GREATER THAN 50 OR CONTACT THE ENGINEER IMMEDIATELY SO THE PAVEMENT SECTION CAN BE MODIFIED.

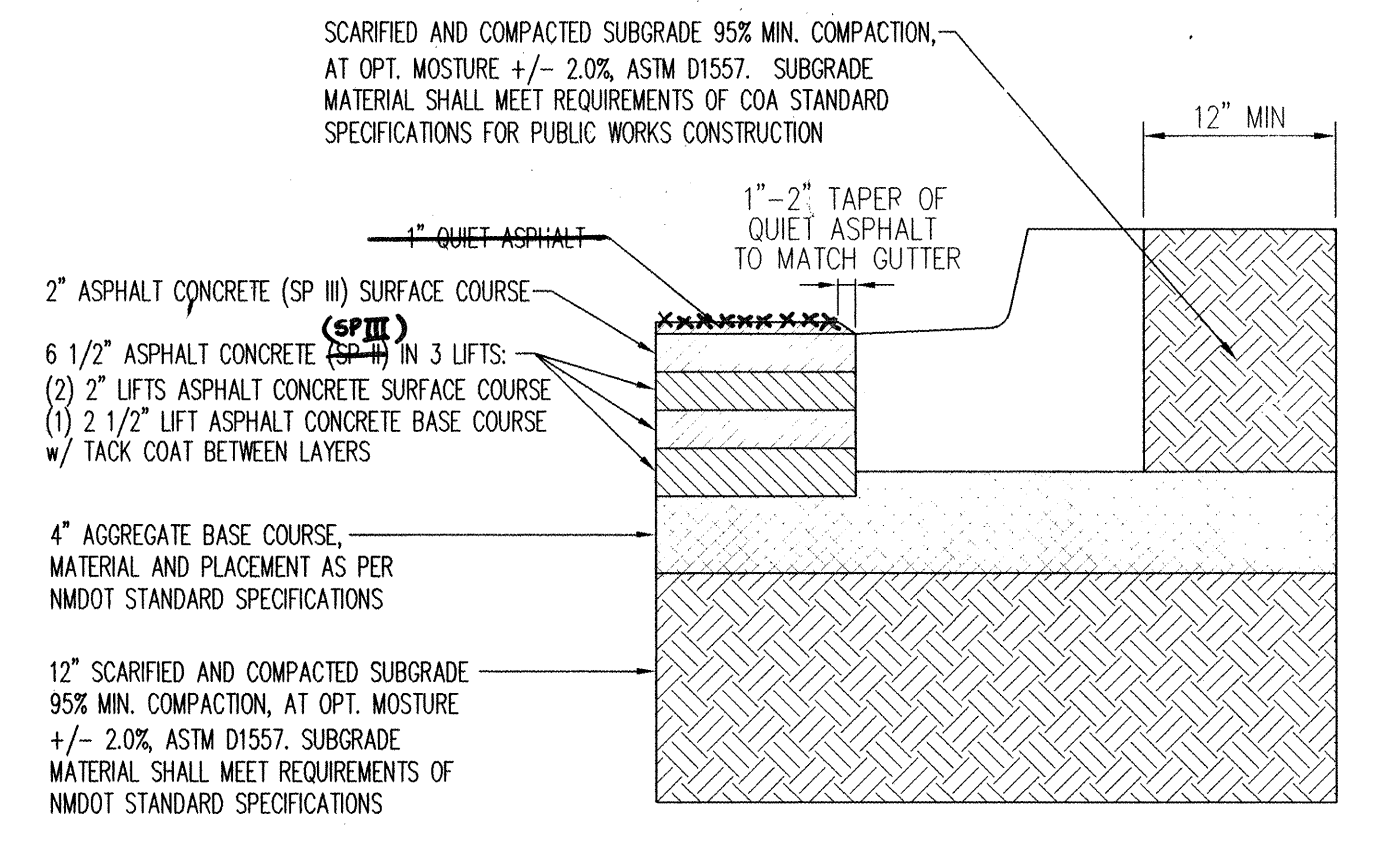


NOTE: CONTRACTOR TO TEST SUBGRADE R-VALUE PRIOR TO CONSTRUCTION.
* IN THE EVENT THE R-VALUE IS LESS THAN 50, REMOVE 2" OF SUB-GRADE MATERIAL AND IMPORT MATERIAL WITH R VALUE GREATER THAN 50 OR CONTACT THE ENGINEER IMMEDIATELY SO THE PAVEMENT SECTION CAN BE MODIFIED.

H EAGLE RANCH ROAD PAVEMENT SECTION
PAVEMENT SECTION OBTAINED FROM COA PROJECT NO. 3040

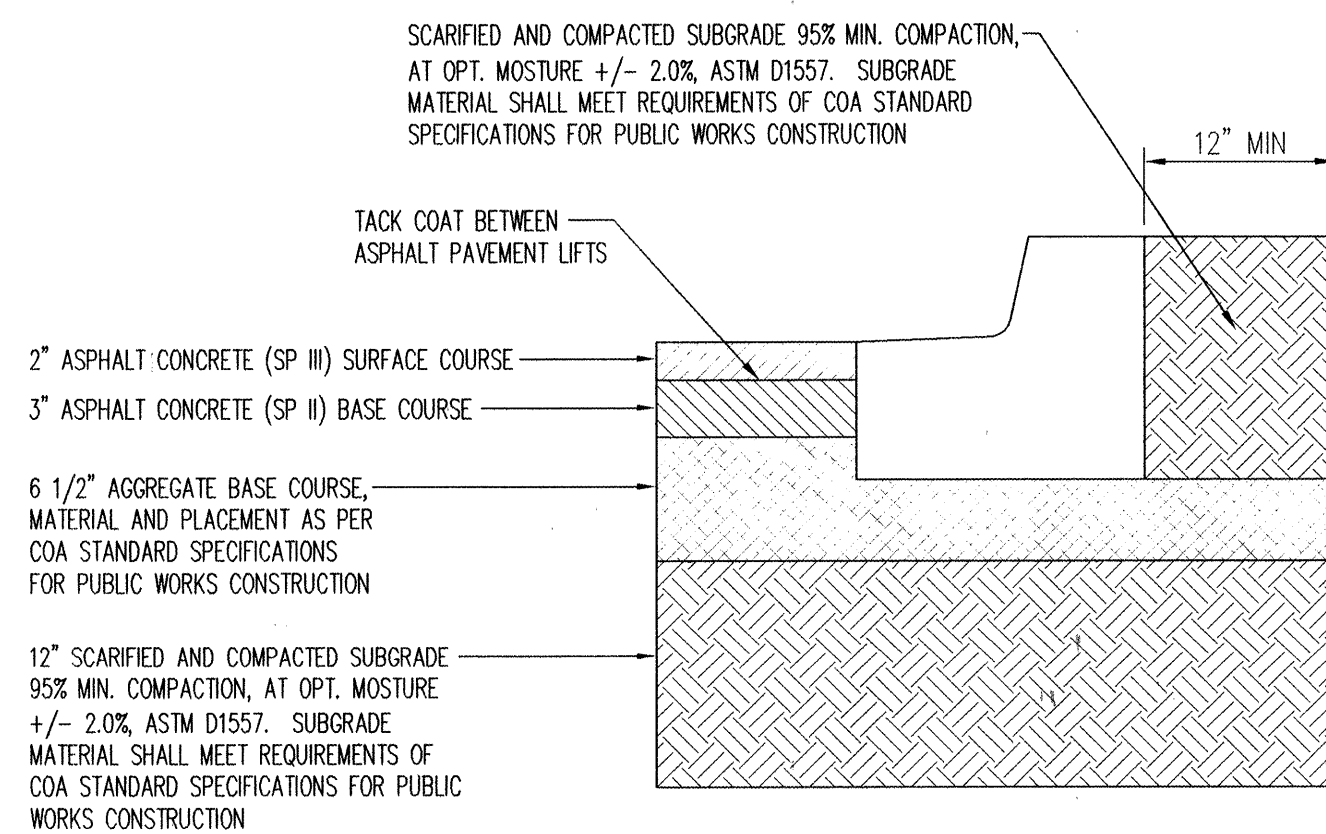


NOTE: CONTRACTOR TO TEST SUBGRADE R-VALUE PRIOR TO CONSTRUCTION.
* IN THE EVENT THE R-VALUE IS LESS THAN 50, REMOVE 2" OF SUB-GRADE MATERIAL AND IMPORT MATERIAL WITH R VALUE GREATER THAN 50 OR CONTACT THE ENGINEER IMMEDIATELY SO THE PAVEMENT SECTION CAN BE MODIFIED.


J COORS BYPASS PAVEMENT SECTION
PAVEMENT SECTION OBTAINED FROM COA PROJECT NO. 4193.93

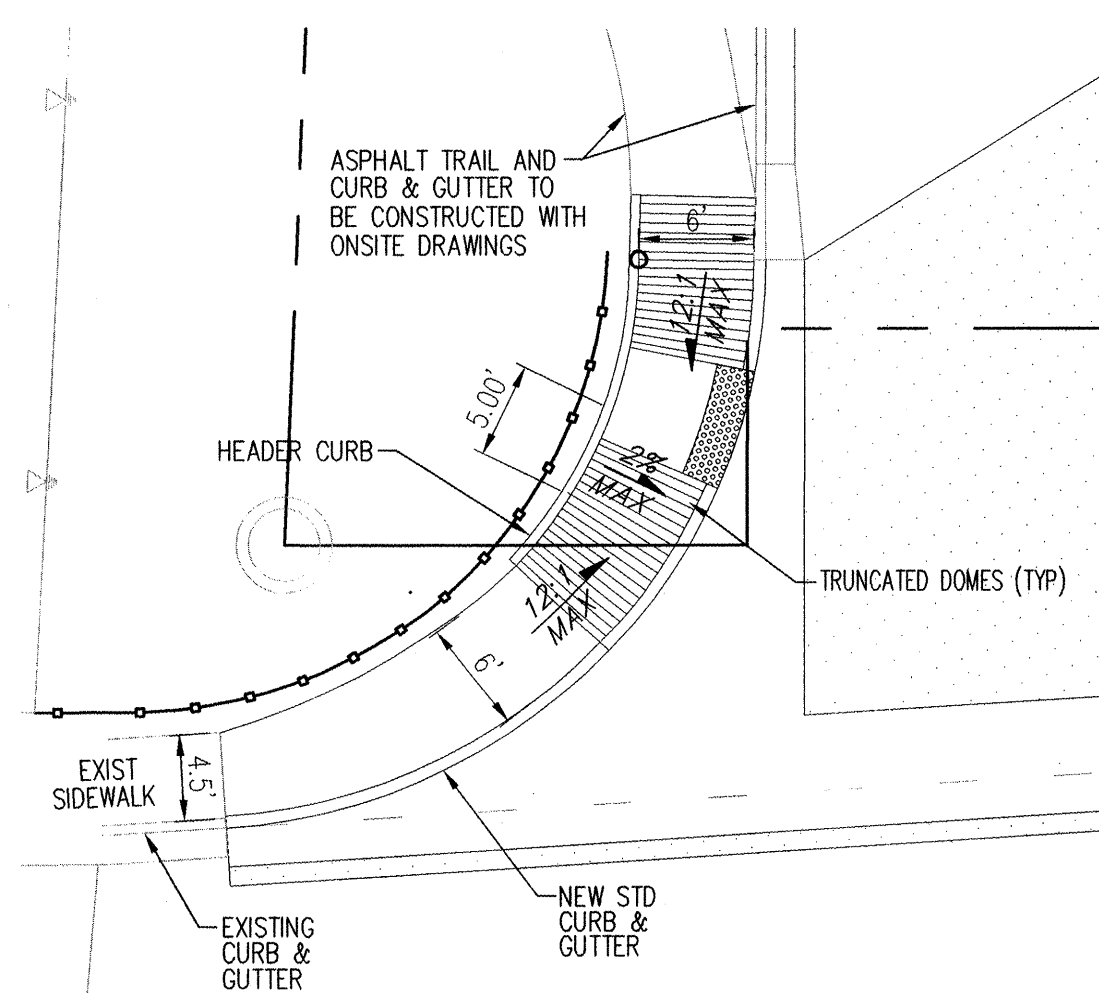

1 CURB RAMP DETAIL
SCALE 1"=10'

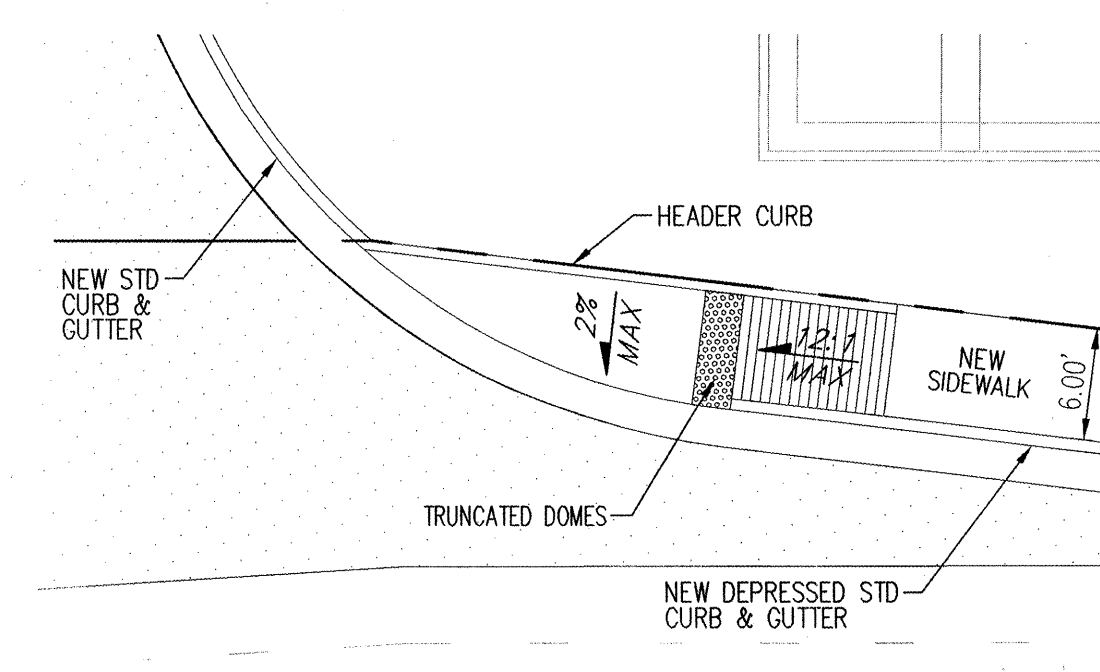

2 CURB RAMP DETAIL
SCALE 1"=10'

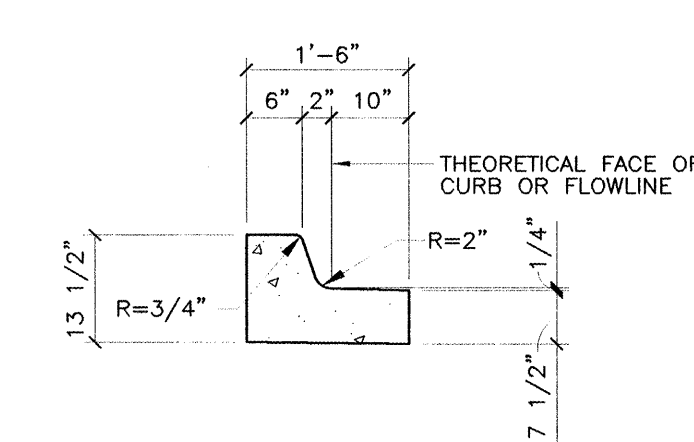

3 DEPRESSED MEDIAN C & G
NTS

M IRVING BLVD PAVEMENT SECTION
PAVEMENT SECTION OBTAINED FROM COA PROJECT NO. 3202

K COORS BLVD PAVEMENT SECTION @ COORS BYPASS
PAVEMENT SECTION OBTAINED FROM COA PROJECT NO. 3202

L COORS BLVD PAVEMENT SECTION @ IRVING BLVD
PAVEMENT SECTION OBTAINED FROM COA PROJECT NO. 3202





AS-BUILT INFORMATION				BENCH MARKS				SURVEY INFORMATION				ENGINEER'S SEAL				REVISIONS				DESIGN			
CONTRACTOR: <u>Bohannon Const.</u> DATE: <u>1-2008</u>				BENCH MARK: <u>ACS CONTROL MONUMENT</u>				FIELD NOTES: <u>NO.</u> <u>BY</u> <u>DATE</u>								DATE: 07 / 2007							
STARTED BY: <u>Surin-Jack</u> DATE: <u>1-2008</u>				1 3/4" ALUMINUM DISK STAMPED "ACS BM. 6-B13"				FIELD: <u>NO.</u> <u>BY</u> <u>DATE</u>								DRAWN BY: <u>B. ORTEGA</u>							
INSPECTION BY: <u>BYT</u> DATE: <u>1-2008</u>				LOCATED ON TOP OF CONCRETE BRIDGE SLEEPER SLAB,				FIELD: <u>NO.</u> <u>BY</u> <u>DATE</u>								CHECKED BY: <u>G. BROUGHTON</u>							
VERIFICATION BY: <u>Bohannon Const.</u> DATE: <u>1-2008</u>				SOUTHEASTLY QUADRANT OF EAGLE RANCH RD NW																			
CORRECTED BY: <u>BYT</u> DATE: <u>1-2008</u>				AND THE CALABASILAS ARROYO																			
MICRO-FILM INFORMATION				ELEVATION = 5085.637 FT. (NGVD 1929)																			
RECORDED BY				DATE																			
NO.				DATE																			



Bohannon & Huston
 Courtyard 1 7800 Jefferson St. NE Albuquerque, NM 87109-4336
 ENGINEERING • SPATIAL DATA • ADVANCED TECHNOLOGIES

CITY OF ALBUQUERQUE
 DEPARTMENT OF MUNICIPAL DEVELOPMENT
 COSTCO PUBLIC INFRASTRUCTURE
 PAVEMENT SECTIONS & DETAILS

DESIGN REVIEW COMMITTEE	CITY ENGINEER APPROVAL	MO./DAY/YR.	MO./DAY/YR.
APPROVED	APPROVED		
DESIGN REVIEW COMMITTEE	DESIGN REVIEW COMMITTEE		
CITY PROJECT NO.	ZONE MAP NO.	SHEET	OF
729082	B-13, B-14, C-13, D-13	18	22

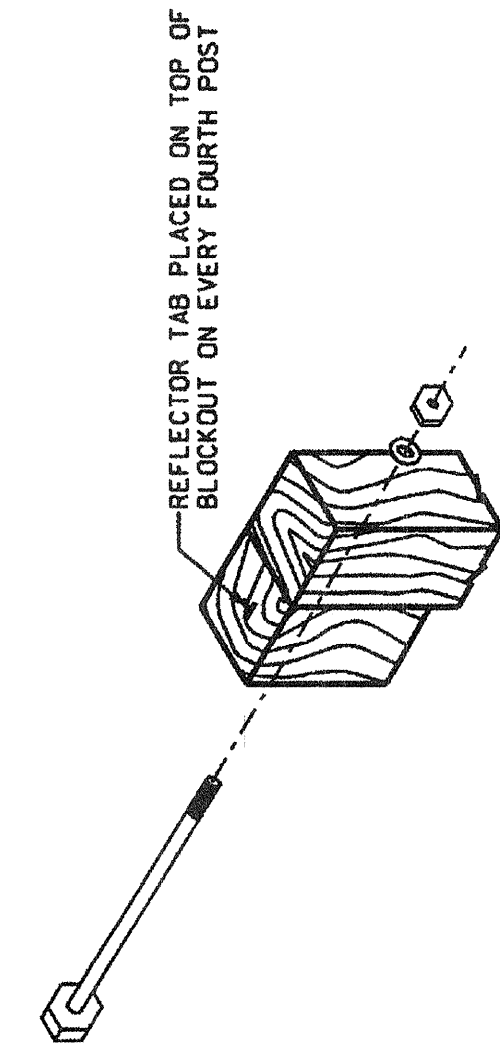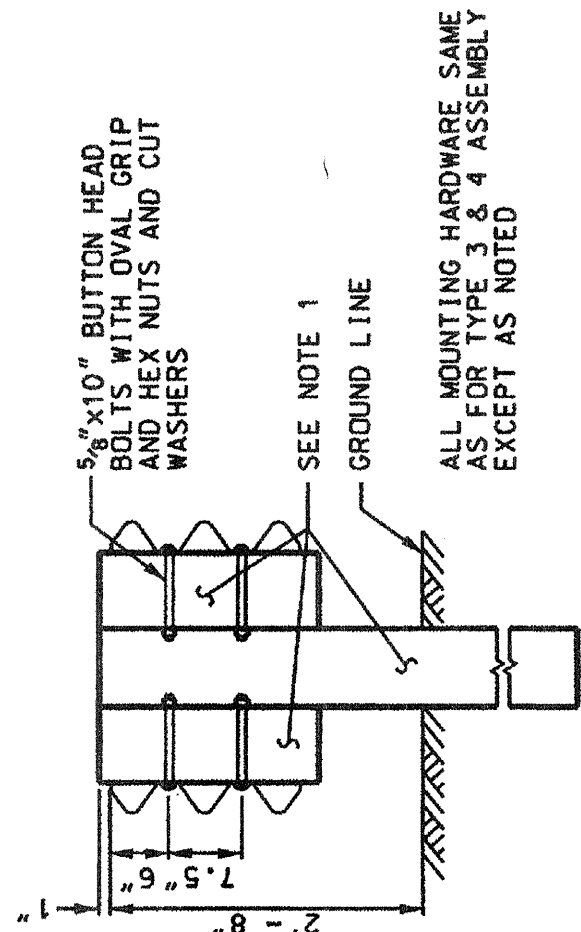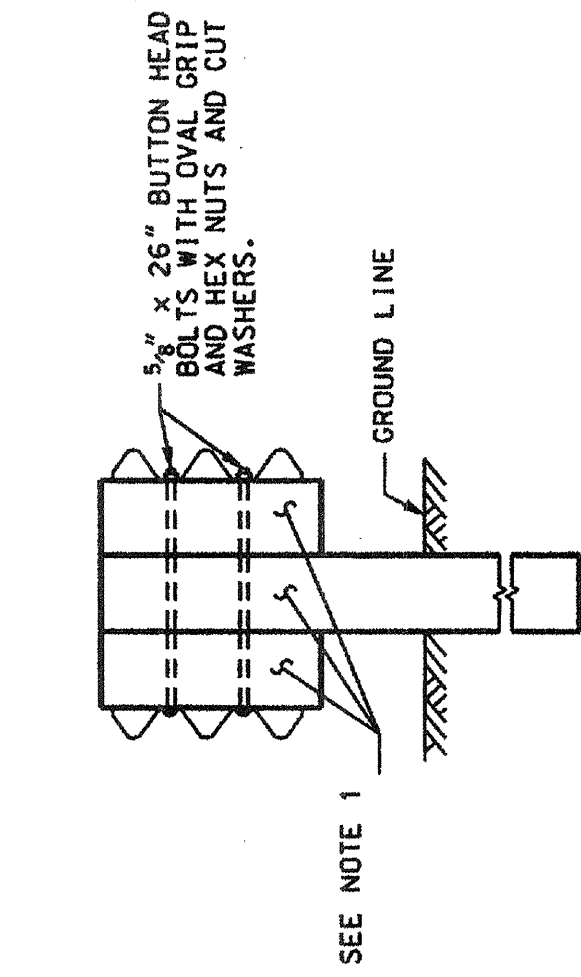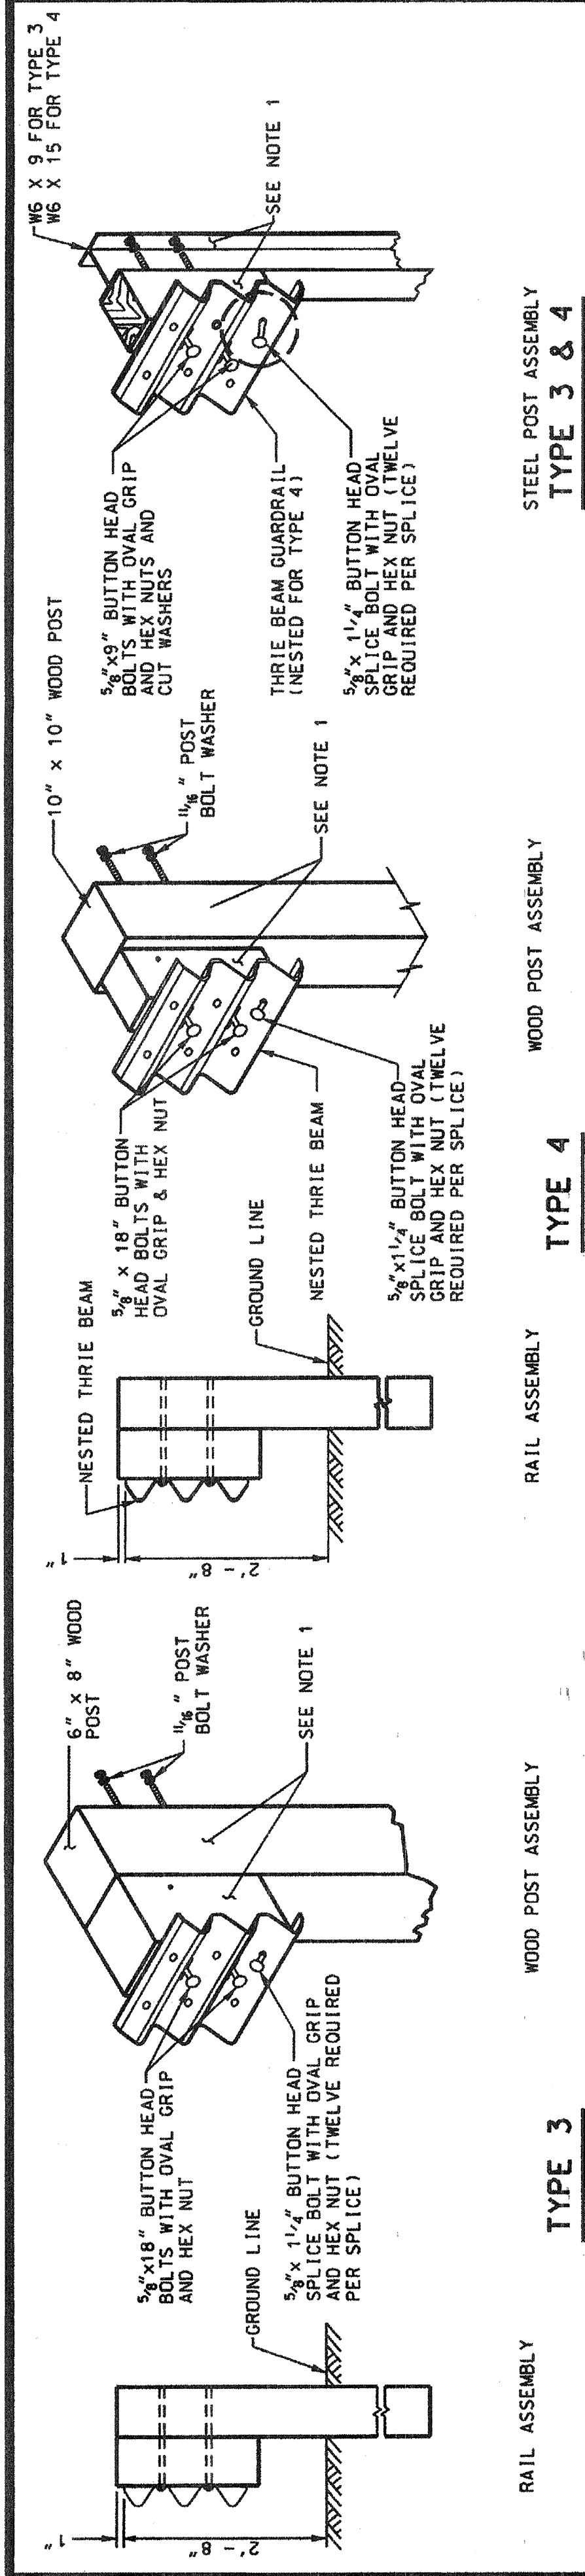

WOOD POST ASSEMBLY
TYPE 5





STEEL POST ASSEMBLY
TYPE 5

REFLECTOR TAB PLACEMENT DETAIL


[illegible]

NOTES:


1. TYPE 3 AND TYPE 5 POSTS SHALL BE EX8, TIMBER OR WEX9. TYPE 4 POSTS SHALL BE EX10, TIMBER OR WEX15. FOR DETAILS, SEE "SHEET 3 OF 4".
2. UNLESS NOTED OTHERWISE, TYPE 3 AND TYPE 5 GUARDRAIL POST SPACING SHALL BE 6' ON CENTER. TYPE 4 SHALL BE A MAXIMUM OF 3'-1 1/2' ON CENTER.
3. BOLTS ARE TO BE INSTALLED AS SHOWN SO THAT THE THREADED END OF THE BOLTS AND NUTS ARE PLACED AWAY FROM TRAFFIC SIDE OF RAIL.
4. DO NOT PLACE ANY WASHERS UNDER THE BOLTS ON THE TRAFFIC SIDE OF THE BARRIER.
5. REFLECTOR TABS SHALL BE PLACED AT 25' INTERVALS (EVERY 4TH POST @ 6'-3" POST SPACING) ON ALL GUARDRAIL INSTALLATIONS.
6. THE COLOR OF THE REFLECTIVE SHEETING ON THE REFLECTOR TABS SHALL BE THE SAME AS THE COLOR OF THE SHOULDER LINE PAYMENT MARKING IN FRONT OF THE BARRIER.
7. REFLECTOR TABS SHALL HAVE A MINIMUM OF 3"x5" REFLECTIVE SHEETING ON BOTH SIDES AND SHALL ATTACH SECURELY TO THE BLOCKOUT.
8. SEE SHEET 4 OF 4 "METAL BARRIER COMPONENTS" FOR THRIE BEAM DETAILS.
9. SPLICES SHALL BE LAPPED SO THE FREE END DOES NOT FACE TRAFFIC FLOW.
10. CONSTRUCTION TOLERANCE FOR HEIGHT OF GUARDRAIL IS $\pm 1/2"$.

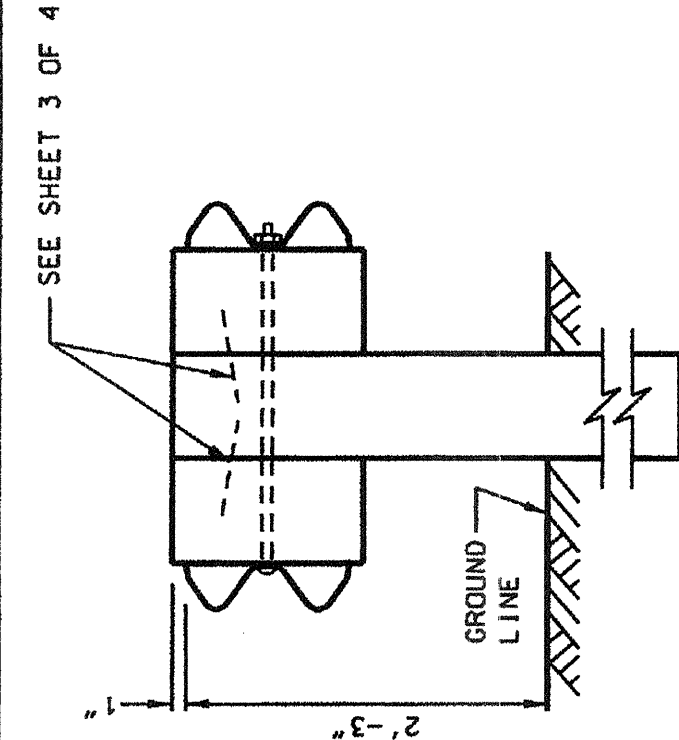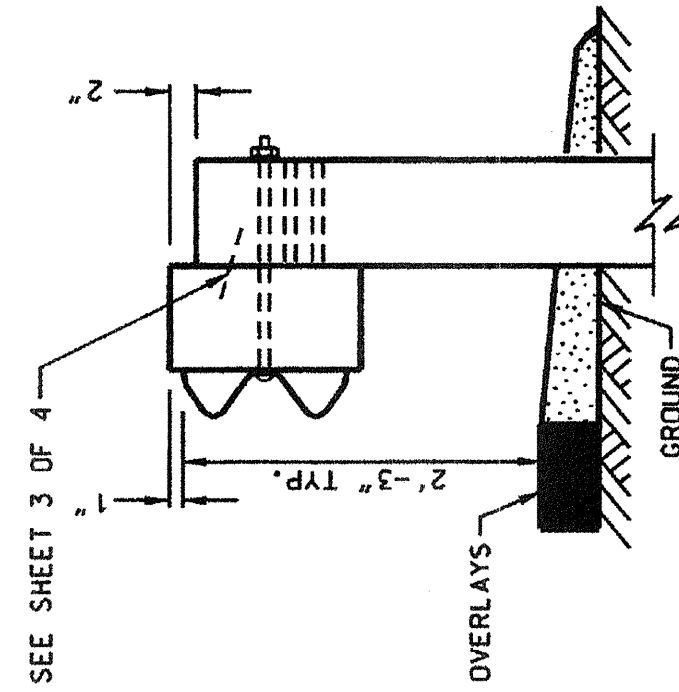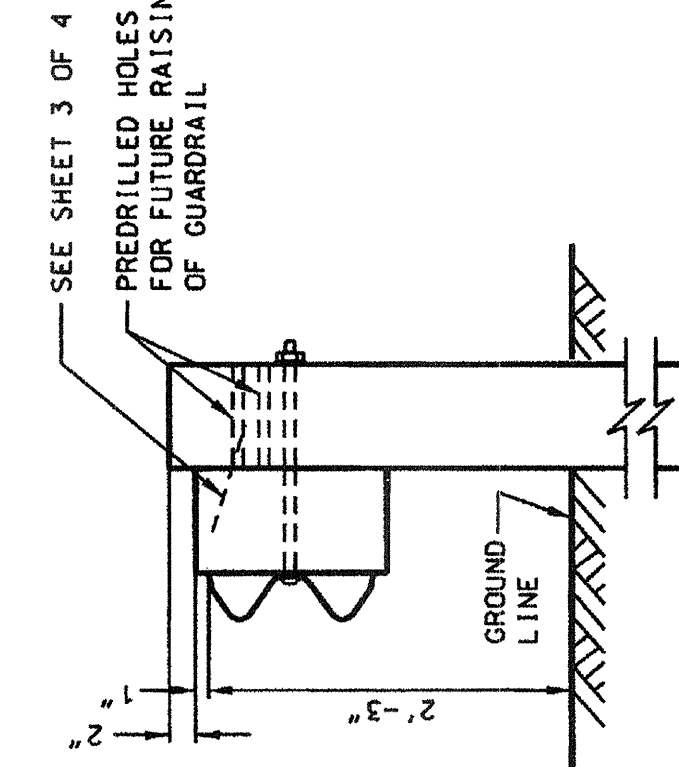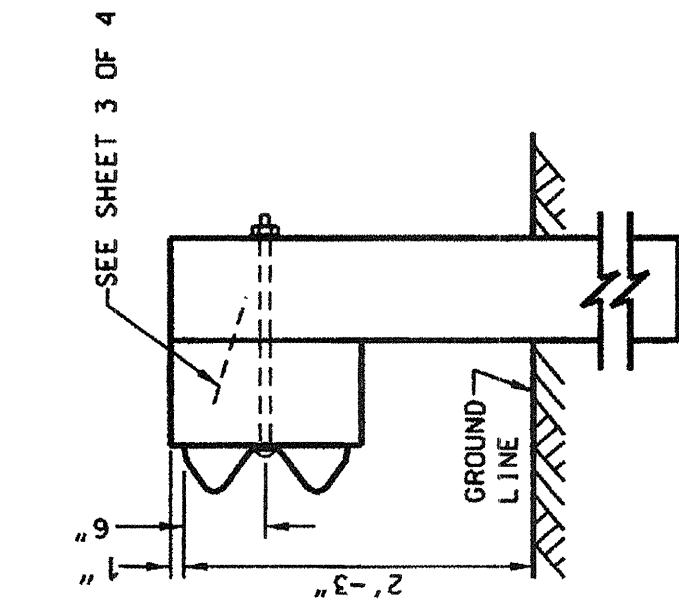

TYPE 1

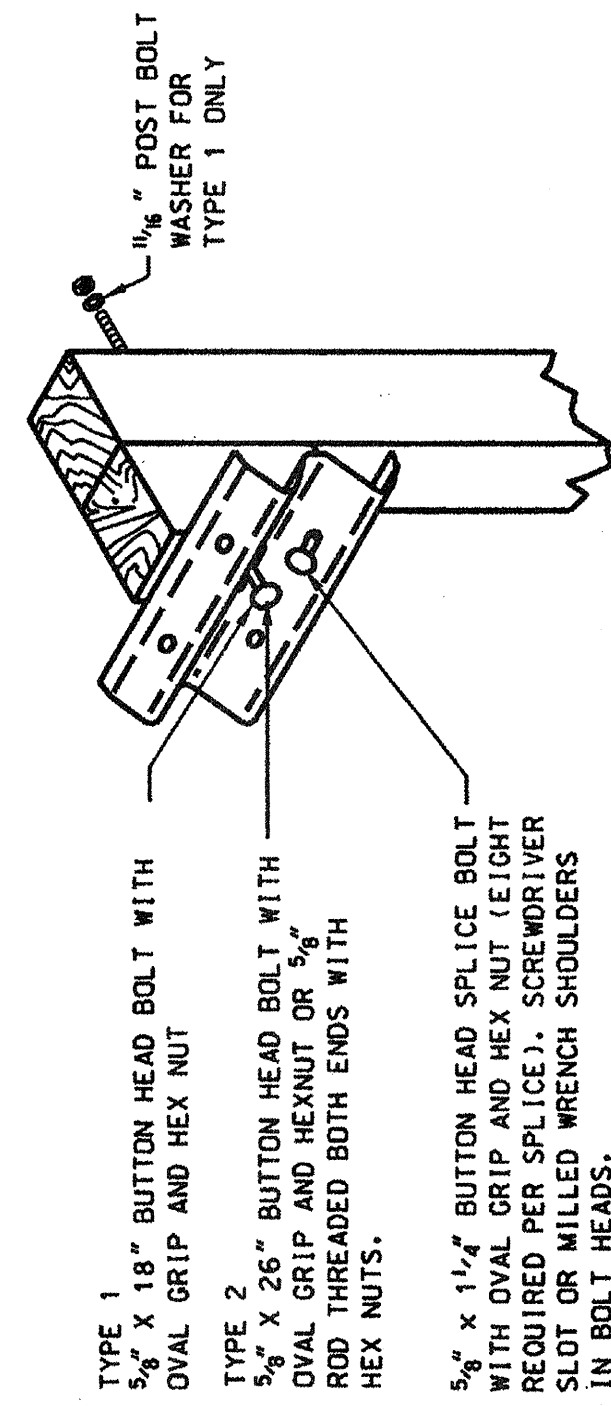

TYPE 1 ALTERNATE

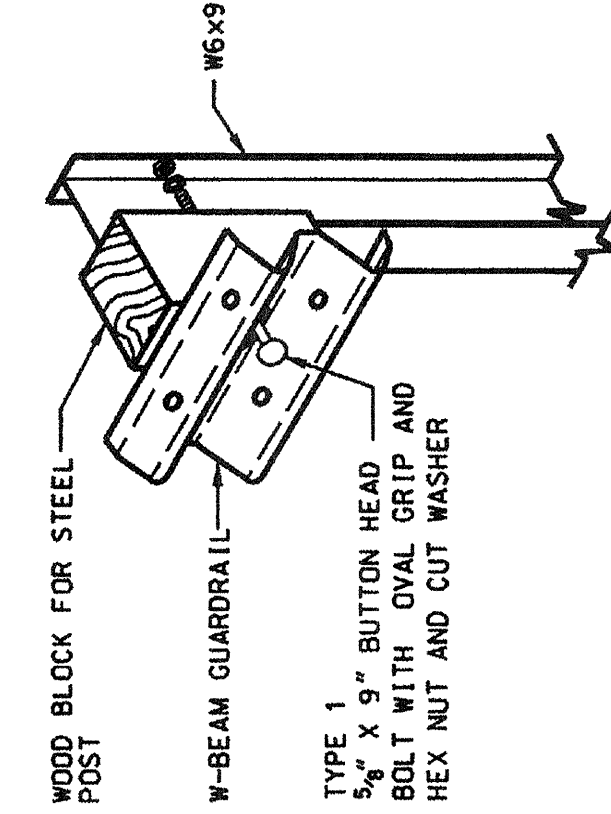


RAIL ELEMENT RAISED

TYPE 2

NOTES:

1. GUARDRAIL POST SPACING FOR TYPES 1 & 2 SHALL BE 6'-0" ON CENTER, UNLESS OTHERWISE SPECIFIED.
2. TYPE 1 & 2 POSTS SHALL BE 6X8 TIMBER OR W 6X9. FOR POST AND BLOCK DETAILS SEE SHEET 3 OF 4. "METAL BARRIER POSTS & BLOCKS."
3. SEE SHEET 2 OF 4 FOR REFLECTOR TAB DETAILS AND PLACEMENT.
4. BULTS ARE TO BE INSTALLED AS SHOWN SO THAT THE GUARDRAIL BARRIER COMPONENTS ARE PLACED AWAY FROM TRAFFIC SIDE OF RAIL.
5. DO NOT PLACE ANY WISHERS UNDER THE BULTS ON THE TRAFFIC SIDE OF THE METAL BARRIER.
6. SEE SHEET 4 OF 4 "METAL BARRIER COMPONENTS" FOR W-BEAM DETAILS.
7. SPLICES SHALL BE LAPPED SO THE FREE END DOES NOT FACE TRAFFIC FLOW.
8. CONSTRUCTION TOLERANCE FOR HEIGHT OF GUARDRAIL IS $\pm 1/2"$.
9. STANDARD W-BEAM WITH 6 FOOT POST SPACING CAN BE EXPECTED TO DEFLECT 3 FEET.

WOOD POST ASSEMBLY DETAIL

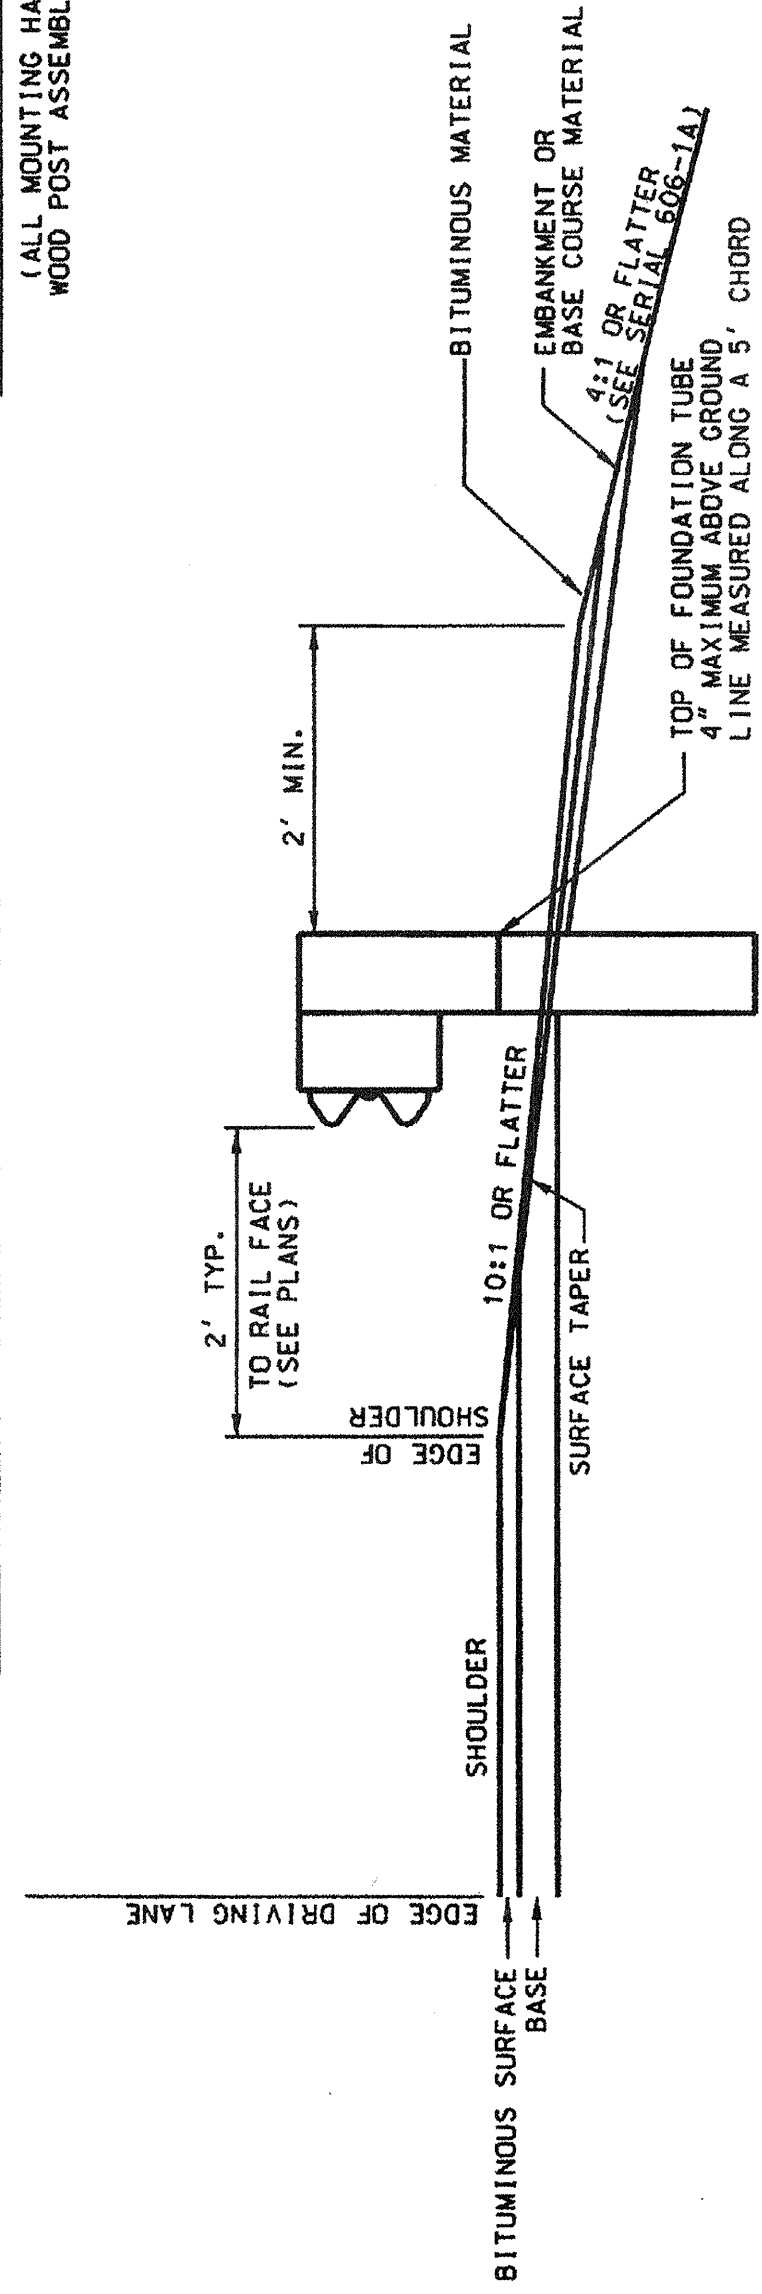

STEEL POST ASSEMBLY DETAIL

(ALL MOUNTING HARDWARE SAME AS FOR WOOD POST ASSEMBLY. EXCEPT AS NOTED)


[illegible]

INSTALLATION AND SURFACING DETAILS


1. WOOD POSTS FOR ALL GUARDRAIL PLACEMENT SHALL BE 6x8 AND STEEL POSTS SHALL BE W6X9 EXCEPT FOR TYPE 4 GUARDRAIL AND WHERE NOTED OTHERWISE.

2. TIMBER BLOCKS FOR W-BEAM INSTALLATIONS SHALL BE TOE-NAILED ON EACH SIDE OF THE WOOD BLOCK TO WOOD POSTS WITH A 16D GALVANIZED NAIL TO RESTRICT BLOCK ROTATION.


3. SEE THE DEPARTMENT'S APPROVED PRODUCT LIST FOR OTHER PROPRIETARY BLOCKS THAT MAY BE SUBSTITUTED.

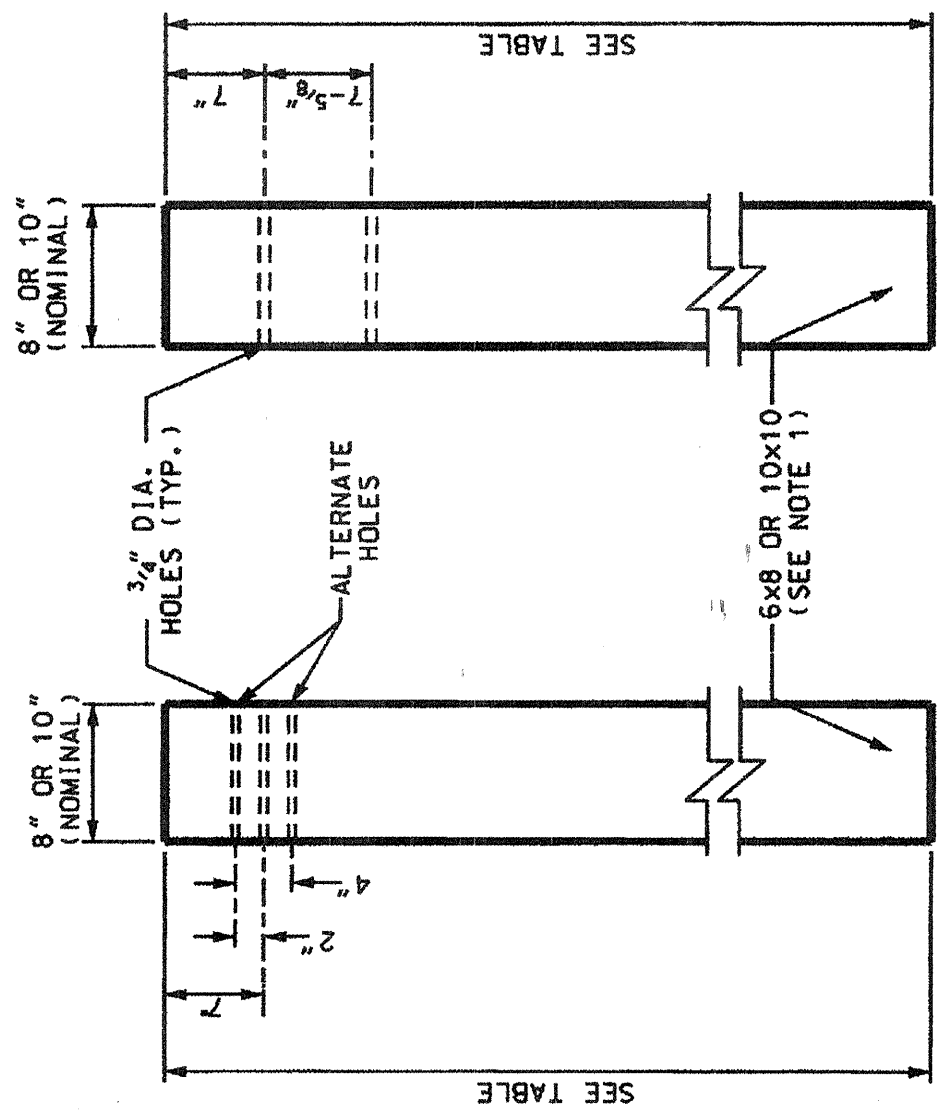

POST LENGTH TABLE		
GUARDRAIL TYPE	WOOD POSTS	STEEL POSTS
		DRIVEN
1 OR 2	6'-0"	6'-0"
4	6'-6"	7'-0"
3 AND 5	6'-6"	6'-6"

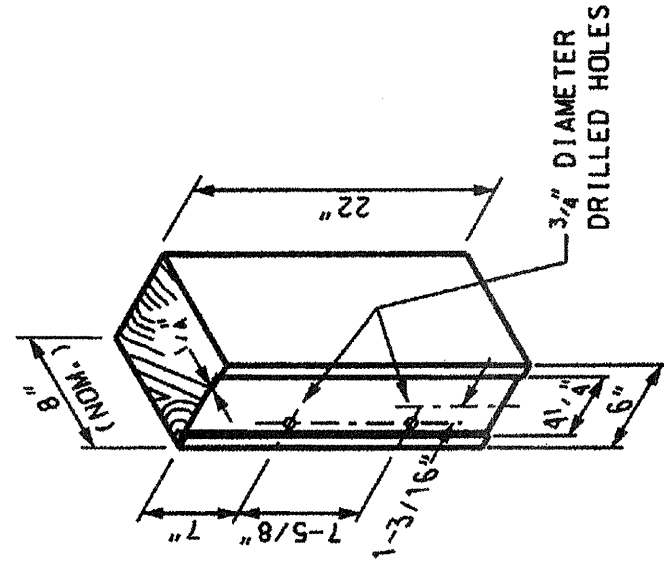

THREE BEAM WOOD BLOCK FOR STEEL POSTS

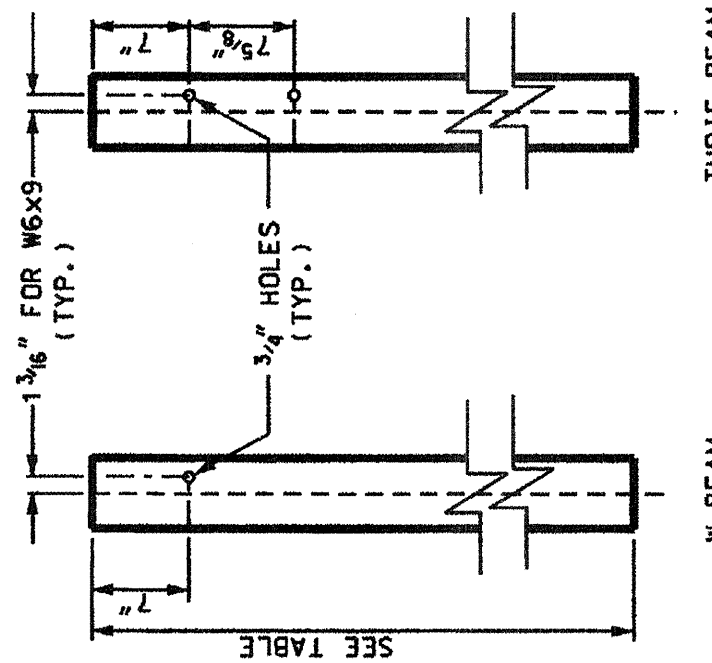

STEEL POSTS

NOTE: STEEL BLOCKS FOR THRIE BEAM SHALL NOT BE USED ON ROADWAYS WITH SPEEDS GREATER THAN 45MPH. A WOOD BLOCK OR AN APPROVED PLASTIC BLOCK SHALL BE USED.

1. ALL MATERIALS AND WORKMANSHIP SHALL CONFORM TO THE NEW MEXICO DEPARTMENT OF TRANSPORTATION STANDARD SPECIFICATIONS FOR HIGHWAY AND BRIDGE CONSTRUCTION (CURRENT EDITION).

2. ALL HARDWARE SHALL MEET FHWA CRASHWORTHINESS REQUIREMENTS AS PER NCHRP 350 GUIDELINES AND SHALL BE ON THE DEPARTMENT'S APPROVED PRODUCT LIST.

3. THE RAIL IS NOT BOLTED TO THE CRT POST AT THE CENTER OF THE NOSE FOR THE 8'-6" RADIUS INSTALLATION ONLY.


4. SEE SERIAL 606-01-1/2
FOR W-BEAM GUARDRAIL.

5. NO WASHERS ARE USED ON THE 5/8" BUTTON HEAD BOLTS CONNECTING THE


6. THE CURVED GUARDRAIL SECTION SHALL BE SHOP BENT.

7. THE SLOPE IN FRONT OF THE INSTALLATION SHOULD NOT EXCEED 10:1.

8. CURVED GUARDRAIL SHALL ONLY BE USED ON OPERATING SPEEDS OF 60 MPH OR LESS. 35' RADIUS CURVED GUARDRAIL SHOULD ONLY BE USED ON OPERATING SPEEDS OF 50 MPH OR LESS.

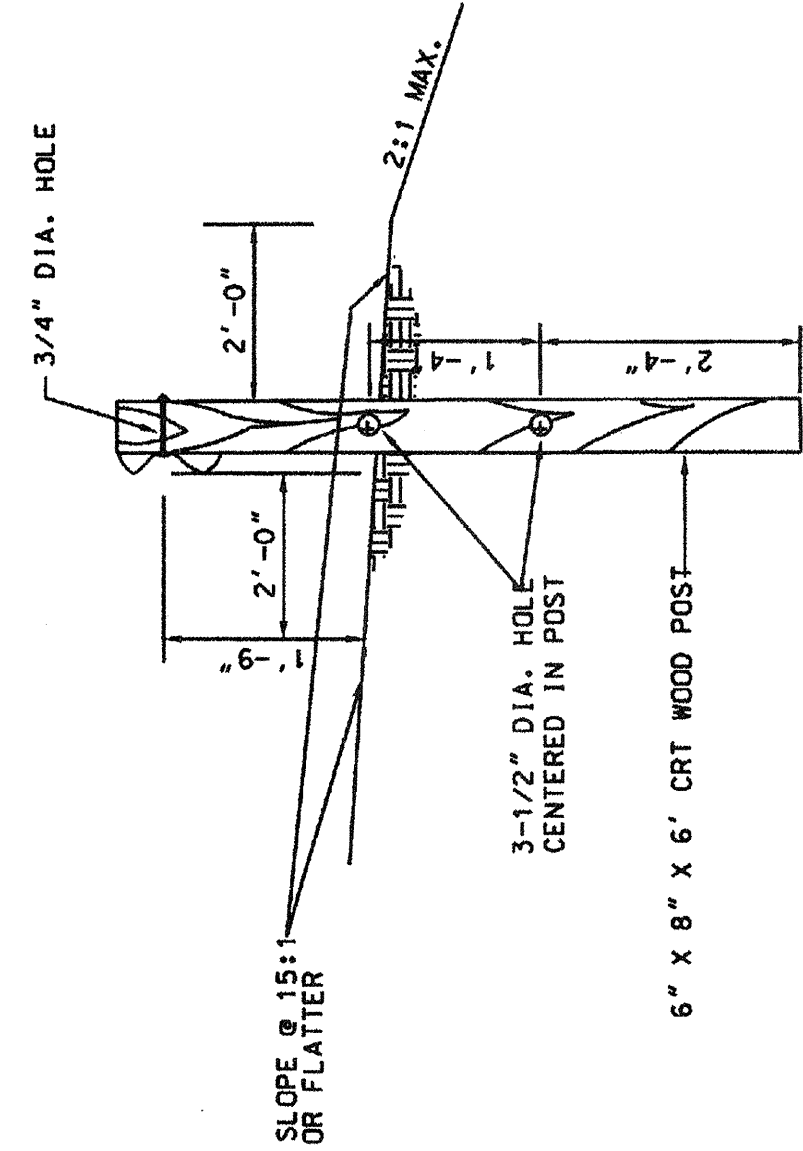

8" X 8" X 6' WOOD POST

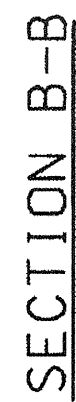

NEW MEXICO
DEPARTMENT OF TRANSPORTATION
STANDARD DRAWING

APPROVED _____
DESIGN ENGINEER
DATE 1-11-09


DESIGNED BY _____ DRAWN BY ✓ CHECKED BY _____

606-06-1/3

SHEET 1 OF 3

NOTES

1. ALL MATERIAL AND WORKMANSHIP SHALL CONFORM TO THE N.M.D.O.T.'S STANDARD SPECIFICATION (CURRENT EDITION). HIGHWAY AND BRIDGE CONSTRUCTION.
2. ALL HARDWARE SHALL MEET FHWA CRASHWORTHINESS REQUIREMENTS AS PER NCHRP 350 GUIDELINES AND SHALL BE ON THE DEPARTMENT'S APPROVED PRODUCT LIST.
3. SEE SERIAL 606-01-1/2 AND 606-02-1/1 FOR W-BEAM GUARDRAILS.
4. SEE SPECIAL ANCHORS, SERIAL 606-06-3/3, FOR SOIL PLATE AND BEARING PLATE DETAILS.
5. ATTACH W-BEAM TO STEEL PIPE WITH BUTTON HEAD BOLT WITH NO WASHER. NO CONNECTION TO POST IS REQUIRED.
6. BOLTS SHALL CONFORM TO THE REQUIREMENTS OF ASTM M164 AND NUTS TO THE REQUIREMENTS OF ASTM A 563. GRADE A OR BETTER, AND BE GALVANIZED IN ACCORDANCE WITH ASTM A 153.
7. WIRE ROPE SHALL CONFORM TO THE REQUIREMENTS OF ASHTM M 30 AND SHALL BE 3/4" INCH PREFORMED, 6X19, WIRE STRAND CORE OR INDEPENDENT WIRE ROPE CORE. GALVANIZED, RIGHT REGULAR LAY, MANUFACTURED OF IMPROVED FLOW STEEL WITH MINIMUM BREAKING STRENGTH OF 42,000 POUNDS.
8. ALL ANGLES, CHANNELS, AND PLATES SHALL CONFORM TO THE REQUIREMENTS OF ASTM A 36 AND STRUCTURAL TUBING TO ASTM A 500. WELDING SHALL BE IN ACCORDANCE WITH THE AMERICAN WELDING SOCIETY'S STRUCTURAL WELDING CODE ANSI/AWS D1.1.
9. ALL STRUCTURAL STEEL SHALL BE GALVANIZED IN ACCORDANCE WITH ASTM A 123. NO PUNCHING, DRILLING, CUTTING, OR WELDING WILL BE PERMITTED AFTER GALVANIZING.
10. THE YELLOW REFLECTIVE SHEETING SHALL CONSIST OF AN 8"x12" STRIP OF YELLOW REFLECTIVE SHEETING THAT CONFORMS TO THE SHAPE SHOWN. THIS ITEM IS INCIDENTAL TO METAL BARRIER ANCHORAGE AND NO SEPARATE PAYMENT WILL BE MADE.
11. THE TYPE "B" END ANCHORAGE SHALL ONLY BE USED ON LOW VOLUME, LOW SPEED ROADWAYS (45 MPH OR LESS).
12. REFER TO "A" GUIDE TO STANDARDIZED BARRIER HARDWARE FOR AN ASHTO, ACC., AND ARBITA TASK FORCE REPORT FOR SPECIFIC HARDWARE DETAILS.

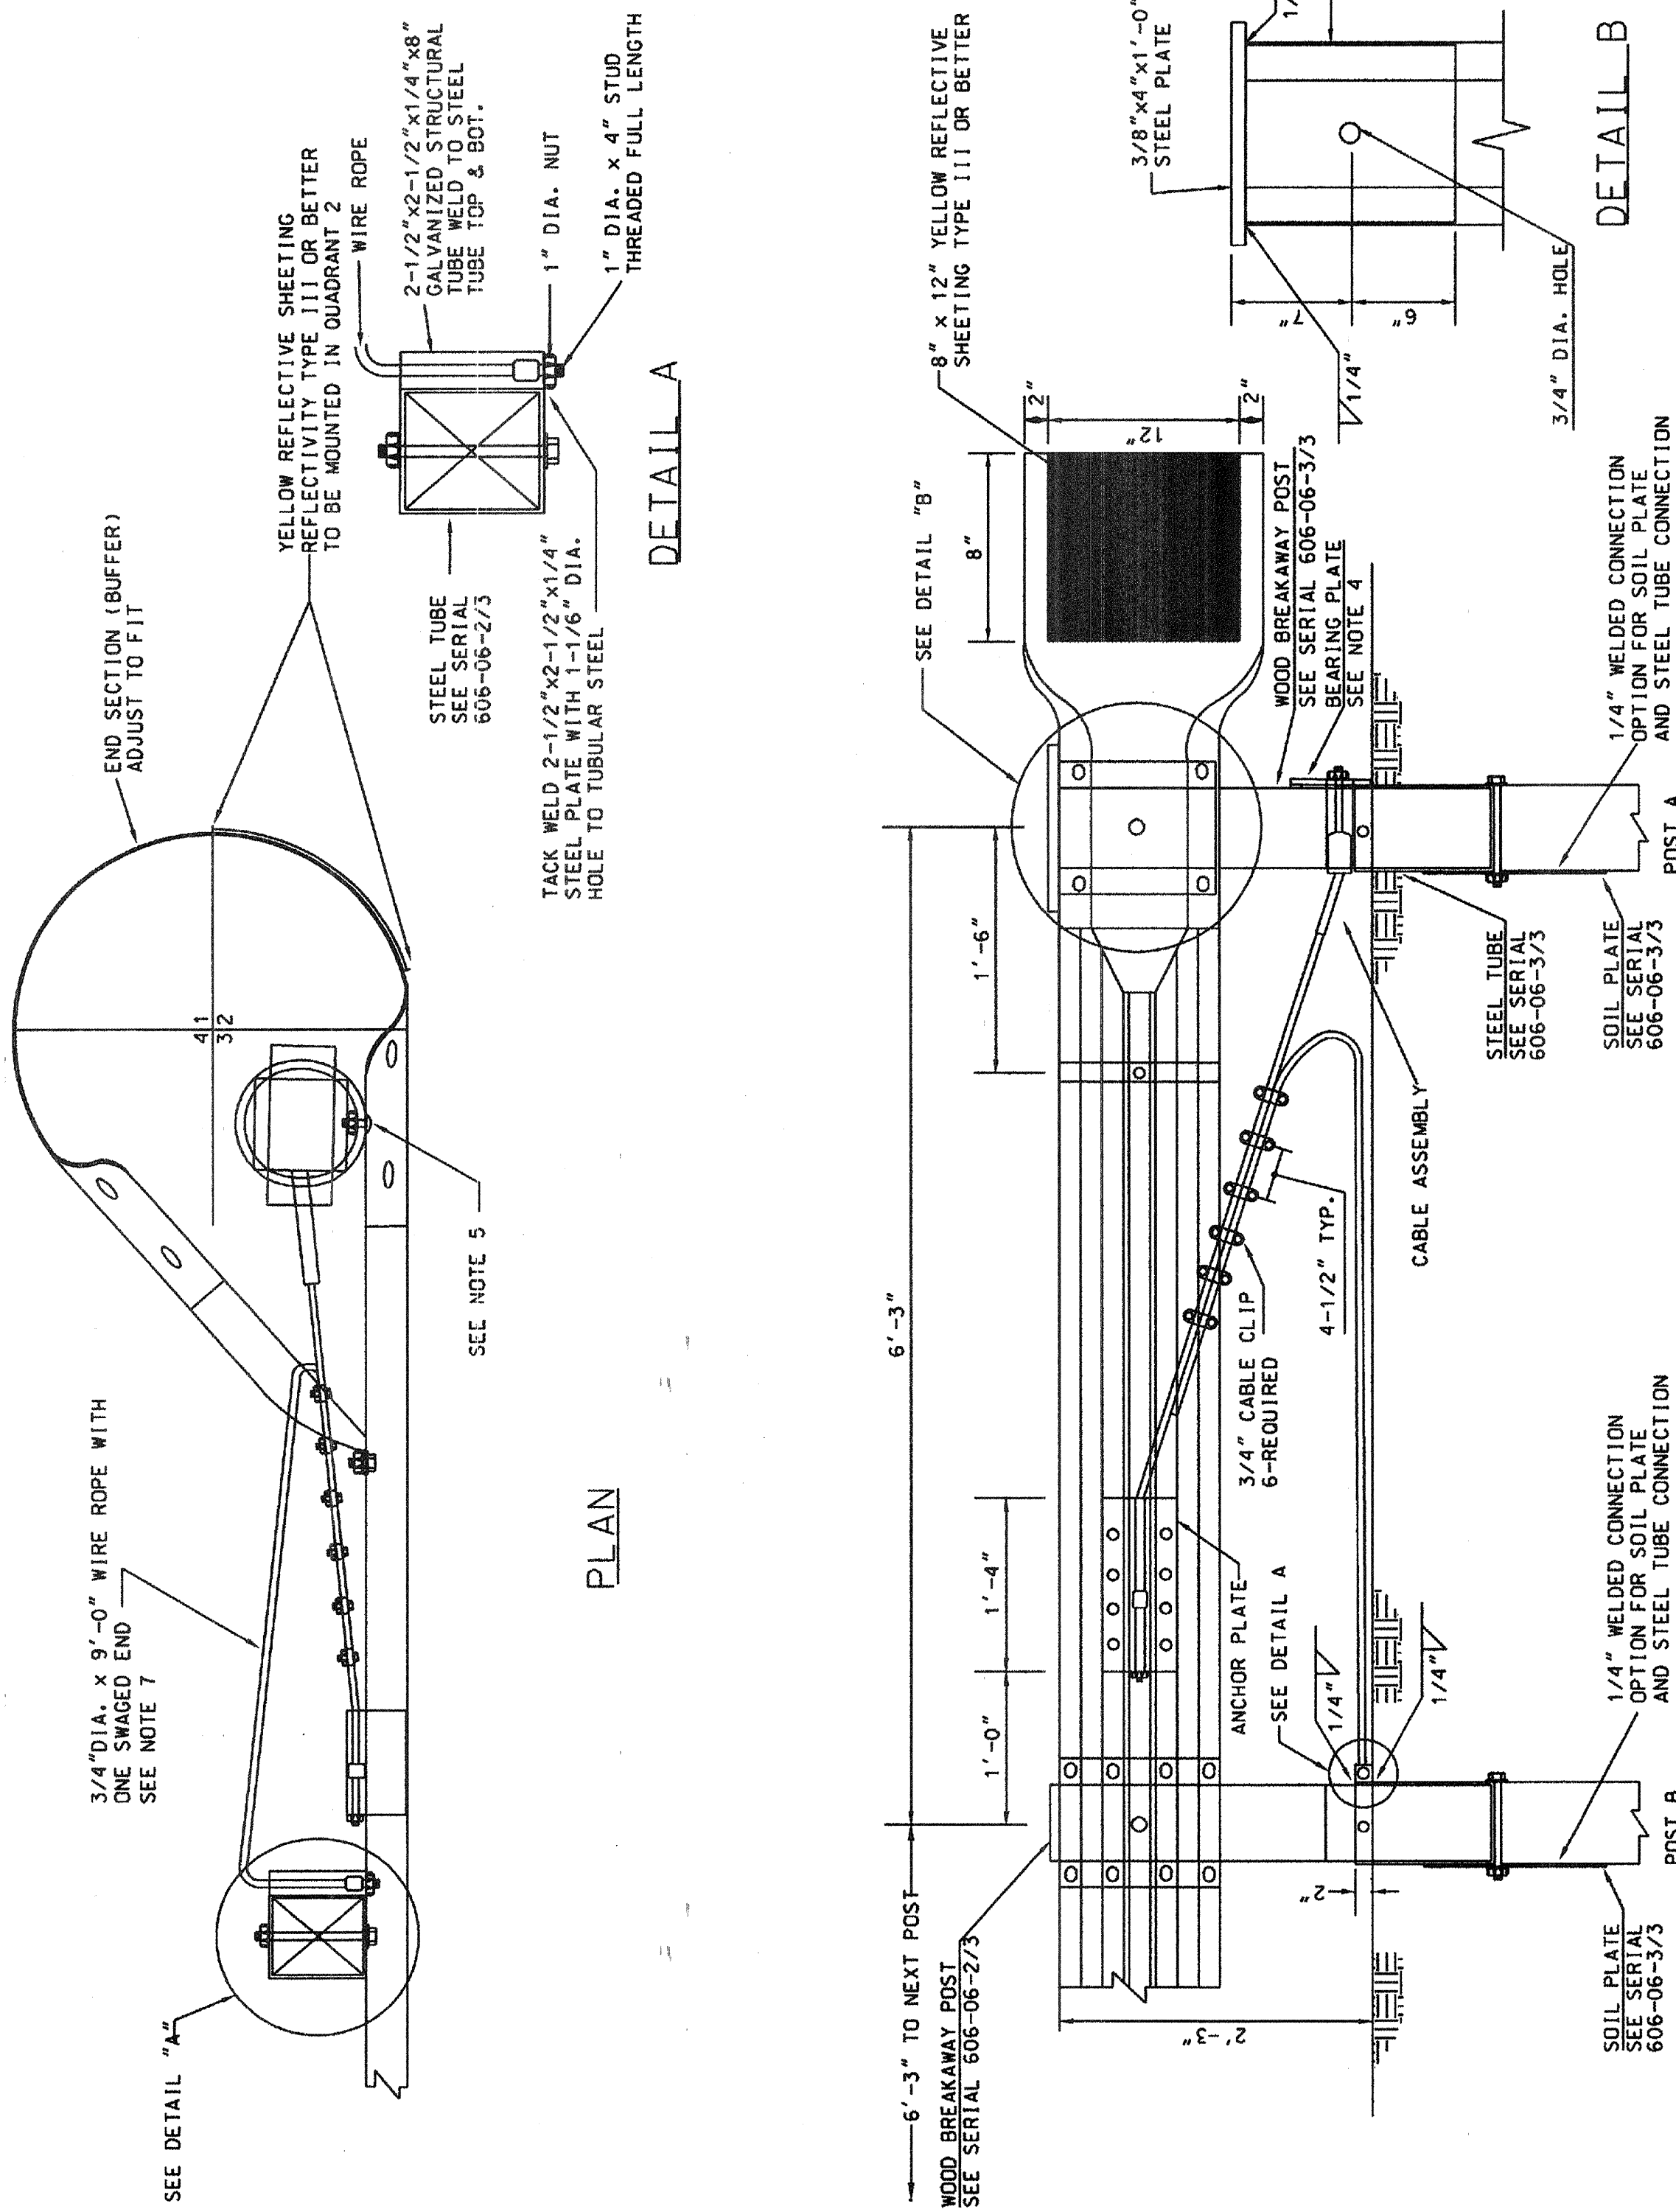


ELEVATION


[illegible]

NOTES

1. THE WOOD BRACKENBURY POST SHALL BE S4S TIMBER WITH A STRESS GRADE OF 1200 PSI AND SHALL BE GRADE MARKED OR CERTIFIED BY A RECOGNIZED ASSOCIATION OR AGENCY WHICH IS CERTIFIED BY THE BOARD OF REVIEW, TO AMERICAN LUMBER STANDARDS COMMITTEE, TO GRADE THE SPECIES. WOOD PRESERVATIVES SHALL CONFORM TO THE REQUIREMENTS OF AASHTO DESIGNATION M 133.
2. ALL HARDWARE SHALL MEET FWWA CRASHWORTHINESS REQUIREMENTS AS PER NCHRP 350 GUIDELINES AND SHALL BE ON THE DEPARTMENT'S APPROVED PRODUCT LIST.
3. ALL ANGLES, CHANNELS, AND PLATES SHALL CONFORM TO THE REQUIREMENTS OF ASTM A 36 AND STRUCTURAL TUBING TO ASTM A 500. WELDING SHALL MEET THE CURRENT REQUIREMENTS OF THE AMERICAN WELDING SOCIETY STRUCTURAL WELDING CODE AWS/AWS D14. ALL STRUCTURAL STEEL SHALL BE GALVANIZED IN ACCORDANCE WITH ASTM A 123. NO PUNCHING, DRILLING, CUTTING OR WELDING WILL BE PERMITTED AFTER GALVANIZING.
4. POST B IS FABRICATED SIMILAR TO POST A BY ADDING THE GALVANIZED STRUCTURAL TUBE (SEE SERIAL 606-06-2/3 DETAIL B) BEFORE GALVANIZING.

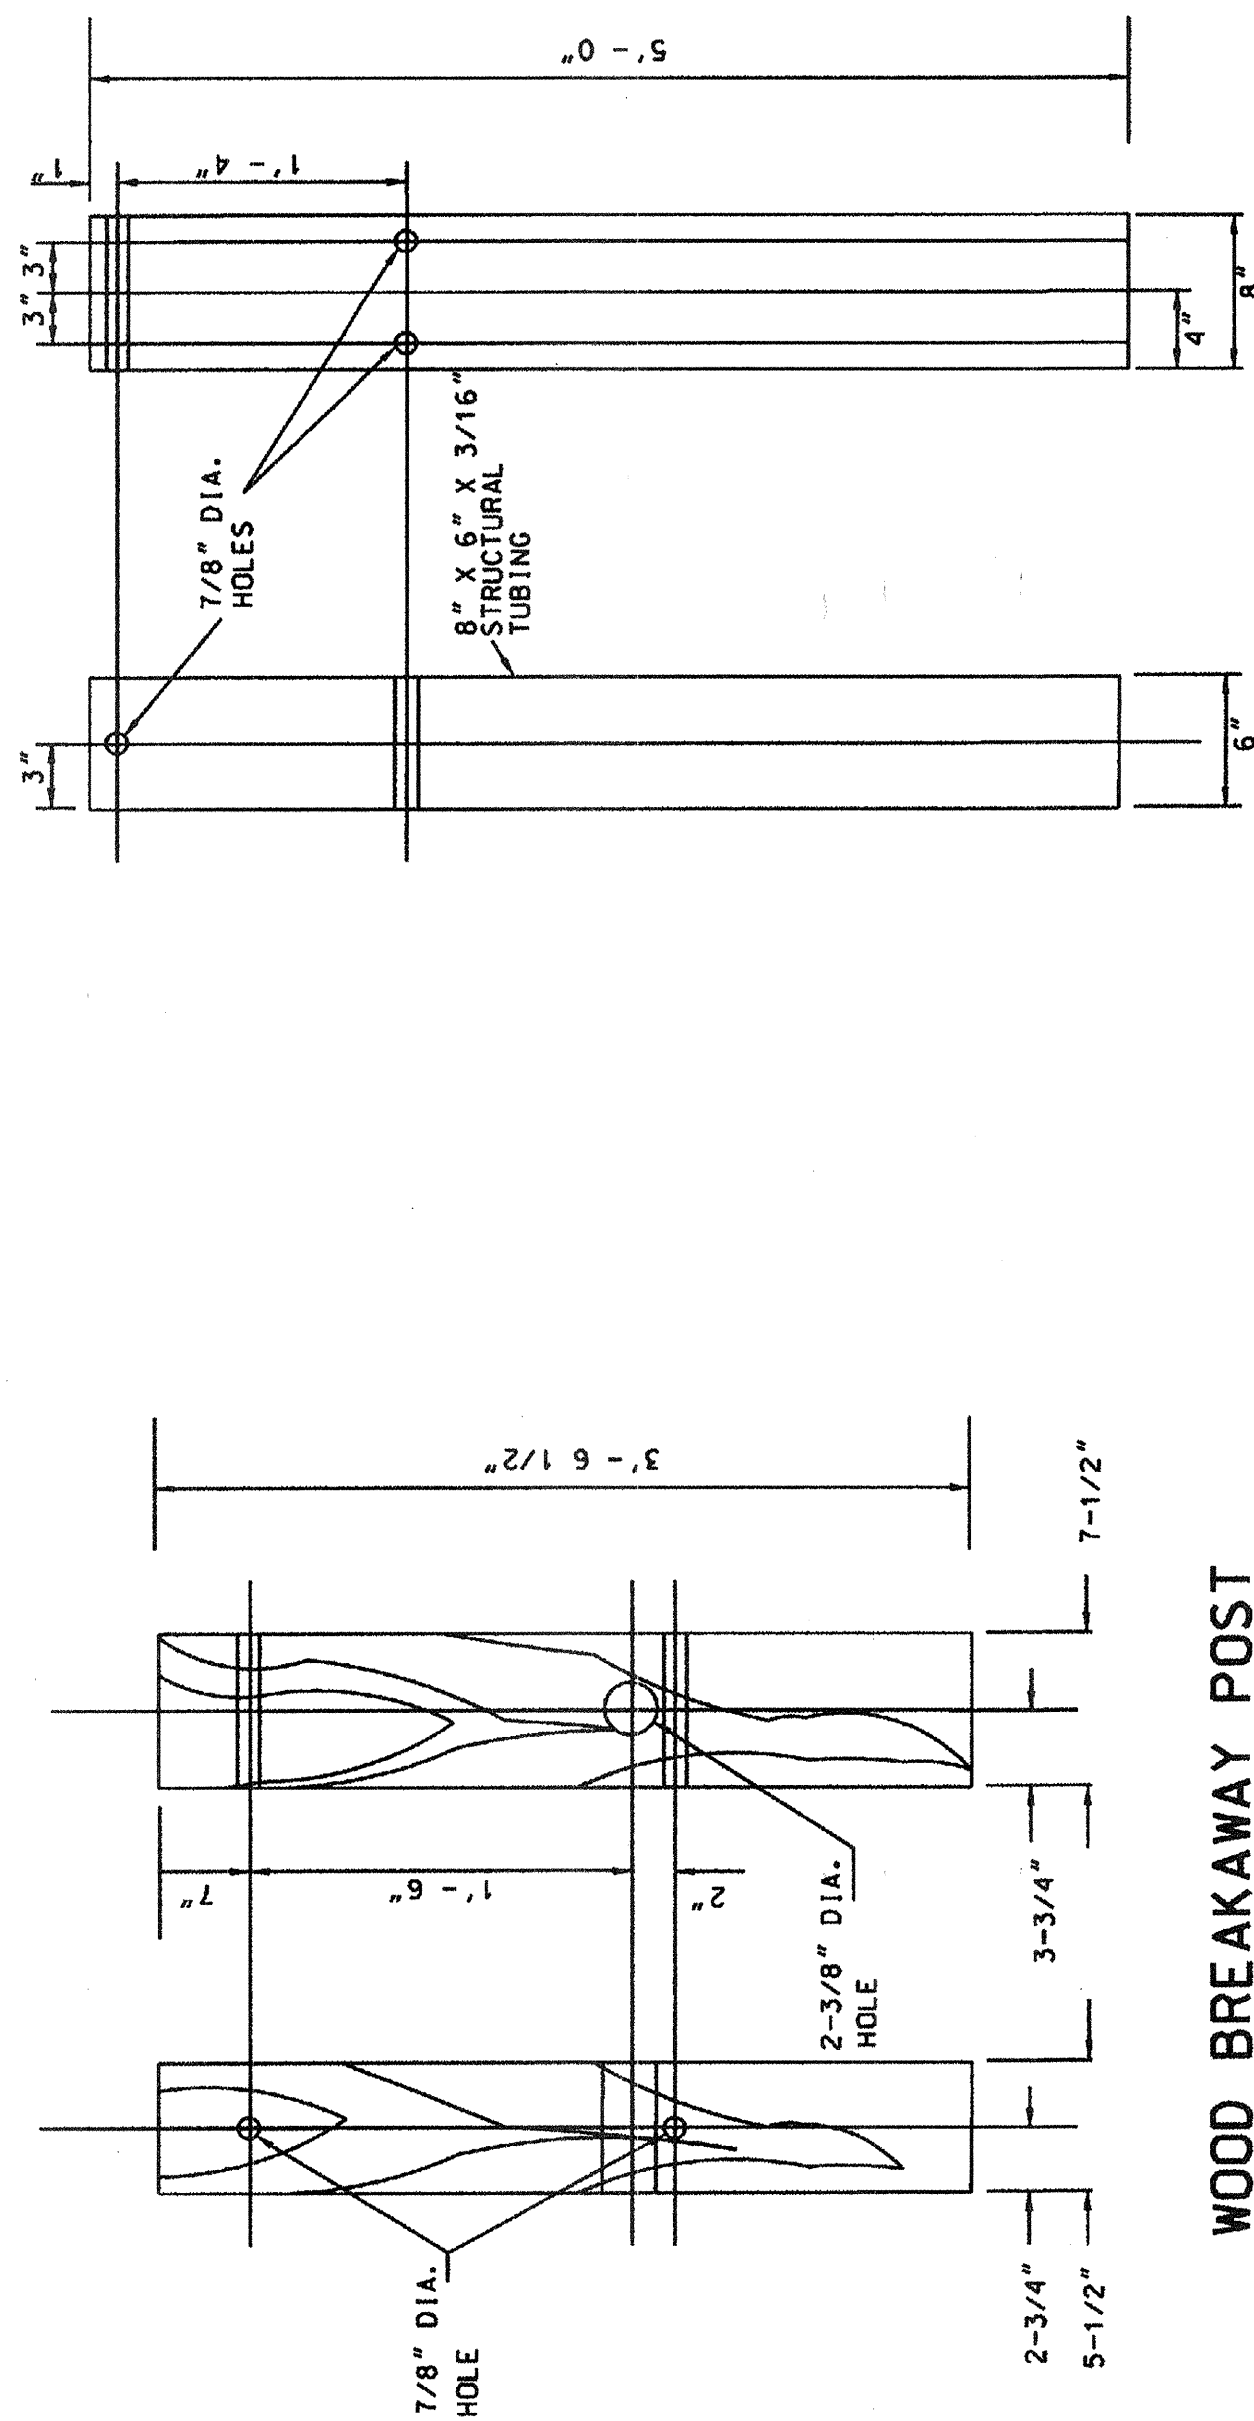

STEEL TUBE (POST A)

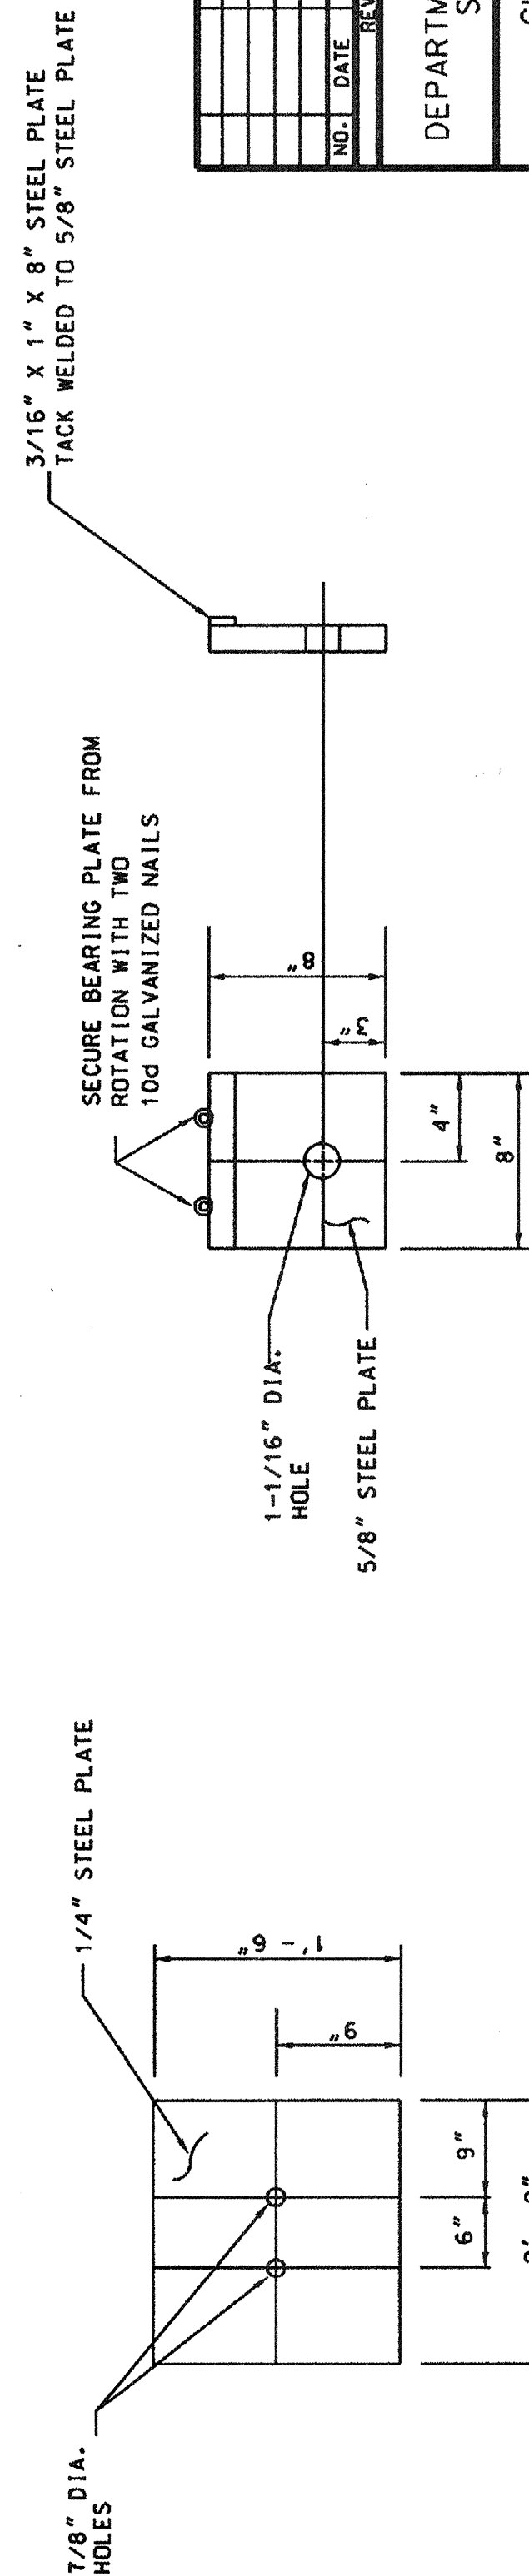

BEARING PLATE

SOIL PLATE

[illegible]

TRAFFIC SIGNAL NOTES

- ALL WORK ON THESE PLANS TO BE PERFORMED UNDER THIS CONTRACT SHALL CONFORM TO THE CURRENT NATIONAL ELECTRIC CODE, THE STANDARDS OF THE NATIONAL BOARD OF FIRE UNDERWRITERS FOR ELECTRICAL WIRING AND APPARATUS, AND THE CITY'S TRAFFIC ENGINEERING OPERATIONS THIRD DRAFT SPECIFICATIONS (JUNE 1994).
- LOCATIONS OF CONDUITS, FOUNDATIONS, CONTROL CABINETS, POLES, PULL BOXES, MANHOLES, AND SPLICE CABINETS SHOWN ON THE PLANS ARE SCHEMATIC AND SHALL BE ADJUSTED IN THE FIELD TO AVOID UTILITY CONFLICTS AND TO MAXIMIZE CLEAR SPACE AVAILABLE FOR PEDESTRIANS AND WHEELCHAIRS TO COMPLY WITH THE AMERICANS WITH DISABILITIES ACT. THE CONTRACTOR SHALL MEET WITH THE CITY'S TRAFFIC ENGINEERING OPERATIONS PERSONNEL IN THE FIELD AT ALL LOCATIONS TO SPOT EQUIPMENT BEFORE BEGINNING THE WORK. ALL SUCH EQUIPMENT SHALL BE INSTALLED WITHIN THE RIGHT-OF-WAY. FOUNDATIONS, POLES, CONTROL CABINETS, AND SPLICE CABINETS SHALL NOT BE PLACED IN THE PEDESTRIAN PATH.
- THE CONTRACTOR IS WARNED THAT EXISTING CONDUITS MAY CONTAIN AC POWER AND CAUTION SHALL BE EXERCISED IN INTERCEPTING OR INSTALLING CABLE IN EXISTING CONDUIT.
- THE CONTRACTOR SHALL BORE, DRILL, OR PUSH WHEN CROSSING EXISTING PAVEMENTS AND ANY DRIVEWAYS FOR SIDE STREET CROSSINGS. BEFORE CONDUIT CAN BE BORED, DRILLED, OR PUSHED THE CONTRACTOR SHALL LOCATE ALL EXISTING UTILITIES. THE CONTRACTOR SHALL LOCATE AND EXPOSE GAS LINES WHICH CROSS ANY PROPOSED BORES. THESE EXCAVATIONS SHALL REMAIN OPEN UNTIL AFTER THE BORE IS COMPLETE. CONTRACTOR SHALL REMOVE AND REPLACE IN KIND ANY SIDEWALK OR PAVEMENT REQUIRED TO EXPOSE SUCH LINES. THE CONTRACTOR MAY CUT, TRENCH, AND REPLACE EXISTING PAVEMENT ONLY WHEN APPROVED BY THE PROJECT MANAGER.
- ALL NEW LOOP LEAD-IN CABLES SHALL BE TAGGED AT THE CONTROL CABINET TO IDENTIFY EACH CABLE BY PHASE AND LOOP NUMBER. ALL OPTICAL DETECTOR CABLE SHALL BE TAGGED AT THE CONTROL CABINET TO IDENTIFY EACH BY DIRECTION AND LOCATION.
- THE CONTRACTOR SHALL NOTIFY THE CITY OF ALBUQUERQUE TRAFFIC ENGINEERING OPERATIONS (857-8000) THREE WORKING DAYS IN ADVANCE OF ANY ANTICIPATED WORK ON SIGNALS. TRAFFIC ENGINEERING OPERATIONS PERSONNEL WILL ASSIST THE CONTRACTOR IN FIELD LOCATION OF EQUIPMENT, AND MUST BE PRESENT WHEN SIGNALS ARE SHUT-OFF OR TURNED ON. THE CONTRACTOR SHALL ALSO NOTIFY THE CITY OF ALBUQUERQUE TRAFFIC ENGINEERING OPERATIONS EACH TIME A TRAFFIC SIGNAL CONTROLLER DOOR IS OPENED.
- LIVE UNUSED CONDUCTORS WILL NOT BE ALLOWED AT MASTARM POLES AND PEDESTAL POLES. ALL SUCH UNUSED CONDUCTORS SHALL BE DISCONNECTED AT THE LARGE PULL BOX ADJACENT TO THE POLE. ALL WIRE SPLICES SHALL BE WATERPROOF. ALL UNUSED CONDUCTORS SHALL BE WATERPROOFED USING NYLON CRIMPED ON WIRE CAPS.
- IF TRENCH WIDTHS LESS THAN 12" ARE PROPOSED BY THE CONTRACTOR, APPROVED COMPACTION METHODS SHALL BE USED DURING BACKFILL TO PREVENT LATENT TRENCH FAILURES. THE CONTRACTOR SHALL USE GROUT OR LEAN FILL AS APPROVED BY THE PROJECT MANAGER IN LIEU OF EARTH BACKFILL.
- THE CITY OF ALBUQUERQUE TRAFFIC ENGINEERING OPERATIONS PERSONNEL WILL PROVIDE TRAFFIC SIGNAL TIMING PLANS AND WILL PROGRAM TRAFFIC SIGNAL CONTROLLERS.
- FOR CONDUITS CONTAINING ONLY LOW VOLTAGE COMMUNICATIONS CABLES, THE REQUIREMENTS FOR A SINGLE CONDUCTOR BARE COPPER #8 AWG MAY BE WAIVED WHERE PERMITTED BY THE NATIONAL ELECTRIC CODE.
- EXISTING CONDUITS TO BE REMOVED OR ABANDONED SHALL HAVE ALL WIRING REMOVED.
- EXISTING CONDUITS SHALL BE REPAIRED, ADJUSTED, OR REPLACED AS DIRECTED BY THE PROJECT MANAGER WHERE ELECTRICAL PULL BOXES OR TRAFFIC MANHOLES ARE INSTALLED OR REPLACED.
- THE CONTRACTOR SHALL PROVIDE OFF-DUTY POLICE OFFICERS TO DIRECT TRAFFIC WHEN SIGNALS ARE TURNED OFF.
- ALL DATA SHOWN HEREIN CONCERNING EXISTING UTILITIES HAS BEEN OBTAINED FROM "AS-BUILT" DRAWINGS AND FROM FIELD OBSERVATIONS AND LIMITED UNDERGROUND EXPLORATION WHICH MAY OR MAY NOT BE ACCURATE. THE CONTRACTOR WILL BE RESPONSIBLE FOR ADDITIONAL EXPLORATORY POT-HOLING OR TRENCHING, AS DETERMINED NECESSARY BY THE CONTRACTOR TO MORE SPECIFICALLY LOCATE UTILITY LINES PRIOR TO INSTALLATION OF FOUNDATIONS OR CONDUITS TO ENSURE NO CONFLICTS EXIST. COST OF LOCATING UTILITY LINES INCLUDING EXPLORATORY TRENCHING WILL BE CONSIDERED INCIDENTAL TO CONSTRUCTION.
- THE FOLLOWING CITY OF ALBUQUERQUE STANDARD DRAWING SHALL BE USED FOR THIS PROJECT:
2550 TRAFFIC SIGNAL PULL BOX DETAIL

TRAFFIC SIGNAL ESTIMATED QUANTITIES

ITEM #	ITEM DESCRIPTION	UNIT	ESTIMATED QUANTITY
0424.006	RIGID ELECTRICAL CONDUIT, 2" INCLUDING TRENCH, BACKFILL, PATCHING, PUSHING, BORING, & JACKING	LIN FT	255
0424.101	ELECTRICAL CONDUIT, ANY SIZE, REMOVE & DISPOSE, COMPL.	LIN FT	230
0425.003	ELECTRICAL PULL BOX, (LARGE)	EACH	2
0425.101	ELECTRICAL PULL BOX, ANY TYPE, REMOVE & DISPOSE	EACH	3
0426.010	MULTI-CONDUCTOR CABLE #5, CIP	LF	180
0426.101	EXISTING WIRING, REMOVE & DISPOSE, CIP	LF	180
0427.002	3 SECTION TRFFIC SIGNAL ASSEMBLY, CIP	EA	3
0427.101	TRAFFIC SIGNAL ASSEMBLY, ANY TYPE, REMOVE & SALVAGE, COMPL.	EA	3
0428.021	LOOP DETECTOR WIRE	LIN FT	1872
0428.050	LOCP LEAD-IN CABLE	LIN FT	1290
0428.060	DETECTOR SAWCUT	LIN FT	659

AS-BUILT INFORMATION		BENCH MARKS		SURVEY INFORMATION		ENGINEER'S SEAL		REVISIONS		DESIGN		DATE		DATE	
CONTRACTOR: Robinson DATE: 1-2-07		ACS CONTROL MONUMENT		NO.		PAUL F. STEFFIN REGISTERED PROFESSIONAL ENGINEER		NO. DATE		DESIGNED BY: PFS		DATE: 05/2007		DRAWN BY: LAH	
INSPECTED BY: Surf-Tek DATE: 1-2-07		1 3/4" ALUMINUM DISK STAMPED "ACS BM 6-B13"		BY				REMARKS		CHECKED BY: KOT		DATE: 05/2007		DATE: 05/2007	
FIELD VERIFICATION BY: Robinson DATE: 1-2-07		LOCATED ON TOP OF CONCRETE BRIDGE SLEEPER SLAB, SOUTHEASTERLY QUADRANT OF EAGLE RANCH RD NW AND THE CA ABASILLAS ARROYO						REVISIONS							
CORRECTED BY: BLT DATE: 1-2-07								DESIGN							
MICRO-FILM INFORMATION		ELEVATION = 5085.637 FT. (NVD 1929)													
RECORDED BY: NO.															


Bohannon & Huston
Court yard | 7500 Jefferson St NE Albuquerque, NM 87109-4335
ENGINEERING • SPATIAL DATA • ADVANCED TECHNOLOGIES

**CITY OF ALBUQUERQUE**
DEPARTMENT OF MUNICIPAL DEVELOPMENT

COSTCO PUBLIC INFRASTRUCTURE
COORS BOULEVARD/COORS BYPASS
TRAFFIC SIGNAL NOTES AND ESTIMATED QUANTITIES

DESIGN REVIEW COMMITTEE	CITY ENGINEER APPROVAL	MO./DAY/YR.	MO./DAY/YR.
APPROVED SEP 25 2007 DESIGN REVIEW COMMITTEE	APPROVED OCT 31 2007 DESIGN REVIEW COMMITTEE		
LAST DESIGN UPDATE			


CITY PROJECT NO.	ZONE MAP NO.	SHEET	OF
729082	B-13, B-14, C-13, D-13	19	22

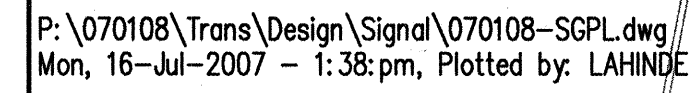


- | FIELD NOTES | | | BENCH MARKS | | AS-BUILT INFORMATION | |
|-------------|----|------|---|-------------------------------------|----------------------|--|
| NO. | BY | DATE | | | | |
| | | | ACS CONTROL MONUMENT | WORKED BY <u>Robinson</u> | DATE <u>1-20-07</u> | |
| | | | 1 3/4" ALUMINUM DISK STAMPED "ACS BM, 6-B13" | INSTRUMENTED BY <u>Robinson</u> | DATE <u>1-20-07</u> | |
| | | | LOCATED ON TOP OF CONCRETE BRIDGE SLEEPER SLAB, | FIELD VERIFICATION BY <u>BHI</u> | DATE <u>1-20-07</u> | |
| | | | SOUTHEASTERLY QUADRANT OF EAGLE RANCH RD NW | FIELD CORRECTION BY <u>Robinson</u> | DATE <u>1-20-07</u> | |
| | | | AND THE CALABASILLAS ARROYO | FIELD CORRECTION BY <u>BHI</u> | DATE <u>1-20-07</u> | |
| | | | ELEVATION = 5065.637 FT. (NGVD 1929) | MICRO-FILM INFORMATION | | |
| | | | | RECORDED BY | DATE | |
| | | | | NO. | DATE | |


NO.	DATE	REMARKS	BY
DESIGN REVISIONS			
DESIGN			

DESIGNED BY	PJ'S	DATE 06 / 2007
DRAWN BY	LAH	DATE 06 / 2007
CHECKED BY	KDF	DATE 06 / 2007

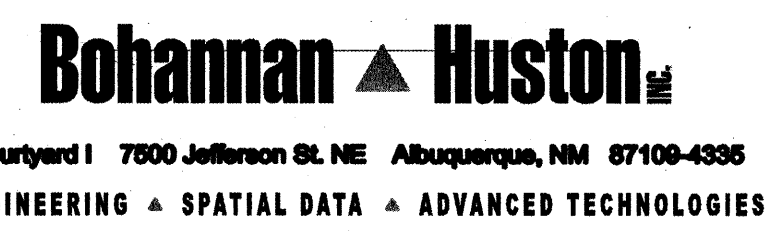


 DESIGN REVIEW COMMITTEE	CITY ENGINEER APPROVAL	LAST DESIGN UPDATE	MO./DAY/YR.	MO./DAY/YR.
				

CITY PROJECT NO.	729082	ZONE MAP NO.	B-13, B-14, C-13, D-13	SHEET	20	OF	22
------------------	--------	--------------	------------------------	-------	----	----	----

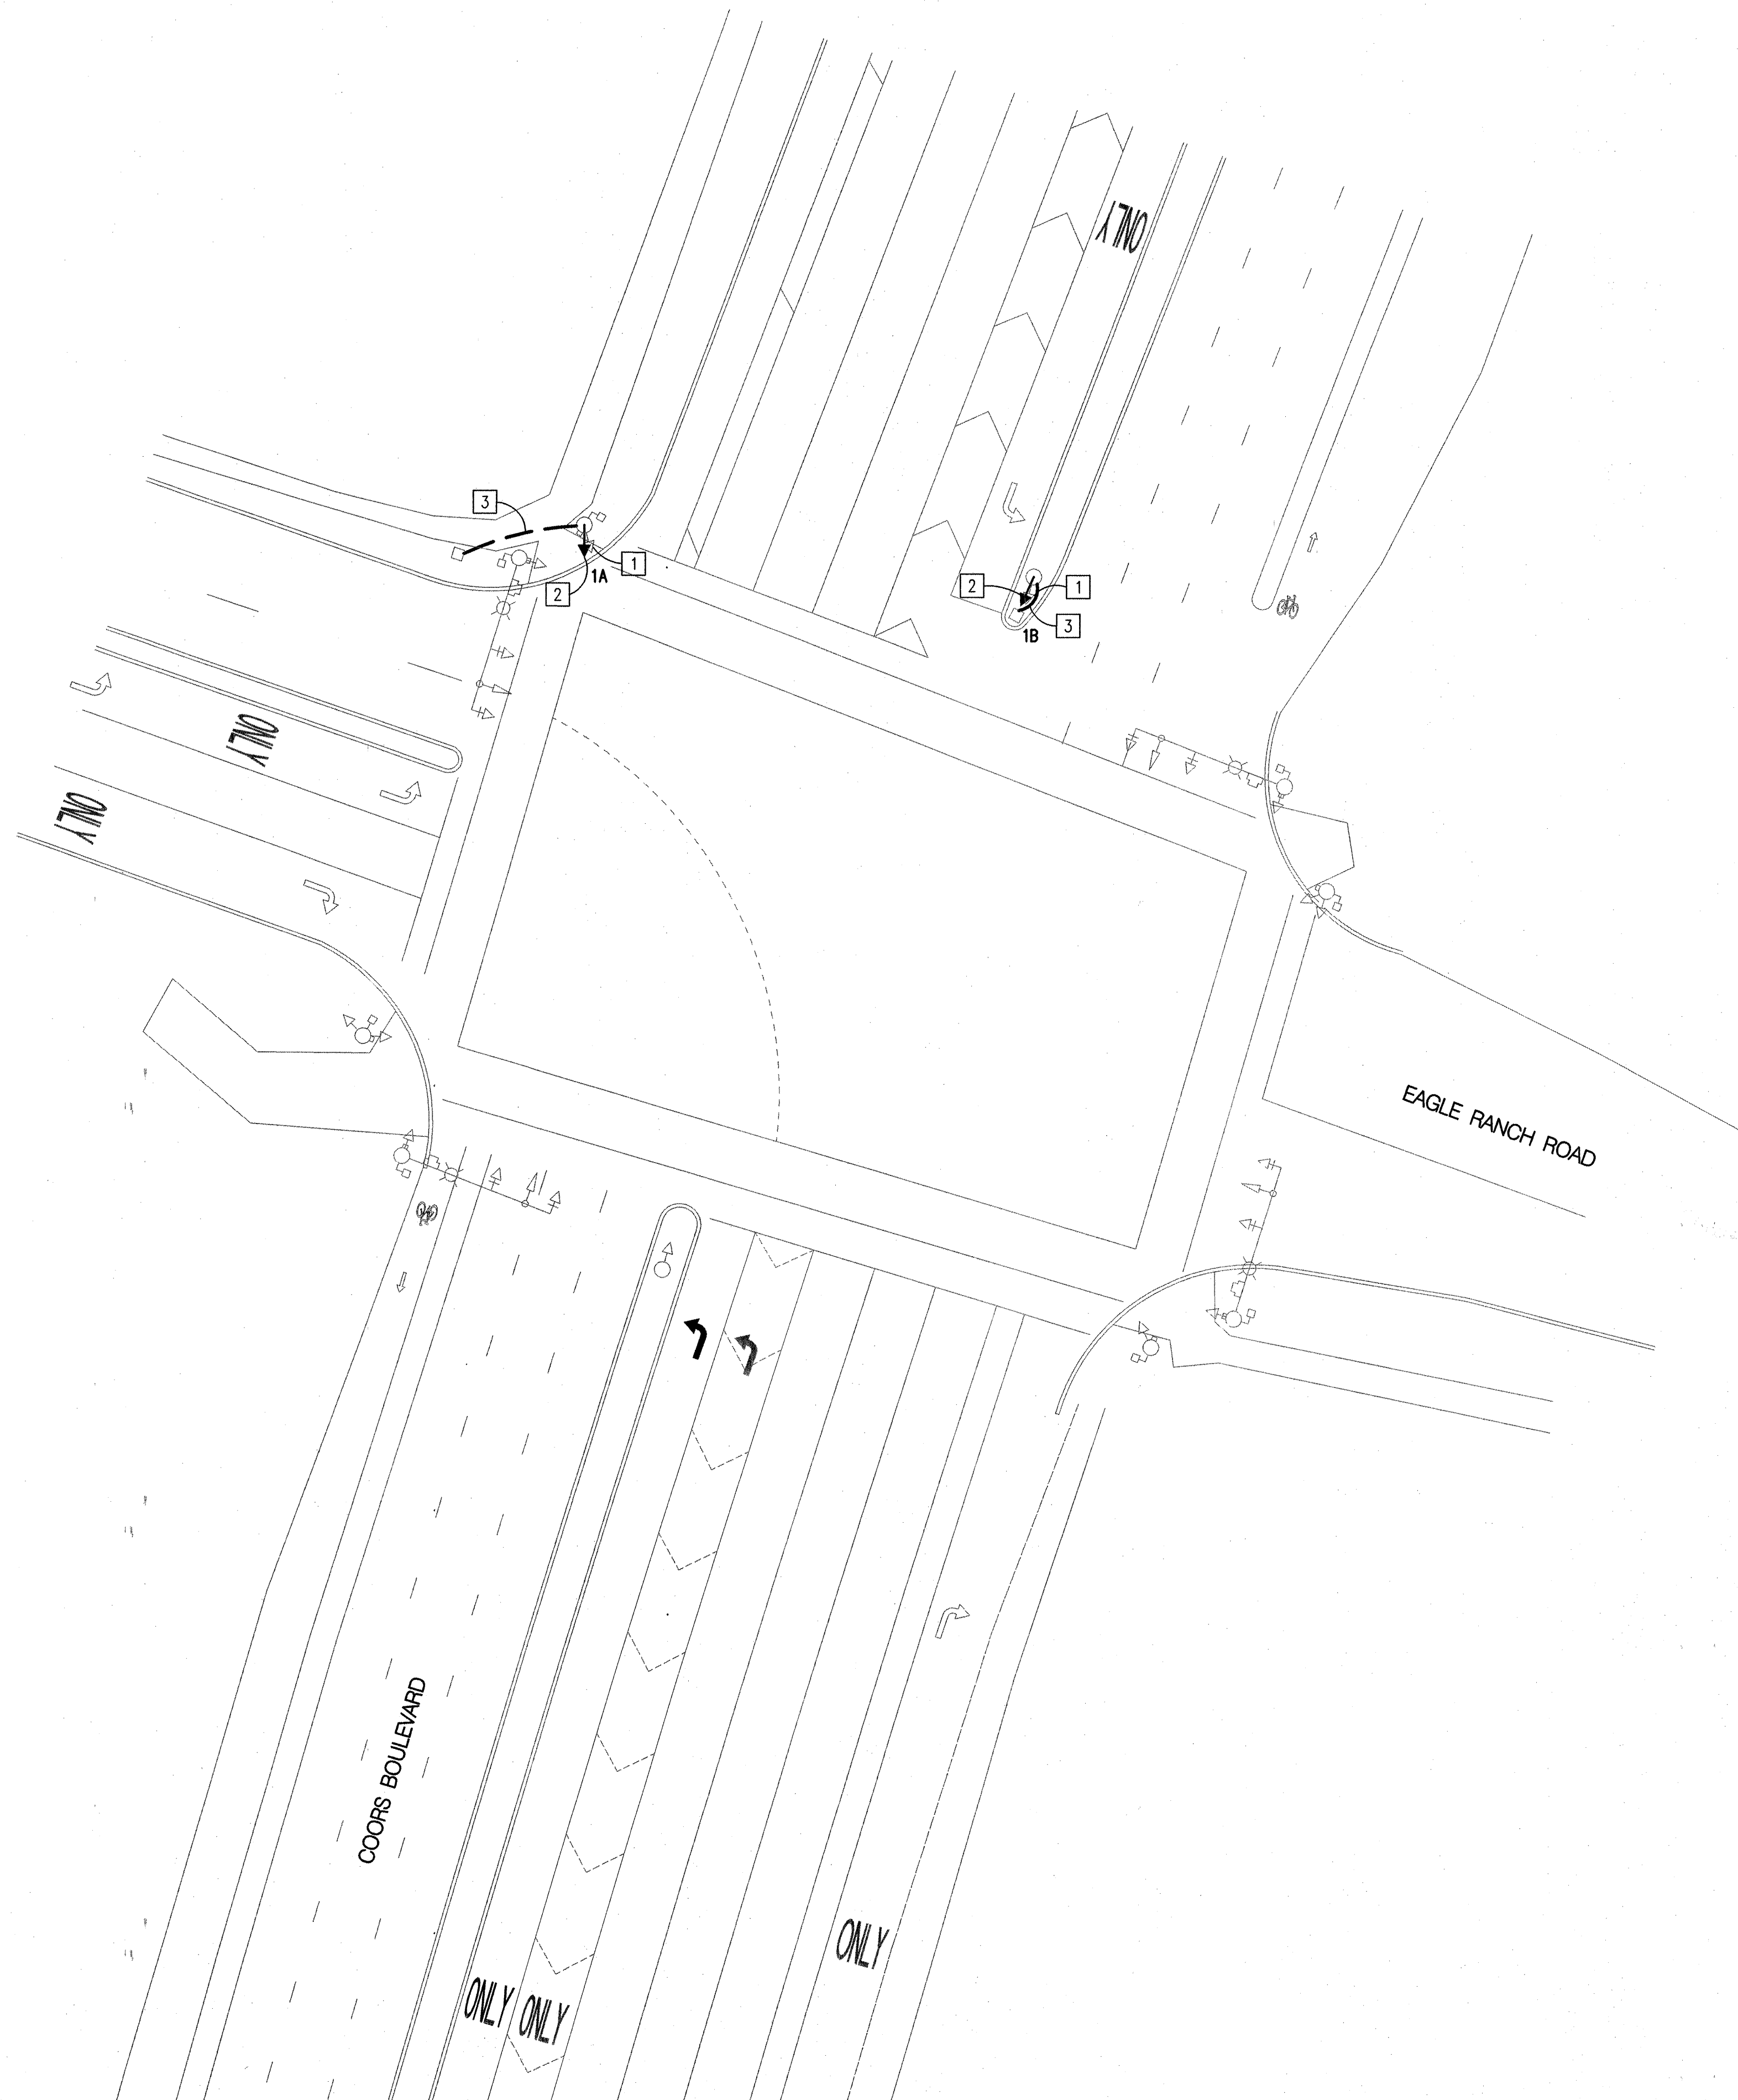

TYPICAL SIGNAL FACE
LENS ARRANGEMENTS

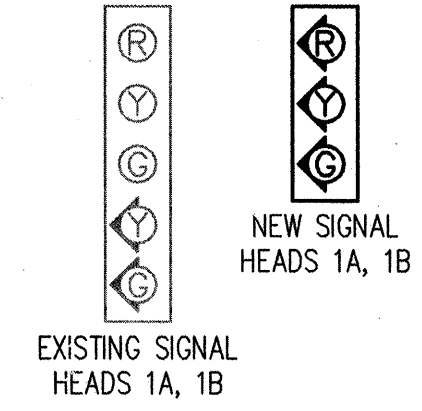


KEYED NOTES

- 1 REMOVE AND SALVAGE EXISTING SIGNAL HEAD
- 2 INSTALL NEW SIGNAL HEAD
- 3 REMOVE EXISTING #7 MULTI-CONDUCTOR CABLE FROM PULL BOX TO SIGNAL HEAD AND REPLACE WITH #5 MULTI-CONDUCTOR

NOTE

CONTRACTOR SHALL ADJUST VIDEO DETECTION TO INCLUDE ADDITIONAL LEFT TURN LANE.

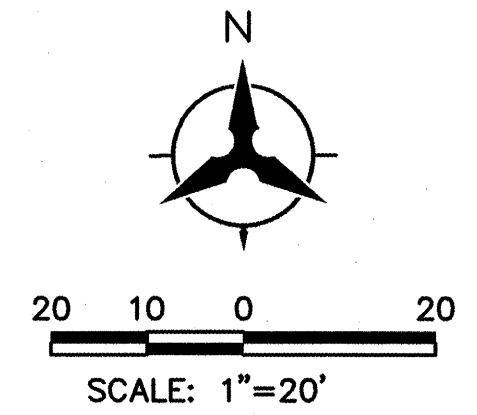


Bohannon & Huston

Courtyard I 7800 Jefferson St. NE Albuquerque, NM 87109-4335
ENGINEERING • SPATIAL DATA • ADVANCED TECHNOLOGIES



CITY OF ALBUQUERQUE
DEPARTMENT OF
MUNICIPAL DEVELOPMENT


COSTCO PUBLIC INFRASTRUCTURE
COORS BOULEVARD/EAGLE RANCH ROAD
SIGNAL MODIFICATION PLAN

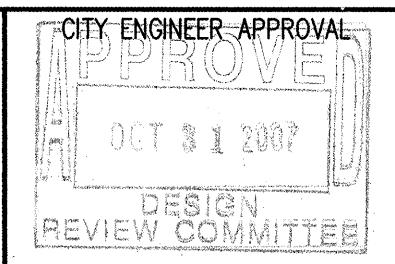

LAST DESIGN
UPDATE

MO./DAY/YR.	MO./DAY/YR.

CITY PROJECT NO.	ZONE MAP NO.	SHEET	OF
729082	B-13, B-14, C-13, D-13	21	22

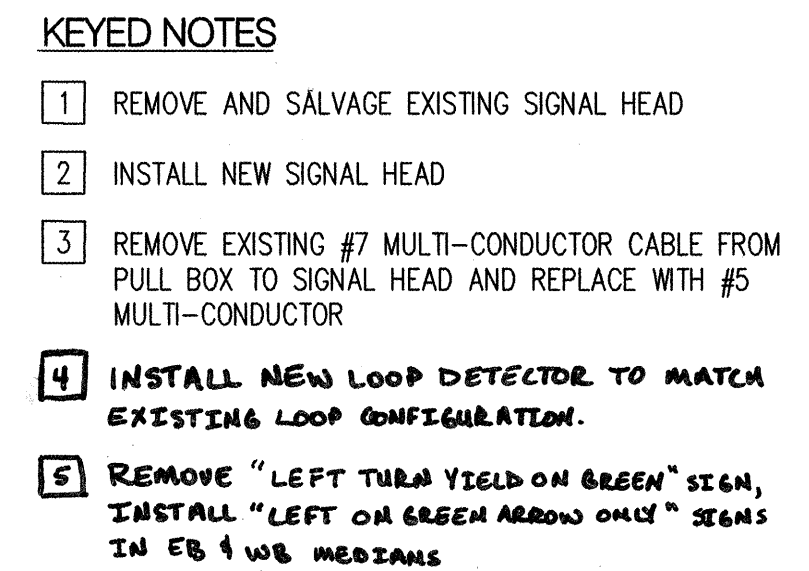

Bohannon  Huston, Inc.
 Courtyard I 7500 Jefferson St. NE Albuquerque, NM 87109-4335
ENGINEERING ▲ SPATIAL DATA ▲ ADVANCED TECHNOLOGIES







CITY OF ALBUQUERQUE

DEPARTMENT OF MUNICIPAL DEVELOPMENT

COSTCO PUBLIC INFRASTRUCTURE

COORS BYPASS/EAGLE RANCH ROAD

SIGNAL MODIFICATION PLAN

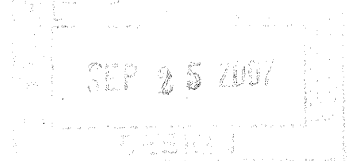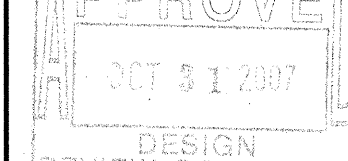DESIGN REVIEW COMMITTEE	CITY ENGINEER APPROVAL		MO./DAY/YR.	MO./DAY/YR.
		LAST DESIGN UPDATE		
CITY PROJECT NO. 729082		ZONE MAP NO. B-13, B-14, C-13, D-13		SHEET 22 OF 22