





CITY OF ALBUQUERQUE
PUBLIC WORKS DEPARTMENT
NEW MEXICO UTILITIES, INC.

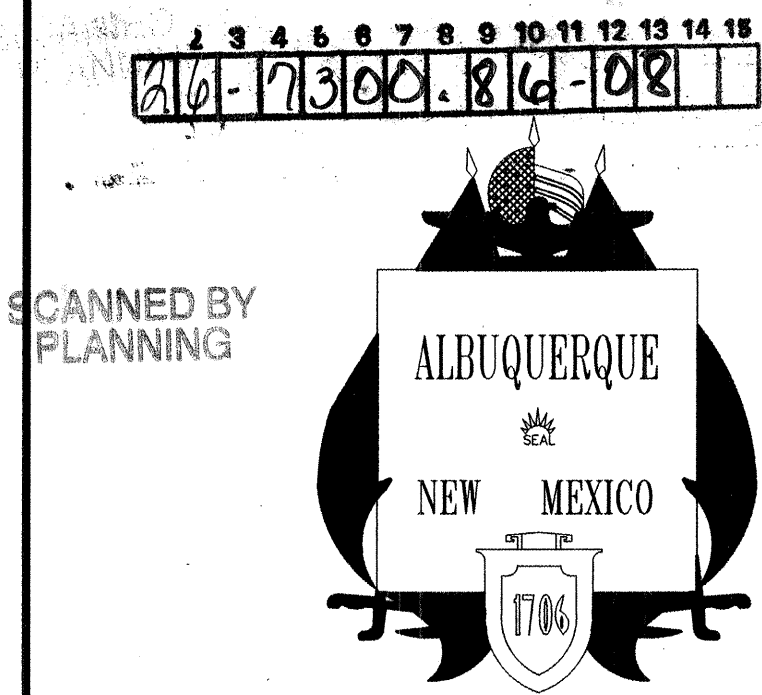

RECORD DRAWINGS
J. Allen Salinger of the firm of Smith Engineering Company, a Registered Professional Engineer in the State of New Mexico, do hereby state that to the best of my knowledge and belief, the infrastructure for this project as shown on the plans has been constructed in general accordance with the project plans and in general accordance with the City of Albuquerque Standard Specifications for Public Works Construction (Including all updates), and that the general intent of the plans has been met except as noted on the as-built construction drawings. The infrastructure construction has been observed by a qualified person from Smith Engineering Company and this statement covers infrastructure installation that was observed while a representative from Smith Engineering was on site. This statement is based on site observations by Smith Engineering Company personnel and on as-built information provided to Smith Engineering Company by Russ Hugg (Surveyor's name), NMPS number 9750 (PS#).

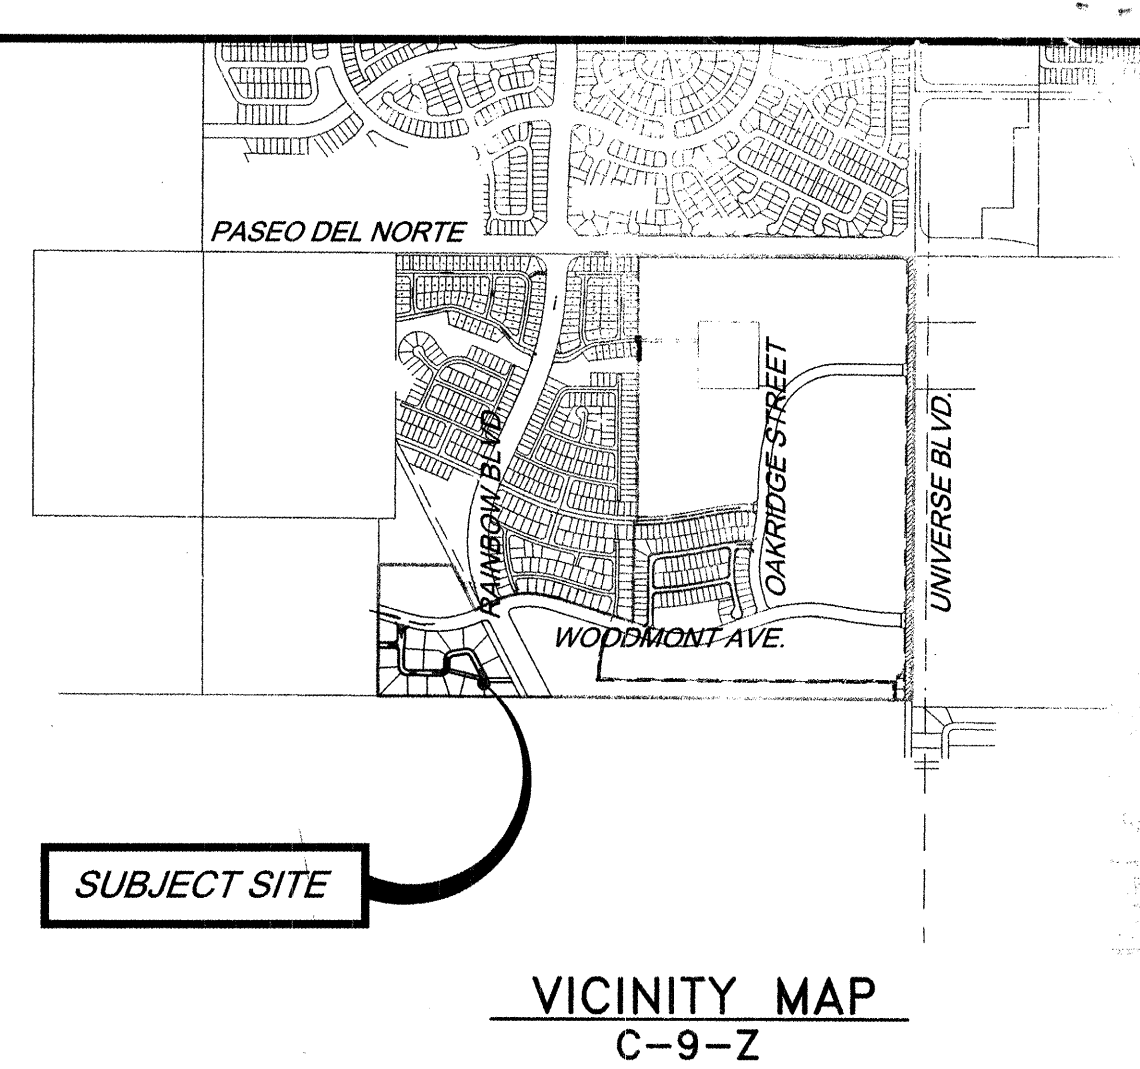

CONSTRUCTION PLANS
FOR
VALLE VISTA
AT THE TRAILS UNIT II
GRADING, PAVING, UTILITIES, & STORM DRAIN
INDEX TO DRAWINGS

SHEET No.	DESCRIPTION	SHEET No.	DESCRIPTION
1	COVER	12	COMPOSITE UTILITY PLAN
2	SUBDIVISION PLAT	13	VALLE PRADO PL NW STORM DRAIN & SANITARY SEWER PLAN & PROFILE
3-4	EROSION CONTROL PLAN	14	VALLE PRADO PL NW WATER, SEWER STORM DRAIN PLAN & PROFILE
5	GRADING & DRAINAGE PLAN	15	VALLE PRADO PL NW WATER, SEWER PLAN & PROFILE
6	TYPICAL LOT GRADING/RETAINING WALL DETAILS	16	VALLE JARDIN RD NW & UTILITY EASEMENT WATER, SEWER AND STORM DRAIN PLAN & PROFILE
7	COMPOSITE PAVING PLAN		
8	TYPICAL PAVING SECTIONS & PAVING DETAILS		
9	VALLE PRADO PL NW PAVING PLAN & PROFILE		
10	VALLE PRADO PL NW PAVING PLAN & PROFILE		
11	VALLE JARDIN RD NW PAVING PLAN & PROFILE		

SURVEYORS CERTIFICATION
I, Russ P. Hugg, New Mexico Professional Surveyor Number 9750, hereby certify that the as-built information shown hereon is the result of an actual field survey performed by me or under my direct supervision and that the same is true and correct to the best of my knowledge and belief;
Russ P. Hugg
NMPS No. 9750
4-17-2007

- GENERAL NOTES**
- ALL WORK DETAILED ON THESE PLANS TO BE PERFORMED UNDER THIS CONTRACT SHALL, EXCEPT AS OTHERWISE STATED OR PROVIDED HEREIN, BE CONSTRUCTED IN ACCORDANCE WITH THE CITY OF ALBUQUERQUE STANDARD SPECIFICATIONS FOR PUBLIC WORKS CONSTRUCTION, 1986 EDITION AS AMENDED THRU UPDATE NO. 7.
 - CONTRACTOR SHALL NOTIFY THE PROJECT ENGINEER NOT LESS THAN SEVEN (7) DAYS PRIOR TO STARTING WORK IN ORDER THAT THE ENGINEER MAY TAKE NECESSARY MEASURES TO INSURE THE PRESERVATION OF SURVEY MONUMENTS. CONTRACTOR SHALL NOT DISTURB PERMANENT SURVEY MONUMENTS WITHOUT THE CONSENT OF THE ENGINEER, AND SHALL BEAR THE EXPENSE OF REPLACING ANY THAT MAY BE DISTURBED WITHOUT PERMISSION. REPLACEMENT SHALL BE DONE ONLY BY THE CITY SURVEY SECTION. WHEN A CHANGE IS MADE IN ANY ROADWAY IN WHICH A PERMANENT SURVEY MONUMENT IS LOCATED, CONTRACTOR SHALL, AT HIS OWN EXPENSE, ADJUST THE MONUMENT COVER TO THE NEW GRADE UNLESS OTHERWISE SPECIFIED. REFER TO SECTION 4.4 OF GENERAL CONDITIONS OF THE CITY OF ALBUQUERQUE STANDARD SPECIFICATIONS FOR PUBLIC WORKS CONSTRUCTION.
 - FIVE (5) WORKING DAYS PRIOR TO BEGINNING CONSTRUCTION, THE CONTRACTOR SHALL SUBMIT TO THE CONSTRUCTION COORDINATION DIVISION A DETAILED CONSTRUCTION SCHEDULE. TWO (2) WORKING DAYS PRIOR TO CONSTRUCTION, THE CONTRACTOR SHALL OBTAIN A BARRICAADING PERMIT FROM THE CONSTRUCTION COORDINATION DIVISION. CONTRACTOR SHALL NOTIFY BARRICADE ENGINEER (924-3400) PRIOR TO OCCUPYING AN INTERSECTION. SEE SECTION 19 OF THE SPECIFICATIONS.
 - TWO (2) WORKING DAYS PRIOR TO ANY EXCAVATION, CONTRACTOR MUST CONTACT NEW MEXICO ONE CALL SYSTEM, INC. (260-1990) FOR LOCATION OF EXISTING UTILITIES.
 - PRIOR TO CONSTRUCTION, THE CONTRACTOR SHALL EXCAVATE AND VERIFY THE HORIZONTAL AND VERTICAL LOCATIONS OF ALL OBSTRUCTIONS AND EXISTING PAVEMENT. SHOULD A CONFLICT EXIST, THE CONTRACTOR SHALL NOTIFY THE ENGINEER OR SURVEYOR SO THAT THE CONFLICT CAN BE RESOLVED WITH A MINIMUM OF DELAY.
 - ALL UTILITY WORK SHALL BE CONSTRUCTED IN ACCORDANCE WITH NEW MEXICO UTILITIES, INC. SPECIFICATIONS FOR WATER AND WASTE WATER FACILITIES (MOST RECENT REVISIONS). (NMUI 898-2661)
 - THE CONTRACTOR SHALL NOTIFY NEW MEXICO UTILITIES (898-2661) THREE WORKING DAYS PRIOR TO BEGINNING THE CONSTRUCTION OF THE UTILITIES.
 - THE PUBLIC WATER LINE MUST BE A MINIMUM OF 18" ABOVE THE SEWER LINE AT ALL CROSSINGS.
 - ELECTRONIC MARKER DISKS (EMD) WILL BE PLACED ACCORDING TO SECTION 170 OF THE CITY OF ALBUQUERQUE STANDARD SPECIFICATIONS.
 - ALL UTILITIES AND UTILITY SERVICE LINES SHALL BE INSTALLED PRIOR TO PAVING.
 - BACKFILL COMPACTION SHALL BE ACCORDING TO SPECIFIED STREET USE.
 - TACK COAT REQUIREMENTS SHALL BE DETERMINED BY THE ENGINEER.
 - SIDEWALKS AND WHEELCHAIR RAMPS WITHIN THE CURB RETURNS SHALL BE CONSTRUCTED WHEREVER A NEW CURB RETURN IS CONSTRUCTED.
 - ALL STREET STRIPING ALTERED OR DESTROYED SHALL BE REPLACED BY CONTRACTOR WITH PLASTIC REFLECTORIZED PAVEMENT MARKINGS IN EXISTING STRIPING LOCATIONS UNLESS OTHERWISE INDICATED BY THIS PLAN SET.
 - ANY WORK AFFECTING AN ARTERIAL ROADWAY REQUIRES 24 HOUR CONSTRUCTION.
 - THE CONTRACTOR SHALL BE RESPONSIBLE FOR REPAIR, OR REMOVAL AND REPLACEMENT, OF ANY PAVEMENT, PAVEMENT MARKINGS, CURB AND GUTTER, DRIVEPADS, SIDEWALK, WHEELCHAIR RAMP OR ANY OTHER EXISTING IMPROVEMENTS DAMAGED BY THE CONTRACTOR'S OPERATIONS.
 - FOR STORM DRAIN CONSTRUCTION, RCP PIPE SHALL NOT BE GROUTED JOINTS TO FINAL INSPECTION. FINAL INSPECTION WILL DETERMINE JOINTS TO BE GROUTED FOR FINAL ACCEPTANCE OF THE CONSTRUCTION.
 - EXCAVATION, TRENCHING AND SHORING ACTIVITIES MUST BE CARRIED OUT IN ACCORDANCE WITH OSHA 29 CFR 1926.650 SUBPART P. THE CONTRACTOR SHALL BE RESPONSIBLE FOR HIS EMPLOYEES SAFETY.
 - WARNING--EXISTING UTILITY LINE LOCATIONS ARE SHOWN IN AN APPROXIMATE MANNER ONLY, AND SUCH LINES MAY EXIST WHILE NONE ARE SHOWN. THE LOCATION OF ANY SUCH EXISTING LINES IS BASED UPON INFORMATION PROVIDED BY THE UTILITY COMPANY, THE OWNER, OR BY OTHERS, AND THE INFORMATION MAY BE INCOMPLETE OR MAY BE OBSOLETE BY THE TIME CONSTRUCTION COMMENCES. THE ENGINEER HAS UNDER TAKEN NO FIELD VERIFICATION OF THE LOCATION, DEPTH, SIZE, OR TYPE OF EXISTING UNDERGROUND UTILITY LINES, MAKES NO REPRESENTATION THERE TO, AND ASSUMES NO RESPONSIBILITY OR LIABILITY THEREFOR. THE CONTRACTOR SHALL INFORM ITSELF OF THE LOCATION OF ANY UTILITY LINE IN OR NEAR THE AREA OF THE WORK IN ADVANCE OF AND DURING EXCAVATION WORK. THE CONTRACTOR IS FULLY RESPONSIBLE FOR ANY AND ALL DAMAGE CAUSED BY ITS FAILURE TO LOCATE, IDENTIFY, AND PRESERVE ANY AND ALL EXISTING UTILITIES. THE CONTRACTOR SHALL COMPLY WITH STATE STATUTES, MUNICIPAL AND LOCAL ORDINANCES, RULES AND REGULATIONS PERTAINING TO THE LOCATION OF THESE LINES AND FACILITIES, IN PLANNING AND CONDUCTING EXCAVATION, WHETHER BY CALLING OR NOTIFYING THE UTILITIES, COMPLYING WITH "BLUE STAKES" PROCEDURES, OR OTHERWISE.
 - PRIVATE STREETS REQUIRE STREET NAME SIGNS, STOP SIGNS AND ANY NECESSARY STRIPING. (DEVELOPER'S RESPONSIBILITY).

DRB CASE No. 1004606

WILSON & COMPANY
2600 THE AMERICAN ROAD S.E.
SUITE 100
RIO RANCHO, NEW MEXICO
87124
(505) 898-8021

UTILITY COMPANY CONTACTS

NEW MEXICO UTILITIES (Water & Sanitary Sewer) Bob Goy 4700 Irving Blvd., NW Suite 201 Albuquerque, New Mexico 87114 (505) 898-2661	PNM ELECTRIC 4201 Edith Blvd. NE Albuquerque, New Mexico 87107 (505) 241-0525	QWEST 201 3rd Street, NW Suite 700 Albuquerque, New Mexico 87102 David Muller (505) 245-8706	Comcast Digital Cable Rita Erickson 4611 Montbel Pl., NE Albuquerque, NM 87107 (505) 761-6235
AMAFCA Executive Engineer John Kelly 2600 Prospect Ave., NE Albuquerque, New Mexico 87107 (505) 884-2215	PNM GAS 4625 Edith Blvd., NE Albuquerque, New Mexico 87107 Elisabeth Goble (505) 241-7745	AT&T Dave Crowl 111 3rd St., NW Albuquerque, New Mexico 87103 (505) 842-2911	

NOTE
APPROVAL SIGNATURES REQUIRED FOR ENTITIES OTHER THAN CITY OF ALBUQUERQUE ARE PROVIDED ON INDIVIDUAL SHEETS.

NOTE
THE ENGINEER HAS UNDERTAKEN LIMITED FIELD VERIFICATION OF THE LOCATION, DEPTH, SIZE, OR TYPE OF EXISTING UNDERGROUND UTILITY LINES. MAKES NO REPRESENTATION PERTAINING THERETO AND ASSUMES NO RESPONSIBILITY OR LIABILITY THEREFOR. THE CONTRACTOR SHALL INFORM ITSELF OF THE LOCATION OF ANY UTILITY LINE IN OR NEAR THE AREA OF THE WORK IN ADVANCE OF AND DURING EXCAVATION WORK. THE CONTRACTOR IS FULLY RESPONSIBLE FOR ANY AND ALL DAMAGE CAUSED BY ITS FAILURE TO LOCATE, IDENTIFY, AND PRESERVE ANY AND ALL EXISTING UTILITIES. THE CONTRACTOR SHALL COMPLY WITH STATE STATUTES, MUNICIPAL AND LOCAL ORDINANCES, RULES AND REGULATIONS PERTAINING TO THE LOCATION OF THESE LINES AND FACILITIES IN PLANNING AND CONDUCTING EXCAVATION, WHETHER BY CALLING OR NOTIFYING THE UTILITIES, COMPLYING WITH "BLUE STAKES" PROCEDURES, OR OTHERWISE.

NOTE
THESE DRAWINGS DO NOT INCLUDE NECESSARY COMPONENTS FOR CONSTRUCTION SAFETY WHICH SHALL REMAIN THE RESPONSIBILITY OF THE CONTRACTOR.

NOTE
THIS DOCUMENT, AND THE IDEAS AND DESIGNS INCORPORATED HEREIN, ARE INTENDED FOR USE ON THIS PROJECT AND IS NOT TO BE USED, IN WHOLE OR IN PART, FOR ANY OTHER PROJECT WITHOUT THE WRITTEN AUTHORIZATION OF WILSON & COMPANY. IN THE EVENT OF UNAUTHORIZED USE, THE USER ASSUMES ALL RESPONSIBILITY AND LIABILITY WHICH RESULTS.

TRAFFIC CONTROL

TRAFFIC CONTROL FOR CONSTRUCTION SHALL BE IN ACCORDANCE WITH SECTION 2800 TEMPORARY TRAFFIC CONTROL OF THE CITY OF ALBUQUERQUE STANDARD SPECIFICATIONS FOR PUBLIC WORKS CONSTRUCTION, 2003 EDITION AS AMENDED THRU UPDATE NO. 7. CONTRACTOR SHALL SUBMIT CONSTRUCTION PHASING SCHEDULE FOR APPROVAL FROM DESIGN ENGINEER PRIOR TO CONSTRUCTION.

FIVE (5) WORKING DAYS PRIOR TO BEGINNING CONSTRUCTION THE CONTRACTOR SHALL SUBMIT TO THE CONSTRUCTION COORDINATION DIVISION A DETAILED CONSTRUCTION SCHEDULE. TWO (2) WORKING DAYS PRIOR TO CONSTRUCTION, THE CONTRACTOR SHALL OBTAIN A BARRICAADING PERMIT FROM THE CONSTRUCTION COORDINATION DIVISION. CONTRACTOR SHALL NOTIFY BARRICADE ENGINEER (924-3400) PRIOR TO OCCUPYING AN INTERSECTION. SEE SECTION 19 OF THE SPECIFICATIONS. ALL STREET STRIPING ALTERED OR DESTROYED SHALL BE REPLACED WITH PLASTIC REFLECTORIZED PAVEMENT MARKINGS BY CONTRACTOR TO LOCATION AS EXISTING OR AS SHOWN IN THIS PLAN SET.


REV	SHEETS	CITY ENGINEER	DATE	USER DEPARTMENT	DATE	USER DEPARTMENT	DATE
ENGINEERS STAMP & SIGNATURE		APPROVALS	ENGINEER	DATE	*****		
		DRC Chairman		7/15/06	APPROVED FOR CONSTRUCTION		
		Transportation		7/15/06			
		Water/Wastewater		7/15/06			
		Hydrology		7/15/06			
		N.M.U.I.					
		A.M.A.F.C.A.					
		Constr. Coord.					
City Project No.				730086	Sheet 1 Of 16		

DUST AND EROSION CONTROL GENERAL NOTES

1. EROSION AND SEDIMENT CONTROL MEASURES SHALL BE INSTALLED PRIOR TO ANY LAND DISTURBANCE.
2. CONTRACTOR SHALL IMPLEMENT AND MAINTAIN DUST CONTROL MEASURES TO MINIMIZE WIND BORNE EROSION OF MATERIALS FROM THE PROJECT AREA. DUST CONTROL MEASURES MAY INCLUDE BUT ARE NOT LIMITED TO PRE-WETTING, WATERING, MULCH, REVEGETATION, DRIFT/SILT FENCING, WOODEN LATH SNOW FENCING, GROUND COVERS, SOIL STABILIZERS, COMPACTION TO HARD SURFACE CRUST AND HALTING SOIL DISTURBANCE ACTIVITIES. DUST CONTROL MEASURES SHALL BE IMPLEMENTED AS DETERMINED IN CONSULTATION WITH THE CONTRACTOR, ENGINEER, AND THE CITY OF RIO RANCHO.
3. CONTRACTOR SHALL IMPLEMENT AND MAINTAIN EROSION CONTROL MEASURES TO MINIMIZE THE WATER BORNE EROSION OF SEDIMENT FROM THE PROJECT AREA. EROSION CONTROL MEASURES MAY INCLUDE BUT ARE NOT LIMITED TO GROUND COVERS, SOIL STABILIZERS, MULCH, REVEGETATION, CONTOUR GRADING, SWALES, BERMS, SEDIMENT PONDS, SEDIMENT/SILT FENCING, FILTER FABRICS AND/OR MATERIALS, AND STRAW BALES. EROSION CONTROL MEASURES SHALL BE IMPLEMENTED AS DETERMINED IN CONSULTATION WITH THE CONTRACTOR, ENGINEER, AND THE CITY OF RIO RANCHO.
4. ADDITIONAL DUST CONTROL AND/OR EROSION CONTROL MEASURES MAY BE REQUIRED DURING CONSTRUCTION DEPENDING ON UNFORESEEN CIRCUMSTANCES AND WEATHER CONDITIONS. ANY ADDITIONAL MEASURES SHALL BE IMPLEMENTED AS DETERMINED IN CONSULTATION WITH THE CONTRACTOR, ENGINEER, AND THE CITY OF RIO RANCHO.
5. CONTRACTOR SHALL MINIMIZE SOIL DISTURBANCE TO THE MAXIMUM EXTENT POSSIBLE. CLEAR AND GRUB WORK SHALL BE PERFORMED IN INCREMENTAL STEPS AS THE WORK PROGRESSES. REVEGETATION WORK SHALL ALSO BE PERFORMED IN INCREMENTAL STEPS AS THE WORK IS COMPLETED.
6. CONTRACTOR SHALL MAKE ARRANGEMENTS FOR AND OBTAIN CONSTRUCTION WATER IN ACCORDANCE WITH THE POLICIES AND REQUIREMENTS OF THE WATER PROVIDER. CONTACT THE CITY OF RIO RANCHO WATER & WASTEWATER DEPARTMENT AT 898-5020 x3008.
7. CONTRACTOR SHALL NOT ENTER ONTO PRIVATE PROPERTY TO IMPORT, EXPORT, OR HAUL MATERIAL WITHOUT WRITTEN PERMISSION FROM THE PROPERTY OWNER.
8. CONTRACTOR SHALL PRE-WET THE WORK AREA PRIOR TO SOIL DISTURBANCE AND SHALL WATER THE SITE AS NECESSARY TO CONTROL DUST DURING CONSTRUCTION. CONTRACTOR SHALL LEAVE THE SITE IN A WET-DOWN, STABLE CONDITION AT THE END OF EACH WORK DAY. A SUFFICIENT DUST CONTROL WATER SUPPLY AND DUST CONTROL EQUIPMENT SHALL BE MAINTAINED AT THE PROJECT SITE AT ALL TIMES.
9. TO MINIMIZE TRACKING OF SOIL AND GRAVEL ONTO PAVED STREETS, STABILIZED CONSTRUCTION ENTRANCES AND/OR A CONTRACTOR OPERATED STREET SWEEPER WILL BE USED TO CONTROL SOIL TRACKING.
10. IF SOIL OR WIND CONDITIONS ARE SUCH THAT DUST CANNOT BE CONFINED TO THE PROJECT SITE, CONTRACTOR SHALL VOLUNTARILY HALT SOIL DISTURBANCE ACTIVITIES UNTIL WINDS ABATE AND/OR DUST CAN BE EFFECTIVELY CONTROLLED.
11. ALL TRUCKS HAULING IMPORT, EXPORT OR ONSITE MATERIAL SHALL BE EQUIPPED WITH SOUND BEDS, SIDEBORDS, TAILGATES AND COVERS MAINTAINED IN GOOD WORKING ORDER. COVERS SHALL BE USED AT ALL TIMES DURING HAULING OPERATIONS.
12. CONTRACTOR SHALL PROMPTLY CLEAN UP ANY MATERIAL SPILLED, CARRIED, TRACKED OR ERODED ONTO ADJACENT PRIVATE PROPERTY OR PUBLIC RIGHT-OF-WAY. CONTRACTOR SHALL BE RESPONSIBLE FOR THE CLEANUP AND REMOVAL OF WATER BORNE AND WIND BORNE MATERIAL WHICH ORIGINATES FROM THE WORK AREA AND IS ATTRIBUTABLE TO PROJECT CONSTRUCTION.
13. DRIFT/SILT FENCING SHALL BE ADP ENTERPRISES, INC. DURETHENE SNOW AND SAND CONTROL FENCING AWSF-4100-40, WOOD LATH SNOW FENCE OR APPROVED EQUAL INSTALLED AND MAINTAINED IN ACCORDANCE WITH MANUFACTURERS' RECOMMENDATIONS.
14. SEDIMENT/SILT FENCING SHALL BE AMOCO PROPEX SILT STOP, AMERICAN EXCELSIOR COMPANY SILT STOP, MIRAFI, INC. SILT FENCE OR APPROVED EQUAL INSTALLED AND MAINTAINED IN ACCORDANCE WITH MANUFACTURERS' RECOMMENDATIONS.
15. WHERE SOIL CONDITIONS PERMIT EFFECTIVE IMPLEMENTATION, CONTRACTOR MAY COMPACT DISTURBED SOIL AREAS TO A HARD SURFACE FOR TEMPORARY DUST CONTROL.
16. IN AREAS WHERE FUTURE SOIL DISTURBANCE OR CONSTRUCTION BY OTHERS IS IMMINENT AND WHEN THE INTERIM NON-WORK TIME PERIOD DOES NOT ENCOMPASS ANY TIME BETWEEN FEBRUARY 15 AND MAY 15, CONTRACTOR MAY GRADE, SHAPE, MOISTURE PROCESS AND COMPACT DISTURBED SOIL AREAS TO FORM A SMOOTH, HARD SURFACE CRUST AFTER CONSTRUCTION WORK IS COMPLETE.
17. EXCEPT AS OTHERWISE AUTHORIZED IN WRITING, CONTRACTOR SHALL GRADE, MULCH, CRIMP AND SEED ALL DISTURBED SOIL AREAS IN ACCORDANCE WITH CITY OF ALBUQUERQUE, SECTION 1012, NATIVE GRASS SEEDING WESTSIDE MIX, OF THE PROJECT SPECIFICATIONS.
18. THE CONTRACTOR AND THE CITY PROJECT MANAGER (OR HIS DESIGNEE) WILL INSPECT THE SITE EVERY TWO WEEKS AND AFTER ANY RAINFALL EVENT EXCEEDING 1/8 INCH. WRITTEN INSPECTION REPORTS WILL BE KEPT ON FILE ON SITE. CONTRACTOR WILL INSPECT ALL STORM WATER CONTROL MEASURES IN PLACE AND MAKE MODIFICATIONS OF CONTROL MEASURES AS PROJECT PROGRESSES TO BEST UTILIZE POLLUTION CONTROL MEASURES.
19. INSPECTION FORMS WILL BE SIGNED AND DATED BY THE CONTRACTOR AND THE CITY PROJECT MANAGER (OR HIS DESIGNEE).


SOLID & HAZARDOUS WASTE CONTROLS

1. ONSITE CHEMICAL TOILETS WILL BE PROVIDED BY THE CONTRACTOR AND WILL BE MAINTAINED BY THE CONTRACTOR FOR THE DURATION OF THE PROJECT.
2. TRASH CONTAINERS WILL BE PROVIDED BY THE CONTRACTOR, LOCATED BY EMPLOYEE LUNCH AND PARKING SITES, AND USED BY THE CONTRACTOR'S EMPLOYEES. CONTAINERS WILL BE EMPTIED AS NECESSARY.
3. NO HAZARDOUS MATERIALS WILL BE STORED ON THE PROJECT SITE. ANY FUEL STORED ONSITE WILL BE ENCLOSED BY SPILL CONTAINMENT STRUCTURES.
4. FUELING AND MINOR VEHICLE MAINTENANCE WILL BE DONE ON THE PROJECT SITE THROUGHOUT THE PROJECT DURATION. MAJOR VEHICLE OVERHAULS WILL BE DONE OFFSITE.
5. ANY FUEL SPILLS WILL BE IMMEDIATELY CONTAINED AND CLEANED UP BY THE CONTRACTOR. A SPILL KIT WILL BE LOCATED AT THE CONSTRUCTION OFFICE TRAILER LOCATION AND ALL OPERATORS WILL BE TRAINED IN THE USE OF THE SPILL KIT. EMERGENCY PHONE NUMBERS OF THE SAFETY DIRECTOR WILL ALSO BE POSTED IN THE CONSTRUCTION OFFICE TRAILER. CONTAMINATED SOIL WILL BE DISPOSED OF IN A MANNER PRESCRIBED FOR THE SPILLED MATERIAL. SPILL EMERGENCIES WILL BE REPORTED TO THE RIO RANCHO DEPARTMENT OF PUBLIC SAFETY, PHONE: 891-7226, OR CONTACT 911.
6. WEEKLY SAFETY MEETINGS WILL BE USED TO TRAIN AND REMIND EMPLOYEES AND SUBCONTRACTORS OF THE IMPORTANCE OF SAFETY, FIRST AID, POLLUTION PREVENTION AND THE USE OF SPILL KITS.

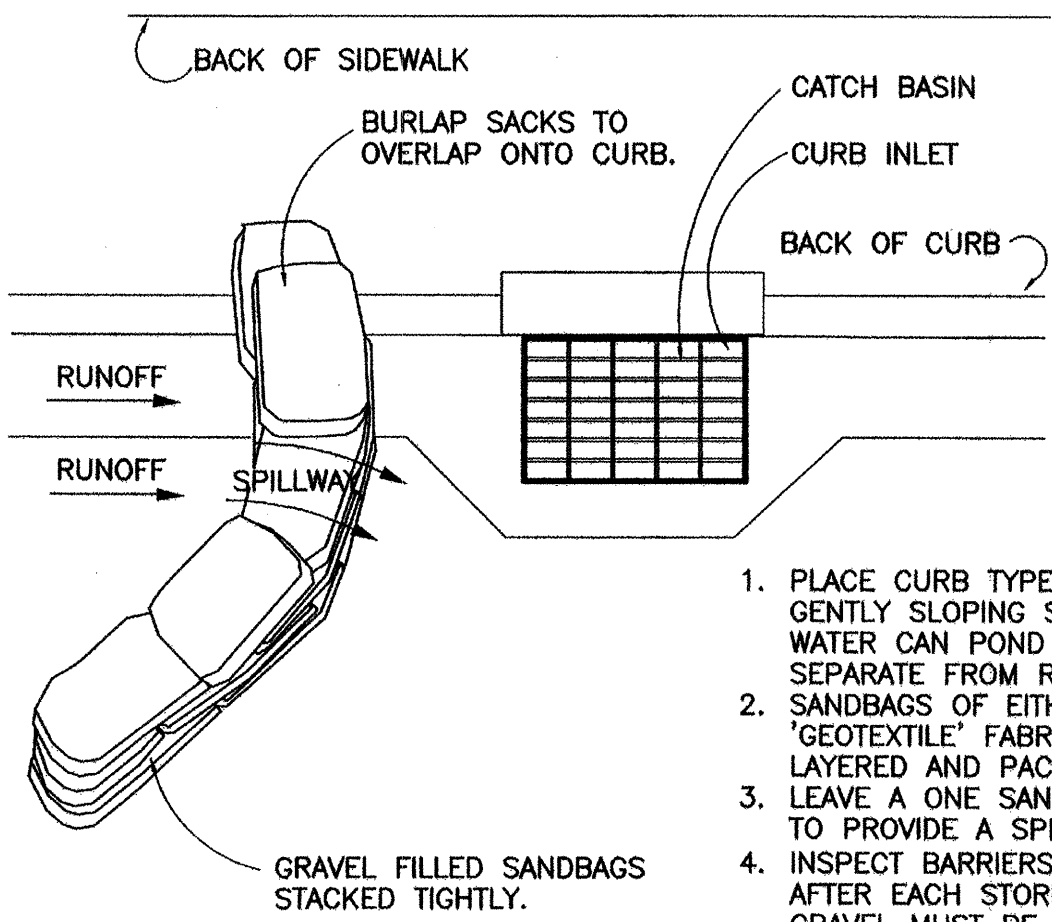


CURB AND GUTTER SEDIMENT BARRIER - PLAN VIEW

NTS

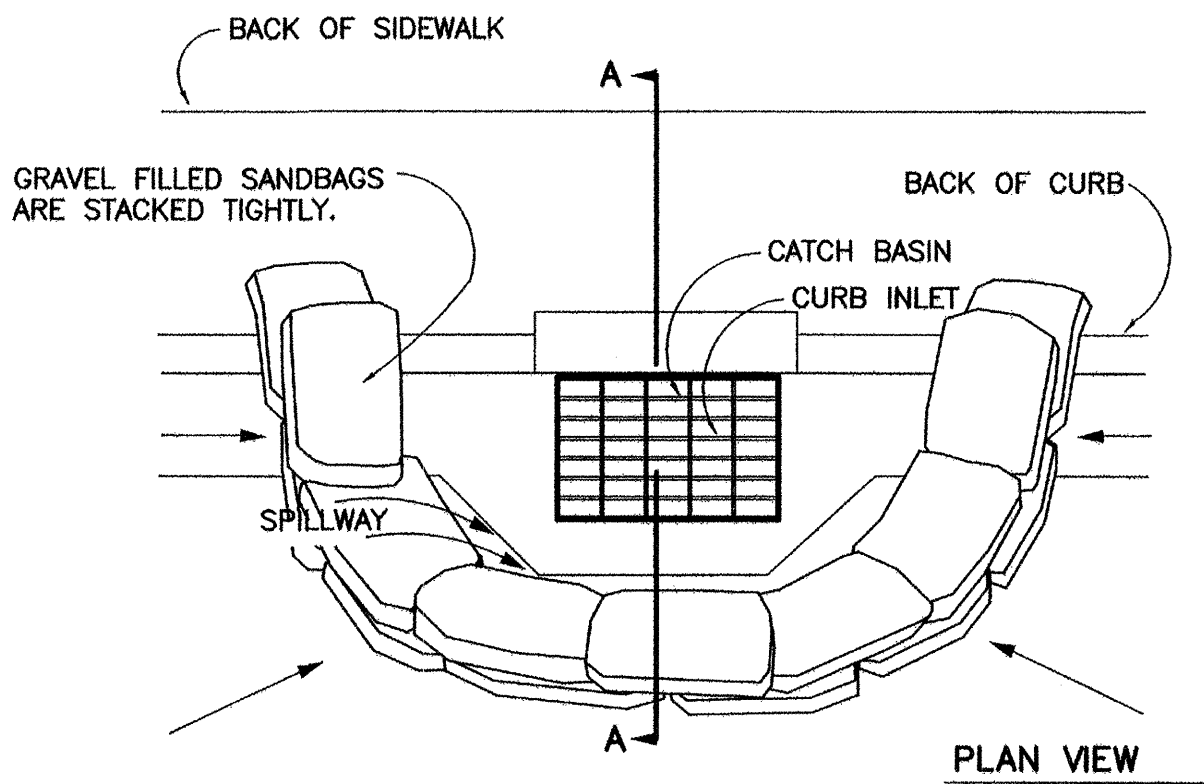


PLAN VIEW

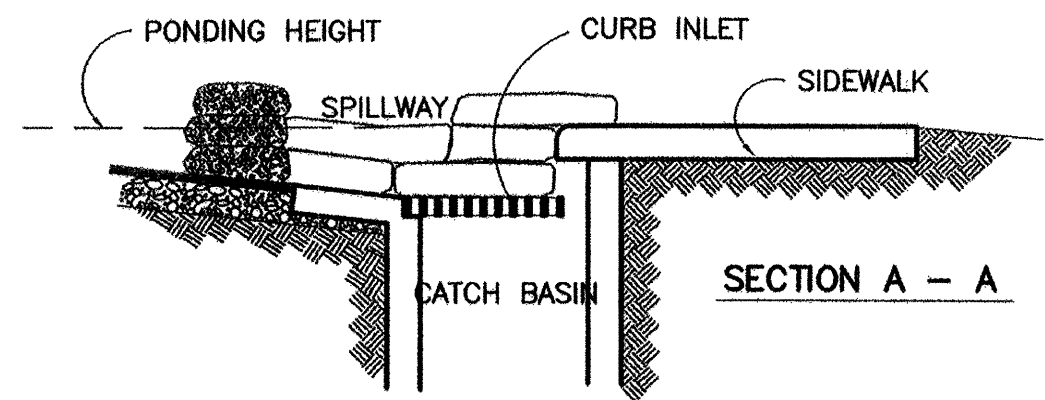


SECTION A - A

CURB INLET SEDIMENT BARRIER

NTS

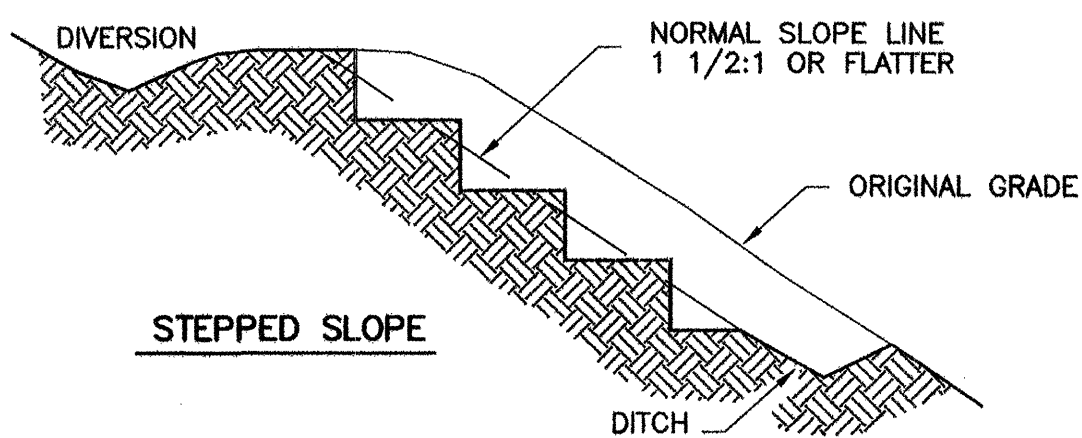


STEPPED SLOPE

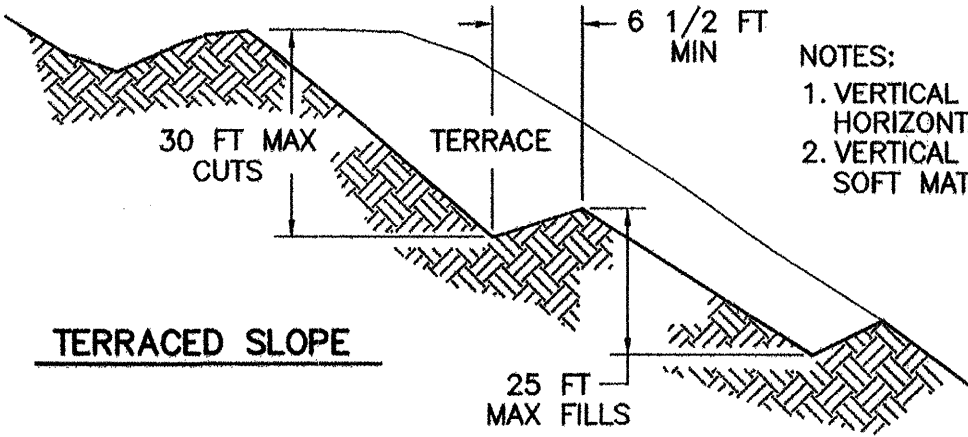

TERRACED SLOPE

STEPPED OR TERRACED SLOPE

NTS

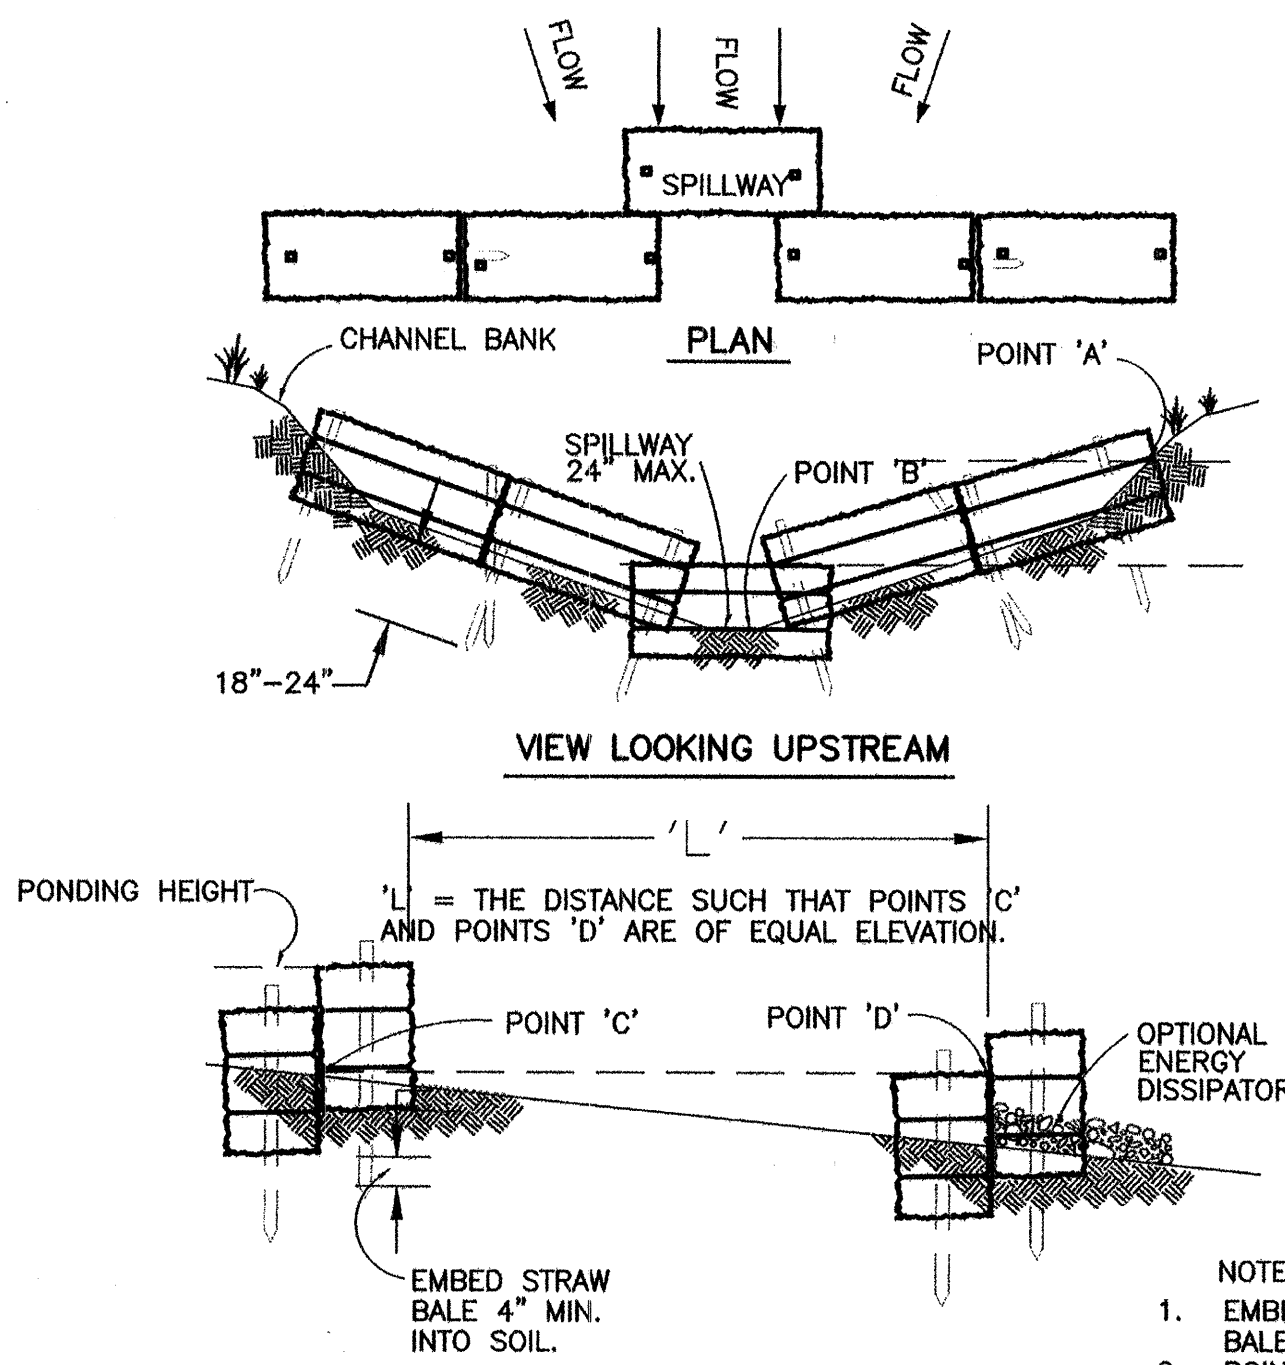


SECTION A - A
SPACING BETWEEN CHECK DAMS

STRAW BALE CHECK DAM

NOTES:


1. EMBED BALES 4" INTO THE SOIL AND 'KEY' BALES INTO THE CHANNEL BANKS.
2. POINT 'A' MUST BE HIGHER THAN POINT 'B'. (SPILLWAY HEIGHT)
3. PLACE BALES PERPENDICULAR TO THE FLOW WITH ENDS TIGHTLY ABUTTING. USE STRAW, ROCKS OR FILTER FABRIC TO FILL ANY GAPS AND TAMP BACKFILL MATERIAL TO PREVENT EROSION OR FLOW AROUND THE BALES.
4. SPILLWAY HEIGHT SHALL NOT EXCEED 24".
5. INSPECT AFTER EACH SIGNIFICANT STORM, MAINTAIN AND REPAIR PROMPTLY.

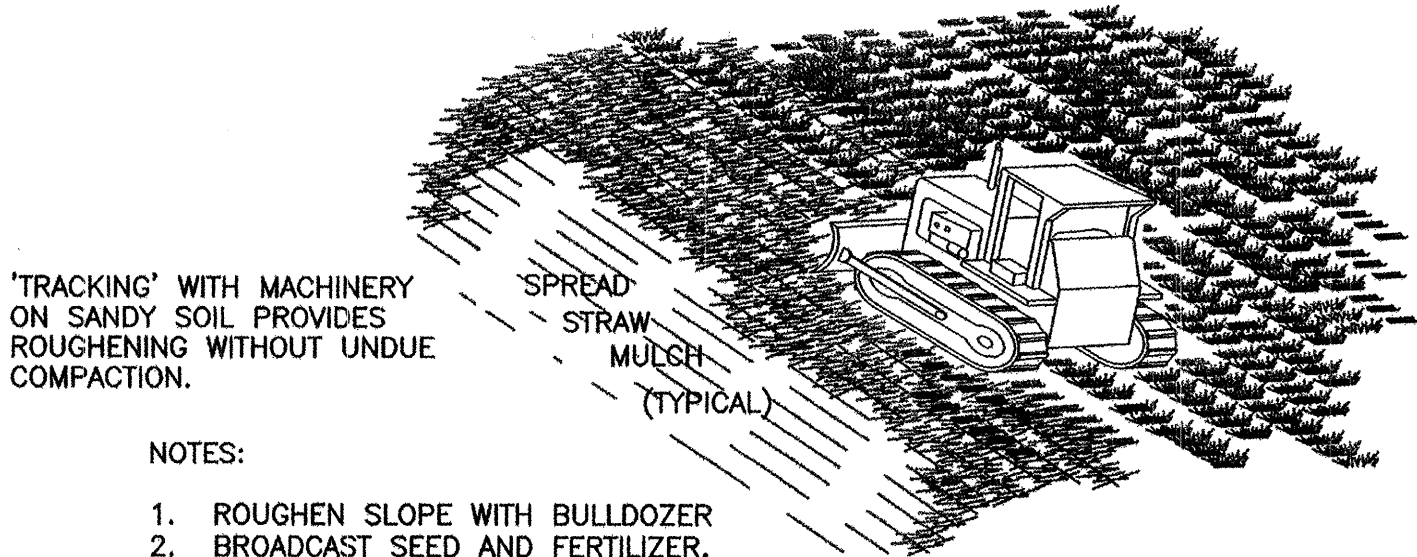

NOTES:

1. ROUGHEN SLOPE WITH BULLDOZER
2. BROADCAST SEED AND FERTILIZER.
3. SPREAD STRAW MULCH 3" THICK. (2 1/2 TONS PER ACRE)
4. PUNCH STRAW MULCH INTO SLOPE BY RUNNING BULLDOZER UP AND DOWN SLOPE.

STRAW ANCHORING

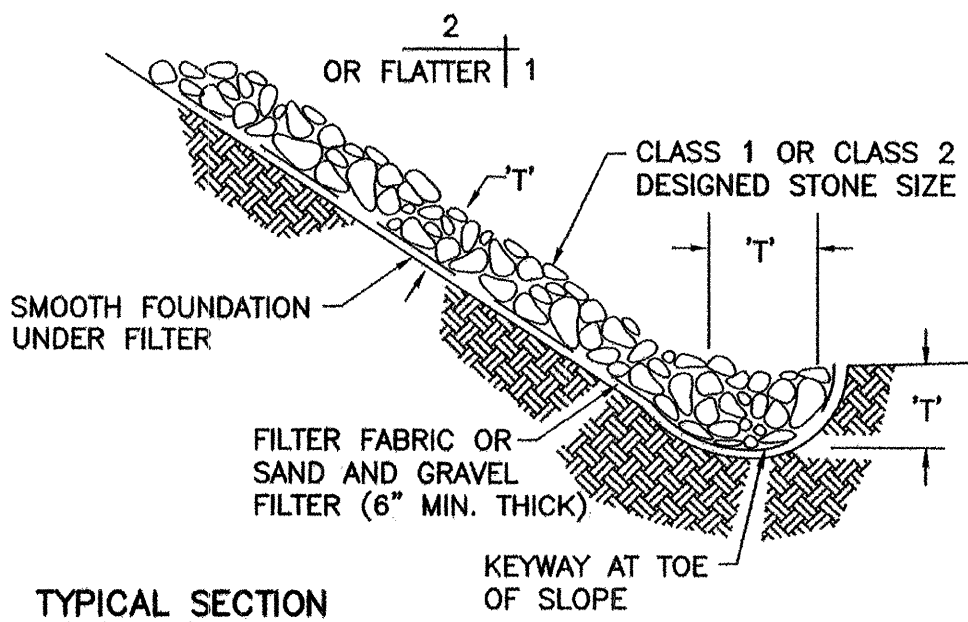

TYPICAL SECTION


NOTE:

"T" = THICKNESS : THICKNESS SHALL BE DETERMINED BY THE ENGINEER.
MINIMUM THICKNESS SHALL BE 1.5x THE MAXIMUM STONE DIAMETER, NEVER LESS THAN 6 INCHES.


RIPRAP PROTECTION

AS-BUILT INFORMATION		BENCH MARKS		SURVEY INFORMATION		ENGINEER'S SEAL	
CONTRACTOR	ACS BRASS TABLET STAMPED "2-B10 1980"	NO.	DATE	NO.	DATE		
WORK ORDER NO.	Geographic Position (NAD 1927)	BY	DATE	BY	DATE		
INSPECTOR'S ACCEPTANCE BY	N.M. State Plane Coordinates (Central Zone)	NO.	DATE	NO.	DATE		
VERIFICATION BY	X= 357,543.73 Y= 1,527,976.48	NO.	DATE	NO.	DATE		
DATE	Ground-to-Grid Factor = 0.99986354					REVISIONS	
MICRO-FILM INFORMATION						NO. DATE	
RECORDED BY						WILSON & COMPANY, ENGINEERS & ARCHITECTS	
NO.						DESIGNED BY	
						DRAWN BY	
						CHECKED BY	
						DATE NOV 2005	
						DATE NOV 2005	
						SJS	


		2600 THE AMERICAN ROAD S.E., SUITE 100, RIO RANCHO, NEW MEXICO 87124, (505) 898-8021	
CITY OF ALBUQUERQUE PUBLIC WORKS DEPARTMENT ENGINEERING GROUP			
VALLE VISTA AT THE TRAILS UNIT II EROSION CONTROL PLAN			
Design Review Committee	City Engineer Approval	Mo./Day/Yr.	Mo./Day/Yr.
Lost Design Update			
City Project No.		Zone Map No.	Sheet Of
730086		C-9-Z	3 16

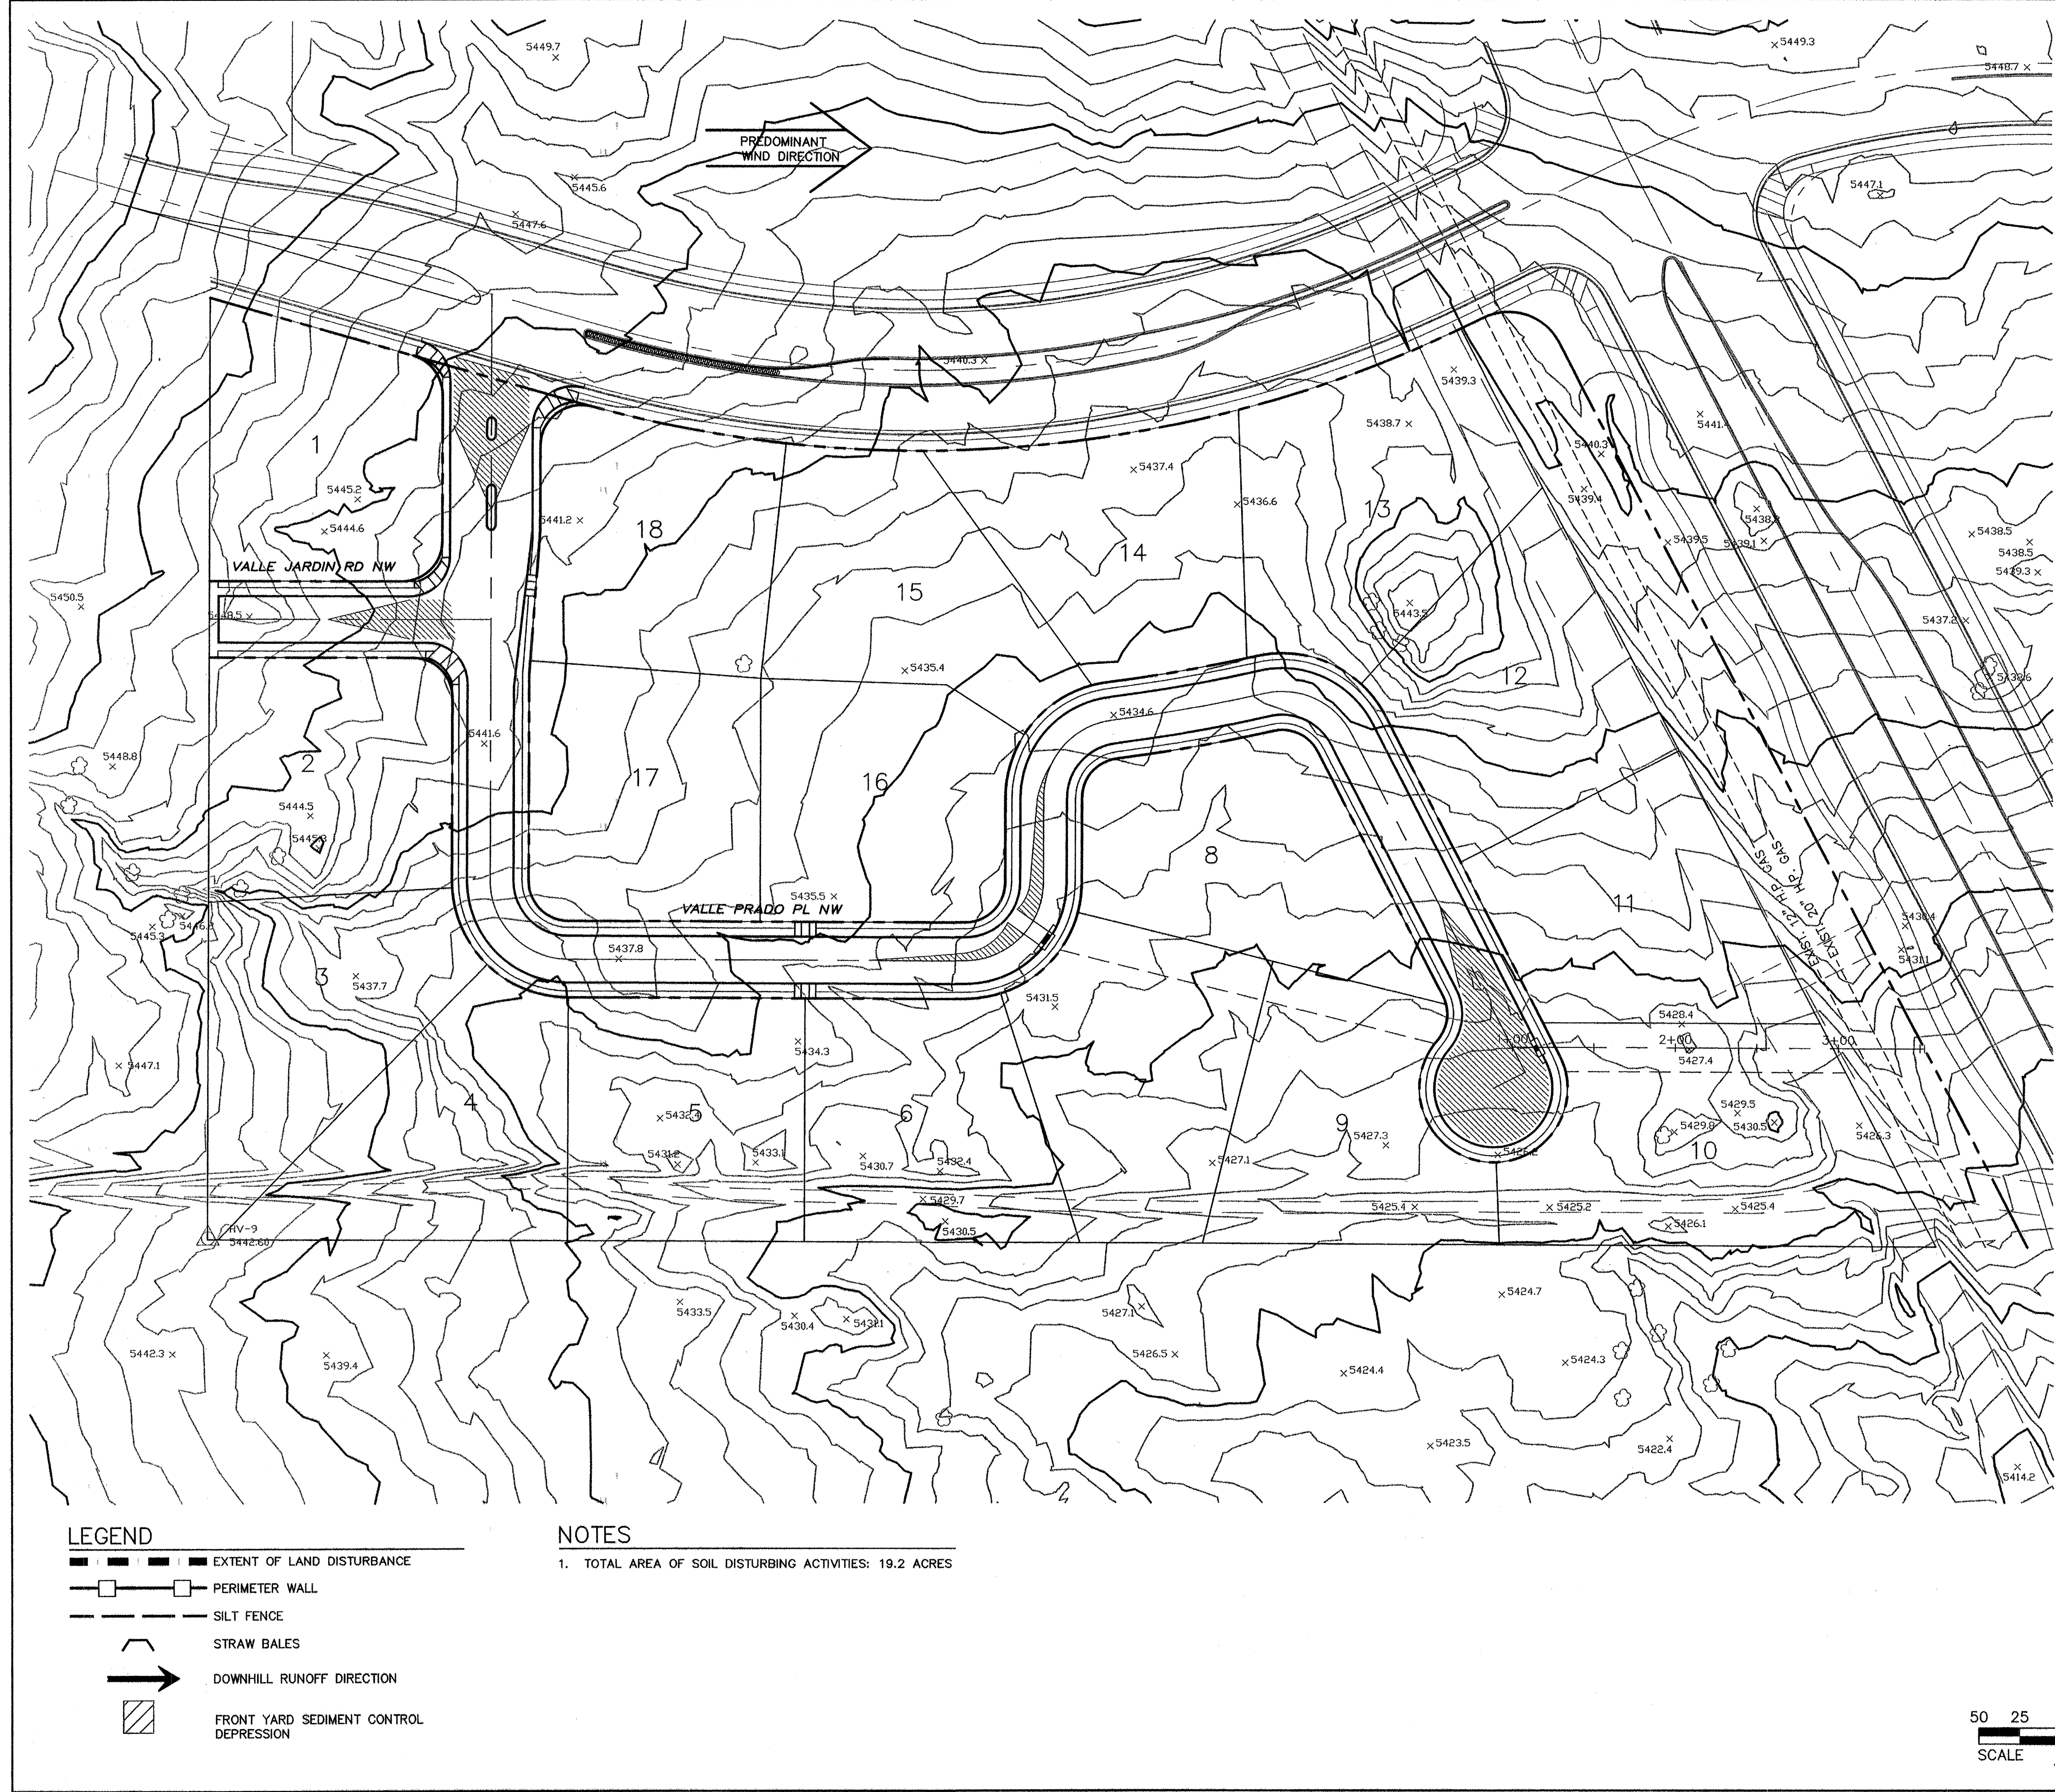

- NOTES:
1. THE ENTRANCE SHALL BE MAINTAINED IN A CONDITION THAT WILL PREVENT TRACKING OR FLOWING OF SEDIMENT ONTO PUBLIC RIGHTS-OF-WAY. THIS MAY REQUIRE TOP DRESSING, REPAIR AND/OR CLEANOUT OF ANY MEASURES USED TO TRAP SEDIMENT.
 2. WHEN NECESSARY, WHEELS SHALL BE CLEANED PRIOR TO ENTRANCE ONTO PUBLIC RIGHT-OF-WAY.
 3. WHEN WASHING IS REQUIRED, IT SHALL BE DONE ON AN AREA STABILIZED WITH CRUSHED STONE THAT DRAINS INTO AN APPROVED SEDIMENT TRAP OR SEDIMENT BASIN.

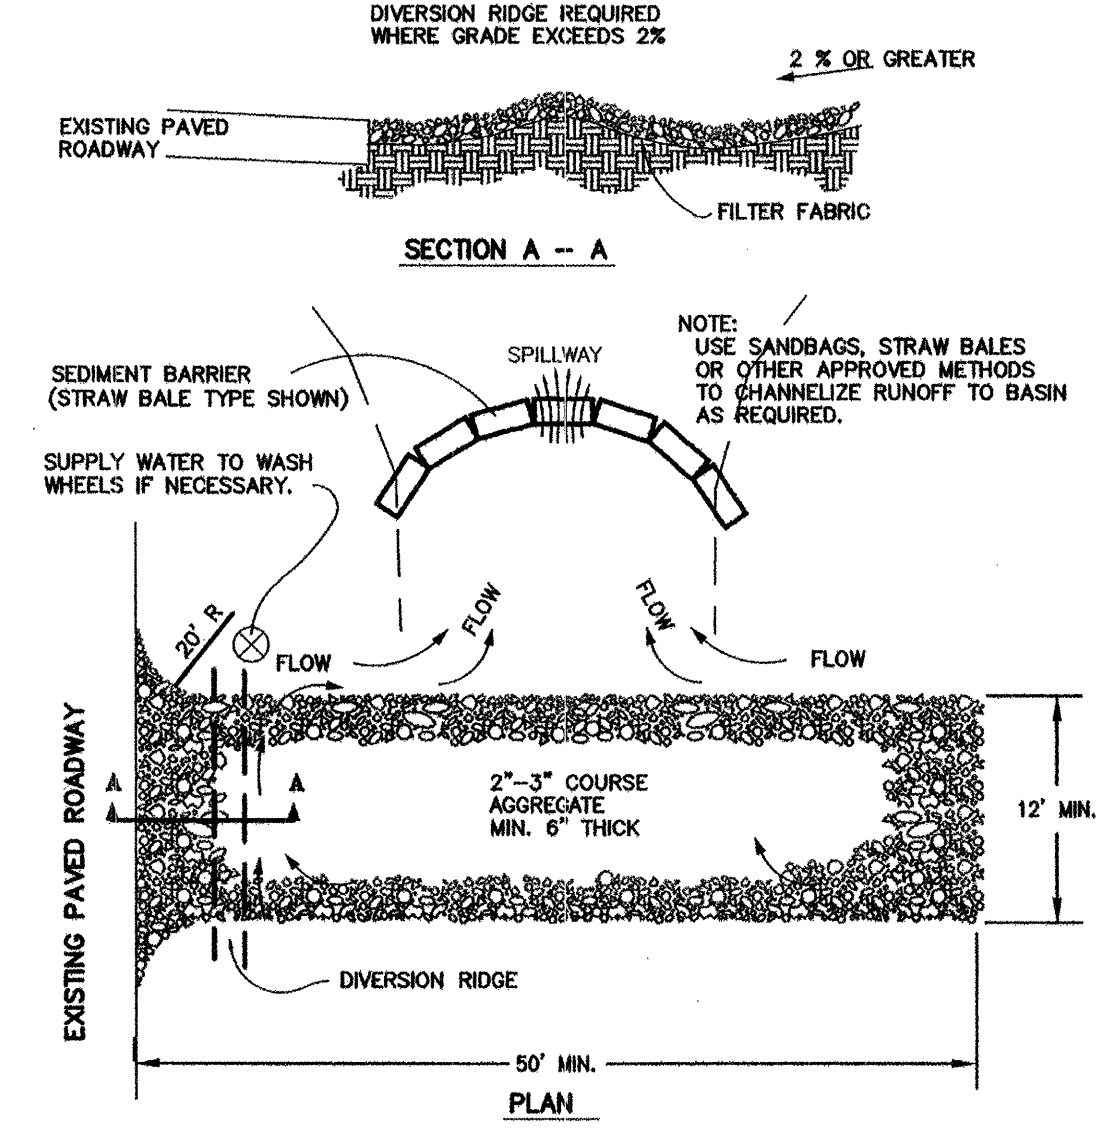


STABILIZED CONSTRUCTION ENTRANCE
NTS

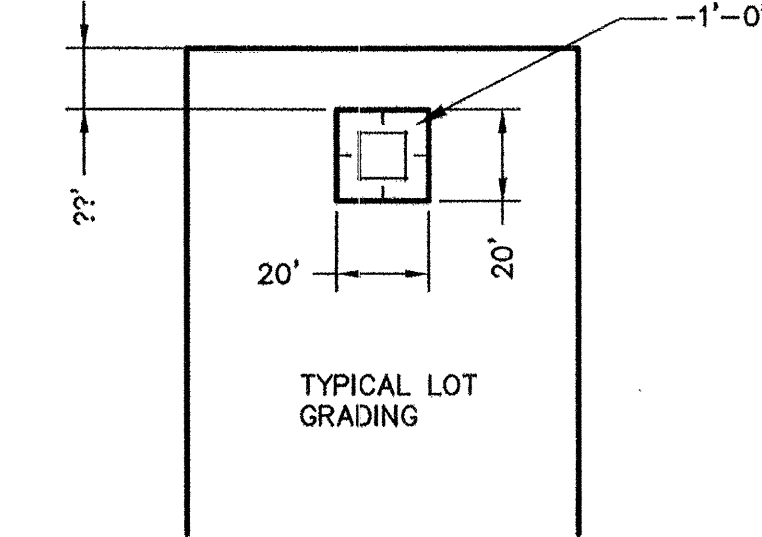


FRONT YARD SEDIMENT CATCHMENT
NTS

WILSON & COMPANY
2600 THE AMERICAN ROAD S.E.
SUITE 100
RIO RANCHO, NEW MEXICO
87124
(505) 898-8021


CITY OF ALBUQUERQUE PUBLIC WORKS DEPARTMENT ENGINEERING GROUP			
VALLE VISTA AT THE TRAILS UNIT II EROSION CONTROL PLAN			
Design Review Committee	City Engineer Approval	Mo./Day/Yr.	
Last Design Update		Mo./Day/Yr.	
City Project No.	Zone Map No.	Sheet	Of
730086	C-9-Z	4	16

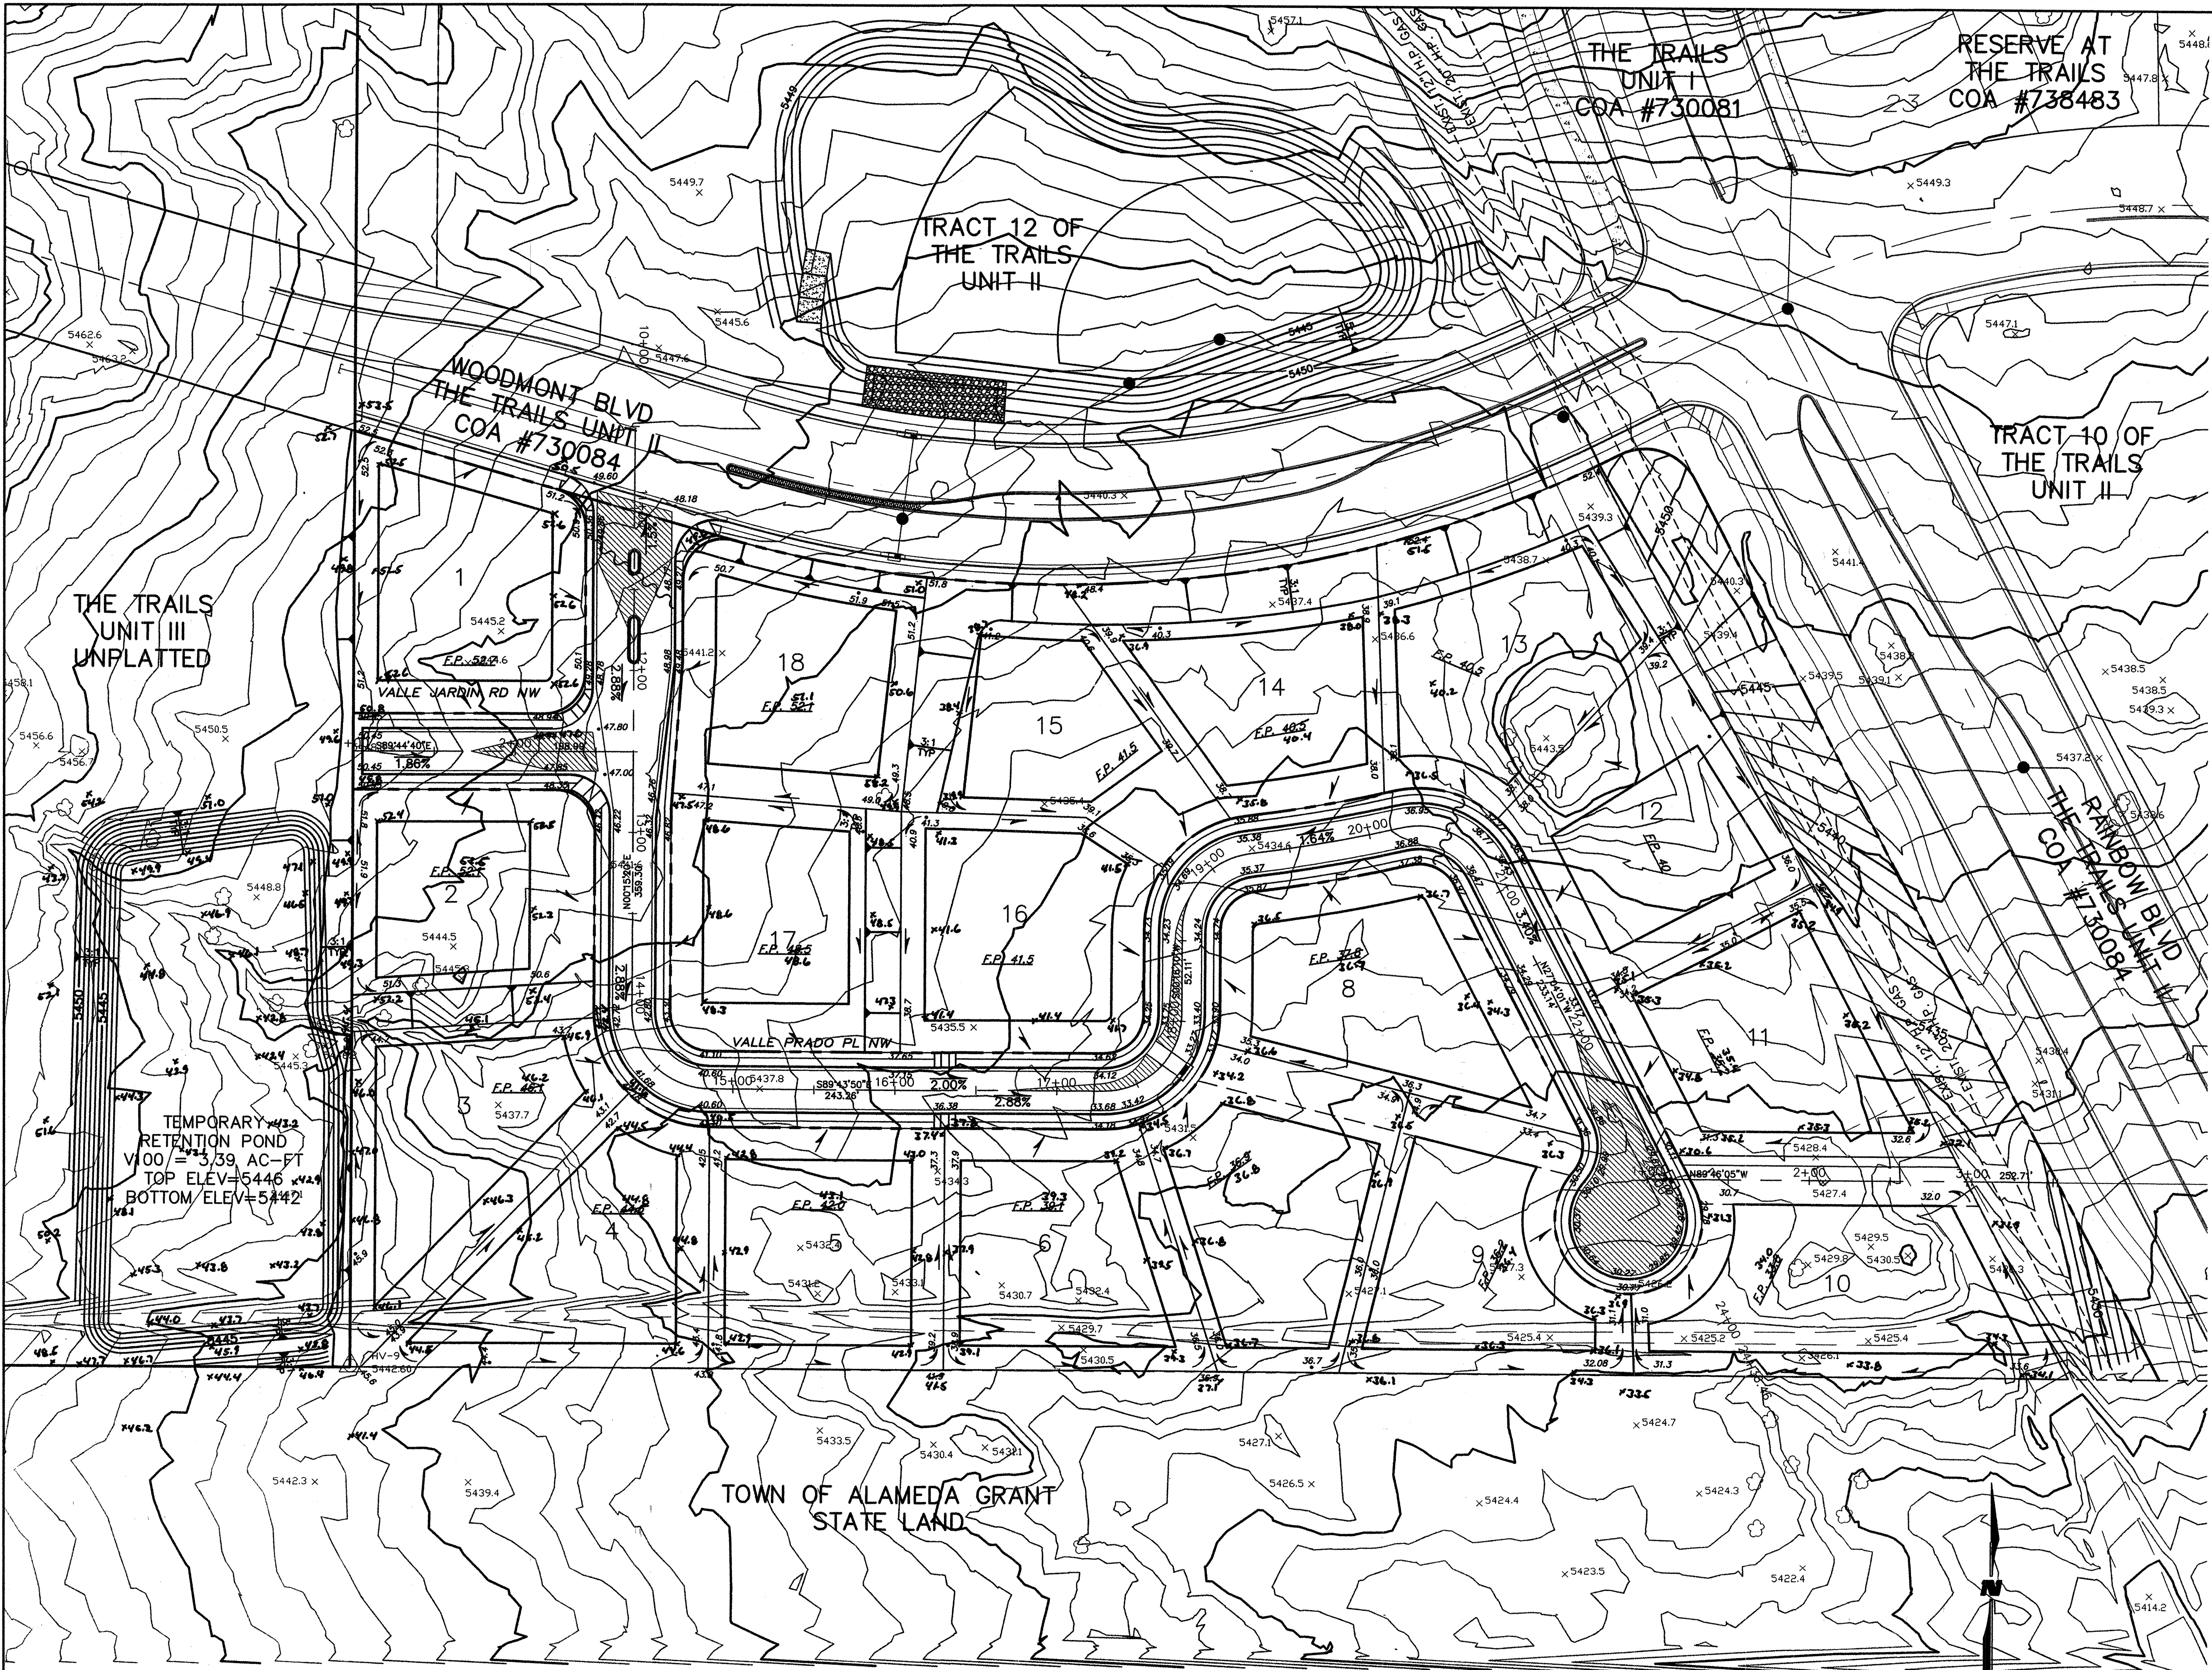




- LEGEND**
- RETAINING WALL
 - HIGH POINT
 - DIRECTION OF FLOW
 - E LINE ELEVATION
 - BASIN BOUNDARY
 - TYPE DOUBLE C INLET
 - RETAINING WALL POINT
 - MH TO BE BUILT WITH COA # 730084
 - SD TO BE BUILT WITH COA # 730084
 - PROPOSED SD MANHOLE
 - PROPOSED SD PIPE

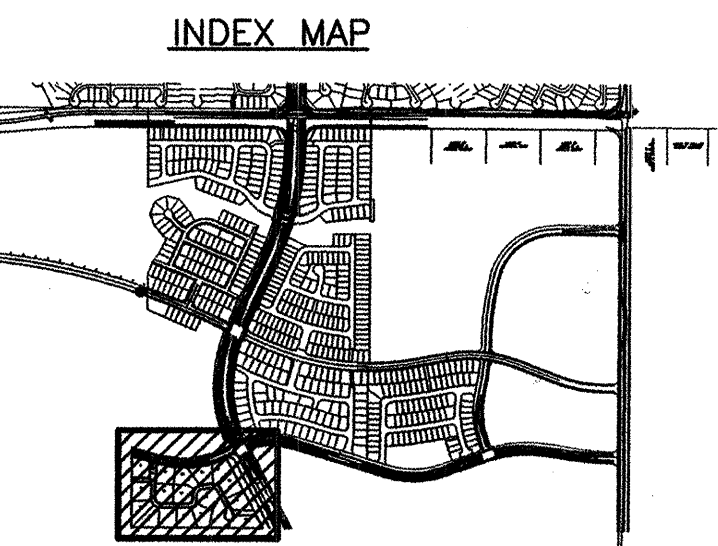



WILSON & COMPANY		2600 THE AMERICAN ROAD S.E. SUITE 100 RIO RANCHO, NEW MEXICO (505) 898-8021	
CITY OF ALBUQUERQUE PUBLIC WORKS DEPARTMENT ENGINEERING GROUP			
VALLE VISTA AT THE TRAILS UNIT II GRADING & DRAINAGE PLAN			
Design Review Committee	City Engineer Approval	Mo./Day/Yr.	
<i>Information Only</i>		Mo./Day/Yr.	
City Project No.	Zone Map No.	Sheet	Of
730086	C-9-Z	5	16

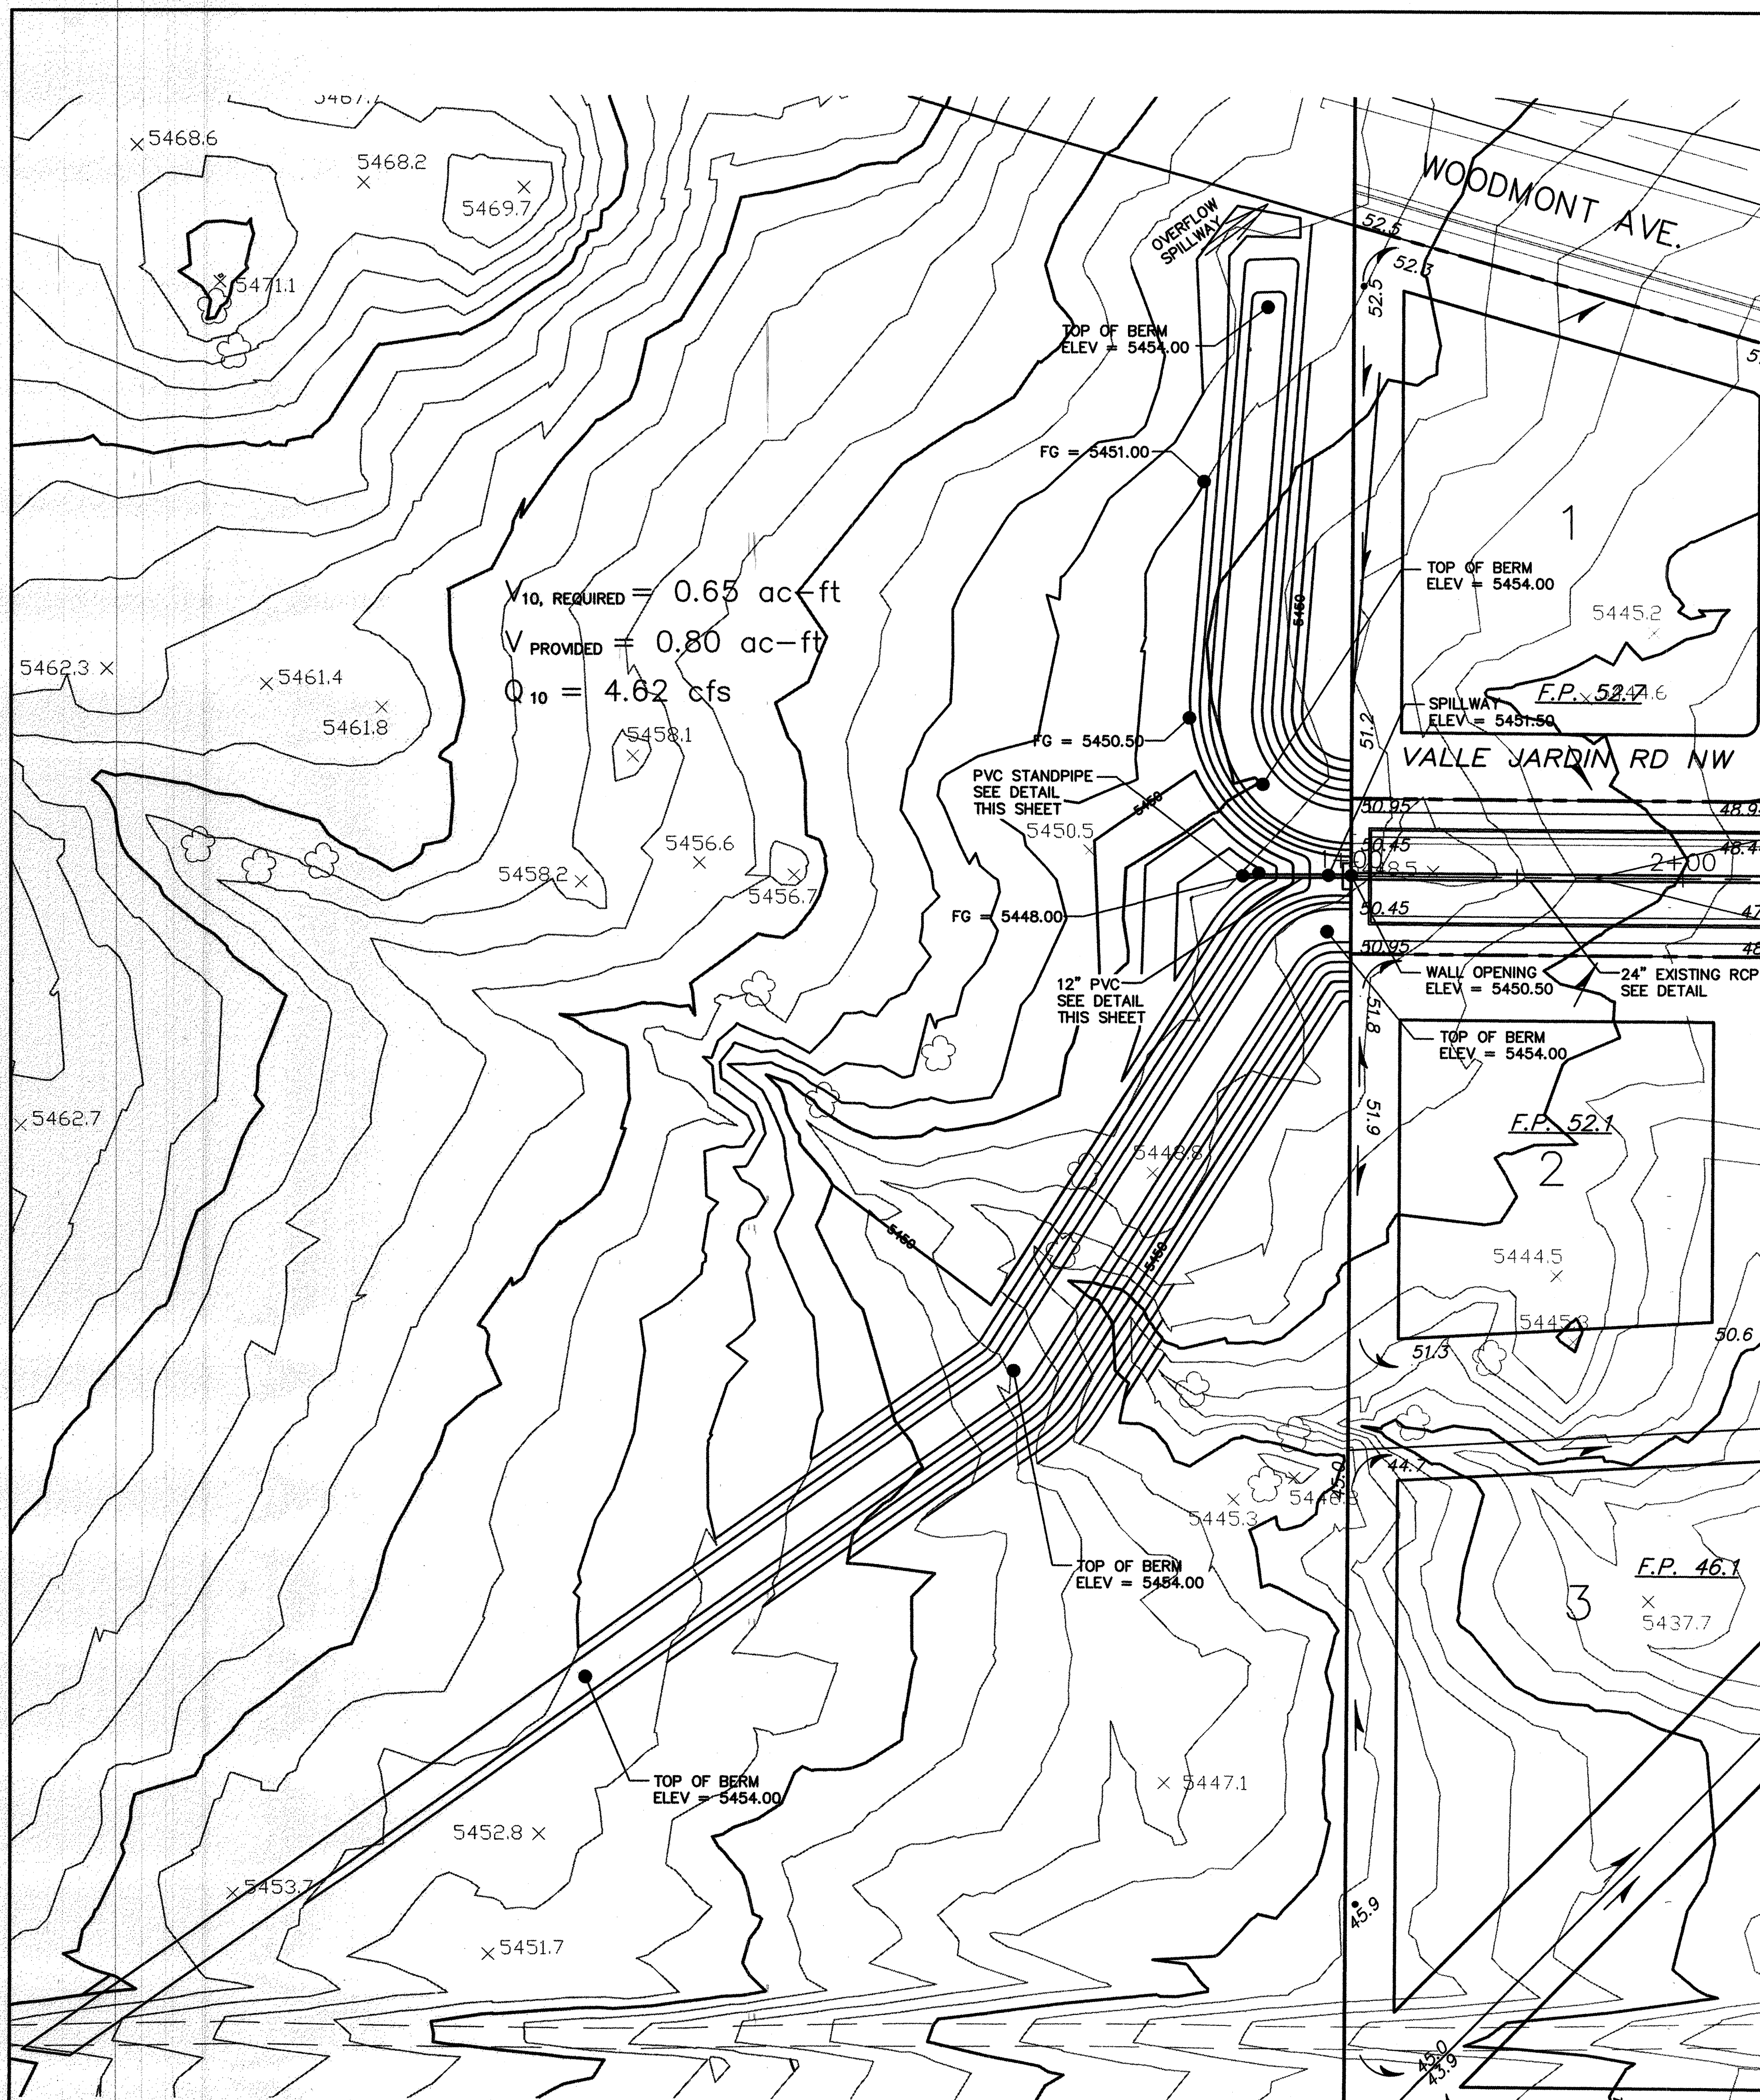

$V_{10, \text{REQUIRED}} = 0.65 \text{ ac-ft}$
 $V_{\text{PROVIDED}} = 0.80 \text{ ac-ft}$
 $Q_{10} = 4.62 \text{ cfs}$

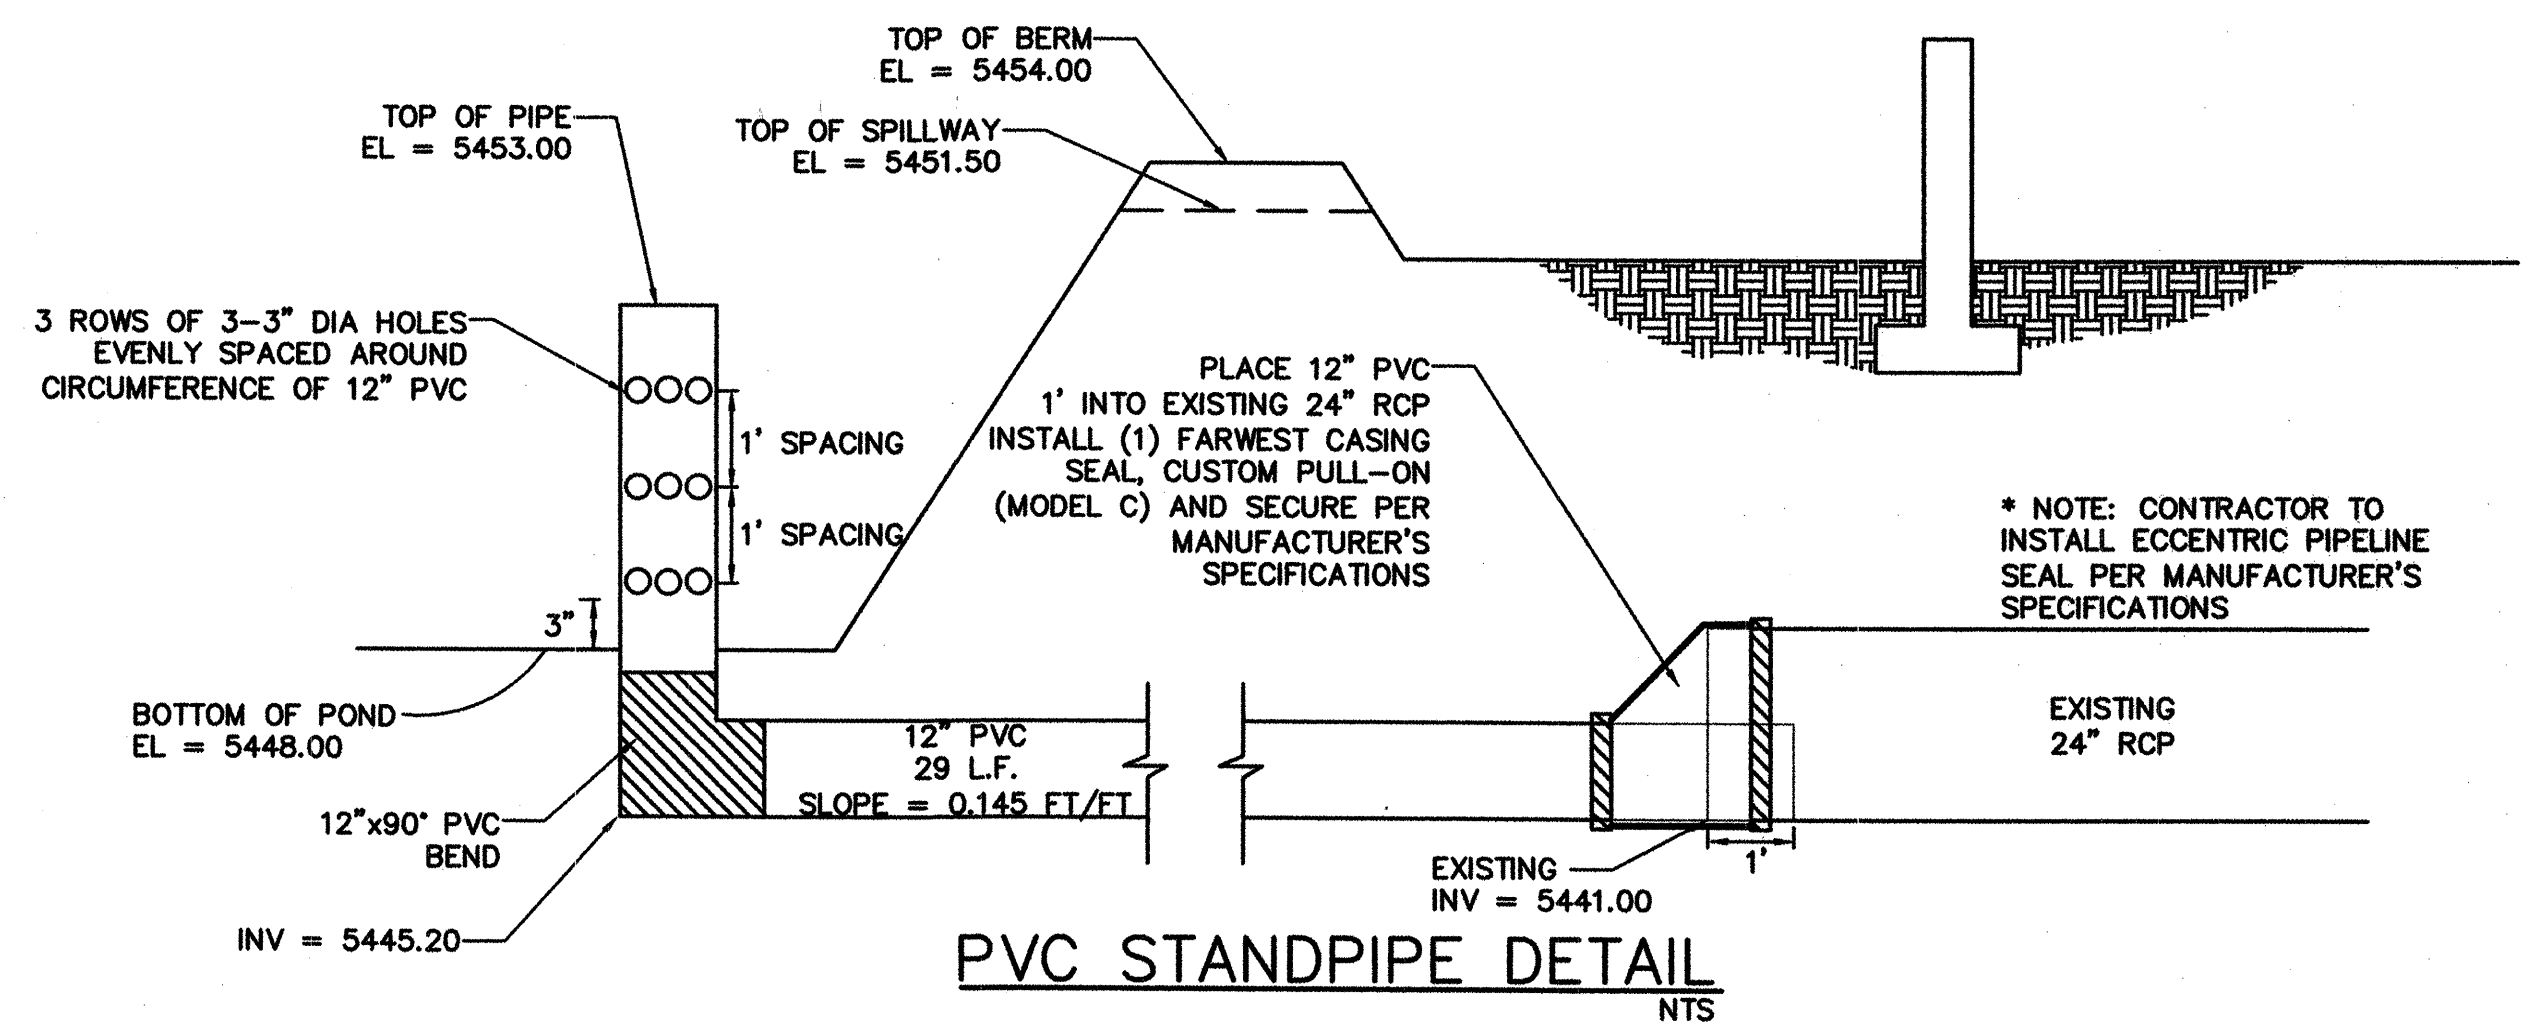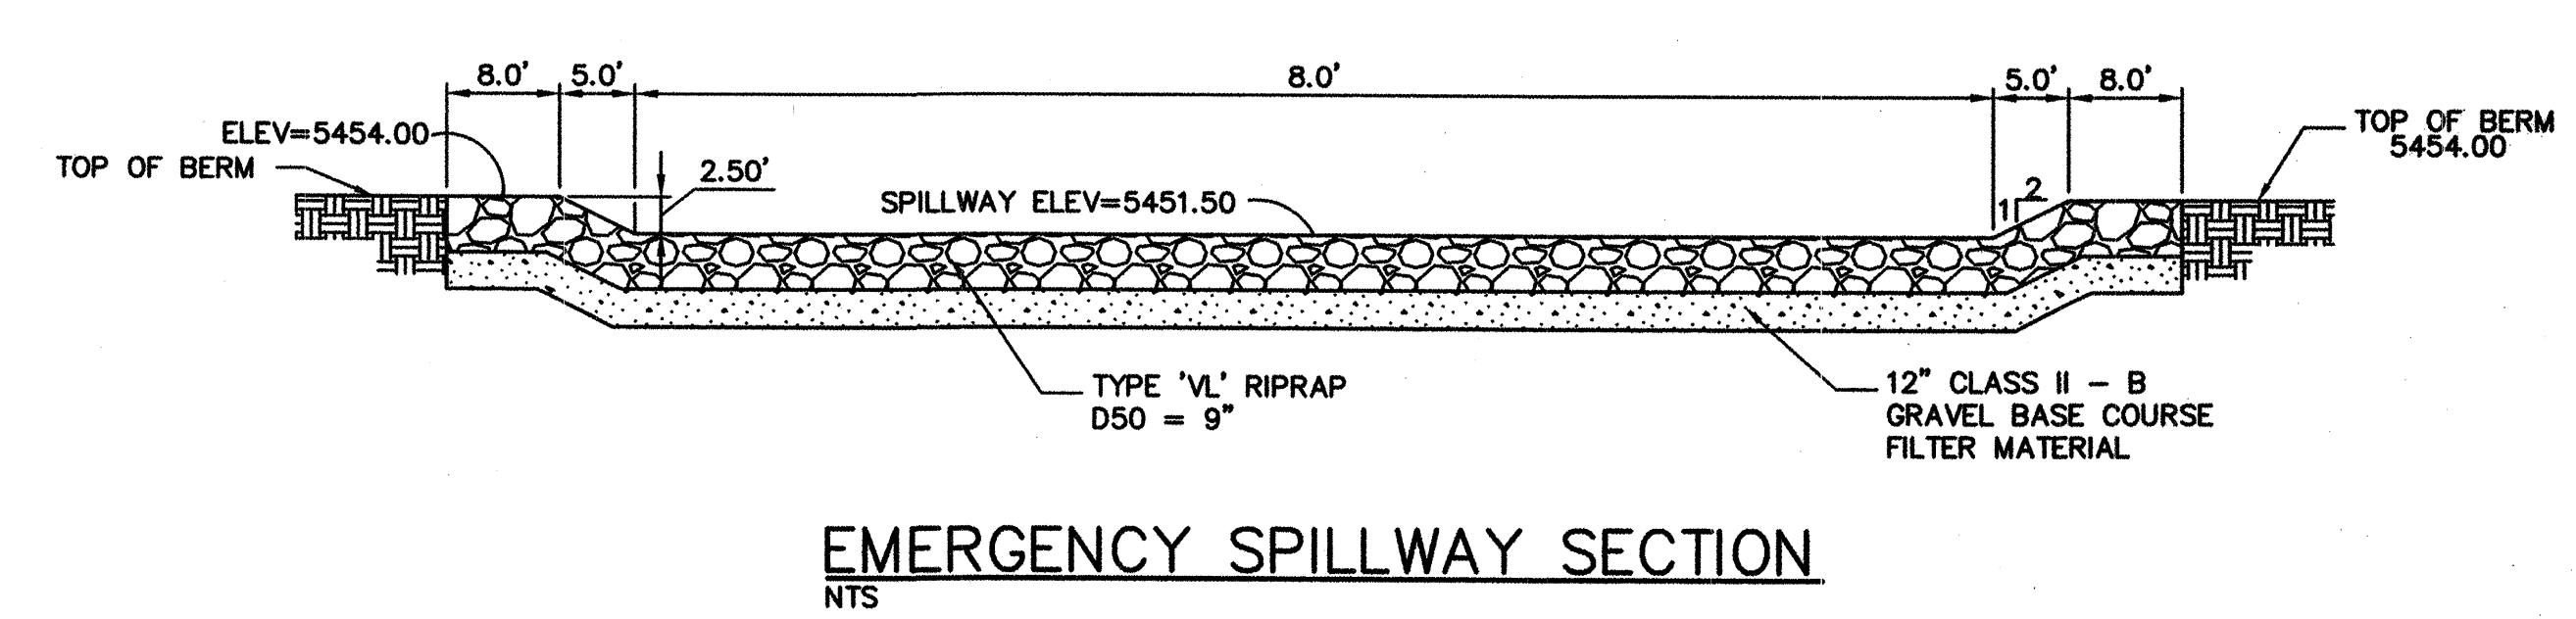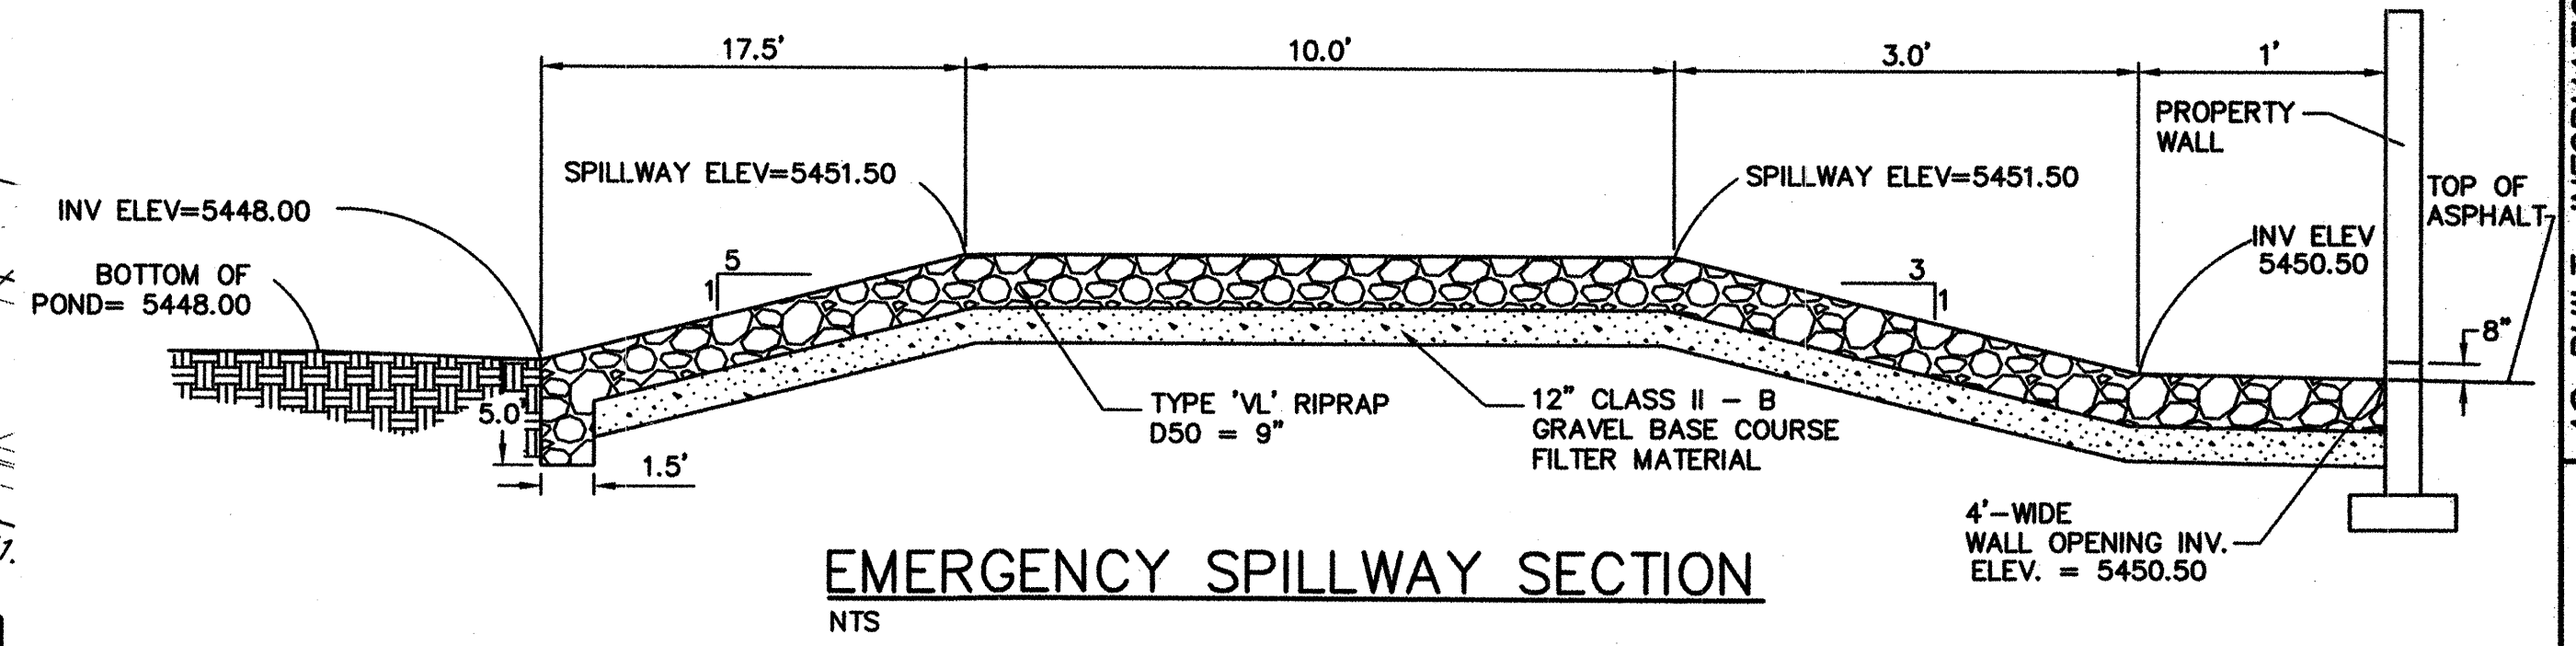

- LEGEND
- RETAINING WALL
 - HIGH POINT
 - DIRECTION OF FLOW
 - E LINE ELEVATION
 - BASIN BOUNDARY
 - TYPE DOUBLE C INLET
 - RETAINING WALL POINT
 - MH TO BE BUILT WITH COA # 730084
 - SD TO BE BUILT WITH COA # 730084
 - PROPOSED SD MANHOLE
 - PROPOSED SD PIPE

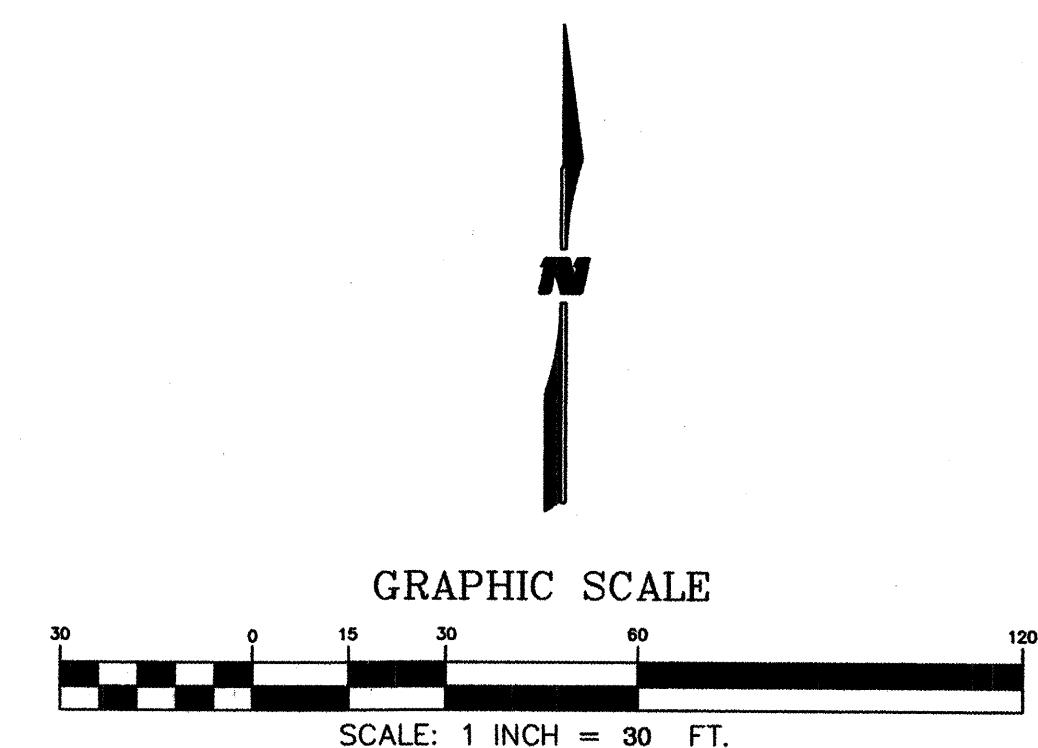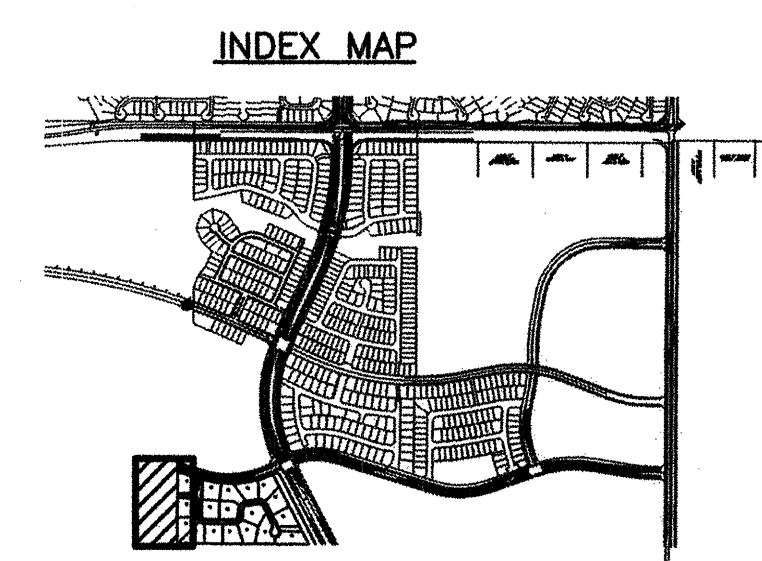

WILSON & COMPANY 2600 THE AMERICAN ROAD S.E. SUITE 100 RIO RANCHO, NEW MEXICO 87124 (505) 898-8021	
CITY OF ALBUQUERQUE PUBLIC WORKS DEPARTMENT ENGINEERING GROUP	
VALLE VISTA AT THE TRAILS UNIT II GRADING & DRAINAGE OFFSIDE POND	
Design Review Committee	City Engineer Approval
City Project No. 730086	Zone Map No. C-9-Z
Sheet 5A	Of 16


NO.	DATE	REMARKS	BY
1	NOV 2005	DESIGNED BY DMD	DATE NOV 2005
2	NOV 2005	DRAWN BY DMD	DATE NOV 2005
3	NOV 2005	CHECKED BY SUS	DATE NOV 2005

AS-BUILT INFORMATION	
CONTRACTOR	DATE


BENCH MARKS	
ACS BRASS TABLET STAMPED "2-B10 1980"	DATE
Geographic Position (NAD 1927)	
N.M. State Plane Coordinates (Central Zone)	
X= 357,543.73 Y= 1,527,976.48	
Ground-to-Grid Factor = 0.99966354	
Δα = -0016'30"	
SLD 1929 Elevation = 5429.35	

SURVEY INFORMATION	
FIELD NOTES	DATE


ENGINEER'S SEAL	
NO.	DATE

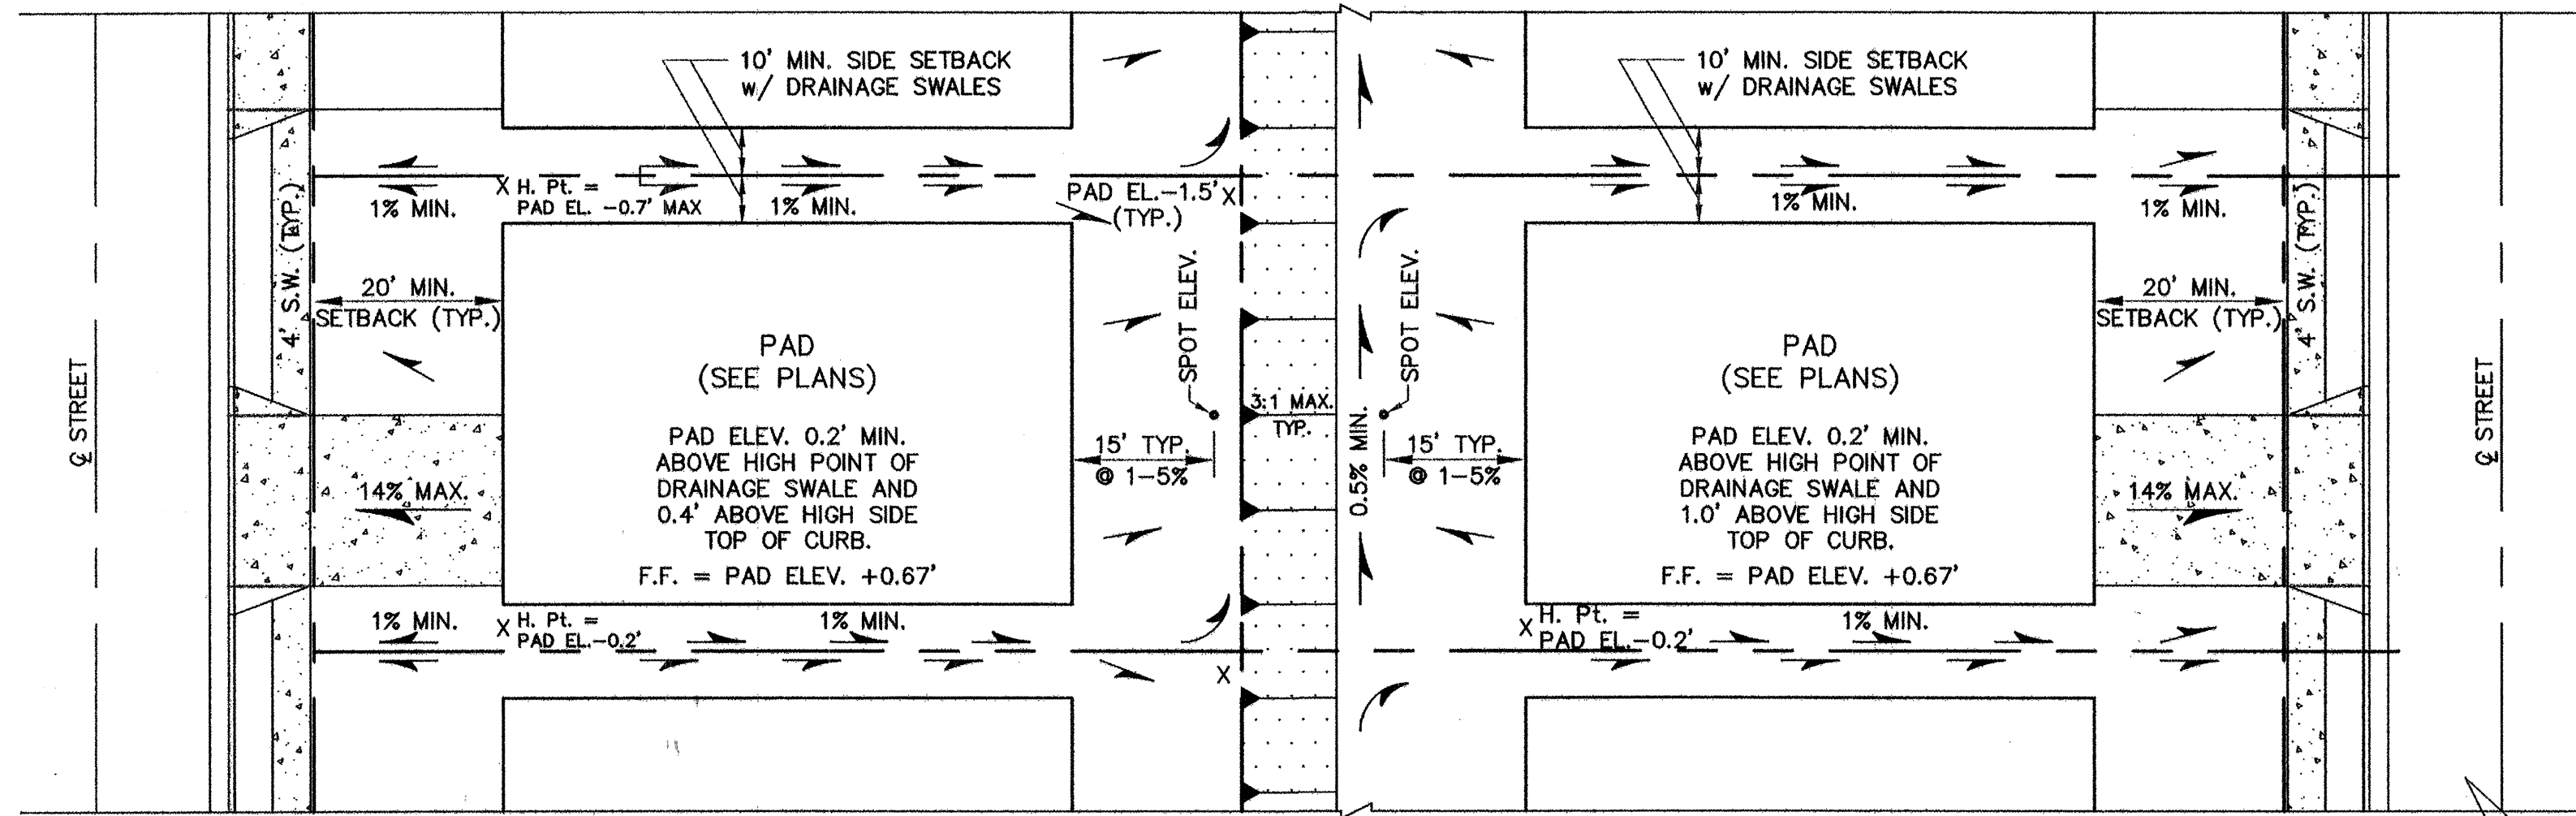


TYPICAL LOT GRADING
NTS

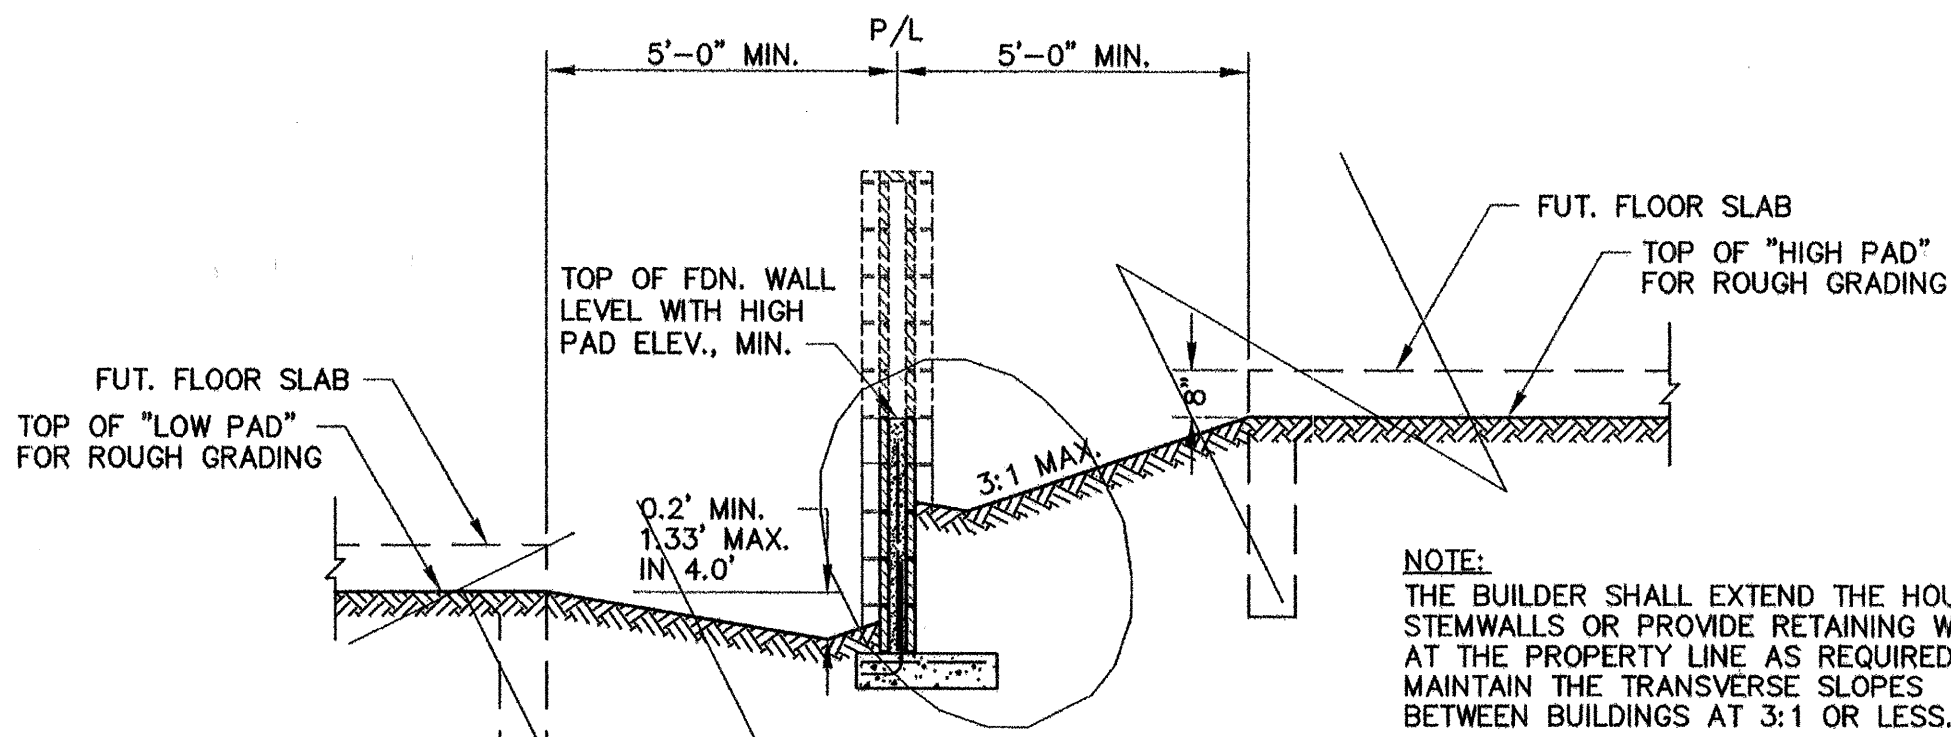


TYPICAL DETAIL @ SIDYARD DRAINAGE SWALES
3/8" = 1'-0"

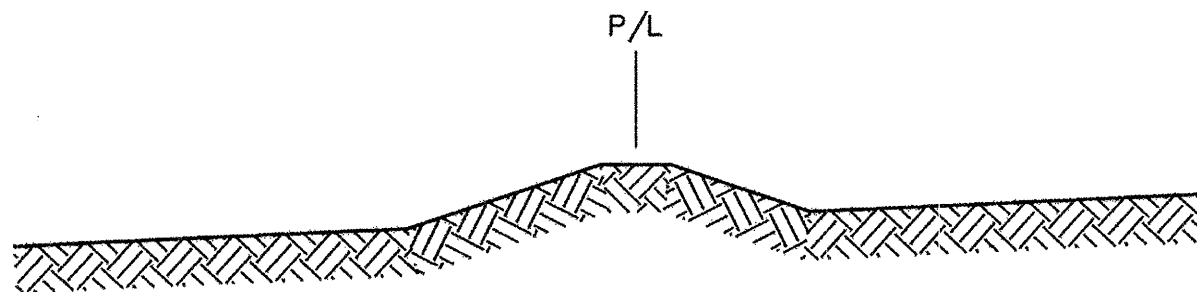


TYPICAL GRADING DETAIL
@ PROPERTY LINES IN FRONT SETBACK
NO SCALE

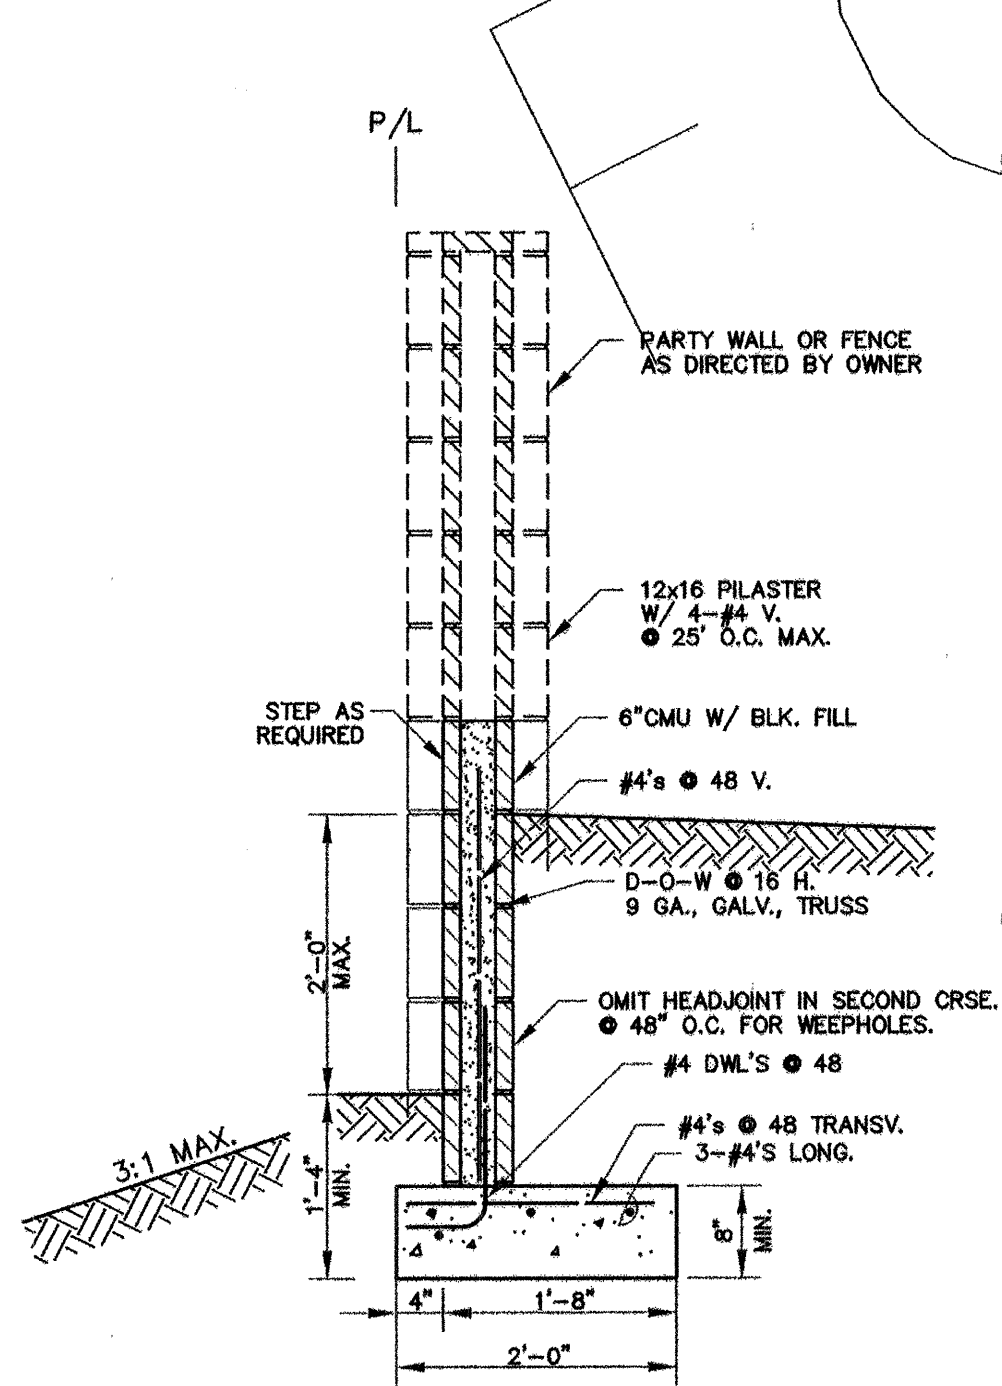


RETAINING WALL - TYPE A
3/4" = 1'-0"

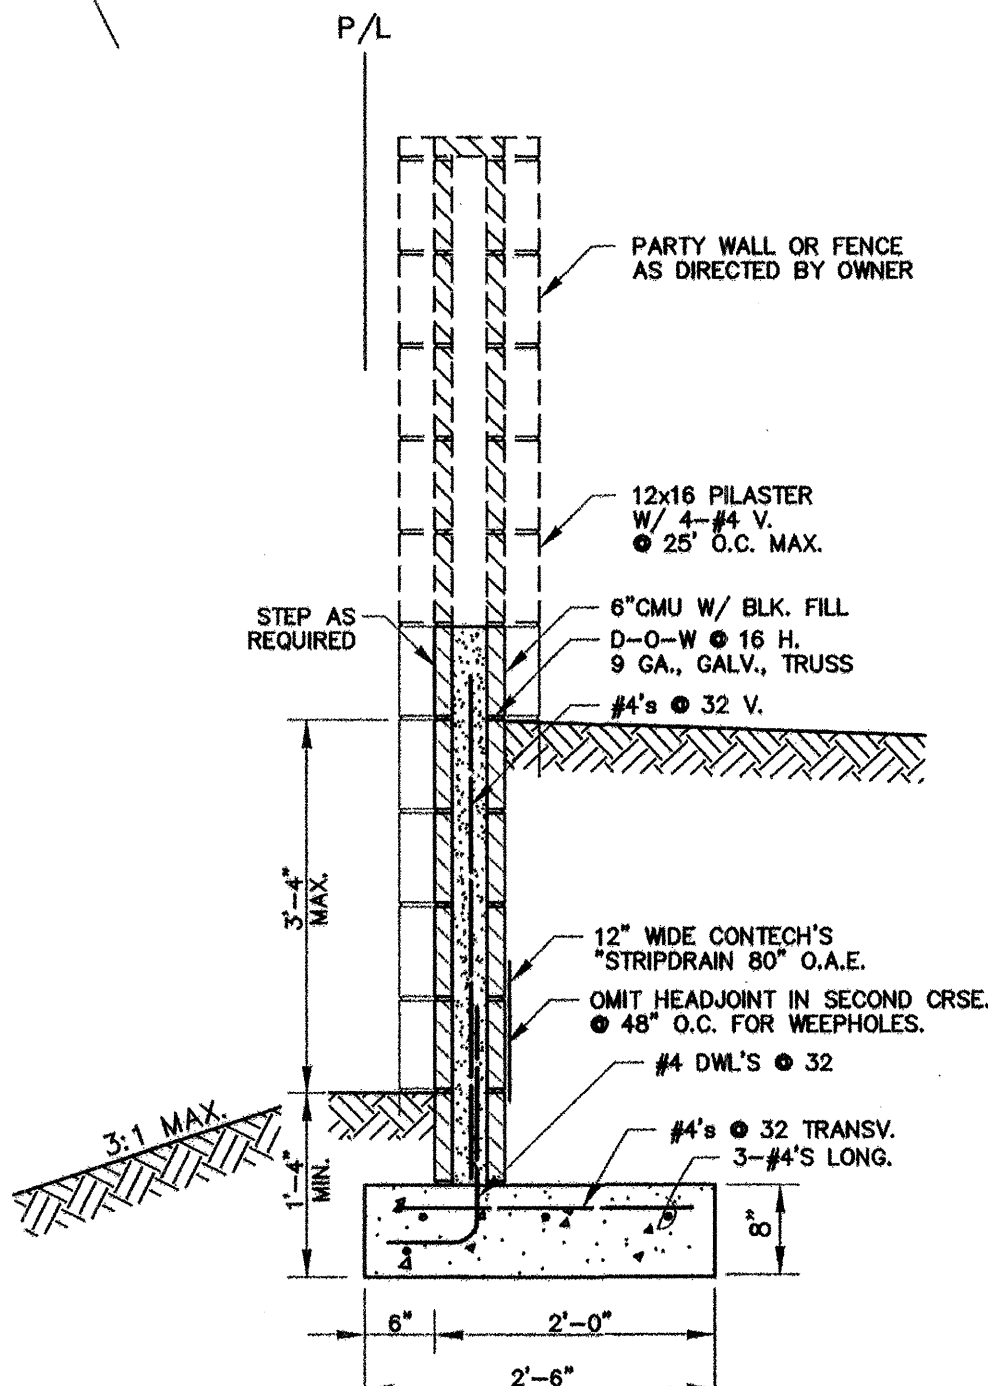


RETAINING WALL - TYPE B
3/4" = 1'-0"

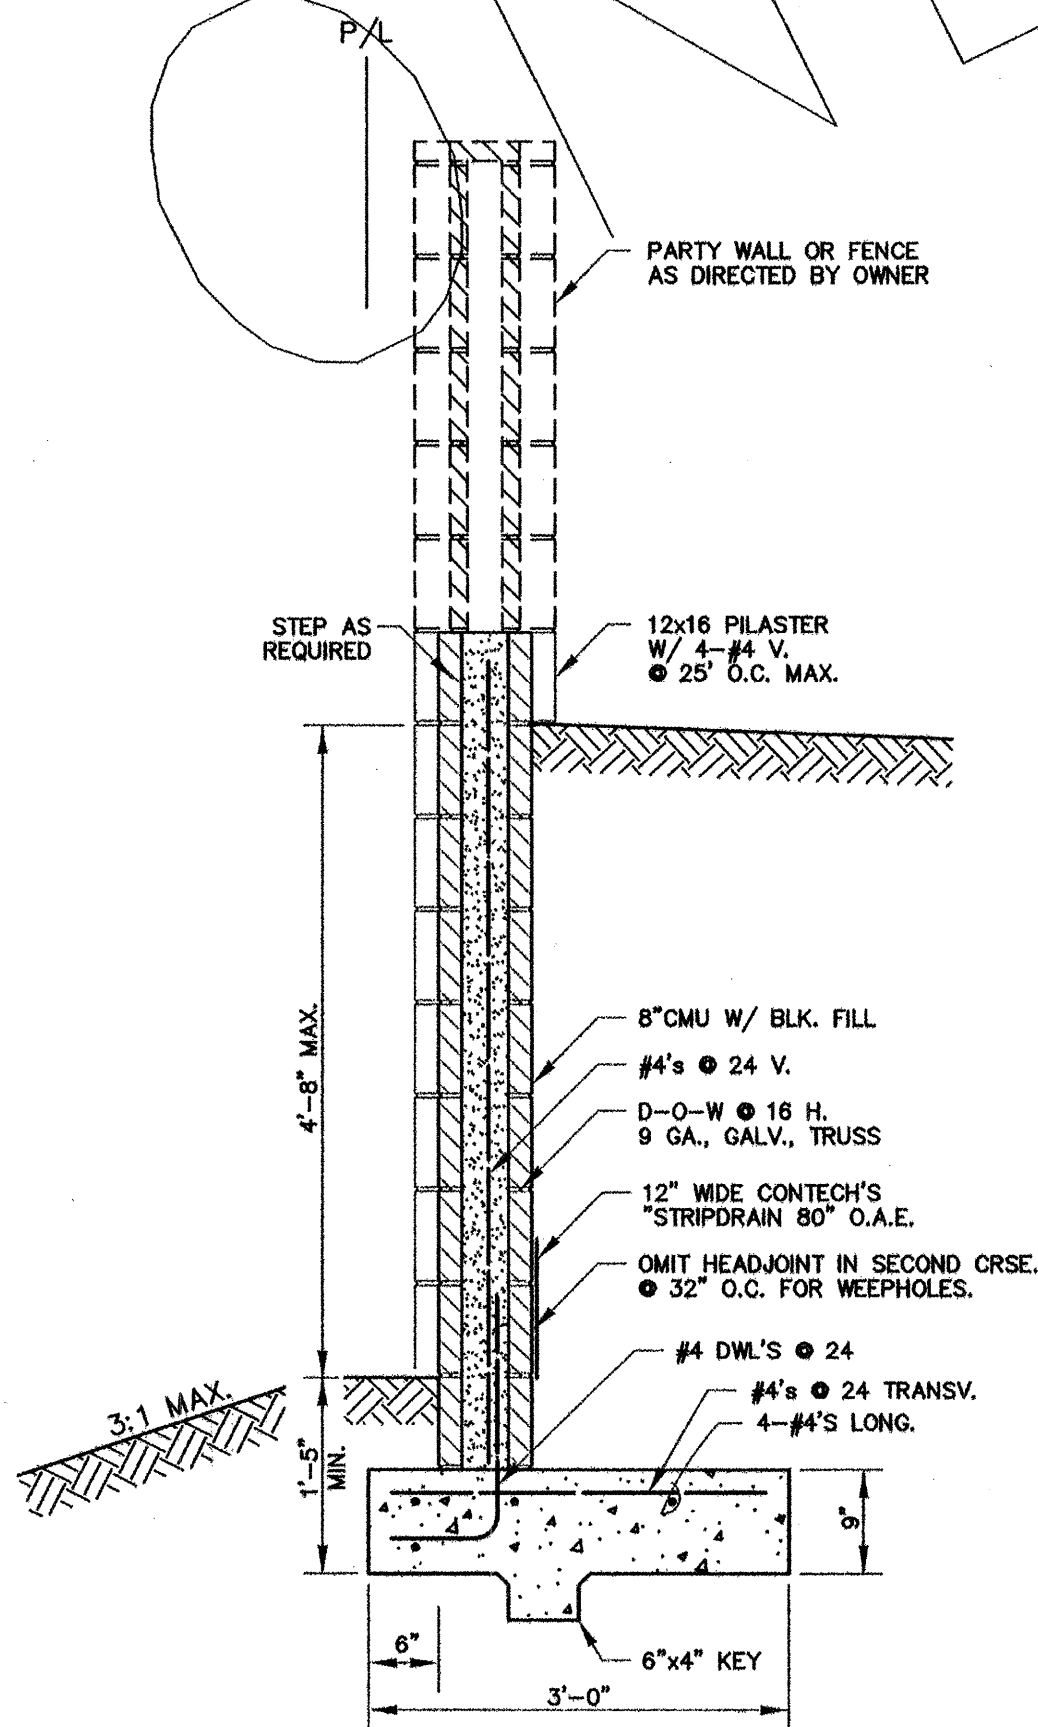

RETAINING WALL - TYPE C
3/4" = 1'-0"

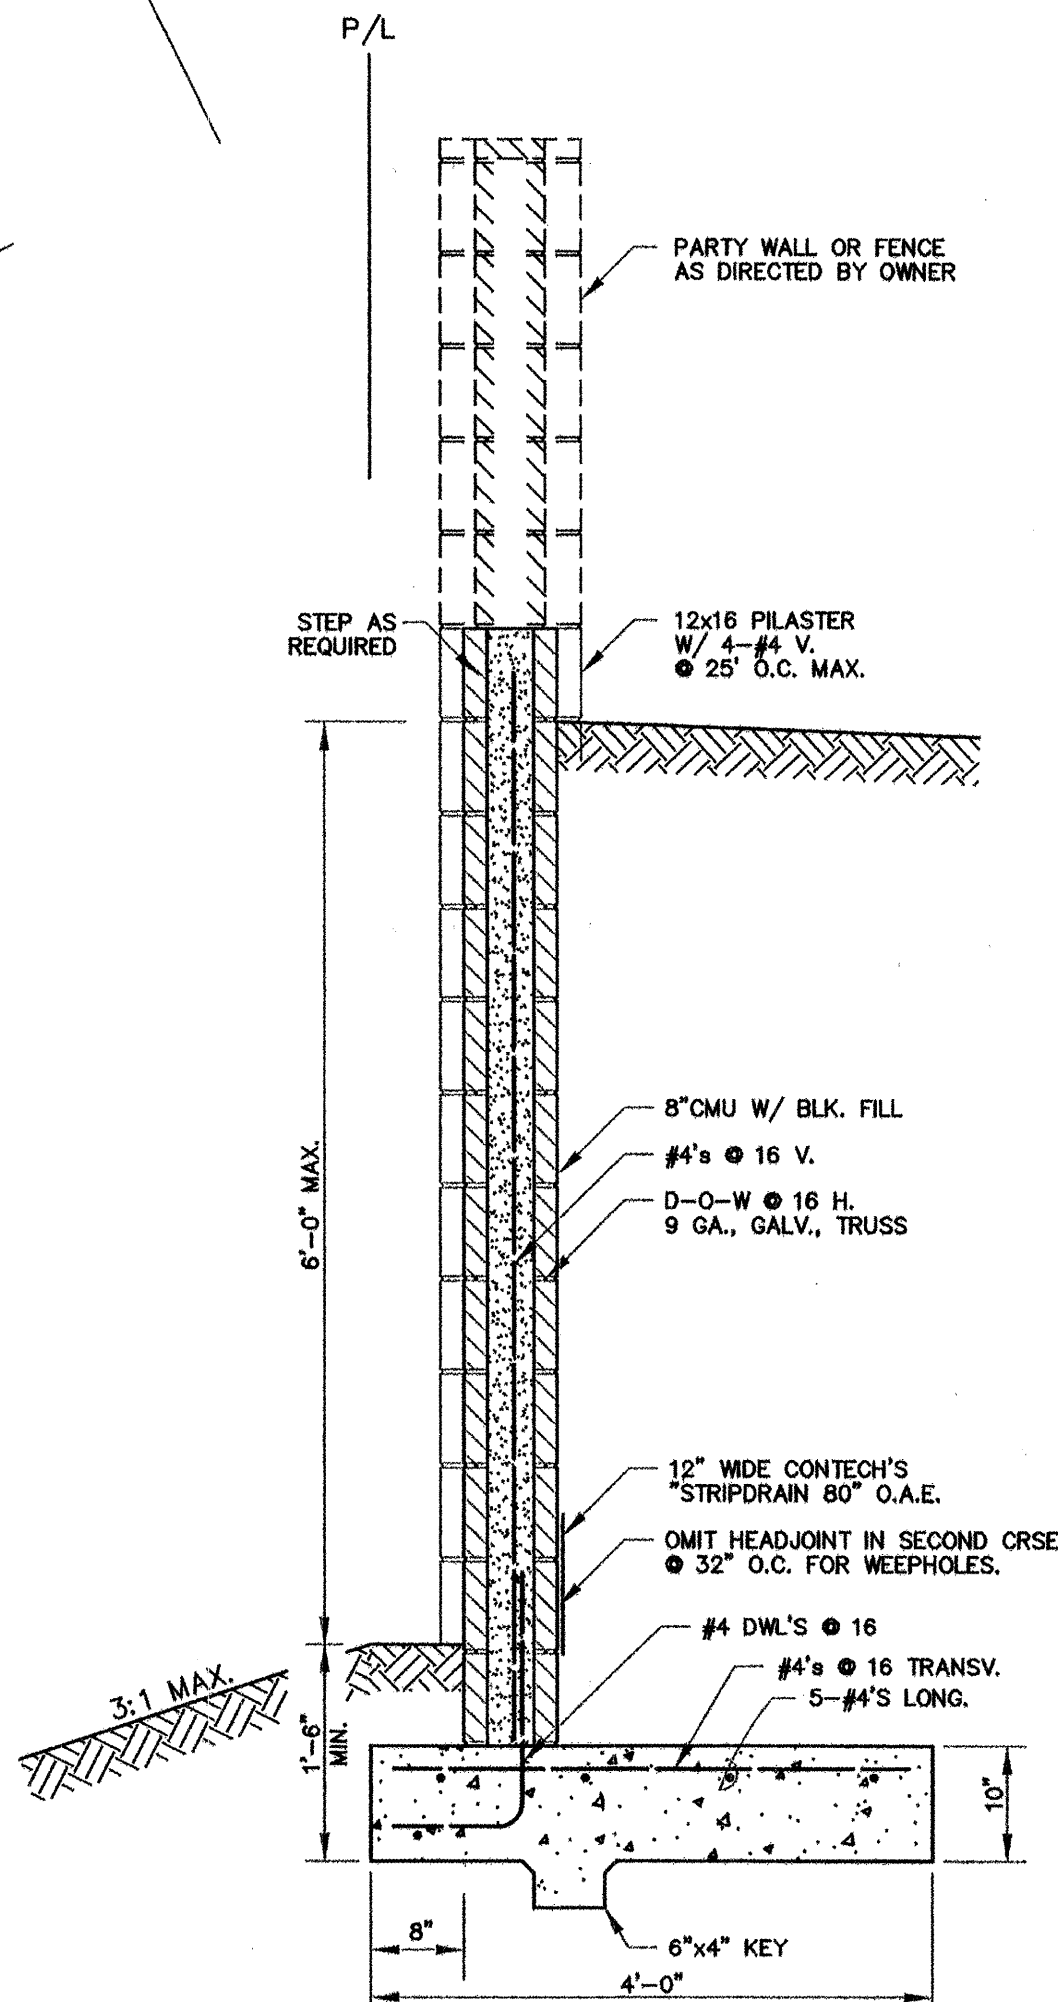

RETAINING WALL - TYPE D
3/4" = 1'-0"

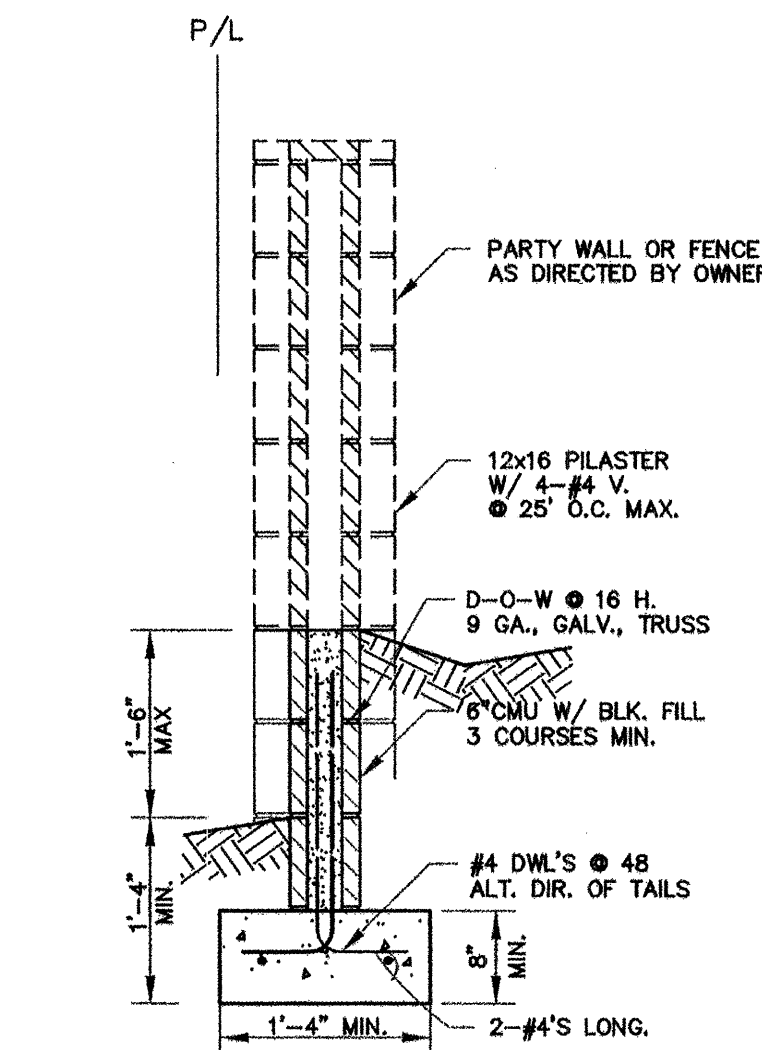


FENCE FOUNDATION WALL
(ELEV. DIFF. < 1.5 FT.)
3/4" = 1'-0"

PRELIMINARY
NOT FOR
CONSTRUCTION


FOR INFORMATION ONLY

ENGINEER'S SEAL										SURVEY INFORMATION				BENCH MARKS		AS-BUILT INFORMATION			
										FIELD NOTES				ACS BRASS TABLE STAMPED "2-B10 1980"					
										NO.		BY		DATE					
NO.		DATE		REMARKS		BY													
WILSON & COMPANY, ENGINEERS & ARCHITECTS																			
DESIGNED BY										DATE		NOV 2005							
DRAWN BY										DATE		NOV 2005							
CHECKED BY										DATE		NOV 2005							
SJS																			

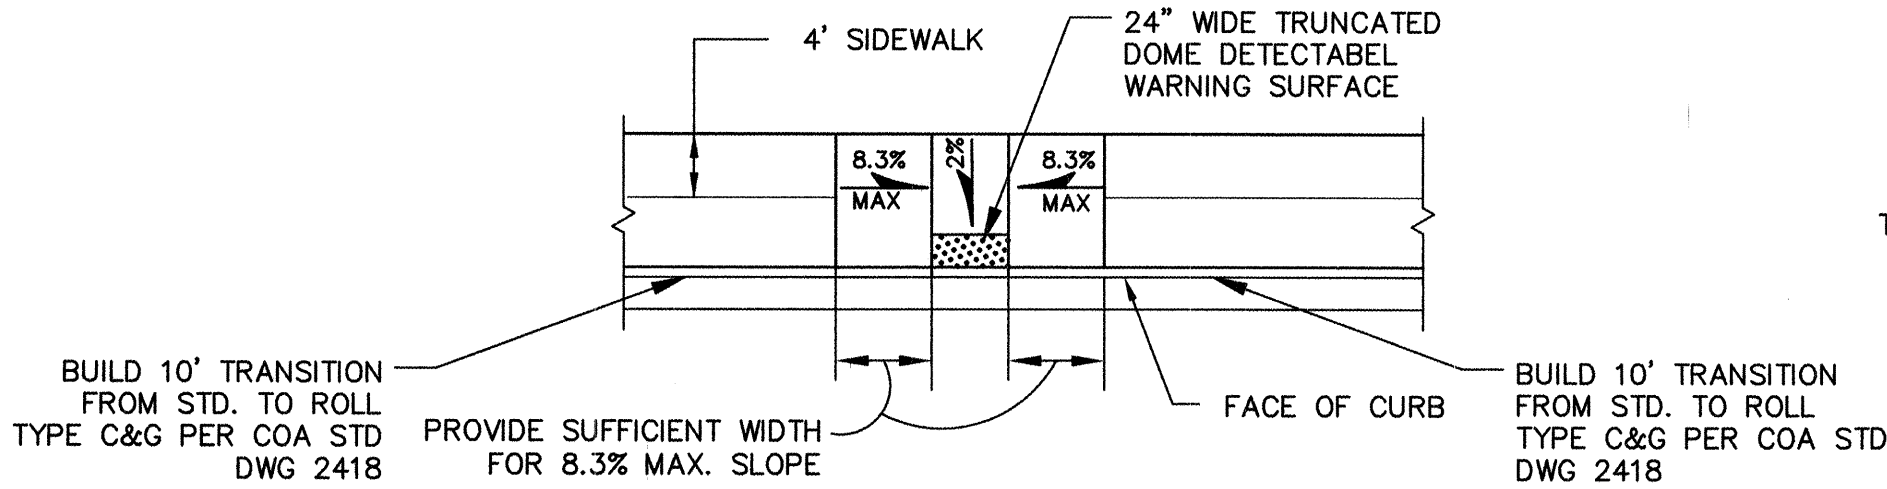


TYPICAL HANDICAP RAMP DETAIL

NTS USE STD COA DWG 2441

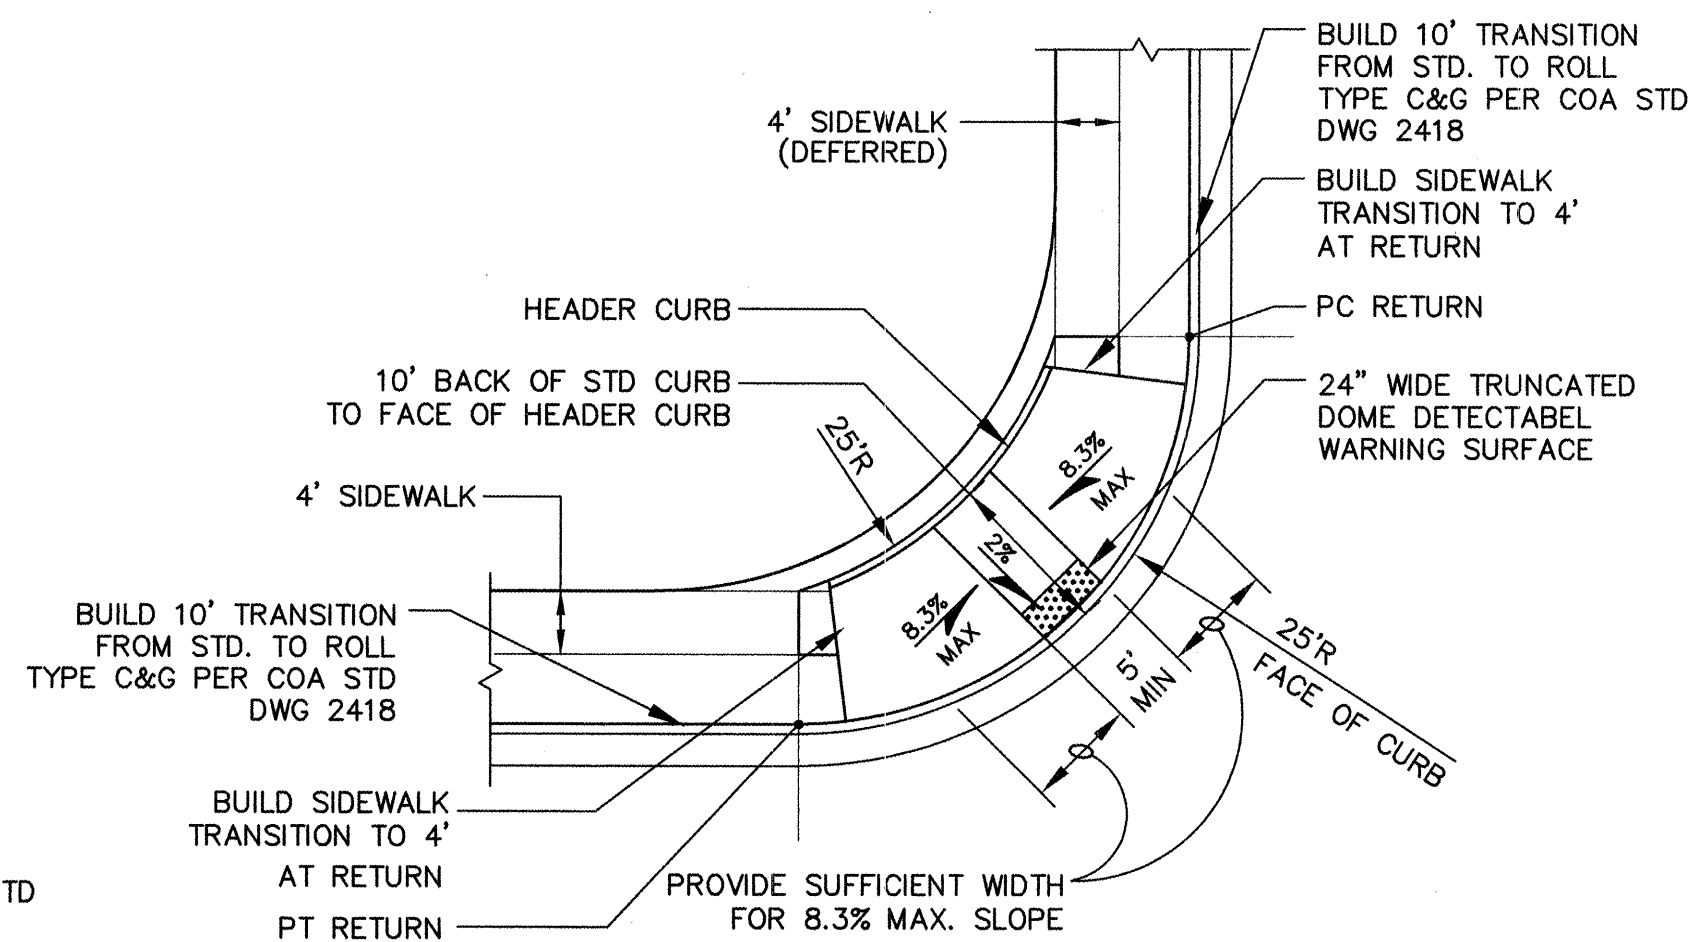


TYPICAL HANDICAP RAMP DETAIL

NTS USE STD COA DWG 2441

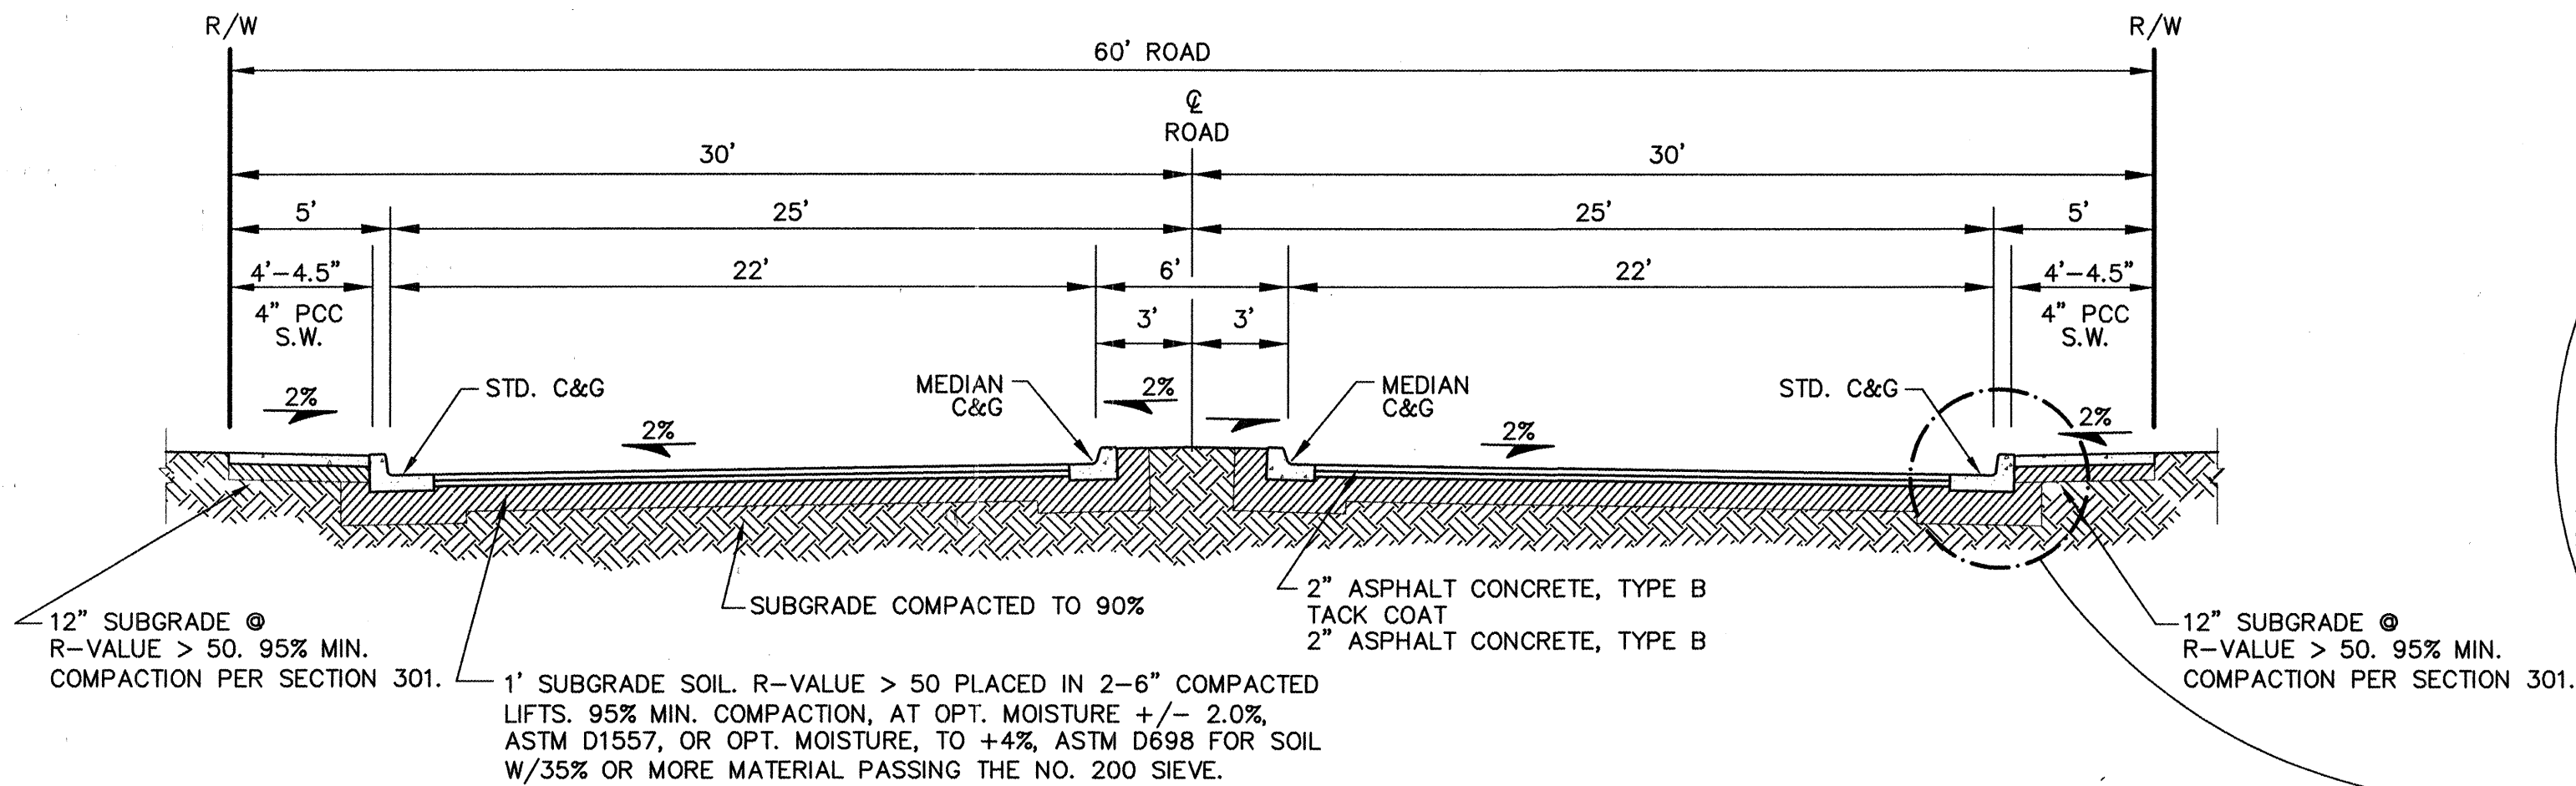


TYPICAL SECTION A-A RESIDENTIAL STREET ENTRANCE
(PER COA STD. DWG. No. 2405A, RESIDENTIAL PAVING SECTION)

1" = 5'-0"

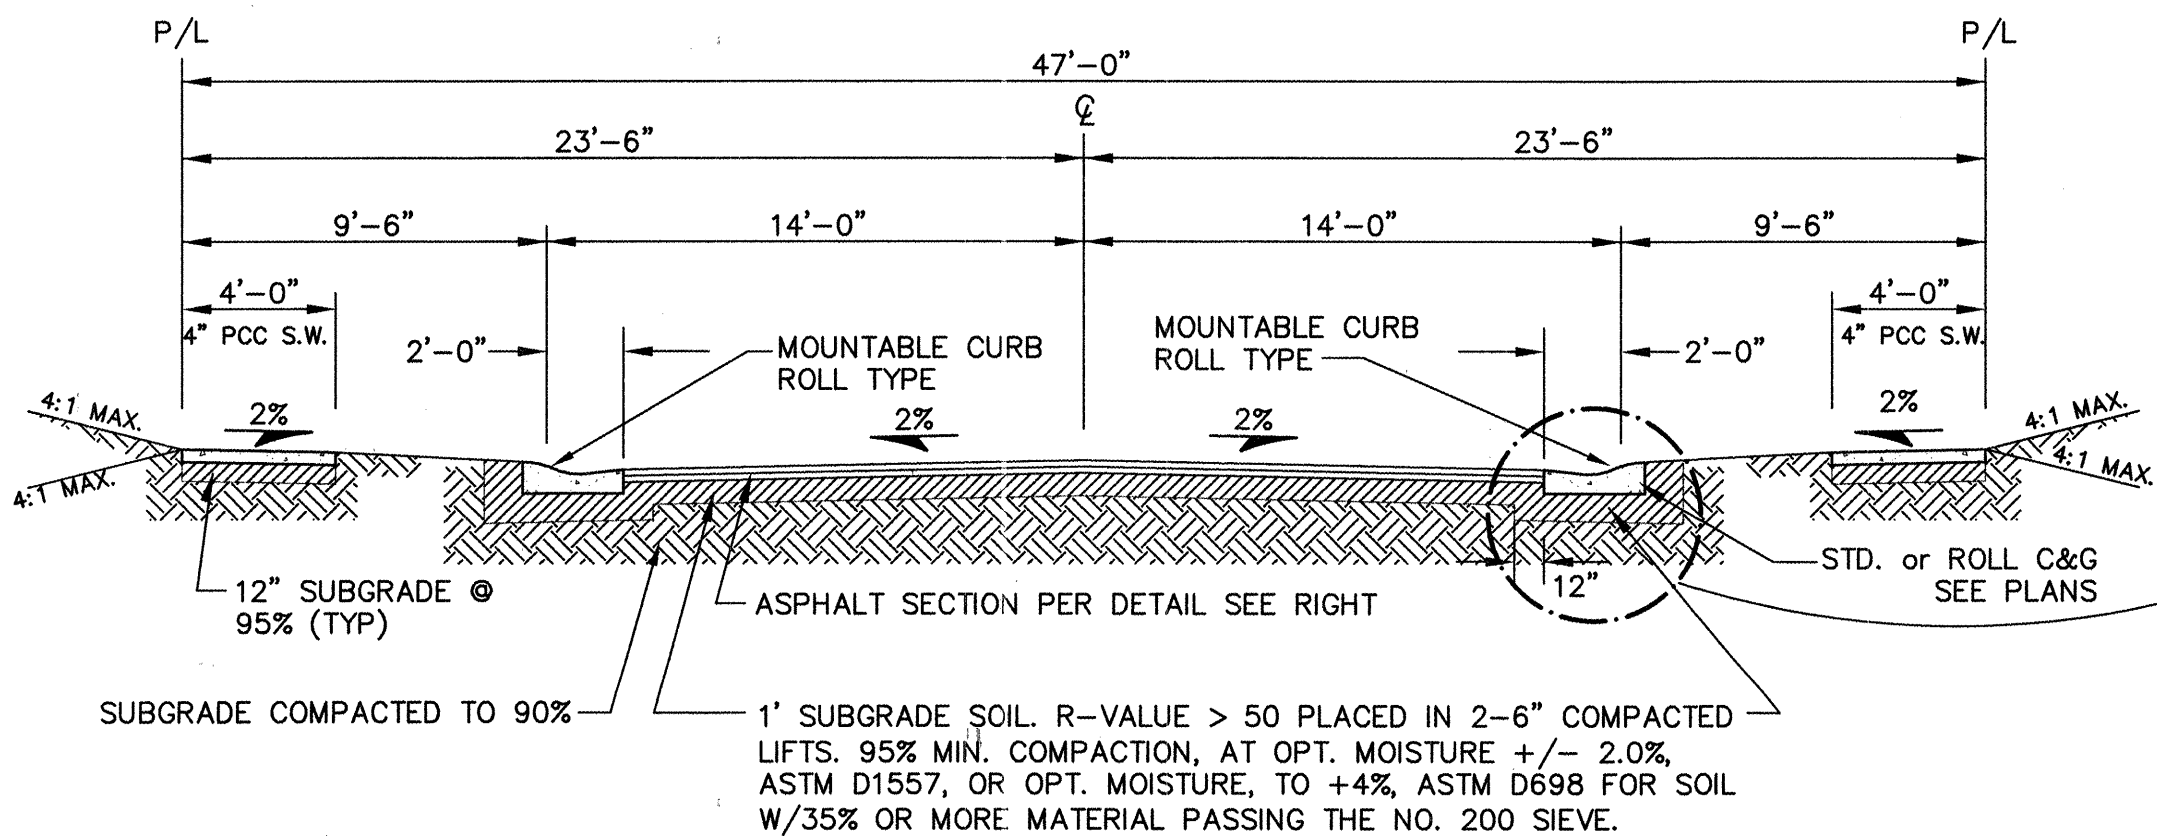


TYPICAL SECTION B-B RESIDENTIAL STREET
(PER COA STD. DWG. No. 2405A, RESIDENTIAL PAVING SECTION)

1" = 5'-0"

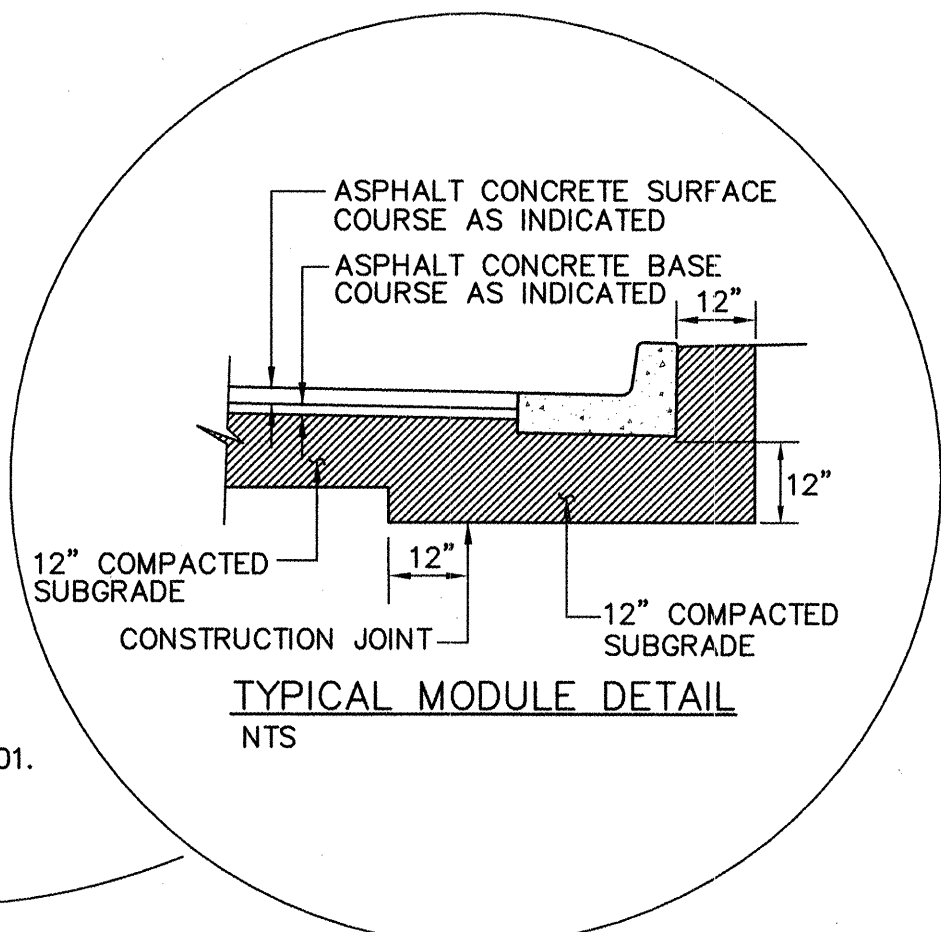

TYPICAL MODULE DETAIL

NTS

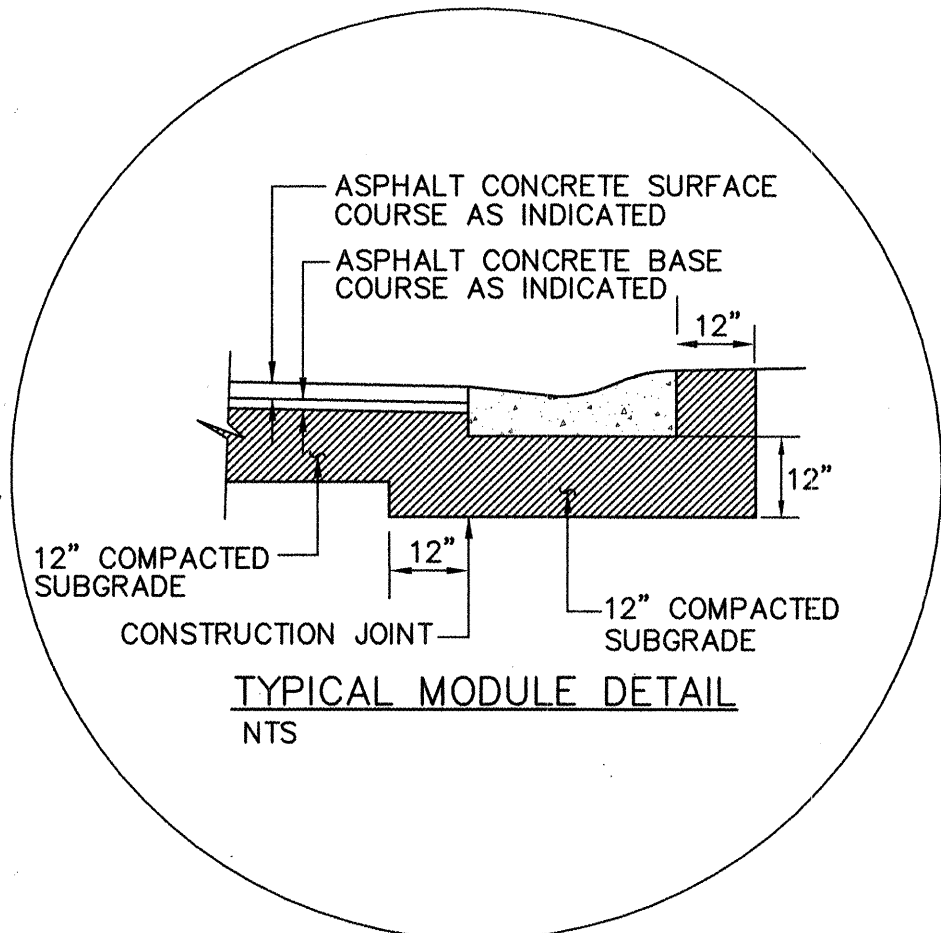


TYPICAL MODULE DETAIL

NTS



11/2" ASPHALT CONCRETE, TYPE C
TACK COAT
11/2" ASPHALT CONCRETE, TYPE C

3" RESIDENTIAL PAVEMENT SECTION
VALLE JARDIN RD NW - ENTIRE ROAD
VALLE PRADO PL NW STA 12+89 TO 23+51.32

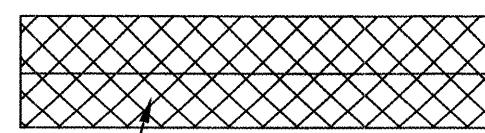

2" ASPHALT CONCRETE, TYPE B
TACK COAT
2" ASPHALT CONCRETE, TYPE B

4" RESIDENTIAL PAVEMENT SECTION
VALLE PRADO PL NW - STA 10+95.55 TO STA 12+89

NOTES:

1. USE ROLL-TYPE CURB: GUTTER WHERE INDICATED ON PLANS. PROVIDE 10' TRANSITION SECTIONS BETWEEN DIFFERENT CURB TYPES PER STD. DWG 2418
2. PAVING TO BE CONSTRUCTED AS DETAILED PER COA STD DWG. 2405A, EXCEPT PAVING SECTIONS SHALL CONSIST OF COMPONENTS AS SHOWN.
3. IN THE EVENT SOILS EXHIBITING AN R-VALUE LESS THAN 50 ARE ENCOUNTERED AT SUBGRADE DEPTH, THESE SOILS SHOULD BE REMOVED TO A DEPTH OF TWENTY FOUR INCHES AND BE REPLACED WITH SOIL WITH A MINIMUM R-VALUE OF 50. IF "SUGAR SAND" IS ENCOUNTERED IT SHOULD BE REMOVED AND REPLACED AS SPECIFIED IN THE CITY OF ALBUQUERQUE STANDARD SPECIFICATIONS FOR PUBLIC WORKS CONSTRUCTION.

WILSON & COMPANY
2600 THE AMERICAN ROAD S.E.
SUITE 100
RIO RANCHO, NEW MEXICO
87124
(505) 898-8021


CITY OF ALBUQUERQUE
PUBLIC WORKS DEPARTMENT
ENGINEERING GROUP

VALLE VISTA AT THE TRAILS UNIT II
TYPICAL PAVING SECTIONS & PAVING DETAILS


Design Review Committee	City Engineer Approval	Mo./Day/Yr.	Mo./Day/Yr.
APPROVED	APPROVED		
DESIGN REVIEW COMMITTEE	CITY ENGINEER		
City Project No.	Zone Map No.	Sheet	Of
730086	C-9-Z	8	16

AS-BUILT INFORMATION	BENCH MARKS	SURVEY INFORMATION	ENGINEER'S SEAL
CONTRACTOR: WILSON & COMPANY WORK STARTED: NOV 2005 DATE: NOV 2005 FIELD ACCEPTANCE BY: WILSON & COMPANY DATE: NOV 2005 DRAWINGS BY: WILSON & COMPANY DATE: NOV 2005 CHECKED BY: WILSON & COMPANY DATE: NOV 2005 RECORDED BY: WILSON & COMPANY DATE: NOV 2005	ACS BRASS TABLET STAMPED "2-B10 1980" Geographic Position (NAD 1977) N.M. State Plane Coordinates (Central Zone) X= 357,543.73 Y= 1,527,976.48 Ground-to-Grid Factor = 0.99966354 ΔX = -00'16"30" SLD 1929 Elevation = 5429.35	DATE: NOV 2005 BY: WILSON & COMPANY NO. 730086	

FACE CURB MEDIAN CURVE TABLE				
CURVE	LENGTH	RADIUS	DELTA	TANGENT
C1	6.28	2.00	180°00'00"	INFINITE
C2	52.49	150.00	20°03'01"	26.52
C3	34.21	150.00	13°03'56"	17.18

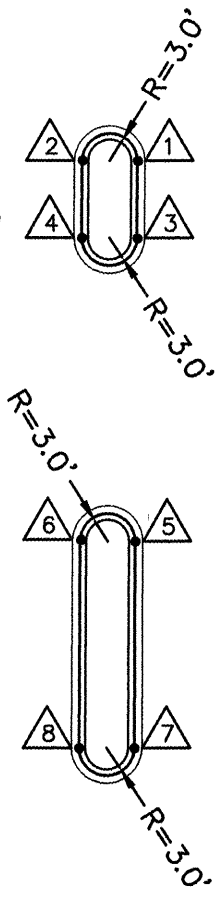

VALLE PRADO PL MEDIAN POINT TABLE				
Δ	STA.	OFFSET	FL ELEV.	
1	11+28.60	3.00' LT	5449.10	
2	11+28.60	3.00' RT	5449.17	
3	11+36.94	3.00' LT	5449.21	
4	11+36.94	3.00' RT	5449.27	
5	11+69.61	3.00' LT	5449.36	
6	11+69.61	3.00' RT	5449.40	
7	11+91.95	3.00' LT	5449.20	
8	11+91.95	3.00' RT	5449.22	

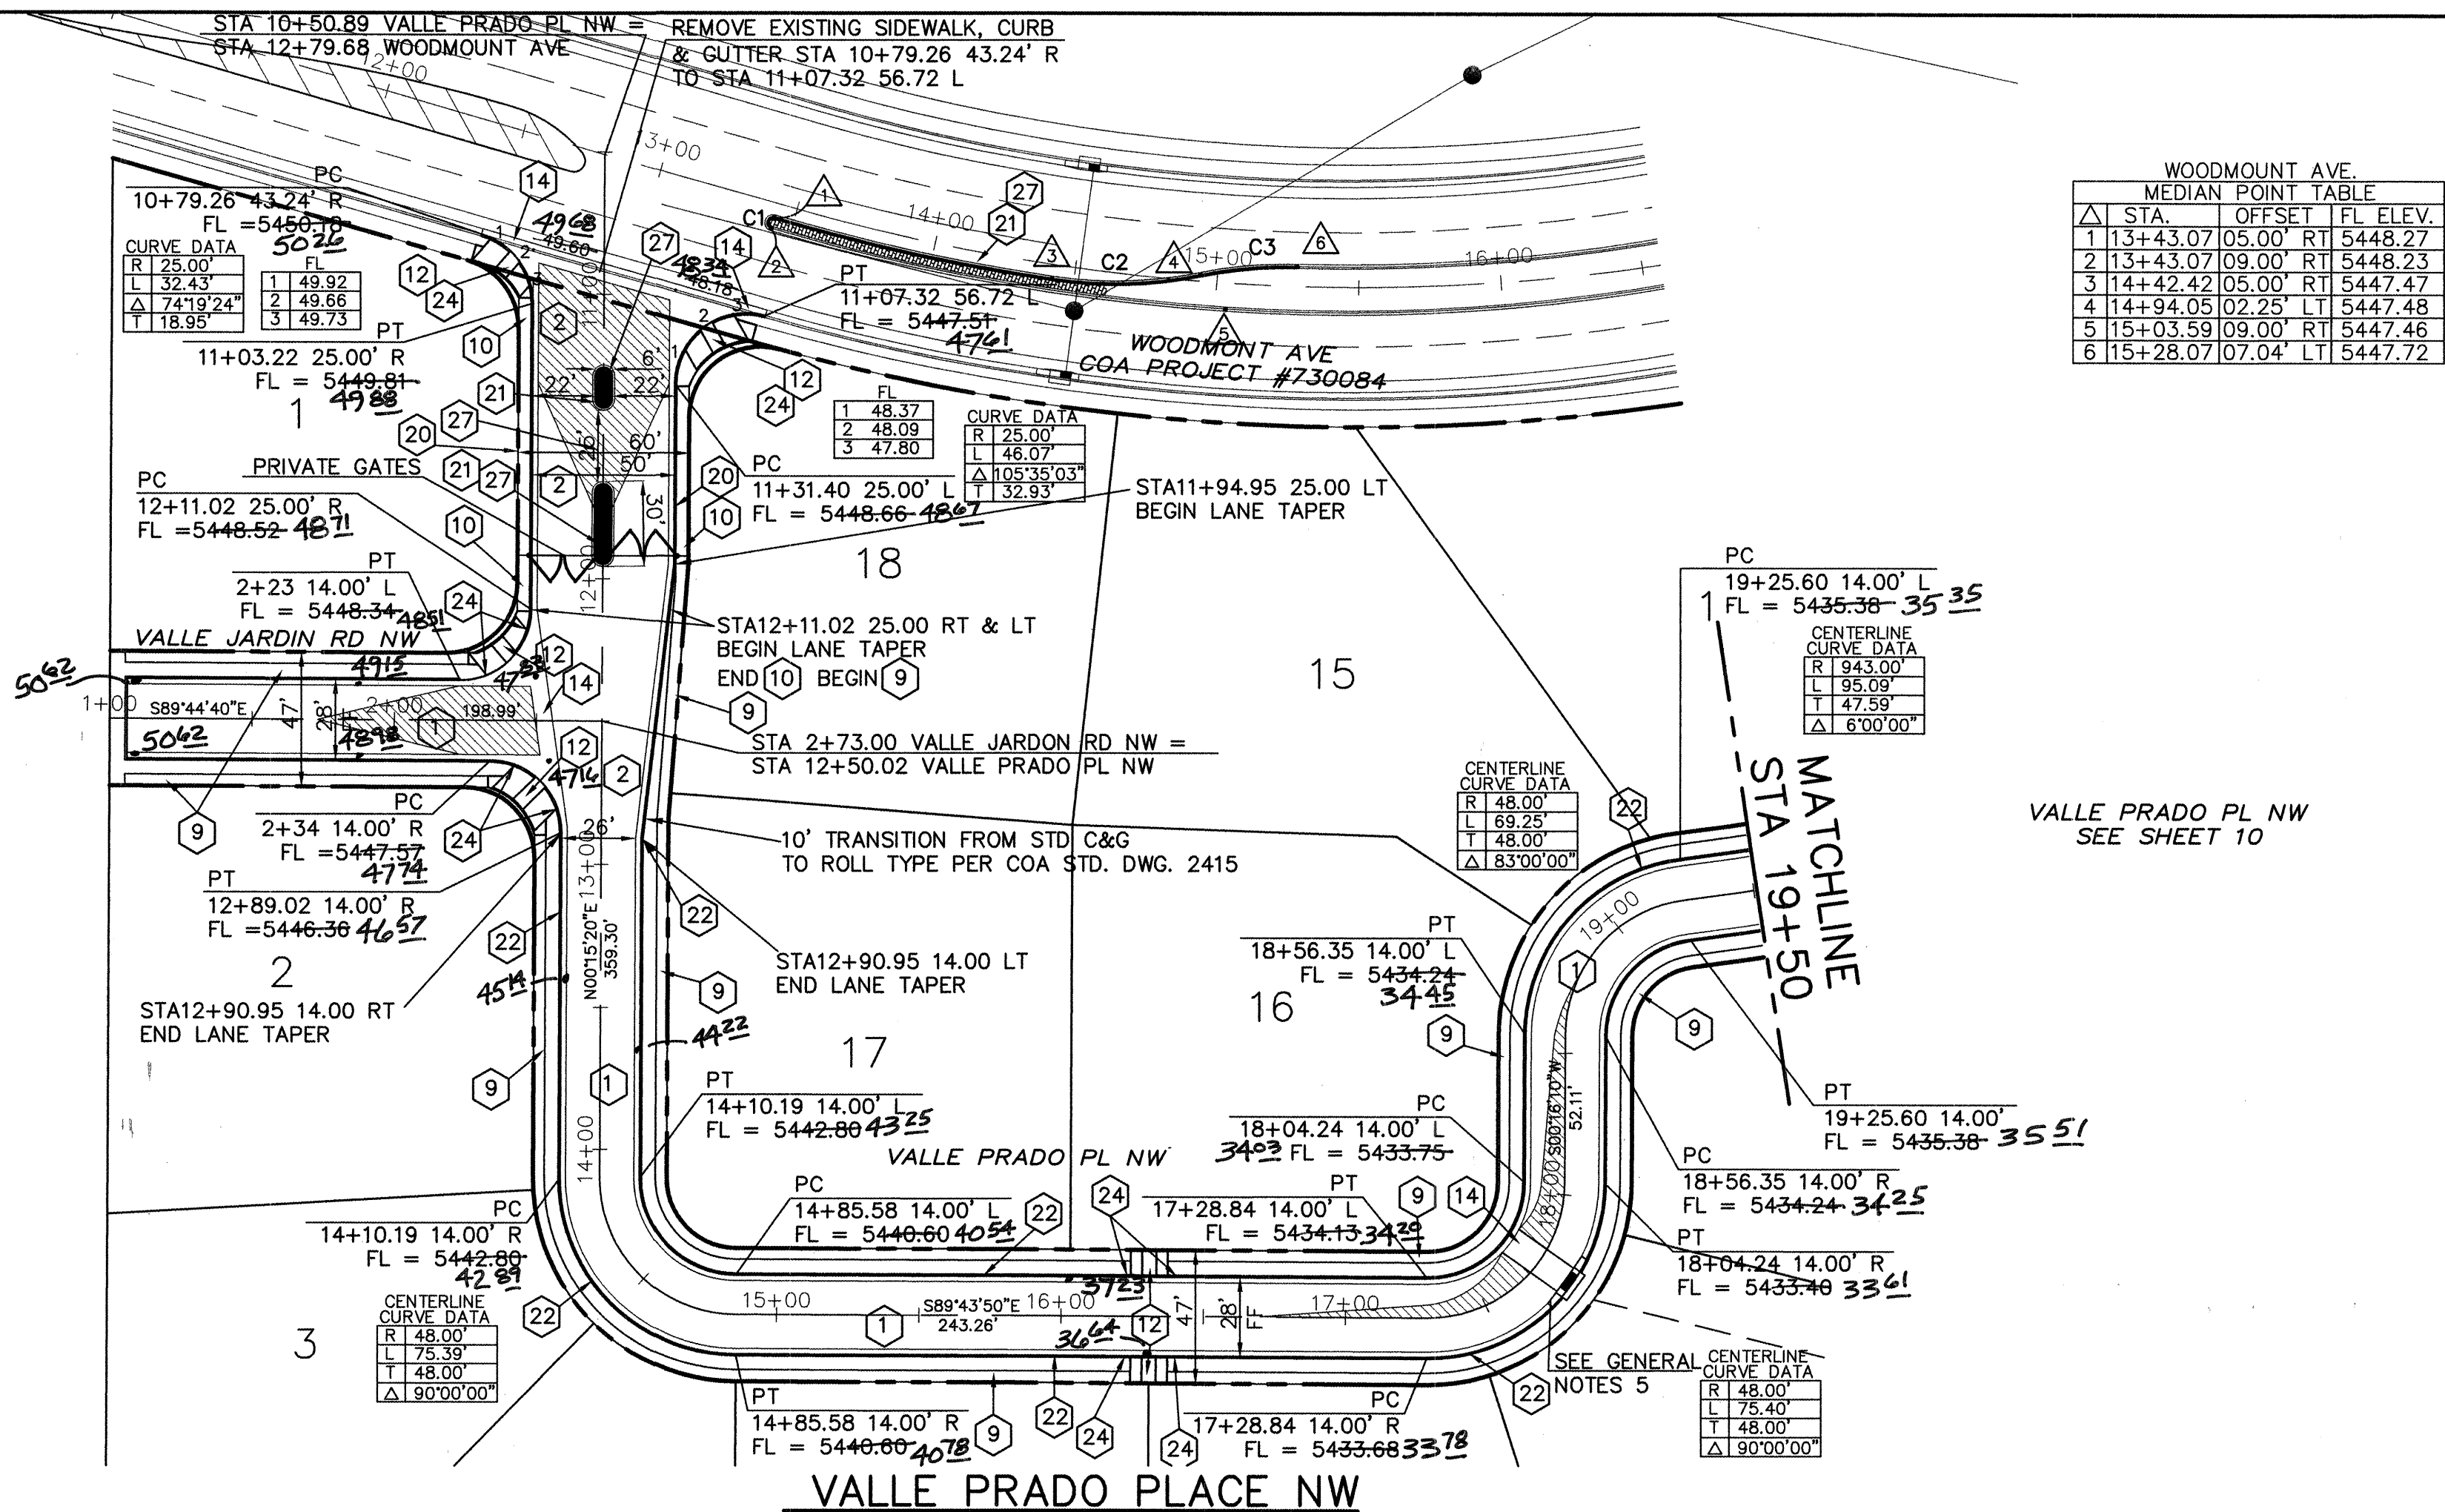

WOODMONT AVE MEDIAN POINT TABLE			
Δ	STA.	OFFSET	FL ELEV.
1	13+43.07	05.00' RT	5448.27
2	13+43.07	09.00' RT	5448.23
3	14+42.42	05.00' RT	5447.47
4	14+94.05	02.25' LT	5447.48
5	15+03.59	09.00' RT	5447.46
6	15+28.07	07.04' LT	5447.72

SCALE:
HORIZ: 1" = 50'
VERT: 1" = 10'


PAVING CONSTRUCTION NOTES

1. BUILD ASPHALT PAVING, PER TYPICAL SECTION (SEE SHEET 8) SECTION B-B
2. BUILD ASPHALT PAVING, PER TYPICAL SECTION (SEE SHEET 8) SECTION A-A
3. BUILD 4' PCC SIDEWALK, PER COA STD. DWG. 2430 (DEFERRED)
4. BUILD 4' PCC SIDEWALK, PER COA STD. DWG. 2430
5. BUILD 6' PCC SIDEWALK, PER COA STD. DWG. 2430
6. BUILD PCC WHEELCHAIR RAMP, PER COA STD. DWG. 2441 (SEE SHEET 8)
7. BUILD PCC 10' VALLEY GUTTER, PER COA STD. DWG. 2420, FLOW LINE 5' O.C.
8. BUILD PCC STD. CURB AND GUTTER, PER COA STD. DWG. 2415
9. BUILD PCC MEDIAN CURB AND GUTTER, PER COA DETAIL 2415B
10. BUILD PCC ROLL-TYPE C&G, PER COA STD. DWG. 2415A
11. BUILD 10' TRANSITION FROM STD. TO ROLL-TYPE C&G PER COA STD DWG 2418
12. BUILD TEXTURED CONCRETE MEDIAN PAVEMENT, PER COA STD. DWG. 2408 & 2501

- LEGEND
- TC TOP OF STANDARD TYPE CURB
- FL FLOW LINE
- TRC TOP OF ROLL TYPE CURB
- 39.85* TOP OF ROLL TYPE CURB ELEVATION AT WHEEL CHAIR RAMP TRANSITION.
- 39.85 FLOWLINE ELEVATION AT INTERSECTION OF PROJECTED FACE OF CURB.
- MATCHLINE OF NEW TO EXISTING ASPHALT PAVEMENT.
- TRANSITION CROWN PER COA STD DWG 2401

GENERAL NOTES

1. ALL CURB RETURNS HAVE 25' RADIUS AT THEORETICAL FACE OF CURB (FLOWLINE) PER COA STD DWG 2415A, UNLESS OTHERWISE INDICATED
2. ALL STATIONS AND OFFSETS ARE TO THEORETICAL FACE OF CURB (FLOWLINE) PER COA STD DWG 2415A, UNLESS OTHERWISE INDICATED
3. ALL CURB LAYOUT DATA IS AT THEORETICAL FACE OF CURB (FLOWLINE) PER COA STD DWG 2415A, UNLESS OTHERWISE INDICATED. CURB LAYOUT THAT IS A DIRECT OFFSET OF PLATTED BASELINE IS NOT SHOWN
4. ADJUST ALL MANHOLE RIMS AND VALVE COVERS PER COA STD. DWG. 2460
5. THERE IS A 5 FT TRANSITION FROM ROLLED CURB TO STD CURB ON EITHER SIDE OF THE INLET.
6. DEPRESS CURB AT VALLEY GUTTER PER COA STD DWG 2415A

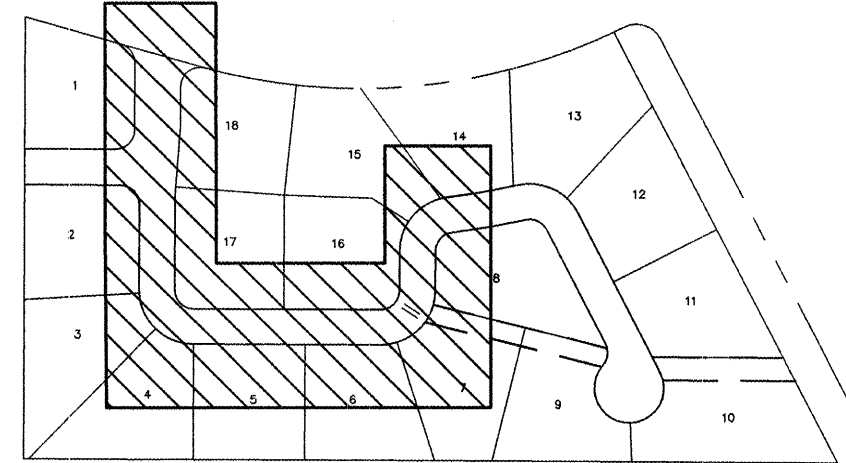

INDEX MAP

SURVEYORS CERTIFICATION



I, Russ P. Hugg, New Mexico Professional Surveyor Number 9750, hereby certify that the as-built information shown hereon is the result of an actual field survey performed by me or under my direct supervision and that the same is true and correct to the best of my knowledge and belief;

Russ P. Hugg
NMPs No. 9750
4.17 2007


WILSON & COMPANY 2600 THE AMERICAN ROAD S.E. SUITE 100 RIO RANCHO, NEW MEXICO (505) 898-8021

CITY OF ALBUQUERQUE
PUBLIC WORKS DEPARTMENT
ENGINEERING GROUP

**VALLE VISTA AT THE TRAILS UNIT II
VALLE PRADO PL NW PAVING PLAN & PROFILE**

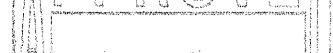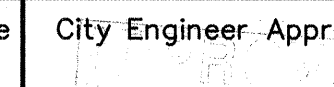Design Review Committee		City Engineer Approval		Mo./Day/Yr.			
				Mo./Day/Yr.	Mo./Day/Yr.		
City Project No.		Zone Map No.		Sheet			
730086		C-9-Z		9 of 16			

AS-BUILT INFORMATION		BENCH MARKS		SURVEY INFORMATION		ENGINEER'S SEAL	
CONTRACTOR	DATE	CONTRACTOR	DATE	NO.	DATE	REMARKS	BY
SALES	02/07	SALES	02/07				
WORK BY	DATE	WORK BY	DATE				
INSPECTOR	DATE	INSPECTOR	DATE				
ACCEPTANCE BY	DATE	ACCEPTANCE BY	DATE				
VERIFICATION BY	DATE	VERIFICATION BY	DATE				
DRAWN BY	DATE	DRAWN BY	DATE				
CHECKED BY	DATE	CHECKED BY	DATE				
RECORDED BY	DATE	RECORDED BY	DATE				

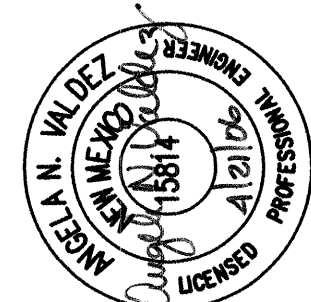

REVISIONS		REVISIONS	
NO.	DATE	NO.	DATE
1	DEC 2006	1	DEC 2006
2	DEC 2006	2	DEC 2006
3	DEC 2006	3	DEC 2006

DESIGNED BY		CHECKED BY	
DATE	DATE	DATE	DATE
DEC 2006	DEC 2006	DEC 2006	DEC 2006




SCALE:
HORIZ: 1" = 50'
VERT: 1" = 10'



I, Russ P. Hugg, New Mexico Professional Surveyor Number 9750, hereby certify that the as-built information shown hereon is the result of an actual field survey performed by me or under my direct supervision and that the same is true and correct to the best of my knowledge and belief;

Russ P. Hagg
NMPS No. 9750

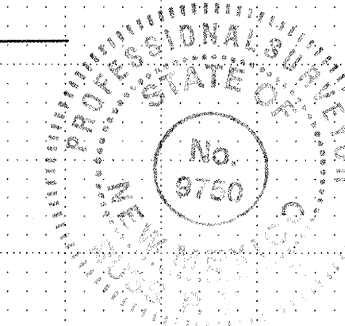

INDEX MAP

WILSON
& COMPANY

2600 THE AMERICAN ROAD S.E.
SUITE 100
RIO RANCHO, NEW MEXICO
87124
(505) 898-8021

CITY OF ALBUQUERQUE
PUBLIC WORKS DEPARTMENT
ENGINEERING GROUP

VALLE VISTA AT THE TRAILS UNIT II VALLE PRADO PL NW PAVING PLAN & PROFILE


Design Review Committee

City Engineer Approval

Fast Design Update




Mo./Day/Yr.	Mo./Day/Yr.

City Project No.	730086	Zone Map No.	C-9-Z	Sheet	Of	10	16
------------------	--------	--------------	-------	-------	----	----	----

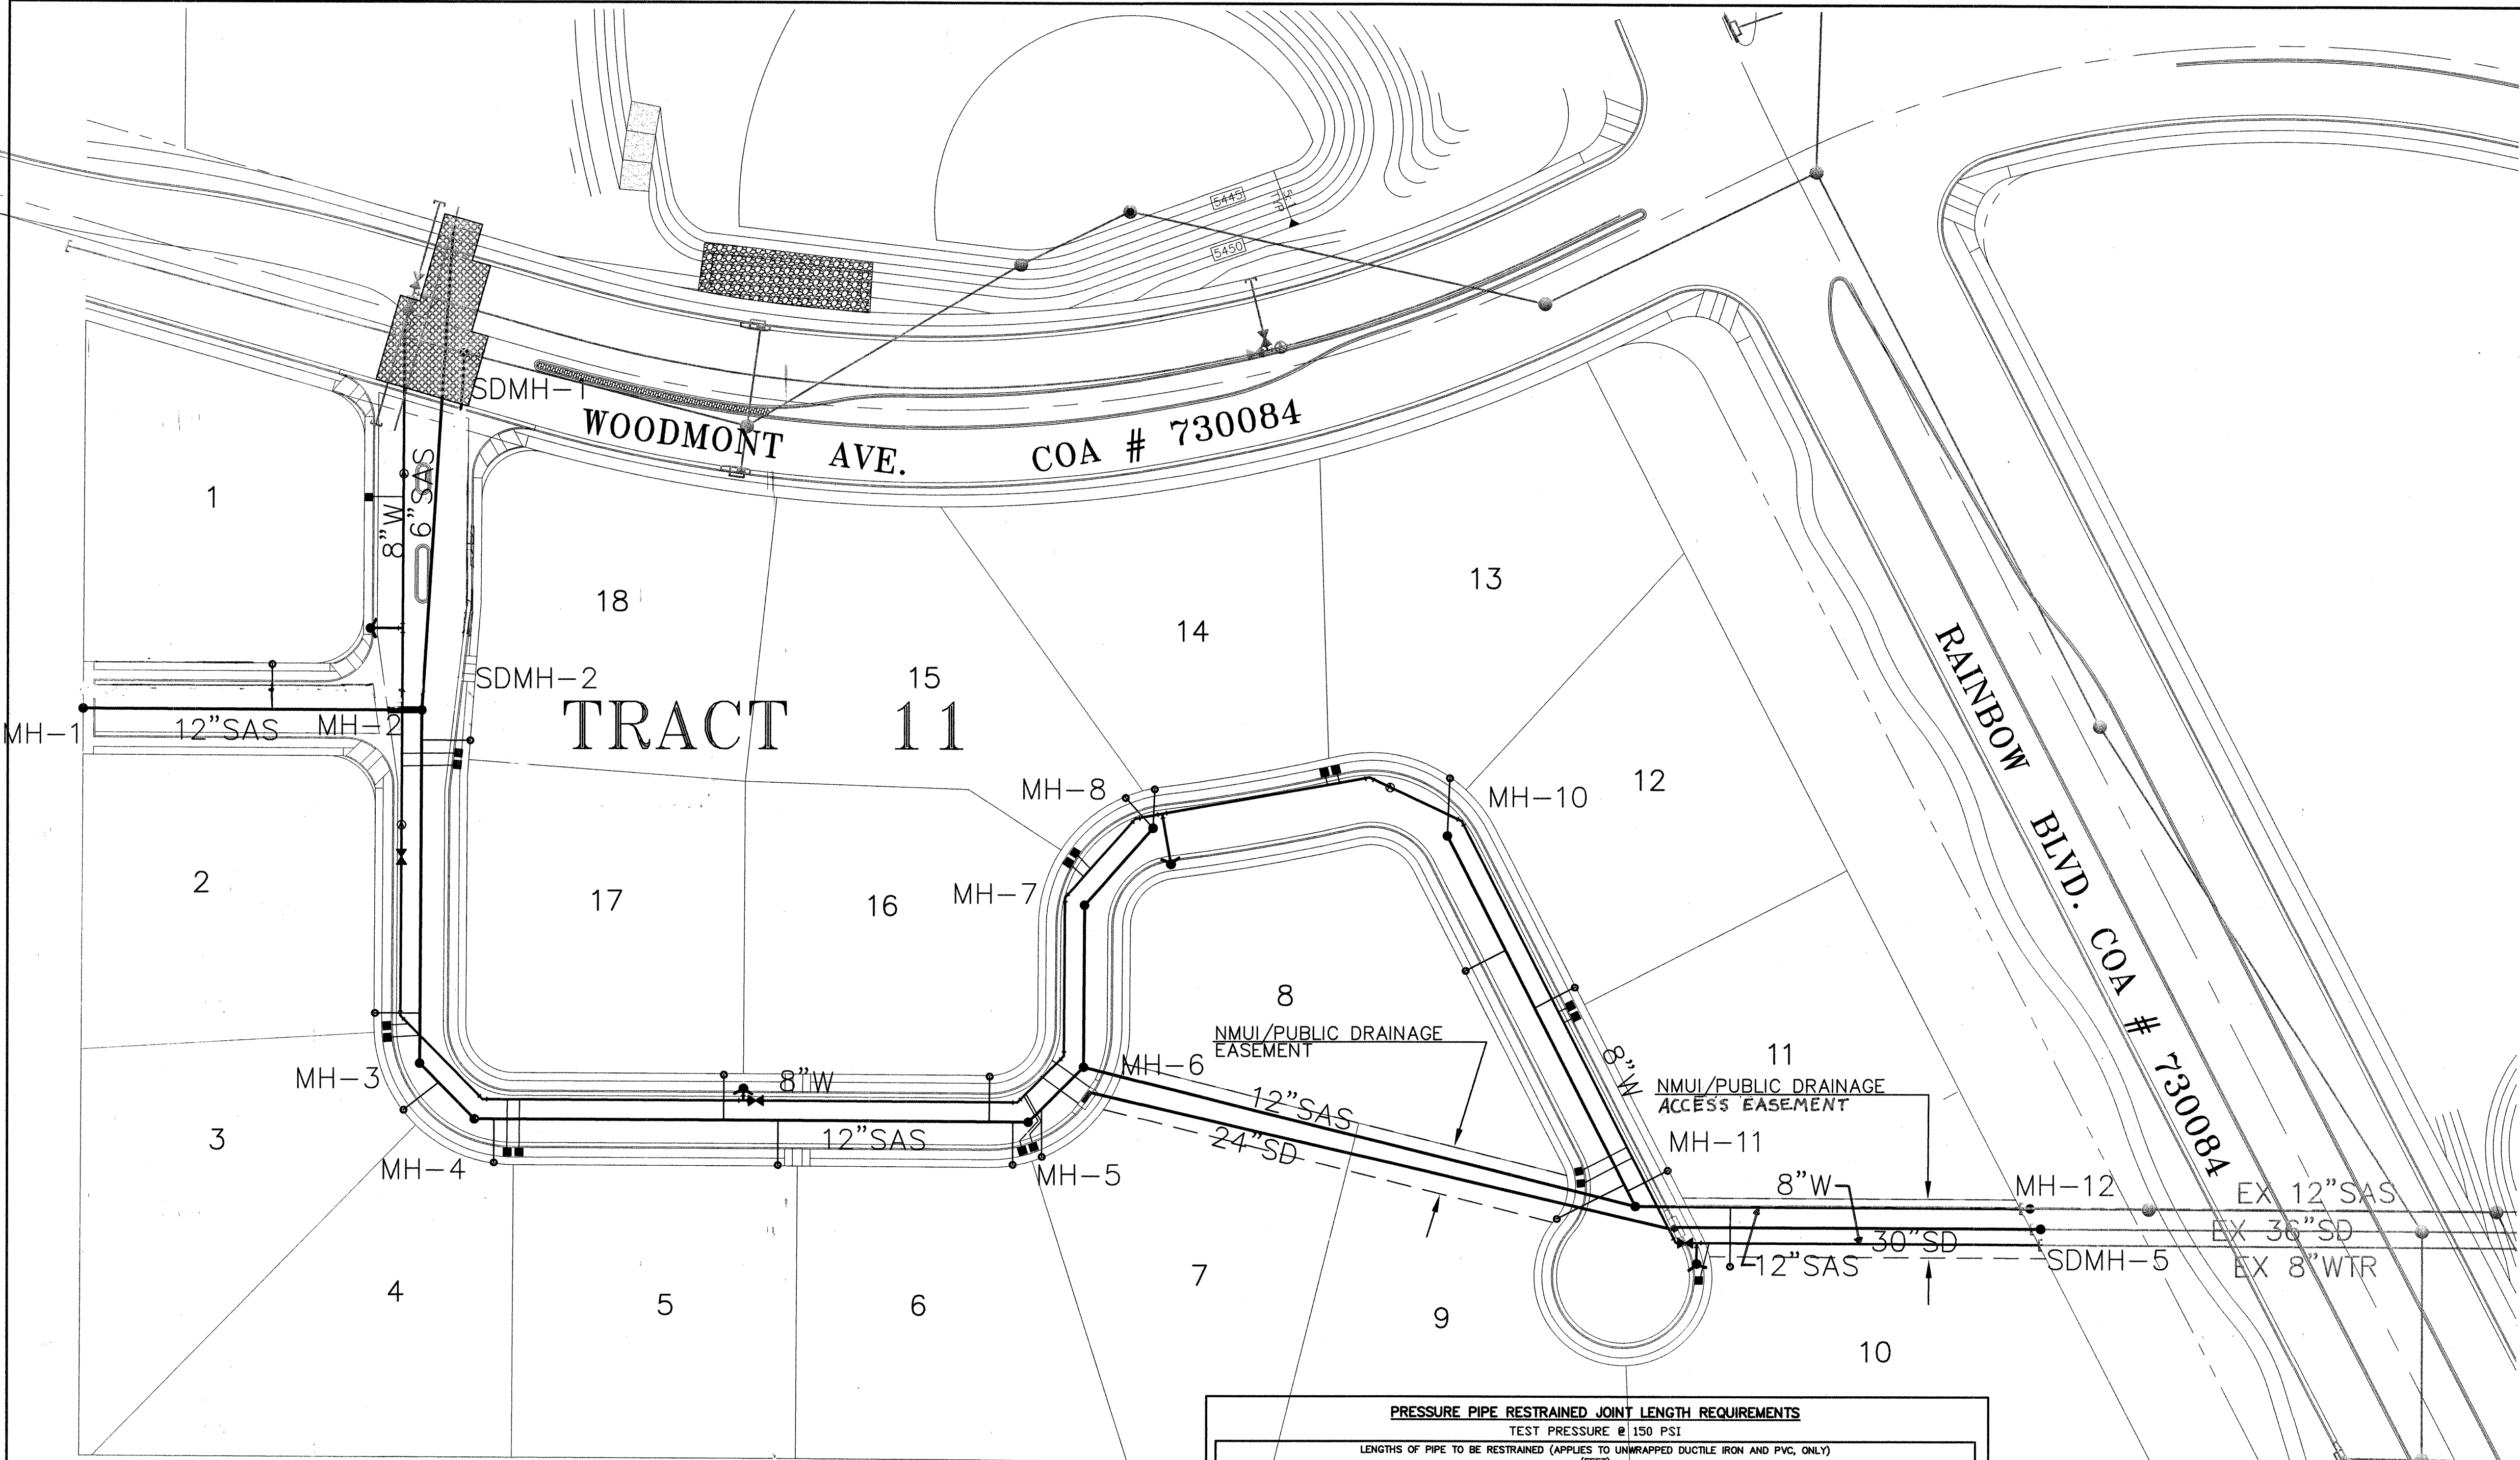

LEGEND

	NEW	EXISTING
RIGHT-OF-WAY LINE	---	---
PAVEMENT EDGE	---	---
WATERLINE	W	W
SANITARY SEWER LINE	SAS	SAS
STORMDRAIN LINE	SD	SD
WATER VALVE	⊗	⊗
REDUCER	▼	▼
FIRE HYDRANT	⊙	⊙
1" SINGLE WATER SERVICE, U.N.O.	⊙	⊙
1" DOUBLE WATER SERVICE, U.N.O.	⊙	⊙
SAS MANHOLE	⊙	⊙
STORM DRAIN MANHOLE	⊙	⊙
SANITARY SEWER SERVICE	---	---
LIMITS OF REMOVAL AND REPLACEMENT OF EXISTING ASPHALT, C&G AND SIDEWALK PAVT PER COA STD DWG 2465 (COLLECTOR)	▨	▨

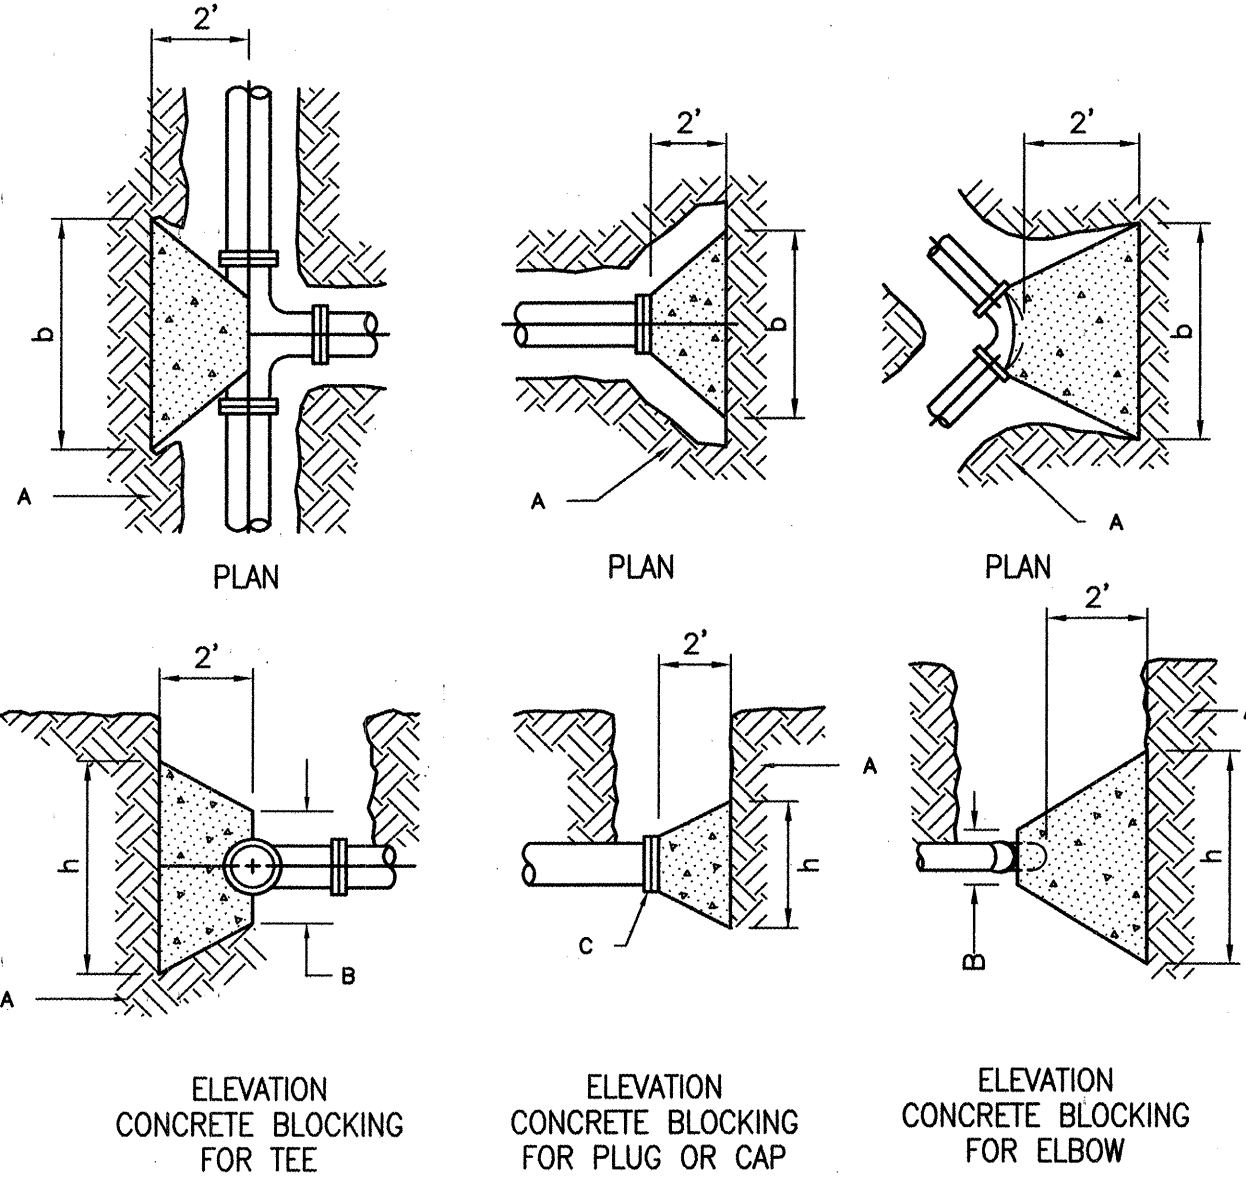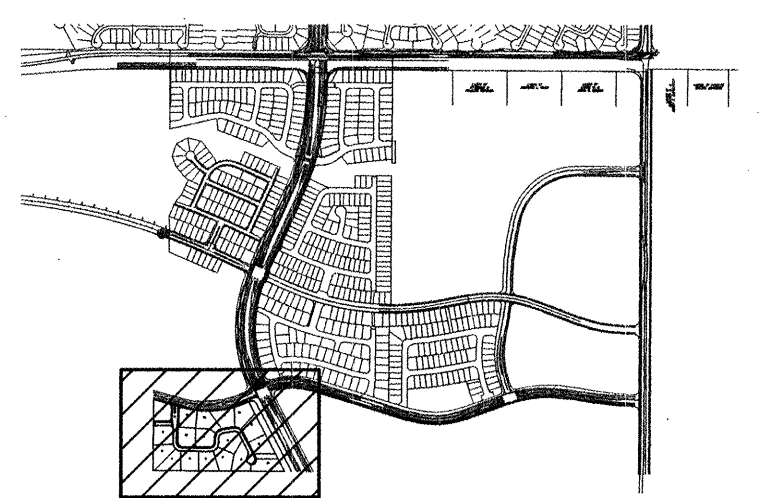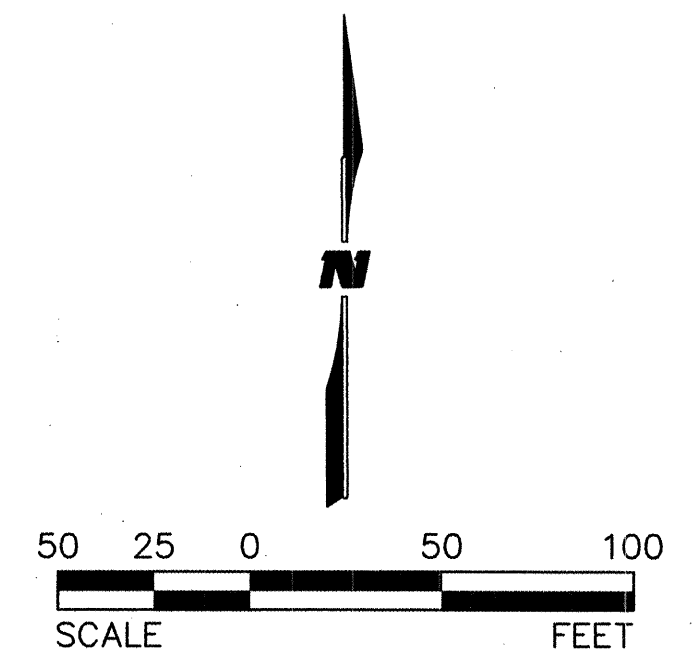

GENERAL NOTES:

- THE ENGINEER SHALL PROVIDE DESIGN FOR ALL JOINTS GREATER THAN 14".

PIPE SIZE	ELBOW ANGLE	ELBOW (b) DIM.	TEE OR PLUG (h) DIM.	TEE OR PLUG (h) DIM.
4"	90° 45°	2'	2'	1'
4"	22 1/2° 11 1/4°	2'	2'	2'
6"	90° 45°	2'	2'	2'
6"	22 1/2° 11 1/4°	2'	2'	3'
8"	90°	3'	3'	3'
8"	45°	2'	2'	3'
8"	22 1/2° 11 1/4°	2'	2'	3'
10"	90°	3'-6"	3'-6"	3'
10"	45°	3'	3'	3'-6"
10"	22 1/2° 11 1/4°	2'	2'	3'-6"
12"	90°	4'	4'	4'
12"	45°	3'-6"	3'-6"	4'
12"	22 1/2° 11 1/4°	2'	2'	4'
14"	90°	5'	5'	4'
14"	45°	3'-6"	3'-6"	5'
14"	22 1/2° 11 1/4°	3'	3'	5'

CONSTRUCTION NOTES:

- UNDISTURBED EARTH.
- O.D. OF PIPE + 8".
- O.D. OF CAP OR PLUG, MIN. 12" X 12".

PRESSURE PIPE RESTRAINED JOINT LENGTH REQUIREMENTS
TEST PRESSURE @ 150 PSI
LENGTHS OF PIPE TO BE RESTRAINED (APPLIES TO UNWRAPPED DUCTILE IRON AND PVC, ONLY) (FEET)

PIPE SIZE	FITTING TYPE		RESTRAINED LENGTH ALONG BRANCH (L _B)	TEE OR VALVE	VERTICAL DOWNBEND	
	90° BEND	45° BEND			UPPER END RESTRAINT	LOWER END RESTRAINT
4" (D)	18'	7'	1'	NOT APPLICABLE	39'	16'
6" (D)	25'	10'	1'	NOT APPLICABLE	55'	23'
8" (D)	32'	13'	1'	NOT APPLICABLE	71'	30'
10" (D)	38'	16'	1'	NOT APPLICABLE	87'	37'
12" (D)	45'	19'	1'	NOT APPLICABLE	103'	44'
14" (D)	52'	22'	1'	NOT APPLICABLE	119'	51'
16" (D)	59'	25'	1'	NOT APPLICABLE	135'	58'
18" (D)	66'	28'	1'	NOT APPLICABLE	151'	65'
20" (D)	73'	31'	1'	NOT APPLICABLE	167'	72'
24" (D)	87'	37'	1'	NOT APPLICABLE	201'	86'

THURST RESTRAINT NOTE:
ALL BURIED VALVES, FITTINGS, AND APPURTENANCES SHALL BE MECHANICAL JOINT-TYPE UTILIZING "MEGA-LUG" STYLE MECHANICAL JOINT RESTRAINTS IN CONJUNCTION WITH "MEGA-LUG" PIPE BELL-HARNESSE RESTRAINTS WHEN ADEQUATE RESTRAINED LENGTH CAN BE OBTAINED. IN THE EVENT ADEQUATE RESTRAINED LENGTHS CANNOT BE OBTAINED, CONTRACTOR SHALL IMMEDIATELY CONTACT ENGINEER FOR DETERMINATION OF APPROPRIATE ACTION TO BE TAKEN. THE EBAA IRON "RESTRAINED LENGTH CALCULATION" PROGRAM (VERSION 4.0) HAS BEEN USED TO DETERMINE MINIMUM RESTRAINED LENGTHS SHOWN IN TABLE ABOVE. THE FOLLOWING GENERAL ASSUMPTIONS APPLY TO ALL CALCULATIONS:

TRENCH TYPE 3 SN (SILTY SANDS, SAND SILT MIXTURE)
SOIL TYPE 45
SAFETY FACTOR 1.5 TO 1

TYPICAL BURY DEPTH
4" THROUGH 12" DIAMETER PIPE 3 FT
14" THROUGH 24" DIAMETER PIPE 4 FT

TYPICAL BURY DEPTHS FOR VERTICAL OFFSETS
4" THROUGH 12" DIAMETER PIPE 3 FT TO TOP OF UPPER BRANCH
6 FT TO TOP OF LOWER BRANCH
14" THROUGH 24" DIAMETER PIPE 4 FT TO TOP OF UPPER BRANCH
7 FT TO TOP OF LOWER BRANCH

CONTRACTOR MAY SUBSTITUTE REDUCED RESTRAINED JOINT LENGTHS IF SOIL AND DEPTH OF BURY CONDITIONS WARRANT. CONTRACTOR SHALL PROVIDE SOIL TEST RESULTS AND APPROPRIATE CALCULATIONS TO SUPPORT THE LENGTH REDUCTION. SOIL TESTING AND CALCULATIONS SHALL BE PERFORMED AT CONTRACTOR'S SOLE EXPENSE.

INDEX MAP
APPROVED FOR CONSTRUCTION

NEW MEXICO UTILITIES INC. DATE: 4/21/05

WILSON & COMPANY 2600 THE AMERICAN ROAD S.E. SUITE 100 RIO RANCHO, NEW MEXICO 87124 (505) 698-8021


CITY OF ALBUQUERQUE
PUBLIC WORKS DEPARTMENT
ENGINEERING GROUP

VALLE VISTA AT THE TRAILS UNIT II
COMPOSITE UTILITY PLAN


Design Review Committee	City Engineer Approval	Mo./Day/Yr.	Mo./Day/Yr.
APPROVED	APPROVED		
DESIGN REVIEW COMMITTEE	CITY ENGINEER		

City Project No. 730086 Zone Map No. C-9-Z Sheet 12 of 16

AS-BUILT INFORMATION		BENCH MARKS		SURVEY INFORMATION		ENGINEER'S SEAL	
CONTRACTOR	CAUS	ACS BRASS TABLET STAMPED	"2-B10 1980"	DATE			REVISIONS NO. DATE BY REMARKS
STAKED BY	CAUS	Geographic Position (NAD 1927)		BY			
ACCEPTED BY	CAUS	N.M. State Plane Coordinates (Central Zone)					
FIELD CHECKED BY	CAUS	X= 357,543.73 Y= 1,527,976.48					
DRAWN BY	CAUS	Ground-to-Grid Factor = 0.9996354				DESIGNED BY	WILSON & COMPANY, ENGINEERS & ARCHITECTS
CHECKED BY	CAUS	ΔQ = -00'16"30"				DRAWN BY	
RECORDED BY	CAUS	SLD 1929 Elevation = 5429.35				CHECKED BY	

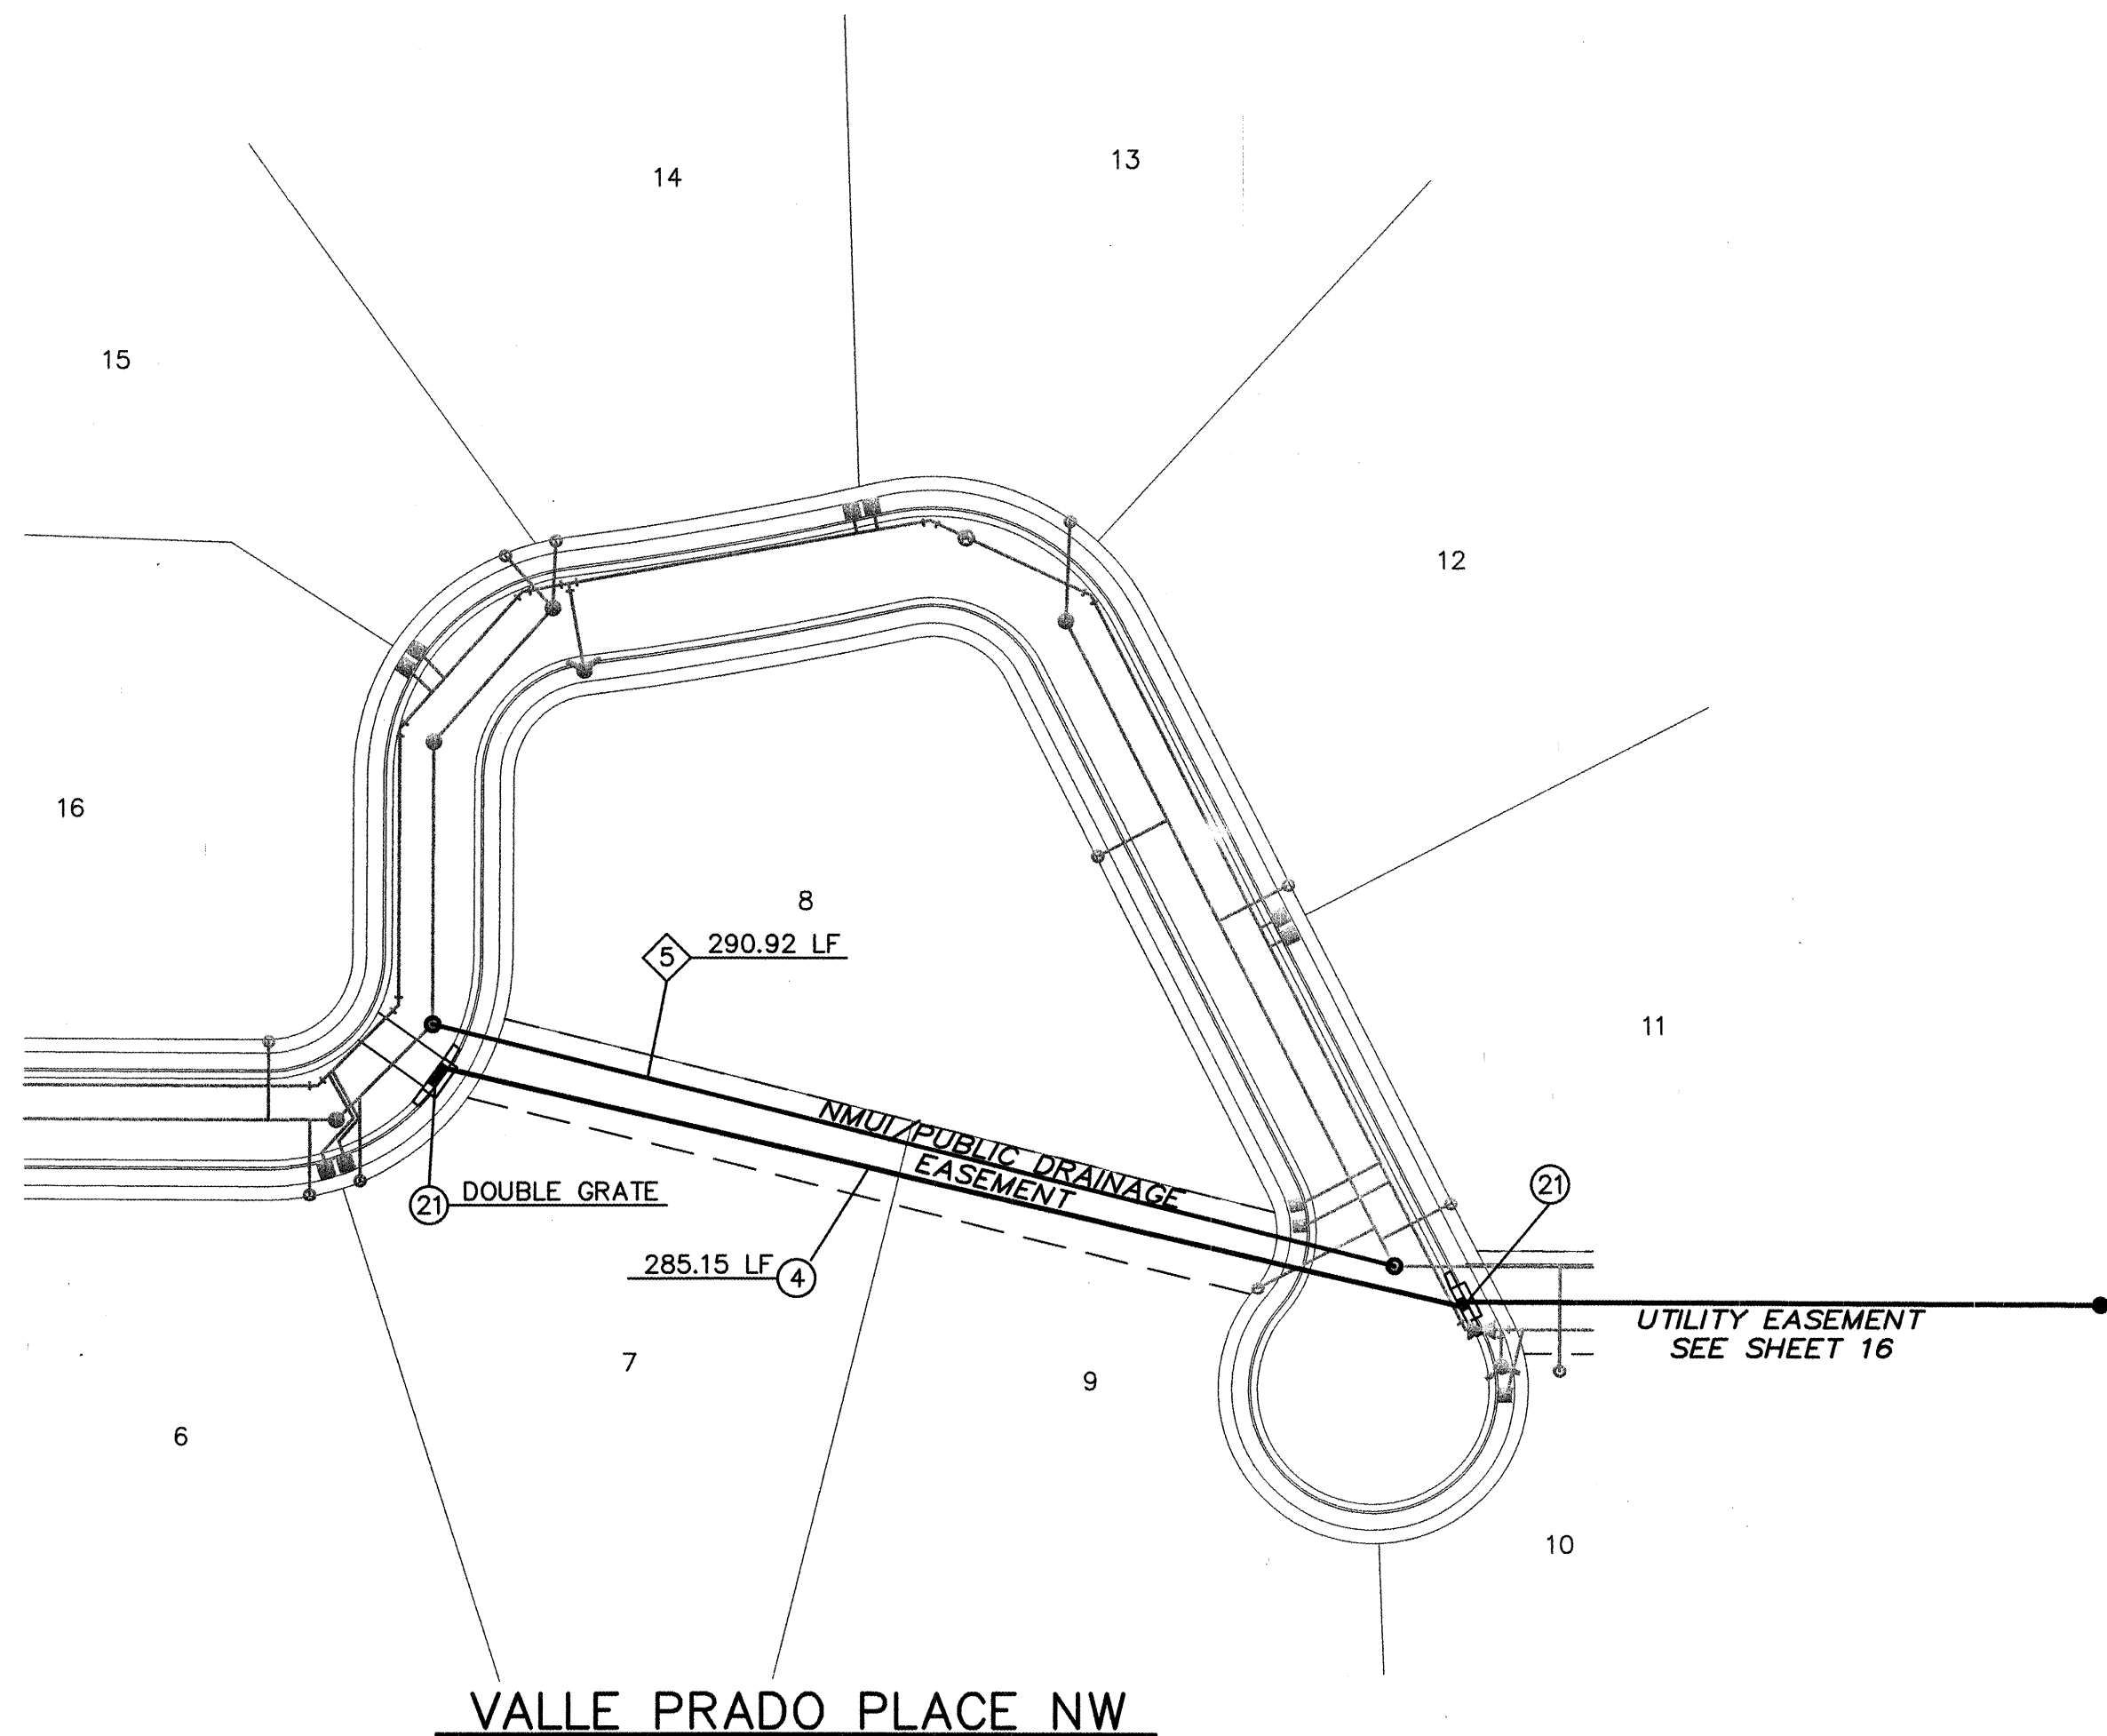

SCALE:
HORIZ: 1" = 50'
VERT: 1" = 10'

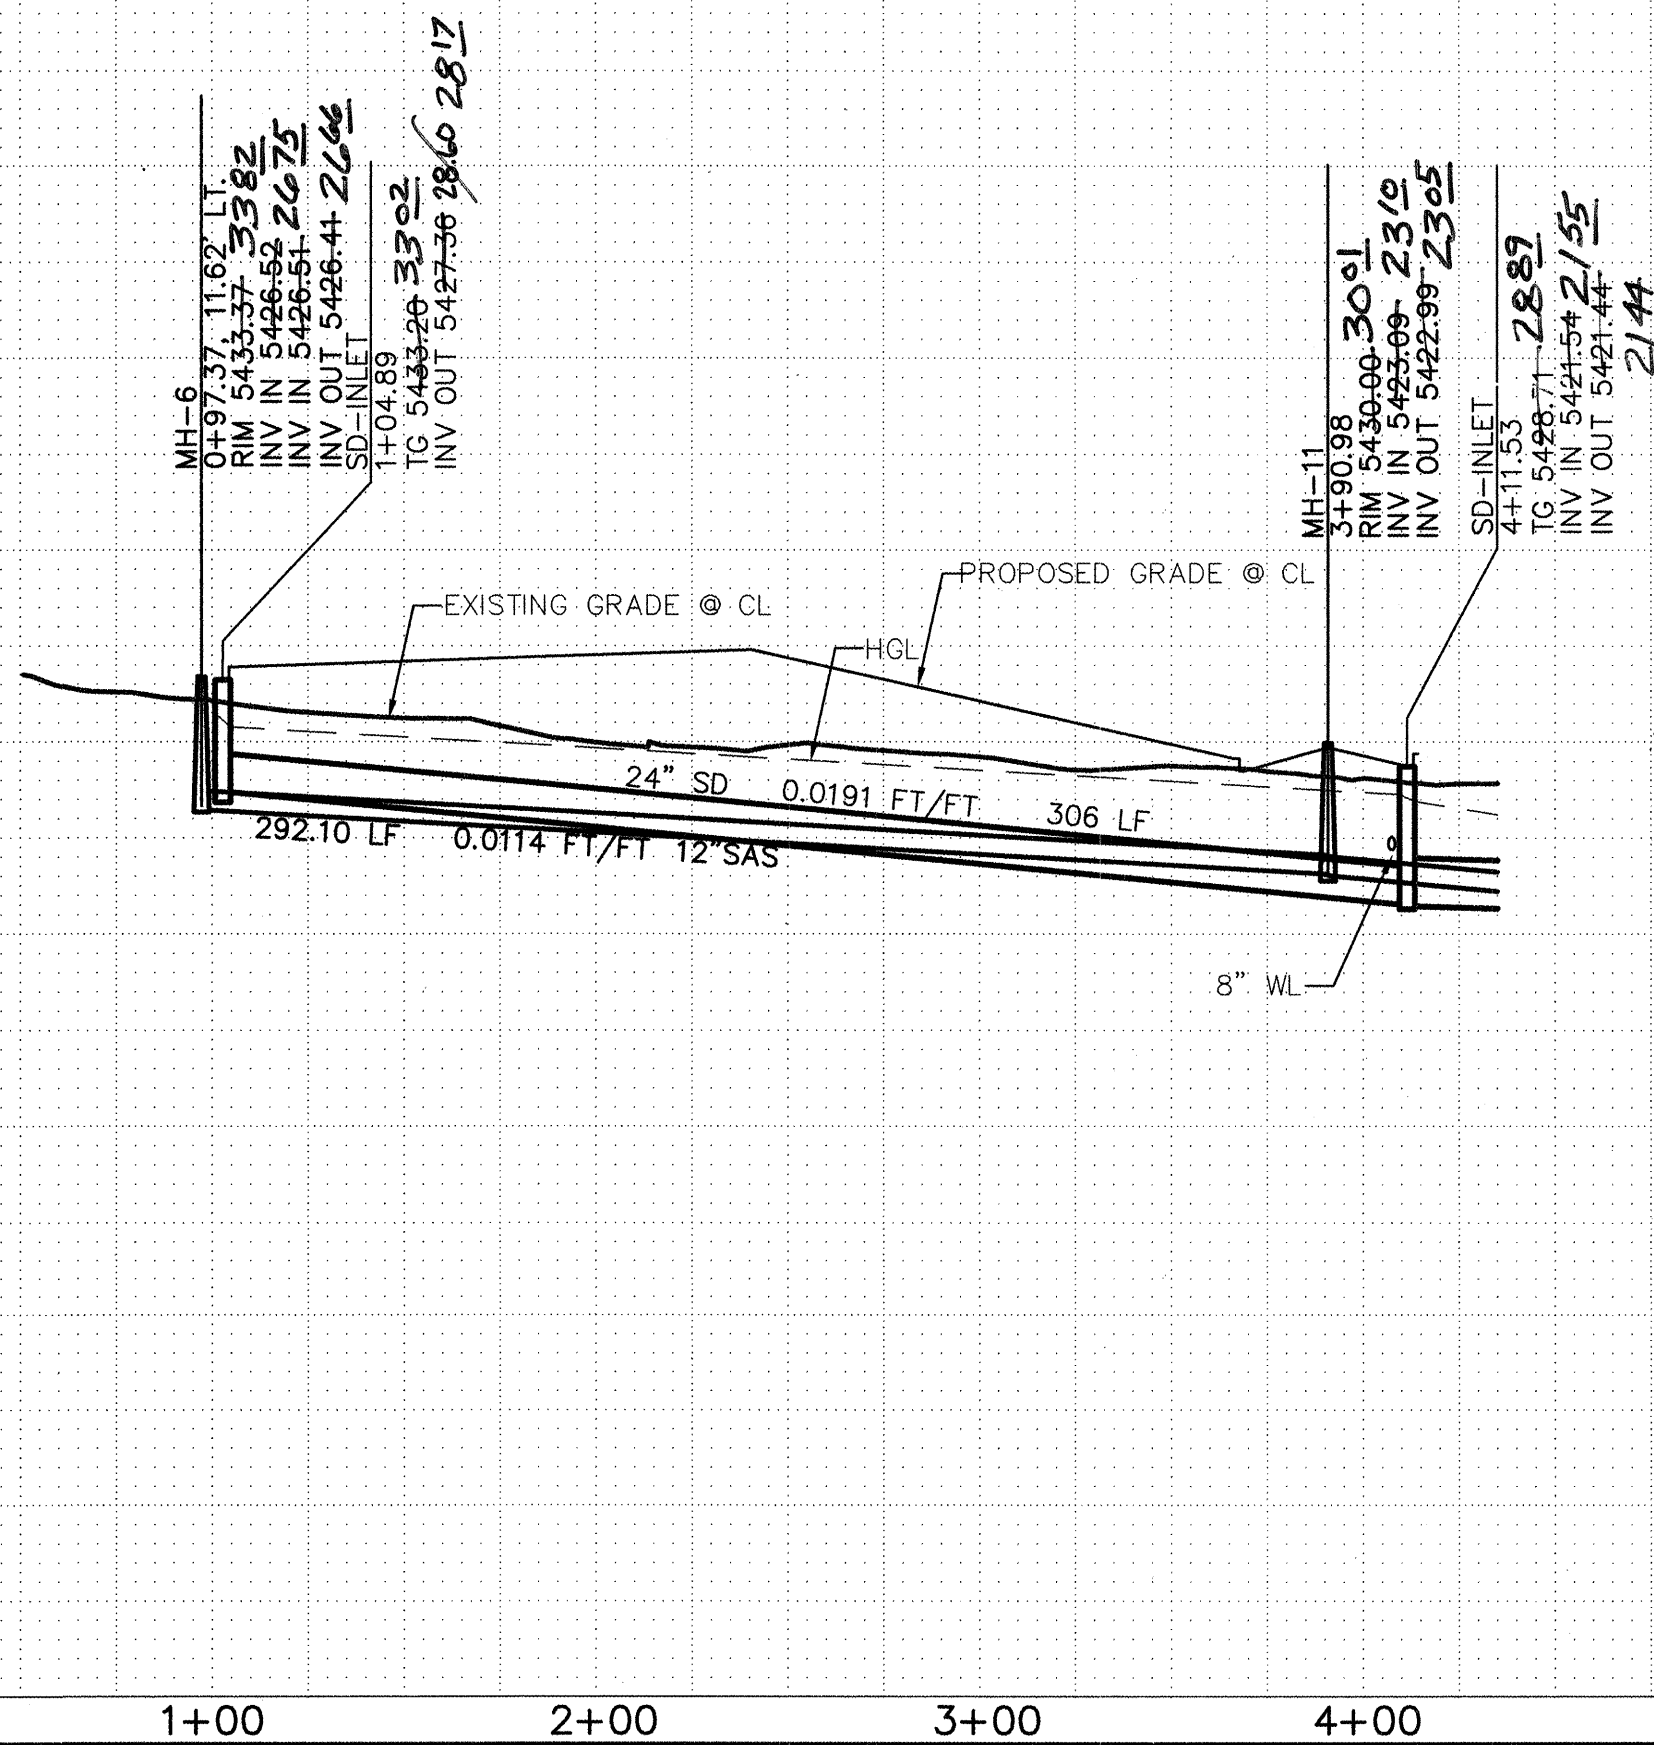


SURVEYORS CERTIFICATION

I, Russ P. Hugg, New Mexico Professional Surveyor Number 9750, hereby certify that the as-built information shown hereon is the result of an actual field survey performed by me or under my direct supervision and that the same is true and correct to the best of my knowledge and belief;

Russ P. Hugg
NMPS No. 9750

4.17, 2007

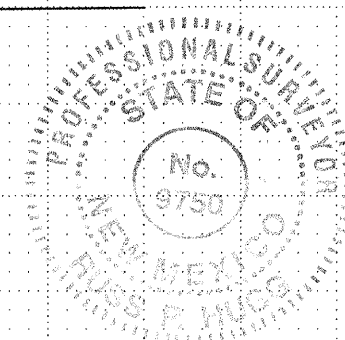

STORM DRAIN CONSTRUCTION NOTES	
I.D.#	DESCRIPTION
4	INSTALL 24" STORM DRAIN PIPE
6	INSTALL 30" STORM DRAIN PIPE
21	INSTALL TYPE A CATCH BASIN SINGLE GRATE AND DOUBLE THROAT PER COA STD. DTL. 2201
30	INSTALL 4' DIA. MANHOLE PER COA STD. DTL. 2101

SEWER CONSTRUCTION NOTES	
I.D.#	DESCRIPTION
5	INSTALL 12" SEWER PIPE PER STD. SPEC. SEC. 901
5	INSTALL 4' DIA. MANHOLE PER COA STD. DTL. 2102

AS-BUILT INFORMATION	
CONTRACTOR	SALES
DATE	02/07
INSPECTOR'S	SURV TEK
DATE	04/07
FIELD ENGINEER	SURV TEK
DATE	04/07
VERIFICATION BY	SURV TEK
DATE	04/07
CORRECTED BY	SURV TEK
DATE	04/07
MICRO-FILM INFORMATION	
RECORDED BY	
NO.	


BENCH MARKS	
ACS BRASS TABLET STAMPED "2-B10 1980"	
Geographic Position (NAD 1927)	
N.M. State Plane Coordinates (Central Zone)	
X= 357,543.73 Y= 1,527,976.48	
Ground-to-Grid Factor = 0.99996354	
ΔQ = -00°16'30"	
SLD 1929 Elevation = 5429.35	

SURVEY INFORMATION	
FIELD NOTES	DATE
BY	
NO.	

ENGINEER'S SEAL	
REMARKS	BY
REVISIONS	DATE
WILSON & COMPANY, ENGINEERS & ARCHITECTS	DATE
DESIGNED BY	DEC
DRAWN BY	DEC
CHECKED BY	SJS
	DATE
	FEB 2006
	FEB 2006

INDEX MAP	
1	18
2	17
3	16
4	15
5	14
6	13
7	12
8	11
9	10


CITY OF ALBUQUERQUE	
PUBLIC WORKS DEPARTMENT	
ENGINEERING GROUP	
VALLE VISTA AT THE TRAILS UNIT II	
VALLE PRADO PLACE NW	
STORM DRAIN & SANITARY SEWER PLAN & PROFILE	
Design Review Committee	City Engineer Approval
Mo./Day/Yr.	Mo./Day/Yr.
DESIGN REVIEW COMMITTEE	CITY ENGINEER
City Project No.	Zone Map No.
730086	C-9-Z
Sheet	Of
13	16

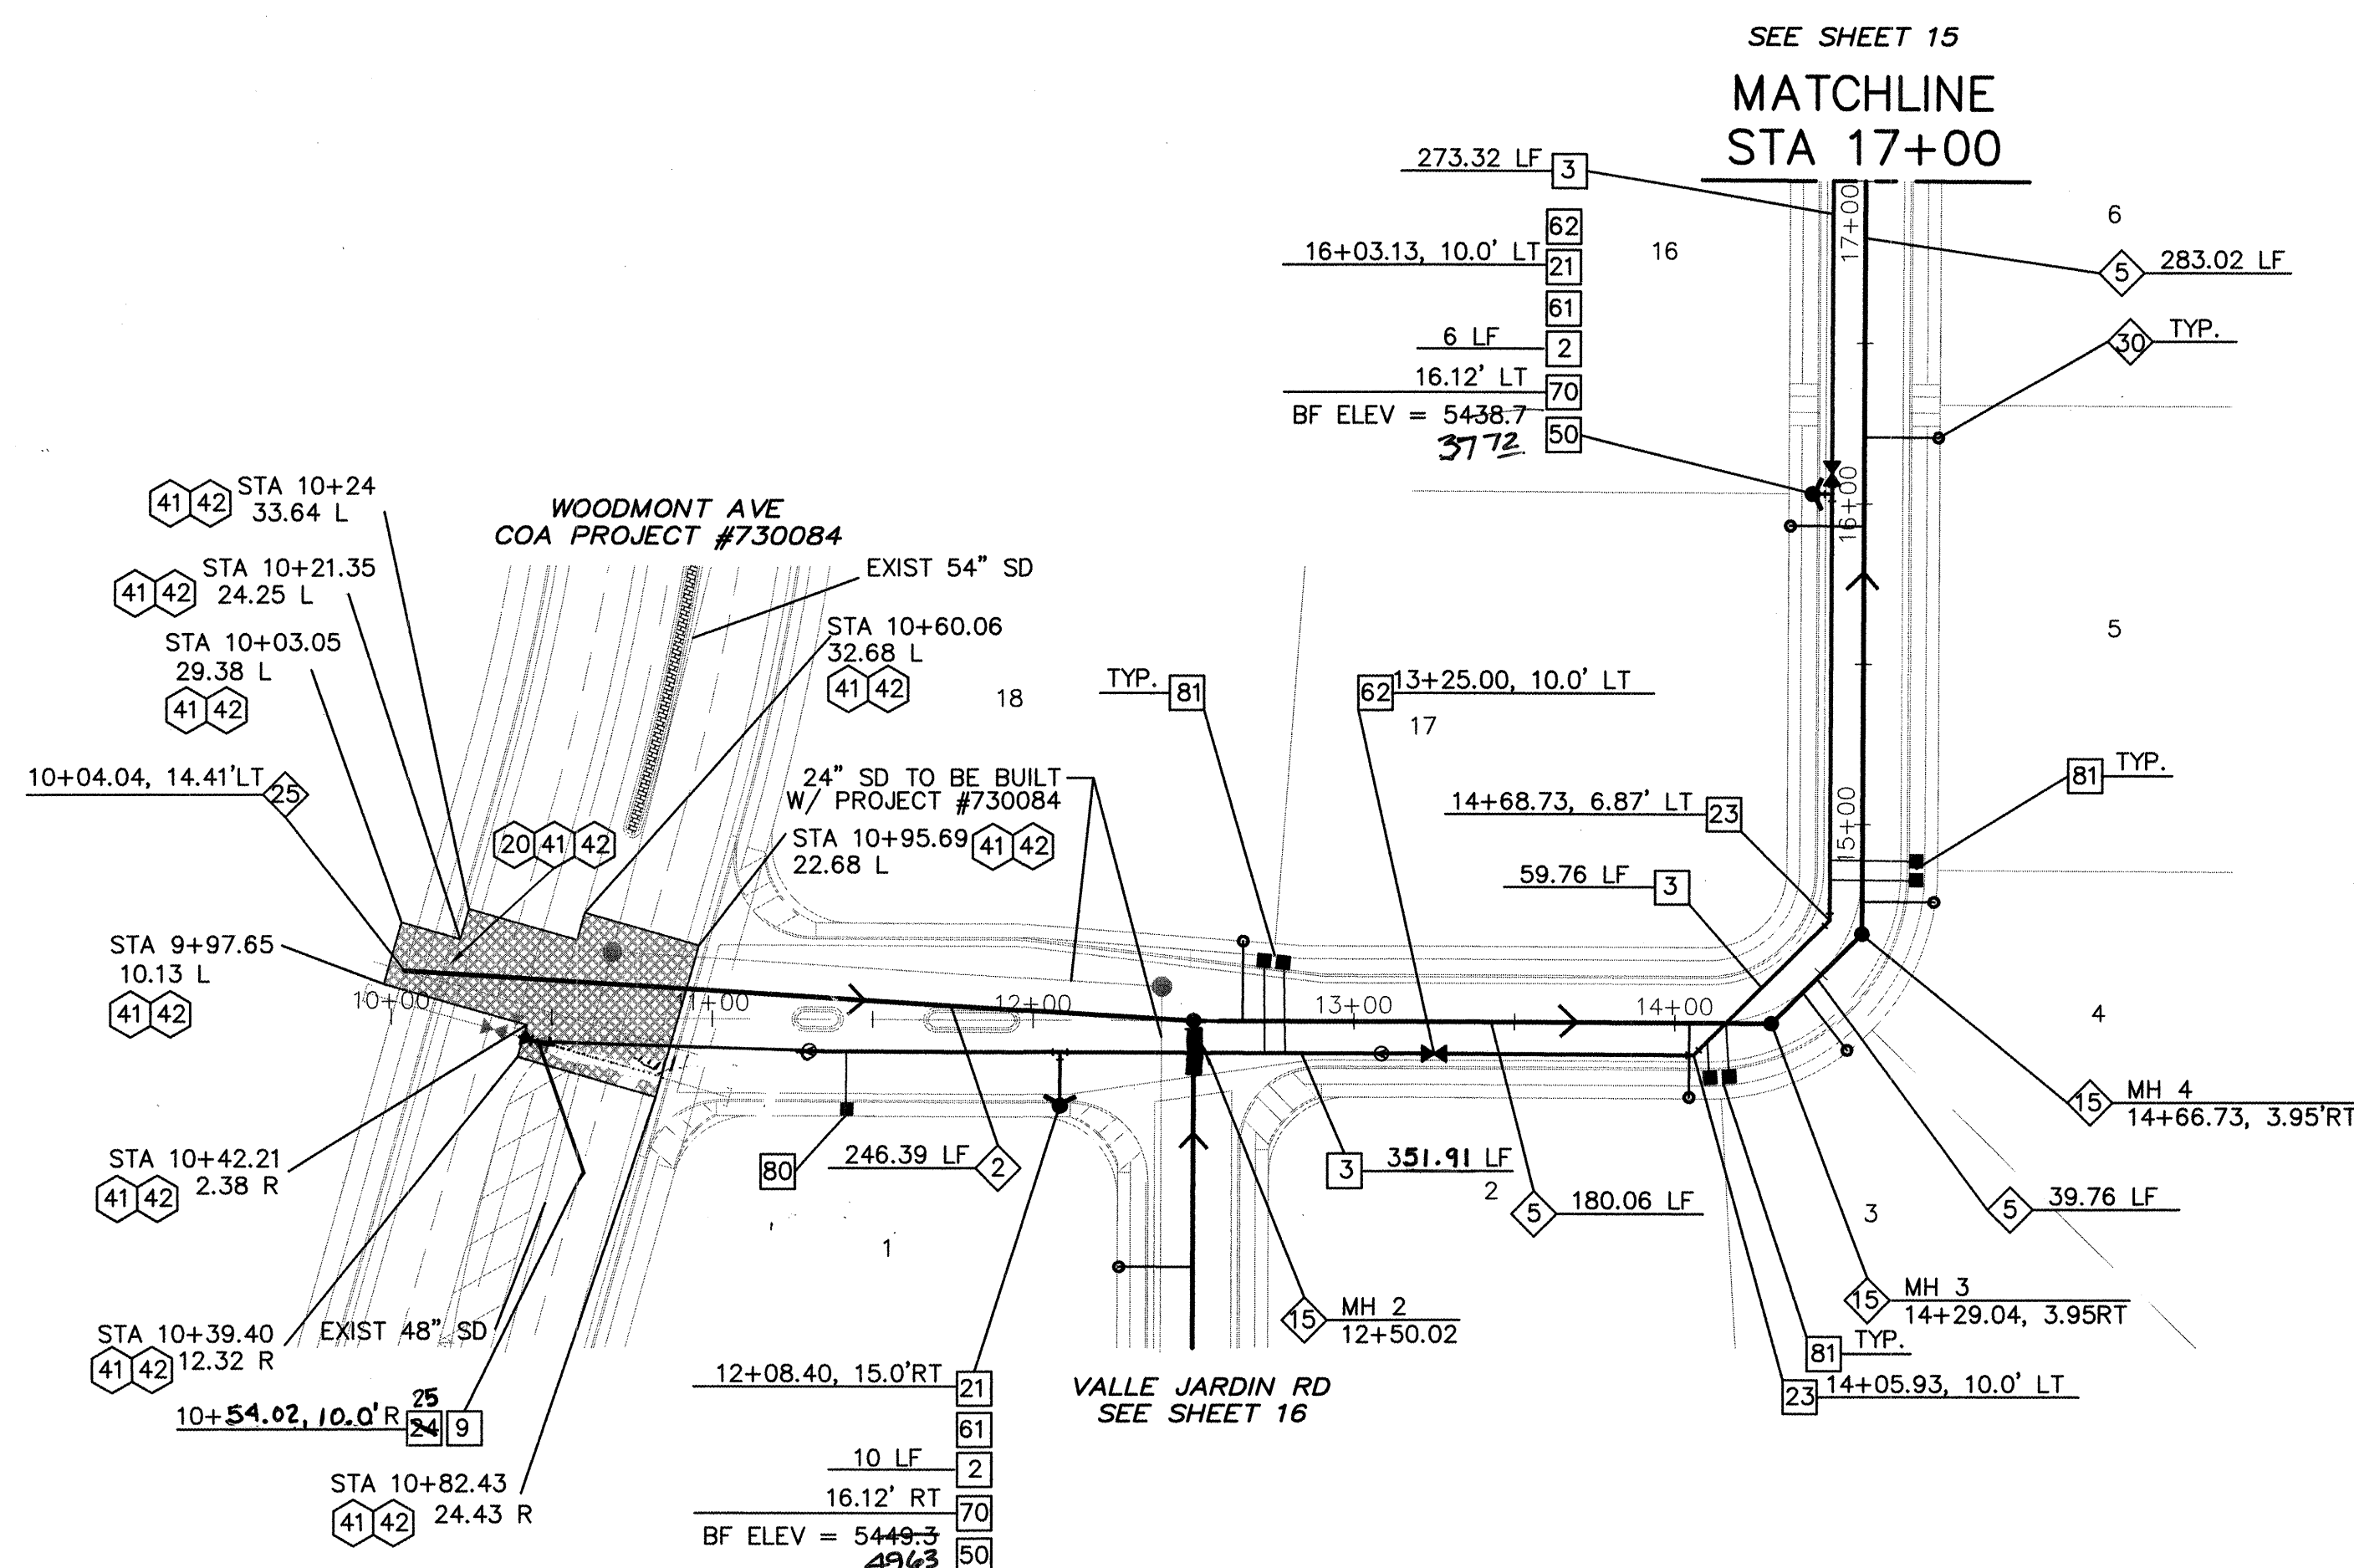

SEWER SERVICE LOCATIONS

<u>LOT</u>	<u>STATION/OFFSET</u>	<u>INV. @ P/L</u>
2	14+04, 23.00R	5439.0
3	14+41, 23.00R	5438.0
4	14+78, 23.00R	5437.0
5	16+20, 23.00R	5433.2
6	17+37, 23.00R	5430.1
18	12+65, 23.00L	5442.8
17	15+93, 23.00L	5434.0
16	17+28, 23.00L	5430.3


SCALE:
HORIZ: 1" = 50'
VERT: 1" = 10'

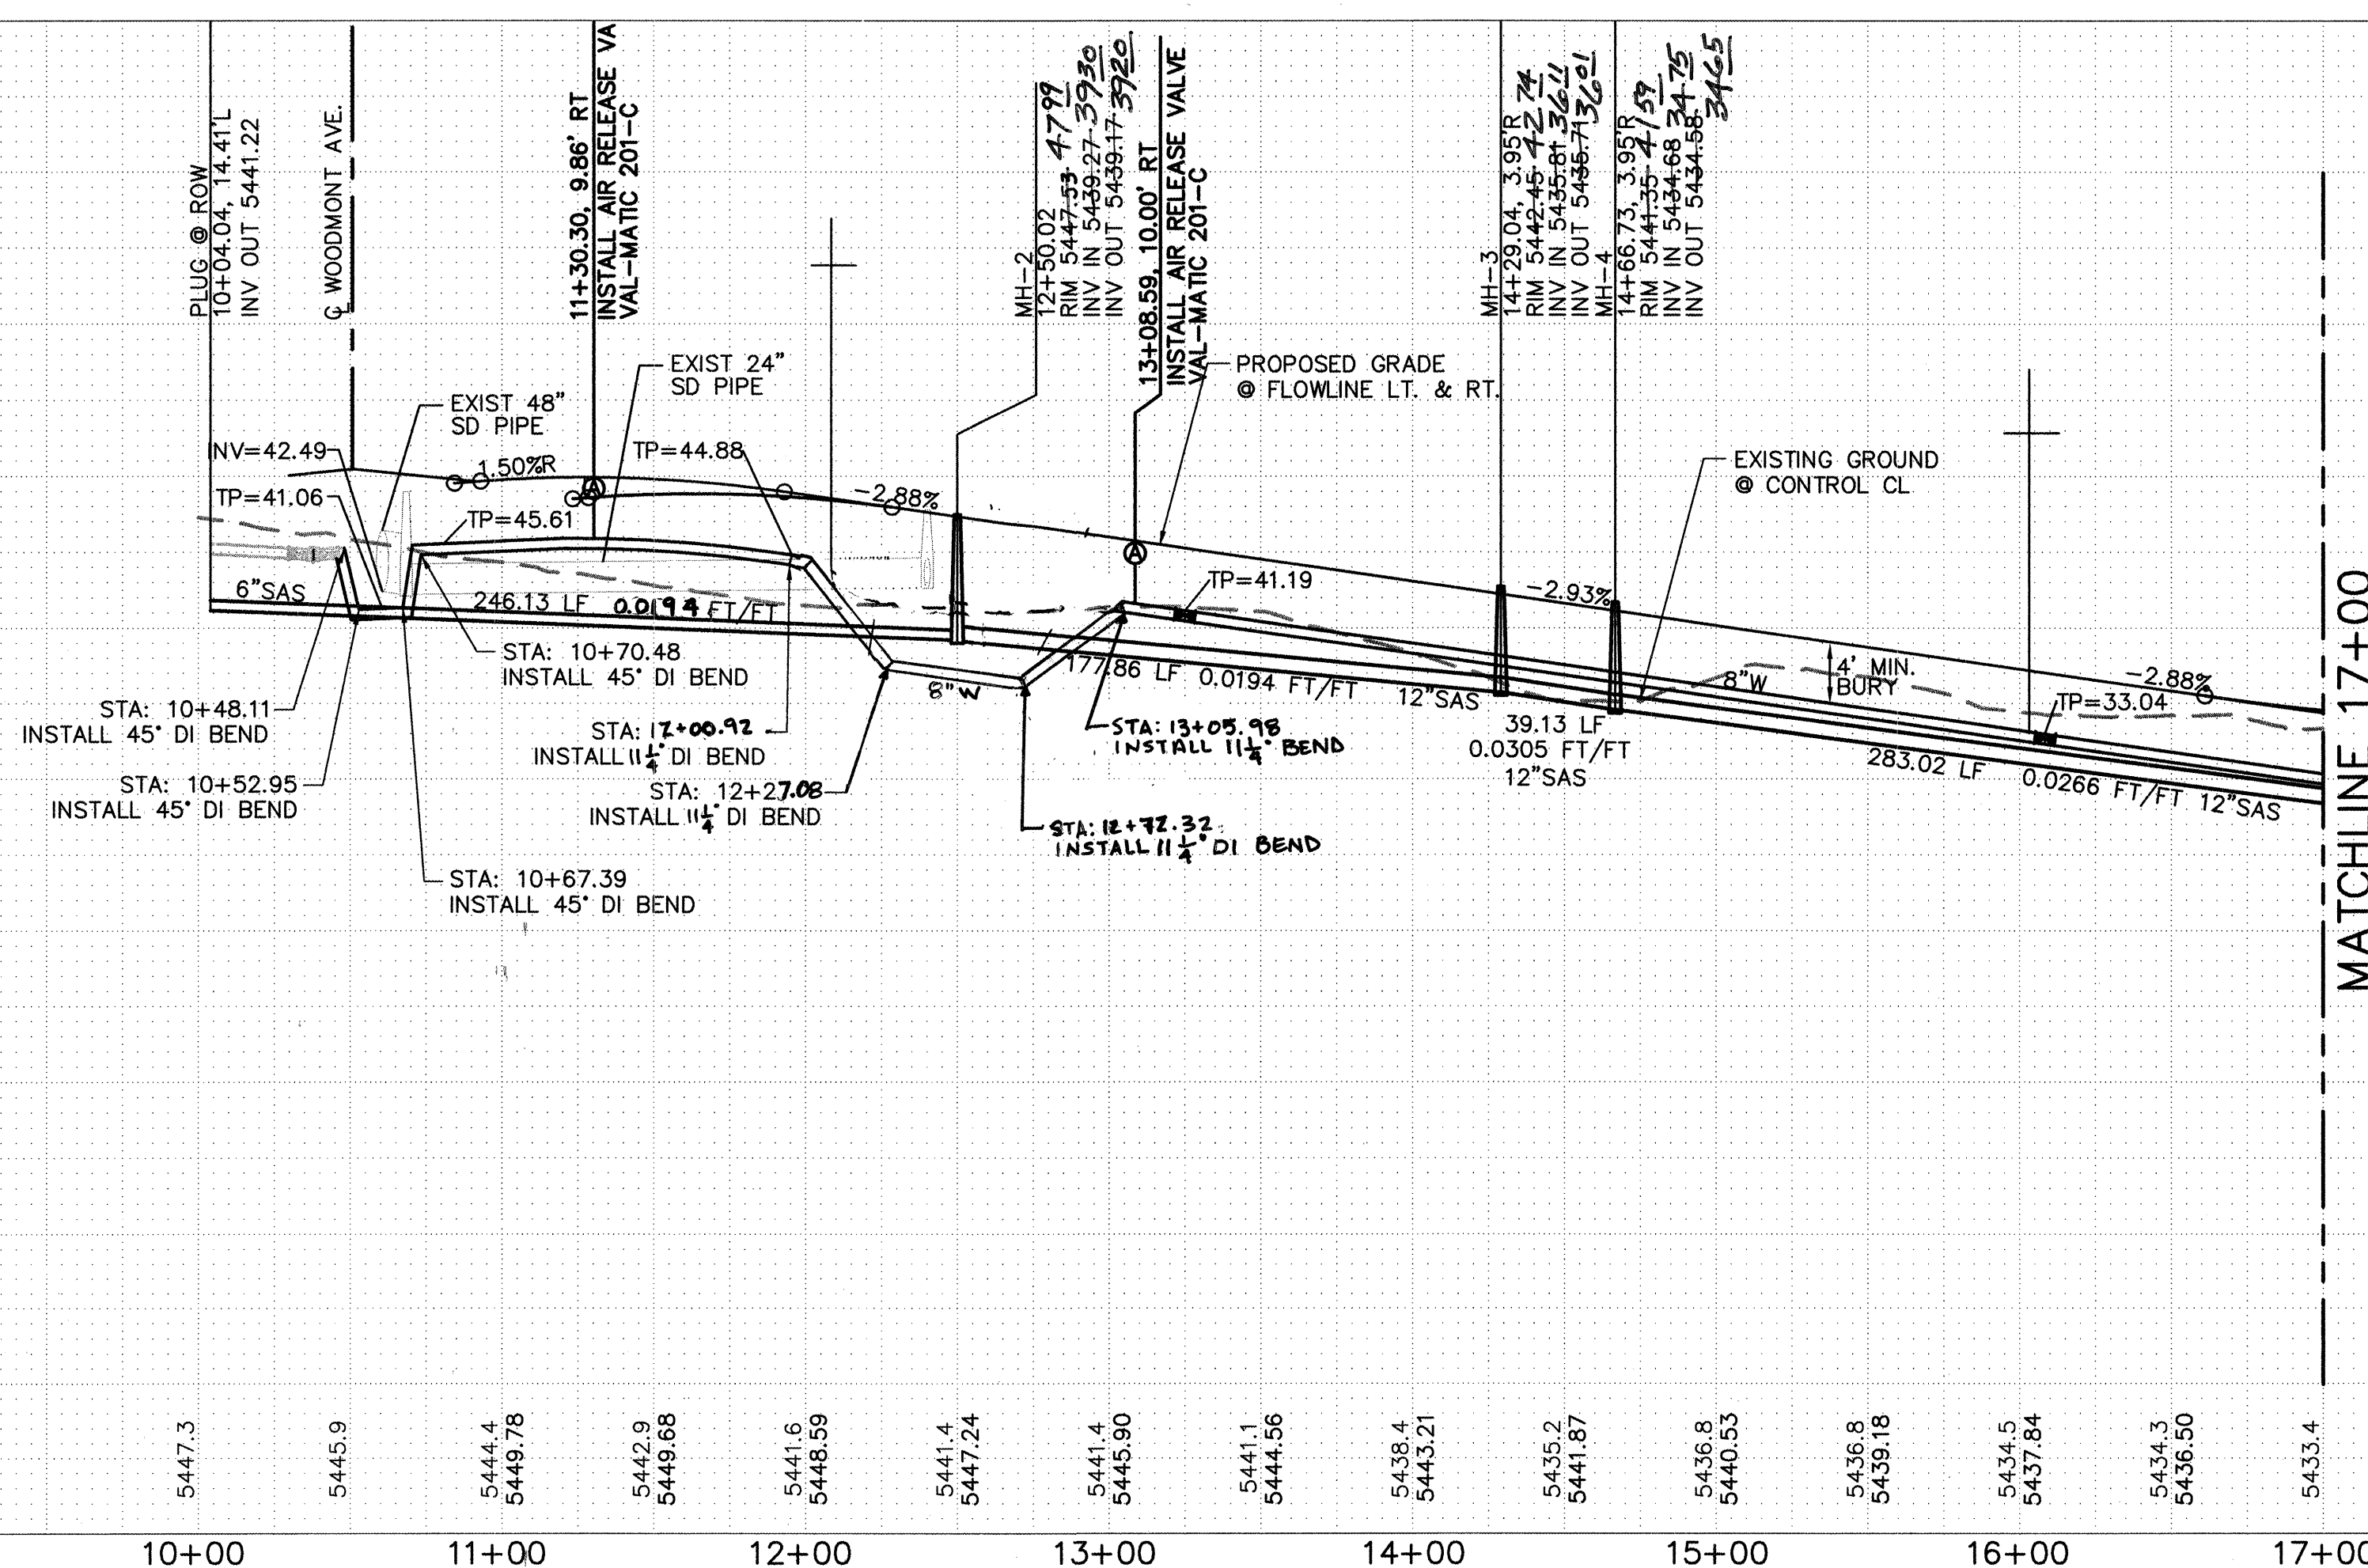

SURVEYORS CERTIFICATION

I, Russ P. Hugg, New Mexico Professional Surveyor Number 9750, hereby certify that the as-built information shown hereon is the result of an actual field survey performed by me or under my direct supervision and that the same is true and correct to the best of my knowledge and belief;

Russ P. Hugg
NMPS No. 9750
4.17, 2007

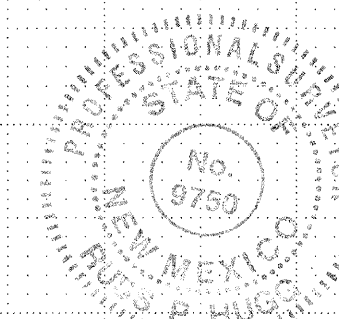

WATER CONSTRUCTION NOTES

I.D.#	DESCRIPTION
2	INSTALL 6" D.I. WATERLINE PER STD. SPEC. SEC. 80
3	INSTALL 8" WATERLINE PER STD. SPEC. SEC. 801
9	CONNECT NEW WATERLINE TO EXISTING WATERLINE
21	INSTALL 8" x 6" TEE
23	INSTALL 8" 45° BEND
24	INSTALL 8" 22 1/2" BEND
25	INSTALL 8" 11 1/4" BEND
50	"MEG A LUG" ALL FITTINGS AND JOINTS FROM TEE TO FIRE HYDRANT
61	INSTALL 6" GATE VALVE AND VALVE BOX PER COA STD. DTLS. 2326 & 2328
62	INSTALL 8" GATE VALVE AND VALVE BOX PER COA STD. DTLS. 2326 & 2328
70	INSTALL FIRE HYDRANT
80	INSTALL 3/4" SINGLE WATER SERVICE
81	INSTALL 3/4" DOUBLE WATER SERVICE

NOTE:


WATER SERVICES SHALL BE INSTALLED
@ PL AS SHOWN HEREIN.

SEWER CONSTRUCTION NOTES

I.D.#	DESCRIPTION
2	INSTALL 6" SEWER PIPE PER STD. SPEC. SEC. 901
5	INSTALL 12" SEWER PIPE PER STD. SPEC. SEC. 901
19	INSTALL 4' DIA. MANHOLE PER COA STD. DTL. 2102
23	INSTALL PLUG AND DEAD END MARKER PER COA STD. DTL. 2145
30	INSTALL 4" SEWER SERVICE

PAVING CONSTRUCTION NOTES

I.D.#	DESCRIPTION
20	BUILD PCC STD. CURB AND GUTTER, PER COA STD. DWG. 2415A
41	SAWCUT & REMOVE EXISTING CURB & GUTTER MATCH EXISTING ASPHALT
42	SAWCUT & REMOVE EXISTING ASPHALT & REPAIR PER COA STD DWG 2465

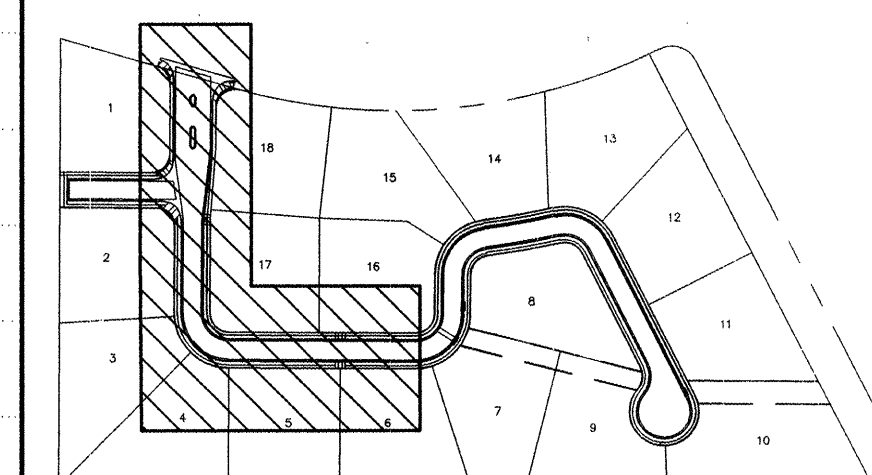

INDEX MAP

APPROVED FOR CONSTRUCTION

NEW MEXICO UTILITIES INC. 7.25.05
DATE

WILSON
 & COMPANY

2600 THE AMERICAN ROAD S
SUITE 100
RIO RANCHO, NEW MEXICO
87124
(505) 898-8021

CITY OF ALBUQUERQUE
PUBLIC WORKS DEPARTMENT
ENGINEERING GROUP

VALLE VISTA AT THE TRAILS UNIT II
VALLE PRADO PLACE NW
WATER, SEWER, & STORM DRAIN PLAN & PROFILE

		Fast Design Update
		

City Project No.	730086	Zone Map No.	C-9-Z
------------------	--------	--------------	-------

REVISIONS		ENGINEER'S SEAL		SURVEY INFORMATION		BENCH MARKS		AS-BUILT INFORMATION	
NO.	DATE	REMARKS	BY	FIELD NOTES		ACS BRASS TABLET STAMPED "2-B10 1980"		CONTRACTOR	
				NO.	BY	DATE		WORK STAINED BY	DATE
							Geographic Position (NAD 1927)	WORK STAINED BY	DATE
							N.M. State Plane Coordinates (Central Zone)	ACCEPTANCE BY	DATE
							X = 357,543.73 Y = 1,527,976.48	FIELD MEASUREMENT BY	DATE
							Ground-to-Grid Factor = 0.999968354	CORRECTED BY	DATE
							$\Delta\alpha = -00^{\circ}16'30"$	REMARKS	DATE
							SLD 1929 Elevation = 5429.35	MICRO-FILM INFORMATION	DATE
								RECORDED BY	DATE
								NO.	

WILSON & COMPANY, ENGINEERS & ARCHITECTS	
DESIGNED BY	DEC FEB 2006
DRAWN BY	C & E FEB 2006
CHECKED BY	SJS FEB 2006

DATE

Mo./Day/Yr.

DATE


Mo./Day/Yr.

Sheet

14

Of

16

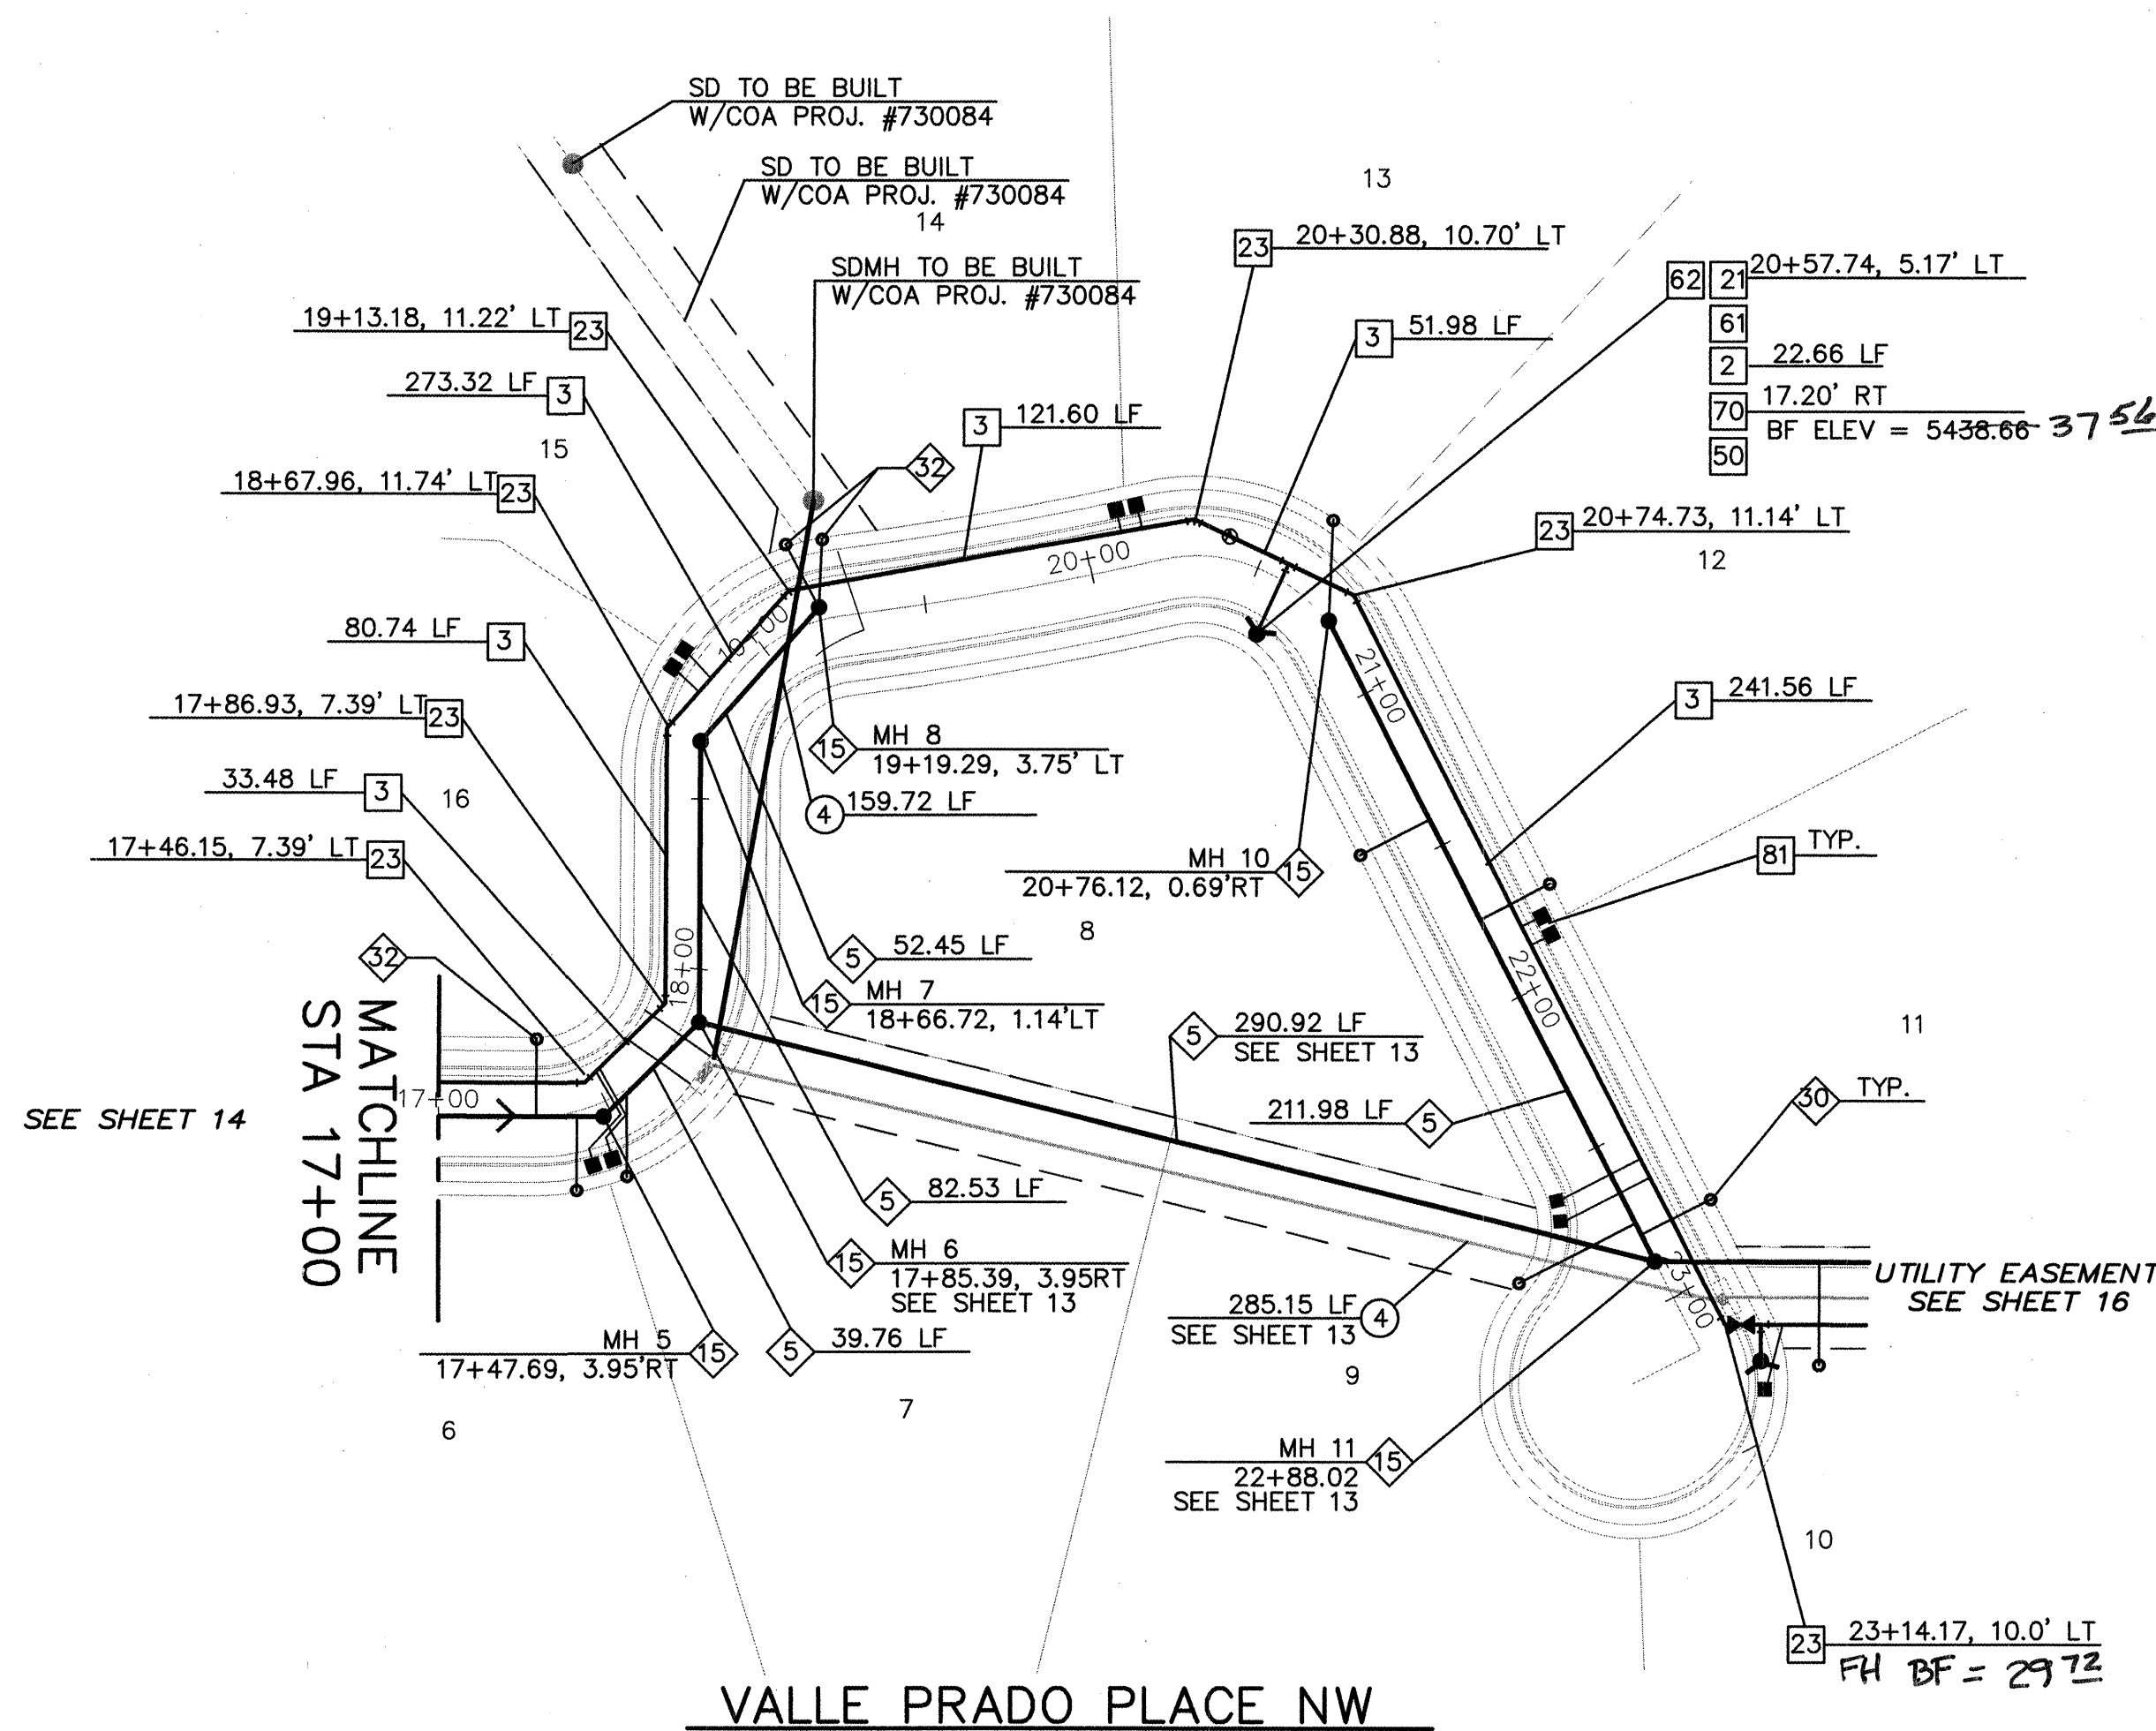

SCALE:
HORIZ: 1" = 50'
VERT: 1" = 10'

WATER CONSTRUCTION NOTES

I.D.#	DESCRIPTION
2	INSTALL 6" D.I. WATERLINE PER STD. SPEC. SEC. 801
3	INSTALL 8" WATERLINE PER STD. SPEC. SEC. 801
9	CONNECT NEW WATERLINE TO EXISTING WATERLINE
21	INSTALL 8" x 6" TEE
23	INSTALL 8" 45° BEND
50	"MEG A LUG" ALL FITTINGS AND JOINTS FROM TEE TO FIRE HYDRANT
61	INSTALL 6" GATE VALVE AND VALVE BOX PER COA STD. DTLS. 2326 & 2328
62	INSTALL 8" GATE VALVE AND VALVE BOX PER COA STD. DTLS. 2326 & 2328
70	INSTALL FIRE HYDRANT
80	INSTALL 3/4" SINGLE WATER SERVICE
81	INSTALL 3/4" DOUBLE WATER SERVICE

SEWER CONSTRUCTION NOTES


I.D.#	DESCRIPTION
2	INSTALL 6" SEWER PIPE PER STD. SPEC. SEC. 901
5	INSTALL 12" SEWER PIPE PER STD. SPEC. SEC. 901
15	INSTALL 4" DIA. MANHOLE PER COA STD. DTL. 2102
30	INSTALL 4" SEWER SERVICE
32	INSTALL 4" C-900 SEWER SERVICE (PRESSURE RATED) AND TRANSITION COUPLING

STORM DRAIN CONSTRUCTION NOTES

I.D.#	DESCRIPTION
4	INSTALL 24" STORM DRAIN PIPE

SEWER SERVICE LOCATIONS

LOT	STATION/OFFSET	INV. @ P/L
7	17+76, 23.00R	5429.1
8	21+41, 23.00R	5430.6
9	27+75, 23.00R	5429.4
11	22+79, 23.00L	5429.5
12	21+74, 23.00L	5429.5
13	20+60, 23.00L	5432.9
14	19+23, 23.00L	5432.9
15	19+16, 23.00L	5430.7

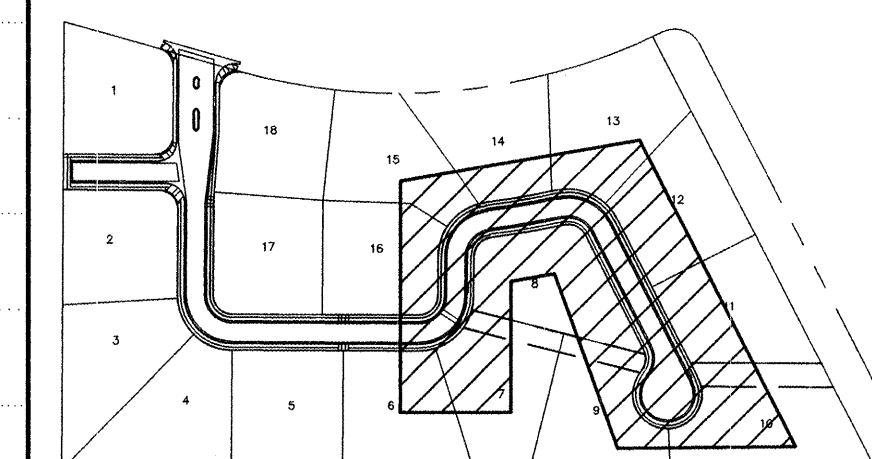

INDEX MAP

APPROVED FOR CONSTRUCTION




WILSON & COMPANY
2600 THE AMERICAN ROAD S.E.
SUITE 100
RIO RANCHO, NEW MEXICO
87124
(505) 898-8021

CITY OF ALBUQUERQUE
PUBLIC WORKS DEPARTMENT
ENGINEERING GROUP

VALLE VISTA AT THE TRAILS UNIT II
VALLE PRADO PLACE NW
WATER & SEWER, PLAN & PROFILE

Design Review Committee
City Engineer Approval
Last Design Update


City Project No. 730086
Zone Map No. C-9-Z
Sheet 15 of 16

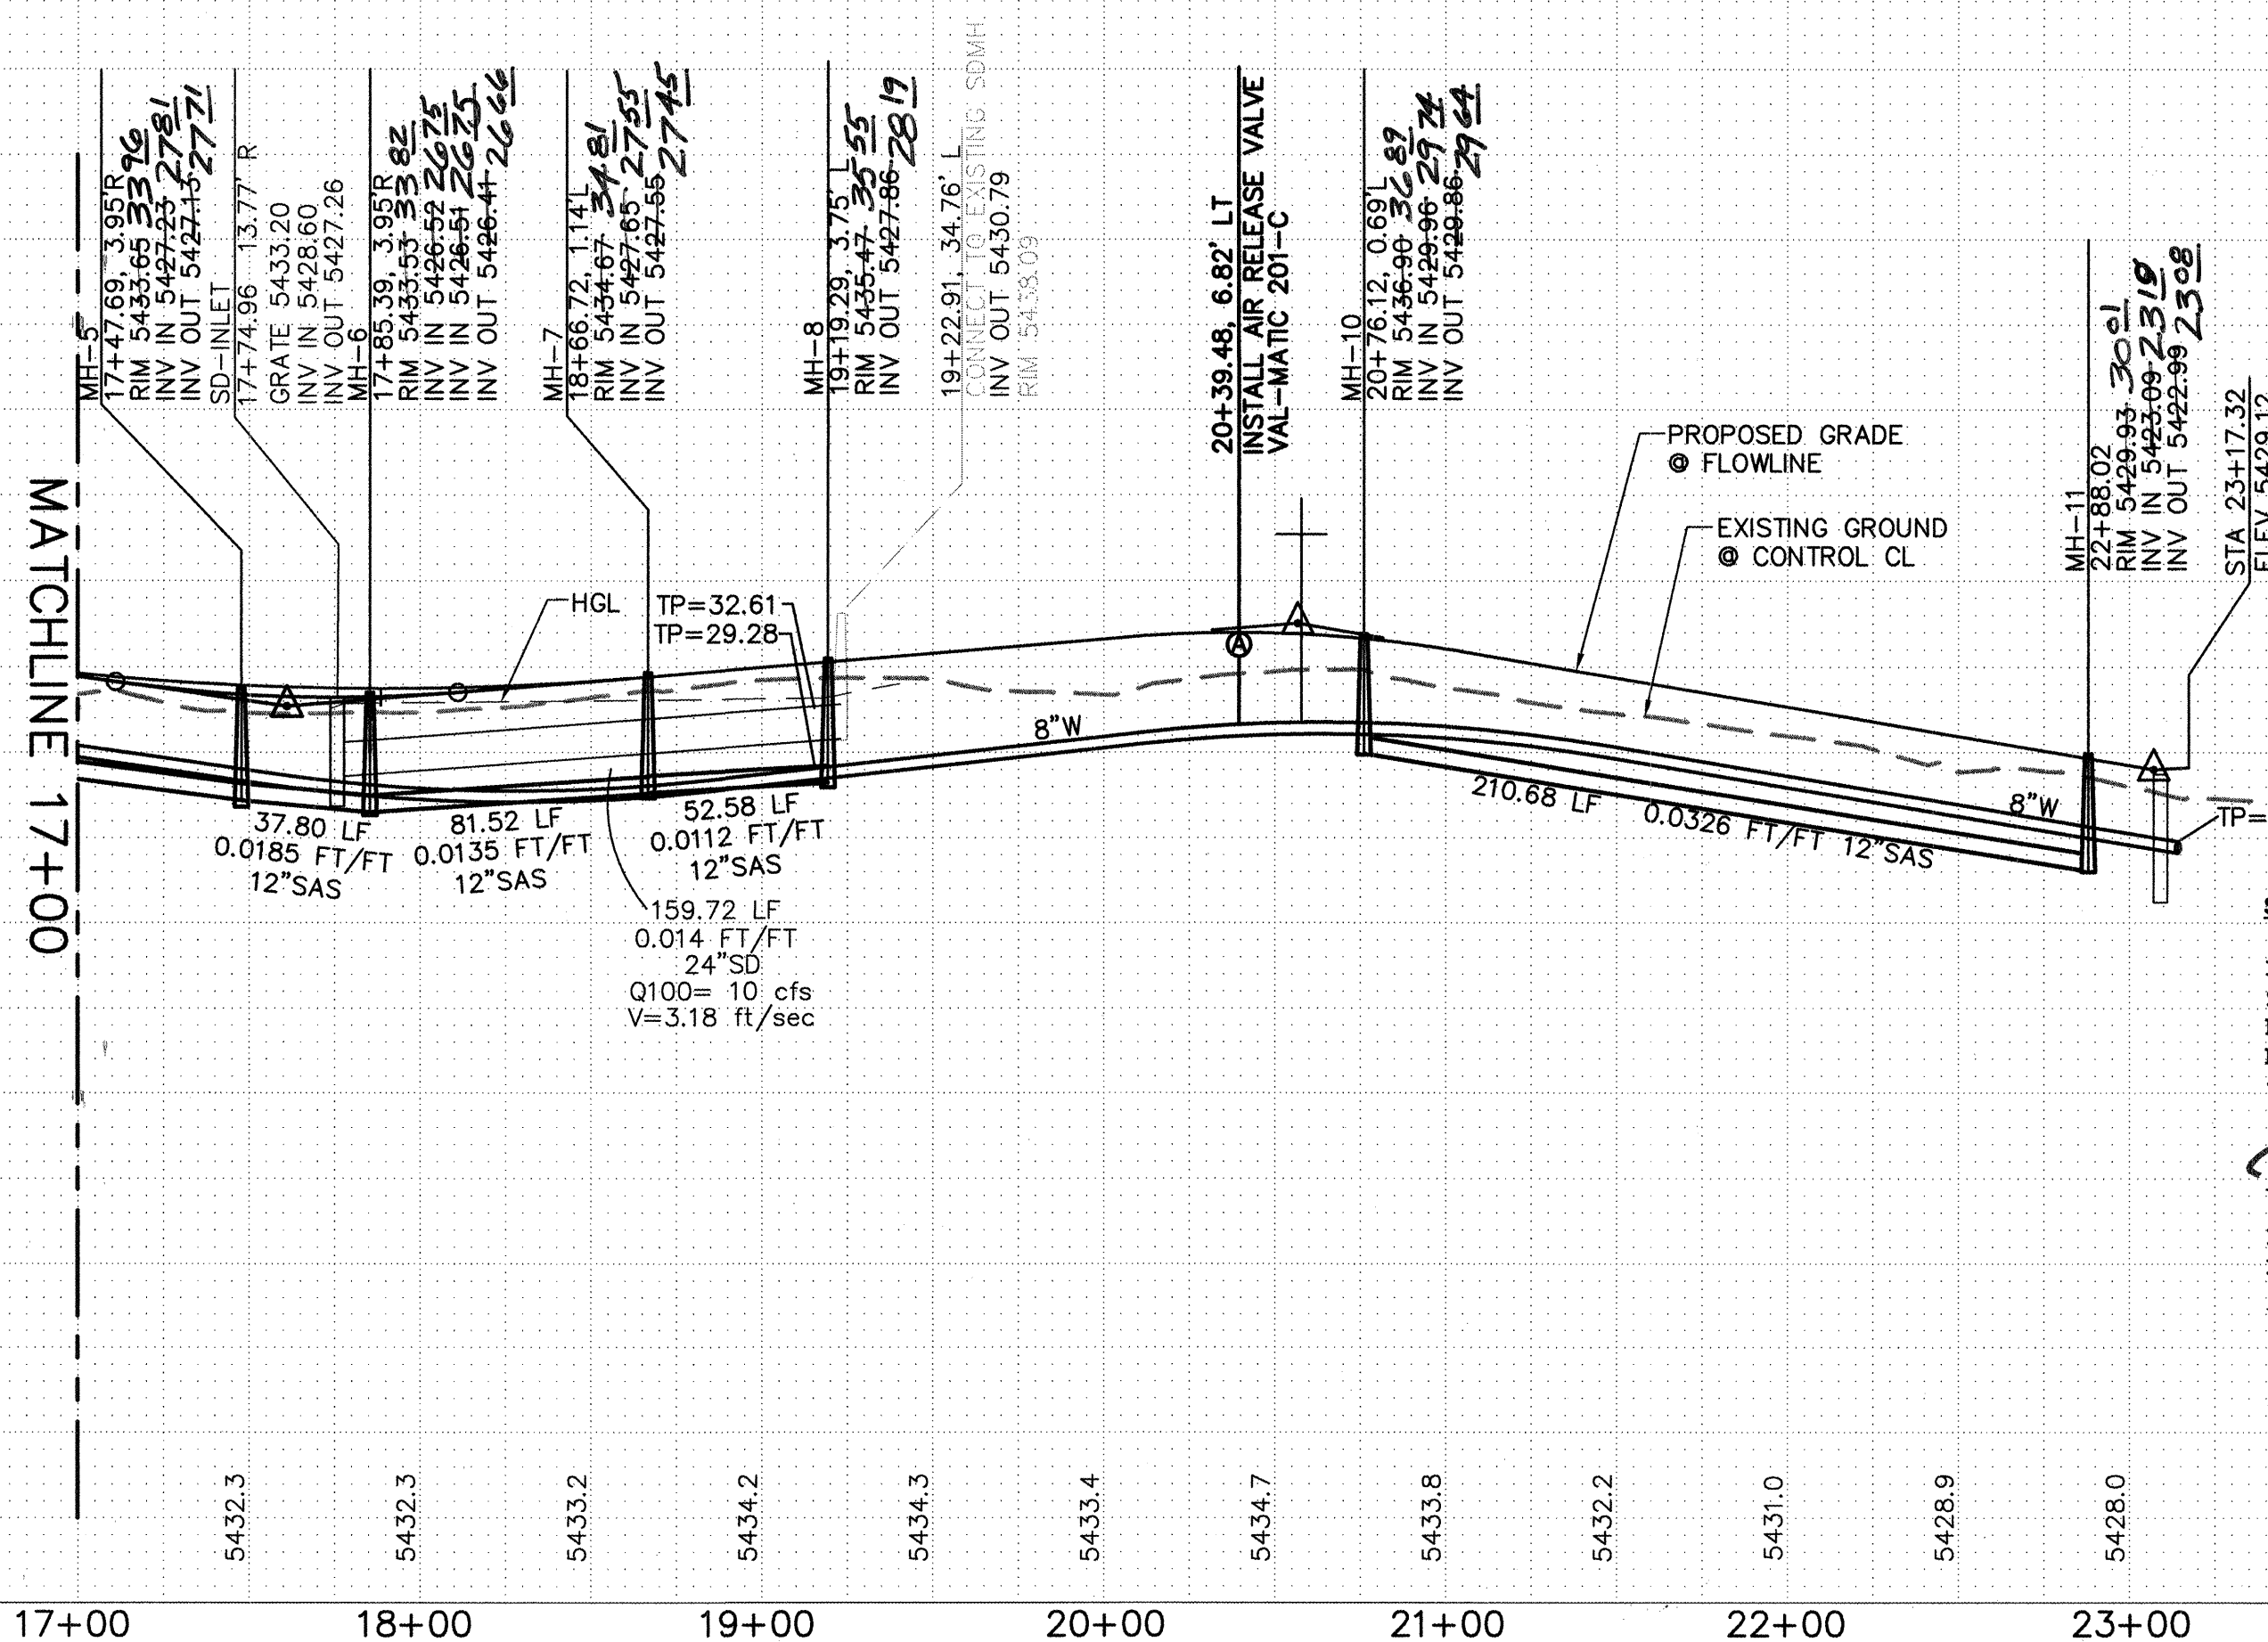


SURVEYORS CERTIFICATION


I, Russ P. Hugg, New Mexico Professional Surveyor Number 9750, hereby certify that the as-built information shown hereon is the result of an actual field survey performed by me or under my direct supervision and that the same is true and correct to the best of my knowledge and belief;

Russ P. Hugg
NMPs No. 9750
4-17, 2007

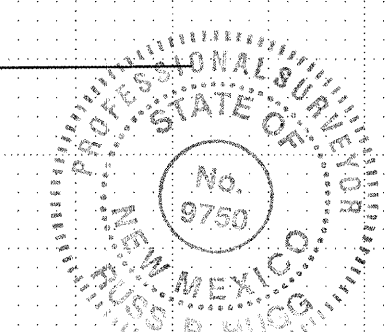

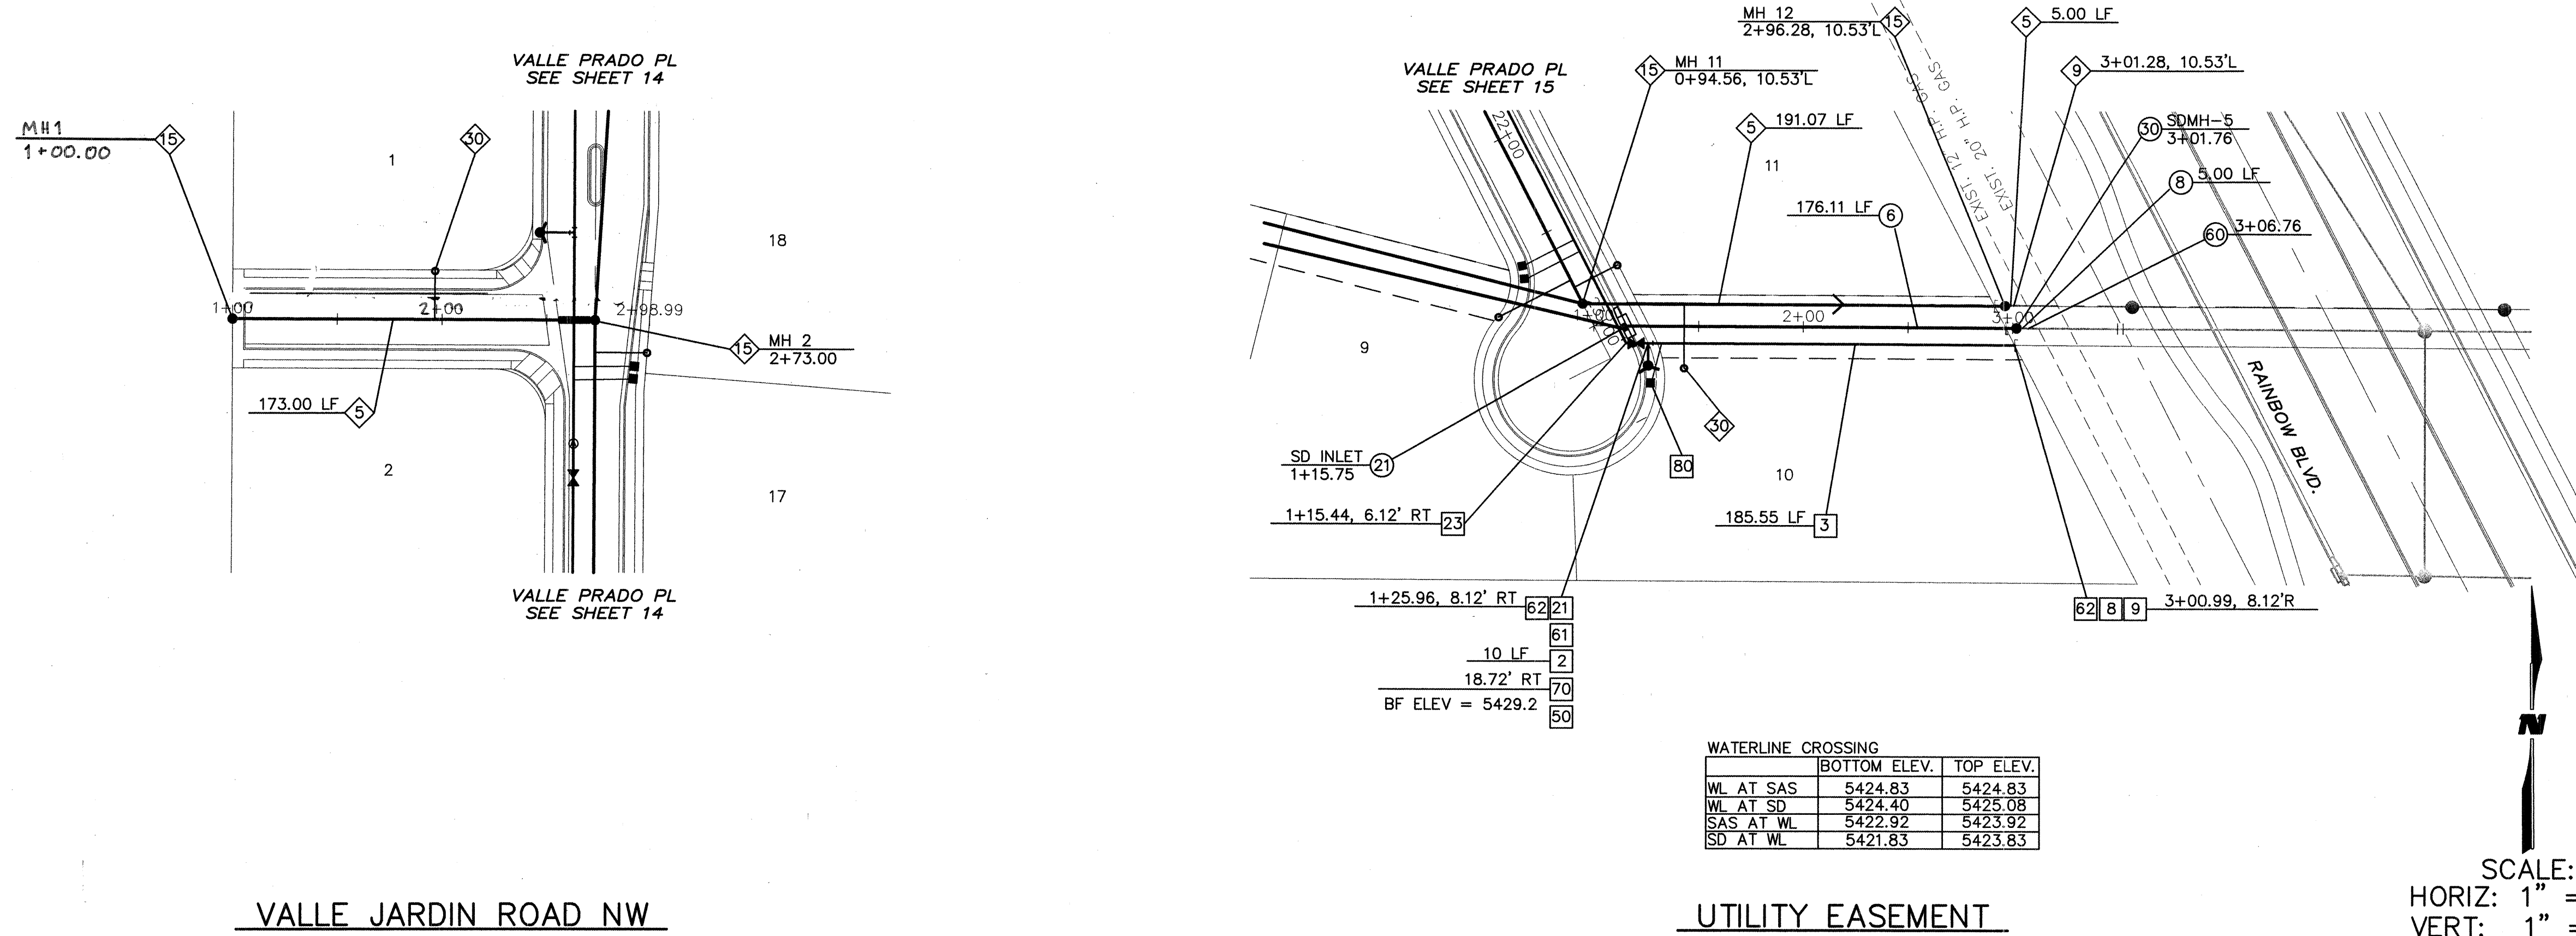



WATERLINE CROSSING		
	BOTTOM ELEV.	TOP ELEV.
WL AT SAS	5424.83	5424.83
WL AT SD	5424.40	5425.08
SAS AT WL	5422.92	5423.92
SD AT WL	5421.83	5423.83

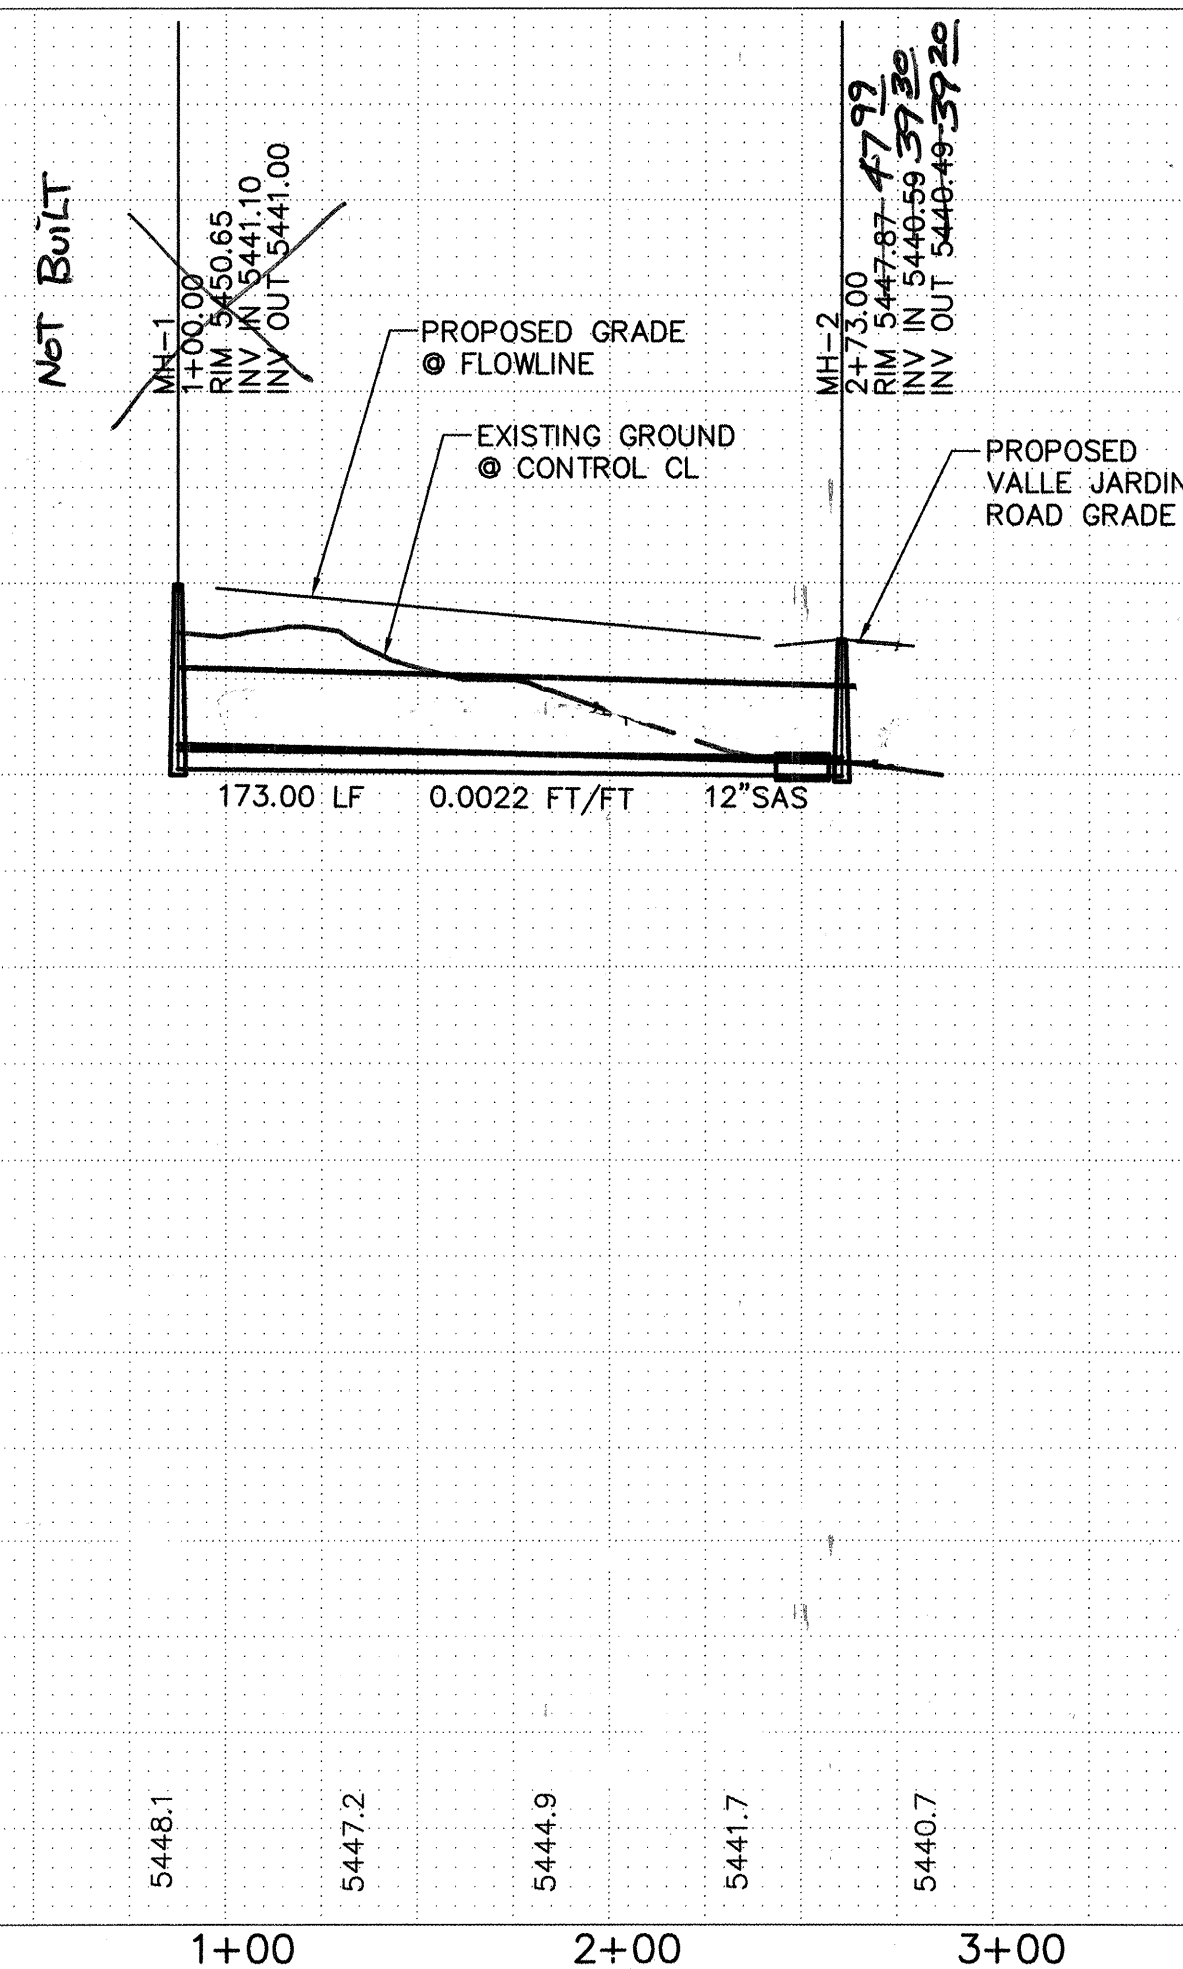

SURVEYORS CERTIFICATION

I, Russ P. Hugg, New Mexico Professional Surveyor Number 9750, hereby certify that the as-built information shown hereon is the result of an actual field survey performed by me or under my direct supervision and that the same is true and correct to the best of my knowledge and belief;

Russ P. Hugg
NMPS No. 9750
4.17, 2007

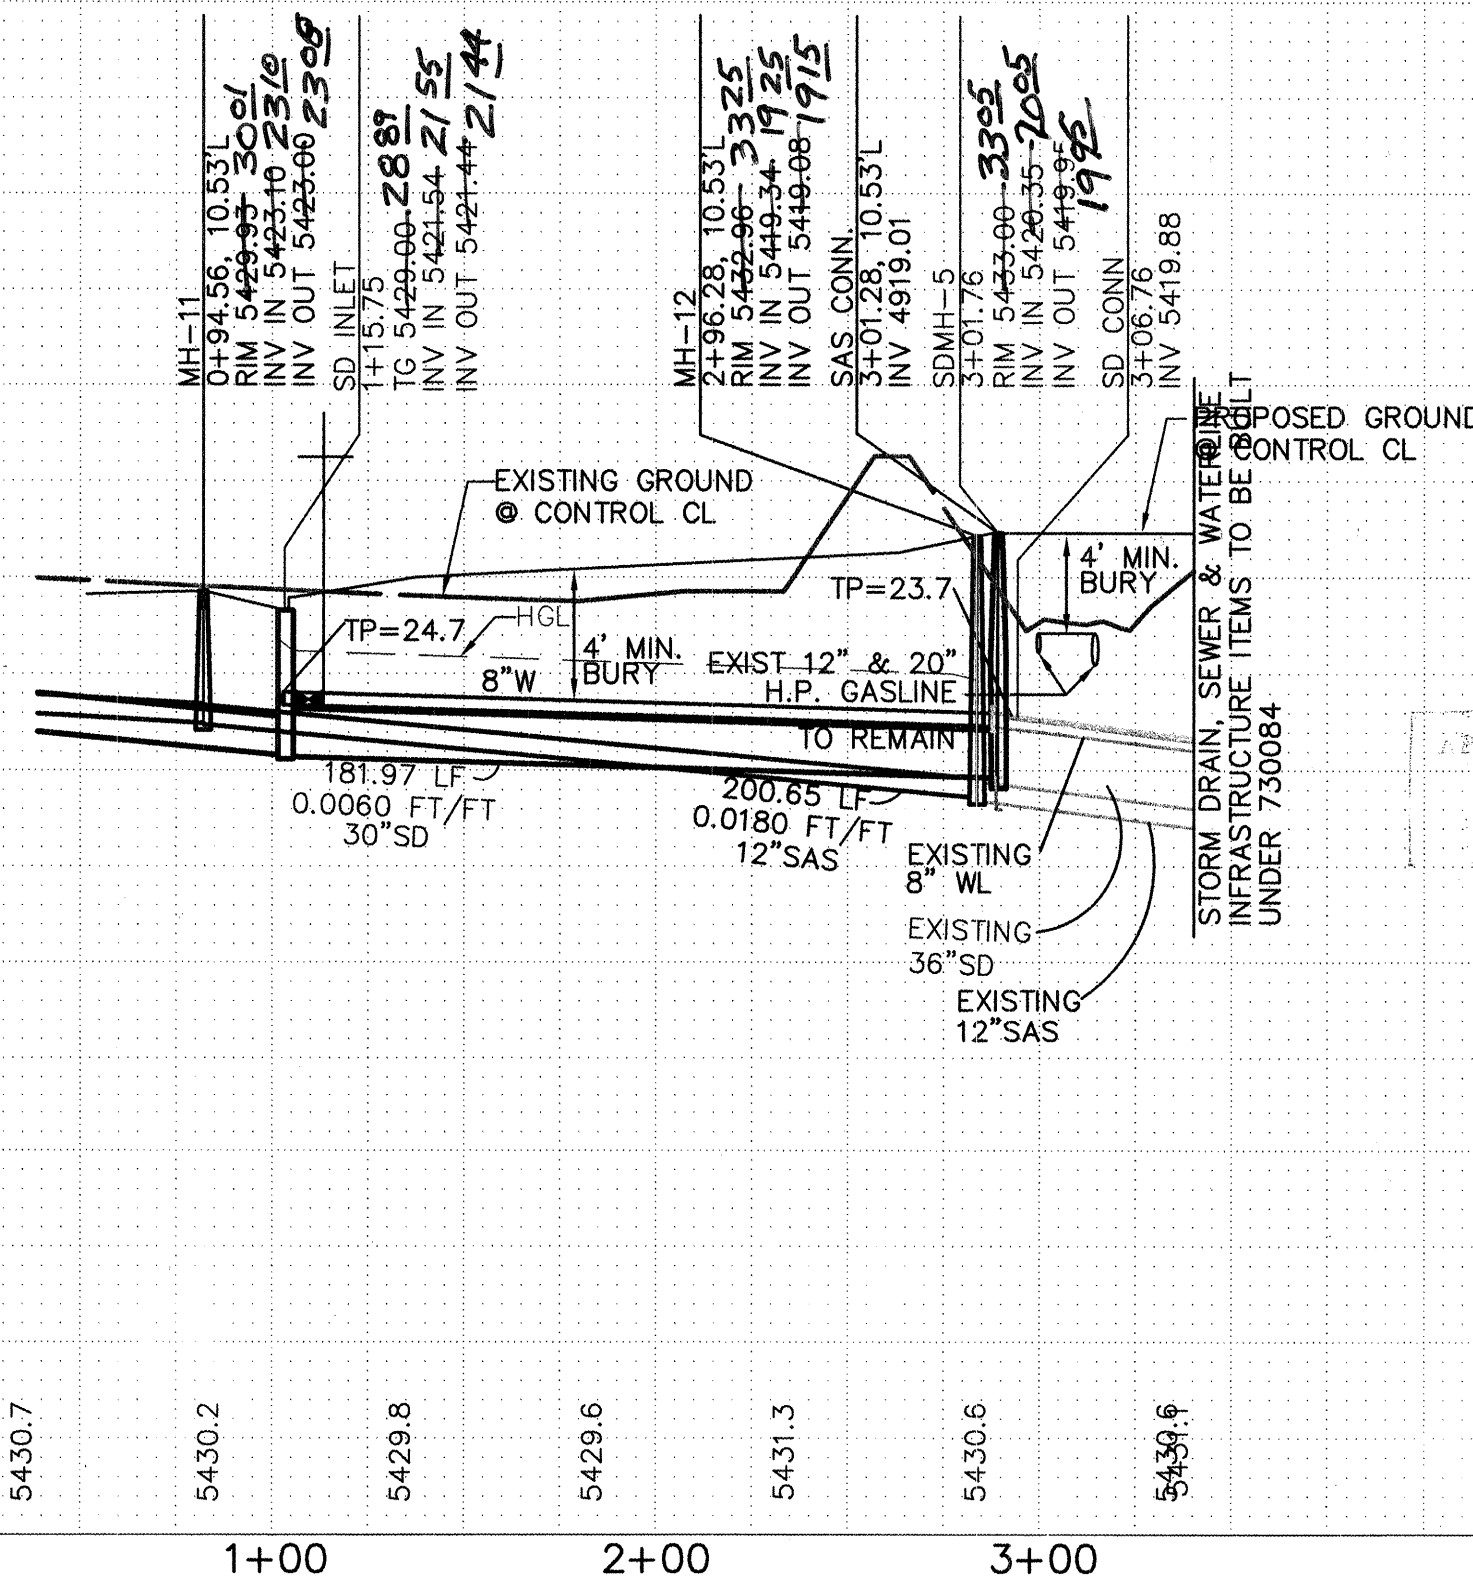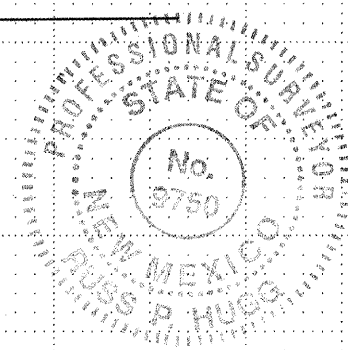


WATER CONSTRUCTION NOTES	
I.D.#	DESCRIPTION
2	INSTALL 6" D.I. WATERLINE PER STD. SPEC. SEC. 801
3	INSTALL 8" WATERLINE PER STD. SPEC. SEC. 801
8	REMOVE EXISTING FITTING
9	CONNECT NEW WATERLINE TO EXISTING WATERLINE
21	INSTALL 8" x 6" TEE
23	INSTALL 8" 45° BEND
50	"MEG A LUG" ALL FITTINGS AND JOINTS FROM TEE TO FIRE HYDRANT
61	INSTALL 6" GATE VALVE AND VALVE BOX PER COA STD. DTLs. 2326 & 2328
62	INSTALL 8" GATE VALVE AND VALVE BOX PER COA STD. DTLs. 2326 & 2328
70	INSTALL FIRE HYDRANT
80	INSTALL 3/4" SINGLE WATER SERVICE

SEWER CONSTRUCTION NOTES	
I.D.#	DESCRIPTION
5	INSTALL 12" SEWER PIPE PER STD. SPEC. SEC. 901
9	REMOVE EXISTING PLUG AND CONNECT NEW SEWER LINE TO EXISTING SEWER LINE
15	INSTALL 4" DIA. MANHOLE PER COA STD. DTL. 2102
30	INSTALL 4" SEWER SERVICE

STORM DRAIN CONSTRUCTION NOTES	
I.D.#	DESCRIPTION
4	INSTALL 24" STORM DRAIN PIPE
6	INSTALL 30" STORM DRAIN PIPE
8	INSTALL 36" STORM DRAIN PIPE
10	INSTALL 48" STORM DRAIN PIPE
21	INSTALL TYPE A CATCH BASIN SINGLE GRATE AND DOUBLE THROAT PER COA STD. DTL. 2201
30	INSTALL 4" DIA. MANHOLE PER COA STD. DTL. 2101
60	REMOVE EXISTING STORM DRAIN PLUG AND CONNECT NEW STORM DRAIN TO EXISTING

SEWER SERVICE LOCATIONS			
LOT	STATION/OFFSET	INV. @ P/L	
1	1+96, 23.00L	5444.7	
10	1+43, 20.00R	5425.5	

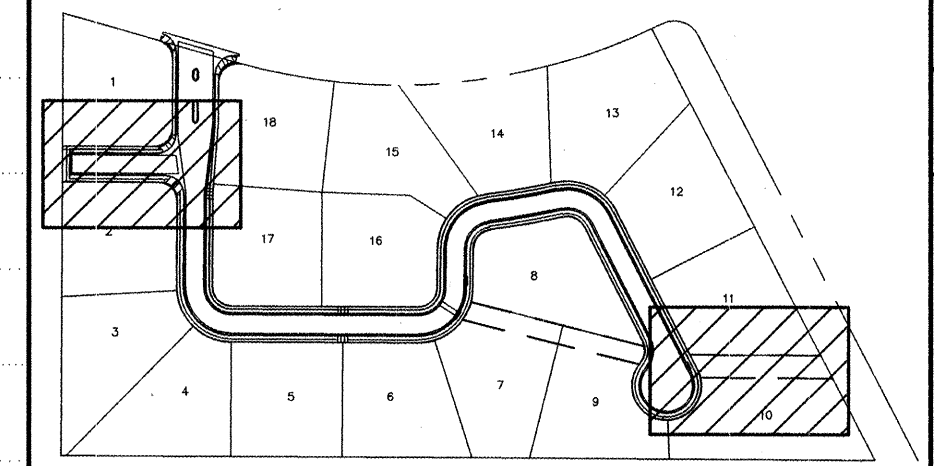

INDEX MAP

APPROVED FOR CONSTRUCTION

NEW MEXICO UTILITIES INC. DATE 4.21.06

WILSON & COMPANY 2600 THE AMERICAN ROAD S.E. SUITE 100 RIO RANCHO, NEW MEXICO 87124 (505) 898-8021

DESIGN REVIEW COMMITTEE		CITY ENGINEER APPROVAL	
DESIGNED BY	DATE	DRAWN BY	CITY ENGINEER
CHECKED BY	DATE		

AS-BUILT INFORMATION		BENCH MARKS		SURVEY INFORMATION		ENGINEER'S SEAL	
CONTRACTOR	DATE	ACS BRASS TABLET STAMPED "2-B10 1980"	DATE	FIELD NOTES	NO.		REVISIONS
WORK	DATE	Geographic Position (NAD 1927)	DATE	BY			
ACCEPTANCE BY	DATE	N.M. State Plane Coordinates (Central Zone)	DATE				
FIELD CHECK BY	DATE	X = 357,543.73 Y = 1,527,976.48	DATE				
DRAWINGS	DATE	Ground-to-Grid Factor = 0.99966354	DATE			NO. DATE	BY
CORRECTED BY	DATE	ΔX = -00'16.30"	DATE			WILSON & COMPANY, ENGINEERS & ARCHITECTS	REVISIONS
RECORDED BY	DATE	SLD 1929 Elevation = 5429.35	DATE			DESIGNED BY	DATE
						DRAWN BY	DATE
						CHECKED BY	DATE