
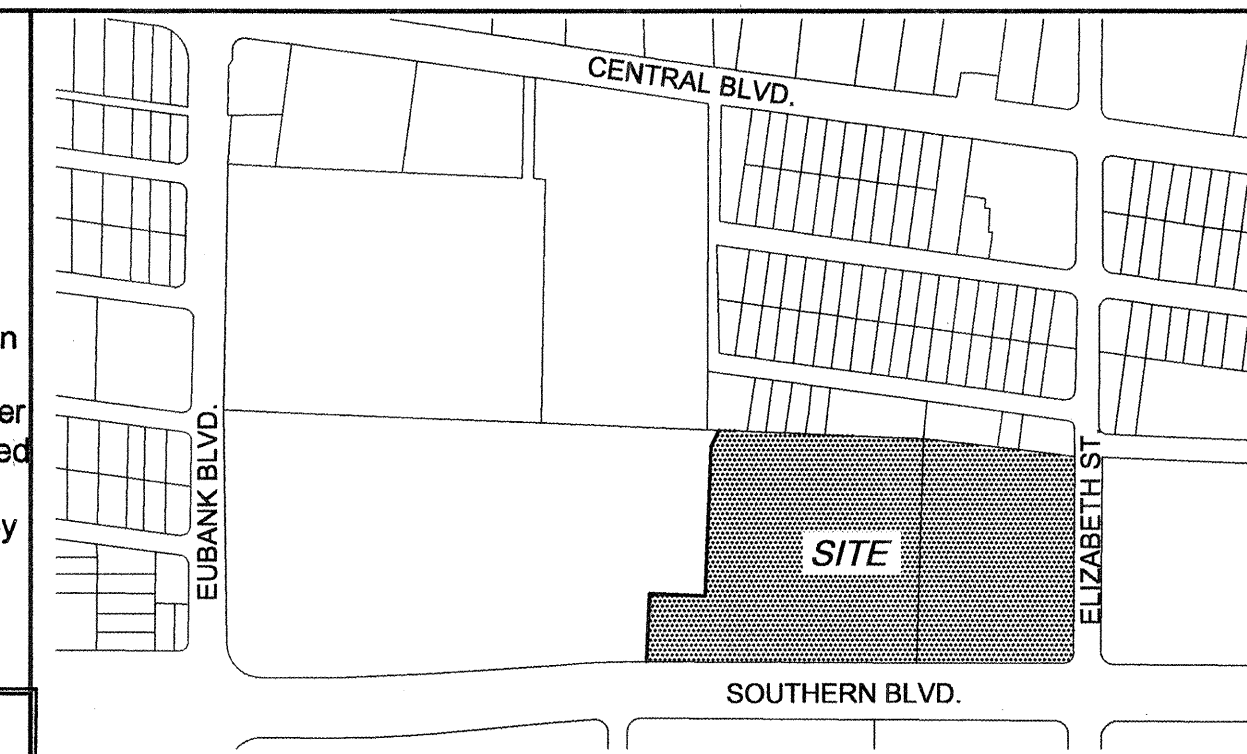


CONSTRUCTION PLANS FOR LONGFORD VILLAGE EAST SUBDIVISION ALBUQUERQUE, NEW MEXICO

RECORD DRAWINGS

I, Patrick J. Conley of the firm of Smith Engineering Co.
A Registered Professional Engineer in the State of New Mexico, do hereby certify, to
the best of my knowledge and belief, that the infrastructure installed as part of this
project has been inspected by me or by a qualified person under my direct supervision
and has been constructed in accordance with the plans and specifications, while
someone from Smith Engineering Company was onsite, approved by the City Engineer
and that the original design intent of the approved plans has been met, except as noted
by me on the as-built construction drawings. This Certification is based on site
inspections by me or personnel under my direction and survey information provided by
Thomas W. Patrick (Surveyor Name) NMPS number 12651 (PS #).

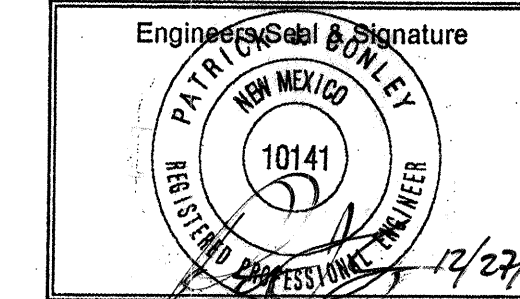

VICINITY MAP
L-21-2

INDEX

SHEET NO.	DESCRIPTION
1	TITLE SHEET
2	PRELIMINARY PLAT
3-4	GRADING PLAN
5	OVERALL PAVING PLAN
6-12	PAVING PLAN AND PROFILES
13	OVERALL UTILITY PLAN
14-21	UTILITY PLAN AND PROFILES
22	SECTIONS AND DETAILS
23	DRAINAGE POND DETAILS

PAVING PLANS

SHEET NO.	DESCRIPTION
6	JICAMA WAY STA. 10+00.00 - 17+00.00 PAVING PLAN AND PROFILE
7	PEQUIN TRAIL STA. 17+00.00 - 20+50.00 PAVING PLAN AND PROFILE
8	HABANERO WAY STA. 20+50.00 - 30+00 PAVING PLAN AND PROFILE
9	TOMATILLO LANE PAVING PLAN AND PROFILE
10	TEPIN TRAIL AND SERRANO LANE PAVING PLAN AND PROFILE
11	CASCABEL TRAIL PAVING PLAN AND PROFILE
12	ALLEY 1 AND ALLEY 2 PAVING PLAN AND PROFILE

UTILITY PLANS

SHEET NO.	DESCRIPTION
14	JICAMA WAY STA. 10+00.00 - 17+00.00 UTILITY PLAN AND PROFILE
15	PEQUIN TRAIL STA. 17+00.00 - 20+50.00 UTILITY PLAN AND PROFILE
16	HABANERO WAY STA. 20+50.00 - 30+00.00 UTILITY PLAN AND PROFILE
17	TOMATILLO LANE UTILITY PLAN AND PROFILE
18	TEPIN TRAIL AND SERRANO LANE UTILITY PLAN AND PROFILE
19	CASCABEL TRAIL UTILITY PLAN AND PROFILE
20	ALLEY 1 AND ALLEY 2 UTILITY PLAN AND PROFILE
21	WATERLINE AND SANITARY SEWER EASEMENTS UTILITY PLAN AND PROFILE

SURVEYOR'S CERTIFICATION

I, Thomas W. Patrick, a duly qualified Registered Professional Land Surveyor under the Laws of the State of New Mexico, do hereby certify that the "as-built" information shown on these drawings was obtained from field construction and "as-built" surveys performed by me, or under my supervision, that the "as-built" information shown on these drawings was added by me, or under my supervision and that this "as-built" information is true and correct to the best of my knowledge and belief. Community Sciences Corporation is not responsible for any of the design concepts, calculations, engineering and/or intent of the record drawings.

Thomas W. Patrick
Thomas W. Patrick, N.M.P.S. 12651

12.22.2004
Date


CONSTRUCTION NOTES:

1. THE CONTRACTOR SHALL ABIDE BY ALL LOCAL, STATE, AND FEDERAL LAWS, RULES AND REGULATIONS WHICH APPLY TO THE CONSTRUCTION OF THESE IMPROVEMENTS.
2. PRIOR TO CONSTRUCTION, CONTRACTOR SHALL EXCAVATE AND VERIFY THE HORIZONTAL AND VERTICAL LOCATIONS OF ALL POTENTIAL OBSTRUCTIONS. SHOULD A CONFLICT EXIST, THE CONTRACTOR SHALL NOTIFY THE ENGINEER OR CONSTRUCTION OBSERVER SO THAT THE CONFLICT CAN BE RESOLVED WITH A MINIMUM AMOUNT OF DELAY.
3. ALL ELECTRICAL, TELEPHONE, CABLE TV, GAS AND OTHER UTILITY LINES, CABLES AND APPURTENANCES ENCOUNTERED DURING CONSTRUCTION THAT REQUIRE RELOCATION, SHALL BE COORDINATED WITH THAT UTILITY. THE CONTRACTOR SHALL BE RESPONSIBLE FOR COORDINATION OF ALL NECESSARY UTILITY ADJUSTMENTS. NO ADDITIONAL COMPENSATION WILL BE ALLOWED FOR DELAYS OR INCONVENIENCES CAUSED BY UTILITY COMPANY WORK CREWS. THE CONTRACTOR MAY BE REQUIRED TO RESCHEDULE HIS ACTIVITIES TO ALLOW UTILITY CREWS TO PERFORM THEIR REQUIRED WORK.
4. DISPOSAL SITE FOR ALL EXCESS EXCAVATION MATERIAL, AND UNSUITABLE MATERIAL SHALL BE OBTAINED BY THE CONTRACTOR IN COMPLIANCE WITH APPLICABLE ENVIRONMENTAL REGULATIONS AND APPROVED BY THE CONSTRUCTION OBSERVER. ALL COSTS INCURRED IN OBTAINING A DISPOSAL SITE AND HAUL THERE TO SHALL BE CONSIDERED INCIDENTAL TO THE PROJECT AND NO SEPARATE MEASUREMENT OR PAYMENT SHALL BE MADE.

5. THE CONTRACTOR IS RESPONSIBLE FOR PROTECTING THE EXISTING UTILITY LINES WITHIN THE CONSTRUCTION AREA. ANY DAMAGE TO EXISTING FACILITIES CAUSED BY CONSTRUCTION ACTIVITY SHALL BE REPAIRED OR REPLACED AT THE CONTRACTOR'S EXPENSE AND APPROVED BY THE CONSTRUCTION OBSERVER.
6. CONSTRUCTION ACTIVITY SHALL BE LIMITED TO THE PROPERTY AND/OR PROJECT LIMITS. ANY DAMAGE TO ADJACENT PROPERTIES RESULTING FROM THE CONSTRUCTION PROCESS IS THE RESPONSIBILITY OF THE CONTRACTOR. ANY COSTS INCURRED FOR REPAIRS SHALL BE THE COST OF THE CONTRACTOR.
7. OVERNIGHT PARKING OF CONSTRUCTION EQUIPMENT SHALL NOT OBSTRUCT DRIVEWAYS OR DESIGNATED TRAFFIC LANES. THE CONTRACTOR SHALL NOT STORE ANY EQUIPMENT OR MATERIAL WITHIN THE PUBLIC RIGHT-OF-WAY.
8. THE CONTRACTOR SHALL OBTAIN ALL THE NECESSARY PERMITS FOR THE PROJECT PRIOR TO COMMENCING CONSTRUCTION (I.E. BARRICADING, SURFACE DISTURBANCE).
9. THE CONTRACTOR SHALL BE RESPONSIBLE TO REPLACE AT HIS EXPENSE ANY AND ALL PROPERTY CORNERS DESTROYED DURING CONSTRUCTION. ALL PROPERTY CORNERS MUST BE RESET BY A REGISTERED LAND SURVEYOR.
10. ALL PERMANENT PAVEMENT MARKING AND TRAFFIC SIGNING SHALL BE FURNISHED BY THE CONTRACTOR PER PLAN.

11. THE CONTRACTOR SHALL FOLLOW THE CONSTRUCTION TRAFFIC CONTROL AND SIGNING PLAN PROVIDED HEREIN. THE CONTRACTOR SHALL COORDINATE WITH THE CITY OF ALBUQUERQUE, TRAFFIC ENGINEERING DEPARTMENT, PRIOR TO BEGINNING ANY CONSTRUCTION WORK ON OR ADJACENT TO EXISTING STREETS.
12. ALL BARRICADES AND CONSTRUCTION SIGNING SHALL CONFORM TO APPLICABLE SECTIONS OF THE "MANUAL OF UNIFORM TRAFFIC CONTROL DEVICES" (MUTCD), U.S. DEPARTMENT OF TRANSPORTATION, LATEST EDITION.
13. THE CONTRACTOR SHALL MAINTAIN ALL CONSTRUCTION BARRICADES AND SIGNING AT ALL TIMES. THE CONTRACTOR SHALL VERIFY THE PROPER LOCATION OF ALL BARRICADING AT THE END AND BEGINNING OF EACH DAY.
14. ALL SAWCUT PAVEMENT SHALL HAVE A UNIFORM EDGE AND BE SPRAYED WITH TACK.
15. WHEN ABUTTING NEW CURB AND GUTTER TO EXISTING PAVEMENT, A 1' WIDE SECTION OF EXISTING PAVEMENT ADJACENT TO THE CURB AND GUTTER SHALL BE SAWCUT, REMOVED, AND REPLACED AS PER THE STANDARD SPECIFICATIONS.
16. THE CONTRACTOR SHALL ASSUME RESPONSIBILITY FOR ANY DAMAGE TO EXISTING PAVEMENTS, PAVEMENT MARKINGS, CURB & GUTTER, DRIVE PADS, WHEELCHAIR RAMPS, AND SIDEWALK DURING CONSTRUCTION, APART FROM THOSE SECTIONS INDICATED FOR REMOVAL ON THE PLANS AND SHALL REPAIR OR REPLACE PER COA STANDARDS, AT HIS OWN EXPENSE.

17. FOR STORM DRAIN CONSTRUCTION, RCP PIPE JOINTS SHALL NOT BE GROUTED PRIOR TO FINAL INSPECTION. FINAL INSPECTION WILL DETERMINE JOINTS TO BE GROUTED FOR FINAL ACCEPTANCE OF THE CONSTRUCTION.
18. ALL EXCAVATION, TRENCHING, AND SHORING ACTIVITIES MUST BE CARRIED-OUT IN ACCORDANCE WITH OSHA 29 CFR 1926.650 SUBPART P.

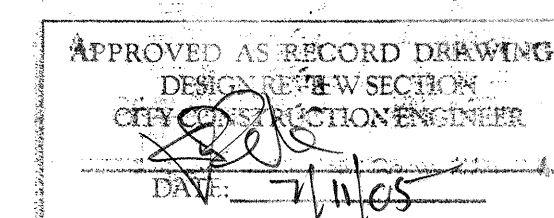


Bohannon & Huston
Courtyard I 7500 Jefferson St. NE Albuquerque, NM 87109-4335
ENGINEERING • SPATIAL DATA • ADVANCED TECHNOLOGIES

1 2 3 4 5 6 7 8 9 10 11 12 13 14 15
26 7328 81 0105

DRB # 1000262



REV.	SHEETS	CITY ENGINEER	DATE	USER DEPARTMENT	DATE	USER DEPARTMENT	DATE
ENGINEERS STAMP & SIGNATURE	APPROVALS	ENGINEER	DATE	*****	APPROVED FOR CONSTRUCTION		
	DRC Chairman	<u>Thomas W. Patrick</u>	<u>12/27/04</u>				
	Transportation	<u>Thomas W. Patrick</u>	<u>12/27/04</u>				
	Water/Wastewater	<u>Thomas W. Patrick</u>	<u>12/27/04</u>				
	Hydrology	<u>Thomas W. Patrick</u>	<u>12/27/04</u>				
Parks							
Const. Coord.							
City Project No. 732881				Sheet 1 Of 23			

PRELIMINARY PLAT FOR LONGFORD VILLAGE EAST TRACT B-1 COSTCO DEVELOPMENT ALBUQUERQUE, NEW MEXICO DECEMBER 2003

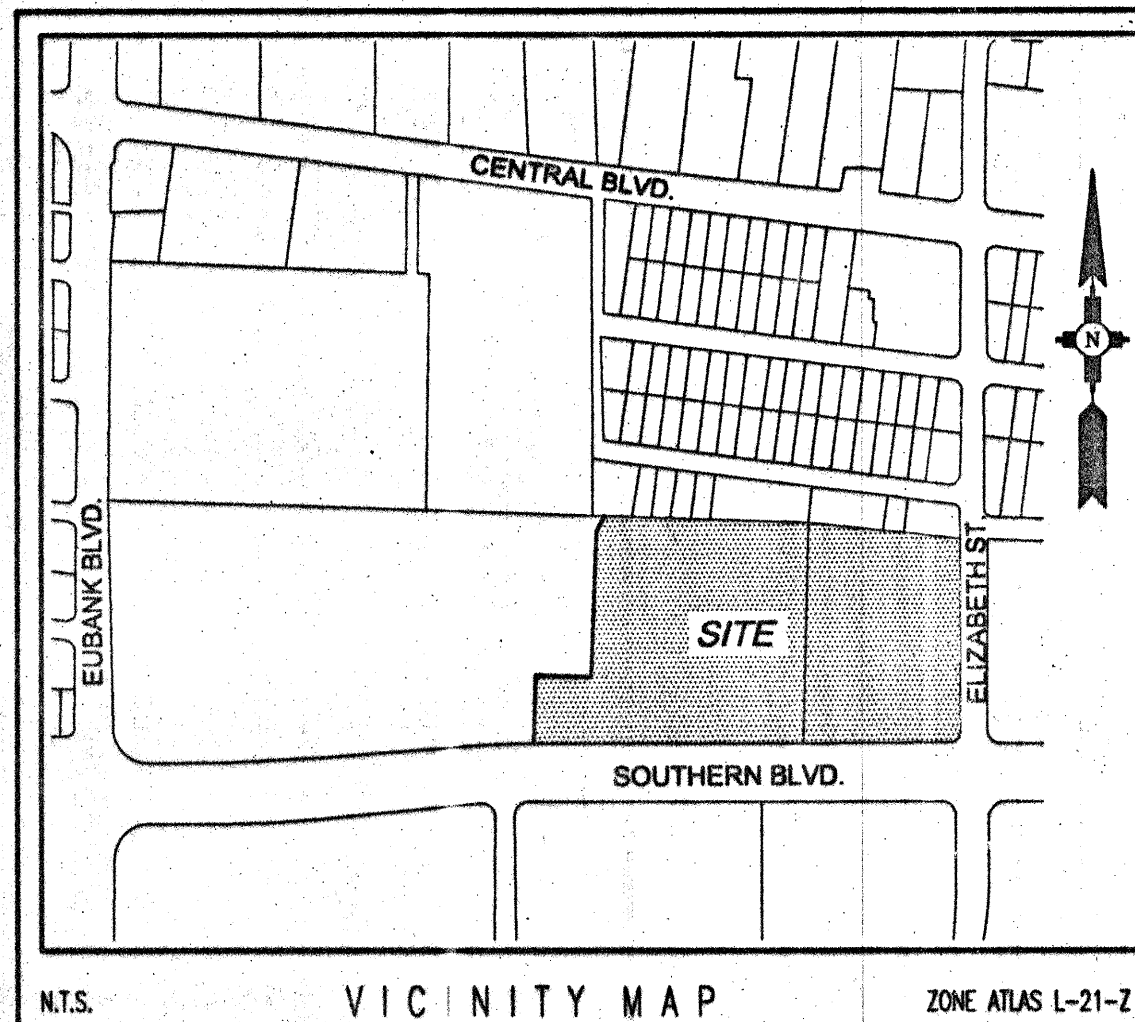

ID	ARC	RADIUS	DELTA	TANGENT
C1	104.31	65.00	91°56'48"	67.25
C2	39.28	25.00	90°01'45"	25.01

ID	BEARING	LENGTH
T1	N02°17'05"E	103.24
T2	S87°43'34"E	145.00
T3	N02°17'55"E	384.96
T4	N02°17'23"E	39.54
T5	S87°43'34"E	938.00
T6	S00°18'32"W	528.79
T7	N89°39'43"W	1027.25

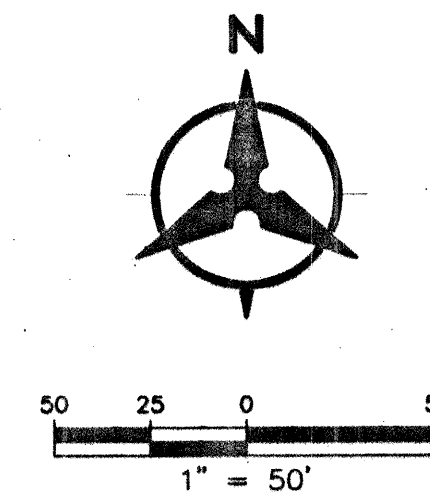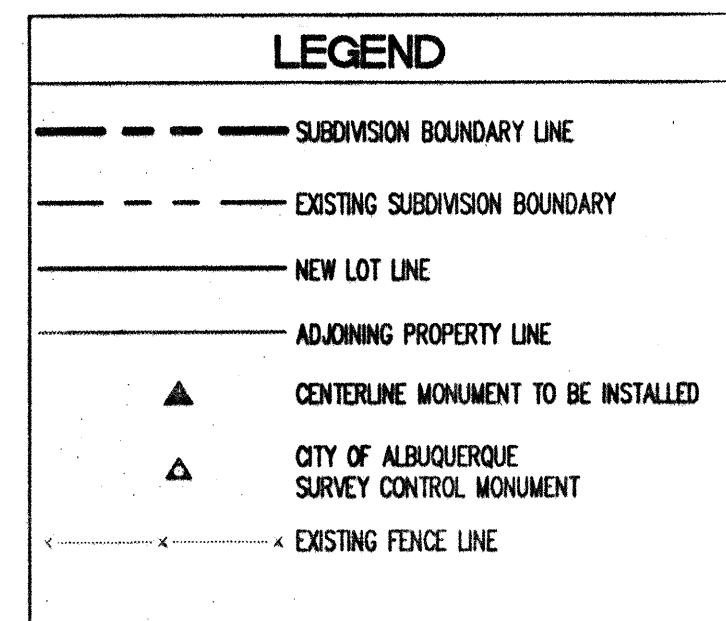

KEYED NOTES

- (A) 8' PUBLIC UTILITY EASEMENT

ACS Aluminum Cap stamped "6-L21, 1986"
Geographic Position (NAD 1983)
N.M. State Plane Coordinates (Central Zone)
X = 1,558,220.5759 Y = 1,481,283.3298
Ground-to-Grid Factor = 0.999907733
 $\Delta\alpha = -00^{\circ}09'28"$
NAVD88 Elevation = 5503.35

LEGAL DESCRIPTION

TRACT B-1 OF THE COSTCO DEVELOPMENT (BK - 2001C PG.194, 07/09/01)

GENERAL NOTES

- EXISTING ZONING: SU-1 FOR PRO.
PROPOSED DEVELOPMENT: SU-1 FOR PRO
- PROPOSED NET ACREAGE: 13.12 AC
NUMBER OF LOTS: 122
PROPOSED DENSITY: 9.30 DU/AC
- MIN. LOT DIMENSIONS: 38.0' X 66.5'
MINIMUM LOT AREA: 2,527.00 SQFT
- ALL UTILITIES AND STORM DRAIN IMPROVEMENTS ARE TO BE PUBLIC, AND TO BE DEDICATED TO THE CITY OF ALBUQUERQUE FOR MAINTENANCE.
- PRIVATE ACCESS: THIS SUBDIVISION IS PLANNED TO BE A GATED COMMUNITY. ALL ROADS WITHIN THE DEVELOPMENT EXIST WITHIN TRACT "A". PRIVATE ACCESS, PUBLIC DRAINAGE, WATER, AND SANITARY SEWER EASEMENT ON TRACT "A".
- HOMEOWNERS ASSOCIATION: THIS SUBDIVISION WILL HAVE A HOMEOWNERS ASSOCIATION. THE HOMEOWNERS ASSOCIATION WILL OWN TRACTS "A", "B", "C", "D", "E", "F", AND "G", AND BE RESPONSIBLE FOR MAINTENANCE INCLUDING STREET AND LANDSCAPE IMPROVEMENTS, AND "H".
- TRACTS "B", "C", "D", "E", "F", AND "G" ARE OPEN SPACE TRACTS ENCUMBERED BY PRIVATE PEDESTRIAN ACCESS EASEMENTS
- LOT SETBACKS SHALL BE 8.5' TO FRONT OF HOUSE, 20' TO GARAGE, 5' SIDEYARD AND 15' BACKYARD
- NO INDIVIDUAL LOTS SHALL BE ALLOWED DIRECT ACCESS TO ELIZABETH STREET S.E., AND/OR SOUTHERN BLVD.
- TRACT "H" IS ENCUMBERED BY PUBLIC WATERLINE EASEMENT.

SITE DATA

ZONE ATLAS NO.	L-21-Z
ZONING	SU-1 FOR PRO
MILES OF FULL WIDTH STREETS CREATED	.63 MILES
NO. OF EXISTING PARCELS	1
NO. OF LOTS CREATED	122
DENSITY	9.30 DU/AC

SURVEY NOTES

- ALL BOUNDARY CORNERS SHOWN (●) ARE FOUND REBAR W/CAP.
- ALL STREET CENTERLINE MONUMENTATION SHALL BE INSTALLED AT ALL CENTERLINE PC'S, PTS, ANGLE POINTS, AND STREET INTERSECTIONS AND SHOWN THUS (▲) AND WILL BE MARKED BY (4") ALUMINUM CAP STAMPED "CITY OF ALBUQUERQUE CENTERLINE MONUMENTATION MARKED, DO NOT DISTURB PLS SURVEYOR'S F."
- THE SUBDIVISION BOUNDARY WILL BE TIED TO THE NEW MEXICO STATE PLANE COORDINATE SYSTEM AS SHOWN.
- BASES OF BEARINGS WILL BE NEW MEXICO STATE PLANE BEARINGS.
- DISTANCES SHALL BE GROUND DISTANCES.
- MANHOLES WILL BE OFFSET AT ALL POINTS OF CURVATURE, TANGENCY STREET INTERSECTIONS, AND ALL OTHER ANGLE POINTS TO ALLOW USE OF CENTERLINE MONUMENTATION.

1	2	3	4	5	6	7	8	9	10	11	12	13	14	15
26	73	28	81	62	05									


APPROVED

Mark Ruhlman 12-4-03
CITY SURVEYOR DATE

Mark Ruhlman 12-4-03
MARK RUHLMAN DATE
DIVISION PRESIDENT,
LONGFORD HOMES OF NEW MEXICO

Bohannon & Huston

Courtyard 1 780 Jefferson St. NE Albuquerque, NM 87109-4905
ENGINEERING • SPATIAL DATA • ADVANCED TECHNOLOGIES

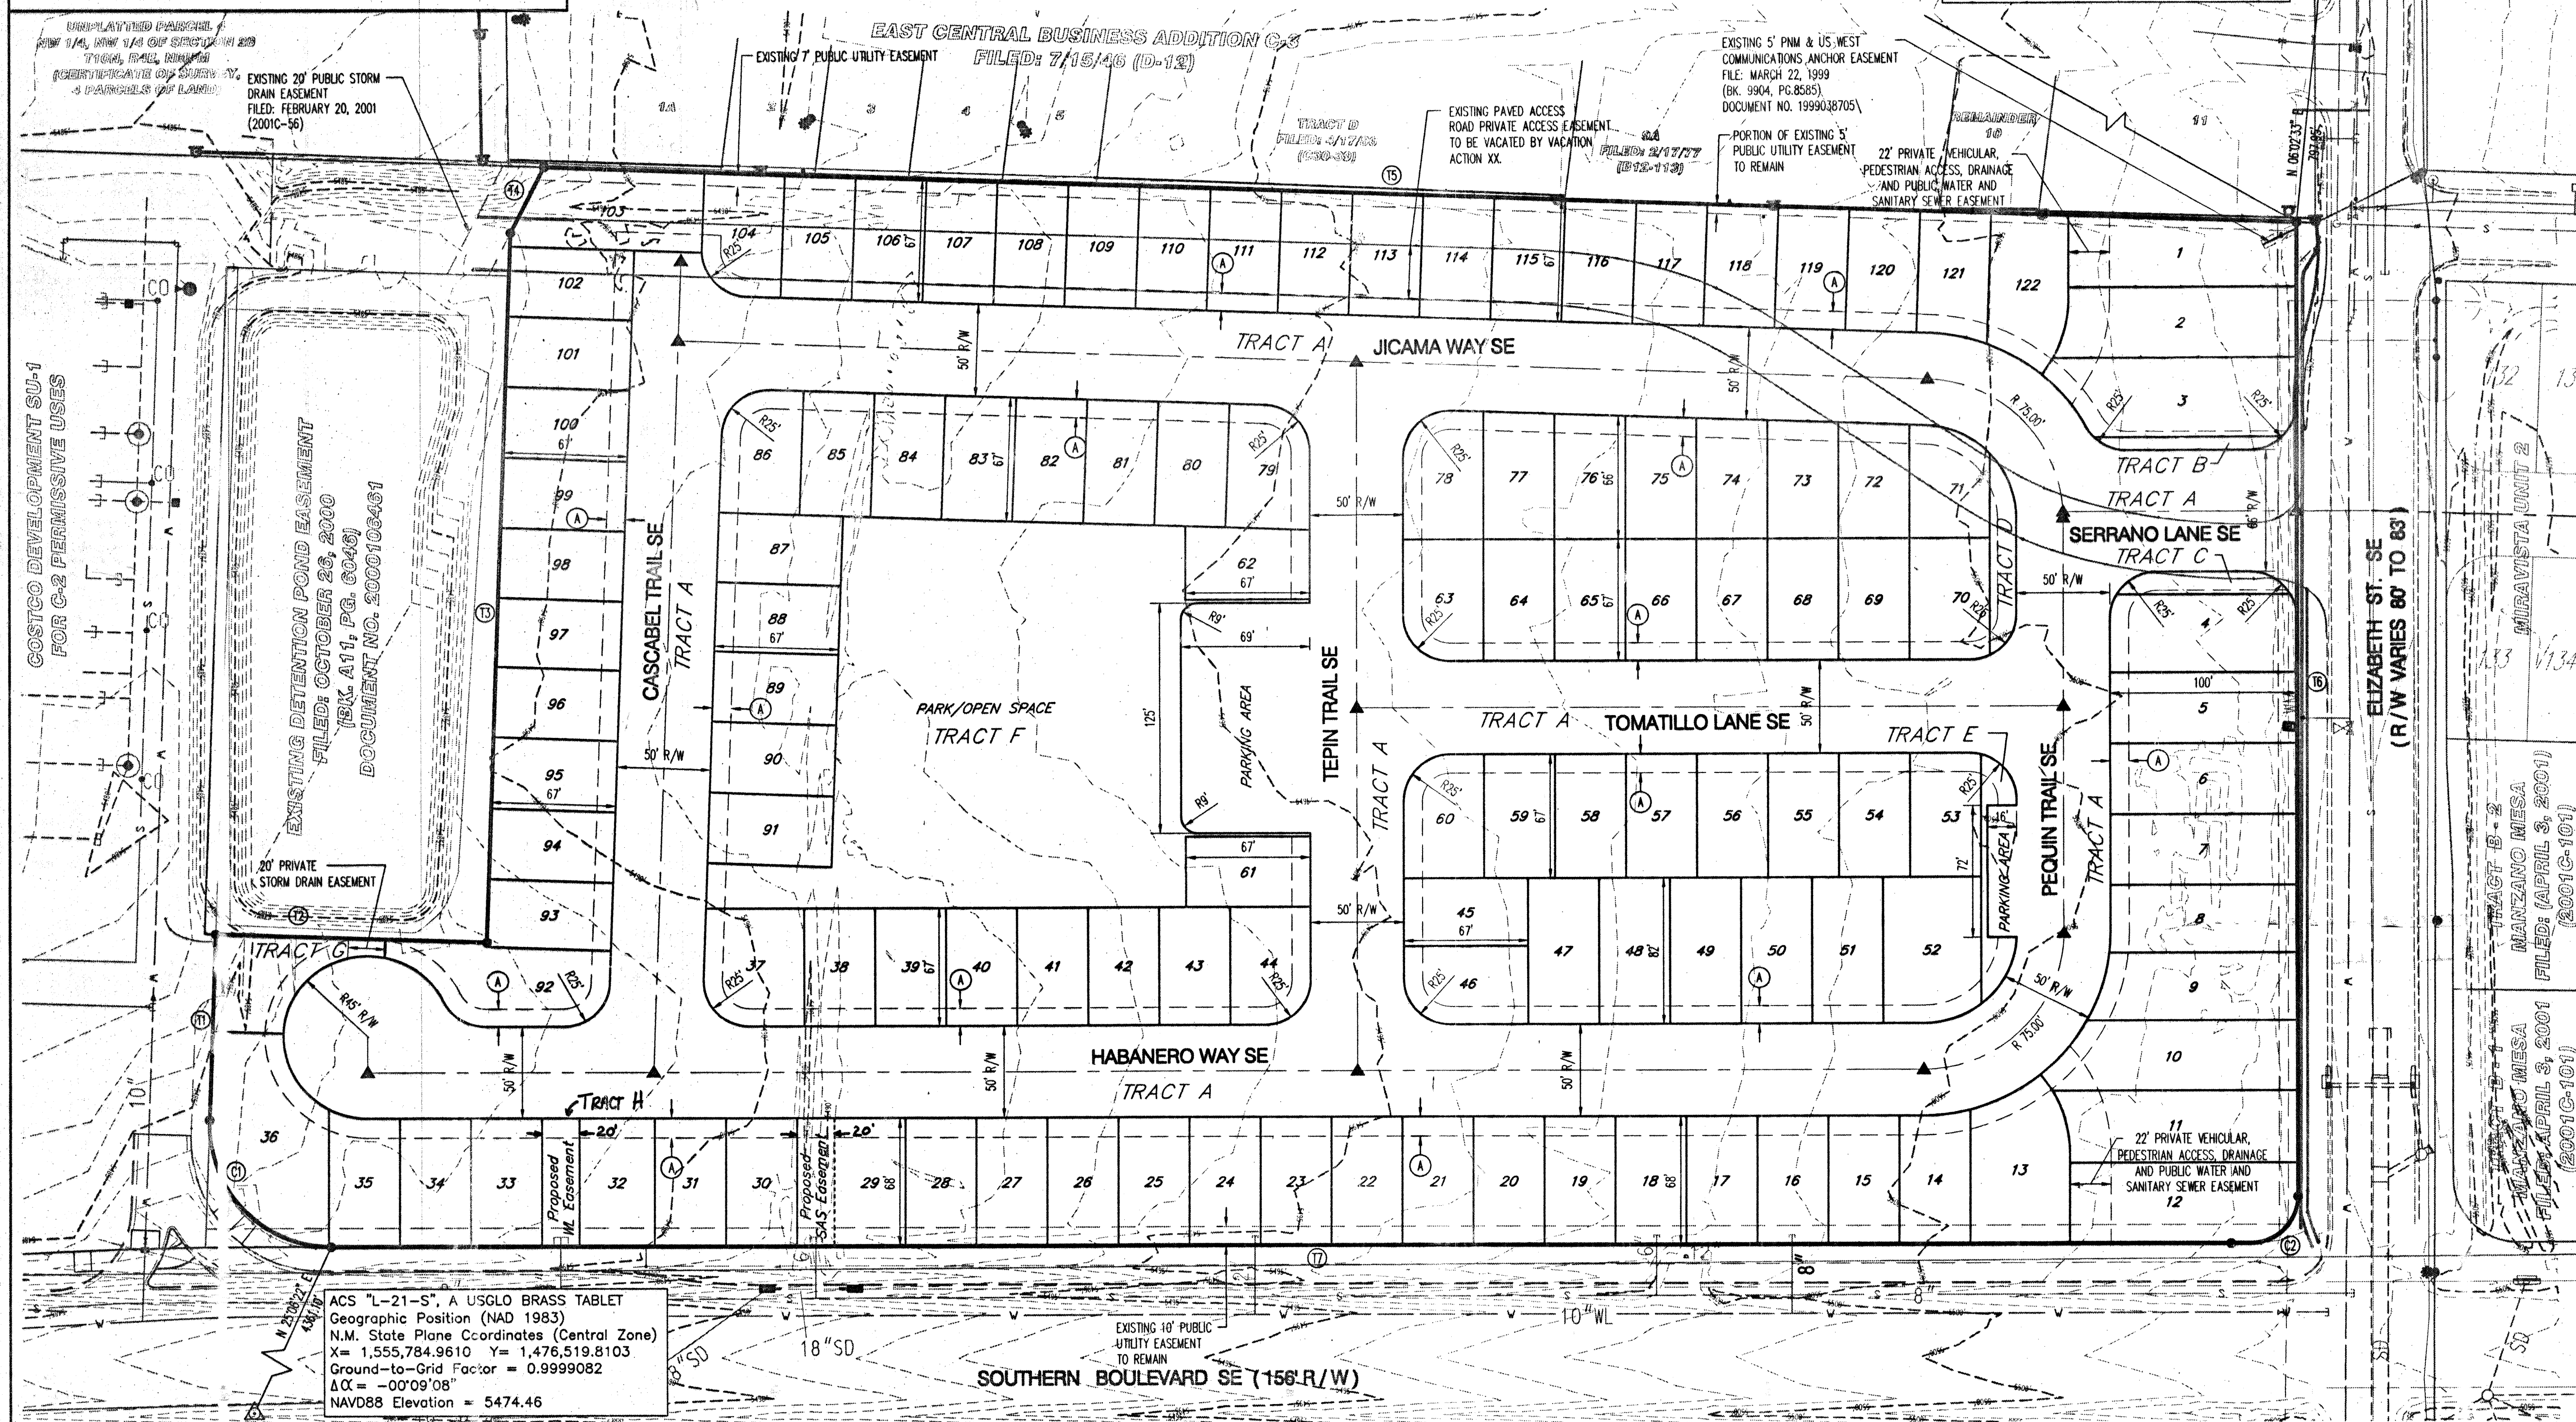

ACS "L-21-S", A USGLD BRASS TABLET
Geographic Position (NAD 1983)
N.M. State Plane Coordinates (Central Zone)
X = 1,555,784.9610 Y = 1,476,519.8103
Ground-to-Grid Factor = 0.9999082
 $\Delta\alpha = -00^{\circ}09'08"$
NAVD88 Elevation = 5474.46

SCANNED BY
MESA REPRO

EXISTING DETENTION POND

HABANERO WAY

TRACT F



JICAMA WAY

TEPIN TRAIL

CASCABEL TRAIL

GENERAL NOTES

1. CONTRACTOR MUST OBTAIN A TOPSOIL DISTURBANCE PERMIT FROM THE ENVIRONMENTAL HEALTH DIVISION PRIOR TO CONSTRUCTION.
2. THE CONTRACTOR IS TO REFER TO EARTHWORK SPECIFICATION AS NOTED IN THE SOILS REPORT.
3. THE CONTRACTOR SHALL CONFORM TO ALL CITY, COUNTY, STATE, AND FEDERAL DUST CONTROL MEASURES & REQUIREMENTS AND WILL BE RESPONSIBLE FOR PREPARING AND OBTAINING ALL NECESSARY APPLICATIONS AND APPROVALS.
4. THE CONTRACTOR SHALL ENSURE THAT NO SOIL ERODES FROM THE LOTS INTO PUBLIC RIGHT-OF-WAY. THIS CAN BE ACHIEVED BY CONSTRUCTING TEMPORARY BERMS AS PER DETAIL, THIS SHEET, AND NETTING THE SOIL TO KEEP IT FROM BLOWING.
5. ALL SPOT ELEVATIONS ARE TO FLOWLINE UNLESS OTHERWISE NOTED.
6. Boulders GREATER THAN 3 FEET IN DIAMETER EXCAVATED DURING GRADING ACTIVITIES SHALL BE STOCKPILED AND DISPOSED OF AT THE DISCRETION OF THE OWNER.
7. ALL WALLS SHOWN ARE TO BE PLACED ALONG PROPERTY LINE. WALLS ARE SHOWN OFFSET FOR VISUAL PURPOSE ONLY.

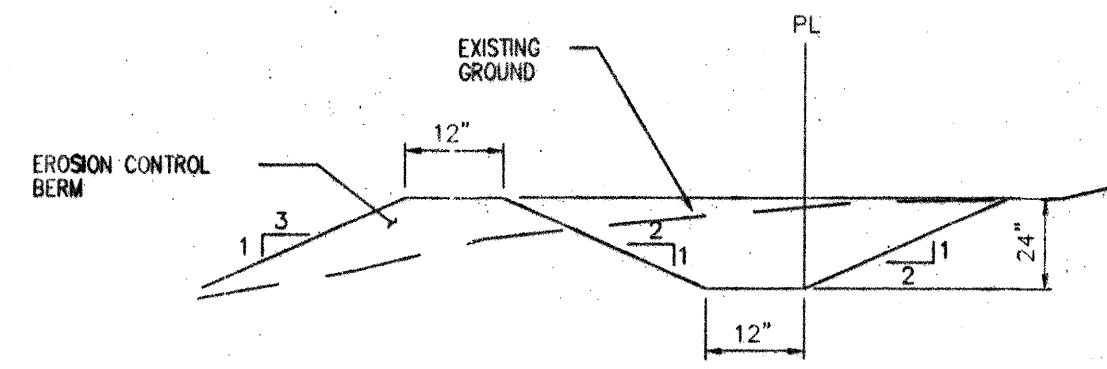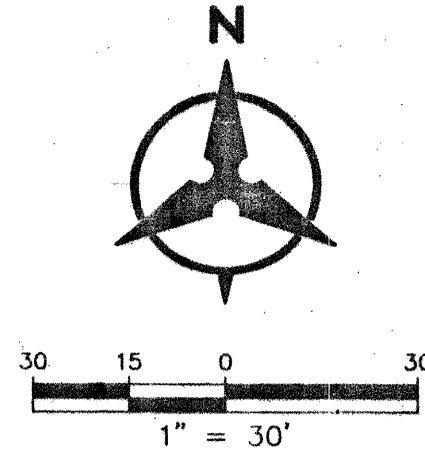

EROSION CONTROL BERM

1. TO PREVENT EROSION FROM THE SITE, DURING GRADING & CONSTRUCTION OPERATIONS, A BERM OF THE ABOVE DIMENSIONS SHALL BE MAINTAINED ON THE WEST WEST BOUNDARY OF THE SITE.
2. WIND EROSION SHALL BE PREVENTED BY MAINTAINING AN ADEQUATELY MOISTENED SITE.
3. AFTER CONSTRUCTION ALL SURFACES WILL BE PAVED OR LANDSCAPED TO PREVENT EROSION.
4. CONTRACTOR MUST OBTAIN A TOP SOIL DISTURBANCE PERMIT FROM ENVIRONMENTAL HEALTH DIVISION PRIOR TO CONSTRUCTION.

EROSION CONTROL PLAN

LEGEND

- (91.62) FUTURE SPOT ELEVATION
- 91.62 PROPOSED SPOT ELEVATION
- x 92.46 EXISTING SPOT ELEVATION (GRID & TC)
- EXISTING CURB & GUTTER
- PROPOSED MOUNTABLE CURB & GUTTER
- PROPOSED STANDARD CURB & GUTTER
- EXISTING CONTOUR W/ INDEX ELEVATION
- FLOW ARROW
- PROPOSED RETAINING WALL
- PROPOSED GARDEN WALL
- CONCRETE FILLED TO 1-FOOT DEPTH
- PROPOSED SLOPE
- PROPOSED STORM DRAIN
- PROPOSED STORM DRAIN MANHOLE
- PROPOSED STORM DRAIN INLET
- PROPOSED CATTLE GUARD INLET
- WALL DRAIN

SURVEYOR'S CERTIFICATE

I, THOMAS W. PATRICK, A DULY QUALIFIED LICENSED PROFESSIONAL SURVEYOR UNDER THE LAWS OF THE STATE OF NEW MEXICO, DO HEREBY CERTIFY THAT THE AS-BUILT INFORMATION SHOWN ON THESE DRAWINGS WAS OBTAINED FROM FIELD CONSTRUCTION AND "AS-BUILT" SURVEYS PERFORMED BY ME, OR UNDER MY SUPERVISION, THAT THE "AS-BUILT" INFORMATION SHOWN ON THESE DRAWINGS (UNLESS OTHERWISE NOTED) WAS ADDED BY ME, OR BY UNDER MY SUPERVISION, AND THAT THIS "AS-BUILT" INFORMATION IS TRUE AND CORRECT TO THE BEST OF MY KNOWLEDGE AND BELIEF. COMMUNITY SCIENCES CORPORATION IS NOT RESPONSIBLE FOR ANY OF THE DESIGN CONCEPTS, CALCULATIONS, ENGINEERING AND/OR INTENT OF THE RECORD DRAWINGS.

THOMAS W. PATRICK
NEW MEXICO PROFESSIONAL SURVEYOR
1251
DATE 12-17-04
NEW MEXICO PROFESSIONAL SURVEYOR NO. 12651

1 2 3 4 5 6 7 8 9 10 11 12 13 14 15
26 73 28 81 13 05

Bohannon & Huston

Courtyard | 7500 Jefferson St NE Albuquerque, NM 87108-4335
ENGINEERING • SPATIAL DATA • ADVANCED TECHNOLOGIES





**CITY OF ALBUQUERQUE
PUBLIC WORKS DEPARTMENT**

**LONGFORD VILLAGE EAST SUBDIVISION
GRADING AND DRAINAGE PLAN**


Des in Review Committee	City Engineer Approval	Ma./Day/Yr.	Ma./Day/Yr.
For Information Only			
Cit	Project No.	Zone Map No.	Sheet
	732881	L-21-Z	3 Of 23

ROUGH GRADING (+/-0.5')
APPROVED FOR ROUGH GRADING
DATE 2/3/04

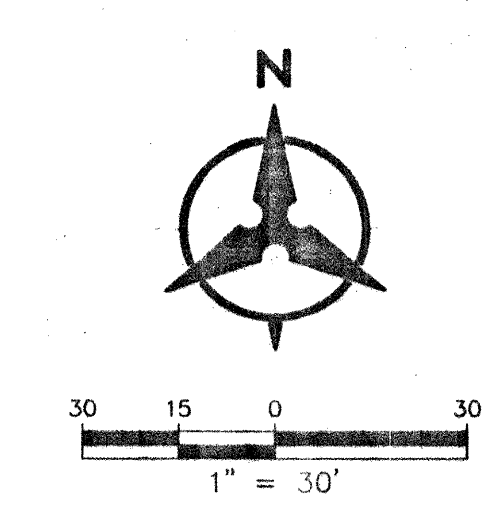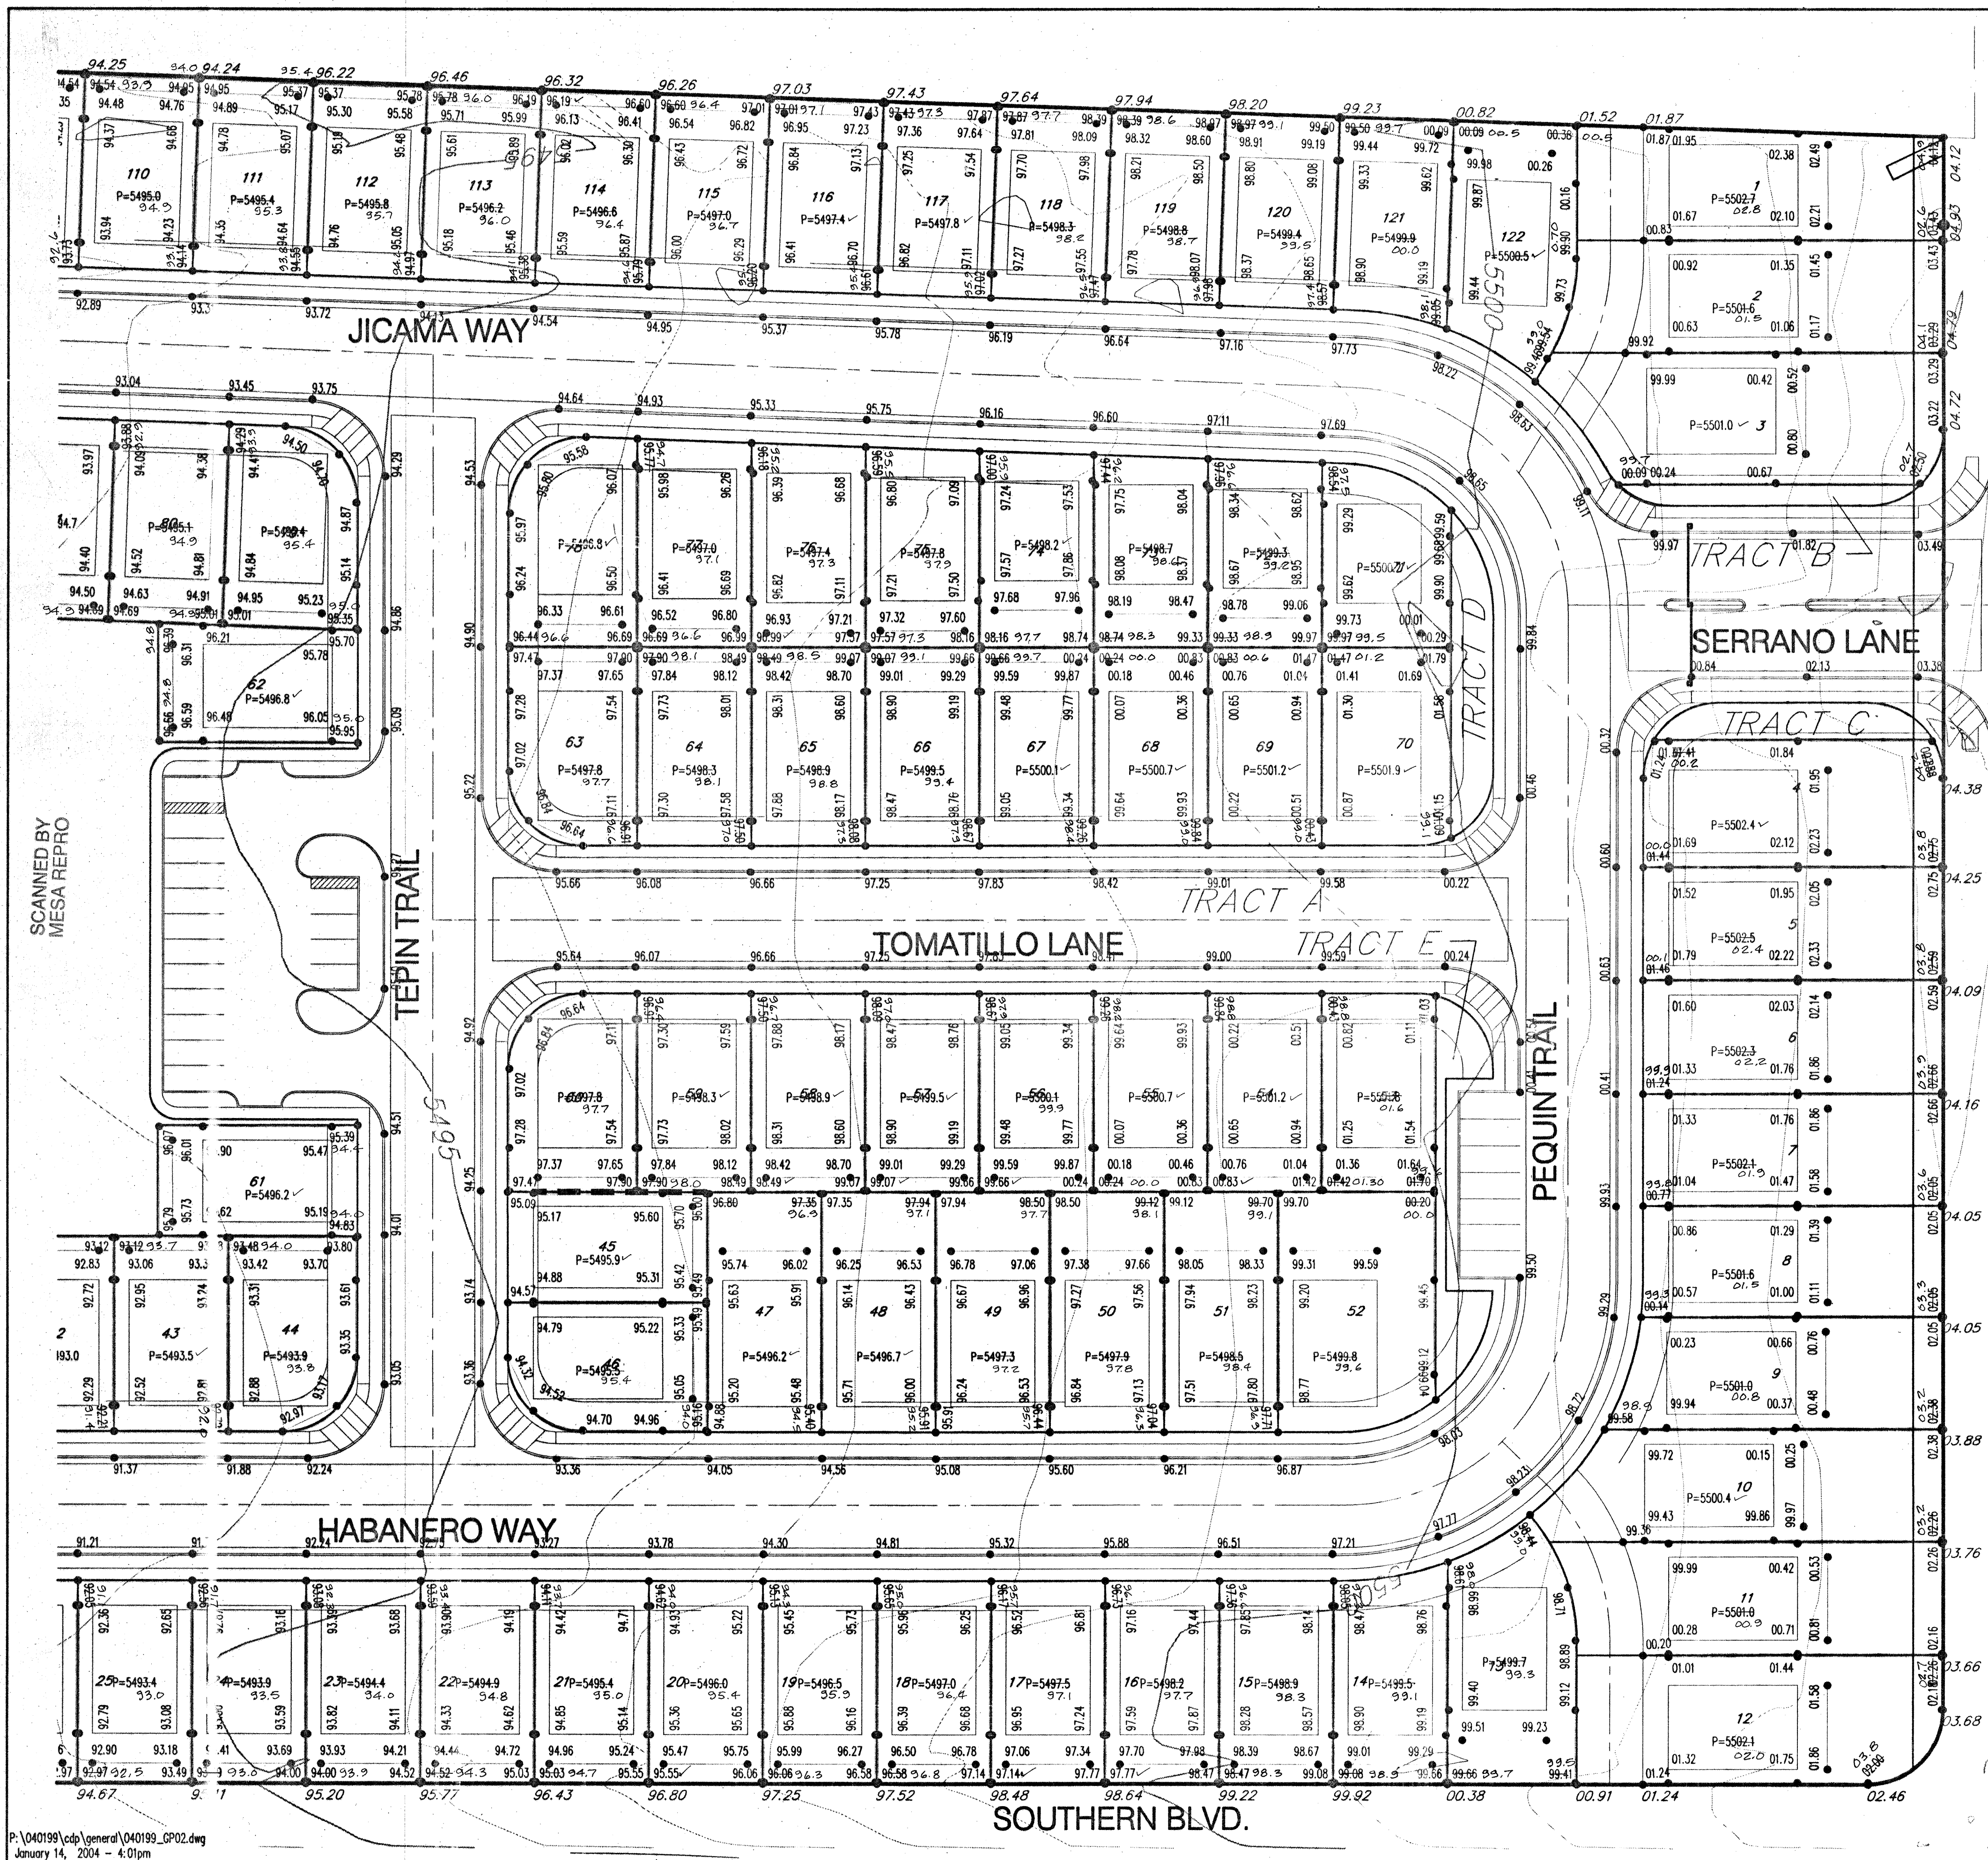

GENERAL NOTES

1. CONTRACTOR MUST OBTAIN A TOPSOIL DISTURBANCE PERMIT FROM THE ENVIRONMENTAL HEALTH DIVISION PRIOR TO CONSTRUCTION.
2. THE CONTRACTOR IS TO REFER TO EARTHWORK SPECIFICATION AS NOTED IN THE SOILS REPORT.
3. THE CONTRACTOR SHALL CONFORM TO ALL CITY, COUNTY, STATE, AND FEDERAL DUST CONTROL MEASURES & REQUIREMENTS AND WILL BE RESPONSIBLE FOR PREPARING AND OBTAINING ALL NECESSARY APPLICATIONS AND APPROVALS.
4. THE CONTRACTOR SHALL ENSURE THAT NO SOIL ERODES FROM THE LOTS INTO PUBLIC RIGHT-OF-WAY. THIS CAN BE ACHIEVED BY CONSTRUCTING TEMPORARY BERM'S AS PER DETAIL, THIS SHEET, AND WETTING THE SOIL TO KEEP IT FROM BLOWING.
5. ALL SPOT ELEVATIONS ARE TO FLOWLINE UNLESS OTHERWISE NOTED.
6. BOLLARDS GREATER THAN 3 FEET IN DIAMETER EXCAVATED DURING GRADING ACTIVITIES SHALL BE STOCKPILED AND DISPOSED OF AT THE DISCRETION OF THE OWNER.
7. ALL WALLS SHOWN ARE TO BE PLACED ALONG PROPERTY LINE. WALLS ARE SHOWN OFFSET FOR VISUAL PURPOSE ONLY.

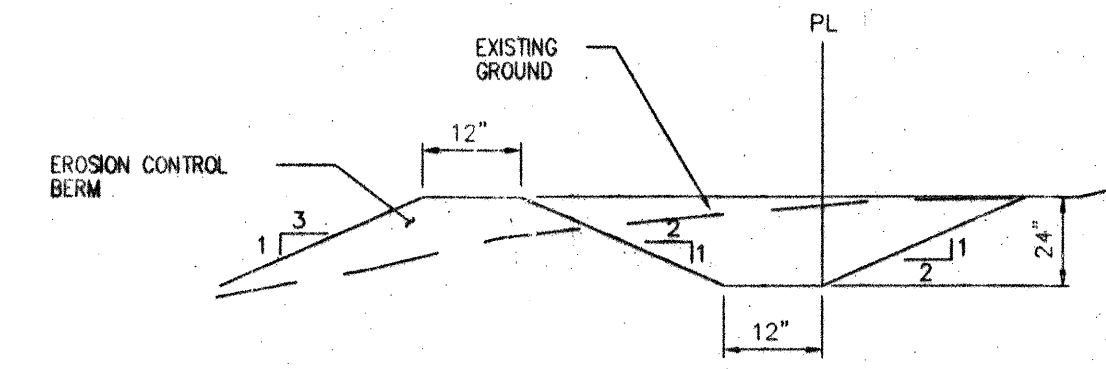

1. TO PREVENT EROSION FROM THE SITE, DURING GRADING & CONSTRUCTION OPERATIONS, A BERM OF THE ABOVE DIMENSIONS SHALL BE MAINTAINED ON THE WEST WEST BOUNDARY OF THE SITE.
2. WIND EROSION SHALL BE PREVENTED BY MAINTAINING AN ADEQUATELY MOISTENED SITE.
3. AFTER CONSTRUCTION ALL SURFACES WILL BE PAVED OR LANDSCAPED TO PREVENT EROSION.
4. CONTRACTOR MUST OBTAIN A TOP SOIL DISTURBANCE PERMIT FROM ENVIRONMENTAL HEALTH DIVISION PRIOR TO CONSTRUCTION.

EROSION CONTROL PLAN
NO SCALE

LEGEND

- (91.62) FUTURE SPOT ELEVATION
- 91.62 PROPOSED SPOT ELEVATION
- 92.46 EXISTING SPOT ELEVATION (GRID & TC)
- EXISTING CURB & GUTTER
- PROPOSED MOUNTAIN CURB & GUTTER
- PROPOSED STANDARD CURB & GUTTER
- EXISTING CONTOUR W/ INDEX ELEVATION
- FLOW ARROW
- PROPOSED RETAINING WALL
- PROPOSED GARDEN WALL, CONCRETE FILLED TO 1-FOOT DEPTH
- PROPOSED SLOPE
- PROPOSED STORM DRAIN
- PROPOSED STORM DRAIN MANHOLE
- PROPOSED STORM DRAIN INLET
- PROPOSED CATTLE GUARD INLET
- WALL DRAIN


SURVEYOR'S CERTIFICATE
I, THOMAS W. PATRICK, A FULLY QUALIFIED LICENSED PROFESSIONAL SURVEYOR UNDER THE LAWS OF THE STATE OF NEW MEXICO, DO HEREBY CERTIFY THAT THE AS-BUILT INFORMATION SHOWN ON THESE DRAWINGS WAS OBTAINED FROM FIELD CONSTRUCTION AND "AS-BUILT" SURVEYS PERFORMED BY ME, OR UNDER MY SUPERVISION, THAT THE "AS-BUILT" INFORMATION SHOWN ON THESE DRAWINGS (UNLESS OTHERWISE NOTED) WAS ADDED BY ME, OR BY UNDER MY SUPERVISION, AND THAT THIS "AS-BUILT" INFORMATION IS TRUE AND CORRECT TO THE BEST OF MY KNOWLEDGE AND BELIEF. COMPANY SCIENCES CORPORATION IS NOT RESPONSIBLE FOR ANY OF THE DESIGN CONCEPTS, CALCULATIONS, ENGINEERING AND/OR INTENT OF THE RECORD DRAWINGS.

THOMAS W. PATRICK
NEW MEXICO PROFESSIONAL SURVEYOR NO. 12651
DATE 12-17-04

Bohannon & Huston
Court yard | 7500 Jefferson St. NE Albuquerque, NM 87109-4335
ENGINEERING • SPATIAL DATA • ADVANCED TECHNOLOGIES

CITY OF ALBUQUERQUE
PUBLIC WORKS DEPARTMENT
LONGFORD VILLAGE EAST SUBDIVISION
GRADING AND DRAINAGE PLAN

Design Review Committee	City Engineer Approval	Mo./Day/Yr.	Mo./Day/Yr.
For Information Only			
City Project No.	732881	Zone Map No.	L-21-Z
Sheet	4	Of	23

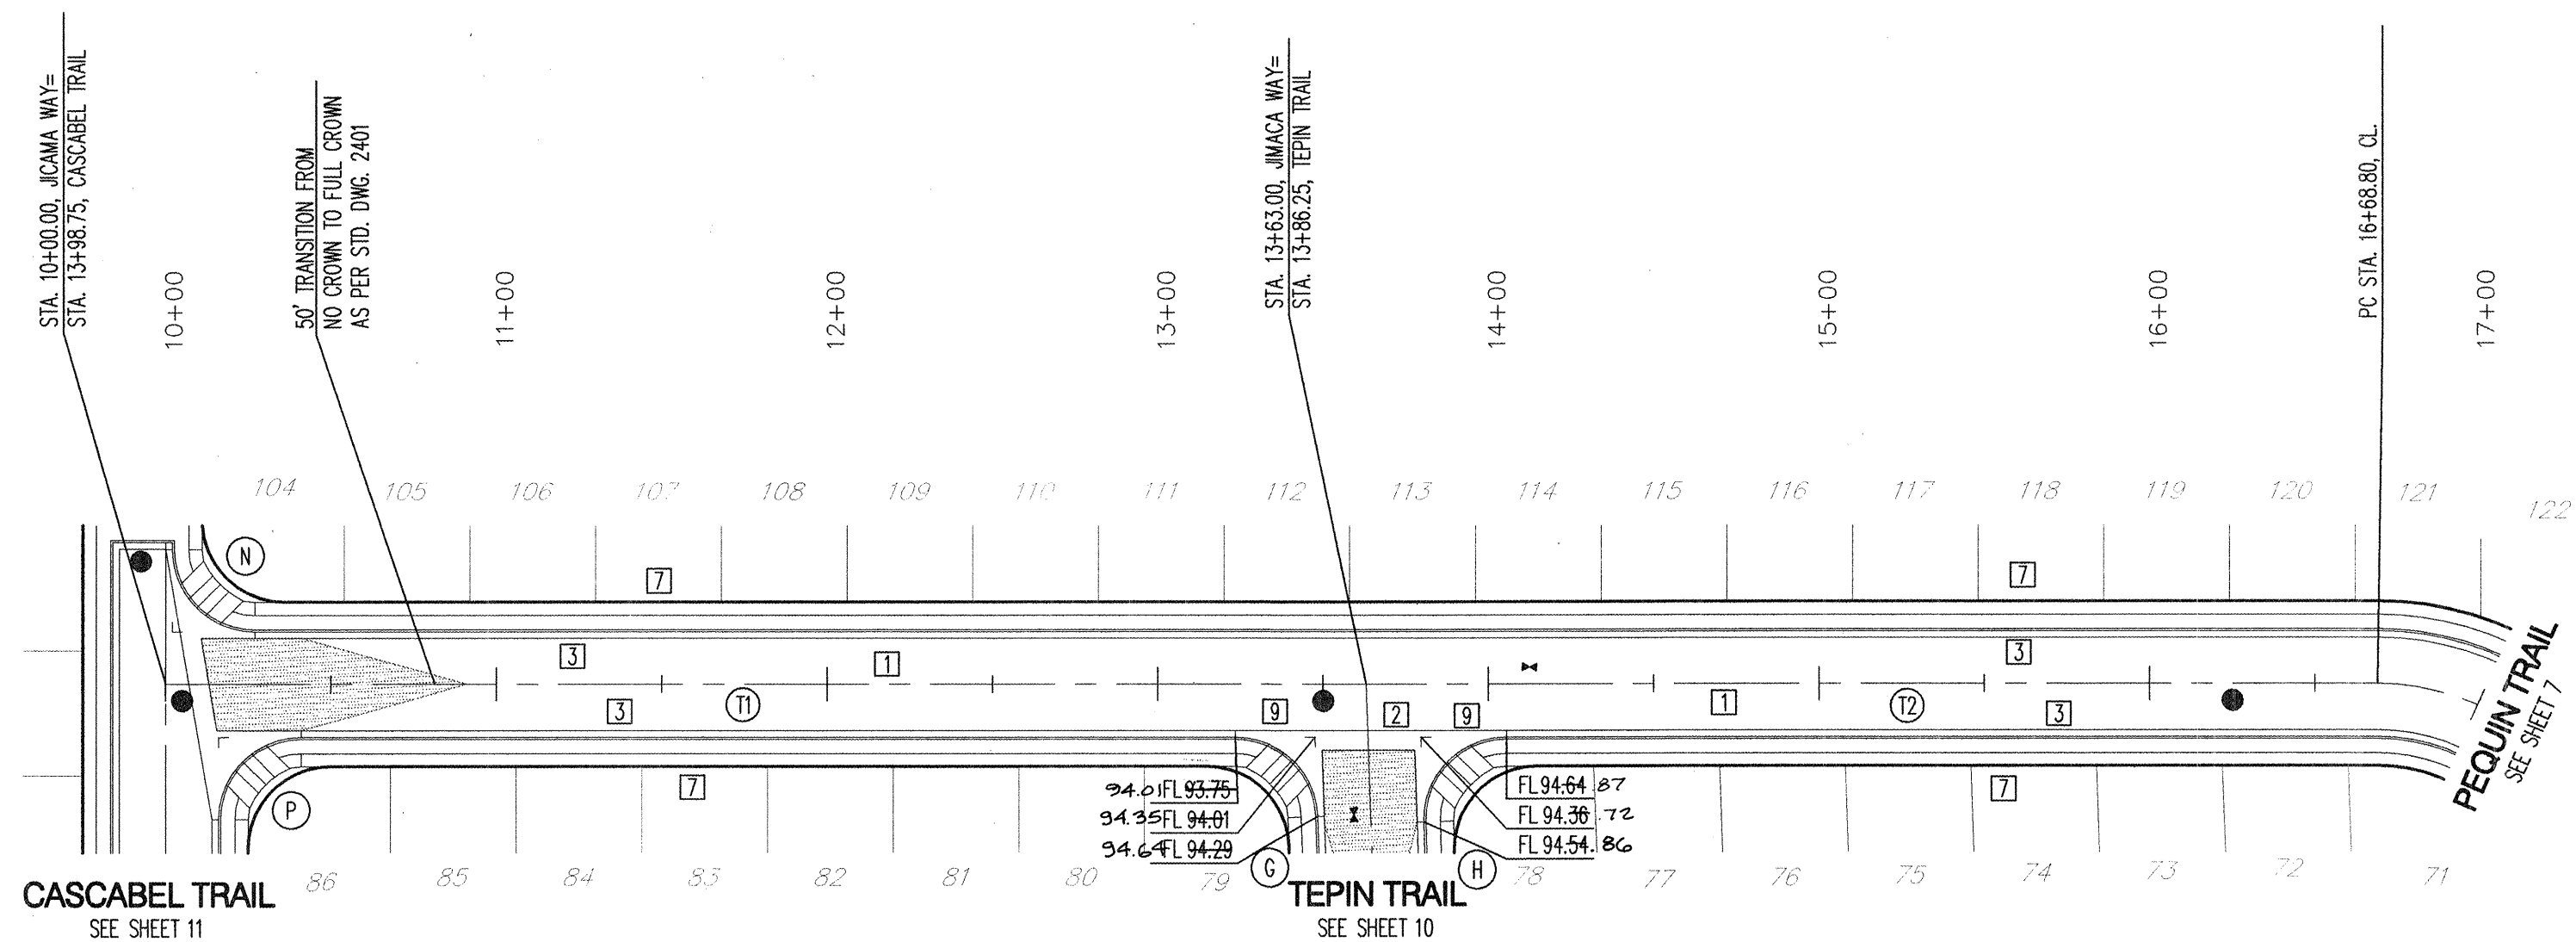

CL Tangent Table		
ID	BEARING	LENGTH
T1	S87°43'34"E	363.00'
T2	S87°43'34"E	305.80'

SEE SHEET 11 FOR
N & P QUARTER
POINT INFORMATION

STA. 13+23.38, 16.00' RT.
PC CURB RETURN

FLOWLINE DATA (G)

PC	93.75	94.01
1	93.88	Δ=88°22'06"
2	94.02	R=25.00'
3	94.15	T=24.16'
PT	94.29	L=38.41'
		Δ=64°4'

STA. 13+48.36, 40.14' RT.
PT CURB RETURN

STA. 13+80.44, 41.86' RT.
PC CURB RETURN

FLOWLINE DATA (H)

PC	94.54	94.85
1	94.57	Δ=91°57'54"
2	94.59	R=25.00'
3	94.62	T=25.87'
PT	94.64	L=40.13'

STA. 14+05.43, 16.00' RT.
PT CURB RETURN

NOTES

1. THE CONTRACTOR SHALL FIELD VERIFY ALL EXISTING UTILITY LOCATIONS AND NOTIFY THE ENGINEER IMMEDIATELY OF ANY DISCREPANCIES.
2. ALL PAVING CURVE DATA AND DIMENSIONS REFER TO FACE OF CURB UNLESS OTHERWISE SPECIFIED.
3. GRADE ELEVATIONS, WHERE NOTED, ARE FOR FLOWLINE OF STANDARD CURB UNLESS OTHERWISE SPECIFIED.
4. CONTRACTOR SHALL PARK EQUIPMENT AND VEHICLES AS NOT TO INTERFERE WITH NORMAL ACTIVITIES OF RESIDENTS OR OTHER CONTRACTORS ON SITE.
5. ANY DAMAGE TO THE EXISTING FACILITIES (CURB & GUTTER, PAVEMENT, CONDUITS, LANDSCAPING, UTILITY LINES, ETC.) DURING CONSTRUCTION SHALL BE REPLACED AT THE CONTRACTORS' EXPENSE.
6. ANY ADDITIONAL GRADING REQUIRED TO MATCH PROPOSED STREET GRADES SHALL BE INCIDENTAL TO PAVING ITEMS.
7. REMOVAL OF THE EXISTING CURB & GUTTER SHALL BE PER C.O.A. STD. DWG. 2415 (SAWCUT ONLY).
8. WHEELCHAIR RAMP SHALL BE CONSTRUCTED PRIOR TO ACCEPTANCE OF CURB AND GUTTER.
9. ALL EXCAVATION, TRENCHING AND SHORING ACTIVITIES MUST BE CARRIED-OUT IN ACCORDANCE WITH OSHA 29 CFR 1926.650 SUBPART B.
10. CONTRACTOR SHALL FIELD VERIFY ALL EXISTING UTILITIES AND TRANSMISSION GAS LINES. CONTRACTOR SHALL COORDINATE RELOCATION OF UTILITY LINES WITH UTILITY COMPANIES AS REQUIRED.
11. CONTRACTOR IS RESPONSIBLE FOR REPAIR AND/OR REPLACEMENT OF ALL UTILITY CONDUITS AND EXISTING LINES.
12. CONTRACTOR IS TO INSTALL A 4" X 4" X 5' POST AND END AT THE END OF EACH SANITARY SEWER SERVICE.
13. CONTRACTOR SHALL PROVIDE THE INSPECTORS (CITY AND PRIVATE) WITH THE PROPOSED HYDROSTATIC TESTING PLAN. THE PLAN MUST BE APPROVED BEFORE TESTING OPERATIONS BEGIN.
14. MH RIMS AND CATCH BASIN INLET ELEVATIONS, VALVE BOXES, ARV, FIRE HYDRANT & FLANGE ELEVATIONS ARE APPROXIMATE. CONTRACTOR SHALL FIELD VERIFY AND ADJUST TO FINAL PAVEMENT GRADES.
15. SAS STATIONING FOLLOWS CL OF ROAD UNLESS OTHERWISE NOTED.
16. STATIONING OF DROP INLET IS TO MIDDLE OF DOWN HILL GRATE AT FACE OF CURB.
17. FLOWLINE ELEVATIONS FOR DROP DROP INLETS ARE PROJECTED FROM FLOWLINE OF STANDARD CURB TO MIDDLE OF DOWNHILL GRATE.
18. FOR STORM DRAIN CONSTRUCTION: ALL RCP JOINTS SHALL BE GROUTED PRIOR TO FINAL INSPECTION. FINAL INSPECTION SHALL DETERMINE WHICH JOINTS ARE TO BE GROUTED FOR FINAL ACCEPTANCE OF THE CONSTRUCTION.
19. ALL UTILITY CURVE DATA AND DIMENSIONS ARE CALCULATED FROM CENTERLINE OF PIPE OR MANHOLE. ALL SAS & SD SLOPES ARE CALCULATED TO TRUE PIPE DIMENSIONS FROM INVERT TO INVERT. (PAY ITEMS ARE SHOWN IN PARENTHESES.)
20. DENOTES CROWN TRANSITION PER C.O.A. STD. DWG. 2401.

ELEVATIONS ARE IN NGVD 29

KEYED NOTES

- 1 BUILD RESIDENTIAL PAVEMENT PER RESIDENTIAL SECTION, SHEETS 5 AND 22.
 - 2 INSTALL 6" CONCRETE VALLEY GUTTER PER COA STD. DWG. 2420.
 - 3 BUILD STD. CURB & GUTTER PER COA STD. DWG. 2415A.
 - * 4 BUILD MEDIAN TYPE CURB AND GUTTER PER COA STD. DWG. 2415B.
 - * 5 BUILD ROLL TYPE CURB & GUTTER PER COA STD. DWG. 2415A.
 - * 6 BUILD 4' SIDEWALK PER COA STD. DWG. 2430.
 - 7 4' SIDEWALK, DEFERRED.
 - * 8 NO SIDEWALK ON THIS SIDE, WAIVED.
 - 9 INSTALL SPECIAL HANDICAP RAMP PER CASE II SHEET 22.
 - * 10 INSTALL MODIFIED HANDICAP RAMP 'A' PER DETAIL SHEET 22.
 - * 11 INSTALL MODIFIED HANDICAP RAMP 'B' PER DETAIL SHEET 22.
 - * 12 INSTALL PARKING BUMPERS
 - * 13 INSTALL 28" WIDE DRIVEPAD PER COA STD. DWG. 2425
 - * 14 INSTALL ALLEY PAVEMENT PER ALLEY SECTION, SHEET 22.
- * NOT USED THIS SHEET.

1 2 3 4 5 6 7 8 9 10 11 12 13 14 15
26 7338 81 0605

Bohannon & Huston
Courtney I 7600 Jefferson St. NE Albuquerque, NM 87109-4336
ENGINEERING • SPATIAL DATA • ADVANCED TECHNOLOGIES



CITY OF ALBUQUERQUE
PUBLIC WORKS DEPARTMENT

LONGFORD VILLAGE EAST SUBDIVISION
PAVING PLAN AND PROFILE
JICAMA WAY STA. 10+00.00 - 17+00.00

Design Review Committee

City Engineer Approval

Mo./Day/Yr.

Mo./Day/Yr.

APPROVED
APR 19 2004
DESIGN REVIEW COMMITTEE

APPROVED
MAY 28 2004
CITY ENGINEER

Last Design Update

City Project No.

Zone Map No.

Sheet


Of

732881


L-21-Z

6

23

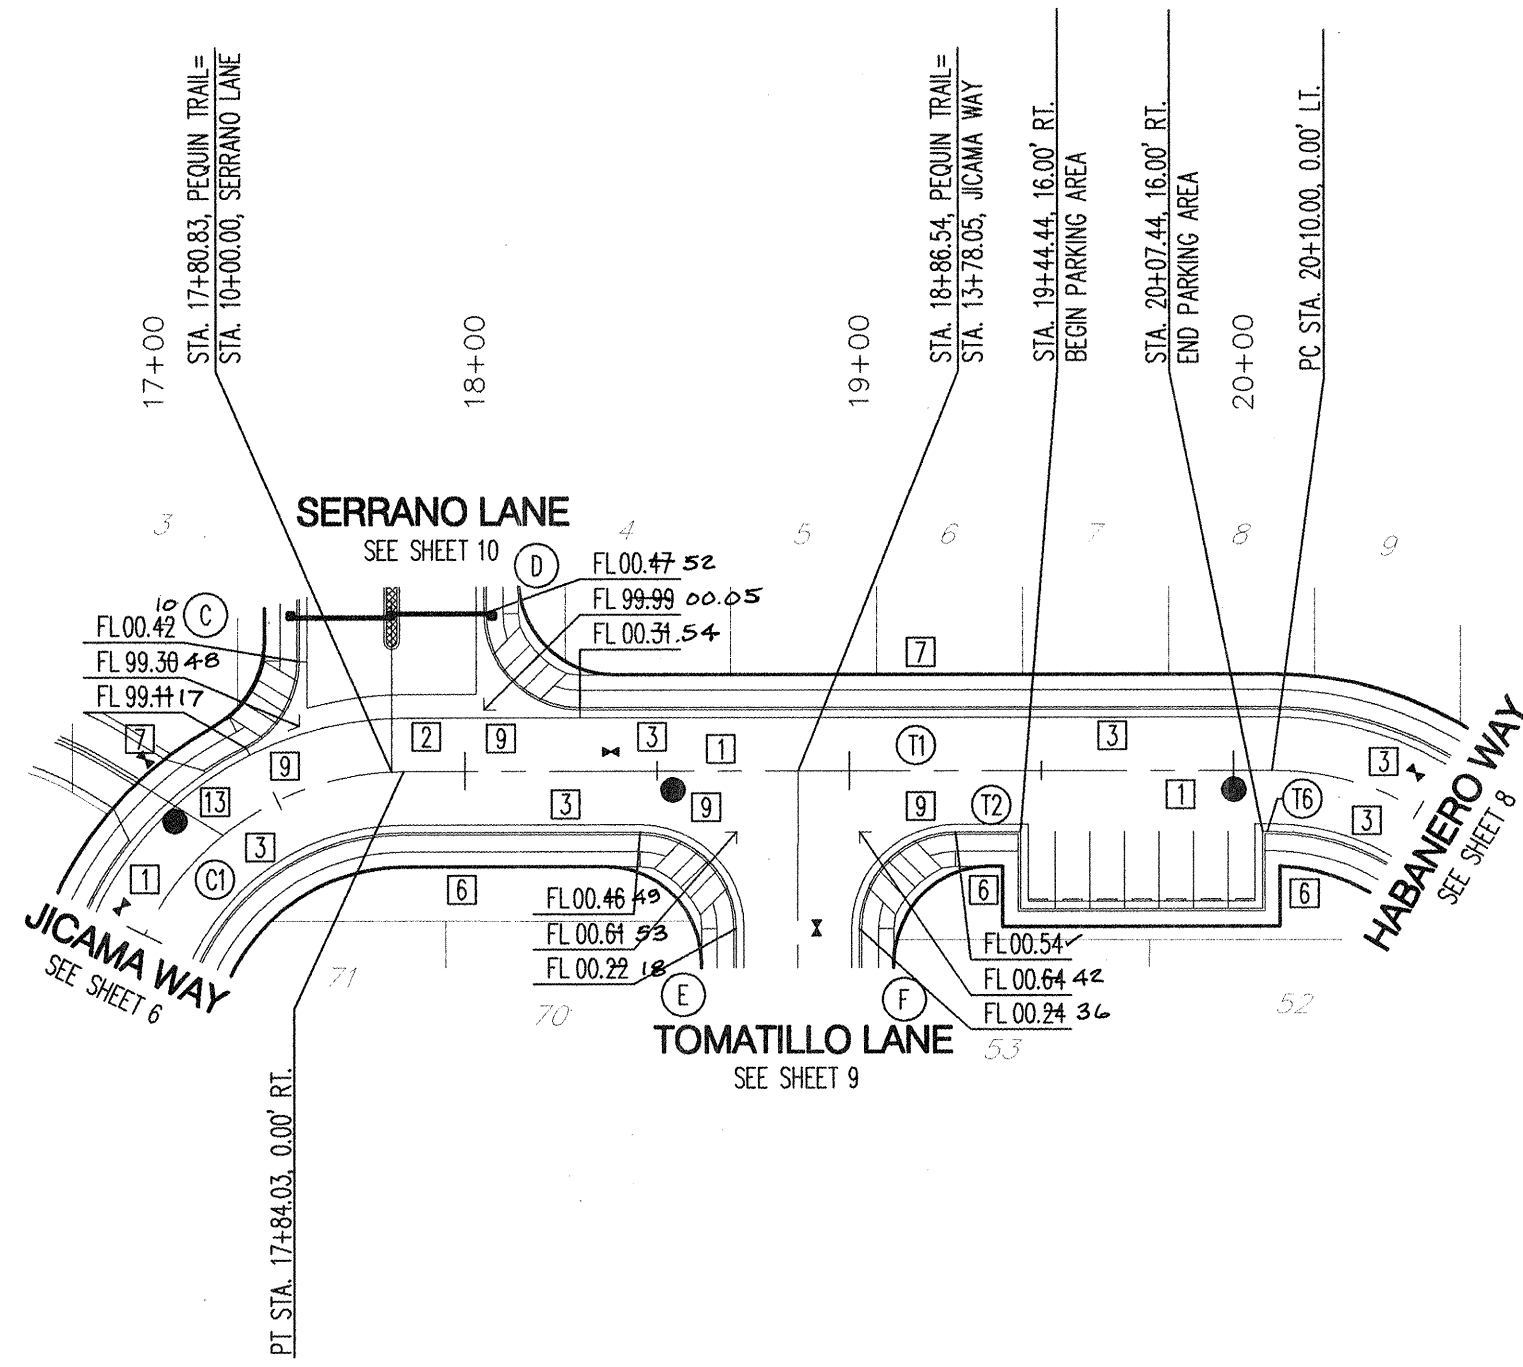

CL Curve Table					Curb Tangent Table			Point Table		
ID	ARC	RADIUS	DELTA	TANGENT	ID	BEARING	LENGTH	ID	STATION	ELEVATION
C1	115.24'	75.00'	88°02'06"	72.47'	T1	S00°18'32"W	225.97'	1	19+44.44	16.00' RT.
					T2	S88°41'28"E	20.00'	2	19+44.44	36.00' RT.
					T3	N00°18'32"E	63.00'	3	20+07.44	36.00' RT.
					T4	S89°41'28"E	20.00'	4	20+07.44	16.00' RT.
					T5	S00°18'32"W	2.56'			

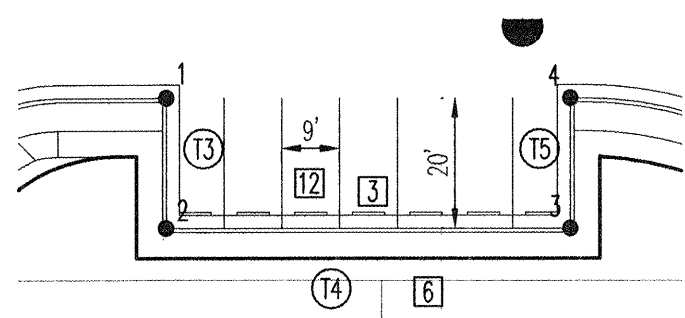

PEQUIN TRAIL

ELEVATIONS ARE IN NGVD 29

KEYED NOTES

- BUILD RESIDENTIAL PAVEMENT PER RESIDENTIAL SECTION, SHEETS 5 AND 22.
 - INSTALL 6" CONCRETE VALLEY GUTTER PER COA STD. DWG. 2420.
 - BUILD STD. CURB & GUTTER PER COA STD. DWG. 2415A.
 - BUILD MEDIAN TYPE CURB AND GUTTER PER COA STD. DWG. 2415B.
 - BUILD ROLL TYPE CURB & GUTTER PER COA STD. DWG. 2415A.
 - BUILD 4' SIDEWALK PER COA STD. DWG. 2430.
 - 4' SIDEWALK, DEFERRED.
 - NO SIDEWALK ON THIS SIDE, WAIVED.
 - INSTALL SPECIAL HANDICAP RAMP PER CASE II SHEET 22.
 - INSTALL MODIFIED HANDICAP RAMP 'A' PER DETAIL SHEET 22.
 - INSTALL MODIFIED HANDICAP RAMP 'B' PER DETAIL SHEET 22.
 - INSTALL PARKING BUMPERS
 - INSTALL 22" WIDE DRIVEPAD PER COA STD. DWG. 2425
 - INSTALL ALLEY PAVEMENT PER ALLEY SECTION, SHEET 22.
- * NOT USED THIS SHEET.

5540

5530

5520

5510


5500

5490

5480

5470

5460

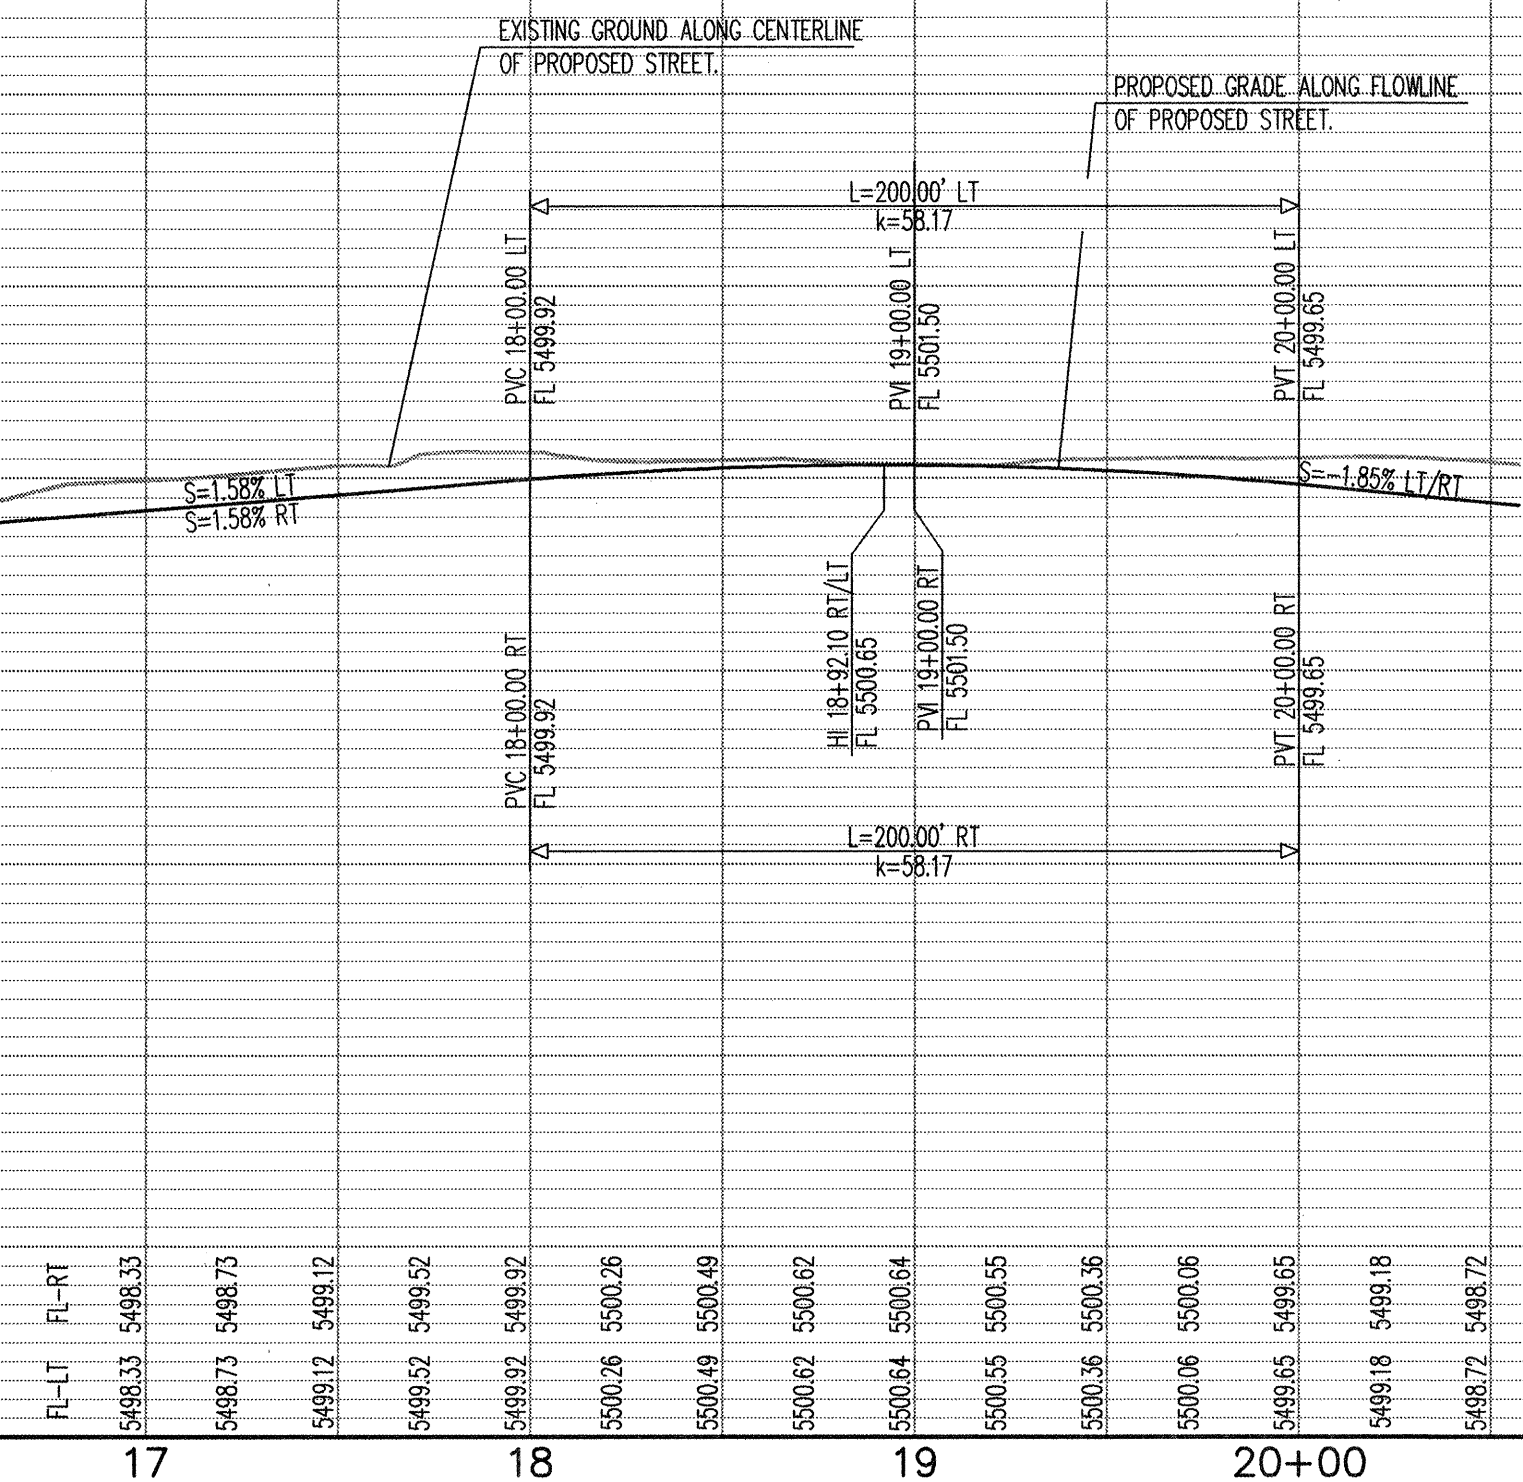

NOTES

- THE CONTRACTOR SHALL FIELD VERIFY ALL EXISTING UTILITY LOCATIONS AND NOTIFY THE ENGINEER IMMEDIATELY OF ANY DISCREPANCIES.
- ALL PAVING CURVE DATA AND DIMENSIONS REFER TO FACE OF CURB UNLESS OTHERWISE SPECIFIED.
- GRADE ELEVATIONS, WHERE NOTED, ARE FOR FLOWLINE OF STANDARD CURB UNLESS OTHERWISE SPECIFIED.
- CONTRACTOR SHALL PARK EQUIPMENT AND VEHICLES AS NOT TO INTERFERE WITH NORMAL ACTIVITIES OF RESIDENTS OR OTHER CONTRACTORS ON SITE.
- ANY DAMAGE TO THE EXISTING FACILITIES (CURB & GUTTER, PAVEMENT, CONDUITS, LANDSCAPING, UTILITY LINES, ETC.) DURING CONSTRUCTION SHALL BE REPLACED AT THE CONTRACTORS' EXPENSE.
- ANY ADDITIONAL GRADING REQUIRED TO MATCH PROPOSED STREET GRADES SHALL BE INCIDENTAL TO PAVING ITEMS.
- REMOVAL OF THE EXISTING CURB & GUTTER SHALL BE PER C.O.A. STD. DWG. 2415 (SAW CUT ONLY).
- WHEELCHAIR RAMPS SHALL BE CONSTRUCTED PRIOR TO ACCEPTANCE OF CURB AND GUTTER.
- ALL EXCAVATION, TRENCHING AND SHORING ACTIVITIES MUST BE CARRIED-OUT IN ACCORDANCE WITH OSHA 29 CFR 1926.650 SUBPART B.
- CONTRACTOR SHALL FIELD VERIFY ALL EXISTING UTILITIES AND TRANSMISSION GAS LINES. CONTRACTOR SHALL COORDINATE RELOCATION OF UTILITY LINES WITH UTILITY COMPANIES AS REQUIRED.
- CONTRACTOR IS RESPONSIBLE FOR REPAIR AND/OR REPLACEMENT OF ALL UTILITY CONDUITS AND EXISTING LINES.
- CONTRACTOR IS TO INSTALL A 4" X 4" X 5' POST AND END AT THE END OF EACH SANITARY SEWER SERVICE.
- CONTRACTOR SHALL PROVIDE THE INSPECTORS (CITY AND PRIVATE) WITH THE PROPOSED HYDROSTATIC TESTING PLAN. THE PLAN MUST BE APPROVED BEFORE TESTING OPERATIONS BEGIN.
- MH RIMS AND CATCH BASIN INLET ELEVATIONS, VALVE BOXES, ARV, FIRE HYDRANT & FLANGE ELEVATIONS ARE APPROXIMATE. CONTRACTOR SHALL FIELD VERIFY AND ADJUST TO FINAL PAVEMENT GRADES.
- SAS STATIONING FOLLOWS CL OF ROAD UNLESS OTHERWISE NOTED.
- STATIONING OF DROP INLET IS TO MIDDLE OF DOWN HILL GRATE AT FACE OF CURB.
- FLOWLINE ELEVATIONS FOR DROP DROP INLETS ARE PROJECTED FROM FLOWLINE OF STANDARD CURB TO MIDDLE OF DOWNHILL GRATE.
- FOR STORM DRAIN CONSTRUCTION: ALL RCP JOINTS SHALL BE GROUTED PRIOR TO FINAL INSPECTION. FINAL INSPECTION SHALL DETERMINE WHICH JOINTS ARE TO BE GROUTED FOR FINAL ACCEPTANCE OF THE CONSTRUCTION.
- ALL UTILITY CURVE DATA AND DIMENSIONS ARE CALCULATED FROM CENTERLINE OF PIPE OR MANHOLE. ALL SAS & SD SLOPES ARE CALCULATED TO TRUE PIPE DIMENSIONS FROM INVERT TO INVERT. (PAY ITEMS ARE SHOWN IN PARENTHESES.)
20. [Symbol] DENOTES CROWN TRANSITION PER C.O.A. STD. DWG. 2401.

1 2 3 4 5 6 7 8 9 10 11 12 13 14 15 16 17 18 19 20

Bohannon & Huston
Courtney I 7800 Jefferson St NE Albuquerque, NM 87109-4336
ENGINEERING • SPATIAL DATA • ADVANCED TECHNOLOGIES



CITY OF ALBUQUERQUE
PUBLIC WORKS DEPARTMENT

LONGFORD VILLAGE EAST SUBDIVISION
PAVING PLAN AND PROFILE
PEQUIN TRAIL STA. 17+00.00 - 20+50.00

Design Review Committee City Engineer Approval
APR 19 2004 APR 28 2004
DESIGN REVIEW COMMITTEE CITY ENGINEER

City Project No. 732881 Zone Map No. L-21-Z

AS-BUILT INFORMATION		BENCH MARKS		SURVEY INFORMATION		ENGINEER'S SEAL	
CONTRACTOR	DATE	WORK	DATE	NO.	BY	REMARKS	By
Hydro Submittal	4/19/04	ACS BRASS TABLE STAMPED "6-121", 1986"	4/19/04				
STAMPED BY	DATE	Geographic Position (NAD 1983)	DATE				
ACCEPTANCE BY	DATE	N.M. State Plane Coordinates (Central Zone)	DATE				
FIELD INSPECTION BY	DATE	X = 1,558,220.88 Y = 1,481,283.33	DATE				
REVISIONS	DATE	Ground-to-Grid Factor = 0.999644584	DATE				
CORRECTED BY	DATE	Δα = -00°09'28"	DATE				
RECORDED BY	DATE	NAVD88 Elevation = 5503.35	DATE				
NO.							

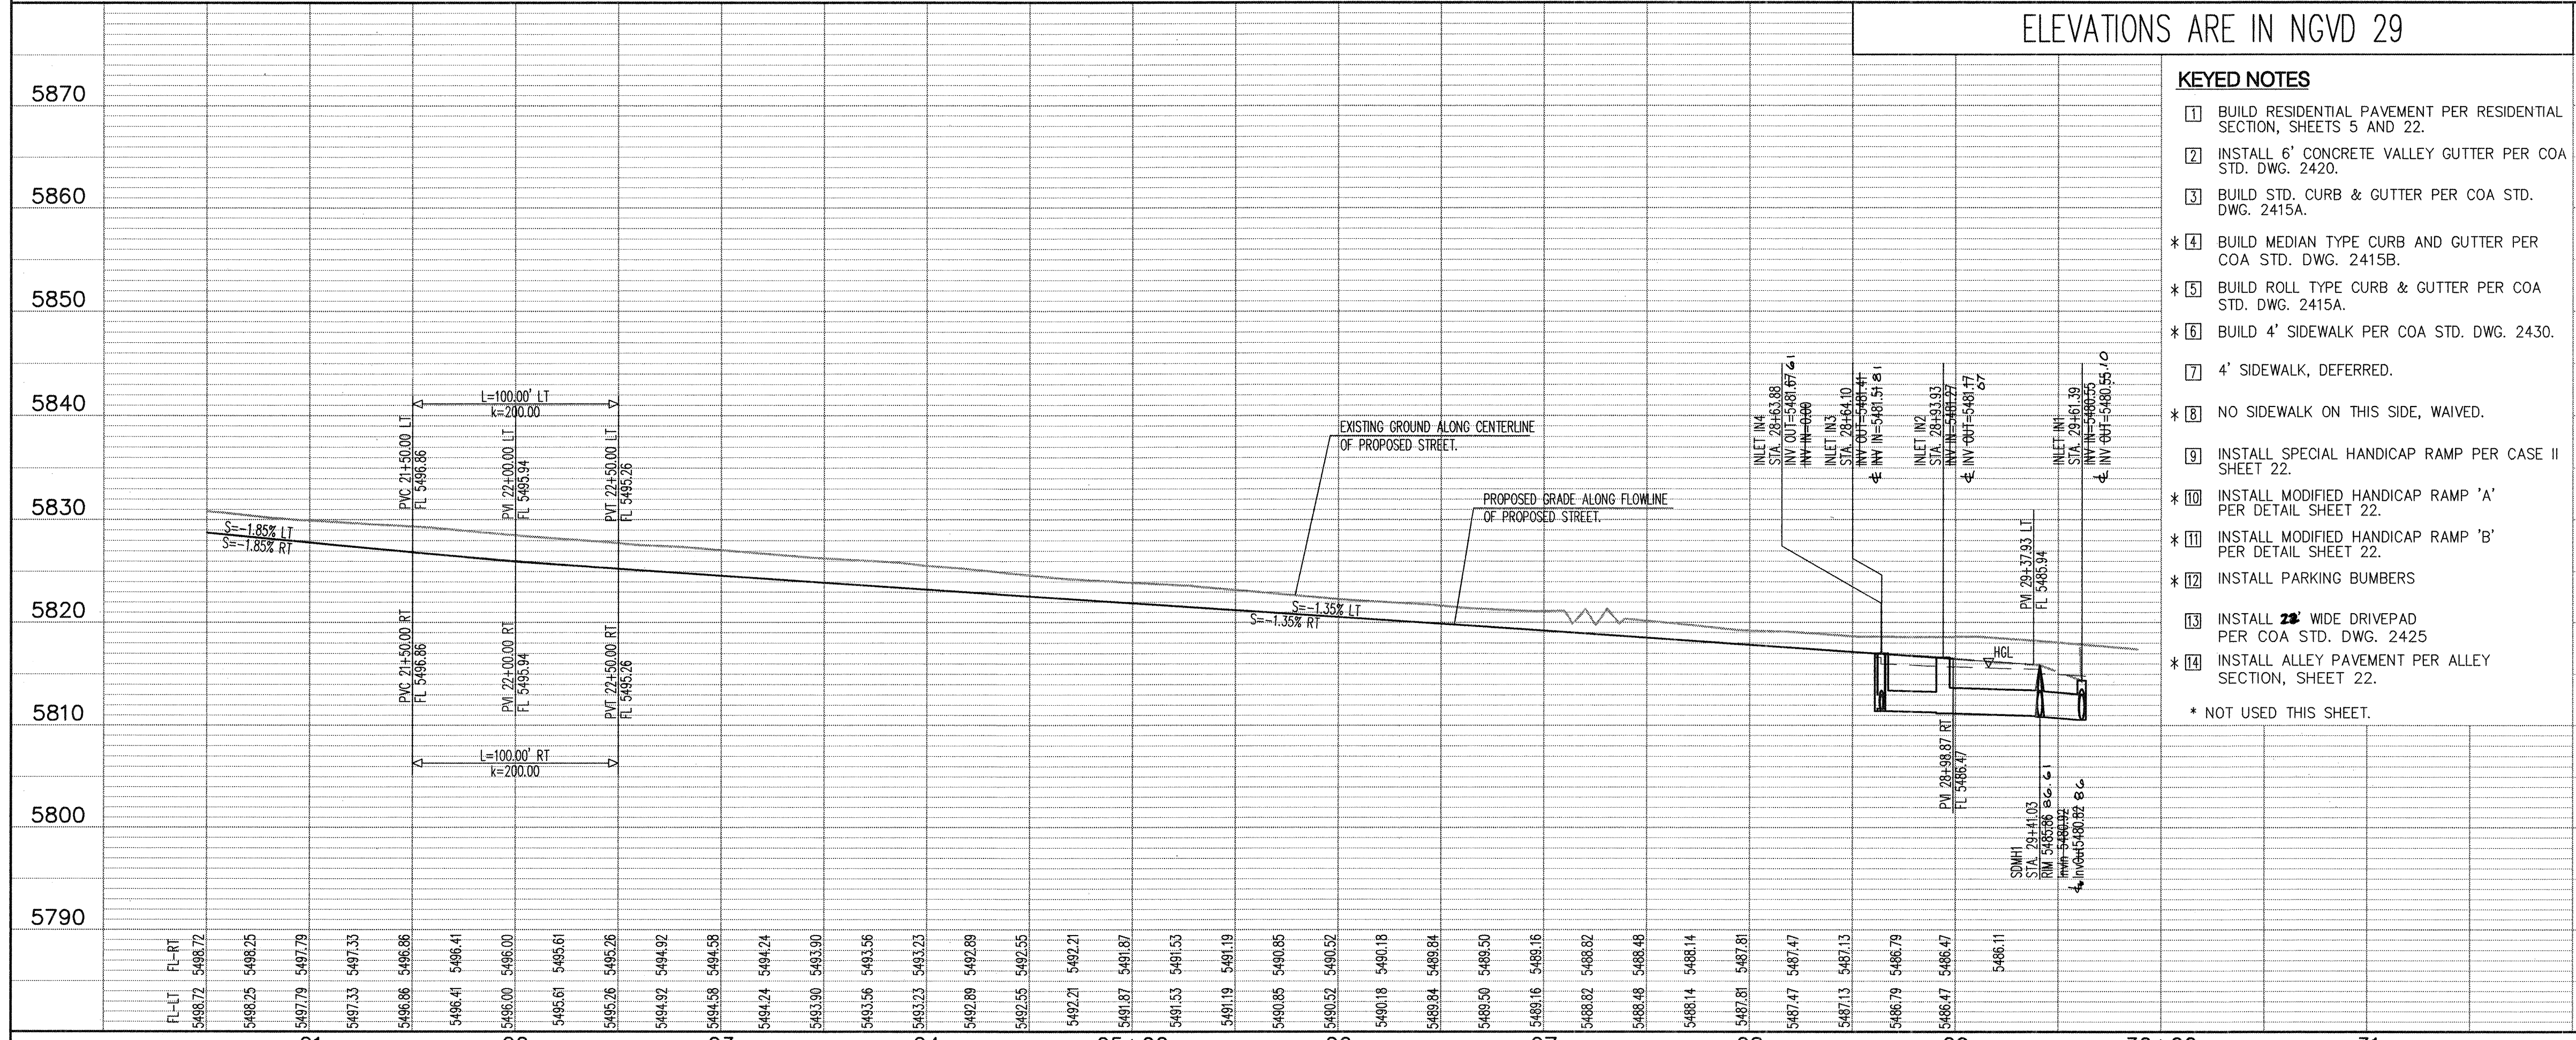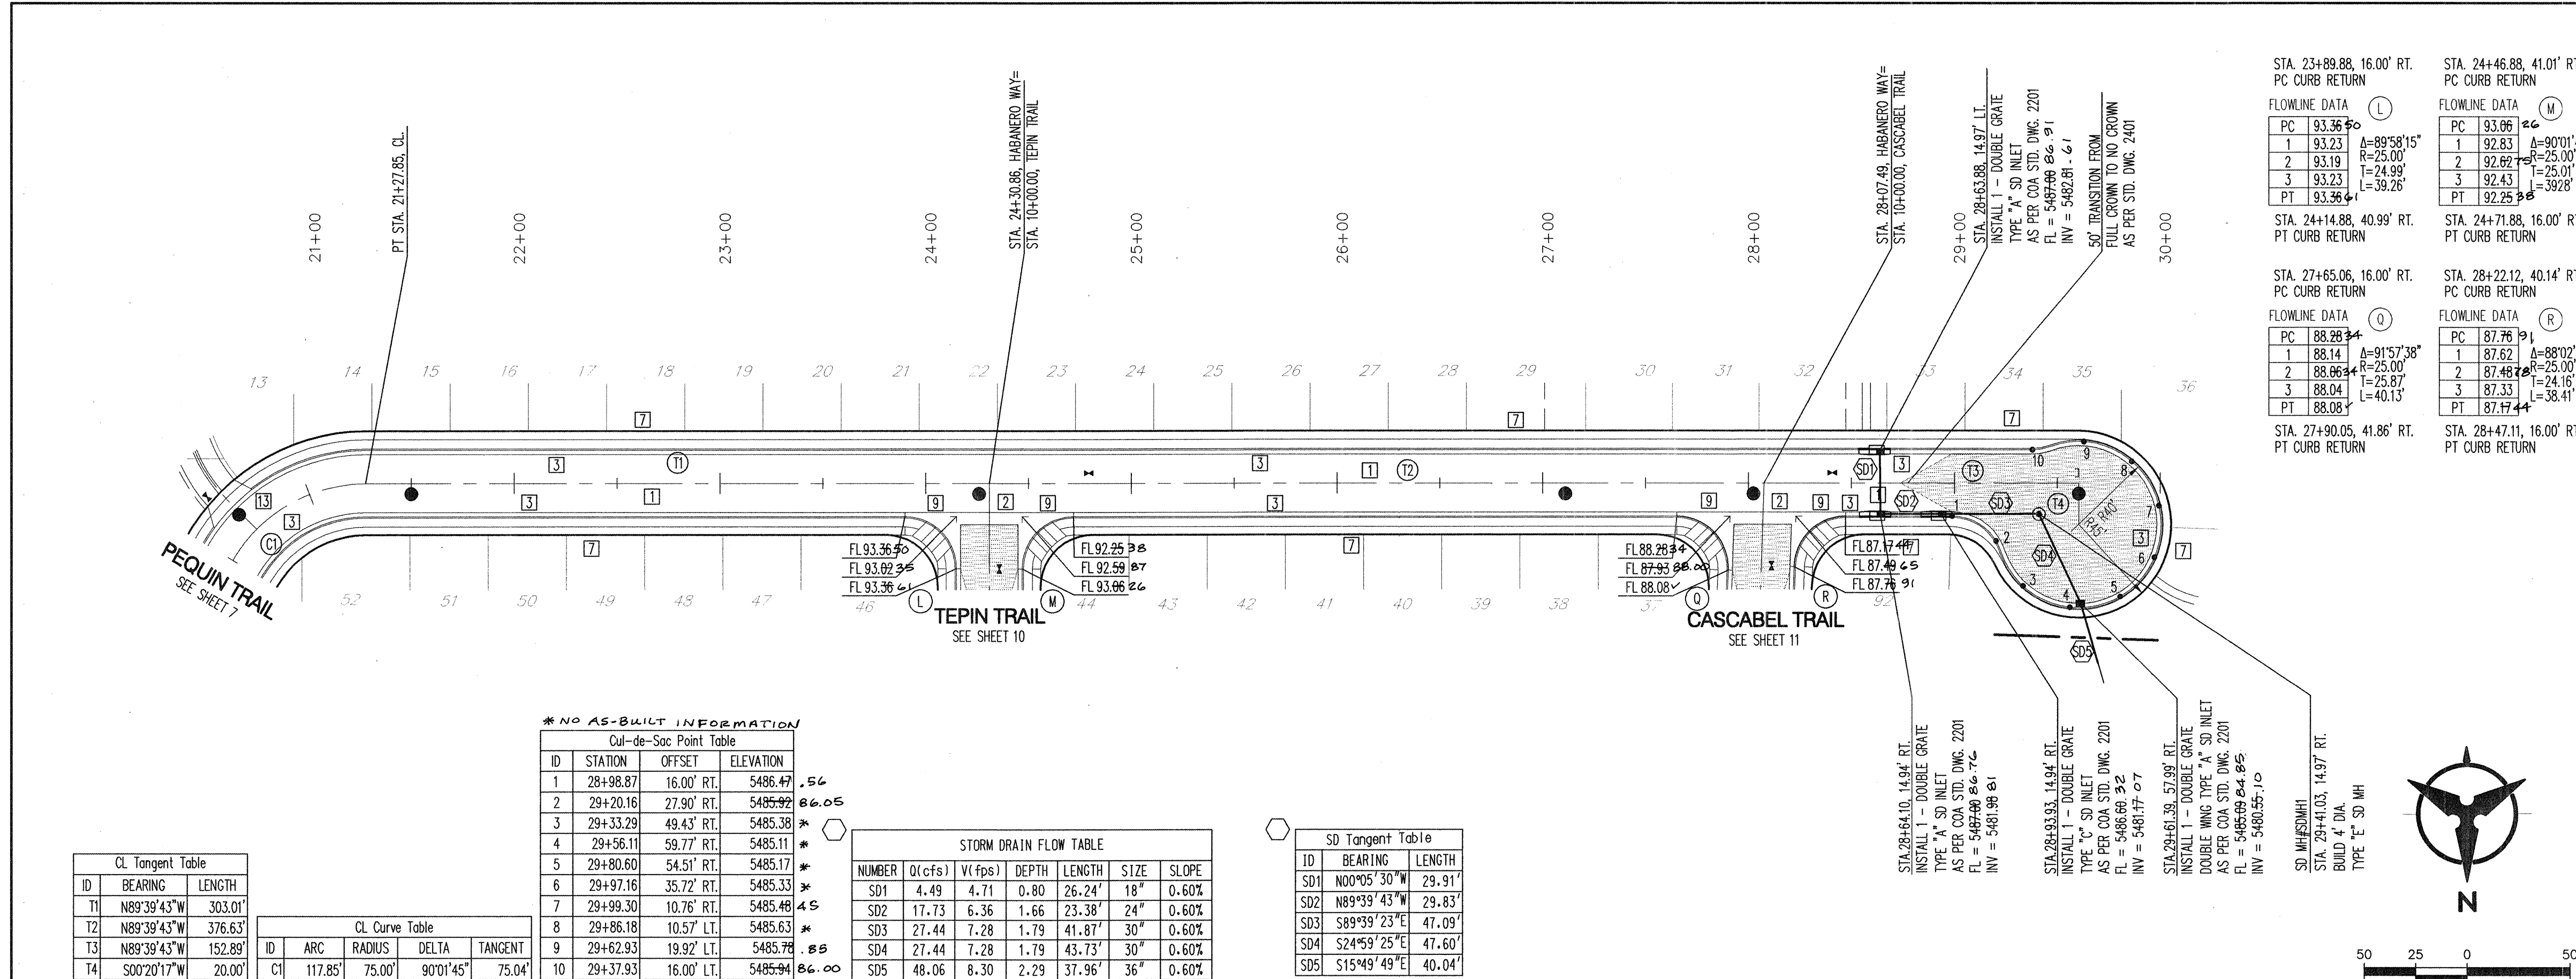

- NOTES**
1. THE CONTRACTOR SHALL FIELD VERIFY ALL EXISTING UTILITY LOCATIONS AND NOTIFY THE ENGINEER IMMEDIATELY OF ANY DISCREPANCIES.
 2. ALL PAVING CURVE DATA AND DIMENSIONS REFER TO FACE OF CURB UNLESS OTHERWISE SPECIFIED.
 3. GRADE ELEVATIONS, WHERE NOTED, ARE FOR FLOWLINE OF STANDARD CURB UNLESS OTHERWISE SPECIFIED.
 4. CONTRACTOR SHALL PARK EQUIPMENT AND VEHICLES AS NOT TO INTERFERE WITH NORMAL ACTIVITIES OF RESIDENTS OR OTHER CONTRACTORS ON SITE.
 5. ANY DAMAGE TO THE EXISTING FACILITIES (CURB & GUTTER, PAVEMENT, CONDUITS, LANDSCAPING, UTILITY LINES, ETC.) DURING CONSTRUCTION SHALL BE REPLACED AT THE CONTRACTORS' EXPENSE.
 6. ANY ADDITIONAL GRADING REQUIRED TO MATCH PROPOSED STREET GRADES SHALL BE INCIDENTAL TO PAVING ITEMS.
 7. REMOVAL OF THE EXISTING CURB & GUTTER SHALL BE PER C.O.A. STD. DWG. 2415 (SAW CUT ONLY).
 8. WHEELCHAIR RAMPS SHALL BE CONSTRUCTED PRIOR TO ACCEPTANCE OF CURB AND GUTTER.
 9. ALL EXCAVATION, TRENCHING AND SHORING ACTIVITIES MUST BE CARRIED-OUT IN ACCORDANCE WITH OSHA 29 CFR 1926.650 SUBPART B.
 10. CONTRACTOR SHALL FIELD VERIFY ALL EXISTING UTILITIES AND TRANSMISSION GAS LINES. CONTRACTOR SHALL COORDINATE RELOCATION OF UTILITY LINES WITH UTILITY COMPANIES AS REQUIRED.
 11. CONTRACTOR IS RESPONSIBLE FOR REPAIR AND/OR REPLACEMENT OF ALL UTILITY CONDUITS AND EXISTING LINES.
 12. CONTRACTOR IS TO INSTALL A 4" X 4" X 5' POST AND END AT THE END OF EACH SANITARY SEWER SERVICE.
 13. CONTRACTOR SHALL PROVIDE THE INSPECTORS (CITY AND PRIVATE) WITH THE PROPOSED HYDROSTATIC TESTING PLAN. THE PLAN MUST BE APPROVED BEFORE TESTING OPERATIONS BEGIN.
 14. MAN RIMS AND CATCH BASIN INLET ELEVATIONS, VALVE BOXES, ARV, FIRE HYDRANT & FLANGE ELEVATIONS ARE APPROXIMATE. CONTRACTOR SHALL FIELD VERIFY AND ADJUST TO FINAL PAVEMENT GRADES.
 15. SAS STATIONING FOLLOWS CL OF ROAD UNLESS OTHERWISE NOTED.
 16. STATIONING OF DROP INLET IS TO MIDDLE OF DOWN HILL GRATE AT FACE OF CURB.
 17. FLOWLINE ELEVATIONS FOR DROP DROP INLETS ARE PROJECTED FROM FLOWLINE OF STANDARD CURB TO MIDDLE OF DOWNHILL GRATE.
 18. FOR STORM DRAIN CONSTRUCTION: ALL RCP JOINTS SHALL BE GROUTED PRIOR TO FINAL INSPECTION. FINAL INSPECTION SHALL DETERMINE WHICH JOINTS ARE TO BE GROUTED FOR FINAL ACCEPTANCE OF THE CONSTRUCTION.
 19. ALL UTILITY CURVE DATA AND DIMENSIONS ARE CALCULATED FROM CENTERLINE OF PIPE OR MANHOLE. ALL SAS & SD SLOPES ARE CALCULATED TO TRUE PIPE DIMENSIONS FROM INVERT TO INVERT. (PAY ITEMS ARE SHOWN IN PARENTHESES.)
 20. DENOTES CROWN TRANSITION PER C.O.A. STD. DWG. 2401.

- KEYED NOTES**
- 1 BUILD RESIDENTIAL PAVEMENT PER RESIDENTIAL SECTION, SHEETS 5 AND 22.
 - 2 INSTALL 6" CONCRETE VALLEY GUTTER PER COA STD. DWG. 2420.
 - 3 BUILD STD. CURB & GUTTER PER COA STD. DWG. 2415A.
 - * 4 BUILD MEDIAN TYPE CURB AND GUTTER PER COA STD. DWG. 2415B.
 - * 5 BUILD ROLL TYPE CURB & GUTTER PER COA STD. DWG. 2415A.
 - * 6 BUILD 4' SIDEWALK PER COA STD. DWG. 2430.
 - 7 4' SIDEWALK, DEFERRED.
 - * 8 NO SIDEWALK ON THIS SIDE, WAIVED.
 - 9 INSTALL SPECIAL HANDICAP RAMP PER CASE II SHEET 22.
 - * 10 INSTALL MODIFIED HANDICAP RAMP 'A' PER DETAIL SHEET 22.
 - * 11 INSTALL MODIFIED HANDICAP RAMP 'B' PER DETAIL SHEET 22.
 - * 12 INSTALL PARKING BUMPERS
 - 13 INSTALL 28" WIDE DRIVEPAD PER COA STD. DWG. 2425
 - * 14 INSTALL ALLEY PAVEMENT PER ALLEY SECTION, SHEET 22.
- * NOT USED THIS SHEET.

Bohannon & Huston
Courtney I 7600 Jefferson St. NE Albuquerque, NM 87109-4336
ENGINEERING & SPATIAL DATA & ADVANCED TECHNOLOGIES

CITY OF ALBUQUERQUE
PUBLIC WORKS DEPARTMENT

LONGFORD VILLAGE EAST SUBDIVISION
PAVING PLAN AND PROFILE
HABANERO WAY STA. 20+50.00 - 30+00.00

Design Review Committee
City Engineer Approval
Last Design Update


City Project No. 732881
Zone Map No. L-21-Z
Sheet 8 Of 23

AS-BUILT INFORMATION		BENCH MARKS		SURVEY INFORMATION		ENGINEER'S SEAL	
CONTRACTOR	DATE	WORK	DATE	NO.	BY	REMARKS	By
Hydrex Systems	4/21/00	AS-BUILT	4/21/00				
STATION	DATE	STATION	DATE				
21+00	4/21/00	21+00	4/21/00				
22+00	4/21/00	22+00	4/21/00				
23+00	4/21/00	23+00	4/21/00				
100+00	4/21/00	100+00	4/21/00				

CL Tangent Table		
ID	BEARING	LENGTH
T1	N89°39'43"W	378.05'

SEE SHEET 10 FOR
J & K QUARTER
POINT INFORMATION

SEE SHEET 7 FOR
E & F QUARTER
POINT INFORMATION

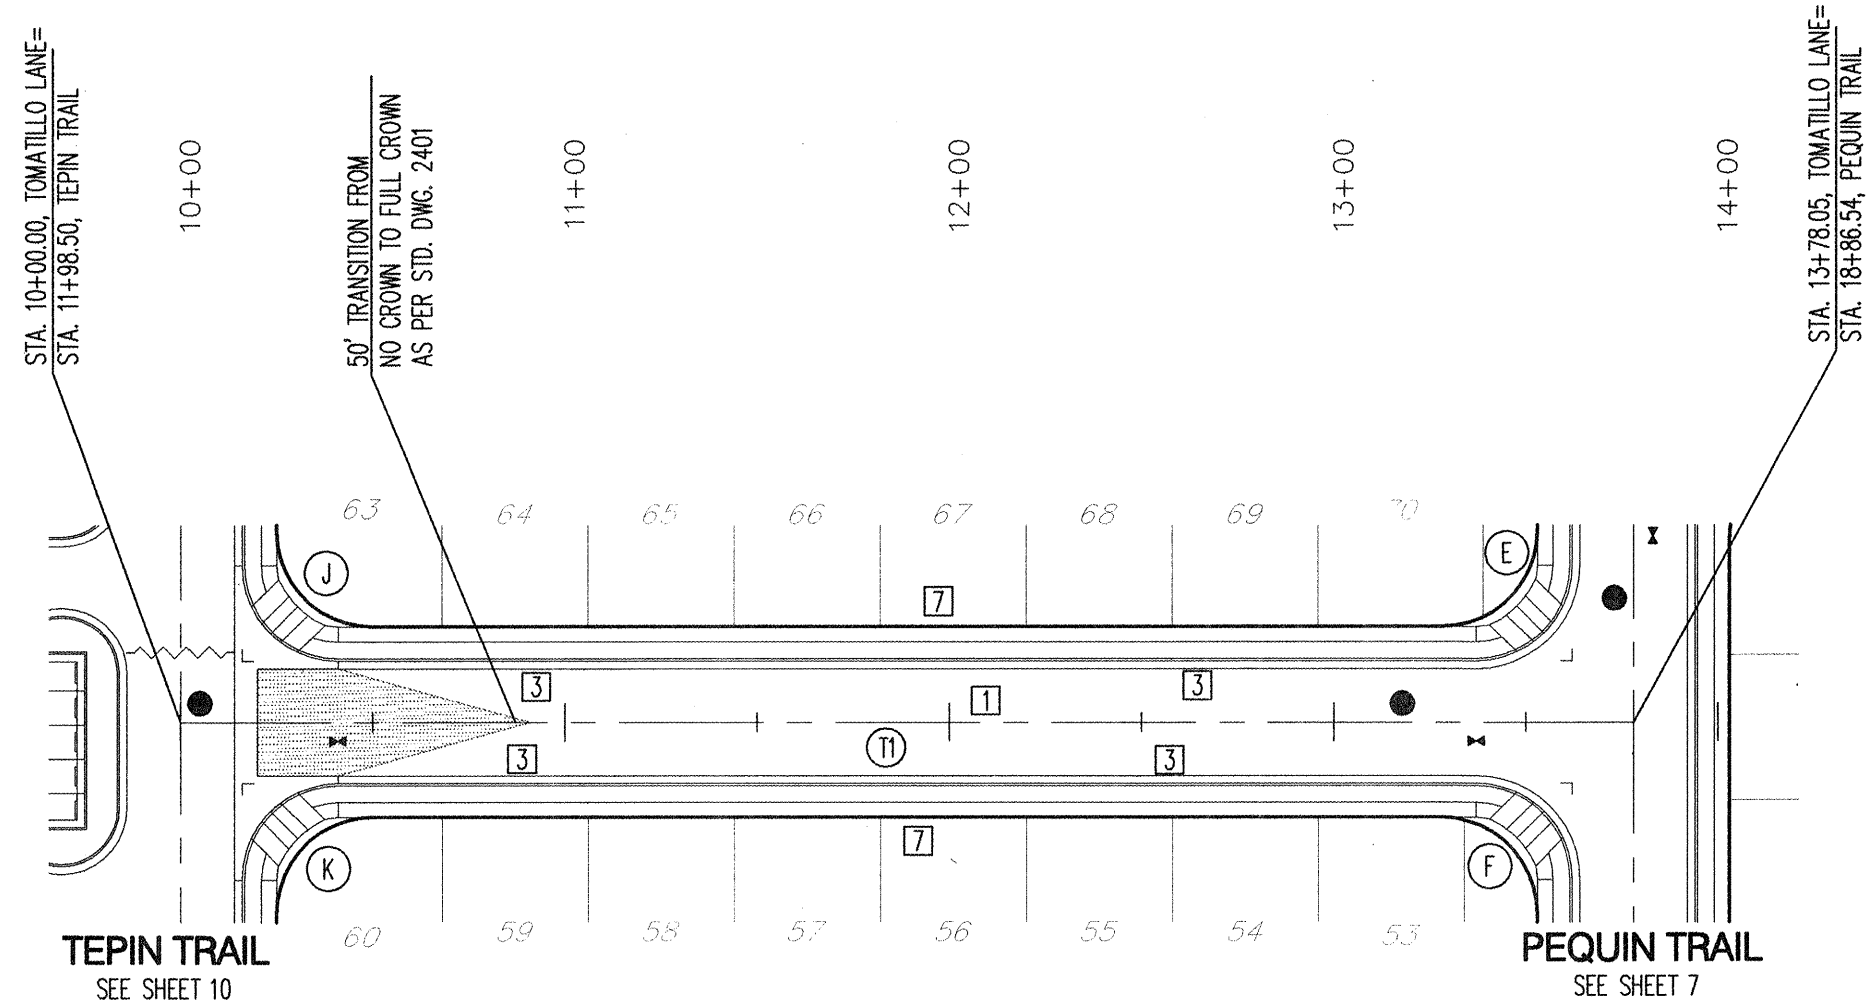


TOMATILLO LANE

ELEVATIONS ARE IN NGVD 29


KEYED NOTES

- 1 BUILD RESIDENTIAL PAVEMENT PER RESIDENTIAL SECTION, SHEETS 5 AND 22.
- *2 INSTALL 6" CONCRETE VALLEY GUTTER PER COA STD. DWG. 2420.
- 3 BUILD STD. CURB & GUTTER PER COA STD. DWG. 2415A.
- *4 BUILD MEDIAN TYPE CURB AND GUTTER PER COA STD. DWG. 2415B.
- *5 BUILD ROLL TYPE CURB & GUTTER PER COA STD. DWG. 2415A.
- *6 BUILD 4' SIDEWALK PER COA STD. DWG. 2430.
- 7 4' SIDEWALK, DEFERRED.
- *8 NO SIDEWALK ON THIS SIDE, WAIVED.
- *9 INSTALL SPECIAL HANDICAP RAMP PER CASE II SHEET 22.
- *10 INSTALL MODIFIED HANDICAP RAMP 'A' PER DETAIL SHEET 22.
- *11 INSTALL MODIFIED HANDICAP RAMP 'B' PER DETAIL SHEET 22.
- *12 INSTALL PARKING BUMPERS
- *13 INSTALL 24" WIDE DRIVEPAD PER COA STD. DWG. 2425
- *14 INSTALL ALLEY PAVEMENT PER ALLEY SECTION, SHEET 22.

* NOT USED THIS SHEET.

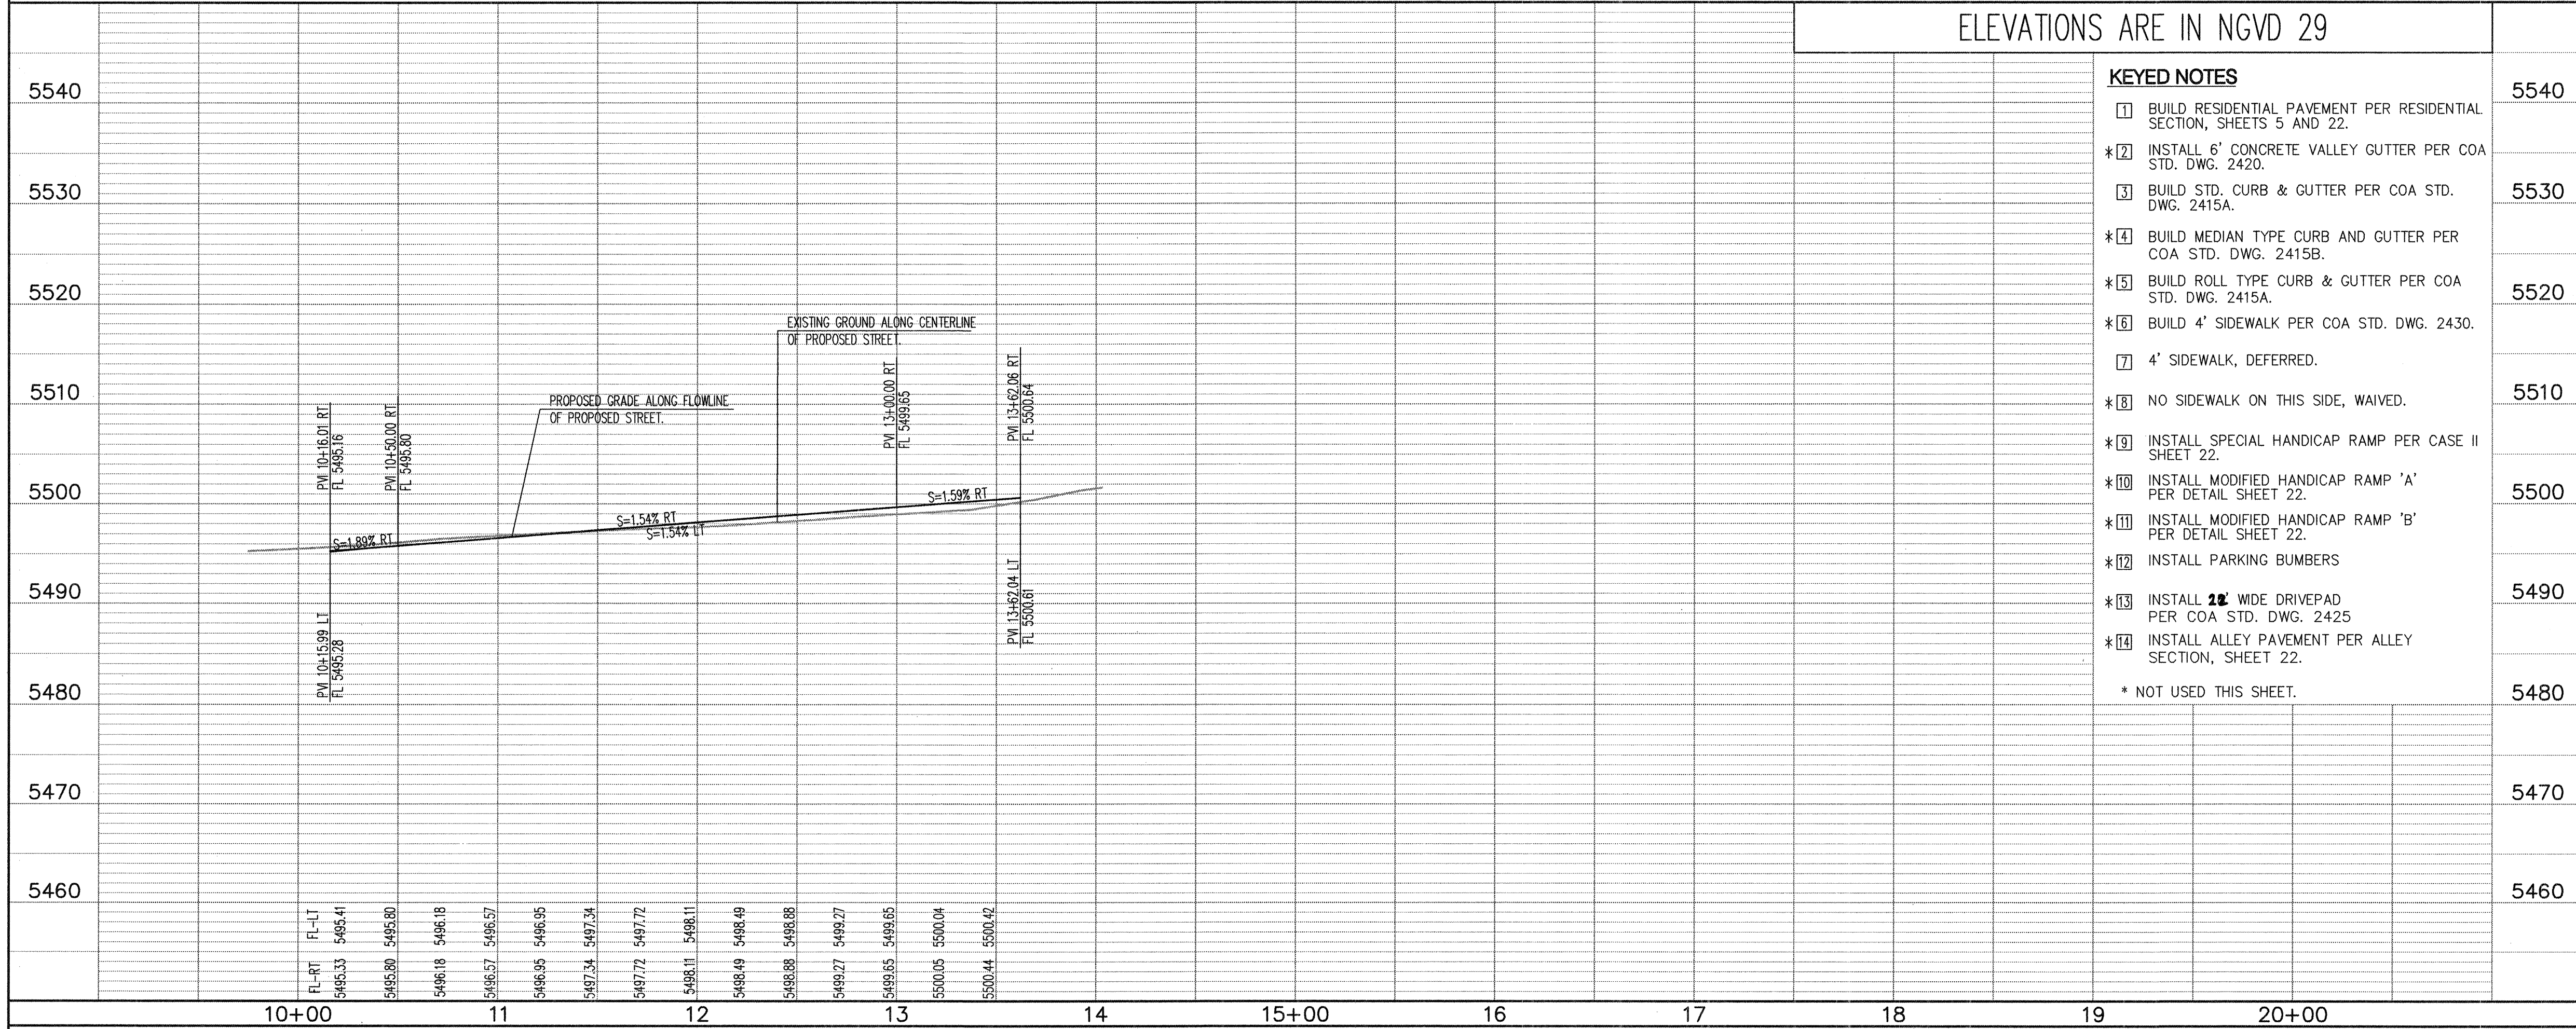


SCALE: 1" = 50' (HORIZ.)
1" = 10' (VERT.)

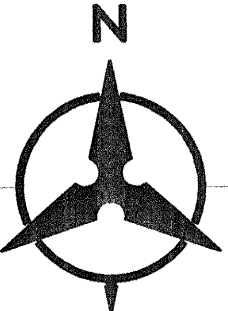

50 25 0 50
1" = 50'

NOTES

1. THE CONTRACTOR SHALL FIELD VERIFY ALL EXISTING UTILITY LOCATIONS AND NOTIFY THE ENGINEER IMMEDIATELY OF ANY DISCREPANCIES.
2. ALL PAVING CURVE DATA AND DIMENSIONS REFER TO FACE OF CURB UNLESS OTHERWISE SPECIFIED.
3. GRADE ELEVATIONS, WHERE NOTED, ARE FOR FLOWLINE OF STANDARD CURB UNLESS OTHERWISE SPECIFIED.
4. CONTRACTOR SHALL PARK EQUIPMENT AND VEHICLES AS NOT TO INTERFERE WITH NORMAL ACTIVITIES OF RESIDENTS OR OTHER CONTRACTORS ON SITE.
5. ANY DAMAGE TO THE EXISTING FACILITIES (CURB & GUTTER, PAVEMENT, CONDUITS, LANDSCAPING, UTILITY LINES, ETC.) DURING CONSTRUCTION SHALL BE REPLACED AT THE CONTRACTORS' EXPENSE.
6. ANY ADDITIONAL GRADING REQUIRED TO MATCH PROPOSED STREET GRADES SHALL BE INCIDENTAL TO PAVING ITEMS.
7. REMOVAL OF THE EXISTING CURB & GUTTER SHALL BE PER C.O.A. STD. DWG. 2415 (SAWCUT ONLY).
8. WHEELCHAIR RAMPS SHALL BE CONSTRUCTED PRIOR TO ACCEPTANCE OF CURB AND GUTTER.
9. ALL EXCAVATION, TRENCHING AND SHORING ACTIVITIES MUST BE CARRIED-OUT IN ACCORDANCE WITH OSHA 29 CFR 1926.650 SUBPART B.
10. CONTRACTOR SHALL FIELD VERIFY ALL EXISTING UTILITIES AND TRANSMISSION GAS LINES. CONTRACTOR SHALL COORDINATE RELOCATION OF UTILITY LINES WITH UTILITY COMPANIES AS REQUIRED.
11. CONTRACTOR IS RESPONSIBLE FOR REPAIR AND/OR REPLACEMENT OF ALL UTILITY CONDUITS AND EXISTING LINES.
12. CONTRACTOR IS TO INSTALL A 4" X 4" X 5' POST AND EMD AT THE END OF EACH SANITARY SEWER SERVICE.
13. CONTRACTOR SHALL PROVIDE THE INSPECTORS (CITY AND PRIVATE) WITH THE PROPOSED HYDROSTATIC TESTING PLAN. THE PLAN MUST BE APPROVED BEFORE TESTING OPERATIONS BEGIN.
14. MH RIMS AND CATCH BASIN INLET ELEVATIONS, VALVE BOXES, ARV, FIRE HYDRANT & FLANGE ELEVATIONS ARE APPROXIMATE. CONTRACTOR SHALL FIELD VERIFY AND ADJUST TO FINAL PAVEMENT GRADES.
15. SAS STATIONING FOLLOWS CL OF ROAD UNLESS OTHERWISE NOTED.
16. STATIONING OF DROP INLET IS TO MIDDLE OF DOWN HILL GRATE AT FACE OF CURB.
17. FLOWLINE ELEVATIONS FOR DROP DROP INLETS ARE PROJECTED FROM FLOWLINE OF STANDARD CURB TO MIDDLE OF DOWNHILL GRATE.
18. FOR STORM DRAIN CONSTRUCTION: ALL RCP JOINTS SHALL BE GROUTED PRIOR TO FINAL INSPECTION. FINAL INSPECTION SHALL DETERMINE WHICH JOINTS ARE TO BE GROUTED FOR FINAL ACCEPTANCE OF THE CONSTRUCTION.
19. ALL UTILITY CURVE DATA AND DIMENSIONS ARE CALCULATED FROM CENTERLINE OF PIPE OR MANHOLE. ALL SAS & SD SLOPES ARE CALCULATED TO TRUE PIPE DIMENSIONS FROM INVERT TO INVERT. (PAY ITEMS ARE SHOWN IN PARENTHESES.)
20. [Symbol] DENOTES CROWN TRANSITION PER C.O.A. STD. DWG. 2401.

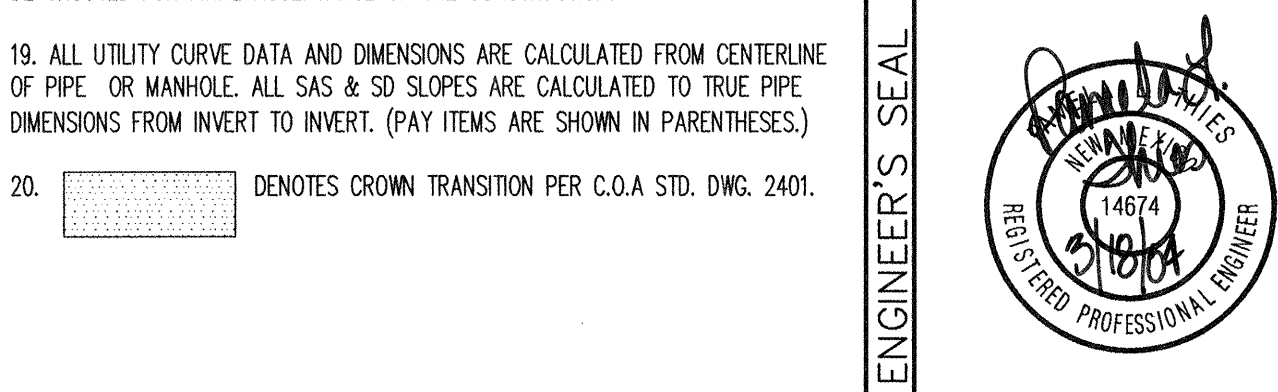

Bohannon & Huston
Courtney I 7800 Jefferson St. NE Albuquerque, NM 87109-4395
ENGINEERING • SPATIAL DATA • ADVANCED TECHNOLOGIES

CITY OF ALBUQUERQUE
PUBLIC WORKS DEPARTMENT

LONGFORD VILLAGE EAST SUBDIVISION
PAVING PLAN AND PROFILE
TOMATILLO LANE

Design Review Committee	City Engineer Approval	Mo./Day/Yr.	Mo./Day/Yr.
APPROVED APR 18 2004 DESIGN REVIEW COMMITTEE	APPROVED MAY 28 2004 CITY ENGINEER		
Last Design Update			


City Project No. 732881 Zone Map No. L-21-Z Sheet 9 Of 23

AS-BUILT INFORMATION	
CONTRACTOR: <i>Bohannon & Huston</i>	DATE: <i>4/18/04</i>
STAMPED BY: <i>CS</i>	DATE: <i>4/18/04</i>
INSPECTOR: <i>CS</i>	DATE: <i>4/18/04</i>
FIELD: <i>CS</i>	DATE: <i>4/18/04</i>
REVISIONS BY: <i>CS</i>	DATE: <i>4/18/04</i>
CORRECTED BY: <i>CS</i>	DATE: <i>4/18/04</i>
MICROFILM INFORMATION	
RECORDED BY:	DATE:
NO.	

BENCH MARKS	
ACS BRASS TABLET STAMPED "6-L21, 1986"	DATE: <i>4/18/04</i>
Geographic Position (NAD 1983)	DATE: <i>4/18/04</i>
N.M. State Plane Coordinates (Central Zone)	DATE: <i>4/18/04</i>
X = 1,558,220.58 Y = 1,481,283.33	DATE: <i>4/18/04</i>
Ground-to-Grid Factor = 0.999644584	DATE: <i>4/18/04</i>
ΔC = -00'09"28"	DATE: <i>4/18/04</i>
NAD88 Elevation = 5503.35	DATE: <i>4/18/04</i>

SURVEY INFORMATION	
NO.	DATE
BY	

ENGINEER'S SEAL	
REMARKS	By
REVISIONS	
DESIGN	
No. Date	
DATE: 02/04	
Drawn By: DH	DATE: 02/04
Checked By: PLT	DATE: 02/04

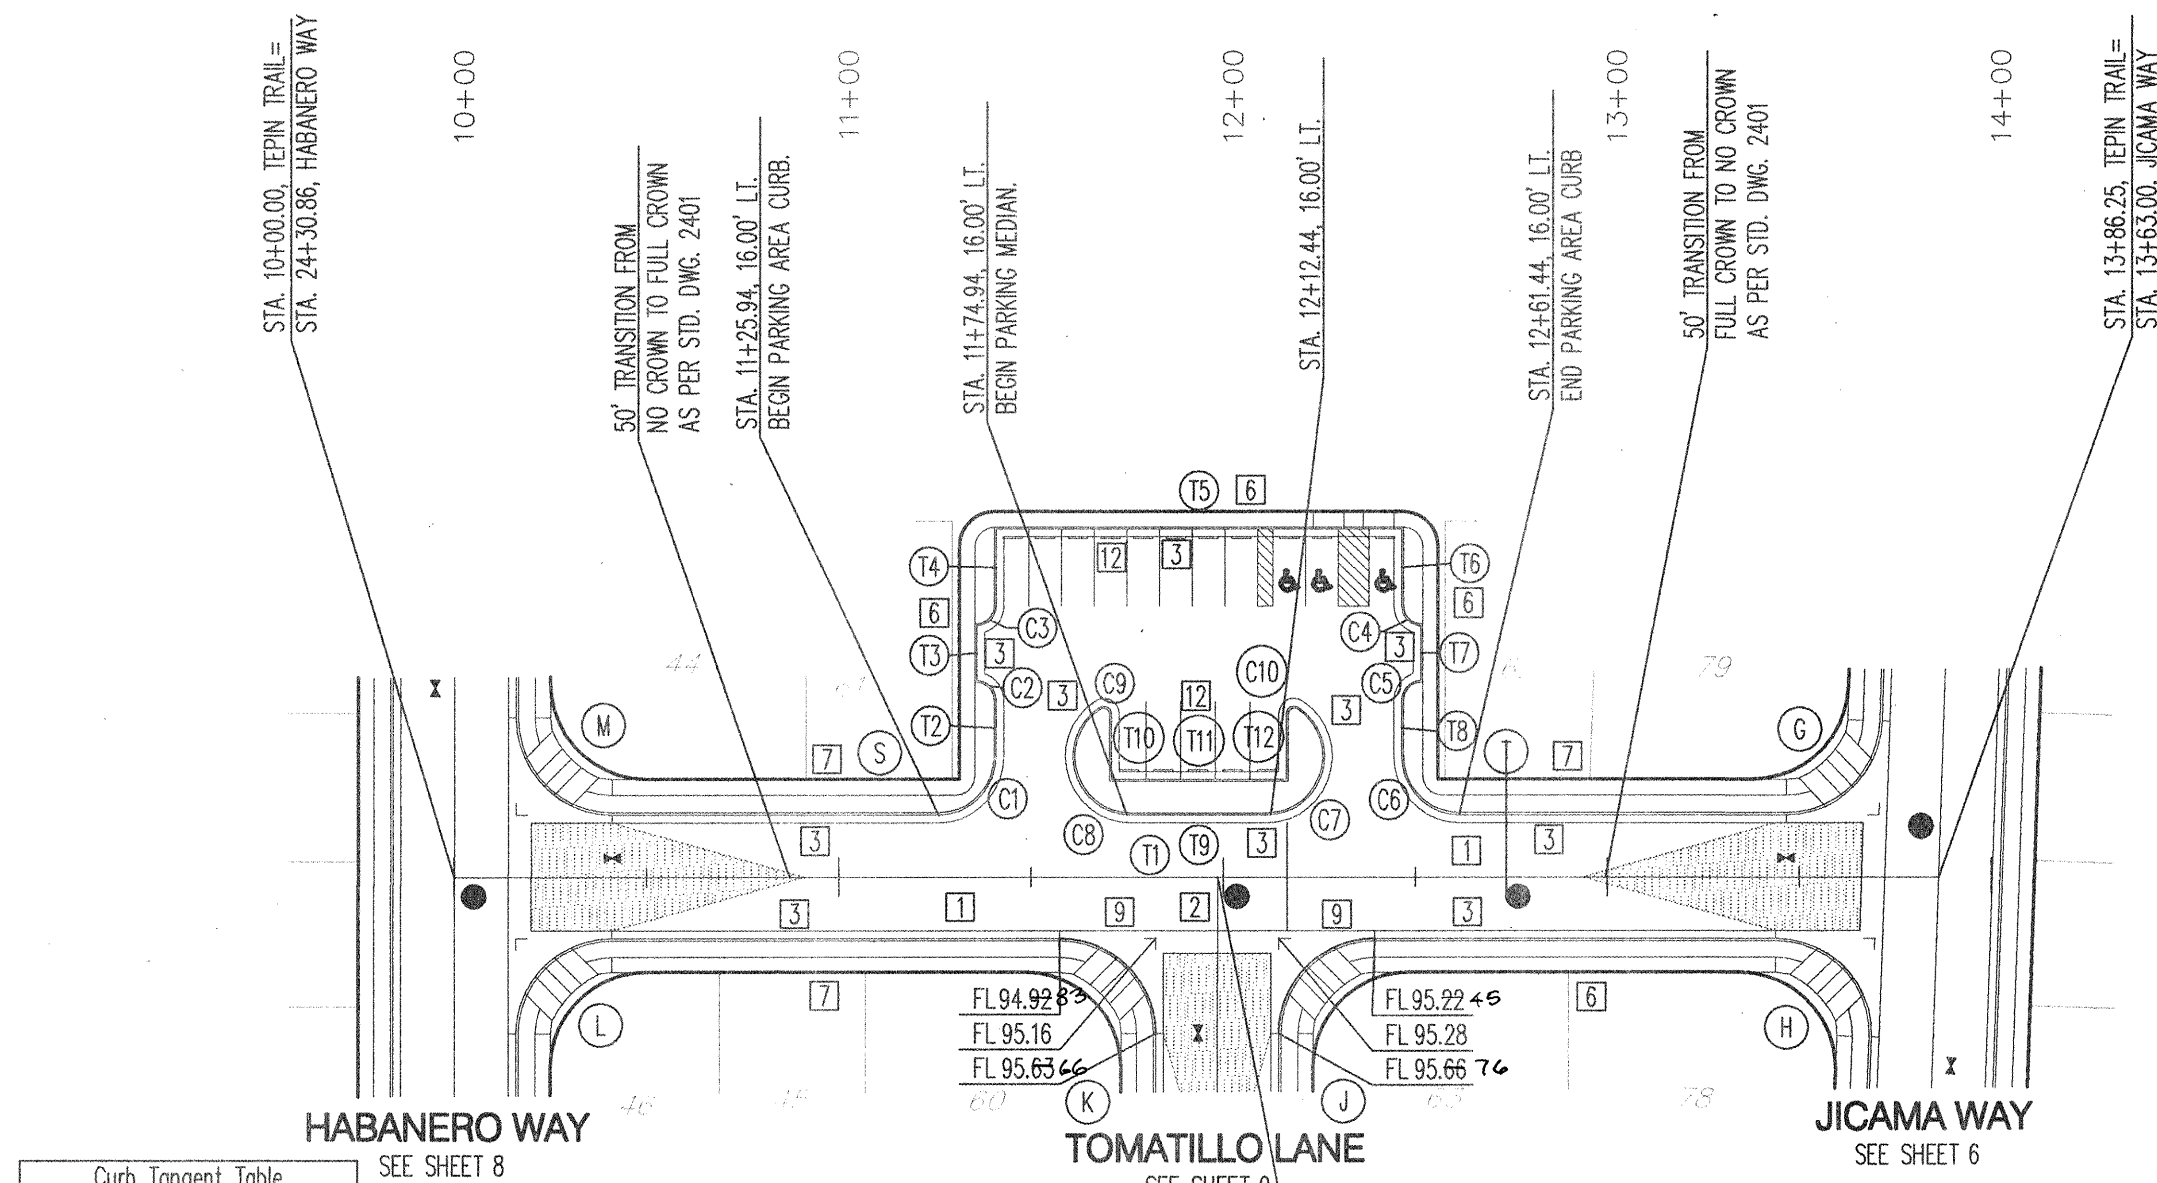

ID	BEARING	LENGTH
12	N89°41'28\"W	14.50'
13	S89°41'28\"E	14.00'
14	N89°41'28\"W	20.00'
15	N00°18'32\"E	105.50'
16	S89°41'28\"E	20.00'
17	S89°41'28\"E	14.00'
18	S89°41'28\"E	14.50'
19	S00°18'32\"W	35.50'
110	N89°41'28\"W	16.95'
111	N00°18'32\"E	45.50'
112	S89°41'28\"E	16.95'

SEE SHEET 8

ID	ARC	RADIUS	DELTA	TANGENT
C1	23.56'	15.00'	90°00'00\"	15.00'
C2	7.85'	5.00'	90°00'00\"	5.00'
C3	7.85'	5.00'	90°00'00\"	5.00'
C4	7.85'	5.00'	90°00'00\"	5.00'
C5	7.85'	5.00'	90°00'00\"	5.00'
C6	23.56'	15.00'	90°00'00\"	15.00'
C7	38.59'	15.00'	147°25'16\"	51.33'
C8	38.59'	15.00'	147°25'16\"	51.33'
C9	4.28'	2.00'	122°34'44\"	3.65'
C10	4.28'	2.00'	122°34'44\"	3.65'

SEE SHEET 9

ID	BEARING	LENGTH
T1	N00°18'32\"E	386.25'

SEE SHEET 8 FOR
M & L QUARTER
POINT INFORMATION

SEE SHEET 6 FOR
G & H QUARTER
POINT INFORMATION

TEPIN TRAIL



PC	PT	STATION	BEARING	LENGTH
94.92	95.05	11+57.48	16.00' RT.	PC CURB RETURN
95.05	95.24	11+57.48	16.00' RT.	PT CURB RETURN

PC	PT	STATION	BEARING	LENGTH
95.66	95.79	12+14.48	40.99' RT.	PC CURB RETURN
95.79	95.98	12+14.48	40.99' RT.	PT CURB RETURN

PC	PT	STATION	BEARING	LENGTH
95.66	95.79	12+14.48	40.99' RT.	PC CURB RETURN
95.79	95.98	12+14.48	40.99' RT.	PT CURB RETURN

PC	PT	STATION	BEARING	LENGTH
94.65	94.78	11+40.94	31.00' LT.	PC CURB RETURN
94.78	94.97	11+40.94	31.00' LT.	PT CURB RETURN

PC	PT	STATION	BEARING	LENGTH
95.09	95.22	12+46.44	16.00' LT.	PC CURB RETURN
95.22	95.41	12+46.44	16.00' LT.	PT CURB RETURN

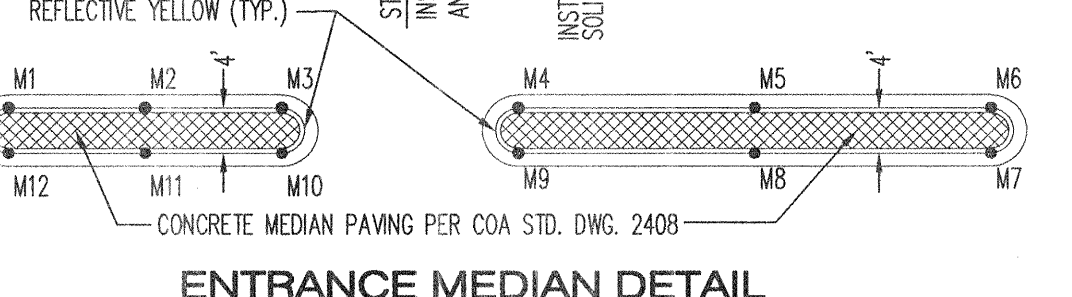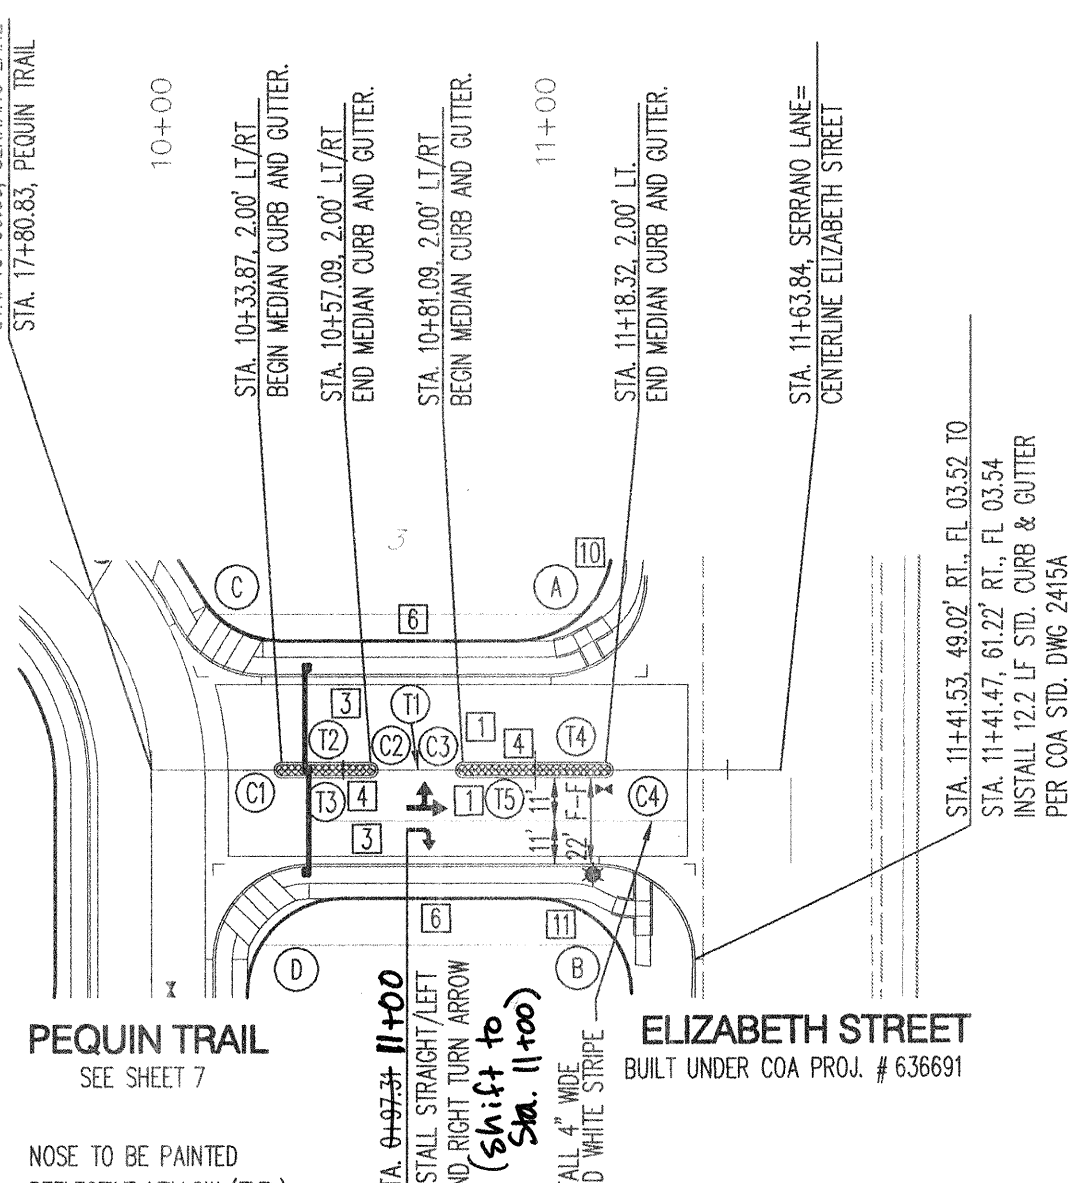

ID	ARC	RADIUS	DELTA	TANGENT
C1	6.28'	2.00'	180°00'00\"	2.00'
C2	6.28'	2.00'	180°00'00\"	2.00'
C3	6.28'	2.00'	180°00'00\"	2.00'
C4	6.28'	2.00'	180°00'00\"	2.00'

SERRANO LANE

ELEVATIONS ARE IN NGVD 29

KEYED NOTES

- BUILD RESIDENTIAL PAVEMENT PER RESIDENTIAL SECTION, SHEETS 5 AND 22.
- INSTALL 6' CONCRETE VALLEY GUTTER PER COA STD. DWG. 2420.
- BUILD STD. CURB & GUTTER PER COA STD. DWG. 2415A.
- BUILD MEDIAN TYPE CURB AND GUTTER PER COA STD. DWG. 2415B.
- BUILD ROLL TYPE CURB & GUTTER PER COA STD. DWG. 2415A.
- BUILD 4' SIDEWALK PER COA STD. DWG. 2430.
- 4' SIDEWALK, DEFERRED.
- NO SIDEWALK ON THIS SIDE, WAIVED.
- INSTALL SPECIAL HANDICAP RAMP PER CASE II SHEET 22.
- INSTALL MODIFIED HANDICAP RAMP 'A' PER DETAIL SHEET 22.
- INSTALL MODIFIED HANDICAP RAMP 'B' PER DETAIL SHEET 22.
- INSTALL PARKING BUMPERS
- INSTALL 18' WIDE DRIVEPAD PER COA STD. DWG. 2425
- INSTALL ALLEY PAVEMENT PER ALLEY SECTION, SHEET 22.

* NOT USED THIS SHEET.

NOTES

- THE CONTRACTOR SHALL FIELD VERIFY ALL EXISTING UTILITY LOCATIONS AND NOTIFY THE ENGINEER IMMEDIATELY OF ANY DISCREPANCIES.
- ALL PAVING CURVE DATA AND DIMENSIONS REFER TO FACE OF CURB UNLESS OTHERWISE SPECIFIED.
- GRADE ELEVATIONS, WHERE NOTED, ARE FOR FLOWLINE OF STANDARD CURB UNLESS OTHERWISE SPECIFIED.
- CONTRACTOR SHALL PARK EQUIPMENT AND VEHICLES AS NOT TO INTERFERE WITH NORMAL ACTIVITIES OF RESIDENTS OR OTHER CONTRACTORS ON SITE.
- ANY DAMAGE TO THE EXISTING FACILITIES (CURB & GUTTER, PAVEMENT, CONDUITS, LANDSCAPING, UTILITY LINES, ETC.) DURING CONSTRUCTION SHALL BE REPLACED AT THE CONTRACTORS' EXPENSE.
- ANY ADDITIONAL GRADING REQUIRED TO MATCH PROPOSED STREET GRADES SHALL BE INCIDENTAL TO PAVING ITEMS.
- REMOVAL OF THE EXISTING CURB & GUTTER SHALL BE PER C.O.A. STD. DWG. 2415 (SAWOUT ONLY).
- WHEELCHAIR RAMPS SHALL BE CONSTRUCTED PRIOR TO ACCEPTANCE OF CURB AND GUTTER.
- ALL EXCAVATION, TRENCHING AND SHORING ACTIVITIES MUST BE CARRIED-OUT IN ACCORDANCE WITH OSHA 29 CFR 1926.650 SUBPART B.
- CONTRACTOR SHALL FIELD VERIFY ALL EXISTING UTILITIES AND TRANSMISSION GAS LINES. CONTRACTOR SHALL COORDINATE RELOCATION OF UTILITY LINES WITH UTILITY COMPANIES AS REQUIRED.
- CONTRACTOR IS RESPONSIBLE FOR REPAIR AND/OR REPLACEMENT OF ALL UTILITY CONDUITS AND EXISTING LINES.
- CONTRACTOR IS TO INSTALL A 4" X 4" X 5' POST AND END AT THE END OF EACH SANITARY SEWER SERVICE.
- CONTRACTOR SHALL PROVIDE THE INSPECTORS (CITY AND PRIVATE) WITH THE PROPOSED HYDROSTATIC TESTING PLAN. THE PLAN MUST BE APPROVED BEFORE TESTING OPERATIONS BEGIN.
- WH RIMS AND CATCH BASIN INLET ELEVATIONS, VALVE BOXES, ARV, FIRE HYDRANT & FLANGE ELEVATIONS ARE APPROXIMATE. CONTRACTOR SHALL FIELD VERIFY AND ADJUST TO FINAL PAVEMENT GRADES.
- SAS STATIONING FOLLOWS CL OF ROAD UNLESS OTHERWISE NOTED.
- STATIONING OF DROP INLET IS TO MIDDLE OF DOWN HILL GRATE AT FACE OF CURB.
- FLOWLINE ELEVATIONS FOR DROP DROP INLETS ARE PROJECTED FROM FLOWLINE OF STANDARD CURB TO MIDDLE OF DOWNHILL GRATE.
- FOR STORM DRAIN CONSTRUCTION: ALL RCP JOINTS SHALL BE GROUTED PRIOR TO FINAL INSPECTION. FINAL INSPECTION SHALL DETERMINE WHICH JOINTS ARE TO BE GROUTED FOR FINAL ACCEPTANCE OF THE CONSTRUCTION.
- ALL UTILITY CURVE DATA AND DIMENSIONS ARE CALCULATED FROM CENTERLINE OF PIPE OR MANHOLE. ALL SAS & SD SLOPES ARE CALCULATED TO TRUE PIPE DIMENSIONS FROM INVERT TO INVERT. (PAY ITEMS ARE SHOWN IN PARENTHESES.)
20. DENOTES CROWN TRANSITION PER C.O.A. STD. DWG. 2401.


Bohannon & Huston
 Courtyard | 7500 Jefferson St. NE | Albuquerque, NM 87109-4335
 ENGINEERING & SPATIAL DATA & ADVANCED TECHNOLOGIES

CITY OF ALBUQUERQUE
PUBLIC WORKS DEPARTMENT


LONGFORD VILLAGE EAST SUBDIVISION
PAVING PLAN AND PROFILE
TEPIN TRAIL AND SERRANO LANE

Design Review Committee	City Engineer Approval	Mo./Day/Yr.	Mo./Day/Yr.
APPROVED APR 19 2004	APPROVED MAY 28 2004		
DESIGN REVIEW COMMITTEE	CITY ENGINEER		


City Project No.	Zone Map No.	Sheet	Of
732881	L-21-Z	10	23

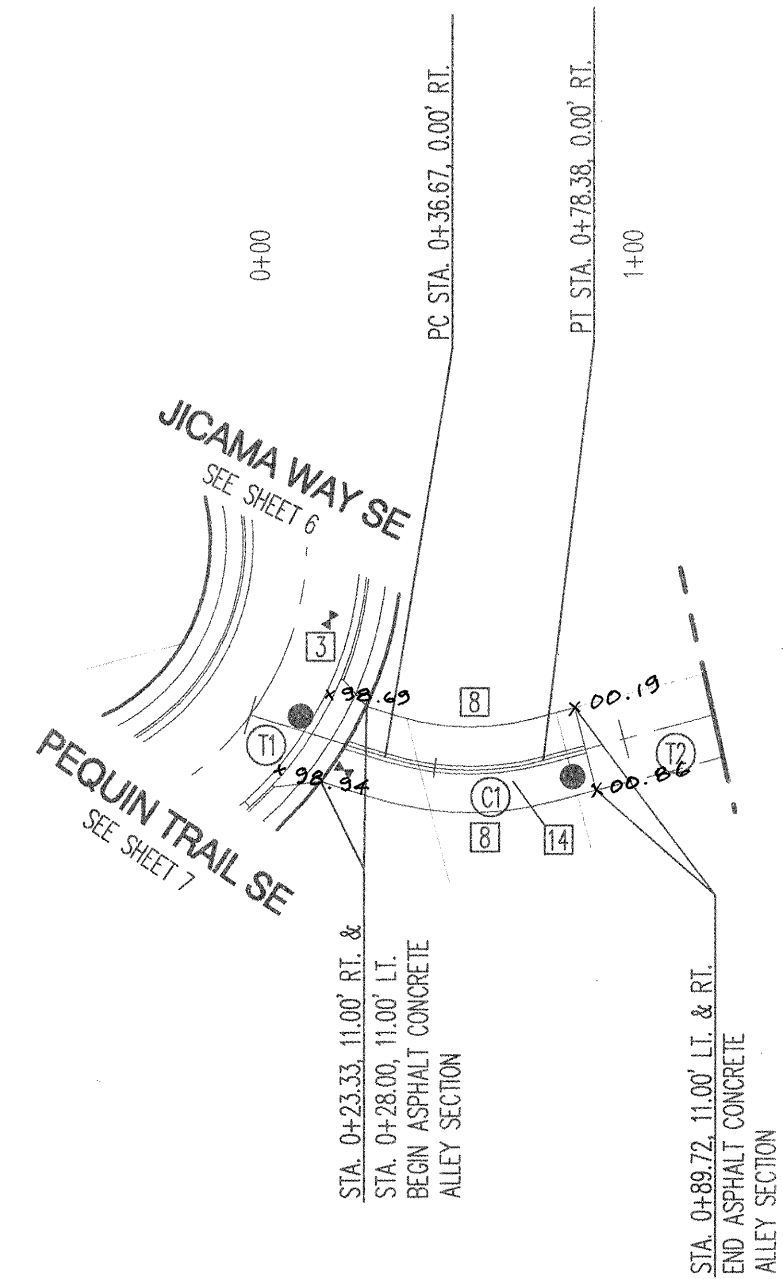


CL Tangent Table			CL Curve Table				
ID	BEARING	LENGTH	ID	ARC	RADIUS	DELTA	TANGENT
T1	N32°01'10"E	36.67	C1	41.71	75.00	31°52'01"	21.41
T2	N00°18'32"E	45.72					

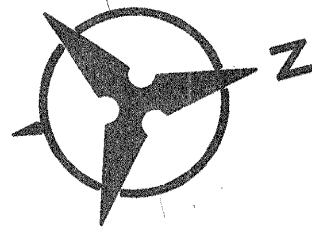

ALLEY 1

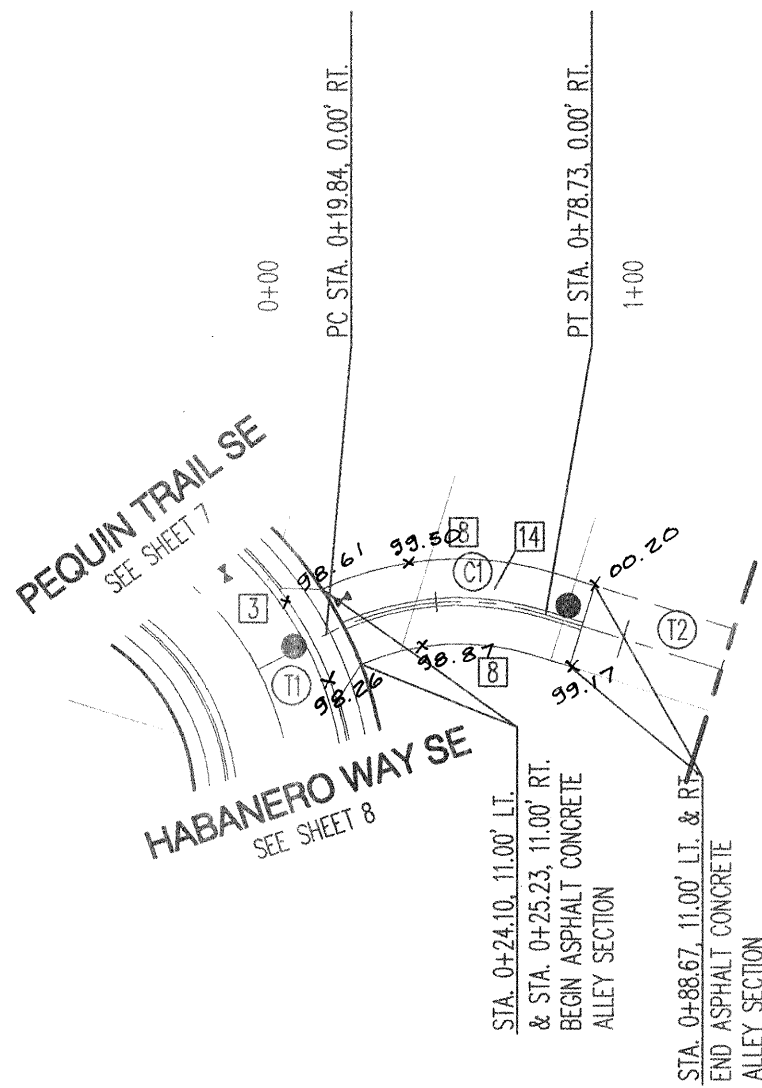

CL Tangent Table			CL Curve Table				
ID	BEARING	LENGTH	ID	ARC	RADIUS	DELTA	TANGENT
T1	S44°40'36"E	19.34	C1	58.89	75.00	44°59'07"	31.05
T2	S00°18'32"W	47.95					

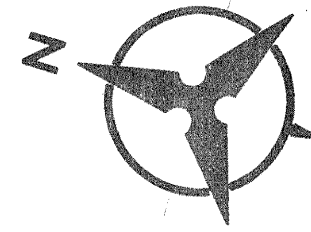

ALLEY 2

ELEVATIONS ARE IN NGVD 29

EXISTING GROUND ALONG CENTERLINE OF PROPOSED STREET.

PROPOSED GRADE ALONG FLOWLINE OF PROPOSED STREET.

EXISTING GROUND ALONG CENTERLINE OF PROPOSED STREET.

PROPOSED GRADE ALONG FLOWLINE OF PROPOSED STREET.

KEYED NOTES

- [1] BUILD RESIDENTIAL PAVEMENT PER RESIDENTIAL SECTION, SHEETS 5 AND 22.
 - [2] INSTALL 6" CONCRETE VALLEY GUTTER PER COA STD. DWG. 2420.
 - [3] BUILD STD. CURB & GUTTER PER COA STD. DWG. 2415A.
 - [4] BUILD MEDIAN TYPE CURB AND GUTTER PER COA STD. DWG. 2415B.
 - [5] BUILD ROLL TYPE CURB & GUTTER PER COA STD. DWG. 2415A.
 - [6] BUILD 4' SIDEWALK PER COA STD. DWG. 2430.
 - [7] 4' SIDEWALK, DEFERRED.
 - [8] NO SIDEWALK ON THIS SIDE, WAIVED.
 - [9] INSTALL SPECIAL HANDICAP RAMP PER CASE II SHEET 22.
 - [10] INSTALL MODIFIED HANDICAP RAMP 'A' PER DETAIL SHEET 22.
 - [11] INSTALL MODIFIED HANDICAP RAMP 'B' PER DETAIL SHEET 22.
 - [12] INSTALL PARKING BUMPERS.
 - [13] INSTALL 22' WIDE DRIVEPAD PER COA STD. DWG. 2425.
 - [14] INSTALL ALLEY PAVEMENT PER ALLEY SECTION, SHEET 22.
- * NOT USED THIS SHEET.

1 2 3 4 5 6 7 8 9 10 11 12 13 14 15
26 7328.81 1205


Bohannon & Huston

Courtyard 1 7800 Jefferson St. NE Albuquerque, NM 87108-4595
ENGINEERING • SPATIAL DATA • ADVANCED TECHNOLOGIES



**CITY OF ALBUQUERQUE
PUBLIC WORKS DEPARTMENT**

LONGFORD VILLAGE EAST SUBDIVISION
PAVING PLAN AND PROFILE
ALLEY 1 AND ALLEY 2

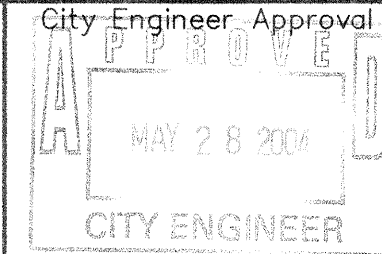

City Project No.

732881

Zone Map No.

L-21-Z

Sheet

Of

12


23

NOTES

1. THE CONTRACTOR SHALL FIELD VERIFY ALL EXISTING UTILITY LOCATIONS AND NOTIFY THE ENGINEER IMMEDIATELY OF ANY DISCREPANCIES.
2. ALL PAVING CURVE DATA AND DIMENSIONS REFER TO FACE OF CURB UNLESS OTHERWISE SPECIFIED.
3. GRADE ELEVATIONS, WHERE NOTED, ARE FOR FLOWLINE OF STANDARD CURB UNLESS OTHERWISE SPECIFIED.
4. CONTRACTOR SHALL PARK EQUIPMENT AND VEHICLES AS NOT TO INTERFERE WITH NORMAL ACTIVITIES OF RESIDENTS OR OTHER CONTRACTORS ON SITE.
5. ANY DAMAGE TO THE EXISTING FACILITIES (CURB & GUTTER, PAVEMENT, CONDUITS, LANDSCAPING, UTILITY LINES, ETC.) DURING CONSTRUCTION SHALL BE REPLACED AT THE CONTRACTORS' EXPENSE.
6. ANY ADDITIONAL GRADING REQUIRED TO MATCH PROPOSED STREET GRADES SHALL BE INCIDENTAL TO PAVING ITEMS.
7. REMOVAL OF THE EXISTING CURB & GUTTER SHALL BE PER C.O.A. STD. DWG. 2415 (SAWOUT ONLY).
8. WHEELCHAIR RAMPS SHALL BE CONSTRUCTED PRIOR TO ACCEPTANCE OF CURB AND GUTTER.
9. ALL EXCAVATION, TRENCHING AND SHORING ACTIVITIES MUST BE CARRIED-OUT IN ACCORDANCE WITH OSHA 29 CFR 1926.650 SUBPART B.
10. CONTRACTOR SHALL FIELD VERIFY ALL EXISTING UTILITIES AND TRANSMISSION GAS LINES. CONTRACTOR SHALL COORDINATE RELOCATION OF UTILITY LINES WITH UTILITY COMPANIES AS REQUIRED.
11. CONTRACTOR IS RESPONSIBLE FOR REPAIR AND/OR REPLACEMENT OF ALL UTILITY CONDUITS AND EXISTING LINES.
12. CONTRACTOR IS TO INSTALL A 4" X 4" X 5' POST AND END AT THE END OF EACH SANITARY SEWER SERVICE.
13. CONTRACTOR SHALL PROVIDE THE INSPECTORS (CITY AND PRIVATE) WITH THE PROPOSED HYDROSTATIC TESTING PLAN. THE PLAN MUST BE APPROVED BEFORE TESTING OPERATIONS BEGIN.
14. MH RIMS AND CATCH BASIN INLET ELEVATIONS, VALVE BOXES, ARV, FIRE HYDRANT & FLANGE ELEVATIONS ARE APPROXIMATE. CONTRACTOR SHALL FIELD VERIFY AND ADJUST TO FINAL PAVEMENT GRADES.
15. SAS STATIONING FOLLOWS CL OF ROAD UNLESS OTHERWISE NOTED.
16. STATIONING OF DROP INLET IS TO MIDDLE OF DOWN HILL GRATE AT FACE OF CURB.
17. FLOWLINE ELEVATIONS FOR DROP DROP INLETS ARE PROJECTED FROM FLOWLINE OF STANDARD CURB TO MIDDLE OF DOWNHILL GRATE.
18. FOR STORM DRAIN CONSTRUCTION: ALL RCP JOINTS SHALL BE GROUTED PRIOR TO FINAL INSPECTION. FINAL INSPECTION SHALL DETERMINE WHICH JOINTS ARE TO BE GROUTED FOR FINAL ACCEPTANCE OF THE CONSTRUCTION.
19. ALL UTILITY CURVE DATA AND DIMENSIONS ARE CALCULATED FROM CENTERLINE OF PIPE OR MANHOLE. ALL SAS & SD SLOPES ARE CALCULATED TO TRUE PIPE DIMENSIONS FROM INVERT TO INVERT. (PAY ITEMS ARE SHOWN IN PARENTHESES.)
20. [Symbol] DENOTES CROWN TRANSITION PER C.O.A. STD. DWG. 2401.

AS-BUILT INFORMATION		BENCH MARKS		SURVEY INFORMATION		ENGINEER'S SEAL	
CONTRACTOR	DATE	ACCS BRASS TABLET	STAMPED "6-121, 1986"	DATE	BY	REMARKS	REVISIONS
INSPECTOR	DATE	Geographic Position	(NAD 1983)				
INSPECTOR	DATE	N.M. State Plane Coordinates	(Central Zone)				
INSPECTOR	DATE	X= 1,558,220.58	Y= 1,481,283.33				
INSPECTOR	DATE	Ground-to-Grid Factor	= 0.999644564				
INSPECTOR	DATE	ACC = -00'09"28"					
INSPECTOR	DATE	NAVD88 Elevation	= 5503.35				

SCANNED BY
MESA REPRO

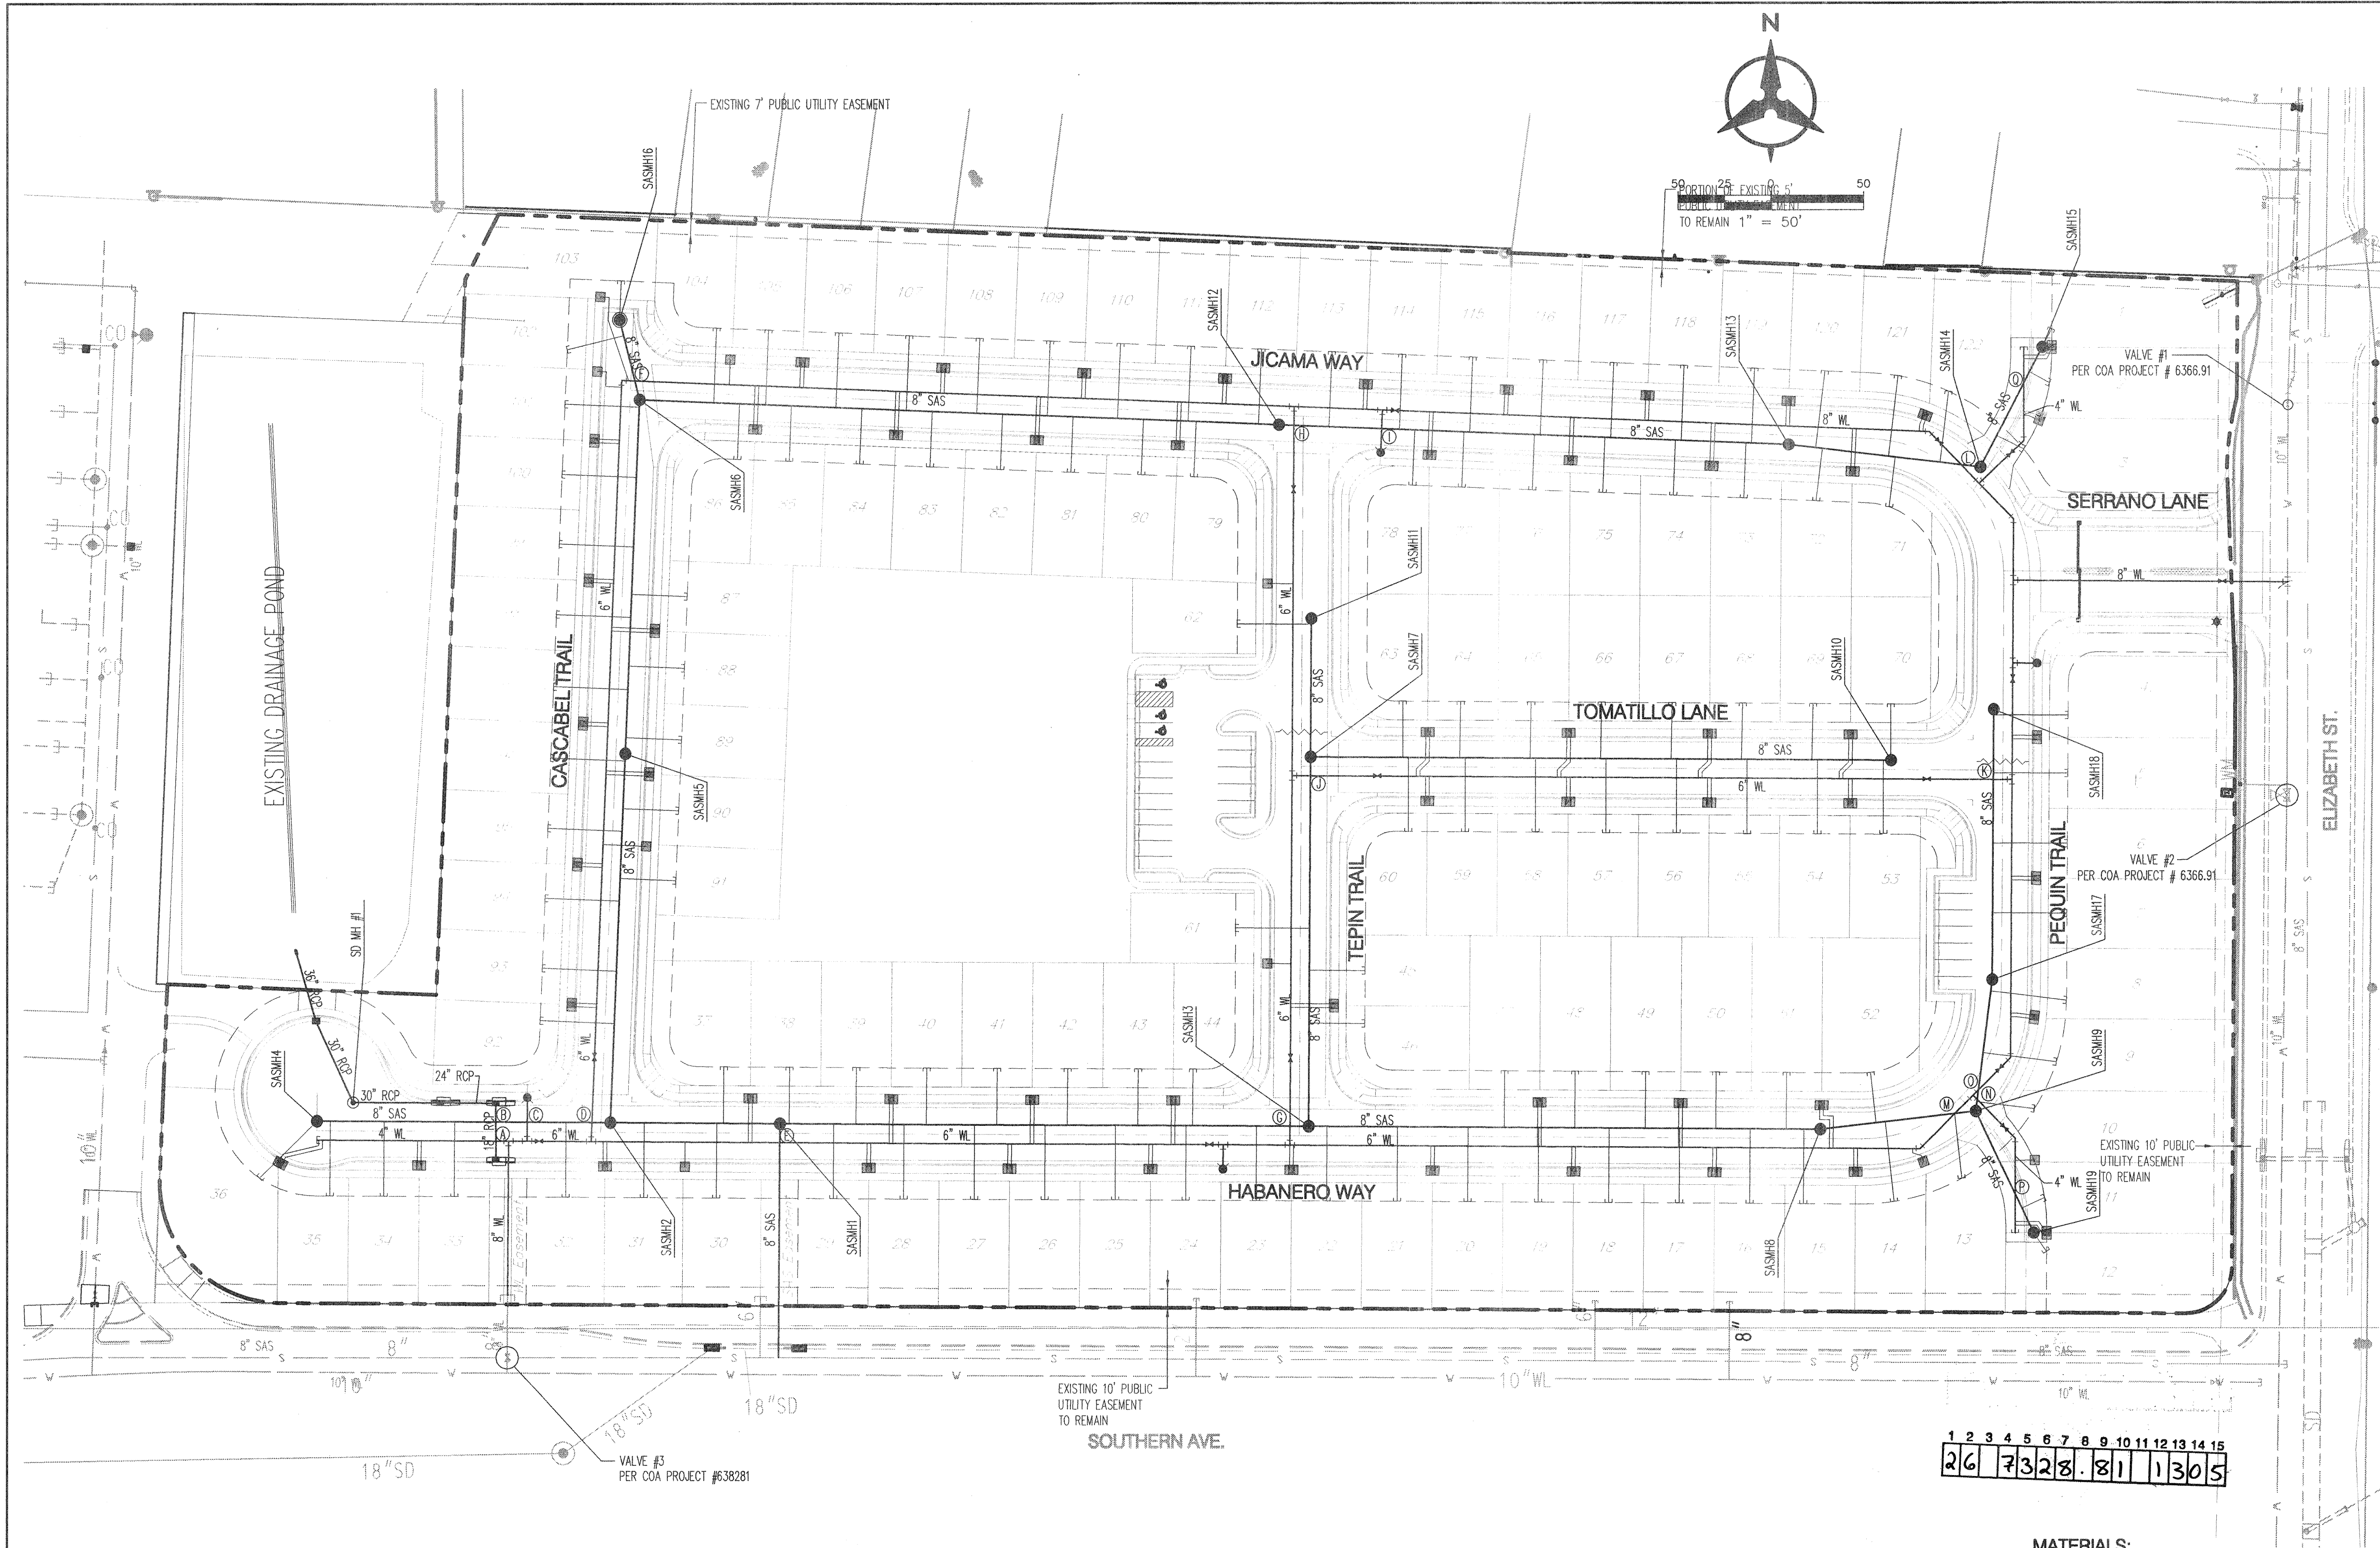

P:\040199\cdd\general\040199_00TIL.dwg
April 12, 2004 - 10:06am

Crossings				
DES	SAS	SD	WL	Clearance
A	-----	18" TP 84.47	4" TP 81.41	**1.14
B	8" TP 79.26	18" TP 82.55	4" BP 81.05	3.22
C	8" BP 78.56	18" BP 82.49	-----	-----
D	8" TP 79.16	-----	6" TP 82.63	2.92
E	8" BP 78.46	-----	6" BP 82.09	-----
F	8" TP 78.95	-----	6" TP 82.43	2.93
G	8" BP 78.25	-----	6" BP 81.89	-----
H	8" TP 78.14	-----	6" TP 84.19	5.50
I	8" BP 77.43	-----	6" BP 83.64	-----
J	8" TP 84.44	-----	6" TP 86.49	1.51
K	8" BP 83.73	-----	6" BP 85.95	-----
L	8" TP 85.86	-----	6" TP 89.15	2.74
M	8" BP 85.16	-----	6" BP 88.61	-----
N	8" TP 87.42	-----	6" TP 90.47	2.50
O	8" BP 86.71	-----	6" BP 89.92	-----
P	8" TP 87.96	-----	6" TP 91.12	2.63

DES	SAS	SD	WL	Clearance
J	8" BP 87.25	-----	6" BP 90.58	-----
K	8" TP 88.42	-----	6" TP 91.65	2.68
L	8" BP 87.72	-----	6" BP 91.10	-----
M	8" TP 93.58	-----	6" TP 96.79	2.67
N	8" BP 92.87	-----	6" BP 96.25	-----
O	8" TP 91.77	-----	6" TP 94.89	2.57
P	8" BP 91.07	-----	6" BP 94.35	-----
Q	8" TP 91.36	-----	6" TP 94.49	2.59
R	8" BP 90.65	-----	6" BP 93.95	-----
S	8" TP 91.67	-----	4" TP 94.61	2.58
T	8" BP 90.96	-----	4" BP 94.25	-----
U	8" TP 91.77	-----	6" TP 94.82	2.51
V	8" BP 91.07	-----	6" BP 94.28	-----
W	8" TP 92.51	-----	4" TP 95.27	2.40
X	8" BP 91.80	-----	4" BP 94.91	-----
Y	8" TP 93.12	-----	4" TP 95.87	2.39
Z	8" BP 92.41	-----	4" BP 95.51	-----

MATERIALS:

SAS LINE: SDR-35 PVC
WATER LINE: C900-PVC

WATER SHUT-OFF PLAN:

FOR CONNECTION VALVE CLOSED
ELIZABETH STREET S.E. 1 & 2
SOUTHERN AVE. S.E. 3

CONTRACTOR WILL BE RESPONSIBLE FOR FLUSHING,
DISINFECTING, AND TESTING THE LINES AS REQUIRED
BY THE NEW MEXICO UTILITIES INC.

WATER SHUT-OFF REQUIREMENTS:

CONTRACTOR WILL BE RESPONSIBLE FOR THE TIMING
AND COORDINATION OF THE WATER SHUT-OFF
REQUIREMENTS IN CONJUNCTION WITH THE COMPLETION
OF CONNECTIONS. AT LEAST SEVEN (7) WORKING DAYS
PRIOR TO CONSTRUCTION, THE CONTRACTOR SHALL
CONTACT CITY OF ALBUQUERQUE TO INITIATE
IMPLEMENTATION OF THIS WATER SHUT-OFF PLAN.
CONTRACTOR SHALL NOT OPERATE VALVES ON THE PROJECT.



LEGEND	
---	PROPERTY LINE
---	NEW EASEMENT
SAS	EXISTING SANITARY SEWER
W	EXISTING WATER LINE
---	EXISTING STORM DRAIN
⊗	EXISTING WATER METER
⊕	EXISTING CAP
⊙	EXISTING VALVE
⊗	EXISTING FIRE HYDRANT
⊙	EXISTING SANITARY SEWER MANHOLE
⊙	EXISTING STORM DRAIN
SAS	PROPOSED SANITARY SEWER
W	PROPOSED WATER LINE
---	PROPOSED VALVE
⊗	PROPOSED HYDRANT
⊕	PROPOSED CAP
⊗	PROPOSED WATER METER
⊙	PROPOSED SANITARY SEWER MANHOLE
⊙	PROPOSED STORM DRAIN
*	PROPOSED STREET LIGHT

Bohannon & Huston
Court yard | 7500 Jefferson St. NE Albuquerque, NM 87109-4335
ENGINEERING & SPATIAL DATA & ADVANCED TECHNOLOGIES



CITY OF ALBUQUERQUE
PUBLIC WORKS DEPARTMENT

LONGFORD VILLAGE EAST SUBDIVISION
OVERALL UTILITY PLAN

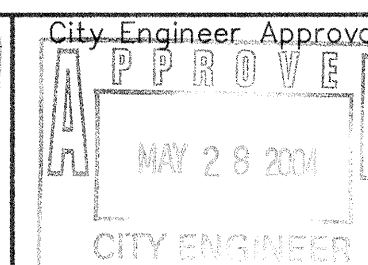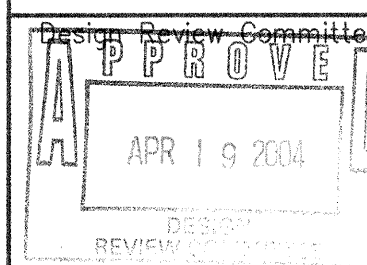

Last Design Update

Mo./Day/Yr.	Mo./Day/Yr.

City Project No. **732881** Zone Map No. **L-21-Z** Sheet **13** Of **23**


AS-BUILT INFORMATION	
CONTRACT NO. 732881	DATE 04/12/04
BY CSC	DATE 04/12/04
INSPECTOR'S NAME CSC	DATE 04/12/04
FIELD NO. NO. 13	DATE 04/12/04
VERIFICATION BY NO. 13	DATE 04/12/04
COMMENTS NO. 13	DATE 04/12/04
MICROFILM INFORMATION	
RECORDED BY NO.	DATE NO.

BENCH MARKS	
ACS BRASS TABLET STAMPED "6-L21, 1986"	DATE NO.
Geographic Position (NAD 1983)	DATE NO.
N.M. State Plane Coordinates (Central Zone)	DATE NO.
X= 1,558,220.58 Y= 1,481,283.33	DATE NO.
Ground-to-Grid Factor = 0.999944584	DATE NO.
ΔX = -00'09"28"	DATE NO.
NAVD88 Elevation = 5503.35	DATE NO.

SURVEY INFORMATION	
FIELD NOTES	DATE NO.
BY NO.	DATE NO.




ENGINEER'S SEAL	
REMARKS	By NO.
REVISIONS	By NO.
DESIGN	By NO.
DATE: 02/04	By NO.
Drawn By: DH	DATE: 02/04
Checked By: PLT	DATE: 02/04

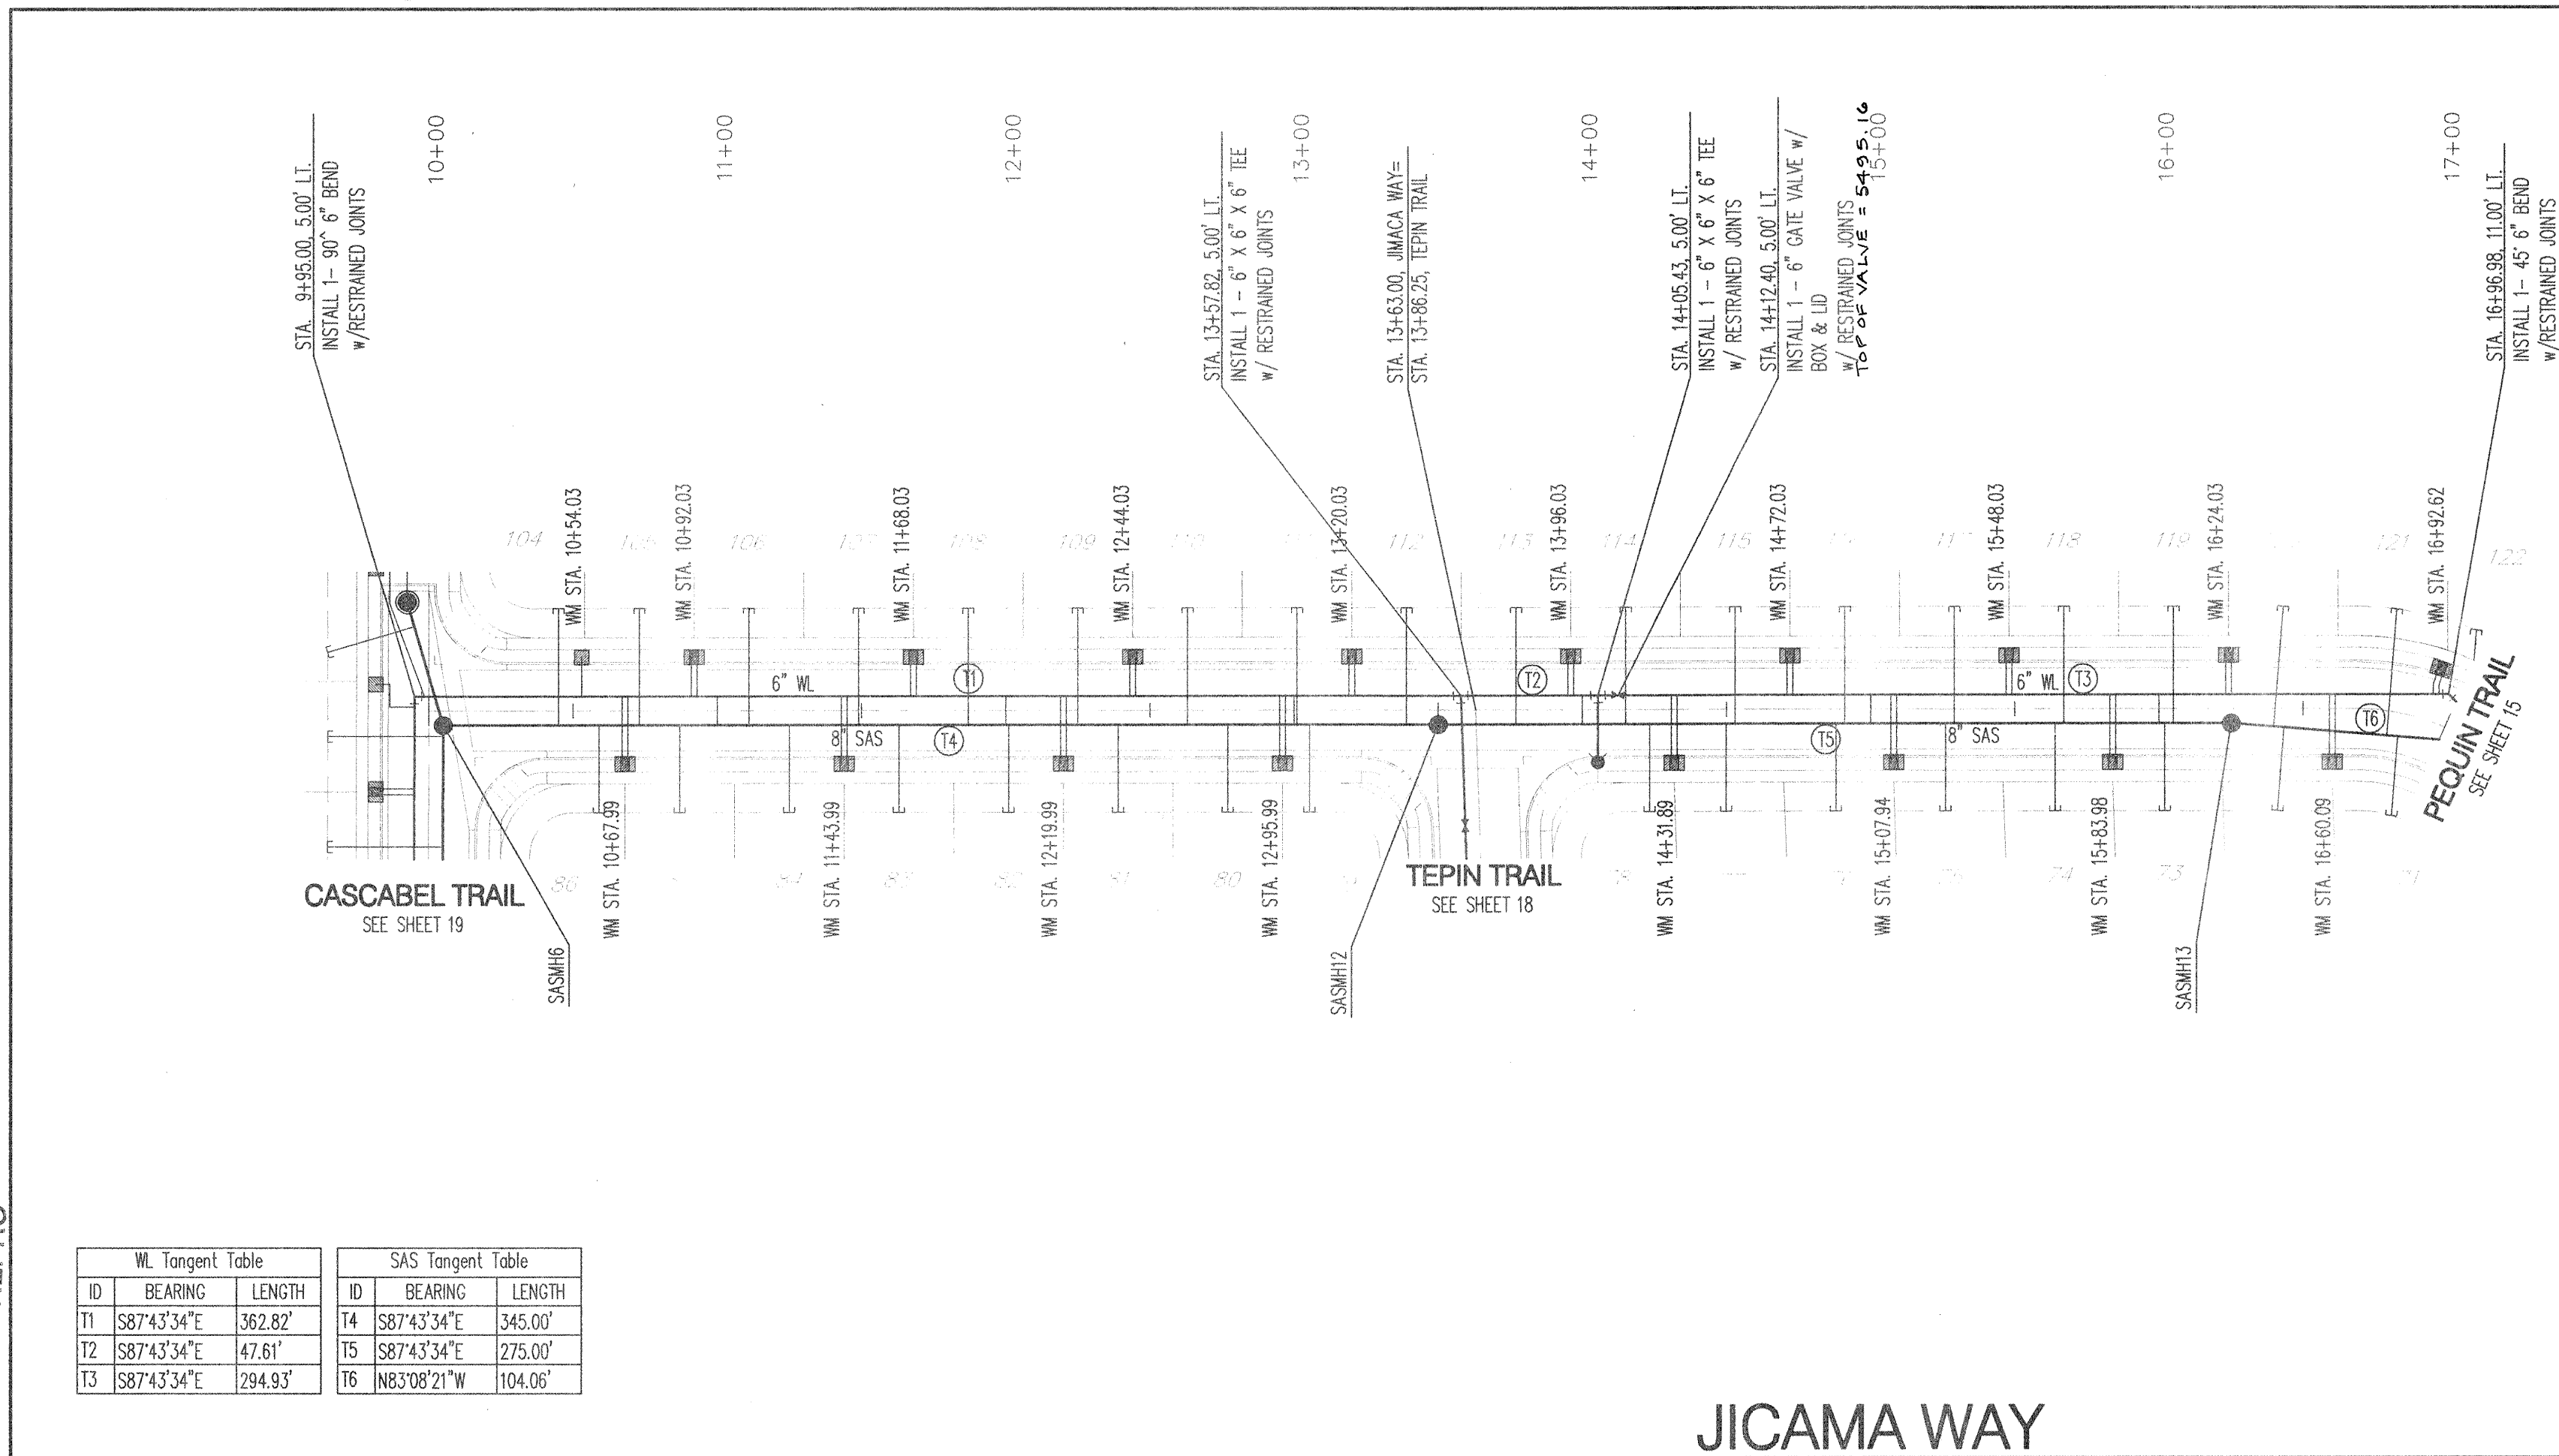

SANITARY SEWER SERVICES			
LOT ID	SAS STATION & OFFSET	SAS LENGTH	TOP OF PIPE AT PLUG (W/RISER)
71	16+84.52, 8.17 RT.	27.22	5492.47
72	16+43.33, 6.47 RT.	28.62	5491.94
73	16+02.99, 5.00 RT.	30.00	5491.45
74	15+64.97, 5.00 RT.	30.00	5491.02
75	15+26.95, 5.00 RT.	30.00	5490.59
76	14+88.93, 5.00 RT.	30.00	5490.16
77	14+50.91, 5.00 RT.	30.00	5489.73
78	14+23.32, 5.00 RT.	30.00	5489.42
79	13+05.33, 5.00 RT.	30.00	5488.20
80	12+76.99, 5.00 RT.	30.00	5487.95
81	12+38.99, 5.00 RT.	30.00	5487.63
82	12+00.99, 5.00 RT.	30.00	5487.30
83	11+62.99, 5.00 RT.	30.00	5486.98
84	11+24.99, 5.00 RT.	30.00	5486.65
85	10+86.99, 5.00 RT.	30.00	5486.33
86	10+48.99, 5.00 RT.	30.00	5486.09
104	10+45.03, 5.00 RT.	40.00	5486.17
105	10+73.03, 5.00 RT.	40.00	5486.41
106	11+11.03, 5.00 RT.	40.00	5486.73
107	11+49.03, 5.00 RT.	40.00	5487.06
108	11+87.03, 5.00 RT.	40.00	5487.38
109	12+25.03, 5.00 RT.	40.00	5487.71
110	12+63.03, 5.00 RT.	40.00	5488.03
111	13+01.03, 5.00 RT.	40.00	5488.36
112	13+39.03, 5.00 RT.	40.00	5488.68
113	13+77.03, 5.00 RT.	40.00	5489.09
114	14+15.03, 5.00 RT.	40.00	5489.52
115	14+53.03, 5.00 RT.	40.00	5489.95
116	14+91.03, 5.00 RT.	40.00	5490.38
117	15+29.03, 5.00 RT.	40.00	5490.81
118	15+67.03, 5.00 RT.	40.00	5491.25
119	16+05.03, 5.00 RT.	40.00	5491.68
120	16+39.73, 6.18 RT.	41.31	5492.14
121	16+80.39, 8.54 RT.	43.62	5492.74
122	17+09.40, 9.99 RT.	38.68	5493.04

NOTE: WATER METER LOCATIONS ARE DESIGNATED BY STATIONING AT PROPERTY CORNERS.

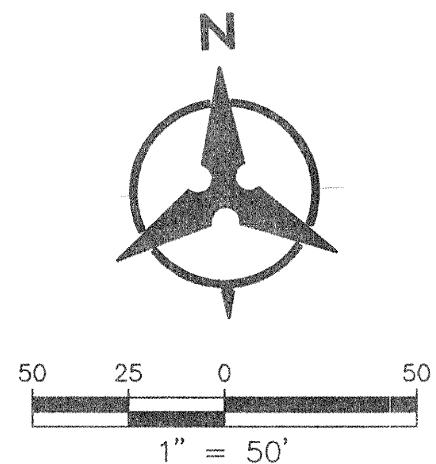

NOTES

- THE CONTRACTOR SHALL FIELD VERIFY ALL EXISTING UTILITY LOCATIONS AND NOTIFY THE ENGINEER IMMEDIATELY OF ANY DISCREPANCIES.
- ALL PAVING CURVE DATA AND DIMENSIONS REFER TO FACE OF CURB UNLESS OTHERWISE SPECIFIED.
- GRADE ELEVATIONS, WHERE NOTED, ARE FOR FLOWLINE OF STANDARD CURB UNLESS OTHERWISE SPECIFIED.
- CONTRACTOR SHALL PARK EQUIPMENT AND VEHICLES AS NOT TO INTERFERE WITH NORMAL ACTIVITIES OF RESIDENTS OR OTHER CONTRACTORS ON SITE.
- ANY DAMAGE TO THE EXISTING FACILITIES (CURB & GUTTER, PAVEMENT, CONDUITS, LANDSCAPING, UTILITY LINES, ETC.) DURING CONSTRUCTION SHALL BE REPLACED AT THE CONTRACTORS' EXPENSE.
- ANY ADDITIONAL GRADING REQUIRED TO MATCH PROPOSED STREET GRADES SHALL BE INCIDENTAL TO PAVING ITEMS.
- REMOVAL OF THE EXISTING CURB & GUTTER SHALL BE PER C.O.A. STD. DWG. 2415 (SAW CUT ONLY).
- WHEELCHAIR RAMPS SHALL BE CONSTRUCTED PRIOR TO ACCEPTANCE OF CURB AND GUTTER.
- ALL EXCAVATION, TRENCHING AND SHORING ACTIVITIES MUST BE CARRIED-OUT IN ACCORDANCE WITH OSHA 29 CFR 1926.650 SUBPART B.
- CONTRACTOR SHALL FIELD VERIFY ALL EXISTING UTILITIES AND TRANSMISSION GAS LINES. CONTRACTOR SHALL COORDINATE RELOCATION OF UTILITY LINES WITH UTILITY COMPANIES AS REQUIRED.
- CONTRACTOR IS RESPONSIBLE FOR REPAIR AND/OR REPLACEMENT OF ALL UTILITY CONDUITS AND EXISTING LINES.
- CONTRACTOR IS TO INSTALL A 4" X 4" X 5' POST AND END AT THE END OF EACH SANITARY SEWER SERVICE.
- CONTRACTOR SHALL PROVIDE THE INSPECTORS (CITY AND PRIVATE) WITH THE PROPOSED HYDROSTATIC TESTING PLAN. THE PLAN MUST BE APPROVED BEFORE TESTING OPERATIONS BEGIN.
- WM RHIMS AND CATCH BASIN INLET ELEVATIONS, VALVE BOXES, ARV, FIRE HYDRANT & FLANGE ELEVATIONS ARE APPROXIMATE. CONTRACTOR SHALL FIELD VERIFY AND ADJUST TO FINAL PAVEMENT GRADES.
- SAS STATIONING FOLLOWS CL OF ROAD UNLESS OTHERWISE NOTED.
- STATIONING OF DROP INLET IS TO MIDDLE OF DOWN HILL GRATE AT FACE OF CURB.
- FLOWLINE ELEVATIONS FOR DROP DROP INLETS ARE PROJECTED FROM FLOWLINE OF STANDARD CURB TO MIDDLE OF DOWNHILL GRATE.
- FOR STORM DRAIN CONSTRUCTION: ALL RCP JOINTS SHALL BE GROUTED PRIOR TO FINAL INSPECTION. FINAL INSPECTION SHALL DETERMINE WHICH JOINTS ARE TO BE GROUTED FOR FINAL ACCEPTANCE OF THE CONSTRUCTION.
- ALL UTILITY CURVE DATA AND DIMENSIONS ARE CALCULATED FROM CENTERLINE OF PIPE OR MANHOLE. ALL SAS & SD SLOPES ARE CALCULATED TO TRUE PIPE DIMENSIONS FROM INVERT TO INVERT. (PAY ITEMS ARE SHOWN IN PARENTHESES.)
20. DENOTES CROWN TRANSITION PER C.O.A. STD. DWG. 2401.

LEGEND

- DOUBLE WATER METER PER COA STD. DWGS 2361, 2362, 2366 & 2368
- SINGLE WATER METER PER COA STD. DWGS 2361, 2362, 2366 & 2368
- WATER LINE SHUTOFF VALVE PER STD. DWGS 2326 & 2328
- WATER LINE TEE
- SAS LATERAL
- SAS MANHOLE
- STORM DRAIN MANHOLE
- STORM DRAIN INLET
- PROPOSED FIRE HYDRANT
- EXISTING WATER VALVE
- PROPOSED STREET LIGHT


Bohannon & Huston

Courtney I 7600 Jefferson St. NE Albuquerque, NM 87108-4395
ENGINEERING & SPATIAL DATA & ADVANCED TECHNOLOGIES



CITY OF ALBUQUERQUE
PUBLIC WORKS DEPARTMENT

LONGFORD VILLAGE EAST SUBDIVISION
UTILITY PLAN AND PROFILE
JICAMA WAY STA. 10+00.00 - 17+00.00

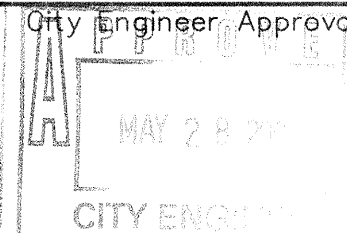


Last Design Update

Mo./Day/Yr.	


W/L Tangent Table		
ID	BEARING	LENGTH
11	S43°42'31"E	38.89'
12	S43°42'31"E	26.89'
13	S00°18'32"W	33.35'
14	S00°18'32"W	44.00'
15	S00°18'32"W	61.71'
16	S00°18'32"W	150.02'

SAS Tangent Table		
ID	BEARING	LENGTH
17	S00°18'32"W	145.95'
18	N07°11'23"E	70.58'

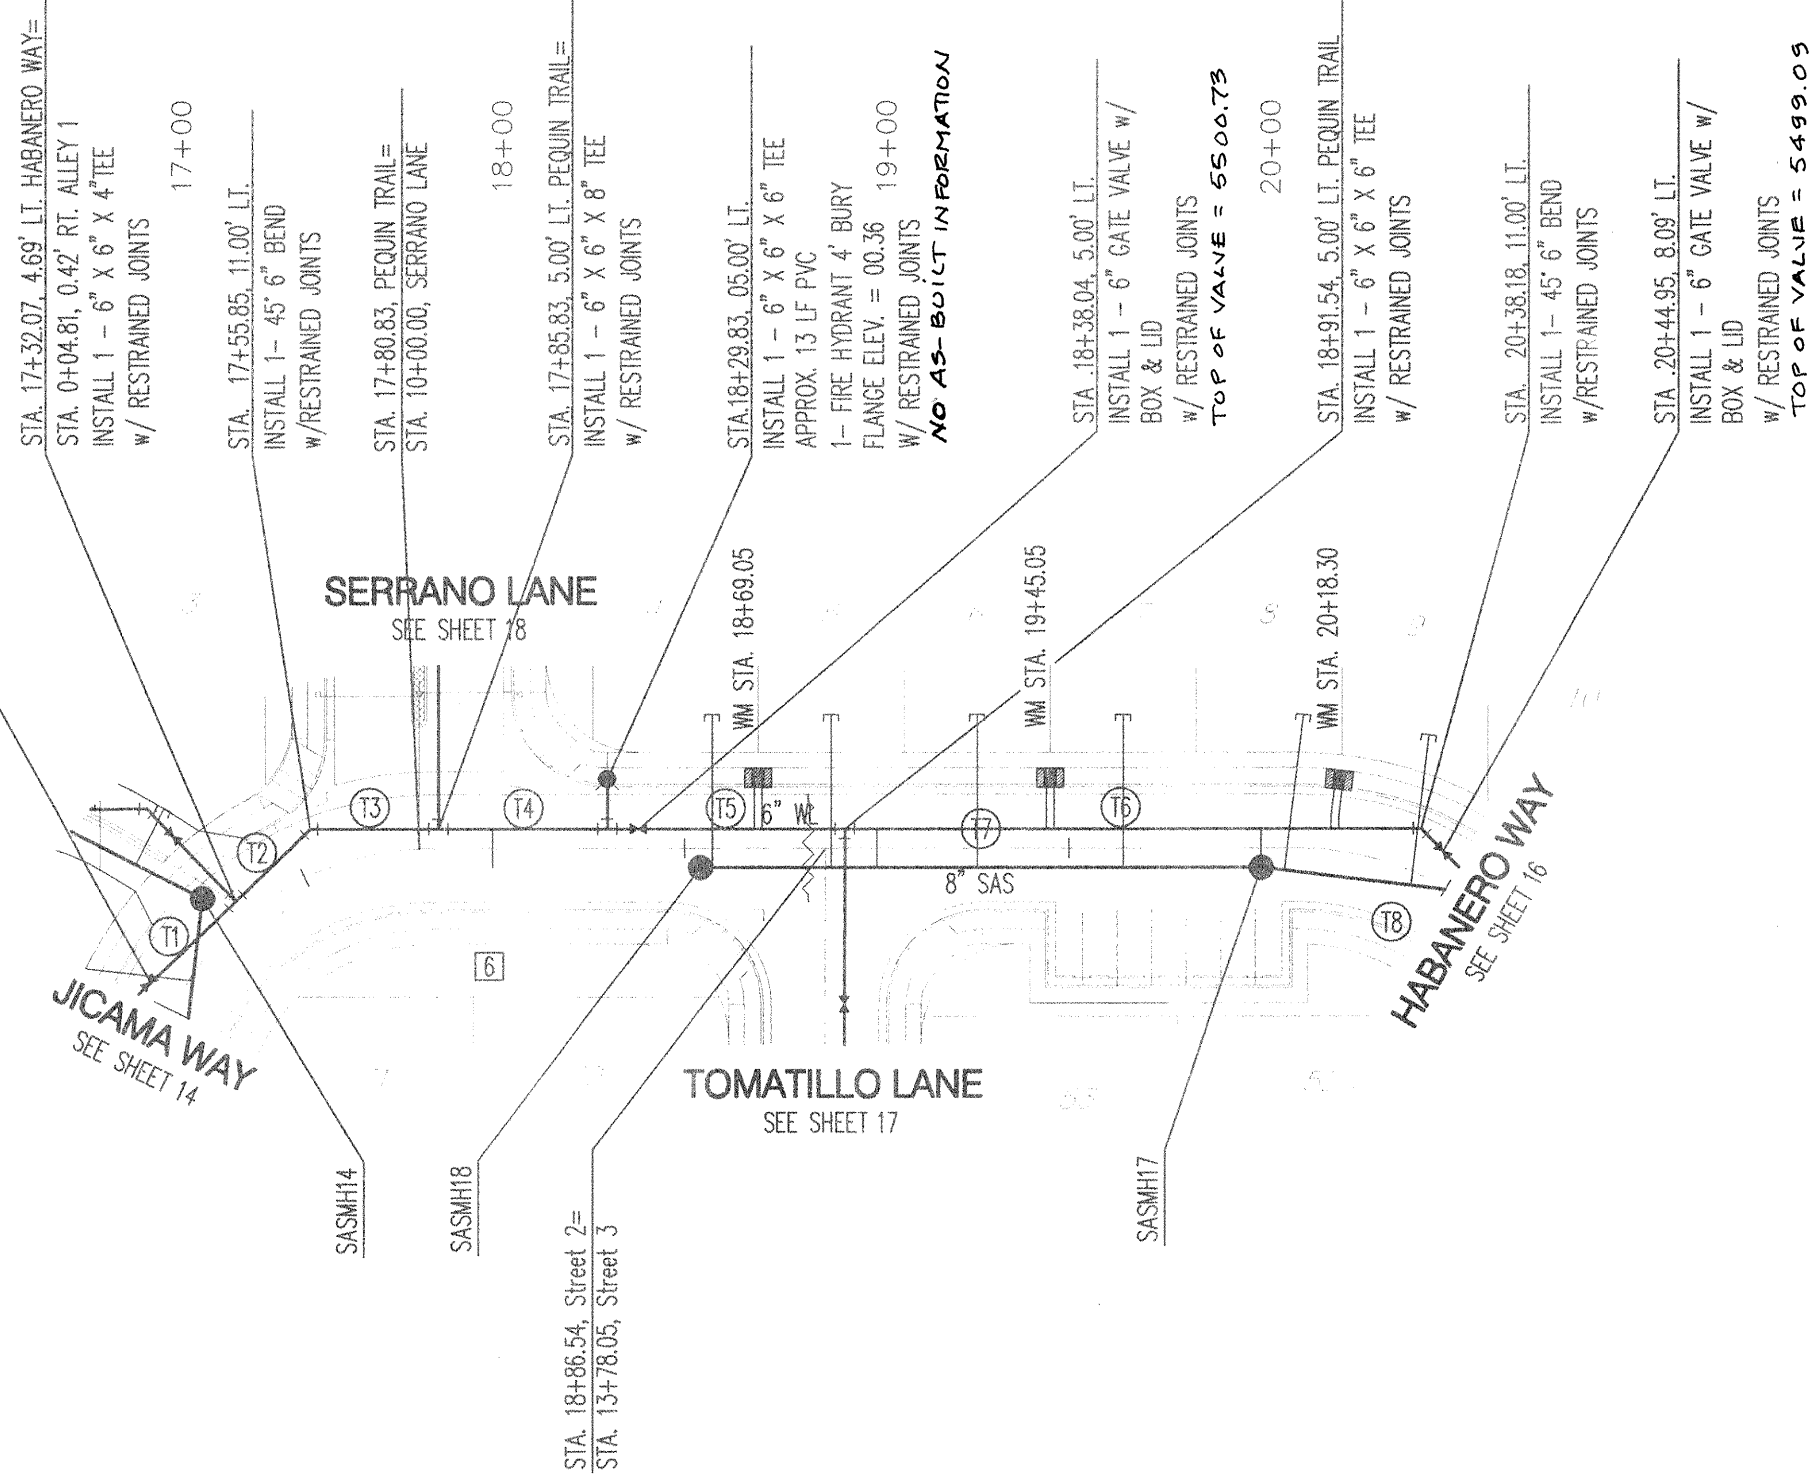

SANITARY SEWER SERVICES			
LOT ID	SAS STATION & OFFSET	SAS LENGTH	TOP OF PIPE AT PLUG (W/RISER)
4	18+57.05, 5.00' RT.	40.00'	5492.59 (3')
5	18+88.05, 5.00' RT.	40.00'	5495.06
6	19+26.05, 5.00' RT.	40.00'	5494.83
7	19+64.05, 5.00' RT.	40.00'	5494.60
8	20+06.13, 5.74' RT.	41.03'	5494.29
9	20+41.32, 3.56' RT.	39.69'	5493.61
10	20+64.31, 7.99' LT.	31.10'	5492.93

NOTE: WATER METER LOCATIONS ARE DESIGNATED
BY STATIONING AT PROPERTY CORNERS.

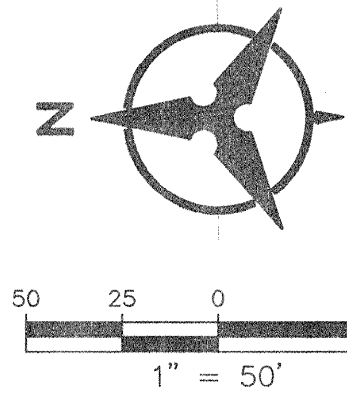

PEQUIN TRAIL

ELEVATIONS ARE IN NGVD 29



NOTES

- THE CONTRACTOR SHALL FIELD VERIFY ALL EXISTING UTILITY LOCATIONS AND NOTIFY THE ENGINEER IMMEDIATELY OF ANY DISCREPANCIES.
- ALL PAVING CURVE DATA AND DIMENSIONS REFER TO FACE OF CURB UNLESS OTHERWISE SPECIFIED.
- GRADE ELEVATIONS, WHERE NOTED, ARE FOR FLOWLINE OF STANDARD CURB UNLESS OTHERWISE SPECIFIED.
- CONTRACTOR SHALL PARK EQUIPMENT AND VEHICLES AS NOT TO INTERFERE WITH NORMAL ACTIVITIES OF RESIDENTS OR OTHER CONTRACTORS ON SITE.
- ANY DAMAGE TO THE EXISTING FACILITIES (CURB & GUTTER, PAVEMENT, CONDUITS, LANDSCAPING, UTILITY LINES, ETC.) DURING CONSTRUCTION SHALL BE REPLACED AT THE CONTRACTORS' EXPENSE.
- ANY ADDITIONAL GRADING REQUIRED TO MATCH PROPOSED STREET GRADES SHALL BE INCIDENTAL TO PAVING ITEMS.
- REMOVAL OF THE EXISTING CURB & GUTTER SHALL BE PER C.O.A. STD. DWG. 2415 (SAWOUT ONLY).
- WHEELCHAIR RAMPS SHALL BE CONSTRUCTED PRIOR TO ACCEPTANCE OF CURB AND GUTTER.
- ALL EXCAVATION, TRENCHING AND SHORING ACTIVITIES MUST BE CARRIED-OUT IN ACCORDANCE WITH OSHA 29 CFR 1926.650 SUBPART B.
- CONTRACTOR SHALL FIELD VERIFY ALL EXISTING UTILITIES AND TRANSMISSION GAS LINES. CONTRACTOR SHALL COORDINATE RELOCATION OF UTILITY LINES WITH UTILITY COMPANIES AS REQUIRED.
- CONTRACTOR IS RESPONSIBLE FOR REPAIR AND/OR REPLACEMENT OF ALL UTILITY CONDUITS AND EXISTING LINES.
- CONTRACTOR IS TO INSTALL A 4" X 4" X 5' POST AND END AT THE END OF EACH SANITARY SEWER SERVICE.
- CONTRACTOR SHALL PROVIDE THE INSPECTORS (CITY AND PRIVATE) WITH THE PROPOSED HYDROSTATIC TESTING PLAN. THE PLAN MUST BE APPROVED BEFORE TESTING OPERATIONS BEGIN.
- WH RIMS AND CATCH BASIN INLET ELEVATIONS, VALVE BOXES, ARV, FIRE HYDRANT & FLANGE ELEVATIONS ARE APPROXIMATE. CONTRACTOR SHALL FIELD VERIFY AND ADJUST TO FINAL PAVEMENT GRADES.
- SAS STATIONING FOLLOWS CL OF ROAD UNLESS OTHERWISE NOTED.
- STATIONING OF DROP INLET IS TO MIDDLE OF DOWN HILL GRATE AT FACE OF CURB.
- FLOWLINE ELEVATIONS FOR DROP DROP INLETS ARE PROJECTED FROM FLOWLINE OF STANDARD CURB TO MIDDLE OF DOWNHILL GRATE.
- FOR STORM DRAIN CONSTRUCTION: ALL RCP JOINTS SHALL BE GROUTED PRIOR TO FINAL INSPECTION. FINAL INSPECTION SHALL DETERMINE WHICH JOINTS ARE TO BE GROUTED FOR FINAL ACCEPTANCE OF THE CONSTRUCTION.
- ALL UTILITY CURVE DATA AND DIMENSIONS ARE CALCULATED FROM CENTERLINE OF PIPE OR MANHOLE. ALL SAS & SD SLOPES ARE CALCULATED TO TRUE PIPE DIMENSIONS FROM INVERT TO INVERT. (PAY ITEMS ARE SHOWN IN PARENTHESES.)
- DENOTES CROWN TRANSITION PER C.O.A. STD. DWG. 2401.

LEGEND

- DOUBLE WATER METER PER COA STD. DWGS 2361, 2362, 2366 & 2368
- SINGLE WATER METER PER COA STD. DWGS 2361, 2362, 2366 & 2368
- WATER LINE SHUTOFF VALVE PER STD. DWGS 2326 & 2328
- WATER LINE TEE
- SAS LATERAL
- SAS MANHOLE
- STORM DRAIN MANHOLE
- STORM DRAIN INLET
- PROPOSED FIRE HYDRANT
- EXISTING WATER VALVE
- PROPOSED STREET LIGHT

Bohannon & Huston

Courtyard I 7500 Jefferson St. NE Albuquerque, NM 87109-4395
ENGINEERING • SPATIAL DATA • ADVANCED TECHNOLOGIES





**CITY OF ALBUQUERQUE
PUBLIC WORKS DEPARTMENT**

**LONGFORD VILLAGE EAST SUBDIVISION
UTILITY PLAN AND PROFILE
PEQUIN TRAIL STA. 17+00.00 - 20+50.00**

DESIGN REVIEW COMMITTEE	CITY ENGINEER APPROVAL	Mo./Day/Yr.	Mo./Day/Yr.
APR 19 2004	MAY 28 2004		
DESIGN REVIEW COMMITTEE	CITY ENGINEER		

City Project No.	Zone Map No.	Sheet	Of
732881	L-21-Z	15	23

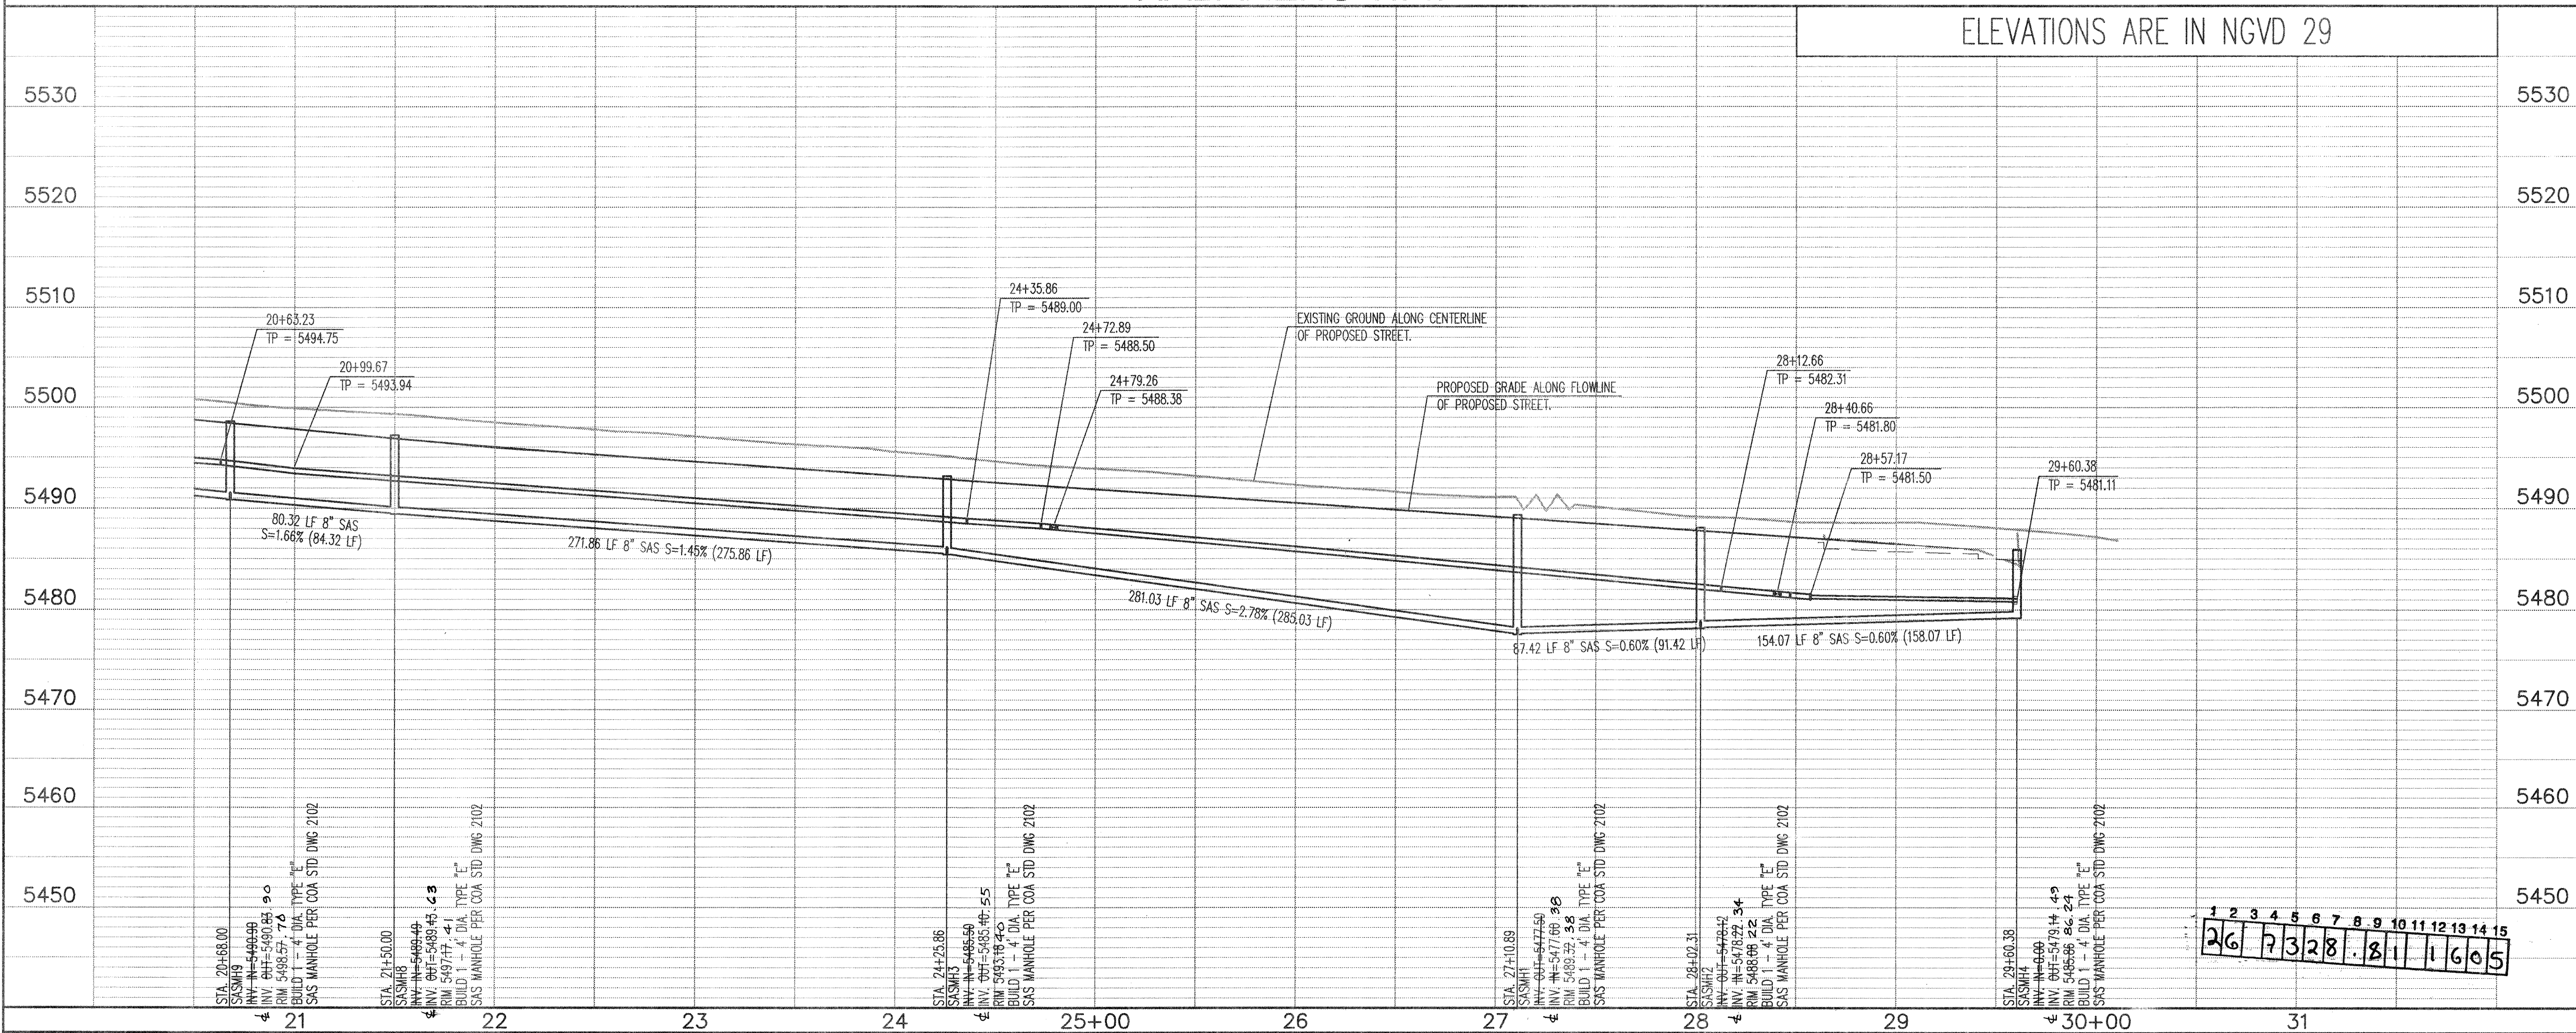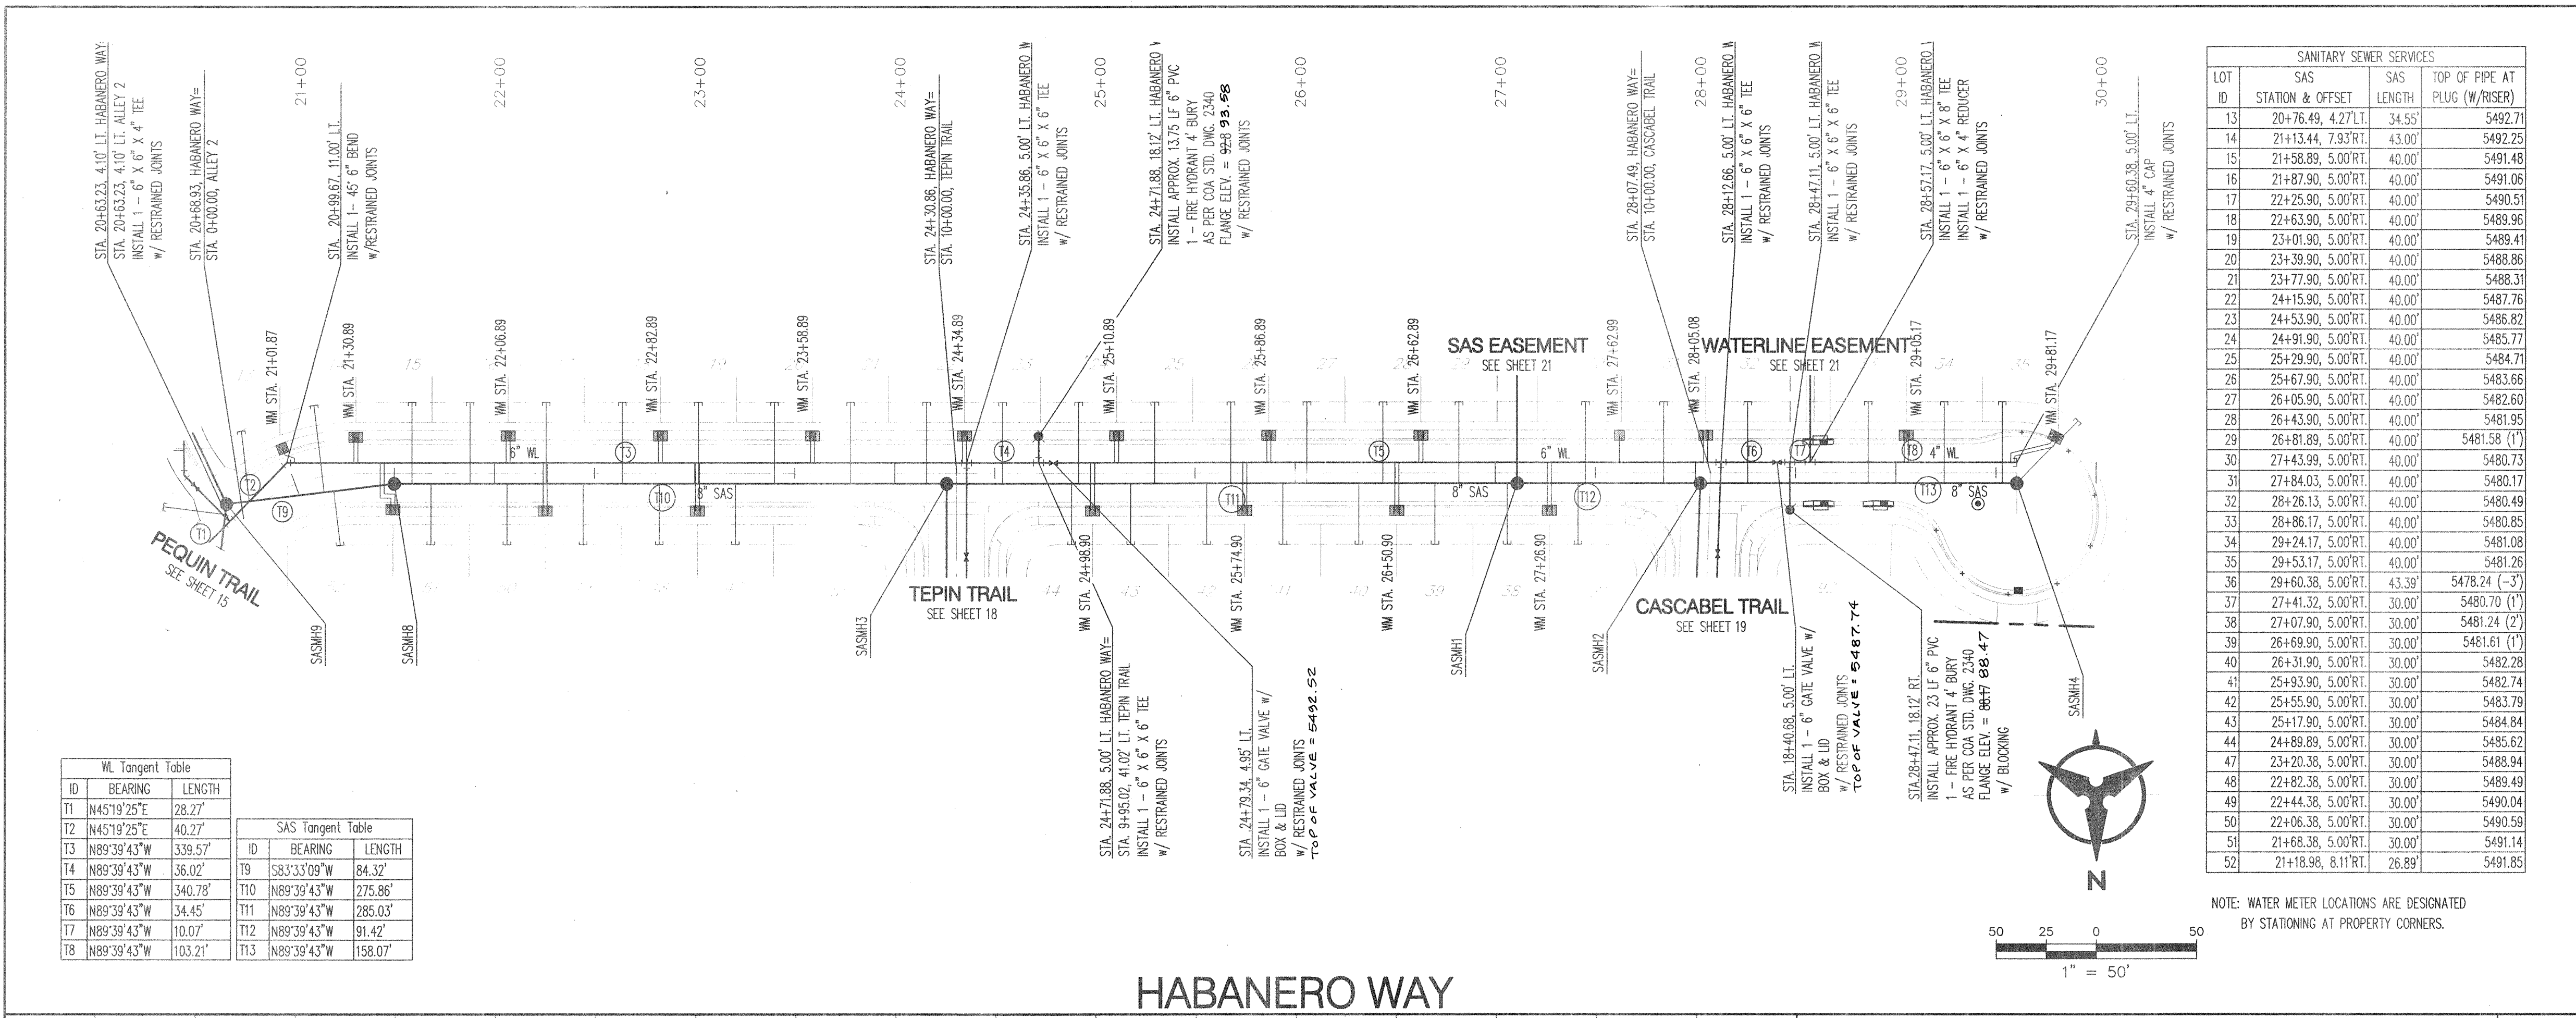

P:\040199\cdp\pnp\040199_Upnp03.dwg
April 12, 2004 - 10:08am

SCALE: 1" = 50' (HORIZ.)
1" = 10' (VERT.)

NOTES

1. THE CONTRACTOR SHALL FIELD VERIFY ALL EXISTING UTILITY LOCATIONS AND NOTIFY THE ENGINEER IMMEDIATELY OF ANY DISCREPANCIES.
2. ALL PAVING CURVE DATA AND DIMENSIONS REFER TO FACE OF CURB UNLESS OTHERWISE SPECIFIED.
3. GRADE ELEVATIONS, WHERE NOTED, ARE FOR FLOWLINE OF STANDARD CURB UNLESS OTHERWISE SPECIFIED.
4. CONTRACTOR SHALL PARK EQUIPMENT AND VEHICLES AS NOT TO INTERFERE WITH NORMAL ACTIVITIES OF RESIDENTS OR OTHER CONTRACTORS ON SITE.
5. ANY DAMAGE TO THE EXISTING FACILITIES (CURB & GUTTER, PAVEMENT, CONDUITS, LANDSCAPING, UTILITY LINES, ETC.) DURING CONSTRUCTION SHALL BE REPLACED AT THE CONTRACTORS' EXPENSE.
6. ANY ADDITIONAL GRADING REQUIRED TO MATCH PROPOSED STREET GRADES SHALL BE INCIDENTAL TO PAVING ITEMS.
7. REMOVAL OF THE EXISTING CURB & GUTTER SHALL BE PER C.O.A. STD. DWG. 2415 (SAWTOOTH ONLY).
8. WHEELCHAIR RAMPS SHALL BE CONSTRUCTED PRIOR TO ACCEPTANCE OF CURB AND GUTTER.
9. ALL EXCAVATION, TRENCHING AND SHORING ACTIVITIES MUST BE CARRIED-OUT IN ACCORDANCE WITH OSHA 29 CFR 1926.650 SUBPART B.
10. CONTRACTOR SHALL FIELD VERIFY ALL EXISTING UTILITIES AND TRANSMISSION GAS LINES. CONTRACTOR SHALL COORDINATE RELOCATION OF UTILITY LINES WITH UTILITY COMPANIES AS REQUIRED.
11. CONTRACTOR IS RESPONSIBLE FOR REPAIR AND/OR REPLACEMENT OF ALL UTILITY CONDUITS AND EXISTING LINES.
12. CONTRACTOR IS TO INSTALL A 4" X 4" X 4" S' POST AND END AT THE END OF EACH SANITARY SEWER SERVICE.
13. CONTRACTOR SHALL PROVIDE THE INSPECTORS (CITY AND PRIVATE) WITH THE PROPOSED HYDROSTATIC TESTING PLAN. THE PLAN MUST BE APPROVED BEFORE TESTING OPERATIONS BEGIN.
14. MH RIMS AND CATCH BASIN INLET ELEVATIONS, VALVE BOXES, ARV, FIRE HYDRANT & FLANGE ELEVATIONS ARE APPROXIMATE. CONTRACTOR SHALL FIELD VERIFY AND ADJUST TO FINAL PAVEMENT GRADES.
15. SAS STATIONING FOLLOWS CL OF ROAD UNLESS OTHERWISE NOTED.
16. STATIONING OF DROP INLET IS TO MIDDLE OF DOWN HILL GRATE AT FACE OF CURB.
17. FLOWLINE ELEVATIONS FOR DROP INLET ARE PROJECTED FROM FLOWLINE OF STANDARD CURB TO MIDDLE OF DOWNHILL GRATE.
18. FOR STORM DRAIN CONSTRUCTION: ALL RCP JOINTS SHALL BE GROUTED PRIOR TO FINAL INSPECTION. FINAL INSPECTION SHALL DETERMINE WHICH JOINTS ARE TO BE GROUTED FOR FINAL ACCEPTANCE OF THE CONSTRUCTION.
19. ALL UTILITY CURVE DATA AND DIMENSIONS ARE CALCULATED FROM CENTERLINE OF PIPE OR MANHOLE. ALL SAS & SD SLOPES ARE CALCULATED TO TRUE PIPE DIMENSIONS FROM INLET TO CROWN. (PAY ITEMS ARE SHOWN IN PARENTHESES.)
20. DENOTES CROWN TRANSITION PER C.O.A. STD. DWG. 2401.

LEGEND

- | | |
|---|---|
|  | DOUBLE WATER METER PER COA STD. DWGS
2361, 2362, 2366 & 2368 |
|  | SINGLE WATER METER PER COA STD. DWGS
2361, 2362, 2366 & 2368 |
|  | WATER LINE SHUTOFF VALVE PER STD. DWGS
2326 & 2328 |
|  | WATER LINE TEE |
|  | SAS LATERAL |
|  | SAS MANHOLE |
|  | STORM DRAIN MANHOLE |
|  | STORM DRAIN INLET |
|  | PROPOSED FIRE HYDRANT |
|  | EXISTING WATER VALVE |
|  | PROPOSED STREET LIGHT |

Bohannon Huston^{INC.}

Courtyard I 7500 Jefferson St. NE Albuquerque, NM 87109-4335
ENGINEERING • SPATIAL DATA • ADVANCED TECHNOLOGIES



CITY OF ALBUQUERQUE
PUBLIC WORKS DEPARTMENT

LONGFORD VILLAGE EAST SUBDIVISION

UTILITY PLAN AND PROFILE
HABANERO WAY STA. 20+50.00 - 30+00.00

Design Review Committee	City Engineer Approval	Mo./Day/Yr.	Mo./Day/Yr.

APPROVE	DATE	Signature Update		
MAY 28 2000				

APR 19 2004
DESIGN
CITY ENGINEER


REVIEW COMMITTEE City of Chicago Department of Public Works		9	
City Project No. 732881	Zone Map No. 1 21 7	Sheet 16	Of

752881	L-21-2	16
--------	--------	----

[illegible]


SCANNED BY
MESA REPRO

WL Tangent Table			SAS Tangent Table		
ID	BEARING	LENGTH	ID	BEARING	LENGTH
T1	N89°39'43"W	388.05'	T2	N89°39'43"W	312.79'

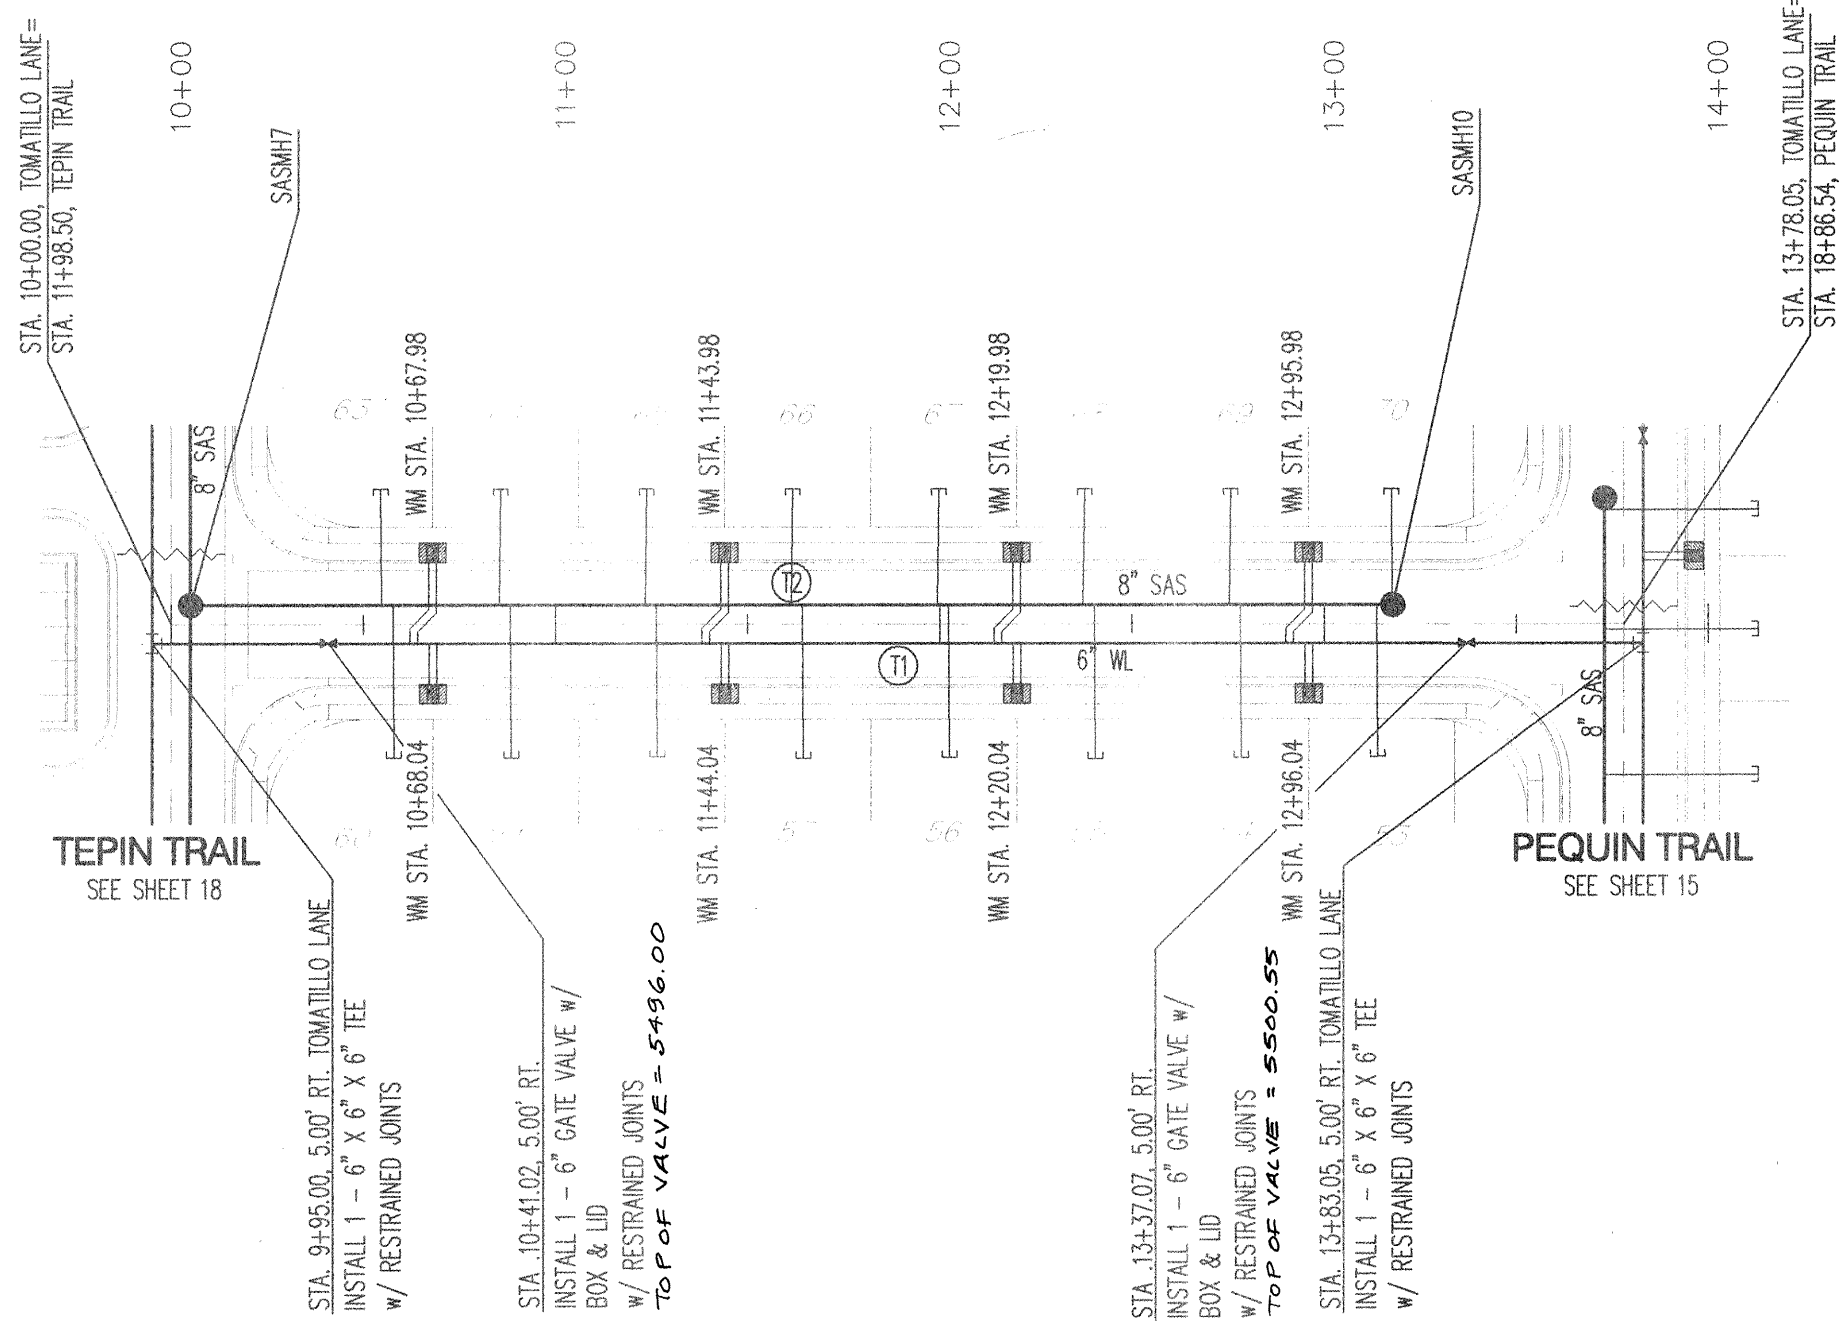

SANITARY SEWER SERVICES			
LOT ID	SAS STATION & OFFSET	SAS LENGTH	TOP OF PIPE AT PLUG (W/RISE)
53	13+15.07, 5.00' LT.	40.00'	5494.63
54	12+77.04, 5.00' LT.	40.00'	5494.06
55	12+39.04, 5.00' LT.	40.00'	5493.49
56	12+01.04, 5.00' LT.	40.00'	5492.92
57	11+63.04, 5.00' LT.	40.00'	5492.36
58	11+25.04, 5.00' LT.	40.00'	5491.79
59	10+87.04, 5.00' LT.	40.00'	5491.22
60	10+49.03, 5.00' LT.	40.00'	5490.81
63	10+58.98, 5.00' LT.	30.00'	5490.61
64	10+86.98, 5.00' LT.	30.00'	5491.02
65	11+24.98, 5.00' LT.	30.00'	5491.59
66	11+62.98, 5.00' LT.	30.00'	5492.16
67	12+00.98, 5.00' LT.	30.00'	5492.72
68	12+38.98, 5.00' LT.	30.00'	5493.29
69	12+76.98, 5.00' LT.	30.00'	5493.86
70	13+14.68, 5.00' LT.	30.00'	5494.46

NOTE: WATER METER LOCATIONS ARE DESIGNATED BY STATIONING AT PROPERTY CORNERS.

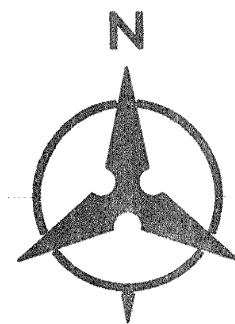

50 25 0 50
1" = 50'

TOMATILLO LANE

ELEVATIONS ARE IN NGVD 29



NOTES

- THE CONTRACTOR SHALL FIELD VERIFY ALL EXISTING UTILITY LOCATIONS AND NOTIFY THE ENGINEER IMMEDIATELY OF ANY DISCREPANCIES.
- ALL PAVING CURVE DATA AND DIMENSIONS REFER TO FACE OF CURB UNLESS OTHERWISE SPECIFIED.
- GRADE ELEVATIONS, WHERE NOTED, ARE FOR FLOWLINE OF STANDARD CURB UNLESS OTHERWISE SPECIFIED.
- CONTRACTOR SHALL PARK EQUIPMENT AND VEHICLES AS NOT TO INTERFERE WITH NORMAL ACTIVITIES OF RESIDENTS OR OTHER CONTRACTORS ON SITE.
- ANY DAMAGE TO THE EXISTING FACILITIES (CURB & GUTTER, PAVEMENT, CONDUITS, LANDSCAPING, UTILITY LINES, ETC.) DURING CONSTRUCTION SHALL BE REPLACED AT THE CONTRACTORS' EXPENSE.
- ANY ADDITIONAL GRADING REQUIRED TO MATCH PROPOSED STREET GRADES SHALL BE INCIDENTAL TO PAVING ITEMS.
- REMOVAL OF THE EXISTING CURB & GUTTER SHALL BE PER C.O.A. STD. DWG. 2415 (SAWOUT ONLY).
- WHEELCHAIR RAMPS SHALL BE CONSTRUCTED PRIOR TO ACCEPTANCE OF CURB AND GUTTER.
- ALL EXCAVATION, TRENCHING AND SHORING ACTIVITIES MUST BE CARRIED-OUT IN ACCORDANCE WITH OSHA 29 CFR 1926.650 SUBPART B.
- CONTRACTOR SHALL FIELD VERIFY ALL EXISTING UTILITIES AND TRANSMISSION GAS LINES. CONTRACTOR SHALL COORDINATE RELOCATION OF UTILITY LINES WITH UTILITY COMPANIES AS REQUIRED.
- CONTRACTOR IS RESPONSIBLE FOR REPAIR AND/OR REPLACEMENT OF ALL UTILITY CONDUITS AND EXISTING LINES.
- CONTRACTOR IS TO INSTALL A 4" X 4" X 5' POST AND END AT THE END OF EACH SANITARY SEWER SERVICE.
- CONTRACTOR SHALL PROVIDE THE INSPECTORS (CITY AND PRIVATE) WITH THE PROPOSED HYDROSTATIC TESTING PLAN. THE PLAN MUST BE APPROVED BEFORE TESTING OPERATIONS BEGIN.
- MH RIMS AND CATCH BASIN INLET ELEVATIONS, VALVE BOXES, ARV, FIRE HYDRANT & FLANGE ELEVATIONS ARE APPROXIMATE. CONTRACTOR SHALL FIELD VERIFY AND ADJUST TO FINAL PAVEMENT GRADES.
- SAS STATIONING FOLLOWS CL OF ROAD UNLESS OTHERWISE NOTED.
- STATIONING OF DROP INLET IS TO MIDDLE OF DOWN HILL GRATE AT FACE OF CURB.
- FLOWLINE ELEVATIONS FOR DROP DROP INLETS ARE PROJECTED FROM FLOWLINE OF STANDARD CURB TO MIDDLE OF DOWNHILL GRATE.
- FOR STORM DRAIN CONSTRUCTION: ALL RCP JOINTS SHALL BE GROUTED PRIOR TO FINAL INSPECTION. FINAL INSPECTION SHALL DETERMINE WHICH JOINTS ARE TO BE GROUTED FOR FINAL ACCEPTANCE OF THE CONSTRUCTION.
- ALL UTILITY CURVE DATA AND DIMENSIONS ARE CALCULATED FROM CENTERLINE OF PIPE OR MANHOLE. ALL SAS & SD SLOPES ARE CALCULATED TO TRUE PIPE DIMENSIONS FROM INVERT TO INVERT. (PAY ITEMS ARE SHOWN IN PARENTHESES.)
- DENOTES CROWN TRANSITION PER C.O.A. STD. DWG. 2401.

LEGEND

- DOUBLE WATER METER PER COA STD. DWGS 2361, 2362, 2366 & 2368
- SINGLE WATER METER PER COA STD. DWGS 2361, 2362, 2366 & 2368
- WATER LINE SHUTOFF VALVE PER STD. DWGS 2326 & 2328
- WATER LINE TEE
- SAS LATERAL
- SAS MANHOLE
- STORM DRAIN MANHOLE
- STORM DRAIN INLET
- PROPOSED FIRE HYDRANT
- EXISTING WATER VALVE
- PROPOSED STREET LIGHT



Bohannon & Huston

Contractor | 7600 Jefferson St. NE Albuquerque, NM 87109-4395
ENGINEERING & SPATIAL DATA & ADVANCED TECHNOLOGIES



CITY OF ALBUQUERQUE
PUBLIC WORKS DEPARTMENT

LONGFORD VILLAGE EAST SUBDIVISION
UTILITY PLAN AND PROFILE
TOMATILLO LANE

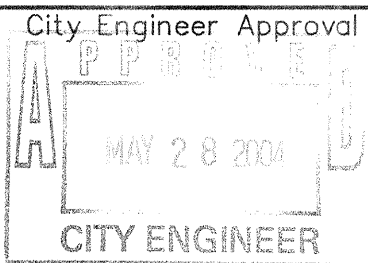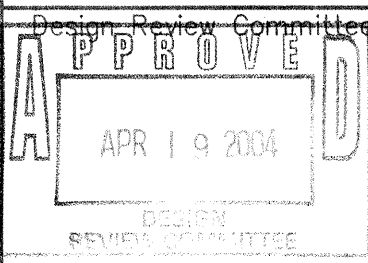

Last Design Update

City Project No.

732881

Zone Map No.

L-21-Z



Sheet


Of

17

23

SCALE: 1" = 50' (HORIZ.)
1" = 10' (VERT.)

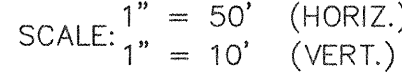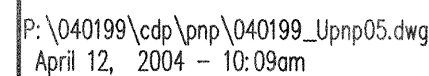

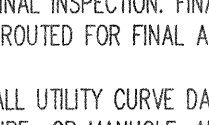1. THE CONTRACTOR SHALL FIELD VERIFY ALL EXISTING UTILITY LOCATIONS AND NOTIFY THE ENGINEER IMMEDIATELY OF ANY DISCREPANCIES.
2. ALL PAVING CURVE DATA AND DIMENSIONS REFER TO FACE OF CURB UNLESS OTHERWISE SPECIFIED.
3. GRADE ELEVATIONS, WHERE NOTED, ARE FOR FLOWLINE OF STANDARD CURB UNLESS OTHERWISE SPECIFIED.
4. CONTRACTOR SHALL PARK EQUIPMENT AND VEHICLES AS NOT TO INTERFERE WITH NORMAL ACTIVITIES OF RESIDENTS OR OTHER CONTRACTORS ON SITE.
5. ANY DAMAGE TO THE EXISTING FACILITIES (CURB & GUTTER, PAVEMENT, CONDUITS, LANDSCAPING, UTILITY LINES, ETC.) DURING CONSTRUCTION SHALL BE REPLACED AT THE CONTRACTORS' EXPENSE.
6. ANY ADDITIONAL GRADING REQUIRED TO MATCH PROPOSED STREET GRADES SHALL BE INCIDENTAL TO PAVING ITEMS.
7. REMOVAL OF THE EXISTING CURB & GUTTER SHALL BE PER C.O.A. STD. DWG. 2415 (SAWJUT ONLY).
8. WHEELCHAIR RAMPS SHALL BE CONSTRUCTED PRIOR TO ACCEPTANCE OF CURB AND GUTTER.
9. ALL EXCAVATION, TRENCHING AND SHORING ACTIVITIES MUST BE CARRIED-OUT IN ACCORDANCE WITH OSHA 29 CFR 1926.650 SUBPART B.
10. CONTRACTOR SHALL FIELD VERIFY ALL EXISTING UTILITIES AND TRANSMISSION GAS LINES. CONTRACTOR SHALL COORDINATE RELOCATION OF UTILITY LINES WITH UTILITY COMPANIES AS REQUIRED.
11. CONTRACTOR IS RESPONSIBLE FOR REPAIR AND/OR REPLACEMENT OF ALL UTILITY CONDUITS AND EXISTING LINES.
12. CONTRACTOR IS TO INSTALL A 4" X 4" X 5' POST AND END AT THE END OF EACH SANITARY SEWER SERVICE.
13. CONTRACTOR SHALL PROVIDE THE INSPECTORS (CITY AND PRIVATE) WITH THE PROPOSED HYDROSTATIC TESTING PLAN. THE PLAN MUST BE APPROVED BEFORE TESTING OPERATIONS BEGIN.
14. MH RIMS AND CATCH BASIN INLET ELEVATIONS, VALVE BOXES, ARV, FIRE HYDRANT & FLANGE ELEVATIONS ARE APPROXIMATE. CONTRACTOR SHALL FIELD VERIFY AND ADJUST TO FINAL PAVEMENT GRADATIONS.
15. SAS STATIONING FOLLOWS CL OF ROAD UNLESS OTHERWISE NOTED.
16. STATIONING OF DROP INLET IS TO MIDDLE OF DOWN HILL GRATE AT FACE OF CURB.
17. FLOWLINE ELEVATIONS FOR DROP DROP INLETS ARE PROJECTED FROM FLOWLINE OF STANDARD CURB TO MIDDLE OF DOWNHILL GRATE.
18. FOR STORM DRAIN CONSTRUCTION, ALL RCP JOINTS ARE TO BE GROUTED PRIOR TO FINAL INSPECTION. FINAL INSPECTION SHALL DETERMINE WHICH JOINTS ARE TO BE GROUTED FOR FINAL ACCEPTANCE OF THE CONSTRUCTION.
19. ALL UTILITY CURVE DATA AND DIMENSIONS ARE CALCULATED FROM CENTERLINE OF PIPE OR MANHOLE. ALL SAS & SD SLOPES ARE CALCULATED TO TRUE PIPE DIMENSIONS FROM INVERT TO INVERT. (PAY ITEMS ARE SHOWN IN PARENTHESES).
20.  DENOTES CROWN TRANSITION PER C.O.A. STD. DWG. 2401

	DOUBLE WATER METER PER COA STD. DWGS 2361, 2362, 2366 & 2368
	SINGLE WATER METER PER COA STD. DWGS 2361, 2362, 2366 & 2368
	WATER LINE SHUTOFF VALVE PER STD. DWGS 2328 & 2328
	WATER LINE TEE
	SAS LATERAL
	SAS MANHOLE
	STORM DRAIN MANHOLE
	STORM DRAIN INLET
	PROPOSED FIRE HYDRANT
	EXISTING WATER VALVE
	PROPOSED STREET LIGHT

Courtyard | 7500 Jefferson St. NE Albuquerque, NM 87109-4335
ENGINEERING ▴ SPATIAL DATA ▴ ADVANCED TECHNOLOGIES



Design Review Committee

MAY 28 2004
 CITY ENGINEER

Zone Map No.


L-21-

[illegible]

SCANNED BY
MESA REPRO



W. Tangent Table		
ID	BEARING	LENGTH
T1	N02°17'55"E	408.92'

SAS Tangent Table		
ID	BEARING	LENGTH
T2	N02°17'55"E	198.62'
T3	N02°17'55"E	189.96'
T4	S14°04'08"E	44.13'

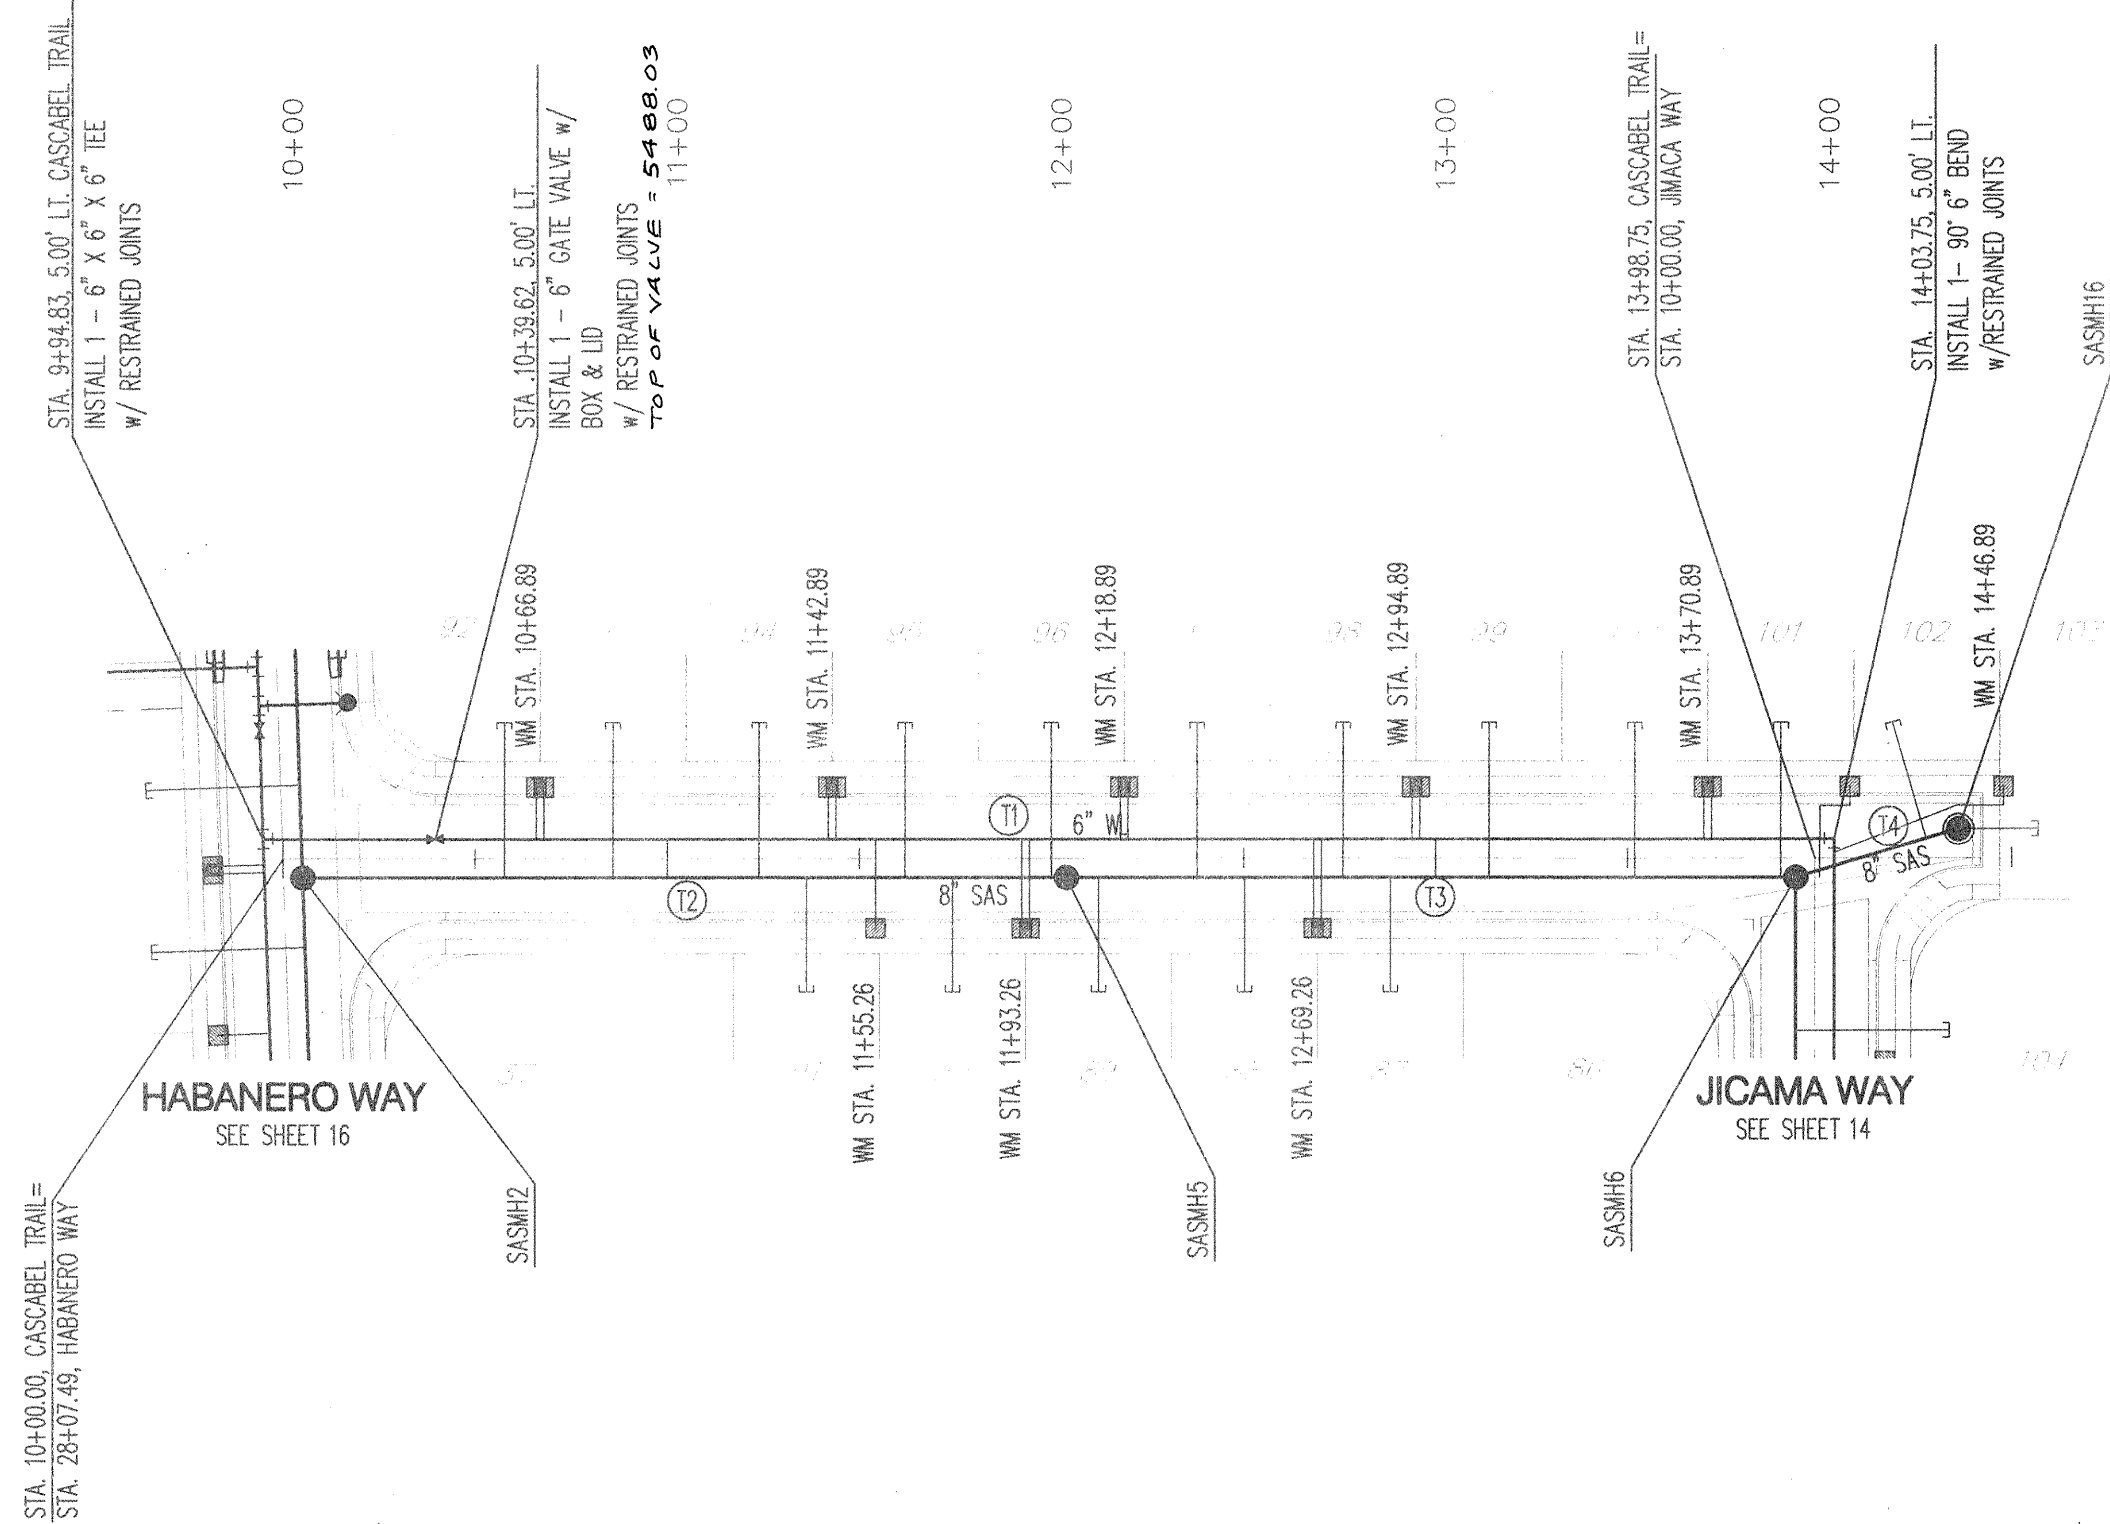


SANITARY SEWER SERVICES			
LOT ID	SAS STATION & OFFSET	SAS LENGTH	TOP OF PIPE AT PLUG (W/RISE)
87	12+88.26, 5.00' RT.	30.00'	5484.92
88	12+50.26, 5.00' RT.	30.00'	5484.69
89	12+12.26, 5.00' RT.	30.00'	5484.47
90	11+74.26, 5.00' RT.	30.00'	5483.74
91	11+36.26, 5.00' RT.	30.00'	5482.93
92	10+57.60, 5.00' RT.	40.00'	5481.44
93	10+85.89, 5.00' RT.	40.00'	5482.05
94	11+23.89, 5.00' RT.	40.00'	5482.86
95	11+61.89, 5.00' RT.	40.00'	5483.67
96	11+99.89, 5.00' RT.	40.00'	5484.49
97	12+37.89, 5.00' RT.	40.00'	5484.82
98	12+75.89, 5.00' RT.	40.00'	5485.05
99	13+13.89, 5.00' RT.	40.00'	5485.28
100	13+51.89, 5.00' RT.	40.00'	5485.50
101	13+89.89, 5.00' RT.	40.00'	5485.73
102	14+27.70, 4.97' LT.	31.30'	5485.87
103	14+36.09, 7.44' LT.	20.79'	5482.27 (3')

NOTE: WATER METER LOCATIONS ARE DESIGNATED BY STATIONING AT PROPERTY CORNERS.

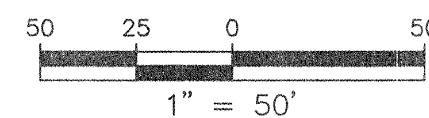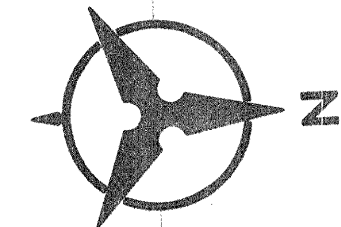

CASCABEL TRAIL

ELEVATIONS ARE IN NGVD 29

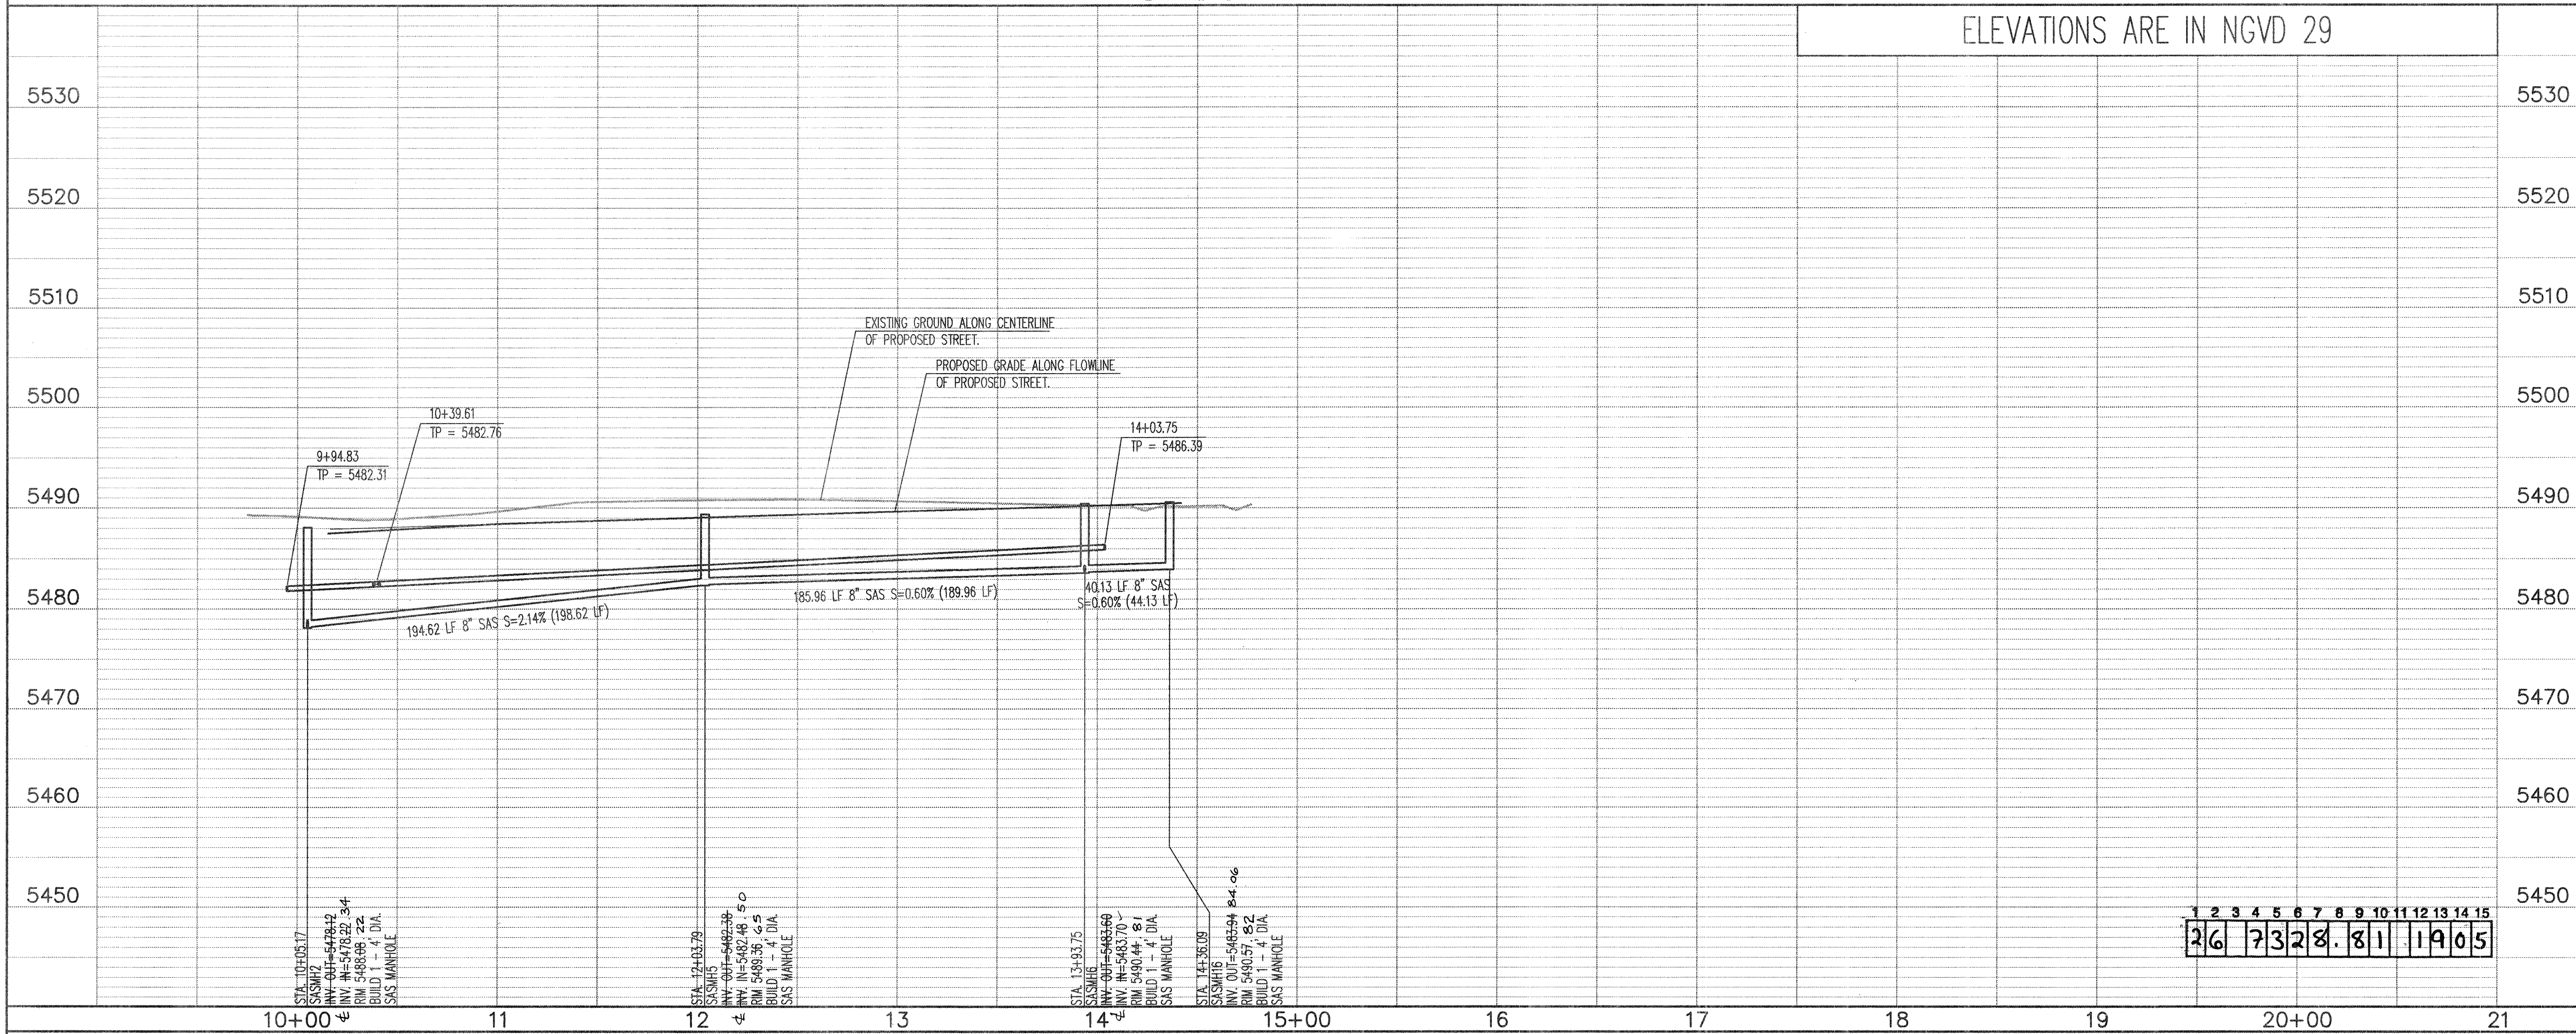

P:\040199\cdp\pmp\040199_Uppm06.dwg
April 12, 2004 - 10:09am

SCALE: 1" = 50' (HORIZ.)
1" = 10' (VERT.)

NOTES

- THE CONTRACTOR SHALL FIELD VERIFY ALL EXISTING UTILITY LOCATIONS AND NOTIFY THE ENGINEER IMMEDIATELY OF ANY DISCREPANCIES.
- ALL PAVING CURVE DATA AND DIMENSIONS REFER TO FACE OF CURB UNLESS OTHERWISE SPECIFIED.
- GRADE ELEVATIONS, WHERE NOTED, ARE FOR FLOWLINE OF STANDARD CURB UNLESS OTHERWISE SPECIFIED.
- CONTRACTOR SHALL PARK EQUIPMENT AND VEHICLES AS NOT TO INTERFERE WITH NORMAL ACTIVITIES OF RESIDENTS OR OTHER CONTRACTORS ON SITE.
- ANY DAMAGE TO THE EXISTING FACILITIES (CURB & GUTTER, PAVEMENT, CONDUITS, LANDSCAPING, UTILITY LINES, ETC.) DURING CONSTRUCTION SHALL BE REPLACED AT THE CONTRACTORS' EXPENSE.
- ANY ADDITIONAL GRADING REQUIRED TO MATCH PROPOSED STREET GRADES SHALL BE INCIDENTAL TO PAVING ITEMS.
- REMOVAL OF THE EXISTING CURB & GUTTER SHALL BE PER C.O.A. STD. DWG. 2415 (SAW CUT ONLY).
- WHEELCHAIR RAMPS SHALL BE CONSTRUCTED PRIOR TO ACCEPTANCE OF CURB AND GUTTER.
- ALL EXCAVATION, TRENCHING AND SHORING ACTIVITIES MUST BE CARRIED-OUT IN ACCORDANCE WITH OSHA 29 CFR 1926.650 SUBPART B.
- CONTRACTOR SHALL FIELD VERIFY ALL EXISTING UTILITIES AND TRANSMISSION GAS LINES. CONTRACTOR SHALL COORDINATE RELOCATION OF UTILITY LINES WITH UTILITY COMPANIES AS REQUIRED.
- CONTRACTOR IS RESPONSIBLE FOR REPAIR AND/OR REPLACEMENT OF ALL UTILITY CONDUITS AND EXISTING LINES.
- CONTRACTOR IS TO INSTALL A 4" X 4" X 5' POST AND EMD AT THE END OF EACH SANITARY SEWER SERVICE.
- CONTRACTOR SHALL PROVIDE THE INSPECTORS (CITY AND PRIVATE) WITH THE PROPOSED HYDROSTATIC TESTING PLAN. THE PLAN MUST BE APPROVED BEFORE TESTING OPERATIONS BEGIN.
- WH RIMS AND CATCH BASIN INLET ELEVATIONS, VALVE BOXES, ARV, FIRE HYDRANT & FLANGE ELEVATIONS ARE APPROXIMATE. CONTRACTOR SHALL FIELD VERIFY AND ADJUST TO FINAL PAVEMENT GRADES.
- SAS STATIONING FOLLOWS CL OF ROAD UNLESS OTHERWISE NOTED.
- STATIONING OF DROP INLET IS TO MIDDLE OF DOWN HILL GRATE AT FACE OF CURB.
- FLOWLINE ELEVATIONS FOR DROP DROP INLETS ARE PROJECTED FROM FLOWLINE OF STANDARD CURB TO MIDDLE OF DOWNHILL GRATE.
- FOR STORM DRAIN CONSTRUCTION: ALL ROP JOINTS SHALL BE GROUTED PRIOR TO FINAL INSPECTION. FINAL INSPECTION SHALL DETERMINE WHICH JOINTS ARE TO BE GROUTED FOR FINAL ACCEPTANCE OF THE CONSTRUCTION.
- ALL UTILITY CURVE DATA AND DIMENSIONS ARE CALCULATED FROM CENTERLINE OF PIPE OR MANHOLE. ALL SAS & SD SLOPES ARE CALCULATED TO TRUE PIPE DIMENSIONS FROM INVERT TO INVERT. (PAY ITEMS ARE SHOWN IN PARENTHESES.)
-  DENOTES CROWN TRANSITION PER C.O.A. STD. DWG. 2401.

LEGEND

-  DOUBLE WATER METER PER COA STD. DWGS 2361, 2362, 2366 & 2368
-  SINGLE WATER METER PER COA STD. DWGS 2361, 2362, 2366 & 2368
-  WATER LINE SHUTOFF VALVE PER STD. DWGS 2326 & 2328
-  WATER LINE TEE
-  SAS LATERAL
-  SAS MANHOLE
-  STORM DRAIN MANHOLE
-  STORM DRAIN INLET
-  PROPOSED FIRE HYDRANT
-  EXISTING WATER VALVE
-  PROPOSED STREET LIGHT



Bohannon & Huston

Courtyard I 7500 Jefferson St. NE Albuquerque, NM 87109-4395
ENGINEERING & SPATIAL DATA & ADVANCED TECHNOLOGIES



CITY OF ALBUQUERQUE
PUBLIC WORKS DEPARTMENT

LONGFORD VILLAGE EAST SUBDIVISION
UTILITY PLAN AND PROFILE
CASCABEL TRAIL

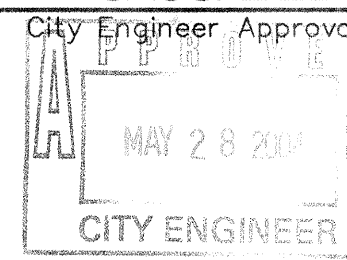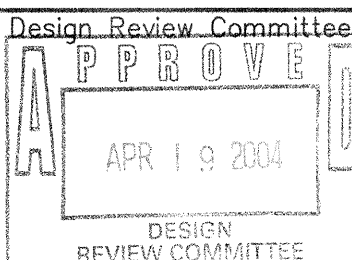

City Project No.

732881

Zone Map No.

L-21-Z


Sheet

Of

19


23

AS-BUILT INFORMATION		BENCH MARKS		SURVEY INFORMATION		ENGINEER'S SEAL	
CONTRACTOR	DATE	ACCS BRASS TABLET STAMPED	NO.	DATE	NO.	NO.	NO.
INSPECTOR	DATE	Geographic Position (NAD 1983)	BY	BY	BY	REMARKS	REVISIONS
FIELD	DATE	N.M. State Plane Coordinates (Central Zone)	NO.	NO.	NO.	DESIGN	DESIGN
VERIFICATION BY	DATE	X = 1,558,220.58 Y = 1,481,283.33	NO.	NO.	NO.	DATE: 02/04	DATE: 02/04
SUPPLEMENTED BY	DATE	Ground-to-Grid Factor = 0.999644584	NO.	NO.	NO.	Drawn By: DH	Checked By: PLT
MICRO-FILM INFORMATION	DATE	Δα = -00°09'28"	NO.	NO.	NO.	DATE: 02/04	DATE: 02/04
RECORDED BY	DATE	NAVD88 Elevation = 5503.35	NO.	NO.	NO.	DATE: 02/04	DATE: 02/04

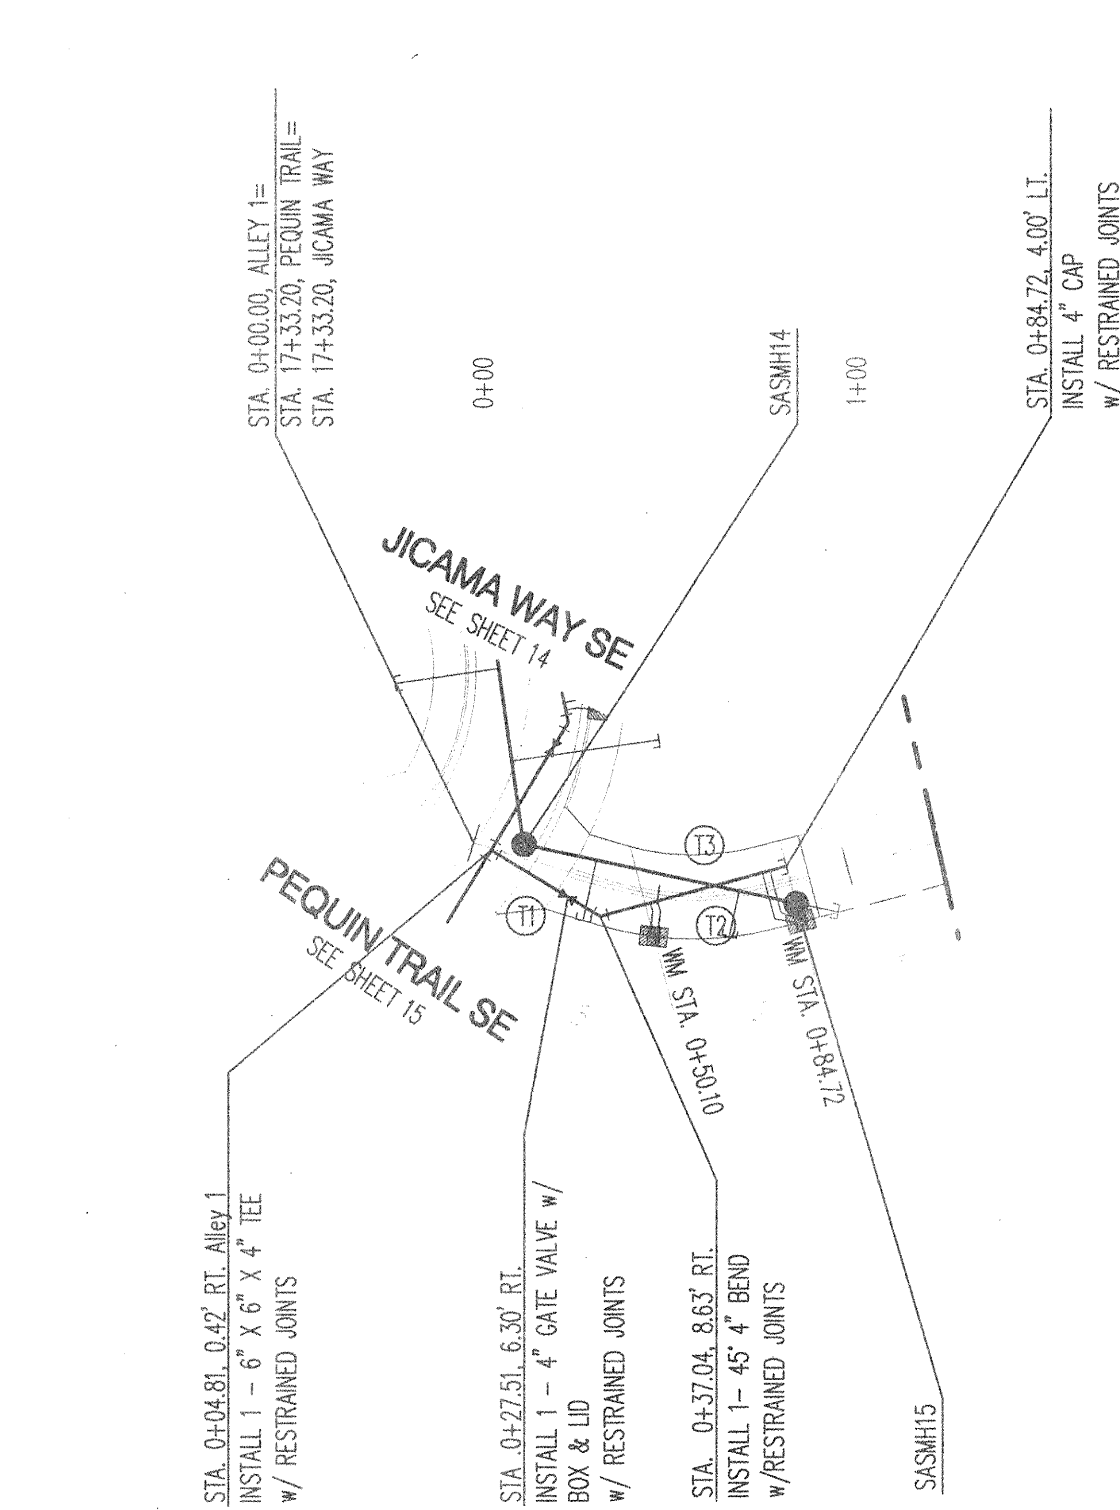


WL Tangent Table			SAS Tangent Table		
ID	BEARING	LENGTH	ID	BEARING	LENGTH
T1	S46°17'29"W	33.28'	T3	S27°22'19"W	72.51'
T2	S00°01'57"W	50.13'			

ALLEY 1

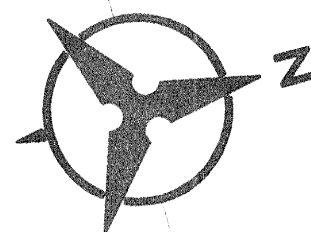

SANITARY SEWER SERVICES			
LOT ID	SAS STATION & OFFSET	SAS LENGTH	TOP OF PIPE AT PLUG (W/ RISER)
1	0+84+72, 6.00'RT.	11.18'	XXXX.XX
2	0+71.23, 0.52'LT.	12.26'	5494.18
3	0+31.92, 5.12'LT.	16.17'	5493.36

NOTE: WATER METER LOCATIONS ARE DESIGNATED
BY STATIONING AT PROPERTY CORNERS.

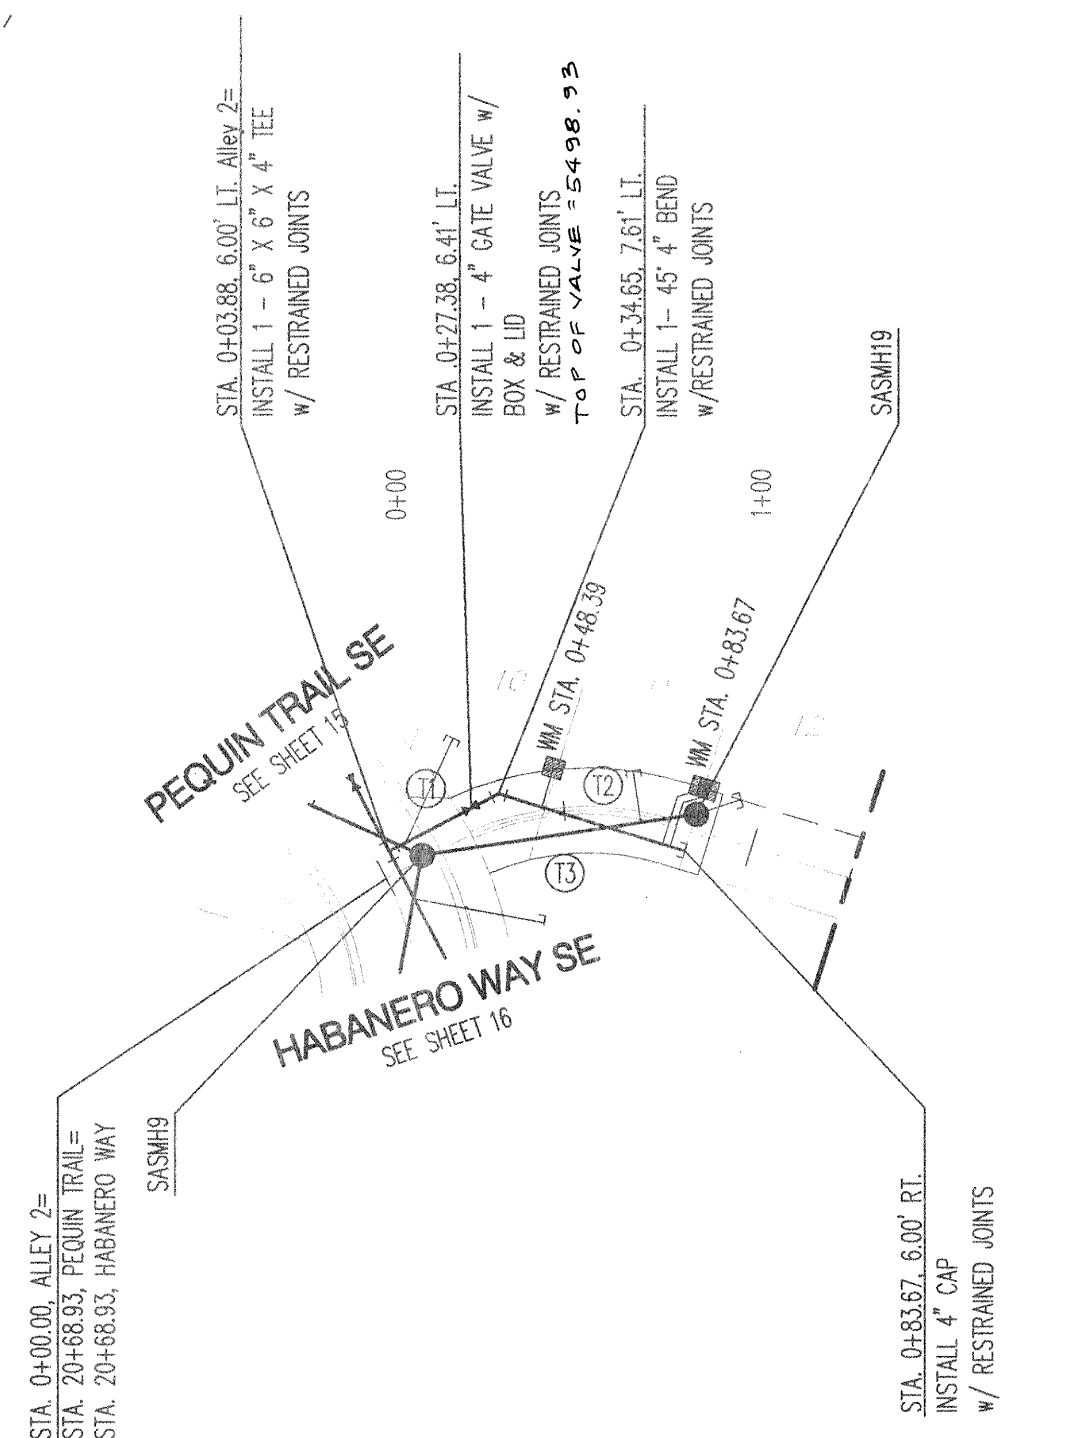




WL Tangent Table			SAS Tangent Table		
ID	BEARING	LENGTH	ID	BEARING	LENGTH
T1	S44°40'36"E	32.17'	T3	N25°31'26"W	72.19'
T2	S00°01'28"W	50.74'			

ALLEY 2




SANITARY SEWER SERVICES			
LOT ID	SAS STATION & OFFSET	SAS LENGTH	TOP OF PIPE AT PLUG (W/RISER)
11	0+70.34, 1.89'RT.	13.54'	5493.3
12	0+83.67, 4.00'LT.	12.21'	XXXXX

NOTE: WATER METER LOCATIONS ARE DESIGNATED
BY STATIONING AT PROPERTY CORNERS.

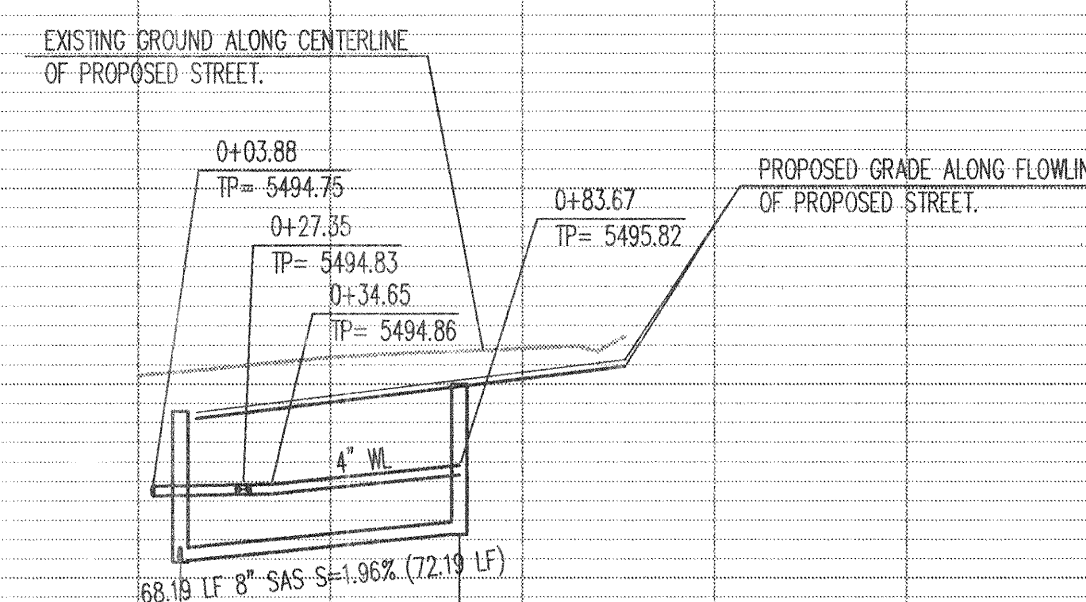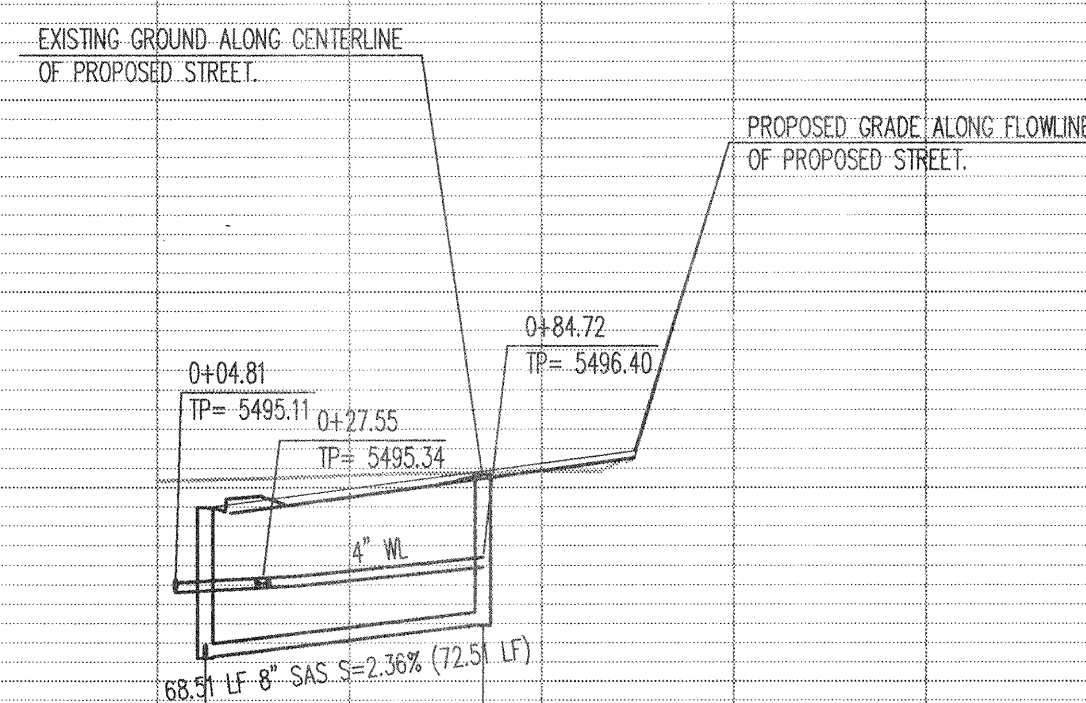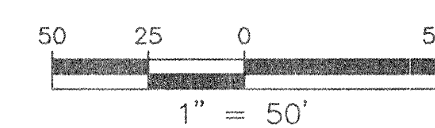

ELEVATIONS ARE IN NGVD 29

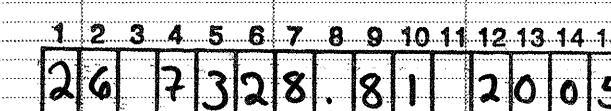

NOTES

1. THE CONTRACTOR SHALL FIELD VERIFY ALL EXISTING UTILITY LOCATIONS AND NOTIFY THE ENGINEER IMMEDIATELY OF ANY DISCREPANCIES.
2. ALL PAVING CURVE DATA AND DIMENSIONS REFER TO FACE OF CURB UNLESS OTHERWISE SPECIFIED.
3. GRADE ELEVATIONS, WHERE NOTED, ARE FOR FLOWLINE OF STANDARD CURB UNLESS OTHERWISE SPECIFIED.
4. CONTRACTOR SHALL PARK EQUIPMENT AND VEHICLES AS NOT TO INTERFERE WITH NORMAL ACTIVITIES OF RESIDENTS OR OTHER CONTRACTORS ON SITE.
5. ANY DAMAGE TO THE EXISTING FACILITIES (CURB & GUTTER, PAVEMENT, CONDUITS, LANDSCAPING, UTILITIES, ETC.) DURING CONSTRUCTION SHALL BE REPLACED AT THE CONTRACTORS' EXPENSE.
6. ANY ADDITIONAL GRADING REQUIRED TO MATCH PROPOSED STREET GRADES SHALL BE INCIDENTAL TO PAVING ITEMS.
7. REMOVAL OF THE EXISTING CURB & GUTTER SHALL BE PER C.O.A. STD. DWG. 2415 (SAW CUT ONLY).
8. WHEELCHAIR RAMPS SHALL BE CONSTRUCTED PRIOR TO ACCEPTANCE OF CURB AND GUTTER.
9. ALL EXCAVATION, TRENCHING AND SHORING ACTIVITIES MUST BE CARRY-OUT IN ACCORDANCE WITH OSHA 29 CFR 1926.850 SUBPART B.
10. CONTRACTOR SHALL FIELD VERIFY ALL EXISTING UTILITIES AND TRANSMISSION GAS LINES. CONTRACTOR SHALL COORDINATE RELOCATION OF UTILITY LINES WITH UTILITY COMPANIES AS REQUIRED.
11. CONTRACTOR IS RESPONSIBLE FOR REPAIR AND/OR REPLACEMENT OF ALL UTILITY CONDUITS AND EXISTING LINES.
12. CONTRACTOR IS TO INSTALL A 4" x 4" x 5' POST AND END AT THE END OF EACH SANITARY SEWER SERVICE.
13. CONTRACTOR SHALL PROVIDE THE INSPECTORS (CITY AND PRIVATE) WITH THE PROPOSED HYDROSTATIC TESTING PLAN. THE PLAN MUST BE APPROVED BEFORE TESTING OPERATIONS BEGIN.
14. MH RIMS AND CATCH BASIN INLET ELEVATIONS, VALVE BOXES, ARV, FIRE HYDRANT & FLANGE ELEVATIONS ARE APPROXIMATE. CONTRACTOR SHALL FIELD VERIFY AND ADJUST TO FINAL PAVEMENT GRADES.
15. SAS STATIONING FOLLOWS CL. OF ROAD UNLESS OTHERWISE NOTED.
16. STATIONING OF DROP INLET IS TO MIDDLE OF DOWN HILL GRATE AT FACE OF CURB.
17. ~~NOTE: THE METER BOXES FOR CONDUITS FOR ALL S&D ARE TO BE PROTECTED FROM FLOWLINE OF MAINLINE HIGHWAY TO BE CONSTRUCTED PER C.O.A. STD. DWG. 2369 WITH TRAFFIC-RATED BOXES.~~
18. FOR STORM DRAIN CONSTRUCTION: ALL RCP JOINTS SHALL BE GROUTED PRIOR TO FINAL INSPECTION. FINAL INSPECTION SHALL DETERMINE WHICH JOINTS ARE TO BE GROUTED FOR FINAL ACCEPTANCE OF THE CONSTRUCTION.
19. ALL UTILITY CURVE DATA AND DIMENSIONS ARE CALCULATED FROM CENTERLINE OF PIPE, OR MANHOLE. ALL SAS & SD SLOPES ARE CALCULATED TO TRUE PIPE DIMENSIONS FROM INVERT TO INVERT. (PAY ITEMS ARE SHOWN IN PARENTHESES).
20.  DENOTES CROWN TRANSITION PER C.O.A. STD. DWG. 2420.

LEGEND

- | | |
|---|---|
|  | DOUBLE WATER METER PER COA STD. DWGS
2361, 2362, 2365 & 2368 |
|  | SINGLE WATER METER PER COA STD. DWGS
2361, 2362, 2366 & 2368 |
|  | WATER LINE SHUTOFF VALVE PER STD. DWGS
2328 & 2328 |
|  | WATER LINE TEE |
|  | SAS LATERAL |
|  | SAS MANHOLE |
|  | STORM DRAIN MANHOLE |
|  | STORM DRAIN INLET |
|  | PROPOSED FIRE HYDRANT |
|  | EXISTING WATER VALVE |
|  | PROPOSED STREET LIGHT |


Bohannon ▲ Huston

Courtyard I 7500 Jefferson St. NE Albuquerque, NM 87109-4335
ENGINEERING • SPATIAL DATA • ADVANCED TECHNOLOGIES



CITY OF ALBUQUERQUE
PUBLIC WORKS DEPARTMENT

LONGFORD VILLAGE EAST SUBDIVISION UTILITY PLAN AND PROFILE ALLEY 1 AND ALLEY 2

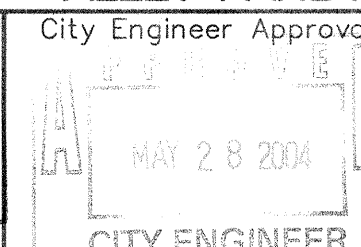

City Project No

Zone Map No.

Sheet

_____ ()

20

© 2006 The Authors
Journal compilation © 2006 Blackwell Publishing Ltd

P:\040199\cdp\pnp\040199_Upnp07.dwg
April 12, 2004 - 10:10am

SCALE: 1" = 50' (HORIZ.)
1" = 10' (VERT.)

732881


Zone Map No.

Sheet

_____ ()



20

© 2006 The Authors
Journal compilation © 2006 Blackwell Publishing Ltd

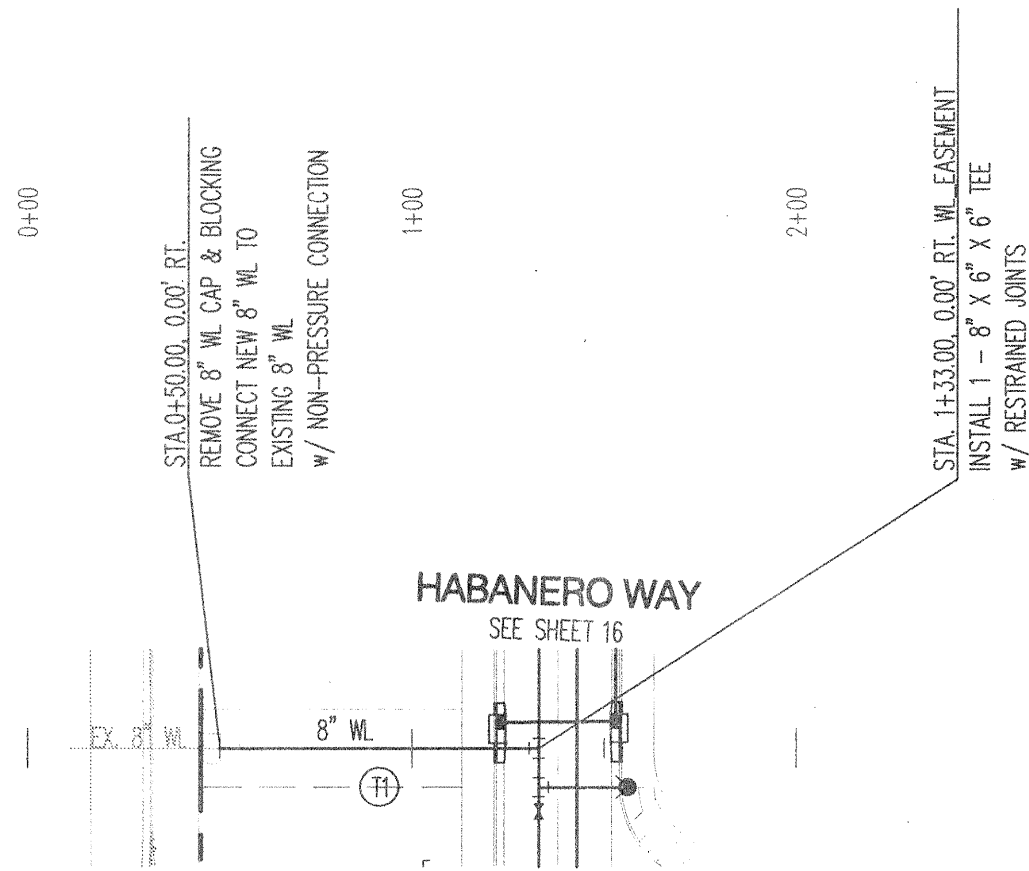





WL Tangent Table		
ID	BEARING	LENGTH
T1	S00°20'17"W	83.00'

WATERLINE EASEMENT

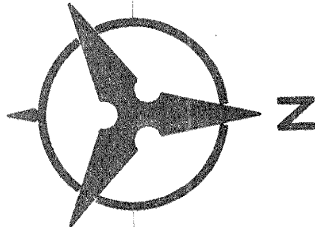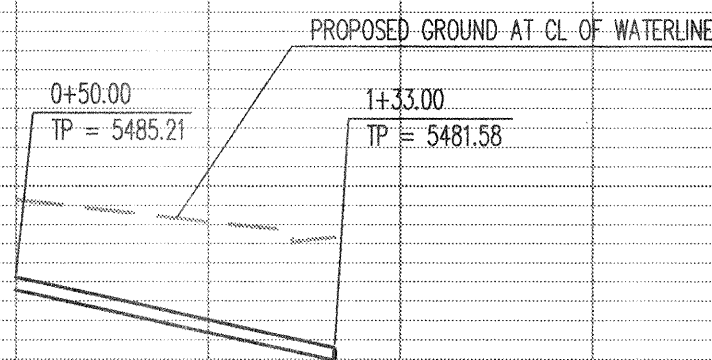

SAS Tangent Table		
ID	BEARING	LENGTH
T1	S00°20'17"W	125.76'

SANITARY SEWER EASEMENT

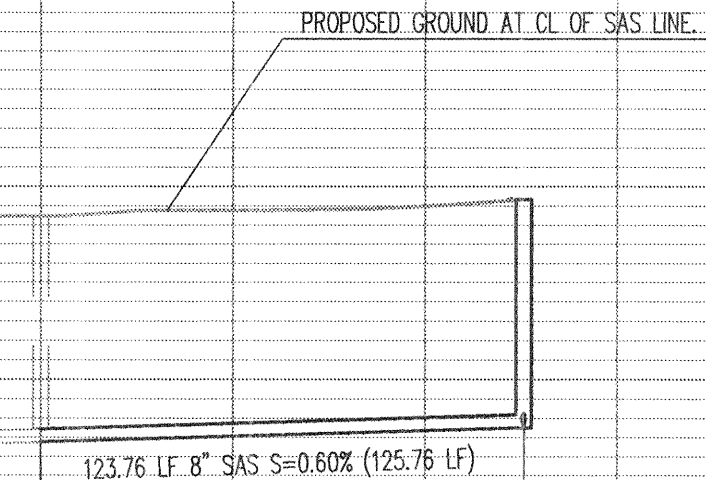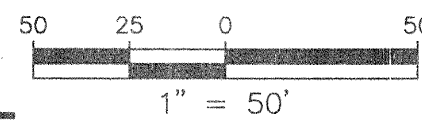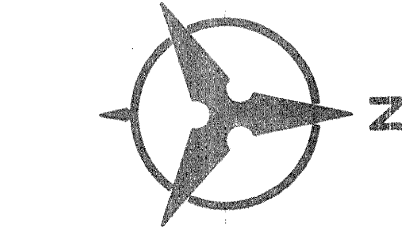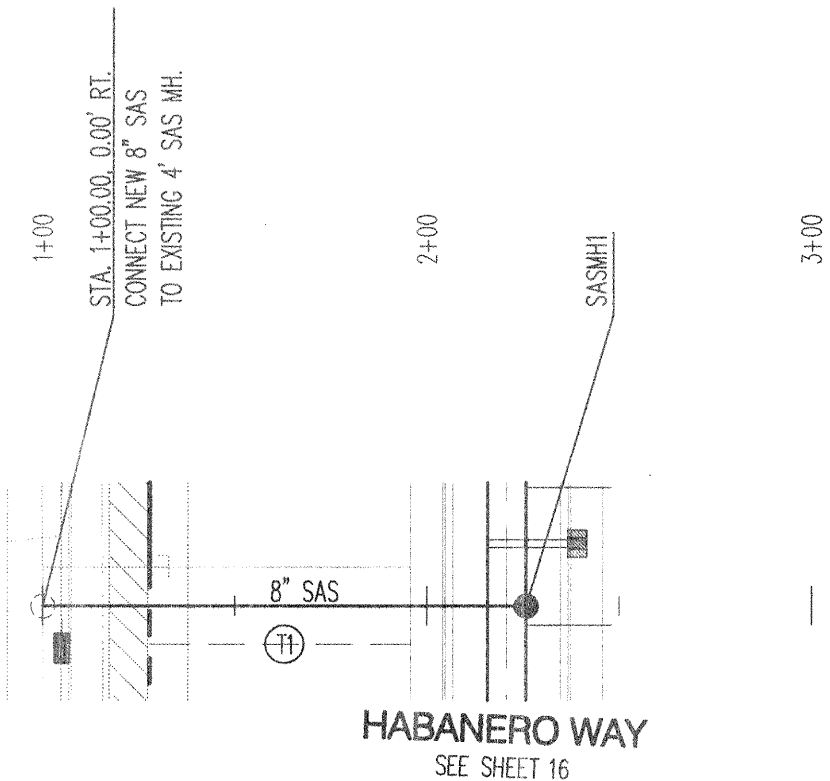

1	2	3	4	5	6	7	8	9	10	11	12	13	14	15
26	73	28	81	21	05									

NOTES

1. THE CONTRACTOR SHALL FIELD VERIFY ALL EXISTING UTILITY LOCATIONS AND NOTIFY THE ENGINEER IMMEDIATELY OF ANY DISCREPANCIES.
2. ALL PAVING CURVE DATA AND DIMENSIONS REFER TO FACE OF CURB UNLESS OTHERWISE SPECIFIED.
3. GRADE ELEVATIONS, WHERE NOTED, ARE FOR FLOWLINE OF STANDARD CURB UNLESS OTHERWISE SPECIFIED.
4. CONTRACTOR SHALL PARK EQUIPMENT AND VEHICLES AS NOT TO INTERFERE WITH NORMAL ACTIVITIES OF RESIDENTS OR OTHER CONTRACTORS ON SITE.
5. ANY DAMAGE TO THE EXISTING FACILITIES (CURB & GUTTER, PAVEMENT, CONDUITS, LANDSCAPING, UTILITY LINES, ETC.) DURING CONSTRUCTION SHALL BE REPLACED AT THE CONTRACTORS' EXPENSE.
6. ANY ADDITIONAL GRADING REQUIRED TO MATCH PROPOSED STREET GRADES SHALL BE INCIDENTAL TO PAVING ITEMS.
7. REMOVAL OF THE EXISTING CURB & GUTTER SHALL BE PER C.O.A. STD. DWG. 2415 (SAWCUT ONLY).
8. WHEELCHAIR RAMPS SHALL BE CONSTRUCTED PRIOR TO ACCEPTANCE OF CURB AND GUTTER.
9. ALL EXCAVATION, TRENCHING AND SHORING ACTIVITIES MUST BE CARRIED-OUT IN ACCORDANCE WITH OSHA 29 CFR 1926.650 SUBPART B.
10. CONTRACTOR SHALL FIELD VERIFY ALL EXISTING UTILITIES AND TRANSMISSION GAS LINES. CONTRACTOR SHALL COORDINATE RELOCATION OF UTILITY LINES WITH UTILITY COMPANIES AS REQUIRED.
11. CONTRACTOR IS RESPONSIBLE FOR REPAIR AND/OR REPLACEMENT OF ALL UTILITY CONDUITS AND EXISTING LINES.
12. CONTRACTOR IS TO INSTALL A 4" X 4" X 5' POST AND END AT THE END OF EACH SANITARY SEWER SERVICE.
13. CONTRACTOR SHALL PROVIDE THE INSPECTORS (CITY AND PRIVATE) WITH THE PROPOSED HYDROSTATIC TESTING PLAN. THE PLAN MUST BE APPROVED BEFORE TESTING OPERATIONS BEGIN.
14. MH RIMS AND CATCH BASIN INLET ELEVATIONS, VALVE BOXES, ARV, FIRE HYDRANT & FLANGE ELEVATIONS ARE APPROXIMATE. CONTRACTOR SHALL FIELD VERIFY AND ADJUST TO FINAL PAVEMENT GRADES.
15. SAS STATIONING FOLLOWS CL OF ROAD UNLESS OTHERWISE NOTED.
16. STATIONING OF DROP INLET IS TO MIDDLE OF DOWN HILL GRATE AT FACE OF CURB.
17. FLOWLINE ELEVATIONS FOR DROP DROP INLETS ARE PROJECTED FROM FLOWLINE OF STANDARD CURB TO MIDDLE OF DOWNHILL GRATE.
18. FOR STORM DRAIN CONSTRUCTION: ALL RCP JOINTS SHALL BE GROUTED PRIOR TO FINAL INSPECTION. FINAL INSPECTION SHALL DETERMINE WHICH JOINTS ARE TO BE GROUTED FOR FINAL ACCEPTANCE OF THE CONSTRUCTION.
19. ALL UTILITY CURVE DATA AND DIMENSIONS ARE CALCULATED FROM CENTERLINE OF PIPE OR MANHOLE. ALL SAS & SD SLOPES ARE CALCULATED TO TRUE PIPE DIMENSIONS FROM INVERT TO INVERT. (PAY ITEMS ARE SHOWN IN PARENTHESES.)
20. [Symbol] DENOTES CROWN TRANSITION PER C.O.A. STD. DWG. 2401.

LEGEND

- DOUBLE WATER METER PER COA STD. DWGS 2361, 2362, 2366 & 2368
- SINGLE WATER METER PER COA STD. DWGS 2361, 2362, 2366 & 2368
- WATER LINE SHUTOFF VALVE PER STD. DWGS 2326 & 2328
- WATER LINE TEE
- SAS LATERAL
- SAS MANHOLE
- STORM DRAIN MANHOLE
- STORM DRAIN INLET
- PROPOSED FIRE HYDRANT
- EXISTING WATER VALVE
- PROPOSED STREET LIGHT

Bohannon & Huston

Courtyard 1 7800 Jefferson St. NE Albuquerque, NM 87109-4336
ENGINEERING • SPATIAL DATA • ADVANCED TECHNOLOGIES




CITY OF ALBUQUERQUE
PUBLIC WORKS DEPARTMENT

LONGFORD VILLAGE EAST SUBDIVISION
UTILITY PLAN AND PROFILE
WATERLINE EASEMENT AND SANITARY SEWER EASEMENT


Design Review Committee	City Engineer Approval	Mo./Day/Yr.	Mo./Day/Yr.
APPROVE APR 19 2004 DESIGN REVIEW COMMITTEE	APPROVE MAY 28 2004 CITY ENGINEER		

City Project No.	Zone Map No.	Sheet	Of
732881	L-21-Z	21	23

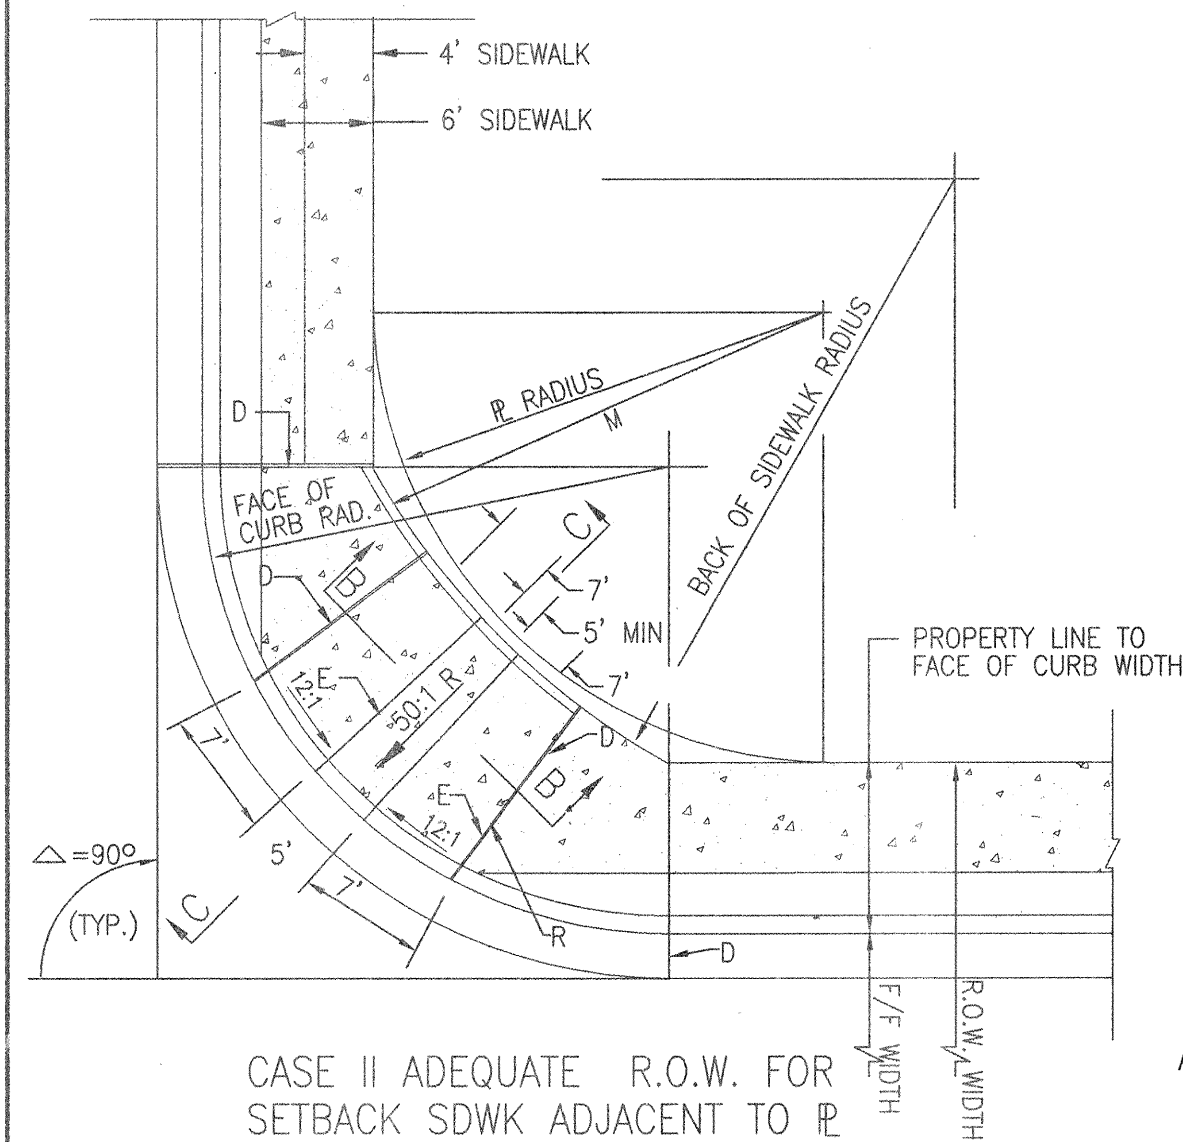


HANDICAP RAMP DETAIL
N.T.S.

IR RAD	CURB RAD	R. CURB WIDTH	BACK SW RAD
90°	25'	25'	4'
90°	30'	25'	4'
90°	30'	30'	4'
90°	30'	30'	4'

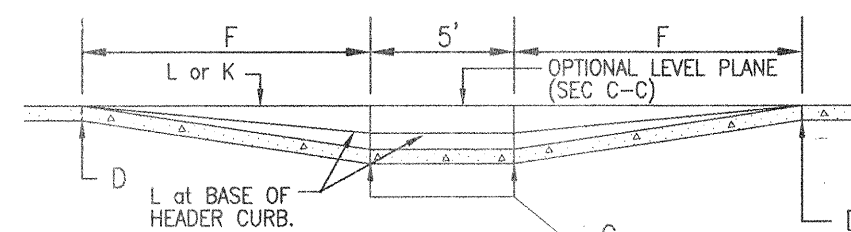

SECTION B-B

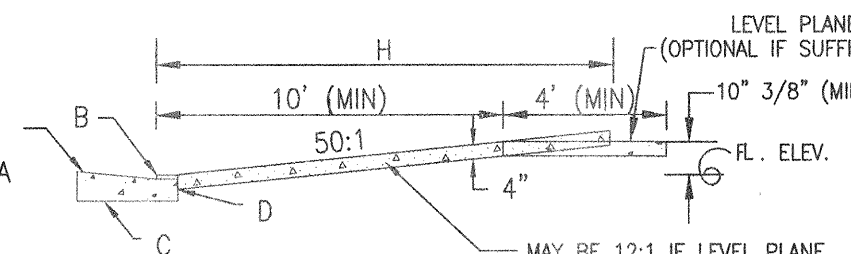


SECTION C-C CASE II

GENERAL NOTES:


- CURB ACCESS RAMPS ARE NORMALLY TO BE LOCATED AT THE CENTER OF THE RETURN OR AS DIRECTED BY THE CITY TRAFFIC ENGINEER.
- SURFACE TEXTURE OF CURB ACCESS RAMPS SHALL BE OBTAINED BY HEAVY BROOMING. (TEXTURE DEPTH .035"). TRANSVERSE TO THE SLOPE OF THE RAMP.
- GUTTER FLOW-LINE PROFILE SHALL BE MAINTAINED THROUGH THE AREA OF THE RAMP. DRAINAGE CATCH BASIN STRUCTURES SHALL NOT BE PLACED IN LINE WITH RAMPS.
- WIDTH OF SIDEWALK AND RAMP MUST BE MAINTAINED AT A MINIMUM OF 5'-0" THROUGH ENTIRE RAMP LENGTH.

CONSTRUCTION NOTES:


- SLOPE OF GUTTER DEPENDENT ON REQUIREMENTS FOR VALLEY GUTTER.
- 1/4" UP ABOVE FLOW LINE (VERTICAL). SEE STD. DWG 2415
- CURB & GUTTER. (SEE STD. DWG 2415 - GUTTER AT THE CURB ACCESS RAMP).
- 1/2" EXPANSION JOINT.
- PARALLEL LINES - TOP AND BOTTOM OF RAMP.
- 12:1 SLOPE AT FACE OF CURB. (SEE STD. DWG 2418)
- CONTRACTION (DUMMY) JOINT.
- VARIES WITH AVAILABLE R.O.W.
- VARIABLE.
- HEADER CURB, SEE DWG. 2415B.
- BACK OF SIDEWALK.
- BACK OF SIDEWALK RADIUS TO BE ESTABLISHED SO AS TO MAINTAIN A 5'-0" RAMP WIDTH (MINIMUM) OR MORE THROUGHOUT. SEE STD. DWG 2440 (NOTE S) IF LESS THAN 5'-0" IS AVAILABLE DUE TO UNTIMELY UNRESOLVABLE CONSTRAINTS.
- 4 1/2" MAX.
- ANY PRIVATE LANDSCAPING AND OR IRRIGATION SHALL BE RESTORED TO ORIGINAL CONDITION. SHOULD ANY PRIVATE IMPROVEMENT NEED TO BE REMOVED, OWNER MUST BE NOTIFIED.
- 12:1 SLOPE MAXIMUM ON RAMP.

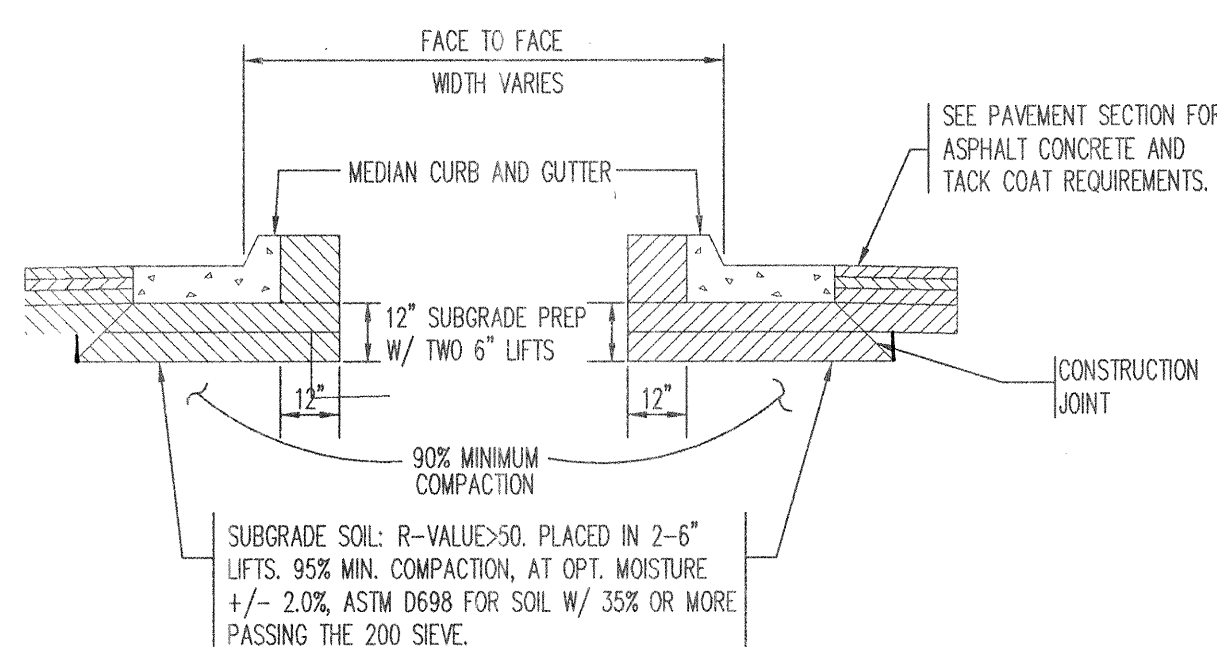


MEDIAN CURB AND GUTTER
NOT TO SCALE

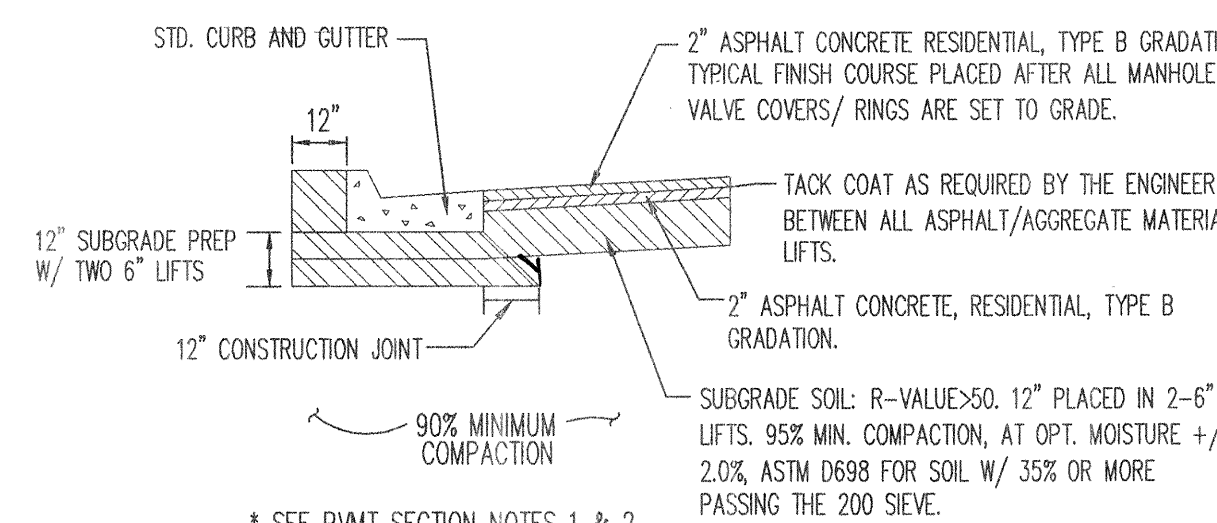


① TYPICAL ENTRANCE PAVEMENT SECTION
PER COA STD DWG 2405B
N.T.S.

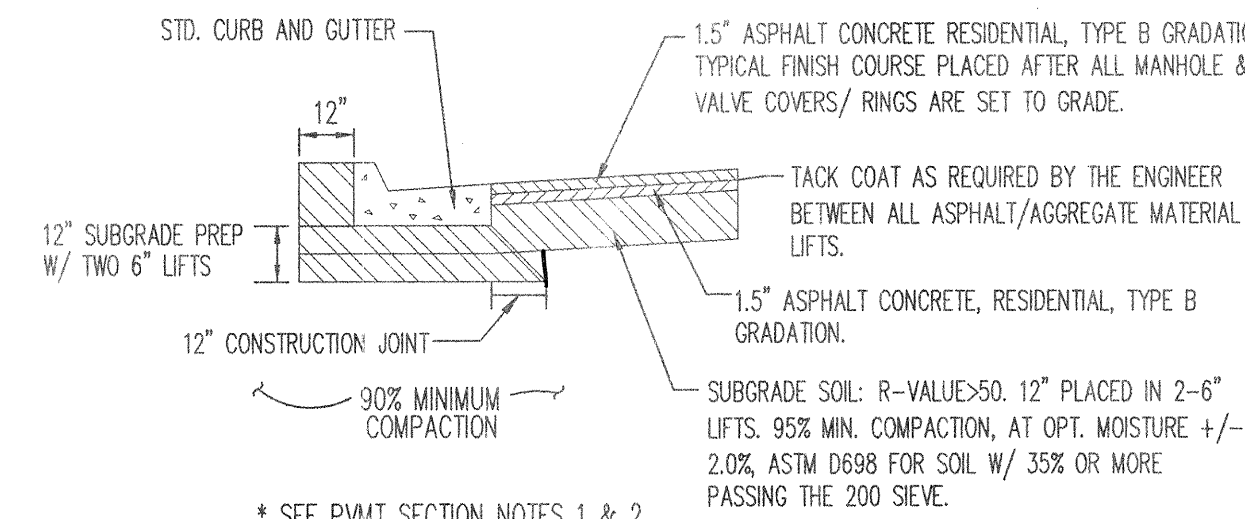


② TYPICAL RESIDENTIAL PAVEMENT SECTION
PER COA STD DWG 2405
N.T.S.

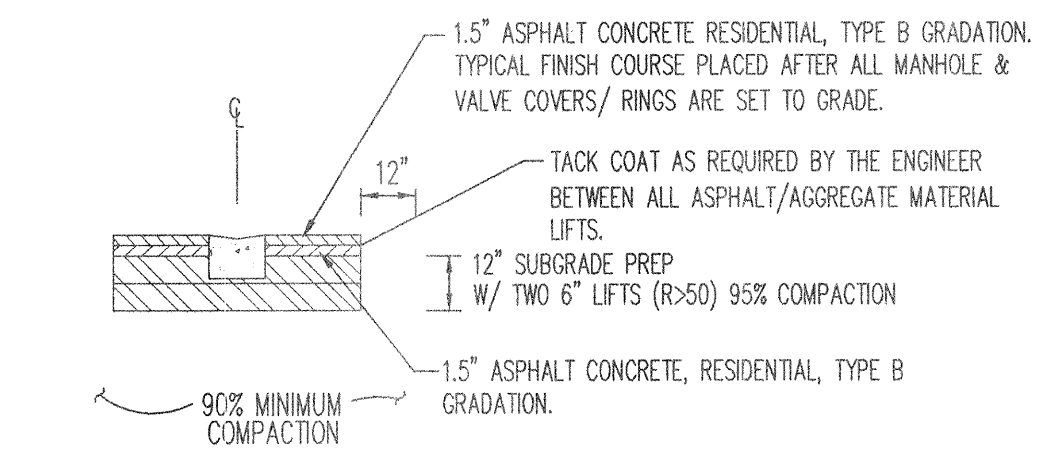


ASPHALT CONCRETE
PER COA STD. DWG. 2411

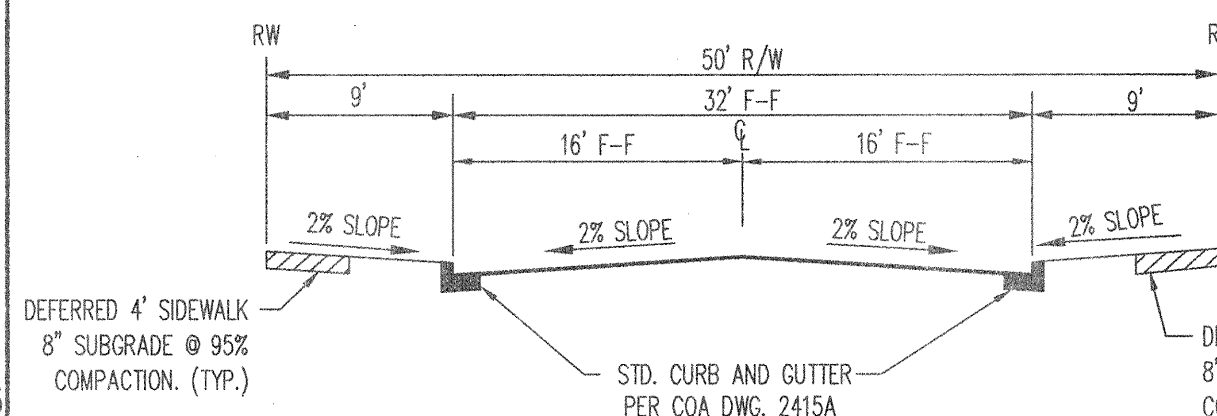


SECTION A-A
TYPICAL RESIDENTIAL STREET - 32' F-F
NOT TO SCALE

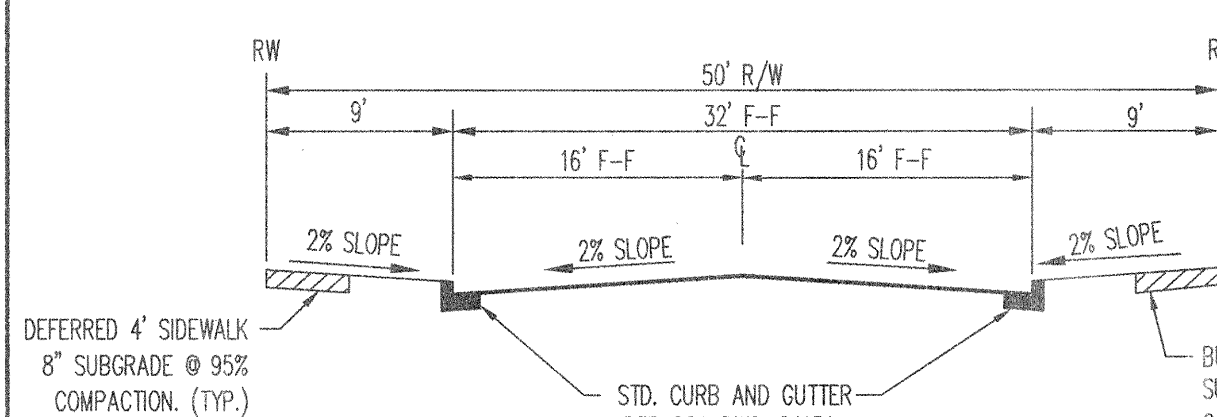


SECTION B-B
TYPICAL RESIDENTIAL STREET - 32' F-F
NOT TO SCALE

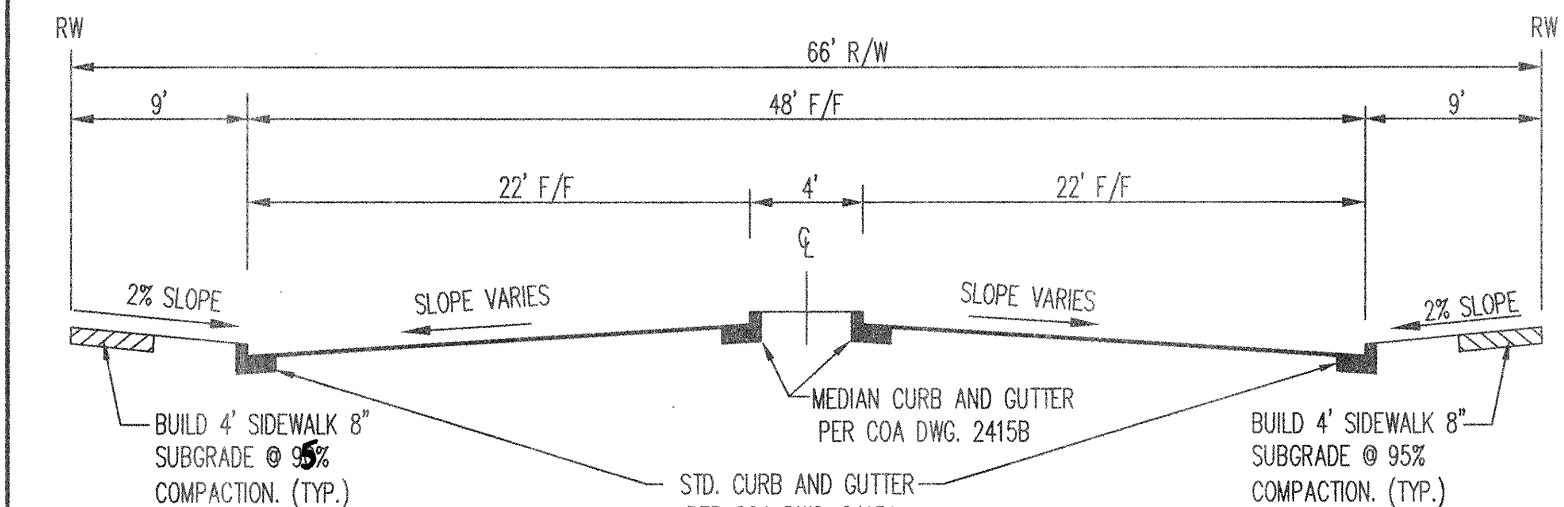


SECTION C-C
SERRANO LANE ENTRANCE
NOT TO SCALE

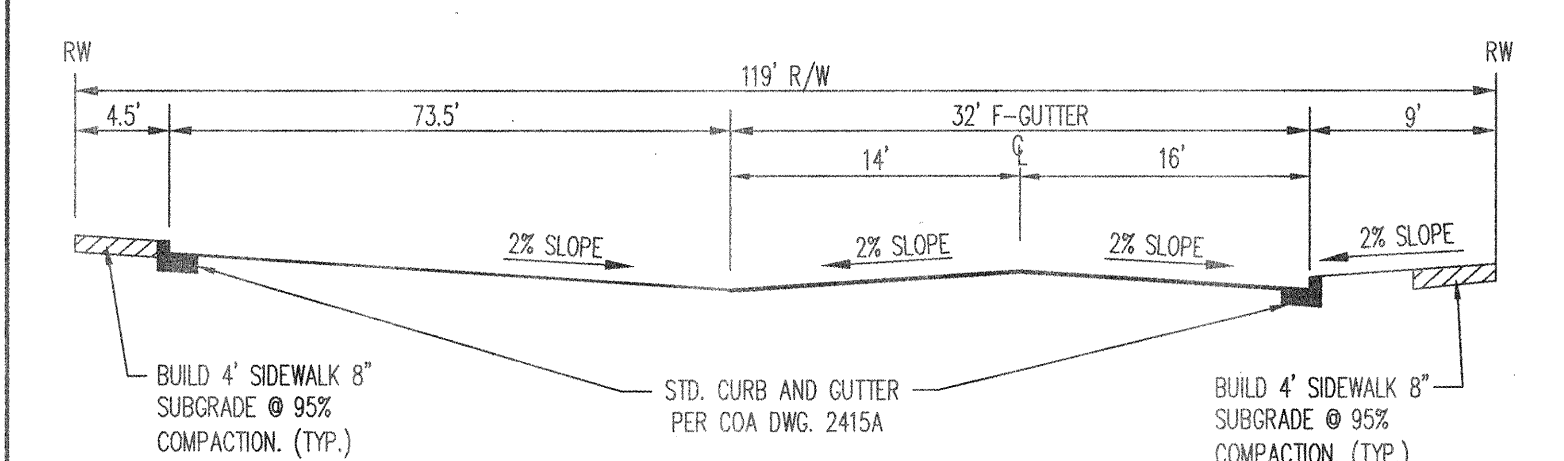


SECTION F-F
TEPIN TRAIL PARKING AREA
NOT TO SCALE

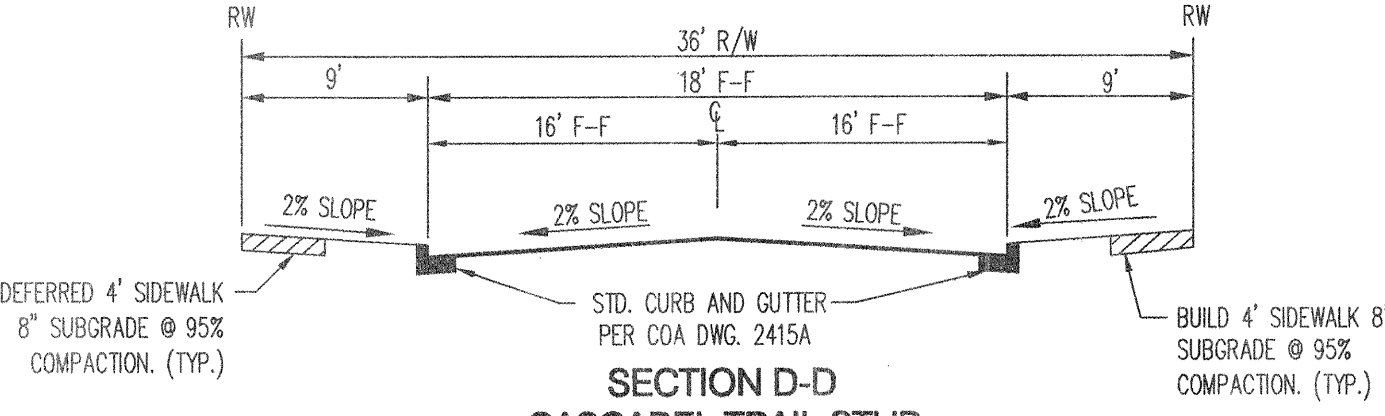


SECTION D-D
CASCABEL TRAIL STUB
NOT TO SCALE

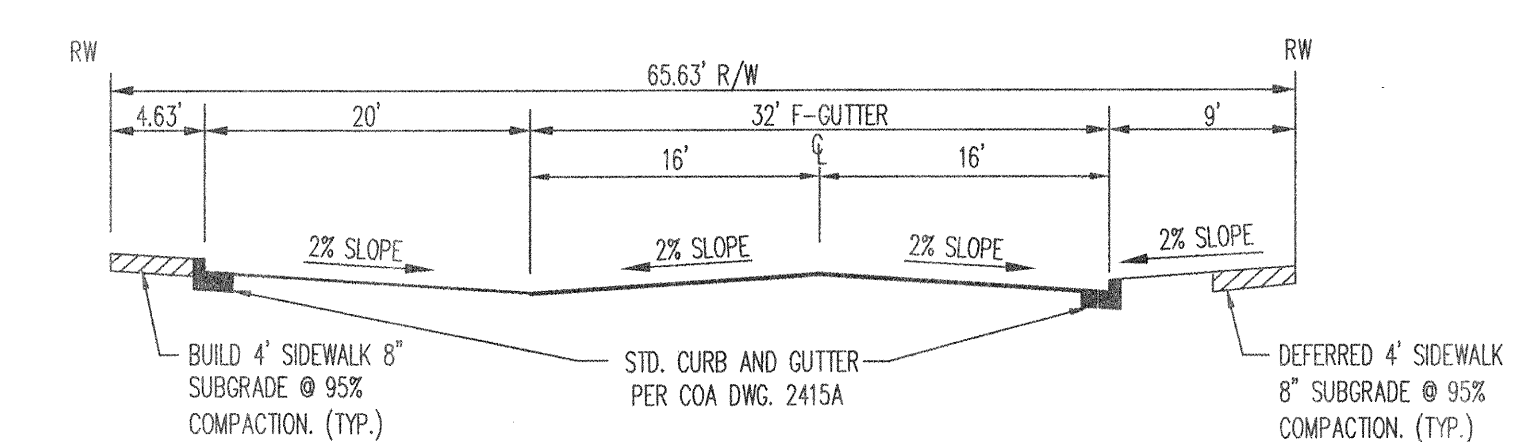


SECTION E-E
PEQUIN TRAIL PARKING AREA
NOT TO SCALE

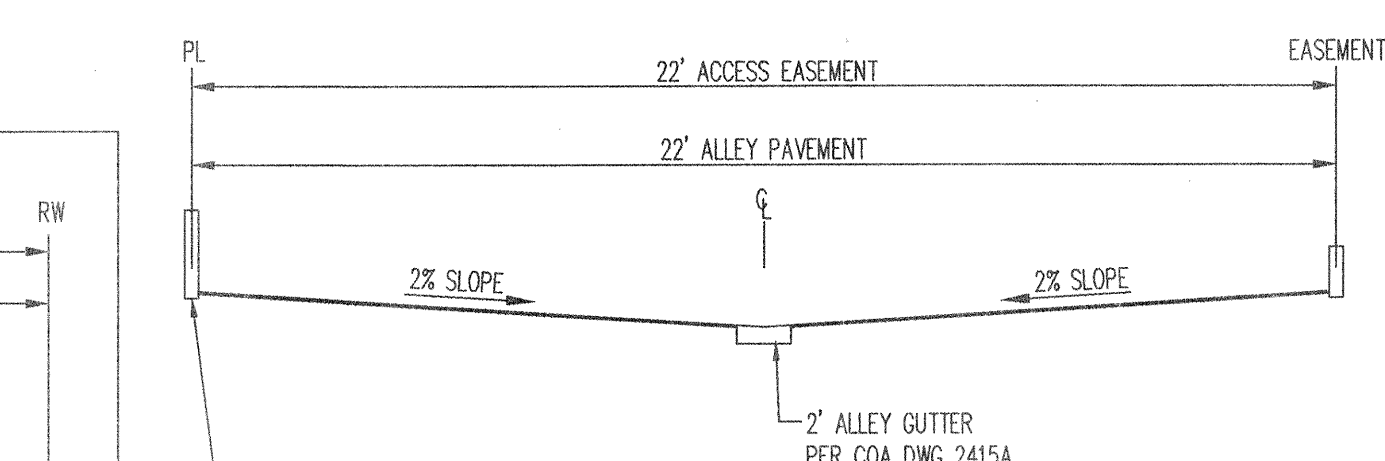


SECTION G-G
RESIDENTIAL ALLEY SECTION

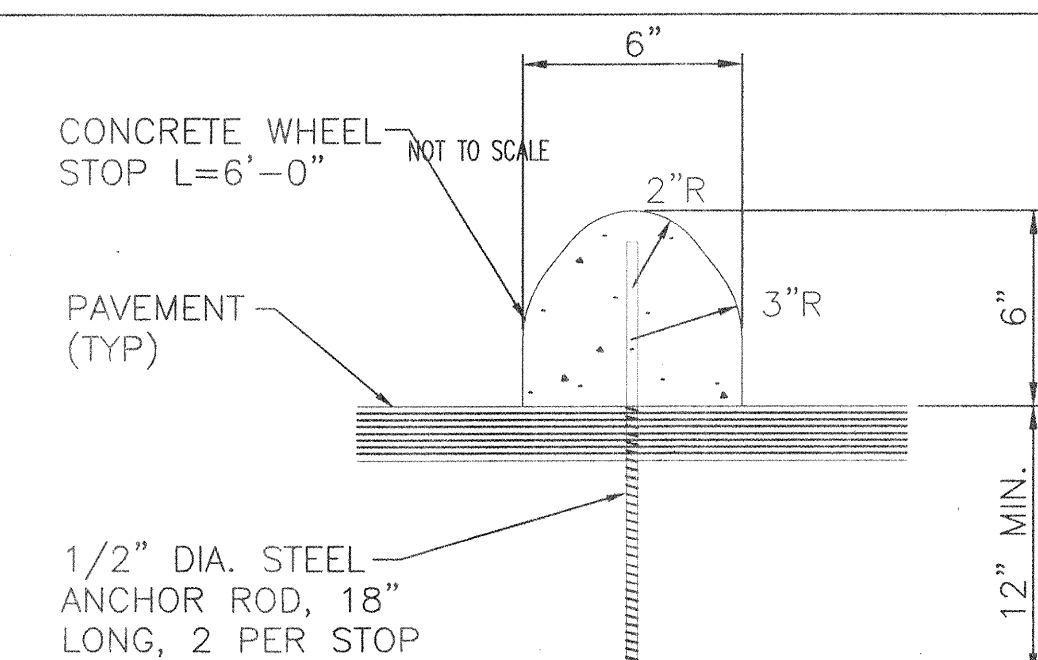


PRECAST PARKING BUMPER
NOT TO SCALE

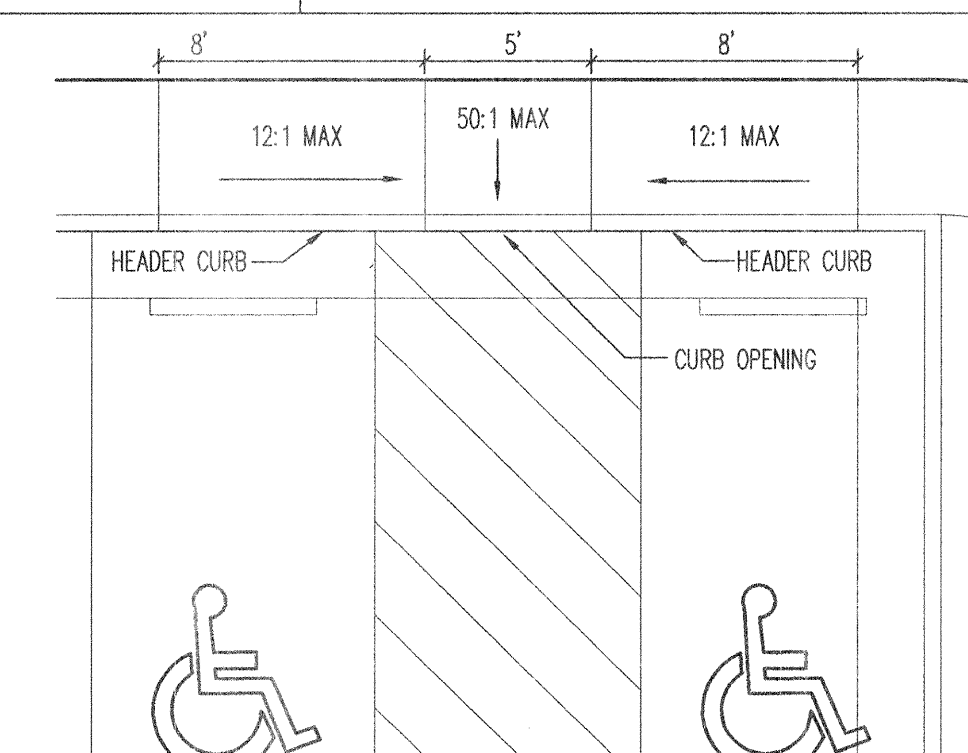


PARKING LOT HANDICAP RAMP DETAIL
N.T.S.

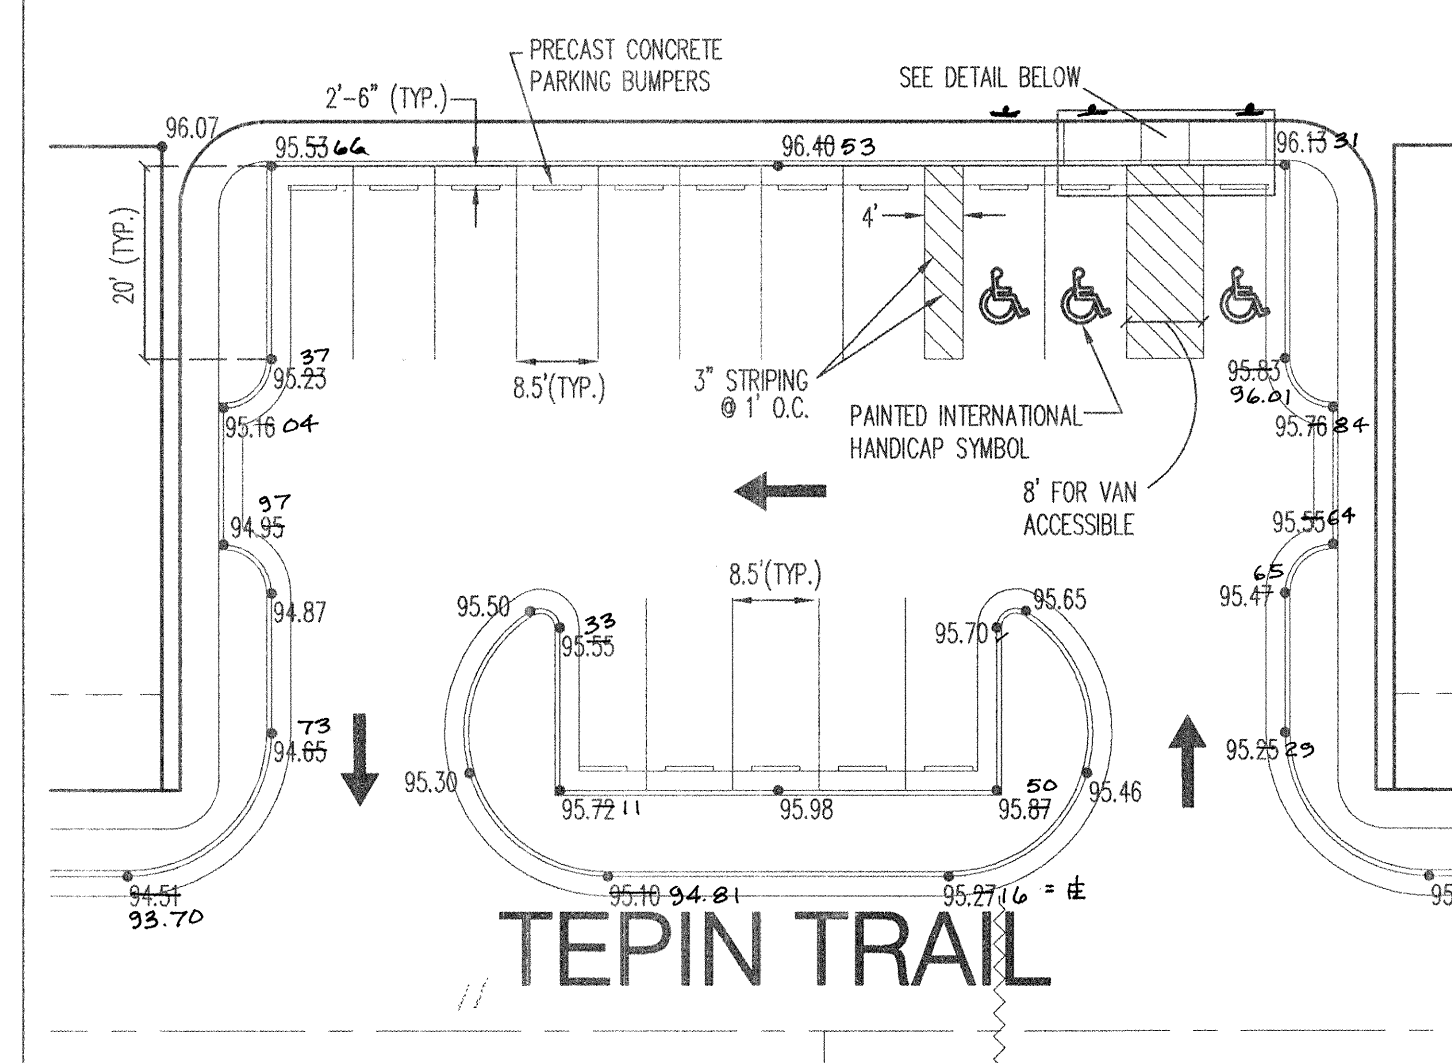


TEPIN TRAIL

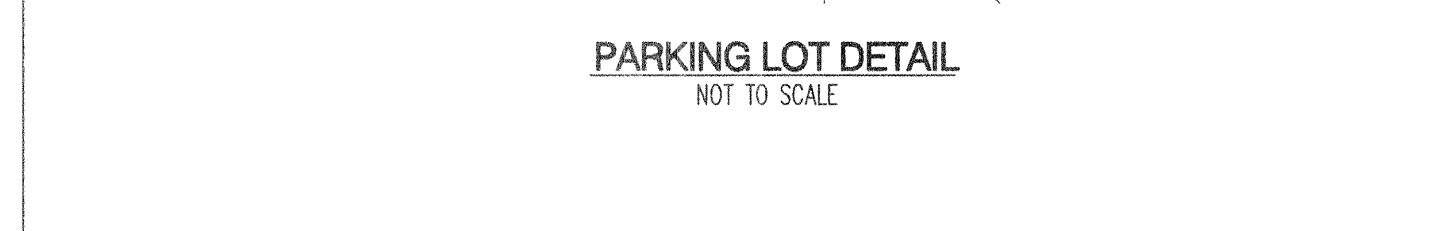


PARKING LOT DETAIL
NOT TO SCALE

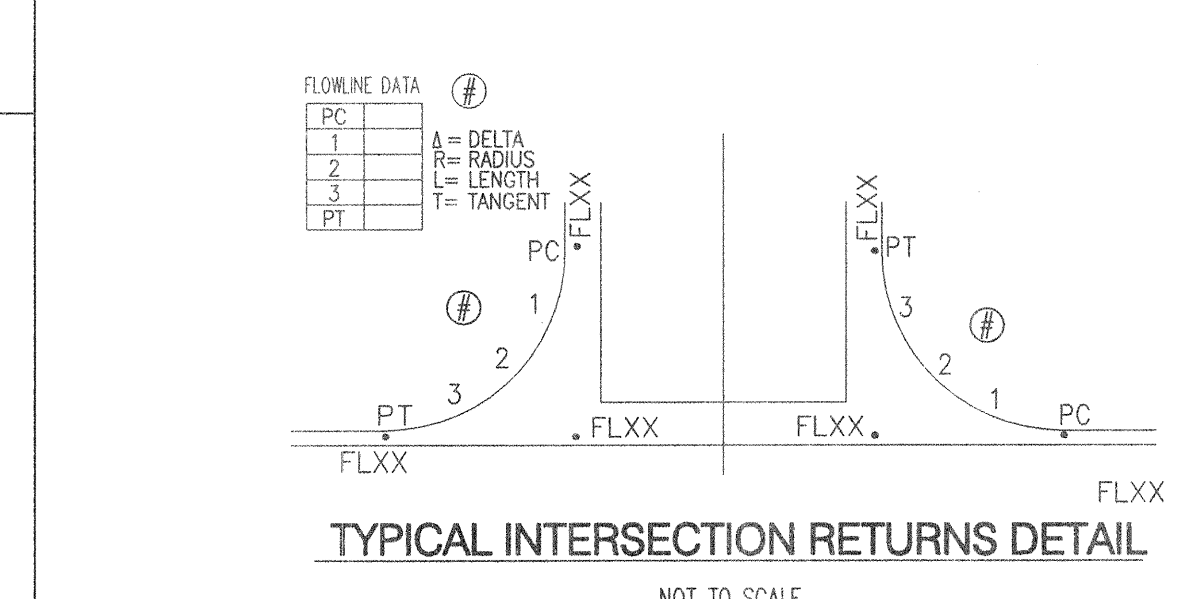

TYPICAL INTERSECTION RETURNS DETAIL
NOT TO SCALE

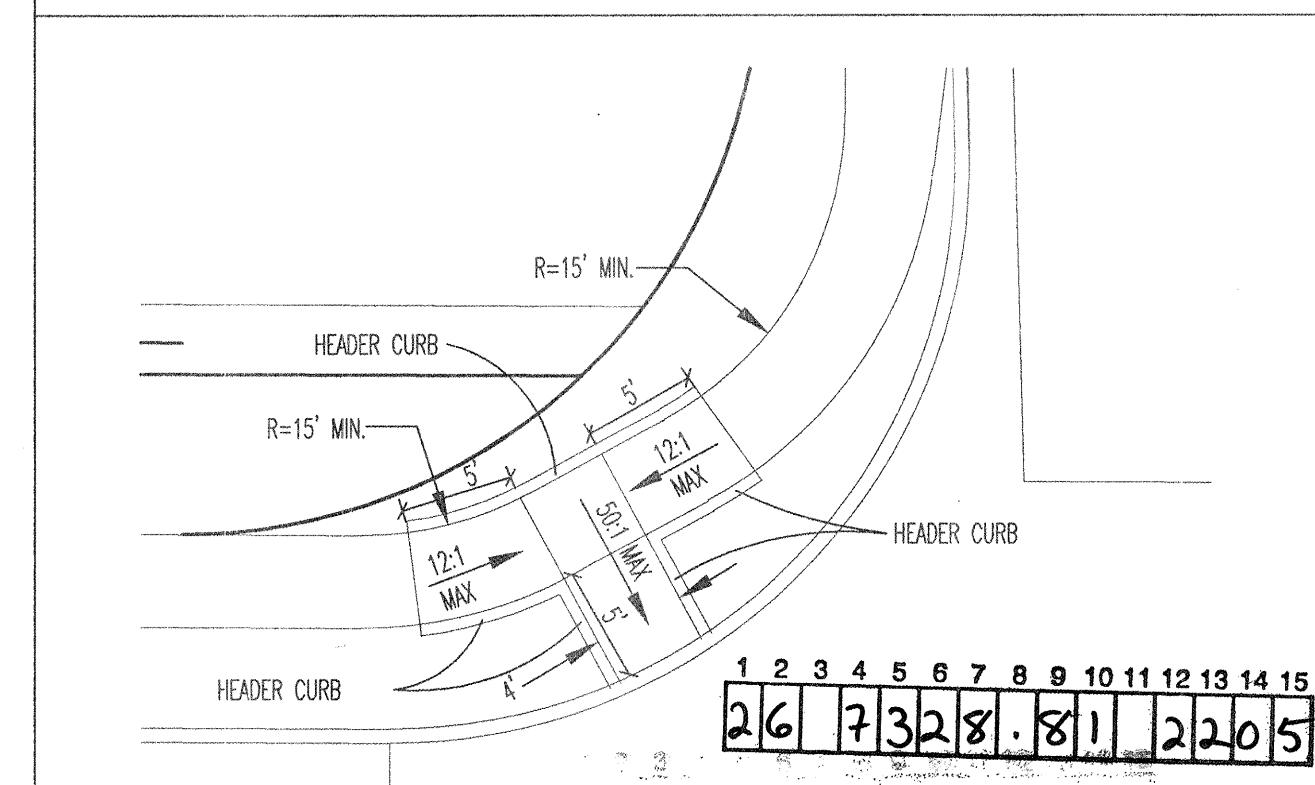



MODIFIED HANDICAP RAMP 'A' DETAIL
N.T.S.

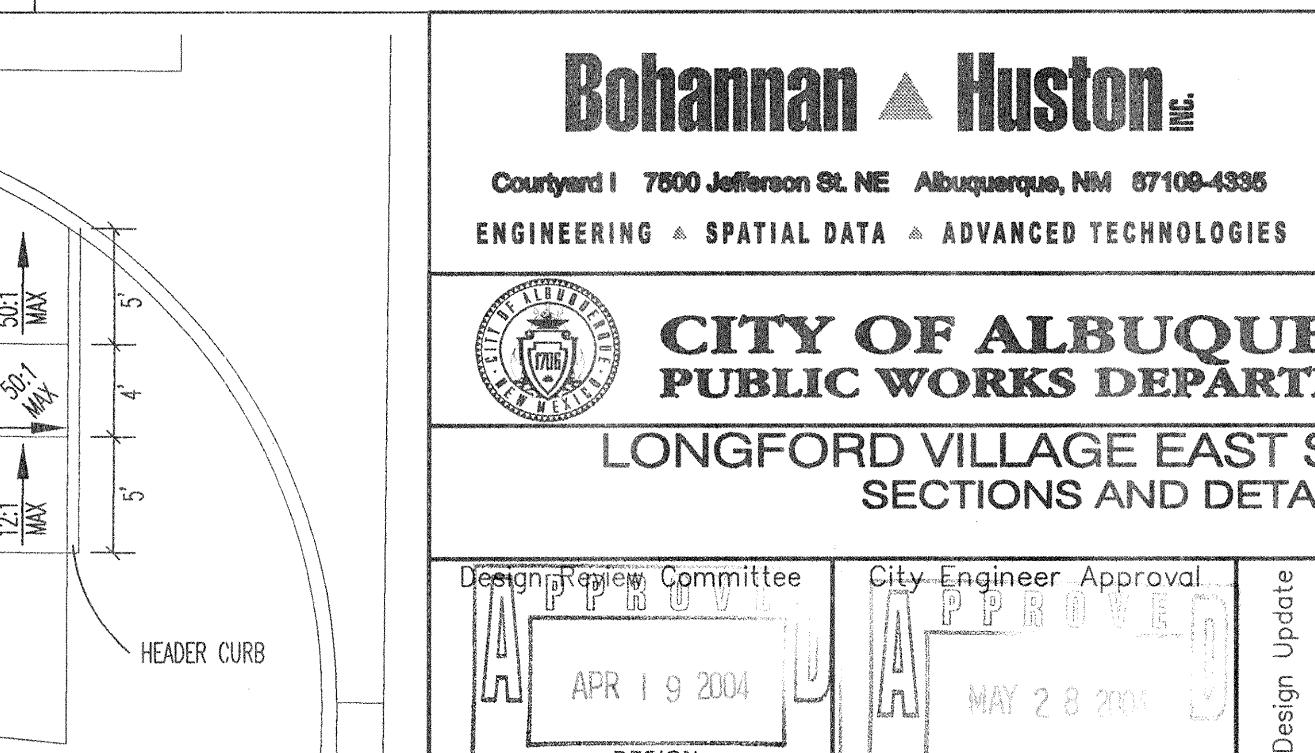

MODIFIED HANDICAP RAMP 'B' DETAIL
N.T.S.

AS-BUILT INFORMATION		BENCH MARKS		SURVEY INFORMATION		ENGINEER'S SEAL	
CONTRACT NO.	DATE	AC'S BRASS TABLET STAMPED	DATE	NO.	BY	REMARKS	DESIGN
040199	04/12/04	76-L21, 1986"	1986"				
INSPECTOR'S NAME	DATE	Geographic Position (NAD 1983)	DATE				
CSC	04/12/04	N.M. State Plane Coordinates (Central Zone)	DATE				
VERIFICATION BY	DATE	X = 1,558,220.58 Y = 1,451,283.33	DATE				
CSC/PLK	04/12/04	Ground-to-Grid Factor = 0.999944584	DATE				
CSC/PLK	04/12/04	Δα = -00'09"28"	DATE				
MICROFILM INFORMATION	DATE	NAVD88 Elevation = 5503.35	DATE				
RECORDED BY	DATE		DATE				

Bohannon & Huston		City of Albuquerque	
7800 Jefferson St. NE Albuquerque, NM 87109-4395		PUBLIC WORKS DEPARTMENT	
ENGINEERING • SPATIAL DATA • ADVANCED TECHNOLOGIES		LONGFORD VILLAGE EAST SUBDIVISION	
DESIGN REVIEW COMMITTEE		CITY ENGINEER	
APR 19 2004		MAY 28 2004	
DESIGN REVIEW COMMITTEE		CITY ENGINEER	
City Project No. 732881		Zone Map No. L-21-Z	
Sheet 22		Of 23	

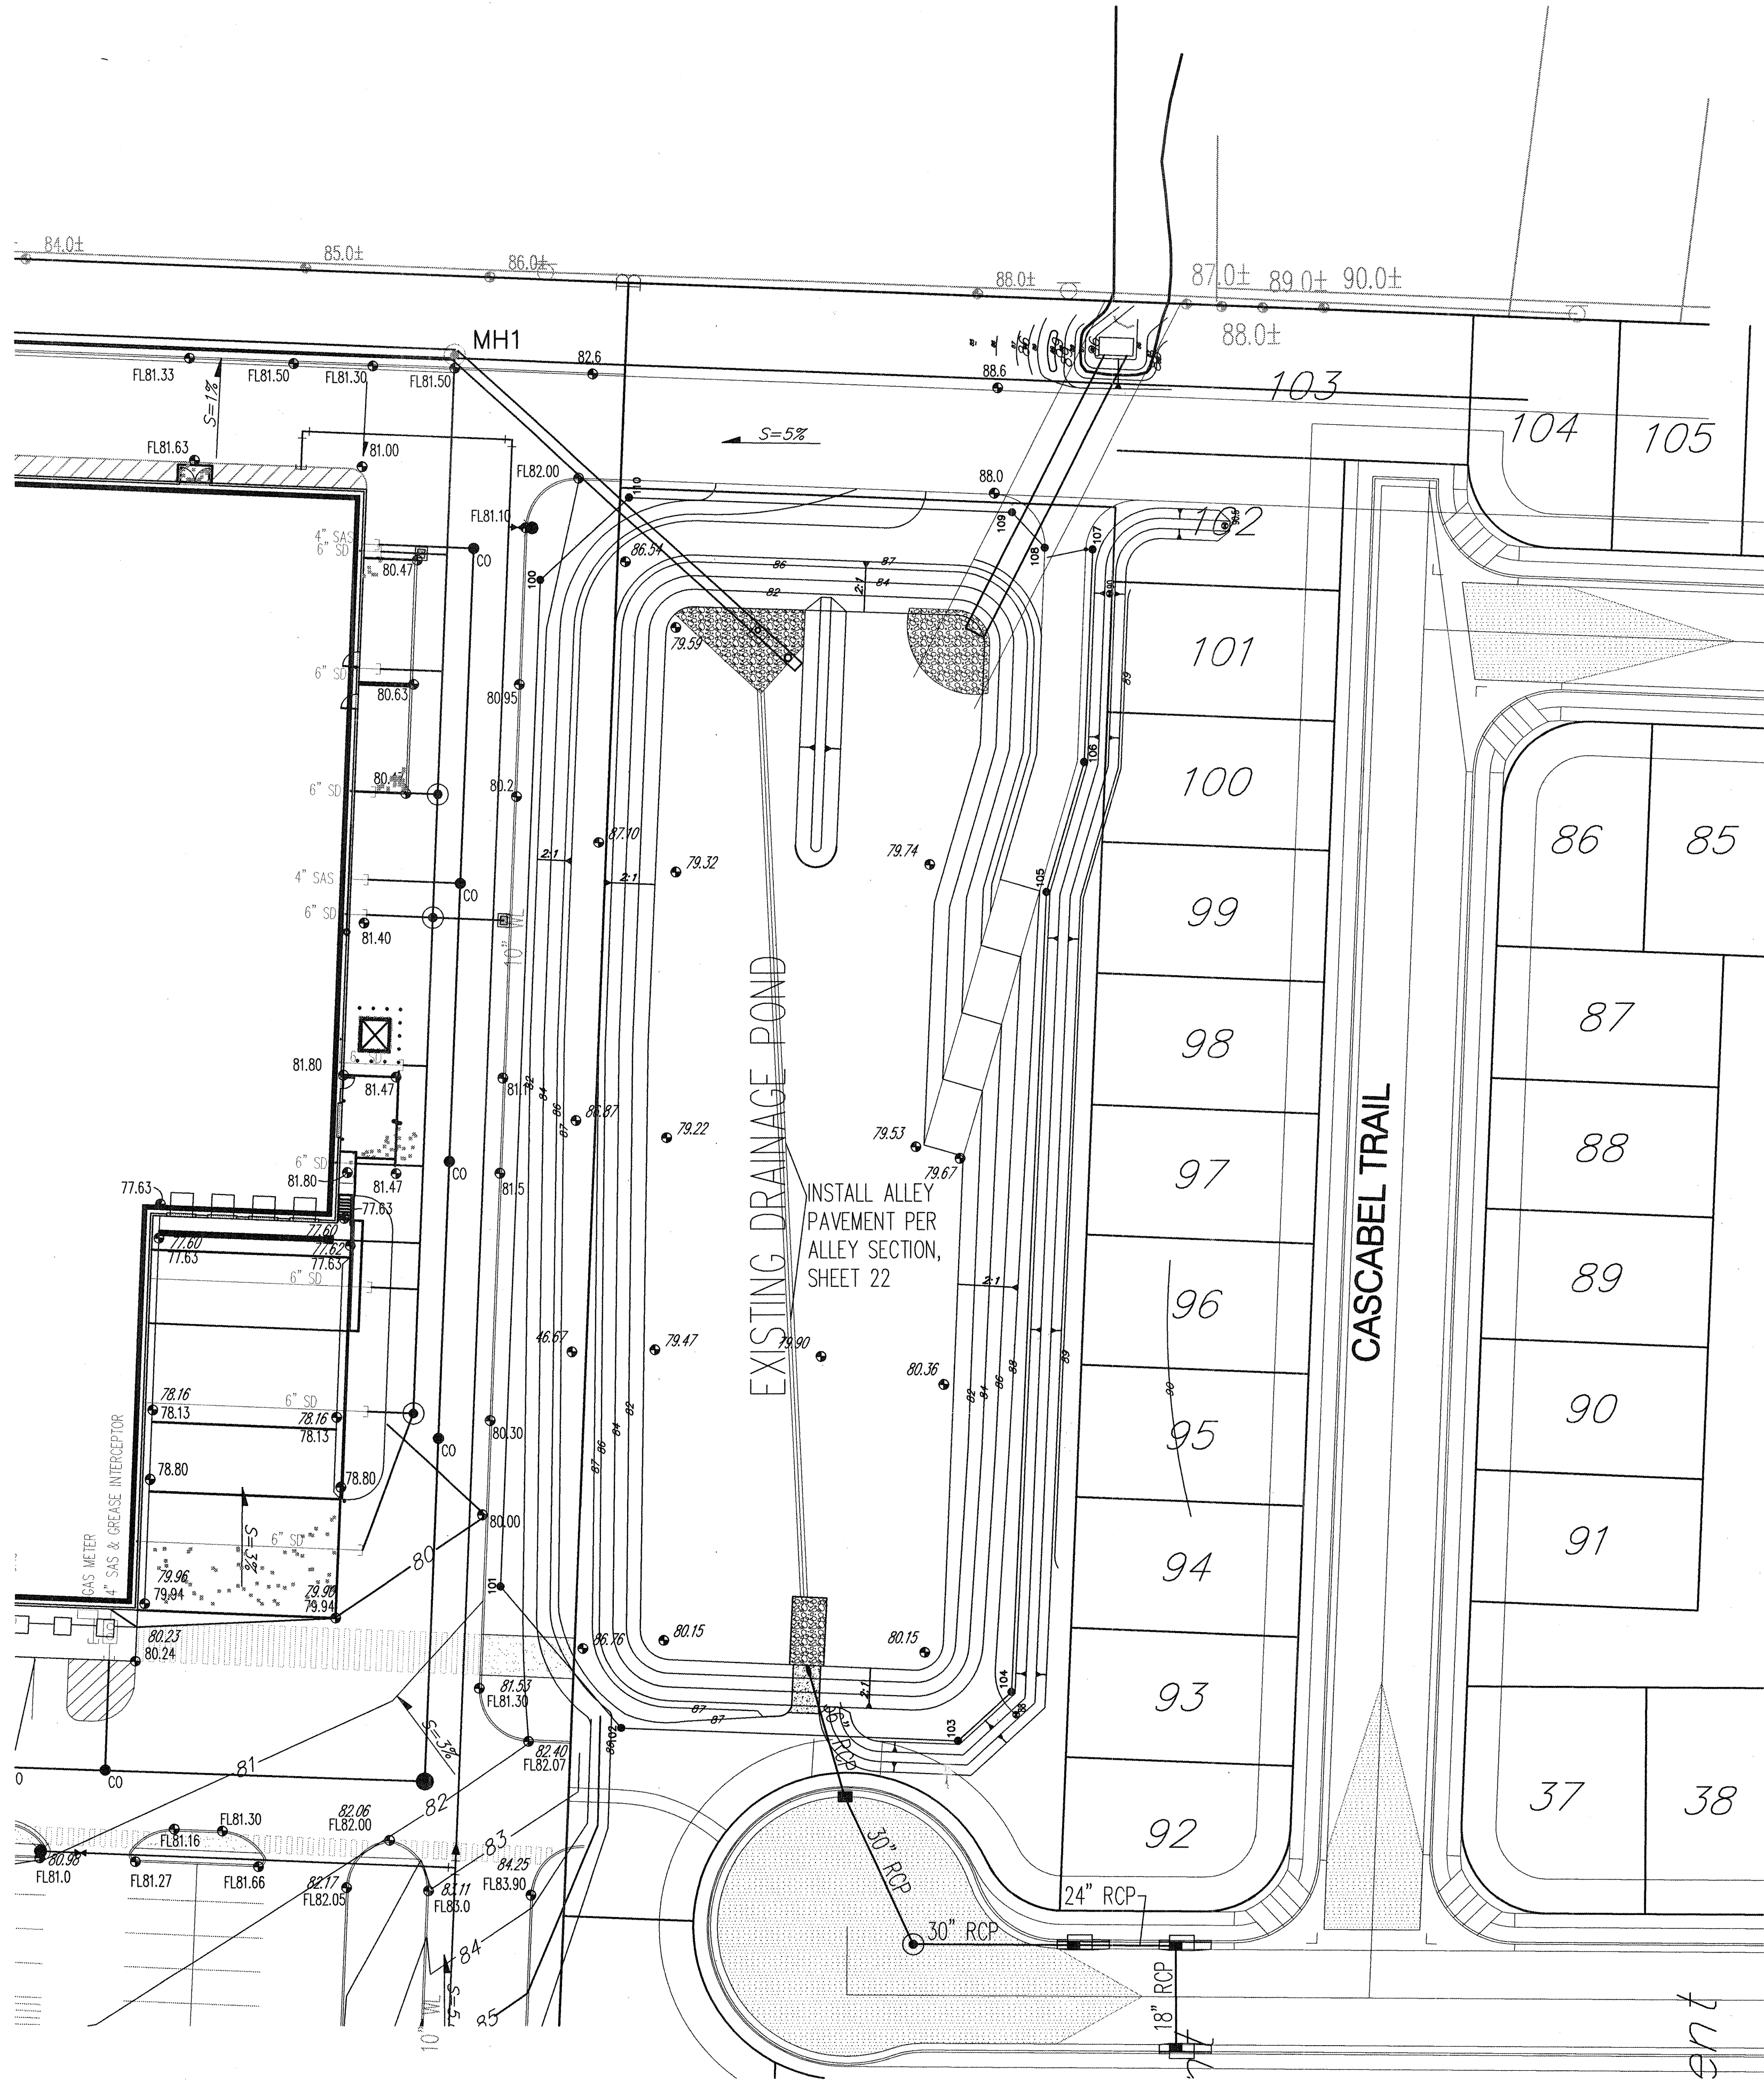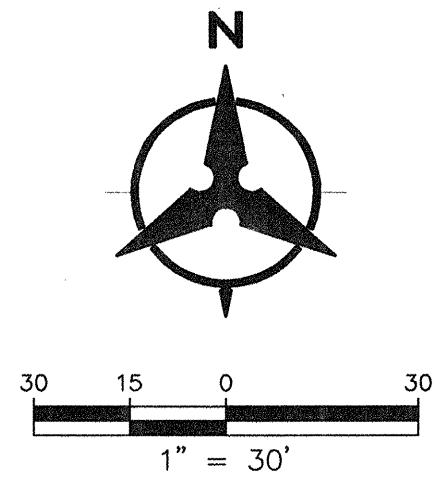

1 2 3 4 5 6 7 8 9 10 11 12 13 14 15
26 7328.81 2305

Bohannon & Huston
Court yard | 7500 Jefferson St. NE Albuquerque, NM 87109-4335
ENGINEERING & SPATIAL DATA & ADVANCED TECHNOLOGIES

CITY OF ALBUQUERQUE
PUBLIC WORKS DEPARTMENT

LONGFORD VILLAGE EAST SUBDIVISION
DRAINAGE POND DETAILS

Design Review Committee	City Engineer Approval	Mo./Day/Yr.	Mo./Day/Yr.
APPROVED APR 19 2004	APPROVED MAY 28 2004		
DESIGN REVIEW COMMITTEE	CITY ENGINEER	Last Design Update	

City Project No. 732881 Zone Map No. L-21-Z Sheet 23 Of 23

ENGINEER'S SEAL		SURVEY INFORMATION		BENCH MARKS		AS-BUILT INFORMATION	
	FIELD NOTES						
	NO.	BY	DATE	ACS BRASS TABLET STAMPED "6-L21, 1986"		WORK STAMPED BY	DATE
				Geographic Position (NAD 1983)		ACCEPTED BY	
				N.M. State Plane Coordinates (Central Zone)		FIELD VERIFICATION BY	DATE
				X = 1,558,220.58	Y = 1,481,283.33	DRAWINGS CORRECTED BY	DATE
				Ground-to-Grid Factor = 0.999644584		MICROFILM INFORMATION	
				ΔQC = -00'09"28"		RECORDED BY	DATE
				NAVD88 Elevation = 5503.35		NO.	