



**CITY OF ALBUQUERQUE  
WATER UTILITY DEPARTMENT  
CONSTRUCTION DRAWINGS  
FOR**


# YALE WELL COLLECTOR REALIGNMENT

MAY 2005

CITY PROJECT NO. 733991

INDEX OF SHEETS

SHEET NO.	SHEET TITLE	SHEET NO.	SHEET TITLE
1	TITLE SHEET, PROJECT LOCATION MAP	10	UNIVERSITY BOULEVARD PLAN & PROFILE STA 90+94 TO 102+00
2	LOCATION MAP	11	UNIVERSITY BOULEVARD PLAN & PROFILE STA 102+00 TO 109+00
3	LEGEND AND GENERAL NOTES	12	UNIVERSITY BOULEVARD PLAN & PROFILE STA 109+00 TO 113+50
4	BUENA VISTA DRIVE PLAN & PROFILE STA 13+74 TO 21+00	13	MISCELLANEOUS AND PIPING DETAILS
5	BUENA VISTA DRIVE PLAN & PROFILE STA 21+00 TO 32+00	14	RESTRAINED JOINT DETAILS AND WATER METER LOCATION DIAGRAM
6	BUENA VISTA DRIVE PLAN & PROFILE STA 32+00 TO 43+00	15	WATER VALVE SHUT-OFF PLAN
7	BUENA VISTA DRIVE PLAN & PROFILE STA 43+00 TO 54+00		
8	BUENA VISTA DRIVE PLAN & PROFILE STA 54+00 TO 65+00		
9	BUENA VISTA DRIVE PLAN & PROFILE STA 65+00 TO 70+34		

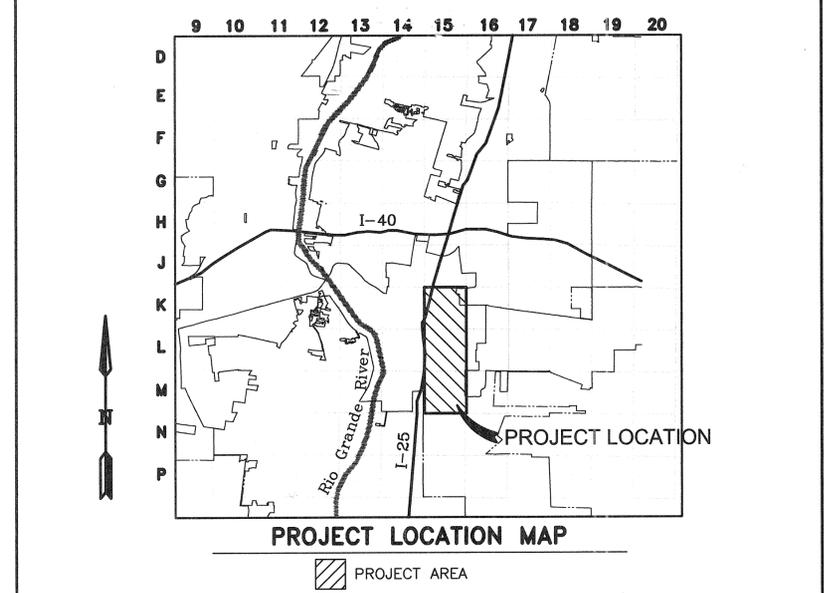


**UTILITY COMPANY CONTACTS**

BUSINESS	NAME	PHONE
PNM-ELECTRIC	MARK BOUCHARD	(505)241-3402
PNM-GAS CO. OF NM	JEFF ROMANOWSKI	(505)241-7703
AT&T	DAVID CROWEL	(505)842-2911
MCI WORLDCOM	ANDY DARNELL	(505)346-4470
COMCAST	RITA ERICKSON	(505)761-6235
TIME WARNER TELECOM	ROYAL HARRISON	(505)938-7339
XSPEDIUS	STEVE BENJAMIN	(505)998-2220
McLEOD USA	RICK MUELLER	(505)244-3161
QWEST/US WEST	DAVID MULLER	(505)245-8706
CITY OF ALBUQUERQUE	BILL BALCH	(505)768-2729
UNIVERSAL ACCESS	BRYAN PRICE	(312)660-6476
QWEST LONG DISTANCE	LARRY KELLY	(505)246-0501
LEVEL 3 COMMUNICATIONS	ROGER WEATHERS	(720)888-5688

I, THE UNDERSIGNED, A REGISTERED PROFESSIONAL ENGINEER IN THE STATE OF NEW MEXICO, DO HEREBY CERTIFY THAT THE INDICATED RECORD DRAWINGS ARE BASED UPON INFORMATION PROVIDED BY THE CONSTRUCTION CONTRACTOR IN THE FORM OF RED-LINED CONSTRUCTION DRAWING MARKUPS TO THE ORIGINAL DESIGN DRAWINGS. THE TRANSFER OF INFORMATION HEREIN IS TRUE AND CORRECT TO THE BEST OF MY KNOWLEDGE AND BELIEF. HOWEVER, I HAVE NOT VERIFIED THE ACCURACY AND/OR COMPLETENESS OF THE INFORMATION PROVIDED BY THE CONSTRUCTION CONTRACTOR AND SHALL NOT BE RESPONSIBLE FOR ERRORS OR OMISSIONS THAT MAY BE INCORPORATED AS A RESULT OF ERRONEOUS INFORMATION PROVIDED BY OTHERS. ALL INFORMATION INCLUDING VERTICAL AND HORIZONTAL DIMENSIONS SHOULD BE FIELD VERIFIED PRIOR TO USE ON FUTURE PROJECTS.

APPROVAL OF RECORD DRAWINGS  
CHIEF CONSTRUCTION ENGINEER  
*Victoria A. May* P.E.  
DATE: 8/13/2005

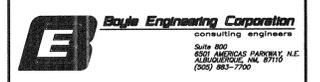

The subject property is located near a former landfill. Due to the subject property being near a former landfill, certain precautionary measures may need to be taken to ensure the health and safety of the public. Recommendations made by a professional engineer with expertise in landfills and landfill gas issues (as required by the most current version of the Interim Guidelines for Development within City Designated Landfill Buffer Zones) shall be consulted prior to development of the site.

X *[Signature]* INTERA INC. FOR AEMD 05-20-05  
Albuquerque Environmental Health Department Approval Date

REV.	SHEETS	CITY ENGINEER	DATE	USER DEPARTMENT	DATE	USER DEPARTMENT	DATE
ALL	AS-BUILT						
ENGINEERS STAMP & SIGNATURE		APPROVALS	ENGINEER	DATE	*****		
		DRC Chairman	<i>[Signature]</i>	5-24-05	APPROVED FOR CONSTRUCTION		
		Transportation	<i>[Signature]</i>	5/23/05			
		Water/Wastewater	<i>[Signature]</i>	5-13-05			
		Hydrology	<i>[Signature]</i>	5-20-05			
		Water Systems	<i>[Signature]</i>	5/20/05			
Water Resources	<i>[Signature]</i>						
Constr. Coord.	Robert Strong		5-20-05				
City Project No.		733991		Sheet		1 of 15	

DWG: A:\01\161\161\000\Plan\SH\CONSTR\CONSTR\SHEET.dwg USER: dante  
 DATE: May 20, 2005 2:59pm PLOTS: h:\plott\dm\6.w



**GENERAL NOTES**


- TWO WORKING DAYS PRIOR TO ANY EXCAVATION, CONTRACTOR MUST CONTACT N.M. ONE-CALL SYSTEM, INC., 260-1990, FOR LOCATION OF EXISTING UTILITIES. CONTRACTOR SHALL ALSO CALL TRAFFIC ENGINEERING AT 857-8000 FOR LOCATION OF TRAFFIC INTERCONNECT WIRING AND OTHER TRAFFIC SIGNAL EQUIPMENT.
- ALL WORK DETAILED ON THESE PLANS TO BE PERFORMED UNDER CONTRACT SHALL, EXCEPT AS OTHERWISE STATED OR PROVIDED FOR HEREON, BE CONSTRUCTED IN ACCORDANCE WITH THE CITY OF ALBUQUERQUE STANDARD SPECIFICATIONS FOR PUBLIC WORKS CONSTRUCTION, 1986 (AS AMENDED THROUGH UPDATE #7.) REFERENCED TO HEREIN AS THE "STANDARD SPECIFICATIONS".
- THE CONTRACTOR SHALL BE RESPONSIBLE FOR TIMING AND COORDINATION OF WATER SHUTOFF. AT LEAST SEVEN (7) WORKING DAYS PRIOR TO CONSTRUCTION, CONTRACTOR SHALL CONTACT THE WATER SYSTEMS DIVISION, 857-8200, TO INITIATE IMPLEMENTATION OF THE NON-PRESSURIZED CONNECTION PLAN.
- FIVE (5) WORKING DAYS PRIOR TO BEGINNING CONSTRUCTION, THE CONTRACTOR SHALL SUBMIT TO CONSTRUCTION COORDINATION DIVISION A DETAILED CONSTRUCTION SCHEDULE. TWO (2) WORKING DAYS PRIOR TO CONSTRUCTION, THE CONTRACTOR SHALL OBTAIN A BARRICADING PERMIT FROM THE CONSTRUCTION COORDINATION DIVISION. CONTRACTOR SHALL NOTIFY BARRICADE ENGINEER (924-3400) PRIOR TO OCCUPYING AN INTERSECTION.
- THE LOCATION OF EXISTING UNDERGROUND UTILITIES HAS BEEN DETERMINED BY INFORMATION PROVIDED BY OTHERS, AND SHALL BE CONSIDERED APPROXIMATE ONLY. THE CONTRACTOR SHALL DETERMINE THE EXACT LOCATION AND SIZE OF ALL EXISTING UTILITY LINES PRIOR TO CONSTRUCTION AND SHALL BE RESPONSIBLE FOR ANY AND ALL DAMAGES RESULTING FROM FAILURE TO LOCATE ANY AND ALL UTILITIES.
- THE CONTRACTOR SHALL SUPPORT AND MAINTAIN OPERATION OF ALL UTILITIES EXPOSED DURING TRENCHING AND OTHER CONSTRUCTION OPERATIONS. ALL CONSTRUCTION ACTIVITIES INVOLVING GAS, POWER, WATER, FIBER OPTIC, TRAFFIC SIGNAL EQUIPMENT, AND/OR OTHER UTILITY LINES SHALL BE COORDINATED WITH THE OWNER OF THE UTILITY PRIOR TO ANY DISTURBANCE. NO UTILITY SERVICE SHALL BE DISRUPTED WITHOUT FIRST NOTIFYING ALL AFFECTED PARTIES 48 HOURS IN ADVANCE.
- THE CONTRACTOR SHALL NOTIFY WATER UTILITY DIVISION OF PUBLIC WORKS (PH. 857-8200) AND THE CITY OF ALBUQUERQUE FIRE DEPARTMENT AT LEAST FIVE (5) WORKING DAYS IN ADVANCE OF ANY DAY THAT FIRE HYDRANTS WILL BE TAKEN OUT OF AND RETURNED TO SERVICE. REFER TO SECTION 18 (GENERAL CONDITIONS) OF THE SPECIFICATIONS.
- THE CONTRACTOR SHALL FIELD VERIFY ALL WATERLINE CONNECTIONS TO EXISTING FACILITIES SUFFICIENTLY IN ADVANCE OF CONSTRUCTION TO ALLOW OBTAINING CORRECT ADAPTERS AND OTHER FITTINGS.
- THE CONTRACTOR SHALL ASSUME RESPONSIBILITY FOR ANY DAMAGE TO EXISTING VALVE BOXES, MANHOLES, SEWER SERVICES, PAVEMENT MARKINGS, CURB & GUTTER, DRIVE PADS, WHEEL CHAIR RAMPS, AND SIDEWALKS DURING CONSTRUCTION, APART FROM THESE SECTIONS INDICATED FOR REMOVAL ON THE PLANS AND SHALL REPAIR OR REPLACE PER C.O.A. STANDARDS AT CONTRACTOR'S EXPENSE.
- QUANTITIES SHOWN FOR THE VARIOUS BID ITEMS ARE FOR CONTRACTOR INFORMATION ONLY. PAYMENT SHALL BE BASED ON ACTUAL QUANTITIES AS CONSTRUCTED.
- THE CONTRACTOR IS RESPONSIBLE FOR REMOVAL AND DISPOSAL OF ALL DEMOLITION DEBRIS IN AN ENVIRONMENTALLY ACCEPTABLE MANNER. ALL SALVAGED MATERIALS SHALL BE HANDLED IN ACCORDANCE WITH SECTION 801.15 OF THE STANDARD SPECIFICATIONS.
- TEMPORARY WATER SERVICE IS TO BE PROVIDED FOR ANY RESIDENCE, SCHOOL OR BUSINESS WHICH WILL BE OUT OF SERVICE MORE THAN FOUR HOURS.
- ALL WATER VALVE BOXES AND SEWER MANHOLES WITHIN THE NEW PAVEMENT ARE TO BE ADJUSTED TO FINISH GRADE PER COA STANDARD DETAILS.
- WHERE WATERLINES ARE TO BE REPLACED, PAVEMENT SHALL BE REMOVED AND REPLACED A MINIMUM OF 8 FEET WIDE WITH A MAXIMUM PAY WIDTH OF 9 FEET WIDE UNLESS OTHERWISE NOTED ON THE CONSTRUCTION DRAWINGS OR APPROVED BY THE ENGINEER.
- STREET CENTERLINE GRADES SHALL BE RESTORED BY THE CONTRACTOR TO THE EXISTING CENTERLINE GRADES UNLESS OTHERWISE DIRECTED BY THE ENGINEER. SMOOTH TRANSITIONS SHALL BE MADE BETWEEN EXISTING PAVEMENT WHICH REMAINS IN PLACE AND PAVEMENT WHICH IS BEING REPLACED.
- ALL STREET STRIPING AND MARKING ALTERED OR DESTROYED SHALL BE REPLACED WITH PLASTIC REFLECTORIZED PAVEMENT MARKINGS BY THE CONTRACTOR TO THE SAME LOCATION AS EXISTING OR AS INDICATED ON THE CONSTRUCTION DRAWINGS.
- THE CONTRACTOR SHALL NOT STORE AND/OR PARK EQUIPMENT IN FRONT OF PRIVATE RESIDENCES OVER NIGHT.
- THE CONTRACTOR SHALL MAINTAIN ALL TRENCHES IN A SAFE CONDITION PROTECTING THE WORKERS AND THE GENERAL PUBLIC. TRENCH PROTECTION SHALL BE IN ACCORDANCE WITH O.S.H.A. 29CFR 1926.650 SUBPART P. EXCAVATIONS SHALL BE SLOPED, BRACED OR SHORED AS REQUIRED BY O.S.H.A. REGULATIONS. THE CONTRACTOR IS SOLELY RESPONSIBLE FOR JOB SITE SAFETY, AND FOR KNOWLEDGE AND COMPLIANCE WITH APPLICABLE O.S.H.A. STANDARDS. NO ADDITIONAL COMPENSATION WILL BE MADE THEREFORE.
- ALL OPEN EXCAVATIONS SHALL BE BACKFILLED OR ADEQUATELY FENCED AT THE END OF EACH WORK DAY TO PREVENT SMALL CHILDREN AND/OR VEHICLES FROM ENTERING THE EXCAVATIONS. ALL OPEN EXCAVATIONS SHALL BE BACKFILLED OVER WEEKENDS AND WHEN THE CONTRACTOR IS NOT WORKING THE FOLLOWING DAY.

(GENERAL NOTES CONTINUED)

- THE CONSTRUCTION DRAWINGS SHOW THE APPROXIMATE ELEVATION OF THE EXISTING PAVEMENT AT THE CENTERLINE OF THE STREET. THE CONTRACTOR SHALL INSTALL THE NEW WATER LINE WITH A MINIMUM OF THREE FEET OF COVER OVER THE WATER LINE REGARDLESS OF ITS ALIGNMENT IN THE STREET.
- LOCATIONS OF PIPES AND OTHER UTILITIES ARE ESTIMATED. CONTRACTOR TO ADJUST ELEVATION OF NEW WATER LINE DURING CONSTRUCTION TO MISS THESE UTILITIES. CONTRACTOR TO MARK THEIR EXACT LOCATION ON THE AS-BUILT DRAWINGS AS THEY ARE ENCOUNTERED.
- PAVEMENT REPLACEMENT**  
RESIDENTIAL STREET - FLEXIBLE PAVEMENT  
FOR PAVEMENT CUTS > 8 FEET WIDE AND > 100 FEET LONG, PAVEMENT SHALL BE REPLACED AS PER CITY STANDARD DRAWING NO. 2405A TO MATCH THE THICKNESS OF THE REMOVED PAVING SECTION. THE TOP OR FINISH COURSE SHALL BE 2" THICK TYPE "C" GRADATION. THE ADDITIONAL THICKNESS OF ASPHALT CONCRETE SHALL BE TYPE "C" GRADATION.  
FOR PAVEMENT CUTS < 8 FEET WIDE, THE PAVEMENT SHALL BE REPLACED AS PER CITY STANDARD DRAWING NO. 2465 TO MATCH EXISTING PAVEMENT THICKNESS PLUS 2 INCHES.  
ARTERIAL/COLLECTOR STREET - FLEXIBLE PAVEMENT  
ARTERIAL STREETS COAL AVENUE & AVENIDA CESAR CHAVEZ PAVEMENT SHALL BE REPLACED AS PER CITY STANDARD DRAWING NO. 2465 TO MATCH EXISTING PAVEMENT THICKNESS PLUS 2 INCHES. THE POTHOLED PAVEMENT DEPTH ON AVENIDA CESAR CHAVEZ IS +/- 7 INCHES.  
THE REMAINING STREETS WITHIN THE PROJECT AREA, NOT DESIGNATED AS EITHER ARTERIAL OR COLLECTOR, ARE DESIGNATED AS RESIDENTIAL STREETS.  
THE ALLEYS WITHIN THE PROJECT AREA, WHETHER PAVED OR NOT PAVED, ARE DESIGNATED AS RESIDENTIAL ALLEYS.  
QUANTITIES SHOWN ON THE PLANS ARE APPROXIMATE BASED ON PAVEMENT THICKNESS ASSUMPTIONS.
- CONTRACTOR SHALL NOTIFY THE CITY OF ALBUQUERQUE GEODETIC SURVEY NOT LESS THAN THREE (3) WORKING DAYS PRIOR TO STARTING WORK THAT WILL IMPACT ANY EXISTING GEODETIC SURVEY MONUMENTS SHALL BE DONE BY THE CITY OF ALBUQUERQUE GEODETIC SURVEY. ANY ACS MONUMENTS DAMAGED OR DESTROYED DUE TO THE FAILURE OF CONTRACTOR TO NOTIFY AS STATED ABOVE SHALL BE REPLACED BY THE CITY OF ALBUQUERQUE GEODETIC SURVEY AT CONTRACTOR'S EXPENSE.
- CONTRACTOR SHALL NOTIFY ENGINEER NO LESS THAN SEVEN (7) DAYS PRIOR TO STARTING WORK IN ORDER THAT THE ENGINEER MAY TAKE NECESSARY MEASURES TO ENSURE THE PRESERVATION OF ALL OTHER PERMANENT SURVEY MONUMENTS WITHOUT THE CONSENT OF THE ENGINEER AND BEAR THE EXPENSE OF REPLACING ANY THAT MAY BE DISTURBED WITHOUT PERMISSION. ONLY THE ENGINEER SHALL DO REPLACEMENT. WHEN A CHANGE IS MADE IN THE FINISHED ELEVATION OF THE PAVEMENT OF ANY ROADWAY IN WHICH A PERMANENT SURVEY MONUMENT IS LOCATED, CONTRACTOR SHALL, AT CONTRACTOR EXPENSE, ADJUST THE MONUMENT COVER TO THE NEW GRADE UNLESS OTHERWISE SPECIFIED.
- CONTRACTOR SHALL CONSTRUCT PROJECT SOUTH ON BUENA VISTA DRIVE FROM COAL AVENUE SOUTH TO GIBSON BOULEVARD, THEN ON UNIVERSITY BLVD FROM GIBSON BOULEVARD TO RANDOLPH ROAD.
- CONTRACTOR SHALL NOT CLOSE MORE THAN TWO BLOCKS OF BUENA VISTA DRIVE AT ANY ONE TIME DURING CONSTRUCTION.
- CONTRACTOR SHALL LIMIT CONSTRUCTION ON BUENA VISTA DRIVE ON HOME GAME DAYS AT UNM ATHLETIC FACILITIES OR AT HOME ISOTOPIES BASEBALL GAMES SUCH THAT BUENA VISTA REMAINS ACCESSIBLE AS AN INGRESS/EGRESS ROAD FOR THOSE SPORTING EVENTS.
- CONTRACTOR SHALL LIMIT COAL AVENUE CLOSURE TO ONE LANE AND PERFORM INVESTIGATION, DEMOLITION AND INSTALLATION ACTIVITIES ON WEEKENDS ONLY. PROVIDE AND MAINTAIN PAVEMENT PATCH UNTIL INSTALLATION IS COMPLETE AND ACCEPTED BY THE CITY.
- CONTRACTOR SHALL COORDINATE WORK ON AVENIDA CESAR CHAVEZ WITH SPORTING EVENTS THE SAME AS REQUIRED FOR BUENA VISTA DRIVE.
- CONTRACTOR SHALL COORDINATE WORK AT GIBSON BOULEVARD (BUENA VISTA DRIVE AND UNIVERSITY BOULEVARD) WITH THE GIBSON BOULEVARD RECONSTRUCTION CONTRACTOR.
- CONTRACTOR SHALL NOT MAKE TIES TO EXISTING WELL COLLECTOR UNLESS APPROVED IN ADVANCE WITH WATER UTILITY DIVISION. CONTACT VICTORIA DERY @ 857-8258 TO SCHEDULE TIES.
- ALL EXCAVATION, TRENCHING AND SHORING ACTIVITIES MUST BE CARRIED OUT IN ACCORDANCE WITH OSHA 29 CFR 1926.650 SUBPART P.
- UTILIZE FLOWABLE FILL WHERE NOTED ON PLANS, OR WHEREVER BACKFILL MATERIAL CAN NOT BE PLACED AND COMPACTED BETWEEN THE NEW PIPE LINE AND EXISTING UTILITIES, OR IF THE SEPARATION BETWEEN THE NEW PIPE LINE AND EXISTING UTILITY IS LESS THAN 6 INCHES, OR IF REQUIRED BY THE DRAWINGS. AT UTILITY CROSSINGS WITH LESS THAN 6 INCH CLEARANCE, FLOWABLE FILL SHALL BE PLACED 5 FEET EACH SIDE. THIS COST IS INCIDENTAL TO BACKFILL COSTS.

**LEGEND**

PROPOSED	EXISTING	DESCRIPTION
NA	--- 8" SAS ---	SANITARY SEWER LINE W/SIZE
NA	--- 8" SD ---	STORM SEWER LINE W/SIZE
6" WL	--- 6" WL ---	WATER LINE W/SIZE
NA	--- ○ ---	MANHOLE
---	---	WATER LINE / GATE VALVE
---	---	WATER LINE / BUTTERFLY VALVE
NA	---	FIRE HYDRANT
NA	---	DROP INLET
---	---	REDUCER
---	NA	PIPE COUPLING
---	---	TEE
---	---	CROSS
---	---	BEND
---	NA	CAP OR PLUG
NA	---	POLE
NA	---	SIGN
NA	---	POLE W/ LIGHT
NA	---	LIGHT POLE
NA	---	UNDERGROUND TELEPHONE LINE
NA	---	UNDERGROUND GAS LINE
NA	---	UNDERGROUND CATV LINE
NA	---	UNDERGROUND ELECTRIC
NA	---	OVERHEAD ELECTRIC
NA	---	RIGHT OF WAY LINE
NA	---	GRAVEL/GRADED/UNPAVED ROAD
NA	---	PAVED ROAD
---	---	CURB AND GUTTER AND SIDEWALK
NA	---	BUILDING
---	---	CONCRETE SIDEWALK OR DRIVEWAY
NA	---	WIRE FENCE
---	---	CHAINLINK FENCE
NA	---	BLOCK WALL
NA	---	3'-6" SIDEWALK
---	---	ZONE MAP BOUNDARY
---	---	WATER METER
---	---	WHEEL CHAIR RAMPS
TP=5149.8	---	TOP OF PIPE W/ELEVATION
WC	---	WELL COLLECTOR
SVY PI STA	---	SURVEY POINT OF INFLECTION STATION
POB SVY STA	---	POINT OF BEGINNING SURVEY STATION
POE SVY STA	---	POINT OF ENDING SURVEY STATION
---	---	COMBINATION AIR/VAC AND RELEASE VALVE

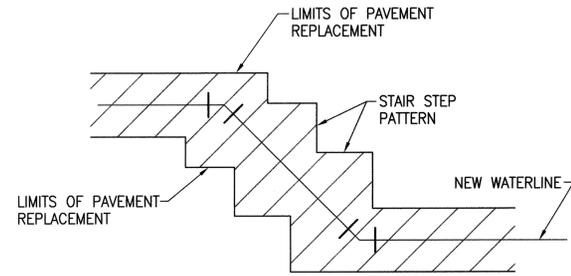

- ALL PAVEMENT REPLACEMENT CUTS FOR WATERLINES ON DIAGONALS MUST BE PARALLEL OR PERPENDICULAR TO THE NORMAL FLOW OF TRAFFIC.
- USE STAIR STEP PATTERN IN ORDER TO KEEP THE MAXIMUM REPLACEMENT WIDTH TO 9 FEET.

TYPICAL DIAGONAL CUT PAVEMENT REPLACEMENT DETAIL  
NTS

YALE WELL COLLECTOR REALIGNMENT - PRIMARY CONTROL			
NAD 27 NGVD29			
PROJECT GROUND TO GRID = 0.99967484			
C.O.A. BENCHMARK	GROUND NORTHING	GROUND EASTING	ELEVATION, (FT.)
SDC_14-15	1,482,395.260	384,452.920	5036.3
SDC_13-4	1,477,563.190	384,890.540	5040.7
1-25-30	1,477,752.770	384,040.910	5038.51
G-9A	1,477,193.800	387,390.920	5143.07
7-L15	1,479,968.770	388,947.850	5161.477
5-M14	1,473,746.303	381,668.933	4937.592
5-K16A	1,485,437.255	390,376.915	5171.38
4-K15	1,485,997.187	384,770.822	5045.075
1-M16	1,477,175.738	388,970.037	5189.847
15-L14	1,480,530.900	381,909.980	4964.823
14-L14	1,479,270.560	382,025.860	4958.507

HORIZONTAL ALIGNMENT SURVEY DATA		
STATION	NORTHING	EASTING
10+00.00	1,483,227.353	388,379.3242
10+41.56	1,483,185.872	388,376.8058
10+41.56	1,483,185.872	388,376.8058
16+62.04	1,482,565.415	388,371.4438
16+62.04	1,482,565.415	388,371.4438
17+65.82	1,482,462.009	388,365.4062
17+65.82	1,482,462.009	388,365.4062
22+65.60	1,481,962.054	388,360.7749
22+65.60	1,481,962.054	388,360.7749
24+10.24	1,481,818.849	388,340.4148
24+10.24	1,481,818.849	388,340.4148
55+36.78	1,478,692.398	388,316.6876
55+36.78	1,478,692.398	388,316.6876
56+67.26	1,478,561.924	388,317.109
56+67.26	1,478,561.924	388,317.109
70+34.44	1,477,194.805	388,303.5235
70+34.44	1,477,194.805	388,303.5235
84+11.95	1,477,201.476	386,926.0358
84+11.95	1,477,201.476	386,926.0358
87+12.63	1,477,209.125	386,625.4546
87+12.63	1,477,209.125	386,625.4546
89+99.47	1,477,231.244	386,339.4672
89+99.47	1,477,231.244	386,339.4672
90+93.63	1,477,137.649	386,329.1832
90+93.63	1,477,137.649	386,329.1832
94+75.35	1,476,755.928	386,329.098
94+75.35	1,476,755.928	386,329.098
95+67.76	1,476,663.531	386,330.5739
95+67.76	1,476,663.531	386,330.5739
99+34.18	1,476,297.112	386,328.3079
99+34.18	1,476,297.112	386,328.3079
105+52.00	1,475,679.289	386,328.1182
105+52.00	1,475,679.289	386,328.1182
113+50.00	1,474,881.294	386,329.438

I, THE UNDERSIGNED, A REGISTERED PROFESSIONAL ENGINEER IN THE STATE OF NEW MEXICO, DO HEREBY CERTIFY THAT THE INDICATED RECORD DRAWINGS ARE BASED UPON INFORMATION PROVIDED BY THE CONSTRUCTION CONTRACTOR IN THE FORM OF RED-LINED CONSTRUCTION DRAWING MARKUPS TO THE ORIGINAL DESIGN DRAWINGS. THE TRANSFER OF INFORMATION HEREIN IS TRUE AND CORRECT TO THE BEST OF MY KNOWLEDGE AND BELIEF. HOWEVER, I HAVE NOT VERIFIED THE ACCURACY AND/OR COMPLETENESS OF THE INFORMATION PROVIDED BY THE CONSTRUCTION CONTRACTOR AND SHALL NOT BE RESPONSIBLE FOR ERRORS OR OMISSIONS THAT MAY BE INCORPORATED AS A RESULT OF ERRONEOUS INFORMATION PROVIDED BY OTHERS. ALL HORIZONTAL DIMENSIONS SHOULD BE FIELD VERIFIED PRIOR TO USE ON FUTURE PROJECTS.

*Chang-Hyuk Kwon*

**BOYLE ENGINEERING CORPORATION**  
consulting engineers  
6501 Americas Parkway N.E. Suite 800  
Albuquerque, NM 87110 (505) 883-7700

**CITY OF ALBUQUERQUE**  
WATER UTILITY DEPARTMENT



TITLE: **YALE WELL COLLECTOR REALIGNMENT**

**LEGEND AND GENERAL NOTES**

Design Review Committee	City Engineer Approval	Mo./Day/Yr.	Mo./Day/Yr.
REVIEW COMMITTEE	MAY 24 2005 CITY ENGINEER		
City Project No. <b>733991</b>	Zone Map No. <b>N/A</b>	Sheet <b>3</b> of <b>15</b>	





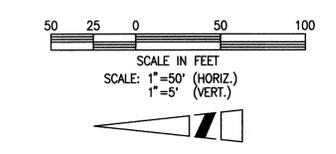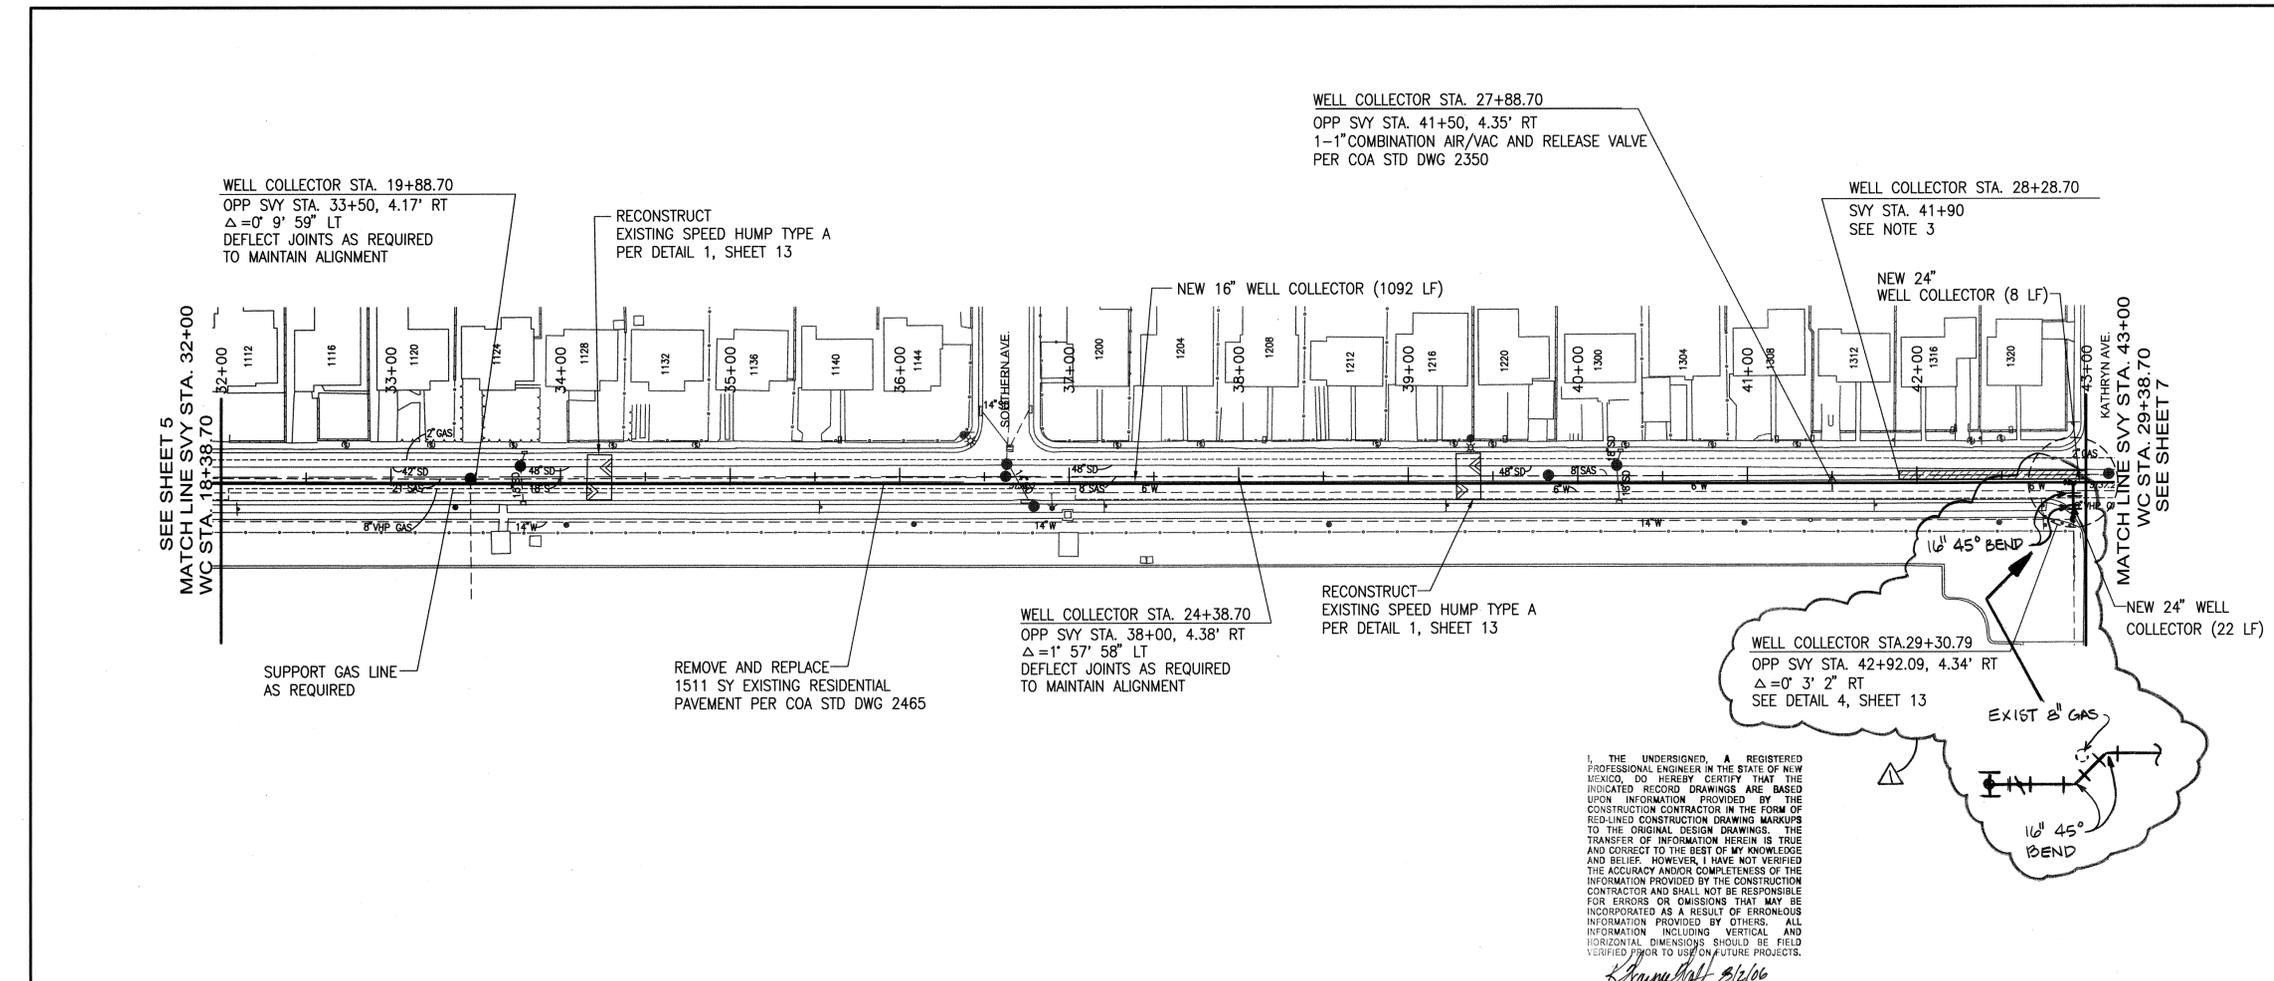


- NOTES:**
1. PROFILE CENTERLINE IS CENTERLINE OF SURVEY, NOT CENTERLINE OF STREET OR WELL COLLECTOR.
  2. RESTRAINED JOINT LENGTHS ARE FOR PVC. IF CONCRETE CYLINDER PIPE OR DUCTILE IRON PIPE IS USED, THRUST RESTRAINT SHALL BE PER SPECIFICATION SECTION 801.13 OR SPECIFICATION SECTION 801.12 RESPECTIVELY.
  3. ENCASE EXISTING 8" SAS PER C.O.A. STD. DWG. 2140 OR REPLACE EXISTING SAS WITH PRESSURE RATED PVC SEWER PIPE.
  4. FOR SURVEY HORIZONTAL ALIGNMENT DATA SEE SHEET 3.
  5. PROFILE STATIONING IS CENTERLINE OF SURVEY NOT CENTERLINE OF WELL COLLECTOR.
  6. DEFLECTIONS SHOWN ARE FOR WELL COLLECTOR NOT SURVEY DEFLECTIONS.
  7. USE TRENCH BOX TO MINIMIZE TRENCH WIDTH AND PROTECT ADJACENT UTILITIES.
  8. GRADE SHOWN IS @ CENTERLINE OF SURVEY
  9. REPLACE ALL RESIDENTIAL GALVANIZED STEEL AND POLYETHYLENE SERVICE LINES FROM DISTRIBUTION LINE. ANY OTHER TYPE OF SERVICE LINE, VERIFY REPLACEMENT WITH ENGINEER. METER YOKE/COPPERSETTER REPLACEMENT TO BE FIELD VERIFIED. METER BOX REPLACEMENT AND RELOCATION SHALL ONLY OCCUR WITH SERVICE LINE REPLACEMENT AND SHALL BE PER C.O.A. STD. DWG. 2362 PER THE FOLLOWING SCHEDULE:

HOUSE NO.	LOCATION	METER SIZE	REPLACE BOX	RELOCATE BOX
1112	F4	3/4"		
1116	F6	3/4"		
1120	F5	1"		
1124	F6	3/4"		
1128	F8	3/4"		
1132	F8	3/4"		
1136	F8	3/4"		
1140	F8	3/4"		
1200	F7	3/4"	X	
1204	F7	3/4"	X	
1208	F7	3/4"	X	
1212	F8	3/4"	X	
1216	F5	3/4"	X	
1220	F3	3/4"	X	
1300	F7	3/4"	X	
1304	F7	3/4"	X	
1308	F8	3/4"		
1312	F6	3/4"	X	
1316	F7	3/4"	X	X
1320	F2	3/4"	X	X

I, THE UNDERSIGNED, A REGISTERED PROFESSIONAL ENGINEER IN THE STATE OF NEW MEXICO, DO HEREBY CERTIFY THAT THE INDICATED RECORD DRAWINGS ARE BASED UPON INFORMATION PROVIDED BY THE CONSTRUCTION CONTRACTOR IN THE FORM OF RED-LINED CONSTRUCTION DRAWING MARKUPS TO THE ORIGINAL DESIGN DRAWINGS. THE TRANSFER OF INFORMATION HEREIN IS TRUE AND CORRECT TO THE BEST OF MY KNOWLEDGE AND BELIEF. HOWEVER, I HAVE NOT VERIFIED THE ACCURACY AND/OR COMPLETENESS OF THE INFORMATION PROVIDED BY THE CONSTRUCTION CONTRACTOR AND SHALL NOT BE RESPONSIBLE FOR ERRORS OR OMISSIONS THAT MAY BE INCORPORATED AS A RESULT OF ERRONEOUS INFORMATION PROVIDED BY OTHERS. ALL INFORMATION INCLUDING VERTICAL AND HORIZONTAL DIMENSIONS SHOULD BE FIELD VERIFIED PRIOR TO USE ON A FUTURE PROJECTS.

*Signature*  
5/16/06

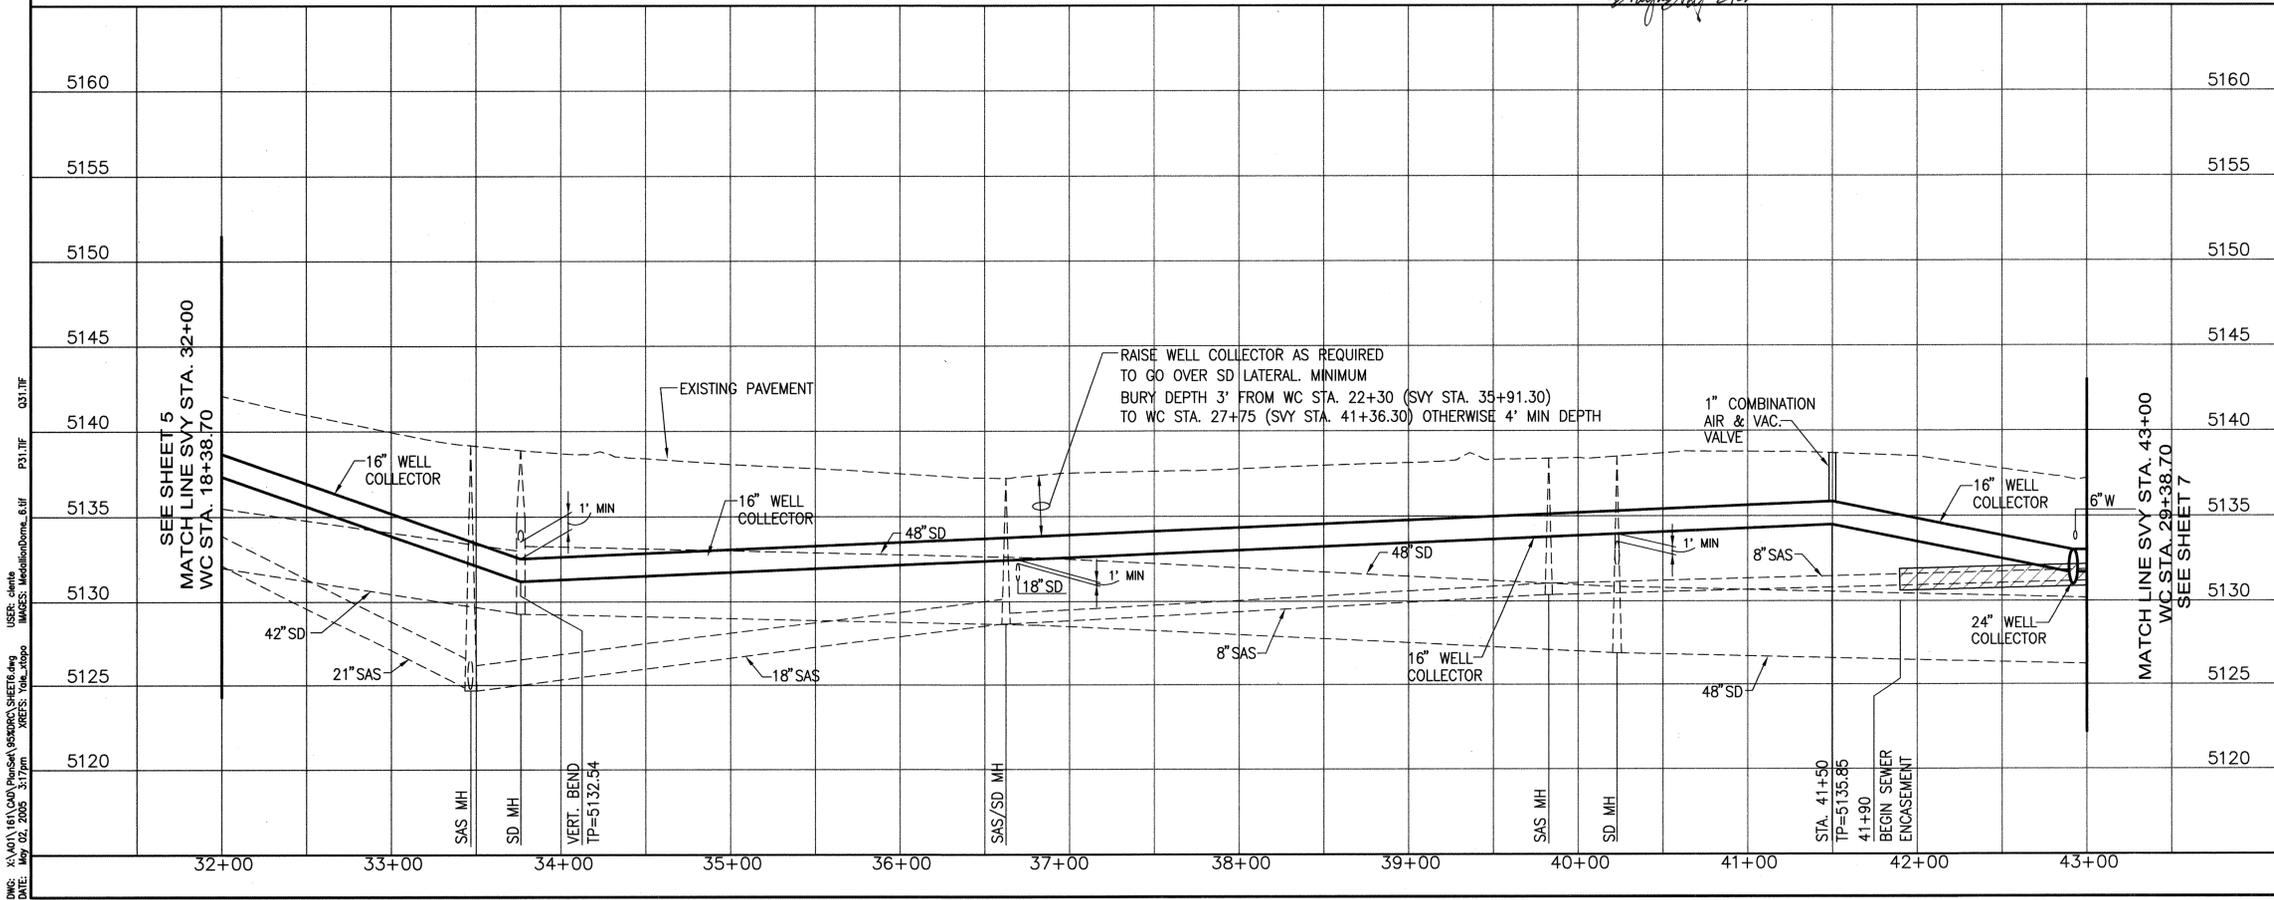

**SOYLE ENGINEERING CORPORATION**  
consulting engineers  
6501 Americas Parkway N.E. Suite 800  
Albuquerque, NM 87110 (505) 883-7700

**CITY OF ALBUQUERQUE**  
WATER UTILITY DEPARTMENT

**TITLE: YALE COLLECTOR REALIGNMENT  
BUENA VISTA DRIVE PLAN & PROFILE  
STA. 32+00 TO 43+00**

Design Review Committee <b>APPROVED</b> MAY 2 2005 CITY ENGINEER	City Engineer <b>APPROVED</b> MAY 2 2005 CITY ENGINEER	Mo./Day/Yr. ____/____/____	Mo./Day/Yr. ____/____/____
---	---	-------------------------------	-------------------------------

City Project No. **733991** Zone Map No. **L-15** Sheet **6** of **15**


DWS: A:\01\161\CAU\Projects\900000\SHEET6.dwg USER: clemie Q31.TIF  
 DATE: May 02, 2005 3:17pm PLOT: ModInfoDwg.plt

AS-BUILT INFORMATION	
CONTRACTOR	WORKED BY
INSPECTORS	ACCEPTANCE BY
VERIFICATION BY	DATE
RECORDED BY	DATE
NO.	

SURVEY INFORMATION	
FIELD NOTES	DATE
NO.	

ENGINEERS SEAL	
DATE	BY
NO.	

REVISIONS	
NO.	DATE
DESIGNED BY	DATE
DRAWN BY	DATE
CHECKED BY	DATE

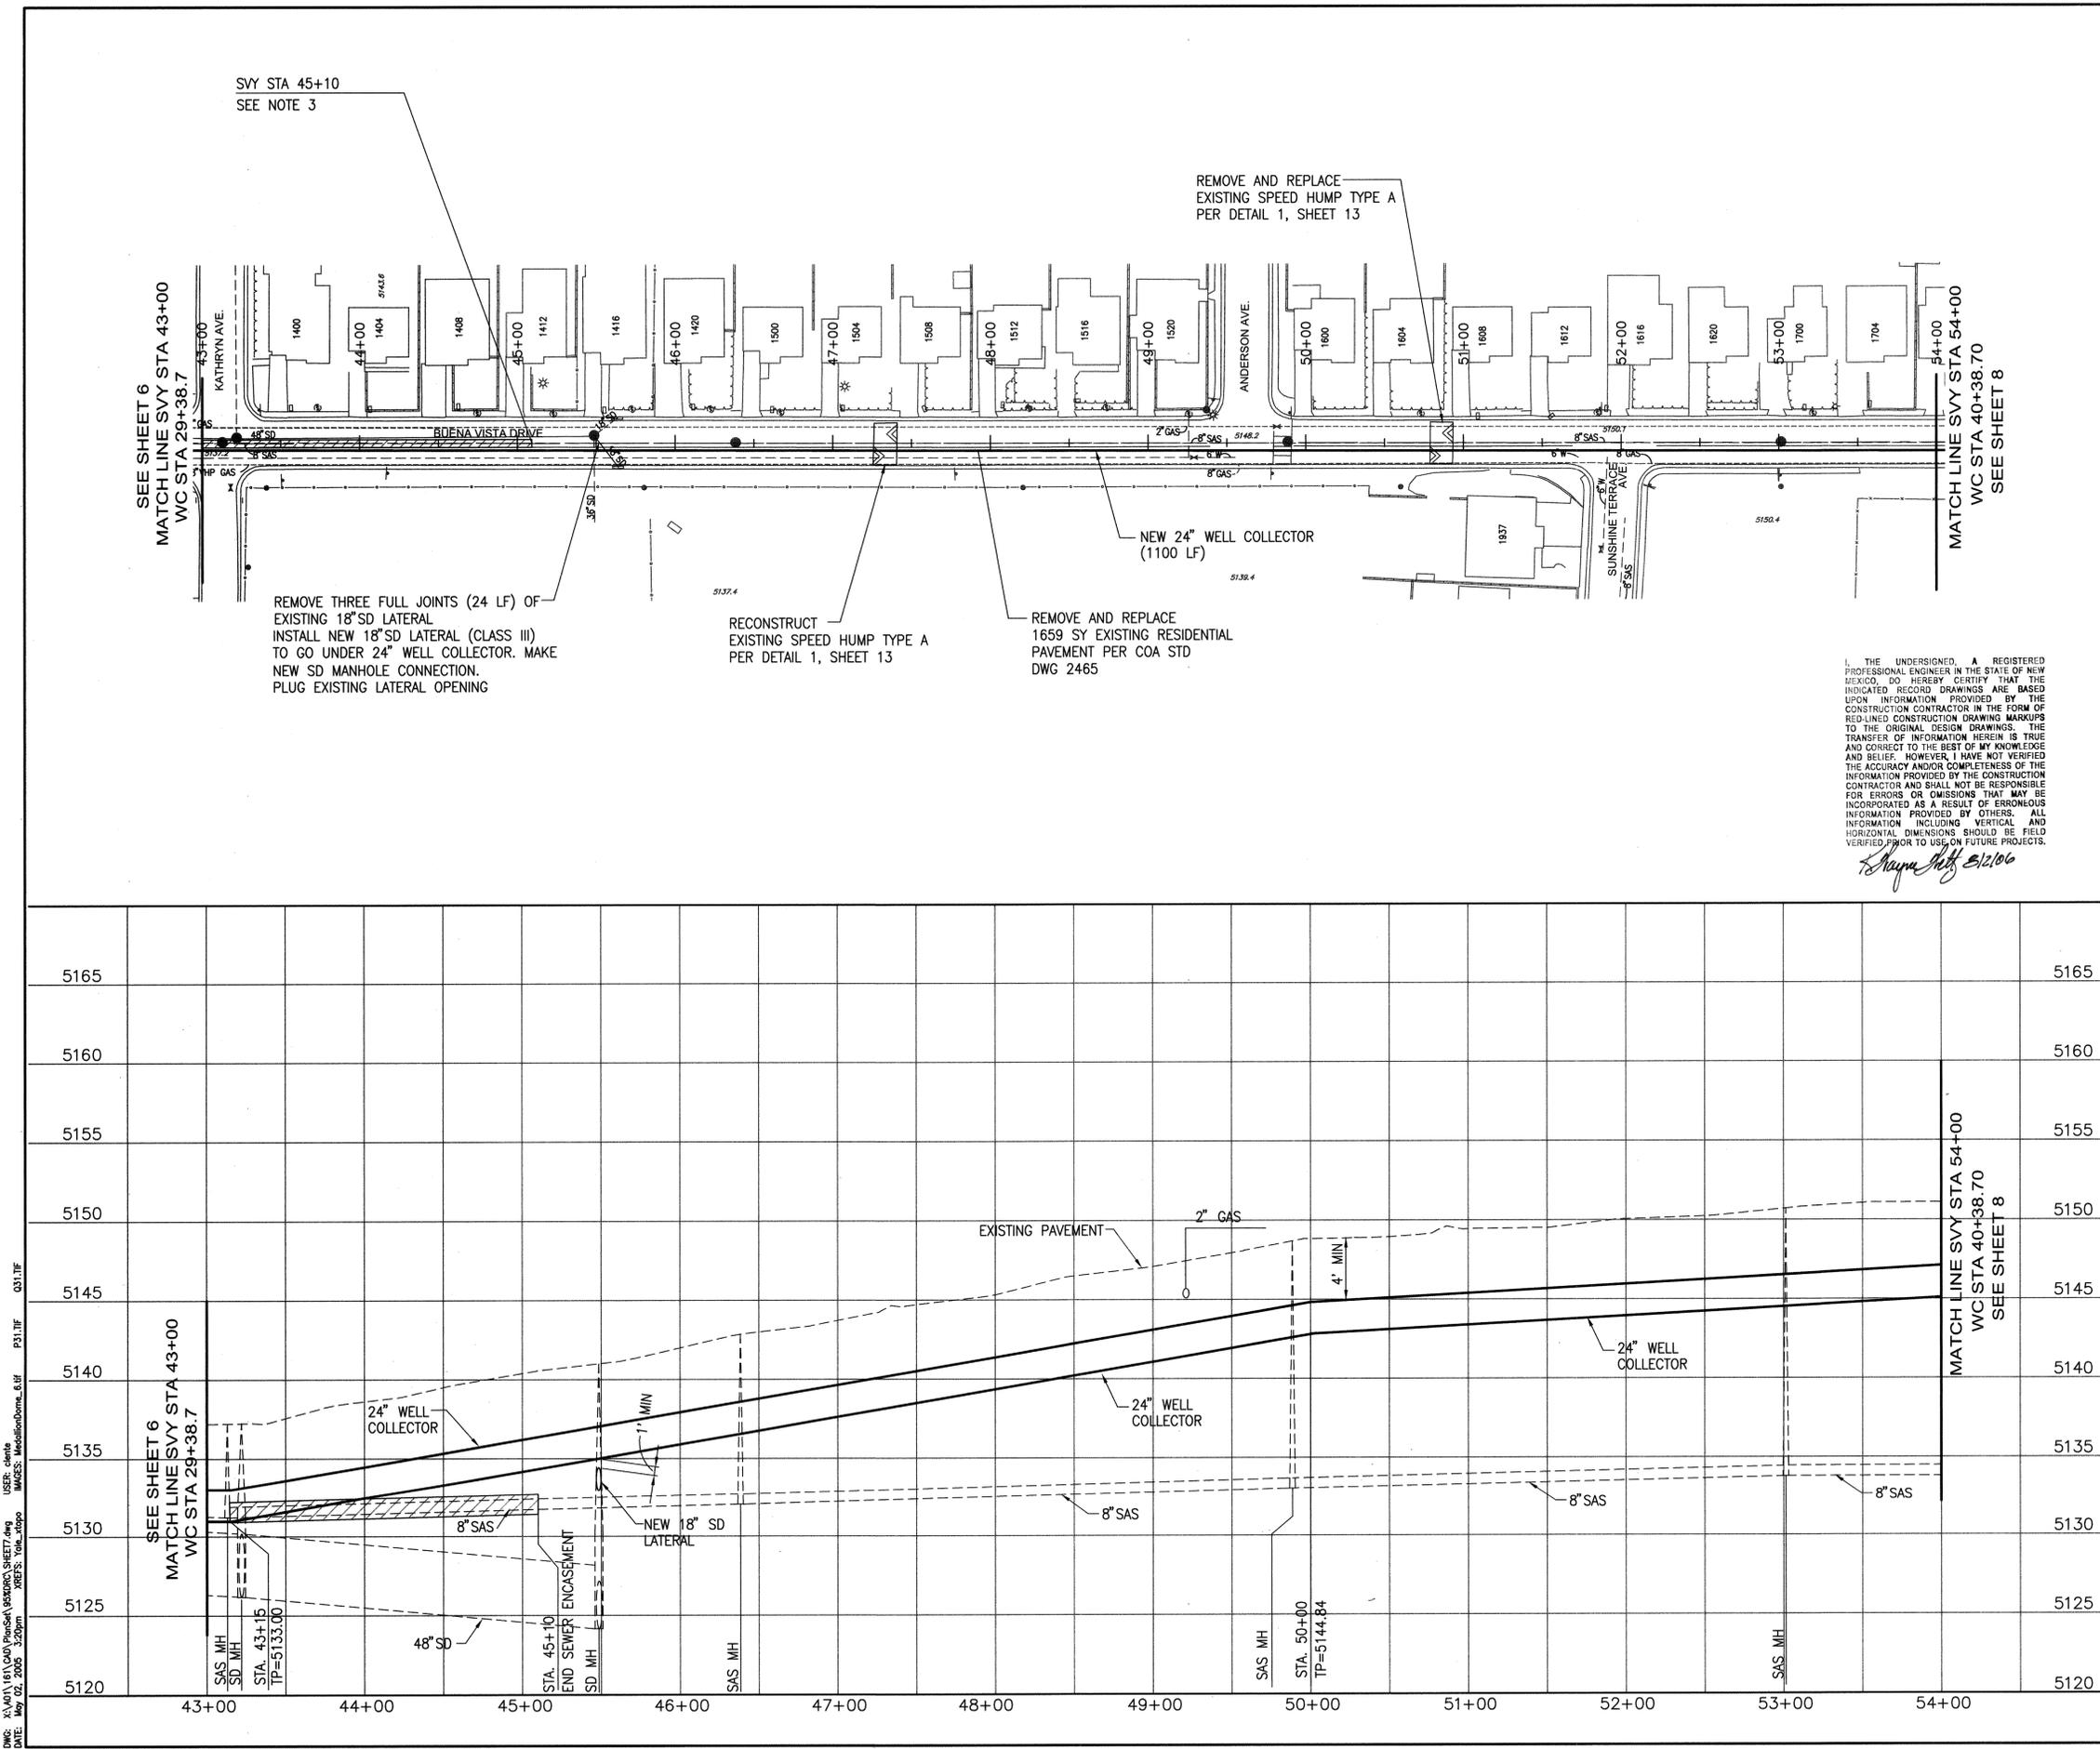

SVY STA 45+10  
SEE NOTE 3

REMOVE AND REPLACE  
EXISTING SPEED HUMP TYPE A  
PER DETAIL 1, SHEET 13

SEE SHEET 6  
MATCH LINE SVY STA 43+00  
WC STA 29+38.7

MATCH LINE SVY STA 54+00  
WC STA 40+38.70  
SEE SHEET 8

REMOVE THREE FULL JOINTS (24 LF) OF  
EXISTING 18" SD LATERAL  
INSTALL NEW 18" SD LATERAL (CLASS III)  
TO GO UNDER 24" WELL COLLECTOR. MAKE  
NEW SD MANHOLE CONNECTION.  
PLUG EXISTING LATERAL OPENING



RECONSTRUCT  
EXISTING SPEED HUMP TYPE A  
PER DETAIL 1, SHEET 13

REMOVE AND REPLACE  
1659 SY EXISTING RESIDENTIAL  
PAVEMENT PER COA STD  
DWG 2465

NEW 24" WELL COLLECTOR  
(1100 LF)

I, THE UNDERSIGNED, A REGISTERED  
PROFESSIONAL ENGINEER IN THE STATE OF NEW  
MEXICO, DO HEREBY CERTIFY THAT THE  
INDICATED RECORD DRAWINGS ARE BASED  
UPON INFORMATION PROVIDED BY THE  
CONSTRUCTION CONTRACTOR IN THE FORM OF  
RED-LINED CONSTRUCTION DRAWING MARKUPS  
TO THE ORIGINAL DESIGN DRAWINGS. THE  
TRANSFER OF INFORMATION HEREIN IS TRUE  
AND CORRECT TO THE BEST OF MY KNOWLEDGE  
AND BELIEF. HOWEVER, I HAVE NOT VERIFIED  
THE ACCURACY AND/OR COMPLETENESS OF THE  
INFORMATION PROVIDED BY THE CONSTRUCTION  
CONTRACTOR AND SHALL NOT BE RESPONSIBLE  
FOR ERRORS OR OMISSIONS THAT MAY BE  
INCORPORATED AS A RESULT OF ERRONEOUS  
INFORMATION PROVIDED BY OTHERS. ALL  
INFORMATION INCLUDING VERTICAL AND  
HORIZONTAL DIMENSIONS SHOULD BE FIELD  
VERIFIED PRIOR TO USE ON FUTURE PROJECTS.

*Shayne J. Kelly 5/12/06*

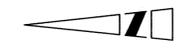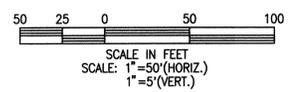

- NOTES:**
1. PROFILE CENTERLINE IS CENTERLINE OF SURVEY, NOT CENTERLINE OF STREET OR WELL COLLECTOR.
  2. RESTRAINED JOINT LENGTHS ARE FOR PVC. IF CONCRETE CYLINDER PIPE OR DUCTILE IRON PIPE IS USED, THRUST RESTRAINT SHALL BE PER SPECIFICATION SECTION 801.13 OR SPECIFICATION SECTION 801.12 RESPECTIVELY.
  3. ENCASE EXISTING 8" SAS PER C.O.A. STD. DWG. 2140 OR REPLACE EXISTING SAS WITH PRESSURE RATED PVC SEWER PIPE.
  4. FOR SURVEY HORIZONTAL ALIGNMENT DATA SEE SHEET 3.
  5. PROFILE STATIONING IS CENTERLINE OF SURVEY NOT CENTERLINE OF WELL COLLECTOR.
  6. DEFLECTIONS SHOWN ARE FOR WELL COLLECTOR NOT SURVEY DEFLECTIONS.
  7. USE TRENCH BOX TO MINIMIZE TRENCH WIDTH AND PROTECT ADJACENT UTILITIES.
  8. GRADE SHOWN IS @ CENTERLINE OF SURVEY
  9. REPLACE ALL RESIDENTIAL GALVANIZED STEEL AND POLYETHYLENE SERVICE LINES FROM DISTRIBUTION LINE. ANY OTHER TYPE OF SERVICE LINE, VERIFY REPLACEMENT WITH ENGINEER. METER YOKE/COPPERSETTER REPLACEMENT TO BE FIELD VERIFIED. METER BOX REPLACEMENT AND RELOCATION SHALL ONLY OCCUR WITH SERVICE LINE REPLACEMENT AND SHALL BE PER C.O.A. STD. DWG. 2362 PER THE FOLLOWING SCHEDULE:

HOUSE NO.	LOCATION	METER SIZE	REPLACE BOX	RELOCATE BOX
1400	F5	3/4"	VERIFY	VERIFY
1404	F4	3/4"	X	X
1408	F7	3/4"	X	X
1412	F4	3/4"	X	X
1416	F6	3/4"	X	X
1420	F4	3/4"	X	X
1500	F4	3/4"	X	X
1504	F5	3/4"	X	X
1508	F4	3/4"	X	X
1512	F7	3/4"	X	X
1516	F5	3/4"	X	X
1520	F7	3/4"	X	X
1937*	R3	3/4"	X	X
1600	F4	3/4"	X	X
1604	F4	3/4"	X	X
1608	F6	3/4"	X	X
1612	F4	3/4"	X	X
1616	F4	3/4"	X	X
1620	F6	3/4"	X	X
1700	F4	3/4"	X	X
1704	F6	3/4"	X	X

\*1937 SUNSHINE TERRACE AVE.

**SOYLE ENGINEERING CORPORATION**  
consulting engineers  
6501 Americas Parkway N.E. Suite 800  
Albuquerque, NM 87110 (505) 883-7700



**TITLE: YALE WELL COLLECTOR REALIGNMENT  
BUENA VISTA DRIVE PLAN & PROFILE  
STA. 43+00 TO 54+00**

Design Review Committee: APPROVE  
City Engineer Approval: APPROVE  
MAY 24 2005  
CITY ENGINEER

City Project No. **733991** Zone Map No. **L-15** Sheet **7** of **15**



DWG: N:\A\161\COU\Projects\65090\DWG\SHEET.dwg  
 DATE: May 22, 2005 10:29am  
 USER: shwp  
 P31.TIF  
 P31.TIF  
 ADDRESS: \\ms01\home\shwp

AS BUILT INFORMATION		BENCH MARKS		SURVEY INFORMATION		ENGINEERS SEAL	
CONTRACTOR	INSPECTOR'S	DATE	NO.	NO.	DATE	NO.	DATE
NM UNDERGROUND	TEREKALAND SURVEY	SEE SHEET 3					
BY: BILL MCCALL	FIELD CHECKED BY: BILL MCCALL						
CONNECTED BY: BEC	MICRO-FILM INFORMATION						
RECORDED BY:	DATE:						
NO.							



NO.	DATE	REVISIONS	DESIGN
AS-BUILT			

DESIGNED BY	DATE	1/04
PJC		
DRAWN BY	DATE	1/04
WBH		
CHECKED BY	DATE	1/04
KW		

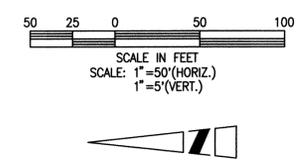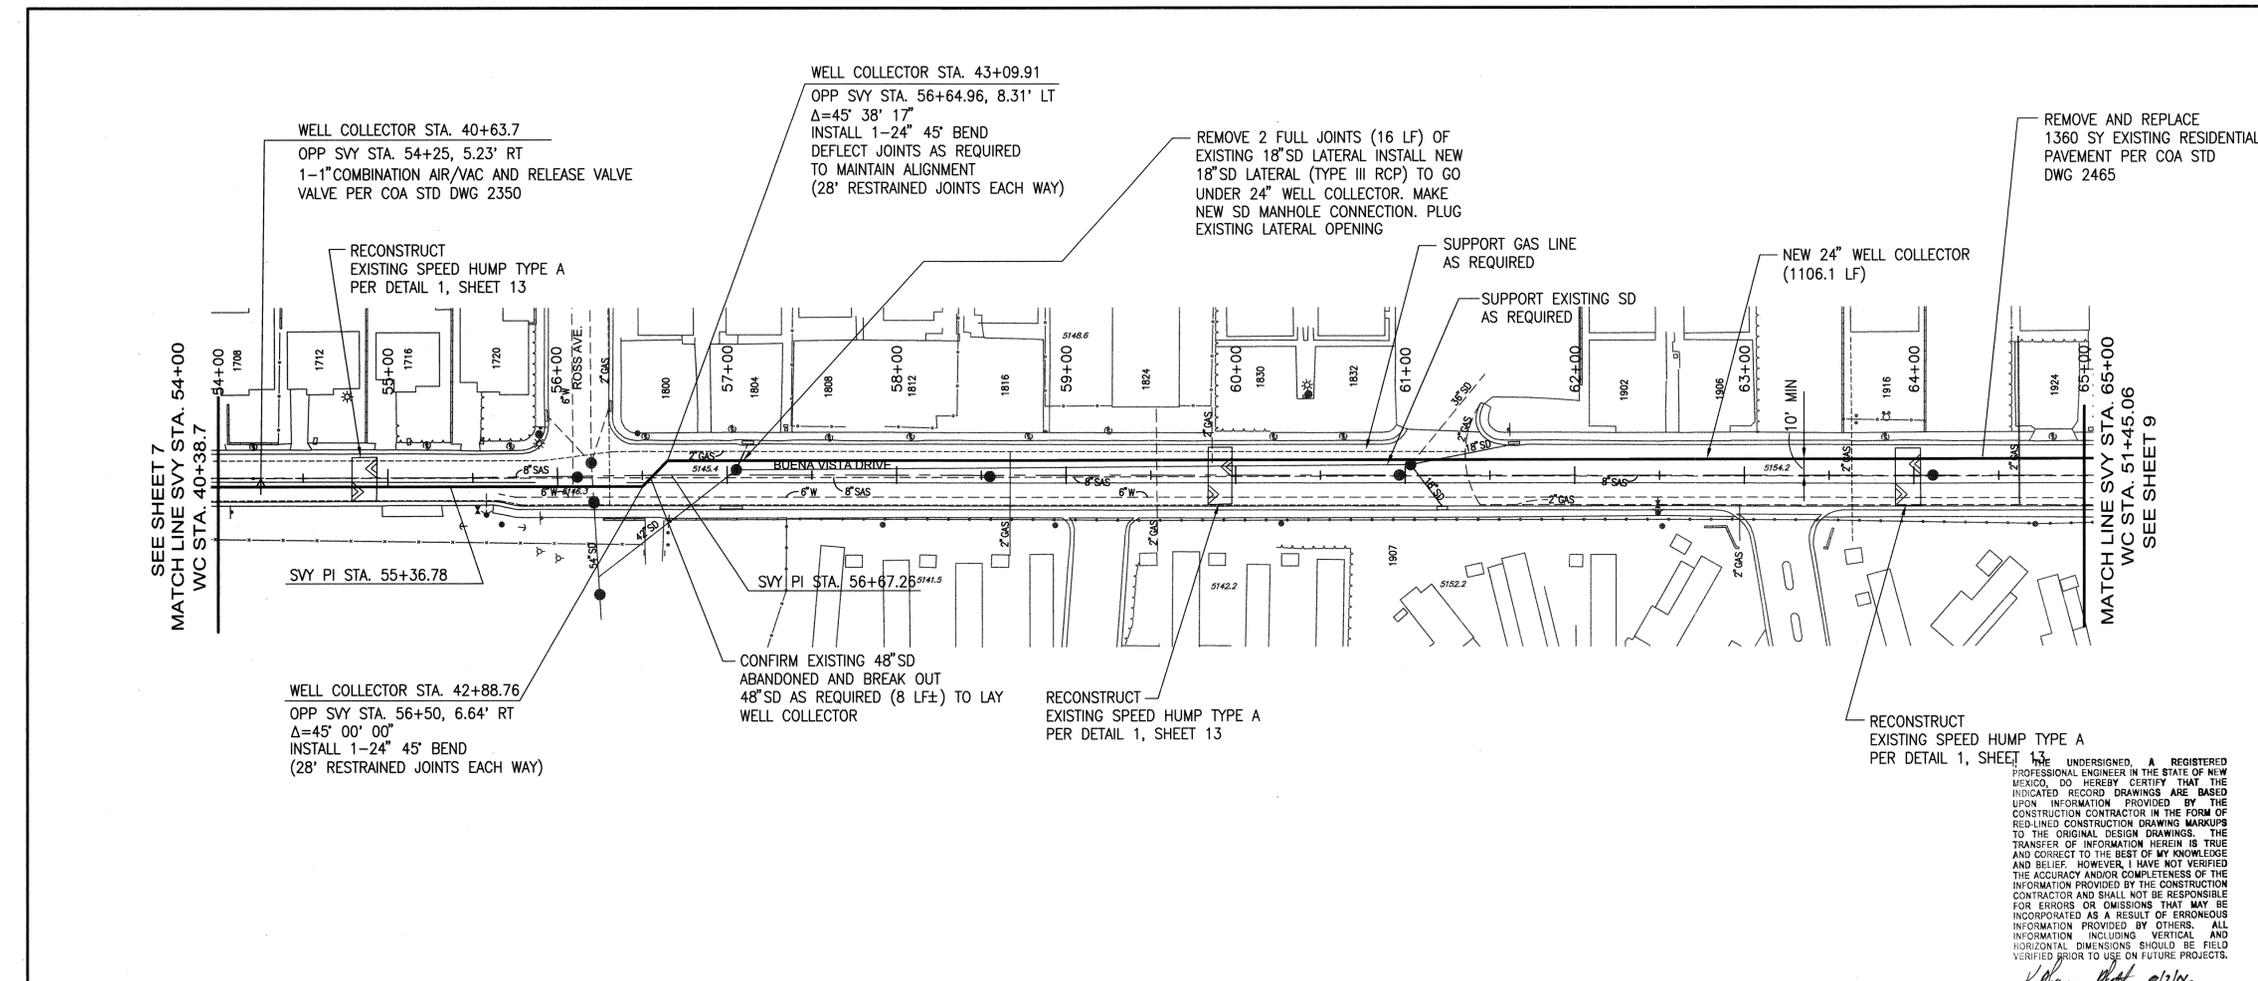


- NOTES:**
1. PROFILE CENTERLINE IS CENTERLINE OF SURVEY, NOT CENTERLINE OF STREET OR WELL COLLECTOR.
  2. RESTRAINED JOINT LENGTHS ARE FOR PVC. IF CONCRETE CYLINDER PIPE OR DUCTILE IRON PIPE IS USED, THRUST RESTRAINT SHALL BE PER SPECIFICATION SECTION 801.13 OR SPECIFICATION SECTION 801.12 RESPECTIVELY.
  3. FOR SURVEY HORIZONTAL ALIGNMENT DATA SEE SHEET 3.
  4. PROFILE STATIONING IS CENTERLINE OF SURVEY NOT CENTERLINE OF WELL COLLECTOR.
  5. DEFLECTIONS SHOWN ARE FOR WELL COLLECTOR NOT SURVEY DEFLECTIONS.
  6. USE TRENCH BOX TO MINIMIZE TRENCH WIDTH AND PROTECT ADJACENT UTILITIES.
  7. GRADE SHOWN IS @ CENTERLINE OF SURVEY
  8. REPLACE ALL RESIDENTIAL GALVANIZED STEEL AND POLYETHYLENE SERVICE LINES FROM DISTRIBUTION LINE. ANY OTHER TYPE OF SERVICE LINE, VERIFY REPLACEMENT WITH ENGINEER. METER YOKE/COPPERSETTER REPLACEMENT TO BE FIELD VERIFIED. METER BOX REPLACEMENT AND RELOCATION SHALL ONLY OCCUR WITH SERVICE LINE REPLACEMENT AND SHALL BE PER C.O.A. STD. DWG. 2362 PER THE FOLLOWING SCHEDULE:

HOUSE NO.	LOCATION	METER SIZE	REPLACE BOX	RELOCATE BOX
1708	F6	3/4"	X	
1712	F6	3/4"	X	
1716	F7	3/4"	X	
1717	VERIFY	VERIFY	VERIFY	VERIFY
1720	F7	3/4"	X	
1721	F5	2"	VERIFY	VERIFY
1800	F4	3/4"	X	
1804	F3	3/4"	X	X
1808	F4	1-1/4"		
1812	F3	1"	X	
1816	F8	3/4"		
1830	F5	1"	X	
1832	F5	1"	VERIFY	
1902	F9	1"	X	
1906	F1	3/4"	X	
1907	F6	2"		
1916	F5	3/4"	X	
1924	F5	3/4"		

I, THE UNDERSIGNED, A REGISTERED PROFESSIONAL ENGINEER IN THE STATE OF NEW MEXICO, DO HEREBY CERTIFY THAT THE INDICATED RECORD DRAWINGS ARE BASED UPON INFORMATION PROVIDED BY THE CONSTRUCTION CONTRACTOR IN THE FORM OF RED-LINED CONSTRUCTION DRAWING MARKUPS TO THE ORIGINAL DESIGN DRAWINGS. THE TRANSFER OF INFORMATION HEREIN IS TRUE AND CORRECT TO THE BEST OF MY KNOWLEDGE AND BELIEF. HOWEVER, I HAVE NOT VERIFIED THE ACCURACY AND/OR COMPLETENESS OF THE INFORMATION PROVIDED BY THE CONSTRUCTION CONTRACTOR AND SHALL NOT BE RESPONSIBLE FOR ERRORS OR OMISSIONS THAT MAY BE INCORPORATED AS A RESULT OF ERRONEOUS INFORMATION PROVIDED BY OTHERS. ALL INFORMATION INCLUDING VERTICAL AND HORIZONTAL DIMENSIONS SHOULD BE FIELD VERIFIED PRIOR TO USE ON FUTURE PROJECTS.

*Shayna Pugh 2/2/06*

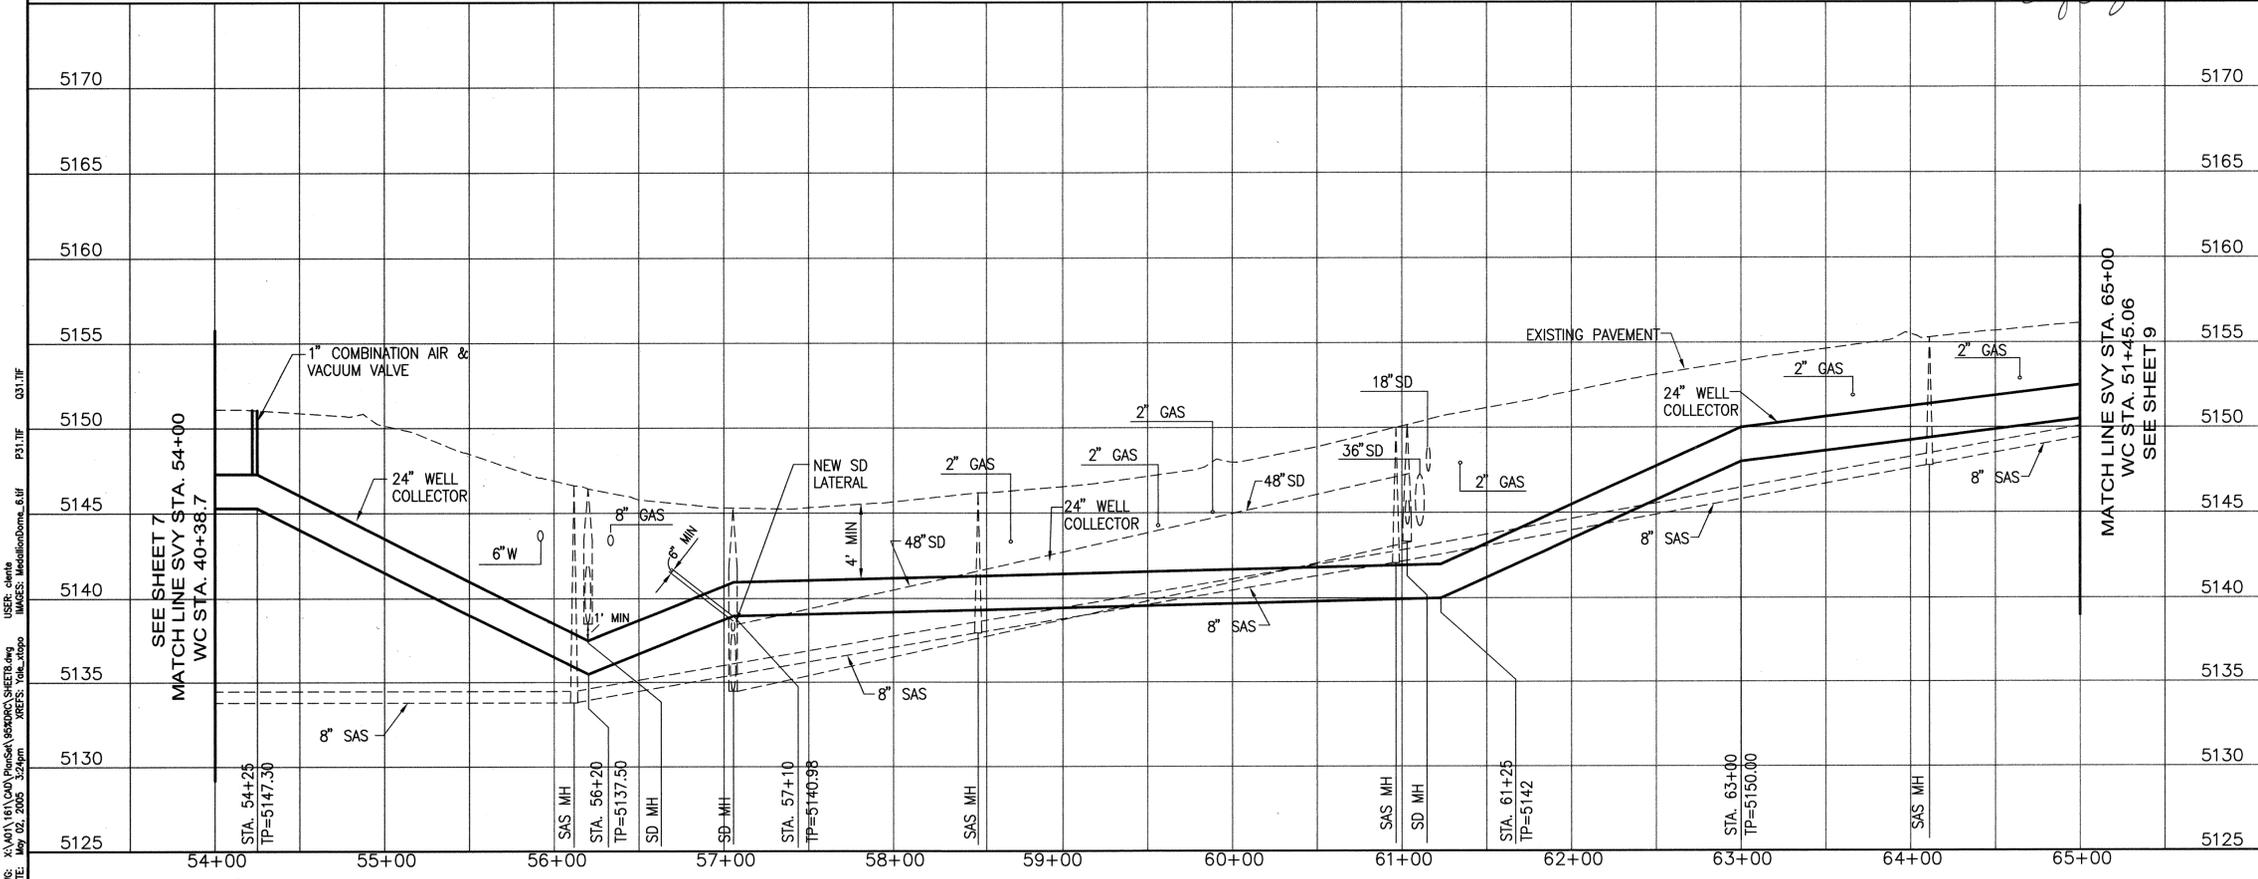

**BOYLE ENGINEERING CORPORATION**  
 consulting engineers  
 6501 Americas Parkway N.E. Suite 800  
 Albuquerque, NM 87110 (505) 883-7700

**CITY OF ALBUQUERQUE**  
 WATER UTILITY DEPARTMENT

**TITLE: YALE WELL COLLECTOR REALIGNMENT  
 BUENA VISTA DRIVE PLAN & PROFILE  
 STA. 54+00 TO 65+00**

Design Review Committee APPROVED  
 City Engineer Approval  
 MAY 24 2005  
 CITY ENGINEER

City Project No. **733991** Zone Map No. **L-15** Sheet **8** of **15**

DWG: AL-A01-161-02 (P) 03/11/05  
 DATE: May 22, 2005 3:25pm  
 USER: cshelton  
 PLOT: 03/11/05  
 PLOT: 03/11/05  
 PLOT: 03/11/05

**AS-BUILT INFORMATION**  
 CONTRACTOR: NIM UNDERGROUND  
 INSPECTOR: TERRA LAND SURVEY  
 FIELD ENGINEER: COA, BILL MCCALL  
 VERIFY DATE: 12/11/04  
 CORRECTED BY: BEC  
 M/C/O: F L M INFORMATION  
 RECORDED BY: NO.  
 DATE:

**BENCH MARKS**  
 SEE SHEET 3

**SURVEY INFORMATION**  
 FIELD NOTES



**ENGINEERS SEAL**

DESIGNED BY: PJC DATE: 1/04  
 DRAWN BY: WBH DATE: 1/04  
 CHECKED BY: KWN DATE: 1/04


REVISIONS  
 NO. DATE BY

REMARKS  
 DESIGN



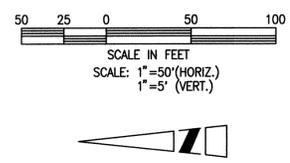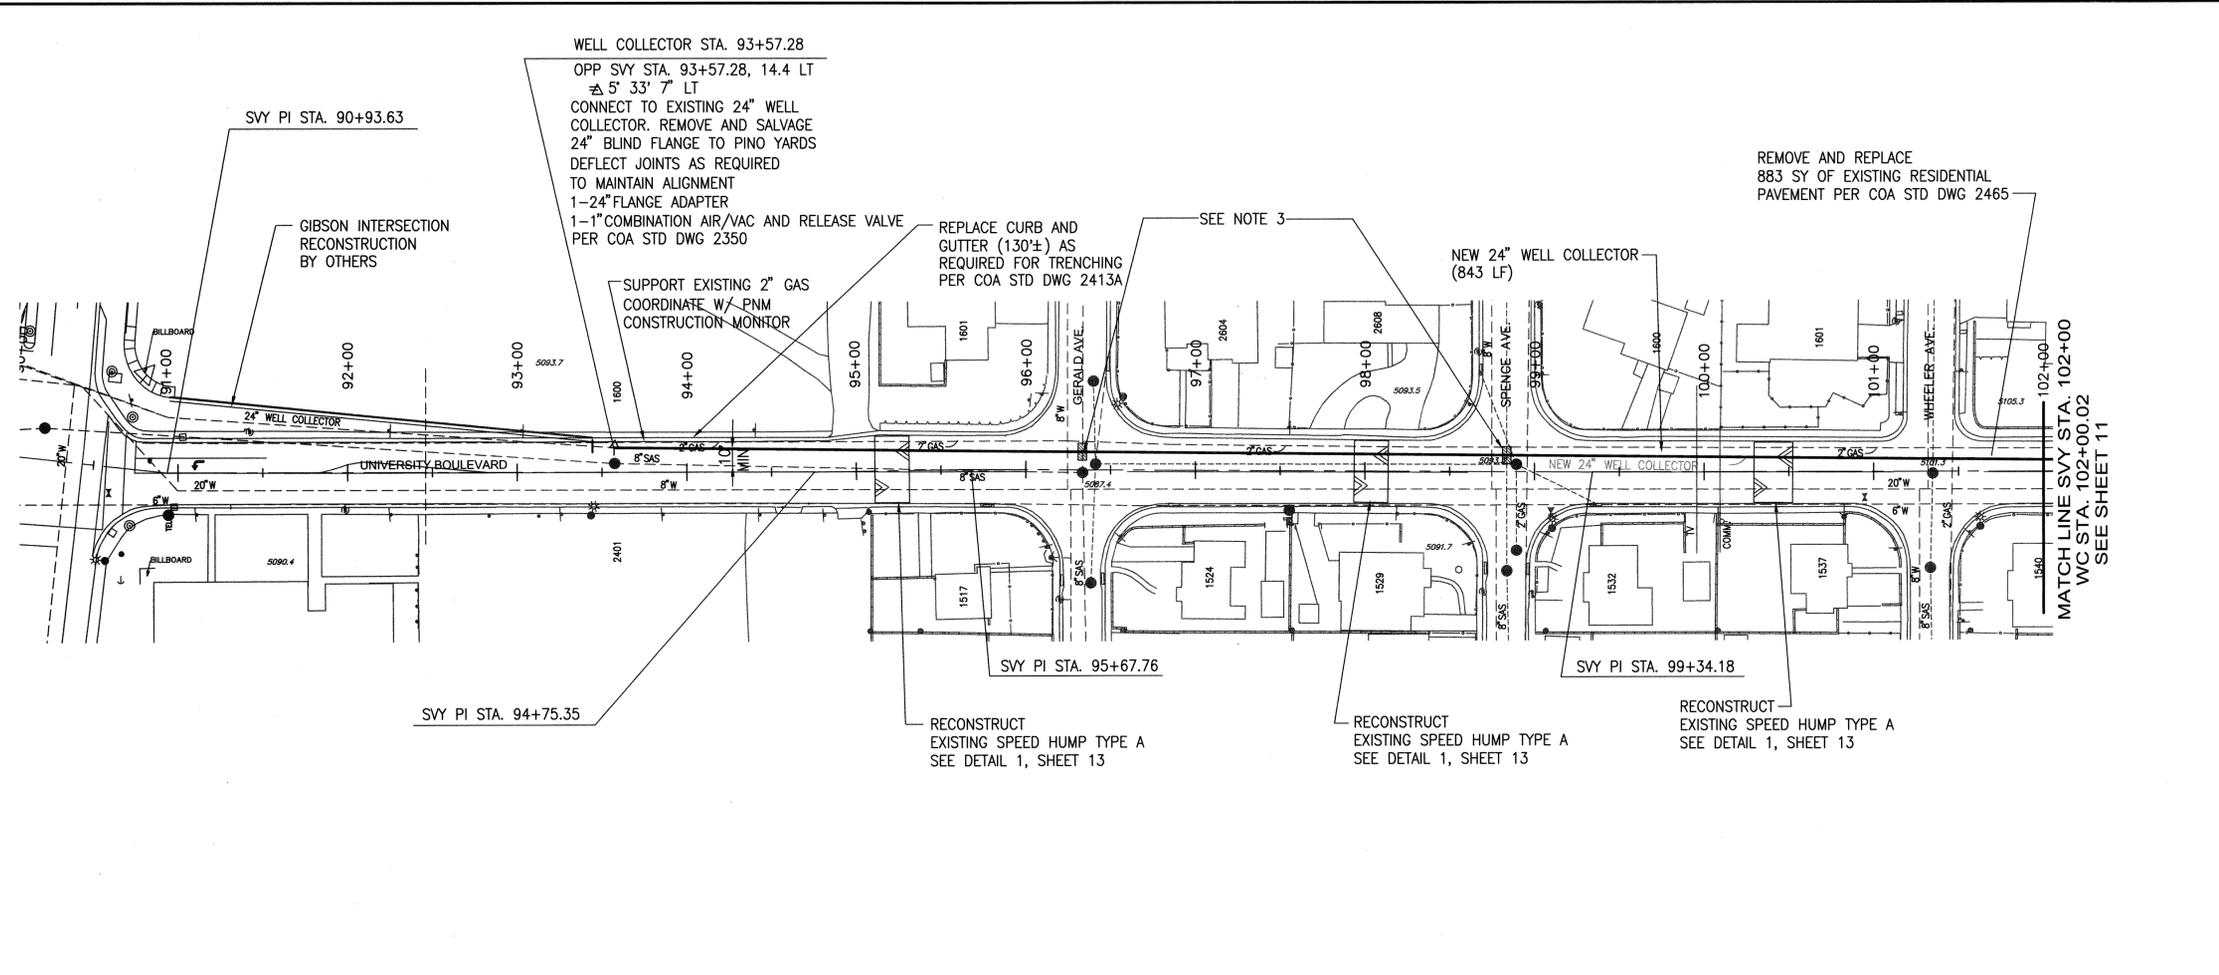

- NOTES:**
1. PROFILE CENTERLINE IS CENTERLINE OF SURVEY, NOT CENTERLINE OF STREET OR WELL COLLECTOR.
  2. RESTRAINED JOINT LENGTHS ARE FOR PVC. IF CONCRETE CYLINDER PIPE OR DUCTILE IRON PIPE IS USED, THRUST RESTRAINT SHALL BE PER SPECIFICATION SECTION 801.13 OR SPECIFICATION SECTION 801.12 RESPECTIVELY.
  3. ENCASE EXISTING 8" SAS PER C.O.A. STD. DWG. 2140 OR REPLACE EXISTING SAS WITH PRESSURE RATED PVC SEWER PIPE.
  4. FOR SURVEY HORIZONTAL ALIGNMENT DATA SEE SHEET 3.
  5. PROFILE STATIONING IS CENTERLINE OF SURVEY NOT CENTERLINE OF WELL COLLECTOR.
  6. DEFLECTIONS SHOWN ARE FOR WELL COLLECTOR NOT SURVEY DEFLECTIONS.
  7. USE TRENCH BOX TO MINIMIZE TRENCH WIDTH AND PROTECT ADJACENT UTILITIES.
  8. GRADE SHOWN IS @ CENTERLINE OF SURVEY

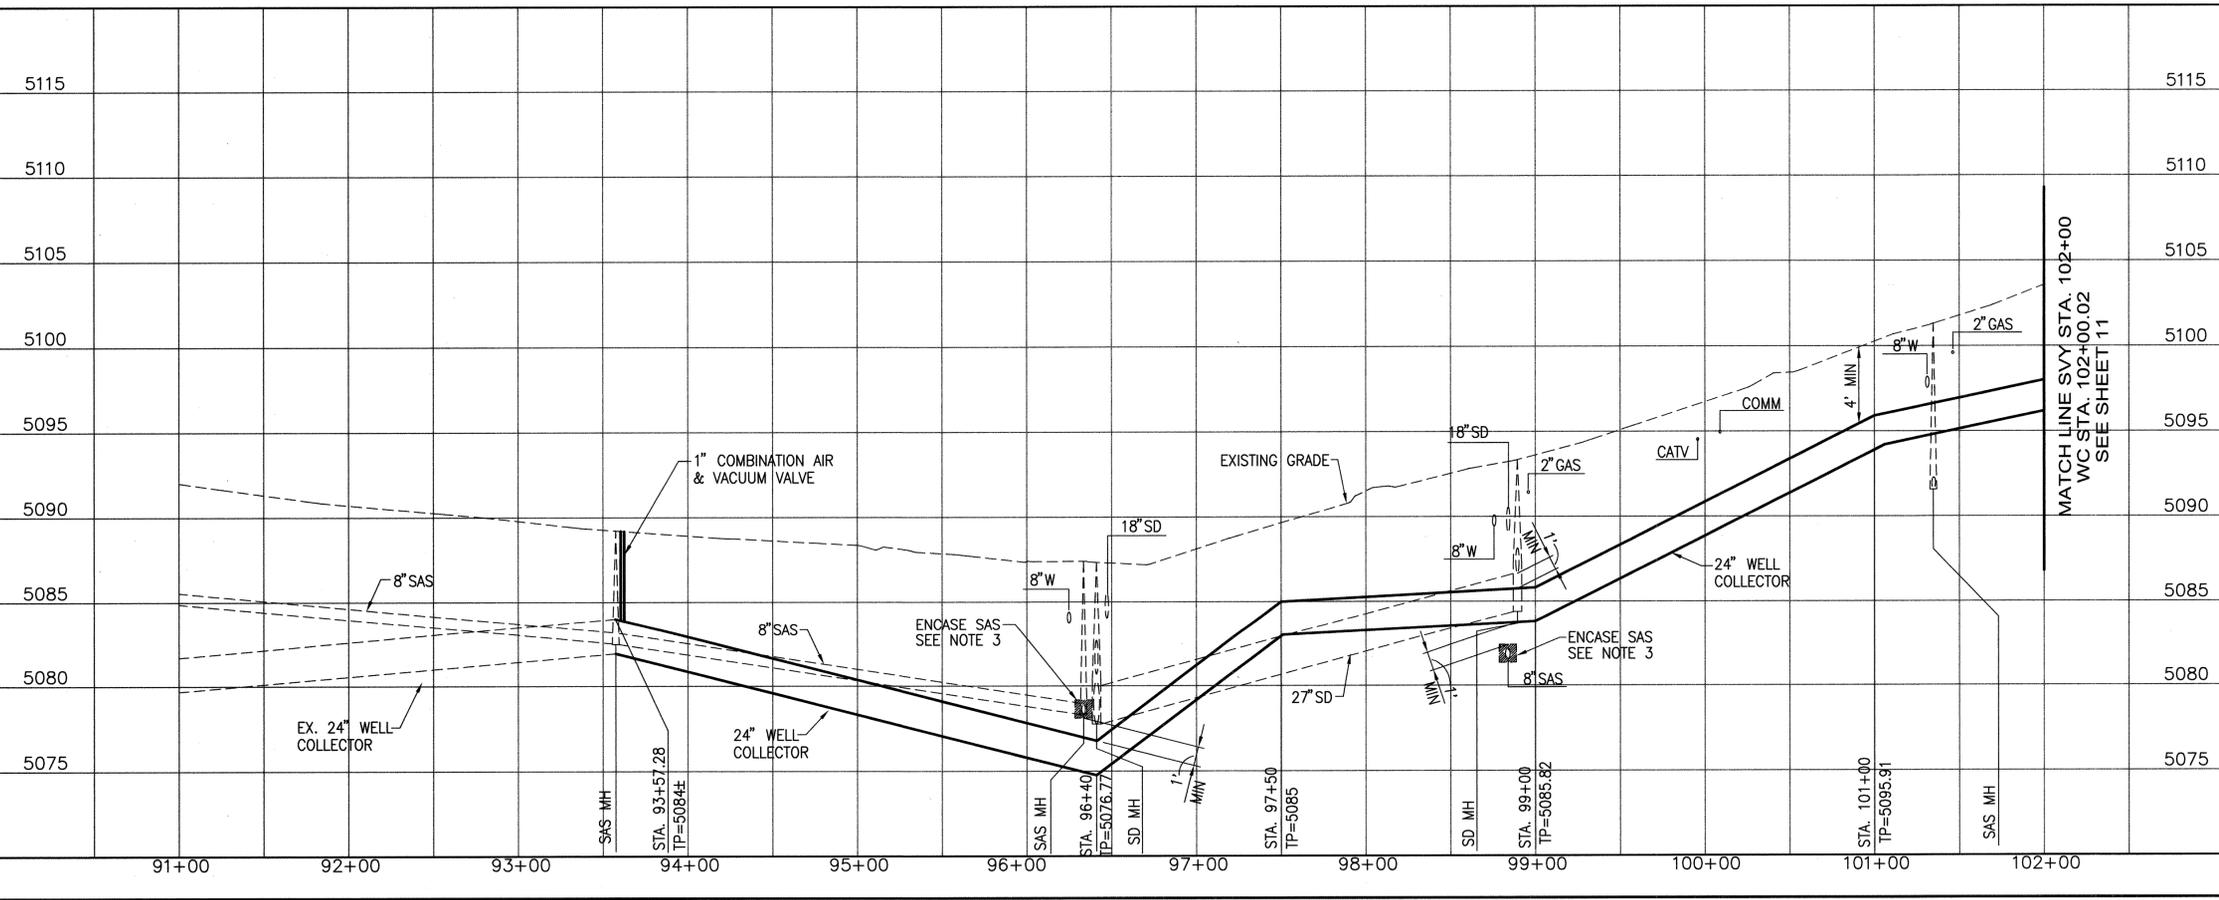

I, THE UNDERSIGNED, A REGISTERED PROFESSIONAL ENGINEER IN THE STATE OF NEW MEXICO, DO HEREBY CERTIFY THAT THE INDICATED RECORD DRAWINGS ARE BASED UPON INFORMATION PROVIDED BY THE CONSTRUCTION CONTRACTOR IN THE FORM OF RED-LINED CONSTRUCTION DRAWING MARKUPS TO THE ORIGINAL DESIGN DRAWINGS. THE TRANSFER OF INFORMATION HEREIN IS TRUE AND CORRECT TO THE BEST OF MY KNOWLEDGE AND BELIEF. HOWEVER, I HAVE NOT VERIFIED THE ACCURACY AND/OR COMPLETENESS OF THE INFORMATION PROVIDED BY THE CONSTRUCTION CONTRACTOR AND SHALL NOT BE RESPONSIBLE FOR ERRORS OR OMISSIONS THAT MAY BE INCORPORATED AS A RESULT OF ERRONEOUS INFORMATION PROVIDED BY OTHERS. ALL INFORMATION INCLUDING VERTICAL AND HORIZONTAL DIMENSIONS SHOULD BE FIELD VERIFIED PRIOR TO USE ON FUTURE PROJECTS.

*Shayna Hest* 5/2/06

**BOYLE ENGINEERING CORPORATION**  
consulting engineers  
6501 Americas Parkway N.E. Suite 800  
Albuquerque, NM 87110 (505) 883-7700

**CITY OF ALBUQUERQUE**  
WATER UTILITY DEPARTMENT

**TITLE:**  
YALE COLLECTOR REALIGNMENT  
BUENA VISTA DRIVE PLAN & PROFILE  
STA. 90+94 TO 102+00



Design Review Committee APPROVED  
City Engineer APPROVED  
MAY 24 2005  
CITY ENGINEER

City Project No. **733991** Zone Map No. **M-15** Sheet **10** of **15**

AS BUILT INFORMATION		CONTRACTOR N.M. UNDERGROUND	DATE
BENCH MARKS		INSPECTOR'S STAMP BY TERA LAND SURVEY	DATE
SURVEY INFORMATION		FIELD NOTES	DATE
ENGINEERS SEAL		NO.	DATE
AS-BUILT		REMARKS	DATE
DESIGN		REVISIONS	DATE
DESIGNED BY PJC		DATE	1/04
DRAWN BY WBH		DATE	1/04
CHECKED BY KWW		DATE	1/04



DWG. NO. 15111 (REV. 05/04) PROJECT: 733991 SHEET: 10 OF 15  
 DATE: 05/24/05 08:30 AM  
 USER: cshane  
 PLOT: 05/24/05 08:30 AM  
 PLOT: 05/24/05 08:30 AM



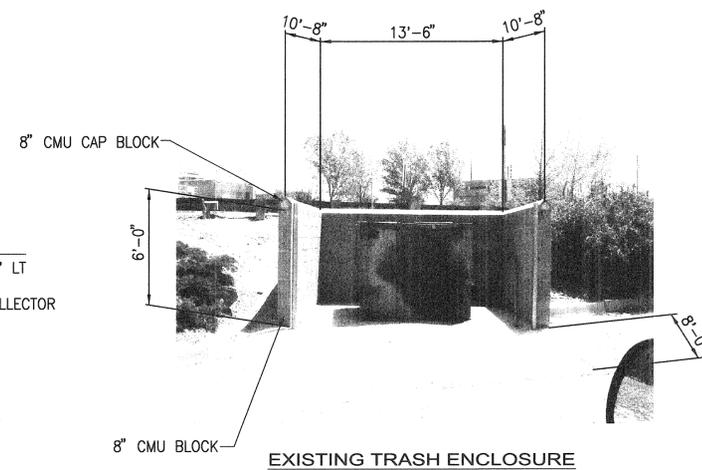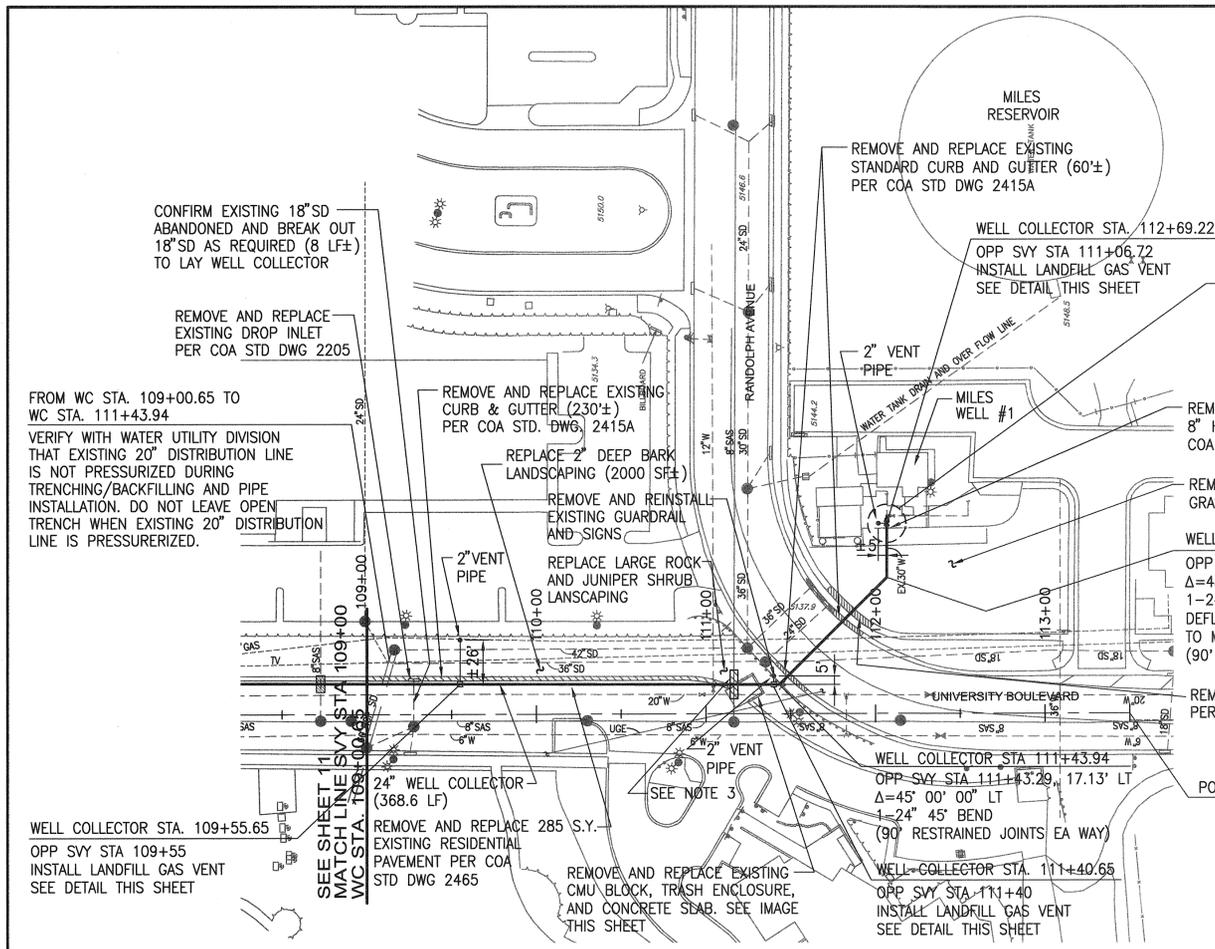

The subject property is located near a former landfill. Due to the subject property being near a former landfill, certain precautionary measures may need to be taken to ensure the health and safety of the public. Recommendations made by a professional engineer with expertise in landfills and landfill gas issues (as required by the most current version of the Interim Guidelines for Development within City Designated Landfill Buffer Zones) shall be consulted prior to development of the site.

- NOTES:**
1. PROFILE CENTERLINE IS CENTERLINE OF SURVEY, NOT CENTERLINE OF STREET OR WELL COLLECTOR.
  2. RESTRAINED JOINT LENGTHS ARE FOR PVC. IF CONCRETE CYLINDER PIPE OR DUCTILE IRON PIPE IS USED, THRUST RESTRAINT SHALL BE PER SPECIFICATION SECTION 801.13 OR SPECIFICATION SECTION 801.12 RESPECTIVELY.
  3. ENCASE EXISTING 8" SAS PER C.O.A. STD. DWG. 2140 OR REPLACE EXISTING SAS WITH PRESSURE RATED PVC SEWER PIPE.
  4. FOR SURVEY HORIZONTAL ALIGNMENT DATA SEE SHEET 3.
  5. PROFILE STATIONING IS CENTERLINE OF SURVEY NOT CENTERLINE OF WELL COLLECTOR.
  6. DEFLECTIONS SHOWN ARE FOR WELL COLLECTOR NOT SURVEY DEFLECTIONS.
  7. USE TRENCH BOX TO MINIMIZE TRENCH WIDTH AND PROTECT ADJACENT UTILITIES.
  8. GRADE SHOWN IS @ CENTERLINE OF SURVEY

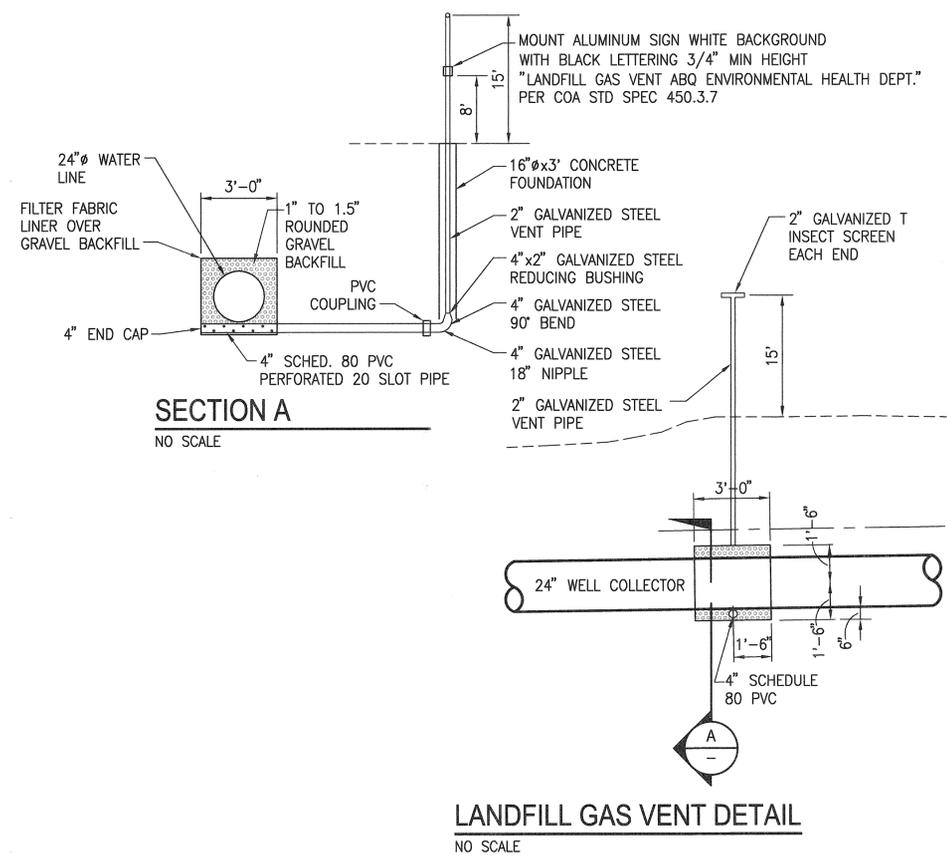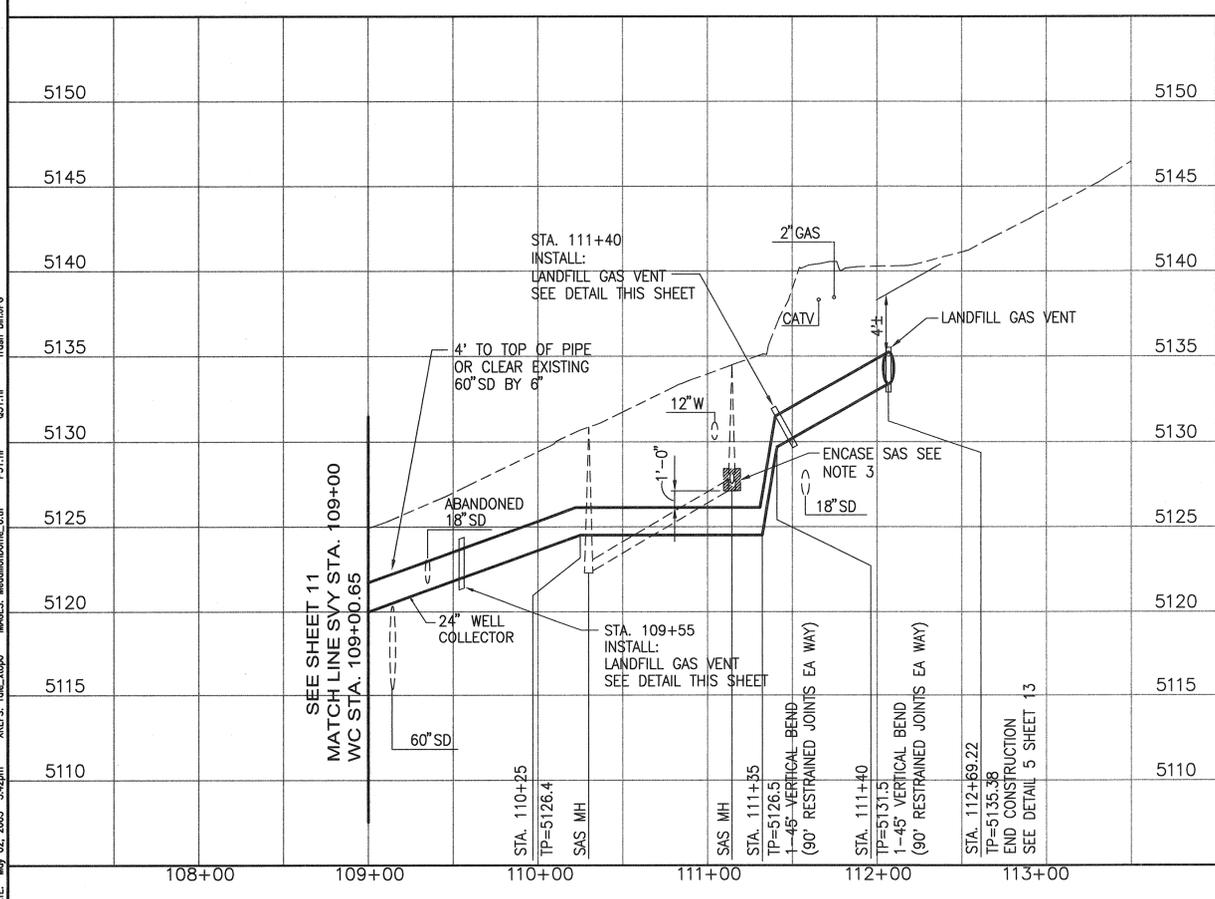

I, THE UNDERSIGNED, A REGISTERED PROFESSIONAL ENGINEER IN THE STATE OF NEW MEXICO, DO HEREBY CERTIFY THAT THE INDICATED RECORD DRAWINGS ARE BASED UPON INFORMATION PROVIDED BY THE CONSTRUCTION CONTRACTOR IN THE FORM OF RED-LINED CONSTRUCTION DRAWING MARKUPS TO THE ORIGINAL DESIGN DRAWINGS. THE TRANSFER OF INFORMATION HEREIN IS TRUE AND CORRECT TO THE BEST OF MY KNOWLEDGE AND BELIEF. HOWEVER, I HAVE NOT VERIFIED THE ACCURACY AND/OR COMPLETENESS OF THE INFORMATION PROVIDED BY THE CONSTRUCTION CONTRACTOR AND SHALL NOT BE RESPONSIBLE FOR ERRORS OR OMISSIONS THAT MAY BE INCORPORATED AS A RESULT OF ERRONEOUS INFORMATION PROVIDED BY OTHERS. ALL INFORMATION INCLUDING VERTICAL AND HORIZONTAL DIMENSIONS SHOULD BE FIELD VERIFIED PRIOR TO USE ON FUTURE PROJECTS.

*Shayne Kelly 5/2/06*

**SOYLE ENGINEERING CORPORATION**  
consulting engineers  
6501 Americas Parkway N.E. Suite 800  
Albuquerque, NM 87110 (505) 883-7700

**CITY OF ALBUQUERQUE**  
WATER UTILITY DEPARTMENT

**TITLE:**  
YALE COLLECTOR REALIGNMENT  
BUENA VISTA DRIVE PLAN & PROFILE  
STA. 102+00 TO 109+00

Design Review Committee: *[Signature]*  
City Engineer Approval: *[Signature]*  
MAY 24 2005  
CITY ENGINEER

City Project No. **733991** Zone Map No. **M-15** Sheet **12** of **15**

AS BUILT INFORMATION		CONTRACTOR NOT UNDERGROUND										
DRAWN BY: TERRY LAND SURVEY		INSPECTOR'S: C.O.A. BILL MCCALL										
FIELD CHECKED BY: BILL MCCALL		CORRECTED BY: BEC										
MICROFILM INFORMATION		RECORDED BY: NO.										
DATE		DATE										
NO.		NO.										
SURVEY INFORMATION		FIELD NOTES										
DATE		DATE										
NO.		NO.										
ENGINEERS SEAL		REVISIONS										
		<table border="1"> <tr> <th>NO.</th> <th>DATE</th> <th>REMARKS</th> </tr> <tr> <td> </td> <td> </td> <td> </td> </tr> <tr> <td> </td> <td> </td> <td> </td> </tr> </table>		NO.	DATE	REMARKS						
NO.	DATE	REMARKS										
DESIGNED BY: PJC		DATE: 1/04										
DRAWN BY: WBH		DATE: 1/04										
CHECKED BY: KWH		DATE: 1/04										

DWG: AL-A01-161-CAD\Projects\66000\DWG\SH12.dwg  
 USER: celine  
 DATE: May 22, 2005 3:42pm  
 PLOT: P31.TIF  
 Q31.TIF  
 Trash Bar.PS




# RESTRAINED JOINTS FOR PVC WATER LINES

## 1. HORIZONTAL BEND


BEND ANGLE	PIPE SIZE				
	8"	10"	12"	16"	24"
90°	26'	31'	36'	49'	67'
45°	11'	13'	15'	21'	28'
22 1/2°	5'	6'	7'	10'	14'
11 1/4°	3'	3'	4'	5'	7'

Lr = LENGTH OF PIPE TO BE RESTRAINED

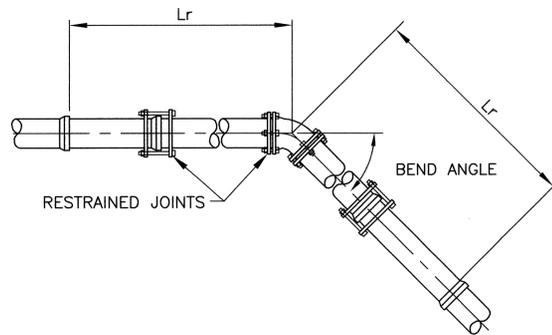

## 4. REDUCER

SMALL END	Lr			
	12"	16"	20"	24"
8"	81'			
10"	36'			
12"		66'	117'	160'
14"		35'	93'	141'
16"			66'	118'

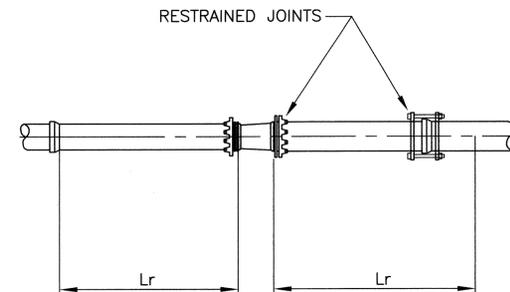


## 2. VERTICAL OFFSET (45°)

	PIPE SIZE				
	8"	10"	12"	16"	24"
Lhs	30'	36'	42'	64'	90'
Lls	8'	10'	12'	21'	28'

Lhs = LENGTH OF PIPE TO BE RESTRAINED ON VERTICAL DOWN BENDS

Lls = LENGTH OF PIPE TO BE RESTRAINED ON VERTICAL UP BENDS

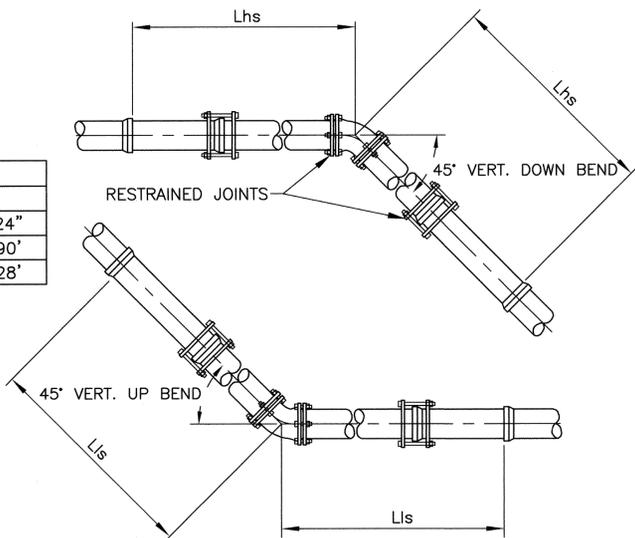


## 5. IN-LINE VALVES & DEAD ENDS

Lr	PIPE SIZE				
	10"	12"	14"	16"	24"
Lr	86'	102'	138'	154'	218'

NOTE: VALVES SHALL BE RESTRAINED ON BOTH SIDES.

Lr = LENGTH OF PIPE TO BE RESTRAINED

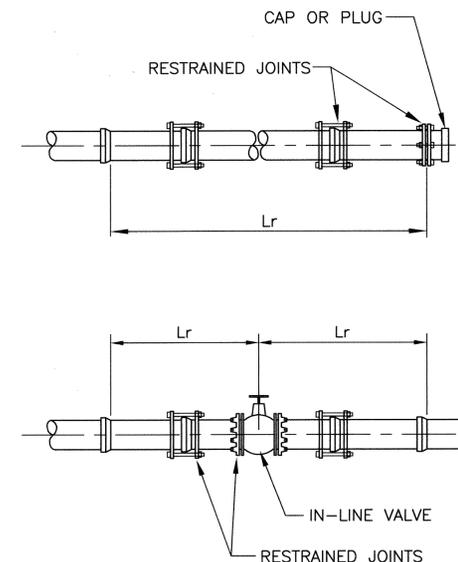


## 3. TEE

BRANCH SIZE	Lbr (Lrn=0.5') / Lbr (Lrn=10')				
	8"	10"	12"	16"	24"
10"		84'/33'	83'/21'		
12"			99'/47'	145'/60'	212'/157'
14"				143'/42'	210'/146'
16"				140'/24'	209'/133'
24"					204'/82'

NOTE: IF Lrn > 20', THEN ALL TEE SIZES NEED TO BE RESTRAINED AT THE FITTING ONLY (FO).

Lrn = SHORTEST LENGTH OF PIPE RESTRAINED ON EITHER SIDE OF THE TEE

Lbr = LENGTH OF PIPE TO BE RESTRAINED ON THE BRANCH

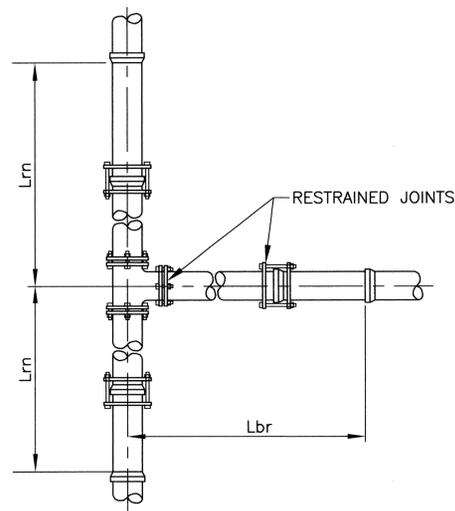

## WATER METER LOCATION DIAGRAM

FIRST DIGIT: TELLS YOU THE GENERAL LOCATION OF THE METER AS YOU FACE THE HOUSE FROM THE STREET.


F (FRONT), B (BACK OR ALLEY),  
L (LEFT SIDE OF PROPERTY),  
R (RIGHT SIDE OF PROPERTY)

SECOND DIGIT: TELLS YOU THE SPECIFIC LOCATION OF THE METER.

CODE 1 THRU 9, REFER TO DIAGRAM A  
D REFERS TO A SHARED METER BOX

THIRD DIGIT: TELLS YOU WHICH METER YOU ARE LOOKING FOR IF THERE IS MORE THAN ONE:

E - EAST W - WEST N - NORTH  
S - SOUTH M - MIDDLE METER

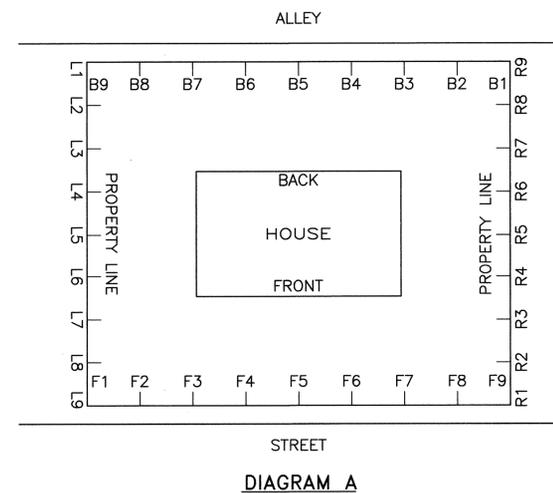

## NOTES:

- ALL JOINTS AND FITTINGS WITHIN THE SPECIFIED RESTRAINED LENGTH, MUST BE RESTRAINED.
- ALL LENGTHS ARE IN FEET.
- ALL RESTRAINED JOINT LENGTHS ARE BASED ON THE CONDITIONS NOTED UNDER "BASIS OF DESIGN". ANY CHANGES TO THESE CONDITIONS MUST BE NOTED AND LENGTHS RECALCULATED AND SUBMITTED TO THE ENGINEER FOR APPROVAL PRIOR TO INSTALLATION.
- THE CONTRACTOR SHALL NOTE THE LOCATION, TYPE AND EXTENT OF ALL RESTRAINED JOINTS INSTALLED ON THIS PROJECT AS PART OF THE RECORD DRAWINGS.
- THE CONTRACTOR SHALL SUBMIT THRUST RESTRAINT DESIGN FOR PIPE THAT IS NOT THE SIZE OR MATERIAL TYPE SHOWN IN THESE DETAILS.

I, THE UNDERSIGNED, A REGISTERED PROFESSIONAL ENGINEER IN THE STATE OF NEW MEXICO, DO HEREBY CERTIFY THAT THE INDICATED RESTRAINED LENGTHS ARE BASED UPON INFORMATION PROVIDED BY THE CONSTRUCTION CONTRACTOR IN THE FORM OF RED-LINED CONSTRUCTION DRAWINGS. THE TRANSFER OF INFORMATION HEREIN IS TRUE AND CORRECT TO THE BEST OF MY KNOWLEDGE AND BELIEF. HOWEVER, I HAVE NOT VERIFIED THE ACCURACY AND/OR COMPLETENESS OF THE INFORMATION PROVIDED BY THE CONSTRUCTION CONTRACTOR AND SHALL NOT BE RESPONSIBLE FOR ERRORS OR OMISSIONS THAT MAY BE INCORPORATED AS A RESULT OF ERRONEOUS INFORMATION PROVIDED BY OTHERS. ALL INFORMATION INCLUDING VERTICAL AND HORIZONTAL DIMENSIONS SHOULD BE FIELD VERIFIED PRIOR TO USE ON FUTURE PROJECTS.

*Shayna Kelly 5/12/06*

## BASIS OF DESIGN

- PIPE MATERIAL = PVC
- TEST PRESSURE = 150 PSI
- SOIL TYPE = "SM" (ASTM STANDARD D24870)
- TRENCH TYPE & BEDDING = TYPE 4, (ANSI/AWWA C150/A21.50)
- PIPE COVER = 3' MINIMUM
- FACTOR OF SAFETY = 1.5


**BOYLE ENGINEERING CORPORATION**  
consulting engineers  
6501 Americas Parkway N.E. Suite 800  
Albuquerque, NM 87110 (505) 883-7700

**CITY OF ALBUQUERQUE**  
WATER UTILITY DEPARTMENT


TITLE: **YALE COLLECTOR REALIGNMENT RESTRAINED JOINT DETAILS WATER METER LOCATION DIAGRAM**

Design Review Committee	City Engineer Approval	Mo./Day/Yr.	Mo./Day/Yr.
APPROVED	APPROVED		
REVIEW COMMITTEE	CITY ENGINEER		
	MAY 24 2005		

City Project No. **733991** Zone Map No. **N/A** Sheet **14** of **15**

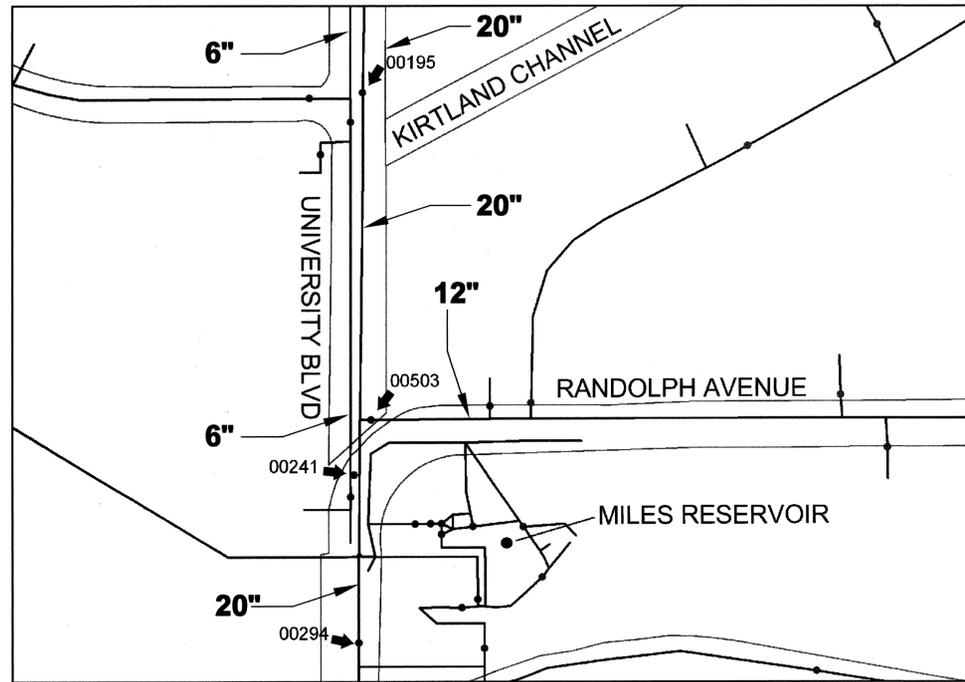

**UNIVERSITY BLVD. AND RANDOLPH AVENUE  
SEE SHEET 12  
ZONE ATLAS M-15**

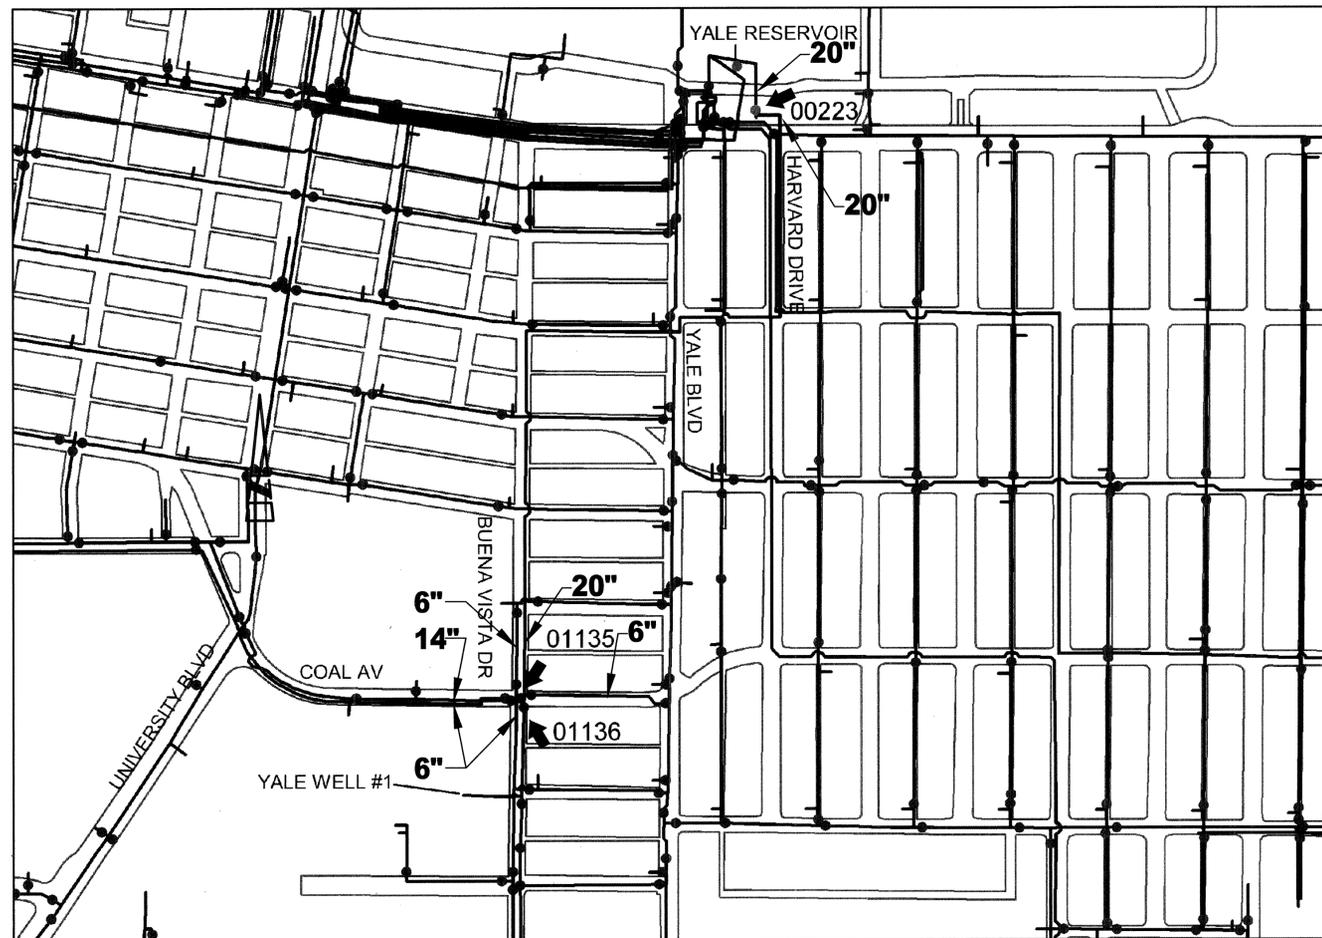

**COAL AVENUE AND BUENA VISTA DRIVE  
SEE SHEETS 4 AND 13  
ZONE ATLAS K-15 AND K-16**

1. THE CONTRACTOR SHALL BE RESPONSIBLE FOR TIMING AND COORDINATION OF WATER SHUTOFF. AT LEAST (7) WORKING DAYS PRIOR TO CONSTRUCTION, CONTRACTOR SHALL CONTACT THE WATER SYSTEMS DIVISION, 857-8200, TO INITIATE IMPLEMENTATION OF THE NON-PRESSURIZED CONNECTION PLAN.

I, THE UNDERSIGNED, A REGISTERED PROFESSIONAL ENGINEER IN THE STATE OF NEW MEXICO, DO HEREBY CERTIFY THAT THE INDICATED RECORD DRAWINGS ARE BASED UPON INFORMATION PROVIDED BY THE CONSTRUCTION CONTRACTOR IN THE FORM OF RED-LINED CONSTRUCTION MARKUPS TO THE ORIGINAL DESIGN DRAWINGS. THE TRANSFER OF INFORMATION HEREIN IS TRUE AND CORRECT TO THE BEST OF MY KNOWLEDGE AND BELIEF. HOWEVER, I HAVE NOT VERIFIED THE ACCURACY AND/OR COMPLETENESS OF THE INFORMATION PROVIDED BY THE CONSTRUCTION CONTRACTOR AND SHALL NOT BE RESPONSIBLE FOR ERRORS OR OMISSIONS THAT MAY BE INCORPORATED AS A RESULT OF ERRONEOUS INFORMATION PROVIDED BY OTHERS. ALL INFORMATION INCLUDING VERTICAL AND HORIZONTAL DIMENSIONS SHOULD BE FIELD CHECKED PRIOR TO USE ON FUTURE PROJECTS.

*Dr. Juan N. Ortiz* 8/2/04

**LEGEND**

↑ WATER VALVE TO BE SHUT OFF DURING INSTALLATION/CONNECTION OF NEW WATER LINE.

**SOYLE ENGINEERING CORPORATION**  
consulting engineers  
6501 Americas Parkway N.E. Suite 800  
Albuquerque, NM 87110 (505) 883-7700



**CITY OF ALBUQUERQUE  
WATER UTILITY DEPARTMENT**

**TITLE: YALE COLLECTOR REALIGNMENT  
WATER VALVE SHUT-OFF PLAN**

Design Review Committee  
**APPROVED**  
MAY 24 2005  
DESIGN REVIEW COMMITTEE

City Engineer Approval  
**APPROVED**  
MAY 24 2005  
CITY ENGINEER


Mo./Day/Yr.	Mo./Day/Yr.

City Project No. **733991** Zone Map No. **M-15** Sheet **15** of **15**

AS BUILT INFORMATION	
CONTRACTOR NAME	UNDERGROUND
STATED BY	TERESA LAND SURVEY
INSPECTOR'S NAME	C.O.A. BILL MCCALL
FIELD VERIFICATION BY	BILL MCCALL
CHECKED BY	PEC
MICRO-FILM INFORMATION	
RECORDED BY	NO.
DATE	

BENCH MARKS	
NO.	DATE

SURVEY INFORMATION	
NO.	DATE

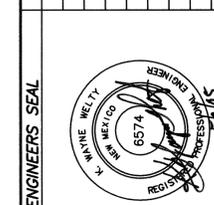

ENGINEERS SEAL

AS-BUILT	REMARKS	DATE	BY
REVISIONS		DATE	BY
DESIGNED BY	PJC	DATE	1/04
DRAWN BY	WBH	DATE	1/04
CHECKED BY	KWW	DATE	1/04

DWG: X:\A01\161\040\Projects\808080\SHEETS\4.dwg USER: dclate  
 DATE: May 22, 2005 4:23pm PLOT: X:\A01\161\040\Projects\808080\4.dwg