


CONSTRUCTION PLANS
FOR
OFFSITE PUBLIC INFRASTRUCTURE
UNSER CROSSING
ALBUQUERQUE, NEW MEXICO

INDEX

SHEET NUMBER	DESCRIPTION	SHEET NUMBER	DESCRIPTION
1	TITLE SHEET	14	TRAFFIC SIGNAL NOTES, EQUIPMENT REQUIREMENTS AND LEGEND
2	SURVEY CONTROL SHEET / OVERALL SITE PLAN	15	TRAFFIC SIGNAL ESTIMATED QUANTITIES AND INCIDENTAL ITEMS
2A-2G	PLAT	16	EXISTING UTILITY INFORMATION - FOUNDATION LOCATIONS
2H	GRADING PLAN - FOR INFORMATION ONLY	17	TRAFFIC SIGNAL PLAN - CENTRAL AVE / 86TH STREET
3	DEMOLITION PLAN	18	CONDUITS & CABLES - CENTRAL AVE / 86TH STREET
4	OVERALL PAVING PLAN	19	FUNCTIONS & DETECTORS - CENTRAL AVE / 86TH STREET
5	TYPICAL SECTIONS AND PAVING DETAILS	20	TRAFFIC SIGNAL PLAN - CENTRAL AVE / DRIVEWAY "B"
6	WHEEL CHAIR RAMP DETAILS	21	CONDUITS & CABLES - CENTRAL AVE / DRIVEWAY "B"
7 - 9	PAVING PLAN CENTRAL AVENUE (Base Bid)	22	FUNCTIONS & DETECTORS - CENTRAL AVE / DRIVEWAY "B"
	PAVING PLAN & PROFILE SHEETS	23	INTERSECTION LIGHTING PLANS
10 - 11	BRIDGE BLVD (Additive Alternate #2)	24	SIGNAL MODIFICATION PLAN - CENTRAL AVE / UNSER BLVD
11A	BRIDGE BLVD. STORM DRAIN (Additive Alternate #2)	25 - 26	INTERCONNECT PLAN - CENTRAL AVE
11B	STORM DRAIN DETAILS	27	SPLICE CABINET DETAILS
12	86TH STREET (Additive Alternate #1)	28	LIGHTING NOTES, QUANTITIES AND LEGEND
13	STRIPING & SIGNING PLAN	29	ROADWAY LIGHTING PLAN - CENTRAL AVE

NOTICE TO CONTRACTORS
CONTINUED

12. CONTRACTOR SHALL PROVIDE AND MAINTAIN ALL CONSTRUCTION SIGNAGE UNTIL PROJECT HAS BEEN ACCEPTED BY THE CITY OF ALBUQUERQUE.
13. DEVELOPER SHALL PROVIDE AND MAINTAIN ALL SIGNING AND STRIPING WITHIN PRIVATE STREETS / DEVELOPMENT.
14. ALL EXCAVATION, TRENCHING AND SHORING ACTIVITIES MUST BE CARRIED-OUT IN ACCORDANCE WITH OSHA 29 CFR 1926.650 SUBPART P
15. ALL UTILITIES THAT ARE LOCATED UNDER ANY ROADWAY OR FUTURE ROADWAY SHALL BE BACKFILLED TO 95% COMPACTION FOR THE ENTIRE DEPTH OF THE TRENCH. THIS INCLUDES ALL SANITARY SEWER LINES, WATER LINES, STORM DRAIN LINES, DRY UTILITY SLEEVES AND TRAFFIC SIGNAL / STREET LIGHT CONDUITS.

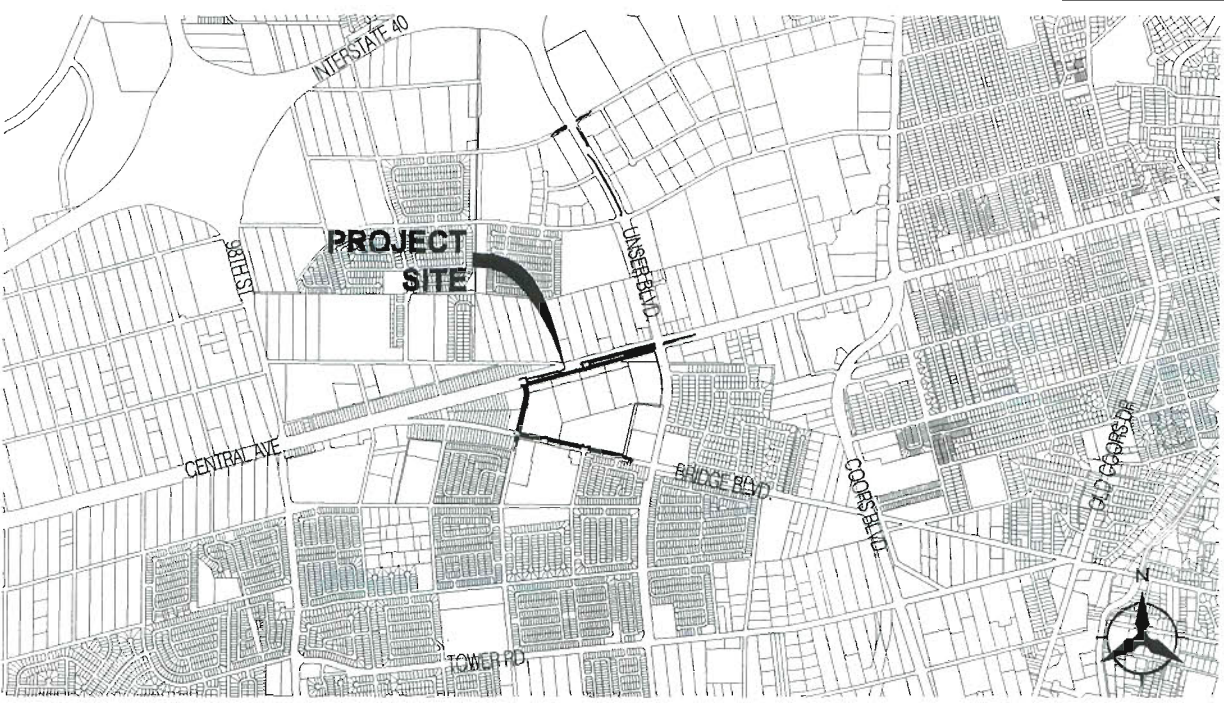

VICINITY MAP: NOT TO SCALE ZONE MAP NO. K-9 K-10

NOTICE TO CONTRACTORS

1. AN EXCAVATION/CONSTRUCTION PERMIT WILL BE REQUIRED BEFORE BEGINNING ANY WORK WITHIN THE CITY RIGHT-OF-WAY
2. ALL WORK DETAILED ON THESE PLANS TO BE PERFORMED UNDER CONTRACT SHALL, EXCEPT AS OTHERWISE STATED OR PROVIDED FOR HEREON, BE CONSTRUCTED IN ACCORDANCE WITH THE CITY OF ALBUQUERQUE STANDARD SPECIFICATIONS FOR PUBLIC WORKS CONSTRUCTION, 1986 EDITION AS REVISED THROUGH UPDATE NO. 7, INCLUDING AMENDMENT NO. 1.
3. TWO WORKING DAYS PRIOR TO ANY EXCAVATION, THE CONTRACTOR MUST CONTACT NEW MEXICO ONE CALL SYSTEM (260-1990) FOR LOCATION OF EXISTING UTILITIES.
4. PRIOR TO CONSTRUCTION, THE CONTRACTOR SHALL EXCAVATE AND VERIFY THE HORIZONTAL AND VERTICAL LOCATIONS OF ALL OBSTRUCTIONS. SHOULD A CONFLICT EXIST, THE CONTRACTOR SHALL NOTIFY THE ENGINEER OR SURVEYOR IMMEDIATELY SO THAT THE CONFLICT CAN BE RESOLVED WITH A MINIMUM AMOUNT OF DELAY.
5. SEVEN (7) WORKING DAYS PRIOR TO BEGINNING CONSTRUCTION, THE CONTRACTOR SHALL SUBMIT, TO THE CONSTRUCTION COORDINATION DIVISION, A DETAILED CONSTRUCTION SCHEDULE. TWO (2) WORKING DAYS PRIOR TO CONSTRUCTION, THE CONTRACTOR SHALL OBTAIN A BARRICADING PERMIT FROM THE CONST. COORDINATION DIVISION. CONTRACTOR SHALL NOTIFY CONSTRUCTION COORDINATION ENGINEER (924-3400) PRIOR TO OCCUPYING AN INTERSECTION. REFER TO SECTION 19 OF THE GENERAL CONDITIONS OF THE STANDARD SPECIFICATIONS.
6. ALL WORK EFFECTING ARTERIAL ROADWAYS REQUIRES TWENTY-FOUR HOUR CONSTRUCTION.
7. ALL STREET STRIPING ALTERED OR DESTROYED SHALL BE REPLACED W/ PLASTIC REFLECTORIZED PAVEMENT MARKING BY CONTRACTOR TO THE SAME LOCATION AS EXISTING, OR AS INDICATED BY THIS PLAN SET.
8. CONTRACTOR SHALL NOTIFY THE ENGINEER NOT LESS THAN SEVEN (7) DAYS PRIOR TO STARTING WORK IN ORDER THAT THE CITY SURVEYOR MAY TAKE NECESSARY MEASURES TO INSURE THE PRESERVATION OF SURVEY MONUMENTS. CONTRACTOR SHALL NOT DISTURB PERMANENT SURVEY MONUMENTS WITHOUT THE CONSENT OF THE CITY SURVEYOR AND SHALL NOTIFY THE CITY SURVEYOR AND BEAR THE EXPENSE OF REPLACING ANY THAT MAY BE DISTURBED WITHOUT PERMISSION. REPLACEMENT SHALL BE DONE ONLY BY THE CITY SURVEYOR. WHEN A CHANGE IS MADE IN THE FINISHED ELEVATIONS OF THE PAVEMENT OF ANY ROADWAY IN WHICH A PERMANENT SURVEY MONUMENT IS LOCATED, CONTRACTOR SHALL, AT HIS OWN EXPENSE, ADJUST THE MONUMENT COVER TO THE NEW GRADE UNLESS OTHERWISE SPECIFIED. REFER TO SECTION 4.4 OF THE GENERAL CONDITIONS OF THE STANDARD SPECIFICATIONS.
9. CONTRACTOR SHALL RECORD DATA ON ALL UTILITY LINES AND ACCESSORIES AS REQUIRED BY THE CITY OF ALBUQUERQUE FOR THE PREPARATION OF "AS CONSTRUCTED" DRAWINGS. CONTRACTOR SHALL NOT COVER UTILITY LINES AND ACCESSORIES UNTIL ALL DATA HAS BEEN RECORDED.
10. CONTRACTOR SHALL MAINTAIN A GRAFFITI-FREE WORK SITE. CONTRACTOR SHALL PROMPTLY REMOVE ANY GRAFFITI FROM ALL EQUIPMENT, WHETHER PERMANENT OR TEMPORARY.
11. CONTRACTOR SHALL COORDINATE WITH THE ABCWUA WATER SYSTEMS DIVISION (857-8200) SEVEN WORKING DAYS IN ADVANCE OF ANY WORK THAT MAY AFFECT EXISTING PUBLIC WATER OR SEWER UTILITIES. EXISTING VALVES TO BE OPERATED BY WATER PERSONNEL ONLY. CONTRACTOR SHALL CONTACT THE WATER SYSTEMS DIVISION SEVEN(7) DAYS PRIOR TO NEEDING VALVES TURNED ON OR OFF.

THE FOLLOWING NOTES ALSO APPLY WHEN CHECKED

- ☒ ALL UTILITIES AND UTILITY SERVICE LINES SHALL BE INSTALLED PRIOR TO PAVING.
- ☒ BACKFILL COMPACTION SHALL BE ACCORDING TO SPECIFIED STREET USE.
- ☒ TACK COAT REQUIREMENTS SHALL BE DETERMINED BY THE ENGINEER.
- ☒ SIDEWALKS AND WHEELCHAIR RAMPS WITHIN THE CURB RETURNS SHALL BE CONSTRUCTED WHEREVER A NEW CURB RETURN IS CONSTRUCTED.
- ☒ IF CURB IS DEPRESSED FOR A DRIVEPAD, THE DRIVEPAD SHALL BE CONSTRUCTED PRIOR TO ACCEPTANCE OF CURB AND GUTTER.
- ☒ ALL STORM DRAINAGE FACILITIES SHALL BE COMPLETED PRIOR TO FINAL ACCEPTANCE.
- ☒ THE REQUESTOR OR DEVELOPER SHALL BE RESPONSIBLE FOR REPAIR OR REPLACEMENT OF ALL CURB AND GUTTER OR SIDEWALK DAMAGED AFTER APPROVAL BY THE CITY ENGINEER OF WORK COMPLETED BY THE CONTRACTOR.

SURVEYOR'S CERTIFICATION

I, BRIAN J. MARTINEZ, A DULY QUALIFIED, REGISTERED, PROFESSIONAL LAND SURVEYOR UNDER THE LAWS OF THE STATE OF NEW MEXICO, DO HEREBY CERTIFY THAT THE "AS-BUILT" INFORMATION SHOWN ON THESE DRAWINGS WAS OBTAINED FROM FIELD CONSTRUCTION AND "AS-BUILT" SURVEYS PERFORMED BY ME OR UNDER MY SUPERVISION, THAT THE "AS-BUILT" INFORMATION SHOWN ON THESE DRAWINGS IS TRUE AND CORRECT TO THE BEST OF MY KNOWLEDGE AND BELIEF. CARTESIAN SURVEYS IS NOT RESPONSIBLE FOR ANY OF THE DESIGN CONCEPTS, CALCULATIONS, ENGINEERING, OR INTENT OF THE RECORDED DRAWINGS.



Brian J. Martinez, NMPS 18374

Bohannon & Huston

Engineering • Spatial Data • Advanced Technologies

REV.	SHEETS	CITY ENGINEER	DATE	USER DEPARTMENT	DATE	USER DEPARTMENT	DATE
ENGINEERS STAMP & SIGNATURE	APPROVALS	ENGINEER	DATE	*****			
	DRC Chairman	Signature	10/30/08	APPROVED FOR CONSTRUCTION			
	Transportation	Signature	10/30/08				
	Water/Wastewater	Signature	10-30-08				
	Hydrology	Signature	10-23-08				
	CIP						
	Const. Mngmt.						
DRB CASE NUMBER		CITY PROJECT NO.		SHEET OF			
1007204		735684		1 29			

Introduction:

The purpose of the control listed below is to serve as a spatial reference for the project located at the southwest corner of Central Av and Unser Blvd. The intended accuracy is 0.10' horizontal and 0.10' vertical. Geographic coordinates and ellipsoid height were obtained from a primary point BH 08-289-01 using an autonomous GPS position which is accurate within 30 meters. All other points are relative to this position.

Project Control Statistics:

Units: US Survey Foot
Horizontal Datum: NAD83
Vertical Datum: NAVD88
Projection: Transverse Mercator
State Plane and/or UTM Zone: New Mexico Central Zone (3002)
Basis of Bearing: Grid Bearings
Project Combined Factor: 0.99982780 from 14_K9
Modification Method Used: Scaled State Plane coordinates about origin (0.0) no truncation
Field Methodology: RTK observations, Trimble site calibration to Primary control
Equipment Used: Trimble GPS Equipment (4700, 5700, 5800 Dual Frequency Receivers)
Control Set Date: February 28, 2008
Observation Date: November 21, 2007 and February 28, 2008
Adjustment/Publication Date: November 29, 2007

Primary Control Used:

Point	Latitude	Longitude	Ellipsoid	Elevation	Northing	Easting	Description
7_K9	35°04'29.85"N	106°43'56.94"W	5068.99	5140.08	1483375.28	1496536.47	AGRS
10_L9	35°04'22.21"N	106°44'33.24"W	5136.03	5207.17	1482617.47	1493514.59	AGRS
REWARD	35°05'13.72"N	106°44'55.82"W	5249.71	5319.69	1487836.03	1491664.01	AGRS
3_K10	35°04'59.14"N	106°42'38.11"W	5023.51	5094.52	1486305.81	1503103.98	AGRS
7_K10	35°04'38.24"N	106°43'22.09"W	5026.78	5087.85	1484209.99	1499438.30	AGRS
7_L10	35°04'18.50"N	106°43'22.92"W	5016.94	5088.07	1482213.55	1499359.43	AGRS
14_K9	35°04'24.42"N	106°43'49.20"W	5046.93	5118.02	1482623.11	1497177.83	AGRS

Adjusted Coordinate Listing:

Point	Latitude	Longitude	Ellipsoid	Elevation	Northing	Easting	Description
BH 08-289-01	35°04'30.32"N	106°43'32.15"W	5030.39	5101.48	1483412.20	1488598.66	Aluminum Cap
BH 08-289-02	35°04'32.00"N	106°43'47.03"W	5054.10	5125.19	1483588.63	1497362.02	Aluminum Cap
BH 08-289-03	35°04'35.04"N	106°43'33.63"W	5034.73	5105.78	1483891.06	1498477.20	Aluminum Cap
BH 08-289-04	35°04'39.74"N	106°43'17.94"W	5024.07	5095.13	1484360.11	1499783.84	Aluminum Cap
BH 08-289-05	35°04'18.32"N	106°43'17.08"W	5012.45	5083.56	1482192.90	1499845.23	PK Nail
BH 08-289-06	35°04'21.59"N	106°43'51.87"W	5051.06	5122.17	1482537.46	1499553.95	PK Nail
BH 08-289-07	35°04'34.80"N	106°43'54.22"W	5062.71	5133.79	1483874.61	1496765.46	PK Nail

Geospatial Positional Accuracy Report:

Point	Horizontal Positional Accuracy	Vertical Positional Accuracy
BH 08-289-01	0.066'	0.023'
BH 08-289-02	0.068'	0.037'
BH 08-289-03	0.069'	0.038'
BH 08-289-04	0.068'	0.039'
BH 08-289-05	0.069'	0.038'
BH 08-289-06	0.069'	0.043'
BH 08-289-07	0.068'	0.040'



Note: The method for establishing horizontal positions for established control points does not meet the criteria for horizontal positional accuracy classification according to the Geometric Geodetic Accuracy Standards and Specifications for Using GPS Relative Positioning Techniques, August 1, 1999. The estimated Network Horizontal RMS is 0.10' survey level.

The method for establishing vertical positions for established control points does not meet the criteria for vertical positional accuracy classification according to the Standards and Specifications for Geodetic Control Network, September 1984. The estimated Network Vertical RMS is 0.10' survey level.

The estimated Network Accuracy of control monuments included in the primary control, used to constrain the position of established control points has a published order of accuracy of 1st order Horizontal, 2nd Class 1st order vertical as published by the City of Albuquerque.


I, Robert Gromatzky, New Mexico Professional Surveyor No. 16469, do hereby certify that this Control Survey Report was prepared by me or under my direct supervision based on an actual survey on the ground as described herein; that I am responsible for this survey; and that the survey and report meets the minimum standards for surveying in New Mexico.

Date: 10-25-08

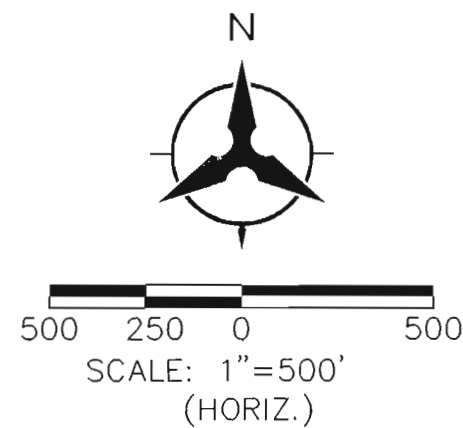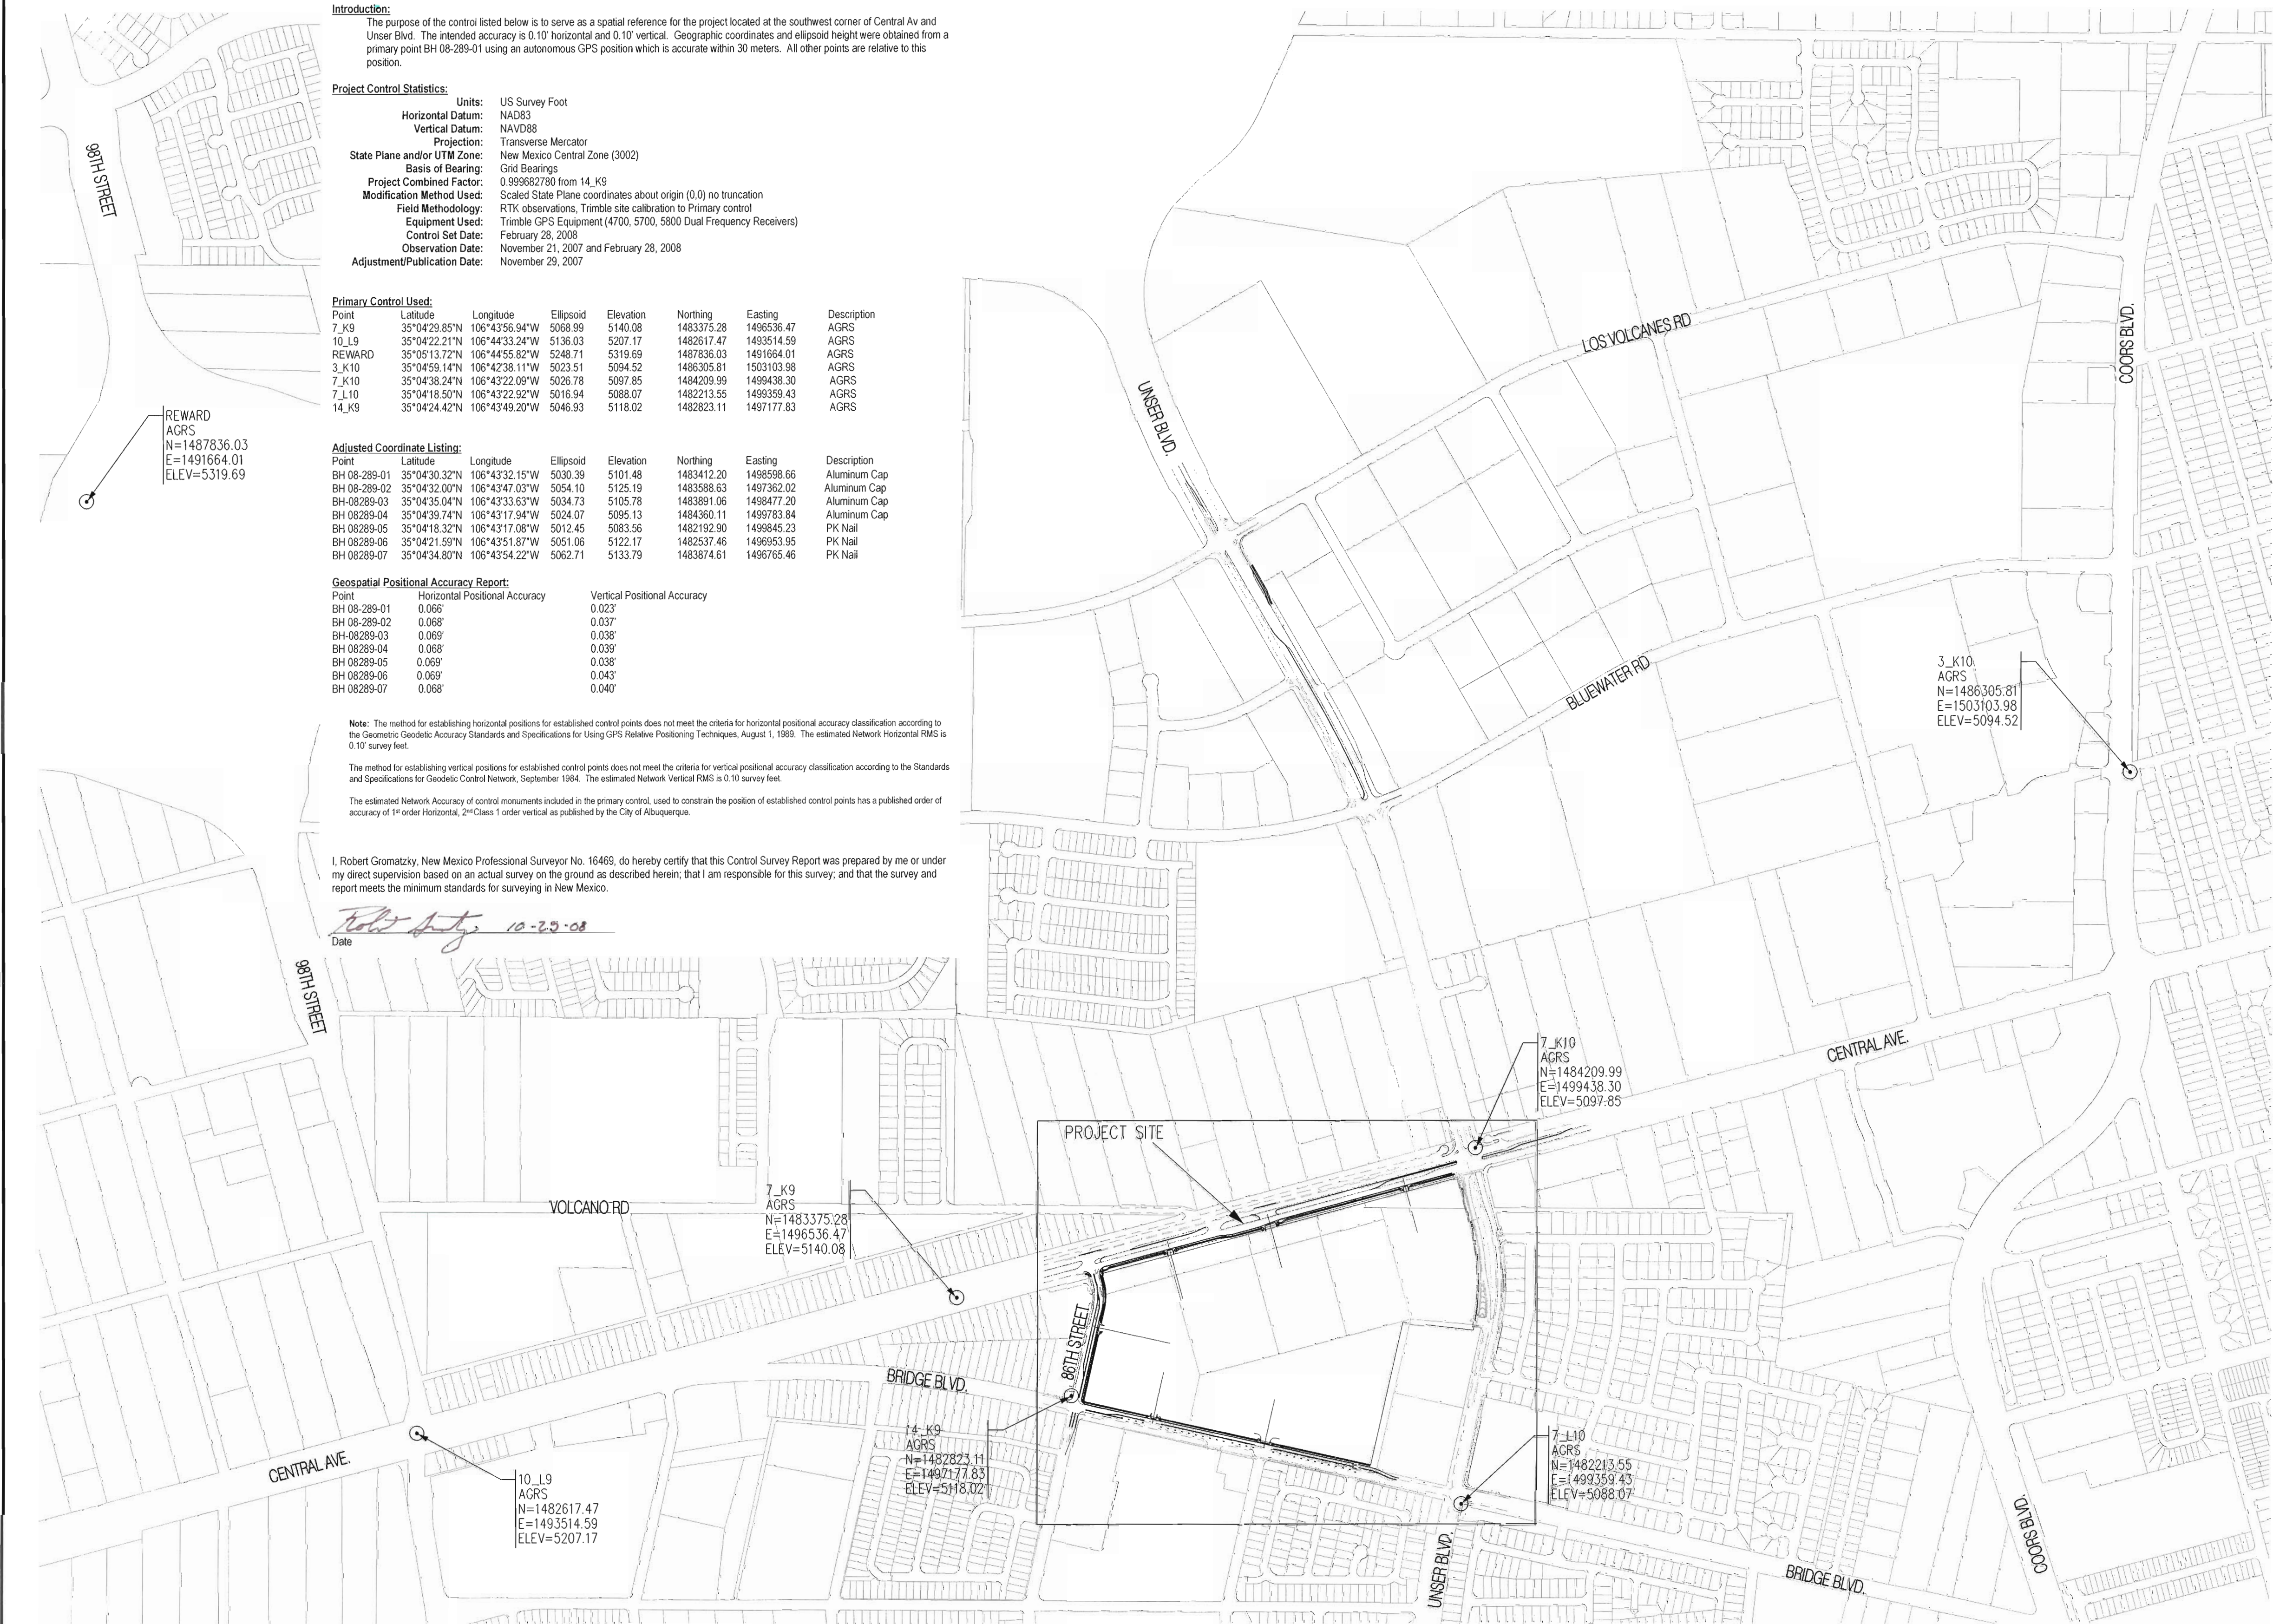

Bohannon & Huston Court yard 7500 Jefferson St. NE Albuquerque, NM 87109-4335 ENGINEERING SPATIAL DATA ADVANCED TECHNOLOGIES	
CITY OF ALBUQUERQUE DEPARTMENT OF MUNICIPAL DEVELOPMENT	
OFFSITE PUBLIC INFRASTRUCTURE - UNSER CROSSING SURVEY CONTROL SHEET / OVERALL SITE PLAN	
DESIGN REVIEW COMMITTEE	CITY ENGINEER APPROVAL
LAST DESIGN UPDATE	
CITY PROJECT NO. 735684	ZONE MAP NO. K-9 K-10
SHEET 2 OF 29	

SP-2008242970

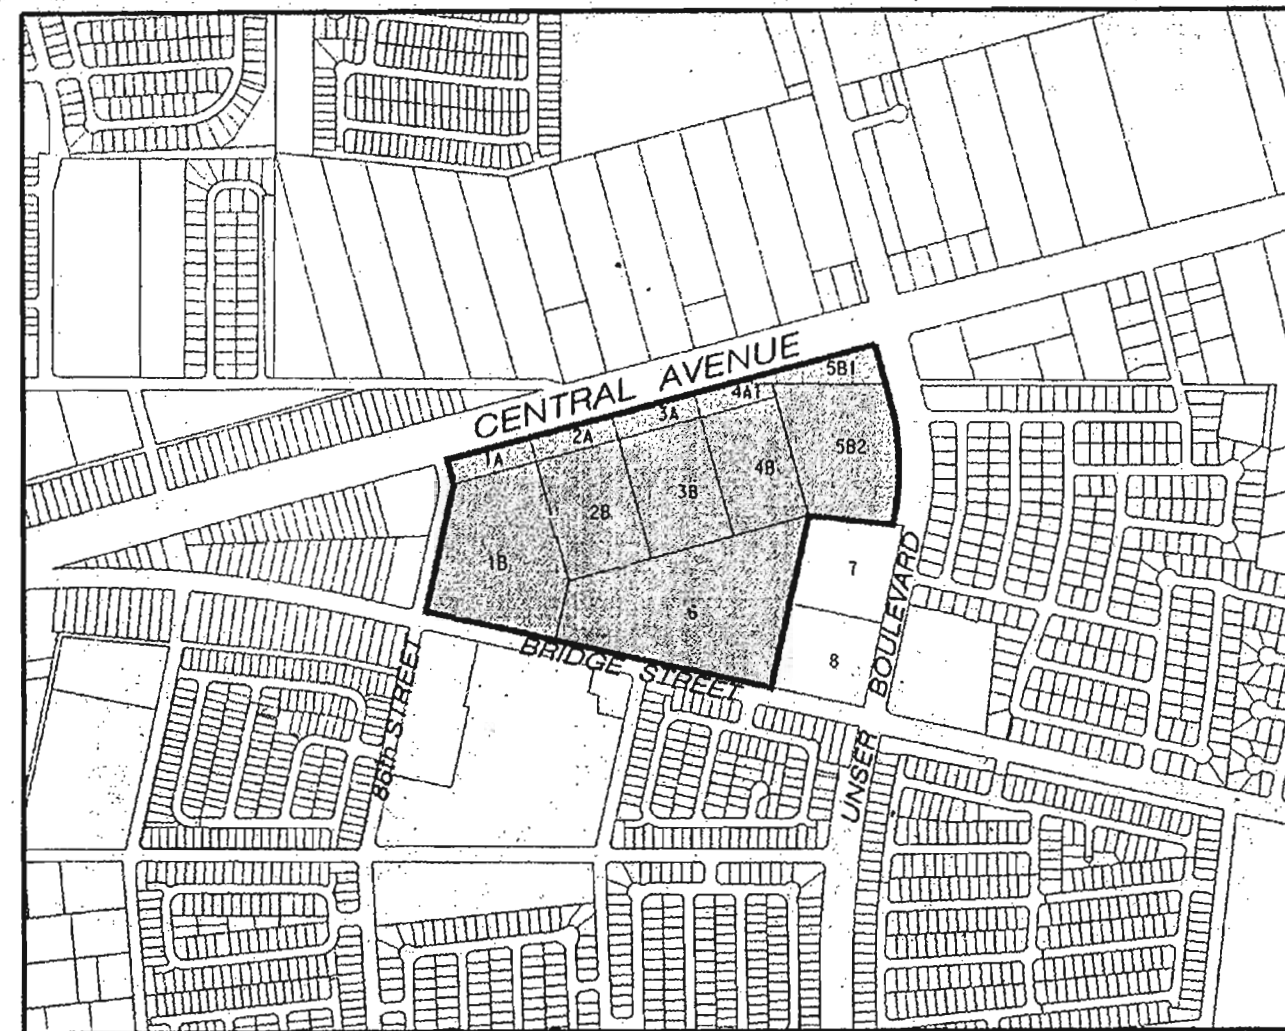

LOCATION MAP

ZONE ATLAS INDEX MAP Nos. K9 & K10
NOT TO SCALE

SUBDIVISION DATA

1. DRB No.
2. Zone Atlas Index Nos. K-9 and K-10
3. Zoning: C-2 & SU-1.
4. Gross Subdivision Acreage: 50.6833 Acres.
5. Total number of tracts Created: Fourteen (14) Tracts.
6. Total Area of dedicated public street right-of-way: 0.3042 acre.
7. Date of Survey: June, 2008.
8. Plat is located within the Town of Atasco Grant in projected Sections 21 & 22, Township 10 North, Range 2 East, NMPM, City of Albuquerque, Bernalillo County, New Mexico.

DISCLOSURE STATEMENT

The purpose of this Plat is to subdivide Tracts One-A (1-A), One-B (1-B), Two-A (2-A), Two-B (2-B), Three-A (3-A), Three-B (3-B), Four-B (4-B) and Six (6) of V.E. Barrett Subdivision, as the same is shown and designated on the plat thereof, filed in the office of the County Clerk of Bernalillo County, New Mexico, on February 13, 1967, in Book C6, Page 161 together with all of Tracts Four-A-1 (4-A-1), Five-B-1 (5-B-1), and Five-B-2 (5-B-2), Lands of Wefco, Partners, as the same are shown and designated on the plat thereof, filed in the office of the County Clerk of Bernalillo County, New Mexico, on April 6, 1987, in Book C-33 into fourteen (14) new tracts, to vacate easements, to dedicate public street right-of-way to the City of Albuquerque, and to grant easements.

PUBLIC UTILITY EASEMENTS

PUBLIC UTILITY EASEMENTS shown on this plat are for the common joint use of:

- PNM Electric Services for the installation, maintenance and service of underground electrical lines, transformers, and other equipment, fixtures, structures, and related facilities reasonably necessary to provide electrical service.
- PNM Gas services for installation, maintenance, and service of underground natural gas lines, valves and other equipment and facilities reasonably necessary to provide natural gas.
- QWEST for the installation, maintenance, and service of all buried communication lines and other related equipment and facilities reasonably necessary to provide communication services, including but not limited to above ground pedestals and closures.
- Comcast Cable for the installation, maintenance, and service of such underground lines, cable, and other related equipment and facilities reasonably necessary to provide Cable TV service.

Included is the right to build, rebuild, construct, reconstruct, locate, relocate, change, remove, modify, renew, operate, and maintain facilities for the purposes described above, together with free access to, from, and over said easements, including sufficient working area space for electric transformers, with the right and privilege to trim and remove trees, shrubs or bushes which interfere with the purposes set forth herein. No building, sign, pool, (above ground or subsurface), hot tub, concrete or wood pool decking, or other structure shall be erected or constructed on said easements, nor shall any well be drilled or operated thereon. Property owners shall be solely responsible for correcting any violations of National Electric Safety Code caused by construction of pools, decking, or any structures adjacent to or near easements shown on this plat.

Easements for electric transformers/switchgears, as installed shall extend ten feet (10') in front of transformer/switchgear doors and five feet (5') on each side.

DESCRIPTION

A certain tract of land situate within the Town of Atasco Grant in projected Sections 21 and 22, Township 10 North, Range 2 East, New Mexico Principal Meridian, City of Albuquerque, Bernalillo County, New Mexico being and comprising all of Tracts One-A (1-A), One-B (1-B), Two-A (2-A), Two-B (2-B), Three-A (3-A), Three-B (3-B), Four-B (4-B) and Six (6) of V.E. Barrett Subdivision, as the same is shown and designated on the plat thereof, filed in the office of the County Clerk of Bernalillo County, New Mexico, on February 13, 1967, in Book C6, Page 161 together with all of Tracts Four-A-1 (4-A-1), Five-B-1 (5-B-1), and Five-B-2 (5-B-2), Lands of Wefco, Partners, as the same are shown and designated on the plat thereof, filed in the office of the County Clerk of Bernalillo County, New Mexico on April 6, 1987, in Book C-33, Page 81.

Tract contains 50.6833 acres of land, more or less.

NOTES

1. Bearings are New Mexico State Plane Grid Bearings (Central Zone) NAD 1983 and the Basis of Bearings is the inverse between Albuquerque Control Monuments "7-K10" and "14-K9" Bearing = S58°28'10"W.
2. Record Bearings and distances are shown in parenthesis.
3. Distances are ground distances.
4. All easements of record are as shown on the Plat of record or made known to me by the owner, utility companies, or other interested parties.
5. All interior tract corners to be monumented by a #5 rebar and yellow plastic survey cap stamped "GROMATZKY PS 16469".
6. All streets are public, to be dedicated to the City of Albuquerque with the filing of this plat.
7. Pursuant to section 14-14-4-7 of the City of Albuquerque Code of Ordinances, "No property within the area of this Plat shall at anytime be subject to a deed restriction, covenant, or binding agreement prohibiting solar collectors from being installed on buildings or erected on the lots or parcels within the area of the proposed plat. The foregoing requirements shall be a condition to approval of this plat."
8. Reciprocal cross access easements for the benefit of Tracts 1 through 14, are granted by separate Easements, Convents, Conditions and Restrictions ("ECC&Rs") recorded concurrently herewith to be maintained by the owners of those Tracts as provided in the ECC&Rs.
9. Reciprocal storm water drainage easements for the benefit of Tracts 1 through 14 are granted by the ECC&Rs to be maintained by the owners of those Tracts as provided in the ECC&Rs.
10. Tracts 1 thru 14 are subject to covenants and restrictions in the ECC&Rs.
11. This grant of easement is for the benefit of the owners, tenants, employees and invitees of Tract 7 and 8, V.E. Barrett Subdivision for the sole purpose of vehicular access. Grantees' exercise of this easement shall not unreasonably interfere with business operations on the grantor's property. Grantees shall indemnify the grantor against claims arising from use of this easement. Grantees shall reimburse an equitable share of the reasonable costs of maintaining such vehicular access upon invoice from the party performing such maintenance and insuring such vehicular access. Grantees shall obtain general commercial liability insurance covering use of this easement with limits reasonably acceptable to grantors naming grantors as additional insureds.

SUBORDINATION CLAUSE:

The Undersigned Subordinates its interest in the herein - described Real Property to the Right and Interests of The City of Albuquerque in The Real Property and all interest herein dedicated to The City of Albuquerque.

LIENHOLDER

In witness thereof, The Huntington National Bank, as the Lending Institution, has caused these presents to be

Executed this 25th day of July AD 2008

BY: John Clingan JOHN CLINGAN

AS: Vice President - Commercial Lending
Commonwealth of Pennsylvania, COUNTY OF Allegheny

The foregoing instrument was acknowledged before me this 25th day of July 2008,

THE HUNTINGTON NATIONAL BANK

BY: John Clingan JOHN CLINGAN

AS: Vice President - Commercial Lending

Witness My Hand and Official Seal

Judith L. White Judith L. White, Notary Public

City of Pittsburgh, My Commission Expires: 4-15-2010
Notary Address: Allegheny County

SURVEYOR'S CERTIFICATION

I, Robert Gromatzky, a registered Professional New Mexico Surveyor, certify that I am responsible for this survey and that this plat was prepared by me or under my supervision, shows all easements as shown on the plat of record, or made known to me by the owner, utility companies, or other interested parties and conforms to the Minimum Requirements of the Board of Registration for Professional Engineers and Professional Surveyors and meets the minimum requirements for monumentation and surveys contained in the City of Albuquerque Subdivision Ordinance, and is true and accurate to the best of my knowledge and belief.

Robert Gromatzky
New Mexico Professional Surveyor 16469

Date: 7-24-08



FREE CONSENT AND DEDICATION

This plat of that certain tract of land situate within the Town of Atasco Grant in projected Sections 21 & 22, Township 10 North, Range 2 East, New Mexico Principal Meridian, City of Albuquerque, Bernalillo County, New Mexico being and comprising all of Tracts One-A (1-A), One-B (1-B), Two-A (2-A), Two-B (2-B), Three-A (3-A), Three-B (3-B), Four-B (4-B) and Six (6) of V.E. Barrett Subdivision, as the same is shown and designated on the plat thereof, filed in the office of the County Clerk of Bernalillo County, New Mexico, on February 13, 1967, in Book C6, Page 161 together with all of Tracts Four-A-1 (4-A-1), Five-B-1 (5-B-1), and Five-B-2 (5-B-2), Lands of Wefco, Partners, as the same are shown and designated on the plat thereof, filed in the office of the County Clerk of Bernalillo County, New Mexico on April 6, 1987, in Book C-33, Page 81, records of Bernalillo County, New Mexico, now comprising Tracts 1 thru 14, Unser Crossings is with the free consent and in accordance with the desires of the undersigned owner(s) and/or proprietor(s) thereof. Said owner(s) and/or proprietor(s) do hereby dedicate additional public right-of-way for 86th Street SW as shown hereon to the City of Albuquerque in fee simple with warranty covenants and do hereby grant to the City All Access, Utility and Drainage Easements shown hereon as granted to the City including the right to construct, operate, inspect, and maintain facilities therein; and to the providers of public utilities all Public Utility Easements shown hereon for the common and joint use of Gas, Electrical Power, and Communication Services for buried distribution lines, conduits, and pipes for underground utilities where shown or indicated, including the right of ingress and egress for construction and maintenance, and the right to trim interfering trees and shrubs. The City has the right to enter upon the easement property at any time and perform whatever inspection, installation, maintenance, repair, modification or removal ("Work") it deems appropriate without liability to the City. If the Work effects any improvements or encroachments by the grantor, their assigns or heirs, the City will not be financially or otherwise responsible for rebuilding or repairing of improvements or encroachments. If in the opinion of the City, the Work to be performed by the City could endanger the structural integrity or otherwise damage the improvements or encroachments, the grantor, their assigns or heirs, shall, at its own expense, take whatever protective measures are required to safeguard the improvements or encroachments. This plat shows all easements, lots, and tracts, as shown on the plat of record, or made known to me by either the owner, utility companies, commitment for title insurance, or other interested parties. All lots, tracts, and easements comprising the platted real property shall be known by the names and identifications made on this plat. All public utility easements, drainage easements, pedestrian access easements, vehicular non-access easements, and water and sewer line easements depicted on this plat are non-exclusive and are granted to the providing utility company or the City of Albuquerque, as applicable, for the specific purpose described on this plat. By recordation of this plat, all easements, restrictions, lots, and tracts which were created by any previously recorded plat or subdivision map which comprised or affected the real property subdivided by this plat shall be deemed vacated and abandoned unless otherwise noted on its plat. Said owner warrants that he holds complete and indefeasible title in fee simple to the land subdivided. Said owner(s) and/or proprietor(s) do hereby consent to all of the foregoing and do hereby certify that this subdivision is their free act and deed.

ARMSTRONG CENTRAL UNSER BLVD, LLC, a New Mexico Limited Liability Company

By: Robert W. Frisch Robert W. Frisch, a Delaware Limited Liability Company

Armstrong Development Holdings, Inc., a Delaware corporation, its sole member

By: Robert W. Frisch Robert W. Frisch, Vice President

State of New Mexico, SS

County of Bernalillo

COMMONWEALTH OF PENNSYLVANIA

COUNTY OF Allegheny

This instrument was acknowledged before me on 25th day of July 2008,
by ROBERT W. FRISCH VICE PRESIDENT
managing member of Armstrong Central Unser, LLC, a New Mexico limited liability company.

My Commission Expires: 4-15-2010 Judith L. White
Notary Public

SANDIA PLAZA PARTNERS, LLC, a New Mexico Limited Liability Company

By: Traci J. Wolf TRACI J. WOLF

Traci J. Wolf
Title: MANAGING MEMBER

State of New Mexico, SS

County of Bernalillo

This instrument was acknowledged before me on 20th day of July 2008,
by Traci J. Wolf of Sandia Plaza Partners, LLC a New Mexico limited liability company.

My Commission Expires: 11-8-2010 Rachael Runtz
Notary Public

JURISDICTIONAL AFFIDAVIT

I, Robert Gromatzky, a registered Professional New Mexico Surveyor, hereby affirm that the property described does lie within the platting and subdivision jurisdiction of the City of Albuquerque.

Robert Gromatzky
New Mexico Professional Surveyor 16469

Date: 7-24-08



PLAT OF
UNSER CROSSINGS
(A REPLAT OF TRACTS 1A, 1B, 2A, 2B, 3A, 3B, 4B
& TRACT 6 V.E. BARRETT SUBDIVISION
AND TRACTS 4-A-1, 5-B-1 & 5-B-2
LANDS OF WEFECO, PARTNERS)
ALBUQUERQUE, BERNALILLO COUNTY, NEW MEXICO
JULY, 2008

PROJECT NUMBER

APPLICATION NUMBER

PLAT APPROVAL

UTILITY APPROVALS: David L. Belil 8/1/08
QUEST TELECOMMUNICATIONS DATE

COMCAST CABLE DATE

PNM ELECTRIC SERVICES DATE

PNM GAS SERVICES DATE

CITY APPROVALS: Robert W. Frisch 7-29-08
CITY SURVEYOR DATE

TRAFFIC ENGINEERING, TRANSPORTATION DIVISION DATE

ALBUQUERQUE BERNALILLO COUNTY WATER UTILITY AUTHORITY DATE

PARKS & RECREATION DEPARTMENT DATE

A.M.A.F.C.A. DATE

CITY ENGINEER DATE

DRB CHAIRPERSON, PLANNING DEPARTMENT DATE

REAL PROPERTY DIVISION DATE

COMMONWEALTH OF PENNSYLVANIA

Notary Seal
Judith L. White, Notary Public
City Of Pittsburgh, Allegheny County
My Commission Expires Apr. 15, 2010
Member, Pennsylvania Association of Notaries

TAX CERTIFICATION

THIS IS TO CERTIFY THAT TAXES ARE CURRENT AND PAID ON UPC #

PROPERTY OWNER OF RECORD

ALBUQUERQUE BERNALILLO COUNTY TREASURER'S OFFICE DATE

In approving this plat, PNM Electric Services and Gas Services (PNM) did not conduct a Title Search of the properties shown hereon. Consequently, PNM does not waive or release any easement or easement rights to which it may be entitled.

Bohman & Huston

Court yard | 7500 Jefferson St. NE Albuquerque, NM 87109-4335

ENGINEERING • SPATIAL DATA • ADVANCED TECHNOLOGIES

SHEET 1 OF 7

P:\080289\SURVEY\004 replat\graphics\080289plot01.dgn
24-JUL-2008 17:22
mcle

JOB NO. 080289 004

2A of 29


NOTE: SEE SHEETS 3 THRU 7 FOR SUBDIVISION DETAILS

Curve Data					
ID	DELTA	TANGENT	ARC	RADIUS	CHORD
C1	27° 34' 44"	301.66'	591.62'	1229.11'	585.92'
	(27° 34' 45")	(301.72')	(591.75')	(1229.36')	(586.05')

TABLES ARE FOR THIS SHEET ONLY


Tangent Data		
ID	BEARING	DISTANCE
T1	N29° 25' 55" E	190.37'
T2	N63° 31' 04" W	68.56'
T3	S12° 48' 38" W	4.37'
	(S12° 48' 43" W)	(3.87')
T4	N14° 59' 22" W	122.28'
	(N13° 15' 20" W)	(122.27')

PLAT OF
UNSER CROSSINGS
(A REPLAT OF TRACTS 1A, 1B, 2A, 2B, 3A, 3B, 4B
& TRACT 6 V.E. BARRETT SUBDIVISION
AND TRACTS 4-A-1, 5-B-1 & 5-B-2
LANDS OF WEFCO, PARTNERS)
ALBUQUERQUE, BERNALILLO COUNTY, NEW MEXICO
JULY, 2008

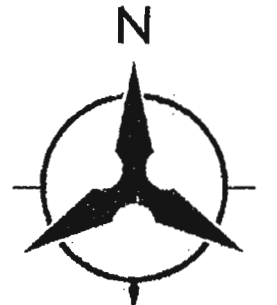

200 100 0 100 200
SCALE: 1" = 200'

ACS ALUMINUM DISC STAMPED "7-K10 1989"
GEOGRAPHIC POSITION (NAD 83)
NM STATE PLANE COORDINATES (CENTRAL ZONE)
N = 1,483,739.165 E = 1,498,962.651
GROUND TO GRID FACTOR = 0.999683006
DELTA ALPHA = -00°16'18.14"
NAVD 1988 ELEVATION = 5097.854

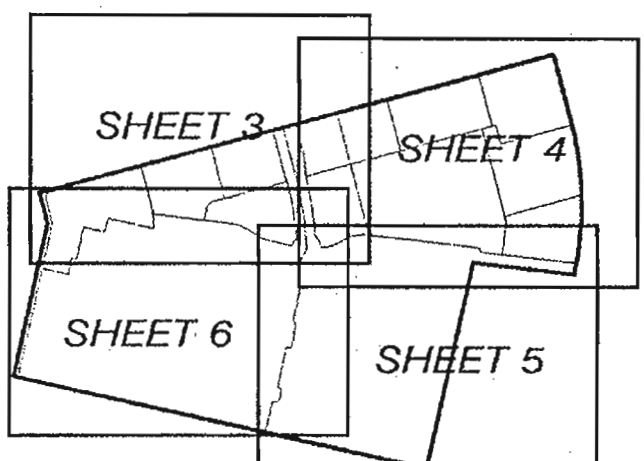

ACS ALUMINUM DISC STAMPED "14-K9 2002"
GEOGRAPHIC POSITION (NAD 83)
NM STATE PLANE COORDINATES (CENTRAL ZONE)
N = 1,482,352.731 E = 1,496,702.894
GROUND TO GRID FACTOR = 0.999682780
DELTA ALPHA = -00°16'33.63"
NAVD 1988 ELEVATION = 5118.017


LEGEND

- SUBDIVISION BOUNDARY LINE
- EXISTING (OLD) LOT LINE TO BE ELIMINATED WITH THE FILING OF THIS PLAT
- NEW LOT LINE
- CENTERLINE
- PROPOSED EASEMENT LINE
- EXISTING EASEMENT LINE
- ADJOINING PROPERTY LINE
- RIGHT OF WAY
- PUE PUBLIC UTILITY EASEMENT GRANTED WITH THE FILING OF THIS PLAT
- CITY OF ALBUQUERQUE CONTROL MONUMENT
- #5 REBAR WITH YELLOW PLASTIC SURVEY CAP STAMPED "GROMATZKY PS 16469"
- FOUND #5 REBAR/CAP AS NOTED
- FOUND #5 REBAR NO CAP
- EXISTING EASEMENTS VACATED BY VACATION ACTION 08DRB-70232




Bohannon & Huston
Court yard | 7500 Jefferson St. NE Albuquerque, NM 87109-4335
ENGINEERING & SPATIAL DATA & ADVANCED TECHNOLOGIES

SHEET 2 OF 7

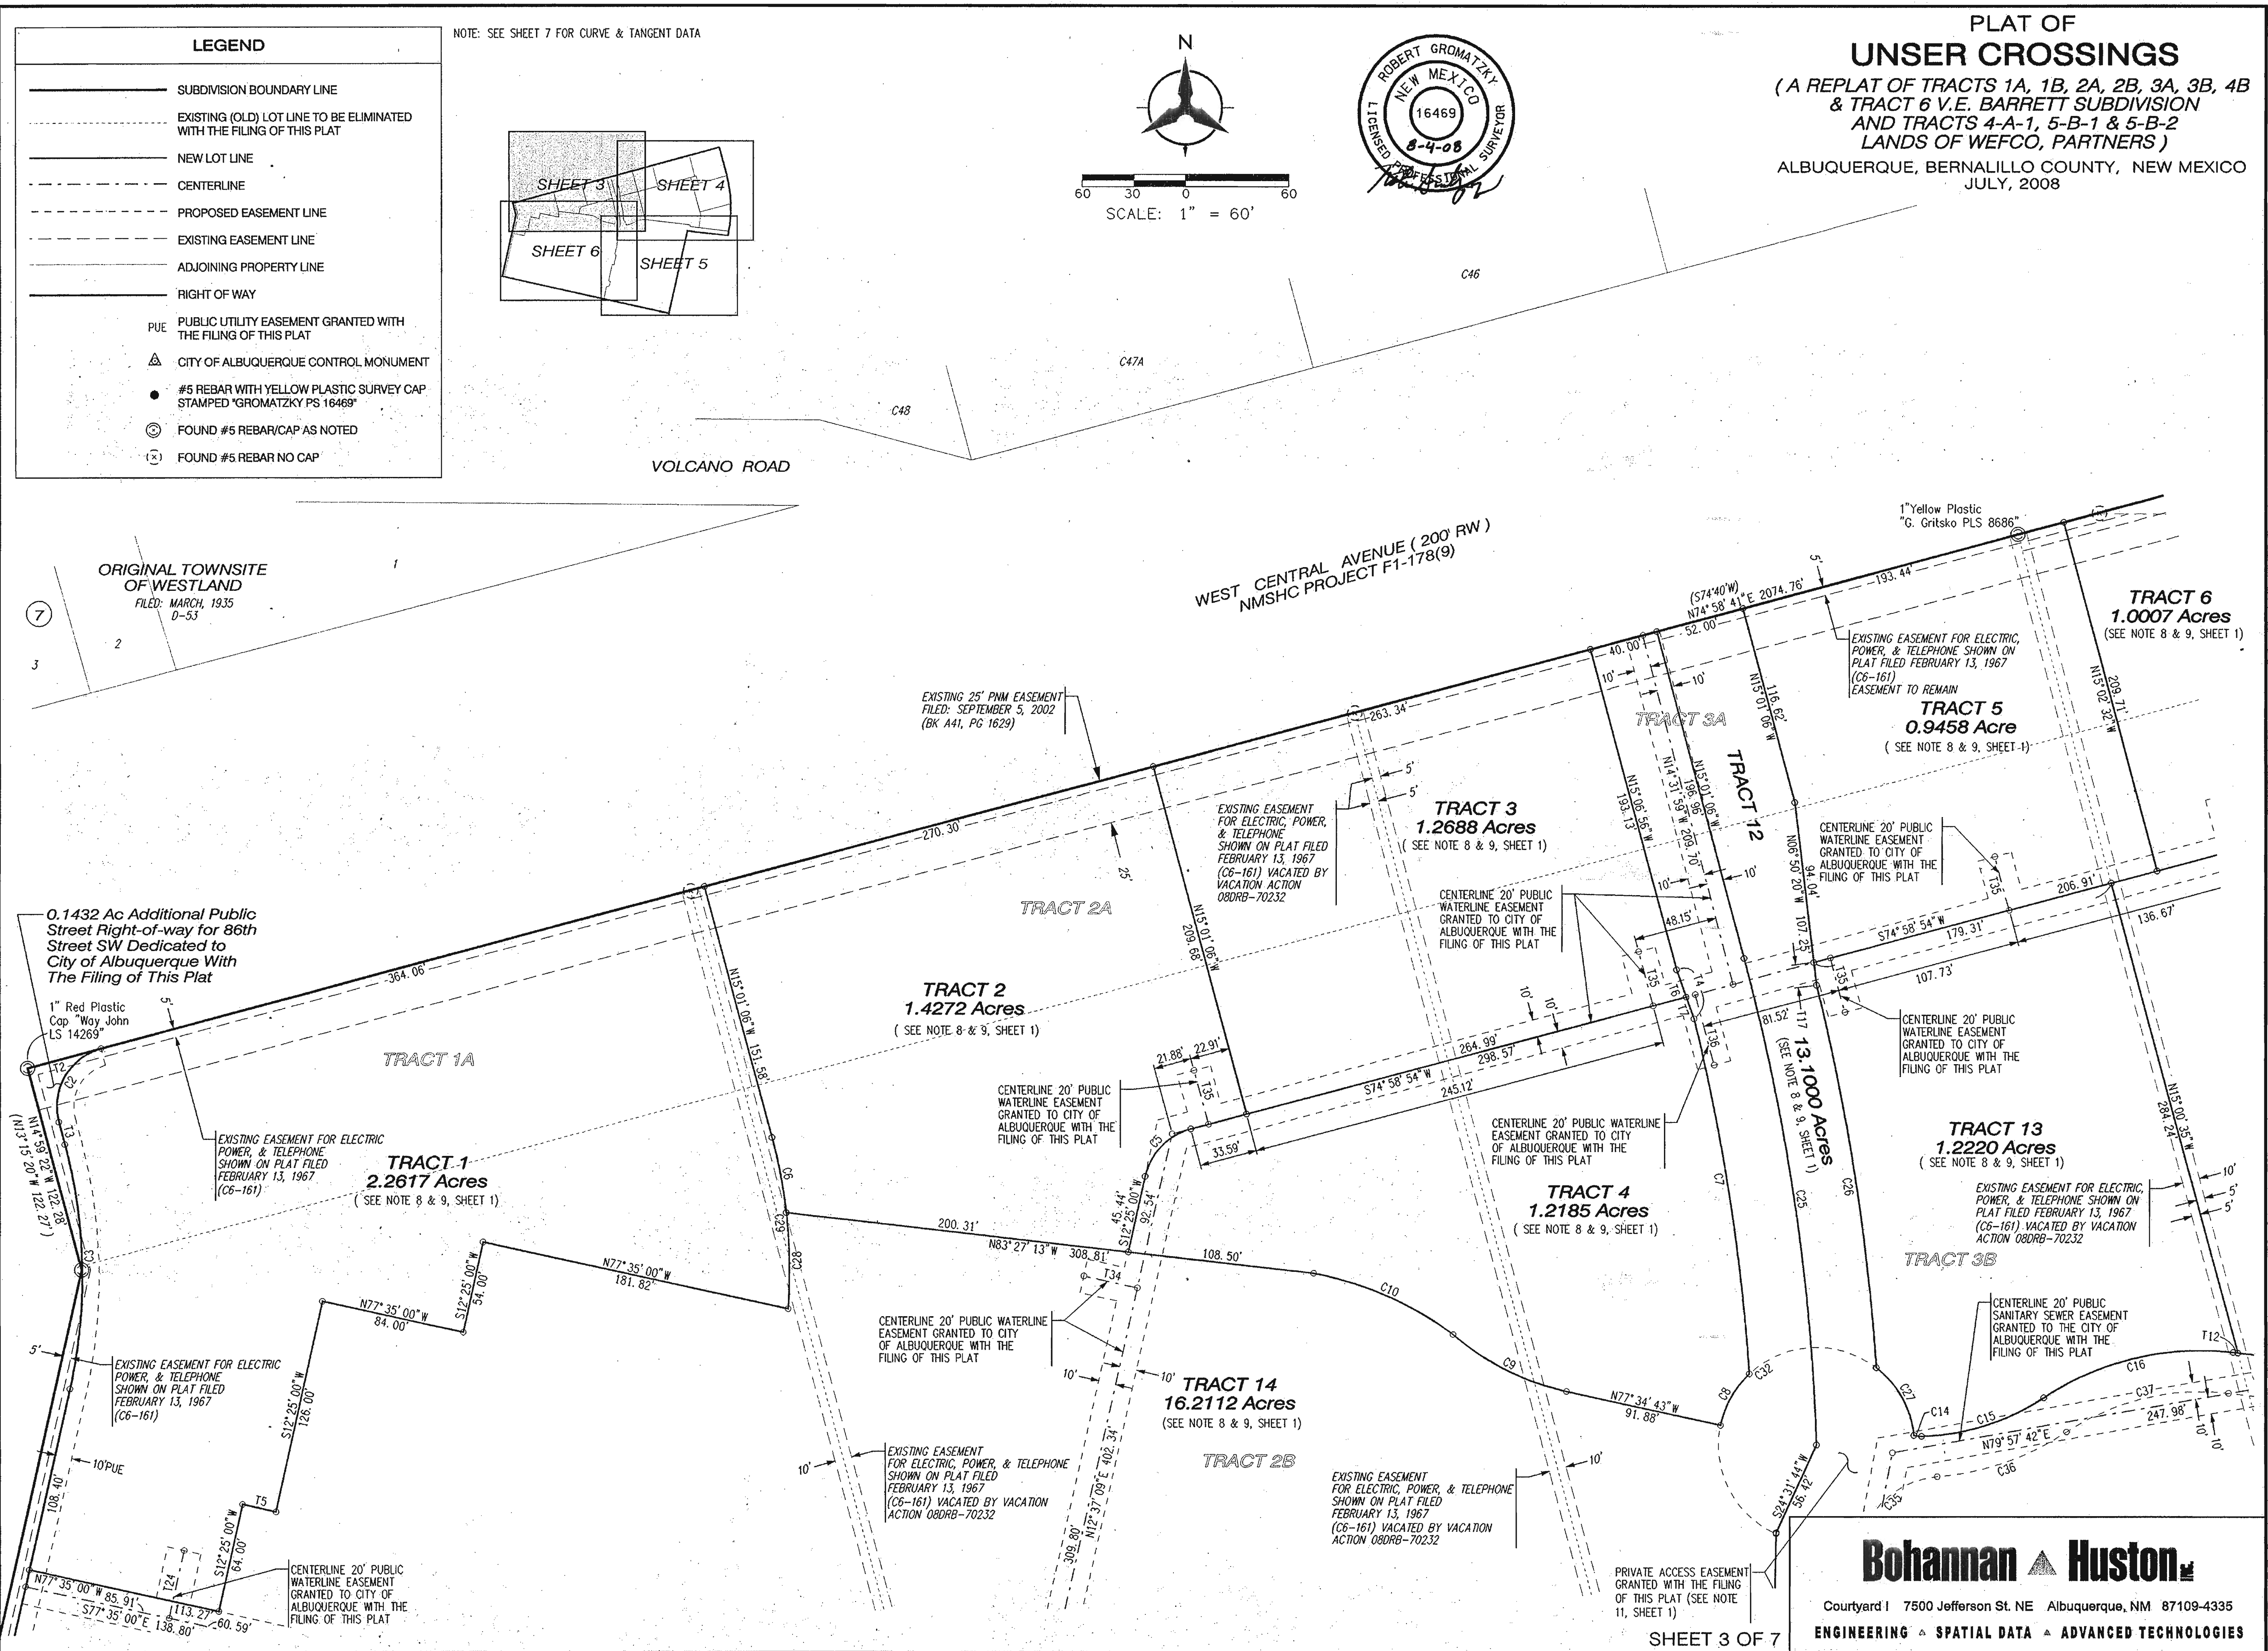

Bohannon & Huston
 Courtyard I 7500 Jefferson St. NE Albuquerque, NM 87109-4335
 ENGINEERING • SPATIAL DATA • ADVANCED TECHNOLOGIES


PLAT OF
UNSER CROSSINGS
(A REPLAT OF TRACTS 1A, 1B, 2A, 2B, 3A, 3B, 4B
& TRACT 6 V.E. BARRETT SUBDIVISION
AND TRACTS 4-A-1, 5-B-1 & 5-B-2
LANDS OF WEFCO, PARTNERS)
ALBUQUERQUE, BERNALILLO COUNTY, NEW MEXICO
JULY, 2008

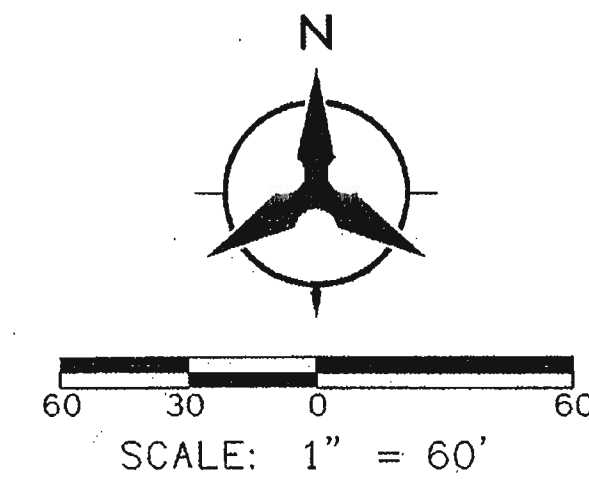

LEGEND

	SUBDIVISION BOUNDARY LINE
	EXISTING (OLD) LOT LINE TO BE ELIMINATED WITH THE FILING OF THIS PLAT
	NEW LOT LINE
	CENTERLINE
	PROPOSED EASEMENT LINE
	EXISTING EASEMENT LINE
	ADJOINING PROPERTY LINE
	RIGHT OF WAY
	PUBLIC UTILITY EASEMENT GRANTED WITH THE FILING OF THIS PLAT
	CITY OF ALBUQUERQUE CONTROL MONUMENT
	#5 REBAR WITH YELLOW PLASTIC SURVEY CAP STAMPED "GROMATZKY PS 16469"
	FOUND #5 REBAR/CAP AS NOTED
	FOUND #5 REBAR NO CAP


NOTE: SEE SHEET 7 FOR CURVE & TANGENT DATA

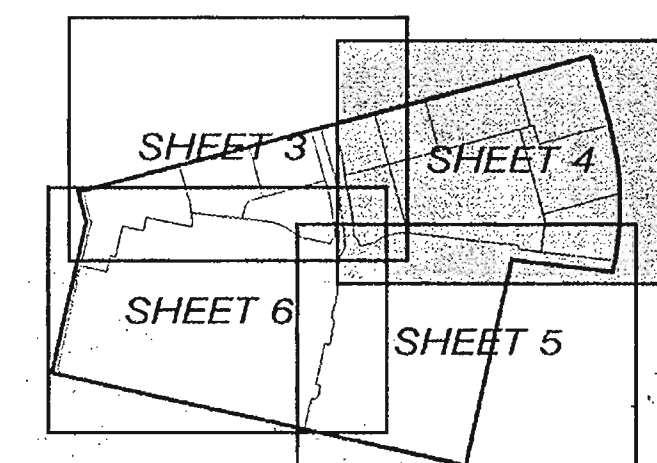


Bohannon & Huston

Courtyard I 7500 Jefferson St. NE Albuquerque, NM 87109-4335
ENGINEERING & SPATIAL DATA & ADVANCED TECHNOLOGIES

SHEET 4 OF 7

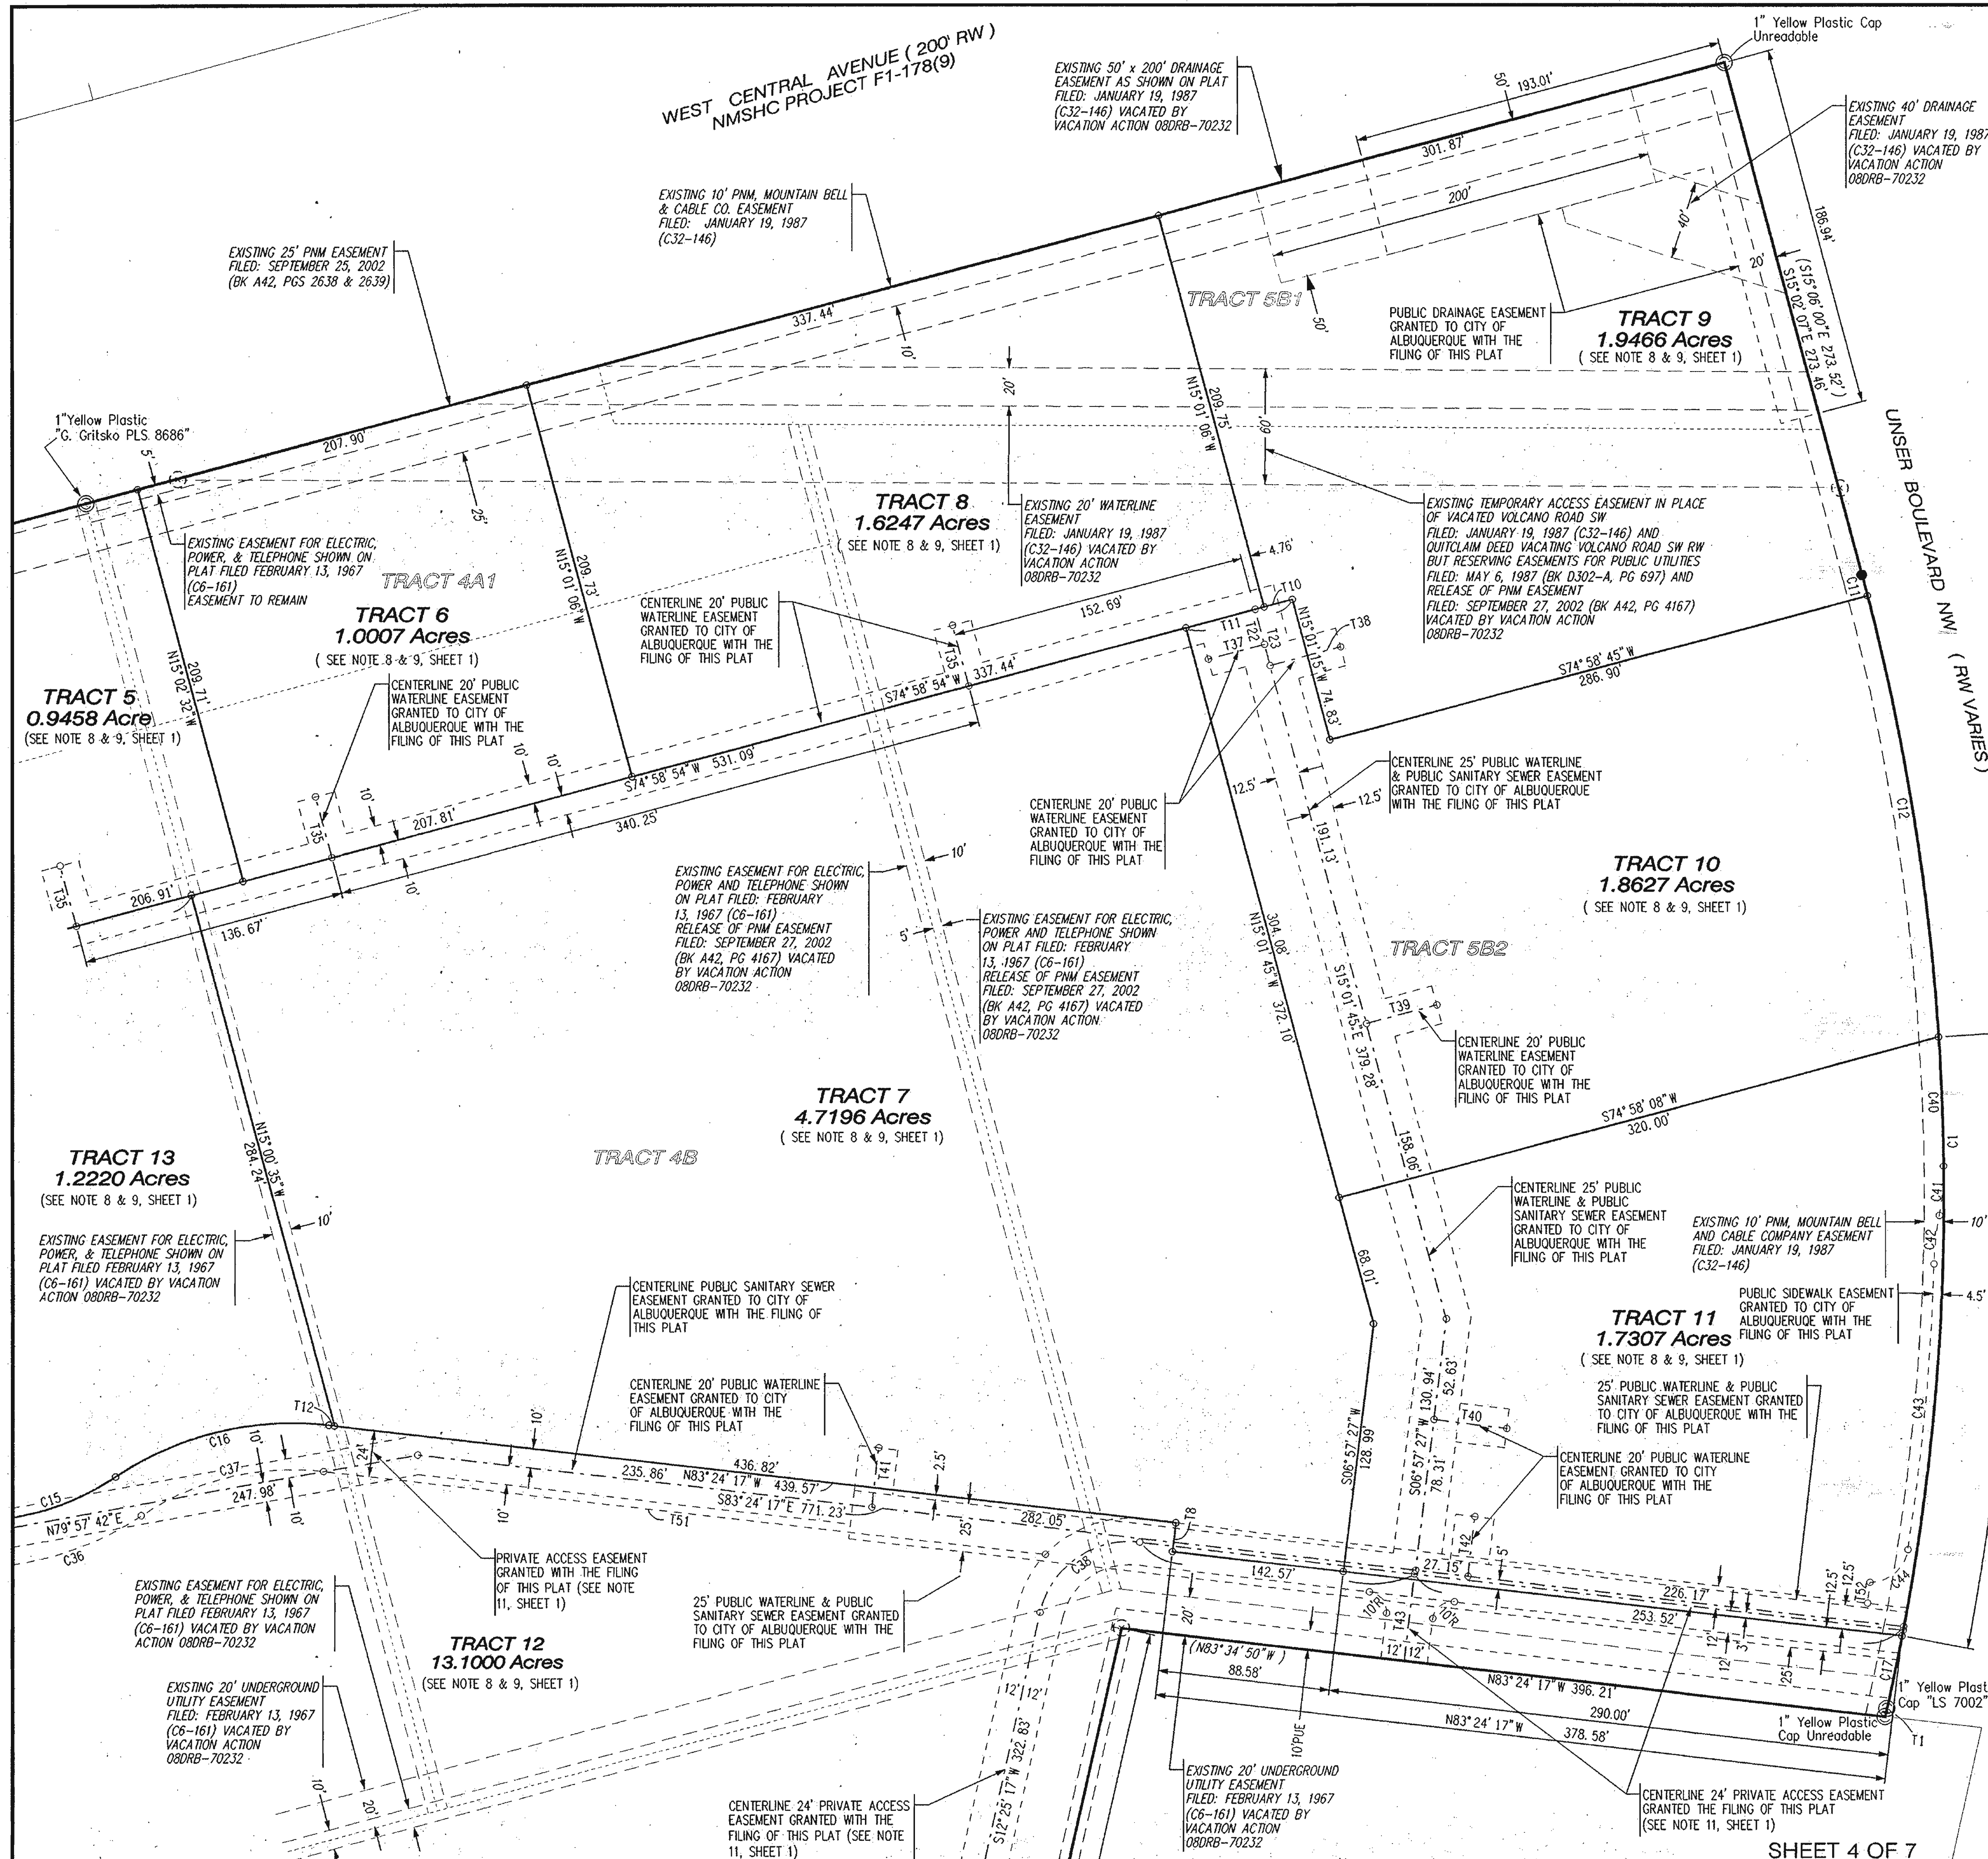

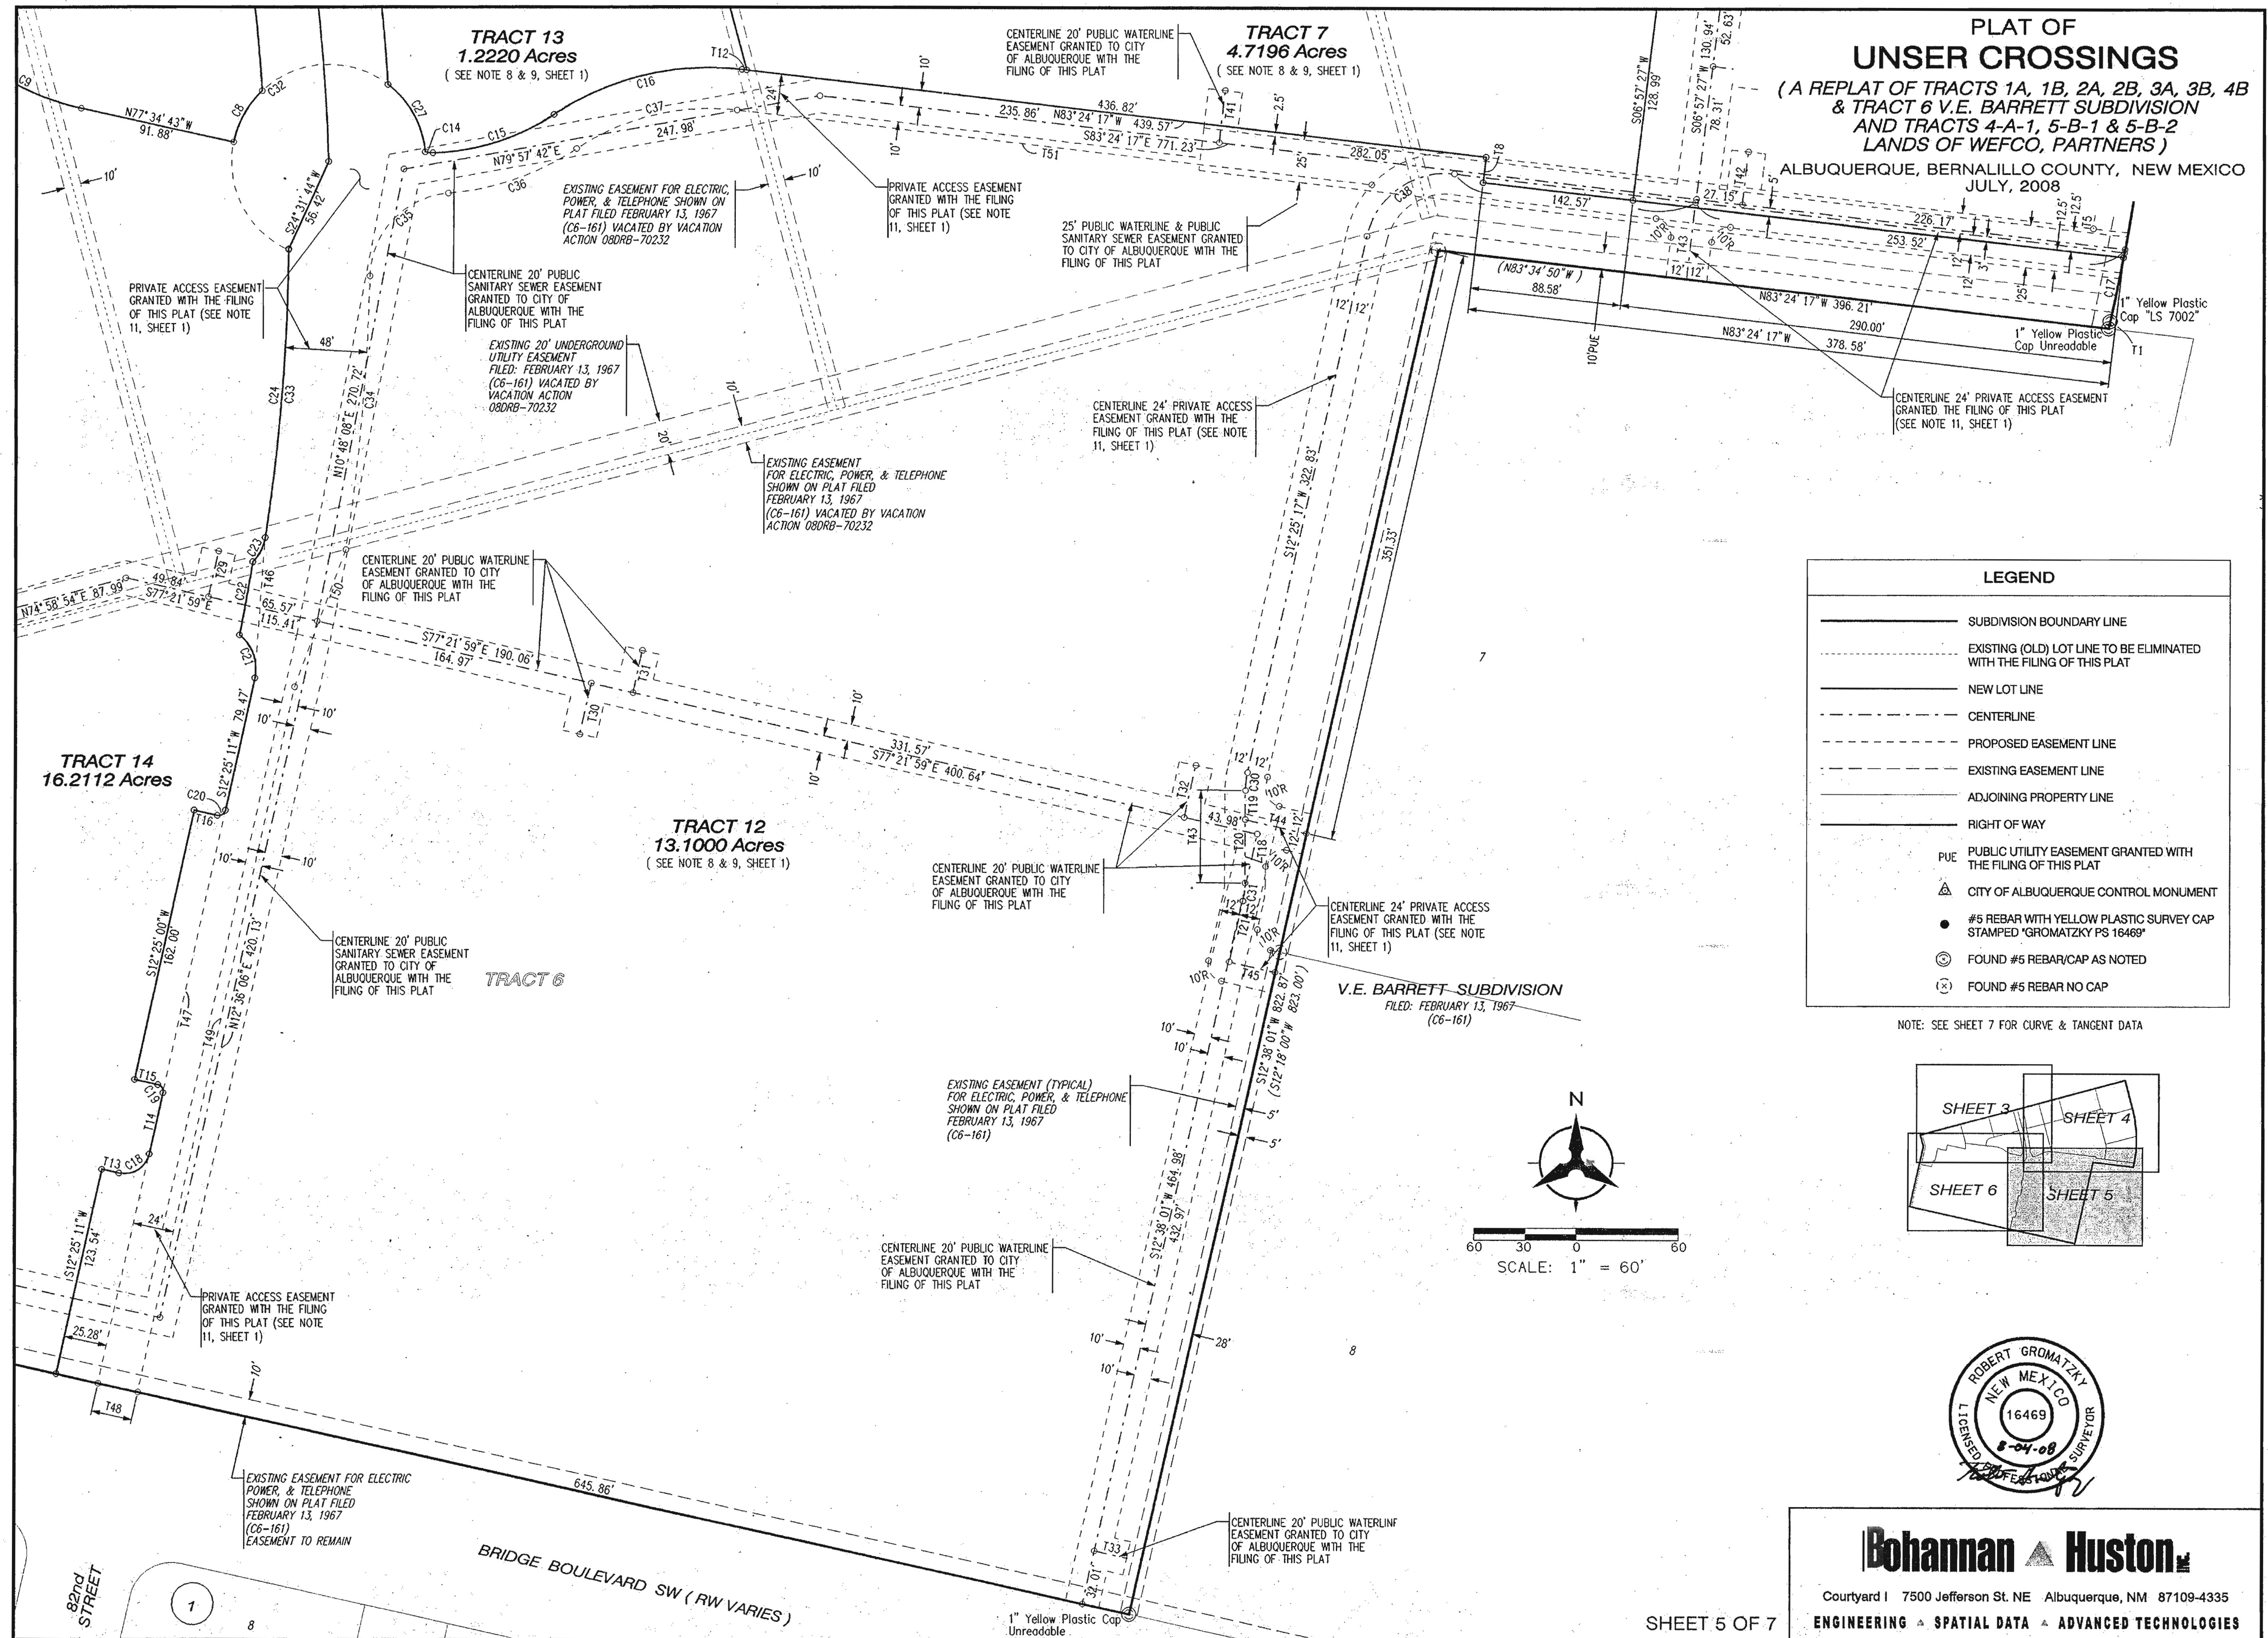

TRACT 13
1.2220 Acres
(SEE NOTE 8, SHEET 1)


PRIVATE ACCESS EASEMENTS
GRANTED WITH THE FILING
OF THIS PLAT (SEE NOTE
11, SHEET 1)

CENTERLINE 20' PUBLIC
SANITARY SEWER EASEMENT
GRANTED TO CITY OF
ALBUQUERQUE WITH THE
FILING OF THIS PLAT

TRACT 12
13.1000 Acres
(SEE NOTE 8, SHEET 1)



60 30 0 60
SCALE: 1" = 60'

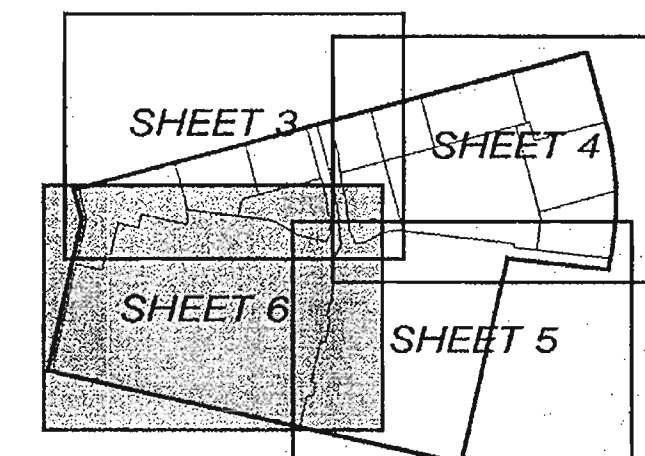


Bohannon Huston

Courtyard I 7500 Jefferson St. NE Albuquerque, NM 87109-4335
ENGINEERING • SPATIAL DATA • ADVANCED TECHNOLOGIES

P:\080289\SURVEY\004 replot\graphics\080289plot06.dgn
31-JUL-2008 -
17:32
mcole

JOB NO. 080289 00

2F of 29

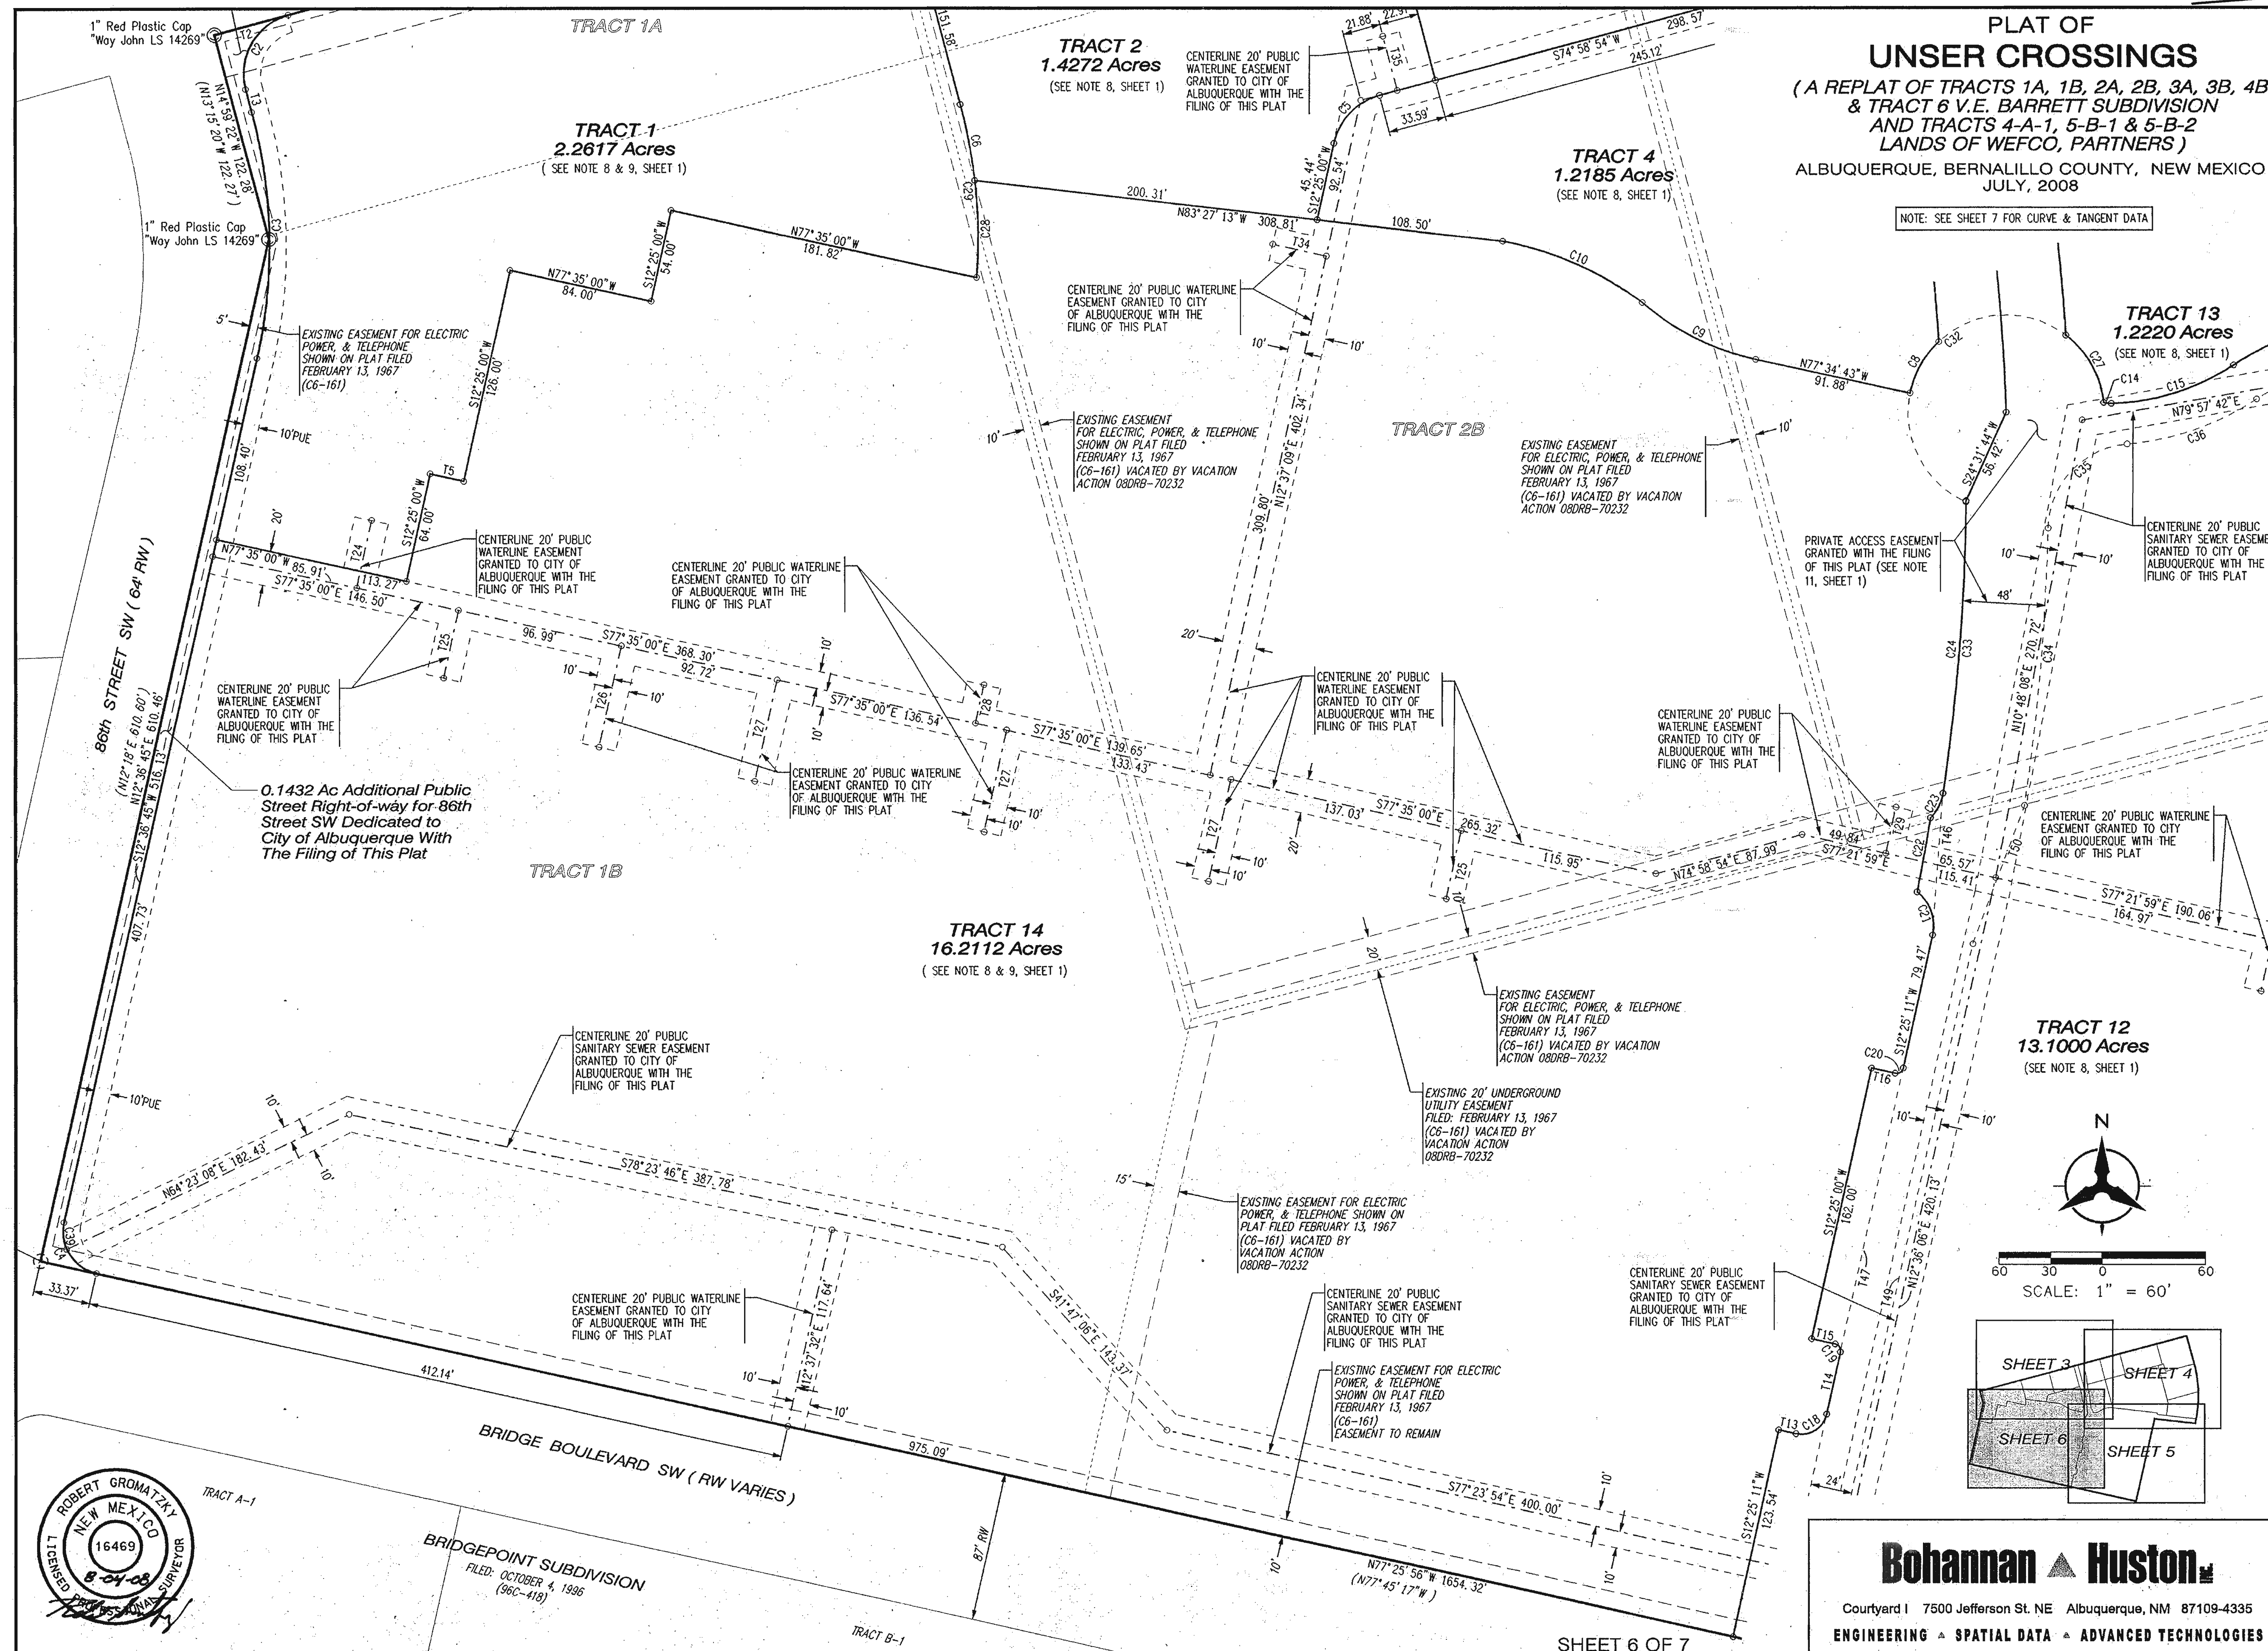

PLAT OF
UNSER CROSSINGS
(A REPLAT OF TRACTS 1A, 1B, 2A, 2B, 3A, 3B, 4B
& TRACT 6 V.E. BARRETT SUBDIVISION
AND TRACTS 4-A-1, 5-B-1 & 5-B-2
LANDS OF WEFCO, PARTNERS)
ALBUQUERQUE, BERNALILLO COUNTY, NEW MEXICO
JULY, 2008

Curve Data						
ID	DELTA	TANGENT	ARC	RADIUS	CHORD	CHORD BRG
C1	27°34'44"	301.66'	591.62'	1229.11'	585.92'	S01°14'45"E
	(27°34'45")	(301.72')	(591.75')	(1229.36')	(586.05')	
C2	89°58'03"	34.98'	54.96'	35.00'	49.48'	S29°59'40"W
C3	27°36'07"	73.69'	144.52'	300.00'	143.13'	S01°11'19"E
C4	90°02'41"	25.02'	39.29'	25.00'	35.37'	S32°24'36"E
C5	62°33'54"	22.48'	40.40'	37.00'	38.43'	S43°41'57"W
C6	08°34'35"	22.49'	44.91'	300.00'	44.86'	N10°43'48"W
C7	09°56'21"	105.47'	210.42'	1213.00'	210.16'	S08°48'37"E
C8	35°08'42"	18.05'	34.96'	57.00'	34.42'	S29°07'40"W
C9	28°29'54"	38.09'	74.61'	150.00'	73.84'	N63°19'46"W
C10	25°49'36"	45.47'	89.40'	198.33'	88.65'	N66°16'01"W
C11	00°31'07"	5.56'	11.12'	1229.11'	11.12'	S14°46'33"E
C12	10°45'24"	115.71'	230.75'	1229.11'	230.41'	S09°08'18"E
C13	14°31'04"	156.56'	311.44'	1229.11'	310.60'	S03°29'56"W
C14	17°10'55"	2.27'	4.50'	15.00'	4.48'	S82°55'32"E
C15	32°05'30"	38.83'	75.61'	135.00'	74.63'	N72°26'16"E
C16	40°12'12"	60.39'	115.78'	165.00'	113.42'	N76°29'37"E
C17	01°47'09"	19.16'	38.31'	1229.11'	38.31'	S11°39'02"W
C18	90°00'00"	15.00'	23.56'	15.00'	21.21'	N57°25'11"E
C19	90°00'11"	4.00'	6.28'	4.00'	5.66'	N32°34'54"W
C20	89°59'49"	4.00'	6.28'	4.00'	5.66'	N57°25'06"E
C21	64°30'23"	15.78'	28.15'	25.00'	26.68'	N19°50'00"W
C22	02°03'08"	21.87'	43.73'	1221.00'	43.73'	N10°15'24"E
C23	37°13'34"	8.42'	16.24'	25.00'	15.96'	N27°08'02"E
C24	07°58'50"	85.52'	170.77'	1226.00'	170.63'	N04°31'50"E
C25	13°11'43"	144.58'	287.88'	1250.00'	287.24'	N08°25'14"W
C26	10°05'13"	113.58'	226.58'	1287.00'	226.28'	S08°49'31"E
C27	46°40'10"	24.59'	46.43'	57.00'	45.16'	S28°59'58"E
C28	10°45'54"	28.27'	56.37'	300.00'	56.28'	N01°03'34"W
C29	19°20'29"	51.12'	101.27'	300.00'	100.79'	S05°20'51"E
C30	12°11'31"	5.34'	10.64'	50.00'	10.62'	S06°19'32"W
C31	12°24'15"	5.43'	10.82'	50.00'	10.80'	S06°25'54"W
C32	240°04'00"	-----	238.83'	57.00'	98.69'	S54°18'07"W
C33	07°57'03"	85.20'	170.13'	1226.00'	169.99'	S04°32'43"W
C34	07°17'09"	81.11'	162.00'	1274.00'	161.89'	N04°52'40"E
C35	84°10'26"	45.16'	73.46'	50.00'	67.03'	N43°19'19"E
C36	29°01'01"	41.15'	80.52'	159.00'	79.67'	N70°54'02"E
C37	40°12'12"	51.60'	98.94'	141.00'	96.92'	N76°29'37"E
C38	84°10'26"	42.45'	69.05'	47.00'	63.00'	S54°30'30"W
C39	36°54'18"	8.34'	16.10'	25.00'	15.83'	N05°50'24"W
C40	03°05'50"	33.23'	66.44'	1229.11'	66.43'	N02°12'42"W
C41	11°19'05"	12.88'	25.68'	130.00'	25.64'	S04°59'46"W
C42	08°56'47"	12.71'	25.37'	162.50'	25.35'	S06°10'55"W
C43	06°57'21"	74.43'	148.67'	1224.61'	148.58'	S05°11'12"W
C44	80°41'45"	16.99'	28.17'	20.00'	25.90'	S49°00'45"W

Tangent Data		
ID	BEARING	DISTANCE
T1	S12°48'38"W	4.37'
	(S12°48'43"W)	(3.87')
T2	N74°58'41"E	44.41'
T3	S14°59'22"E	13.60'
T4	N19°33'49"W	30.14'
T5	N77°35'00"W	20.00'
T6	N19°33'49"W	16.62'
T7	N19°33'49"W	13.52'
T8	S06°35'43"W	15.00'
T9	S74°58'54"W	41.76'
T10	S74°58'54"W	15.00'
T11	S74°58'54"W	56.76'
T12	N83°24'17"W	2.76'
T13	N77°34'49"W	10.28'
T14	S12°25'11"W	37.09'
T15	N77°35'00"W	14.00'
T16	N77°35'00"W	14.01'
T17	N06°50'20"W	13.22'
T18	S00°13'46"W	37.25'
T19	S00°13'46"W	17.00'
T20	S00°13'46"W	54.25'
T21	S12°38'01"W	36.53'
T22	S15°01'45"E	18.65'
T23	S15°01'45"E	11.44'
T24	N12°25'00"E	40.43'
T25	S12°25'00"W	40.49'
T26	S12°25'00"W	60.50'
T27	S12°25'00"W	60.51'
T28	N12°25'00"E	23.00'
T29	N12°38'01"E	27.37'
T30	S12°38'01"W	30.67'
T31	N12°38'01"E	25.29'
T32	N12°38'01"E	31.32'
T33	S77°21'59"E	19.59'
T34	N77°22'51"W	31.85'
T35	N15°01'06"W	32.50'
T36	S15°01'06"E	42.63'
T37	S74°58'15"W	29.92'
T38	N74°58'15"E	37.51'
T39	N74°58'15"E	37.50'
T40	S83°02'33"E	37.77'
T41	N06°35'43"E	30.83'
T42	N06°35'43"E	31.10'
T43	N06°35'43"E	45.58'
T44	S77°11'06"E	36.67'
T45	S77°25'56"E	27.50'
T46	S04°10'34"W	82.55'
T47	S12°25'11"W	425.17'
T48	S77°25'56"E	24.00'
T49	N12°25'11"E	425.23'
T50	N20°29'35"E	85.82'
T51	S83°24'17"E	374.78'
T52	S06°35'43"W	10.88'

Bohannon  Huston

Courtyard I 7500 Jefferson St. NE Albuquerque, NM 87109-4335

ENGINEERING • SPATIAL DATA • ADVANCED TECHNOLOGIES

SHEET 7 OF 7

P:\080289\SURVEY\004 replat\graphics\080289plot07.dgn
31-JUL-2008 17:33
mcole


JOB NO. 080289 004

DISA
Darren Sowell
ARCHITECTS
4700 Lincoln N.E., Suite 111
Albuquerque, N.M. 87109
Phone: (505) 342-6200
Fax: (505) 342-6201

Bohannon & Huston
ENGINEERING • SPATIAL DATA • ADVANCED TECHNOLOGIES

Mitchell Associates, LLC
Landscape Architects
Cortado Blvd. NE, Suite 112
Albuquerque, NM 87110
Phone: (505) 838-6956
darryl@mitassoc.com

ARMSTRONG DEVELOPMENT
PROPERTIES, INC.

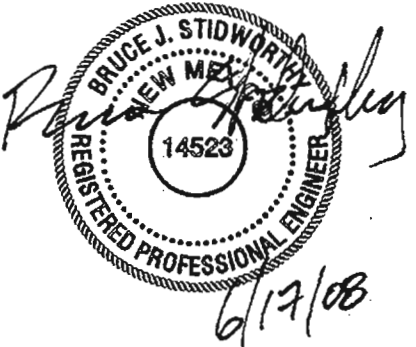

Unser Crossing
DRB Submittal
Site Plan for Building Permit
Central Avenue and Unser Boulevard
Albuquerque, New Mexico 87121

Job Number
Drawn By BO
Checked RM/BJJS
Issue Date June 17, 2008


CONCEPTUAL
GRAVING
PLAN

Scale


C-101

KEYED NOTES


1. STORM DRAIN INLET.
2. STORM DRAIN MANHOLE.
3. STORM DRAIN MANHOLE WITH SLOTTED COVER.
4. STUB ROOF DRAIN TO WITHIN 5' OF BUILDING.
5. STUB STORM DRAIN TO 10' BEYOND PROPERTY LINE.
6. CONNECT EXISTING STORM DRAIN CULVERTS TO NEW JUNCTION BOX. CONNECT JUNCTION BOX TO EXISTING STORM DRAIN IN UNSER BLVD. THIS WORK SHALL BE COMPLETED WITH PUBLIC INFRASTRUCTURE PLANS.
7. RETAINING WALL.
8. TYPE DOUBLE A INLET
9. TYPE C INLET
10. EXISTING DROP INLET TO REMAIN

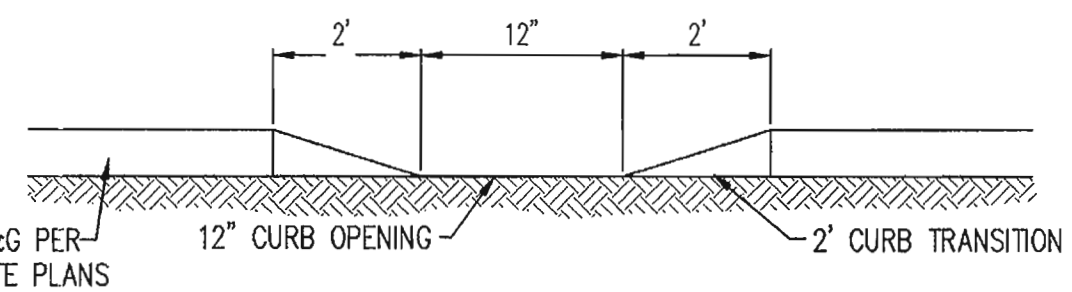

1 TYPICAL CURB CUT DETAIL
N.T.S.

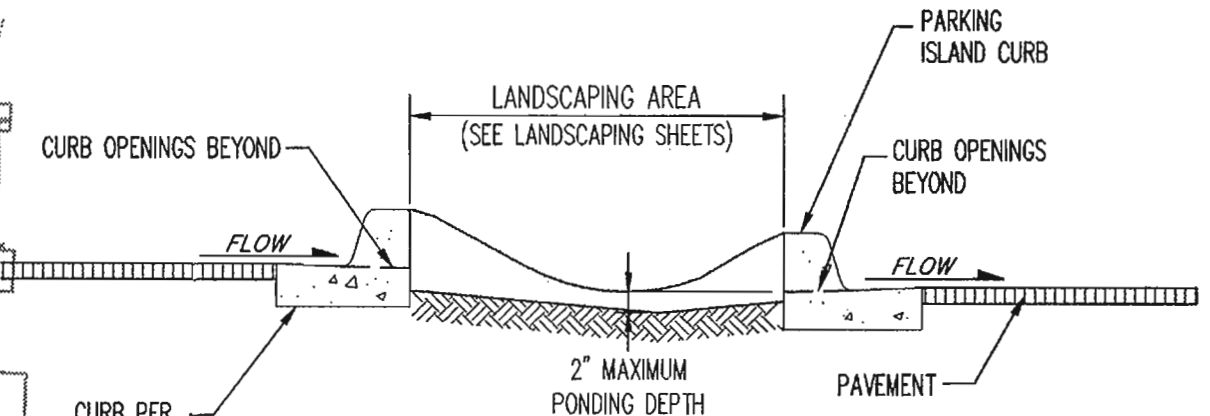



CROSS SECTION
N.T.S.

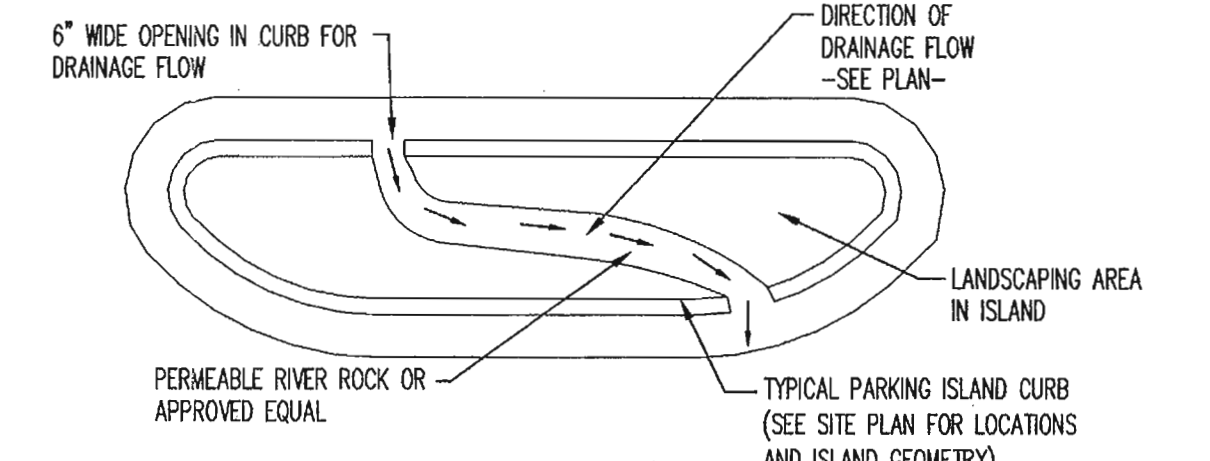



PLAN VIEW
N.T.S.

2 TYPICAL WATER HARVESTING DETAIL
N.T.S.

- LEGEND
- PROPERTY LINE
 - - - 5301 - - - EXISTING CONTOURS
 - X 5301.15 EXISTING GROUND SPOT ELEVATION
 - EXISTING ELECTRICAL POLE
 - 65.23 PROPOSED SPOT ELEVATION
 - TC=TOP OF CURB, FL=FLOW LINE
 - TW=TOP OF WALL, BW=BOTTOM OF WALL
 - EX=EXISTING, TG=TOP OF GRADE
 - S=2.0% PROPOSED DIRECTION OF FLOW
 - WATER BLOCK
 - 5305 --- PROPOSED RETAINING WALL
 - 5305 --- PROPOSED INDEX CONTOURS
 - PROPOSED INTER CONTOURS
 - PROPOSED CURB & GUTTER
 - - - EASEMENT
 - EXISTING TREE
 - SD PROPOSED STORM DRAIN LINE
 - PROPOSED STORM DRAIN MANHOLE
 - PROPOSED STORM DRAIN INLET
 - ⊙ EXISTING STORM DRAIN MANHOLE

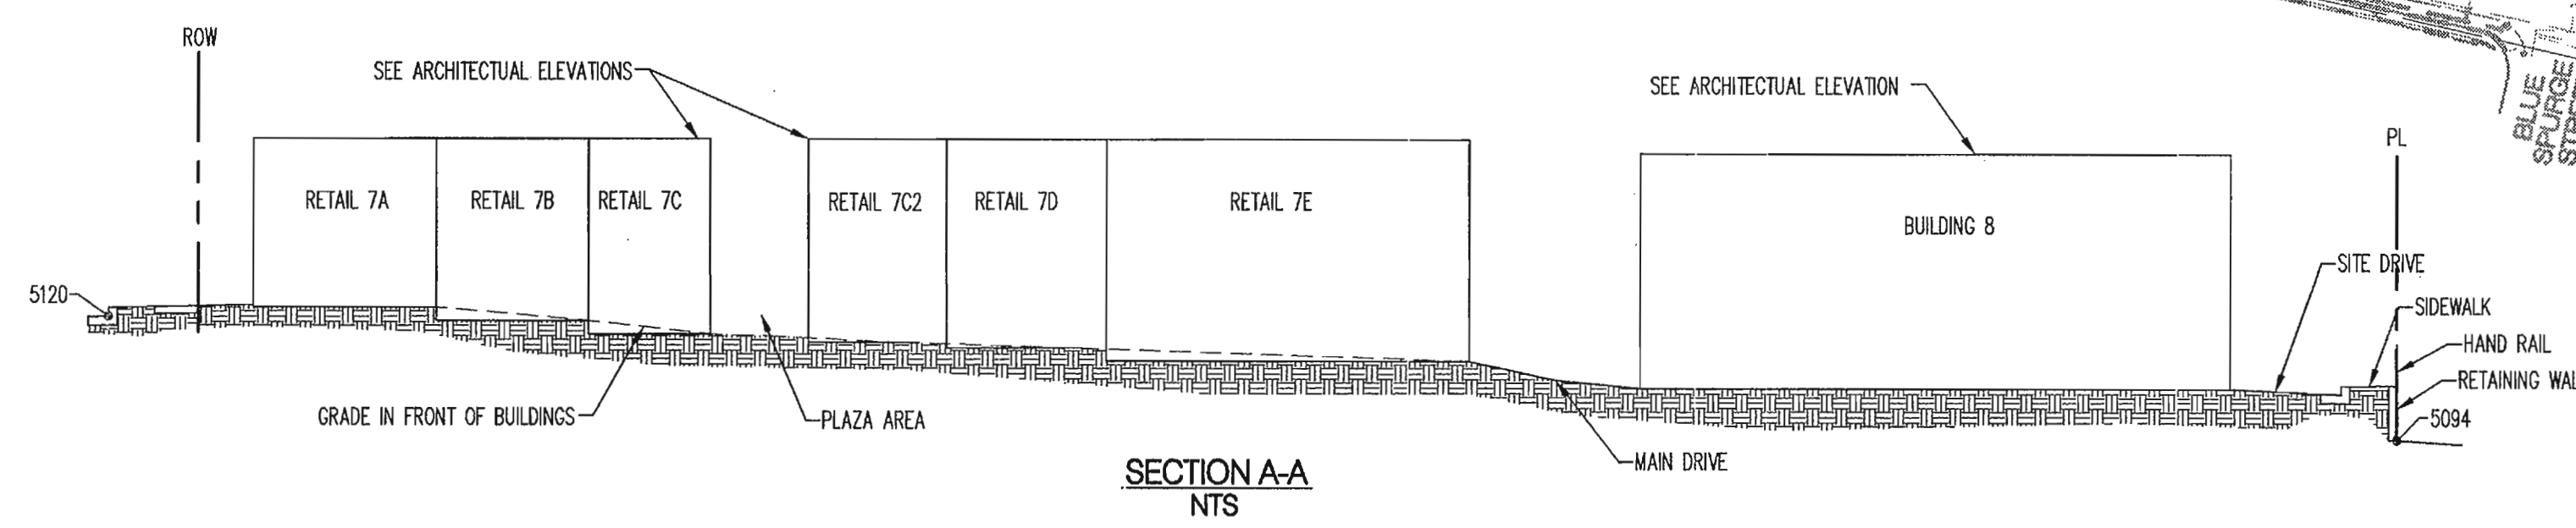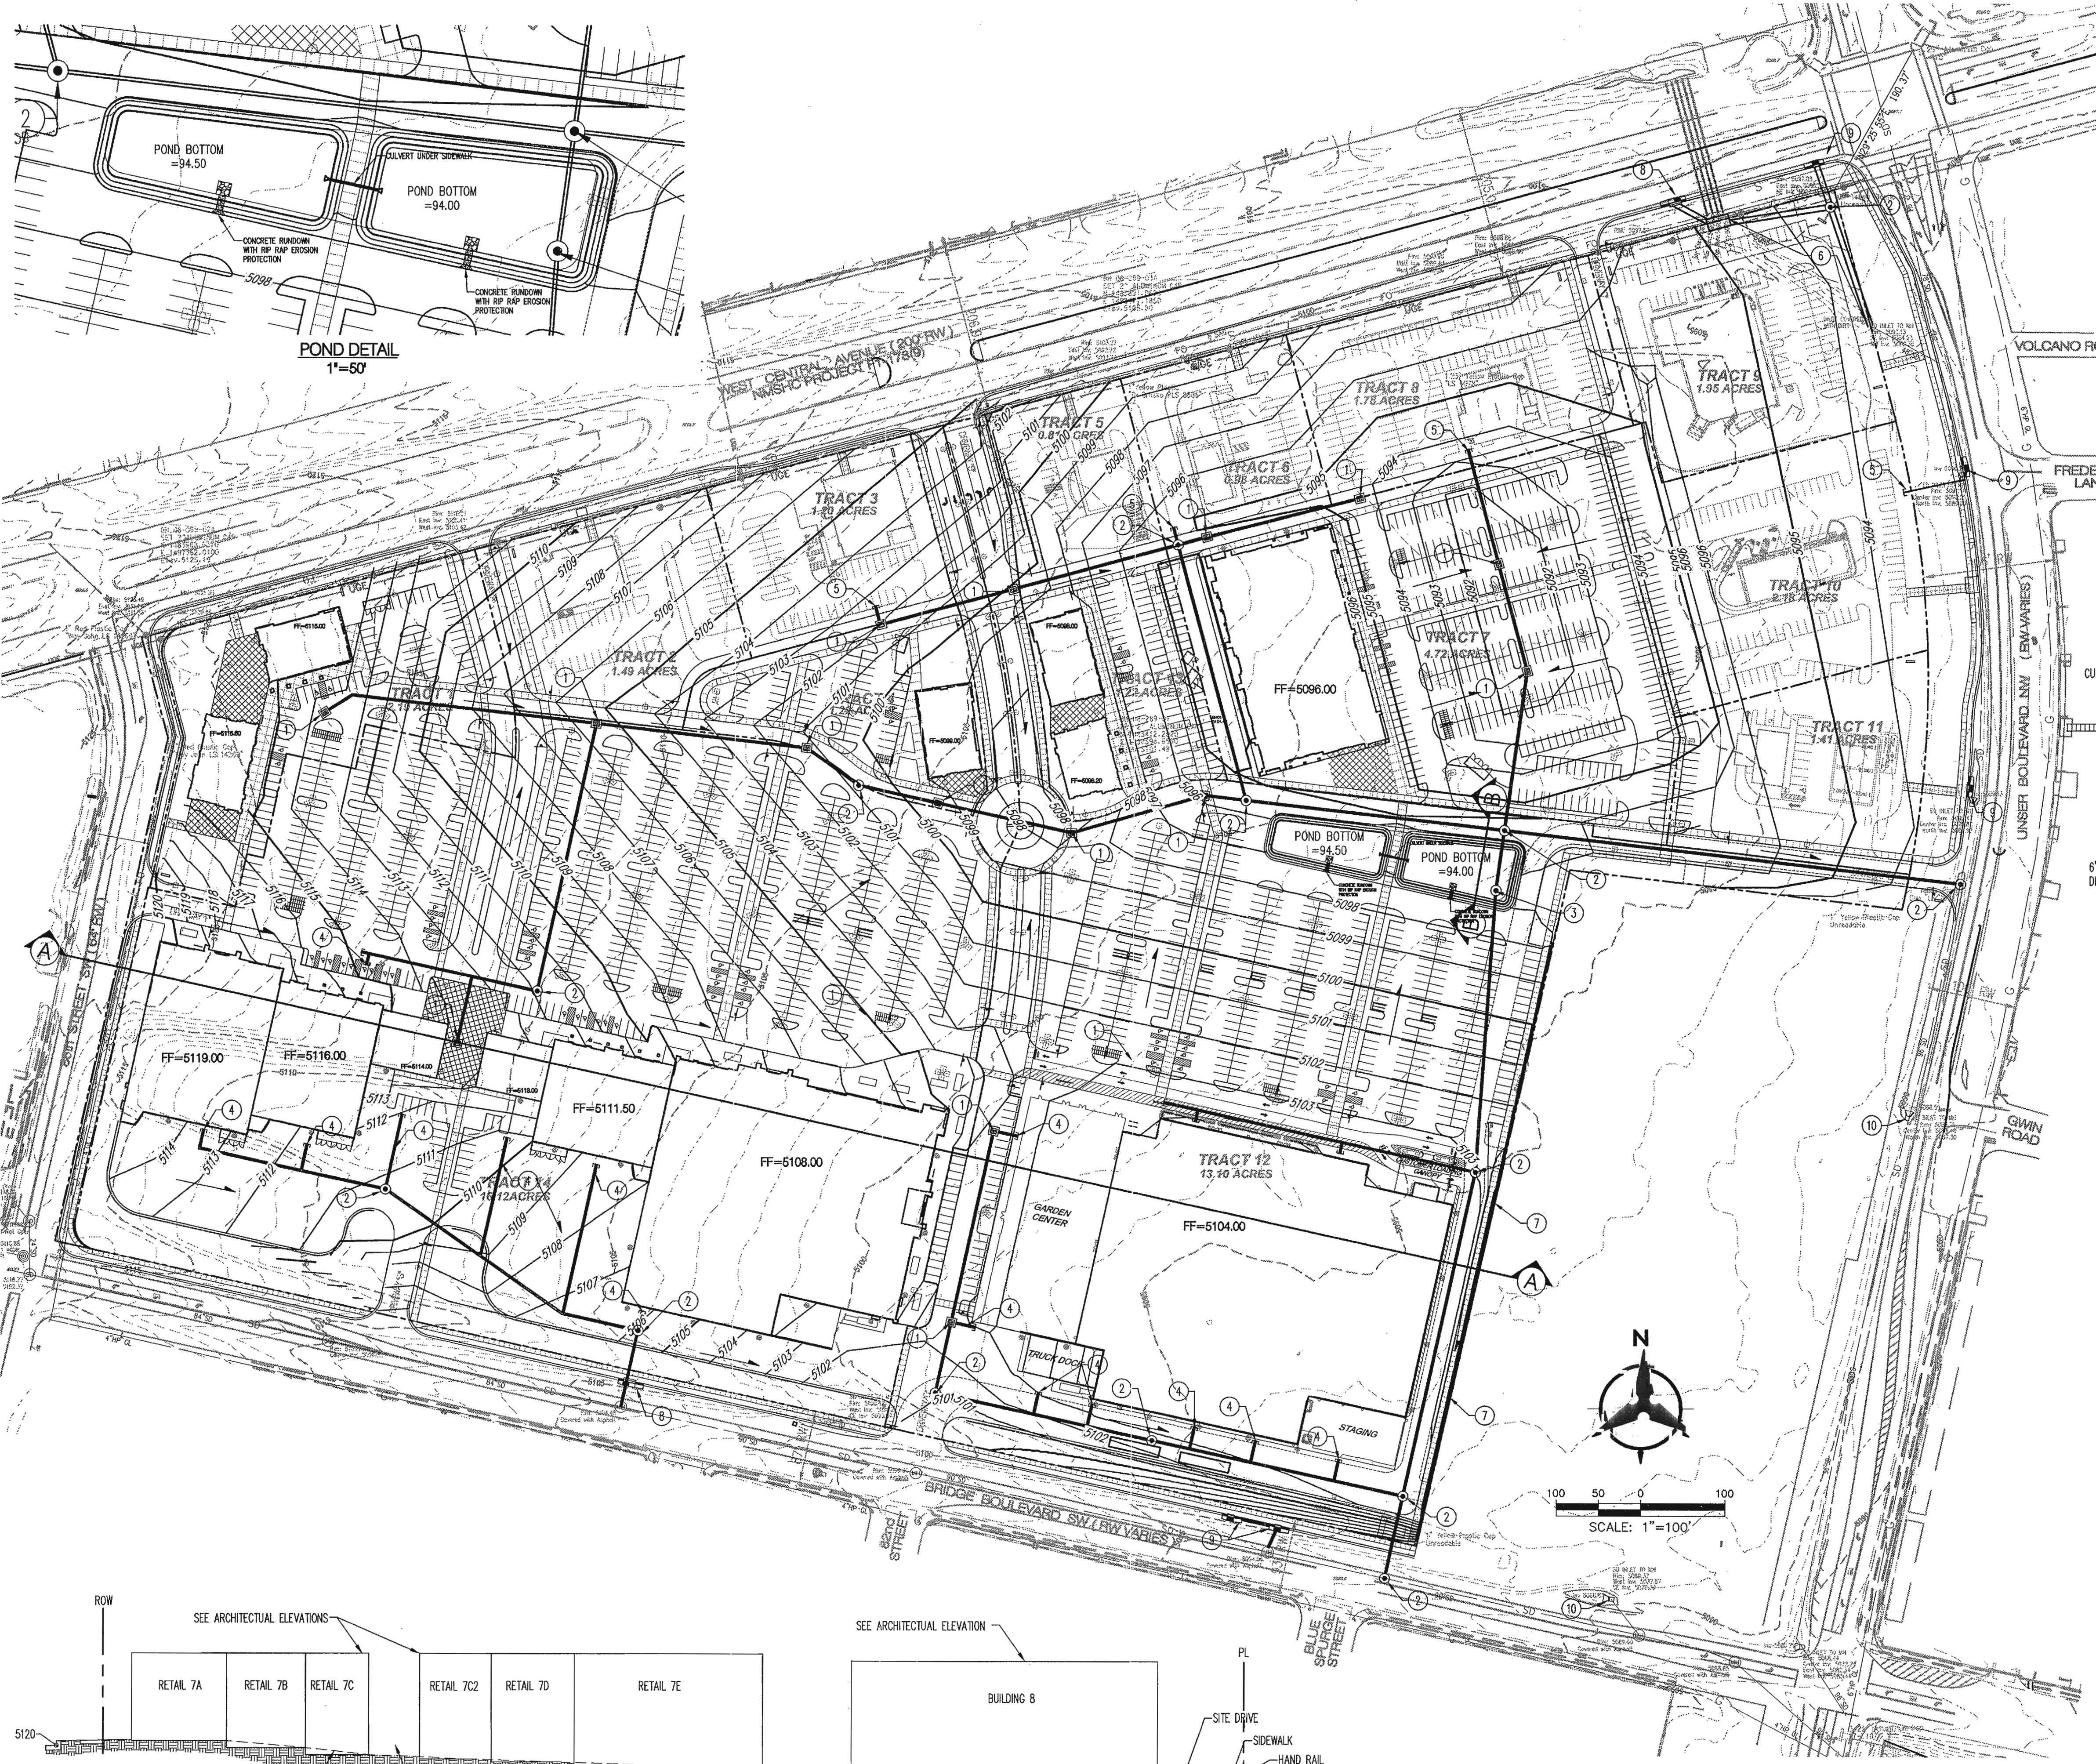


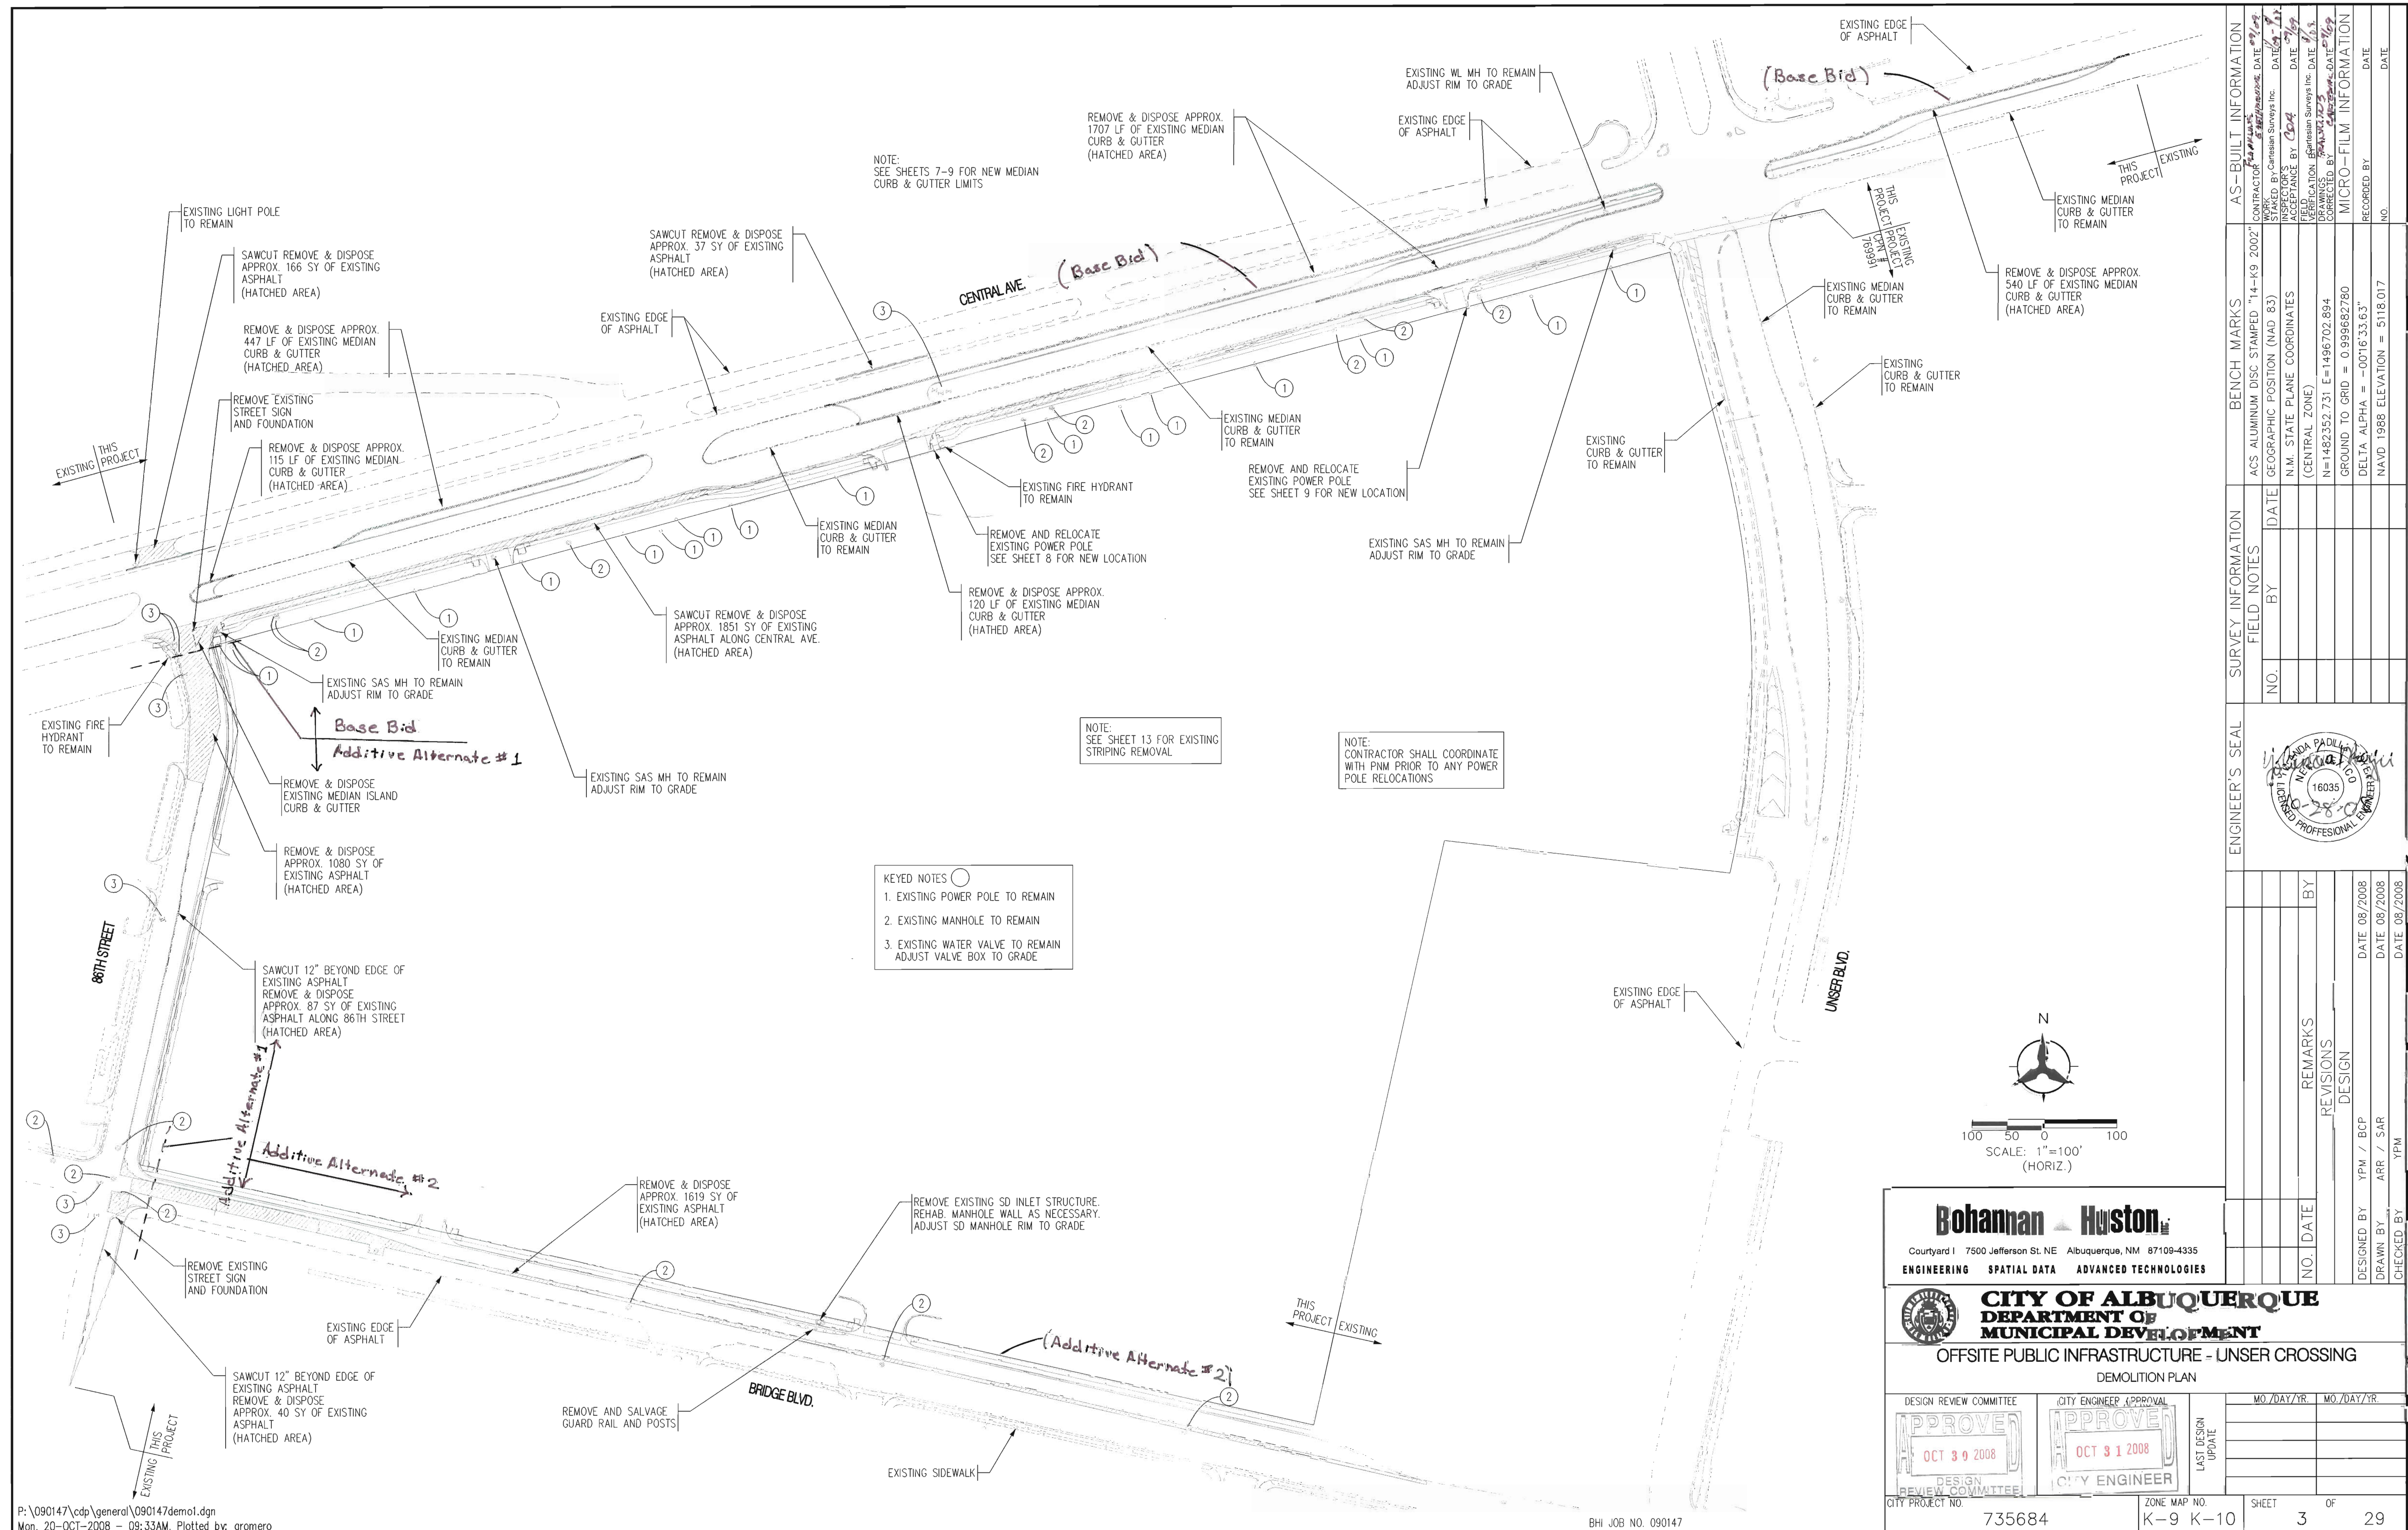


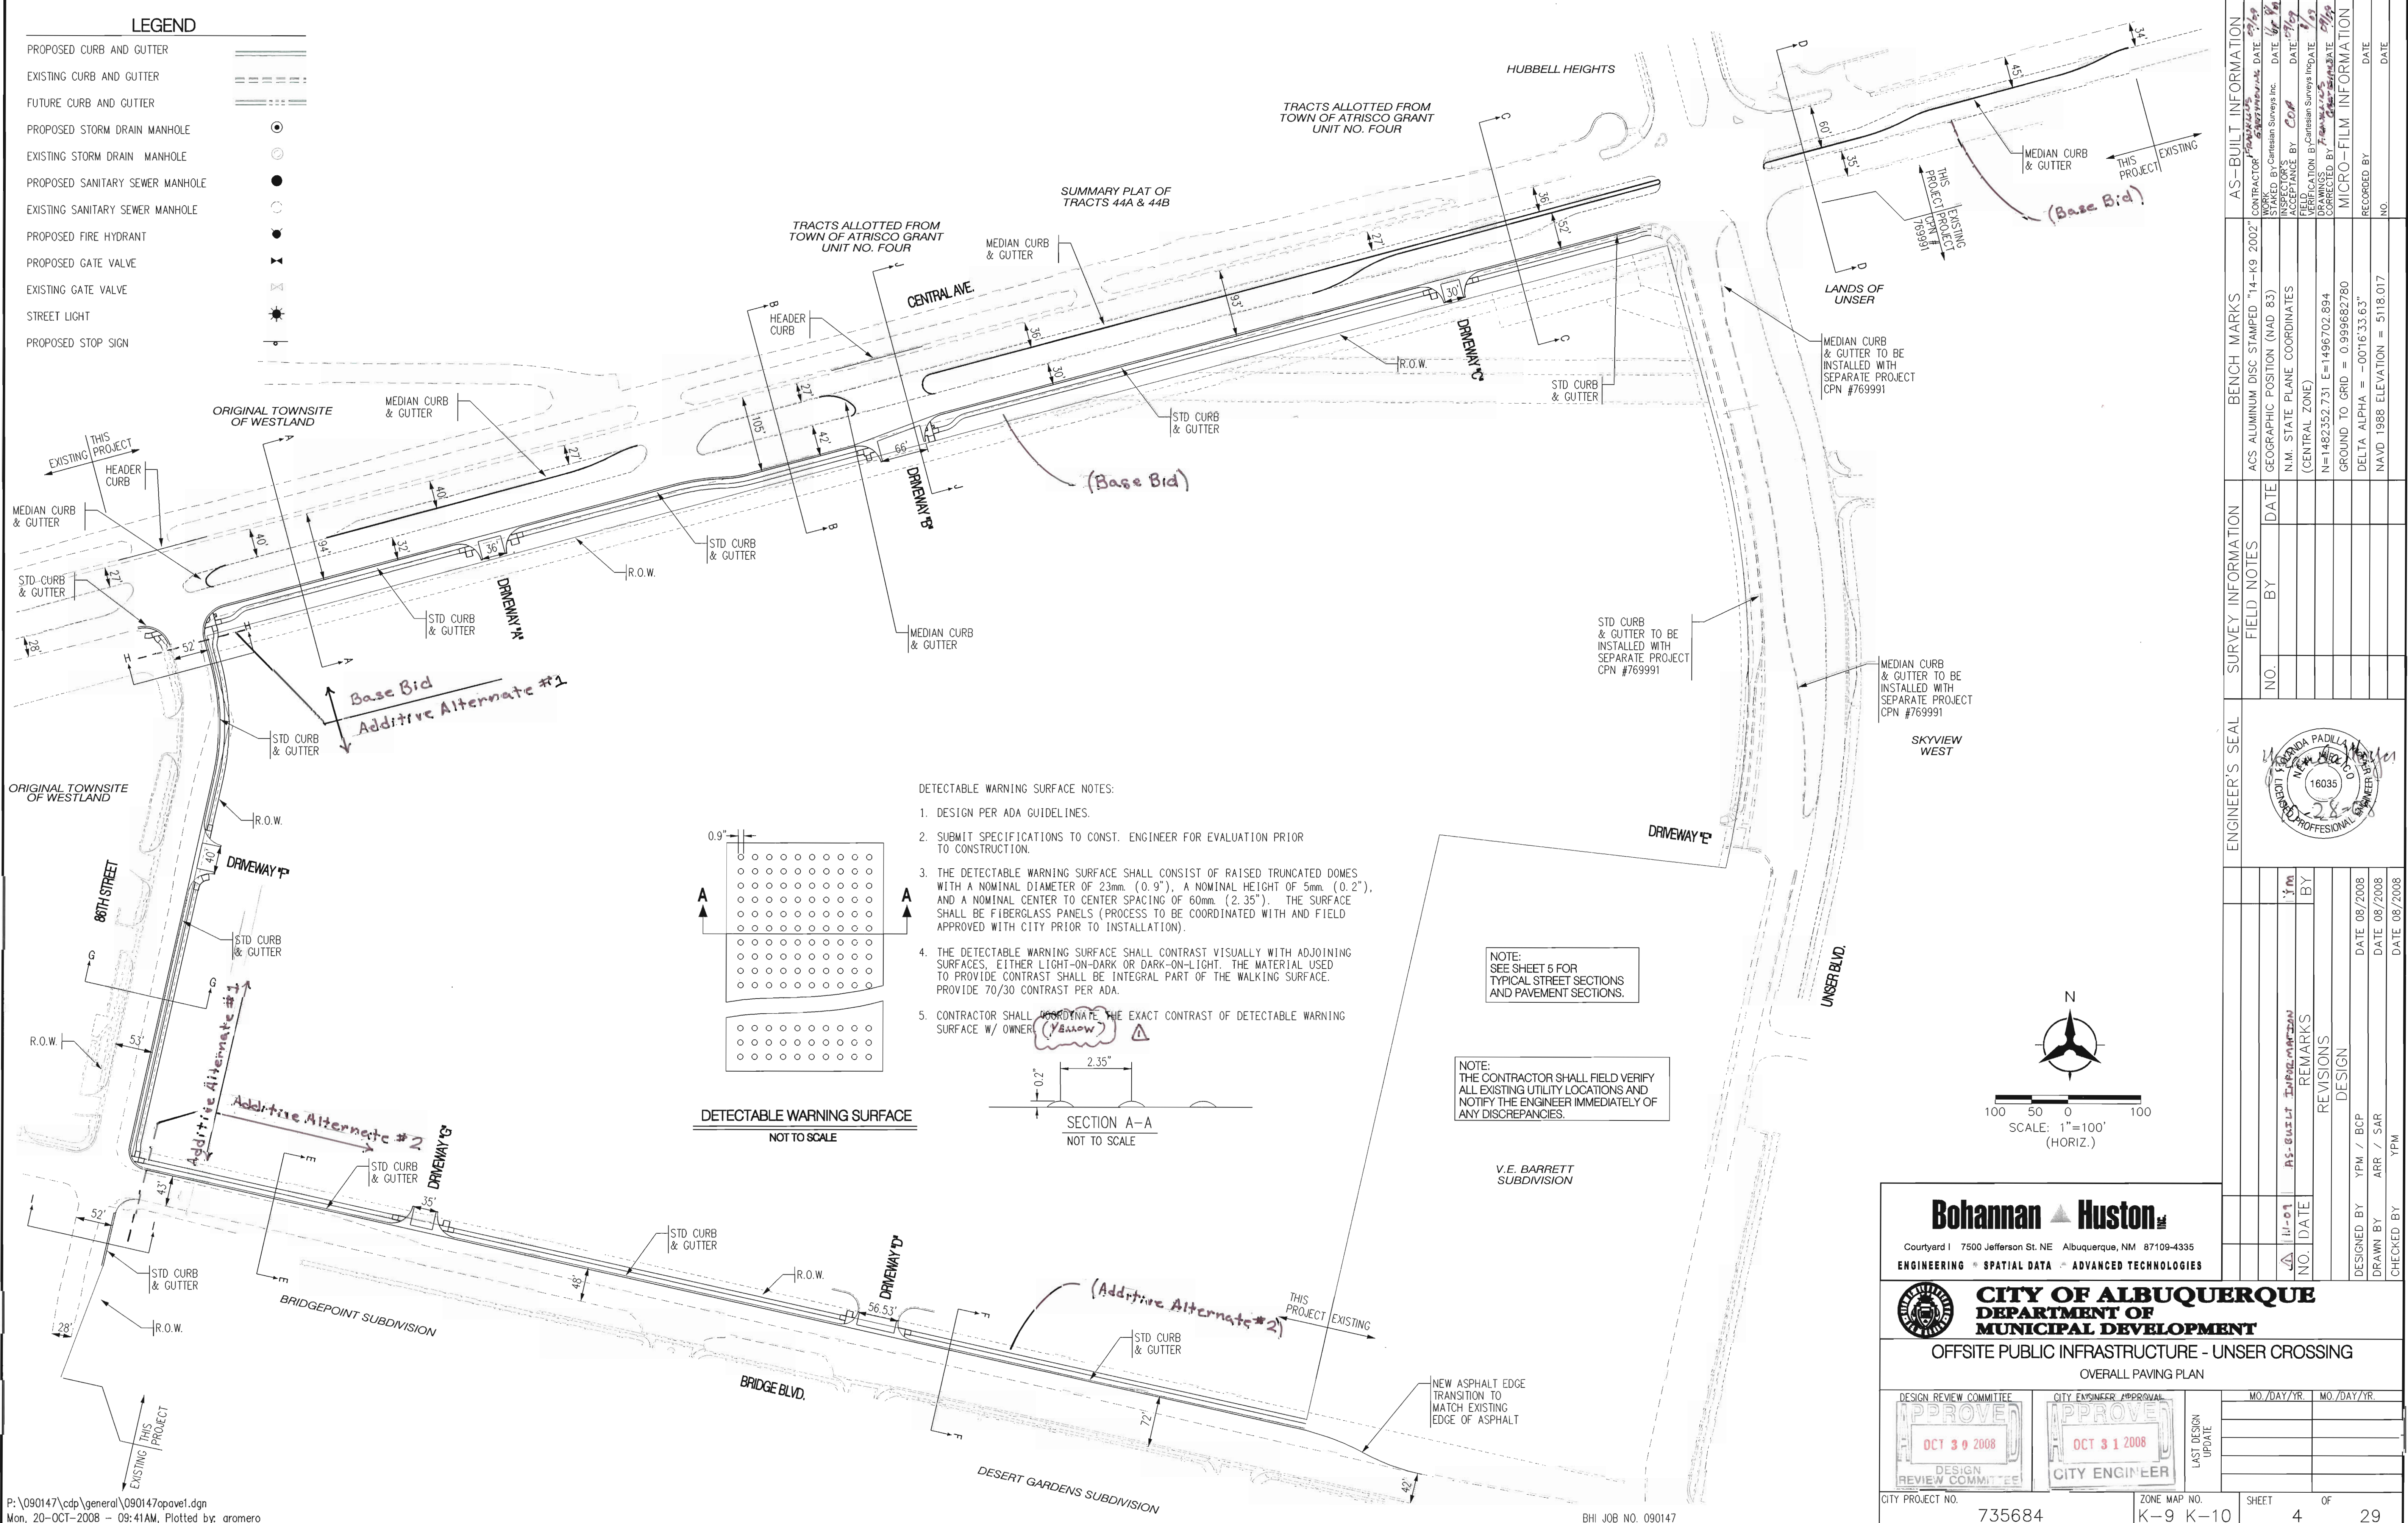

LEGEND


PROPOSED CURB AND GUTTER	=====
EXISTING CURB AND GUTTER	-----
FUTURE CURB AND GUTTER	----
PROPOSED STORM DRAIN MANHOLE	○
EXISTING STORM DRAIN MANHOLE	○
PROPOSED SANITARY SEWER MANHOLE	●
EXISTING SANITARY SEWER MANHOLE	●
PROPOSED FIRE HYDRANT	●
PROPOSED GATE VALVE	⋈
EXISTING GATE VALVE	⋈
STREET LIGHT	⊙
PROPOSED STOP SIGN	⊙

- DETECTABLE WARNING SURFACE NOTES:
1. DESIGN PER ADA GUIDELINES.
 2. SUBMIT SPECIFICATIONS TO CONST. ENGINEER FOR EVALUATION PRIOR TO CONSTRUCTION.
 3. THE DETECTABLE WARNING SURFACE SHALL CONSIST OF RAISED TRUNCATED DOWNS WITH A NOMINAL DIAMETER OF 23mm (0.9"), A NOMINAL HEIGHT OF 5mm (0.2"), AND A NOMINAL CENTER TO CENTER SPACING OF 60mm (2.35"). THE SURFACE SHALL BE FIBERGLASS PANELS (PROCESS TO BE COORDINATED WITH AND FIELD APPROVED WITH CITY PRIOR TO INSTALLATION).
 4. THE DETECTABLE WARNING SURFACE SHALL CONTRAST VISUALLY WITH ADJOINING SURFACES, EITHER LIGHT-ON-DARK OR DARK-ON-LIGHT. THE MATERIAL USED TO PROVIDE CONTRAST SHALL BE INTEGRAL PART OF THE WALKING SURFACE. PROVIDE 70/30 CONTRAST PER ADA.
 5. CONTRACTOR SHALL COORDINATE THE EXACT CONTRAST OF DETECTABLE WARNING SURFACE W/ OWNER.

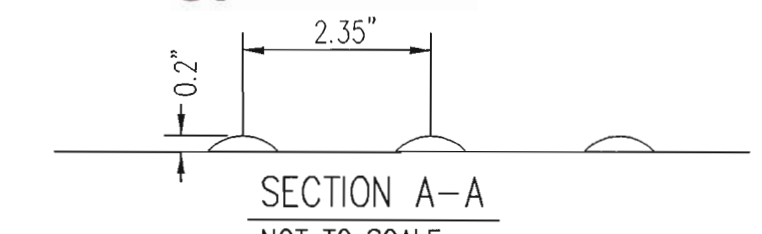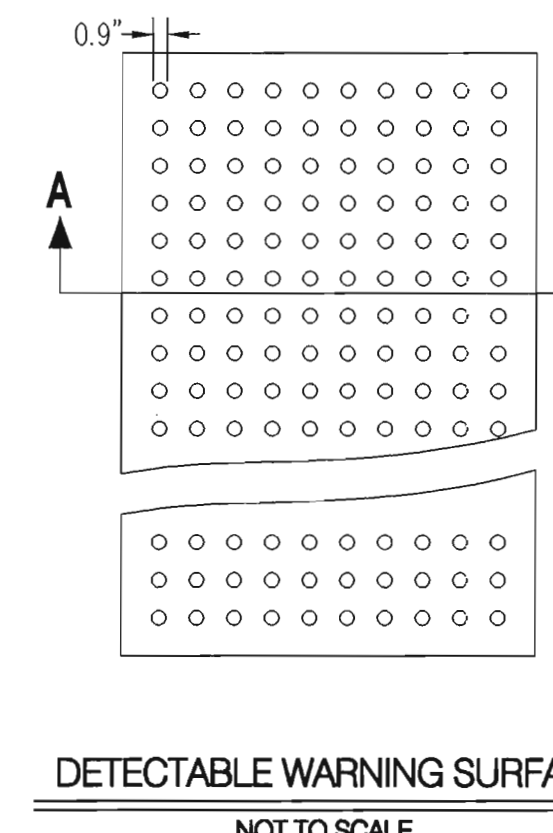

NOTE: SEE SHEET 6 FOR TYPICAL STREET SECTIONS AND PAVEMENT SECTIONS.

NOTE: THE CONTRACTOR SHALL FIELD VERIFY ALL EXISTING UTILITY LOCATIONS AND NOTIFY THE ENGINEER IMMEDIATELY OF ANY DISCREPANCIES.

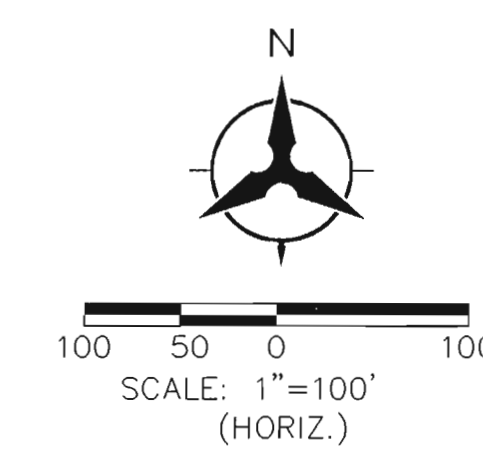

AS-BUILT INFORMATION				BENCH MARKS				SURVEY INFORMATION				ENGINEER'S SEAL			
CONTRACTOR	DATE	STAMPED BY	DATE	ACS ALUMINUM DISC STAMPED "14-K9 2002"	GEORGIC POSITION (NAD 83)	N.M. STATE PLANE COORDINATES	(CENTRAL ZONE)	NO.	DATE	BY	DATE	NO.	DATE	BY	DATE
STAKED BY	DATE	ACCEPTANCE BY	DATE												
FIELD CHECKED BY	DATE	FIELD CHECKED BY	DATE												
DESIGNED BY	DATE	DESIGNED BY	DATE												
DRAWN BY	DATE	DRAWN BY	DATE												
CHECKED BY	DATE	CHECKED BY	DATE												
RECORDED BY	DATE	RECORDED BY	DATE												
NO.	DATE	NO.	DATE												

Bohannon & Huston
Courtyard | 7500 Jefferson St. NE | Albuquerque, NM 87109-4335
ENGINEERING • SPATIAL DATA • ADVANCED TECHNOLOGIES





CITY OF ALBUQUERQUE
DEPARTMENT OF MUNICIPAL DEVELOPMENT
OFFSITE PUBLIC INFRASTRUCTURE - UNSER CROSSING
OVERALL PAVING PLAN

DESIGN REVIEW COMMITTEE
APPROVE
OCT 30 2008
DESIGN REVIEW COMMITTEE

CITY ENGINEER APPROVAL
APPROVE
OCT 31 2008
CITY ENGINEER

LAST DESIGN UPDATE

CITY PROJECT NO.	735684	ZONE MAP NO.	K-9 K-10	SHEET	4	OF	29
------------------	--------	--------------	----------	-------	---	----	----






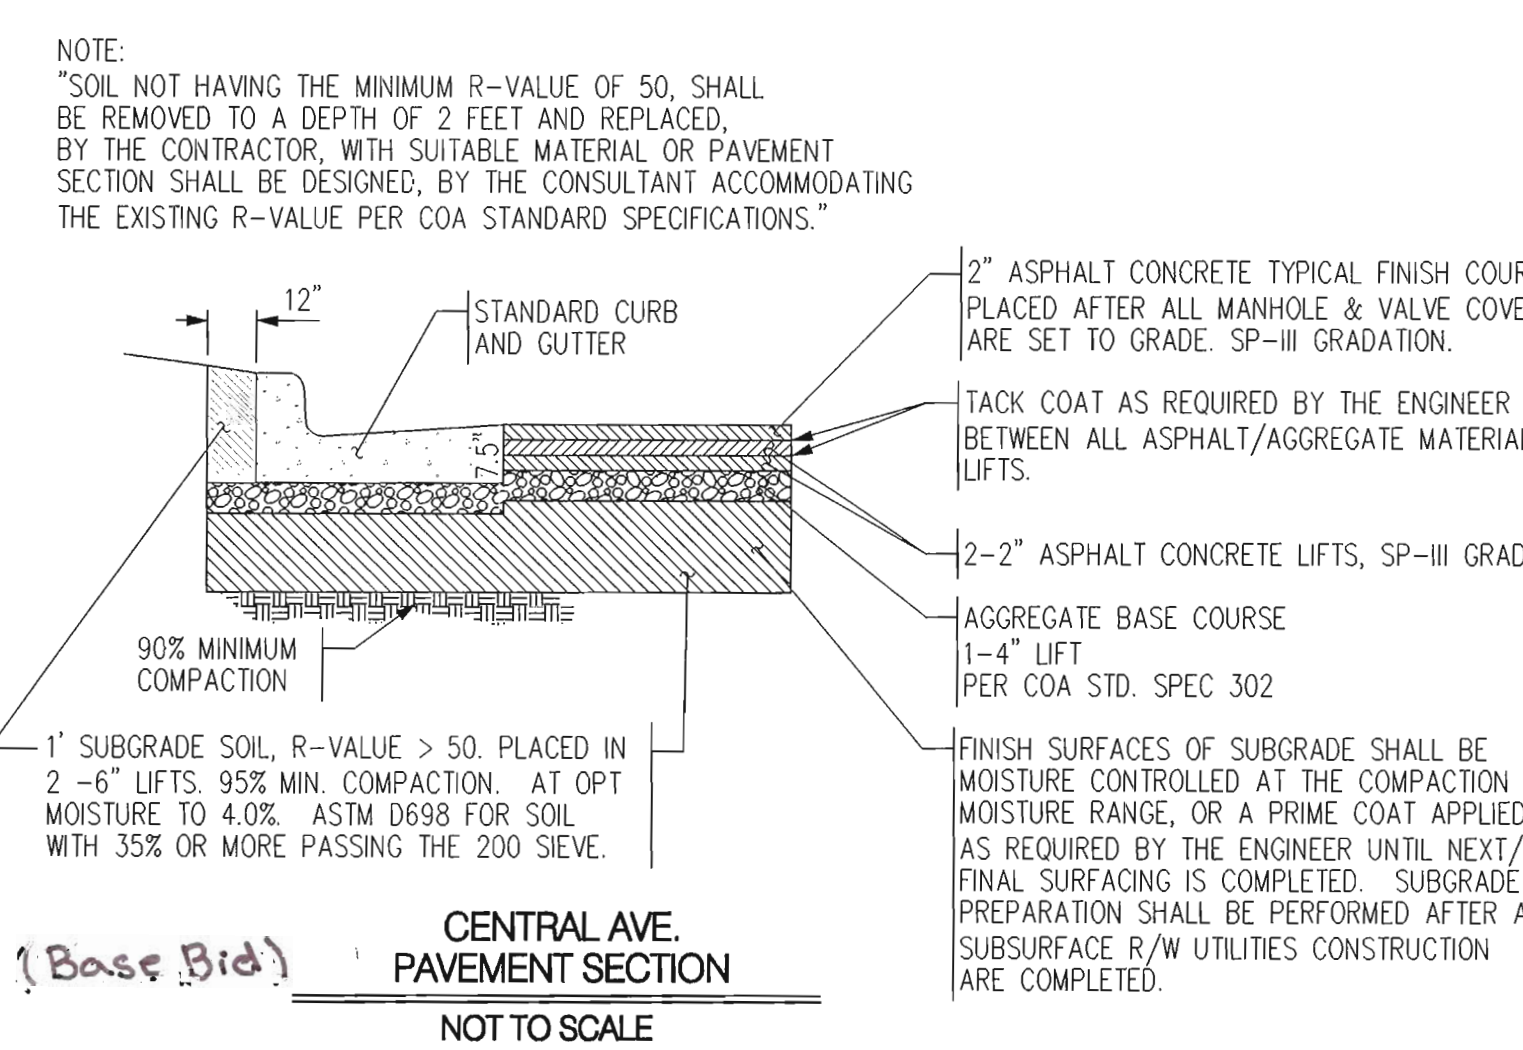
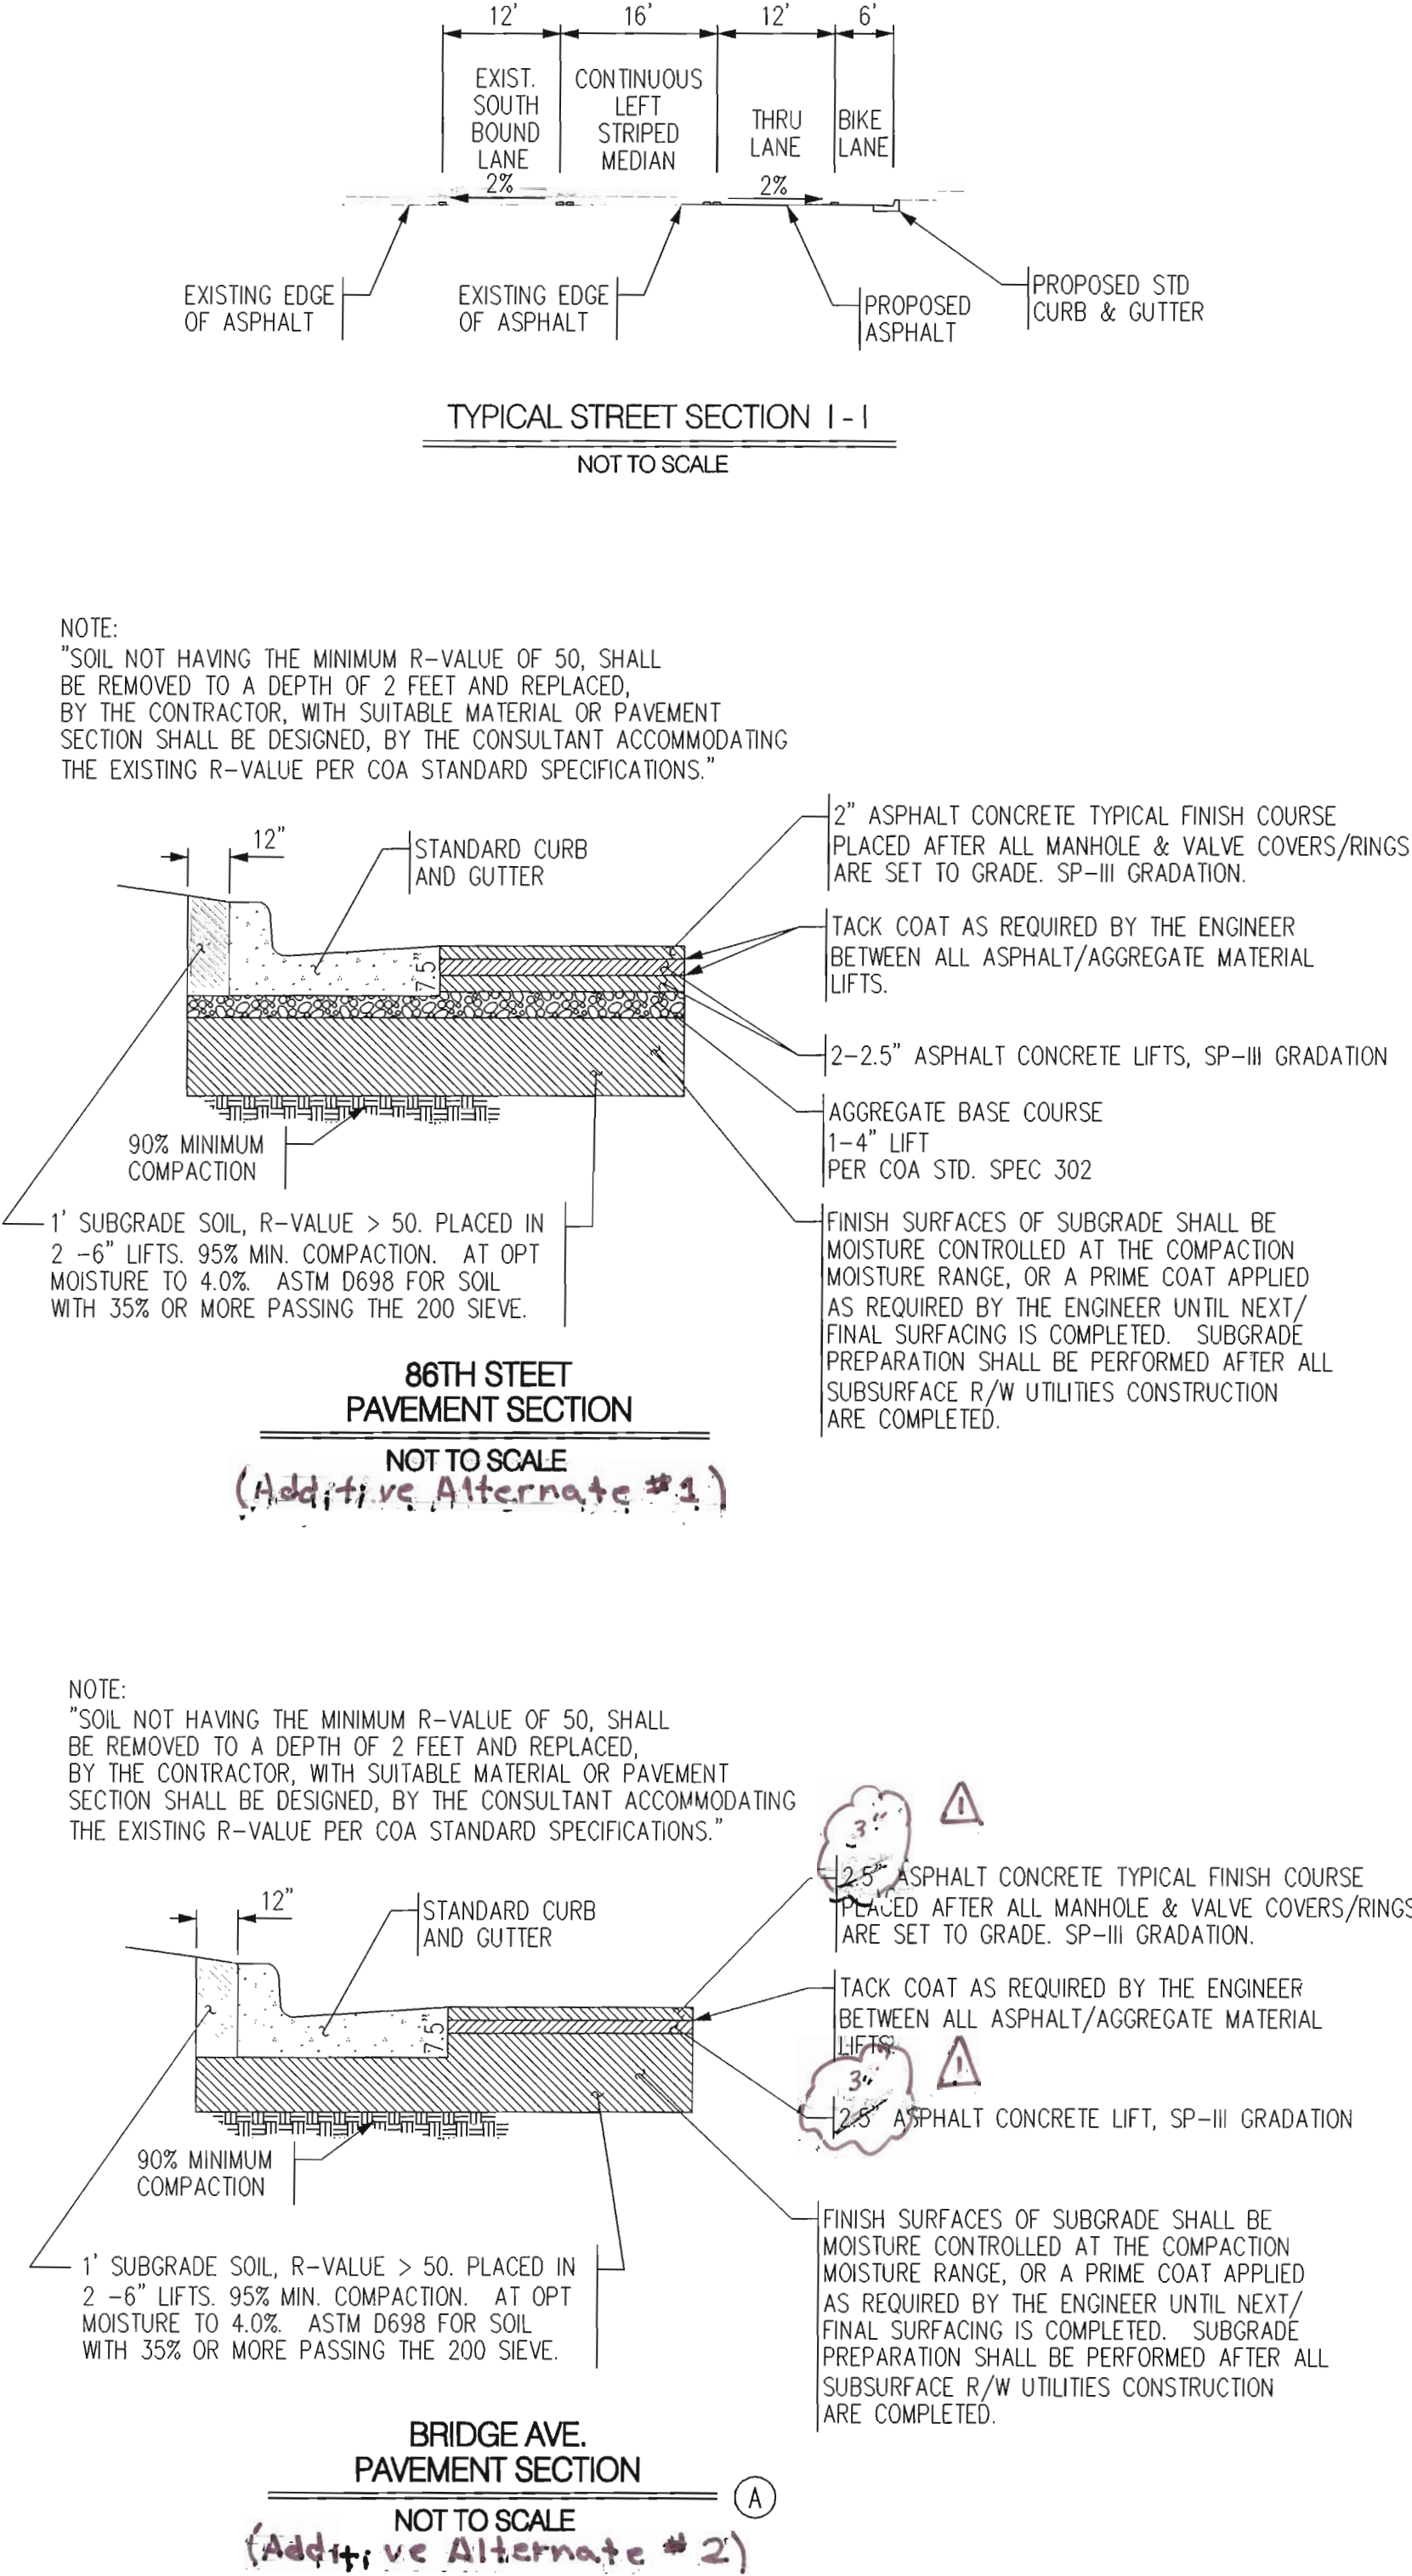
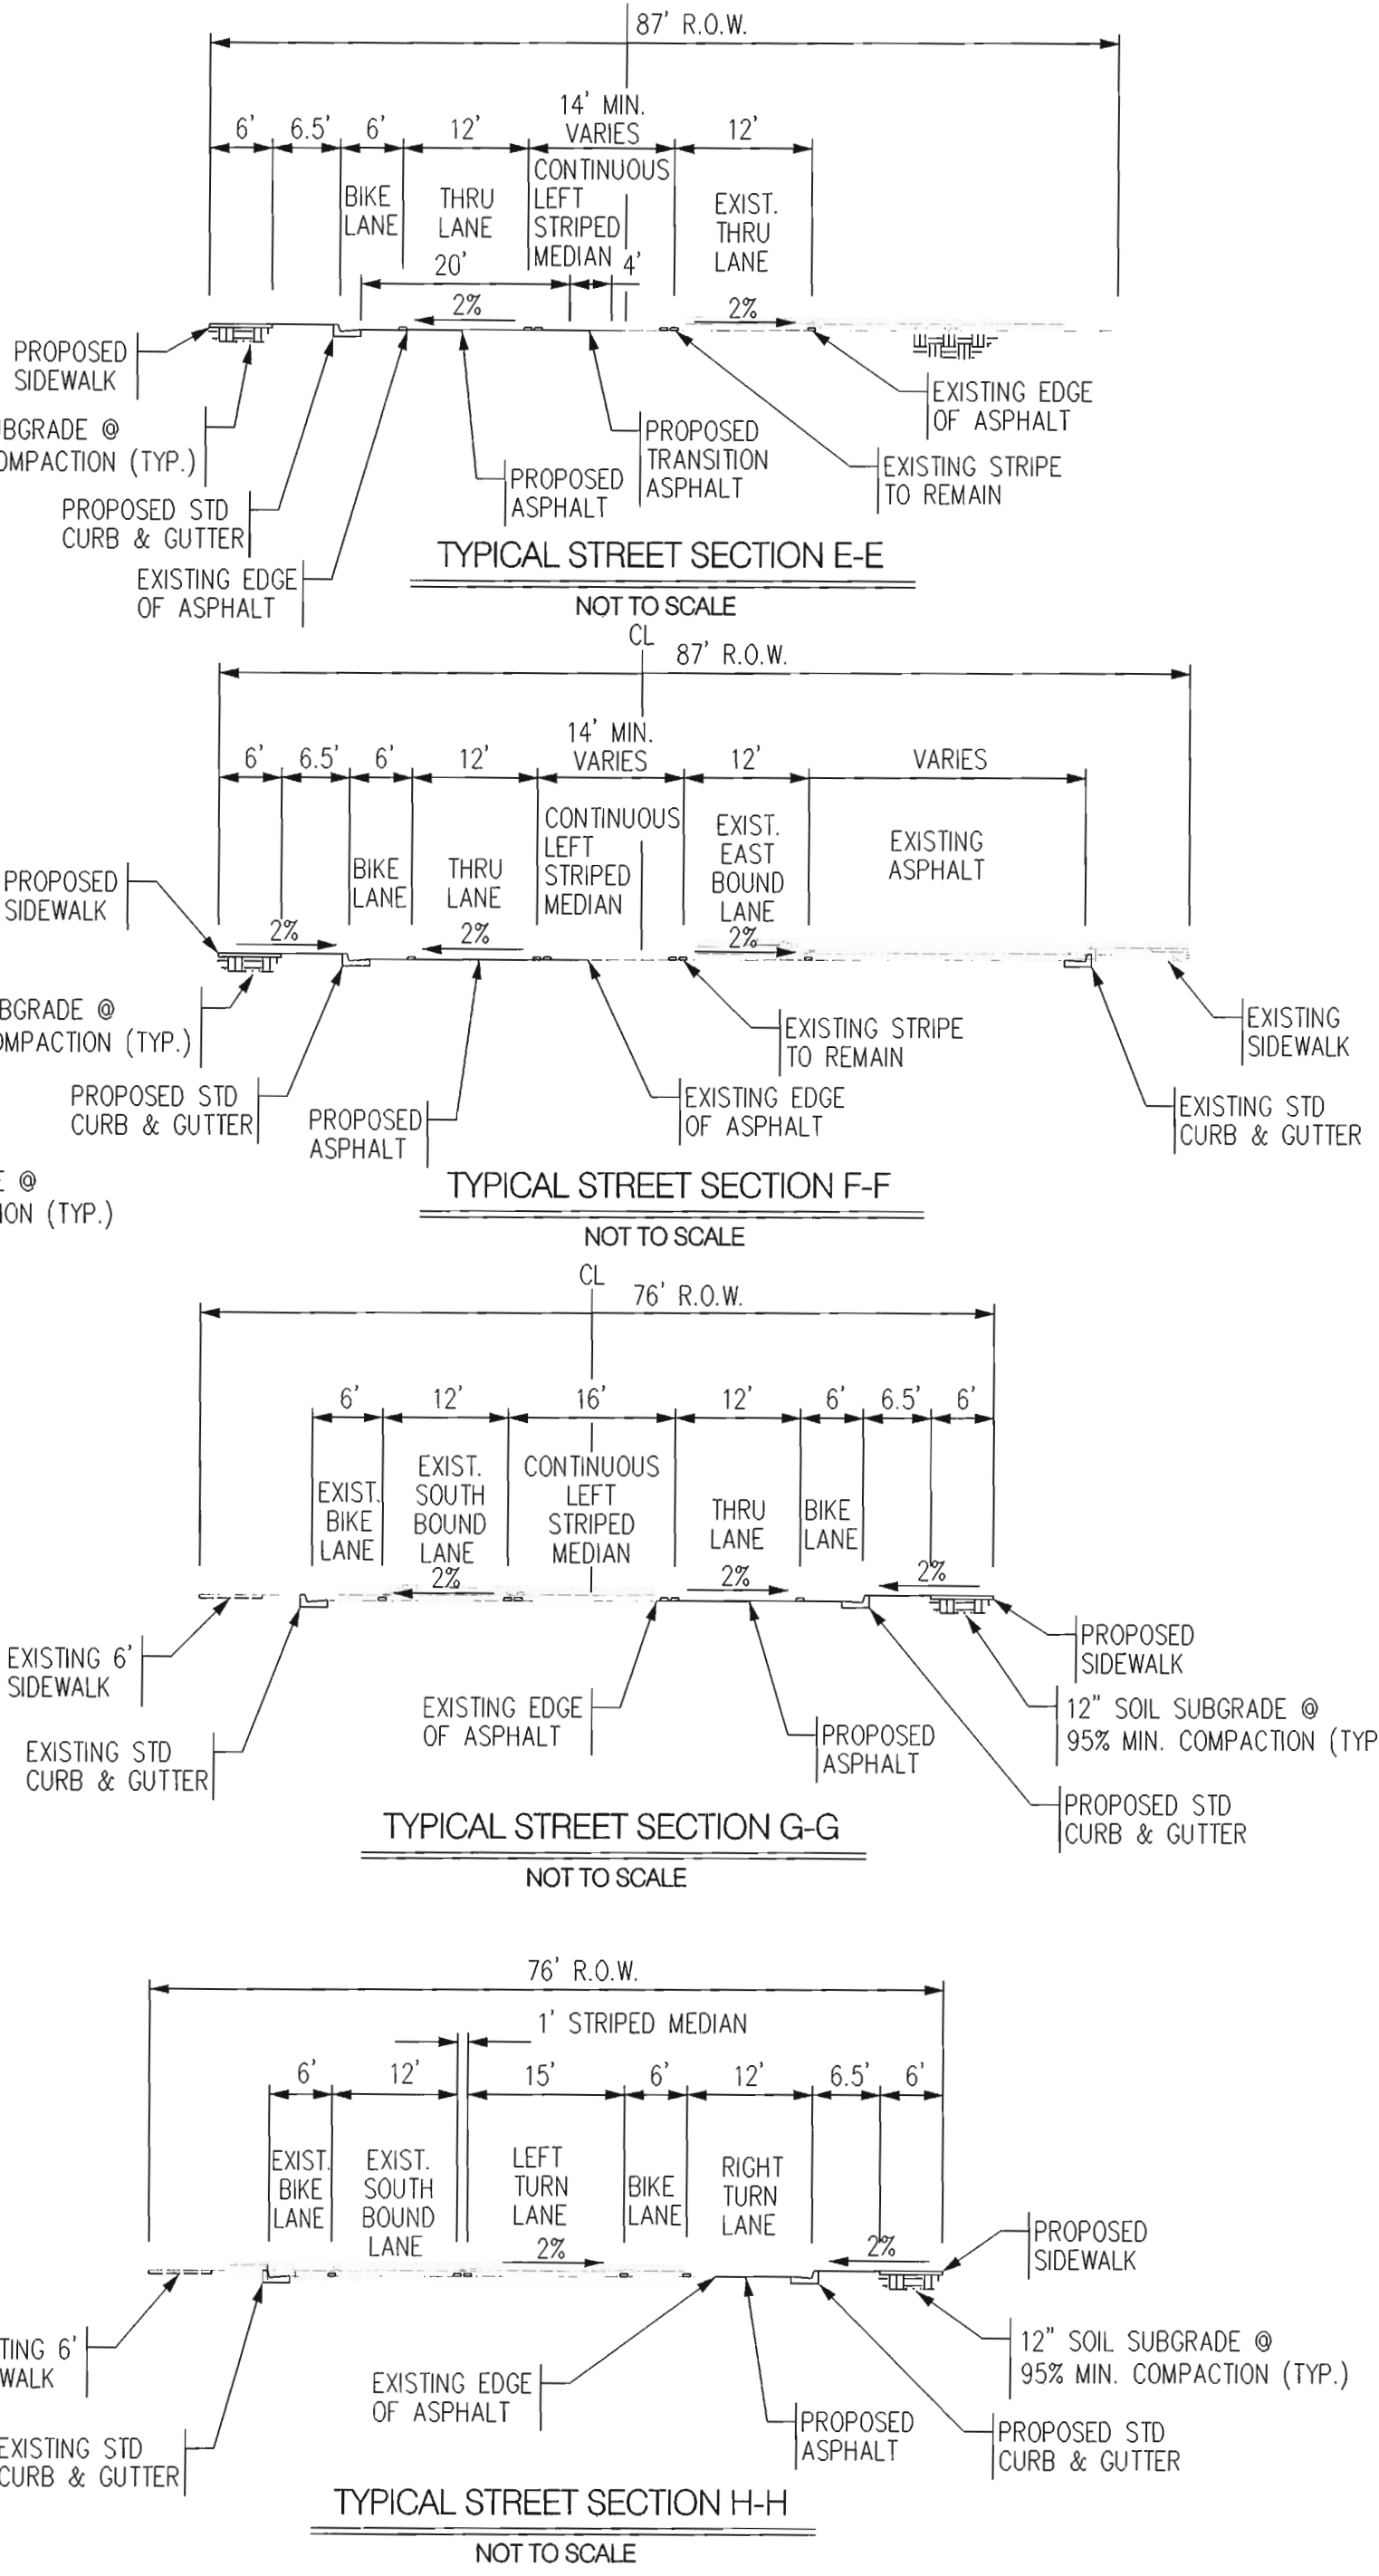
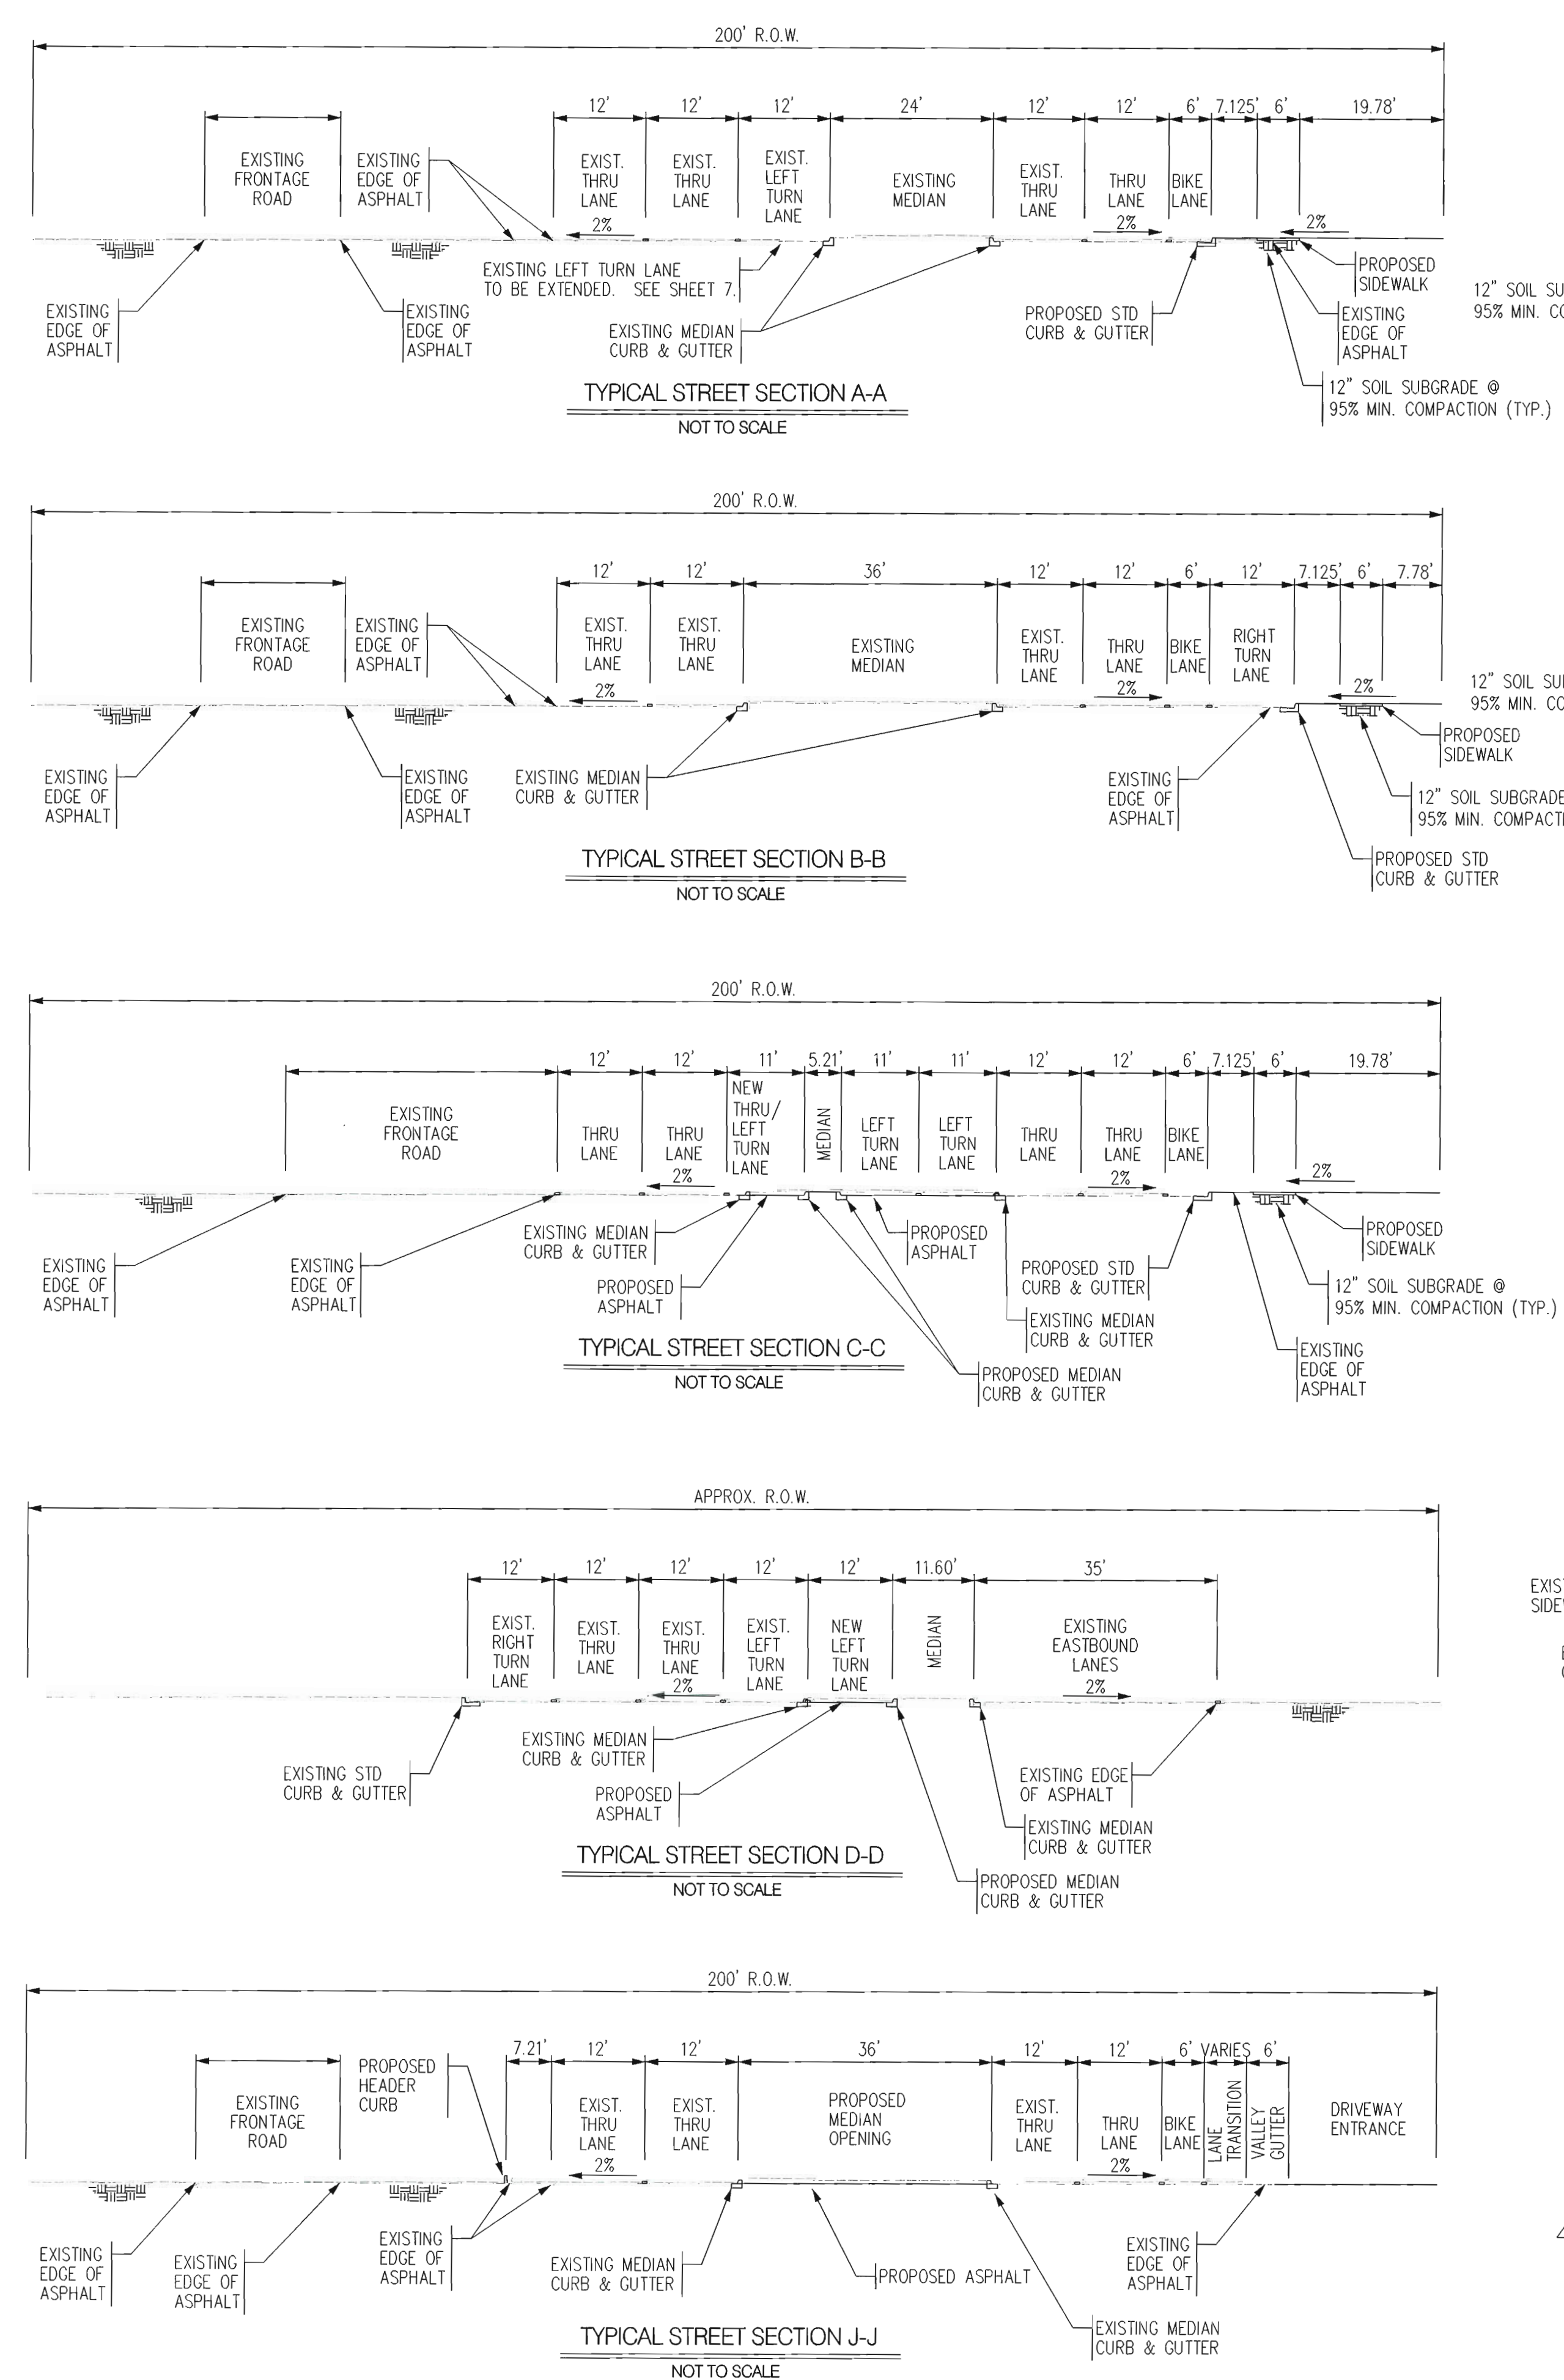



Bohannon & Huston
Court yard | 7500 Jefferson St. NE | Albuquerque, NM 87109-4335
ENGINEERING • SPATIAL DATA • ADVANCED TECHNOLOGIES

CITY OF ALBUQUERQUE
DEPARTMENT OF
MUNICIPAL DEVELOPMENT
OFFSITE PUBLIC INFRASTRUCTURE - UNSER CROSSING
TYPICAL SECTIONS AND PAVING DETAILS

DESIGN REVIEW COMMITTEE APPROVE OCT 30 2008
CITY ENGINEER APPROVE OCT 31 2008
LAST DESIGN UPDATE


CITY PROJECT NO. 735684
ZONE MAP NO. K-9 K-10
SHEET 5 OF 29

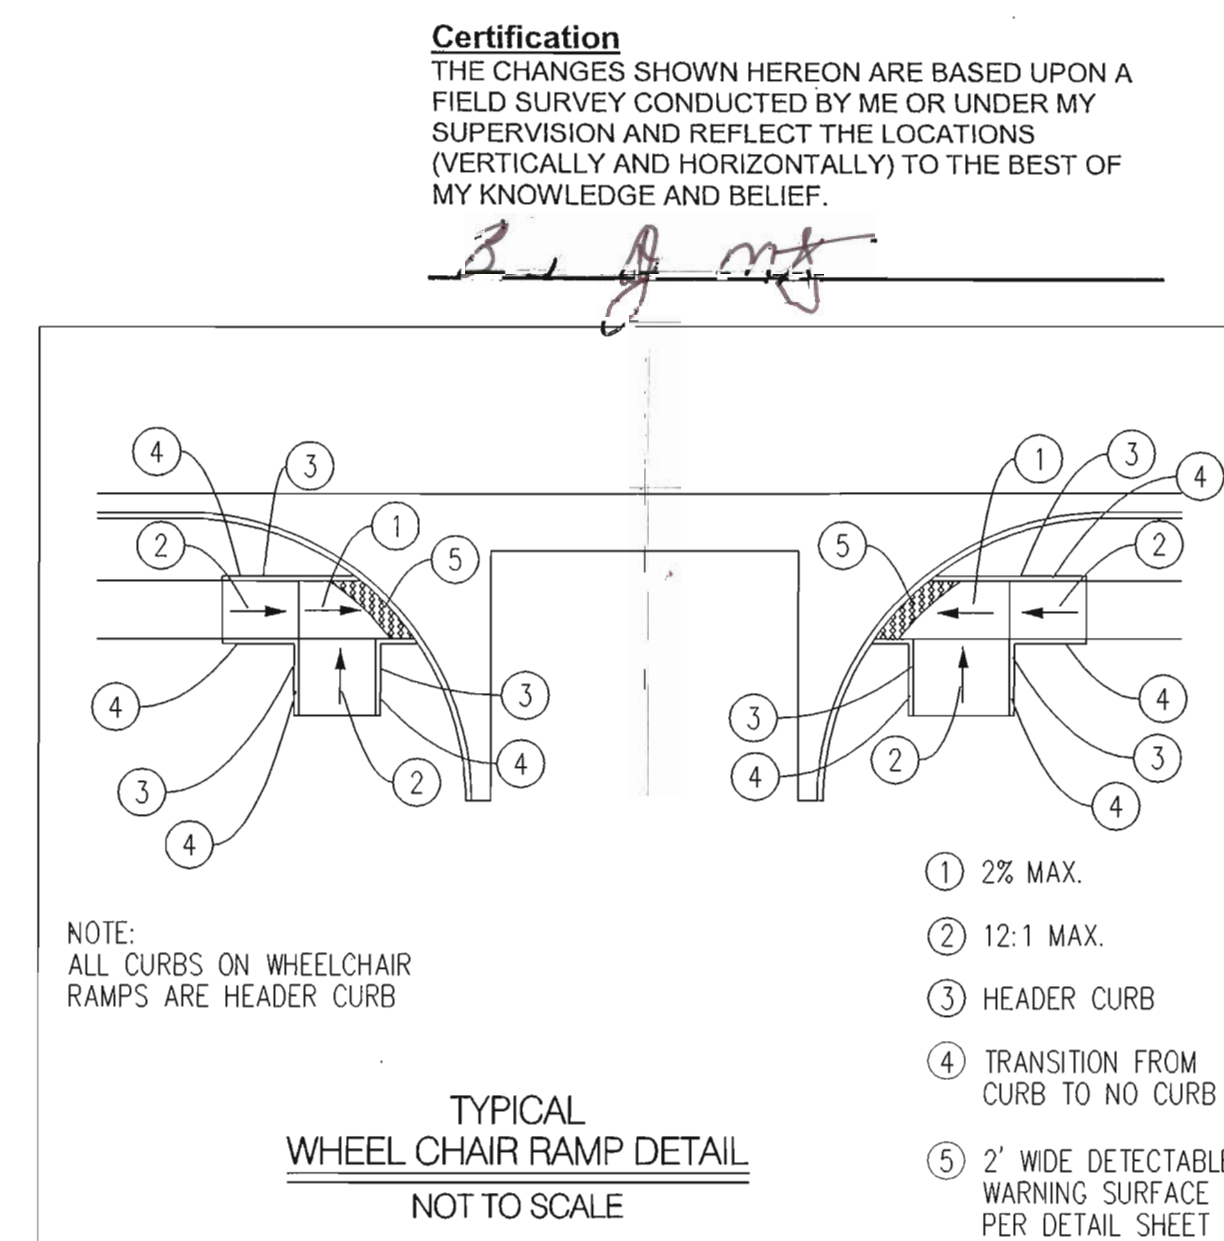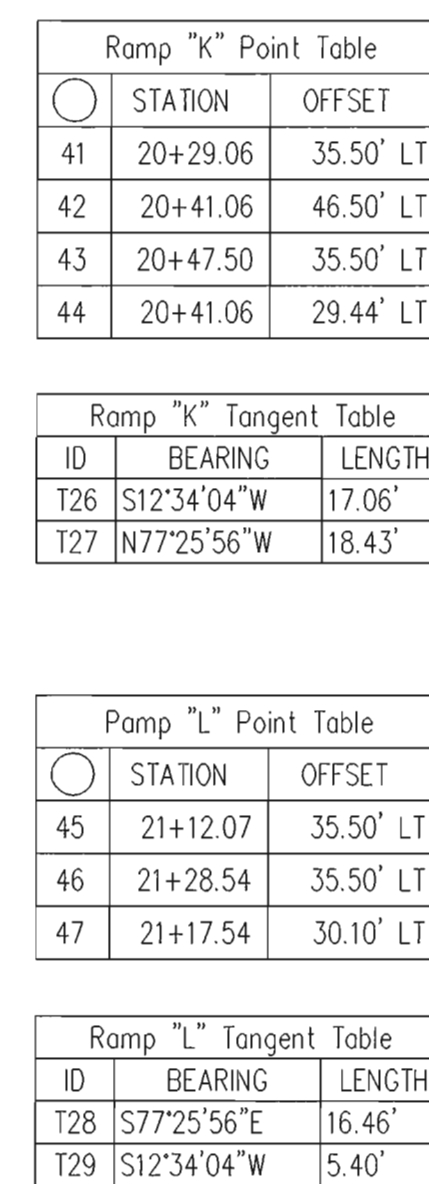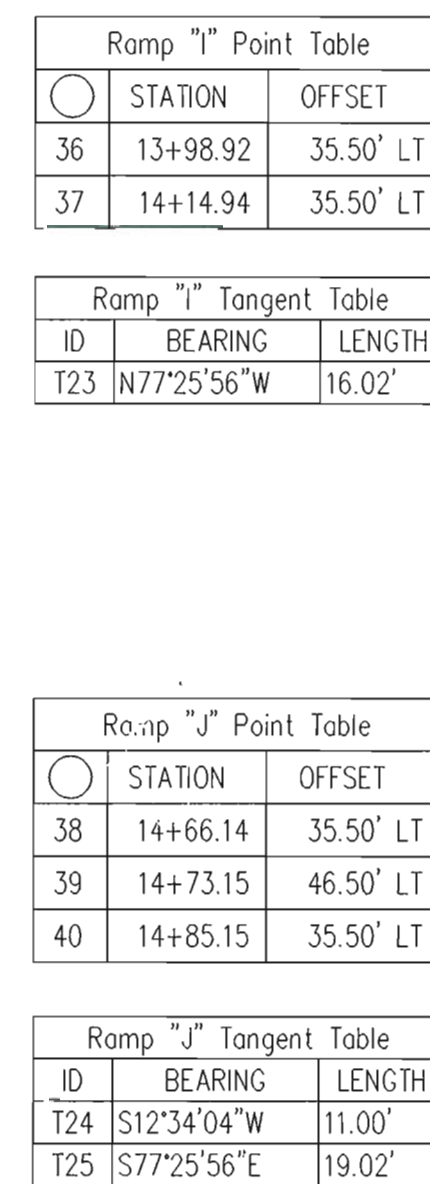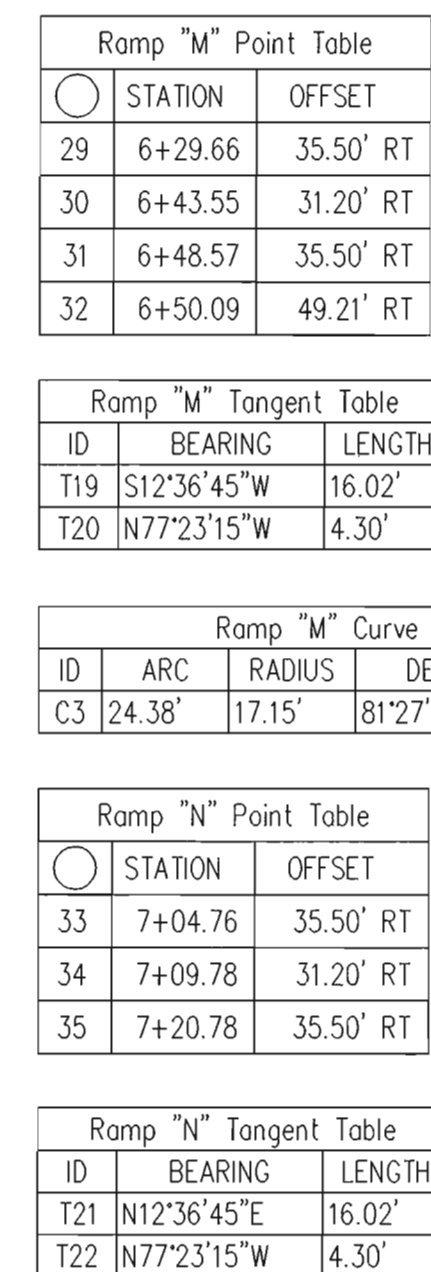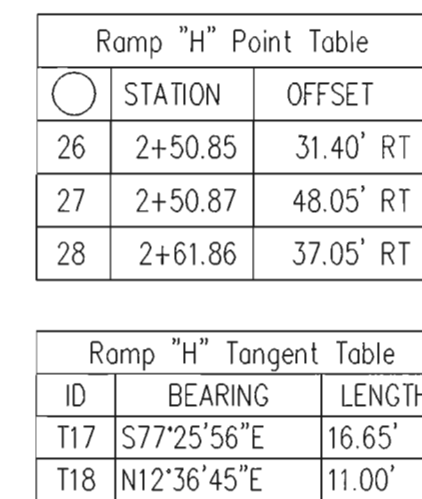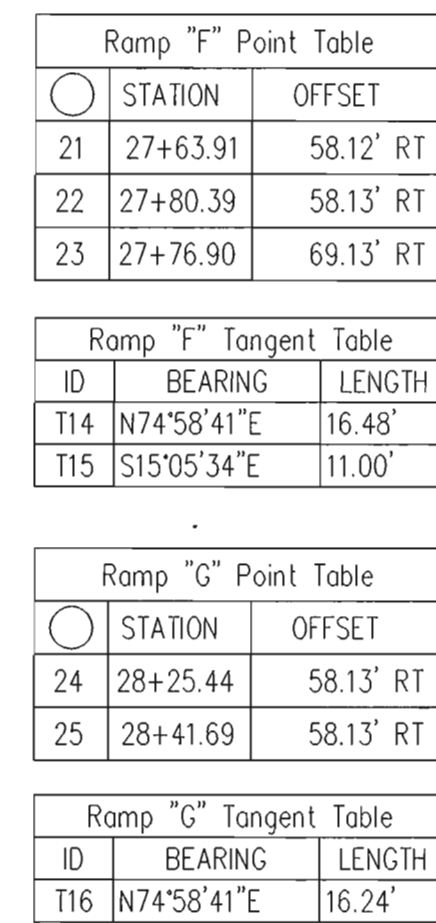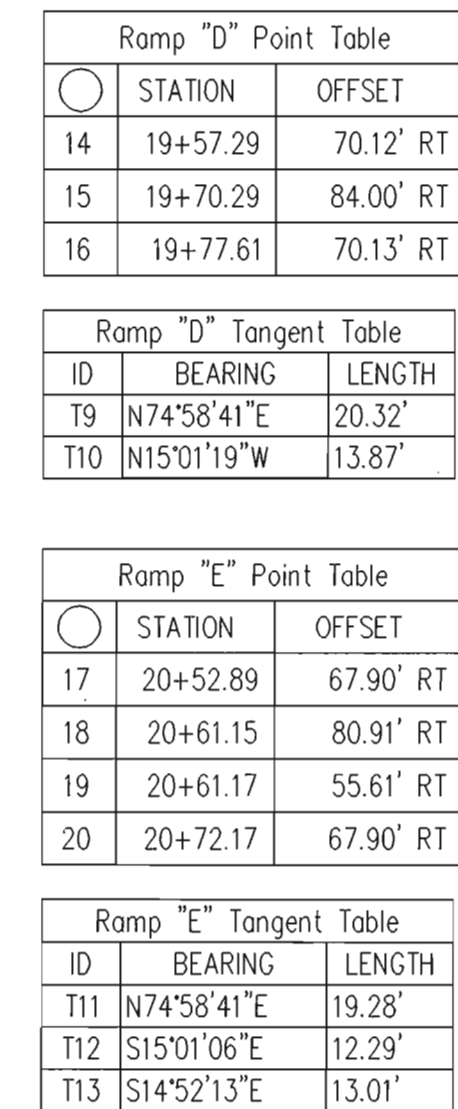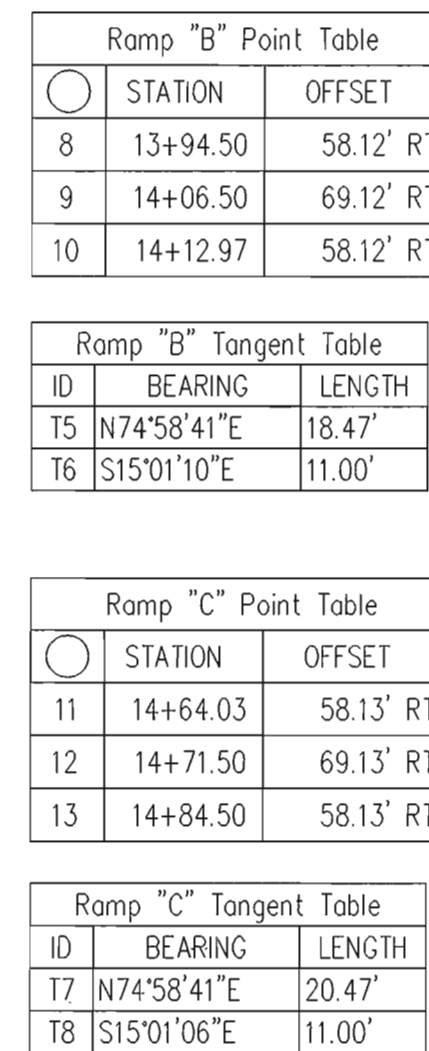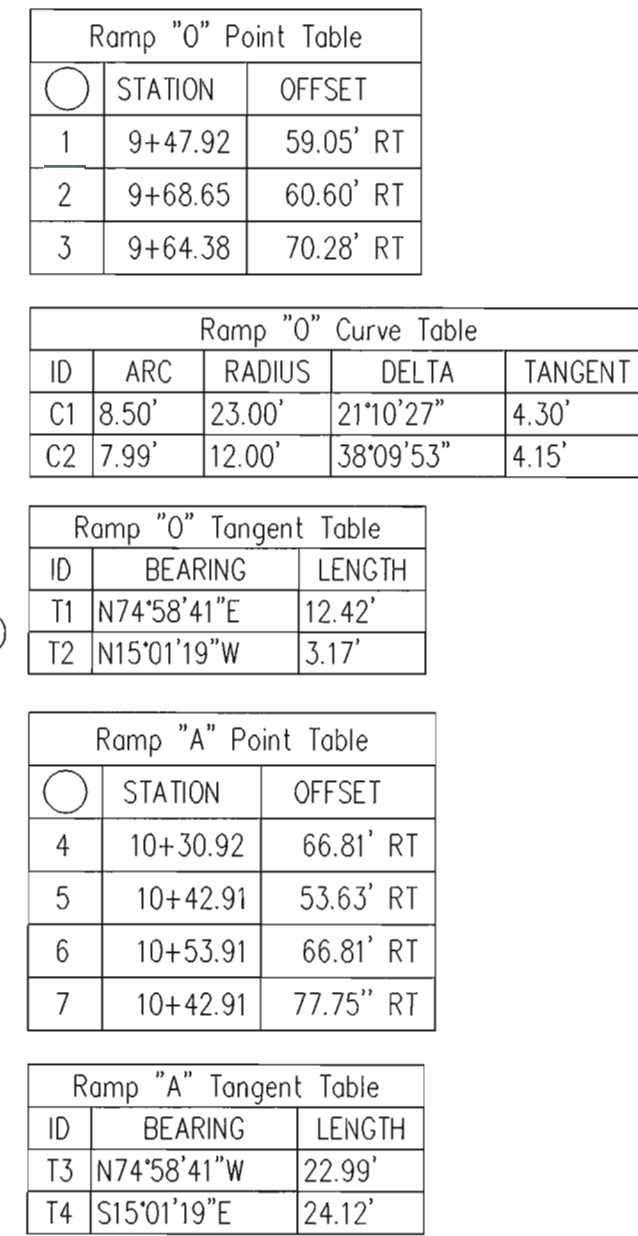

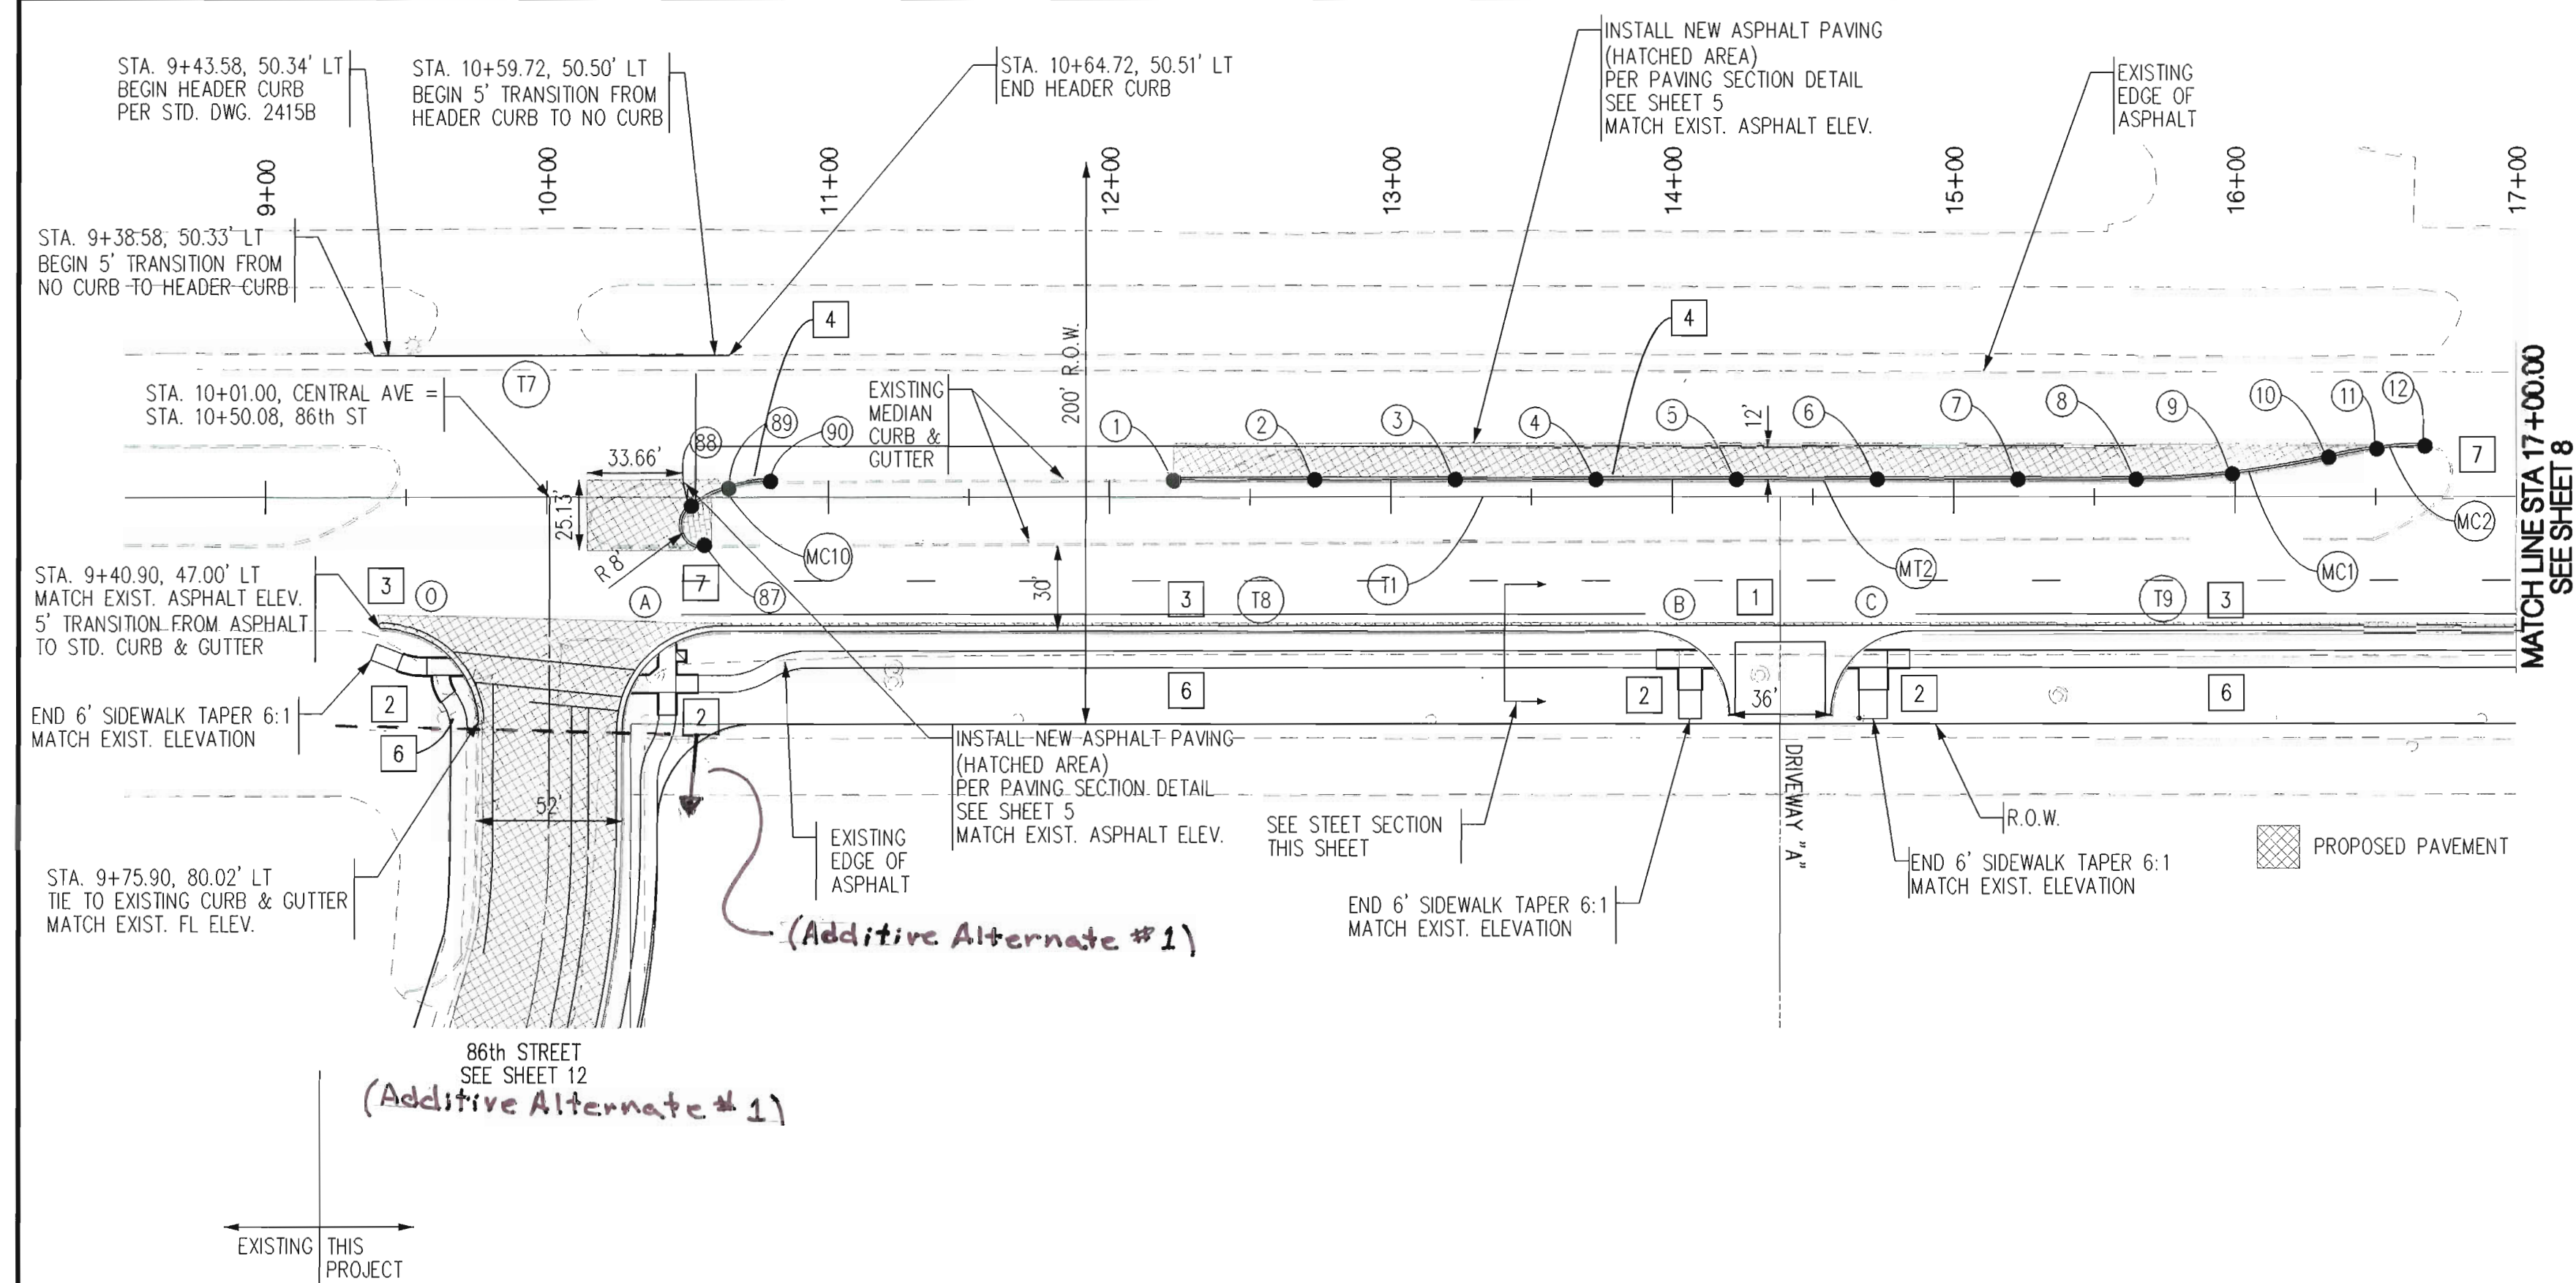


NOTE:
ADJUST ALL STORM DRAIN MANHOLES,
SANITARY SEWER MANHOLES, AND
WATER VALVES TO FINISHED GRADE.

CONTRACTOR SHALL COORDINATE WITH
DRY UTILITY OWNER AND ADJUST
ALL DRY UTILITIES MANHOLES TO FINISHED
GRADE.

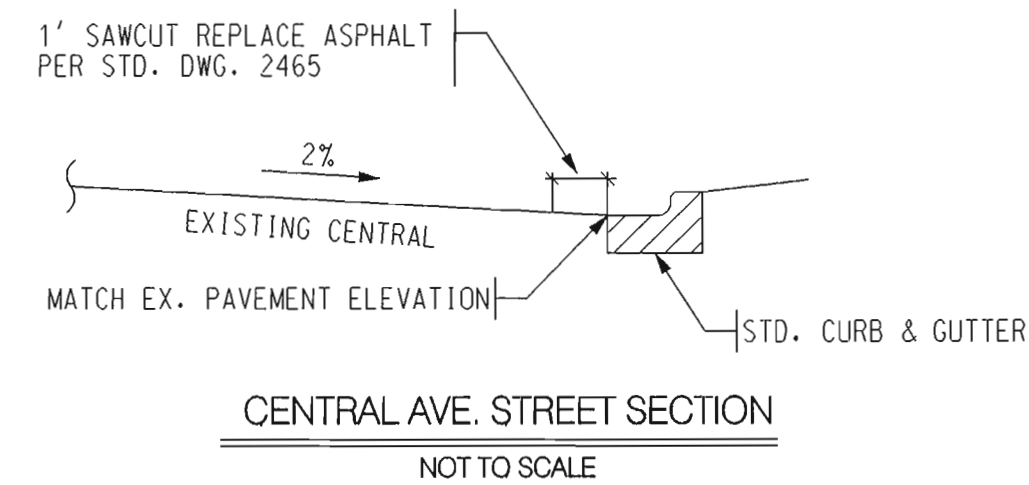

Certification
THE CHANGES SHOWN HEREON ARE BASED UPON A
FIELD SURVEY CONDUCTED BY ME OR UNDER MY
SUPERVISION AND REFLECT THE LOCATIONS
(VERTICALLY AND HORIZONTALLY) TO THE BEST OF
MY KNOWLEDGE AND BELIEF.

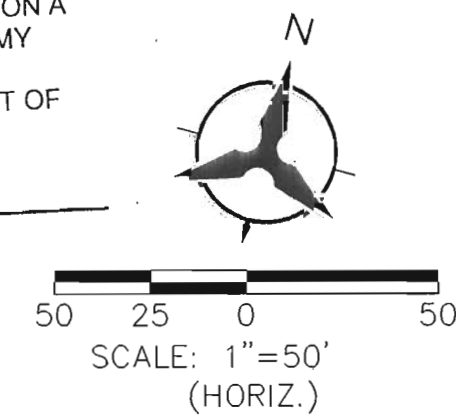

CENTRAL AVENUE (Base Bid)

MEDIAN Point Table				
○	STATION	OFFSET	ELEVATION	
*	1	12+22.79	6.30' LT	MATCH EX.
	2	12+72.79	6.30' LT	5124.29
	3	13+22.79	6.30' LT	5120.38
	4	13+72.79	6.30' LT	5119.34
	5	14+22.79	6.30' LT	5118.38
	6	14+72.79	6.30' LT	5117.47
	7	15+22.79	6.30' LT	5116.55
	8	15+64.75	6.30' LT	5115.83
	9	15+98.99	8.26' LT	5115.25
	10	16+33.24	14.22' LT	5114.60
	11	16+50.34	17.23' LT	5114.29
*	12	16+67.45	18.25' LT	MATCH EX.
	87	10+56.78	18.20' RT	MATCH EX.
	88	10+51.36	3.16' RT	5125.22
	89	10+64.72	3.40' LT	5124.91
*	90	10+79.42	5.47' LT	MATCH EX.

* TIE TO EXISTING MEDIAN CURB & GUTTER
MATCH EXISTING ELEVATIONS

CL Tangent Table		
ID	BEARING	LENGTH
T1	N74°58'41"E	3070.38'

Medion Tangent Table		
ID	BEARING	LENGTH
MT2	N74°58'41"E	341.97'

Median Curve Table				
ID	ARC	RADIUS	DELTA	TANGENT
MC1	69.29'	300.00'	13°14'00"	34.80'
MC2	34.33'	150.00'	13°06'51"	17.24'
MC10	29.88'	50.00'	34°14'14"	15.40'

ID	BEARING	LENGTH
T7	N74°53'58"E	126.13'
T8	N74°58'41"E	328.55'
T9	N74°58'41"E	215.41'

(A) CURB RETURN FLOWLINE DATA

PC	24.02
1	24.30
2	24.58
3	24.21
PT	23.84
PI	24.48

D = 89°58'03"
R = 35.00'
T = 34.98'
L = 54.96'
C = 49.48'

PC STA. 10+26.95, 82.98' RT.
PT STA. 10+61.95, 48.00' RT.
PI STA. 10+26.97, 48.00' RT.
RAD STA. 10+61.95, 83.00' RT.
*SEE SHEET 6 FOR WHEEL
CHAIR RAMP DETAILS

CURB RETURN FLOWLINE DATA	
PC	17.25
1	17.03
2	16.80
3	16.95
PT	17.10
PI	16.70

PC STA. 13+90.50, 48.00' RT.
PT STA. 14+20.50, 78.00' RT.
PI STA. 14+20.50, 48.00' RT.
RAD STA. 13+90.50, 78.00' RT.
*SEE SHEET 6 FOR WHEEL
CHAIR RAMP DETAILS

(C) CURB RETURN FLOWLINE DATA

PC	16.39	$D = 89^{\circ}59'47''$ $R = 30.00'$ $T = 30.00'$ $L = 47.12'$ $C = 42.43'$
1	16.25	
2	16.10	
3	15.81	
PT	15.52	
PI	16.00	

PC STA. 14+56.50, 78.00' RT.
PT STA. 14+86.50, 48.00' RT.
PI STA. 14+56.50, 48.00' RT.
RAD STA. 14+86+50, 78.00' RT.
*SEE SHEET 6 FOR WHEEL
CHAIR RAMP DETAILS

① CURB RETURN SLOWING DATA

	PC	26.08	226.2	Δ
1	25.87			
2	25.65			
3	24.49			
PT	23.32			
PI	25.60			

R = 35.00'
T = 33.13'
L = 53.05'
C = 48.12'

PC STA. 9+40.90, 47.00' RT.
PT STA. 9+75.90, 80.02' RT.
PI STA. 9+74.03, 47.00' RT.
RAD STA. 9+40.95, 82.00' RT.
*SEE SHEET 6 FOR WHEEL
CHAIR RAMP DETAILS

KEYED GENERAL NOTES

- 1 INSTALL 6" CONCRETE VALLEY GUTTER
AS PER STD. DWG. 2420
- 2 INSTALL WHEELCHAIR RAMP AS
PER DETAIL SHEET 6
- 3 STD. CURB & GUTTER PER STD. DWG. 2415A
- 4 MEDIAN CURB & GUTTER PER STD. DWG. 2415B
- 5 EXTRUDED ASPHALT CURB PER STD. DWG. 2415B
- 6 BUILD 6' SIDEWALK PER STD. DWG. 2430
- 7 BUILD 4" TEXTURED MEDIAN PAVEMENT
FROM MEDIAN NOSE TO 10' FROM NOSE OR TO
5' MIN. WIDTH F-F AS SHOWN ON PLANS.
COLOR TO BE DETERMINED BY CITY
PROJECT MANAGER. MEDIAN NOSES
SHALL BE PAINTED YELLOW TO APPROX. 6'
BEHIND PC/PT PER COA STD DWG 2408 & 2502
- 8 FOR STRIPING PLAN SEE SHEET 13

GENERAL NOTE:
ALL STORM DRAIN MANHOLES SHALL BE
6' DIAMETER TYPE "E" AS PER STANDARD
DRAWING 2102 UNLESS OTHERWISE NOTED.

Bohannon & Huston, Inc.

Courtyard | 7500 Jefferson St. NE Albuquerque, NM 87109-4335
ENGINEERING  **SPATIAL DATA**  **ADVANCED TECHNOLOGIES**



CITY OF ALBUQUERQUE
DEPARTMENT OF
MUNICIPAL DEVELOPMENT

OFFSITE PUBLIC INFRASTRUCTURE - UNSER CROSSING

PAVING PLAN
CENTRAL AVENUE STA 9+00 - STA 17+00

DESIGN REVIEW COMMITTEE
APPROVED
OCT 30 2008
DESIGN REVIEW COMMITTEE


CITY ENGINEER APPROVAL

APPROVED

OCT 31 2008

CITY ENGINEER



LAST DESIGN UPDATE	MO./DAY/YR.	MO./DAY/YR.

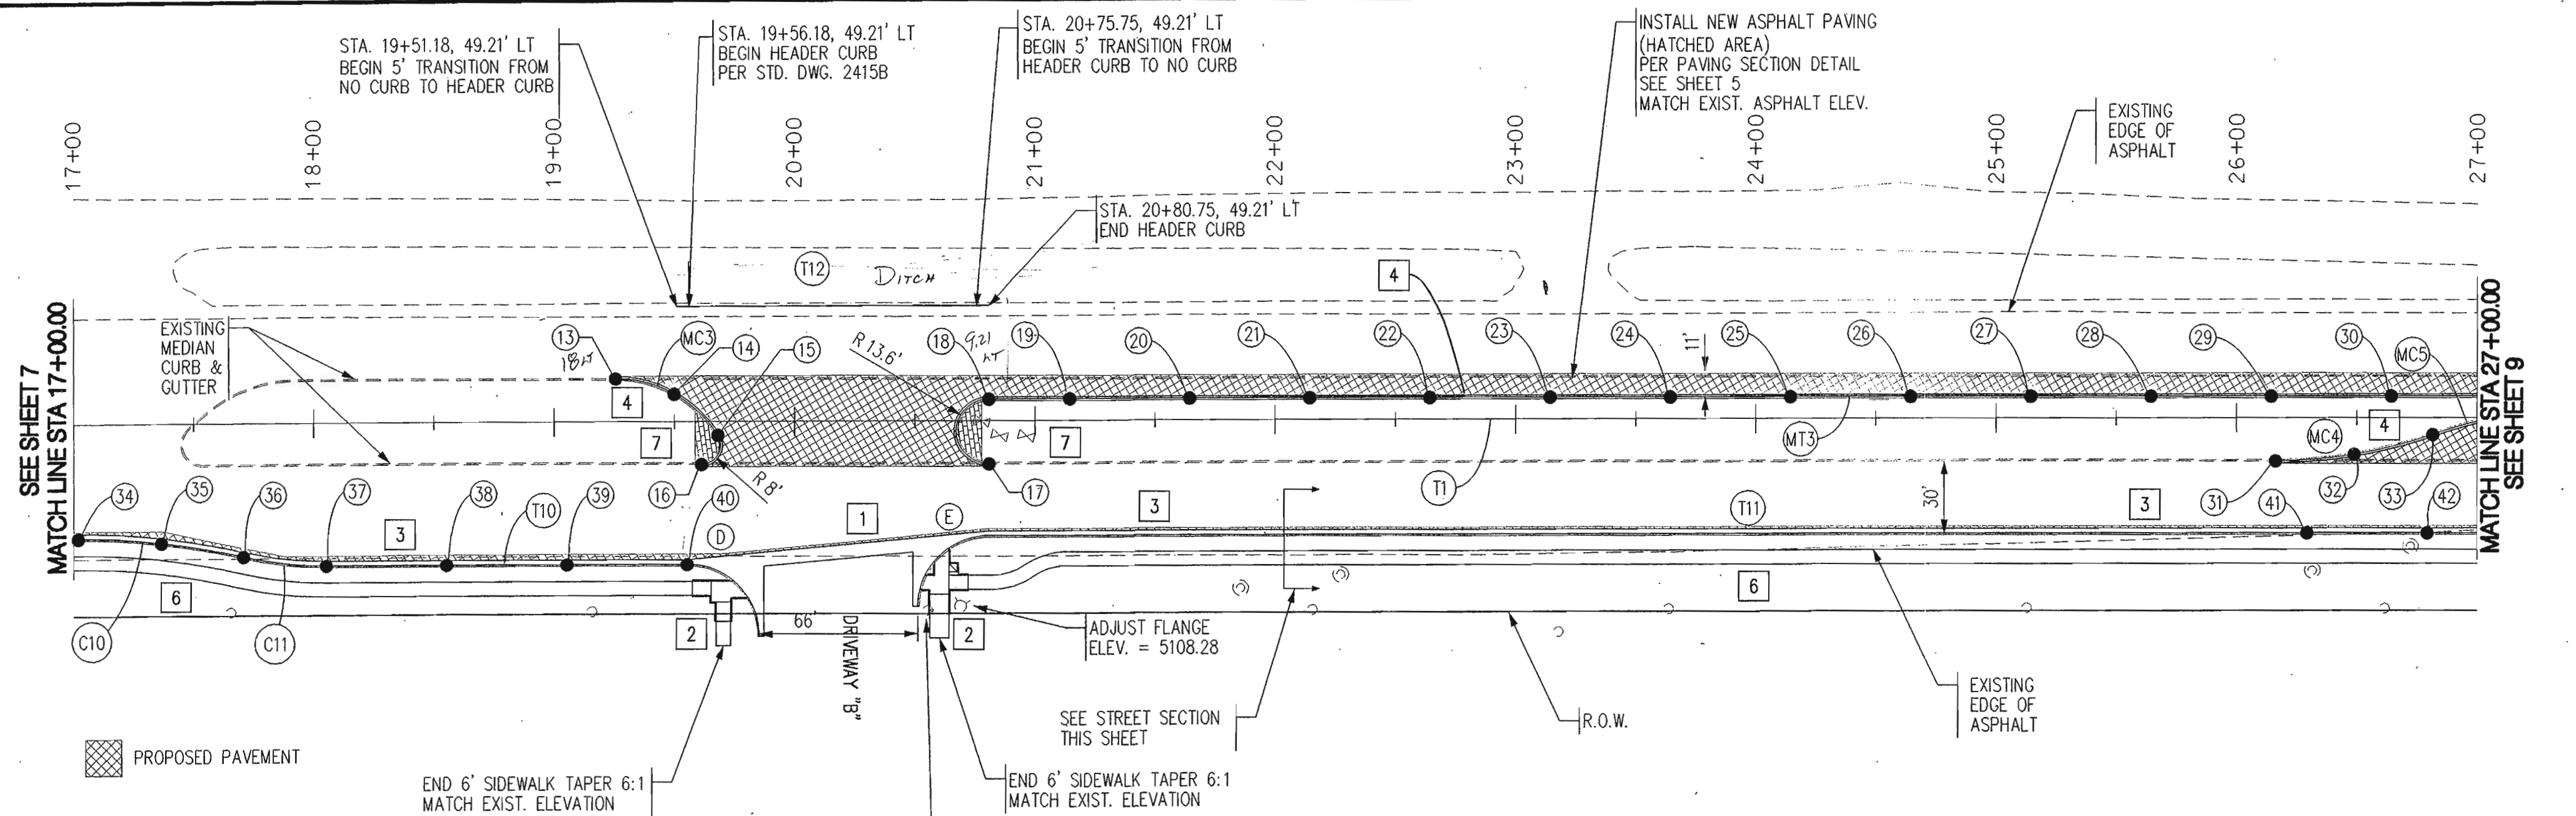

NOTE:
ADJUST ALL STORM DRAIN MANHOLES,
SANITARY SEWER MANHOLES, AND
WATER VALVES TO FINISHED GRADE.

CONTRACTOR SHALL COORDINATE WITH
DRY UTILITY OWNER AND ADJUST
ALL DRY UTILITIES MANHOLES TO FINISHED
GRADE.

D CURB RETURN FLOWLINE DATA			E CURB RETURN FLOWLINE DATA		
PC	07.96	D = 90°00'13" R = 30.00' T = 30.00' L = 47'13" C = 42.43'	PC	07.25	D = 89°59'47"
1	07.81		1	07.07	R = 30.00'
2	07.66		2	06.88	T = 30.00'
3	07.85		3	06.49	L = 47'12"
PT	08.03		PT	06.10	C = 42.43'
PI	07.56		PI	06.78	
PC STA. 19+55.14, 60.00' RT. PT STA. 19+85.14, 90.00' RT. PI STA. 19+79.59, 90.00' RT. RAD STA. 19+55.14, 90.00' RT. *SEE SHEET 6 FOR WHEEL CHAIR RAMP DETAILS			PC STA. 20+51.14, 78.00' R' PT STA. 20+51.14, 48.00' R' PI STA. 20+51.14, 48.00' R' RAD STA. 20+81.14, 78.00' R' *SEE SHEET 6 FOR WHEEL CHAIR RAMP DETAILS		

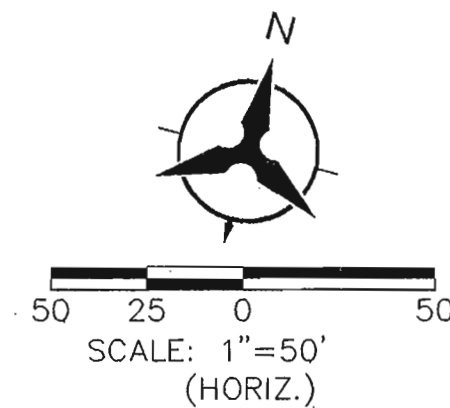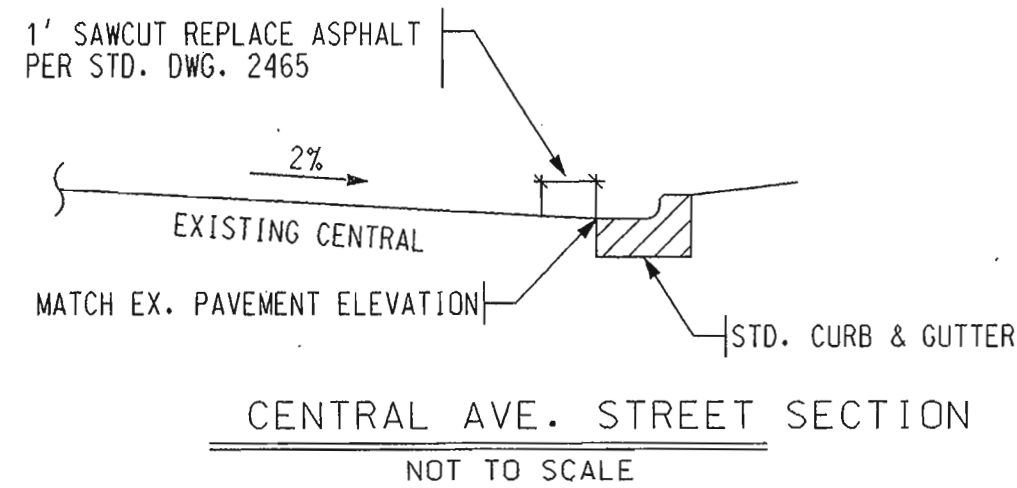

CENTRAL AVENUE (Base Bid)

Point Table				Point Table			Point Table				
○	STATION	OFFSET	ELEVATION	STATION	OFFSET	ELEVATION	○	STATION	OFFSET	ELEVATION	
13	19+25.46	18.01' LT	MATCH EX. 24	23+64.35	9.21' LT	5103.68	35	17+36.55	50.01' RT	5111.37	
14	19+49.81	11.62' LT	5109.32	25	24+14.35	9.21' LT	5103.21	36	17+70.73	56.00' RT	5110.81
15	19+67.96	5.81' RT	5108.96	26	24+64.35	9.21' LT	5102.84	37	18+05.14	60.00' RT	5110.14
16	19+61.14	18.00' RT	MATCH EX. 27	25+14.35	9.21' LT	5102.43	38	18+55.14	60.00' RT	5109.39	
17	20+80.75	18.00' RT	MATCH EX. 28	25+64.35	9.21' LT	5102.25	39	19+05.14	60.00' RT	5108.64	
18	20+80.75	9.21' LT	5107.12	29	26+14.35	9.21' LT	5101.52	40	19+55.14	60.00' RT	5107.89
19	21+14.35	9.21' LT	5106.68	30	26+64.35	9.21' LT	5107.08	41	26+29.23	48.00' RT	5099.60
20	21+64.35	9.21' LT	5105.99	31	26+16.13	18.00' RT	MATCH EX.	42	26+79.23	48.00' RT	5099.18
21	22+14.35	9.21' LT	5105.36	32	26+48.84	15.31' RT	5100.00				
22	22+64.35	9.21' LT	5104.76	33	26+81.67	7.18' RT	5099.94				
23	23+14.35	9.21' LT	5104.19	34	17+01.91	48.00' RT	5111.85				

* TIE TO EXISTING MEDIAN CURB & GUTTER
MATCH EXISTING ELEVATIONS

X.XX.XX = VERIFIED ELEVATION

CL Tangent Table		
ID	BEARING	LENGTH
T1	N74°58'41"E	3070.38'

MEDIAN Tangent Table		
ID	BEARING	LENGTH
MT3	N74°58'41"E	1033.60'

MEDIAN Curve Table				
ID	ARC	RADIUS	DELTA	TANGENT
MC3	50.88'	50.00'	58°18'31"	27.89'
MC4	66.64'	200.00'	19°05'28"	33.63'
MC5	66.64'	200.00'	19°05'28"	33.63'

ID	BEARING	LENGTH
T10	N74°58'41"E	150.00'
T11	N74°58'41"E	676.78'
T12	N74°58'41"E	129.57'

ID	ARC	RADIUS	DELTA	TANGENT
C10	69.44'	300.00'	13°15'41"	34.87'
C11	34.72'	150.00'	13°15'41"	17.44'

Certification
THE CHANGES SHOWN HEREON ARE BASED UPON A
FIELD SURVEY CONDUCTED BY ME OR UNDER MY
SUPERVISION AND REFLECT THE LOCATIONS
(VERTICALLY AND HORIZONTALLY) TO THE BEST OF
MY KNOWLEDGE AND BELIEF.

B. A. M.

- | NOTES | | AS-BUILT INFORMATION | BENCH MARKS | SURVEY INFORMATION |
|-------|--|----------------------|-------------|--------------------|
| 1. | THE CONTRACTOR SHALL FIELD VERIFY ALL EXISTING UTILITY LOCATIONS AND NOTIFY THE ENGINEER IMMEDIATELY OF ANY DISCREPANCIES. | | | |
| 2. | ALL CURB RETURN RADI1 SHALL BE 25' UNLESS OTHERWISE SPECIFIED. | | | |
| 3. | ALL CURVE DATA AND DIMENSIONS REFER TO FACE OF CURB UNLESS OTHERWISE SPECIFIED. | | | |
| 4. | GRADE ELEVATIONS, WHERE NOTED, ARE ALONG FLOWLINE OF CURB UNLESS OTHERWISE SPECIFIED. | | | |
| 5. | CONTRACTOR IS TO INSTALL A 4" X 4" X 5' POST AND END AT THE END OF EACH SANITARY SEWER SERVICE. | | | |
| 6. | CONTRACTOR IS RESPONSIBLE FOR REPAIR AND/OR REPLACEMENT OF ALL UTILITY CONDUITS AND EXISTING LINES. | | | |
| 7. | ANY ADDITIONAL GRADING REQUIRED TO MATCH PROPOSED STREET GRADES SHALL BE INCIDENTAL TO PAVING ITEMS. | | | |
| 8. | CONTRACTOR SHALL PROVIDE THE INSPECTORS, (CITY AND PRIVATE) WITH THE PROPOSED HYDROSTATIC TESTING PLAN. THE PLAN MUST BE APPROVED BEFORE TESTING OPERATIONS BEGIN. | | | |
| 9. | CONTRACTOR SHALL PARK EQUIPMENT AND VEHICLES AS NOT TO INTERFERE WITH NORMAL ACTIVITIES OF RESIDENTS OR OTHER CONTRACTORS ON SITE. | | | |
| 10. | ANY DAMAGE TO THE EXISTING FACILITIES (CURB & GUTTER), PAVEMENT, CONDUITS, LANDSCAPING, UTILITY LINES, ETC.) DURING CONSTRUCTION SHALL BE REPLACED AT THE CONTRACTORS' EXPENSE. | | | |
| 11. | REMOVAL OF THE EXISTING CURB AND GUTTER SHALL BE AS PER COA STD. DWG. 2415A (SAWCUT ONLY). | | | |
| 12. | WHEELCHAIR RAMPS SHALL BE CONSTRUCTED PRIOR TO ACCEPTANCE OF CURB & GUTTER. | | | |
| 13. | RCP SHALL BE INSTALLED SO THAT THE JOINT GAP AT THE HOME POSITION SHALL CONFORM TO THE APPROVED MANUFACTURER'S RECOMMENDATIONS. MANUFACTURER'S RECOMMENDED JOINT GAP TOLERANCES FOR EACH PIPE SIZE AND TYPE SHALL BE SUBMITTED TO THE ENGINEER FOR APPROVAL PRIOR TO PLACEMENT OF PIPE. RCP JOINTS SHALL NOT BE GROUTED UNLESS DIRECTED BY THE ENGINEER AFTER CITY APPROVAL. | | | |
| 14. | ALL EXCAVATION, TRENCHING, AND SHORING ACTIVITIES MUST BE CARRIED-OUT IN ACCORDANCE WITH OSHA 29 CFR 1926.650 SUBPART P. | | | |

KEYED GENERAL NOTES

- 1 INSTALL 6" CONCRETE VALLEY GUTTER
AS PER STD. DWG. 2420
- 2 INSTALL WHEELCHAIR RAMP AS
PER DETAIL SHEET 6
- 3 STD. CURB & GUTTER PER STD. DWG. 2415A
- 4 MEDIAN CURB & GUTTER PER STD. DWG. 2415B
- 5 EXTRUDED ASPHALT CURB PER STD. DWG. 2415B
- 6 BUILD 6' SIDEWALK PER STD. DWG. 2430
- 7 BUILD 4" TEXTURED MEDIAN PAVEMENT
FROM MEDIAN NOSE TO 10' FROM NOSE OR TO
5' MIN. WIDTH F-F AS SHOWN ON PLANS.
COLOR TO BE DETERMINED BY CITY
PROJ. MANGER. MEDIAN NOSES
SHALL BE PAINTED YELLOW TO APPROX. 6'
BEHIND PC/PT PER COA STD DWG 240B & 2502
- 8 FOR STRIPING PLAN SEE SHEET 13

GENERAL NOTE:
ALL STORM DRAIN MANHOLES SHALL BE
6' DIAMETER TYPE "E" AS PER STANDARD
DRAWING 2102 UNLESS OTHERWISE NOTED.

Bohannon  Huston[®]

Courtyard I 7500 Jefferson St. NE Albuquerque, NM 87109-4335
ENGINEERING **SPATIAL DATA** **ADVANCED TECHNOLOGIES**




CITY OF ALBUQUERQUE
DEPARTMENT OF
MUNICIPAL DEVELOPMENT


OFFSITE PUBLIC INFRASTRUCTURE - UNSER CROSSING

PAVING PLAN
CENTRAL AVENUE STA 17+00 - STA 27+00

DESIGN REVIEW COMMITTEE	CITY ENGINEER APPROVAL	MO./DAY/YR.	MO./DAY/YR.
APPROVE	APPROVE		
OCT 3 4 2008	OCT 3 1 2008		
DESIGN REVIEW COMMITTEE	CITY ENGINEER	LAST DESIGN UPDATE	

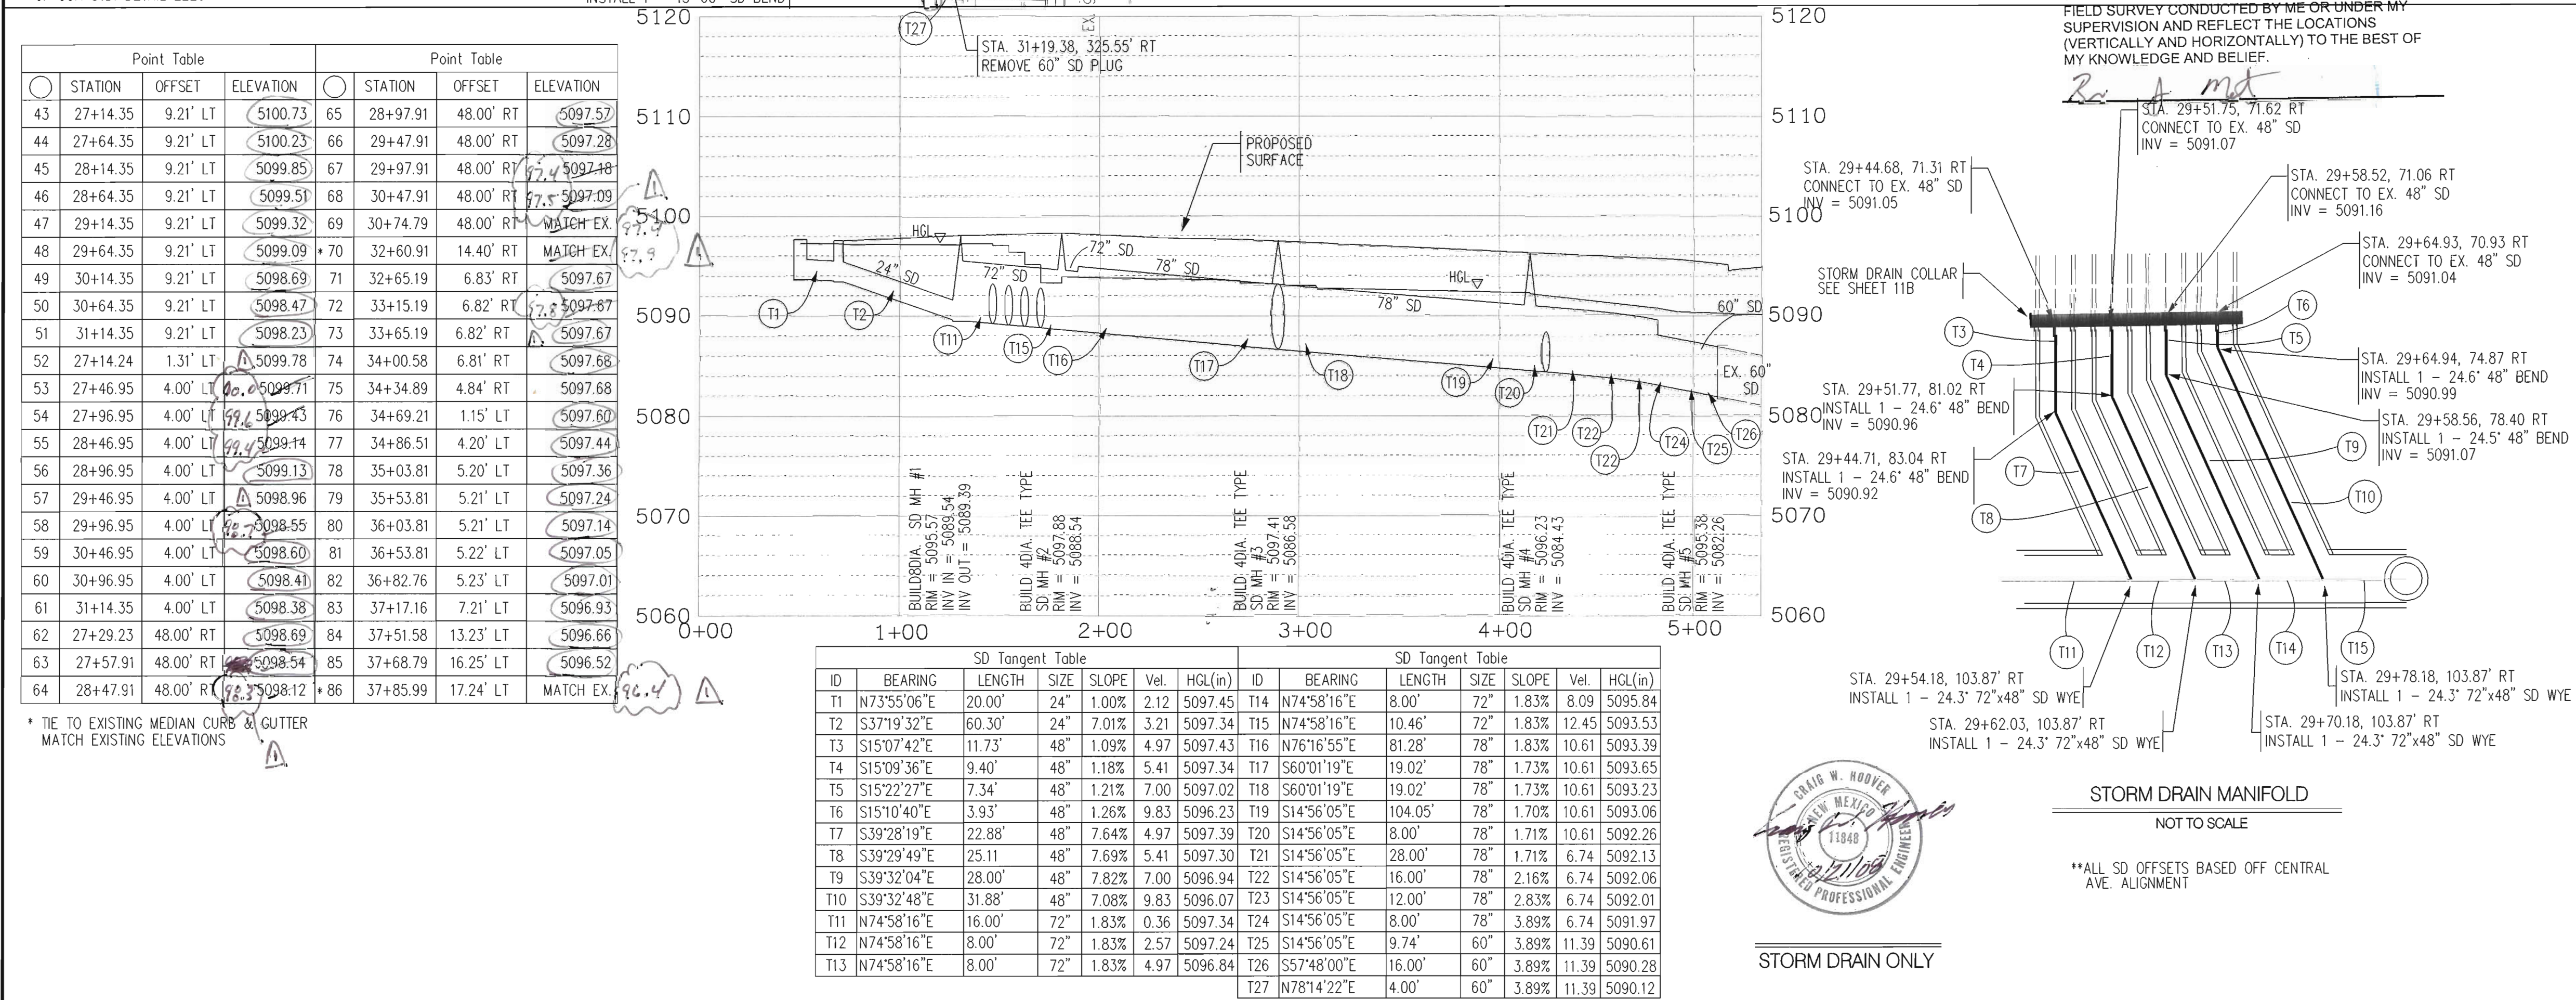

- | | | | |
|------------------------------|--------------------------|------------|----------|
| DESIGN
(REVIEW COMMITTEE) | CITY ENGINEER | | |
| CITY PROJECT NO.
735684 | ZONE MAP NO.
K-9 K-10 | SHEET
9 | OF
29 |

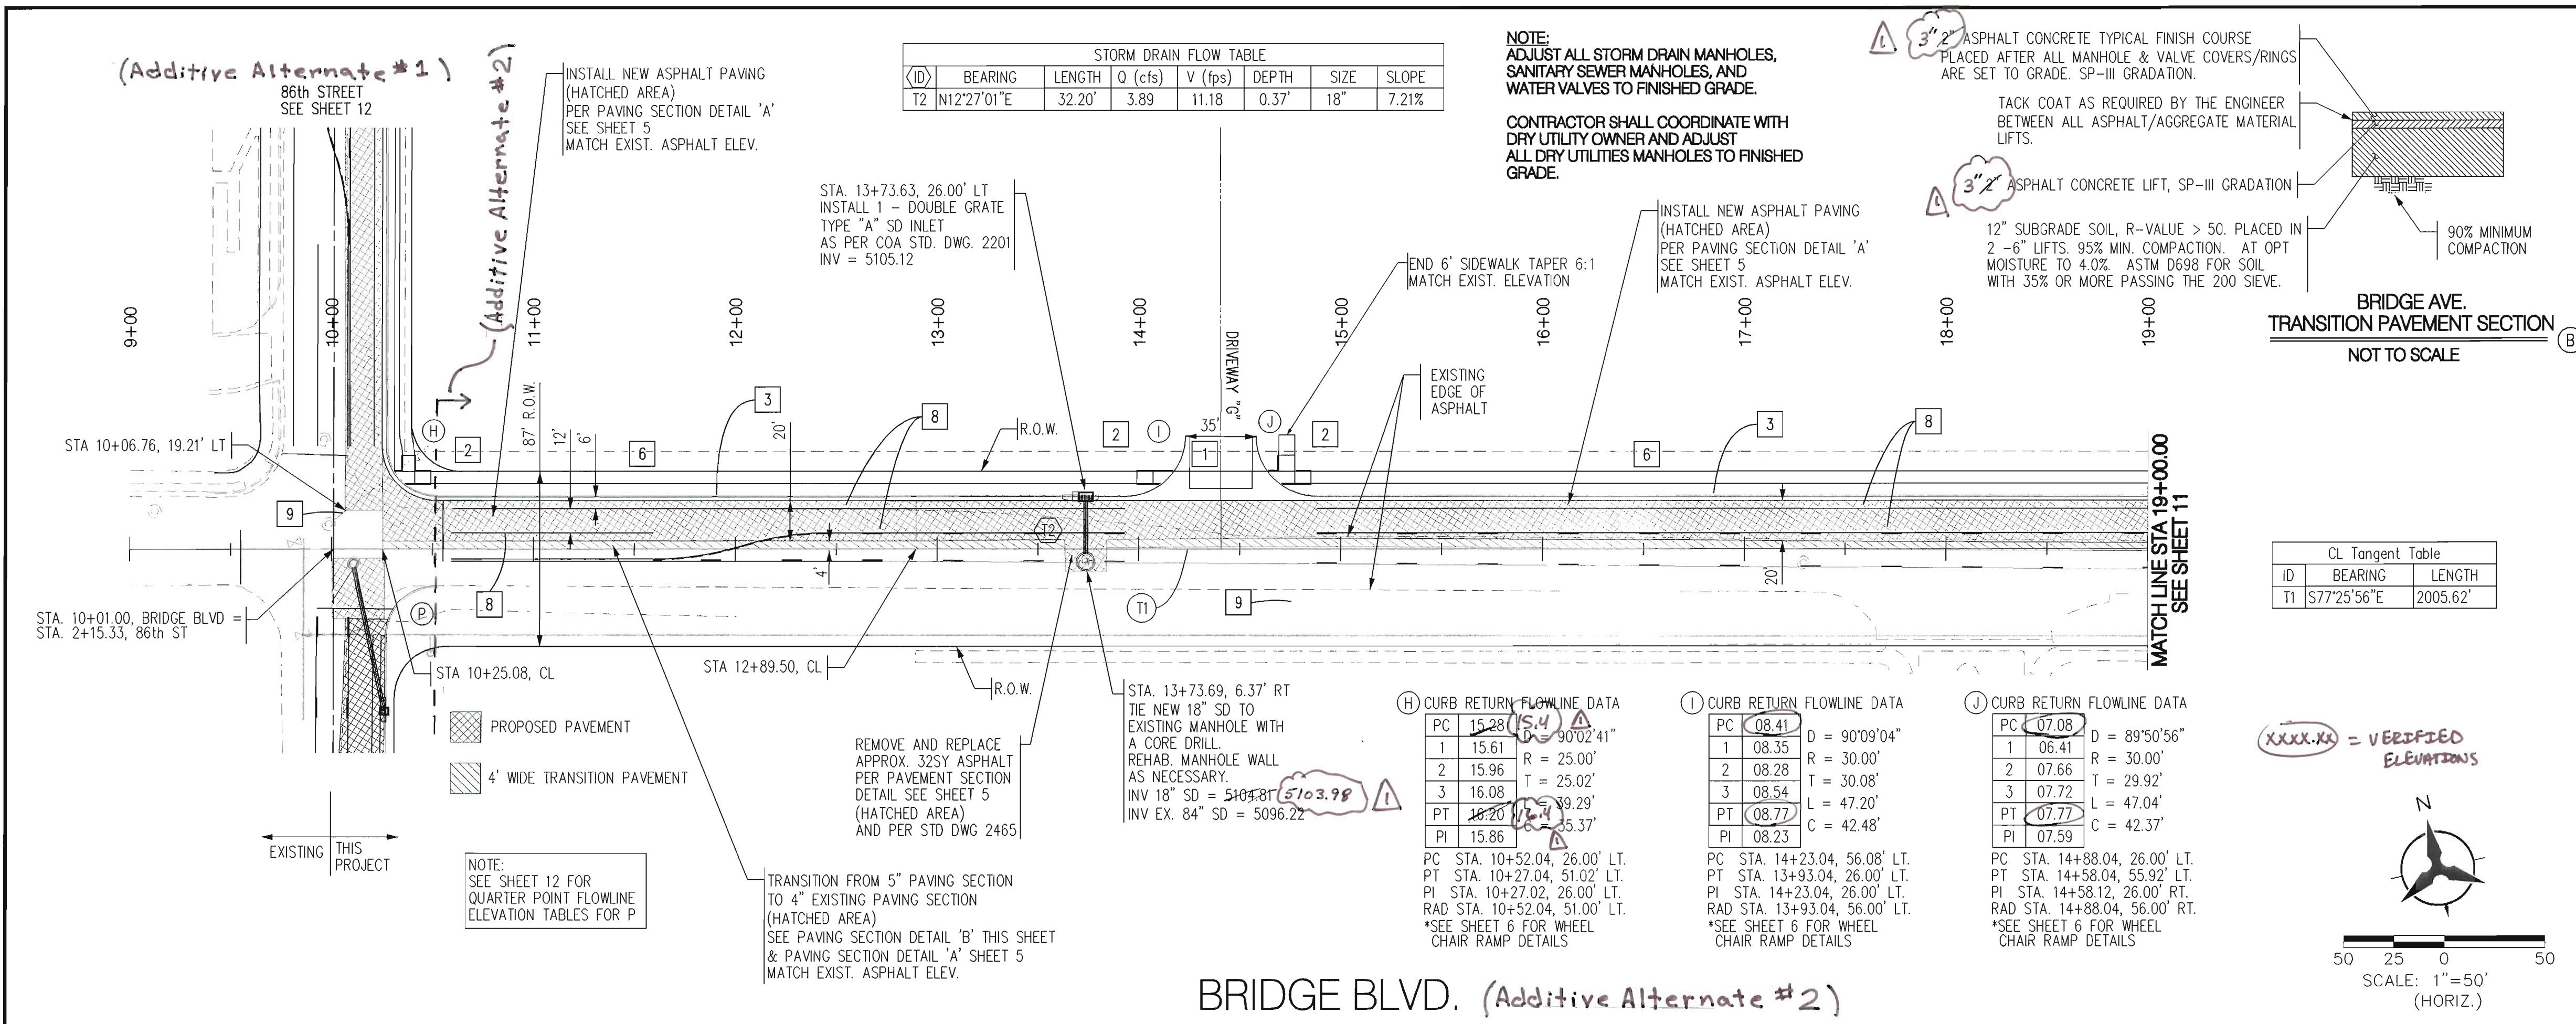

NOTES

- THE CONTRACTOR SHALL FIELD VERIFY ALL EXISTING UTILITY LOCATIONS AND NOTIFY THE ENGINEER IMMEDIATELY OF ANY DISCREPANCIES.
- ALL CURB RETURN RADII SHALL BE 25' UNLESS OTHERWISE SPECIFIED.
- ALL CURVE DATA AND DIMENSIONS REFER TO FACE OF CURB UNLESS OTHERWISE SPECIFIED.
- GRADE ELEVATIONS, WHERE NOTED, ARE ALONG FLOWLINE OF CURB UNLESS OTHERWISE SPECIFIED.
- CONTRACTOR IS TO INSTALL A 4" X 4" X 5' POST AND END AT THE END OF EACH SANITARY SEWER SERVICE.
- CONTRACTOR IS RESPONSIBLE FOR REPAIR AND/OR REPLACEMENT OF ALL UTILITY CONDUITS AND EXISTING LINES.
- ANY ADDITIONAL GRADING REQUIRED TO MATCH PROPOSED STREET GRADES SHALL BE INCIDENTAL TO PAVING ITEMS.
- CONTRACTOR SHALL PROVIDE THE INSPECTORS, (CITY AND PRIVATE) WITH THE PROPOSED HYDROSTATIC TESTING PLAN. THE PLAN MUST BE APPROVED BEFORE TESTING OPERATIONS BEGIN.
- CONTRACTOR SHALL PARK EQUIPMENT AND VEHICLES AS NOT TO INTERFERE WITH NORMAL ACTIVITIES OF RESIDENTS OR OTHER CONTRACTORS ON SITE.
- ANY DAMAGE TO THE EXISTING FACILITIES (CURB & GUTTER), PAVEMENT, CONDUITS, LANDSCAPING, UTILITY LINES, ETC.) DURING CONSTRUCTION SHALL BE REPLACED AT THE CONTRACTORS' EXPENSE.
- REMOVAL OF THE EXISTING CURB AND GUTTER SHALL BE AS PER COA STD. DWG. 2415A (SAWCUT ONLY).
- WHEELCHAIR RAMPS SHALL BE CONSTRUCTED PRIOR TO ACCEPTANCE OF CURB & GUTTER.
- RCP SHALL BE INSTALLED SO THAT THE JOINT GAP AT THE HOME POSITION SHALL CONFORM TO THE APPROVED MANUFACTURER'S RECOMMENDATIONS. MANUFACTURER'S RECOMMENDED JOINT GAP TOLERANCES FOR EACH PIPE SIZE AND TYPE SHALL BE SUBMITTED TO THE ENGINEER FOR APPROVAL PRIOR TO PLACEMENT OF PIPE. RCP JOINTS SHALL NOT BE GROUTED UNLESS DIRECTED BY THE ENGINEER AFTER CITY APPROVAL.
- ALL EXCAVATION, TRENCHING, AND SHORING ACTIVITIES MUST BE CARRIED-OUT IN ACCORDANCE WITH OSHA 29 CFR 1926.650 SUBPART P.

KEYED GENERAL NOTES

- INSTALL 6" CONCRETE VALLEY GUTTER AS PER STD. DWG. 2420
- INSTALL WHEELCHAIR RAMP AS PER DETAIL SHEET 6
- STD. CURB & GUTTER PER STD. DWG. 2415A
- MEDIAN CURB & GUTTER PER STD. DWG. 2415B
- EXTRUDED ASPHALT CURB PER STD. DWG. 2415B
- BUILD 6" SIDEWALK PER STD. DWG. 2430
- BUILD 4" TEXTURED MEDIAN PAVEMENT FROM MEDIAN NOSE TO 10' FROM NOSE OR TO 5' MIN. WIDTH F-F AS SHOWN ON PLANS. COLOR TO BE DETERMINED BY CITY PROJECT MANAGER. MEDIAN NOSES SHALL BE PAINTED YELLOW TO APPROX. 6' BEHIND PC/PT PER COA STD DWG 2408 & 2502
- FOR STRIPING PLAN SEE SHEET 13
- UTILITY CONNECTIONS DETAILED UNDER COA WO #735661. ALL UTILITY CONNECTIONS SHALL BE INSTALLED PRIOR TO COMPLETION OF PAVING. CONTRACTOR SHALL COORDINATE WITH ON-SITE UTILITY CONTRACTOR PRIOR TO PAVING IN BRIDGE BLVD.


GENERAL NOTE:
ALL STORM DRAIN MANHOLES SHALL BE 6' DIAMETER TYPE "E" AS PER STANDARD DRAWING 2102 UNLESS OTHERWISE NOTED.


Bohannon & Huston
Court yard | 7500 Jefferson St. NE Albuquerque, NM 87109-4335
ENGINEERING SPATIAL DATA ADVANCED TECHNOLOGIES

CITY OF ALBUQUERQUE
DEPARTMENT OF MUNICIPAL DEVELOPMENT
OFFSITE PUBLIC INFRASTRUCTURE - UNSER CROSSING
PAVING PLAN & PROFILE
BRIDGE BLVD. STA 9+00 - STA 19+00

DESIGN REVIEW COMMITTEE	CITY ENGINEER APPROVAL	MO./DAY/YR.	MO./DAY/YR.
APPROVE OCT 30 2008 DESIGN REVIEW COMMITTEE	APPROVE OCT 31 2008 CITY ENGINEER		

CITY PROJECT NO. 735684
ZONE MAP NO. K-9 K-10
SHEET 10 OF 29

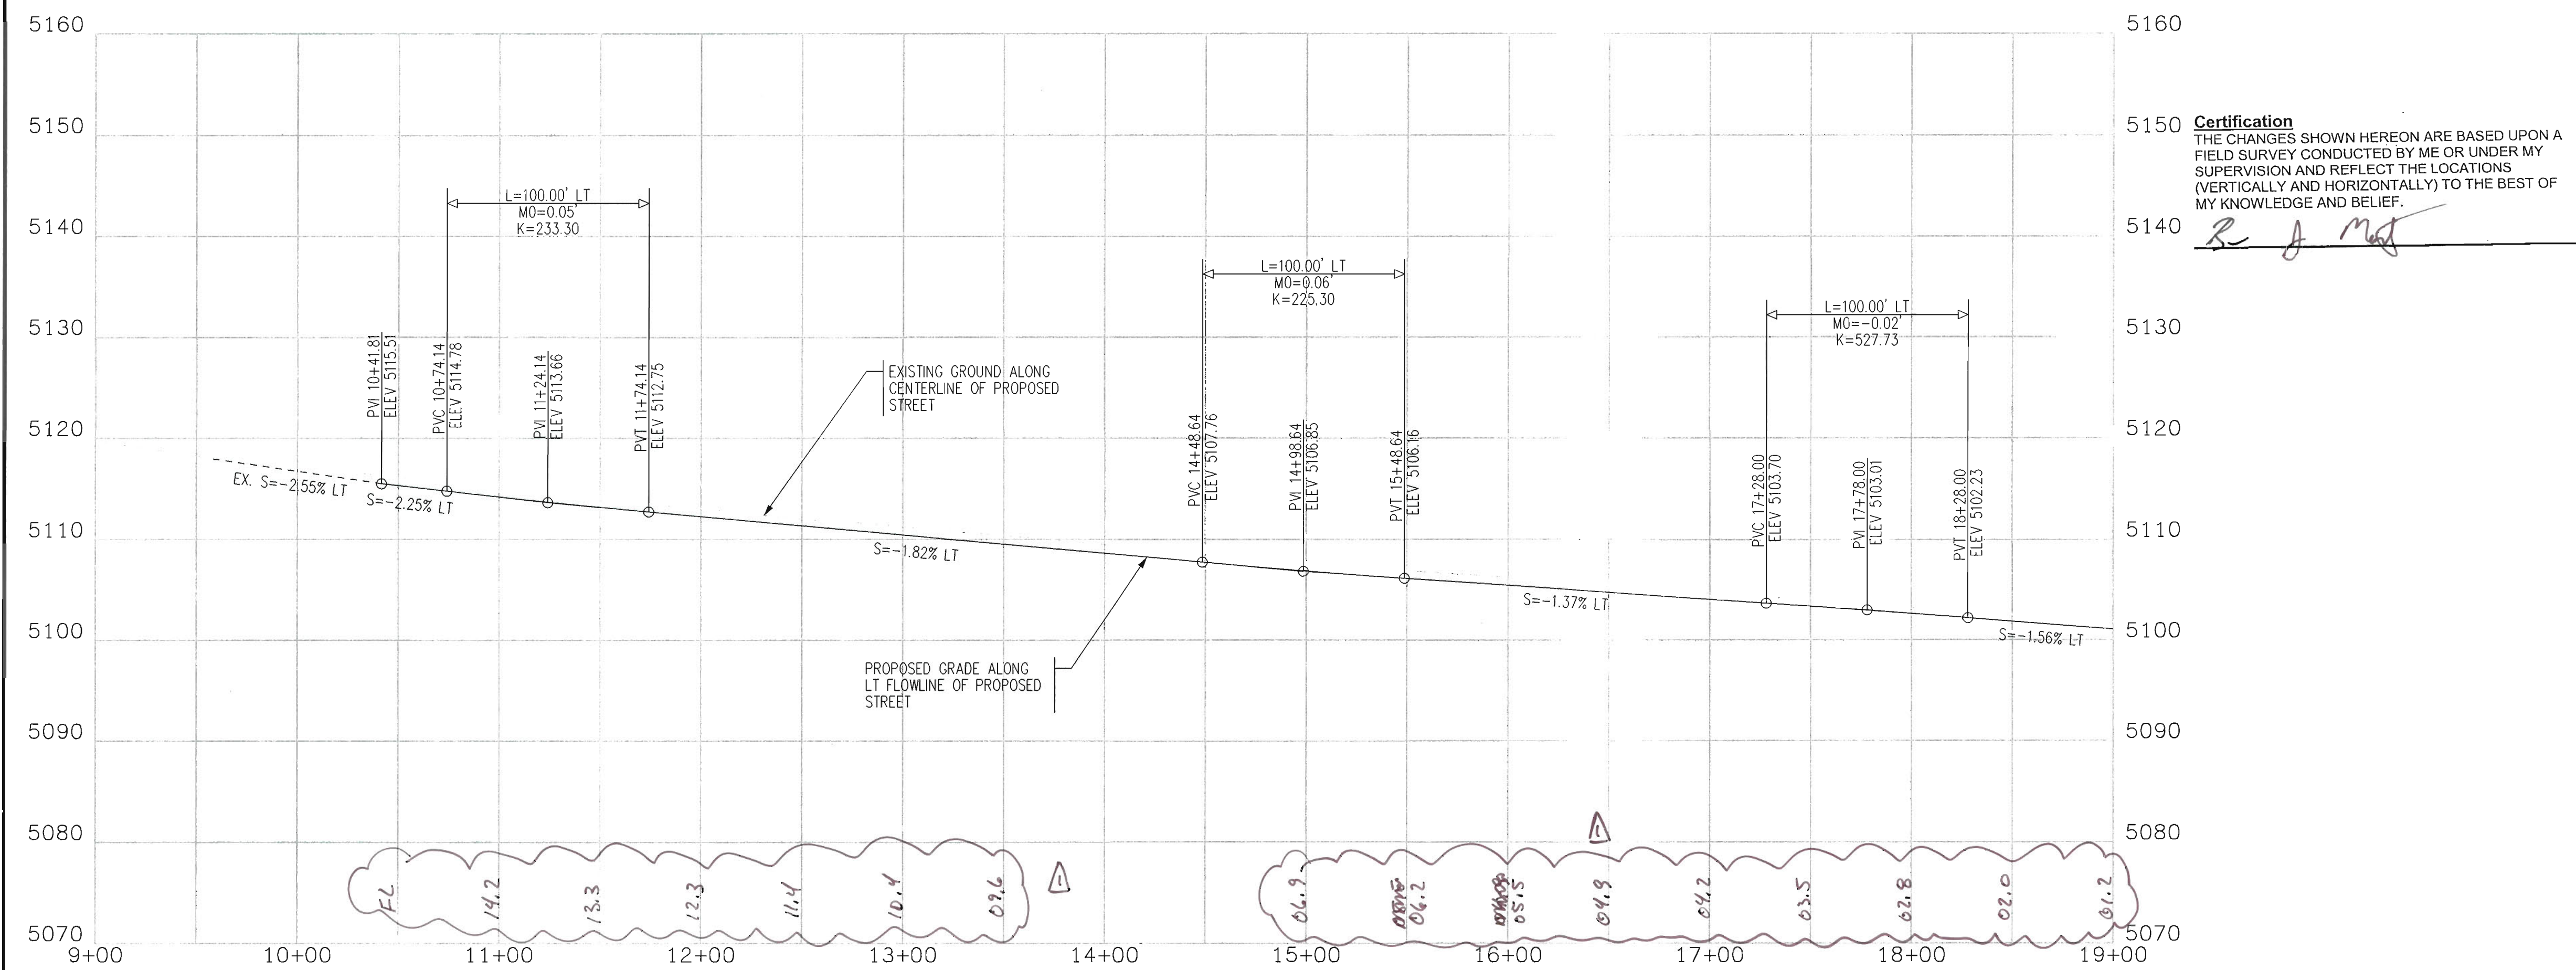

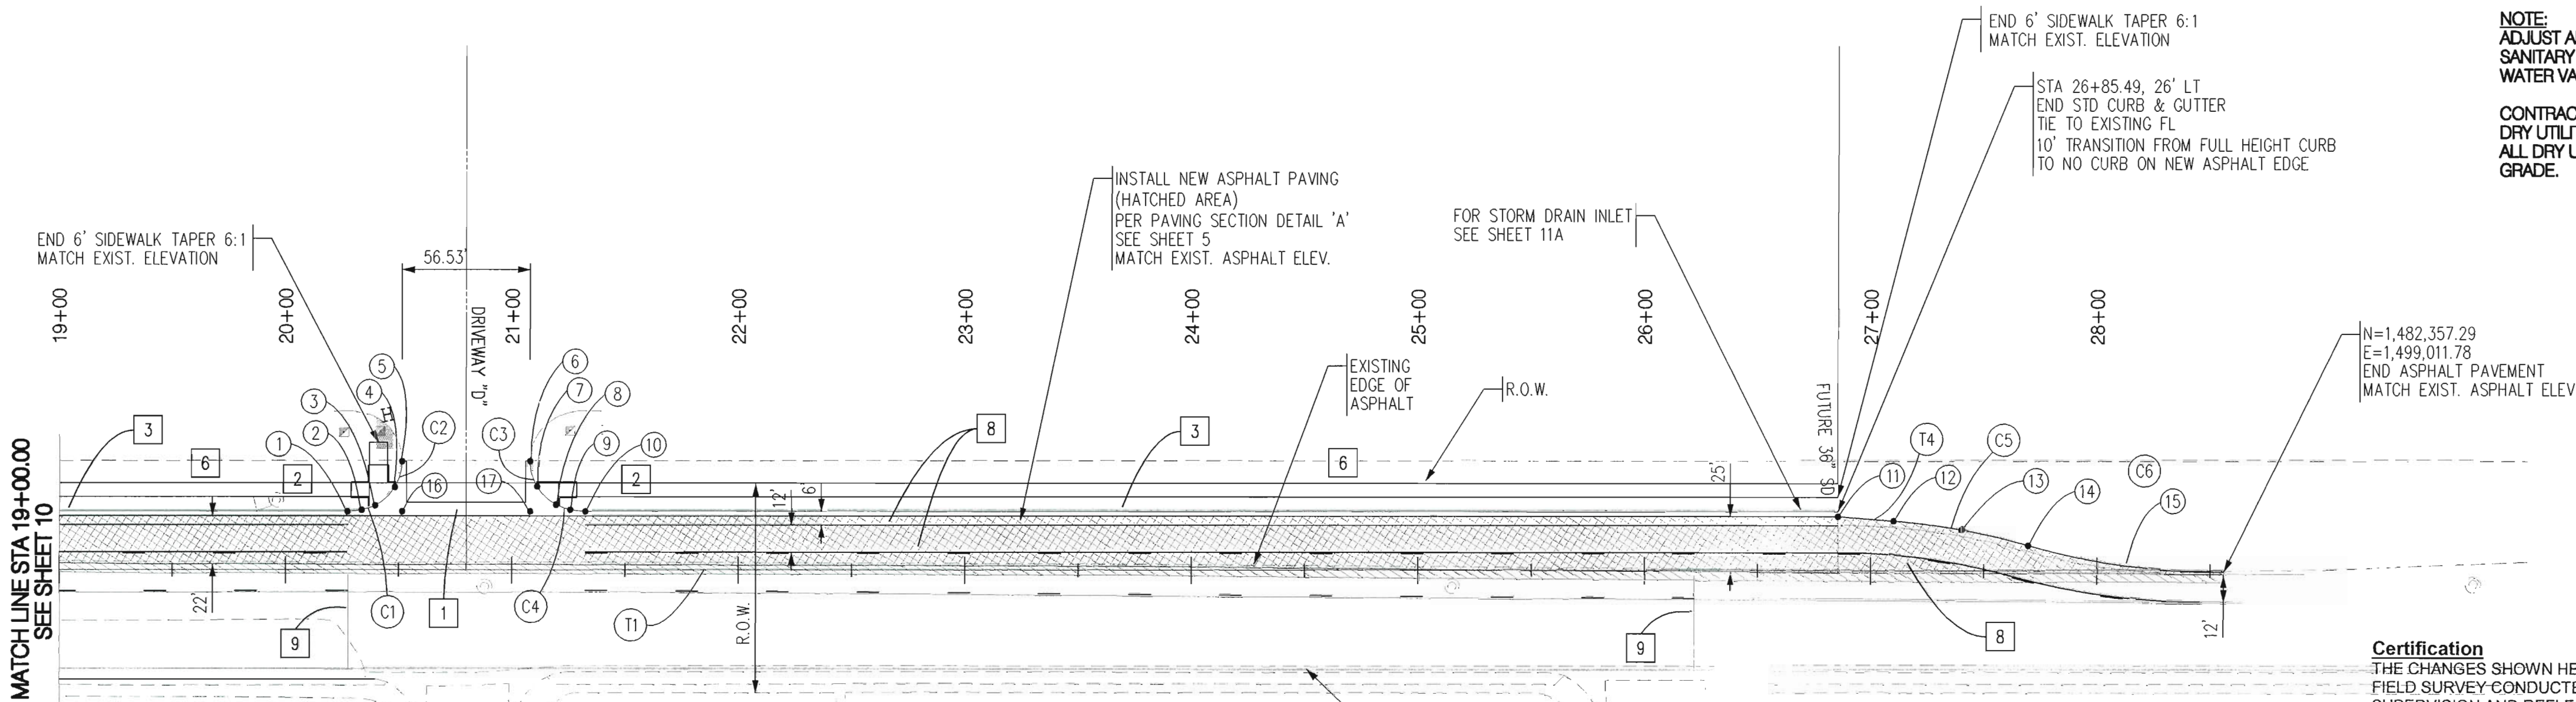

NOTE:
ADJUST ALL STORM DRAIN MANHOLES,
SANITARY SEWER MANHOLES, AND
WATER VALVES TO FINISHED GRADE.

CONTRACTOR SHALL COORDINATE WITH
DRY UTILITY OWNER AND ADJUST
ALL DRY UTILITIES MANHOLES TO FINISHED
GRADE.

Certification
THE CHANGES SHOWN HEREON ARE BASED UPON A
FIELD SURVEY CONDUCTED BY ME OR UNDER MY
SUPERVISION AND REFLECT THE LOCATIONS
(VERTICALLY AND HORIZONTALLY) TO THE BEST OF
MY KNOWLEDGE AND BELIEF.

Ben J. Met

CURB RETURN Point Table			CURB RETURN Point Table		
STATION	OFFSET	ELEVATION	STATION	OFFSET	ELEVATION
1 20+27.37	26.00' LT	5099.12	7 21+11.08	37.03' LT	5098.12
2 20+33.62	26.66' LT	5099.03	8 21+19.41	28.94' LT	5097.82
3 20+39.60	28.61' LT	5098.94	9 21+25.72	26.75' LT	5097.66
4 20+48.28	36.69' LT	5098.98	10 21+32.37	26.00' LT	5097.50
5 20+51.48	48.12' LT	5099.31	16 20+51.48	26.00' LT	5098.74
6 21+08.02	48.23' LT	5098.45	17 21+08.02	26.00' LT	5097.87


ID	ARC	RADIUS	DELTA	TANGENT
C1	12.60'	30.00'	24°03'31"	6.39'
C2	24.03'	21.95'	62°42'03"	13.38'
C3	23.20'	22.03'	61°07'50"	13.01'
C4	13.40'	30.00'	25°35'34"	6.81'

ID	BEARING	LENGTH
T1	S77°25'56"E	2005.62'


ID	ARC	RADIUS	DELTA	TANGENT
C5	60.53'	303.00'	11°26'46"	30.37'
C6	87.60'	300.00'	16°43'53"	44.12'

ID	BEARING	LENGTH
T3	S72°47'02"E	24.64'

STATION	OFFSET	ELEVATION
11 26+85.49	24.00' LT	5091.44
12 27+10.04	22.00' LT	5091.43
13 27+40.04	18.05' LT	5091.26
14 27+69.49	11.12' LT	5091.15
15 28+12.31	2.09' LT	5090.89

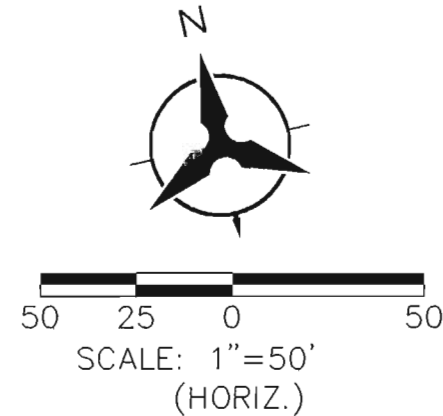

BRIDGE BLVD.
(Additive Alternate #2)

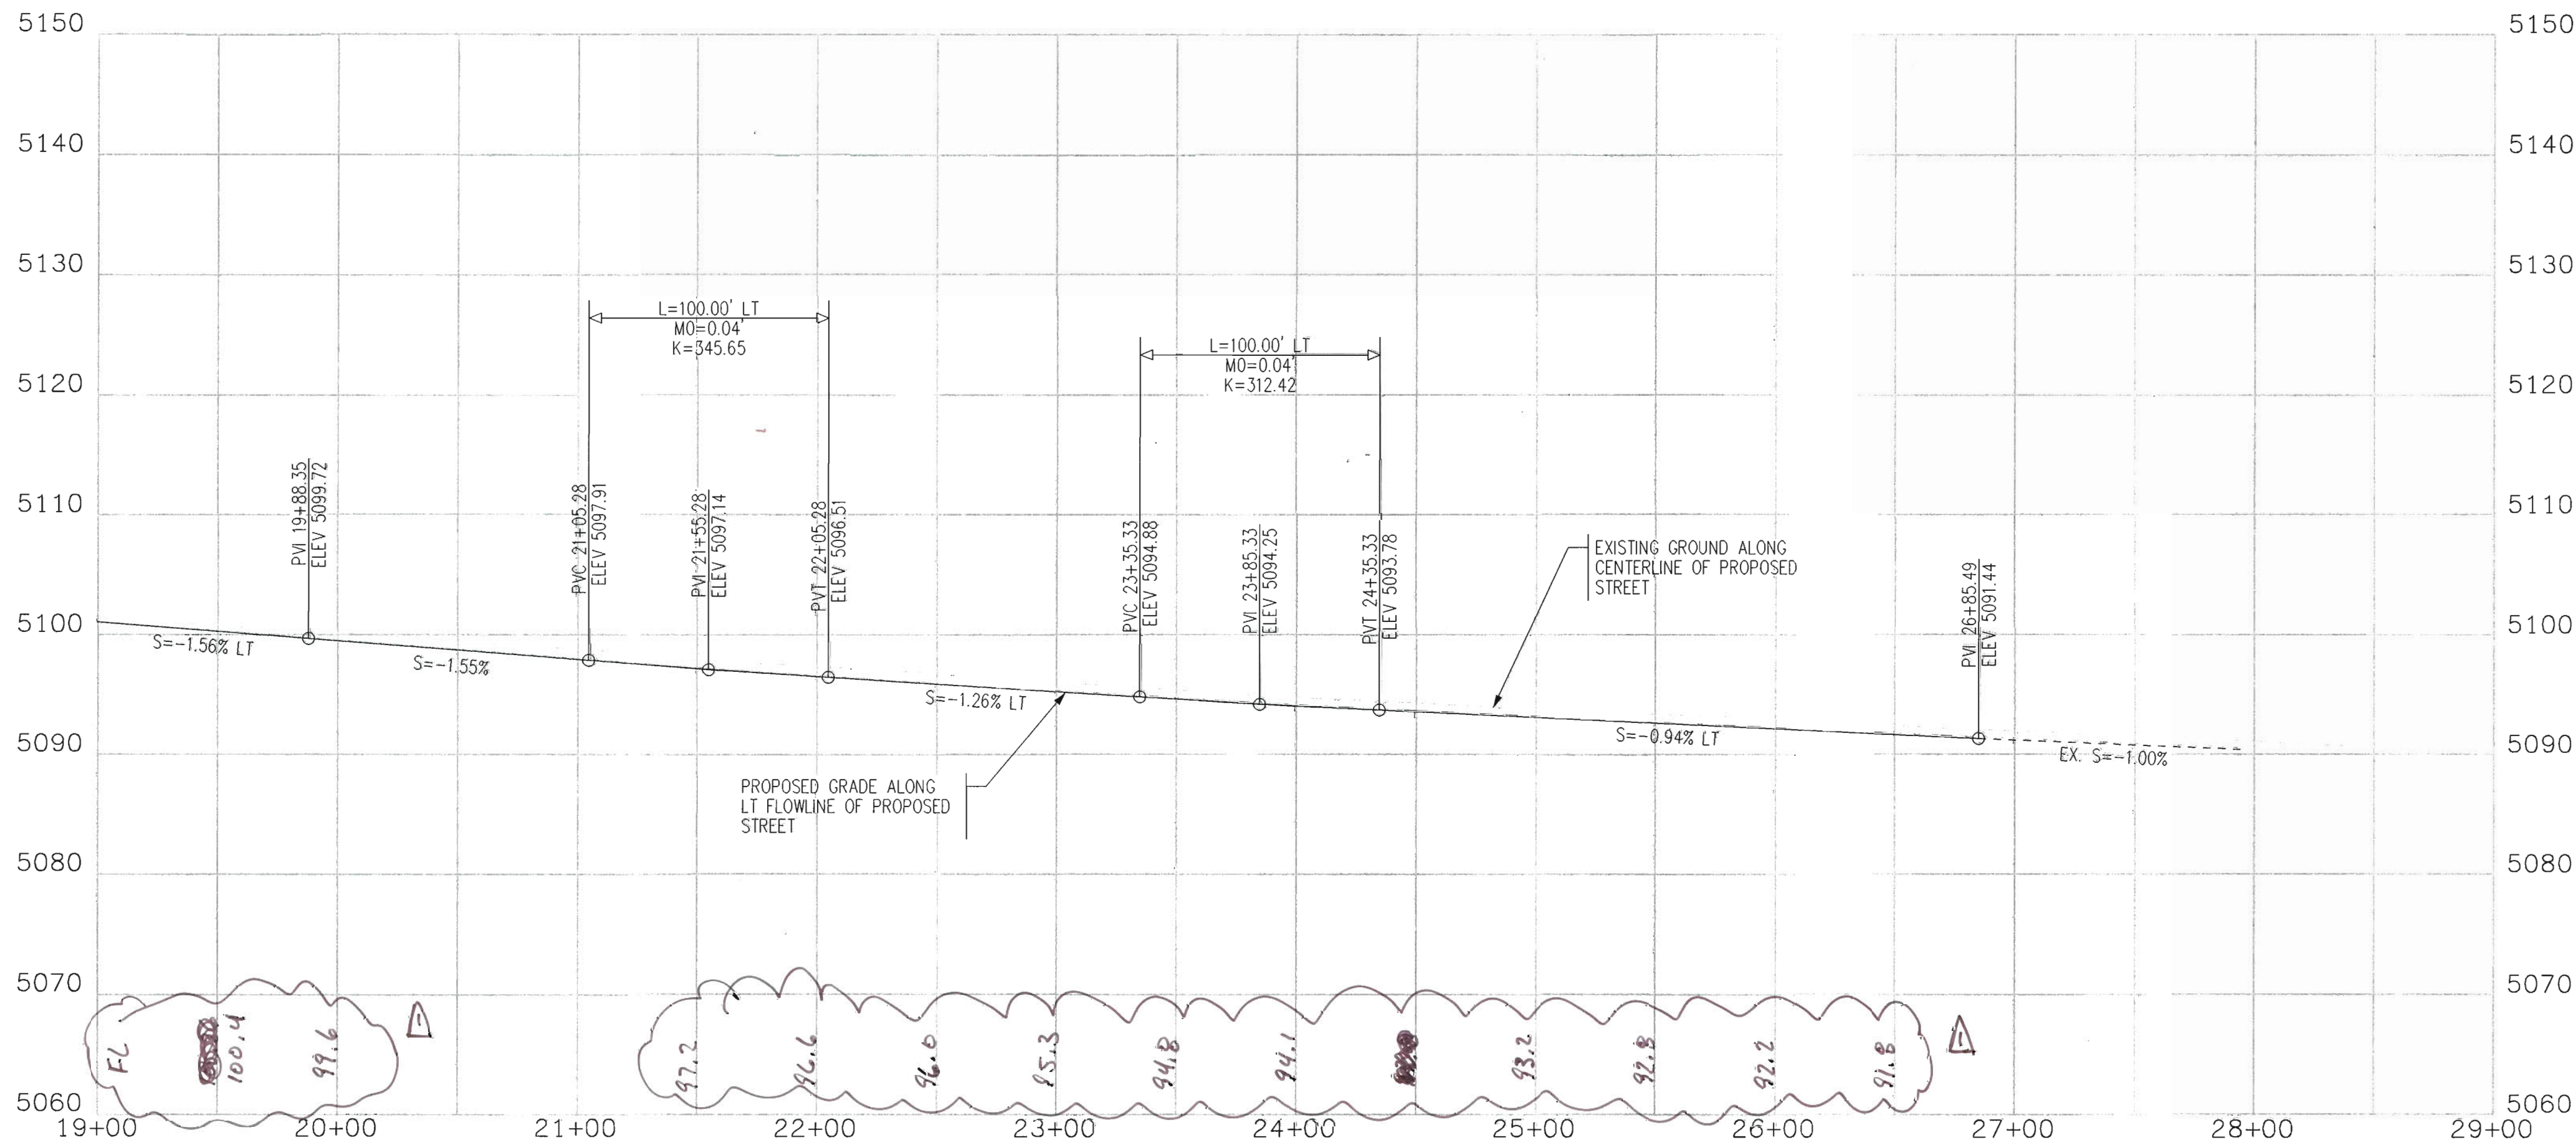

KEYED GENERAL NOTES

- 1 INSTALL 6" CONCRETE VALLEY GUTTER AS PER STD. DWG. 2420
- 2 INSTALL WHEELCHAIR RAMP AS PER DETAIL SHEET 6
- 3 STD. CURB & GUTTER PER STD. DWG. 2415A
- 4 MEDIAN CURB & GUTTER PER STD. DWG. 2415B
- 5 EXTRUDED ASPHALT CURB PER STD. DWG. 2415B
- 6 BUILD 6' SIDEWALK PER STD. DWG. 2430
- 7 BUILD 4" TEXTURED MEDIAN PAVEMENT FROM MEDIAN NOSE TO 10' FROM NOSE OR TO 5' MIN. WIDTH F-F AS SHOWN ON PLANS. COLOR TO BE DETERMINED BY CITY PROJECT MANAGER. MEDIAN NOSES SHALL BE PAINTED YELLOW TO APPROX. 6' BEHIND PC/PT PER COA STD DWG 2408 & 2502
- 8 FOR STRIPING PLAN SEE SHEET 13
- 9 UTILITY CONNECTIONS DETAILED UNDER COA WO #735661. ALL UTILITY CONNECTIONS SHALL BE INSTALLED PRIOR TO COMPLETION OF PAVING. CONTRACTOR SHALL COORDINATE WITH ON-SITE UTILITY CONTRACTOR PRIOR TO PAVING IN BRIDGE BLVD.

GENERAL NOTE:
ALL STORM DRAIN MANHOLES SHALL BE
6" DIAMETER TYPE "E" AS PER STANDARD
DRAWING 2102 UNLESS OTHERWISE NOTED.



Bohannon & Huston
Courtney I 7500 Jefferson St. NE Albuquerque, NM 87109-4335
ENGINEERING SPATIAL DATA ADVANCED TECHNOLOGIES

CITY OF ALBUQUERQUE
DEPARTMENT OF
MUNICIPAL DEVELOPMENT

OFFSITE PUBLIC INFRASTRUCTURE - UNSER CROSSING
PAVING PLAN & PROFILE
BRIDGE BLVD. STA 19+00 - STA 28+50


DESIGN REVIEW COMMITTEE	CITY ENGINEER APPROVAL	MO./DAY/YR.	MO./DAY/YR.
APPROVED OCT 30 2008	APPROVED OCT 31 2008		
DESIGN REVIEW COMMITTEE	CITY ENGINEER	LAST DESIGN UPDATE	

CITY PROJECT NO. 735684 ZONE MAP NO. K-9 K-10 SHEET 11 OF 29

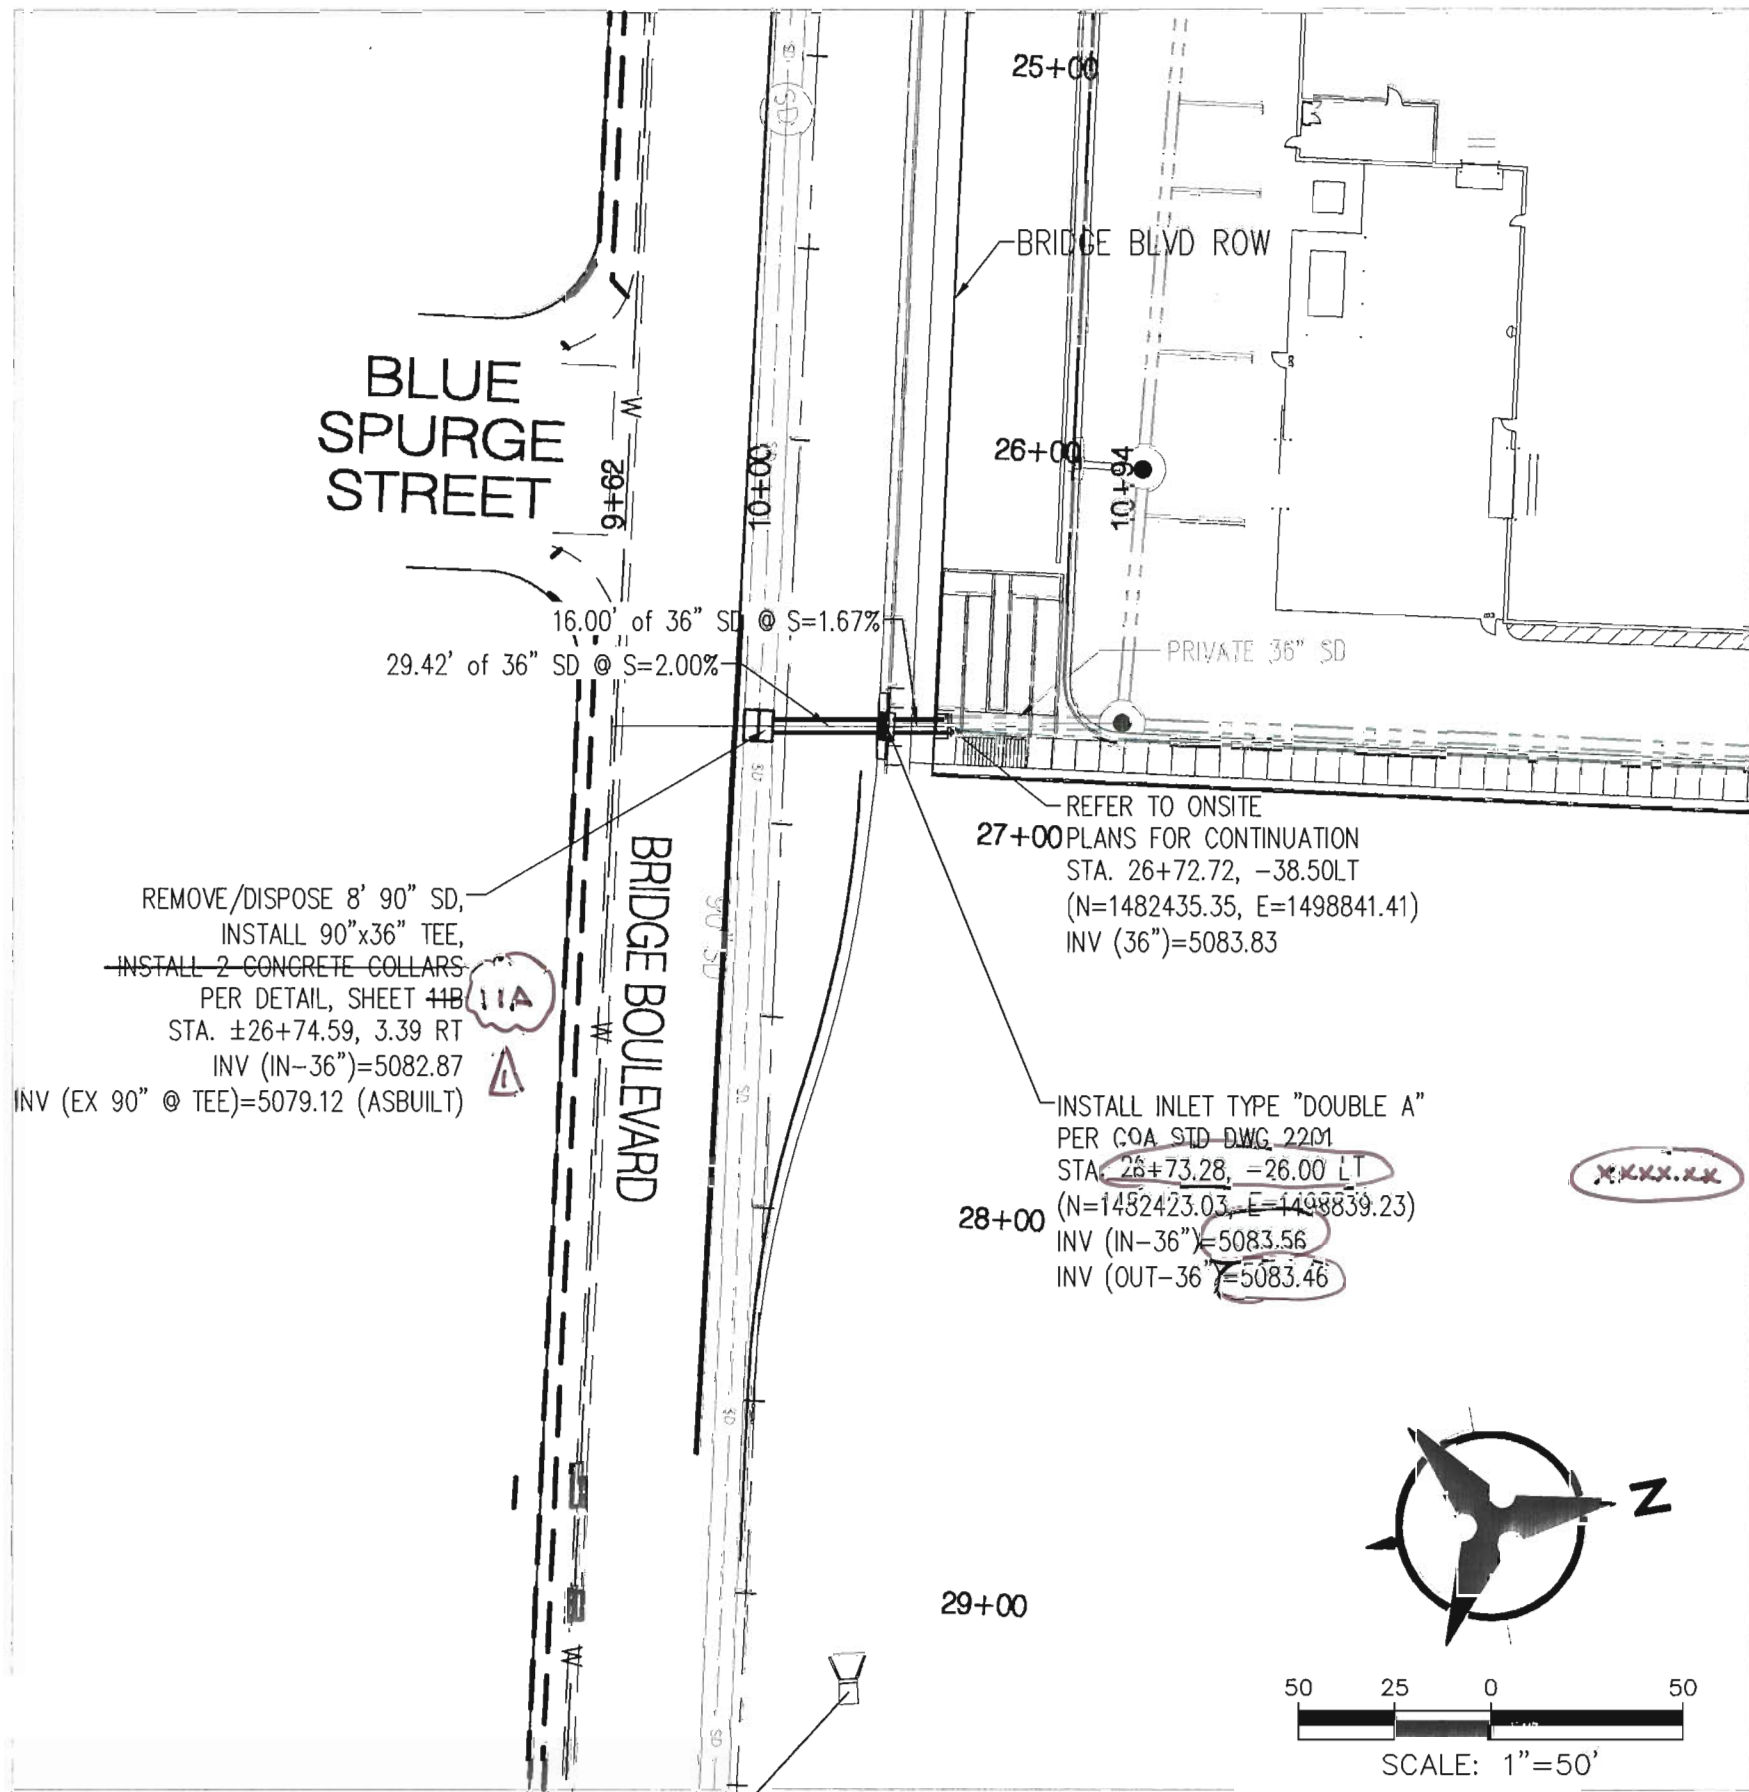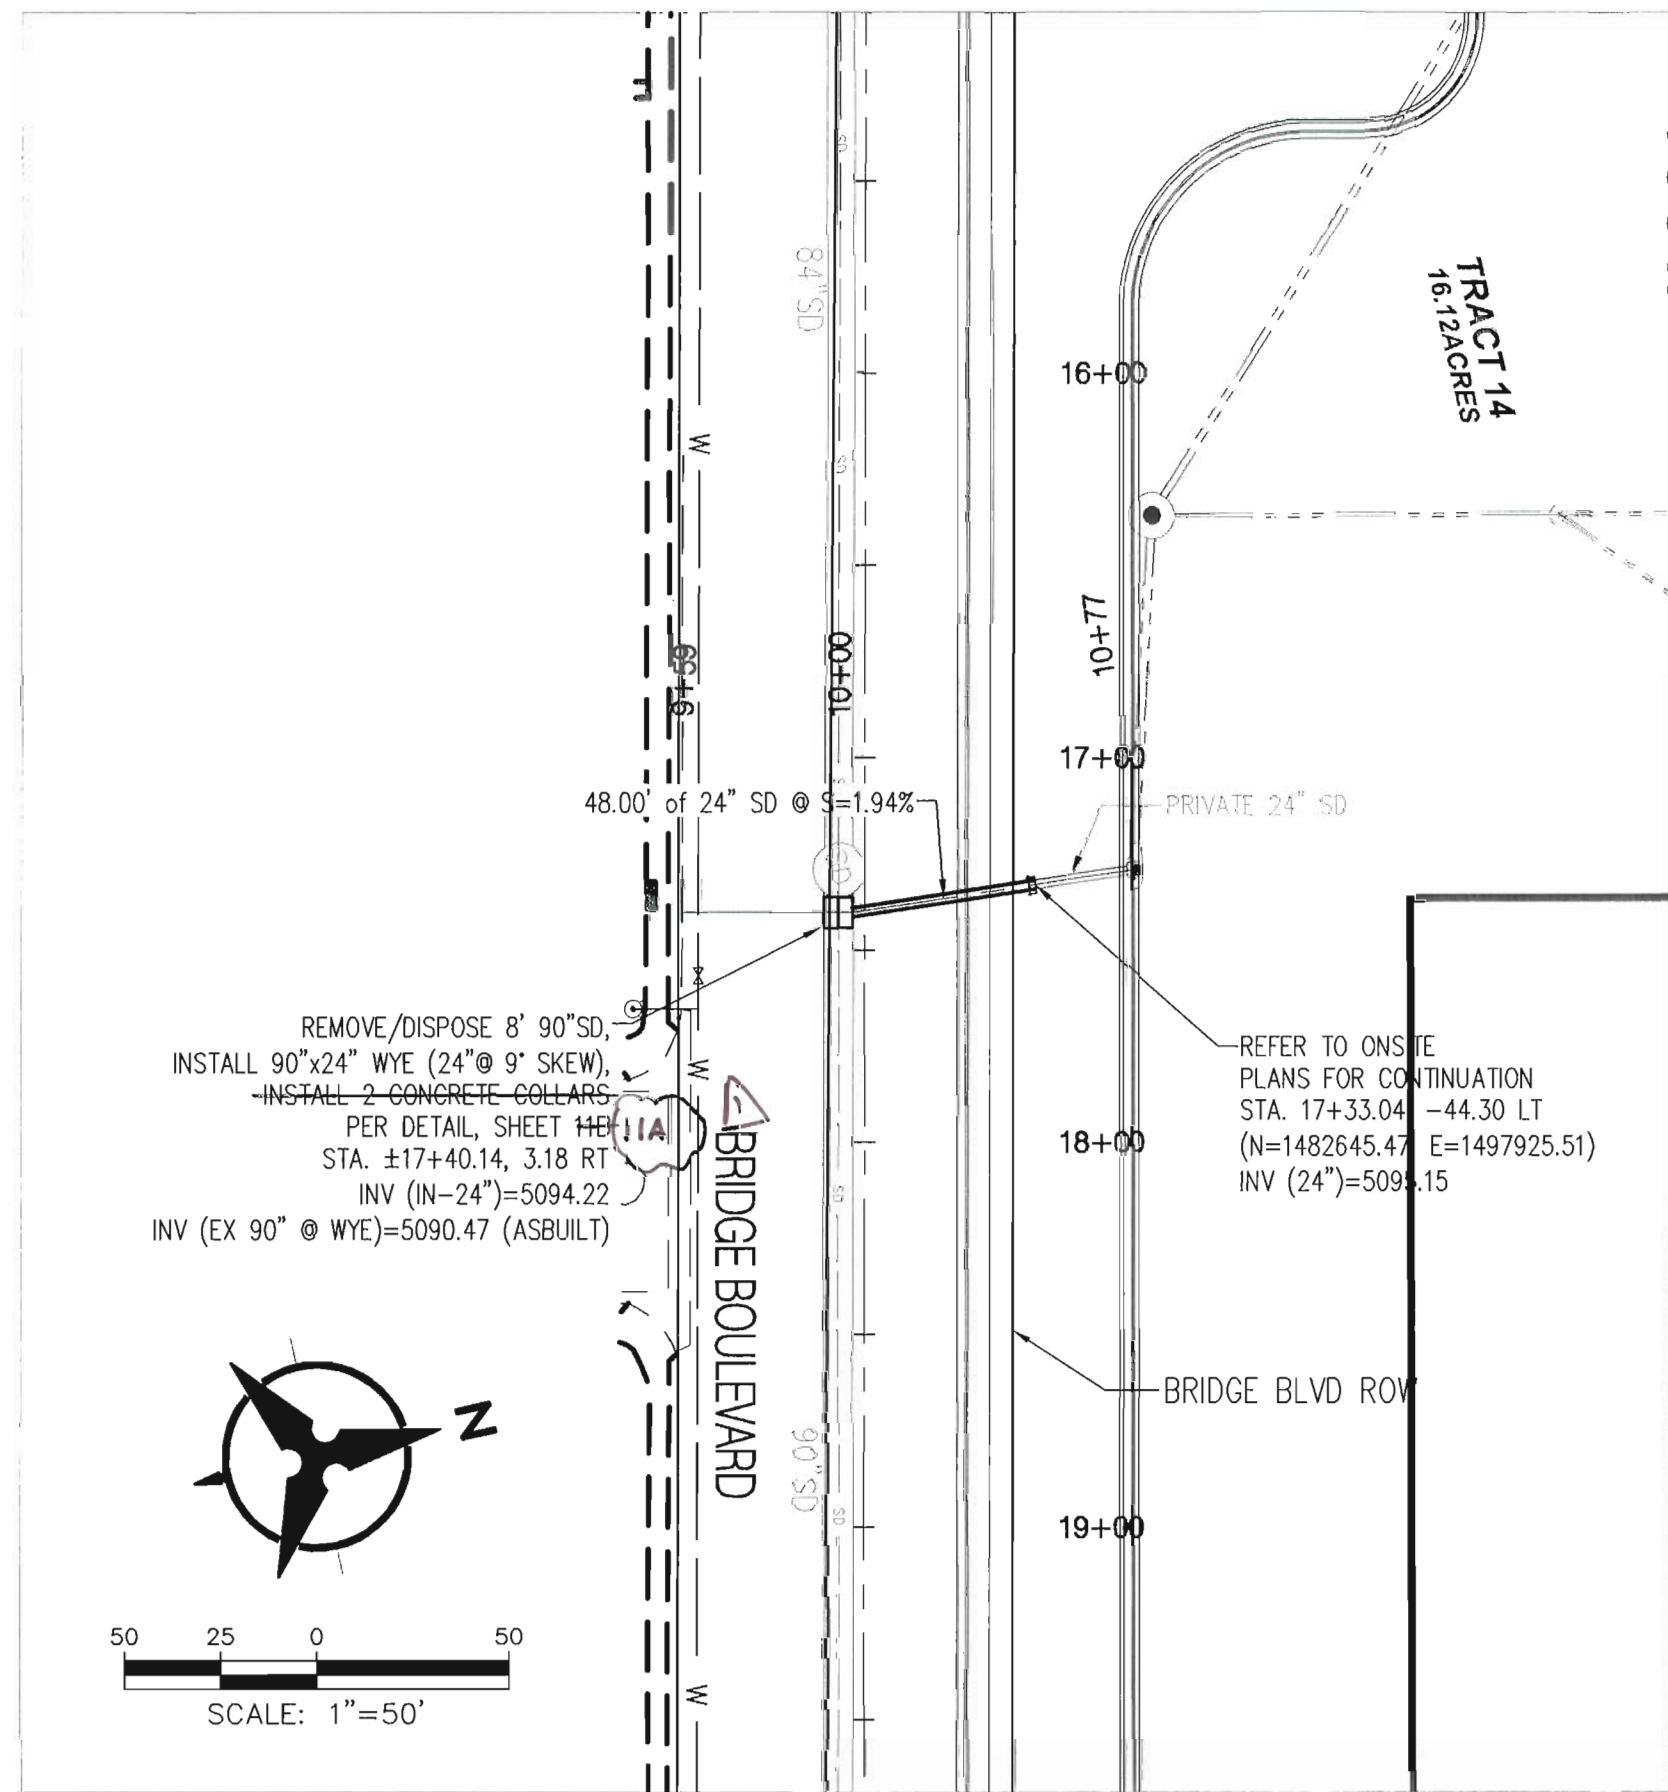

(Additive Alternate # 2)

NOTE:
CONTRACTOR SHALL LOCATE
NEAREST 8" STORM DRAIN PIPE
SECTION TO STATIONING
SHOWN FOR CONNECTION AND
IF A DISCREPANCY EXISTS FROM
PLANS CONTACT ENGINEER
IMMEDIATELY.

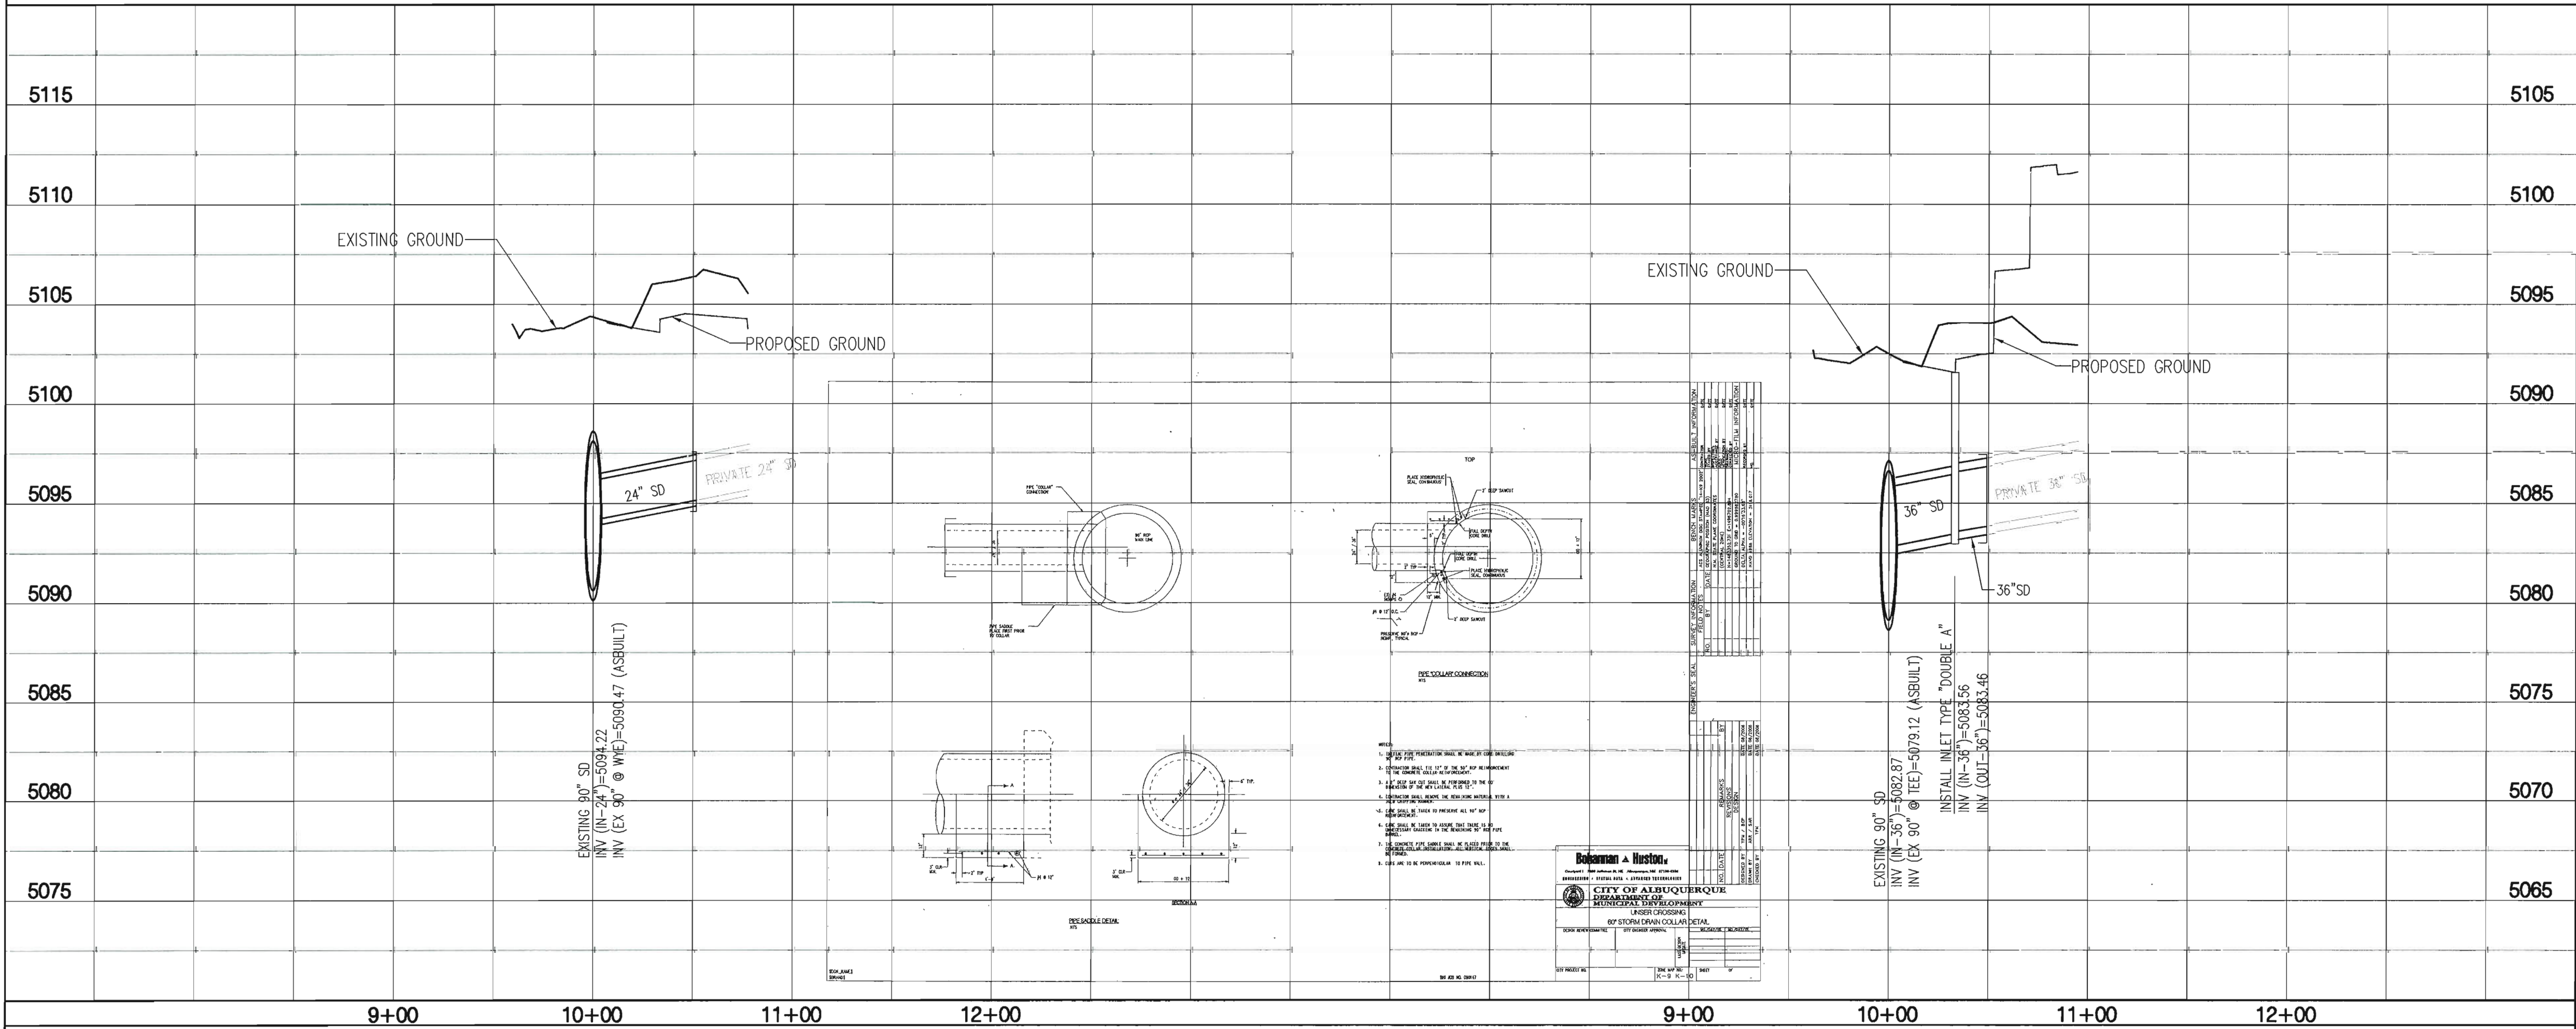


Certification
THE CHANGES SHOWN HEREON ARE BASED UPON A
FIELD SURVEY CONDUCTED BY ME OR UNDER MY
SUPERVISION AND REFLECT THE LOCATIONS
(VERTICALLY AND HORIZONTALLY) TO THE BEST OF
MY KNOWLEDGE AND BELIEF.

Bohannon & Huston
Courtney I 7600 Jefferson St NE Albuquerque, NM 87108-4336
ENGINEERING • SPATIAL DATA • ADVANCED TECHNOLOGIES


CITY OF ALBUQUERQUE
PUBLIC WORKS DEPARTMENT
OFFSITE PUBLIC INFRASTRUCTURE - UNSER CROSSING
BRIDGE BOULEVARD STORM DRAIN
PLAN AND PROFILE

Design Review Committee	City Engineer Approval	Mo./Day/Yr.	Mo./Day/Yr.
APPROVED OCT 30 2008 DESIGN REVIEW COMMITTEE	APPROVED OCT 31 2008 CITY ENGINEER		


City Project No. 735684 Zone Map No. K-9 K-10 Sheet 11A Of 29

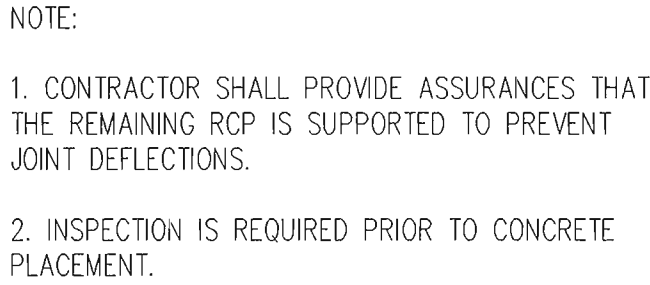

NTS

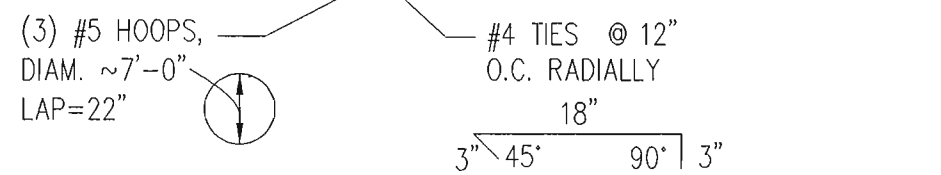


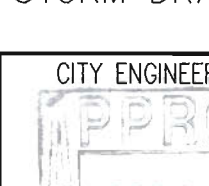



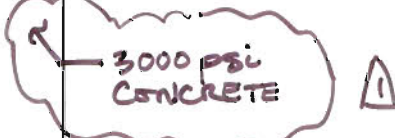
NTS



SECTION B-B

[illegible][illegible]

		DESIGNED BY: BW DRAWN BY: BW CHECKED BY: BW	
Courtyard I 7500 Jefferson St. NE Albuquerque, NM 87109-4335 ENGINEERING ▴ SPATIAL DATA ▴ ADVANCED TECHNOLOGIES		11-01	NO. DATE
 <div style="text-align: center;"> CITY OF ALBUQUERQUE DEPARTMENT OF MUNICIPAL DEVELOPMENT </div>			
OFFSITE PUBLIC INFRASTRUCTURE – UNSER CROSSING STORM DRAIN COLLAR DETAILS			
DESIGN REVIEW COMMITTEE 	CITY ENGINEER APPROVAL 	LAST DESIGN UPDATE	MO./DAY/YR. MO./DAY/YR. MO./DAY/YR. MO./DAY/YR.
CITY PROJECT NO. <div style="text-align: right; font-size: 1.5em;">735684</div>	ZONE MAP NO. <div style="text-align: right; font-size: 1.5em;">K-9 K-10</div>	DRAWING NO.	SHEET 11B OF 29

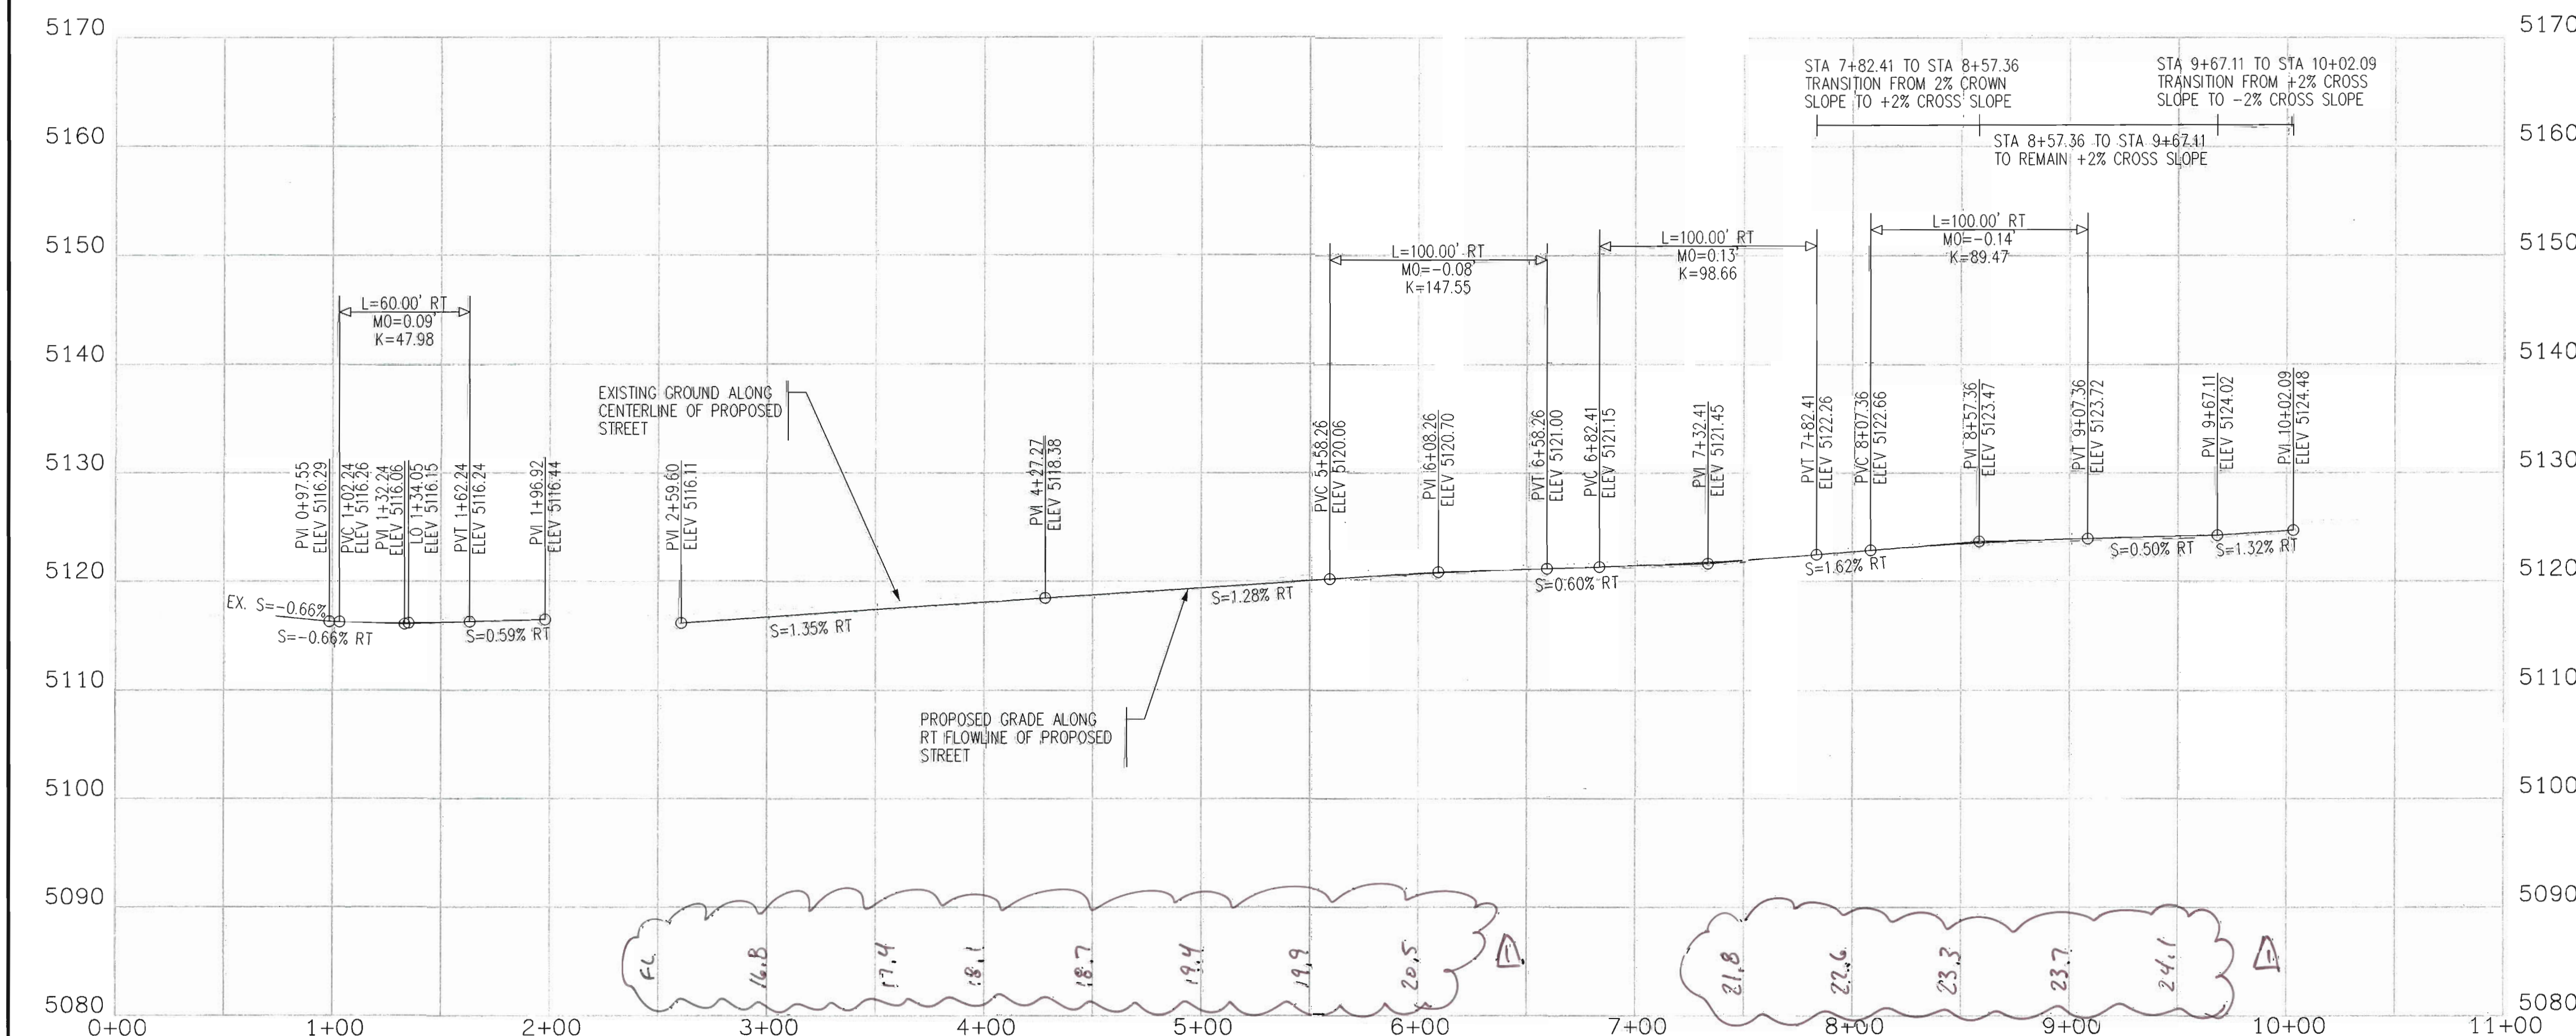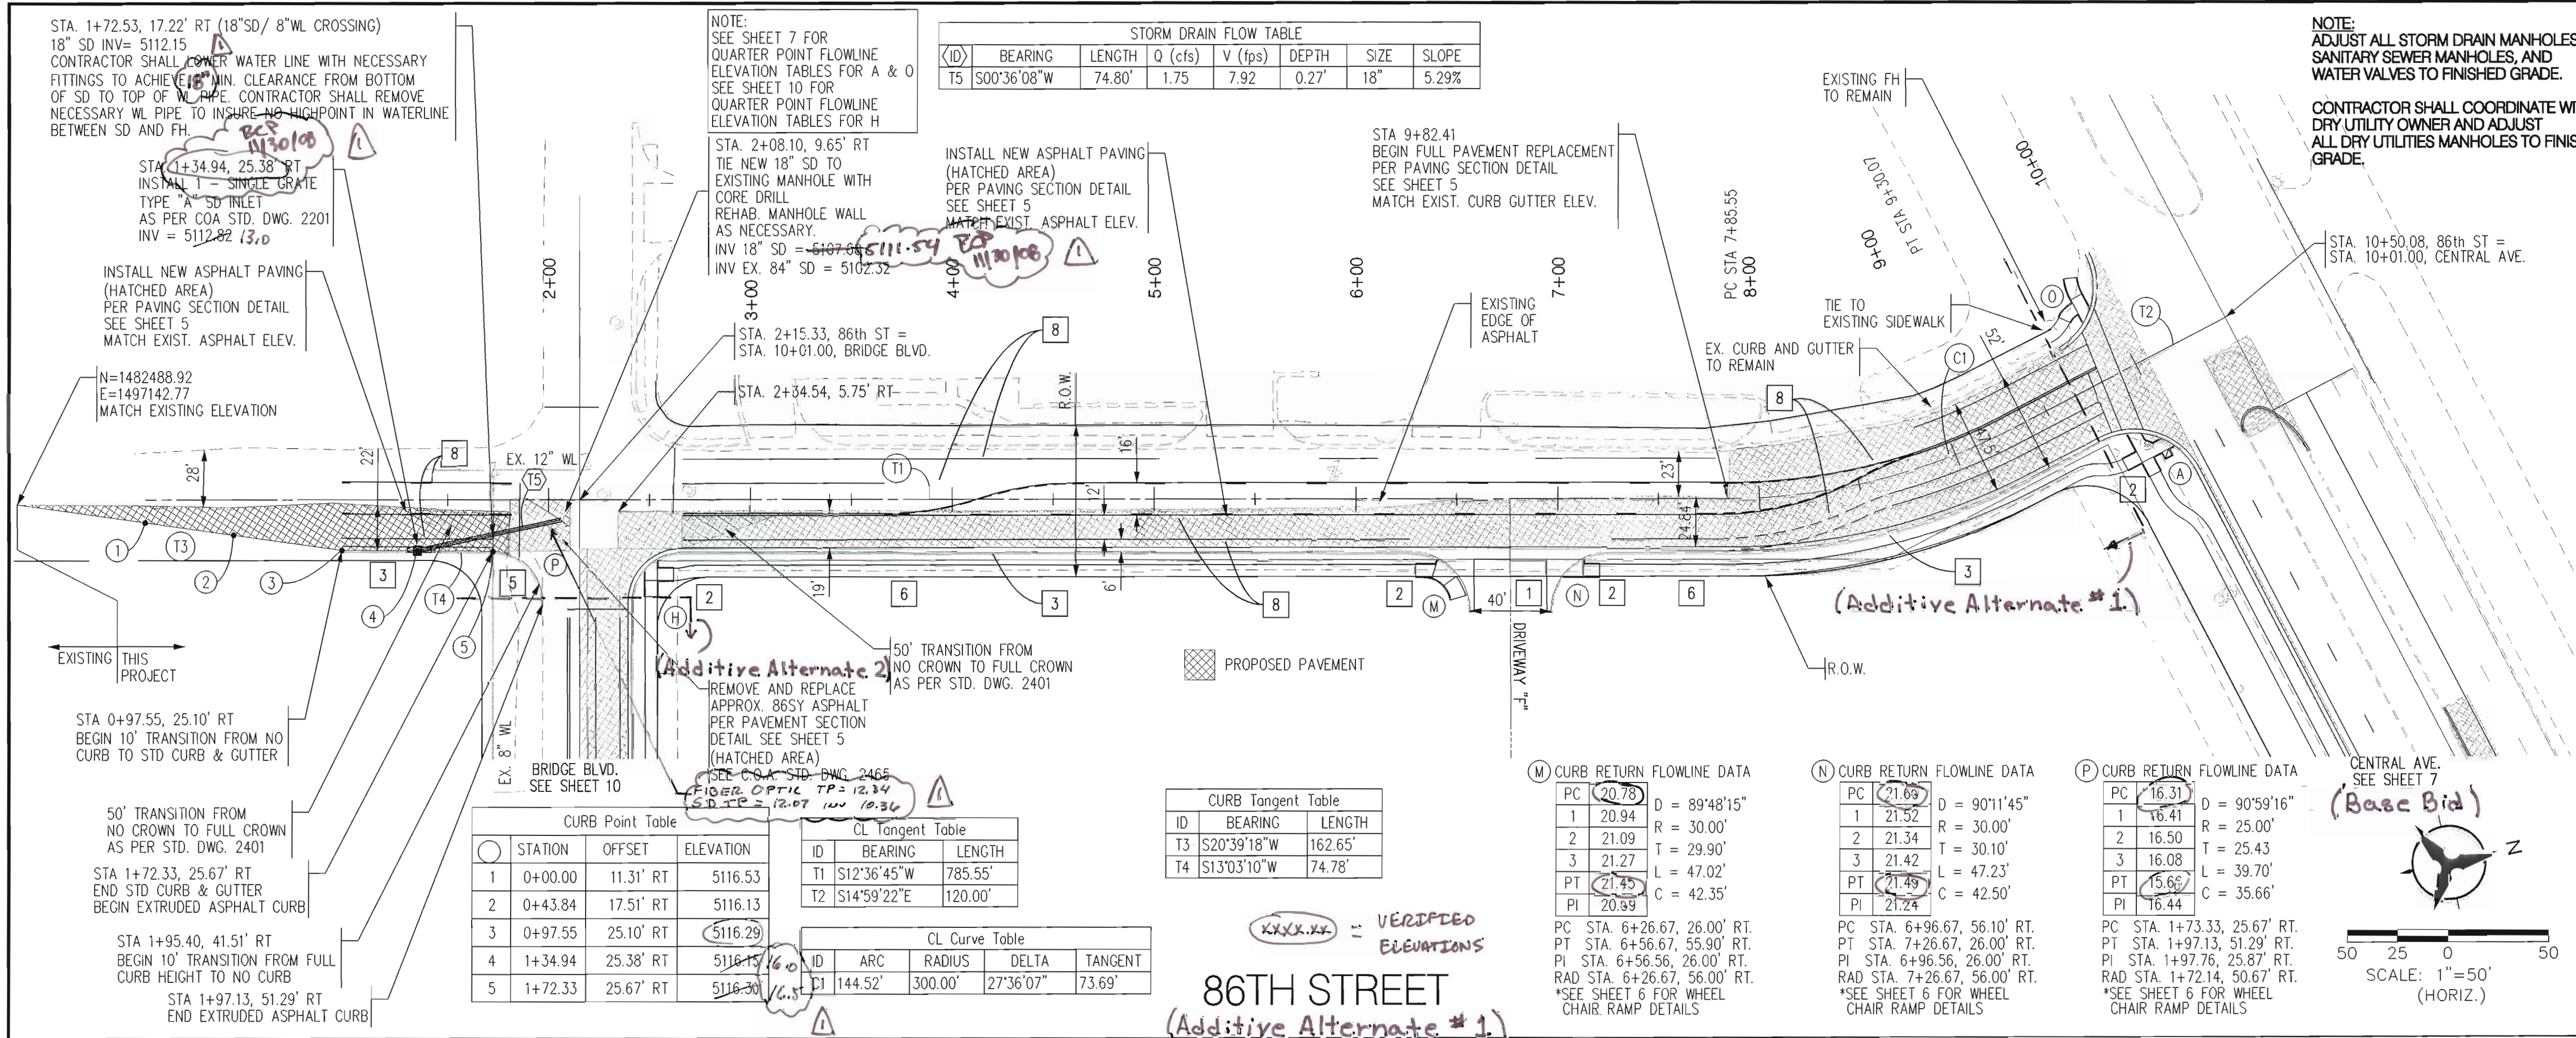


P: \090147\cdp\pnp\090147ppnp6.dgn
Mon, 20-OCT-2008 - 09:48AM, Plotted by: aromer

SCALE: 1" = 50' (HORIZ.)
1" = 10' (VERT.)

BHI JOB NO. 090147

NOTES						AS-BUILT INFORMATION											
<p>1. THE CONTRACTOR SHALL FIELD VERIFY ALL EXISTING UTILITY LOCATIONS AND NOTIFY THE ENGINEER IMMEDIATELY OF ANY DISCREPANCIES.</p> <p>2. ALL CURB RETURN RADII SHALL BE 25' UNLESS OTHERWISE SPECIFIED.</p> <p>3. ALL CURVE DATA AND DIMENSIONS REFER TO FACE OF CURB UNLESS OTHERWISE SPECIFIED.</p> <p>4. GRADE ELEVATIONS, WHERE NOTED, ARE ALONG FLOWLINE OF CURB UNLESS OTHERWISE SPECIFIED.</p> <p>5. CONTRACTOR IS TO INSTALL A 4" x 4" x 5' POST AND END AT THE END OF EACH SANITARY SEWER SERVICE.</p> <p>6. CONTRACTOR IS RESPONSIBLE FOR REPAIR AND/OR REPLACEMENT OF ALL UTILITY CONDUITS AND EXISTING LINES.</p> <p>7. ANY ADDITIONAL GRADING REQUIRED TO MATCH PROPOSED STREET GRADES SHALL BE INCIDENTAL TO PAVING ITEMS.</p> <p>8. CONTRACTOR SHALL PROVIDE THE INSPECTORS, (CITY AND PRIVATE) WITH THE PROPOSED HYDROSTATIC TESTING PLAN. THE PLAN MUST BE APPROVED BEFORE TESTING OPERATIONS BEGIN.</p> <p>9. CONTRACTOR SHALL PARK EQUIPMENT AND VEHICLES AS NOT TO INTERFERE WITH NORMAL ACTIVITIES OF RESIDENTS OR OTHER CONTRACTORS ON SITE.</p> <p>10. ANY DAMAGE TO THE EXISTING FACILITIES (CURB & GUTTER), PAVEMENT, CONDUITS, LANDSCAPING, UTILITY LINES, ETC.) DURING CONSTRUCTION SHALL BE REPLACED AT THE CONTRACTORS' EXPENSE.</p> <p>11. REMOVAL OF THE EXISTING CURB AND GUTTER SHALL BE AS PER COA STD. DWG. 2415A (SAW CUT ONLY).</p> <p>12. WHEELCHAIR RAMPS SHALL BE CONSTRUCTED PRIOR TO ACCEPTANCE OF CURB & GUTTER.</p> <p>13. RCP SHALL BE INSTALLED SO THAT THE JOINT GAP AT THE HOLE POSITION SHALL CORRELATE TO THE APPROVED MANUFACTURER'S RECOMMENDATIONS. MANUFACTURER'S RECOMMENDED JOINT GAP TOLERANCES FOR EACH PIPE SIZE AND TYPE SHALL BE SUBMITTED TO THE ENGINEER FOR APPROVAL PRIOR TO PLACEMENT OF PIPE. RCP JOINTS SHALL NOT BE GROUDED UNLESS DIRECTED BY THE ENGINEER AFTER CITY APPROVAL.</p> <p>14. ALL EXCAVATION, TRENCHING, AND SHORING ACTIVITIES MUST BE CARRIED-OUT IN ACCORDANCE WITH OSHA 29 CFR 1926.650 SUBPART F.</p>	<p>BENCH MARKS</p> <p>ACS ALUMINUM DISC STAMPED "14-K9 2002"</p> <p>GEOGRAPHIC POSITION (NAD 83)</p> <p>N.M. STATE PLANE COORDINATES (CENTRAL ZONE)</p> <p>N=1482352.731 E=1496702.894</p> <p>GROUND TO GRID = 0.9996682780</p> <p>DELTA ALPHA = -0016°33.63"</p> <p>NAVD 1988 ELEVATION = 5118.017'</p>			<p>CONTRACTOR <i>[Signature]</i></p> <p>DRAWINGS <i>[Signature]</i></p> <p>CHECKED BY <i>[Signature]</i></p> <p>DATE <i>[Date]</i></p>		<p>WORK <i>[Signature]</i></p> <p>STANDARD <i>[Signature]</i></p> <p>ACCEPTANCE <i>[Signature]</i></p> <p>DATE <i>[Date]</i></p>											
<p>SURVEY INFORMATION</p> <p>FIELD NOTES</p> <p>NO. _____ BY _____ DATE _____</p>						<p>ENGINEER'S SEAL</p>											
<p>KEYED GENERAL NOTES</p> <p>[1] INSTALL 6" CONCRETE VALLEY GUTTER AS PER STD. DWG. 2420</p> <p>[2] INSTALL WHEELCHAIR RAMP AS PER DETAIL SHEET 6</p> <p>[3] STD. CURB & GUTTER PER STD. DWG. 2415A</p> <p>[4] MEDIAN CURB & GUTTER PER STD. DWG. 2415B</p> <p>[5] EXTRUDED ASPHALT CURB PER STD. DWG. 2415B</p> <p>[6] BUILD 6' SIDEWALK PER STD. DWG. 2430</p> <p>[7] BUILD 4" TEXTURED MEDIAN PAVEMENT FROM MEDIAN NOSE TO 10' FROM NOSE OR TO 5' MIN. WIDTH F-F AS SHOWN ON PLANS. COLOR TO BE DETERMINED BY CITY PROJECT MANAGER. MEDIAN NOSSES SHALL BE PAINTED YELLOW TO APPROX. 6' BEHIND PC/PT PER COA STD DWG 2408 & 2502</p> <p>[8] FOR STRIPING PLAN SEE SHEET 13</p>						<p>REVISIONS</p> <table border="1" style="width: 100%;"> <thead> <tr> <th>NO.</th> <th>DATE</th> <th>BY</th> <th>REMARKS</th> </tr> </thead> <tbody> <tr> <td>1-09</td> <td></td> <td>YPM</td> <td>AS-BUILT INFORMATION</td> </tr> </tbody> </table> <p>DESIGN</p> <p>DATE 08/2008</p> <p>DESIGNED BY YPM / BCP</p> <p>DRAWN BY ARR / SAR</p> <p>CHECKED BY YPM</p>				NO.	DATE	BY	REMARKS	1-09		YPM	AS-BUILT INFORMATION
NO.	DATE	BY	REMARKS														
1-09		YPM	AS-BUILT INFORMATION														
<p>HEREON ARE BASED UPON A SITUATION SURVEY PREPARED BY ME OR UNDER MY CLOSE PERSONAL SUPERVISION AND THE LOCATIONS INDICATED THEREON ARE TRUE TO THE BEST OF MY KNOWLEDGE AND BELIEF.</p>						<p>GENERAL NOTE: ALL STORM DRAIN MANHOLES SHALL BE 6" DIAMETER TYPE "E" AS PER STANDARD DRAWING 2102 UNLESS OTHERWISE NOTED.</p>											
<p>Bohannon & Huston</p> <p>Courtyard 7500 Jefferson St NE Albuquerque, NM 87109-4335</p> <p>ENGINEERING SPATIAL DATA ADVANCED TECHNOLOGIES</p>						<p>CITY OF ALBUQUERQUE DEPARTMENT OF MUNICIPAL DEVELOPMENT</p>											
<p>OFFSITE PUBLIC INFRASTRUCTURE - UNSER CROSSING PAVING PLAN & PROFILE 86TH STREET</p>						<p>MO./DAY/YR. MO./DAY/YR.</p>											
<p>DESIGN REVIEW COMMITTEE</p>		<p>CITY ENGINEER APPROVAL</p>		<p>LAST DESIGN UPDATE</p>													
<p>CITY PROJECT NO. 735684</p>		<p>ZONE MAP NO. K-9 K-10</p>		<p>SHEET 12</p>		<p>OF 29</p>											

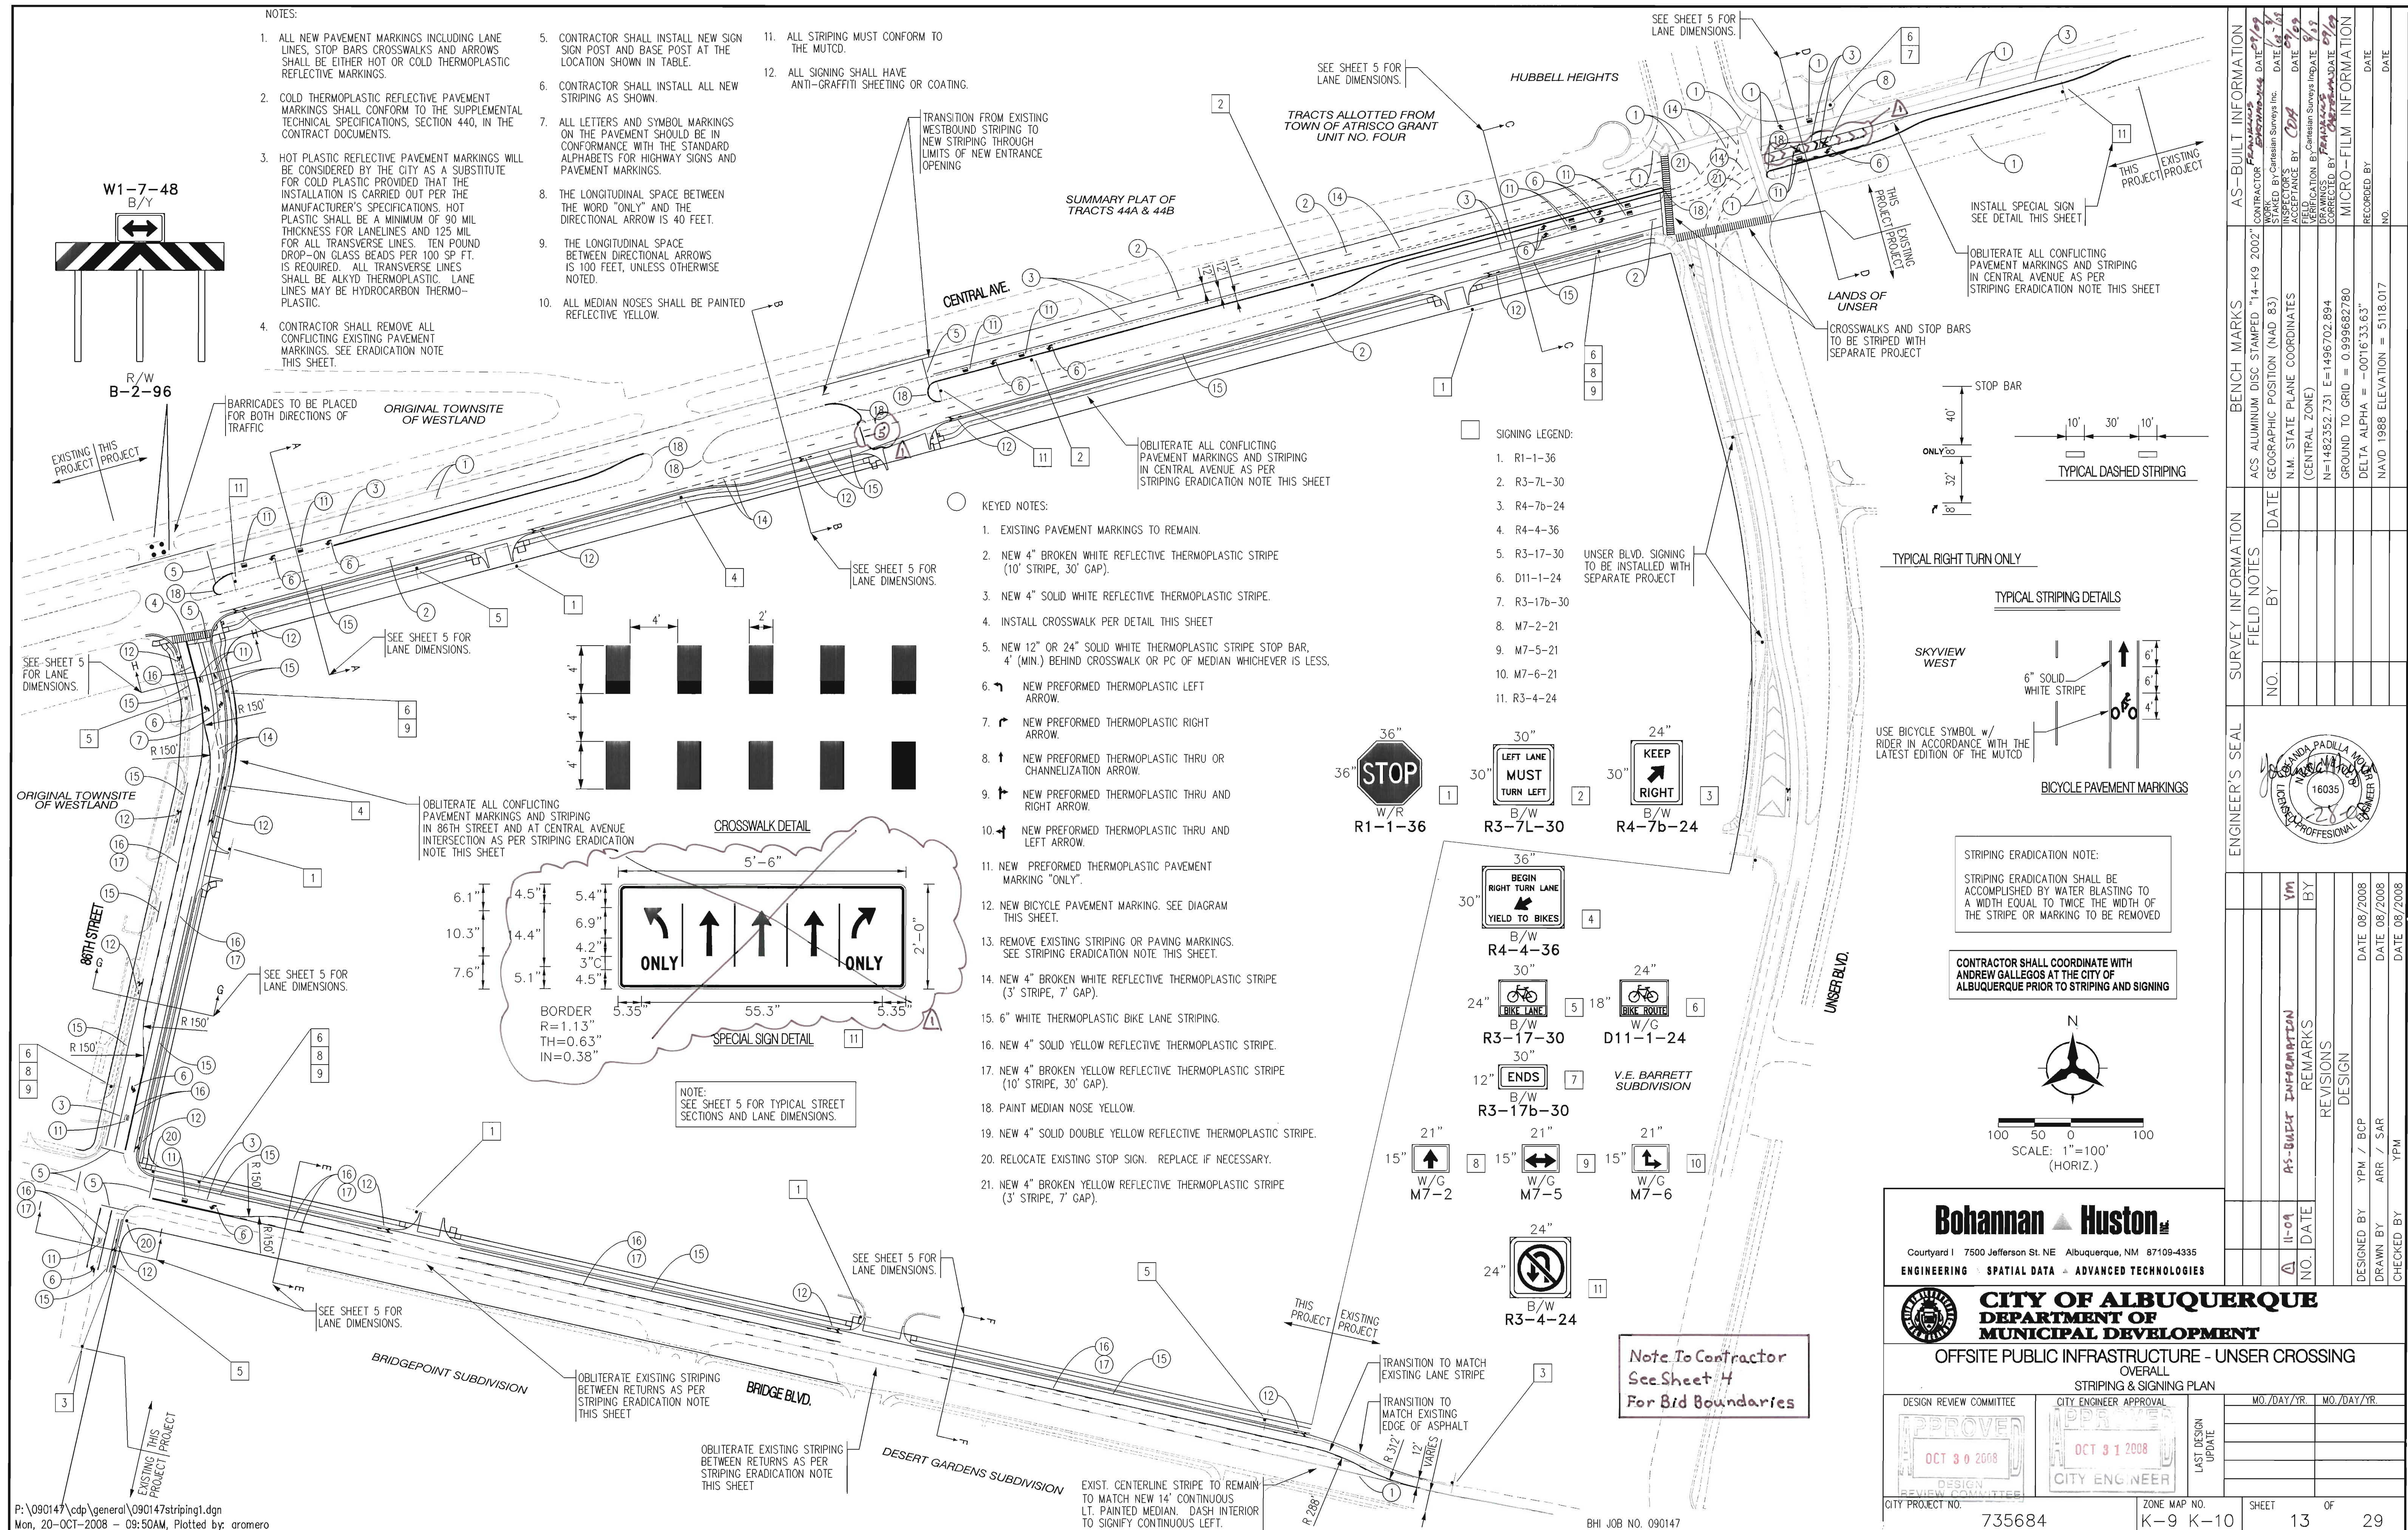

TRAFFIC SIGNAL NOTES

3. ALL WORK ON THESE PLANS TO BE PERFORMED UNDER THIS CONTRACT SHALL CONFORM TO THE CURRENT NATIONAL ELECTRIC CODE, THE NATIONAL BOARD OF FIRE UNDERWRITERS FOR ELECTRICAL WIRING AND APPARATUS AND THE CITY'S TRAFFIC ENGINEERING OPERATIONS LATEST SPECIFICATIONS.
2. LOCATIONS OF CONDUITS, FOUNDATIONS, CONTROL CABINETS, POLES, PULL BOXES, MANHOLES, AND SPLICE CABINETS SHOWN ON THE PLANS ARE SCHEMATIC AND SHALL BE ADJUSTED IN THE FIELD TO MAXIMIZE CLEAR SPACE AVAILABLE FOR PEDESTRIANS AND WHEELCHAIRS TO COMPLY WITH THE AMERICAN WITH DISABILITIES ACT. THE CONTRACTOR SHALL MEET WITH THE CITY'S TRAFFIC ENGINEERING OPERATIONS PERSONNEL IN THE FIELD AT ALL LOCATIONS TO SPOT EQUIPMENT BEFORE BEGINNING THE WORK. ALL SUCH EQUIPMENT SHALL BE INSTALLED WITHIN THE RIGHT-OF-WAY. THE LOCATION OF MASTARMS AND PEDESTAL POLES ARE SHOWN ON THE PLANS. THESE STATIONS AND OFFSETS SHALL BE VERIFIED IN THE FIELD AND ADJUSTED AS CONDITIONS CHANGE.
3. THE CONTRACTOR IS WARNED THAT EXISTING CONDUITS MAY CONTAIN AC POWER AND CAUTION SHALL BE EXERCISED IN INTERCEPTING OR INSTALLING CABLE IN EXISTING CONDUIT
4. THE CONTRACTOR SHALL BORE, DRILL OR PUSH WHEN CROSSING EXISTING PAVEMENTS AND ANY DRIVEWAYS FOR SIDE STREET CROSSINGS. BEFORE CONDUIT CAN BE BORED, DRILLED OR PUSHED THE CONTRACTOR SHALL LOCATE ALL EXISTING UTILITIES. THE CONTRACTOR SHALL LOCATE AND EXPOSE GAS LINES WHICH CROSS ANY PROPOSED BORES. THESE EXCAVATIONS SHALL REMAIN OPEN UNTIL AFTER THE BORE IS COMPLETE. CONTRACTOR SHALL REMOVE AND REPLACE IN KIND ANY SIDEWALK OR PAVEMENT REQUIRED TO EXPOSE SUCH LINES.
5. SPLICING OF COMMUNICATIONS CABLE WILL NOT BE PERMITTED IN PULL BOXES. SPLICING OF COMMUNICATIONS CABLE (CONNECTIONS) WILL BE PERMITTED ONLY AT SPLICE CABINETS OR CONTROLLER CABINETS WITH SPLICE BARS. SPLICING OF TRAFFIC SIGNALS MCC WILL BE PERMITTED IN LARGE PULL BOXES INCLUDING LARGE MEDIUM PULL BOXES. SPLICING OF VIDEO DETECTION COAXIAL CABLE WILL NOT BE PERMITTED FROM THE MASTARM BASE TO THE CONTROLLER CABINET. SPLICING OF OPTICAL DETECTOR CABLE WILL NOT BE PERMITTED FROM THE DETECTOR TO THE CONTROLLER CABINET
6. ALL VIDEO DETECTION COAXIAL AND POWER CABLES SHALL BE TAGGED AT THE CONTROL CABINET TO IDENTIFY EACH CABLE BY CAMERA NUMBER AND LOCATION. ALL OPTICAL DETECTOR CABLE SHALL BE TAGGED AT THE CONTROL CABINET TO IDENTIFY EACH BY DIRECTION AND LOCATION
7. ALL PULL BOXES SHALL BE REINFORCED POLYMER MORTAR HEAVY DUTY TYPE WITH REINFORCED POLYMER MORTAR HEAVY DUTY COVERS. CONCRETE COVERS, STEEL COVERS, AND CONCRETE PULL BOXES WILL NOT BE ACCEPTABLE
8. THE CONTRACTOR SHALL NOTIFY THE CITY OF ALBUQUERQUE TRAFFIC ENGINEERING OPERATIONS (857-8000) FIVE WORKING DAYS IN ADVANCE OF ANY ANTICIPATED WORK ON SIGNALS, LIGHTING, AND POWER SERVICES. TRAFFIC ENGINEERING OPERATIONS PERSONNEL WILL ASSIST THE CONTRACTOR IN FIELD LOCATION OF EQUIPMENT, COLOR, CODING OF WIRING, AND MUST BE PRESENT WHEN SIGNALS AND LIGHTING ARE SHUT-OFF OR TURNED ON. THE CONTRACTOR SHALL ALSO NOTIFY THE CITY OF ALBUQUERQUE TRAFFIC ENGINEERING OPERATIONS EACH TIME A TRAFFIC SIGNAL CONTROL DOOR IS OPEN
9. THE CONTRACTOR SHALL NOTIFY PNM 30 DAYS IN ADVANCE OF ANTICIPATED POWER SERVICE CONNECTIONS. THE CONTRACTOR SHALL COORDINATE WITH PNM TO ESTABLISH ELECTRICAL SERVICE IN THE CITY'S NAME. THE CONTRACTOR SHALL PAY THE LOCAL POWER COMPANY ALL COSTS TO PROVIDE ELECTRICAL SERVICE. THIS WORK IS CONSIDERED INCIDENTAL TO CONSTRUCTION. PNM CONTACT FOR TRAFFIC SIGNAL POWER SERVICE IS ANDREA CONTRERAS - 241-3666.
10. THE CONTRACTOR SHALL REMOVE ALL CONFLICTING SIGNING AND DELIVER TO THE CITY TRAFFIC ENGINEERING YARDS WHEN TRAFFIC SIGNALS ARE PUT INTO OPERATION.
11. LIVE UNUSED CONDUCTORS WILL NOT BE ALLOWED AT MASTARM POLES AND PEDESTAL POLES. ALL SUCH UNUSED CONDUCTORS SHALL BE DISCONNECTED AT THE LARGE PULL BOX ADJACENT TO THE POLE.
12. IF TRENCH WIDTHS LESS THAN 12" ARE PROPOSED BY THE CONTRACTOR, APPROVED COMPACTION METHODS SHALL BE USED DURING BACKFILL TO PREVENT LATENT TRENCH FAILURES. THE CONTRACTOR SHALL USE GROUT OR LEAN FILL AS APPROVED BY THE PROJECT MANAGER IN LIEU OF EARTH BACKFILL.
13. FOR CONDUITS CONTAINING ONLY LOW VOLTAGE COMMUNICATIONS CABLES, THE REQUIREMENTS FOR A SINGLE CONDUCTOR BARE COPPER #8 AWG MAY BE WAIVED WHERE PERMITTED BY THE NATIONAL ELECTRIC CODE.
14. THE CITY OF ALBUQUERQUE TRAFFIC ENGINEERING OPERATIONS PERSONNEL WILL PROVIDE TRAFFIC SIGNAL TIMING PLANS AND WILL PROGRAM TRAFFIC SIGNAL CONTROLLERS.
15. EXISTING CONDUITS TO BE REMOVED OR ABANDONED SHALL HAVE ALL WIRING REMOVED.
16. EXISTING CONDUITS SHALL BE REPAIRED, ADJUSTED, OR REPLACED AS DIRECTED BY THE PROJECT MANAGER WHERE ELECTRICAL PULL BOXES OR TRAFFIC MANHOLES ARE INSTALLED OR REPLACED.
17. CONTRACTOR SHALL COIL EXCESS INTERCONNECT CABLE AT ALL NEW OR EXISTING TRAFFIC MANHOLES BETWEEN SPLICE CABINET OR CONTROL CABINETS WITH SPLICE BARS. IF MORE THAN ONE MANHOLE EXISTS BETWEEN SPLICE CABINETS OR CONTROL CABINETS WITH SPLICE BARS, THEN COILING IS ONLY REQUIRED AT ONE OF THE MANHOLES. THE FOLLOWING QUANTITIES OF COMMUNICATION CABLE SHALL BE COILED:













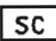
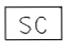



12 PAIR - 50 FT.
18. ALL DATA SHOWN HEREIN CONCERNING EXISTING UTILITIES HAS BEEN OBTAINED FROM "AS-BUILT" DRAWINGS AND FROM FIELD OBSERVATIONS WHICH MAY OR MAY NOT BE ACCURATE. THE CONTRACTOR WILL BE RESPONSIBLE FOR EXPLORATORY TRENCHING, IF NECESSARY, TO MORE SPECIFICALLY LOCATE UTILITY LINES. COST OF LOCATING UTILITY LINES INCLUDING EXPLORATORY TRENCHING WILL BE CONSIDERED INCIDENTAL TO CONSTRUCTION.
19. THE CONTRACTOR SHALL ENSURE ALL PEDESTRIAN PUSHBUTTONS AND PEDESTRIAN SIGNAL INDICATION LOCATIONS ADHERE TO THE MOST CURRENT AMERICANS WITH DISABILITIES ACT (ADA) AND CITY OF ALBUQUERQUE REGULATIONS. THE CONTRACTOR SHALL CONTACT THE PROJECT MANAGER AND/OR THE LOCAL AGENCY ADA REPRESENTATIVE TO INSPECT AND APPROVE RAMP CONFIGURATIONS AS STAKED BEFORE FINAL PLACEMENT OF CONCRETE. PUSHBUTTONS FOR PEDESTRIAN SIGNALS SHOULD BE LOCATED AS FOLLOWS:

- + LATERALLY WITHIN 5' OF THE STRIPED CROSSWALK.
- + LONGITUDINALLY WITHIN 10' OF THE EDGE OF CURB, SHOULDER OR PAVEMENT.
- + PARALLEL TO THE CROSSWALK TO BE USED.
- + WITHIN 10" REACH OF A FLAT (50:1 MAX SLOPE) ALL-WEATHER SURFACE FOR WHEELCHAIR ACCESS.

TRAFFIC SIGNAL EQUIPMENT REQUIREMENTS

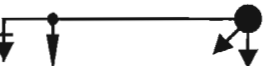- A. THE TRAFFIC SIGNAL CONTROLLERS SUPPLIED FOR THIS PROJECT SHALL BE AS DIRECTED BY COA TRAFFIC ENGINEERING DEPARTMENT (ANDREW GALLEGOS, 857-8004).
- B. THE TRAFFIC SIGNAL CONTROLLER CABINETS SUPPLIED FOR THIS PROJECT SHALL BE AS DIRECTED BY COA.
2. SPLICE CABINETS SHALL BE AS DETAILED ON THE PLANS. LOW VOLTAGE SPLICE BLOCKS SHALL BE 50 UNITS TO THE FOOT, WITH EACH SPLICE BLOCK CAPABLE OF HANDLING 25 PAIR CABLE (NUMBER OF SPLICE BLOCKS IN EACH CABINET CAPABLE OF HANDLING NUMBER OF CONDUCTORS SHOWN ON PLANS). SPLICE BLOCKS SHALL BE BELL SYSTEMS PART #66B3-50 OR APPROVED EQUAL. ALL COMMUNICATION CABLE PAIRS SHALL BE TERMINATED AT THE SPLICE BLOCK INCLUDING INACTIVE PAIRS.
3. GDI 4195A TWISTED PAIR MODEM WITH 4-WIRE SURGE PROTECTOR TO INTEGRATE WITH I2 (SIEMENS SYSTEM).
4. INTERCONNECT CABLES SHALL COMPLY WITH REA SPECIFICATION PE-22. INTERCONNECT CABLE SHALL CONTAIN THE NUMBER OF WIRE PAIRS SHOWN ON THE PLANS AND THE INDIVIDUAL CONDUCTORS SHALL BE 19 AWG SOLID.
5. EMERGENCY VEHICLE PRE-EMPT EQUIPMENT SHALL BE 3M "OPTICOM" MODEL 562 OR LATEST MODEL PHASE SELECTORS MOUNTED ON 3M "OPTICOM" MODEL 560 RACKS, OR APPROVED EQUAL. ALL RACKS SHALL BE CAPABLE OF PROVIDING FOUR CHANNELS OF DETECTION. PHASE SELECTOR MODELS SHALL BE CAPABLE OF TWO CHANNELS OF DETECTION EACH. OPTICAL DETECTORS SHALL BE 3M "OPTICOM" MODEL 711, ONE (1) CHANNEL, ONE (1) DIRECTION OR APPROVED EQUAL. OPTICAL DETECTOR CABLE SHALL BE 3M "OPTICOM" MODEL 138 OR EQUAL. A MANUFACTURERS REPRESENTATIVE SHALL ASSIST THE CONTRACTOR IN THE FIELD AS WORK PROGRESSES TO COMPLETE THE INSTALLATION OF ALL PRE-EMPTION EQUIPMENT AND ASSIST IN SETTING UP, TURNING ON, PROGRAMMING AND FIELD TESTING PRE-EMPTION EQUIPMENT TO INSURE THAT THE EQUIPMENT IS OPERATIONAL.
6. THIS PROJECT INVOLVES THE INSTALLATION OF A VEHICLE DETECTION SYSTEM. THEREFORE, THE CONTRACTOR SHALL FURNISH AND INSTALL THE FOLLOWING:
 - A. THE VIDEO DETECTION SYSTEM SHALL BE AUTOSCOPE SOLO PRO II, ITERIS VANTAGE II, TRAFICON OR APPROVED EQUAL. THE VIDEO DETECTION SYSTEM SHALL INCLUDE ALL NECESSARY HARNESSSES, VIDEO PROCESSOR UNIT, MATERIAL AND MISCELLANEOUS COMPONENTS NECESSARY TO PROVIDE A COMPLETE AND OPERATING SYSTEM.
 - B. VIDEO CAMERAS SHALL BE EQUIPPED WITH ZOOM LENSES.
 - C. COMPUTER SOFTWARE AND HARNESSSES TO CONNECT AND OPERATE THE NEW SYSTEM.
 - D. VIDEO CABLE AS RECOMMENDED BY THE MANUFACTURER.
- E. TRAINING BY MANUFACTURER, ON-SITE FOR CITY OF ALBUQUERQUE TRAFFIC ENGINEERING PERSONNEL. THIS TRAINING SHALL REVIEW THE OPERATION COMPONENTS OF THE VIDEO DETECTION SYSTEM AS WELL AS DISCUSSION OF ALL REQUIRED MAINTENANCE.
7. ALL SIGNAL INDICATORS AND PEDESTRIAN SIGNAL HEADS SHALL BE LED, AS APPROVED BY THE CITY. PEDESTRIAN SIGNALS SHALL BE COUNTERDOWN AS APPROVED BY THE CITY.
8. ILLUMINATED STREET NAME SIGNS SHALL BE CARMANAH OR APPROVED EQUAL.
9. THE FOLLOWING CITY OF ALBUQUERQUE STANDARD DRAWINGS SHALL BE USED FOR THIS PROJECT:
 - 2550 TRAFFIC SIGNAL PULL BOX DETAIL
 - 2551 TRAFFIC SIGNAL MANHOLE DETAIL
 - 2555 TRAFFIC SIGNAL CONTROLLER CABINET & PEDESTAL FOUNDATION DETAIL
 - 2557 TRAFFIC SIGNAL SPLICE CABINET GROUND MOUNT (LARGE)
 - 2558 TRAFFIC SIGNAL FOUNDATION DETAIL TYPE II & TYPE III STANDARDS
 - 2562c TRAFFIC SIGNAL MASTARM DETAIL TYPE III STANDARD
 - 2562d TRAFFIC SIGNAL TYPE III STANDARD - MISCELLANEOUS DETAILS
 - 2568 TRAFFIC SIGNAL MACHINE VISION VEHICLE DETECTOR SYSTEM
 - 2569 TRAFFIC SIGNAL OPTICAL DETECTOR INSTALLATION DETAILS
 - 2570 TRAFFIC ELECTRICAL SERVICE DETAIL
 - 2572 TRAFFIC SIGNAL METER PEDESTAL DETAIL COMBINATION SIGNAL & LIGHTING

TRAFFIC SIGNAL LEGEND

NEW	EXISTING	ITEM
		PULL BOX
		SERVICE POLE
		METER PEDESTAL
		CONTROLLER CABINET
-----		CONDUIT RUN (SIGNALS)
-----		CONDUIT RUN (LIGHTING)
-----	-----	CONDUIT RUN (INTERCONNECT)
		TRAFFIC SIGNAL PEDESTAL POLE
		CONDUIT RUN NUMBER (SIGNAL)
		CONDUIT RUN NUMBER (POWER SERVICE)
		TYPE II STANDARD WITH MASTER TRAFFIC SIGNAL, BACKPLATE, AND OPTICAL DETECTOR
		TYPE III STANDARD WITH MASTER TRAFFIC SIGNAL, BACKPLATE, OPTICAL DETECTOR, LUMINAIRE, AND VIDEO CAMERA
		PEDESTRIAN PUSH BUTTON (MOUNTED TO SIDE OF POLE WHERE INDICATED)
		PEDESTRIAN SIGNALS (MOUNTED TO SIDE OF POLE WHERE INDICATED)
		SPLICE CABINET
		TRAFFIC MANHOLE
		VIDEO CAMERA

ENGINEER'S SEAL		SURVEY INFORMATION		BENCH MARKS		AS-BUILT INFORMATION	
		FIELD NOTES					
		NO.	BY			CONTRACTOR	DATE
				ACS ALUMINUM DISC STAMPED "14-K9 2002"		<i>THORSON</i>	<i>07/09</i>
				GEOGRAPHIC POSITION (NAD 83)		PERFORMED BY <i>Carlesten Surveys Inc.</i>	DATE <i>06/09</i>
				N.M. STATE PLANE COORDINATES		INSPECTOR'S	DATE <i>06/09</i>
				(CENTRAL ZONE)		ACCEPTANCE BY <i>COF</i>	DATE <i>07/09</i>
				N=1482352.731 E=1496702.894		VERIFICATION BY <i>Carlesten Surveys Inc/DATE</i>	<i>07/09</i>
				GROUND TO GRID = 0.9996862780		DRAWINGS	
				DELTA ALPHA = -0016'33.63"		CORRECTED BY <i>Carlesten Surveys Inc/DATE</i>	<i>07/09</i>
				NAVD 1988 ELEVATION = 5118.017		RECORDED BY	DATE
						NO.	DATE

DESIGNED BY LAH / KDT

DATE 08/2008

DRAWN BY LAH

DATE 08/2008

CHECKED BY

DATE 08/2008

[illegible]


[illegible]

INCIDENTAL ITEMS*

1. REMOVAL OF EXISTING PULL BOXES, CONDUITS, OR OTHER SIGNAL EQUIPMENT FOR INSTALLATION OF NEW SIGNAL EQUIPMENT.
2. CABLE TESTING AND DIAGRAMS.
3. BORING, DRILLING, PUSHING, AND TRENCHING, INCLUDING REMOVAL AND REPLACEMENT OF PAVEMENT, SIDEWALKS, DRIVE PADS, VALLEY GUTTERS, WHEELCHAIR RAMPS, CURB & GUTTER, AND LANDSCAPING (INCLUDING SPRINKLERS). FOR INSTALLATION OF PULL BOXES, CONDUITS, AND SIGNAL FOUNDATIONS, EXCEPT AS NOTED ON THE PLANS.
4. LOCATION OF UTILITY LINES INCLUDING EXPLORATORY TRENCHING AND EXPOSING OF GAS LINES WHEN BORING.
5. DESIGN, MATERIALS, INSTALLATION AND REMOVAL OF SAFETY BARRIER FOR SHIELDING EQUIPMENT OR MATERIAL.
6. APPRISING PUBLIC THROUGH THE LOCAL NEWS MEDIA.
7. HAULING OF MATERIAL TO BE DISPOSED TO CITY LANDFILL.
8. REMOVAL, SALVAGE, AND TRANSPORTATION OF EXISTING SIGNAL EQUIPMENT TO THE TRAFFIC ENGINEERING OPERATIONS YARD.
9. LEAN FILL FOR CONDUIT TRENCHES.
10. PULL BOX ADJUSTMENT TO GRADE.
11. OFF-DUTY POLICE OFFICER FOR TRAFFIC CONTROL.
12. REMOVAL AND REPLACEMENT IN KIND OR BETTER OF LANDSCAPING INCLUDING SPRINKLERS, FOR INSTALLATION OF PULL BOXES, CONDUITS AND SIGNAL FOUNDATIONS.
13. COST FOR PUBLIC SERVICE COMPANY TO PROVIDE ELECTRICAL SERVICE.
14. PROCESSOR FOR VEHICLE DETECTION SYSTEM.

* ITEMS LISTED ARE ONLY A GENERAL DESCRIPTION OF THE REQUIRED WORK AND MATERIALS, AND MAY NOT BE COMPLETE. THIS LIST DOES NOT INCLUDE ANY INCIDENTAL WORK OR MATERIALS REQUIRED BY THE SPECIAL PROVISIONS SERIALS (STANDARD DETAILS), SUPPLEMENTAL SPECIFICATIONS, OR THE STANDARD SPECIFICATIONS.

[illegible]

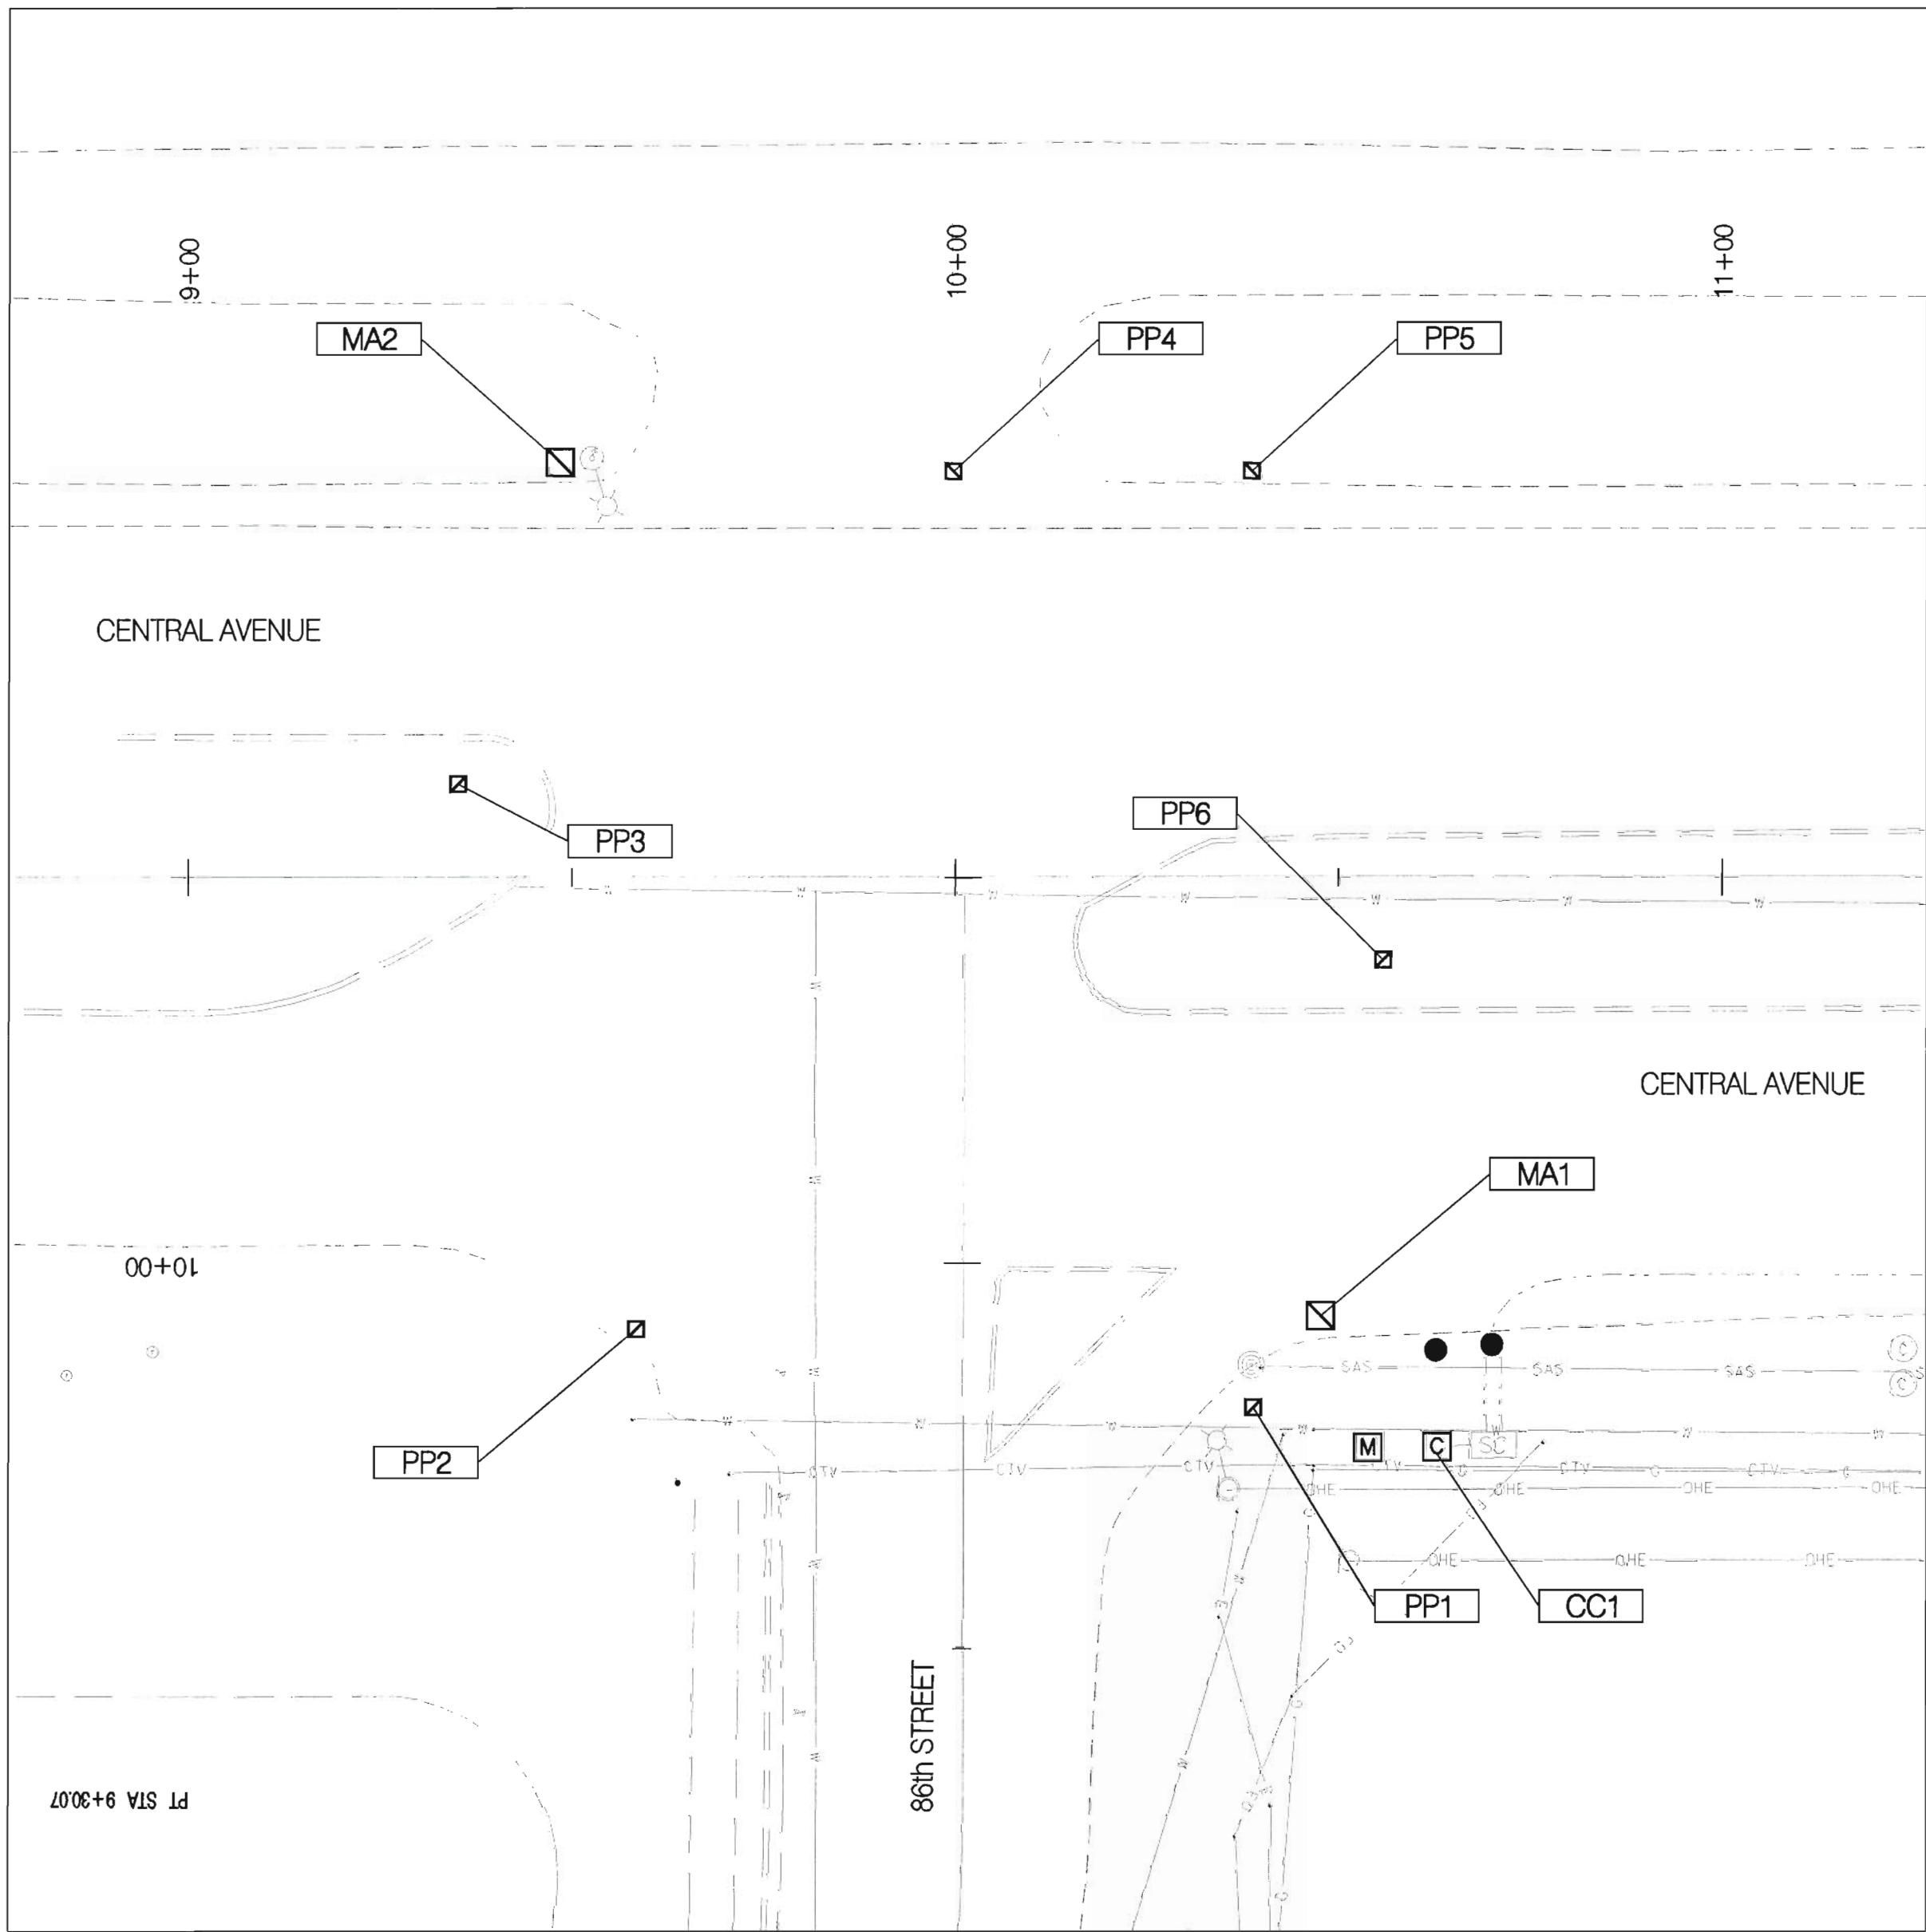


CENTRAL AVENUE / 86th STREET

FOUNDATION LOCATIONS - CENTRAL AVE / 86th STREET					
	TYPE	STATION	OFFSET	LUMINAIRE MOUNT. HT.	LUMINAIRE ARM
MA1	MASTARM - 35' TYPE III	10+47.66	56.85' RT	40'	10'
MA2	MASTARM - 30' TYPE III	9+48.48	54.06' LT	40'	10'
PP1	PEDESTAL - 15' TYPE I	10+38.92	68.80' RT	-	-
PP2	PEDESTAL - 15' TYPE I	9+58.47	58.60' RT	-	-
PP3	PEDESTAL - 15' TYPE I	9+35.20	12.17' LT	-	-
PP4	PEDESTAL - 15' TYPE I	9+99.71	52.91' LT	-	-
PP5	PEDESTAL - 15' TYPE I	10+38.61	52.95' LT	-	-
PP6	PEDESTAL - 15' TYPE I	10+55.83	10.64' RT	-	-
CC1	CONTROLLER	10+62.88	73.90' RT	-	-


NOTES

- FOUNDATION LOCATIONS ARE SHOWN FOR THE PROPOSED SIGNAL EQUIPMENT. THE CONTRACTOR SHALL COORDINATE INSTALLATION OF FOUNDATIONS SO THAT THE TOP OF THE FOUNDATIONS ARE FLUSH WITH THE NEW ADJACENT ACCESS RAMPS AS SHOWN ON THE PLANS.
- UTILITIES SHOWN WERE OBTAINED FROM FIELD OBSERVATIONS AND SURVEYS, AND ARE FOR THE CONTRACTOR'S INFORMATION. THE CONTRACTOR IS RESPONSIBLE FOR EXPOSING UTILITIES TO IDENTIFY THE EXACT LOCATION PRIOR TO INSTALLATION OF THE NEW FOUNDATIONS. NO SEPARATE PAYMENT WILL BE MADE FOR WORK NEEDED TO IDENTIFY UTILITY LOCATIONS.

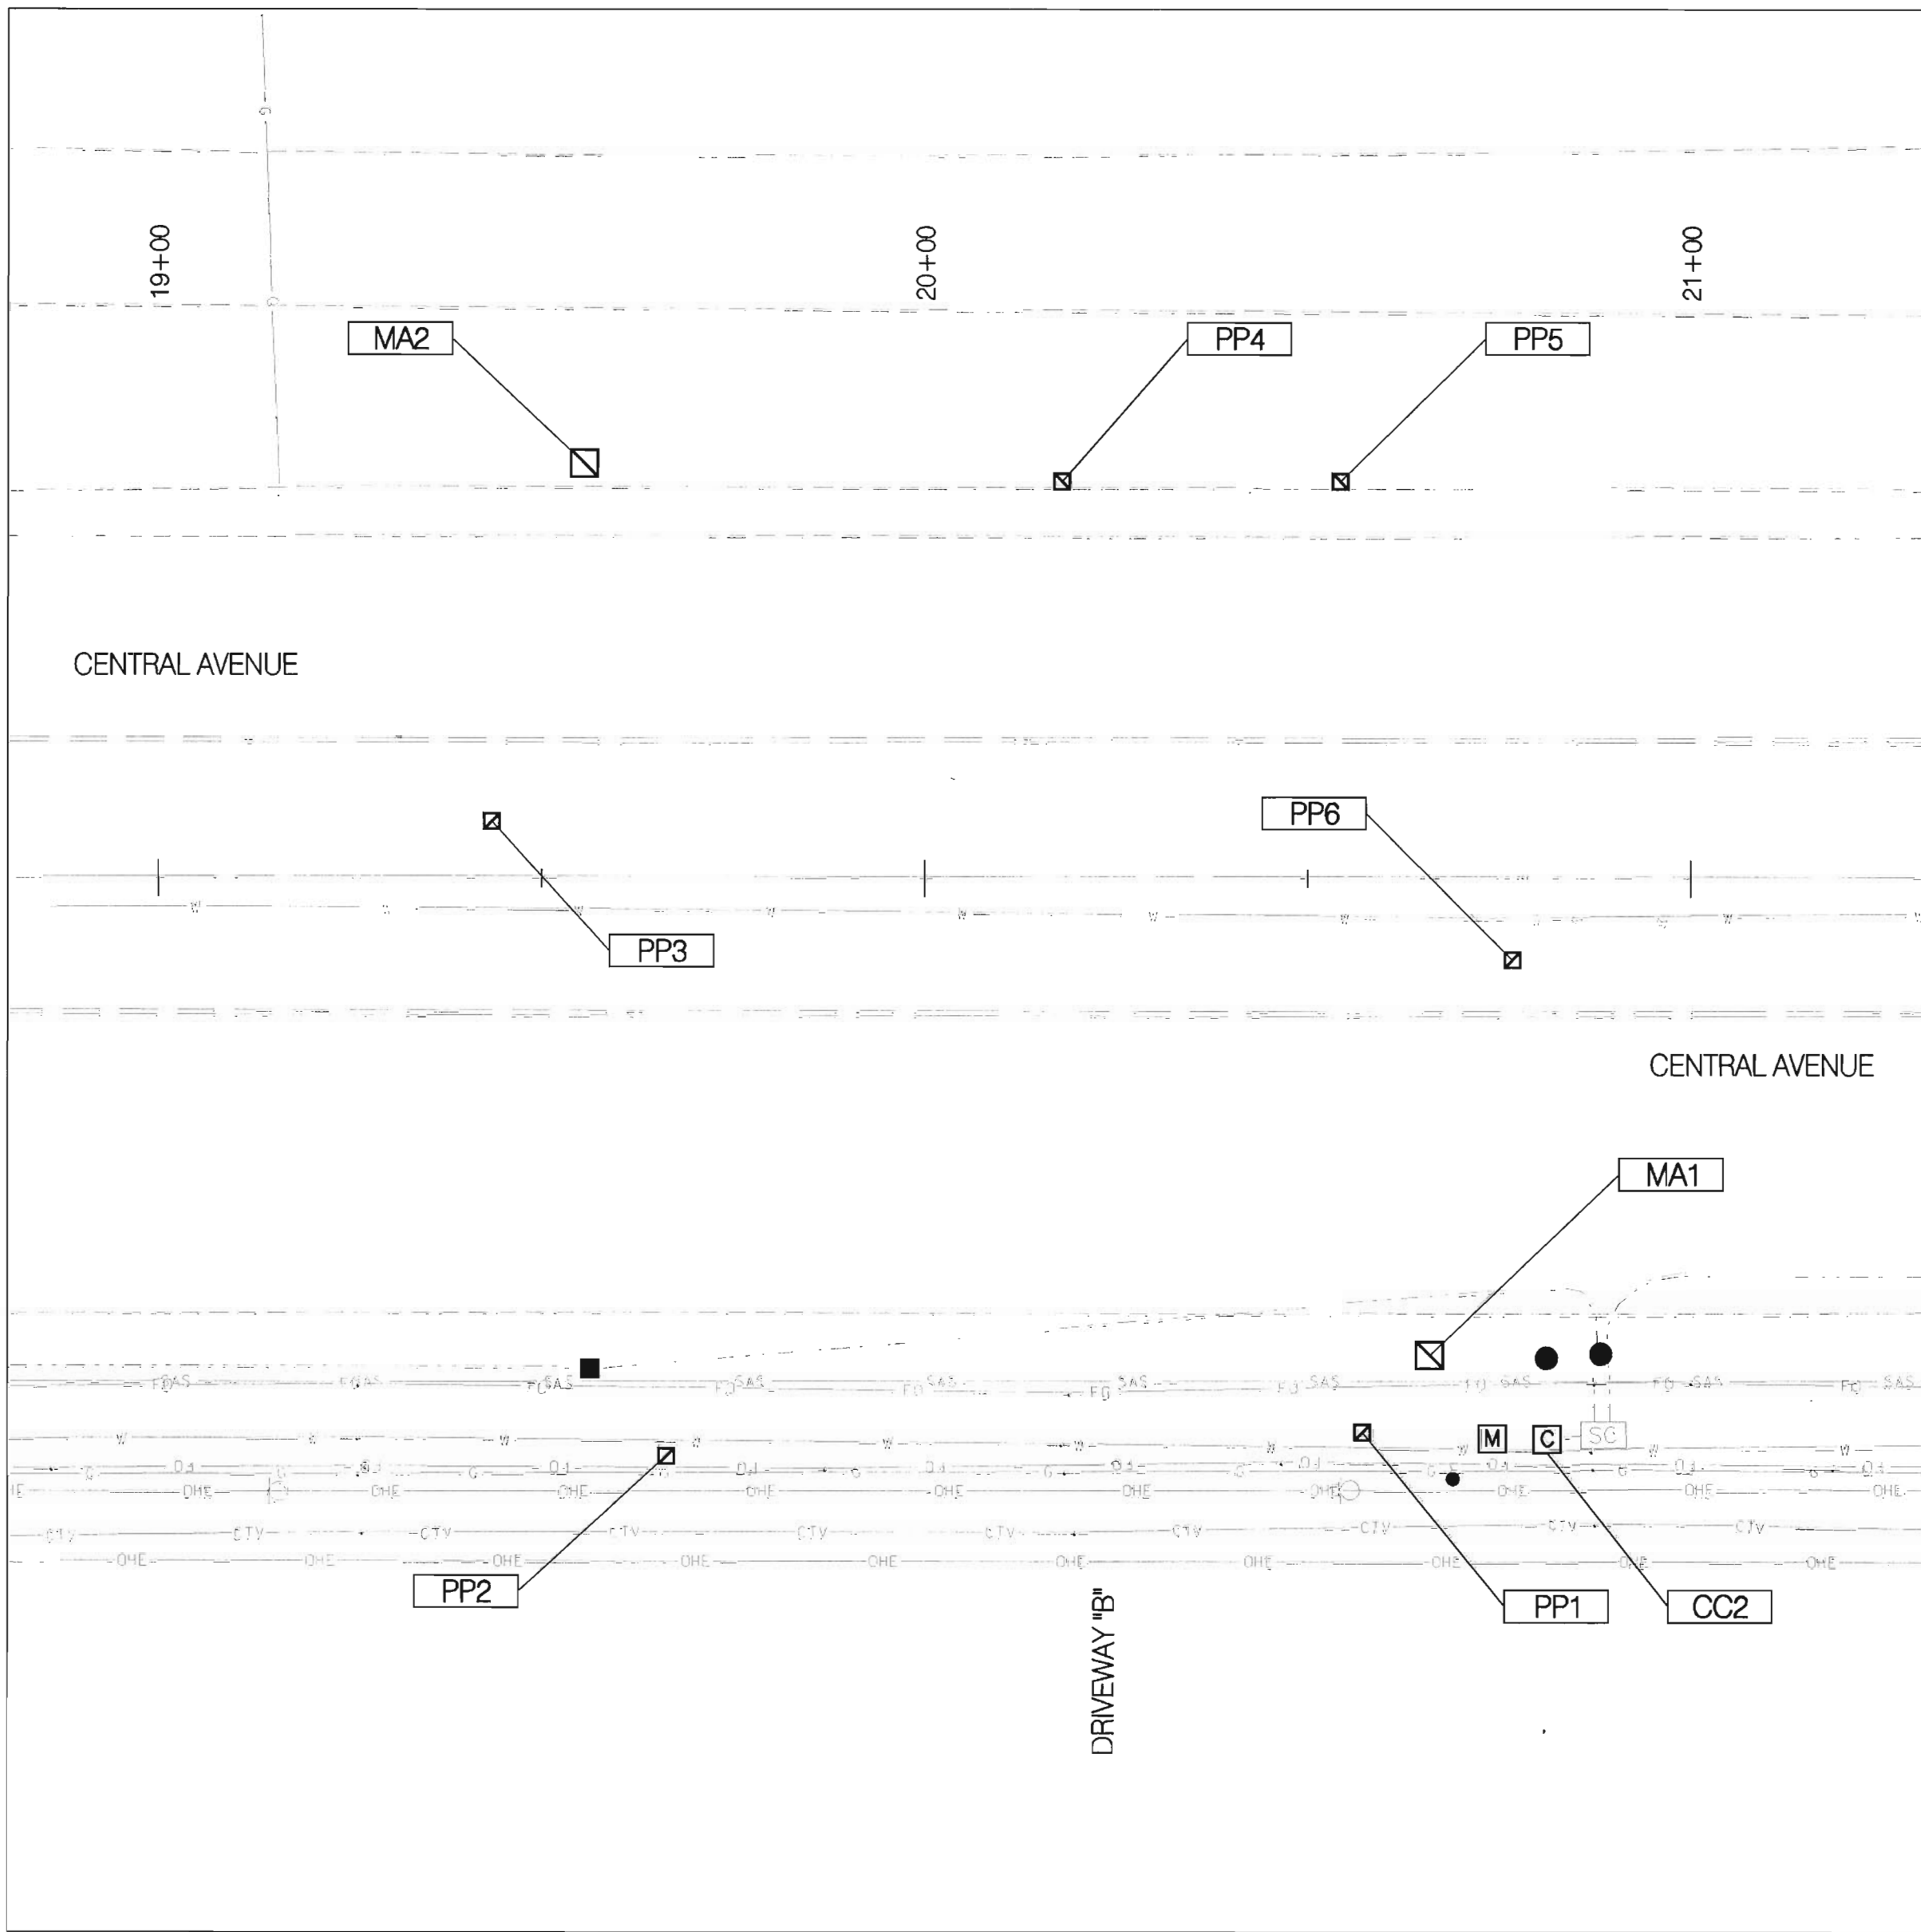

CENTRAL AVENUE / DRIVEWAY "B"




FOUNDATION LOCATIONS - CENTRAL AVE / DRIVEWAY "B"					
	TYPE	STATION	OFFSET	LUMINAIRE MOUNT. HT.	LUMINAIRE ARM
MA1	MASTARM - 40' TYPE III	20+65.92	61.85' RT	40'	10'
MA2	MASTARM - 30' TYPE III	19+55.51	54.06' LT	40'	10'
PP1	PEDESTAL - 15' TYPE I	20+57.17	71.90' RT	-	-
PP2	PEDESTAL - 15' TYPE I	19+66.29	75.00' RT	-	-
PP3	PEDESTAL - 15' TYPE I	19+43.52	7.47' LT	-	-
PP4	PEDESTAL - 15' TYPE I	20+17.86	51.71' LT	-	-
PP5	PEDESTAL - 15' TYPE I	20+54.20	51.71' LT	-	-
PP6	PEDESTAL - 15' TYPE I	20+76.71	10.50' RT	-	-
CC1	CONTROLLER	20+81.34	72.76' RT	-	-

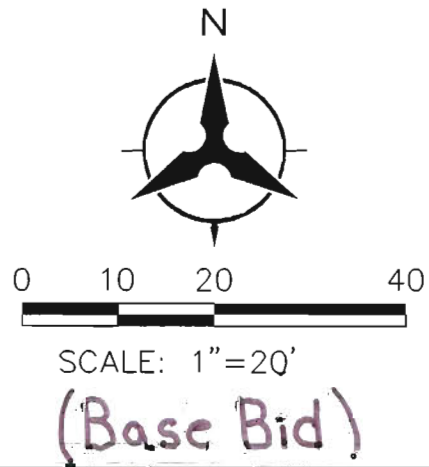

Bohannon & Huston
Courtierd 1 7500 Jefferson St. NE Albuquerque, NM 87109-4335
ENGINEERING & SPATIAL DATA & ADVANCED TECHNOLOGIES

CITY OF ALBUQUERQUE
DEPARTMENT OF MUNICIPAL DEVELOPMENT
OFFSITE PUBLIC INFRASTRUCTURE - UNSER CROSSING
EXISTING UTILITY INFORMATION - FOUNDATION LOCATIONS

DESIGN REVIEW COMMITTEE	CITY ENGINEER-APPROVAL	MO./DAY/YR.	MO./DAY/YR.
APPROVE OCT 3 0 2008 DESIGN REVIEW COMMITTEE	APPROVE OCT 3 1 2008 CITY ENGINEER		
CITY PROJECT NO. 735684		ZONE MAP NO. K-9 K-10	SHEET 16 OF 29

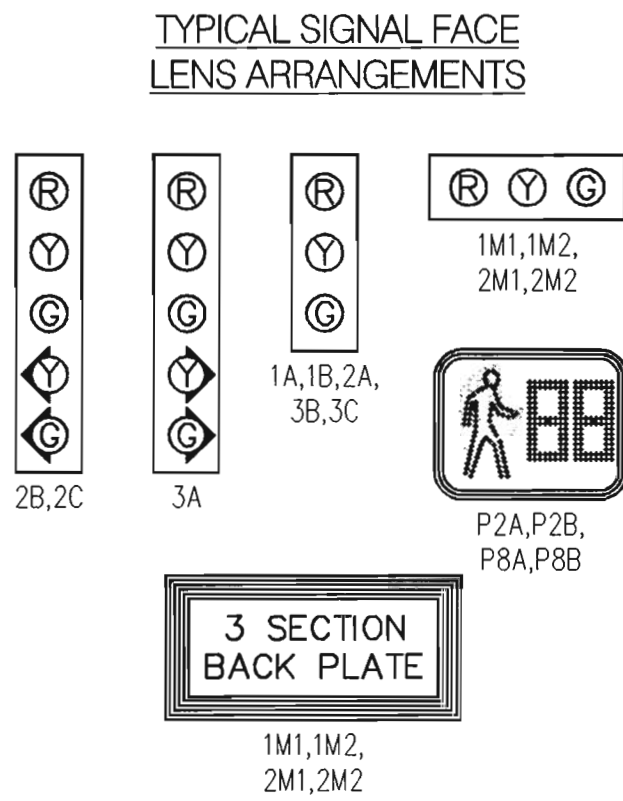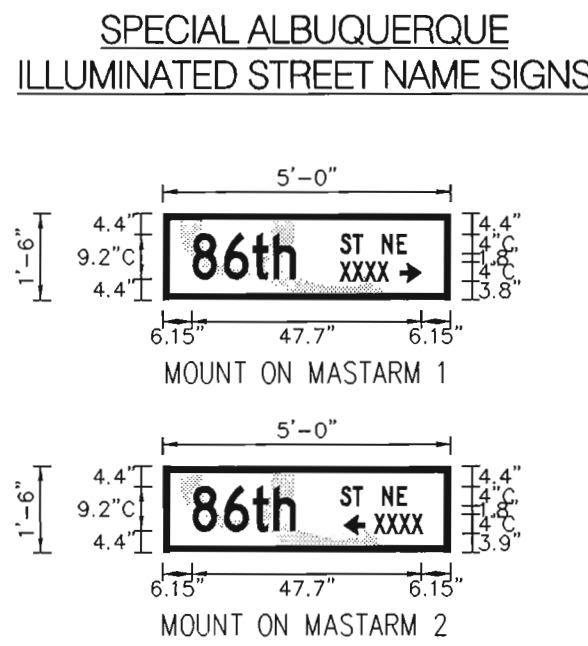
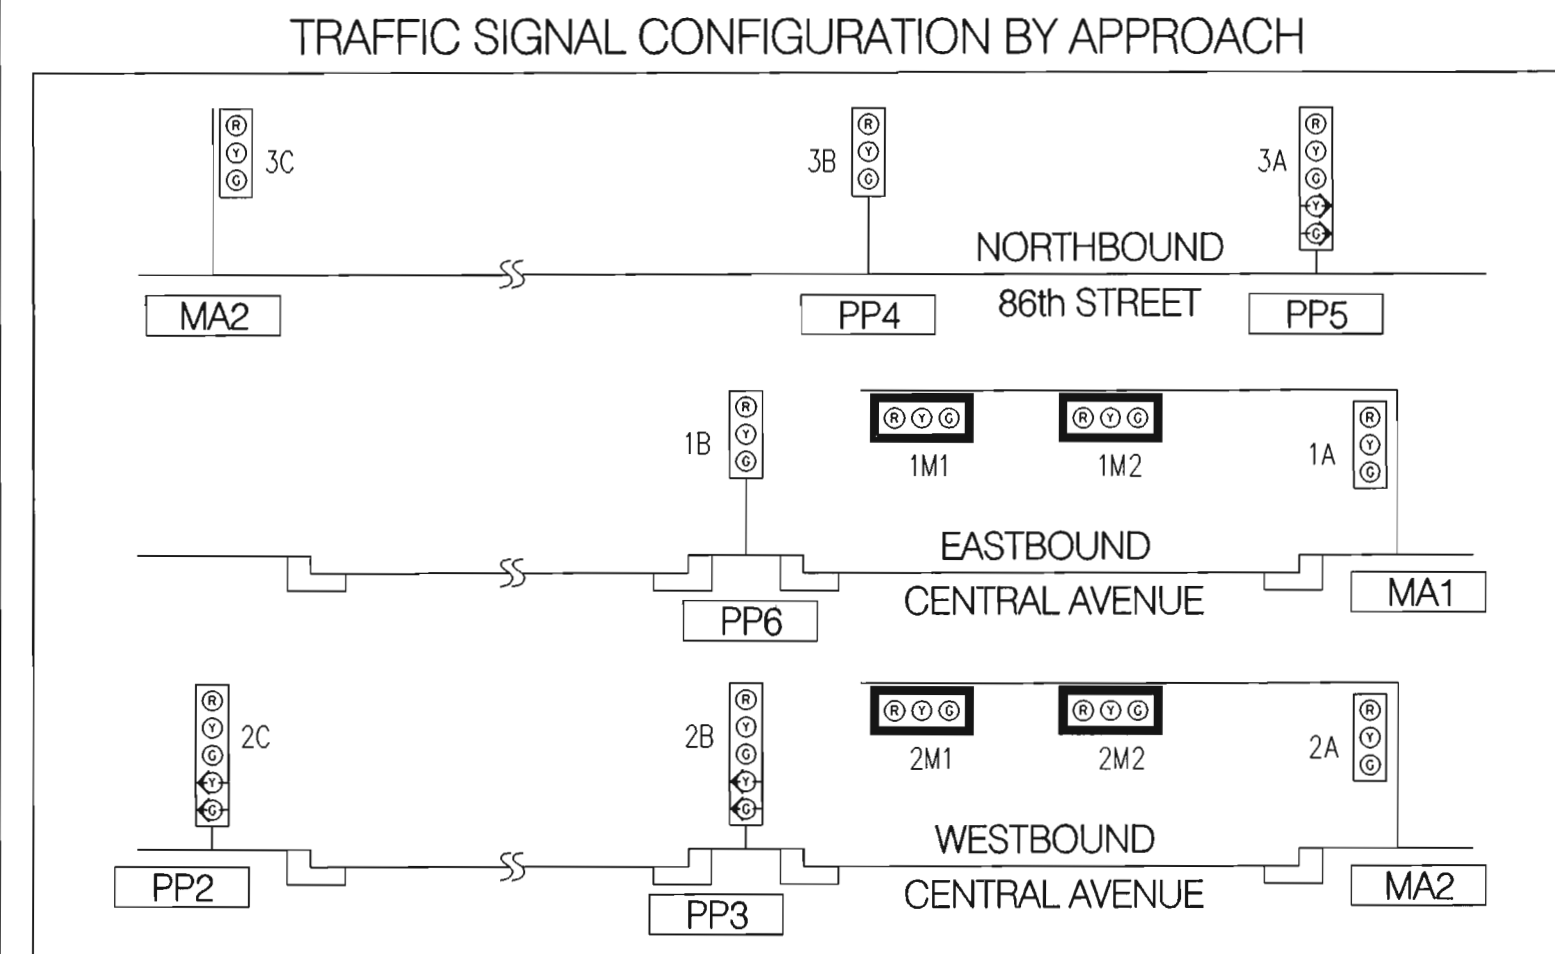


OPTICAL DETECTOR CABLE

FROM	TO	CONDUIT TRACE	TOTAL LENGTH
MA1	CC1	MA1-20-2	95'
MA2	CC1	MA2-22-12-10-8-6-4-2	405'
		TOTAL	500'

VIDEO DETECTOR CABLE

FROM	TO	CONDUIT TRACE	TOTAL LENGTH
MA2	CC1	MA2-22-12-10-8-6-4-2	420'x2=840'
		TOTAL	840'

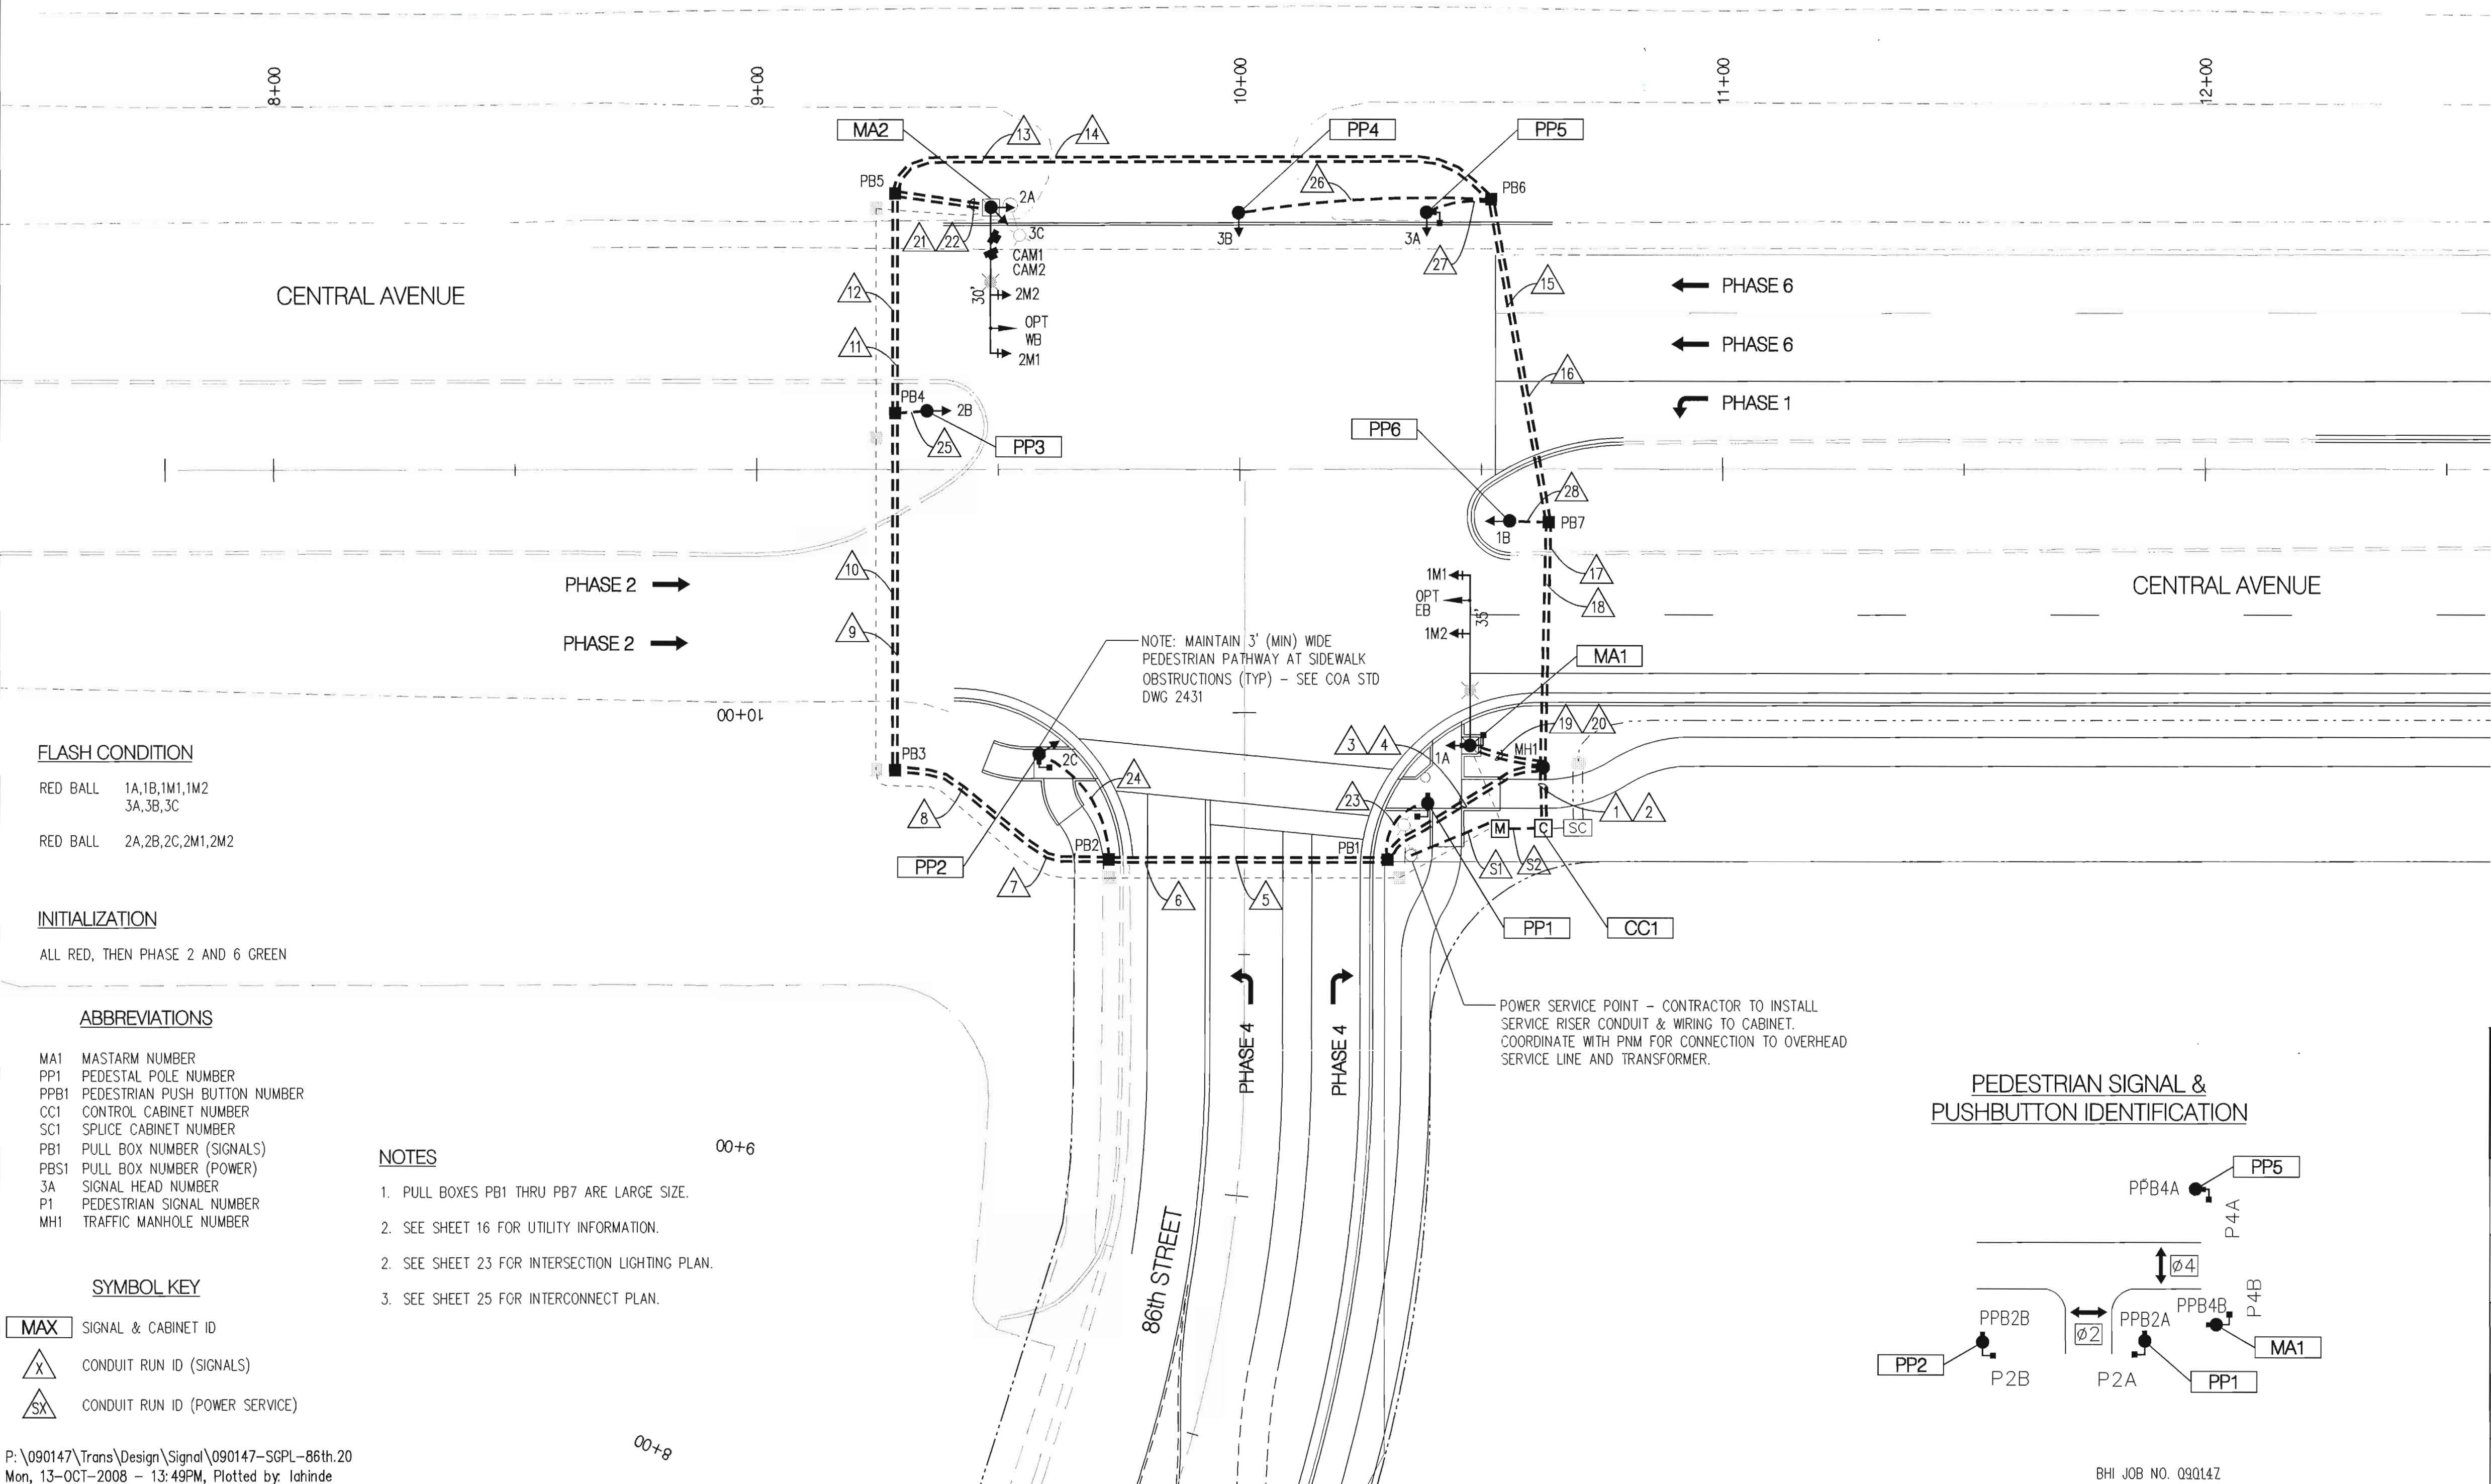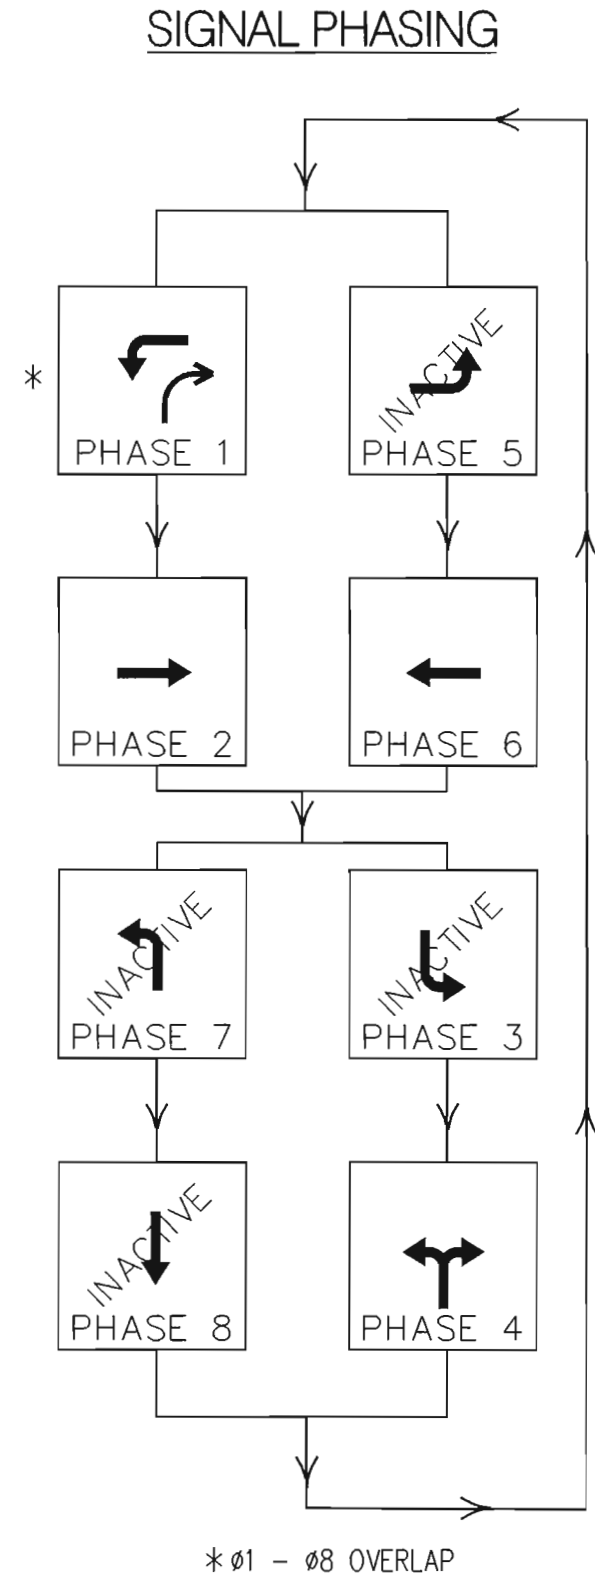

FLASH CONDITION

RED BALL 1A,1B,1M1,1M2
3A,3B,3C

RED BALL 2A,2B,2C,2M1,2M2

INITIALIZATION

ALL RED, THEN PHASE 2 AND 6 GREEN

ABBREVIATIONS

MA1 MASTARM NUMBER
PP1 PEDESTAL POLE NUMBER
PB1 PEDESTRIAN PUSH BUTTON NUMBER
CC1 CONTROL CABINET NUMBER
SC1 SPLICE CABINET NUMBER
PB1 PULL BOX NUMBER (SIGNALS)
PB1 PULL BOX NUMBER (POWER)
3A SIGNAL HEAD NUMBER
P1 PEDESTRIAN SIGNAL NUMBER
MH1 TRAFFIC MANHOLE NUMBER

SYMBOL KEY


MAX SIGNAL & CABINET ID

X CONDUIT RUN ID (SIGNALS)

SK CONDUIT RUN ID (POWER SERVICE)

- NOTES
- PULL BOXES PB1 THRU PB7 ARE LARGE SIZE.
 - SEE SHEET 16 FOR UTILITY INFORMATION.
 - SEE SHEET 23 FOR INTERSECTION LIGHTING PLAN.
 - SEE SHEET 25 FOR INTERCONNECT PLAN.

PEDESTRIAN SIGNAL &
PUSHBUTTON IDENTIFICATION

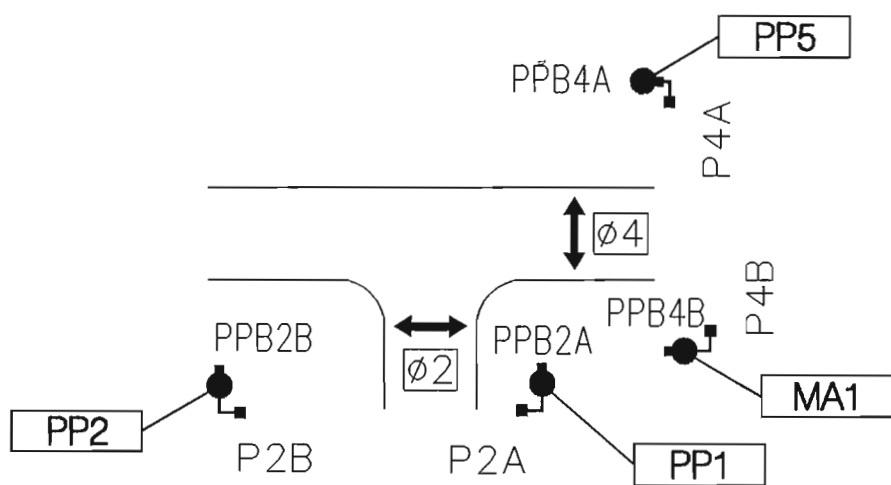

Bohannon & Huston
Courtney I 7500 Jefferson St. NE Albuquerque, NM 87109-4335
ENGINEERING • SPATIAL DATA • ADVANCED TECHNOLOGIES

CITY OF ALBUQUERQUE
DEPARTMENT OF MUNICIPAL DEVELOPMENT

OFFSITE PUBLIC INFRASTRUCTURE - UNSER CROSSING
TRAFFIC SIGNAL PLAN - CENTRAL AVE / 86th STREET

DESIGN REVIEW COMMITTEE APPROVAL
OCT 30 2008

CITY ENGINEER APPROVAL
OCT 31 2008


LAST DESIGN UPDATE

QTY PROJECT NO. 735684

ZONE MAP NO. K-9 K-10

SHEET 17 OF 29

CONDUIT AND CONDUCTOR REQUIREMENTS														
CONDUIT LENGTH, SIZE, AND TYPE					CONDUIT FILL BY CONDUCTOR LENGTH AND TYPE									
RUN	SIZE/LENGTH			TYPE	REMARKS	MCC 5 (#@FT)	MCC 7 (#@FT)	MCC 20 (#@FT)	SCC #2 (#@FT)	SCC #3 (#@FT)	PS (#@FT)	OPTICOM (#@FT)	VIDEO CABLE (#@FT)	OTHER (#@FT)
ID	1"	2"	3"											
S1		25		REC	POWER TO METER				3 @ 30					
S2		10		REC	METER TO CC1				3 @ 15					
1			15	REC	CC1 TO MH1	2 @ 20		2 @ 20		1 @ 20				
2		15		REC	CC1 TO MH1							2 @ 20	2 @ 20	
3			40	REC	MH1 TO PB1	2 @ 45		2 @ 45		1 @ 45				
4		40		REC	MH1 TO PB1							1 @ 45	2 @ 45	
5			65	REC	PB1 TO PB2	2 @ 70		2 @ 70		1 @ 70				
6		65		REC	PB1 TO PB2							1 @ 70	2 @ 70	
7			55	REC	PB2 TO PB3	2 @ 60		2 @ 60		1 @ 60				
8		55		REC	PB2 TO PB3							1 @ 60	2 @ 60	
9			75	REC	PB3 TO PB4	2 @ 80		2 @ 80		1 @ 80				
10		75		REC	PB3 TO PB4							1 @ 80	2 @ 80	
11			50	REC	PB4 TO PB5	2 @ 55		2 @ 55		1 @ 55				
12		50		REC	PB4 TO PB5							1 @ 55	2 @ 55	
13			130	REC	PB5 TO PB6	2 @ 135		2 @ 135		1 @ 135				
14		130		REC	PB5 TO PB6						1 @ 135			
15			75	REC	PB6 TO PB7	2 @ 80		2 @ 80		1 @ 80				
16		75		REC	PB6 TO PB7						1 @ 80			
17			55	REC	PB7 TO MH1	2 @ 60		2 @ 60		1 @ 60				
18		55		REC	PB7 TO MH1						1 @ 60			
19			20	REC	MA1 TO MH1	5 @ 25								
20		20		REC	MA1 TO MH1						1 @ 25	1 @ 25		
21			25	REC	MA2 TO PB5	4 @ 30								
22		25		REC	MA2 TO PB5							1 @ 30	2 @ 30	
23		20		REC	PP1 TO PB1	2 @ 25								
24		30		REC	PP2 TO PB2	2 @ 35	1 @ 35							
25		15		REC	PP3 TO PB4		1 @ 20							
26		55		REC	PP4 TO PB6	1 @ 60								
27		20		REC	PP5 TO PB6	2 @ 25	1 @ 25							
28		15		REC	PP6 TO PB7	1 @ 20								
MA1					BASE TO 1A	1 @ 15								
MA1					BASE TO 1M1	1 @ 55								
MA1					BASE TO 1M1	1 @ 45								
MA1					BASE TO P2A	1 @ 15								
MA1					BASE TO P8B	1 @ 15								
MA1					BASE TO PPB8B	1 @ 5								
MA1					BASE TO OPTICOM EB							1 @ 50		
MA2					BASE TO 2A	1 @ 15								
MA2					BASE TO 2M1	1 @ 45								
MA2					BASE TO 2M2	1 @ 45								
MA2					BASE TO 2C	1 @ 15								
MA2					BASE TO OPTICOM WB							1 @ 45		
MA2					BASE TO CAM1								1 @ 60	
MA2					BASE TO CAM2								1 @ 60	
PP1					BASE TO P2A	1 @ 15								
PP1					BASE TO PPB2A	1 @ 5								
PP2					BASE TO 2C		1 @ 15							
PP2					BASE TO P2B	1 @ 15								
PP2					BASE TO PPB2B	1 @ 5								
PP3					BASE TO 2B		1 @ 15							
PP4					BASE TO 3B	1 @ 15								
PP5					BASE TO 3A		1 @ 15							
PP5					BASE TO P8A	1 @ 15								
PP5					BASE TO PPB8A	1 @ 5								
PP6					BASE TO 1B	1 @ 15								
TOTALS	0	795	605			2065	125	1210	135	605	300	500	840	0


AS-BUILT INFORMATION	CONTRACTOR: Bohannon & Huston DATE: 09/09/2008
BENCH MARKS	INSPECTOR'S: LAH DATE: 09/09/2008
SURVEY INFORMATION	VERIFICATION BY: LAH DATE: 09/09/2008
FIELD NOTES	NO. BY DATE
ENGINEER'S SEAL	
REVISIONS	NO. DATE BY
DESIGN	DESIGNED BY: LAH / KDT DATE: 08/2008
	DRAWN BY: LAH DATE: 08/2008
	CHECKED BY: KDT DATE: 08/2008

(Base Bid)

Bohannon & Huston

Courtyard I 7500 Jefferson St. NE Albuquerque, NM 87109-4335

ENGINEERING • SPATIAL DATA • ADVANCED TECHNOLOGIES




CITY OF ALBUQUERQUE

DEPARTMENT OF MUNICIPAL DEVELOPMENT

OFFSITE PUBLIC INFRASTRUCTURE - UNSER CROSSING


CONDUITS & CABLES - CENTRAL AVE / 86th STREET

DESIGN REVIEW COMMITTEE



OCT 30 2008

CITY ENGINEER APPROVAL



OCT 31 2008

LAST DESIGN UPDATE

CITY PROJECT NO. 735684

ZONE MAP NO. K-9 K-10

SHEET 18 OF 29

P:\090147\Trans\Design\Signal\090147-CC-86th.sht
Mon, 13-Oct-2008 - 13:49PM, Plotted by: lahinde

BHI JOB NO. 090147

THIS INTERSECTION
REQUIRES
VIDEO DETECTION

NOTES:

- 1/ IDENTIFY CONDUCTORS LISTED AS "115 VOLTS".
- 2/ WRAP RING 2 CABLE AT EACH SPLICE POINT WITH COLORED ELECTRICAL TAPE. THE IDENTIFICATION MARKING SHALL BE PROVIDED ON EACH RING 2 CABLE AT EACH SPLICE AND LOCATED 6" BACK FROM THE END.
- 3/ IDENTIFY CONDUCTORS LISTED AS "PPB - LOW VOLTAGE" AT EACH SPLICE POINT. FIVE (5) CONDUCTOR CABLE SHALL BE 24 VOLTS AND USED FOR PUSH BUTTONS ONLY.

DETECTOR RACK ASSIGNMENTS

[illegible]

* INCIDENTAL TO CONSTRUCTION



FUNCTION CHART - 115 VOLT CIRCUIT 1




CONDUCTOR			RING 1 – MULTI CONDUCTOR CABLE 20		RING 2 – MULTI CONDUCTOR CABLE 20 ^{2/}	
CONDUCTOR NUMBER	BASE COLOR	TRACER	FUNCTION	FIELD CONNECTION	FUNCTION	FIELD CONNECTION
1	BLACK	–	SPARE	SPARE	SPARE	SPARE
2	WHITE	–	SPARE	SPARE	SPARE	SPARE
3	RED	–	PHASE 1 RED	SPARE	PHASE 5 RED	SPARE
4	GREEN	–	PHASE 1 GREEN	GREEN LEFT TURN ARROW 2B, 2C	PHASE 5 GREEN	SPARE
5	ORANGE	–	PHASE 1 YELLOW	YELLOW LEFT TURN ARROW 2B, 2C	PHASE 5 YELLOW	SPARE
6	BLUE	–	SPARE	SPARE	SPARE	SPARE
7	WHITE	BLACK	SPARE	SPARE	SPARE	SPARE
8	RED	BLACK	PHASE 2 RED	RED BALL 1A, 1B, 1M1, 1M2	PHASE 6 RED	RED BALL 2A, 2B, 2C, 2M1, 2M2
9	GREEN	BLACK	PHASE 2 GREEN	GREEN BALL 1A, 1B, 1M1, 1M2	PHASE 6 GREEN	GREEN BALL 2A, 2B, 2C, 2M1, 2M2
10	ORANGE	BLACK	PHASE 2 YELLOW	YELLOW BALL 1A, 1B, 1M1, 1M2	PHASE 6 YELLOW	YELLOW BALL 2A, 2B, 2C, 2M1, 2M2
11	BLUE	BLACK	PHASE 2 WALK	PEDESTRIAN WALK P2A, P2B	PHASE 6 WALK	SPARE
12	BLACK	WHITE	PHASE 2 DON'T WALK	PEDESTRIAN DON'T WALK P2A, P2B	PHASE 6 DON'T WALK	SPARE
13	RED	WHITE	PHASE 3 RED	SPARE	PHASE 7 RED	SPARE
14	GREEN	WHITE	PHASE 3 GREEN	SPARE	PHASE 7 GREEN	SPARE
15	BLUE	WHITE	PHASE 3 YELLOW	SPARE	PHASE 7 YELLOW	SPARE
16	BLACK	RED	PHASE 4 RED	RED BALL 3A, 3B, 3C	PHASE 8 RED	SPARE
17	WHITE	RED	PHASE 4 GREEN	GREEN BALL 3A, 3B, 3C	PHASE 8 GREEN	SPARE
18	ORANGE	RED	PHASE 4 YELLOW	YELLOW BALL 3A, 3B, 3C	PHASE 8 YELLOW	SPARE
19	BLUE	RED	PHASE 4 WALK	PEDESTRIAN WALK P4A, P4B	PHASE 8 WALK	SPARE
20	RED	GREEN	PHASE 4 DON'T WALK	PEDESTRIAN DON'T WALK P4A, P4B	PHASE 8 DON'T WALK	SPARE

FUNCTION CHART - 24 VOLT CIRCUIT ^{3/}

CONDUCTOR		RING 1-MULTI CONDUCTOR CABLE 5	RING 2-MULTI CONDUCTOR CABLE 5
NUMBER	BASE COLOR	FUNCTION	FIELD CONNECTION
1	BLACK	PHASE 2	PPB2A, PPB2B
2	WHITE	COMMON	PPB2A, 2B, 4A, 4B
3	RED	PHASE 4	PPB4A, PPB4B
4	GREEN	SPARE	
5	ORANGE	SPARE	

[illegible]

Bohannon  Huston 																																																																																																																																																																																																																																																																																																																																																																																																																																																																																																																																																																																																																																																																																																																																																																																																																																																																																																																																																																																																																																																																																																																																																																																																																																																																																																																																																																																																							</
---	--	--	----

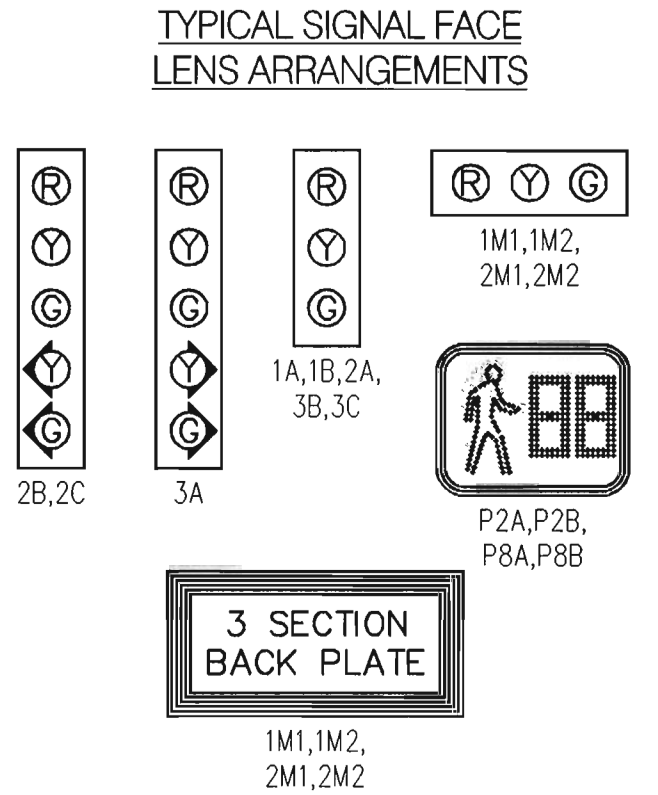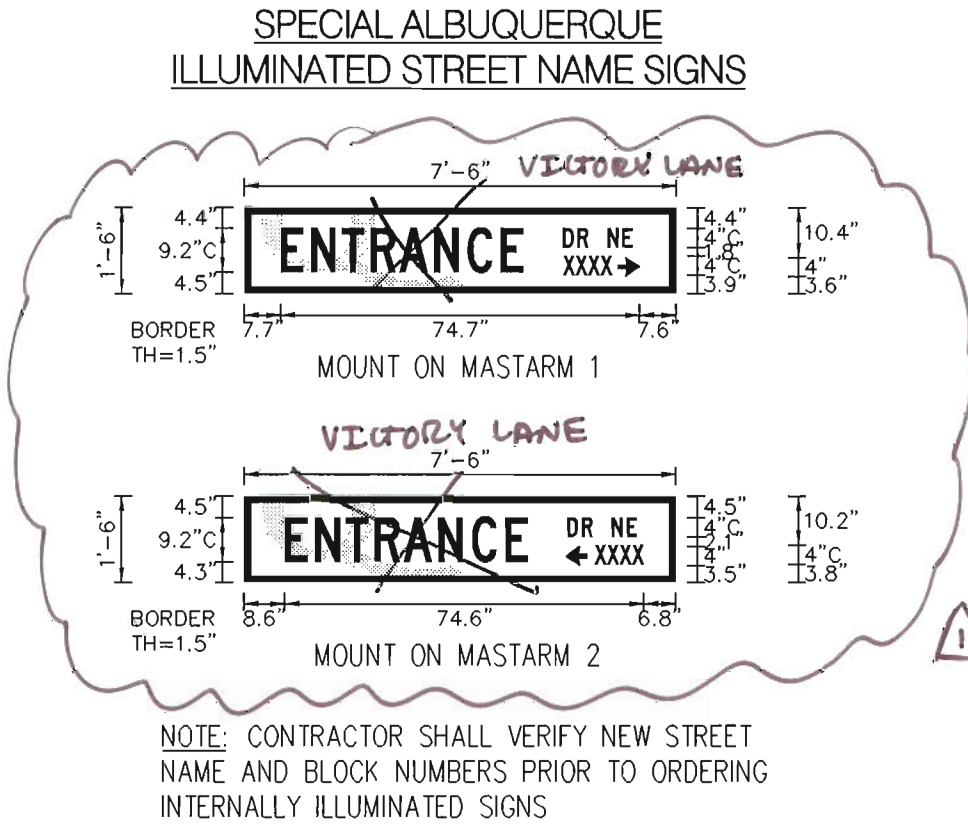
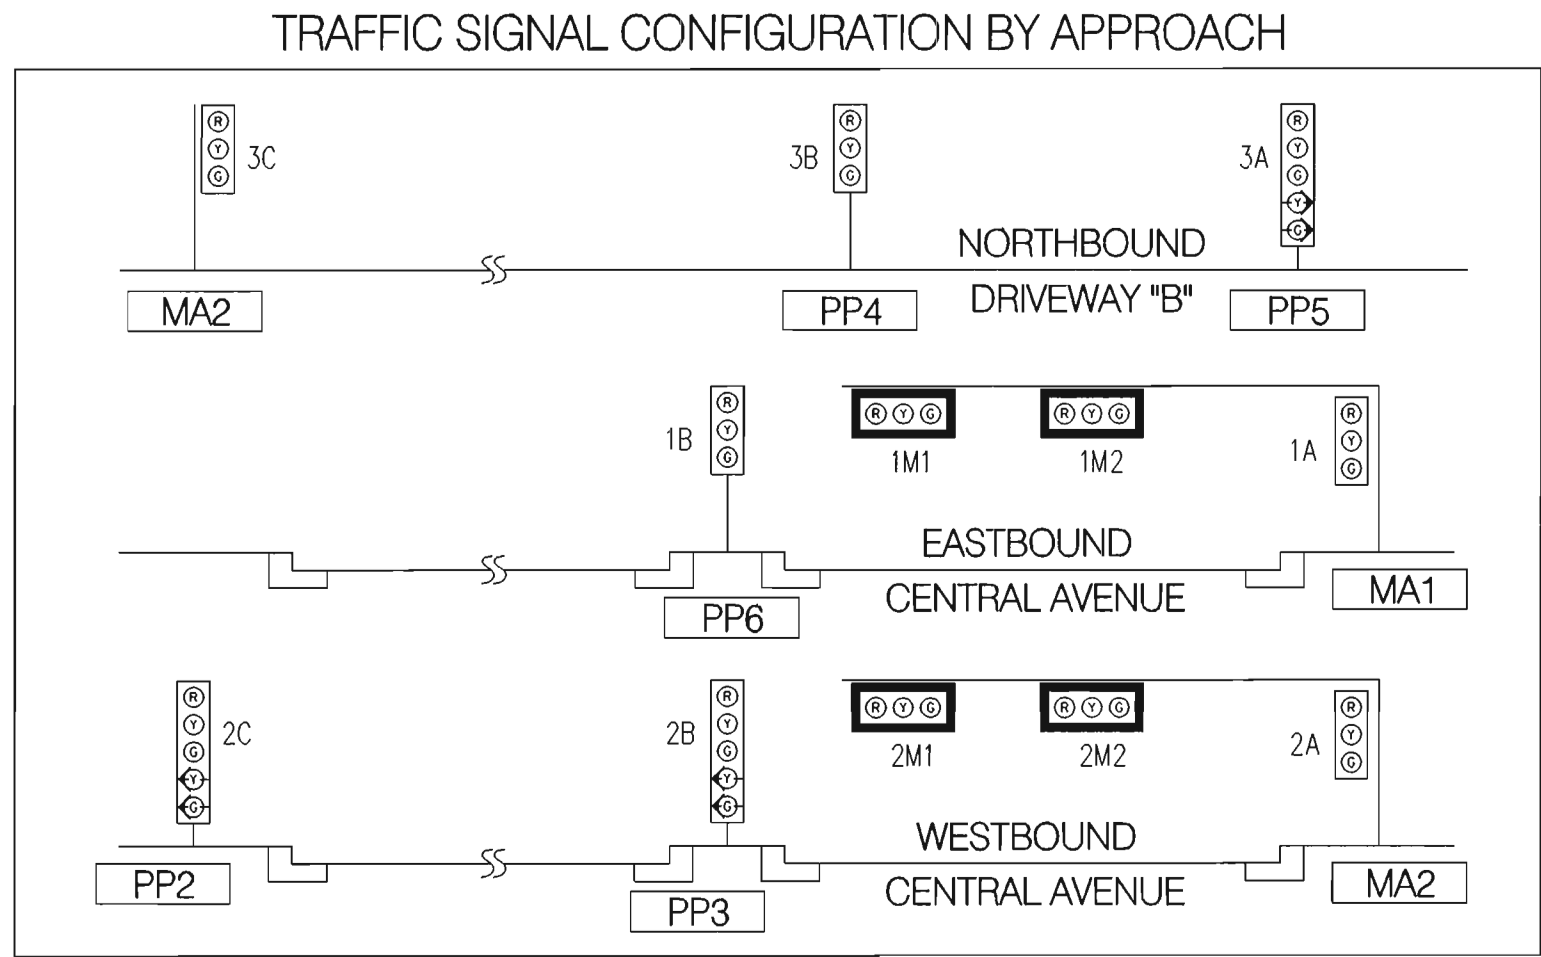


OPTICAL DETECTOR CABLE

FROM	TO	CONDUIT TRACE	TOTAL LENGTH
MA1	CC1	MA1-20-2	100'
MA2	CC1	MA2-22-12-10-8-6-4-2	415'
		TOTAL	515'



VIDEO DETECTOR CABLE

FROM	TO	CONDUIT TRACE	TOTAL LENGTH
MA2	CC1	MA2-22-12-10-8-6-4-2	430'x2=860'
		TOTAL	860'

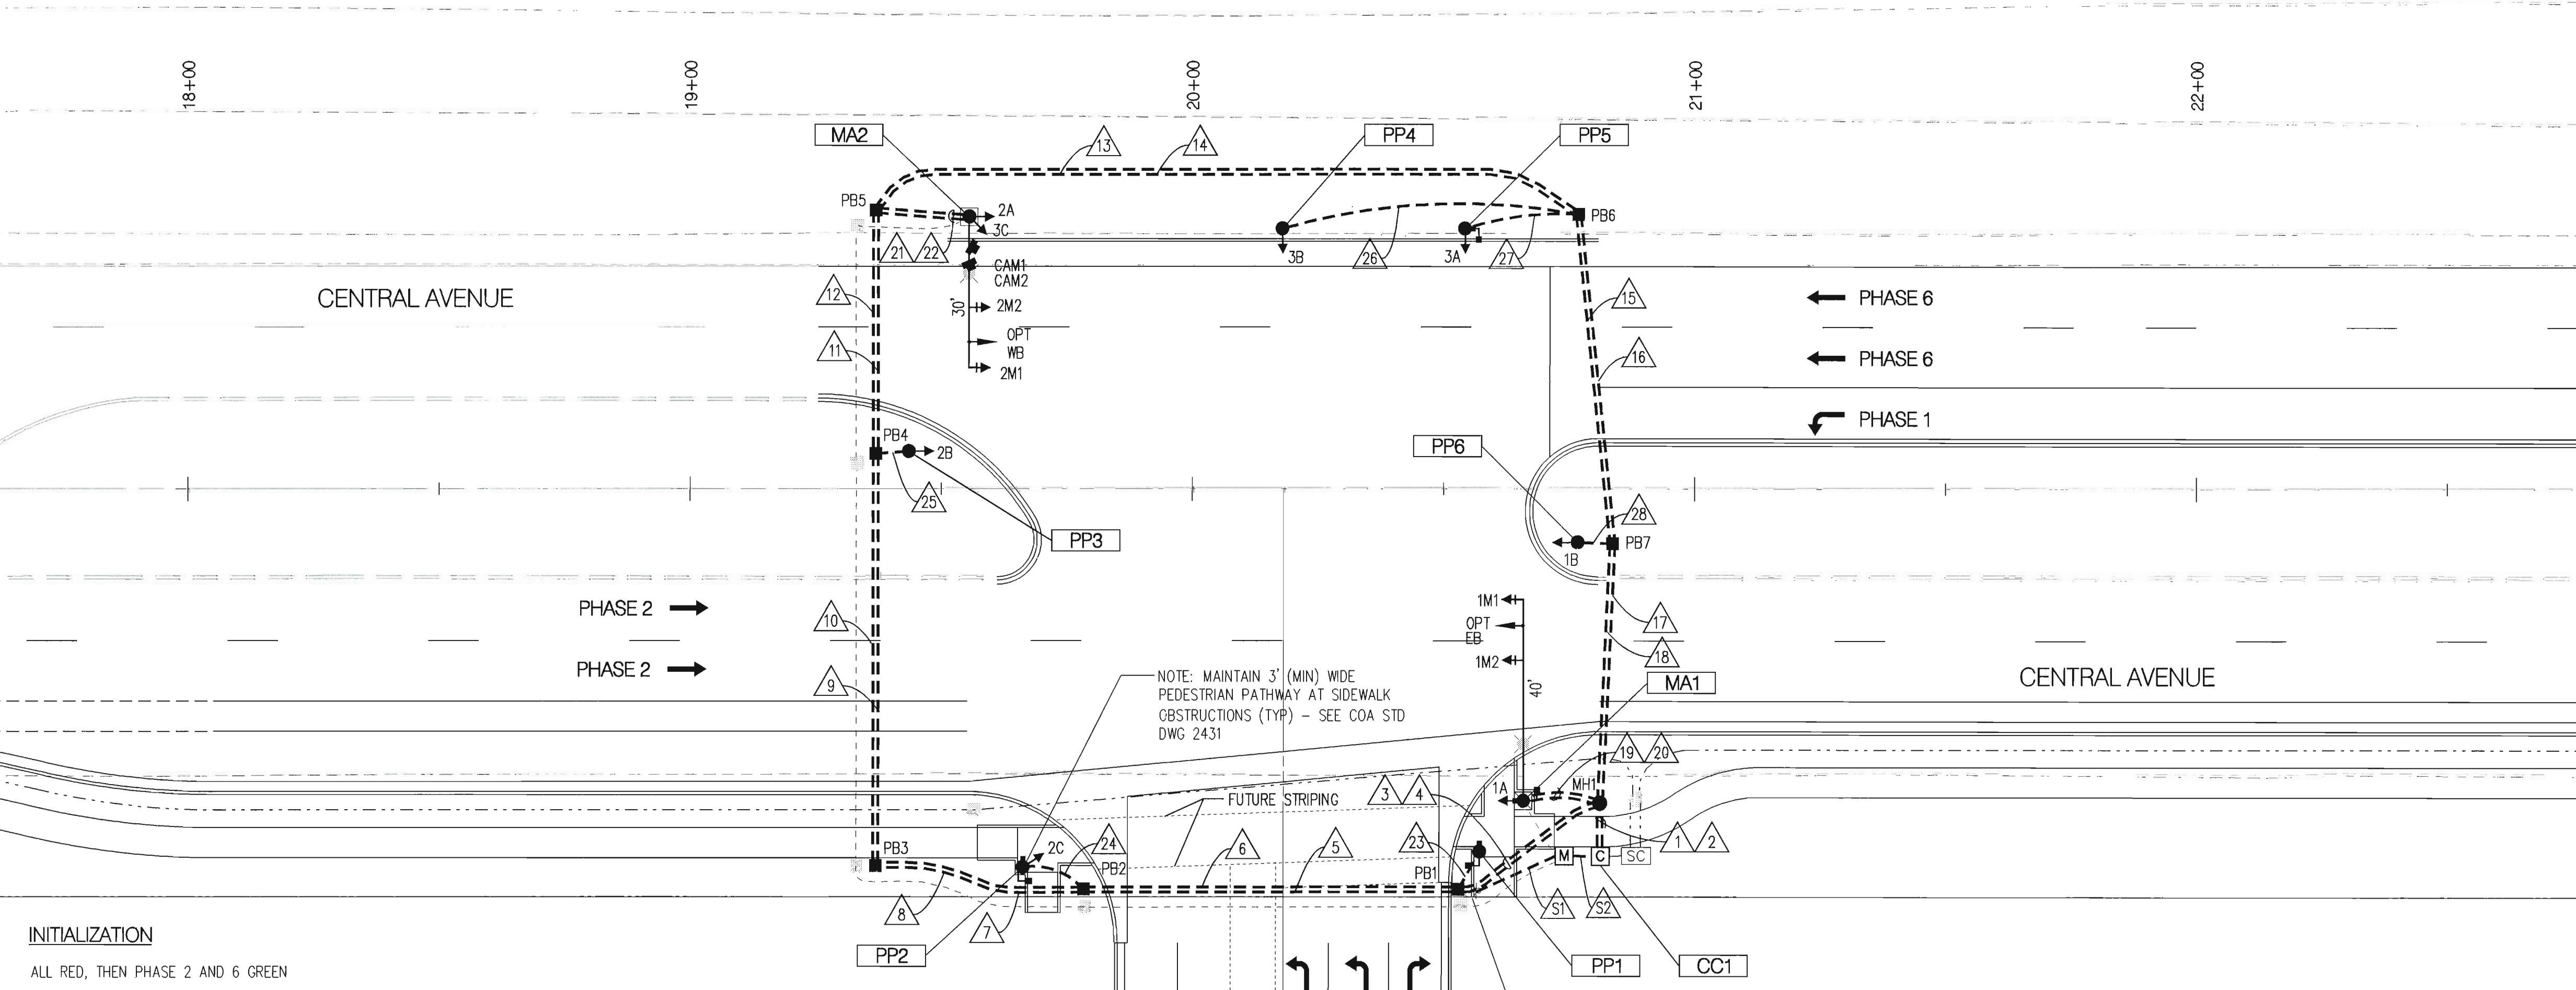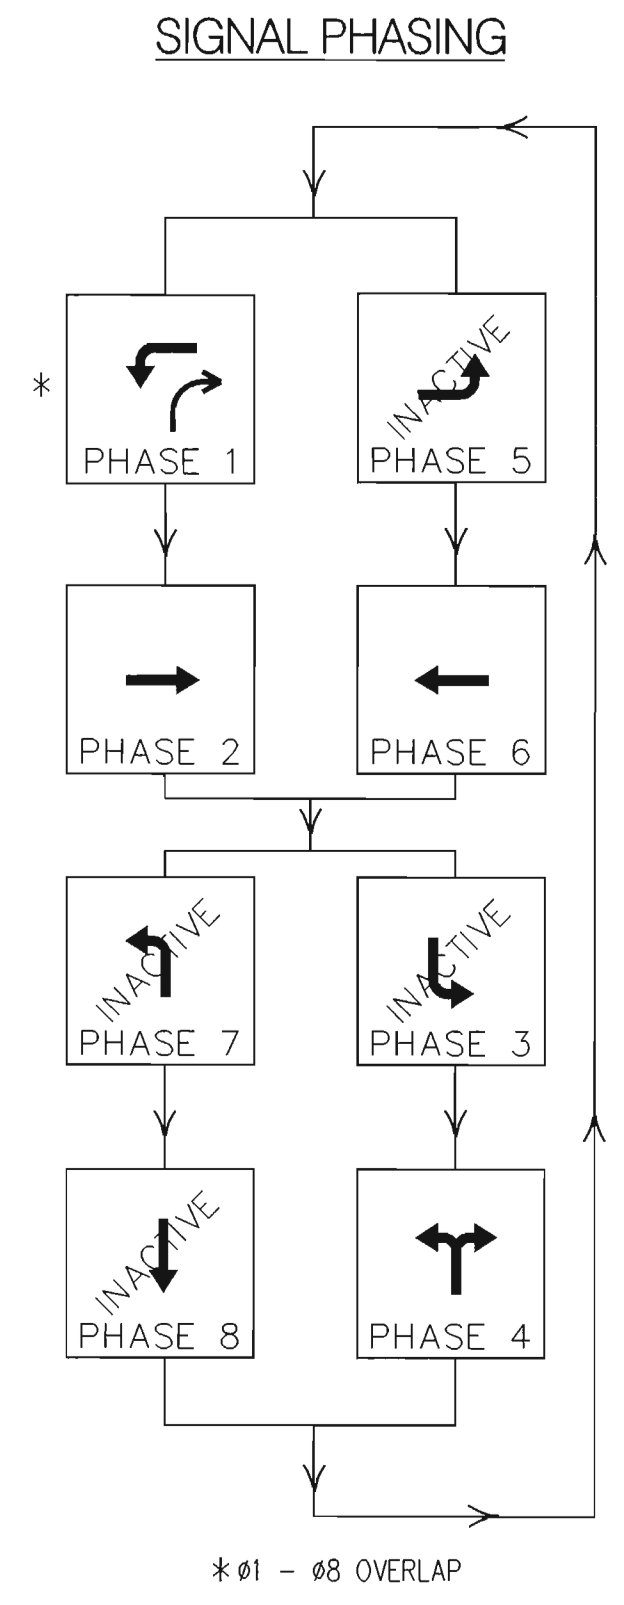

- INITIALIZATION
- ALL RED, THEN PHASE 2 AND 6 GREEN
- ABBREVIATIONS
- MA1 MASTARM NUMBER
 - PP1 PEDESTAL POLE NUMBER
 - PPB1 PEDESTRIAN PUSH BUTTON NUMBER
 - CC1 CONTROL CABINET NUMBER
 - SC1 SPLICE CABINET NUMBER
 - PB1 PULL BOX NUMBER (SIGNALS)
 - PBS1 PULL BOX NUMBER (POWER)
 - 3A SIGNAL HEAD NUMBER
 - P1 PEDESTRIAN SIGNAL NUMBER
 - MH1 TRAFFIC MANHOLE NUMBER
- FLASH CONDITION
- RED BALL 1A,1B,1M1,1M2, 3A,3B,3C
 - RED BALL 2A,2B,2C,2M1,2M2

- SYMBOL KEY
- MAX SIGNAL & CABINET ID
 - X CONDUIT RUN ID (SIGNALS)
 - SX CONDUIT RUN ID (POWER SERVICE)
- NOTES
- PULL BOXES PB1 THRU PB7 ARE LARGE SIZE.
 - SEE SHEET 16 FOR UTILITY INFORMATION.
 - SEE SHEET 23 FOR INTERSECTION LIGHTING PLAN.
 - SEE SHEET 25 FOR INTERCONNECT PLAN.

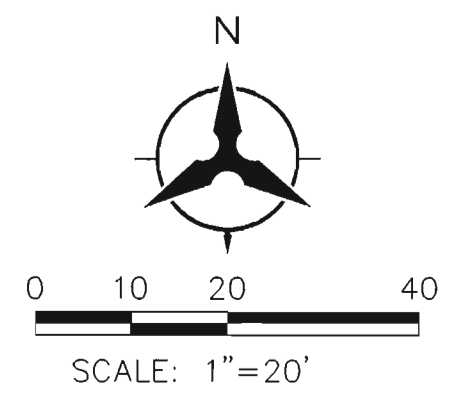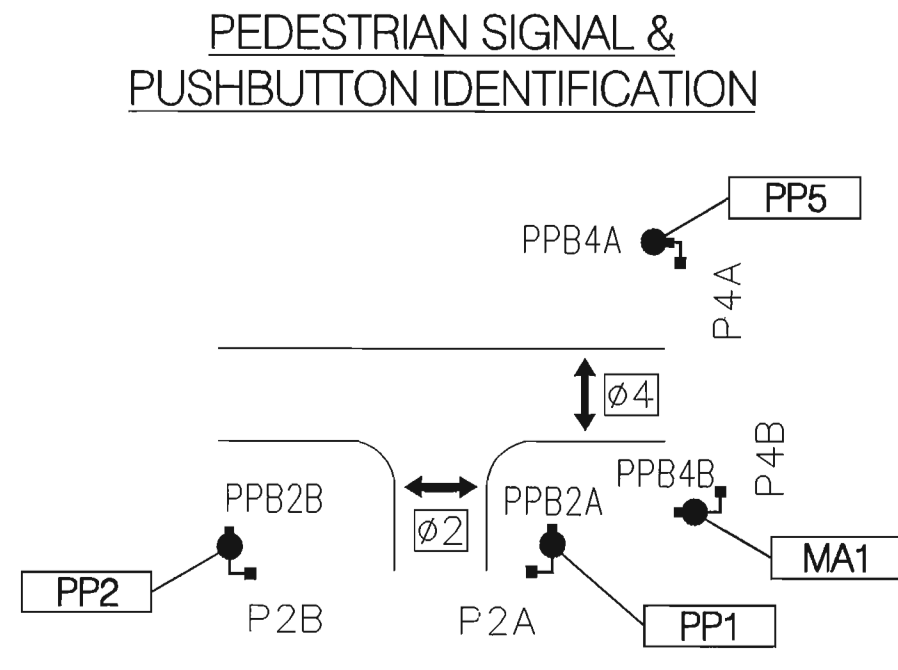

Bohannon & Huston
Court yard I 7500 Jefferson St. NE Albuquerque, NM 87109-4335
ENGINEERING • SPATIAL DATA • ADVANCED TECHNOLOGIES

CITY OF ALBUQUERQUE
DEPARTMENT OF MUNICIPAL DEVELOPMENT

OFFSITE PUBLIC INFRASTRUCTURE - UNSER CROSSING
TRAFFIC SIGNAL PLAN - CENTRAL AVE / DRIVEWAY "B"

DESIGN REVIEW COMMITTEE APPROVAL: OCT 3 1 2008
CITY ENGINEER APPROVAL: OCT 3 1 2008

CITY PROJECT NO. 735684 ZONE MAP NO. K-9 K-10 SHEET 20 OF 29

CONDUIT AND CONDUCTOR REQUIREMENTS															
CONDUIT LENGTH, SIZE, AND TYPE					CONDUIT FILL BY CONDUCTOR LENGTH AND TYPE										
RUN	SIZE/LENGTH			TYPE	REMARKS	MCC 5 (#@FT)	MCC 7 (#@FT)	MCC 20 (#@FT)	SCC #2 (#@FT)	SCC #8 (#@FT)	PS (#@FT)	OPTICOM (#@FT)	VIDEO CABLE (#@FT)	OTHER (#@FT)	
ID	1"	2"	3"			MCC 5 (#@FT)	MCC 7 (#@FT)	MCC 20 (#@FT)	SCC #2 (#@FT)	SCC #8 (#@FT)	PS (#@FT)	OPTICOM (#@FT)	VIDEO CABLE (#@FT)	OTHER (#@FT)	
S1		25		REC	POWER TO METER				3 @ 30						
S2		10		REC	METER TO CC1				3 @ 15						
1			15	REC	CC1 TO MH1	2 @ 20		2 @ 20		1 @ 20					
2		15		REC	CC1 TO MH1							2 @ 20	2 @ 20		
3			40	REC	MH1 TO PB1	2 @ 45		2 @ 45		1 @ 45					
4		40		REC	MH1 TO PB1							1 @ 45	2 @ 45		
5			80	REC	PB1 TO PB2	2 @ 85		2 @ 85		1 @ 85					
6		80		REC	PB1 TO PB2							1 @ 85	2 @ 85		
7			45	REC	PB2 TO PB3	2 @ 50		2 @ 50		1 @ 50					
8		45		REC	PB2 TO PB3							1 @ 50	2 @ 50		
9			85	REC	PB3 TO PB4	2 @ 90		2 @ 90		1 @ 90					
10		85		REC	PB3 TO PB4							1 @ 90	2 @ 90		
11			50	REC	PB4 TO PB5	2 @ 55		2 @ 55		1 @ 55					
12		50		REC	PB4 TO PB5							1 @ 55	2 @ 55		
13			145	REC	PB5 TO PB6	2 @ 150		2 @ 150		1 @ 150					
14		145		REC	PB5 TO PB6						1 @ 150				
15			70	REC	PB6 TO PB7	2 @ 75		2 @ 75		1 @ 75					
16		70		REC	PB6 TO PB7						1 @ 75				
17			55	REC	PB7 TO MH1	2 @ 60		2 @ 60		1 @ 60					
18		55		REC	PB7 TO MH1						1 @ 60				
19			20	REC	MA1 TO MH1	5 @ 25									
20		20		REC	MA1 TO MH1						1 @ 25	1 @ 25			
21			20	REC	MA2 TO PB5	4 @ 25									
22		20		REC	MA2 TO PB5							1 @ 25	2 @ 25		
23		15		REC	PP1 TO PB1	2 @ 20									
24		15		REC	PP2 TO PB2	2 @ 20	1 @ 20								
25		15		REC	PP3 TO PB4		1 @ 20								
26		65		REC	PP4 TO PB6	1 @ 70									
27		25		REC	PP5 TO PB6	2 @ 30	1 @ 30								
28		15		REC	PP6 TO PB7	1 @ 20									
MA1					BASE TO 1A	1 @ 15									
MA1					BASE TO 1M1	1 @ 60									
MA1					BASE TO 1M1	1 @ 50									
MA1					BASE TO P2A	1 @ 15									
MA1					BASE TO P8B	1 @ 15									
MA1					BASE TO PPB8B	1 @ 5									
MA1					BASE TO OPTICOM EB							1 @ 55			
MA2					BASE TO 2A	1 @ 15									
MA2					BASE TO 2M1	1 @ 45									
MA2					BASE TO 2M2	1 @ 45									
MA2					BASE TO 2C	1 @ 15									
MA2					BASE TO OPTICOM WB							1 @ 45			
MA2					BASE TO CAM1								1 @ 60		
MA2					BASE TO CAM2								1 @ 60		
PP1					BASE TO P2A	1 @ 15									
PP1					BASE TO PPB2A	1 @ 5									
PP2							1 @ 15								
PP2					BASE TO P2B	1 @ 15									
PP2					BASE TO PPB2B	1 @ 5									
PP3					BASE TO 2B		1 @ 15								
PP4					BASE TO 3B	1 @ 15									
PP5					BASE TO 3A		1 @ 15								
PP5					BASE TO P8A	1 @ 15									
PP5					BASE TO PPB8A	1 @ 5									
PP6					BASE TO 1B	1 @ 15									
TOTALS	0	810	625			2085	115	1260	135	630	310	515	860	0	

[illegible]

(Base Bid)

Bohannon Huston

Courtyard | 7500 Jefferson St. NE Albuquerque, NM 87109-4335

ENGINEERING • SPATIAL DATA • ADVANCED TECHNOLOGIES




CITY OF ALBUQUERQUE
DEPARTMENT OF
MUNICIPAL DEVELOPMENT


CONDUITS & CABLES - CENTRAL AVE / DRIVEWAY "B"

DESIGN REVIEW COMMITTEE	CITY ENGINEER APPROVAL	MO./DAY/YR.	MO./DAY/YR.
APPROVE	APPROVE		
OCT 30 2008	OCT 31 2008		
DESIGN REVIEW COMMITTEE	CITY ENGINEER	LAST DESIGN UPDATE	

CITY PROJECT NO.	735684	ZONE MAP NO.	K-9 K-10	SHEET	21	OF	29
------------------	--------	--------------	----------	-------	----	----	----

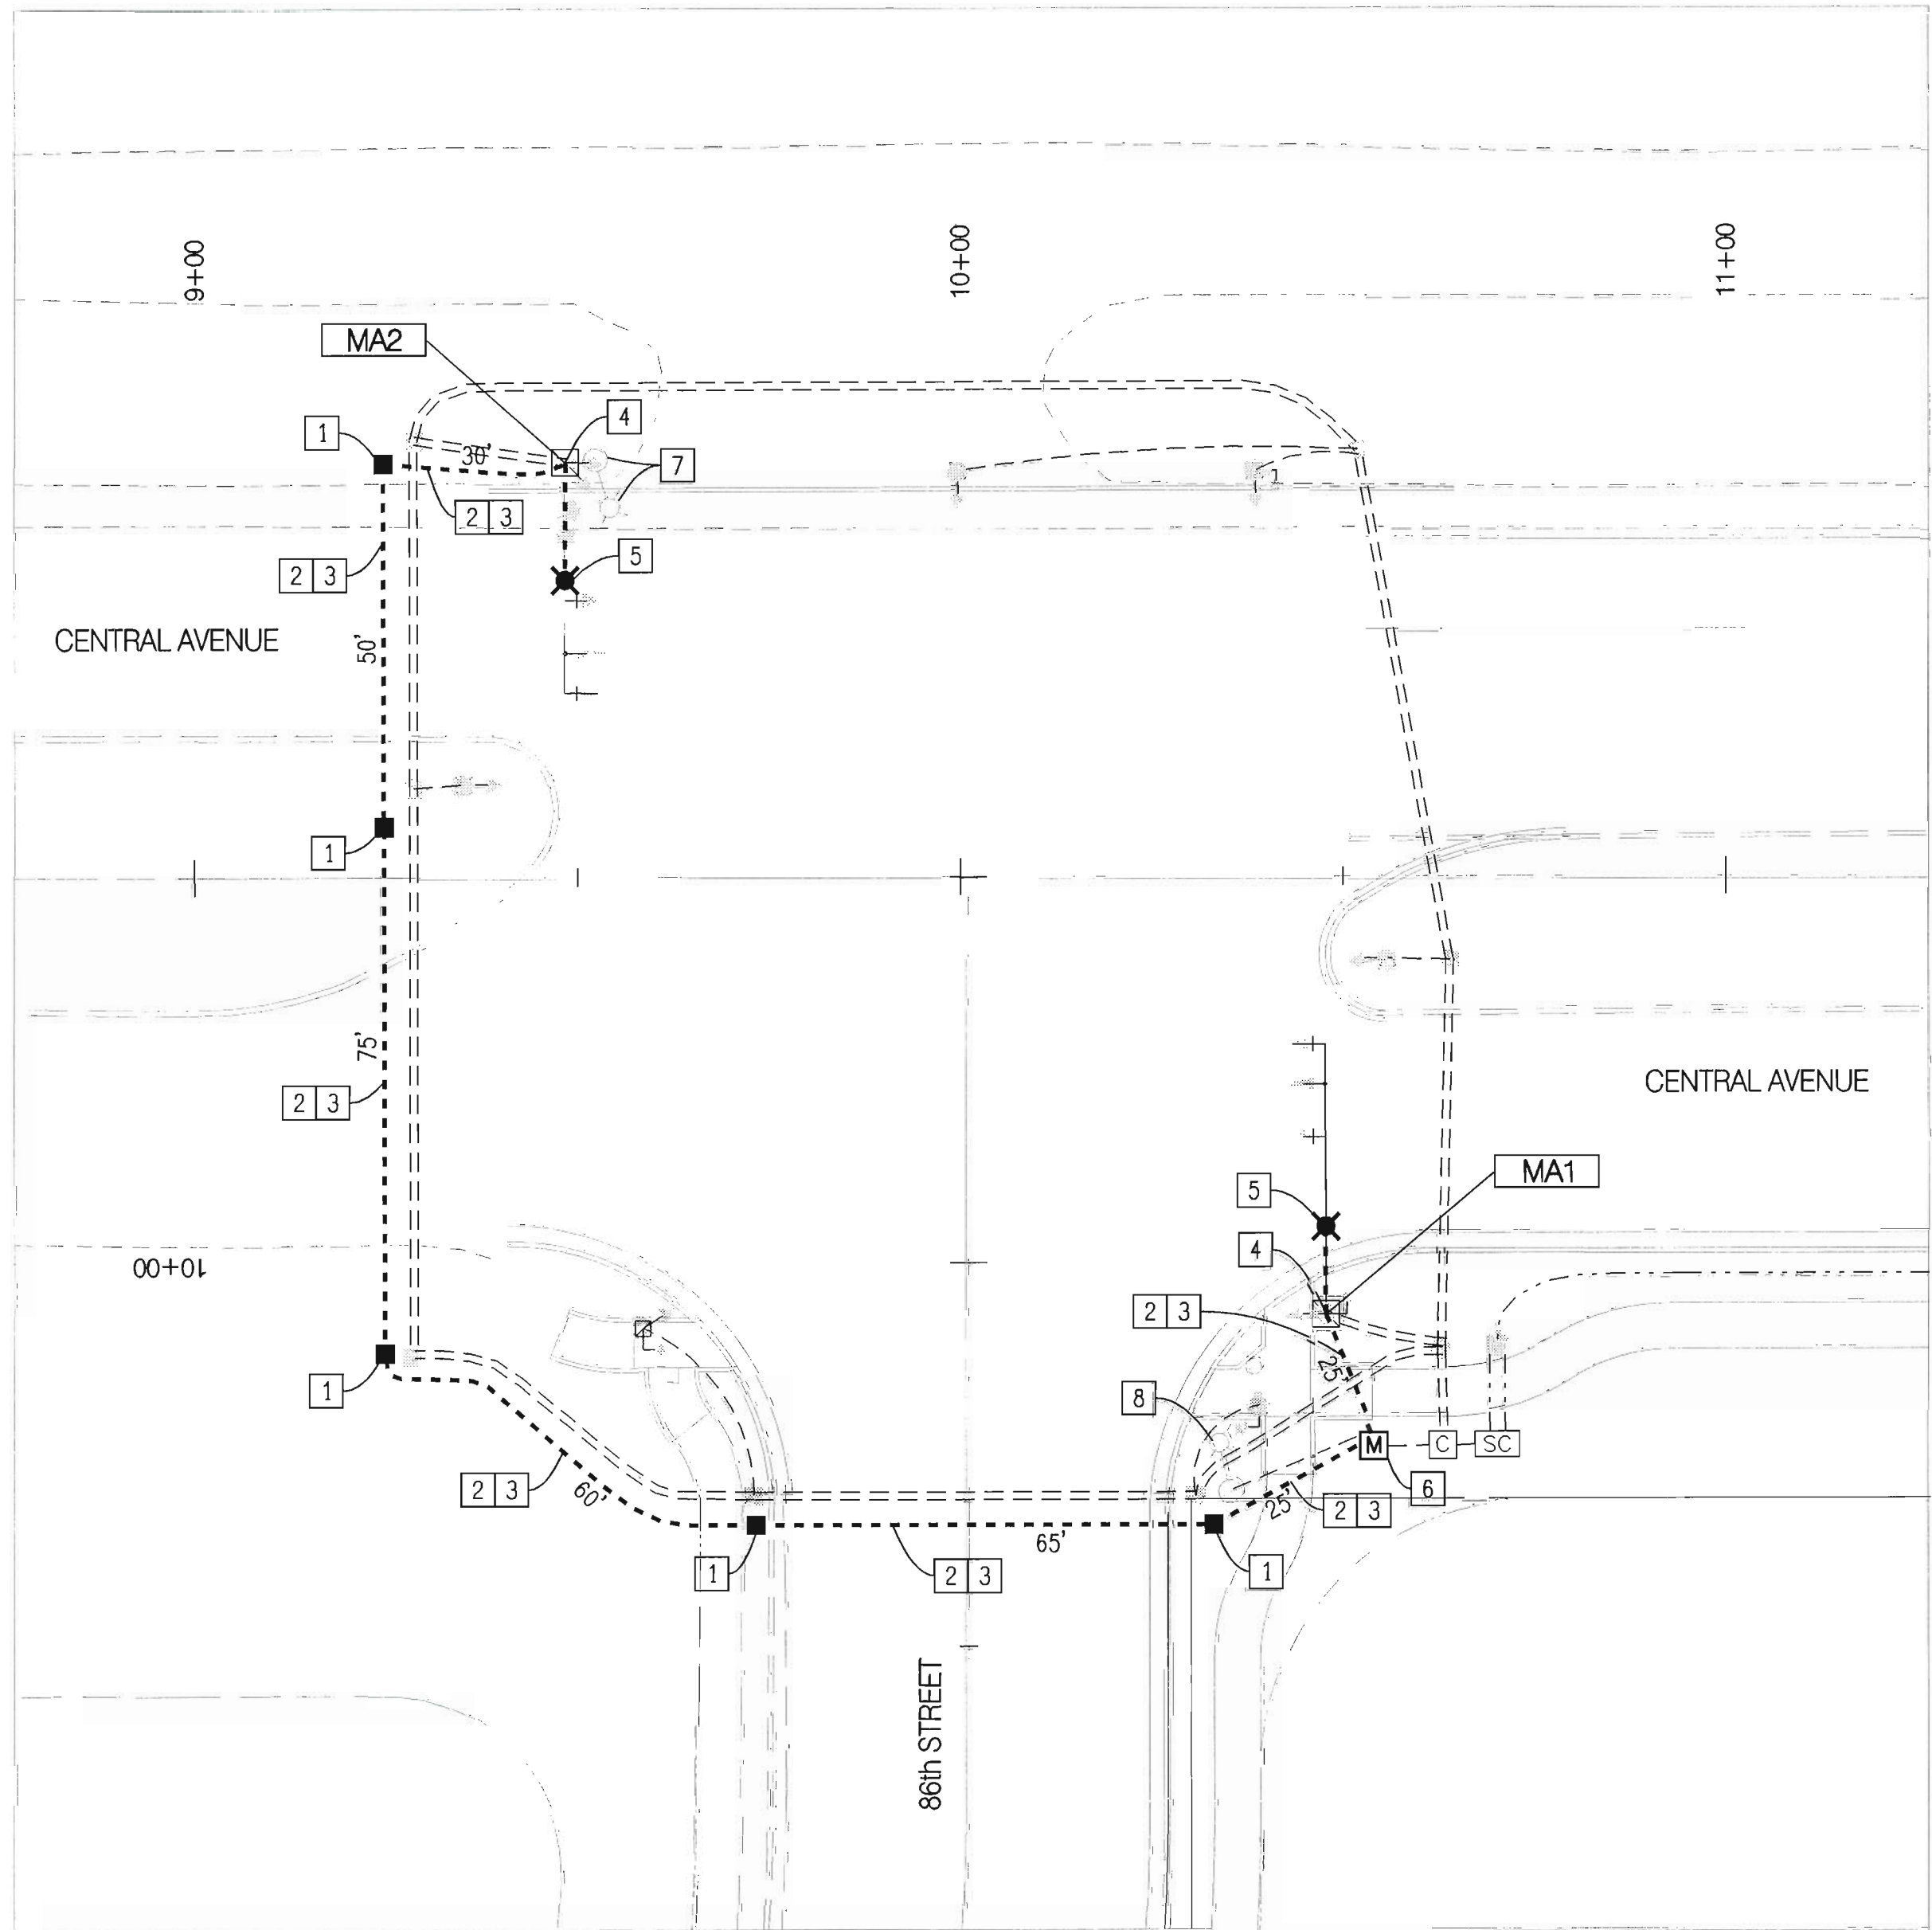


CENTRAL AVENUE / 86th STREET

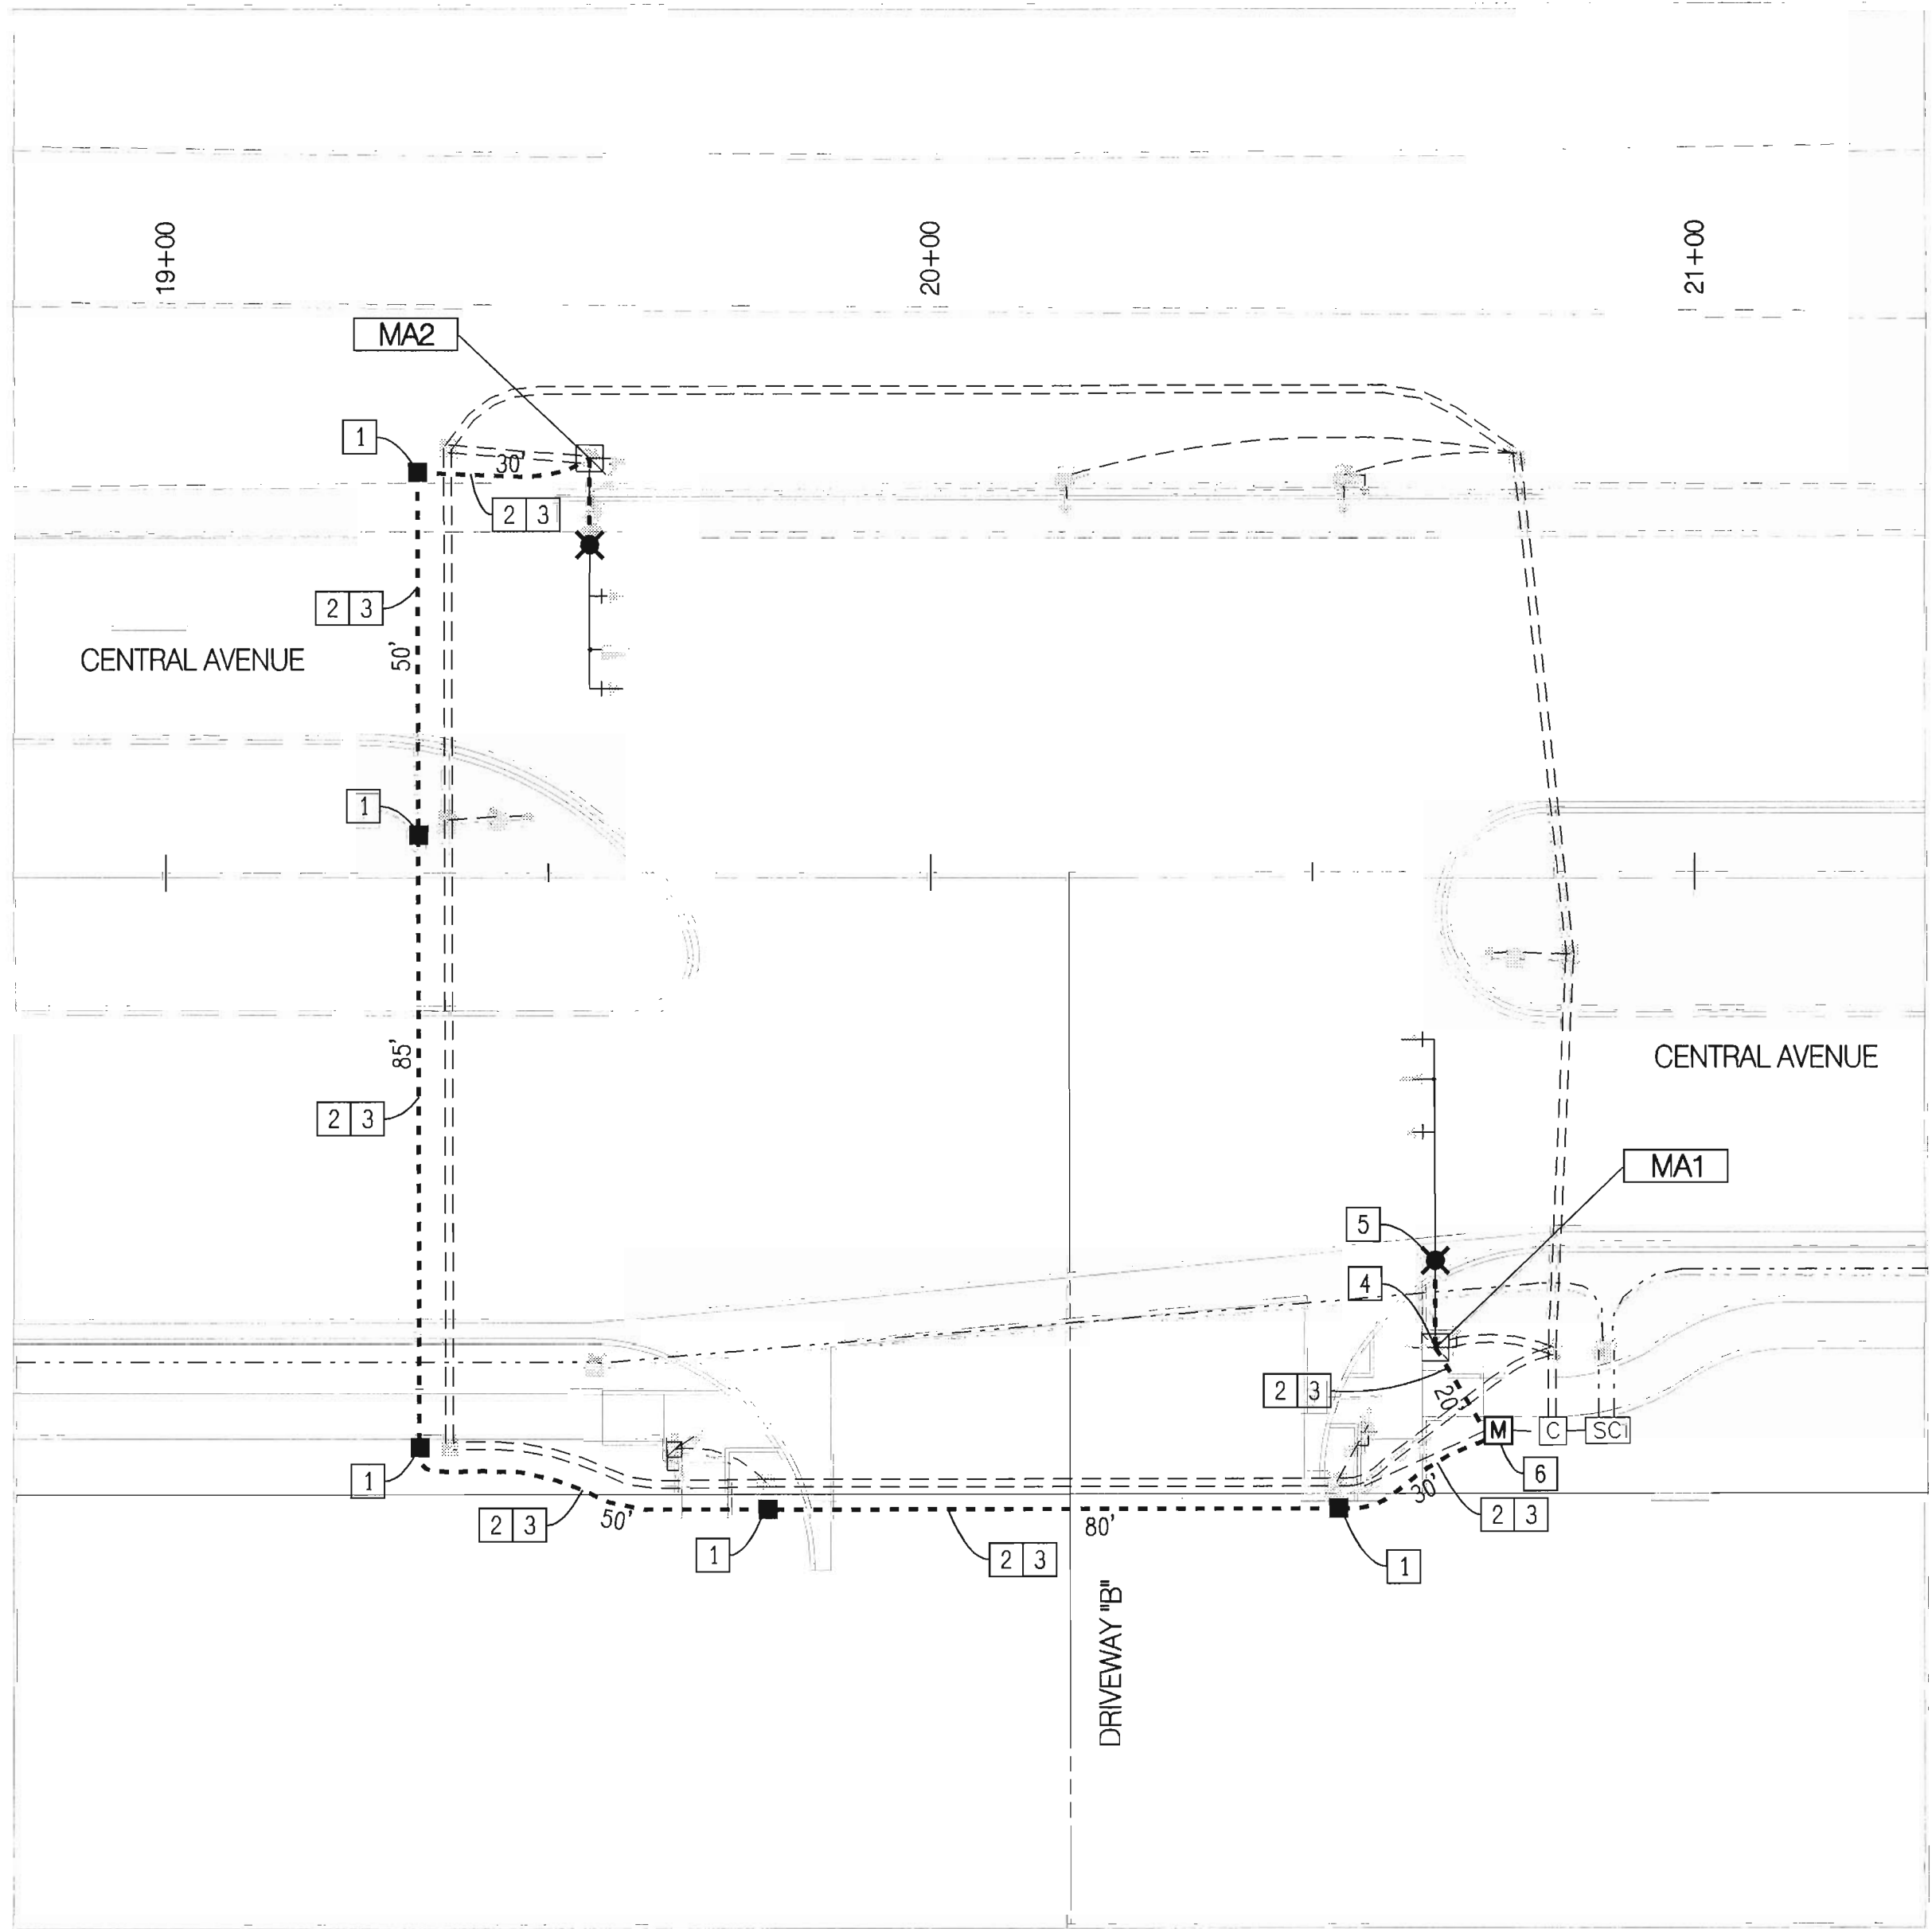



CENTRAL AVENUE / DRIVEWAY "B"

- KEYED NOTES**
- 1. INSTALL NEW ELECTRICAL PULL BOX (STANDARD)
 - 2. INSTALL NEW RIGID ELECTRICAL CONDUIT - 2"
 - 3. INSTALL TWO SINGLE CONDUCTOR WIRES #2 AWG COPPER IN CONDUIT
 - 4. INSTALL TWO SINGLE CONDUCTOR WIRES #10 AWG COPPER FROM MASTARM BASE TO LUMINAIRE
 - 5. INSTALL ROADWAY LIGHTING LUMINAIRE, HIGH PRESSURE SODIUM, 400 WATT, 240 VOLT, FLAT GLASS, CUT-OFF ON TYPE III STANDARD
 - 6. CONNECT TO LIGHTING CIRCUIT AT METER PEDESTAL
 - 7. REMOVE AND SALVAGE EXISTING POLE AND LUMINAIRE. COORDINATE THIS WORK WITH PNM
 - 8. REMOVE AND SALVAGE EXISTING LUMINAIRE. COORDINATE THIS WORK WITH PNM

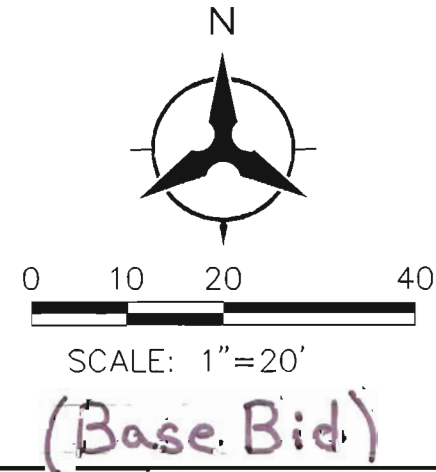
- NOTES**
- 1. ALL NEW EQUIPMENT INCLUDING PULL BOXES AND CONDUIT SHALL BE LOCATED WITHIN THE RIGHT-OF-WAY.



AS-BUILT INFORMATION		BENCH MARKS		SURVEY INFORMATION		ENGINEER'S SEAL	
CONTRACTOR: <i>Bohannon & Huston</i> WORK: <i>Signal</i> STAKED BY: <i>Carleson Surveys Inc.</i> DATE: <i>8/1/08</i>		ACS ALUMINUM DISC STAMPED "14-K9 2002" GEOGRAPHIC POSITION (NAD 83) N.M. STATE PLANE COORDINATES (CENTRAL ZONE) N=1482352.731 E=1486702.894 GROUND TO GRID = 0.999682780 DELTA ALPHA = -0016'33.63" NAVD 1988 ELEVATION = 5118.017		FIELD NOTES NO. BY DATE			
FIELD: <i>Bohannon & Huston</i> CHECKED BY: <i>Bohannon & Huston</i> DATE: <i>8/1/08</i>		REVISIONS NO. DATE BY		REMARKS DESIGN		DESIGNED BY: LAH / KOT DATE: 08/2008 DRAWN BY: LAH DATE: 08/2008 CHECKED BY: KOT DATE: 08/2008	
MICRO-FILM INFORMATION RECORDED BY: <i>Bohannon & Huston</i> DATE: <i>8/1/08</i>							




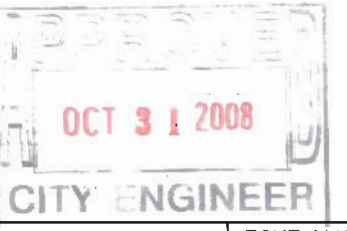
Courtyard | 7500 Jefferson St. NE Albuquerque, NM 87109-4335
ENGINEERING • SPATIAL DATA • ADVANCED TECHNOLOGIES



CITY OF ALBUQUERQUE
DEPARTMENT OF
MUNICIPAL DEVELOPMENT

OFFSITE PUBLIC INFRASTRUCTURE - UNSER CROSSING
INTERSECTION LIGHTING PLANS

DESIGN REVIEW COMMITTEE

DESIGN REVIEW COMMITTEE


CITY ENGINEER APPROVAL

CITY ENGINEER

LAST DESIGN UPDATE

CITY PROJECT NO. 735684

ZONE MAP NO. K-9 K-10

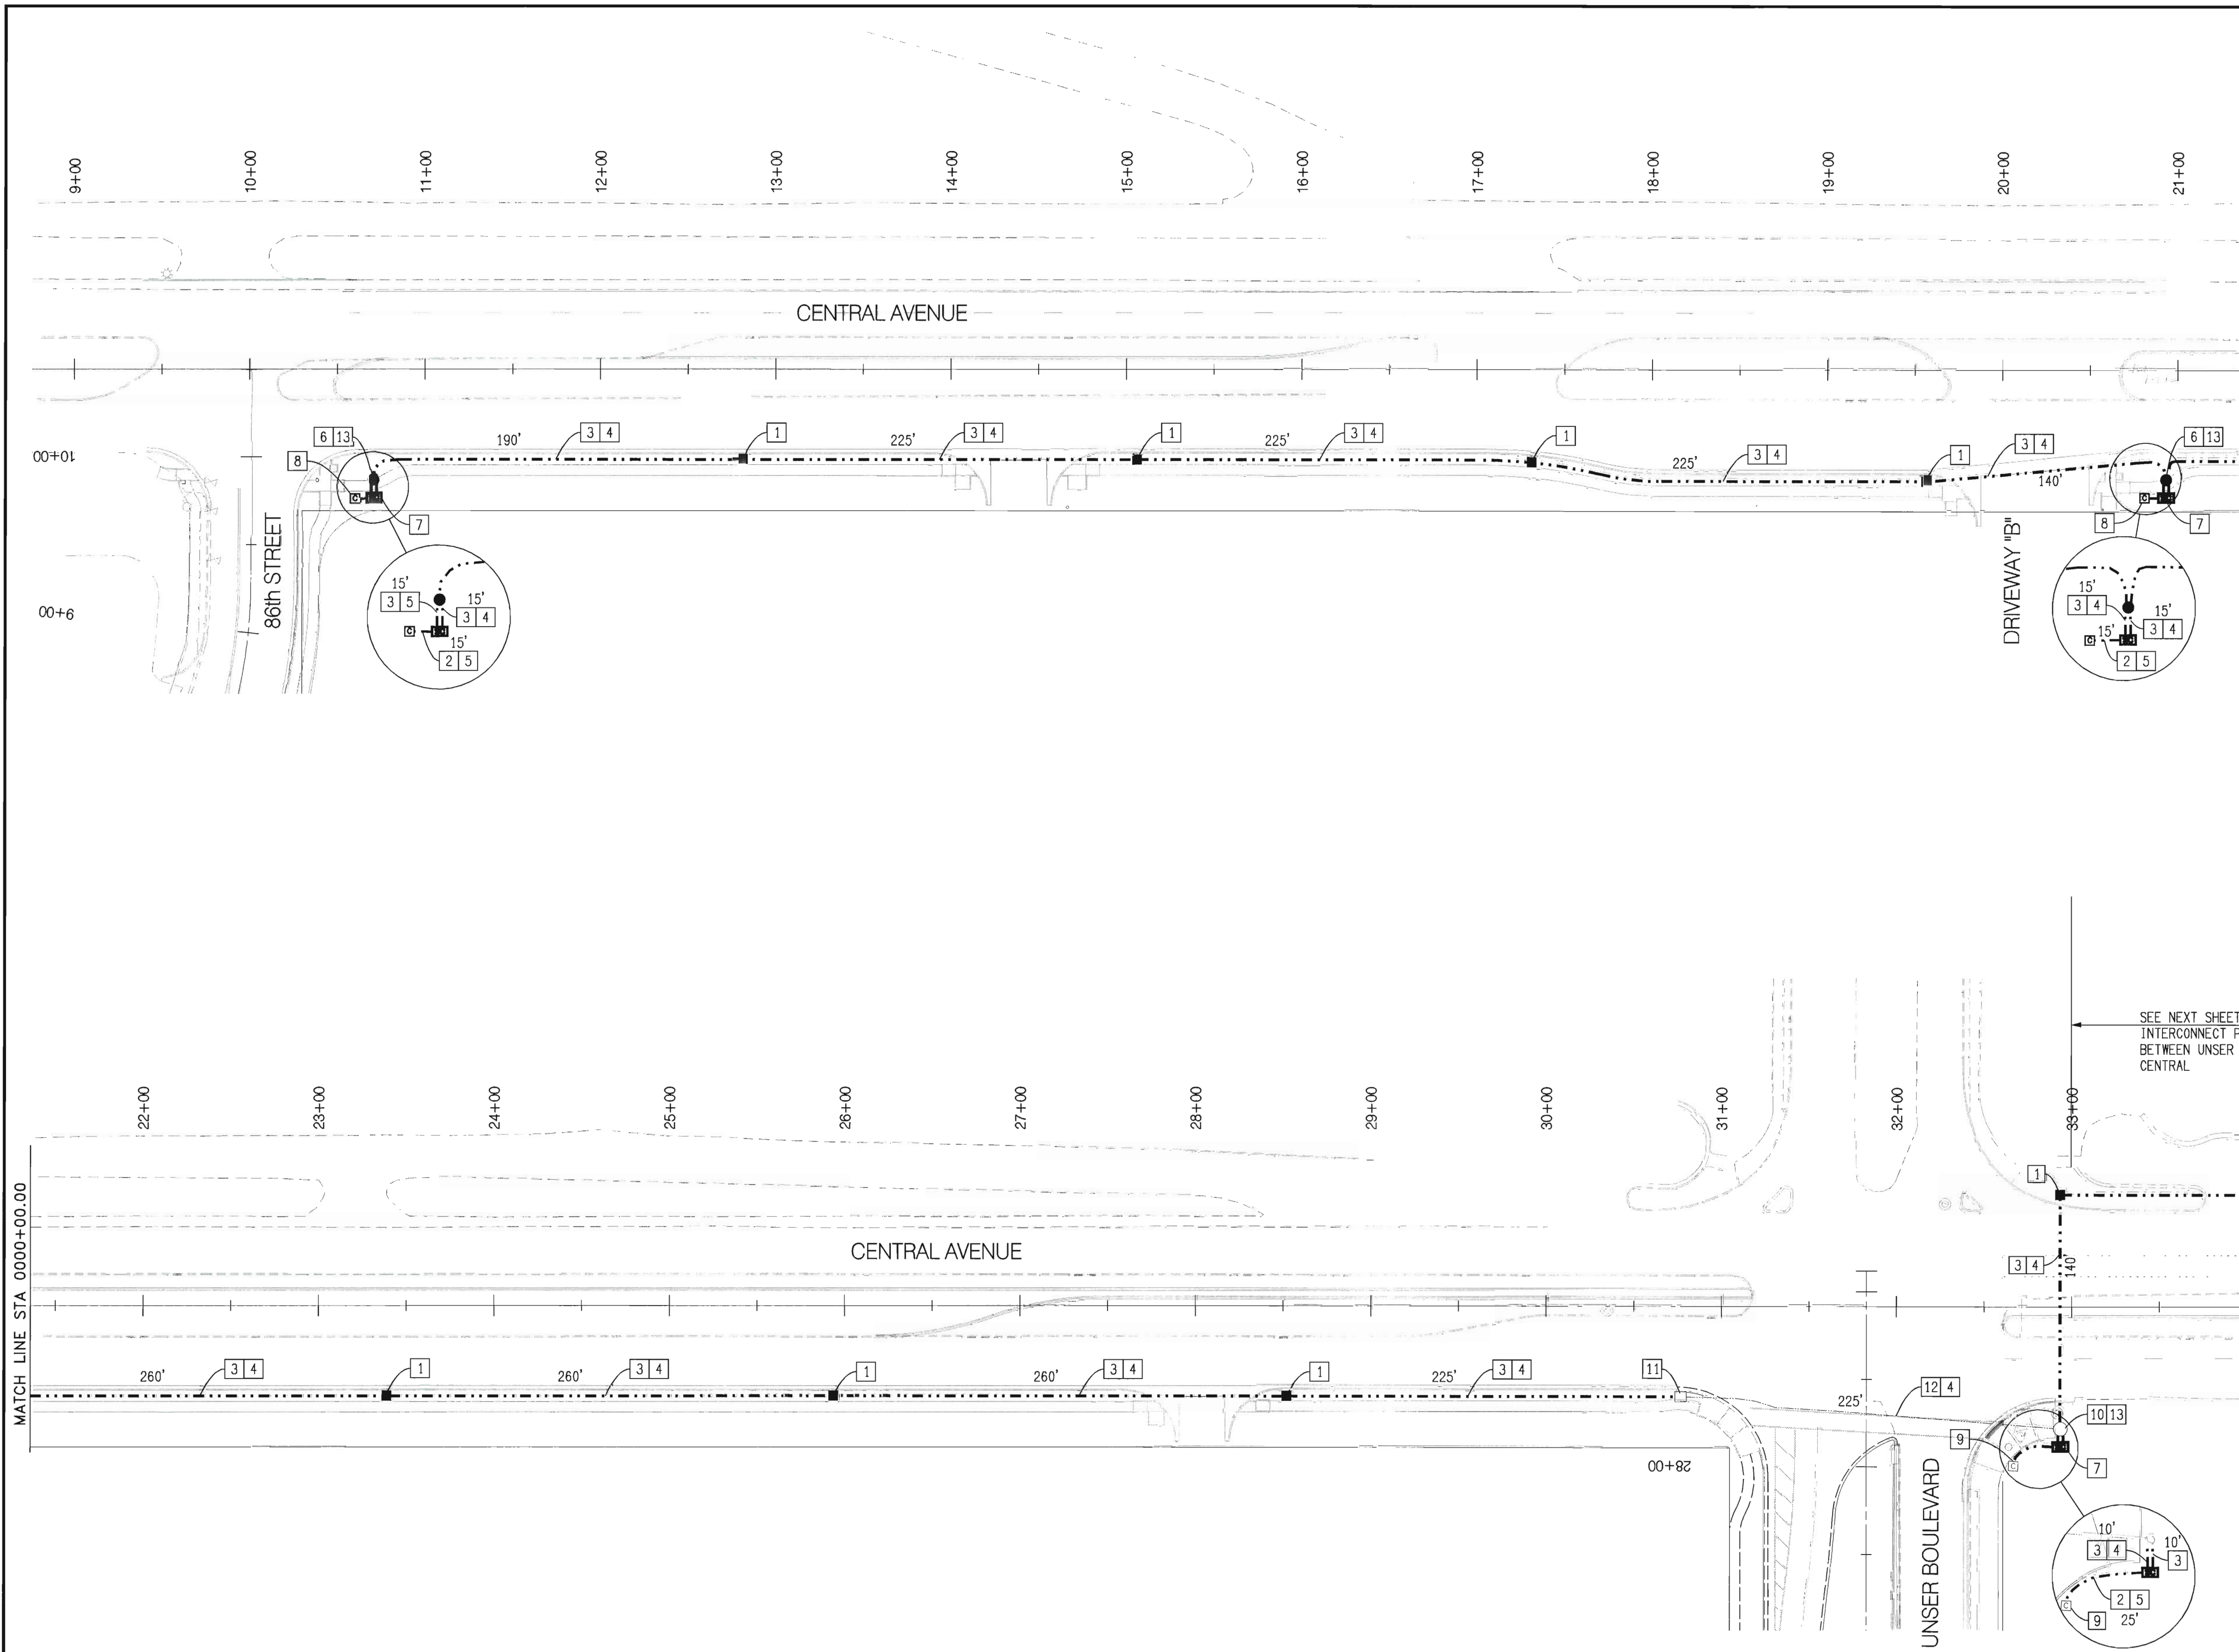SHEET 23 OF 29



- KEYED NOTES
- 1 INSTALL NEW ELECTRICAL PULL BOX (LARGE)
 - 2 INSTALL NEW RIGID ELECTRICAL CONDUIT - 2"
 - 3 INSTALL NEW RIGID ELECTRICAL CONDUIT - 3"
 - 4 INSTALL COMMUNICATION CABLE 12 PAIR
 - 5 INSTALL NEW COMMUNICATION CABLE 6 PAIR
 - 6 INSTALL NEW TRAFFIC MANHOLE
 - 7 INSTALL NEW SPLICE CABINET
 - 8 CONNECT TO NEW CONTROLLER
 - 9 CONNECT TO EXISTING CONTROLLER
 - 10 EXISTING MANHOLE TO REMAIN
 - 11 EXISTING PULL BOX TO REMAIN
 - 12 EXISTING CONDUIT TO REMAIN
 - 13 COIL 50' OF 12 PAIR COMMUNICATION CABLE IN MANHOLE

- NOTES
- 1. ALL NEW EQUIPMENT INCLUDING PULL BOXES, CONDUIT, SPLICE CABINETS AND MANHOLES SHALL BE LOCATED WITHIN THE RIGHT-OF-WAY, BETWEEN THE SIDEWALK AND CURB WHEREVER POSSIBLE.
 - 2. CONDUITS INSTALLED THAT ARE CROSSING PAVED ROADS SHALL BE BORED.



Bohannon & Huston
Courtyard I 7500 Jefferson St. NE Albuquerque, NM 87109-4335
ENGINEERING • SPATIAL DATA • ADVANCED TECHNOLOGIES

**CITY OF ALBUQUERQUE**
DEPARTMENT OF
MUNICIPAL DEVELOPMENT

OFFSITE PUBLIC INFRASTRUCTURE - UNSER CROSSING
INTERCONNECT PLAN - CENTRAL AVE

DESIGN REVIEW COMMITTEE
OCT 31 2008
DESIGN REVIEW COMMITTEE


CITY ENGINEER APPROVAL
OCT 31 2008
CITY ENG. FER

LAST DESIGN UPDATE

MO./DAY/YR.	MO./DAY/YR.

CITY PROJECT NO.	735684	ZONE MAP NO.	K-9 K-10	SHEET	25	OF	29
------------------	--------	--------------	----------	-------	----	----	----

AS-BUILT INFORMATION				BENCH MARKS				SURVEY INFORMATION				ENGINEER'S SEAL			
CONTRACTOR	DATE	WORKS	STAMPED	ACS ALUMINUM DISC	STAMPED	"14-K9 2002"		FIELD NOTES	NO.	BY	DATE	NO.	BY	DATE	
Carlsen Survey Inc.	10/28/08	10/28/08	10/28/08												
ACCEPTANCE BY	DATE	FIELD LOCATION BY	DATE	N.M. STATE PLANE COORDINATES	(CENTRAL ZONE)										
Carlsen Survey Inc.	10/28/08	Carlsen Survey Inc.	10/28/08	N=1482352.731	E=1496702.894										
CORRECTED BY	DATE	DRAWINGS	DATE	GROUND TO GRID	= 0.999682780										
Carlsen Survey Inc.	10/28/08	Carlsen Survey Inc.	10/28/08	DELTA ALPHA	= -0016'33.63"										
MICRO-FILM INFORMATION				RECORDED BY	DATE										
				NO.	DATE										

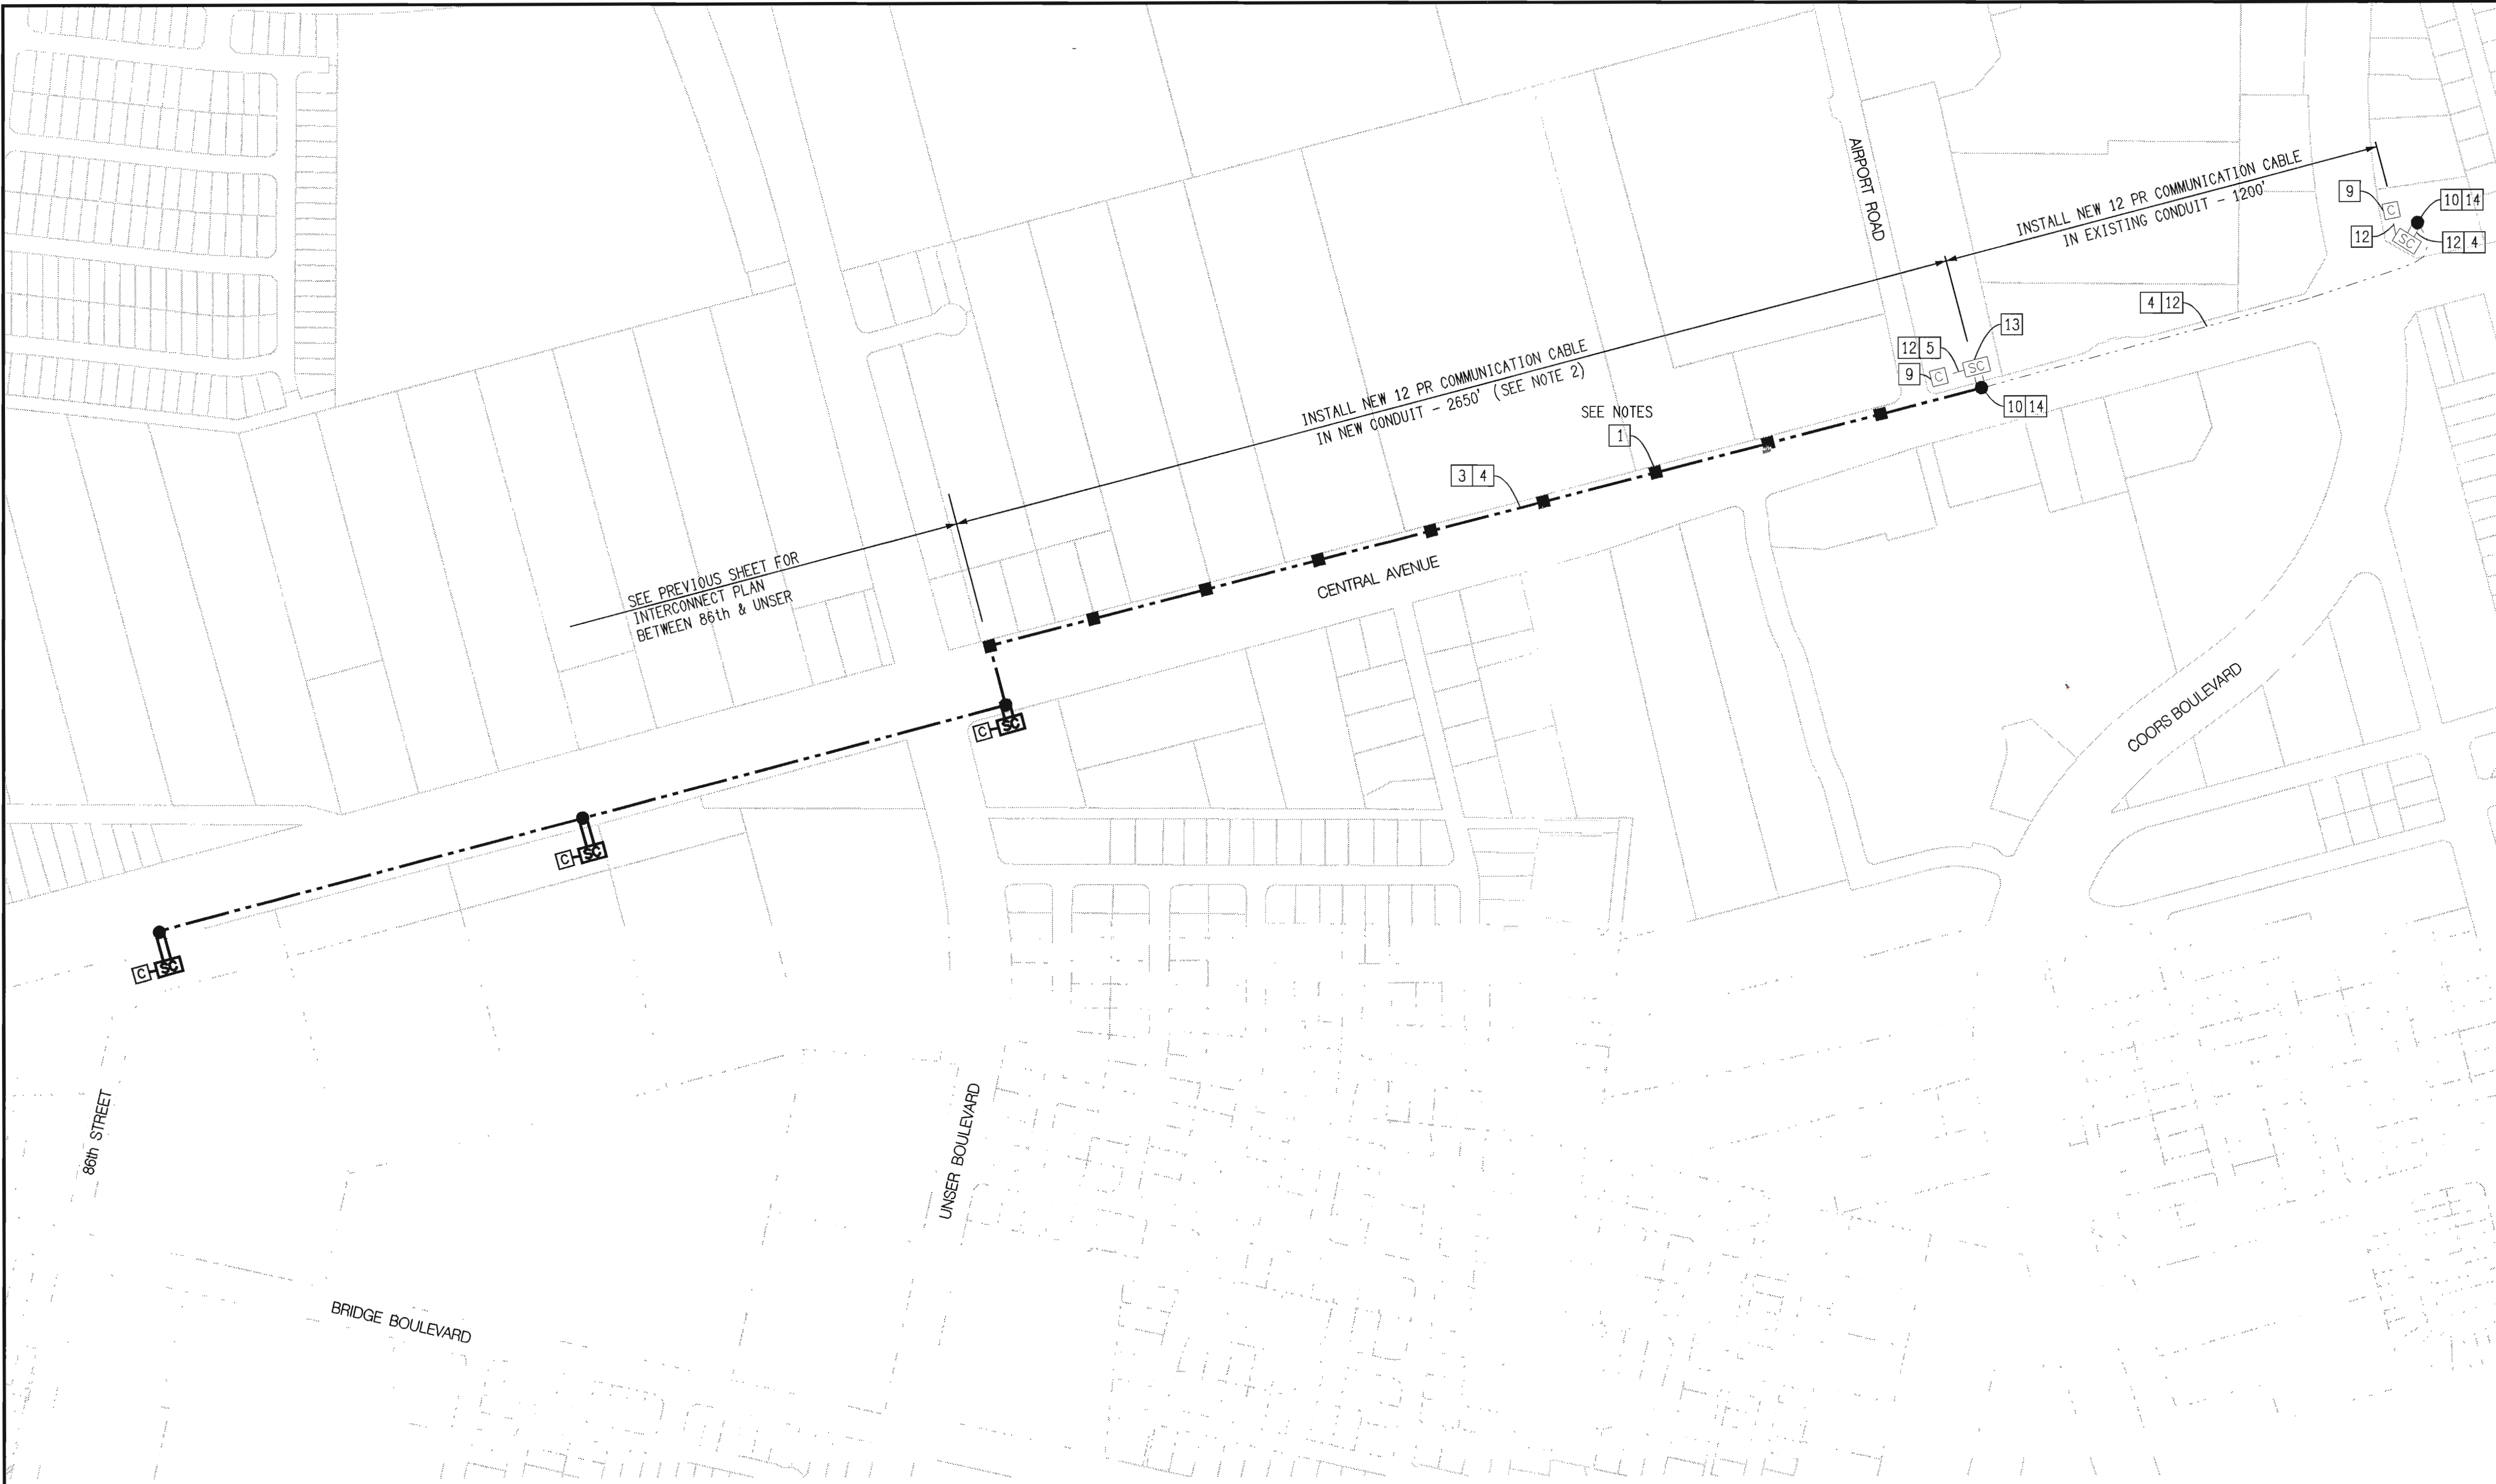

SEE PREVIOUS SHEET FOR
INTERCONNECT PLAN
BETWEEN 86th & UNSER

INSTALL NEW 12 PR COMMUNICATION CABLE
IN NEW CONDUIT - 2650' (SEE NOTE 2)

SEE NOTE
1

INSTALL NEW 12 PR COMMUNICATION CABL
IN EXISTING CONDUIT - 1200'

CENTRAL AVENUE


COORS BOULEVARD

KEYED NOTES

- 1 INSTALL NEW ELECTRICAL PULL BOX (LARGE)
- 2 INSTALL NEW RIGID ELECTRICAL CONDUIT - 2"
- 3 INSTALL NEW RIGID ELECTRICAL CONDUIT - 3"
- 4 INSTALL COMMUNICATION CABLE 12 PAIR
- 5 INSTALL NEW COMMUNICATION CABLE 6 PAIR
- 6 INSTALL NEW TRAFFIC MANHOLE
- 7 INSTALL NEW SPLICE CABINET
- 8 CONNECT TO NEW CONTROLLER
- 9 CONNECT TO EXISTING CONTROLLER
- 10 EXISTING MANHOLE TO REMAIN
- 11 EXISTING PULL BOX TO REMAIN
- 12 EXISTING CONDUIT TO REMAIN
- 13 EXISTING SPLICE CABINET TO REMAIN
- 14 COIL 50' OF 12 PAIR COMMUNICATION CABLE IN MANHOLE

NOTES

1. ALL NEW EQUIPMENT INCLUDING PULL BOXES, CONDUIT, SPLICE CABINETS AND MANHOLES SHALL BE LOCATED WITHIN THE RIGHT-OF-WAY.
2. PULL BOXES BETWEEN UNSER BOULEVARD AND AIRPORT ROAD SHALL BE INSTALLED AT 300' MAX APART. THE CONTRACTOR SHALL COORDINATE EXACT LOCATIONS IN THE FIELD WITH THE CITY OF ALBUQUERQUE TO AVOID DRIVEWAYS, ACCESS RAMPS AND OTHER FEATURES. WHERE POSSIBLE, CONDUIT SHALL BE PLACED BETWEEN THE EXISTING SIDEWALK AND CURB.

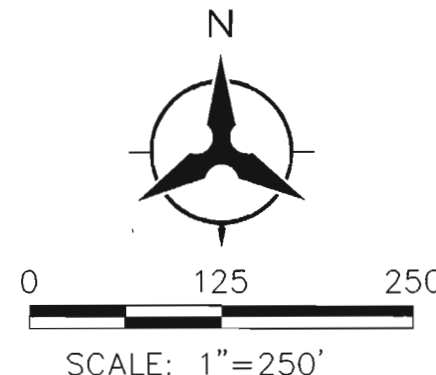

(Base Bid)


Bohannon Huston.

Courtyard I 7500 Jefferson St. NE Albuquerque, NM 87109-4335



CITY OF ALBUQUERQUE
DEPARTMENT OF
MUNICIPAL DEVELOPMENT

OFFSITE PUBLIC INFRASTRUCTURE - UNSER CROSSING
INTERCONNECT PLAN - CENTRAL AVE

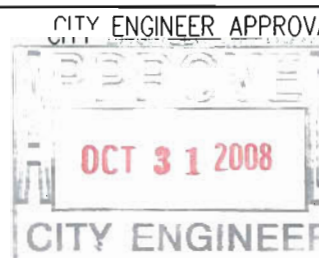

LAST DESIGN

CITY PROJECT NO.	735684	ZONE MAP NO.	K-9 K-10	SHEET	26	OF	29
------------------	--------	--------------	----------	-------	----	----	----

LOCATION OF SPLICE CABINET
CENTRAL AVENUE AND 86th STREET

TERMINAL BLOCK (A)						
CIRCUIT NUMBER	WIRE COLOR	CROSS CONNECTIONS				
		UPSTREAM CABLE *	CONT. CABLE **	***	DOWNSTREAM CABLES ****	*****
TWISTED PAIR 1<	W	1	1			
	BE	2	2			
TWISTED PAIR 2<	W	3	3			
	O	4	4			
TWISTED PAIR 3<	G	6				
TWISTED PAIR 4<	W	7				
	BN	8				
TWISTED PAIR 5<	W	9				
	GY	10				
TWISTED PAIR 6<	R	11				
	BE	12				
TWISTED PAIR 7<	R	13				
	O	14				
TWISTED PAIR 8<	R	15				
	G	16				
TWISTED PAIR 9<	R	17				
	BN	18				
TWISTED PAIR 10<	R	19				
	GY	20				
TWISTED PAIR 11<	BK	21				
	BE	22				
TWISTED PAIR 12<	BK	23				
	O	24				
TWISTED PAIR 13<	BK	25				
	G	26				
TWISTED PAIR 14<	BK	27				
	BN	28				
TWISTED PAIR 15<	BK	29				
	GY	30				
TWISTED PAIR 16<	Y	31				
	BE	32				
TWISTED PAIR 17<	Y	33				
	O	34				
TWISTED PAIR 18<	Y	35				
	G	36				
TWISTED PAIR 19<	Y	37				
	BN	38				
TWISTED PAIR 20<	Y	39				
	GY	40				
TWISTED PAIR 21<	P	41				
	BE	42				
TWISTED PAIR 22<	P	43				
	O	44				
TWISTED PAIR 23<	P	45				
	G	46				
TWISTED PAIR 24<	P	47				
	BN	48				
TWISTED PAIR 25<	P	49				
	GY	50				

CABLE IDENTIFICATION
* UPSTREAM CABLE FROM CENTRAL AND UNSER CROSSING DRIVEWAY XX PR
** CONTROLLER CABLE PROVIDES THE CIRCUIT TO MODEM IN THE SIGNAL CABINET
*** DOWNSTREAM CABLE PROVIDES CIRCUITS TO N/A AND N/A XX PR
**** DOWNSTREAM CABLE PROVIDES CIRCUITS TO N/A AND N/A XX PR
***** N/A

NOTE: TERMINAL BLOCK (B) NOT USED OR SHOWN

SPLICE DETAILS SHOWN WERE PROVIDED BY COA TRAFFIC OPERATIONS.
CONTRACTOR SHALL COMPLETE, INTERCONNECT SPLICES AS SHOWN
AND CONSULT WITH COA TRAFFIC OPERATIONS STAFF PRIOR TO COMPLETION.

LOCATION OF SPLICE CABINET
CENTRAL AVENUE AND UNSER CROSSING DRIVEWAY

TERMINAL BLOCK (A)						
CIRCUIT NUMBER	WIRE COLOR	CROSS CONNECTIONS				
		UPSTREAM CABLE *	CONT. CABLE **	***	DOWNSTREAM CABLES ****	*****
TWISTED PAIR 1<	W	1	1			
	BE	2	2			
TWISTED PAIR 2<	W	3	3			
	O	4	4			
TWISTED PAIR 3<	G	6				
TWISTED PAIR 4<	W	7				
	BN	8				
TWISTED PAIR 5<	W	9				
	GY	10				
TWISTED PAIR 6<	R	11				
	BE	12				
TWISTED PAIR 7<	R	13				
	O	14				
TWISTED PAIR 8<	R	15				
	G	16				
TWISTED PAIR 9<	R	17				
	BN	18				
TWISTED PAIR 10<	R	19				
	GY	20				
TWISTED PAIR 11<	BK	21				
	BE	22				
TWISTED PAIR 12<	BK	23				
	O	24				
TWISTED PAIR 13<	BK	25				
	G	26				
TWISTED PAIR 14<	BK	27				
	BN	28				
TWISTED PAIR 15<	BK	29				
	GY	30				
TWISTED PAIR 16<	Y	31				
	BE	32				
TWISTED PAIR 17<	Y	33				
	O	34				
TWISTED PAIR 18<	Y	35				
	G	36				
TWISTED PAIR 19<	Y	37				
	BN	38				
TWISTED PAIR 20<	Y	39				
	GY	40				
TWISTED PAIR 21<	P	41				
	BE	42				
TWISTED PAIR 22<	P	43				
	O	44				
TWISTED PAIR 23<	P	45				
	G	46				
TWISTED PAIR 24<	P	47				
	BN	48				
TWISTED PAIR 25<	P	49				
	GY	50				

CABLE IDENTIFICATION
* UPSTREAM CABLE FROM CENTRAL AND UNSER XX PR
** CONTROLLER CABLE PROVIDES THE CIRCUIT TO MODEM IN THE SIGNAL CABINET
*** DOWNSTREAM CABLE PROVIDES CIRCUITS TO CENTRAL AND 86th 12 PR
**** DOWNSTREAM CABLE PROVIDES CIRCUITS TO N/A AND N/A XX PR
***** N/A

NOTE: TERMINAL BLOCK (B) NOT USED OR SHOWN

LOCATION OF SPLICE CABINET
CENTRAL AVENUE AND COORS BOULEVARD

TERMINAL BLOCK (A)						
CIRCUIT NUMBER	WIRE COLOR	CROSS CONNECTIONS				
		UPSTREAM CABLE *	CONT. CABLE **	***	DOWNSTREAM CABLES ****	*****
TWISTED PAIR 1<	W	1	1			
	BE	2	2			
TWISTED PAIR 2<	W	3	3			
	O	4	4			
TWISTED PAIR 3<	G	6				
TWISTED PAIR 4<	W	7				
	BN	8				
TWISTED PAIR 5<	W	9				
	GY	10				
TWISTED PAIR 6<	R	11				
	BE	12				
TWISTED PAIR 7<	R	13				
	O	14				
TWISTED PAIR 8<	R	15				
	G	16				
TWISTED PAIR 9<	R	17				
	BN	18				
TWISTED PAIR 10<	R	19				
	GY	20				
TWISTED PAIR 11<	BK	21				
	BE	22				
TWISTED PAIR 12<	BK	23				
	O	24				
TWISTED PAIR 13<	BK	25				
	G	26				
TWISTED PAIR 14<	BK	27				
	BN	28				
TWISTED PAIR 15<	BK	29				
	GY	30				
TWISTED PAIR 16<	Y	31				
	BE	32				
TWISTED PAIR 17<	Y	33				
	O	34				
TWISTED PAIR 18<	Y	35				
	G	36				
TWISTED PAIR 19<	Y	37				
	BN	38				
TWISTED PAIR 20<	Y	39				
	GY	40				
TWISTED PAIR 21<	P	41				
	BE	42				
TWISTED PAIR 22<	P	43				
	O	44				
TWISTED PAIR 23<	P	45				
	G	46				
TWISTED PAIR 24<	P	47				
	BN	48				
TWISTED PAIR 25<	P	49				
	GY	50				

CABLE IDENTIFICATION
* UPSTREAM CABLE FROM _____ AND _____ XX PR
** CONTROLLER CABLE PROVIDES THE CIRCUIT TO MODEM IN THE SIGNAL CABINET
*** DOWNSTREAM CABLE PROVIDES CIRCUITS TO CENTRAL AND AIRPORT XX PR
**** DOWNSTREAM CABLE PROVIDES CIRCUITS TO N/A AND N/A XX PR
***** N/A

NOTE: TERMINAL BLOCK (B) NOT USED OR SHOWN

LOCATION OF SPLICE CABINET
CENTRAL AVENUE AND UNSER BOULEVARD

TERMINAL BLOCK (A)						
CIRCUIT NUMBER	WIRE COLOR	CROSS CONNECTIONS				
		UPSTREAM CABLE *	CONT. CABLE **	***	DOWNSTREAM CABLES ****	*****
TWISTED PAIR 1<	W	1	1			
	BE	2	2			
TWISTED PAIR 2<	W	3	3			
	O	4	4			
TWISTED PAIR 3<	G	6				
TWISTED PAIR 4<	W	7				
	BN	8				
TWISTED PAIR 5<	W	9				
	GY	10				
TWISTED PAIR 6<	R	11				
	BE	12				
TWISTED PAIR 7<	R	13				
	O	14				
TWISTED PAIR 8<	R	15				
	G	16				
TWISTED PAIR 9<	R	17				
	BN	18				
TWISTED PAIR 10<	R	19				
	GY	20				
TWISTED PAIR 11<	BK	21				
	BE	22				
TWISTED PAIR 12<	BK	23				
	O	24				
TWISTED PAIR 13<	BK	25				
	G	26				
TWISTED PAIR 14<	BK	27				
	BN	28				
TWISTED PAIR 15<	BK	29				
	GY	30				
TWISTED PAIR 16<	Y	31				
	BE	32				
TWISTED PAIR 17<	Y	33				
	O	34				
TWISTED PAIR 18<	Y	35				
	G	36				
TWISTED PAIR 19<	Y	37				
	BN	38				
TWISTED PAIR 20<	Y	39				
	GY	40				
TWISTED PAIR 21<	P	41				
	BE	42				
TWISTED PAIR 22<	P	43				
	O	44				
TWISTED PAIR 23<	P	45				
	G	46				
TWISTED PAIR 24<	P	47				
	BN	48				
TWISTED PAIR 25<	P	49				
	GY	50				

CABLE IDENTIFICATION
* UPSTREAM CABLE FROM CENTRAL AND AIRPORT XX PR
** CONTROLLER CABLE PROVIDES THE CIRCUIT TO MODEM IN THE SIGNAL CABINET
*** DOWNSTREAM CABLE PROVIDES CIRCUITS TO CENTRAL AND UNSER CROSSING DRIVEWAY 12 PR
**** DOWNSTREAM CABLE PROVIDES CIRCUITS TO N/A AND N/A XX PR
***** N/A

NOTE: TERMINAL BLOCK (B) NOT USED OR SHOWN

LOCATION OF SPLICE CABINET
CENTRAL AVENUE AND AIRPORT DRIVE

TERMINAL BLOCK (A)						
CIRCUIT NUMBER	WIRE COLOR	CROSS CONNECTIONS				
		UPSTREAM CABLE *	CONT. CABLE **	***	DOWNSTREAM CABLES *****	
TWISTED PAIR 1 <	W	1	1			
	BE	2	2	2		
TWISTED PAIR 2 <	W	3	3	3		
	O	4	4	4		
TWISTED PAIR 3 <	W	5				
	G	6				
TWISTED PAIR 4 <	W	7				
	BN	8				
TWISTED PAIR 5 <	W	9				
	GY	10				
TWISTED PAIR 6 <	R	11				
	BE	12				
TWISTED PAIR 7 <	R	13				
	O	14				
TWISTED PAIR 8 <	R	15				
	G	16				
TWISTED PAIR 9 <	R	17				
	BN	18				
TWISTED PAIR 10 <	R	19				
	GY	20				
TWISTED PAIR 11 <	BK	21				
	BE	22				
TWISTED PAIR 12 <	BK	23				
	O	24				
TWISTED PAIR 13 <	BK	25				
	G	26				
TWISTED PAIR 14 <	BK	27				
	BN	28				
TWISTED PAIR 15 <	BK	29				
	GY	30				
TWISTED PAIR 16 <	Y	31				
	BE	32				
TWISTED PAIR 17 <	Y	33				
	O	34				
TWISTED PAIR 18 <	Y	35				
	G	36				
TWISTED PAIR 19 <	Y	37				
	BN	38				
TWISTED PAIR 20 <	Y	39				
	GY	40				
TWISTED PAIR 21 <	P	41				
	BE	42				
TWISTED PAIR 22 <	P	43				
	O	44				
TWISTED PAIR 23 <	P	45				
	G	46				
TWISTED PAIR 24 <	P	47				
	BN	48				
TWISTED PAIR 25 <	P	49				
	GY	50				

LIGHTING NOTES

1. LOCATIONS OF CONDUITS, FOUNDATIONS, PULL BOXES, AND CONTROL CABINETS SHOWN ON THE PLANS ARE SCHEMATIC AND SHALL BE ADJUSTED IN THE FIELD TO MAXIMIZE CLEAR SPACE AVAILABLE FOR PEDESTRIANS AND WHEELCHAIRS TO COMPLY WITH THE AMERICANS WITH DISABILITIES ACT. THE CONTRACTOR SHALL MEET WITH THE PROJECT MANAGER IN THE FIELD AT ALL LOCATIONS TO SPOT EQUIPMENT BEFORE BEGINNING THE WORK. ALL SUCH EQUIPMENT SHALL BE INSTALLED WITHIN THE RIGHT-OF-WAY.

2. ALL WIRE ON THIS PROJECT TO BE COPPER ONLY.

3. LIGHT STANDARDS SHALL HAVE BREAKAWAY COUPLINGS.

4. ALL ROADWAY LIGHTING CIRCUITS ON THIS PROJECT SHALL BE 240 VOLTS.

5. ALL PULL BOXES INSTALLED FOR ROADWAY LIGHTING SHALL BE STANDARD.

6. CONTRACTOR SHALL REMOVE EXISTING CONDUITS AND PULL BOXES THROUGHOUT THE PROJECT AS DIRECTED BY PROJECT MANAGER.

7. REMWIRING OF EXISTING LUMINAIRES TO REMAIN, TO BE REMOVED AND RESET, AND CONNECTIONS TO NEW CIRCUITS SHALL BE CONSIDERED INCIDENTAL TO CONSTRUCTION.

8. EACH CIRCUIT FOR ROADWAY LIGHTING SHALL BE INSTALLED IN SEPARATE CONDUITS UNLESS APPROVED OTHERWISE.

8. ALL ROADWAY LUMINAIRES AND TYPE V STANDARDS WHICH ARE REMOVED SHALL BE SALVAGED AND DELIVERED TO THE CITY OF ALBUQUERQUE . PINO YARD BY THE CONTRACTOR.

10. EACH TIME A ROADWAY LUMINAIRE IS TURNED ON OR OFF THE CONTRACTOR SHALL COORDINATE WITH THE FOLLOWING REPRESENTATIVES:

PNM

CITY OF ALBUQUERQUE TRAFFIC OPERATIONS

POWER SHALL NEITHER BE TURNED ON OR OFF UNTIL RESPONSIBLE PARTIES FOR EACH LIGHTING SYSTEM HAVE BEEN NOTIFIED.

11. ALL SINGLE CONDUCTOR #10 COPPER WIRES CONNECTING THE MAIN CIRCUIT WIRING TO CORRESPONDING LUMINAIRES SHALL BE CONSIDERED INCIDENTAL TO COST OF POLES.

12. RESPONSIBILITY AND MAINTENANCE OF LIGHTING SYSTEMS INSTALLED AS PART OF THIS PROJECT SHALL BE AS FOLLOWS:

A. ROADWAY LIGHTING SYSTEM SHALL BE ACCEPTED AND MAINTAINED BY CITY OF ALBUQUERQUE AND PNM, THE CONTRACTOR SHALL PROVIDE THE CITY OF ALBUQUERQUE AND PNM FIVE (5) WORKING DAYS NOTICE IN ADVANCE OF TURNING ON THE SYSTEM SO AS TO ALLOW THE CITY OF ALBUQUERQUE AND PNM TO INSPECT AND APPROVE THE SYSTEM BEFORE IT IS TURNED ON.

THE CONTRACTOR SHALL BE RESPONSIBLE FOR MAINTENANCE AND COST OF ENERGIZING ALL LIGHTING SYSTEM UNTIL SUCH TIME THAT THE APPROPRIATE OWNER AND MAINTAINING AGENCY ACCEPT THE RESPONSIBILITY FOR THEIR RESPECTIVE SYSTEMS.

13. THE CONTRACTOR SHALL PAY FOR COSTS FOR PNM TO PROVIDE POWER SERVICE. THESE COSTS WILL BE MEASURED AND PAID UNDER CONTRACT ITEM 0421.018 – SERVICE CONNECTION.

14. ALL LIGHTING CONTROL CABINETS SHALL INCLUDE PHOTO ELECTRIC CELLS.

15. THE DESIGN IS BASED UPON TYPE III, 400 WATT, HIGH PRESSURE SODIUM, CUT-OFF, FLAT GLASS WITHOUT INDIVIDUAL PHOTO CELLS. THE CONTRACTOR SHALL FURNISH AND INSTALL THIS TYPE OF FIXTURE.

16. LIGHTING CONTROL CABINET SHALL BE OF THE FOLLOWING TYPE(S):

6 CIRCUIT, UNMETERED – (LOCATED AT THE SW CORNER OF CENTRAL & DRIVEWAY "B")

17. THE INTERSECTION LIGHTING IS TO BE SERVED BY METER PEDESTAL IN COMBINATION WITH TRAFFIC SIGNALS (SEE SIGNAL PLANS).

18. THE CONTRACTOR SHALL REMOVE EXISTING SERVICE RISERS, SERVICE POLES, CONTROL CABINETS, AND EXISTING WIRING AS REQUIRED BY PNM AND AS DIRECTED BY THE PROJECT MANAGER.

19. ANY LUMINAIRES DAMAGED DURING THE INSTALLATION OF LIGHTING STANDARDS SHALL BE REPLACED IN KIND AT CONTRACTOR'S EXPENSE.

20. ALL LIGHTING CONTROL CABINETS SHALL BE TESCO (OR APPROVED EQUAL). THE CONTRACTOR SHALL SUBMIT A COPY OF THE LIGHTING PLANS TO THE MANUFACTURER. THE MANUFACTURER SHALL REVIEW PLANS AND MODIFY THE EQUIPMENT IN EACH CABINET AS NECESSARY TO ACCOMMODATE LIGHTING REQUIREMENTS AS SHOWN ON PLANS. THE MANUFACTURER SHALL SUBMIT SHOP DRAWINGS OF EACH CABINET TO THE PROJECT MANAGER AND PNM FOR REVIEW AND APPROVAL PRIOR TO MANUFACTURING OF CABINETS. THIS WORK SHALL BE CONSIDERED INGIDENTAL TO THE CABINET AND NO SEPARATE MEASUREMENT OR PAYMENT WILL BE MADE THEREFOR.

21. LIGHTS NEAR EXISTING OVERHEAD TRANSMISSION LINES MUST BE MAINTAIN A REQUIRED VERTICAL AND HORIZONTAL CLEARANCE FROM THE PHASE CONDUCTOR. PNM WILL ASSIST IN MEASUREMENT AND DETERMINATION OF CLEARANCE.

22. THE FOLLOWING CITY OF ALBUQUERQUE STANDARD DRAWINGS SHALL BE USED FOR THE LIGHTING INSTALLATION:

2550 TRAFFIC SIGNAL PULL BOX DETAILS
2574 STREET LIGHTING CONTROL CABINET, SIX CIRCUIT UNMETERED
2580 STREET LIGHTING FOUNDATION & MISCELLANEOUS DETAILS
2581 STREET LIGHTING INSTALLATION & POLE DETAILS

LIGHTING INCIDENTAL ITEMS

1. ANCHOR BOLTS FOR FOUNDATIONS.

2. GROUND RODS FOR FOUNDATIONS.

3. UNIVERSAL SUPPORT BRACKETS FOR SERVICE RISERS.

4. CONCRETE FOUNDATION FOR LIGHTING CONTROL CABINETS INCLUDING EXCAVATION, BACKFILL, CONCRETE, GROUND RODS, AND ANCHOR BOLTS.

5. REMWIRING OF ANY EXISTING LUMINAIRES TO REMAIN OR BE RESET.

6. SINGLE CONDUCTOR #10 AWG COPPER WIRE CONNECTIONS FROM MAIN CIRCUIT TO LUMINAIRES.

7. REMOVAL OF EXISTING STANDARDS AND LUMINAIRES AND DELIVERY TO THE CITY OF ALBUQUERQUE.

8. SHOP DRAWING PREPARATION AND COORDINATION FOR LIGHTING CONTROL CABINETS.

9. ENERGY COST OF THE LIGHTING SYSTEM UNTIL ACCEPTANCE BY THE MAINTAINING AGENCY.

LIGHTING LEGEND

NEW

EXISTING

ITEM

CONDUIT RUN

PULL BOX

JUNCTION BOX

SERVICE POLE WITH SERVICE RISER

LIGHTING CONTROL CABINET

TRAFFIC MANHOLE

CIRCUIT NUMBER

LUMINAIRE NUMBER

STATIONING

00-00-000-0-0

TYPE OF LAMP

TYPE OF DISTRIBUTION

WATTAGE

ARM LENGTH

MOUNTING HEIGHT

LIGHTING QUANTITIES (Estimated)

ITEM NO.	DESCRIPTION	UNIT	ROADWAY LIGHTING	TOTAL (USE)
0421.006	SERVICE RISER (LIGHTING), CIP	EA	1	1
0421.018	SERVICE CONNECTION (LIGHTING), CIP	EA	1	1
0421.024	LIGHTING CONTROL CABINET, SIX CIRCUIT, UNMETERED, CIP	EA	1	1
0422.032	STREET LIGHT STANDARD, SINGLE ARM, 40' (TYPE V DAVIT), CIP	EA	8	8
0423.020	LUMINAIRE FOUNDATION FOR LUMINARIE HEIGHT OF 40' OR LESS, CIP.	EA	8	8
0424.006	ELECTRICAL CONDUIT, 2", INCLUDING TRENCHING, BACKFILL, PATCHING, PUSHING, BORING, JACKING, CIP.	EA	1770	1770
0425.002	PULL BOX, (STANDARD), CIP	EA	3	3
0426.001	SINGLE CONDUCTOR, #2, CIP	LIN FT	3600	3600
0432.002	ROADWAY LUMINAIRE, TYPE 400S, CIP	EA	8	8

P:\090147\Trans\Design\Lighting\090147-LTNT.sht
Mon, 13-OCT-2008 – 13:51PM, Plotted by: lghinde

BHI JOB NO. 090147

AS-BUILT INFORMATION

CONTRACTOR *Bohannon & Huston* DATE *09/09*
STATED BY *Carleson Surveys Inc.* DATE *10-10*
INSPECTOR'S FIELD CHECKED BY *COA* DATE *09/09*
VERIFICATION BY *Carleson Surveys Inc.* DATE *09/09*
CORRECTED BY *Carleson* DATE *09/09*
MICRO-FILM INFORMATION
RECORDED BY DATE
NO. DATE

BENCH MARKS

ACS ALUMINUM DISC STAMPED "14-K9 2002"
GEOGRAPHIC POSITION (NAD 83)
N.M. STATE PLANE COORDINATES
(CENTRAL ZONE)
N=1482352.731 E=1496702.894
GROUND TO GRID = 0.999682780
DELTA ALPHA = -0016'33.63"
NAVD 1988 ELEVATION = 5118.017

SURVEY INFORMATION

FIELD NOTES
DATE
BY
NO.

ENGINEER'S SEAL

KURT D. THORSON
NEW MEXICO
13810
REGISTERED PROFESSIONAL ENGINEER

REMARKS
REVISIONS
DESIGN
DATE 08/2008
LAH / KDT
DATE 08/2008
LAH
DATE 08/2008
KDT

(Base Bid)

Bohannon & Huston

Courtyard I 7500 Jefferson St. NE Albuquerque, NM 87109-4335

ENGINEERING • SPATIAL DATA • ADVANCED TECHNOLOGIES

DESIGN REVIEW COMMITTEE

APPROVE

OCT 30 2008

DESIGN REVIEW COMMITTEE

CITY ENGINEER APPROVAL

APPROVE

OCT 31 2008

CITY ENGINEER

LAST DESIGN UPDATE

MO./DAY/YR.

MO./DAY/YR.

CITY PROJECT NO.

735684

ZONE MAP NO.

K-9 K-10

SHEET

28

OF

29

CITY OF ALBUQUERQUE

DEPARTMENT OF MUNICIPAL DEVELOPMENT

OFFSITE PUBLIC INFRASTRUCTURE - UNSER CROSSING

LIGHTING NOTES, QUANTITIES AND LEGEND

DESIGN REVIEW COMMITTEE

APPROVE

OCT 30 2008

DESIGN REVIEW COMMITTEE

CITY ENGINEER APPROVAL

APPROVE

OCT 31 2008

CITY ENGINEER

LAST DESIGN UPDATE

MO./DAY/YR.

MO./DAY/YR.

CITY PROJECT NO.

735684

ZONE MAP NO.


K-9 K-10

SHEET

28

OF


29

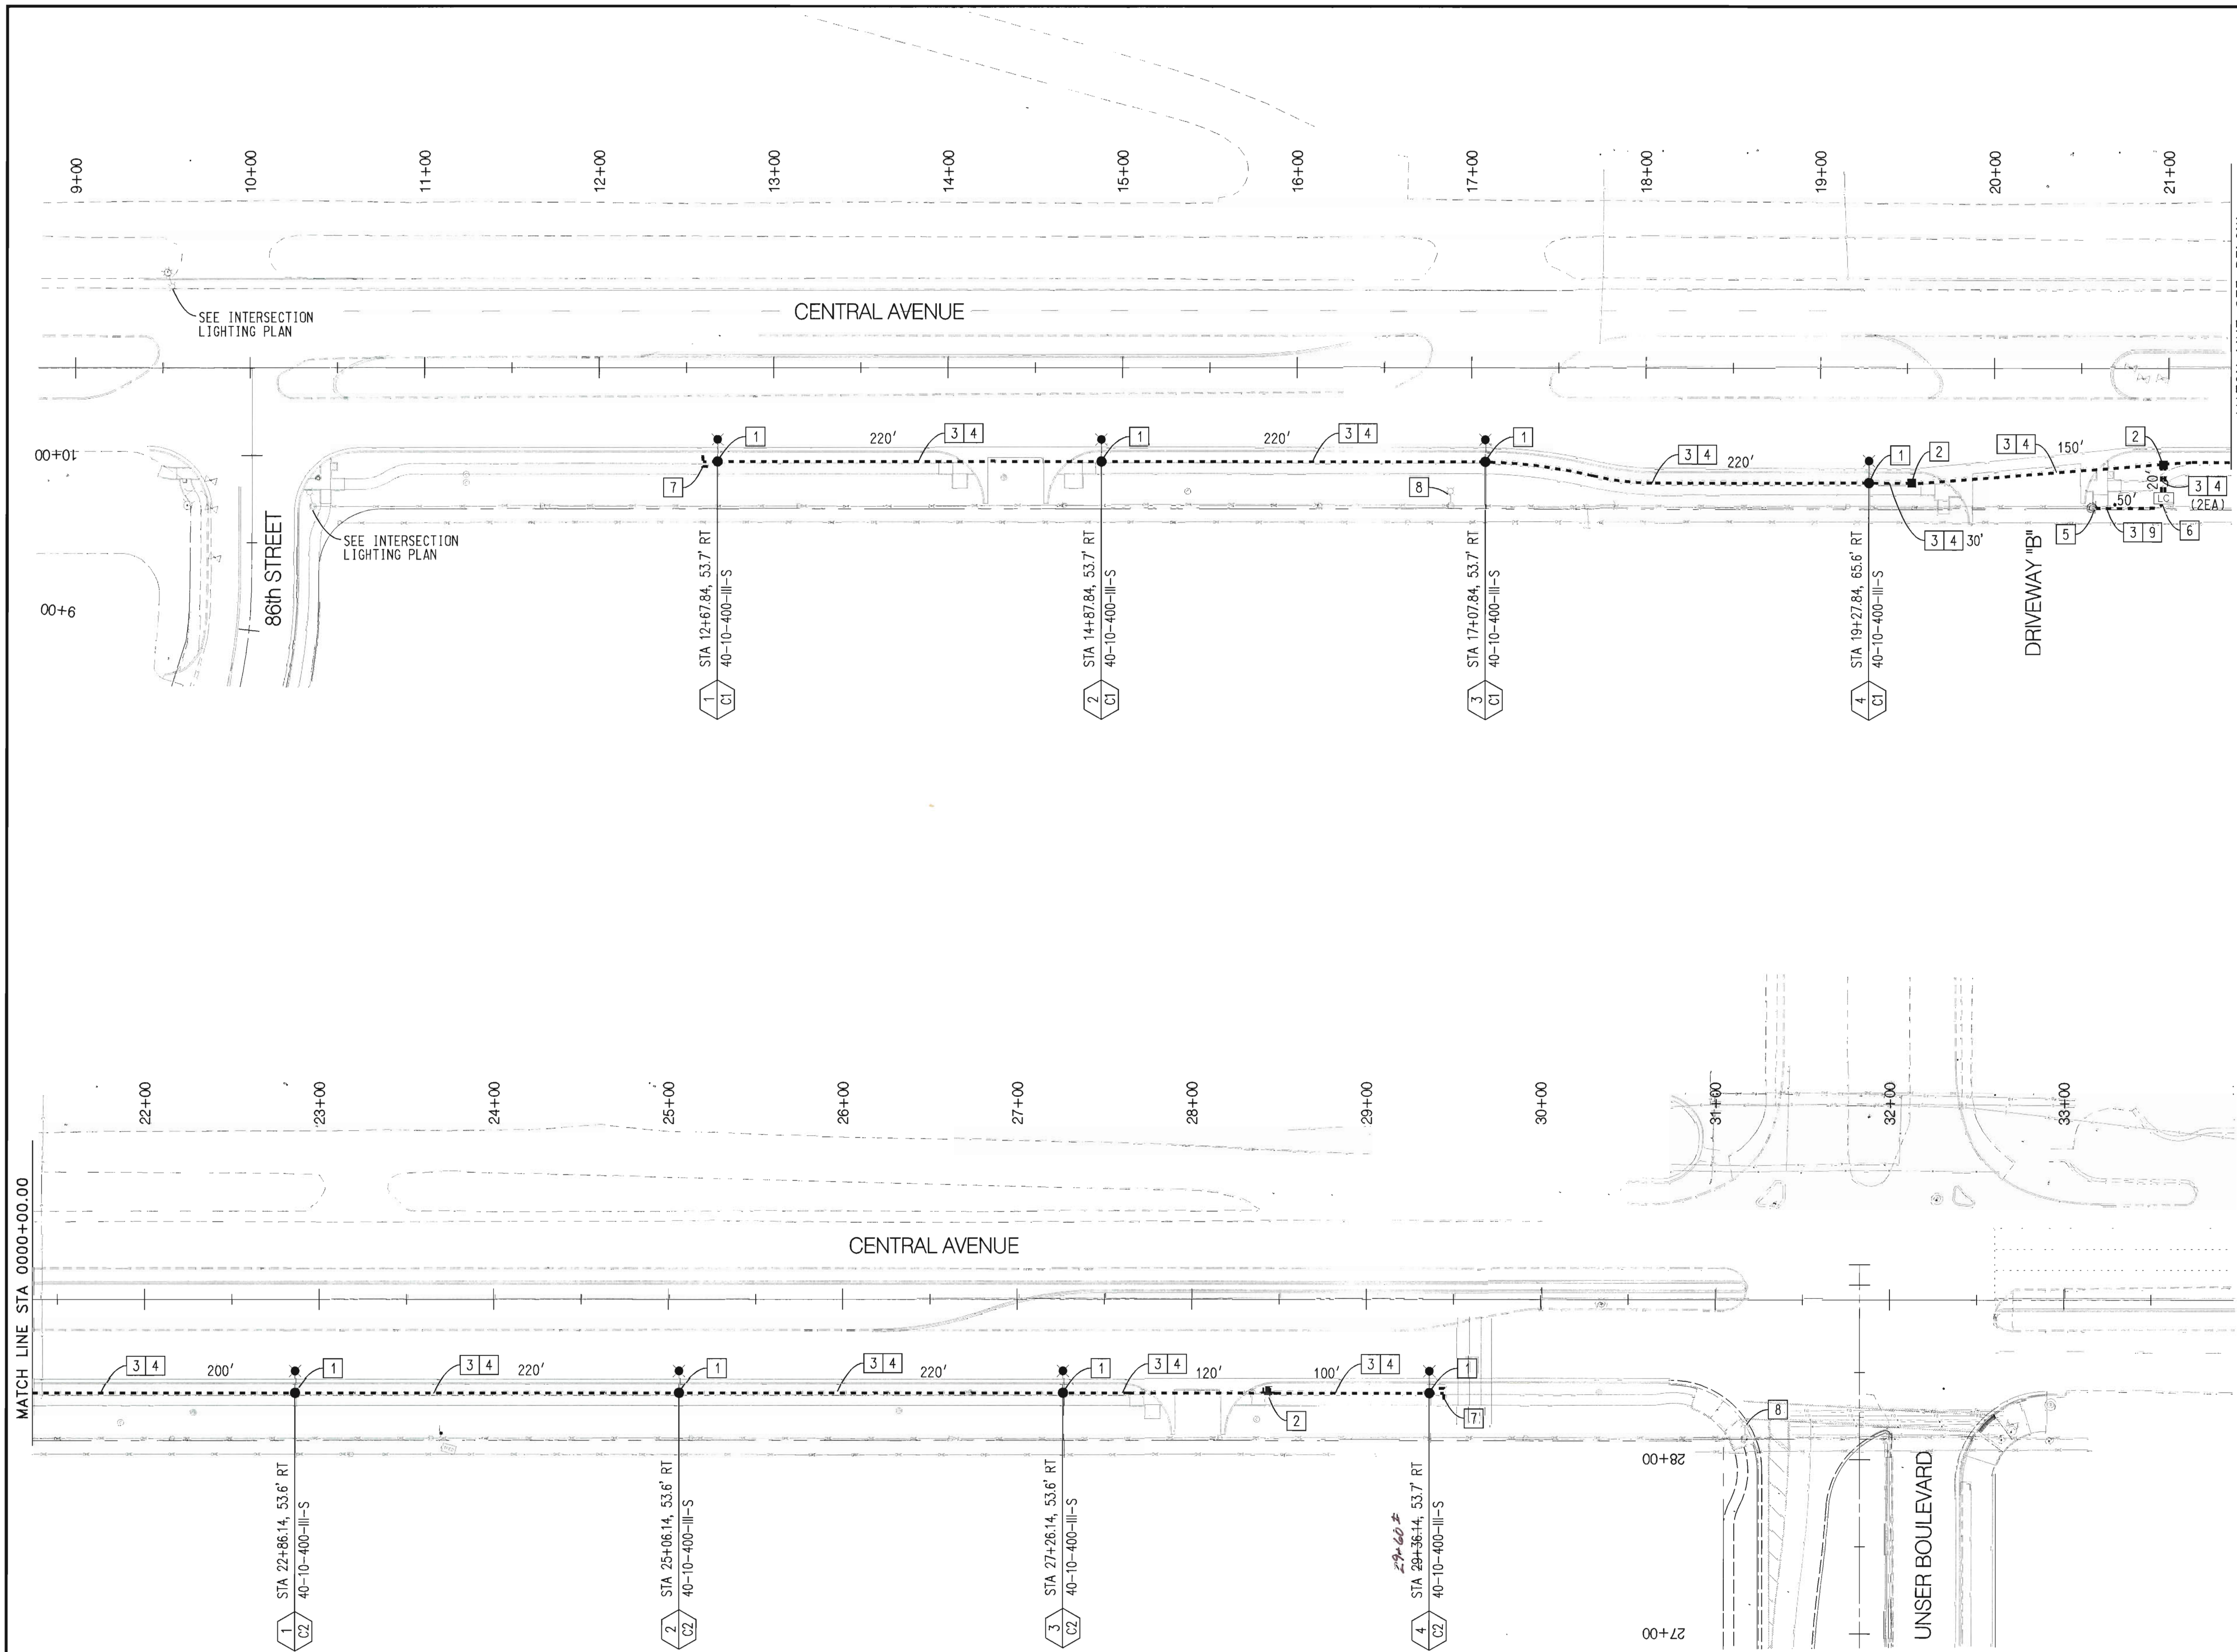

- KEYED NOTES**
1. INSTALL NEW ROADWAY LIGHTING FOUNDATION, 40' LIGHTING TYPE V STANDARD AND TYPE III DISTRIBUTION 400 WATT HPS WITH CUTOFF FIXTURE AND FLAT GLASS PER COA STD DWGS 2580 & 2581
 2. INSTALL NEW ELECTRICAL PULL BOX (STANDARD)
 3. INSTALL NEW RIGID ELECTRICAL CONDUIT, 2"
 4. INSTALL NEW SINGLE CONDUCTOR #2 AWG (2 EACH) AND #6 GROUND
 5. INSTALL LIGHTING SERVICE RISER ON EXISTING POLE
 6. INSTALL NEW LIGHTING CONTROL CABINET, SIX CIRCUIT (UNMETERED)
 7. INSTALL 2" STUBOUT WITH CAP (5')
 8. REMOVE AND SALVAGE EXISTING LUMINAIRE ON EXISTING POWER POLE. COORDINATE THIS WORK WITH PNM
 9. INSTALL NEW SINGLE CONDUCTOR 2/0 (3 EACH, INCIDENTAL TO SERVICE CONNECTION)

NOTES

1. ALL NEW EQUIPMENT INCLUDING PULL BOXES, CONDUIT, SPLICE CABINETS AND MANHOLES SHALL BE LOCATED WITHIN THE RIGHT-OF-WAY, BETWEEN THE SIDEWALK AND CURB WHEREVER POSSIBLE.

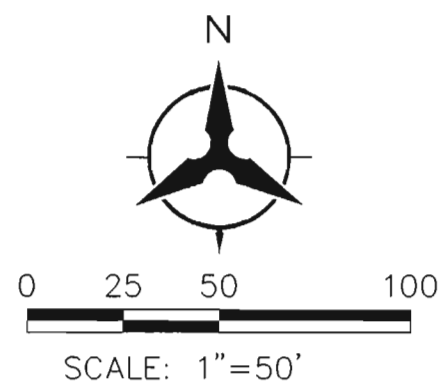

(Base Bid)

Bohannon & Huston
Courttyard I 7500 Jefferson St. NE Albuquerque, NM 87109-4335
ENGINEERING • SPATIAL DATA • ADVANCED TECHNOLOGIES

CITY OF ALBUQUERQUE
DEPARTMENT OF MUNICIPAL DEVELOPMENT
OFFSITE PUBLIC INFRASTRUCTURE - UNSER CROSSING
ROADWAY LIGHTING PLAN - CENTRAL AVE

DESIGN REVIEW COMMITTEE
OCT 30 2008

CITY ENGINEER'S APPROVAL
OCT 31 2008

LAST DESIGN UPDATE

DESIGNED BY LAH / KDT
DATE 08/2008

DRAWN BY LAH
DATE 08/2008

CHECKED BY KDT
DATE 08/2008

CONTRACTOR **Bohannon & Huston** DATE **09/07/08**

INSPECTOR'S SIGNATURE **[Signature]** DATE **10/18/08**

INSPECTION BY **COA** DATE **09/07/08**

VERIFICATION BY **Carlsen Surveys Inc.** DATE **09/07/08**

FIELD CORRECTION BY **Carlsen Surveys Inc.** DATE **09/07/08**

RECORDED BY **[Signature]** DATE **09/07/08**

NO. **1**

AS-BUILT INFORMATION

CONTRACTOR **Bohannon & Huston** DATE **09/07/08**

INSPECTOR'S SIGNATURE **[Signature]** DATE **10/18/08**

INSPECTION BY **COA** DATE **09/07/08**

VERIFICATION BY **Carlsen Surveys Inc.** DATE **09/07/08**

FIELD CORRECTION BY **Carlsen Surveys Inc.** DATE **09/07/08**

RECORDED BY **[Signature]** DATE **09/07/08**

NO. **1**

ENGINEER'S SEAL

NO. DATE

REMARKS

REVISIONS

DESIGN

ZONE MAP NO. **K-9 K-10**


SHEET **29** OF **29**

Shot 1
N 1484081.628
E 1499159.575
Z 5098.895

Shot 2
N 1484063.460
E 1499163.749
Z 5098.461

Shot 3
N 1484094.149
E 1499206.016
Z 5098.508

Shot 4
N 1484076.532
E 1499210.802
Z 5098.177

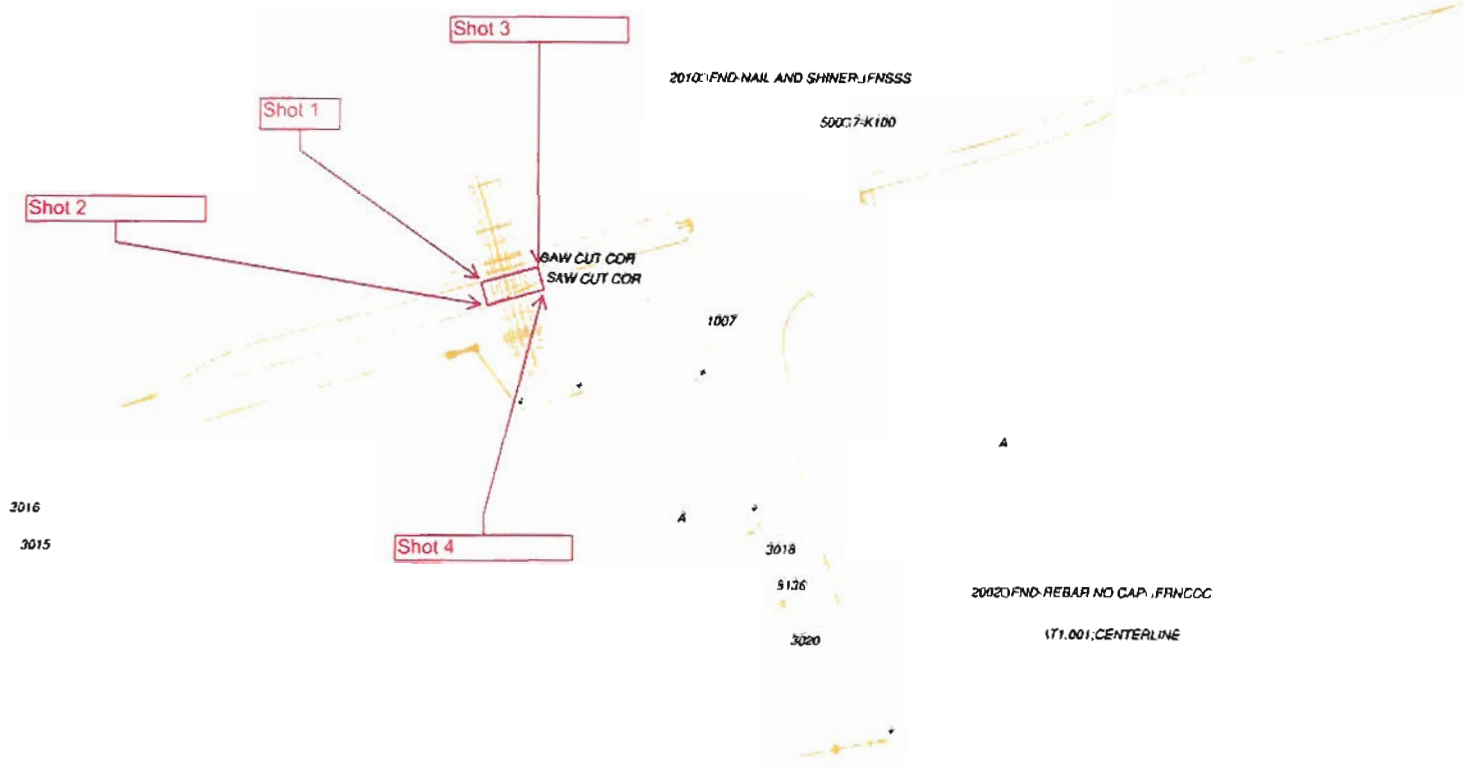

Unser Crossing Spot Shots 11/17/09

