

PUBLIC IMPROVEMENT PLANS
FOR
HERITAGE AT THE TRAILS UNIT 2
ALBUQUERQUE, NEW MEXICO

JULY 2004

PREPARED FOR:
CENTEX HOMES
5120 MASTHEAD NE
ALBUQUERQUE, NM 87109

PREPARED BY:
ISAACSON & ARFMAN, P.A.
128 MONROE ST. NE
ALBUQUERQUE, NM 87108

INDEX TO DRAWINGS

SHEET NO.	TITLE	SHEET NO.	TITLE
1	COVER SHEET		UTILITY PLAN & PROFILE SHEETS
2-3	PLAT	14	MASTER UTILITY PLAN
4-6	GRADING & DRAINAGE PLAN	15	HEARTHSTONE ROAD - STA 10+00.00 TO END
7	PERIMETER WALL PLAN	16	EDISON ROAD - STA 9+50.00 TO END
	PAVING PLAN & PROFILE SHEETS	17	ALLEGIANCE STREET - STA 10+00.00 TO END
8	MASTER PAVING & STORM DRAIN PLAN	18	BATTLE CREEK STREET - STA 10+00.00 TO END
9	PAVING DETAILS	19	OFFSITE UTILITIES - STA 10+00.00 TO END
10	HEARTHSTONE ROAD - STA 10+00.00 TO END		
11	EDISON ROAD - STA 10+00.00 TO END		
12	ALLEGIANCE STREET - STA 10+00.00 TO END		
13	BATTLE CREEK STREET - STA 10+00.00 TO END		

SURVEYORS CERTIFICATION

I, Russ P. Hugg, New Mexico Professional Surveyor Number 9750, Hereby Certify that the as-built information shown hereon is the result of an actual field survey performed by me or under my direct supervision and that the same is true and correct to the best of my knowledge and belief.

Russ P. Hugg
NMPS No. 9750
July 16, 2005



RECORD DRAWINGS

I, Patrick J. Conley of the firm of Smith Engineering Company, A Registered Professional Engineer in the State of New Mexico, do hereby certify, to the best of my knowledge and belief, that the infrastructure installed as part of this project has been inspected by a qualified person under my direct supervision and has been constructed in general accordance with the plans and specifications, while someone from Smith Engineering Company was onsite, approved by the City Engineer and that the original design intent of the approved plans has been met, except as noted by me on the as-built construction drawings. The Certification is based on site inspections by me or personnel under my direction, and as-built survey information provided by Russ Hugg (Surveyor Name) NMPS number 9750 (PS#).



C-9-Z VICINITY MAP 1"=750'±


GENERAL NOTES

- ALL WORK DETAILED ON THESE PLANS TO BE PERFORMED UNDER CONTRACT SHALL, EXCEPT AS OTHERWISE STATED OR PROVIDED FOR HEREON, BE CONSTRUCTED IN ACCORDANCE WITH THE CITY OF ALBUQUERQUE STANDARD SPECIFICATIONS FOR PUBLIC WORKS CONSTRUCTION 1986 EDITION AS AMENDED WITH UPDATE NO. 7.
- ALL WORK ON THIS PROJECT SHALL BE PERFORMED IN ACCORDANCE WITH APPLICABLE FEDERAL, STATE, AND LOCAL LAWS, RULES, AND REGULATIONS CONCERNING CONSTRUCTION SAFETY AND HEALTH.
- PRIOR TO CONSTRUCTION, THE CONTRACTOR SHALL EXCAVATE & VERIFY THE HORIZONTAL AND VERTICAL LOCATIONS OF ALL OBSTRUCTIONS. SHOULD A CONFLICT EXIST, THE CONTRACTOR SHALL NOTIFY THE ENGINEER SO THAT THE CONFLICT CAN BE RESOLVED WITH MINIMUM DELAY.
- TWO (2) WORKING DAYS PRIOR TO ANY EXCAVATION, CONTRACTOR MUST CONTACT LINE LOCATING SERVICE, NM ONE CALL SYSTEMS, INC. @ 260-1990 FOR LOCATION OF EXISTING UTILITIES.
- CONTRACTOR SHALL CONDUCT HIS OPERATIONS IN A MANNER WHICH WILL MINIMIZE INTERFERENCE WITH LOCAL TRAFFIC. CONTRACTOR SHALL COMPLY WITH ALL APPLICABLE LAWS, ORDINANCES, RULES, REGULATIONS, AND ORDERS OF ANY PUBLIC BODY HAVING JURISDICTION FOR THE SAFETY OF PERSONS OR PROPERTY, AND TO PROTECT THEM FROM DAMAGE, INJURY, OR LOSS. CONTRACTOR SHALL ERECT AND MAINTAIN AS REQUIRED BY THE CONDITIONS AND PROGRESS OF THE WORK, ALL NECESSARY SAFEGUARDS FOR SAFETY CONTINUOUSLY AND NOT LIMITED TO NORMAL WORKING HOURS, THROUGHOUT THE DURATION OF THE PROJECT. CONTRACTOR SHALL ADHERE TO SECTION 19 OF THE GENERAL CONDITIONS OF THE CITY OF ALBUQUERQUE STANDARD SPECIFICATIONS FOR PUBLIC WORKS CONSTRUCTION, 1986, AS AMENDED WITH UPDATE NO. 7.
- THE CONTRACTOR AGREES THAT HE SHALL ASSUME THE SOLE AND COMPLETE RESPONSIBILITY FOR THE JOB SITE CONDITIONS DURING THE COURSE OF CONSTRUCTION OF THIS PROJECT, INCLUDING SAFETY OF ALL PERSONS AND PROPERTY; THAT THIS REQUIREMENT SHALL APPLY CONTINUOUSLY AND NOT BE LIMITED TO NORMAL WORKING HOURS; AND THAT THE CONTRACTOR SHALL DEFEND, INDEMNIFY, AND HOLD HARMLESS THE OWNER & ENGINEER FROM ANY AND ALL LIABILITY REAL OR ALLEGED, IN CONNECTION WITH THE PERFORMANCE OF WORK ON THIS PROJECT, EXCEPTING LIABILITY ARISING FROM THE SOLE NEGLIGENCE OF THE OWNER OR ENGINEER.
- TRAFFIC CONTROL: FIVE (5) WORKING DAYS PRIOR TO BEGINNING CONSTRUCTION THE CONTRACTOR SHALL SUBMIT TO THE CONSTRUCTION COORDINATION DIVISION A DETAILED CONSTRUCTION SCHEDULE. TWO (2) WORKING DAYS PRIOR TO CONSTRUCTION, THE CONTRACTOR SHALL OBTAIN A BARRICADING PERMIT FROM THE CONSTRUCTION COORDINATION DIVISION. CONTRACTOR SHALL NOTIFY BARRICADE ENGINEER (924-3400) PRIOR TO OCCUPYING AN INTERSECTION. SEE SECTION 19 OF THE SPECIFICATIONS. ALL STREET STRIPING ALTERED OR DESTROYED SHALL BE REPLACED WITH PLASTIC REFLECTORIZED PAVEMENT MARKINGS BY CONTRACTOR TO LOCATION AS EXISTING OR AS SHOWN IN THIS PLAN SET.
- WHEN ABUTTING EXISTING PAVEMENT TO NEW, SAWCUT EXISTING PAVEMENT TO A STRAIGHT EDGE AND AT A RIGHT ANGLE, OR AS APPROVED BY THE FIELD ENGINEER. REMOVAL OF BROKEN OR CRACKED PAVEMENT WILL ALSO BE REQUIRED.
- EXISTING CURB AND GUTTER NOT TO BE REMOVED UNDER THE CONTRACT WHICH IS DAMAGED OR DISPLACED BY THE CONTRACTOR SHALL BE REMOVED AND REPLACED BY THE CONTRACTOR AT HIS EXPENSE.
- ALL FINAL BACKFILL FOR TRENCHES SHALL BE COMPACTED TO A MINIMUM 90% MAXIMUM DENSITY PER ASTM D-1557 AND AS DIRECTED BY SECTION 701.14.2 AND STANDARD DRAWING NUMBER 2315.
- THE CONTRACTOR SHALL PROMPTLY CLEAN UP ANY MATERIAL EXCAVATED WITHIN THE PUBLIC RIGHT-OF-WAY OR PRIVATE ROADWAY EASEMENTS SO THAT THE EXCAVATED MATERIAL IS NOT SUSCEPTIBLE TO BEING WASHED DOWN THE STREET OR INTO ANY PUBLIC DRAINAGE FACILITY.
- PROPOSED WATERLINE MATERIALS SHALL BE EITHER PVC PIPE MEETING AWWA C900 REQUIREMENTS (6"-12") OR DUCTILE IRON PIPE, THICKNESS CLASS 50 (6"-16").
- FOR STORM DRAIN CONSTRUCTION, RCP PIPE JOINTS SHALL NOT BE GROUDED PRIOR TO FINAL INSPECTION. FINAL INSPECTION WILL DETERMINE JOINTS TO BE GROUDED FOR FINAL ACCEPTANCE OF THE CONSTRUCTION.
- ALL FITTINGS ON WATERLINES SHALL HAVE RESTRAINED JOINTS AS NOTED ON THE PLANS.
- CONTRACTOR SHALL SUPPORT ALL EXISTING, UNDERGROUND UTILITY LINES WHICH BECOME EXPOSED DURING CONSTRUCTION. PAYMENT FOR SUPPORTING WORK SHALL BE INCIDENTAL TO WATER-LINE AND/OR SEWERLINE COSTS.
- CONTRACTOR SHALL ASSIST THE ENGINEER/INSPECTOR IN THE RECORDING OF DATA ON ALL UTILITY LINES AND ACCESSORIES AS REQUIRED BY THE CITY OF ALBUQUERQUE AND NEW MEXICO UTILITIES, INC. FOR THE PREPARATION OF RECORD DRAWINGS. CONTRACTOR SHALL NOT COVER UTILITY LINES AND ACCESSORIES UNTIL ALL DATA HAS BEEN RECORDED.
- THE CONTRACTOR SHALL NOTIFY THE ENGINEER NOT LESS THAN SEVEN (7) DAYS PRIOR TO STARTING WORK IN ORDER THAT THE ENGINEER MAY TAKE NECESSARY MEASURES TO INSURE THE PRESERVATION OF SURVEY MONUMENTS. CONTRACTOR SHALL NOT DISTURB PERMANENT SURVEY MONUMENTS WITHOUT THE CONSENT OF THE ENGINEER AND SHALL NOTIFY THE ENGINEER AND BEAR THE EXPENSE OF REPLACING ANY THAT MAY BE DISTURBED WITHOUT PERMISSION. REPLACEMENT SHALL BE DONE ONLY BY THE CITY SURVEYOR. WHEN A CHANGE IS MADE IN THE FINISHED ELEVATIONS OF THE PAVEMENT OF ANY ROADWAY IN WHICH A PERMANENT SURVEY MONUMENT IS LOCATED, CONTRACTOR SHALL, AT HIS OWN EXPENSE, ADJUST THE MONUMENT COVER TO THE NEW GRADE UNLESS OTHERWISE SPECIFIED. REFER TO SECTION 4.4 OF THE GENERAL CONDITIONS OF THE STANDARD SPECIFICATIONS.
- PNM WILL PROVIDE AT NO COST TO THE CITY OR THE CONTRACTOR THE REQUIRED PERSONNEL FOR INSPECTION OR OBSERVATION DEEMED NECESSARY BY PNM WHILE THE CONTRACTOR IS EXPOSING PNM'S CABLES. HOWEVER, THE CONTRACTOR SHALL BE CHARGED THE TOTAL COST ASSOCIATED WITH REPAIRS TO ANY DAMAGED CABLES OR FOR ANY COST ASSOCIATED WITH SUPPORTING OR RELOCATING THE POLES AND CABLES DURING CONSTRUCTION.
- WARNING--EXISTING UTILITY LINE LOCATIONS ARE SHOWN IN AN APPROXIMATE MANNER ONLY, AND SUCH LINES MAY EXIST WHERE NONE ARE SHOWN. THE LOCATION OF ANY SUCH EXISTING LINES IS BASED UPON INFORMATION PROVIDED BY THE UTILITY COMPANY, THE OWNER, OR BY OTHERS, AND THE INFORMATION MAY BE INCOMPLETE OR MAY BE OBSOLETE BY THE TIME CONSTRUCTION COMMENCES. THE ENGINEER HAS UNDERTAKEN NO FIELD VERIFICATION OF THE LOCATION, DEPTH, SIZE, OR TYPE OF EXISTING UNDERGROUND UTILITY LINES, MAKES NO REPRESENTATION PERTAINING THERETO, AND ASSUMES NO RESPONSIBILITY OR LIABILITY THEREFOR. THE CONTRACTOR SHALL INFORM ITSELF OF THE LOCATION OF ANY UTILITY LINE IN OR NEAR THE AREA OF THE WORK IN ADVANCE OF AND DURING EXCAVATION WORK. THE CONTRACTOR IS FULLY RESPONSIBLE FOR ANY AND ALL DAMAGE CAUSED BY ITS FAILURE TO LOCATE, IDENTIFY, AND PRESERVE ANY AND ALL EXISTING UTILITIES. THE CONTRACTOR SHALL COMPLY WITH STATE STATUTES, MUNICIPAL AND LOCAL ORDINANCES, RULES AND REGULATIONS PERTAINING TO THE LOCATION OF THESE LINES AND FACILITIES, IN PLANNING AND CONDUCTING EXCAVATION, WHETHER BY CALLING OR NOTIFYING THE UTILITIES, COMPLYING WITH "BLUE STAKES" PROCEDURES, OR OTHERWISE.
- ANY WORK OCCURRING WITHIN A FULLY DEVELOPED ARTERIAL ROADWAY REQUIRES 24 HR. CONSTRUCTION.
- ALL EXCAVATION, TRENCHING AND SHORING ACTIVITIES MUST BE ACCOMPLISHED IN ACCORDANCE WITH OSHA 29CFR 1926.650 SUBPART P.
- CONTRACTOR SHALL MAINTAIN A GRAFFITI-FREE WORK SITE. CONTRACTOR SHALL PROMPTLY REMOVE ANY AND ALL GRAFFITI FROM EQUIPMENT, WHETHER PERMANENT OR TEMPORARY.
- ALL UTILITY WORK SHALL BE CONSTRUCTED IN ACCORDANCE WITH NEW MEXICO UTILITIES, INC. SPECIFICATIONS FOR WATER AND WASTEWATER FACILITIES (MOST RECENT REVISIONS).
- THE CONTRACTOR SHALL NOTIFY NEW MEXICO UTILITIES, (898-2661) THREE WORKING DAYS PRIOR TO BEGINNING THE CONSTRUCTION OF THE UTILITIES.



DRB NO. 1003353
ISAACSON & ARFMAN, P.A.
Consulting Engineering Associates
128 Monroe Street N.E.
Albuquerque New Mexico
13248-CVR.DWG 07/15/04

REV.	SHEETS	CITY ENGINEER	DATE	USER	DEPARTMENT	DATE	USER	DEPARTMENT	DATE
ENGINEERS STAMP & SIGNATURE		APPROVALS		ENGINEER		DATE		*****	
		DRC Chairman		[Signature]		9-23-04		APPROVED FOR CONSTRUCTION [Signature] 10-05-04 City Engineer Date	
		Transportation		[Signature]		9-30-04			
		Water/Wastewater		[Signature]		7-29-04			
		Hydrology		[Signature]		7-29-04			
		NMUI		[Signature]		7-29-04			
Constr. Mngmt.		[Signature]		9-23-04					
Constr. Coord.		[Signature]		9-23-04					
City Project No.		738482		Sheet		1		Of 19	

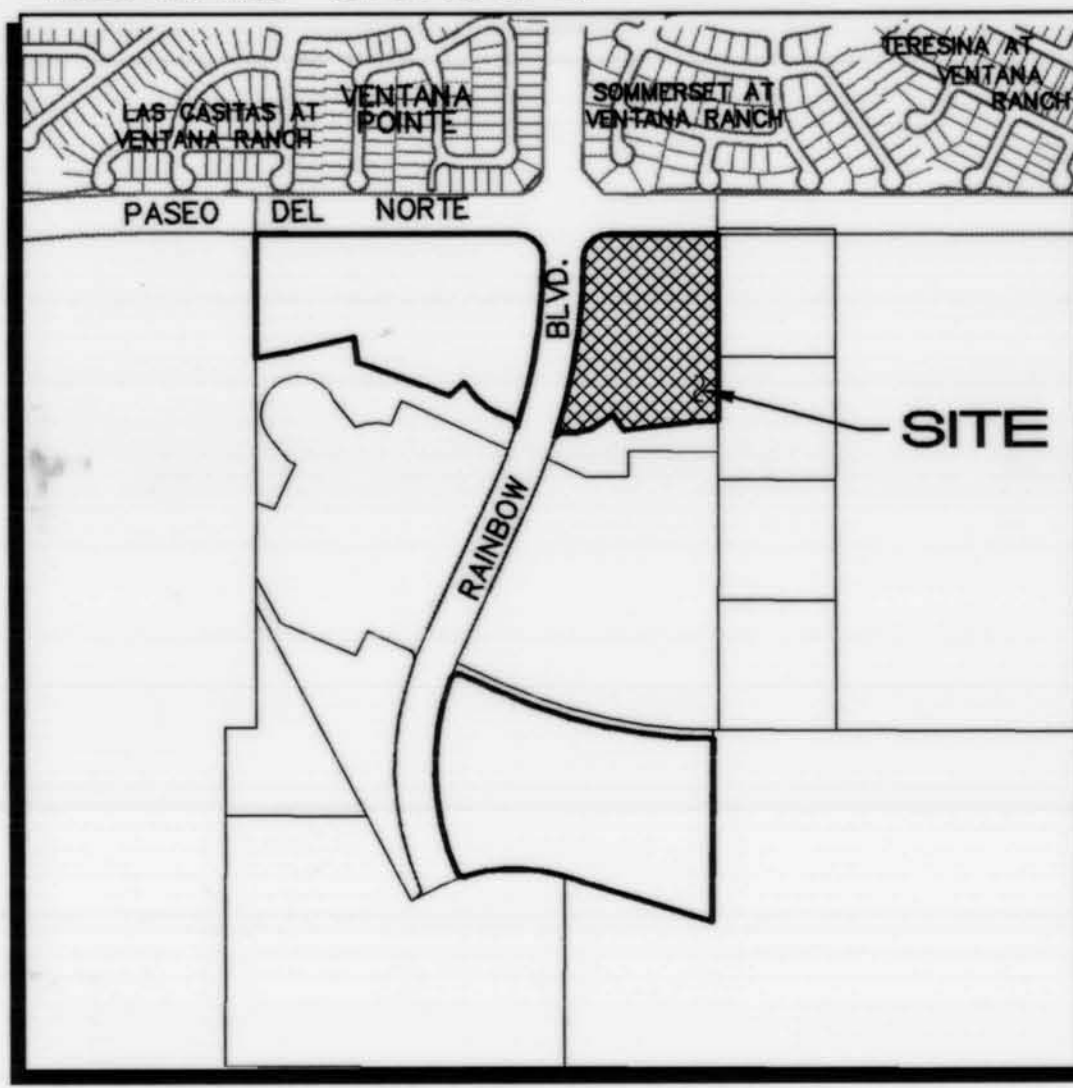

C-9-Z

VICINITY MAP

1"=750'±

SUBDIVISION DATA / NOTES

- Total Number of Existing Tracts: 1
- Total Number of Lots created: 50
- Total Number of Tracts created: 3
- Gross Subdivision Acreage: 9.4494 Ac.
- Total Mileage of Full Width Streets Created: 0.59
- Bearings are New Mexico State Plane Grid Bearings (Central Zone).
- Distances are ground distances.
- Bearings and distances in parenthesis are record.
- Basis of boundary are the following plots (and documents) of record entitled: PLAT OF "THE TRAILS" (12-15-03, 03C-375)
- Field Survey performed on March, 2003.
- Title Report: None provided.
- This property is apparently affected by reservations, restrictions and agreements contained within easements, documents and memorandums as listed within the above mentioned Title Report.
- Basis of boundary is from the plots of record entitled:
UNPLATTED LAND OF "VOLCANO SIX LIMITED"
TRACT OS-1 OPEN SPACE
TRACT OS-2 OPEN SPACE
UNPLATTED LAND OF "THE ARCHDIOCESE OF SANTA FE"
UNPLATTED LAND OF "PARADISE WEST INC."
PLAT OF "THE TRAILS, TRACT D"
(12-15-03, 03C-375)
PLAT OF "THE TRAILS, TRACT J"
(12-15-03, 03C-375)
PLAT OF "THE TRAILS, TRACT G"
(12-15-03, 03C-375)
all being records of Bernalillo County, New Mexico.
- Current Zoning: R-D.
- These properties are within the New Mexico Utilities, Inc. (NMU, Inc.) franchise area, water and sanitary sewer system capabilities are based on the NMU, Inc. facilities, not the City of Albuquerque.
- Centerline (in lieu of R/W) monumentation to be installed at all centerline PC's, PT's, angle points and street intersections prior to acceptance of subdivision street improvements and will consist of a standard four-inch (4") aluminum alloy cap stamped "City of Albuquerque", "Centerline Monumentation", "Survey Marker", "Do Not Disturb", "PLS #7719".
- All property corners to be set with 5/8" rebar with cap "ALS LS 7719".

ALDRICH LAND SURVEYING
P.O. BOX 30701, ALBQ., N.M. 87190
505-884-1990

1324BPT1.DWG 07/26/04

LEGAL DESCRIPTION

A tract of land situate within the Town of Alameda Grant, projected Section 16, Township 11 North, Range 2 East, New Mexico Principal Meridian, City of Albuquerque, Bernalillo County, New Mexico being all of TRACT B, THE TRAILS as the same is shown and designated on said plat filed for record in the office of the County Clerk of Bernalillo County, New Mexico on December 15, 2003 in Book 2003C, Page 375 and containing 9.4494 acres more or less.

DISCLOSURE STATEMENT

The intent of this plat is to subdivide the subject tract into residential lots, to create 3 tracts, to dedicate public rights-of-way, to grant those easements necessary to serve the residential development, and to vacate easements.

FREE CONSENT AND DEDICATION

The subdivision shown hereon is with the free consent and in accordance with the desires of the undersigned Owner(s) and/or Proprietor(s) thereof and said Owner(s) and/or Proprietor(s) do hereby dedicate all streets and public rights-of-way shown hereon to the City of Albuquerque in fee simple with warranty covenants and do hereby grant: all access, utility and drainage easements shown hereon including the right to construct, operate, inspect, and maintain facilities therein, and all public utility easements shown hereon for the common and joint use of gas, electrical power and communication services for overhead and/or buried distribution lines, conduits, and pipes for underground and/or overhead utilities where shown or indicated, and including the right of ingress and egress for construction and maintenance, and the right to trim interfering trees and shrubs. Said Owner(s) and/or Proprietor(s) do hereby consent to all of the foregoing and do hereby certify that this subdivision is their free act and deed.

OWNER

HERITAGE AT THE TRAILS HOMEOWNERS ASSOCIATION

RICHARD T. BRESSAN
PRESIDENT

Date

ACKNOWLEDGMENT

STATE OF NEW MEXICO } SS
COUNTY OF BERNALILLO }

This instrument was acknowledged before me on _____
2004, by Richard T. Bressan as President of Heritage at the Trails Homeowners Association, a New Mexico Non-Profit Corporation, on behalf of said Corporation.

My Commission Expires: _____

Notary Public

OWNER

CENTEX HOMES

NORMAN A. GREGORY
LAND DEVELOPMENT MANAGER

Date

ACKNOWLEDGMENT

STATE OF NEW MEXICO } SS
COUNTY OF BERNALILLO }

This instrument was acknowledged before me on _____
2004, by Norman A. Gregory as Land Development Manager of Centex Homes, a Nevada General Partnership, on behalf of said General Partnership.

My Commission Expires: _____

Notary Public

PLAT FOR HERITAGE AT THE TRAILS SUBDIVISION UNIT 2

BEING A REPLAT OF
TRACT B, THE TRAILS
WITHIN THE TOWN OF ALAMEDA GRANT
PROJECTED SECTION 16,
T. 11 N., R. 2 E., NMPM
CITY OF ALBUQUERQUE,
BERNALILLO COUNTY, NEW MEXICO
AUGUST 2004

APPROVALS

DRB PROJECT NO. 1003353

APPLICATION NO.

Utility Approvals

PNM ELECTRIC SERVICES DIVISION	DATE
PNM GAS SERVICES DIVISION	DATE
QWEST	DATE
COMCAST	DATE
NEW MEXICO UTILITIES	DATE
City Approvals	
CITY SURVEYOR	DATE
REAL PROPERTY DIVISION	DATE
ENVIRONMENTAL HEALTH DEPARTMENT	DATE
TRAFFIC ENGINEERING, TRANSPORTATION DIVISION	DATE
UTILITIES DEVELOPMENT	DATE
PARKS AND RECREATION DEPARTMENT	DATE
AMAFCA	DATE
CITY ENGINEER	DATE
DRB CHAIRPERSON, PLANNING DEPARTMENT	DATE

SURVEYOR'S CERTIFICATION

"I, Timothy Aldrich, a duly qualified Registered Professional Land Surveyor under the laws of the State of New Mexico, do hereby certify that this plat and description were prepared by me or under my supervision, shows all easements as shown on the plot of record or made known to me by the owners and/or proprietors of the subdivision shown hereon, utility companies and other parties expressing an interest and meets the minimum requirements for monumentation and surveys of the Albuquerque Subdivision Ordinance, and further meets the Minimum Standards for Land Surveying in the State of New Mexico (Effective November 1, 1989 and revisions effective December 25, 1991, February 2, 1994 and October 2000), and is true and correct to the best of my knowledge and belief."

Timothy Aldrich, P.S. No. 7719

Date

SHEET 1 OF 3

NOTES:

- SEE SHEET 3 FOR CURVE AND LINE TABLES.
- SEE SHEET 3 FOR EASEMENT NOTES.
- DISTANCES IN BRACKETS ARE MONUMENT DISTANCES.



PLAT FOR HERITAGE AT THE TRAILS SUBDIVISION UNIT 2

BEING A REPLAT OF
TRACT B, THE TRAILS
WITHIN THE TOWN OF ALAMEDA GRANT
PROJECTED SECTION 16,
T. 11 N., R. 2 E., NMPM
CITY OF ALBUQUERQUE,
BERNALILLO COUNTY, NEW MEXICO
AUGUST 2004

LEGEND

- FOUND 5/8" REBAR WITH CAP "LS 5978" (Typ.)
- SET 5/8" REBAR WITH CAP "ALS LS 7719" (TYP.)
- PROPERTY LINE
- ADJOINING PROPERTY LINE
- CENTERLINE MONUMENT

SCALE: 1"=60'

60 40 20 0 60 120 FEET

SHEET 2 OF 3

PLAT FOR
HERITAGE AT THE TRAILS
SUBDIVISION UNIT 2

BEING A REPLAT OF
TRACT B, THE TRAILS
WITHIN THE TOWN OF ALAMEDA GRANT
PROJECTED SECTION 16,
T. 11 N., R. 2 E., NMPM
CITY OF ALBUQUERQUE,
BERNALILLO COUNTY, NEW MEXICO
AUGUST 2004

BOUNDARY CURVE TABLE

CURVE	RADIUS	LENGTH	TANGENT	CHORD	BEARING	DELTA
C1	100.00	156.70	99.62	141.15	S 45°17'41" W	89°46'49"
C2	203.00	155.84	81.99	152.04	N 74°22'22" E	43°59'05"
C3	632.00	5.55	2.78	5.55	S 81°35'59" E	0°30'11"
C4	30.00	42.07	25.33	38.71	S 57°58'08" W	80°21'23"
C5	2328.00	706.41	355.94	703.70	N 09°05'45" E	17°23'09"
C6	100.00	22.49	11.29	22.44	S 83°44'33" W	12°53'06"
C7	25.00	40.43	26.19	36.17	N 43°29'03" W	92°39'31"
C8	100.00	134.21	79.39	124.36	S 38°51'08" W	76°53'44"
C9	2328.00	40.00	20.00	40.00	N 01°01'40" E	0°59'04"
C10	2328.00	55.92	27.96	55.92	N 02°12'30" E	1°22'35"
C11	2328.00	50.09	25.04	50.08	N 03°30'46" E	1°13'58"
C12	2328.00	50.16	25.08	50.16	N 04°44'47" E	1°14'04"
C13	2328.00	55.29	27.65	55.29	N 06°02'39" E	1°21'39"
C14	2328.00	50.39	25.20	50.39	N 07°20'40" E	1°14'25"
C15	2328.00	50.54	25.27	50.54	N 08°35'12" E	1°14'38"
C16	2328.00	50.72	25.36	50.72	N 09°49'58" E	1°14'54"
C17	2328.00	59.40	29.70	59.39	N 11°11'16" E	1°27'43"
C18	2328.00	46.69	23.35	46.69	N 12°29'36" E	1°08'57"
C19	2328.00	62.56	31.28	62.56	N 13°50'16" E	1°32'23"
C20	173.00	2.82	1.41	2.82	S 02°22'40" W	0°56'06"
C21	173.00	44.55	22.40	44.43	S 05°28'00" E	14°45'15"
C22	173.00	26.12	13.08	26.09	S 17°10'08" E	8°39'01"
C23	25.00	37.00	22.83	33.72	N 20°54'23" E	84°48'04"
C24	135.00	57.39	29.14	56.96	N 75°29'12" E	24°21'33"
C25	30.00	55.99	40.50	48.21	S 38°51'47" E	106°56'29"
C26	157.00	79.55	40.65	78.70	S 66°53'47" W	29°01'53"
C27	157.00	5.03	2.51	5.02	S 82°19'45" W	1°50'02"
C28	127.00	9.67	4.84	9.66	S 85°25'36" W	4°21'40"
C29	127.00	5.52	2.76	5.52	S 88°51'12" W	2°29'32"
C30	25.00	38.11	23.87	34.53	S 46°30'57" W	87°20'29"
C31	25.00	39.27	25.00	35.36	N 44°48'48" W	90°00'00"
C32	25.00	36.24	22.14	33.15	N 41°42'59" E	83°03'33"
C33	203.00	41.63	20.89	41.56	S 77°22'15" W	11°45'00"
C34	25.00	39.54	25.27	35.55	S 63°11'43" E	90°37'04"
C35	127.00	45.95	23.23	45.70	S 07°31'14" E	20°43'53"
C36	25.00	39.27	25.00	35.36	S 45°11'12" W	90°00'00"
C37	173.00	20.69	10.36	20.68	S 86°40'22" W	6°51'13"
C38	25.00	42.30	28.23	37.43	S 48°17'01" E	96°56'27"
C39	150.00	89.61	46.19	88.28	S 14°16'07" E	34°13'40"
C40	169.00	134.24	70.89	130.74	N 81°22'23" E	45°30'39"
C41	180.00	77.37	39.29	76.78	S 70°55'55" W	24°37'42"
C42	150.00	17.94	8.98	17.93	S 86°40'22" W	6°51'13"
C43	2328.00	68.58	34.29	68.57	N 15°27'05" E	1°41'16"
C44	2328.00	60.68	30.34	60.68	N 17°02'31" E	1°29'36"
C45	2328.00	5.39	2.69	5.39	N 00°28'09" E	0°07'57"
C46	157.00	84.58	43.34	83.56	S 67°48'48" W	30°51'55"
C47	127.00	15.19	7.60	15.18	S 86°40'22" W	6°51'13"
C48	173.00	73.49	37.31	72.94	S 09°19'28" E	24°20'22"

LOT AREA TABLE

LOT	AREA (SF)
1	9537
2	8885
3	6995
4	6180
5	5899
6	5674
7	6047
8	5379
9	5325
10	5800
11	7126
12	5250
13	5250
14	5250
15	5250
16	5250
17	5250
18	5250
19	5574
20	6170
21	5784
22	5788
23	5266
24	5270
25	5801
26	5278
27	5808
28	5780
29	5359
30	5784
31	5249
32	5249
33	5249
34	8191
35	8408
36	7080
37	6314
38	6198
39	6082
40	6556
41	6416
42	6705
43	6487
44	6057
45	6057
46	5506
47	5506
48	5506
49	7052
50	8448
TRACT A	3596
TRACT B	1600
TRACT C	2284

EASEMENT NOTES

- A. TRACT C SHALL BE COVERED BY A PUBLIC PEDESTRAIN ACCESS EASEMENT TO BE GRANTED TO THE CITY OF ALBUQUERQUE BY THIS PLAT AND MAINTAINED BY THE HOMEOWNERS' ASSOCIATION OF HERITAGE AT THE TRAILS.
- B. TRACT C SHALL BE COVERED BY A PUBLIC DRAINAGE EASEMENT TO BE GRANTED TO THE CITY OF ALBUQUERQUE AND A PUBLIC SANITARY SEWER EASEMENT TO BE GRANTED TO THE CITY OF ALBUQUERQUE AND NEW MEXICO UTILITIES, INC. BY THIS PLAT.
- C. 10' WIDE PUBLIC UTILITY EASEMENT (P.U.E.) TO BE GRANTED BY THIS PLAT.
- D. TRACT A SHALL BE COVERED BY A PRIVATE LANDSCAPING EASEMENT AND SHALL BE GRANTED BY THIS PLAT TO AND MAINTAINED BY THE TRAILS COMMUNITY ASSOCIATION.
- E. TRACT B & C SHALL BE COVERED BY A PRIVATE LANDSCAPING EASEMENT AND SHALL BE GRANTED TO AND MAINTAINED BY THE HOMEOWNERS' ASSOCIATION OF HERITAGE AT THE TRAILS BY THIS PLAT.
- F. EXISTING BLANKET PUBLIC ACCESS, DRAINAGE, WATER, AND SANITARY SEWER EASEMENT (12-15-03, BK. 2003C, PG. 375) VACATED BY THIS PLAT (APPL. #)

OWNER

TRAILS COMMUNITY ASSOCIATION, INC

TRACY MURPHY
PRESIDENT

Date

ACKNOWLEDGMENT


STATE OF NEW MEXICO }
COUNTY OF BERNALILLO } SS

This instrument was acknowledged before me on _____, 2004, by Tracy Murphy as President of Trails Community Association, INC., a New Mexico Non-Profit Corporation, on behalf of said Corporation.

My Commission Expires: _____

Notary Public



LINE TABLE		
LINE	BEARING	DISTANCE
L1	S 52°22'50" W	48.21
L2	N 89°48'48" W	57.00
L3	N 08°50'35" W	99.46
L4	N 00°11'12" E	40.00
L5	N 52°23'36" E	33.41
L6	S 86°05'49" W	19.72
L7	N 02°50'43" E	9.98
L8	S 83°14'46" W	1.56
L9	S 31°22'56" E	18.46
L10	S 89°54'01" E	55.47
L11	N 75°52'18" W	1.83
L12	N 89°48'48" W	30.20
L13	S 89°48'48" E	23.10

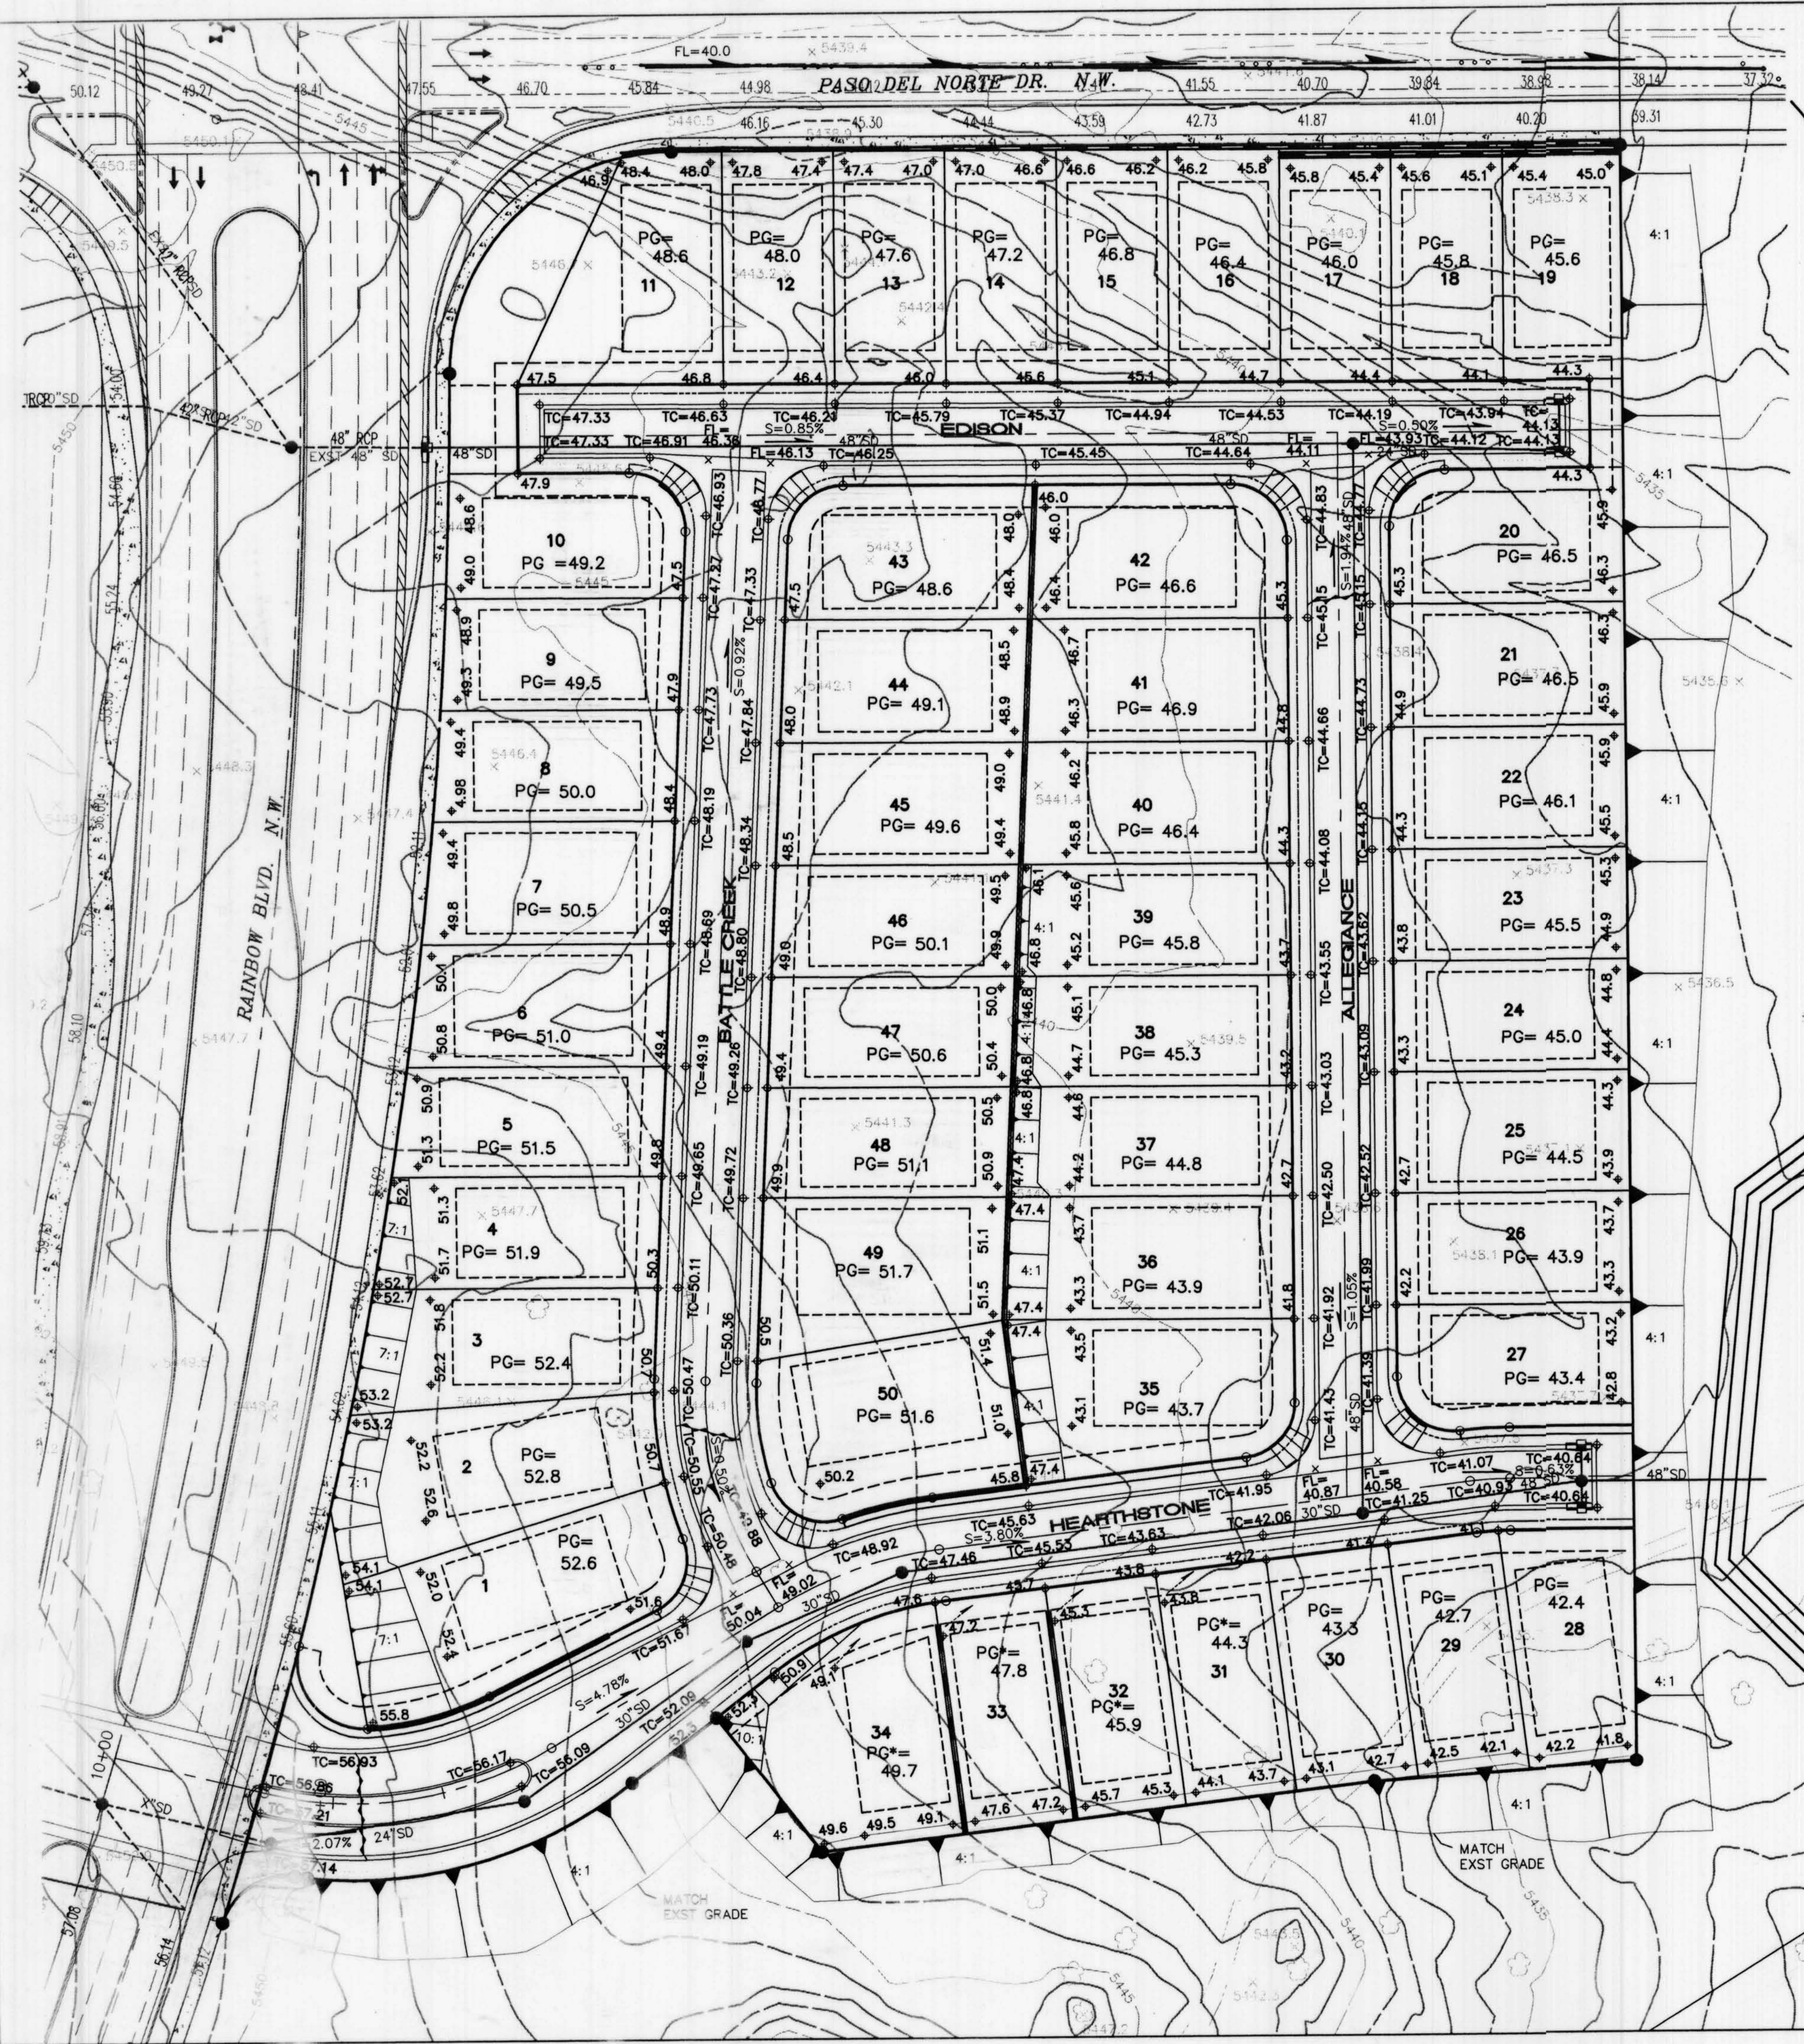

SCALE: 1"=40'

LEGEND

- 5200 — EXISTING CONTOUR
- ◆ 78.3 PROPOSED SPOT ELEVATION
- FLOW ARROW
- PG=6881.0 PAD GRADE ELEVATION
- TC=81.95 TOP OF CURB ELEVATION
- FL=81.45 FLOWLINE ELEVATION
- ~~~~~ WATER BAR
- PROPOSED RETAINING WALL
- STORM DRAIN MANHOLE
- PG*= SEE DETAIL XX ON SHEET 3
- 4:1 PROPOSED SLOPE

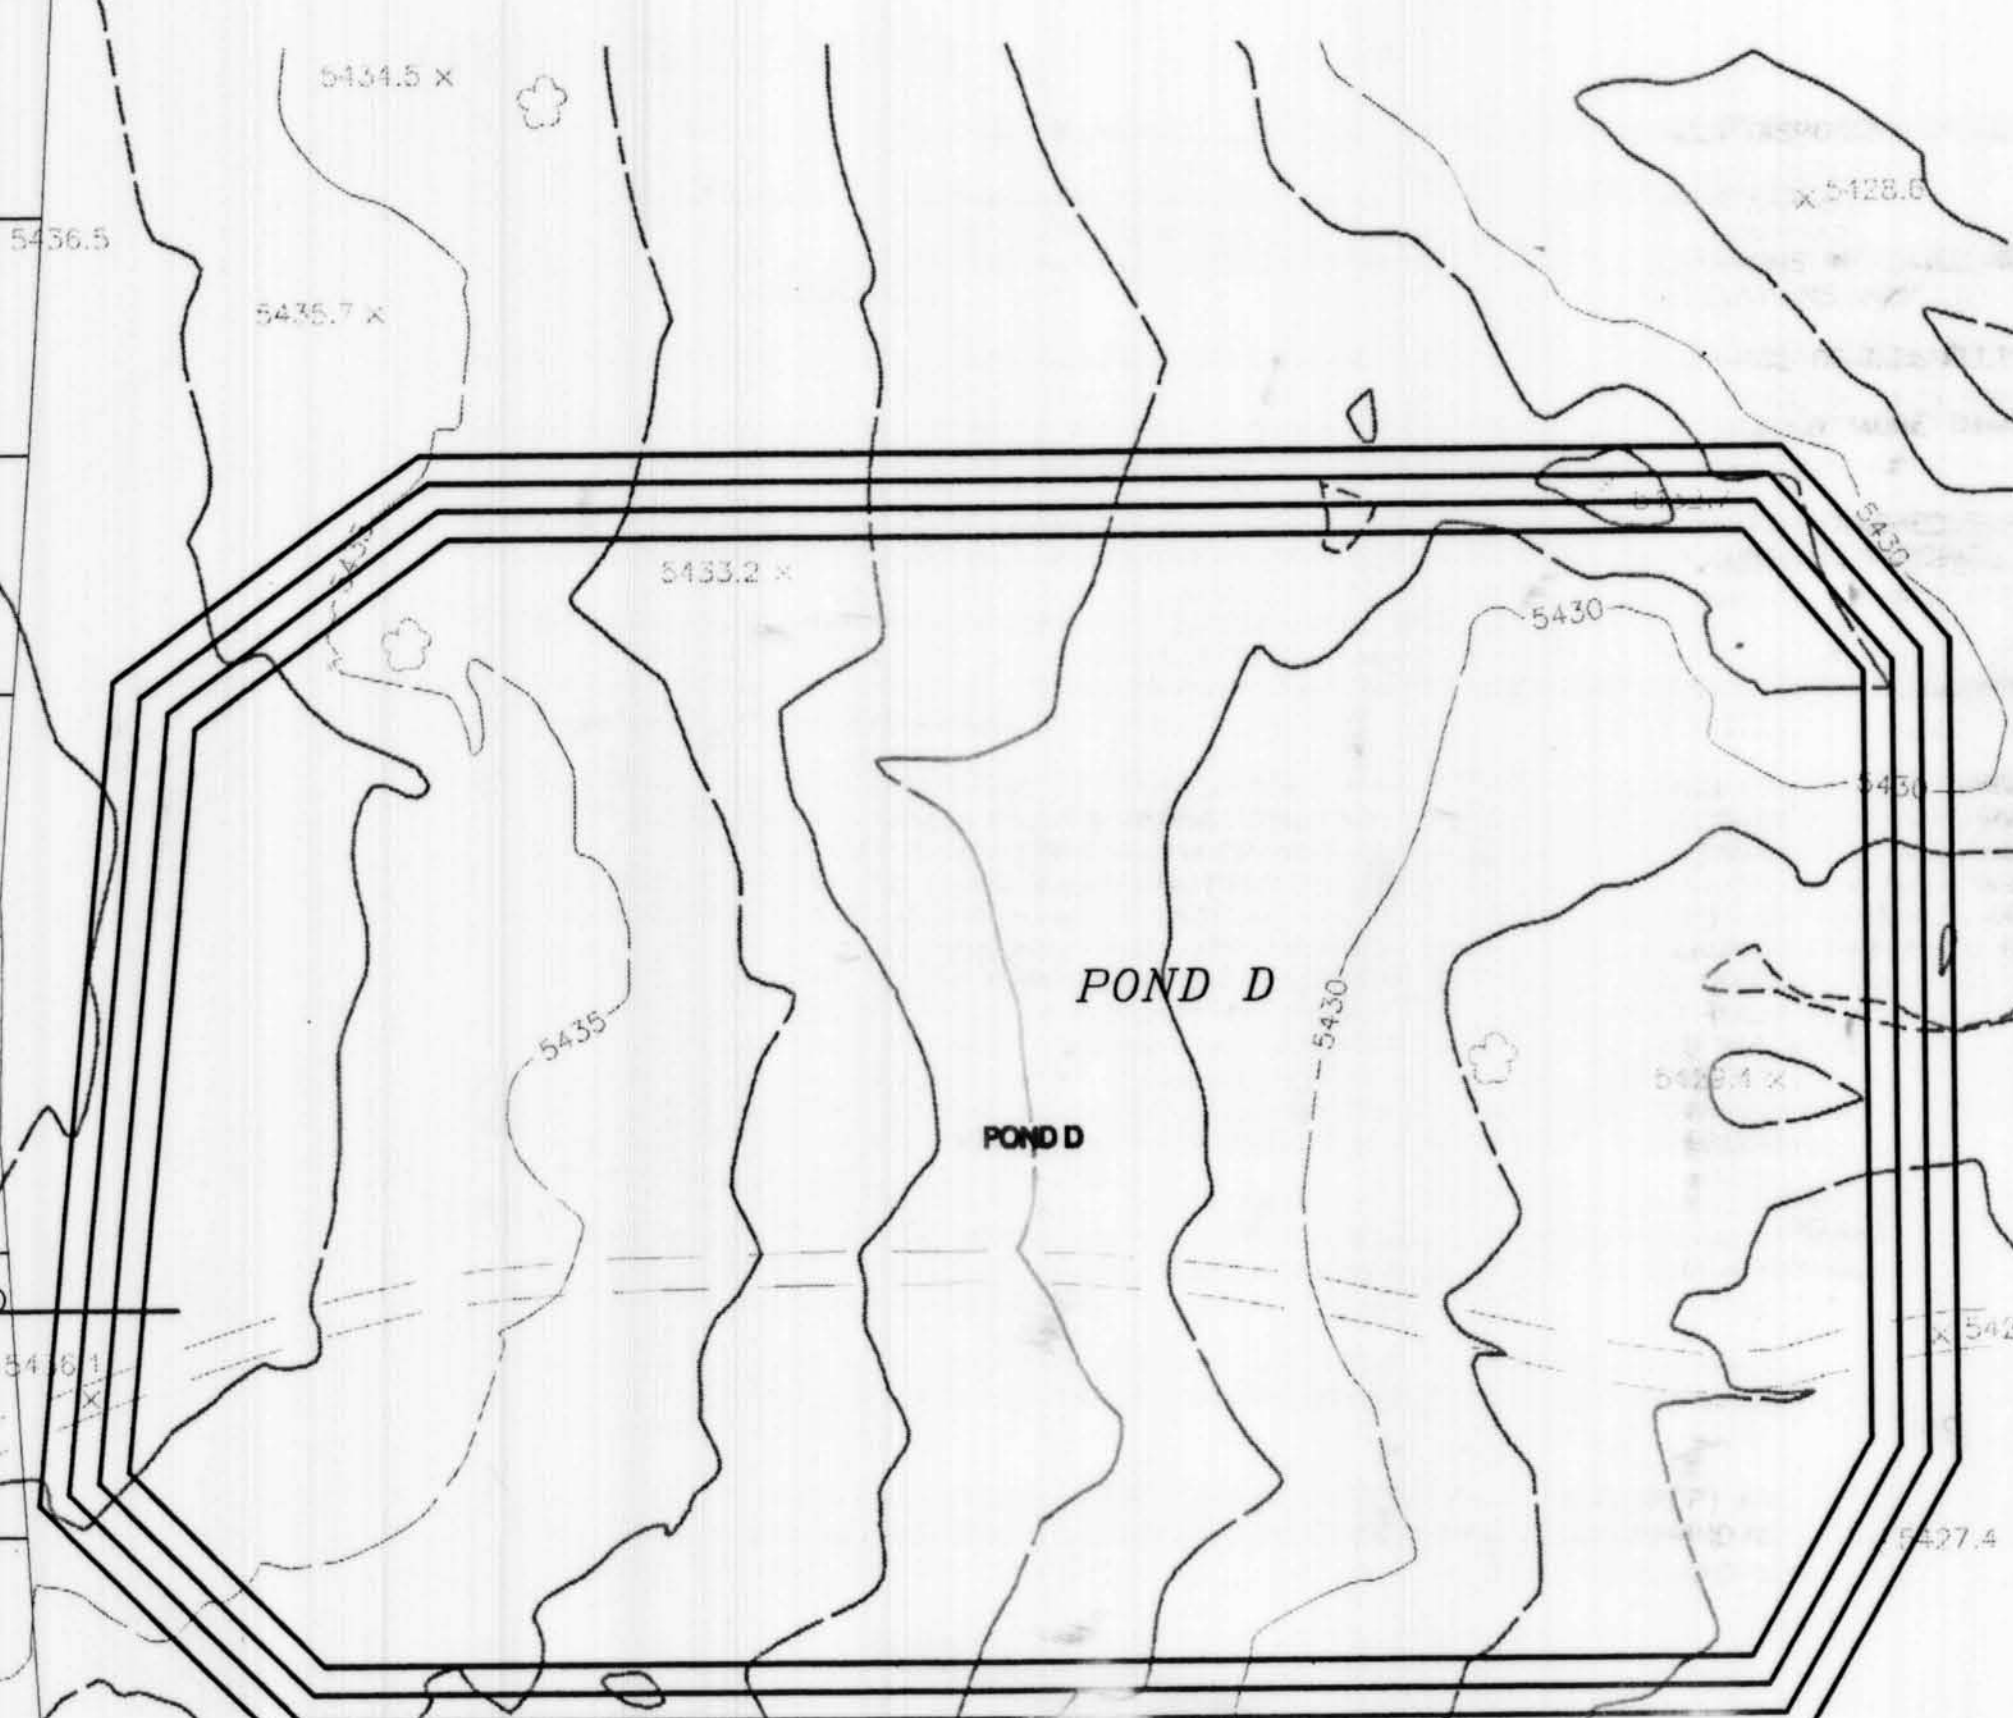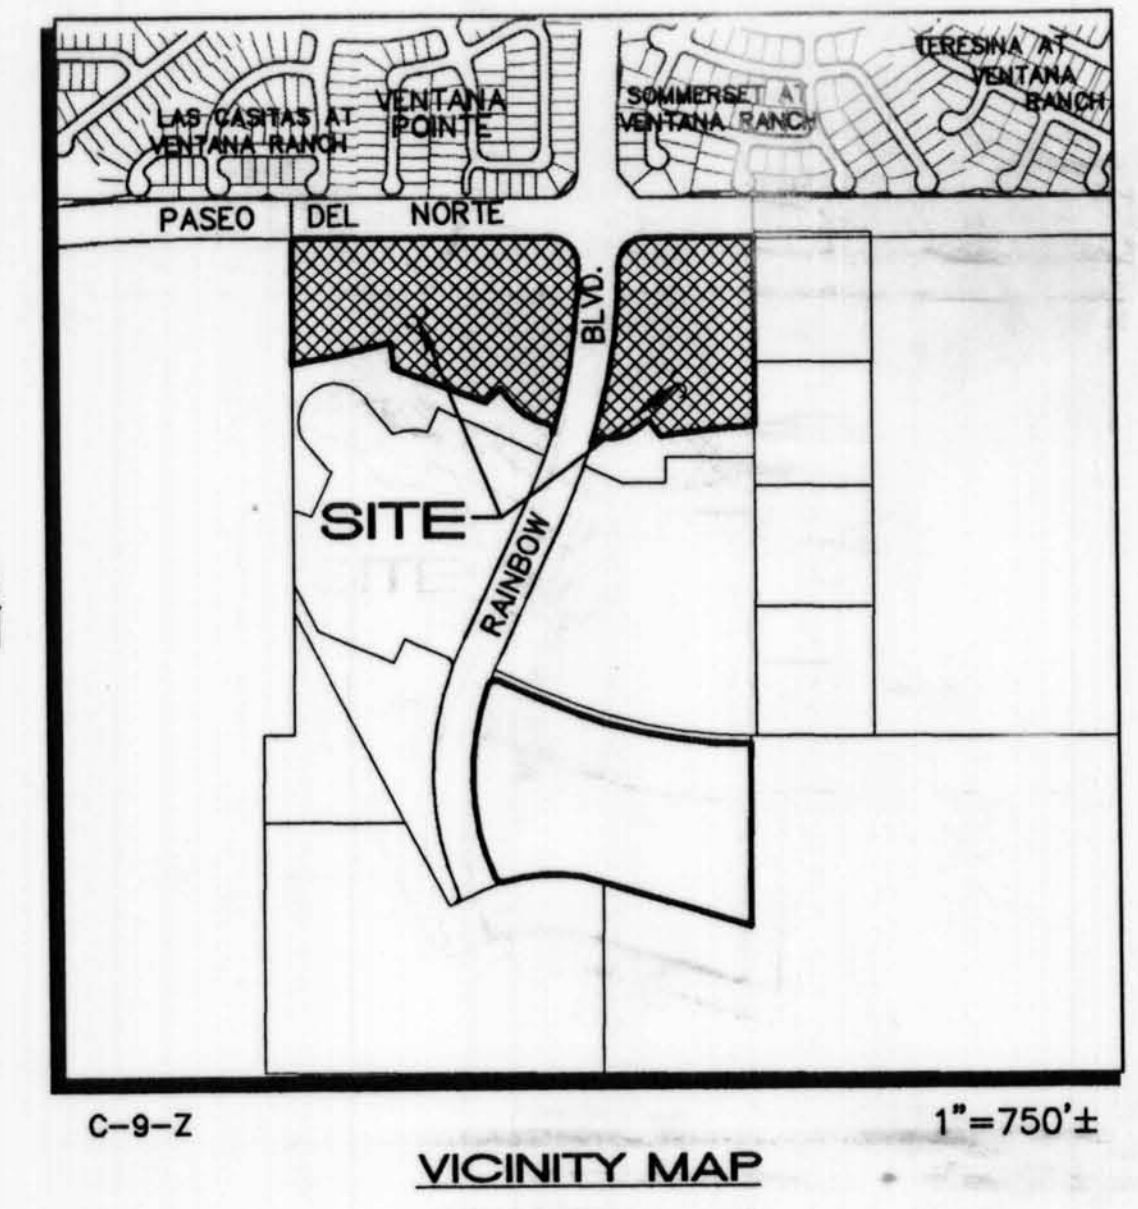

FOR INFORMATION ONLY

HERITAGE AT
THE TRAILS UNIT 2
GRADING & DRAINAGE PLAN

ISAACSON & ARFMAN, P.A.
Consulting Engineering Associates
28 Monroe Street N.E.
Albuquerque, New Mexico

1324B-GRD.DWG 03/19/04


SHEET 1 OF 3
SHEET 4 OF 19

738482



LEGEND

- 5200 — EXISTING CONTOUR
- 52 — PROPOSED CONTOUR
- ◆ 78.3 PROPOSED SPOT ELEVATION
- FLOW ARROW
- PG=6881.0 PAD GRADE ELEVATION
- SIDEWALK CULVERT
- TC=81.95 TOP OF CURB ELEVATION
- FL=81.45 FLOWLINE
- ~~~~~ WATER BAR
- PROPOSED RETAINING WALL
- TW=52.0 TOP OF RETAINING WALL ELEVATION
- BW=50.0 BOTTOM OF RETAINING WALL ELEVATION
- INV=72.5 INVERT ELEVATION
- STORM DRAIN MANHOLE

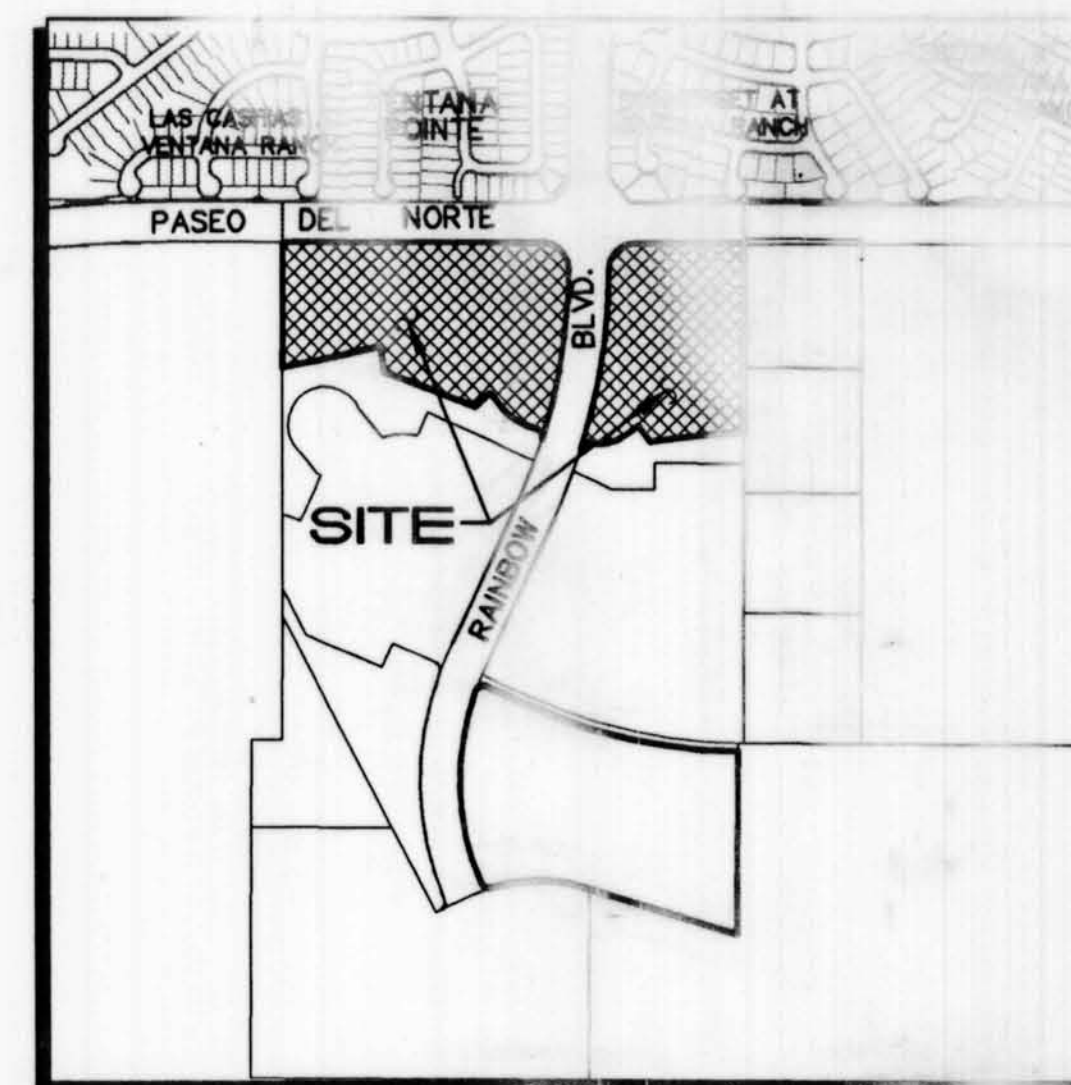

VICINITY MAP

GRADING NOTES:

1. ALL TRASH, DEBRIS, & SURFACE VEGETATION SHALL BE CLEARED AND LEGALLY DISPOSED OFFSITE.
2. ALL SUBGRADE AND FILL SHALL BE COMPACTED TO A MINIMUM OF 90% ASTM D-1557.
3. EXCAVATION IS UNCLASSIFIED AND INCLUDES EXCAVATION TO SUBGRADE ELEVATIONS INDICATED, REGARDLESS OF CHARACTER OF MATERIALS ENCOUNTERED.
4. CONFORM TO ELEVATIONS AND DIMENSIONS SHOWN ON PLANS WITHIN A TOLERANCE OF 0.3± FEET.
5. SCARIFY AND COMPACT SUBGRADE FOR FILLS. PLACE FILL MATERIALS IN LAYERS NOT MORE THAN 8" IN LOOSE DEPTH. MOISTEN AS NECESSARY TO PROVIDE OPTIMUM MOISTURE (±2%) CONTENT.
6. UNIFORMLY GRADE AREAS WITHIN LIMITS OF GRADING AS SHOWN ON PLAN. SMOOTH FINISHED SURFACE WITHIN SPECIFIED TOLERANCE, COMPACT WITH UNIFORM SLOPES BETWEEN POINTS WHERE ELEVATIONS ARE INDICATED.
7. MAXIMUM SLOPES SHALL BE 3:1 MINIMUM SLOPES SHALL BE 1%.
8. TWO (2) WORKING DAYS PRIOR TO ANY EXCAVATION, CONTRACTOR MUST CONTACT NEW MEXICO ONE CALL SYSTEM, 260-1990, FOR LOCATION OF EXISTING UTILITIES.
9. IF ANY UTILITY LINES, PIPELINES, OR UNDERGROUND UTILITY LINES ARE SHOWN ON THESE DRAWINGS, THEY ARE SHOWN IN AN APPROXIMATE MANNER ONLY, AND SUCH LINES MAY EXIST WHERE NONE ARE SHOWN. IF ANY SUCH EXISTING LINES ARE SHOWN, THE LOCATION IS BASED UPON INFORMATION PROVIDED BY THE OWNER OF SAID UTILITY, AND THE INFORMATION MAY BE INCOMPLETE, OR MAY BE OBSOLETE BY THE TIME CONSTRUCTION COMMENCES. THE ENGINEER HAS CONDUCTED ONLY PRELIMINARY INVESTIGATION OF THE LOCATION, DEPTH, SIZE OR TYPE OF EXISTING UTILITY LINES, PIPELINES, OR UNDERGROUND UTILITY LINES. THIS INVESTIGATION IS NOT CONCLUSIVE, AND MAY NOT BE COMPLETE, THEREFORE, MAKES NO REPRESENTATION PERTAINING THERETO, AND ASSUMES NO RESPONSIBILITY OR LIABILITY THEREFORE. THE CONTRACTOR SHALL INFORM ITSELF OF THE LOCATION OF ANY UTILITY LINE, PIPELINE, OR UNDERGROUND UTILITY LINE IN OR NEAR THE AREA OF THE WORK IN ADVANCE OF AND DURING EXCAVATION WORK. THE CONTRACTOR IS FULLY RESPONSIBLE FOR ANY AND ALL DAMAGE CAUSED BY ITS FAILURE TO LOCATE, IDENTIFY AND PRESERVE ANY AND ALL EXISTING UTILITIES, PIPELINES, AND UNDERGROUND UTILITY LINES. IN PLANNING AND CONDUCTING EXCAVATION, THE CONTRACTOR SHALL COMPLY WITH STATE STATUTES, MUNICIPAL AND LOCAL ORDINANCES, RULES AND REGULATIONS, IF ANY, PERTAINING TO THE LOCATION OF THESE LINES AND FACILITIES.
10. OWNER WILL PROVIDE SOIL TESTING AND INSPECTION SERVICES DURING EARTHWORK OPERATIONS. CONTRACTOR SHALL ALLOW TESTING SERVICE TO INSPECT AND APPROVE COMPACTED SUBGRADES AND FILL LAYERS BEFORE FURTHER CONSTRUCTION WORK IS DONE. SHOULD COMPACTION TESTS INDICATE INADEQUATE DENSITY, CONTRACTOR SHALL PROVIDE ADDITIONAL COMPACTION AND TESTING AT NO ADDITIONAL EXPENSE.
11. OWNER HAS ESTABLISHED SUBDIVISION BOUNDARY CORNERS. CONTRACTOR SHALL PROVIDE ALL OTHER CONSTRUCTION STAKING INCLUDING TRACT CORNERS. CONTRACTOR SHALL LOCATE AND PRESERVE ALL BOUNDARY CORNERS AND REPLACE ANY LOST OR DISTURBED CORNERS.
12. OWNER WILL PROVIDE A STORM WATER POLLUTION PREVENTION PLAN (SWPPP) AND INSPECTION. CONTRACTOR SHALL COMPLY WITH THE BEST MANAGEMENT PRACTICES (BMP'S) AS SPECIFIED IN THE SWPPP, AND WITH ALL FEDERAL, STATE, AND LOCAL REGULATIONS.

FOR
INFORMATION
ONLY

HERITAGE AT THE TRAILS - UNIT 2 GRADING & DRAINAGE PLAN RETAINING WALLS







GENEVEVE L. DOMINGUEZ
NEW MEXICO
15000
3/25/04

ISAACSON & ARMAN, P.A.
Consulting Engineering Associates
1800 Alameda Street N.E.
Albuquerque, New Mexico





1324B-GRD.DWG 3/25/04

738482

SHEET 5 OF 19

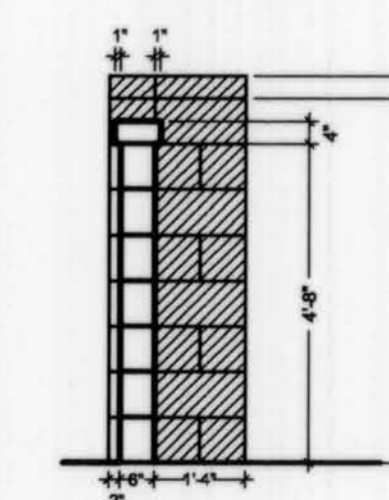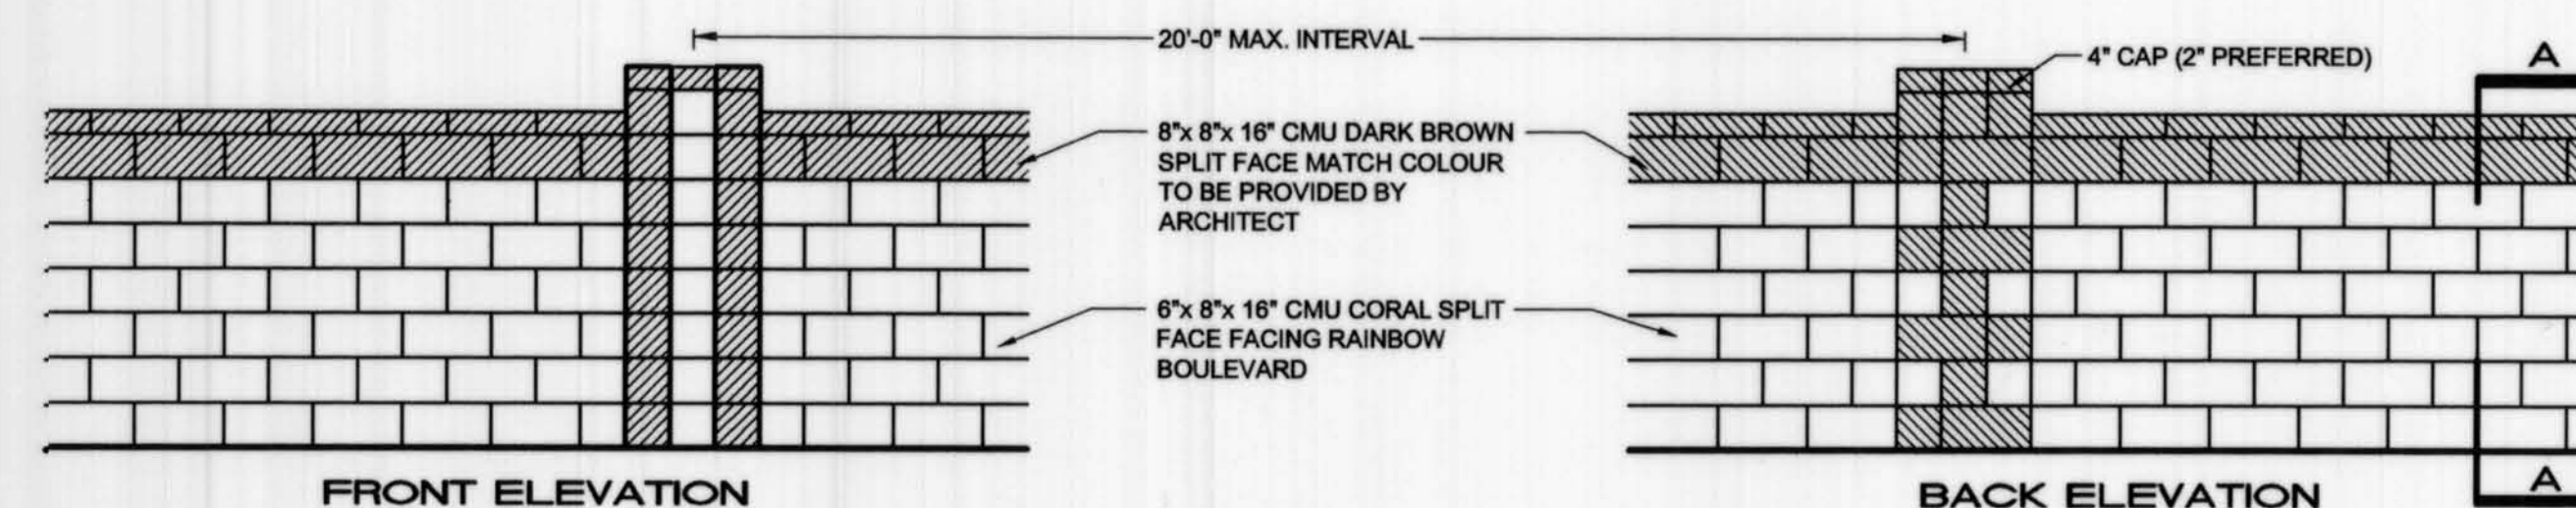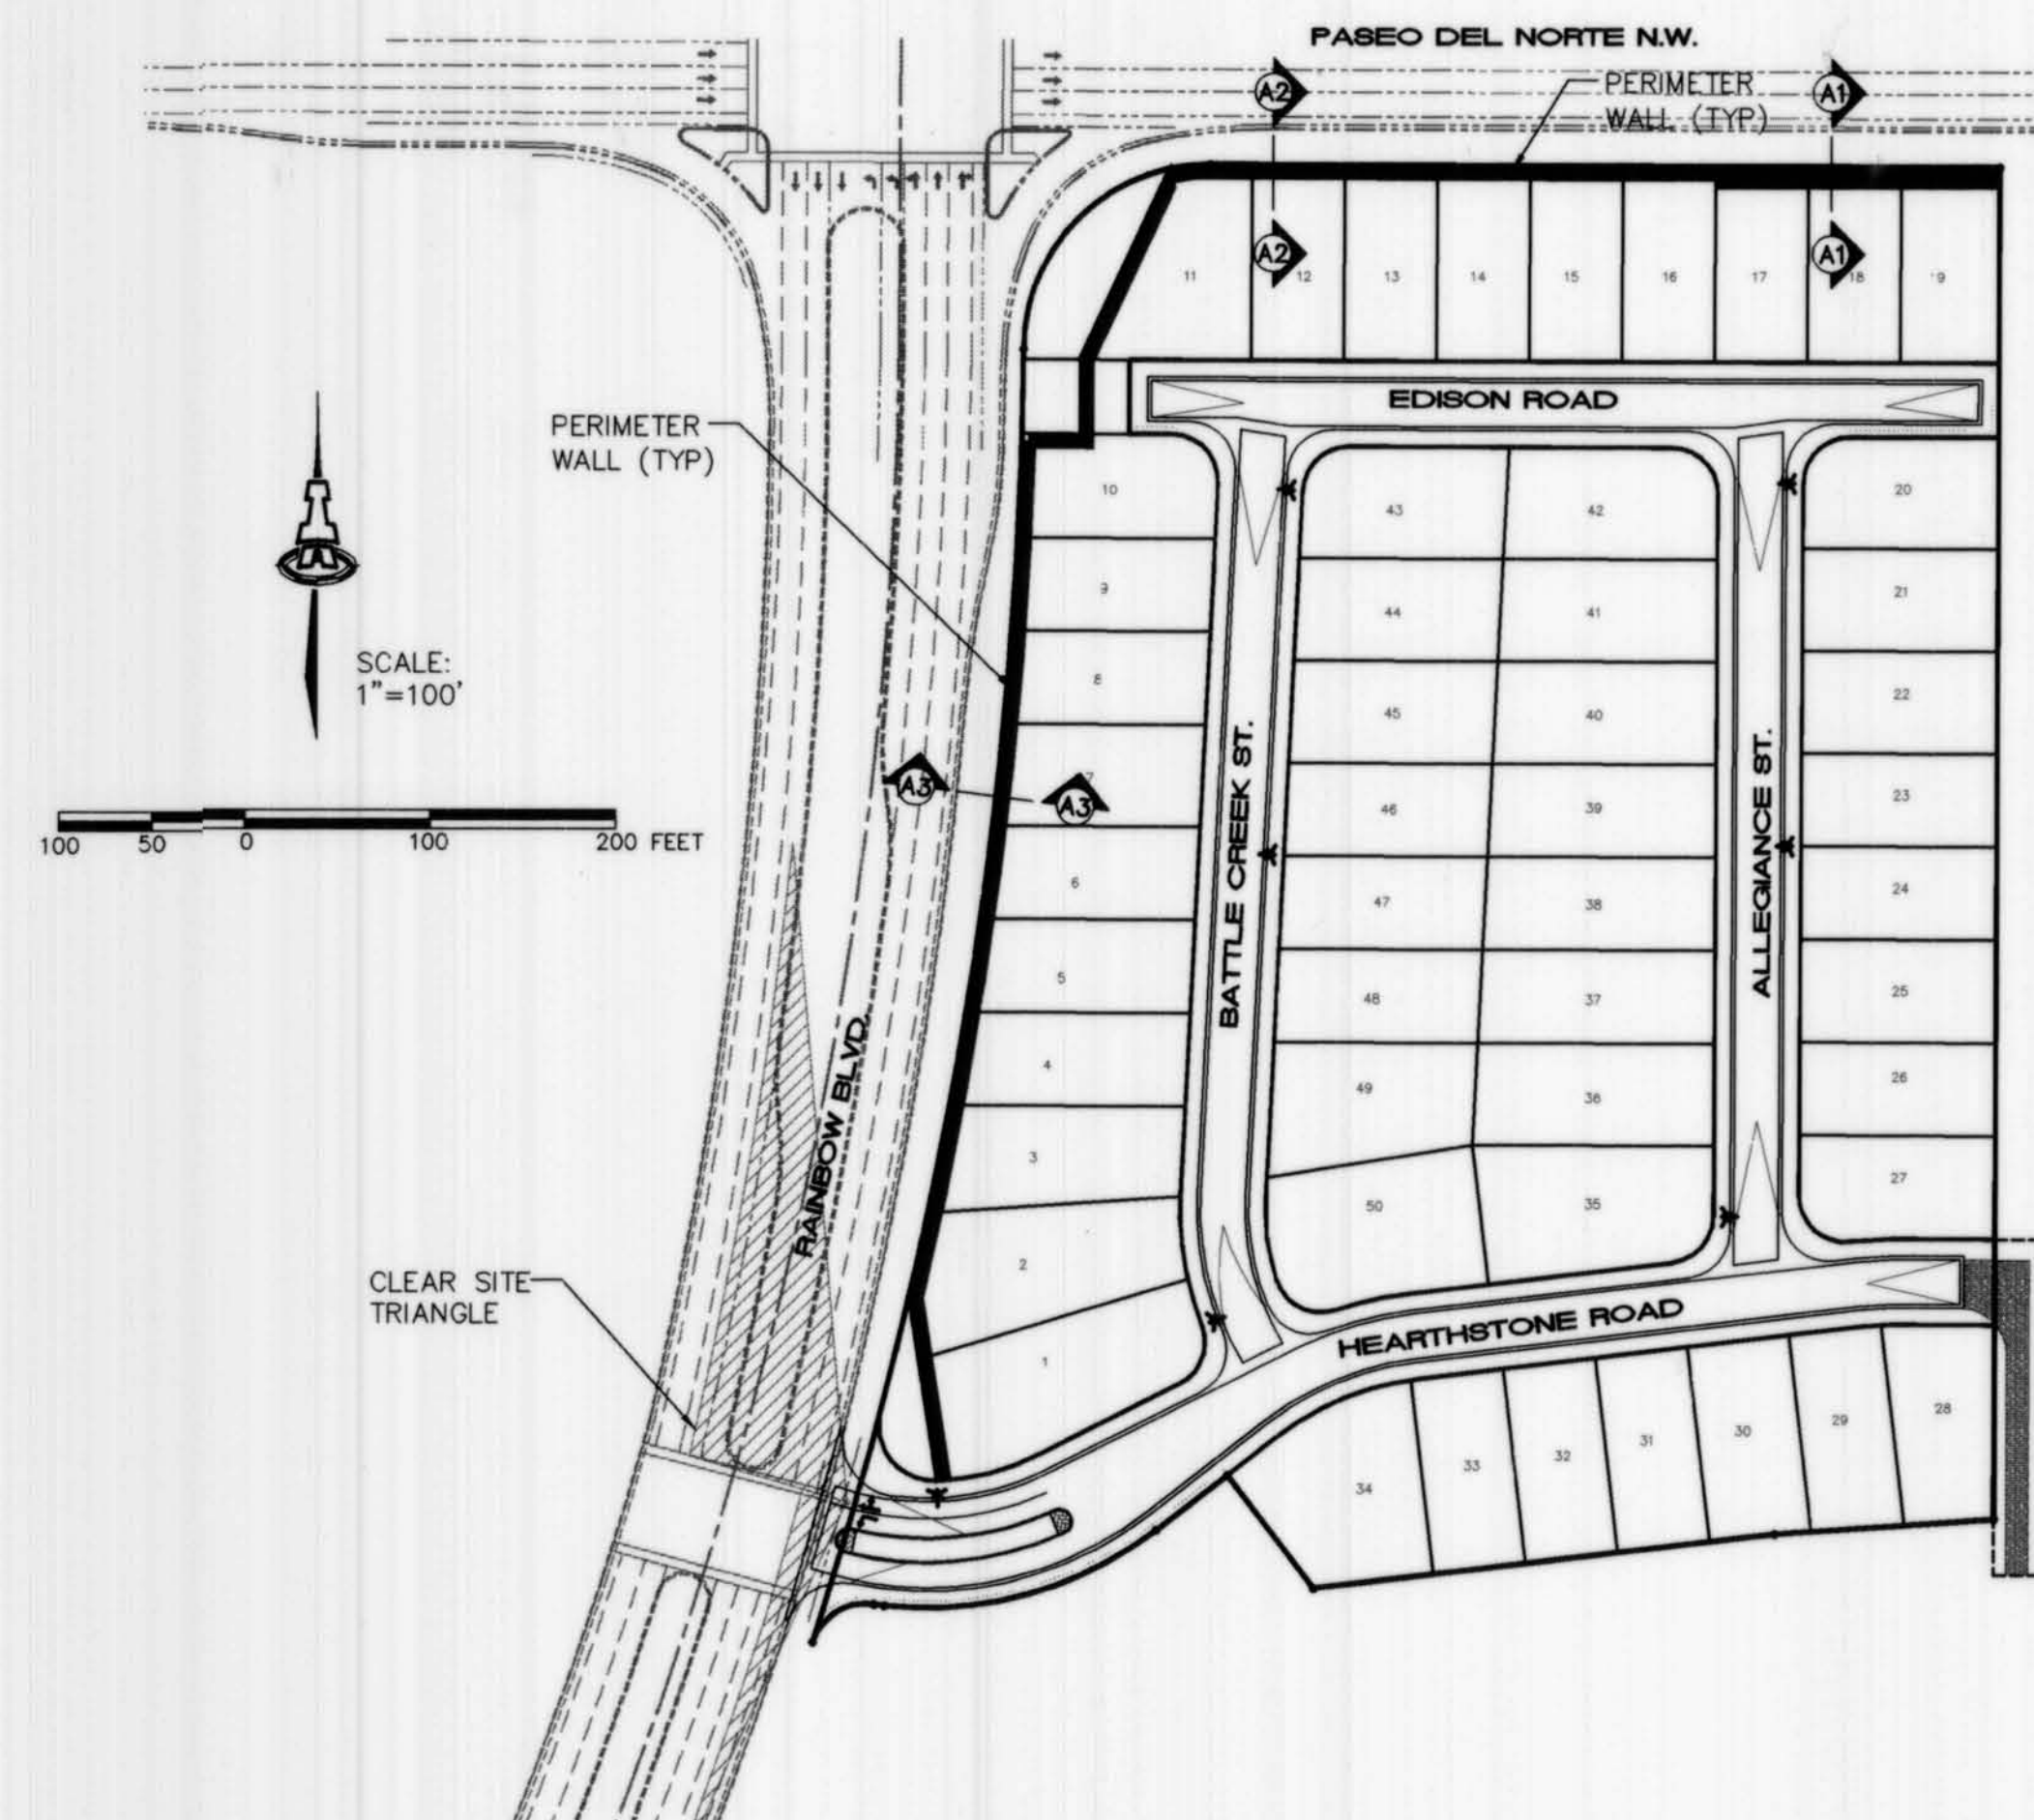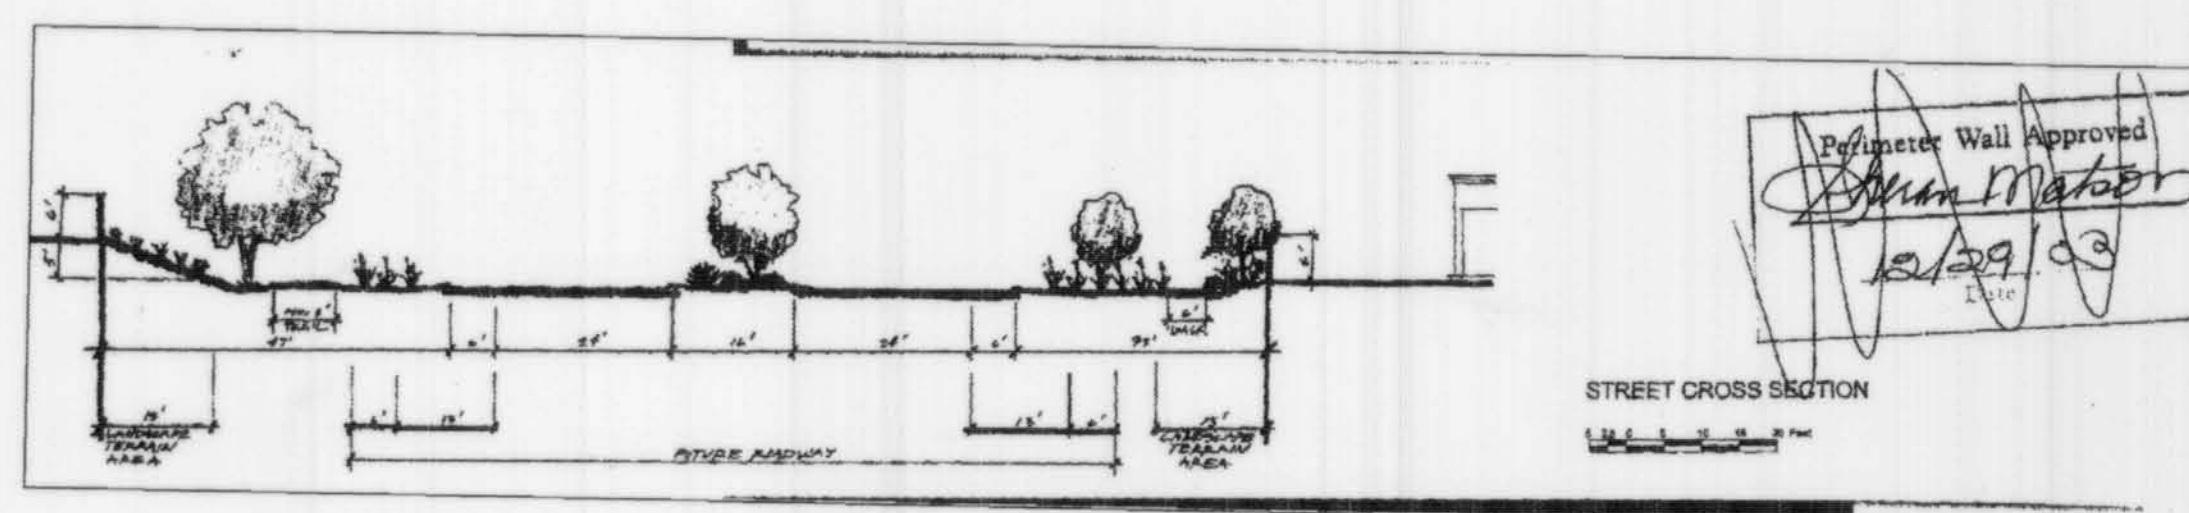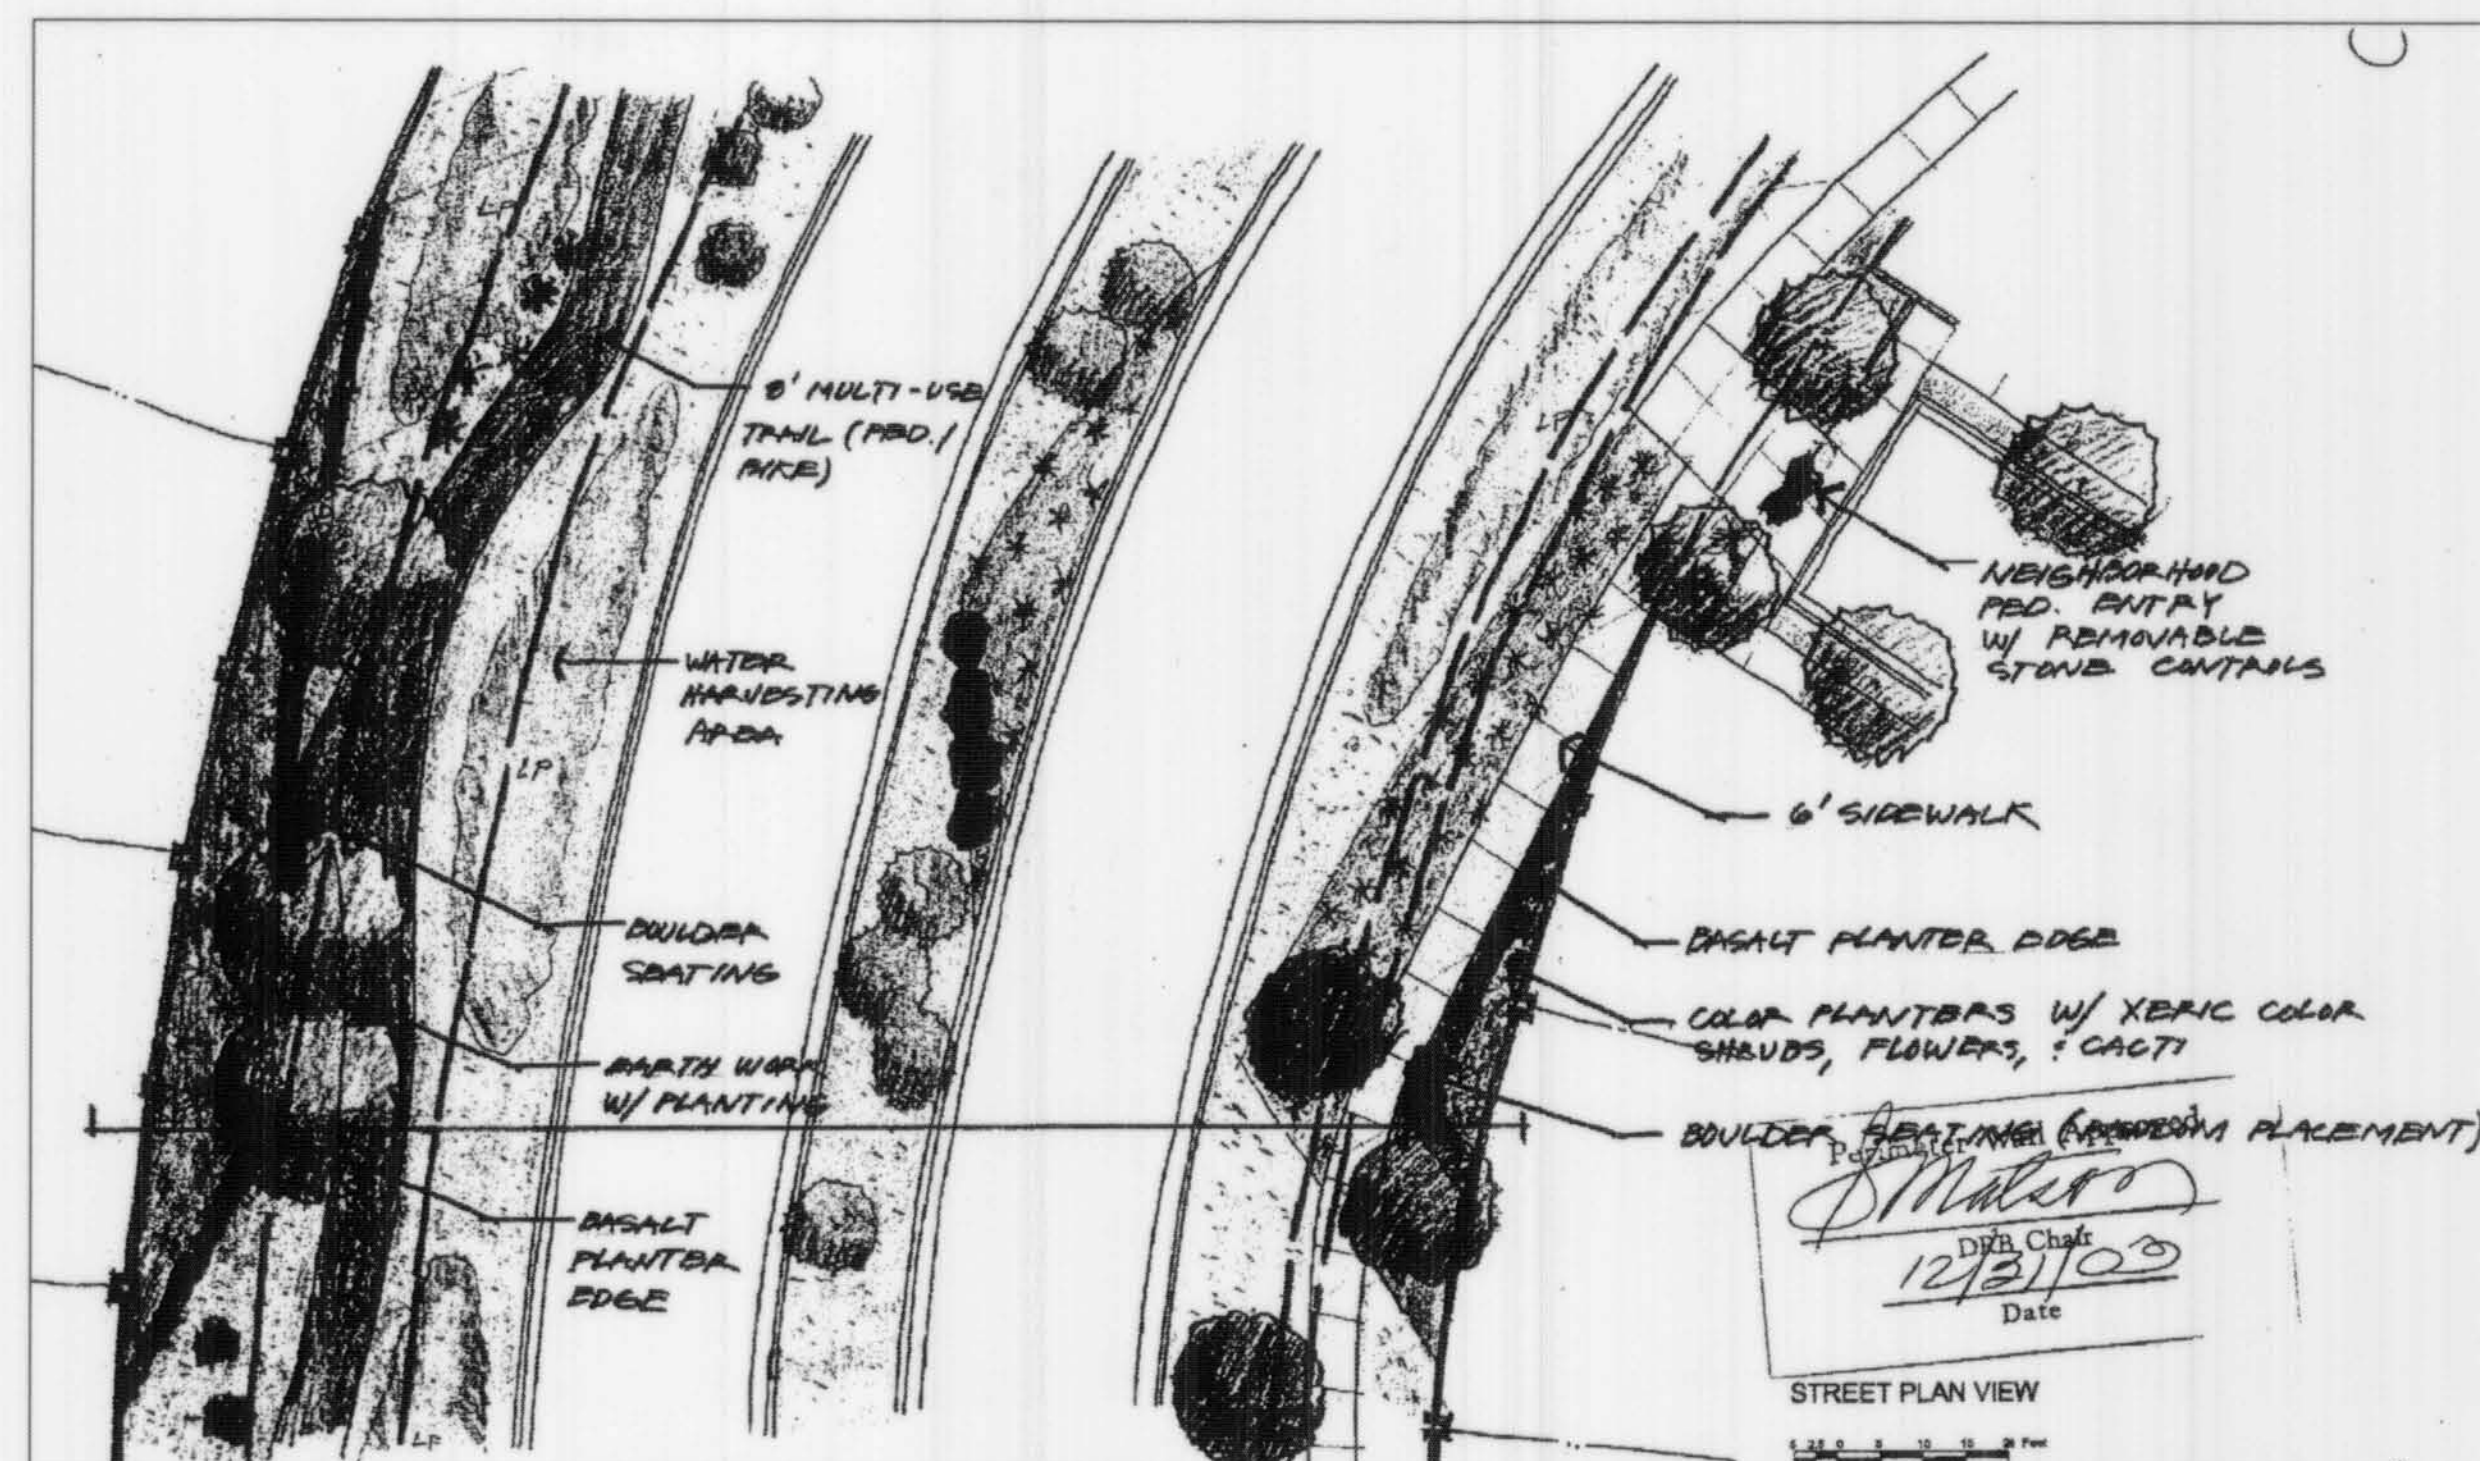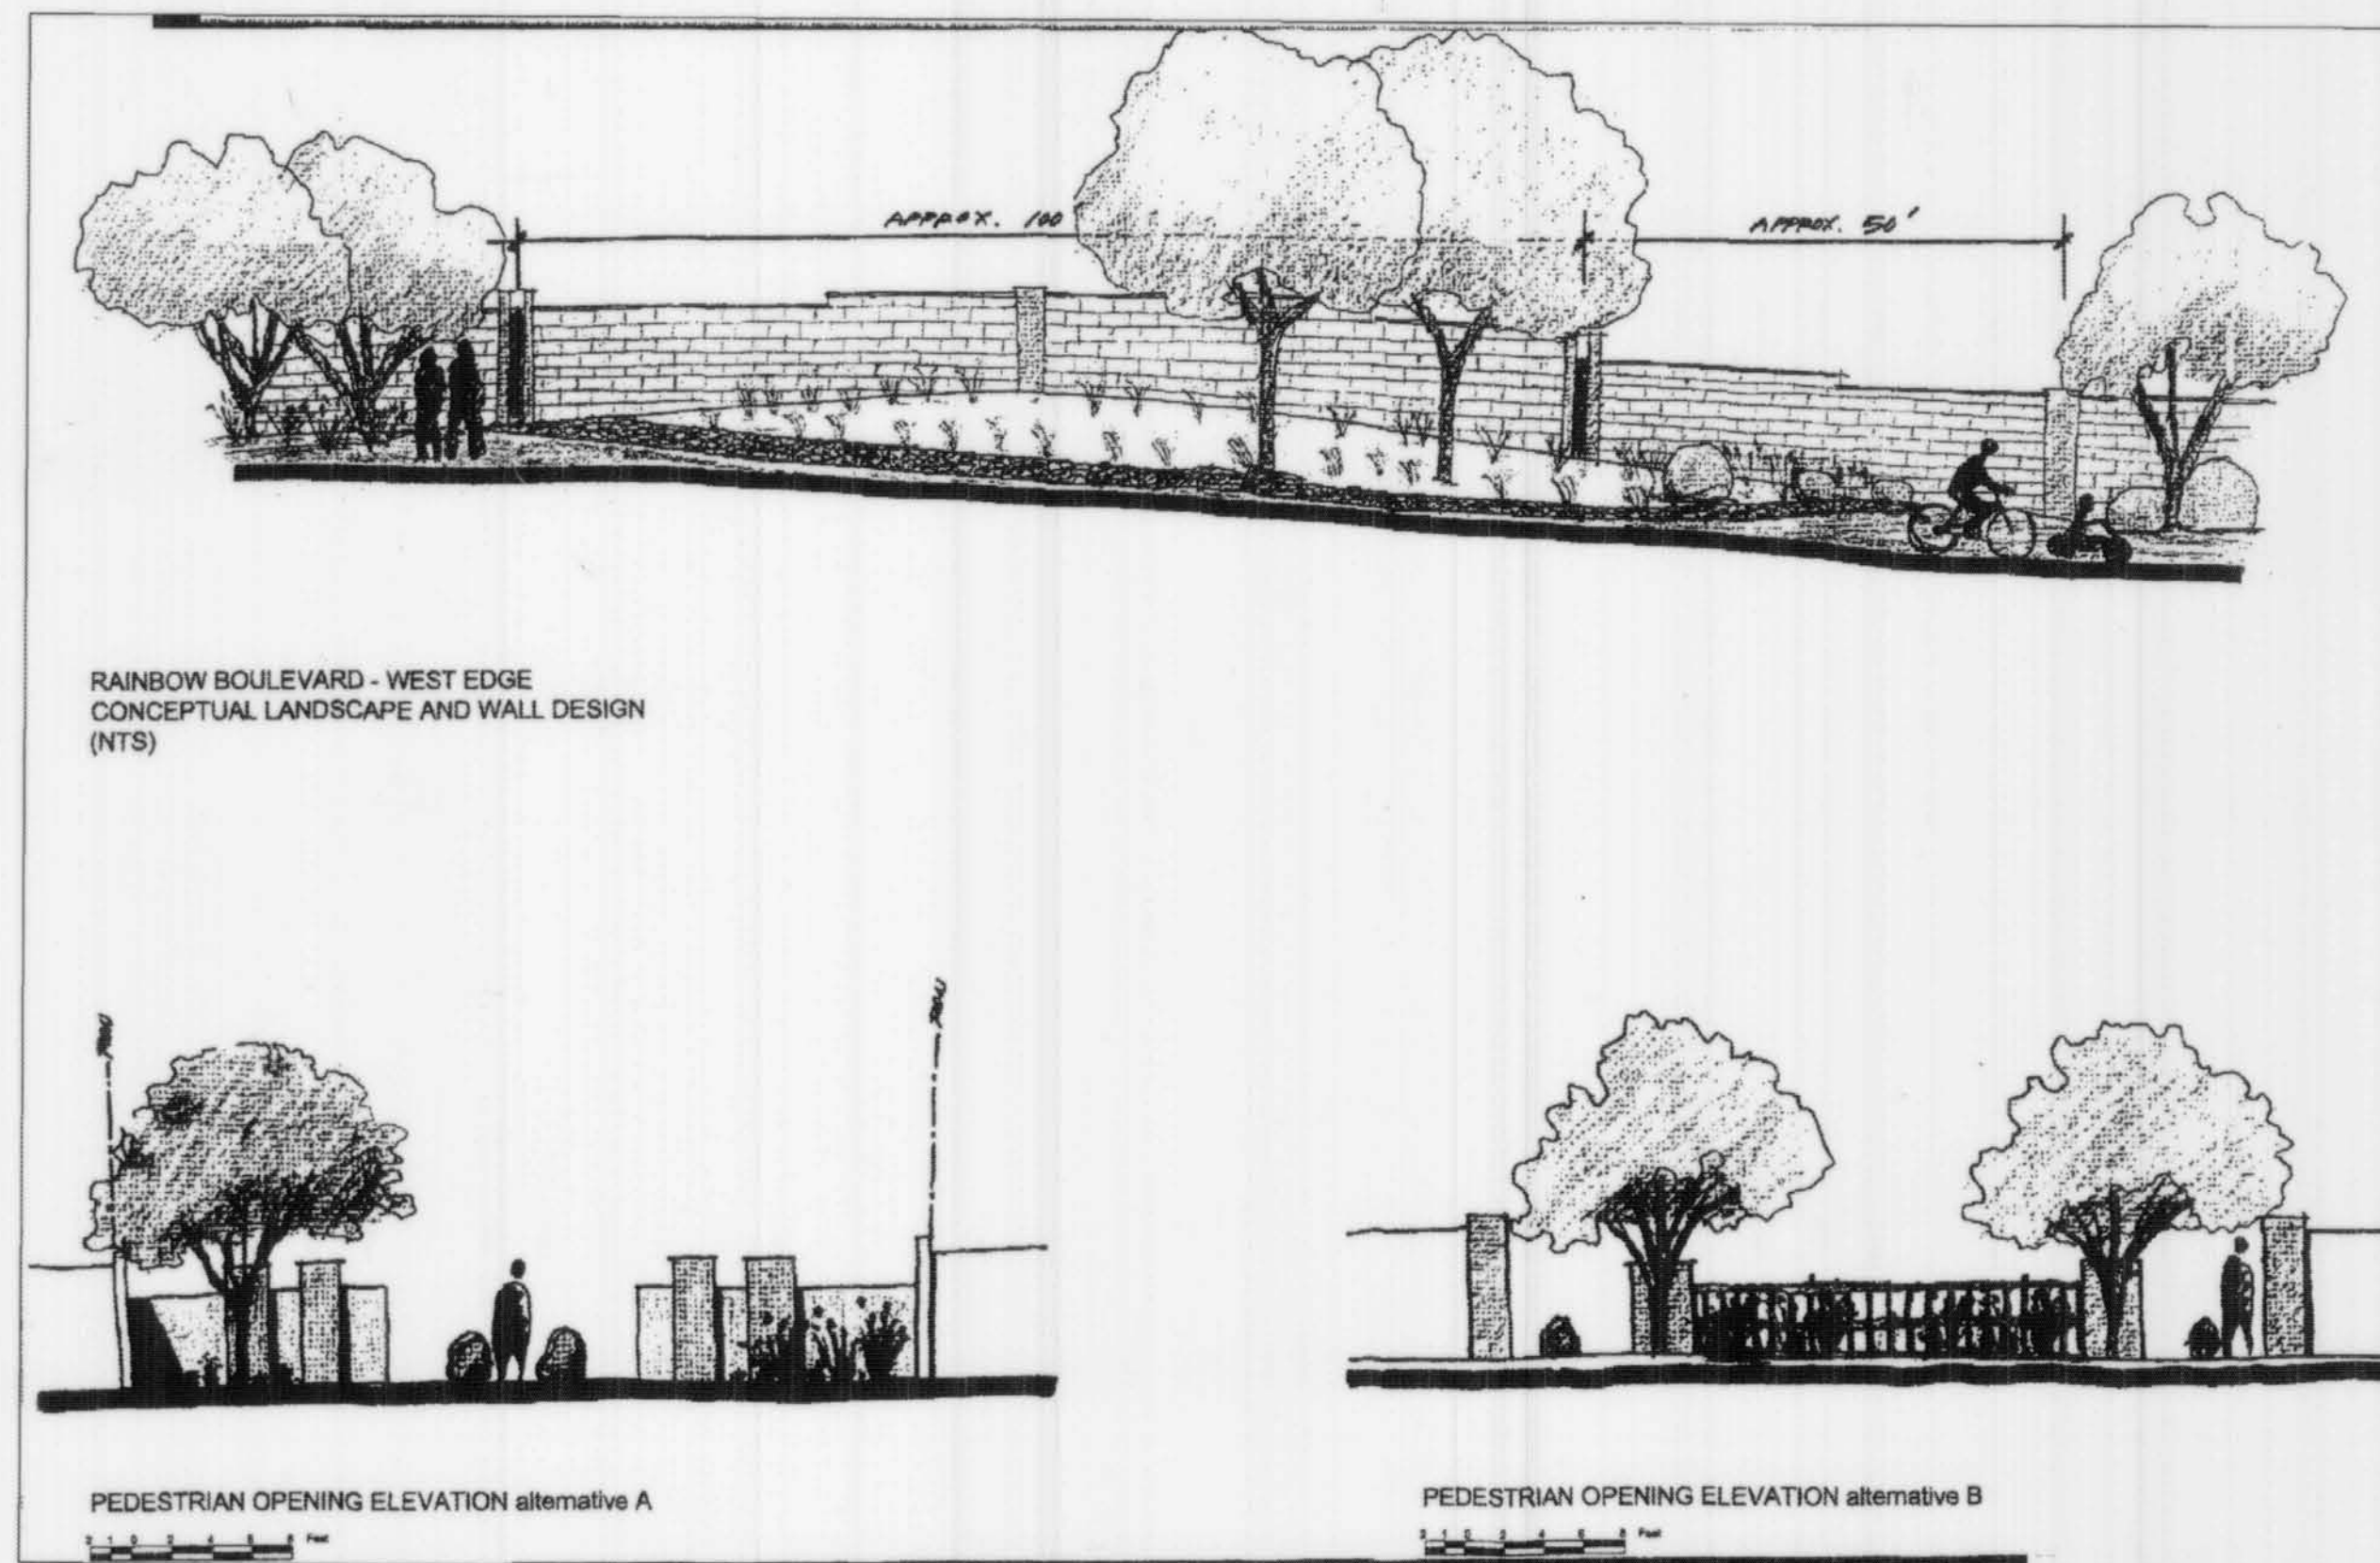


SECTION A-A

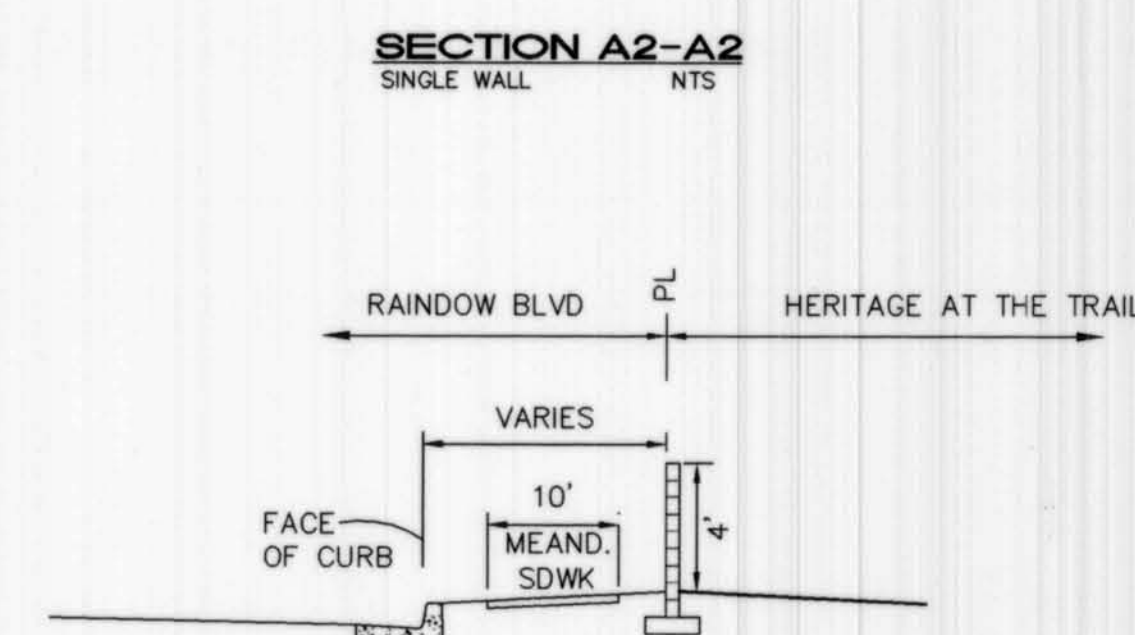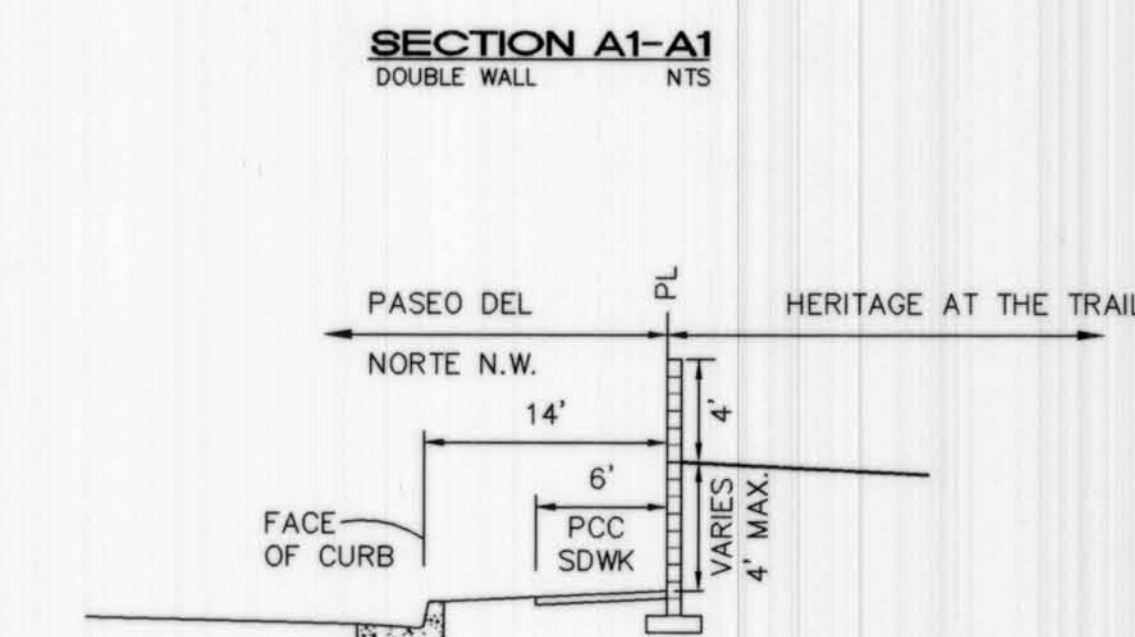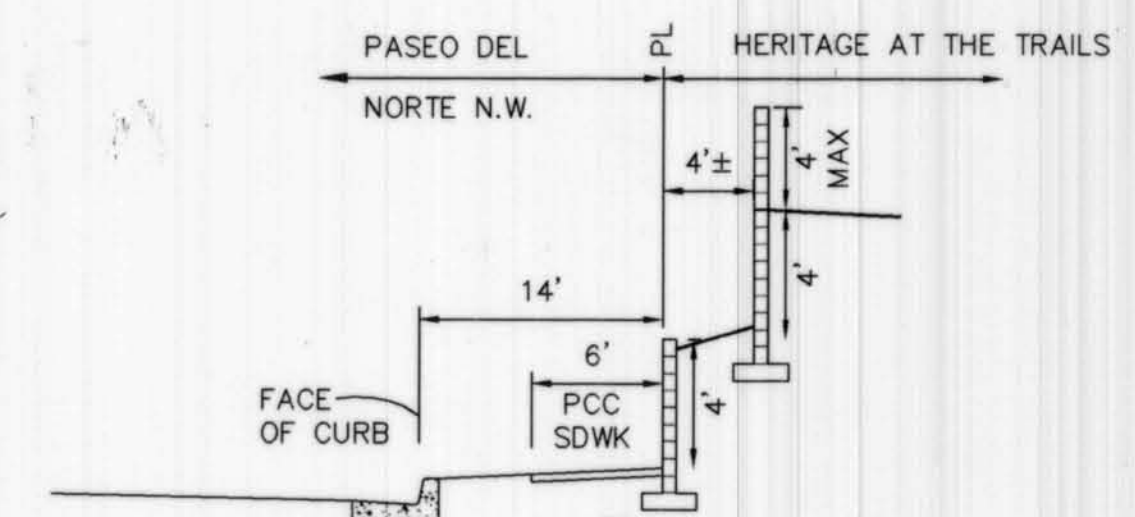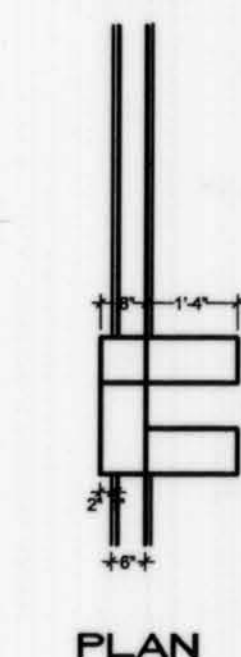

ZONE ATLAS #: C-9
NEAREST INTERSECTION:
PASEO DEL NORTE & RAINBOW
DRB PROJECT #: 1003354

HERITAGE AT THE TRAILS UNIT 2 PERIMETER WALL PLAN

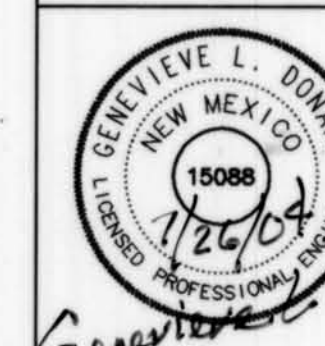


ISAACSON & ARFMAN, P.A.
Consulting Engineering Associates
128 Monroe Street N.E.
Albuquerque New Mexico


1324B-PERIMWALL.DWG:th 07/09/04

SHEET 7 OF 19


738482

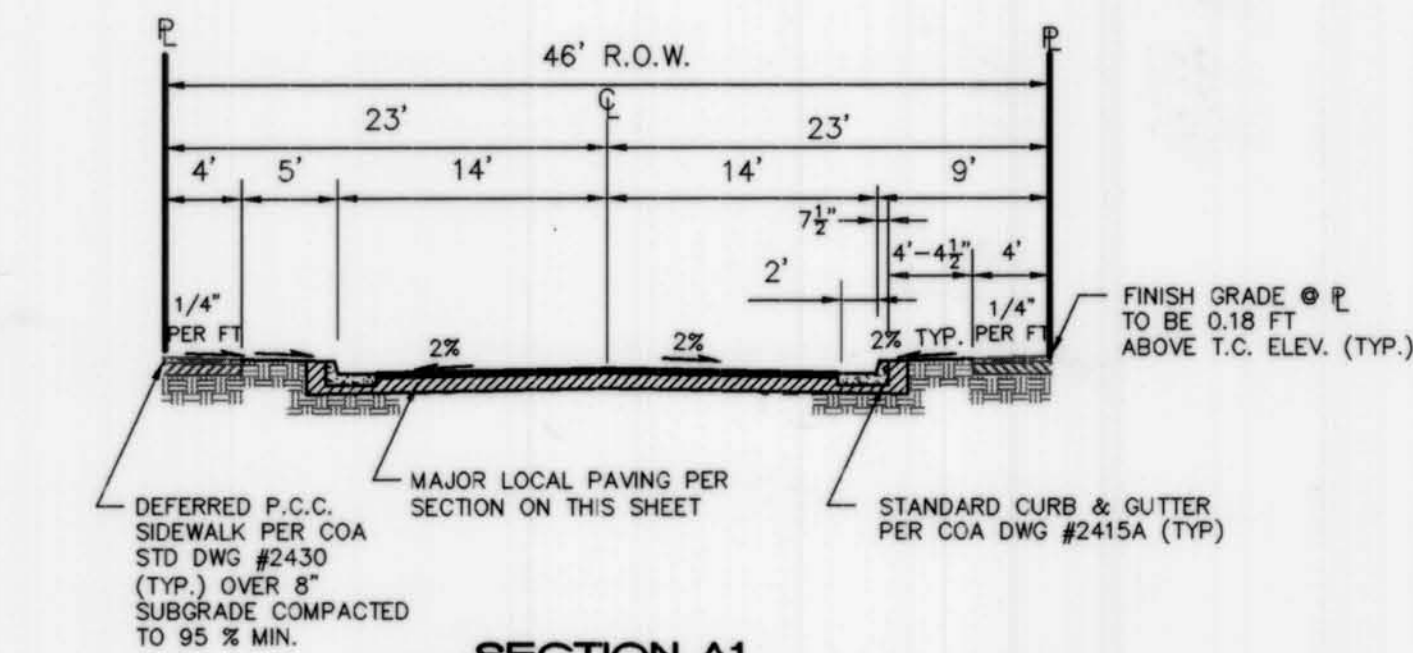


SECTION A1
TYPICAL 46' R.O.W. RESIDENTIAL STREET SECTION
1"=10'

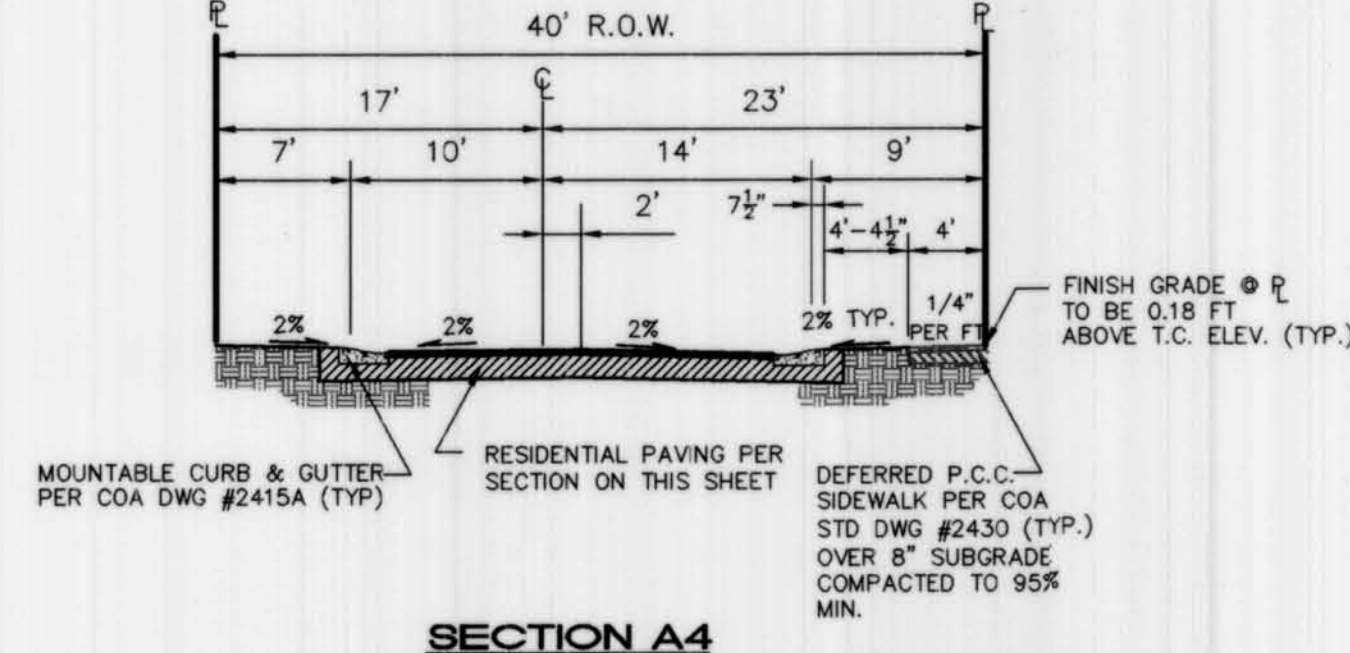


SECTION A4
TYPICAL 40' R.O.W. RESIDENTIAL STREET SECTION
1"=10'

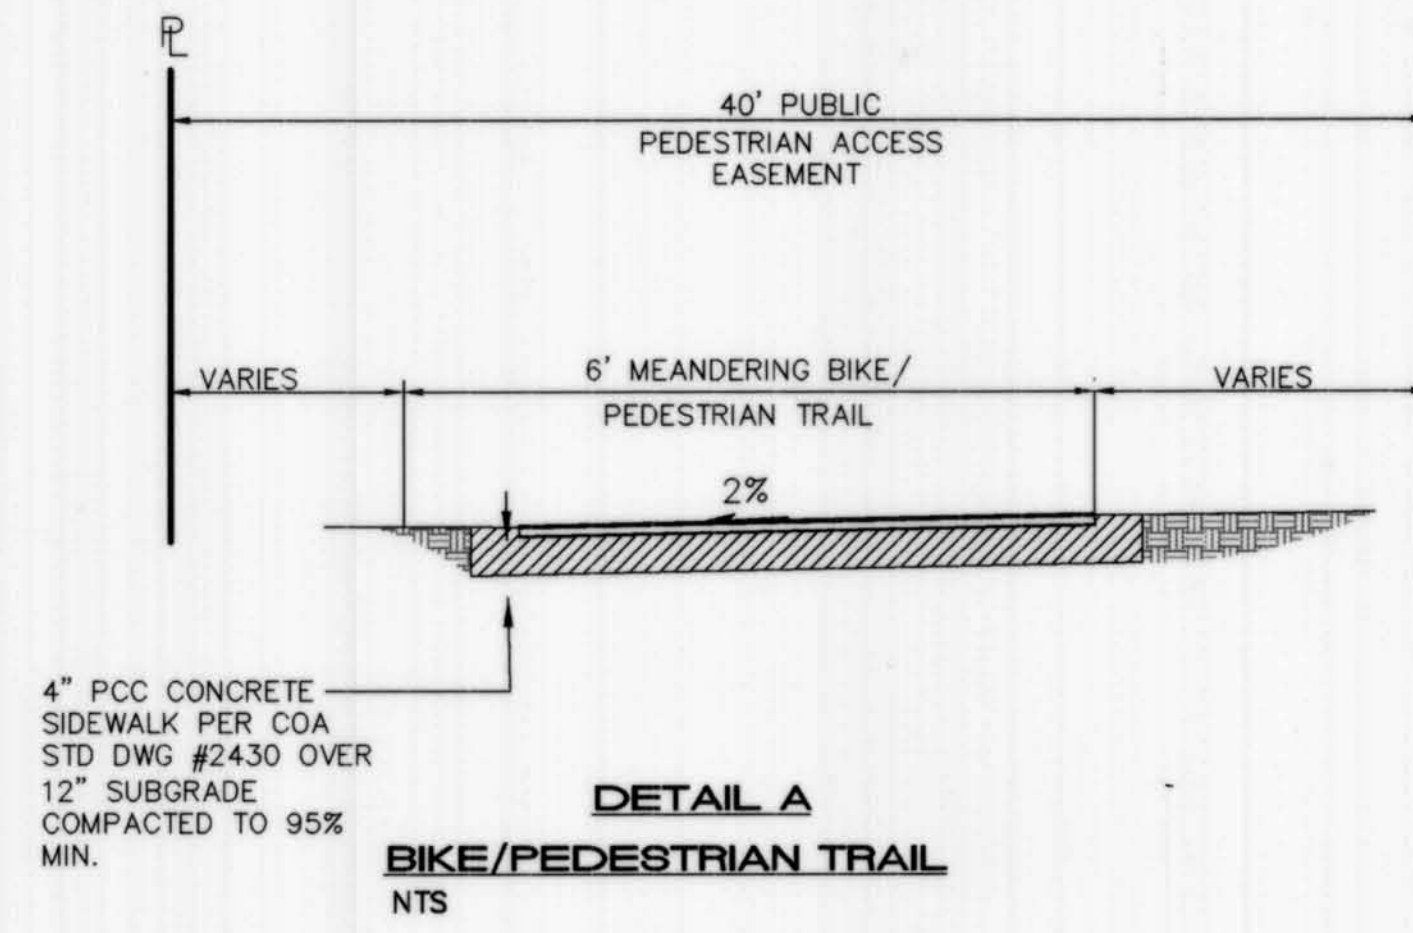


DETAIL A
BIKE/PEDESTRIAN TRAIL
NTS

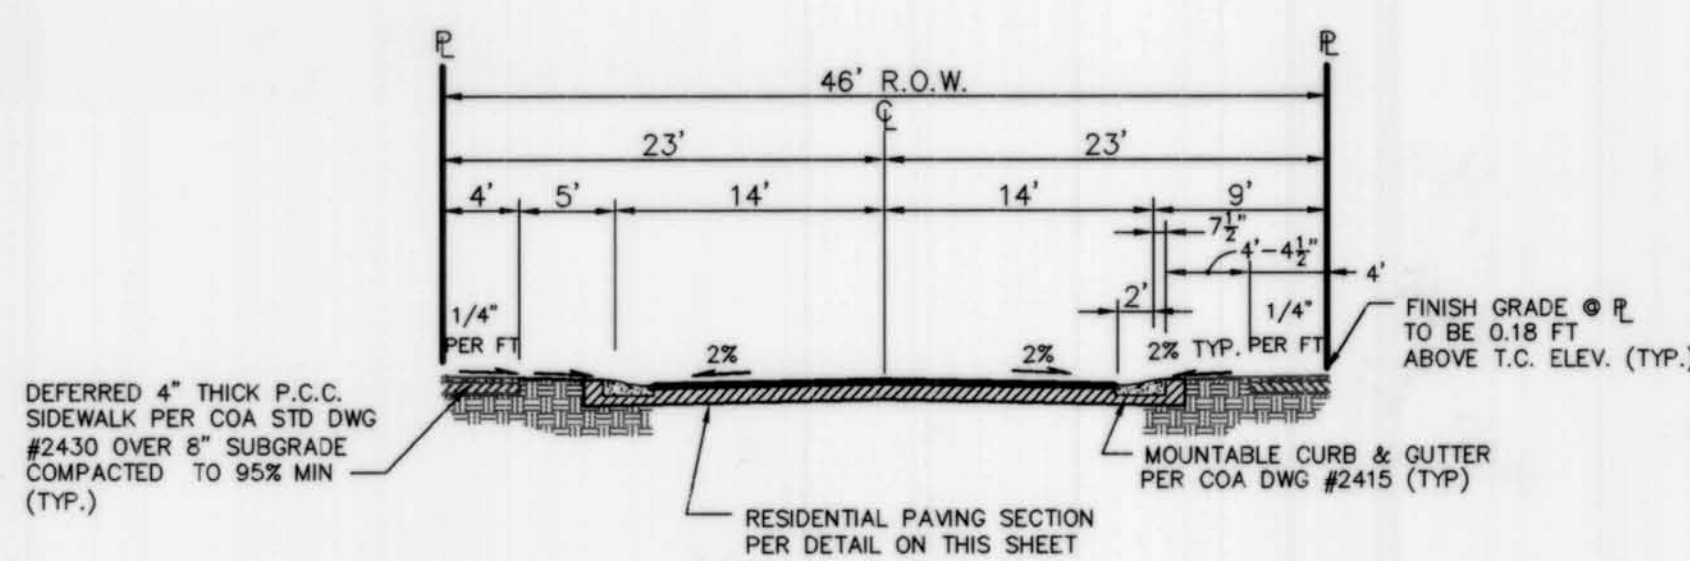


SECTION A2
TYPICAL 46' R.O.W. RESIDENTIAL STREET SECTION
1"=10'

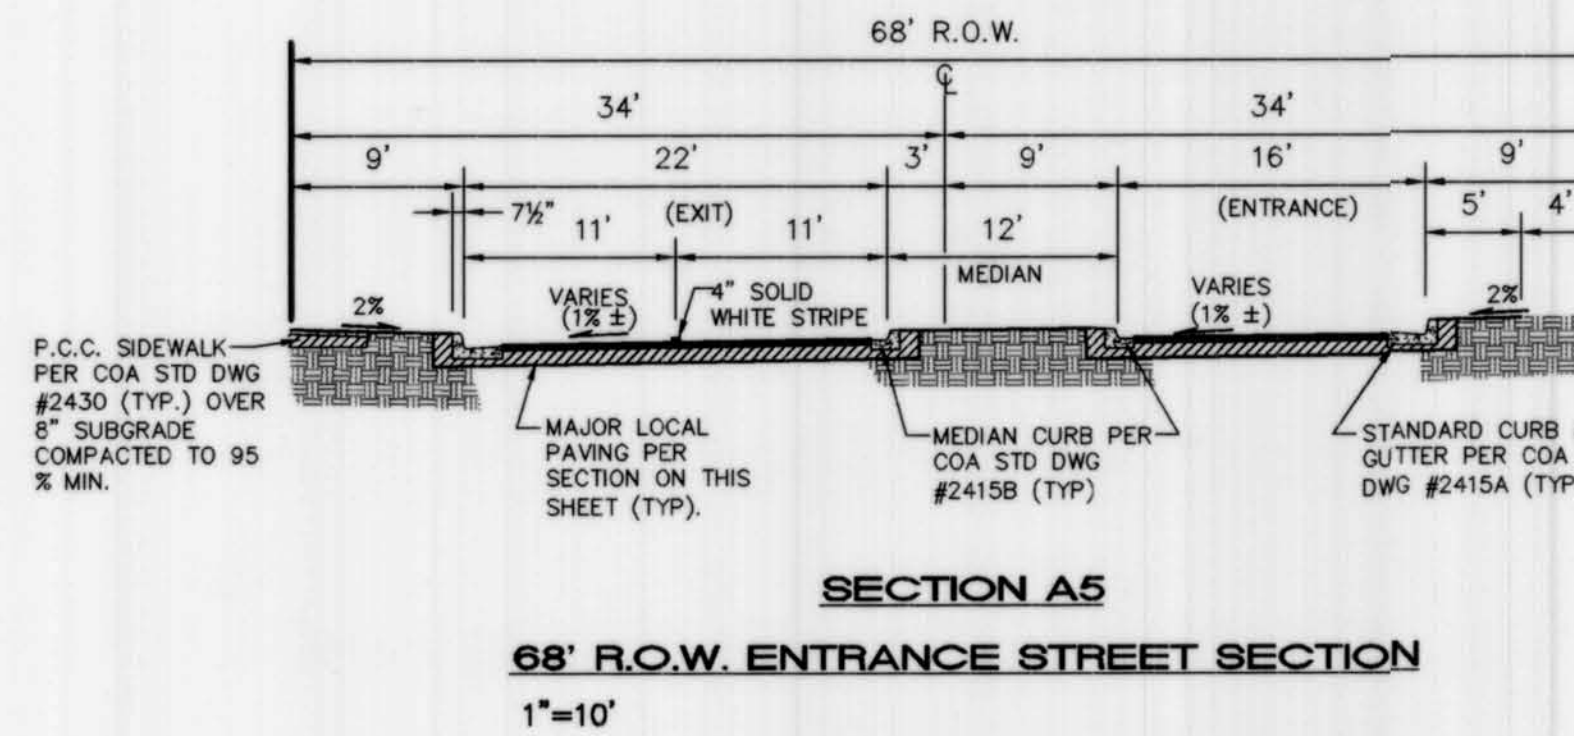


SECTION A5
68' R.O.W. ENTRANCE STREET SECTION
1"=10'

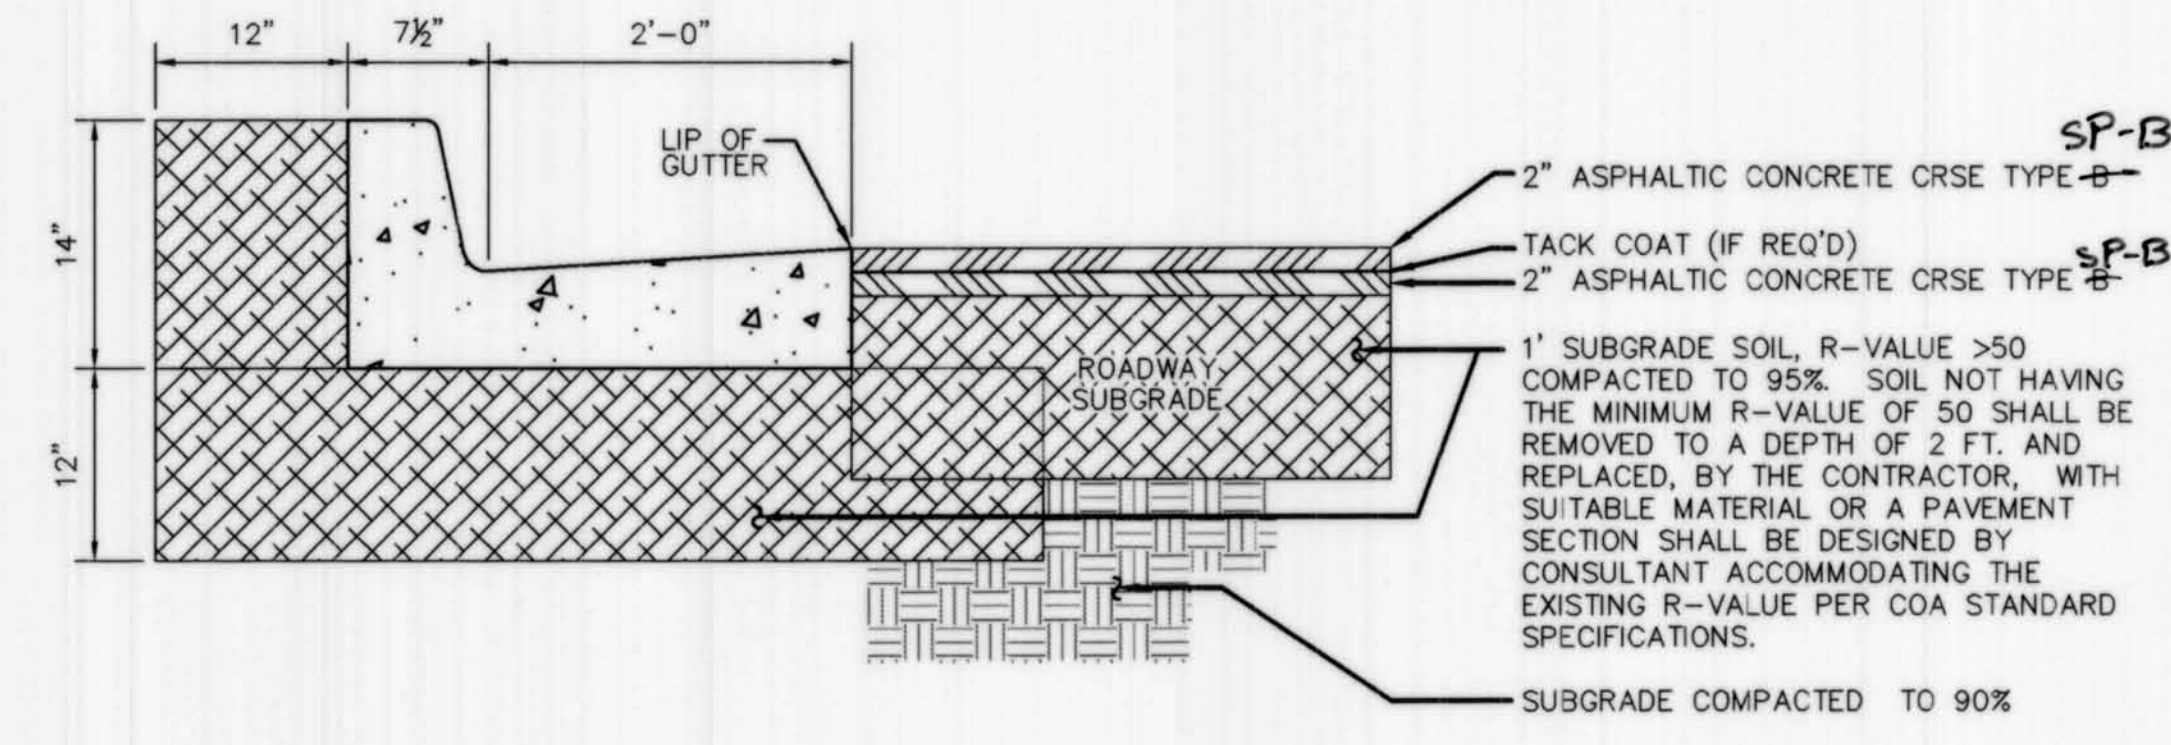


MAJOR LOCAL PAVING SECTION
SCALE: 1"=1'-0"
(PER COA STD DWG # 2405B)

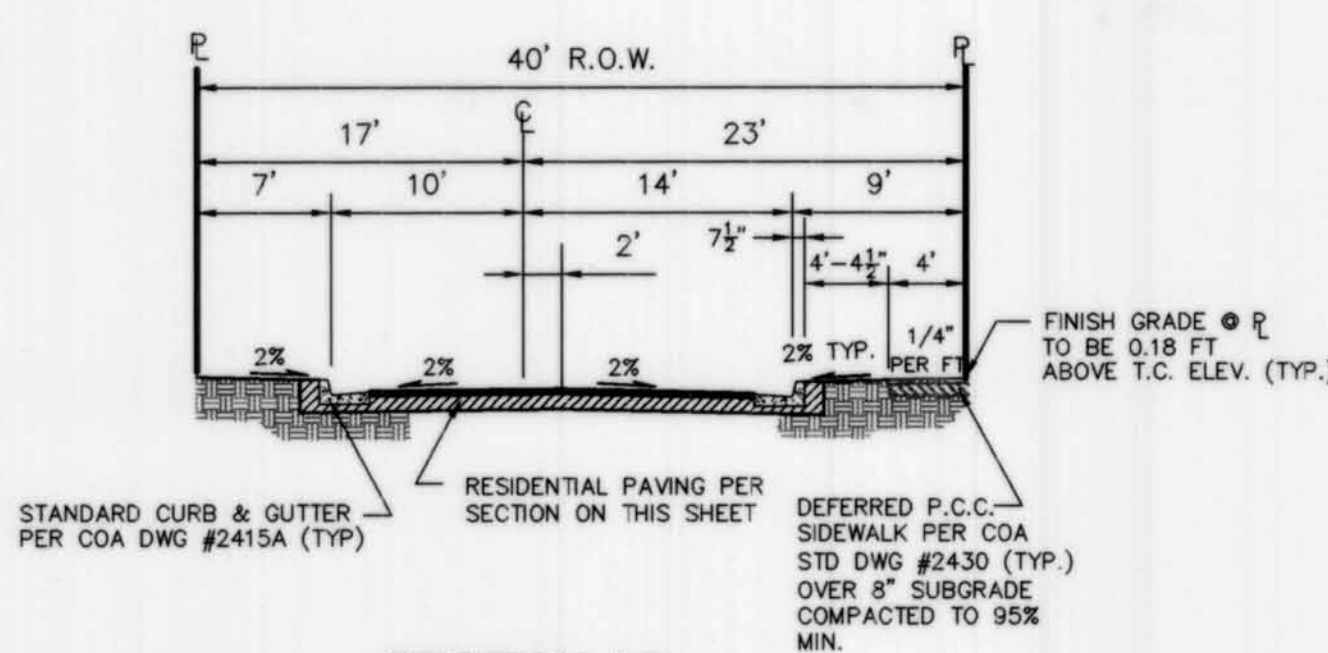

SECTION A3
TYPICAL 40' R.O.W. RESIDENTIAL STREET SECTION
1"=10'

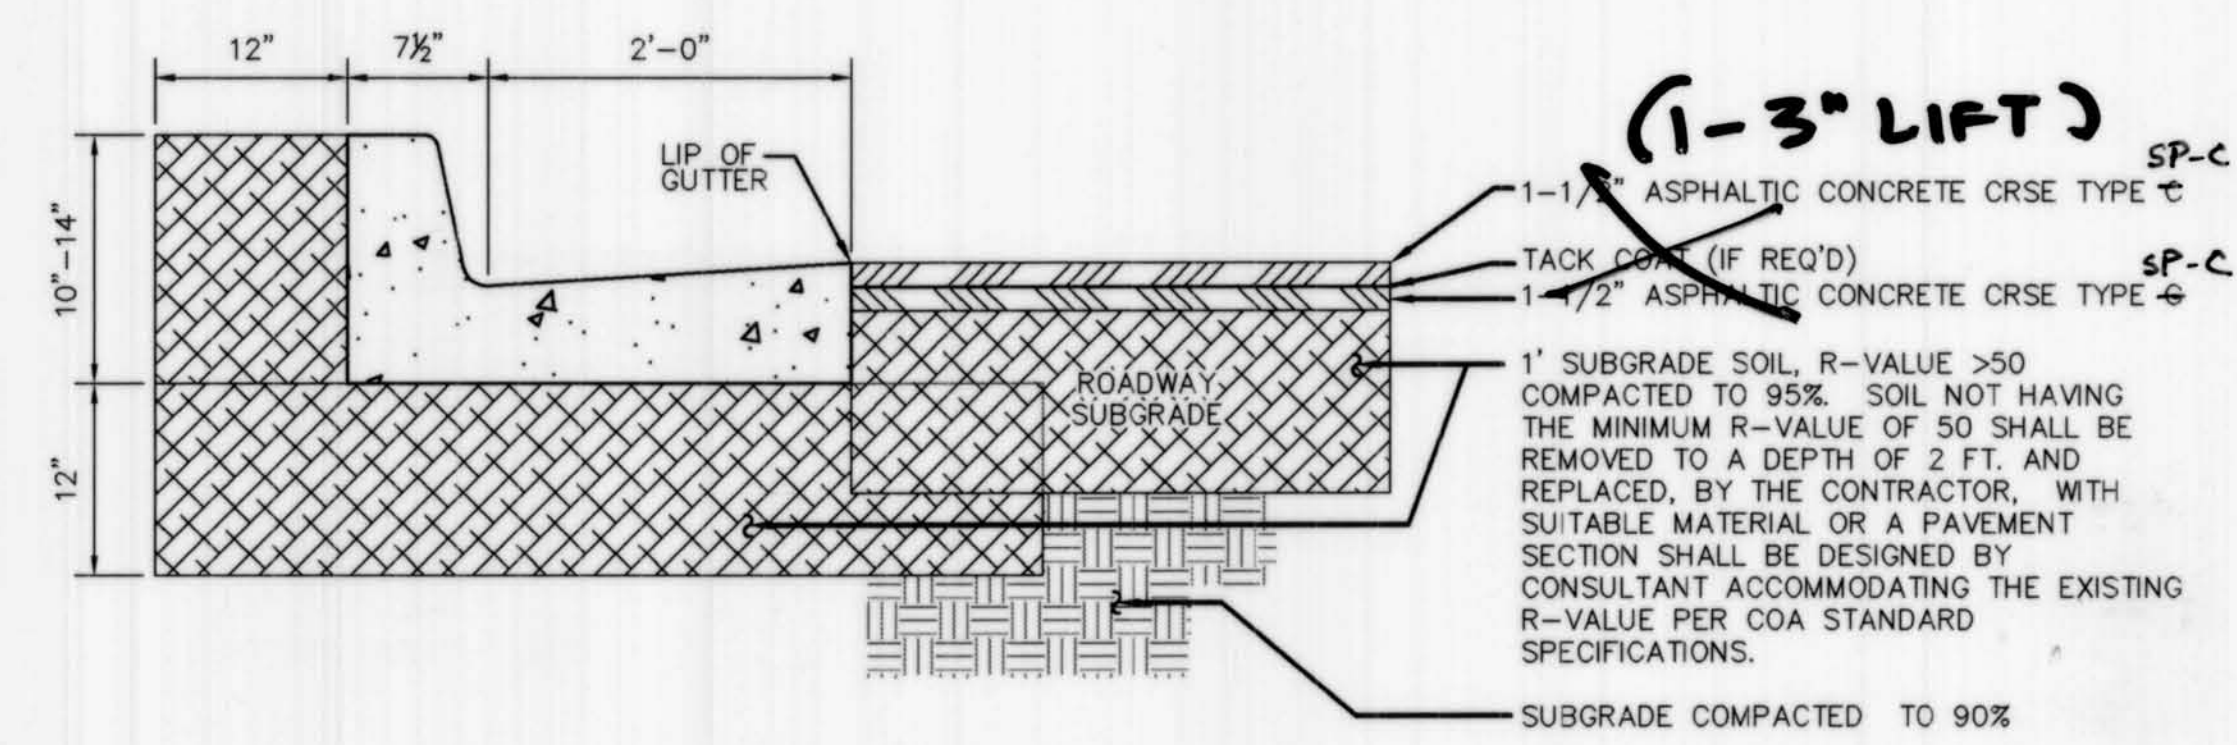


RESIDENTIAL PAVING SECTION
SCALE: 1"=1'-0"
(PER COA STD DWG # 2405A)

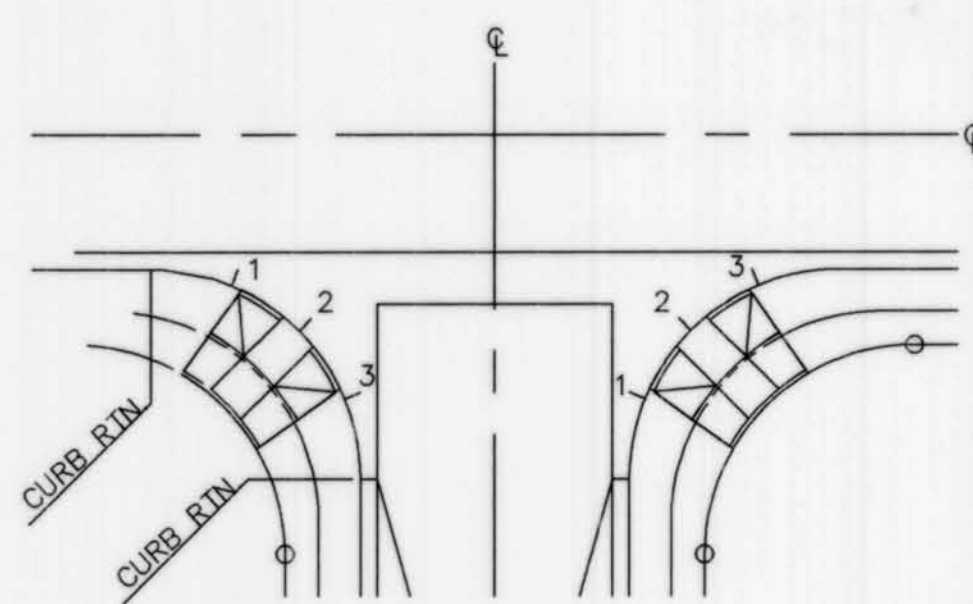

NOTE:
QUARTER POINT GRADES ARE REFERENCED AS 1, 2 & 3
ALONG THE FACE OF CURB IN A CLOCKWISE DIRECTION.

QUARTER POINT DETAIL
NTS

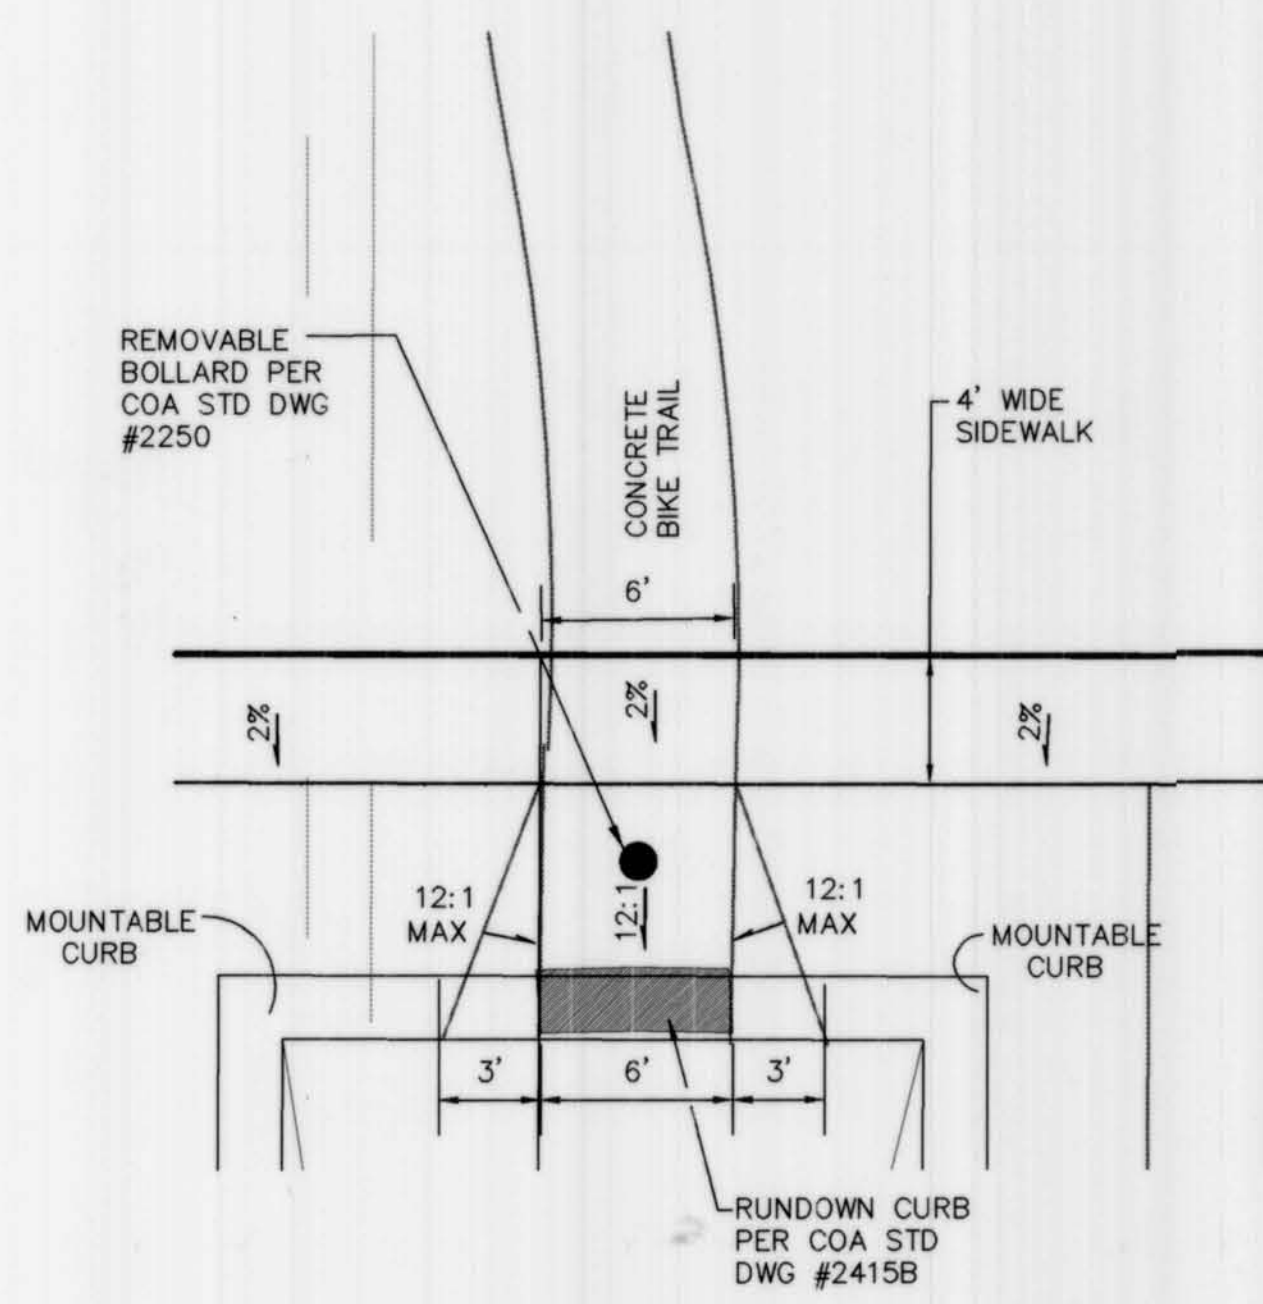

BIKE/PEDESTRIAN TRAIL RAMP DETAIL
1"=6'

NOTE:
ALL PAVING REQUIRED TO
BE PER COA STANDARD
SPECIFICATION UPDATE
NO. 7.


ISAACSON & ARFMAN, P.A.
Consulting Engineering Associates
128 Monroe Street N.E.
Albuquerque, New Mexico 87109/04
13248-PMSTR.DWG

CITY OF ALBUQUERQUE
PUBLIC WORKS DEPARTMENT
ENGINEERING GROUP

TITLE: HERITAGE AT THE TRAILS UNIT 2
PAVING DETAILS

Design Review Committee: SEP 23 2004
City Engineer Approval: OCT 4 2004
City Project No. 738482
Zone Map No. C-9-Z

AS-BUILT INFORMATION				BENCH MARKS				SURVEY INFORMATION				ENGINEER'S SEAL			
CONTRACTOR	WORK STARTED BY	DATE	NO.	AC'S MONUMENT "2-B-10" LOCATED 1 MI. ± WEST OF PARADISE BLVD. AND LA PAZ.	DATE	NO.		FIELD NOTES	DATE	NO.		REMARKS	DATE	NO.	
	INSPECTED BY	DATE		ELEVATION: 5429.35 (NGVD 1929)				ALDRICH SURVEYING	04/03			DESIGN	03/04		
	FIELD ESTIMATION BY	DATE										CHECKED BY	03/04		
	CORRECTED BY	DATE										GLD			
	RECORDED BY	DATE										RFH			
												GLD			

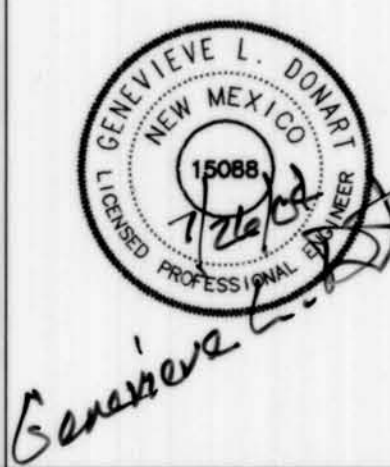

DESIGNED BY	DATE	NO.	BY	DATE	NO.
DRAWN BY	DATE	NO.	BY	DATE	NO.
CHECKED BY	DATE	NO.	BY	DATE	NO.
GLD	03/04		RFH	03/04	
GLD	03/04		GLD	03/04	

TC	FL
1	56.11
2	55.44
3	55.54
4	54.87

TC	FL
1	56.34
2	55.62
3	56.20
4	55.53

TC	FL
1	50.43
2	50.10
3	50.31
4	50.52

TC	FL
1	49.31
2	48.97
3	49.62
4	49.29

TC	FL
1	41.32
2	41.04
3	41.75
4	41.08

TC	FL
1	41.15
2	40.68
3	41.15
4	40.82

FACE OF CURB CURVE TABLE

CURVE	RADIUS	LENGTH	DELTA
FC1	30.00	50.37	96°12'19"
FC2	30.00	44.02	84°04'42"
FC3	6.00	18.85	180°00'00"
FC4	6.00	18.85	180°00'00"
FC5	25.00	38.09	87°17'18"
FC6	25.00	38.41	88°02'05"
FC7	25.00	36.24	83°03'33"
FC8	25.00	42.30	96°56'27"
FC13	194.00	167.00	49°19'19"
FC14	166.00	89.42	30°51'55"
FC15	144.00	85.98	34°12'41"

NOTE:
ALL IMPROVEMENTS IN RAINBOW BLVD.
WILL BE BUILT BY CPN #730081,
(THE TRAILS OFFSITE IMPROVEMENTS).

SCALES:
1"=40' HOR.
1"=10' VERT.

HEARTHSTONE ROAD N.W.

Elevation Datum: NGVD 29

SURVEYORS CERTIFICATION

I, Russ P. Hugg, New Mexico Professional Surveyor Number 9750,
Hereby Certify that the as-built information shown hereon is the
result of an actual field survey performed by me or under my
direct supervision and that the same is true and correct to the
best of my knowledge and belief.

Russ P. Hugg
NMPS No. 9750



STORM DRAIN INLET INFORMATION

INLET NO.	INLET TYPE	STATION* & OFFSET	TOP GR. EL.	INV. OUT
1	TYPE A	9+99.50, 14' RT	-39.78 39.02	32.80
2	TYPE A	9+99.50, 14' LT	-39.78 39.11	36.00

*STATIONING IS TO MIDPOINT OF GRATE @ FACE OF CURB

CONNECTOR PIPE INFORMATION

FROM INLET NO.	Q (CFS)	DIA. (IN)	LENGTH (FT)	SLOPE (FT/FT)
1	6.40	18"	15'	0.053
2	6.40	18"	11'	0.146


ISAACSON & ARFMAN, P.A.
Consulting Engineering Associates
128 Monroe Street N.E.
Albuquerque
13248-PV1DWGrth 07/26/04

CITY OF ALBUQUERQUE
PUBLIC WORKS DEPARTMENT
ENGINEERING GROUP

TITLE:
HERITAGE AT THE TRAILS UNIT 2
HEARTHSTONE ROAD N.W.
STA 10+00.00 TO END
PAVING & STORM DRAIN PLAN & PROFILE




City Project No. 738482 Zone Map No. C-9-Z Sheet 10 of 19

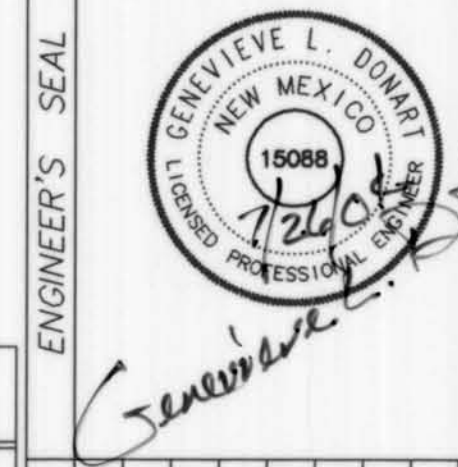

NO.	DATE	REVISIONS
1	03/04	DESIGN
2	03/04	REVISED
3	03/04	REVISED
4	03/04	REVISED

DESIGNED BY GLD DATE 03/04
DRAWN BY RPH DATE 03/04
CHECKED BY GLD DATE 03/04

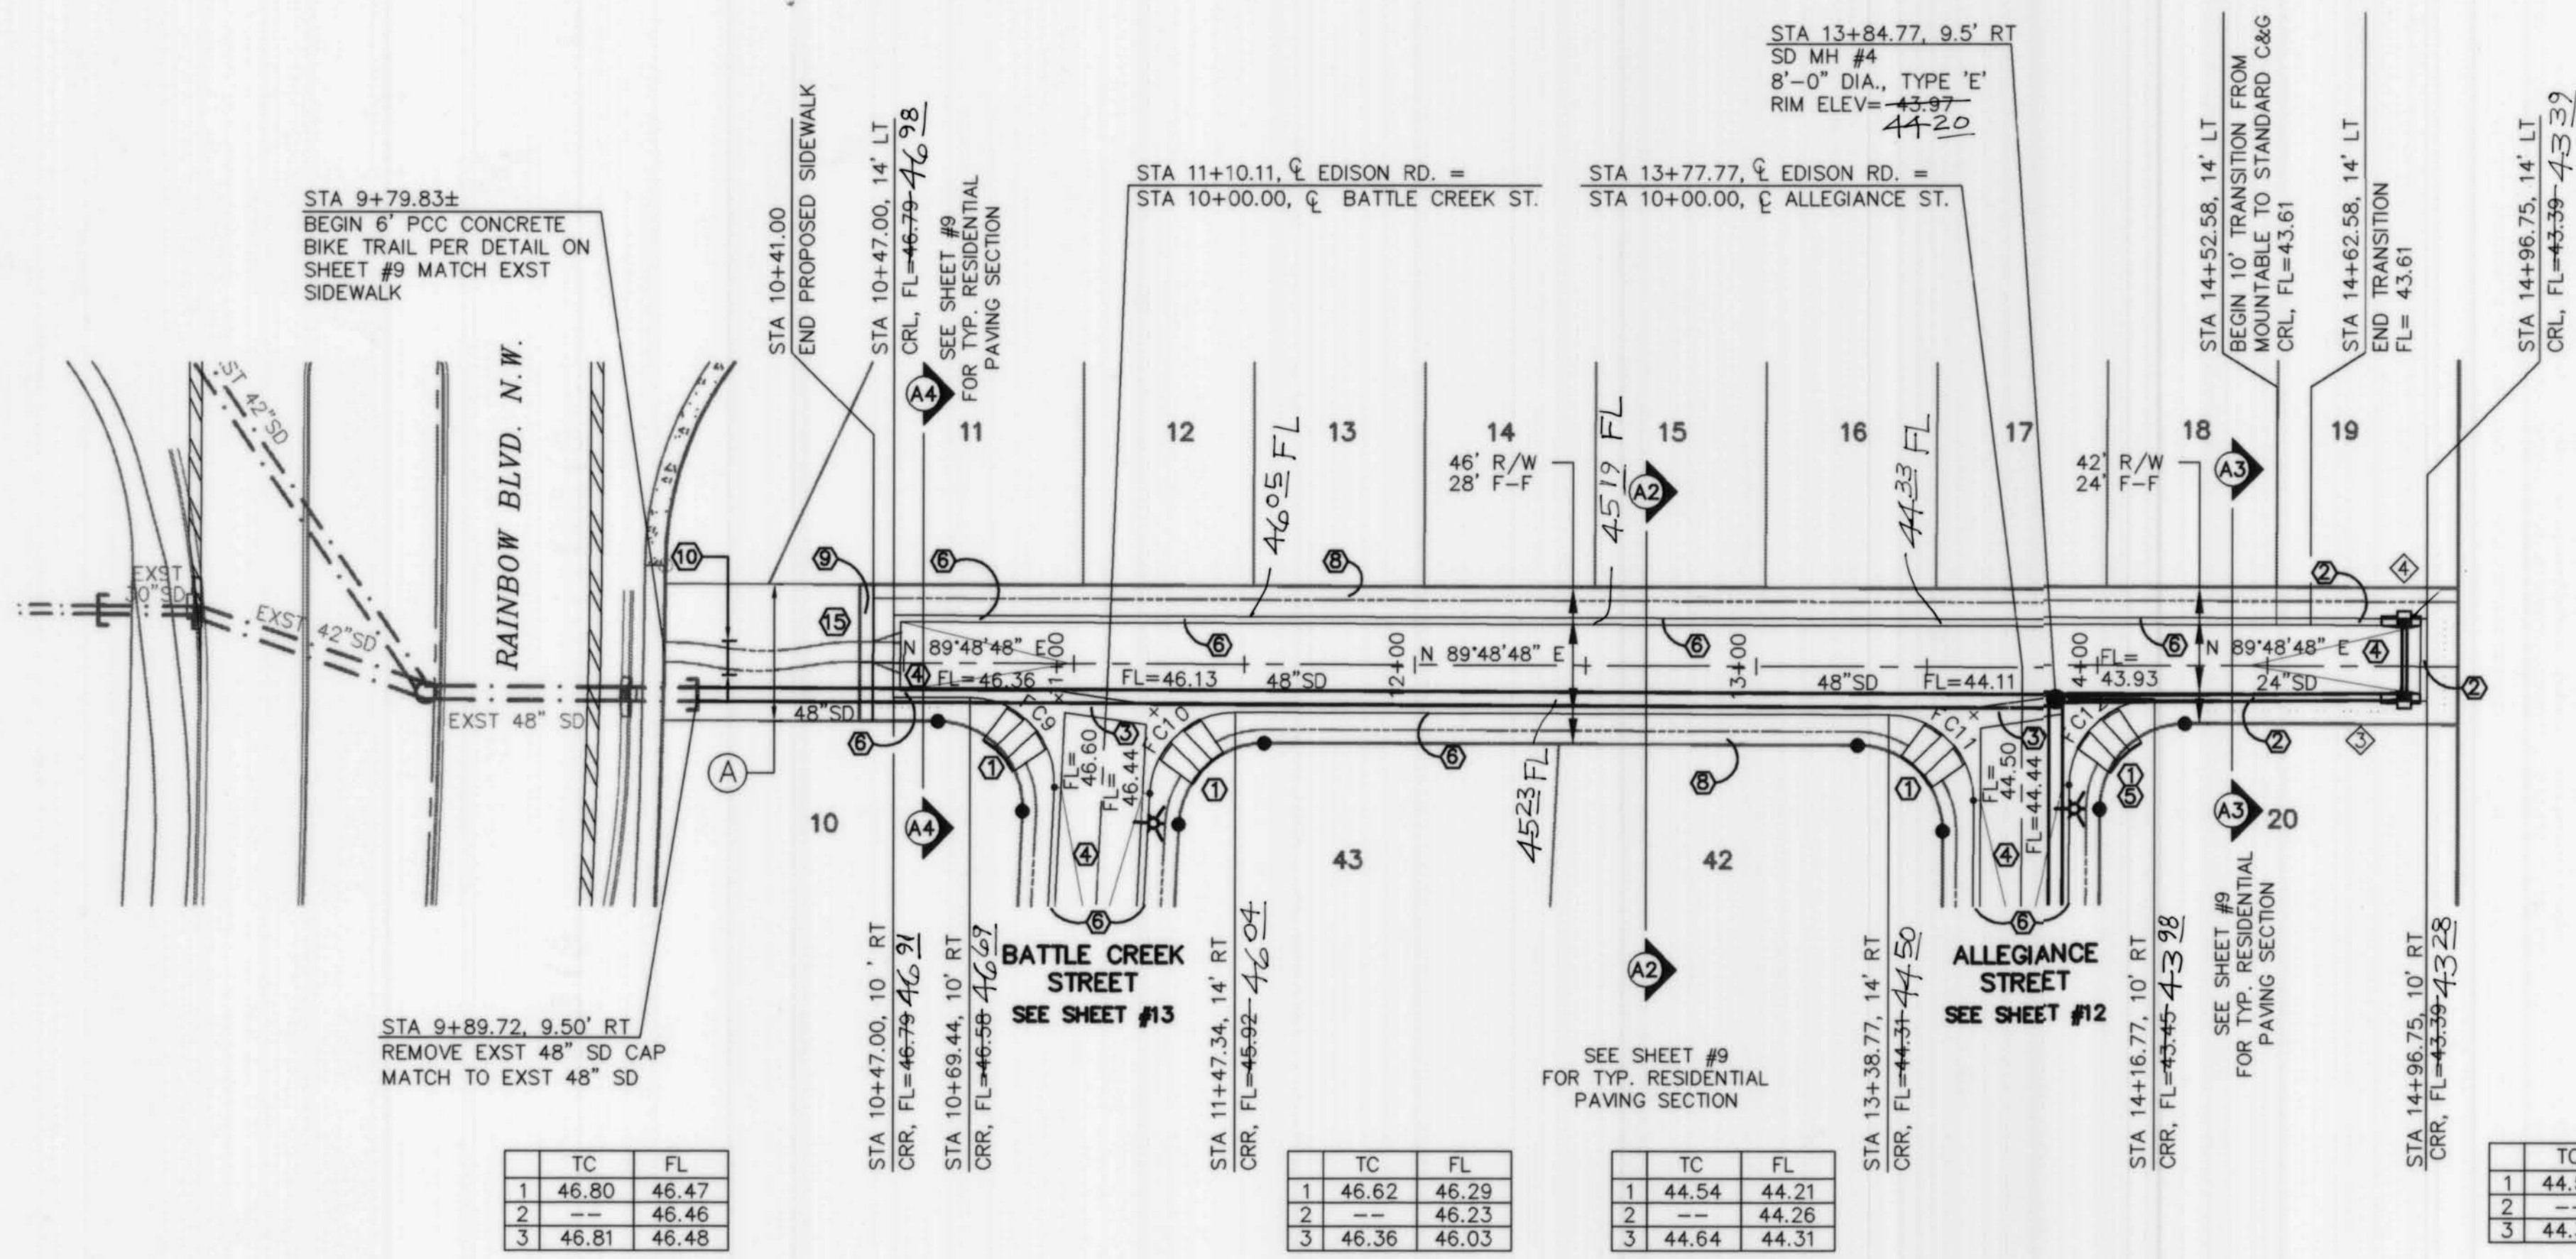

EASEMENT DATA

(A) 42' PUBLIC SANITARY SEWER, DRAINAGE AND PEDESTRIAN ACCESS EASEMENT GRANTED BY FINAL PLAT.

FACE OF CURB CURVE TABLE

CURVE	RADIUS	LENGTH	DELTA
FC9	25.00	40.43	92°39'31"
FC10	25.00	38.11	87°20'29"
FC11	25.00	39.27	90°00'00"
FC12	25.00	39.27	90°00'00"


SCALES:
1"=40' HOR.
1"=10' VERT.

Elevation Datum: NGVD 29

SURVEYORS CERTIFICATION

I, Russ P. Hugg, New Mexico Professional Surveyor Number 9750, Hereby Certify that the as-built information shown hereon is the result of an actual field survey performed by me or under my direct supervision and that the same is true and correct to the best of my knowledge and belief.

Russ P. Hugg
New Mexico
Professional Surveyor
No. 9750

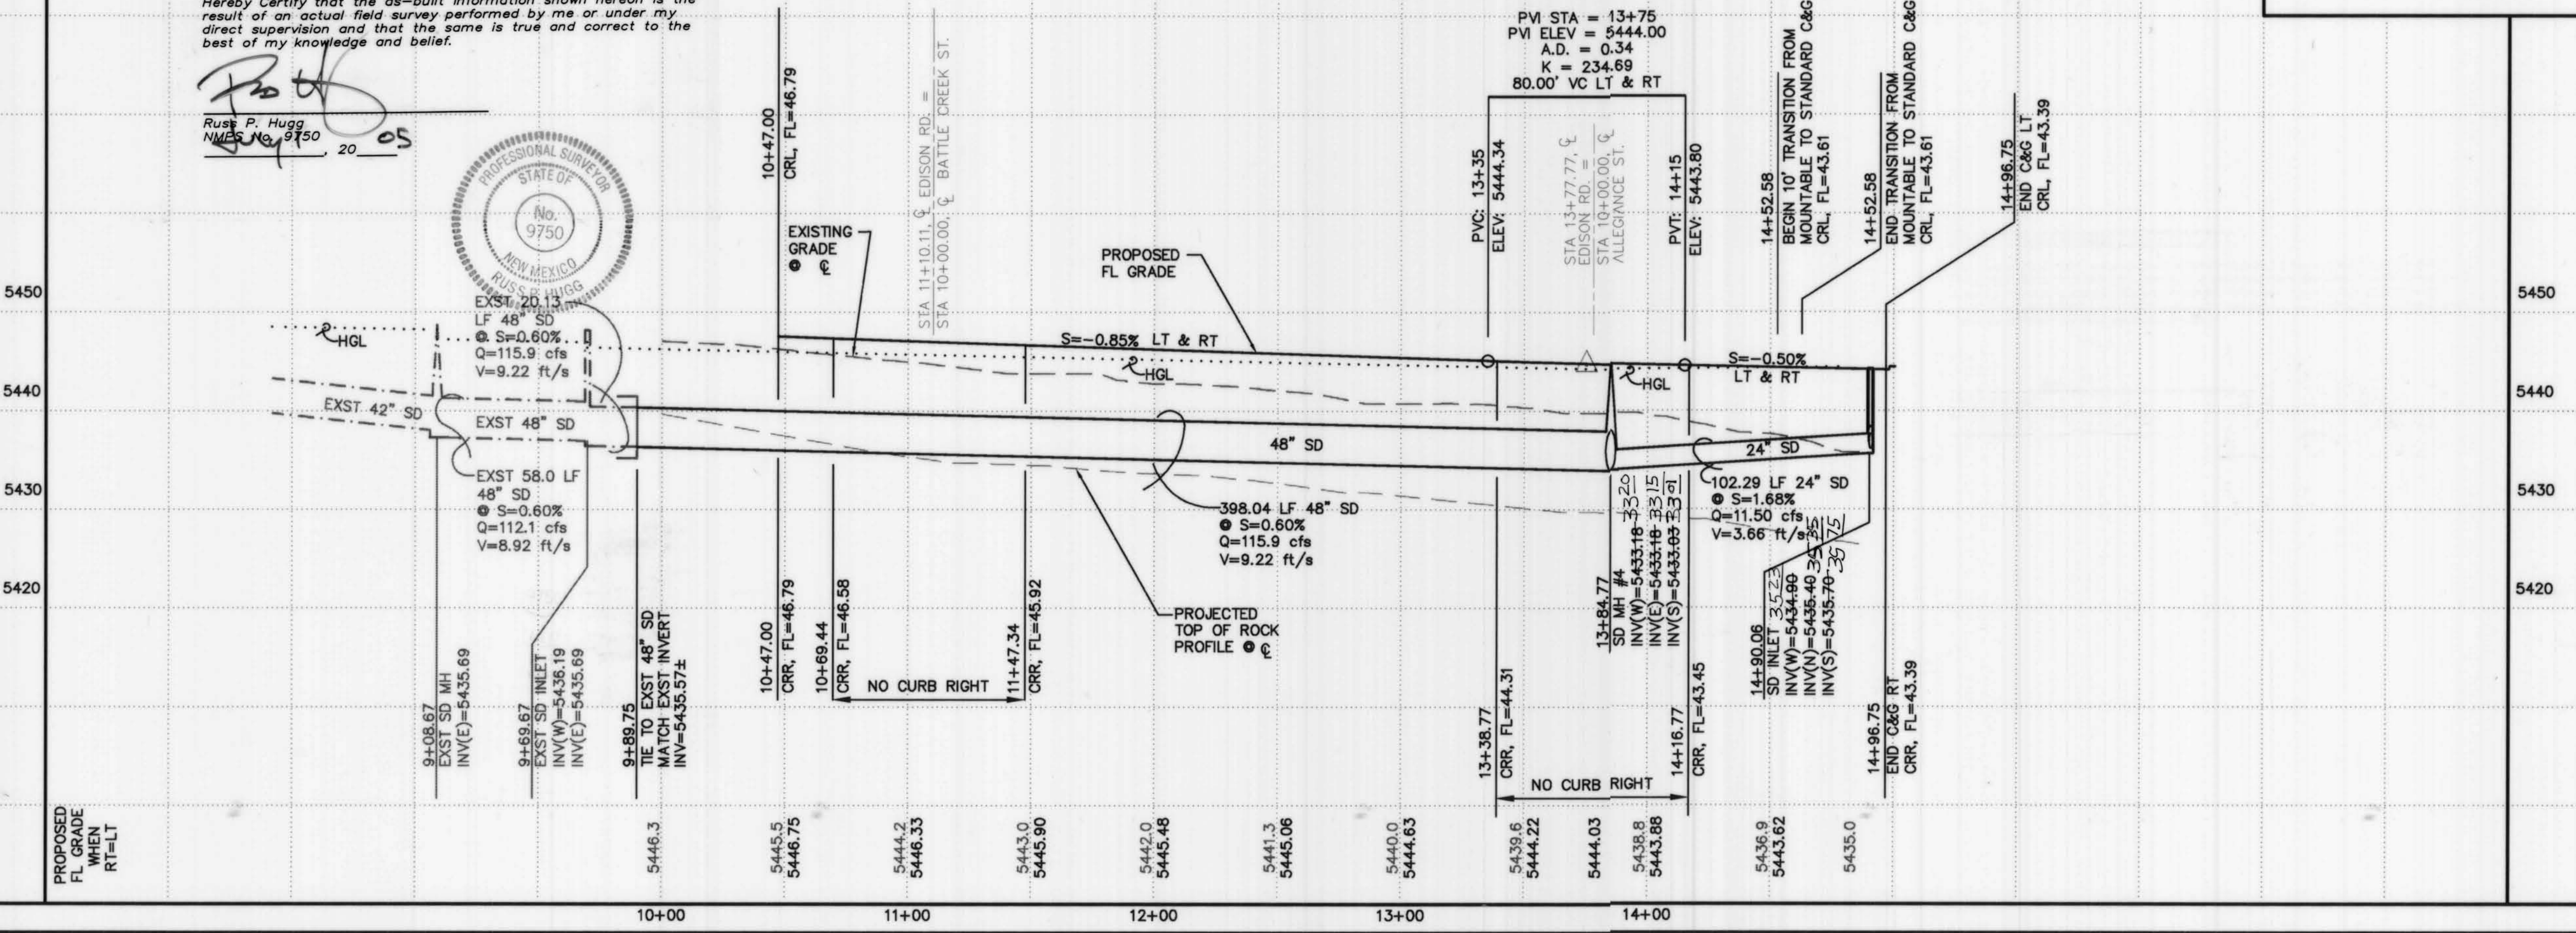

KEYED CONSTRUCTION NOTES

- CONSTRUCT HANDICAP RAMP PER COA STD DWG #2441, CASE II WITH HEADER CURB.
- STANDARD CURB & GUTTER PER COA STD DWG #2415A.
- CONSTRUCT PCC VALLEY GUTTER 6' WIDE, 1 1/2" INVERT PER COA STD DWG #2420.
- CROWN TO NO CROWN TRANSITION 50' MIN. LENGTH. PER COA STD DWG #2401.
- TRANSITION FROM MOUNTABLE TO STANDARD CURB PER COA STD DWG #2418.
- MOUNTABLE CURB & GUTTER PER COA STD DWG #2415A.
- MEDIAN CURB & GUTTER PER COA STD DWG #2415B.
- DEFERRED 4' WIDE PCC SIDEWALK PER COA STD DWG #2430.
- CONSTRUCT 4' WIDE PCC SIDEWALK PER COA STD DWG #2430.
- 6' WIDE CONCRETE BIKE TRAIL PER DETAIL SHEET #9.
- PCC PATTERNED CONCRETE PER COA STD DWG #2408 TO 10' FROM MEDIAN NOSE.
- REMOVE EXST SIDEWALK AS NEEDED. MATCH SIDEWALK TO BACK OF PROPOSED WHEELCHAIR RAMPS.
- CONSTRUCT HANDICAP RAMP PER COA STD DWG #2426.
- PAINT MEDIAN CURB AT NOSE WITH REFLECTIVE YELLOW PAINT.
- CONSTRUCT RAMP PER BIKE/PEDESTRIAN RAMP DETAIL ON SHEET 9.
- THERMOPLASTIC MARKING - LEFT ONLY ARROW.
- THERMOPLASTIC MARKING - THROUGH & RIGHT ARROW.
- THERMOPLASTIC MARKING - SOLID WHITE STRIPE.
- CAREFULLY REMOVE 108.58 LF OF EXISTING CURB & GUTTER.
- 10 LF MOUNTABLE CURB PER COA STD DWG #2415A. CENTERED ON THE R.O.W. CENTERLINE.

STORM DRAIN INLET INFORMATION

INLET NO.	INLET TYPE	STATION* & OFFSET	TOP GR. EL.	INV. OUT
3	DBL C	14+90.06, 14' LT	43.11	35.23
4	TYPE A	14+90.06, 10' RT	43.23	34.90

CONNECTOR PIPE INFORMATION

FROM INLET NO.	Q (CFS)	DIA. (IN)	LENGTH (FT)	SLOPE (FT/FT)
4	5.75	18"	21'	0.014

ISAACSON & ARFMAN, P.A.
Consulting Engineering Associates
128 Monroe Street N.E.
Albuquerque, New Mexico
1324B-PV20WGrth 07/26/04

CITY OF ALBUQUERQUE
PUBLIC WORKS DEPARTMENT
ENGINEERING GROUP

TITLE: HERITAGE AT THE TRAILS UNIT 2
EDISON ROAD
STA 10+00.00 TO END
PAVING & STORM DRAIN PLAN & PROFILE

Design Review Committee: **APPROVED** SEP 23 2004

City Engineer Approval: **APPROVED** OCT - 4 2004

City Project No. **738482** Zone Map No. **C-9-Z**

AS-BUILT INFORMATION

CONTRACTOR: **ACCS MONUMENT "2-B-10" LOCATED 1 MI. WEST OF PARADISE BLVD. AND LA PAZ.**

DATE: **04/03**

ENGINEER'S SEAL

Professional Engineer Seal for Russ P. Hugg, No. 9750, State of New Mexico.

REVISIONS


NO.	DATE	REMARKS
1	03/04	DESIGN
2	03/04	REVISIONS

DESIGNED BY: **GLD** DATE: **03/04**

DRAWN BY: **RPH** DATE: **03/04**

CHECKED BY: **GLD** DATE: **03/04**

Sheet **11** Of **19**

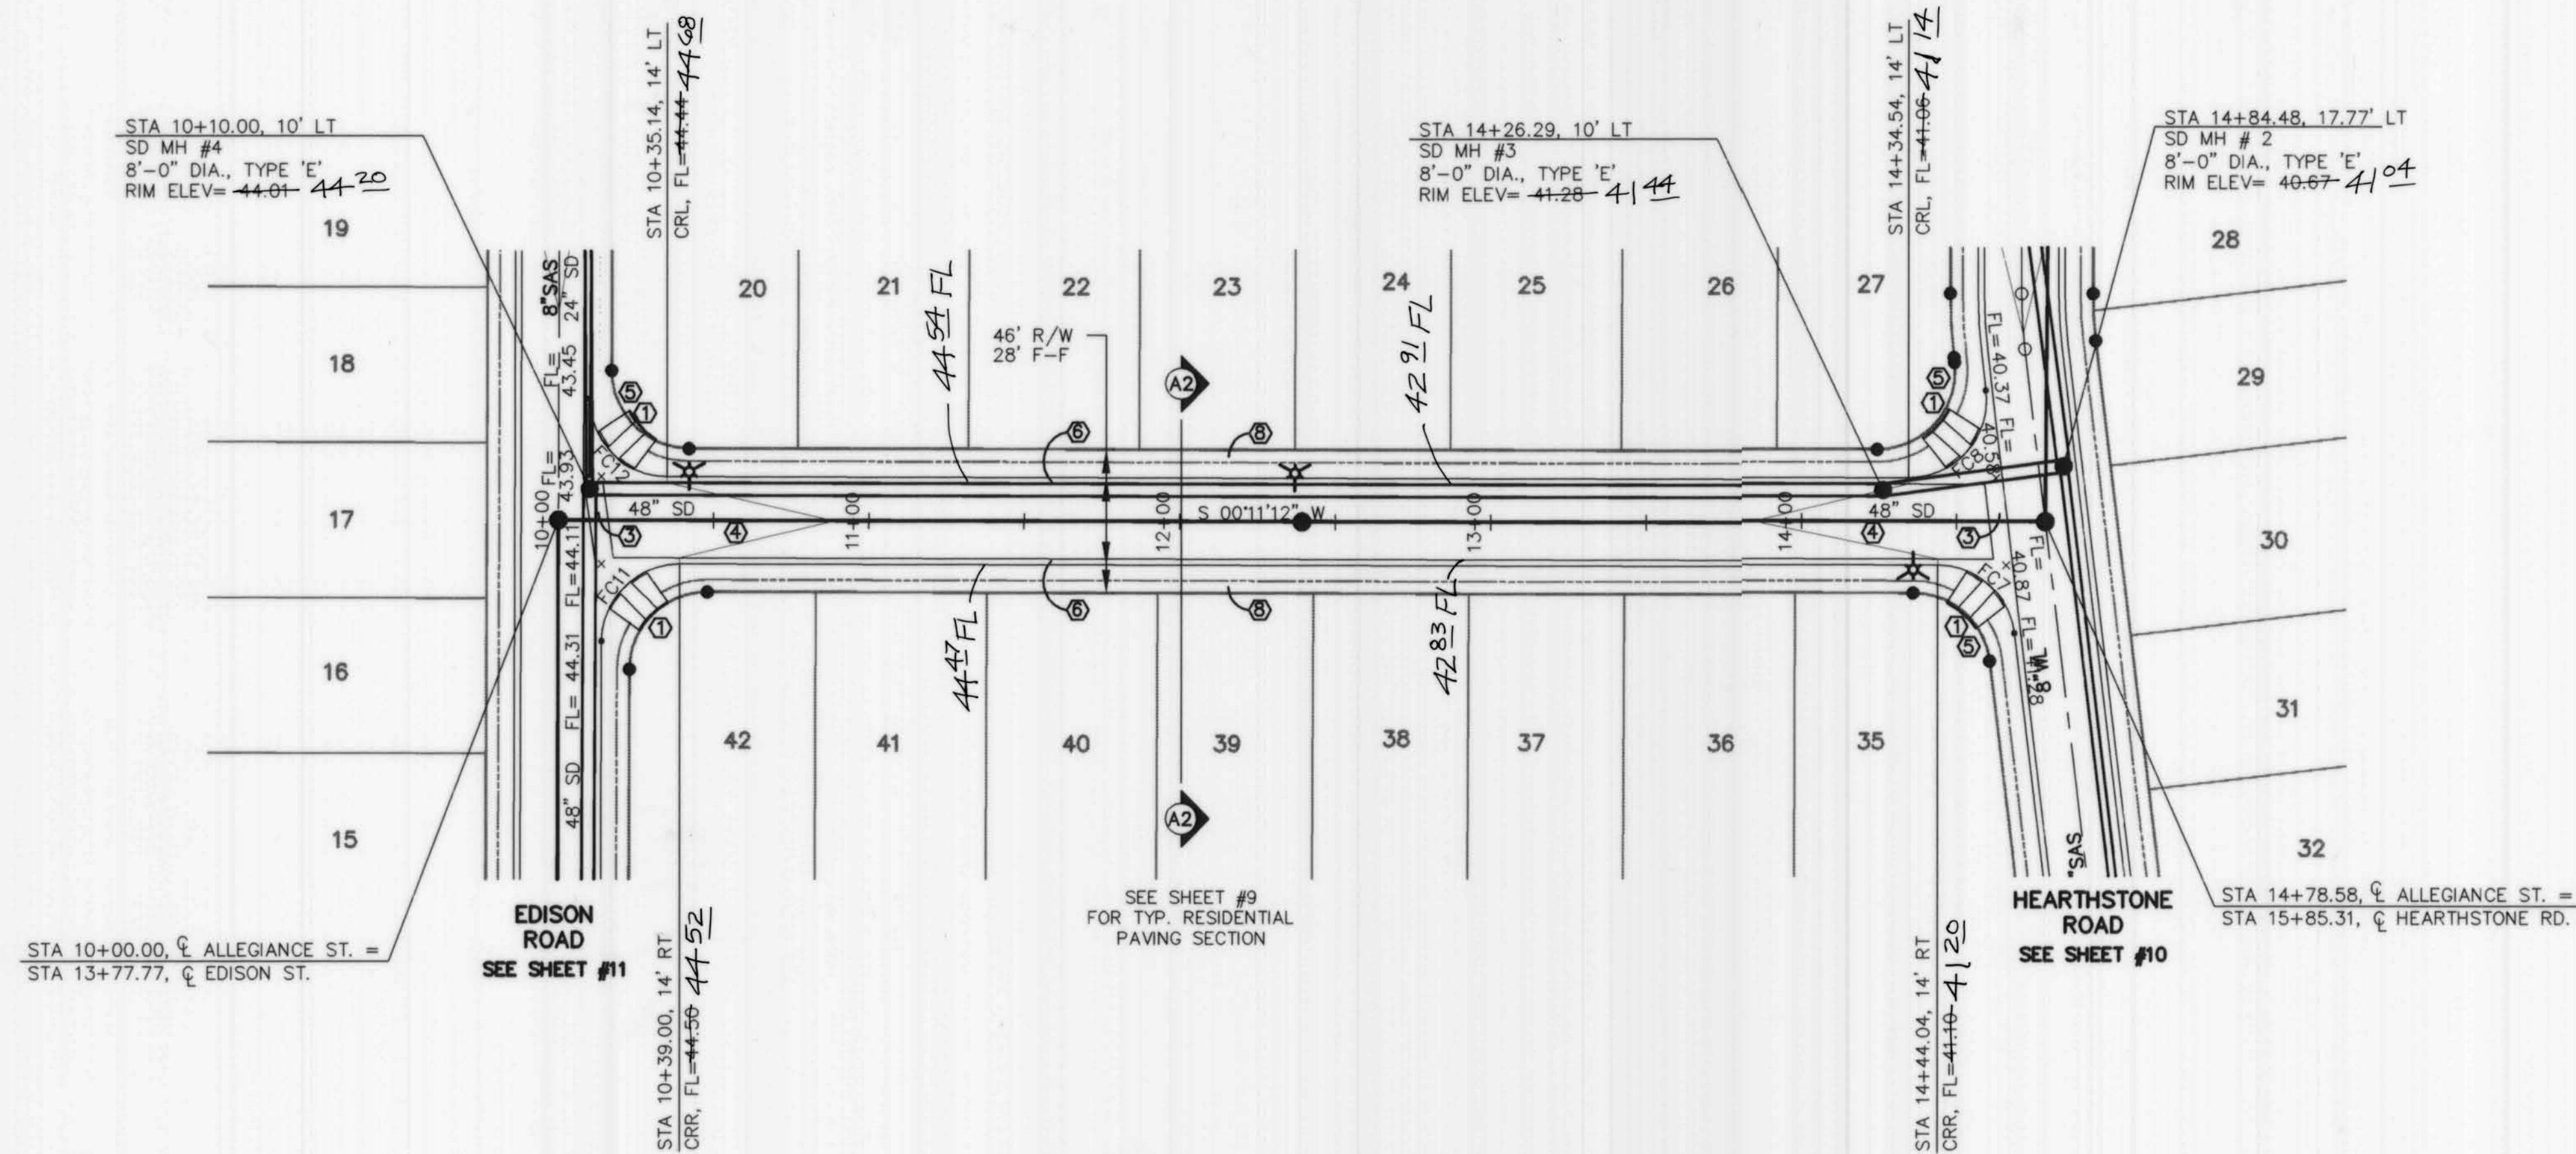

ALLEGIANCE STREET

SCALES:
1"=40' HOR.
1"=10' VERT.

Elevation Datum: NGVD 29

SURVEYORS CERTIFICATION

I, Russ P. Hugg, New Mexico Professional Surveyor Number 9750, Hereby Certify that the as-built information shown hereon is the result of an actual field survey performed by me or under my direct supervision and that the same is true and correct to the best of my knowledge and belief.

Russ P. Hugg
NMPS No. 9750



CURVE	RADIUS	LENGTH	DELTA
FC7	25.00	36.24	83°03'33"
FC8	25.00	42.30	96°56'27"
FC11	25.00	39.27	90°00'00"
FC12	25.00	39.27	90°00'00"

ISAACSON & ARFMAN, P.A.
Consulting Engineering Associates
128 Monroe Street N.E.
Albuquerque, New Mexico 87102
1324A-PV3DWGrh 07/02/04

CITY OF ALBUQUERQUE
PUBLIC WORKS DEPARTMENT
ENGINEERING GROUP

TITLE: **HERITAGE AT THE TRAILS UNIT 2
ALLEGIANCE STREET
STA 10+00.00 TO END
PAVING & STORM DRAIN PLAN & PROFILE**

DESIGN REVIEW COMMITTEE	CITY ENGINEER
DESIGNED BY: GLD	CHECKED BY: GLD
DRAWN BY: RFH	DATE: 03/04
DATE: 03/04	DATE: 03/04

City Project No. **738482** Zone Map No. **C-9-Z** Sheet **12** Of **19**

KEYED CONSTRUCTION NOTES

- CONSTRUCT HANDICAP RAMP PER COA STD DWG #2441, CASE II WITH HEADER CURB.
- STANDARD CURB & GUTTER PER COA STD DWG #2415A.
- CONSTRUCT PCC VALLEY GUTTER 6' WIDE, 1 1/2" INVERT PER COA STD DWG #2420.
- CROWN TO NO CROWN TRANSITION 50' MIN. LENGTH. PER COA STD DWG #2401.
- TRANSITION FROM MOUNTABLE TO STANDARD CURB PER COA STD DWG #2418.
- MOUNTABLE CURB & GUTTER PER COA STD DWG #2415A.
- MEDIAN CURB & GUTTER PER COA STD DWG #2415B.
- DEFERRED 4' WIDE PCC SIDEWALK PER COA STD DWG #2430.
- CONSTRUCT 4' WIDE PCC SIDEWALK PER COA STD DWG #2430.
- 6' WIDE CONCRETE BIKE TRAIL PER DETAIL SHEET #9.
- PCC PATTERNED CONCRETE PER COA STD DWG #2408 TO 10' FROM MEDIAN NOSE.
- REMOVE EXST SIDEWALK AS NEEDED, MATCH SIDEWALK TO BACK OF PROPOSED WHEELCHAIR RAMPS.
- CONSTRUCT HANDICAP RAMP PER COA STD DWG #2426.
- PAINT MEDIAN CURB AT NOSE WITH REFLECTIVE YELLOW PAINT.
- CONSTRUCT RAMP PER BIKE/PEDESTRIAN RAMP DETAIL ON SHEET 9.
- THERMOPLASTIC MARKING - LEFT ONLY ARROW.
- THERMOPLASTIC MARKING - THROUGH & RIGHT ARROW.
- THERMOPLASTIC MARKING - SOLID WHITE STRIPE.
- CAREFULLY REMOVE 108.58 LF OF EXISTING CURB & GUTTER.
- 10 LF MOUNTABLE CURB PER COA STD DWG #2415A, CENTERED ON THE R.O.W. CENTERLINE.

AS-BUILT INFORMATION	CONTRACTOR	DATE
CONTRACTOR	ISAACSON & ARFMAN, P.A.	07/02/04
INSPECTOR'S DATE	DATE	DATE
FIELD VERIFICATION BY	DATE	DATE
CONNECTED BY	DATE	DATE
MICRO-FILM INFORMATION	RECORDED BY	NO.

BENCH MARKS	FIELD NOTES
ACS MONUMENT "2-B-10" LOCATED 1 MI.± WEST OF PARADISE BLVD. AND LA PAZ. ELEVATION: 5429.35 (NGVD 1929)	ALDRICH SURVEYING 04/03

ENGINEER'S SEAL	REVISIONS
15088	DESIGNED BY: GLD
15088	DRAWN BY: RFH
15088	CHECKED BY: GLD
15088	DATE: 03/04
15088	DATE: 03/04

REMARKS	BY
REVISIONS	DESIGN

STA 10+00.00, C BATTLE CREEK ST. =
STA 11+10.11, C EDISON ROAD.

STA 10+37.23, 14' LT
CRL FL=46.44

STA 10+38.85, 14' RT
CRR FL=46.80

EDISON
ROAD
SEE SHEET #11

SEE SHEET #9
FOR TYP. RESIDENTIAL
PAVING SECTION

CURVE DATA
R=150.00'
L=89.61'
Δ=34°13'40"
CHD BRG=S 14°16'07" E

STA 15+33.51, C BATTLE CREEK ST. =
STA 13+22.38, C HEARTHSTONE RD.

HEARTHSTONE
ROAD
SEE SHEET #10

BATTLE CREEK STREET

SCALES:
1"=40' HOR.
1"=10' VERT.

Elevation Datum: NGVD 29

FACE OF CURB CURVE TABLE

CURVE	RADIUS	LENGTH	DELTA
FC5	25.00	38.09	87°17'18"
FC6	25.00	38.41	88°02'05"
FC9	25.00	40.43	92°39'31"
FC10	25.00	38.11	87°20'29"

SURVEYORS CERTIFICATION

I, Russ P. Hugg, New Mexico Professional Surveyor Number 9750, Hereby Certify that the as-built information shown hereon is the result of an actual field survey performed by me or under my direct supervision and that the same is true and correct to the best of my knowledge and belief.

Russ P. Hugg
NMPS No. 9750



ISAACSON & ARFMAN, P.A.
Consulting Engineering Associates
128 Monroe Street N.E.
Albuquerque, New Mexico
1324B-PV4DWGrh 07/02/04

CITY OF ALBUQUERQUE
PUBLIC WORKS DEPARTMENT
ENGINEERING GROUP

TITLE: HERITAGE AT THE TRAILS UNIT 2
BATTLE CREEK STREET
STA 10+00.00 TO END
PAVING & STORM DRAIN PLAN & PROFILE

Design Review Committee	City Engineer Approval	Mo./Day/Yr.
SEP 23 2004	OCT - 4 2004	
DESIGN REVIEW COMMITTEE	CITY ENGINEER	
City Project No.	Zone Map No.	Sheet
738482	C-9-Z	13

CONTRACTOR	DATE
STANDARD	DATE
INSPECTOR'S	DATE
FIELD	DATE
VERIFICATION	DATE
CORRECTION	DATE
RECORDED	DATE


AS-BUILT INFORMATION	BENCH MARKS
AC'S MONUMENT "2-B-10" LOCATED 1	
MI.± WEST OF PARADISE BLVD. AND LA PAZ	
ELEVATION: 5429.35 (NGVD 1929)	

SURVEY INFORMATION	FIELD NOTES
ALDRICH SURVEYING	04/03

ENGINEER'S SEAL	BY
GENIEVE L. DONAT	

REVISIONS	DATE	BY
DESIGN	03/04	
DRAWN	03/04	
CHECKED	03/04	

NO.	DATE	REMARKS

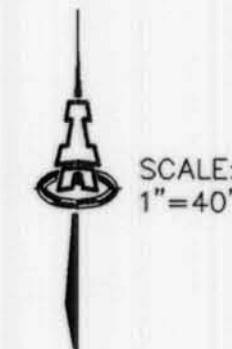

THIS TABLE IS BASED UPON THE FOLLOWING CRITERIA:

DIFFERENT CRITERIA, E.G., DUCTILE IRON PIPE, GREATER DEPTH OF BURY, ETC., WILL REQUIRE DIFFERENT RESTRAINED LENGTHS. THESE MUST BE CALCULATED BY A QUALIFIED PROFESSIONAL ENGINEER AND APPROVED BY THE PUBLIC WORKS DEPARTMENT.

UTILITY CROSSING TABLE

WATER SHUT-OFF PLAN

SHUT-OFF VALVES 1, & 2, TO PROVIDE NON-PRESSURE CONNECTION. THE CONTRACTOR SHALL CONTACT NEW MEXICO UTILITIES, INC. (898-2661) 5 WORKING DAYS PRIOR TO SHUT-OFF OR TURN-ON AT VALVES. ONLY N.M.U.I. PERSONNEL ARE ALLOWED TO OPERATE VALVES.

RESTRAINED JOINT LENGTHS, L_r ,
FOR REDUCERS, (FT.)
MINIMUM UNOBSTRUCTED, STRAIGHT-RUN LENGTH
RESTRAIN EITHER LARGE PIPE, OR SMALL PIPE.

NOTES:


1. ALL MECHANICAL JOINTS SHALL BE RESTRAINED AT THE FITTING.
2. THE CONTRACTOR SHALL PROVIDE A MINIMUM PIPE LENGTH OF 20 LF FROM ALL MECHANICAL JOINTS. ALL PIPE JOINTS WITHIN 20 LF OF A MECHANICAL JOINT SHALL BE RESTRAINED AT THE CONTRACTOR'S EXPENSE.
3. THE CONTRACTOR SHALL RESTRAIN ALL PIPE JOINTS IN THE SPECIFIED DISTANCE LISTED IN THE TABLE ON THIS SHEET.
4. THE CONTRACTOR SHALL RESTRAIN ALL FIRE HYDRANT JOINTS FROM THE TEE ON THE MAIN TO THE FIRE HYDRANT FLANGE.
5. CONCRETE BLOCKING IS STILL REQUIRED FOR SOME FITTINGS AS REQUIRED BY THE NEW MEXICO UTILITIES, INC. STANDARD SPECIFICATIONS.

	SINGLE WATER METER & BOX
	DOUBLE WATER METER & BOX
	GATE VALVE W/ VALVE BOX
	FIRE HYDRANT
	WATER LINE W/ FITTING
	STORM DRAIN CATCH BASIN
	STORM DRAIN MANHOLE
	EXISTING SAS MANHOLE
	PROPOSED SAS MANHOLE

NOTE:
ALL IMPROVEMENTS IN RAINBOW BLVD.
WILL BE BUILT BY CPN #730081,
(THE TRAILS OFFSITE IMPROVEMENTS).

APPROVED FOR WATER AND
SANITARY SEWER CONSTRUCTION.

(for NEW MEXICO UTILITIES, INC.) DATE 7-15-01

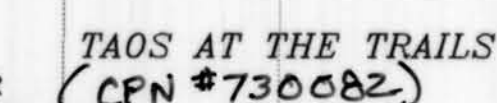

25' PUBLIC WATER
LINE AND SANITARY
SEWER EASEMENT
2004099011
BK-A80 Pg 8753
09-15-2004

OS-2
OPEN SPACE
2.0903 AC.
FILED: DECEMBER 15, 2003
(Bk-2003C;Pg-375)

MATCHLINE SEE RIGHT


ISAACSON & ARFMAN, P.A.
Consulting Engineering Associates
128 Monroe Street N.E.
Albuquerque, New Mexico
1324B-UMSTR.DWGrth 07/06/04

CITY OF ALBUQUERQUE
PUBLIC WORKS DEPARTMENT
ENGINEERING GROUP

TITLE: HERITAGE AT THE TRAILS UNIT 2
MASTER UTILITY PLAN

	Mo./Day/Yr.	Mo./Day/Yr.
Design Review Committee	Sep 23 2004	OCT - 4 2004
CITY ENGINEER Approval		
Last Design Update		

City Project No.	738482	Zone Map No.	C-9-Z	Sheet	14	Of	19
------------------	--------	--------------	-------	-------	----	----	----

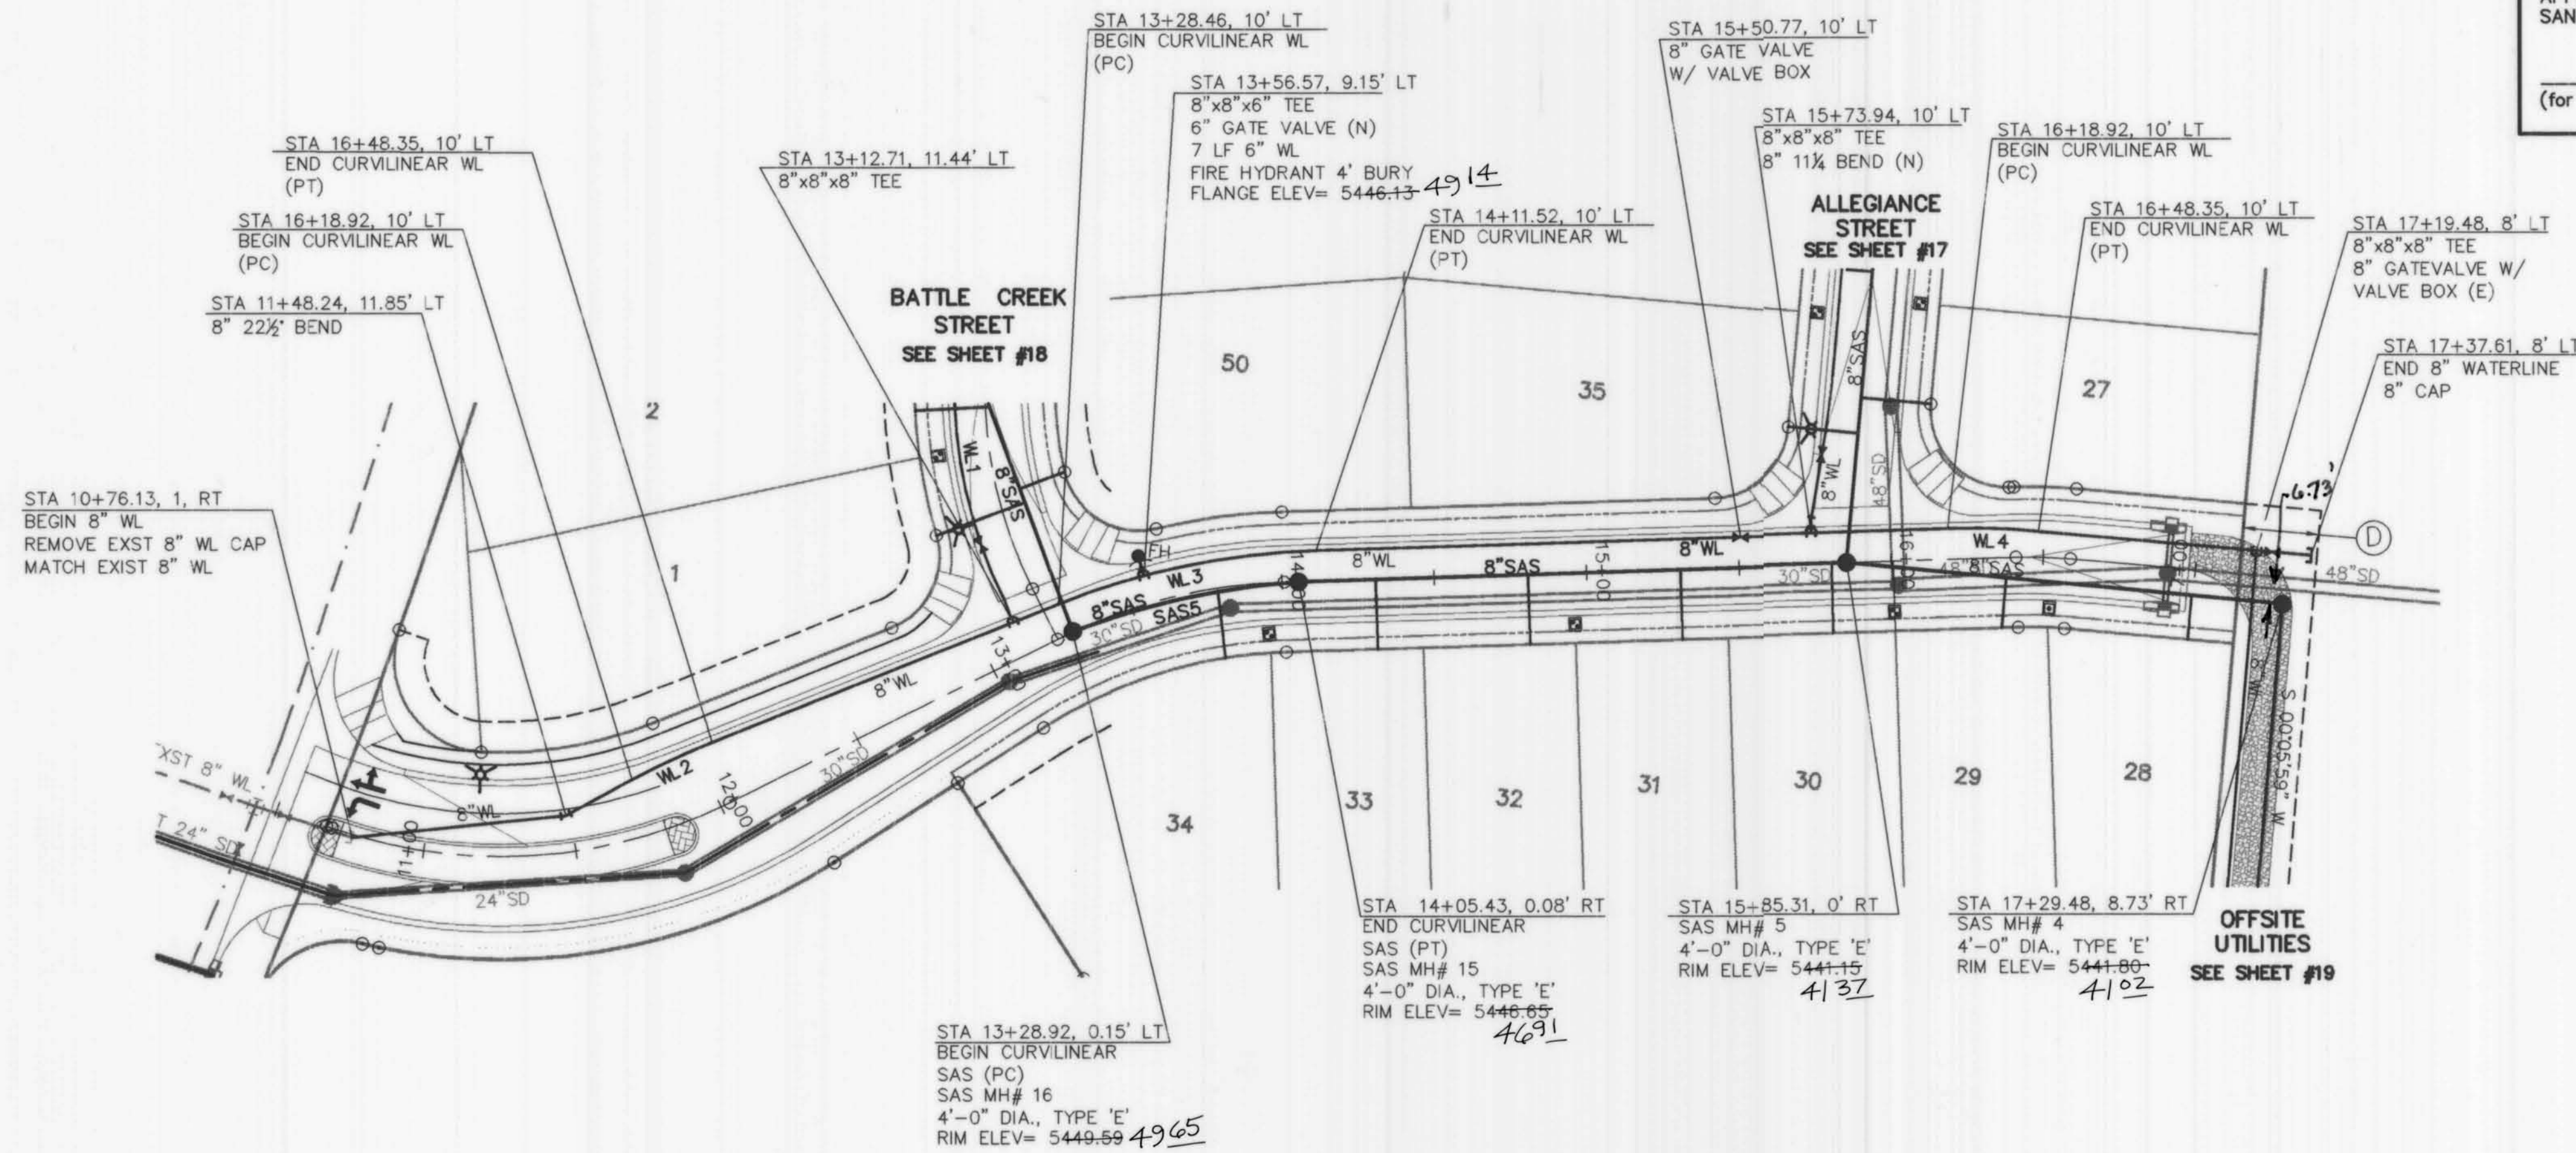

APPROVED FOR WATER AND
SANITARY SEWER CONSTRUCTION.
[Signature] 7-16-04
(for NEW MEXICO UTILITIES, INC.) DATE

- GENERAL NOTES**
- CONSTRUCT SAS SERVICES PER NMUI STANDARD SPECS.
 - CONSTRUCT ALL SINGLE & DOUBLE WATER SERVICES PER NMUI STANDARD SPECS, EXHIBITS A, B, C, & D.
 - SEE SHEET #14 FOR WATER SHUT-OFF PLAN.
 - SEE SHEET #14 FOR RESTRAINED JOINT LENGTHS FOR WATER LINE FITTINGS.
 - CONSTRUCT FIRE HYDRANTS PER DESIGNATED DEPTHS & LENGTHS PER COA STD DWG #2340 AND NMUI STANDARD SPECS.
 - INSTALL VALVE RING & COVER PER COA STD DWG #2328 AND NMUI STANDARD SPECS.
 - INSTALL A CONCRETE COLLAR AROUND ALL SAS MH RIMS AND VALVE BOXES PER NMUI STANDARD SPECS.

- LEGEND**
- SINGLE WATER METER & BOX
 - DOUBLE WATER METER & BOX
 - GATE VALVE W/ VALVE BOX
 - FIRE HYDRANT
 - SAS MANHOLE
 - WATER LINE W/ FITTING

UTILITY SERVICE TABLE

LOT NO.	STATION		SAS INV @ R/W
	WATER, LENGTH	SAS, LENGTH	
28	16+52.48, 10'(S)	16+99.48, 16'	35.28*
29	16+35.66, 17'	16+35.66, 17'	35.69*
30	16+00.72, 9'	15+80.31, 23'	36.06*
31	15+30.72, 23'	15+30.72, 23'	37.11*
32	14+95.72, 9'	14+80.72, 23'	38.86*
33	14+30.72, 23'	14+30.72, 23'	40.76
34	13+94.99, 9'	13+77.78, 22'	42.77

ALL WATER SERVICES ARE DOUBLE EXCEPT WHERE NOTED AS (S) SINGLE.
* INSTALL SAS SERVICE RISERS

UTILITY CURVE TABLE

CURVE	RADIUS	LENGTH	DELTA	CHD BRG
WL1	160.00	94.53	33°51'04"	S 14°04'49" E
WL2	250.00	29.11	6°40'20"	S 60°00'11" W
WL3	250.00	86.86	19°54'25"	S 73°17'33" W
WL4	250.00	29.90	6°51'13"	S 86°40'22" W
SAS5	297.69	71.55	13°46'18"	S 71°56'04" W

EASEMENT DATA

(D) 25' PUBLIC WATER & SANITARY SEWER EASEMENT GRANTED BY

ISAACSON & ARFMAN, P.A.
Consulting Engineering Associates
128 Monroe Street N.E.
Albuquerque, New Mexico
13248-UTL10DWGrth 07/06/04

CITY OF ALBUQUERQUE
PUBLIC WORKS DEPARTMENT
ENGINEERING GROUP

TITLE: HERITAGE AT THE TRAILS UNIT 2
HEARTHSTONE TRAIL ROAD
STA 10+00.00 TO END
UTILITY PLAN & PROFILE

Design-Review-Committee APPROVED SEP 23 2004
City Engineer Approval APPROVED OCT - 4 2004
Last Design Update


City Project No. 738482 Zone Map No. C-9-Z Sheet 15 Of 19

SURVEYORS CERTIFICATION

I, Russ P. Hugg, New Mexico Professional Surveyor Number 9750, Hereby Certify that the as-built information shown hereon is the result of an actual field survey performed by me or under my direct supervision and that the same is true and correct to the best of my knowledge and belief.

[Signature]
Russ P. Hugg
NMPS No. 9750
July 1, 2005

PROFESSIONAL SURVEYOR
STATE OF NEW MEXICO
No. 9750
RUSS P. HUGG

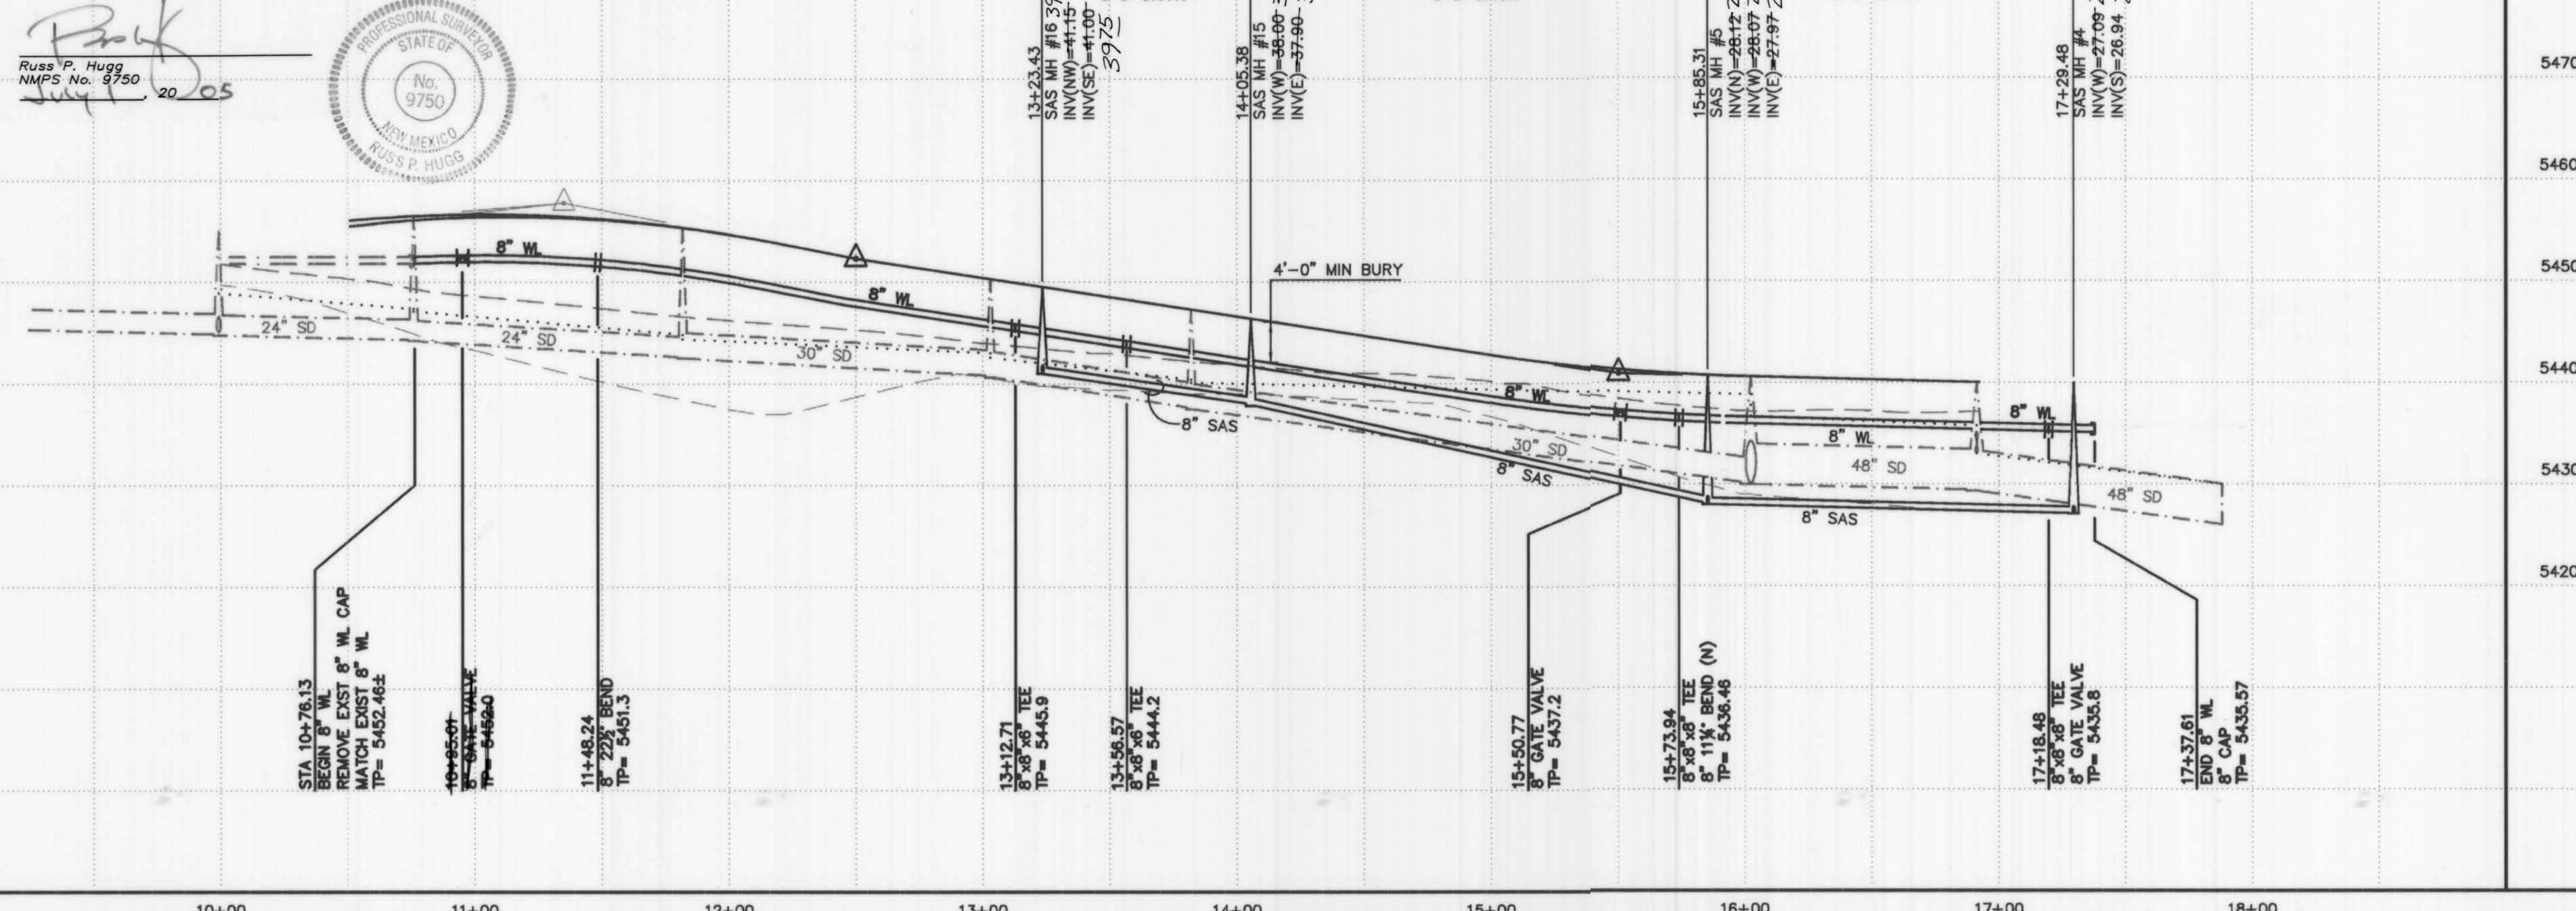

Elevation Datum: NGVD 29

SCALES:
1"=40' HOR.
1"=10' VERT.

AS-BUILT INFORMATION

CONTRACTOR: SURVITEK DATE: 07/06/04

INSPECTOR: SURVITEK DATE: 07/06/04

ACCEPTANCE: SURVITEK DATE: 07/06/04

REVISIONS

NO.	DATE	REMARKS
1	07/06/04	DESIGN
2	07/06/04	DESIGN
3	07/06/04	DESIGN
4	07/06/04	DESIGN
5	07/06/04	DESIGN
6	07/06/04	DESIGN
7	07/06/04	DESIGN
8	07/06/04	DESIGN
9	07/06/04	DESIGN
10	07/06/04	DESIGN

ENGINEER'S SEAL

GENEVEVE L. DONAT
NEW MEXICO
15088
7/15/04
PROFESSIONAL ENGINEER

7-K-04

1. CONSTRUCT SAS SERVICES PER NMUI STANDARD SPECS.
2. CONSTRUCT ALL SINGLE & DOUBLE WATER SERVICES PER NMUI STANDARD SPECS, EXHIBITS A, B, C, & D.
3. SEE SHEET #14 FOR WATER SHUT-OFF PLAN.
4. SEE SHEET #14 FOR RESTRAINED JOINT LENGTHS FOR WATER LINE FITTINGS.
5. CONSTRUCT FIRE HYDRANTS PER DESIGNATED DEPTHS & LENGTHS PER COA STD DWG #2340 AND NMUI STANDARD SPECS.
6. INSTALL VALVE RING & COVER PER COA STD DWG #2328 AND NMUI STANDARD SPECS.
7. INSTALL A CONCRETE COLLAR AROUND ALL SAS MH RIMS AND VALVE BOXES PER NMUI STANDARD SPECS.

	SINGLE WATER METER & BOX
	DOUBLE WATER METER & BOX
	GATE VALVE W/ VALVE BOX
	FIRE HYDRANT
	SAS MANHOLE
	WATER LINE W/ FITTING

LOT NO.	STATION		SAS INV @ R/W
	WATER, LENGTH	SAS, LENGTH	
11	11+02.58, 7'	10+87.58, 23'	41.76*
12		11+37.58, 23'	41.34*
13		11+87.58, 23'	40.91*
14		12+37.58, 23'	40.49*
15	13+02.58, 7'	12+87.58, 23'	40.07*
16		13+37.58, 23'	39.65*
17	14+02.58, 7'	13+87.58, 23'	39.28*
18		14+22.58, 23'	39.09*
19		14+52.58, 7'(S)	14+67.58, 23'

* INSTALL SAS SERVICE RISERS

[illegible]


ISAACSON & ARFMAN, P.A.
Consulting Engineering Associates
128 Monroe Street N.E.
Albuquerque New Mexico
1324B-UTL2DWGrfh 07/06/04

CITY OF ALBUQUERQUE
PUBLIC WORKS DEPARTMENT
ENGINEERING GROUP

HERITAGE AT THE TRAILS UNIT 2
EDISON ROAD
STA 9+50.00 TO END
UTILITY PLAN & PROFILE

Design Review Committee		City Engineer Approval		Mo./Day/Yr.	Mo./Day/Yr.
APPROVE SEP 23 2004 DESIGN REVIEW COMMITTEE	APPROVE OCT - 4 2004 CITY ENGINEER	Last Design Update			


City Project No.	738482	Zone Map No.	C-9-Z	Sheet	16	Of	19
------------------	--------	--------------	-------	-------	----	----	----

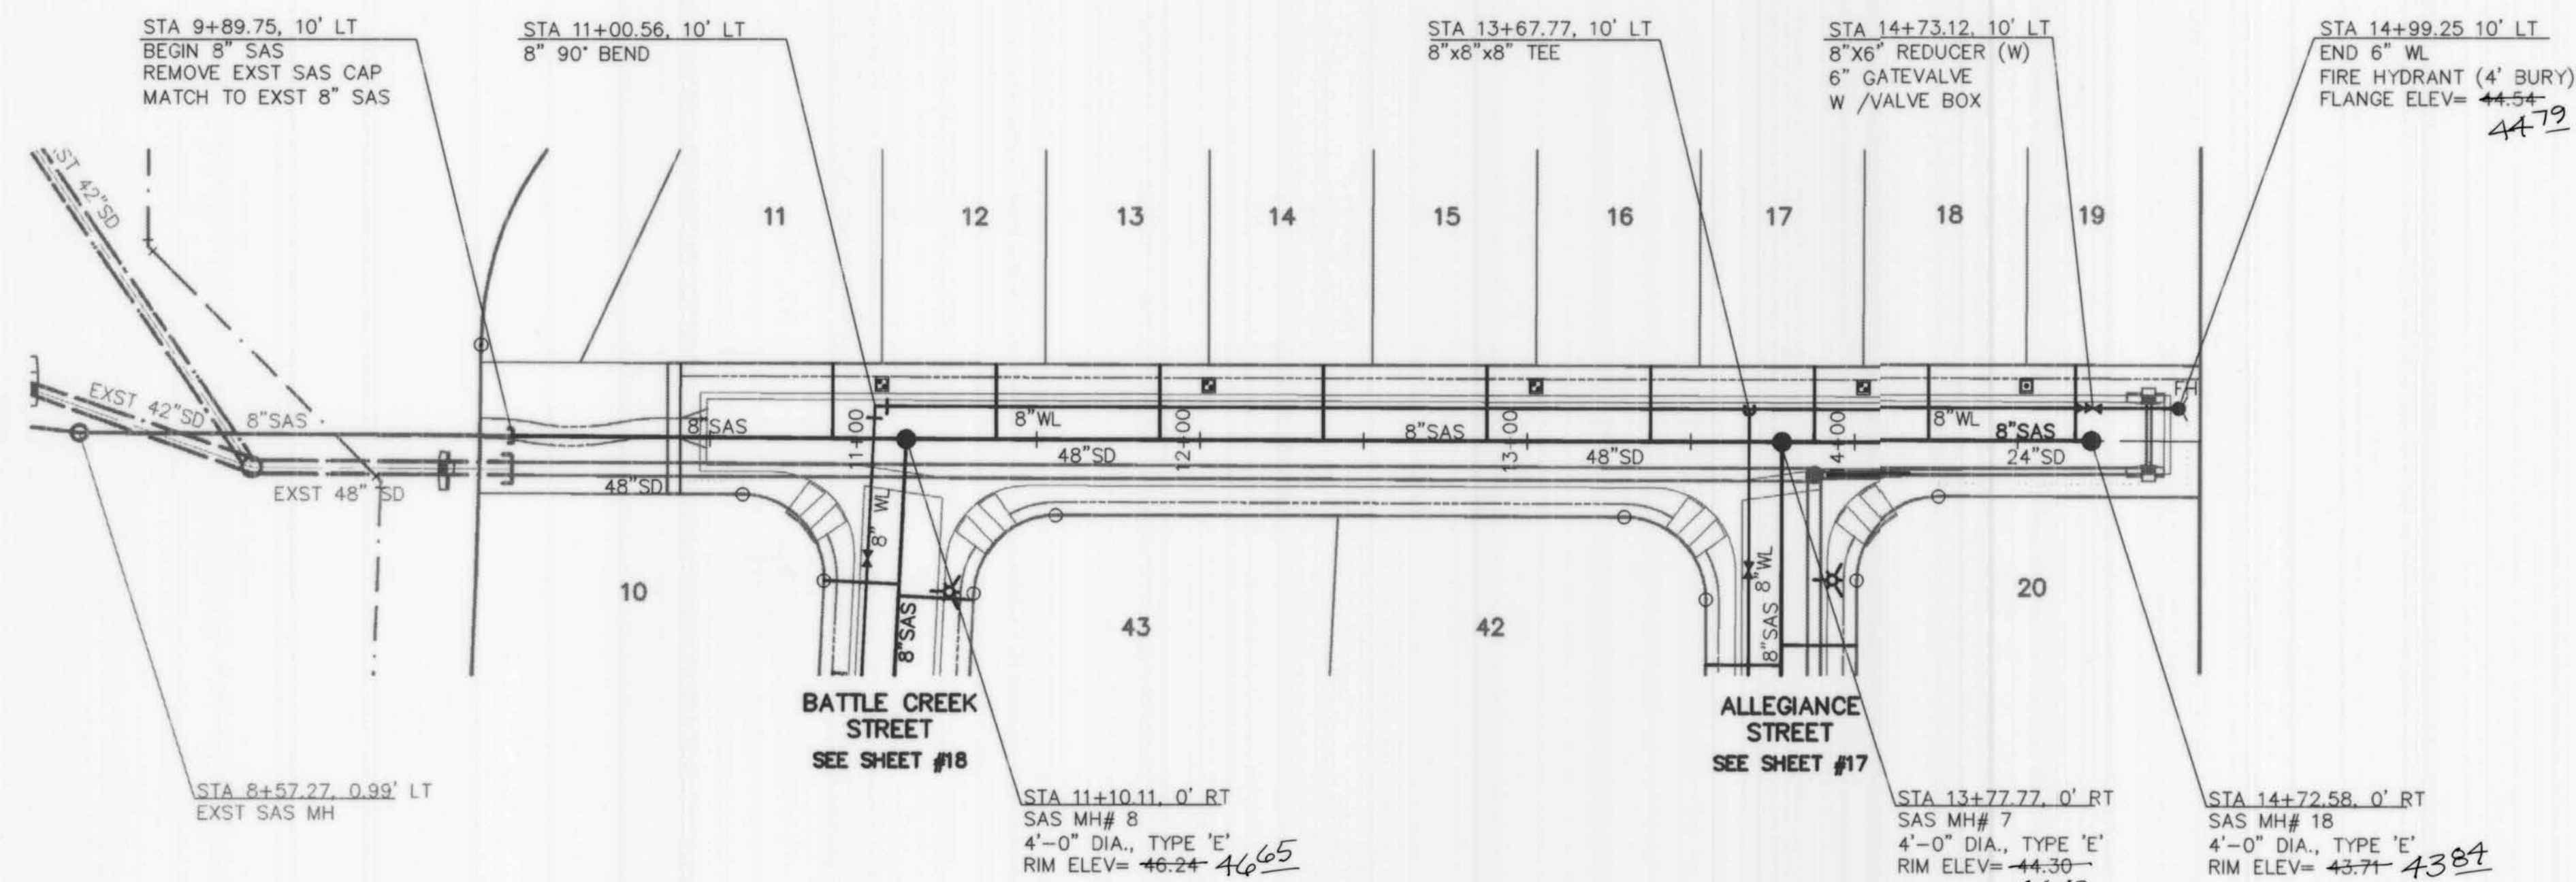

NOTE:
ALL IMPROVEMENTS IN RAINBOW BLVD.
WILL BE BUILT BY CPN #730081,
(THE TRAILS OFFSITE IMPROVEMENTS).

SCALES:
1"=40' HOR.
1"=10' VERT.

Elevation Datum: NGVD 29

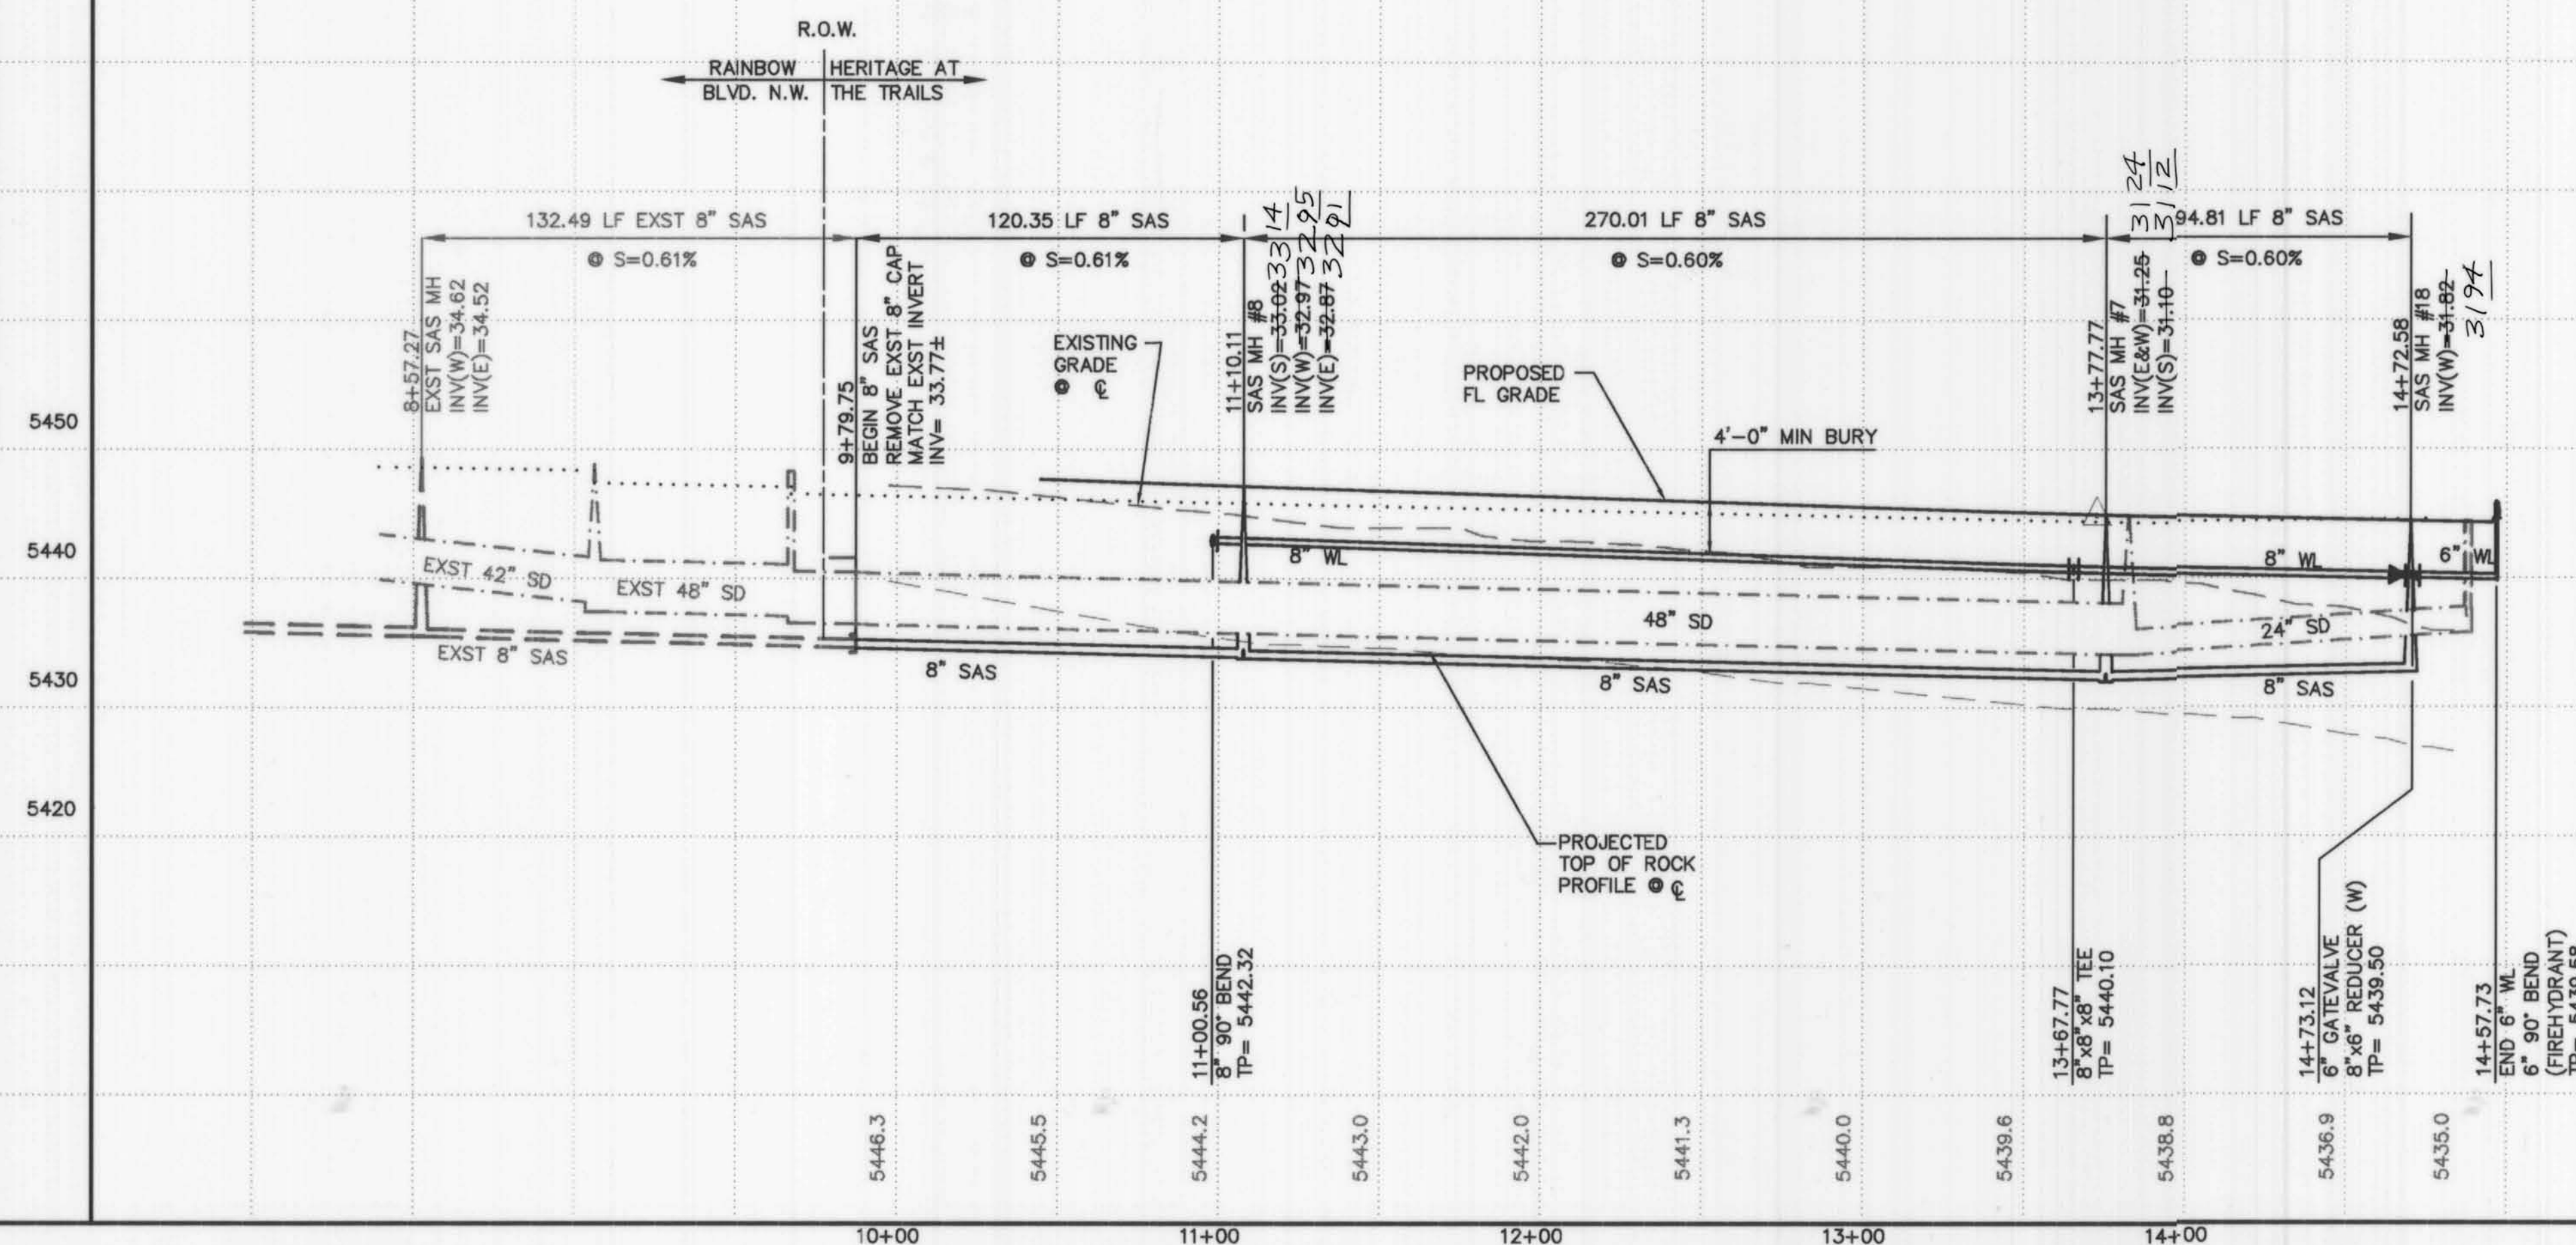

SURVEYORS CERTIFICATION

I, Russ P. Hugg, New Mexico Professional Surveyor Number 9750,
 Hereby Certify that the as-built information shown hereon is the
 result of an actual field survey performed by me or under my
 direct supervision and that the same is true and correct to the
 best of my knowledge and belief.

Russ P. Hugg
NMPS No. 9750
July 1



APPROVED FOR WATER AND
SANITARY SEWER CONSTRUCTION.
[Signature] 7-16-04
(for NEW MEXICO UTILITIES, INC.) DATE

GENERAL NOTES

1. CONSTRUCT SAS SERVICES PER NMUI STANDARD SPECS.
2. CONSTRUCT ALL SINGLE & DOUBLE WATER SERVICES PER NMUI STANDARD SPECS, EXHIBITS A, B, C, & D.
3. SEE SHEET #14 FOR WATER SHUT-OFF PLAN.
4. SEE SHEET #14 FOR RESTRAINED JOINT LENGTHS FOR WATER LINE FITTINGS.
5. CONSTRUCT FIRE HYDRANTS PER DESIGNATED DEPTHS & LENGTHS PER COA STD DWG #2340 AND NMUI STANDARD SPECS.
6. INSTALL VALVE RING & COVER PER COA STD DWG #2328 AND NMUI STANDARD SPECS.
7. INSTALL A CONCRETE COLLAR AROUND ALL SAS MH RIMS AND VALVE BOXES PER NMUI STANDARD SPECS.

LEGEND

- SINGLE WATER METER & BOX
- DOUBLE WATER METER & BOX
- GATE VALVE W/ VALVE BOX
- FIRE HYDRANT
- SAS MANHOLE
- WATER LINE W/ FITTING

UTILITY SERVICE TABLE

LOT NO.	STATION		SAS INV @ R/W
	WATER, LENGTH	SAS, LENGTH	
20	10+77.00, 7'	10+62.00, 23'	40.1*
21	11+17.00, 23'	11+72.00, 23'	39.9*
22	11+87.00, 7'	12+22.00, 23'	38.8*
23	12+87.00, 7'	13+25.00, 23'	37.7*
24	13+92.00, 7'	14+24.38, 23'	36.6*
25	13+98.00, 27'	13+83.00, 23'	37.1*
26	12+93.00, 27'	12+78.00, 23'	38.2*
27	11+93.00, 27'	12+28.00, 23'	38.7*
28	10+83.00, 27'	11+23.00, 23'	39.8*
29	10+68.00, 23'	10+62.00, 23'	40.1*

ALL WATER SERVICES ARE DOUBLE EXCEPT WHERE NOTED AS (S) SINGLE.
* INSTALL SAS SERVICE RISERS

ISAACSON & ARFMAN, P.A.
Consulting Engineering Associates
128 Monroe Street N.E.
Albuquerque, New Mexico
13248-UTL3DWGrth 07/09/04

CITY OF ALBUQUERQUE
PUBLIC WORKS DEPARTMENT
ENGINEERING GROUP

TITLE: HERITAGE AT THE TRAILS UNIT 2
ALLEGIANE STREET
STA 10+00.00 TO END
UTILITY PLAN & PROFILE

Design Review Committee	City Engineer Approval	Ms./Day/yr.	Ms./Day/yr.
City Project No. 738482	Zone Map No. C-9-Z	Sheet 17	Of 19

AS-BUILT INFORMATION				BENCH MARKS				SURVEY INFORMATION			
CONTRACTOR	WORK STATIONED BY	DATE	DATE	ACCS MONUMENT "2-B-10" LOCATED 1 MI. ± WEST OF PARADISE BLVD. AND LA PAZ.	ELEVATION: 5429.35 (NGVD 1929)	FIELD SURVEYING	04/03	ALDRICH SURVEYING	04/03		
BY SURUTER	DATE 02/06/05	DATE 02/06/05	DATE 02/06/05								
BY SURUTER	DATE 02/06/05	DATE 02/06/05	DATE 02/06/05								
BY SURUTER	DATE 02/06/05	DATE 02/06/05	DATE 02/06/05								




NO.	DATE	REVISIONS	BY
		DESIGN	
		GLD	03/04
		RPH	03/04
		GLD	03/04

SURVEYORS CERTIFICATION

I, Russ P. Hugg, New Mexico Professional Surveyor Number 9750, Hereby Certify that the as-built information shown hereon is the result of an actual field survey performed by me or under my direct supervision and that the same is true and correct to the best of my knowledge and belief.


[Signature]
Russ P. Hugg
NMPS No. 9750
July 1, 2005

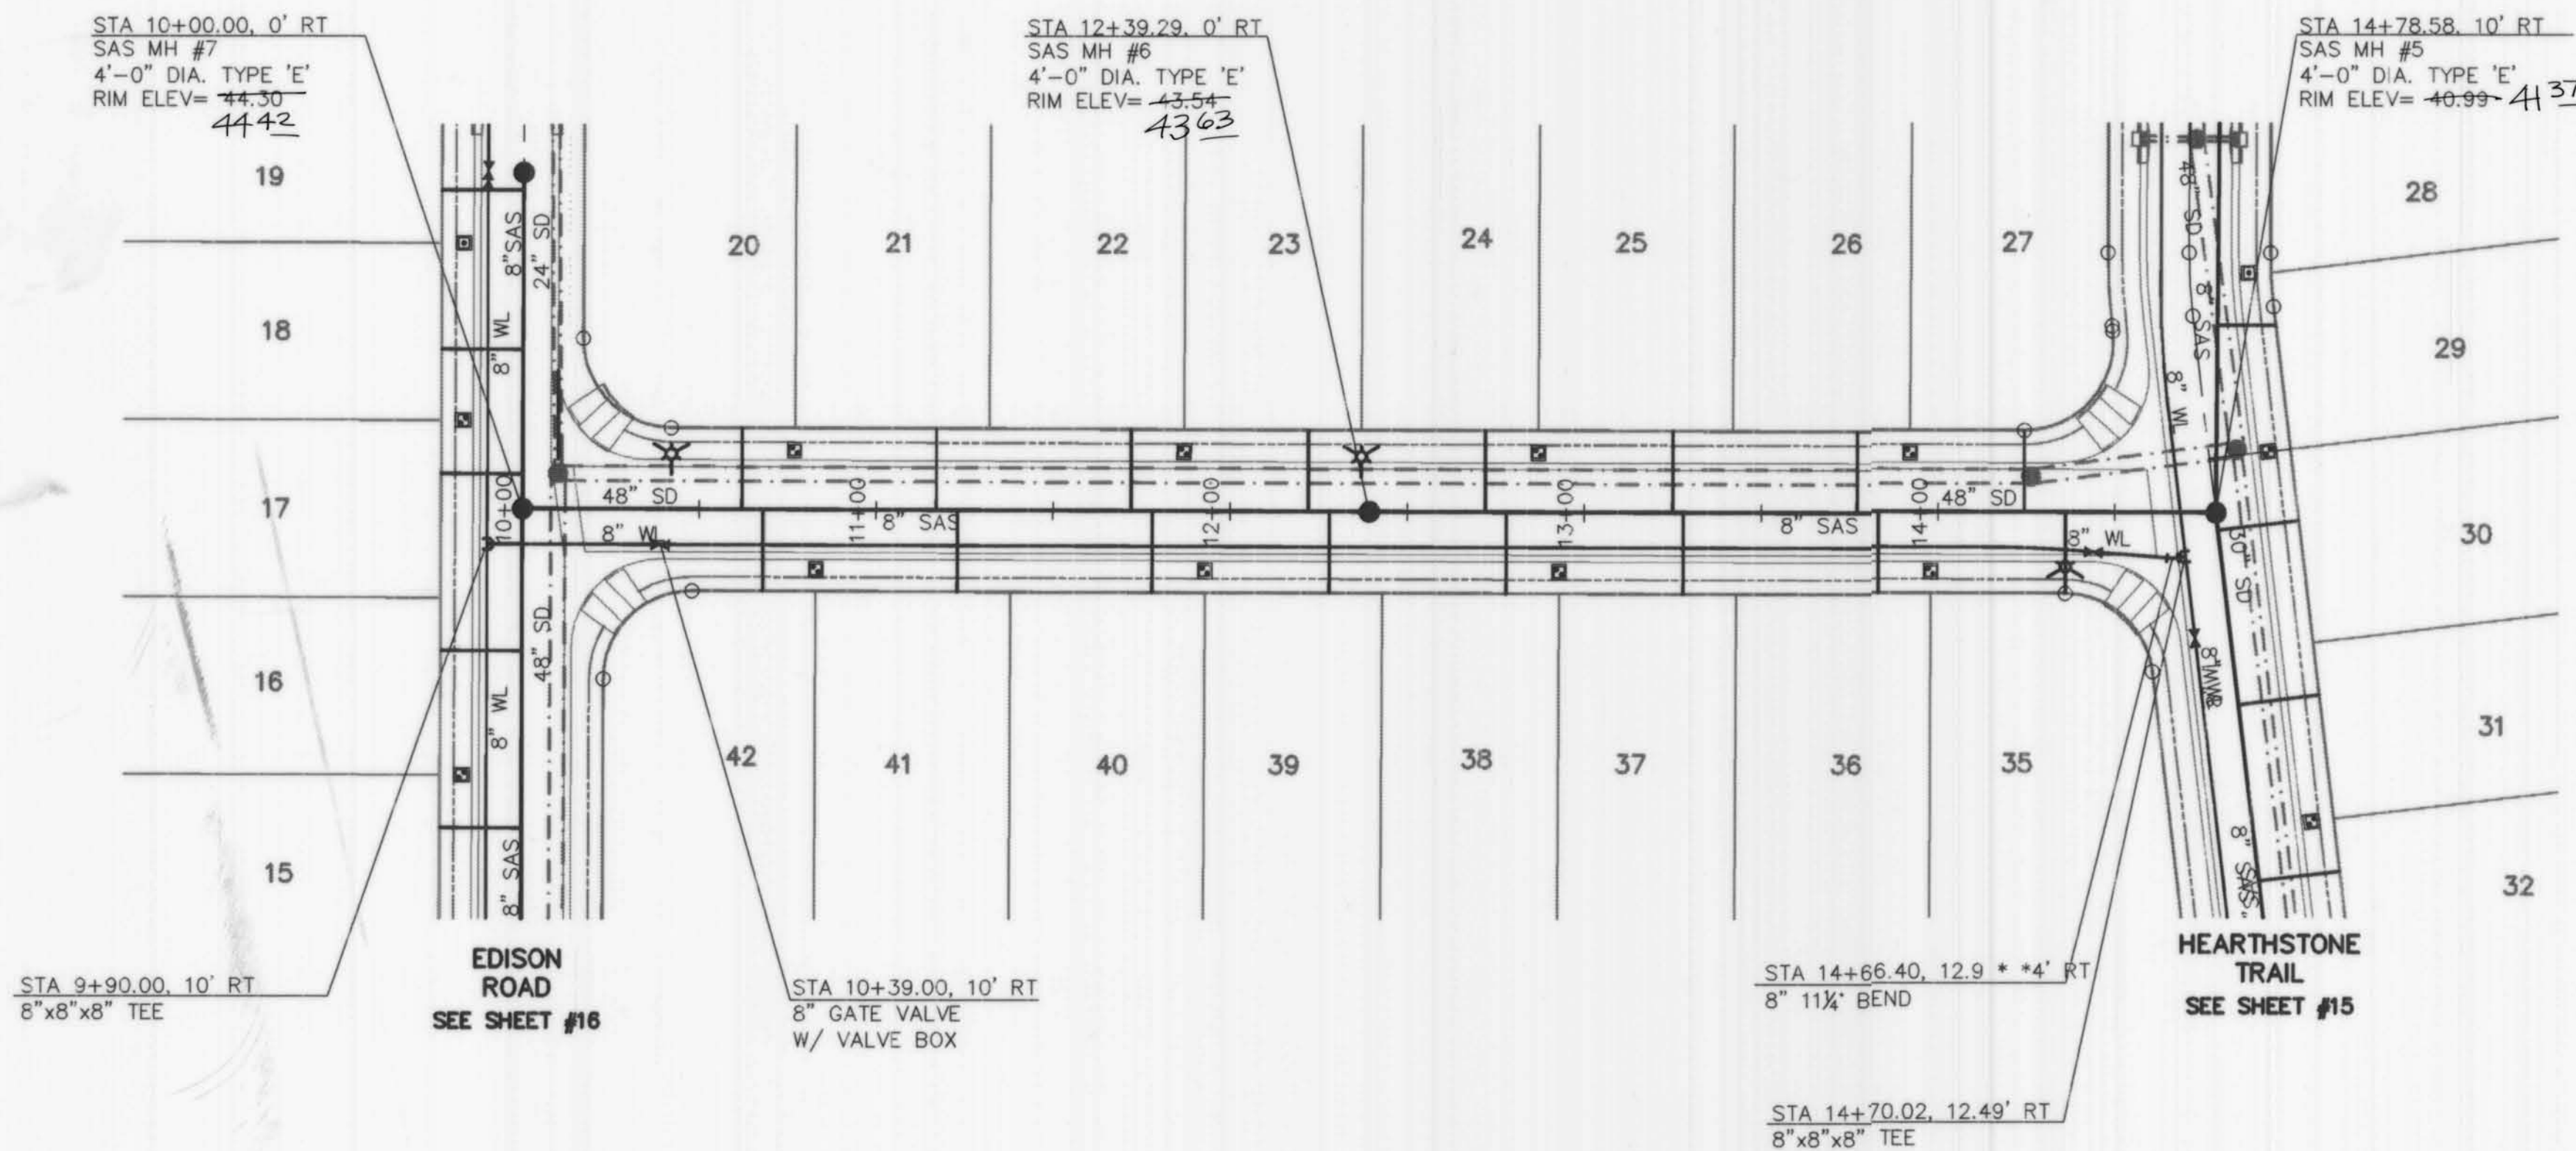

ALLEGIANE STREET

SCALES:
1"=40' HOR.
1"=10' VERT.

Elevation Datum: NGVD 29

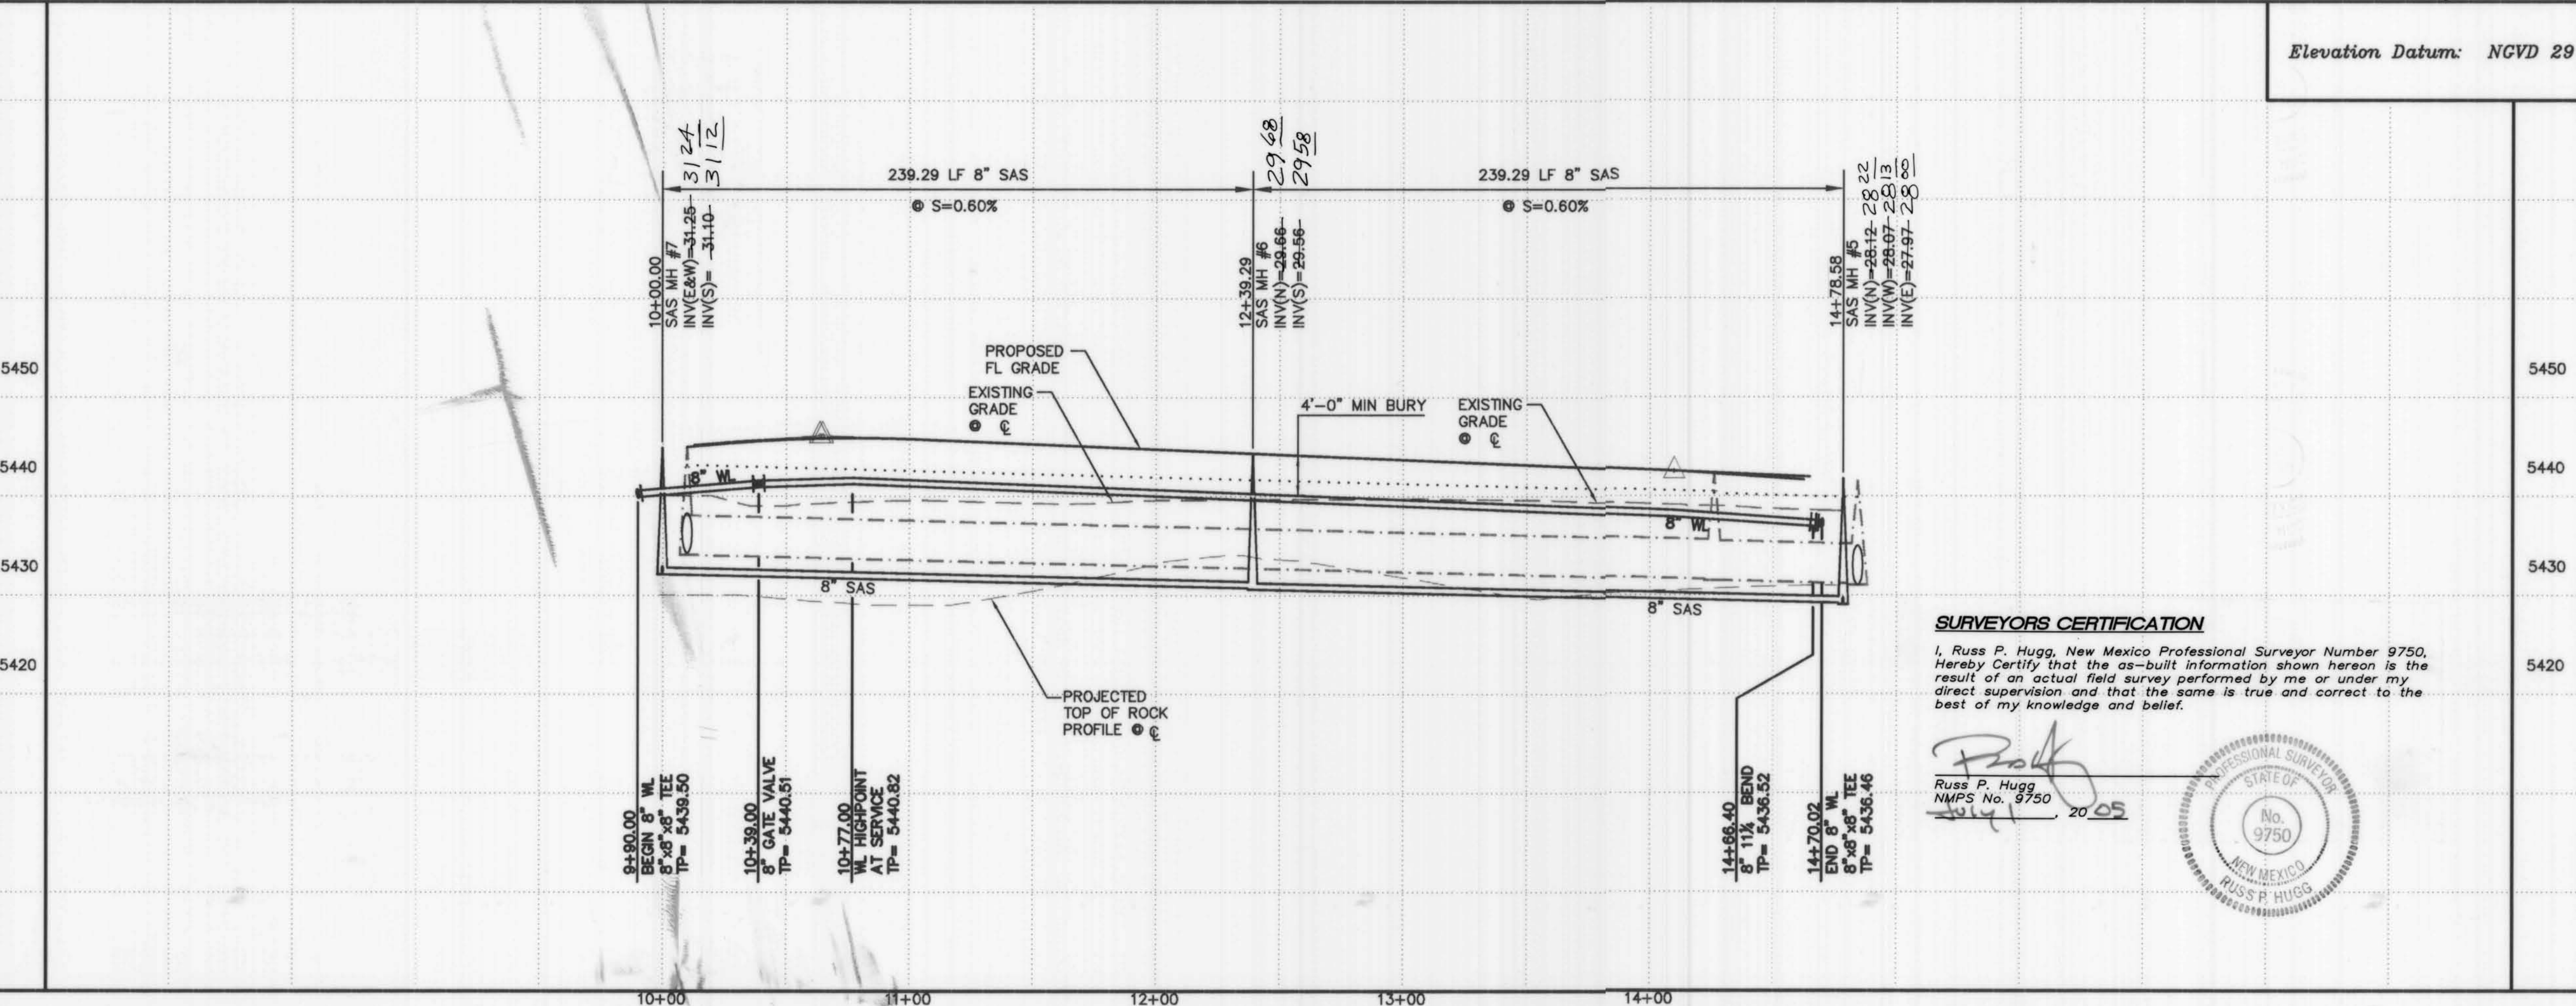


SURVEYORS CERTIFICATION

I, Russ P. Hugg, New Mexico Professional Surveyor Number 9750, Hereby Certify that the as-built information shown hereon is the result of an actual field survey performed by me or under my direct supervision and that the same is true and correct to the best of my knowledge and belief.

[Signature]
Russ P. Hugg
NMPS No. 9750
July 1, 2005



APPROVED FOR WATER AND
SANITARY SEWER CONSTRUCTION.
[Signature] 7-6-04
(for NEW MEXICO UTILITIES, INC.) DATE


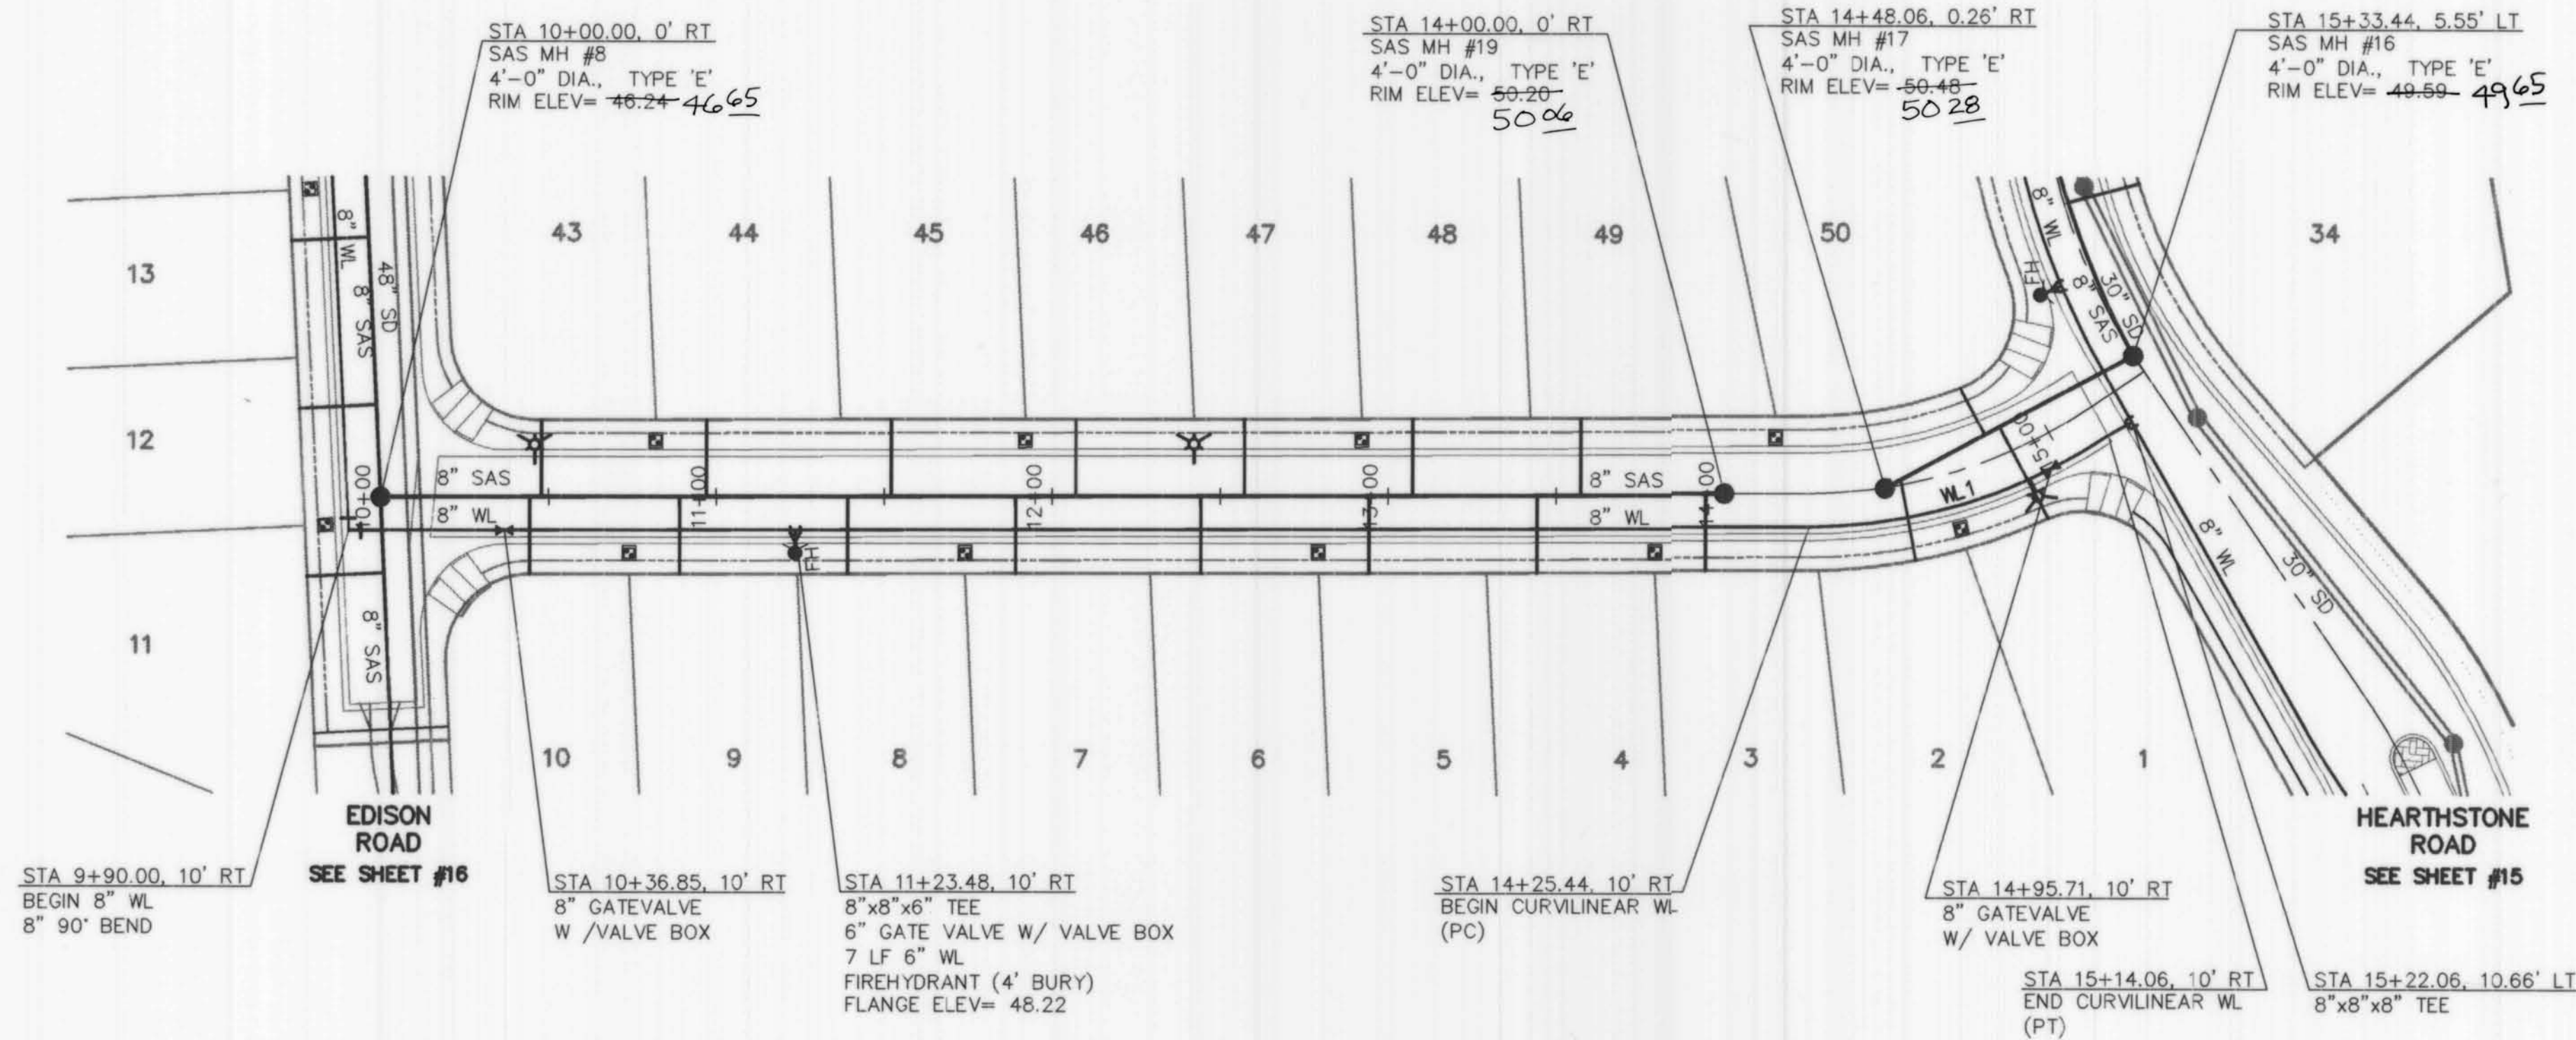


BATTLE CREEK STREET

SCALES:
1"=40' HOR.
1"=10' VERT.

SURVEYORS CERTIFICATION

I, Russ P. Hugg, New Mexico Professional Surveyor Number 9750, Herby Certify that the as-built information shown hereon is the result of an actual field survey performed by me or under my direct supervision and that the same is true and correct to the best of my knowledge and belief.

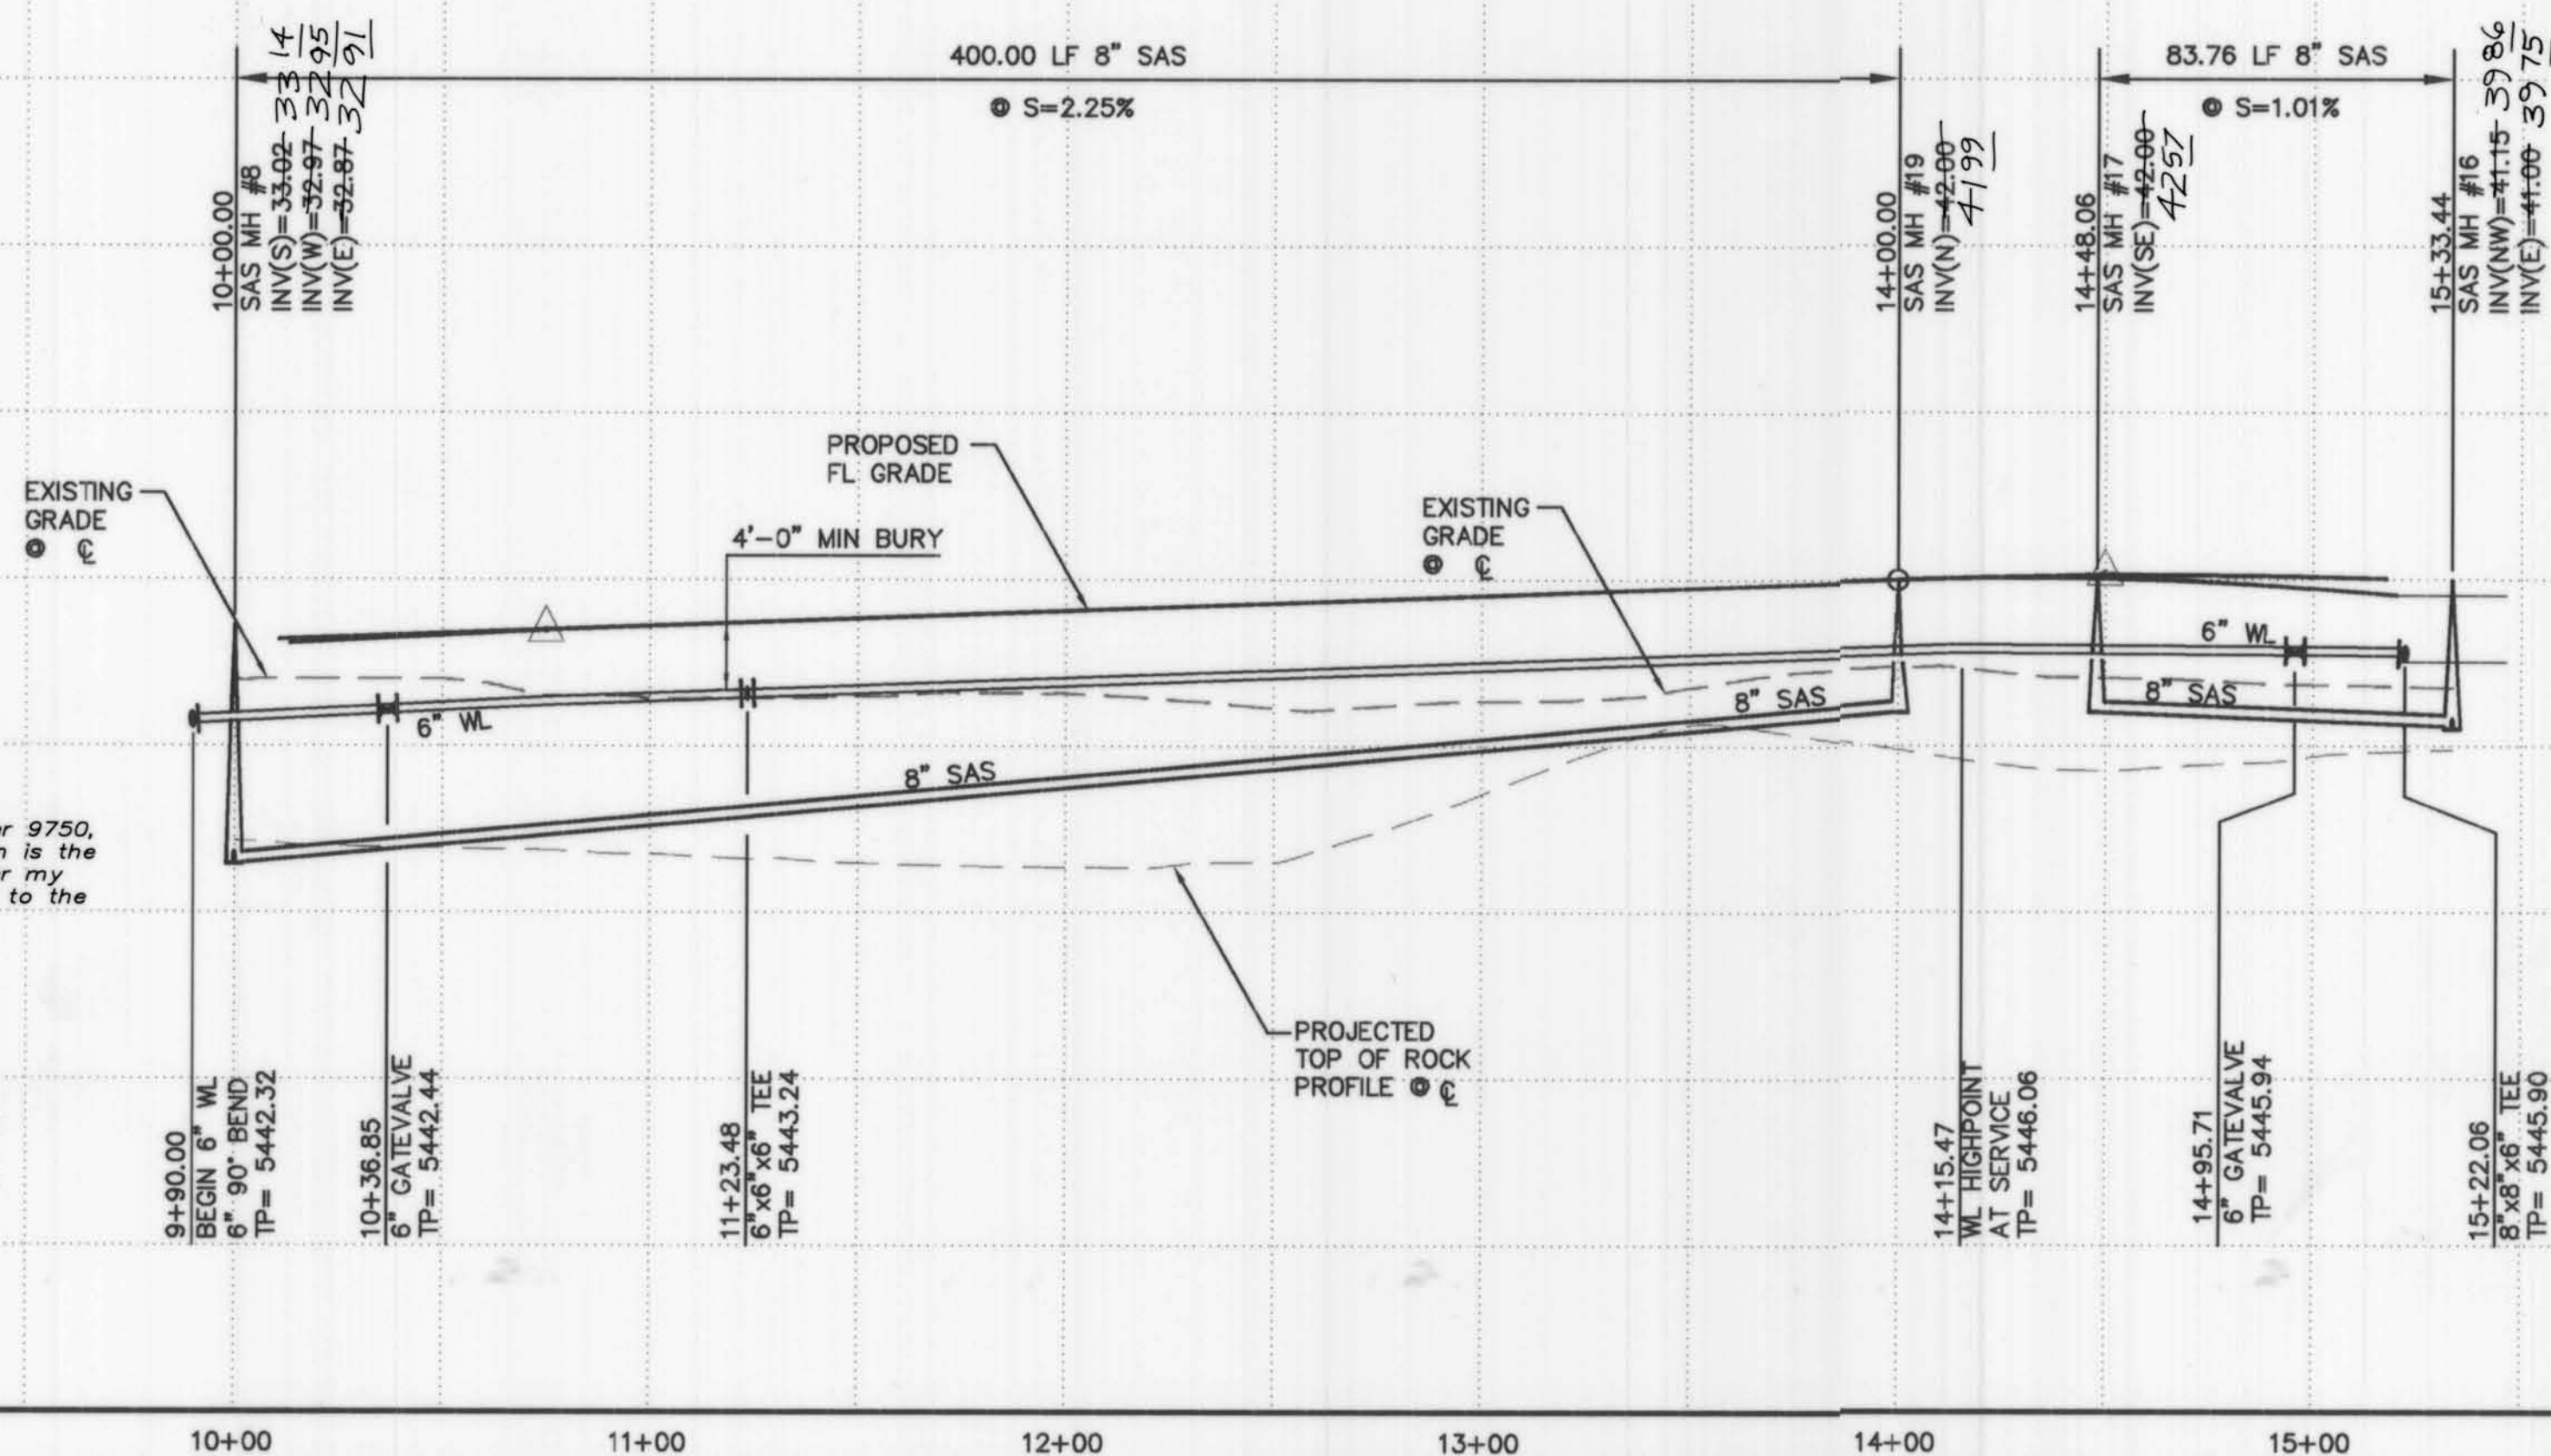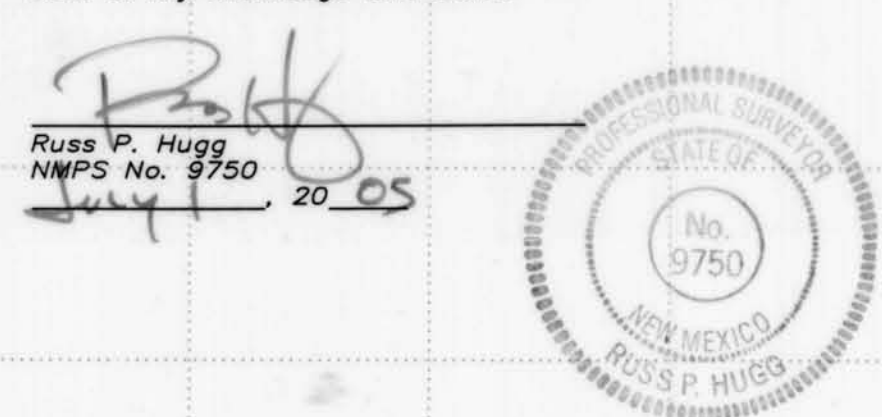

GENERAL NOTES

1. CONSTRUCT SAS SERVICES PER NMUI STANDARD SPECS.
2. CONSTRUCT ALL SINGLE & DOUBLE WATER SERVICES PER NMUI STANDARD SPECS, EXHIBITS A, B, C, & D.
3. SEE SHEET #14 FOR WATER SHUT-OFF PLAN.
4. SEE SHEET #14 FOR RESTRAINED JOINT LENGTHS FOR WATER LINE FITTINGS.
5. CONSTRUCT FIRE HYDRANTS PER DESIGNATED DEPTHS & LENGTHS PER COA STD DWG #2340 AND NMUI STANDARD SPECS.
6. INSTALL VALVE RING & COVER PER COA STD DWG #2328 AND NMUI STANDARD SPECS.
7. INSTALL A CONCRETE COLLAR AROUND ALL SAS MH RIMS AND VALVE BOXES PER NMUI STANDARD SPECS.

UTILITY CURVE TABLE

CURVE	RADIUS	LENGTH	DELTA	CHD BRG
WL1	160.00	94.53	33°51'04"	S 14°04'49" E

LEGEND

- SINGLE WATER METER & BOX
- DOUBLE WATER METER & BOX
- GATE VALVE W/ VALVE BOX
- FIRE HYDRANT
- SAS MANHOLE
- WATER LINE W/ FITTING

UTILITY SERVICE TABLE

LOT NO.	STATION		SAS INV @ R/W
	WATER, LENGTH	SAS, LENGTH	
43	10+82.02, 27'	10+47.82, 23'	42.0
44	10+82.02, 27'	10+97.02, 23'	42.5
45	11+92.14, 27'	11+52.08, 23'	43.0
46	11+92.14, 27'	12+07.14, 23'	43.5
47	12+92.25, 27'	12+57.19, 23'	44.0
48	12+92.25, 27'	13+07.25, 23'	44.4
49	14+15.47, 27'	13+57.30, 23'	44.9
50	14+15.47, 27'	14+79.72, 23'	45.5
1	14+66.51, 7'	14+89.16, 23'	45.5
2	14+66.51, 7'	14+53.11, 23'	45.5
3	13+79.36, 7'	13+94.37, 23'	45.2
4	13+79.36, 7'	13+44.31, 23'	44.7
5	12+79.25, 7'	12+94.25, 23'	44.3
6	12+79.25, 7'	12+44.20, 23'	43.8
7	11+74.14, 7'	11+89.14, 23'	43.3
8	11+74.14, 7'	11+39.09, 23'	42.9*
9	10+74.03, 7'	10+89.03, 23'	42.4*
10	10+74.03, 7'	10+44.27, 23'	42.0*


ALL WATER SERVICES ARE DOUBLE EXCEPT WHERE NOTED AS (S) SINGLE.
* INSTALL SAS SERVICE RISERS.

ISAACSON & ARFMAN, P.A.
Consulting Engineering Associates
128 Monroe Street N.E.
Albuquerque New Mexico
1324A-UTL4DWGrth 07/14/04

CITY OF ALBUQUERQUE
PUBLIC WORKS DEPARTMENT
ENGINEERING GROUP

TITLE: HERITAGE AT THE TRAILS UNIT 2
BATTLE CREEK STREET
STA 10+00.00 TO END
UTILITY PLAN & PROFILE

Design Review Committee APPROVED SEP 23 2004	City Engineer Approval APPROVED OCT - 4 2004	Mo./Day/Yr. Mo./Day/Yr.
DESIGN REVIEW COMMITTEE	CITY ENGINEER	Mo./Day/Yr.

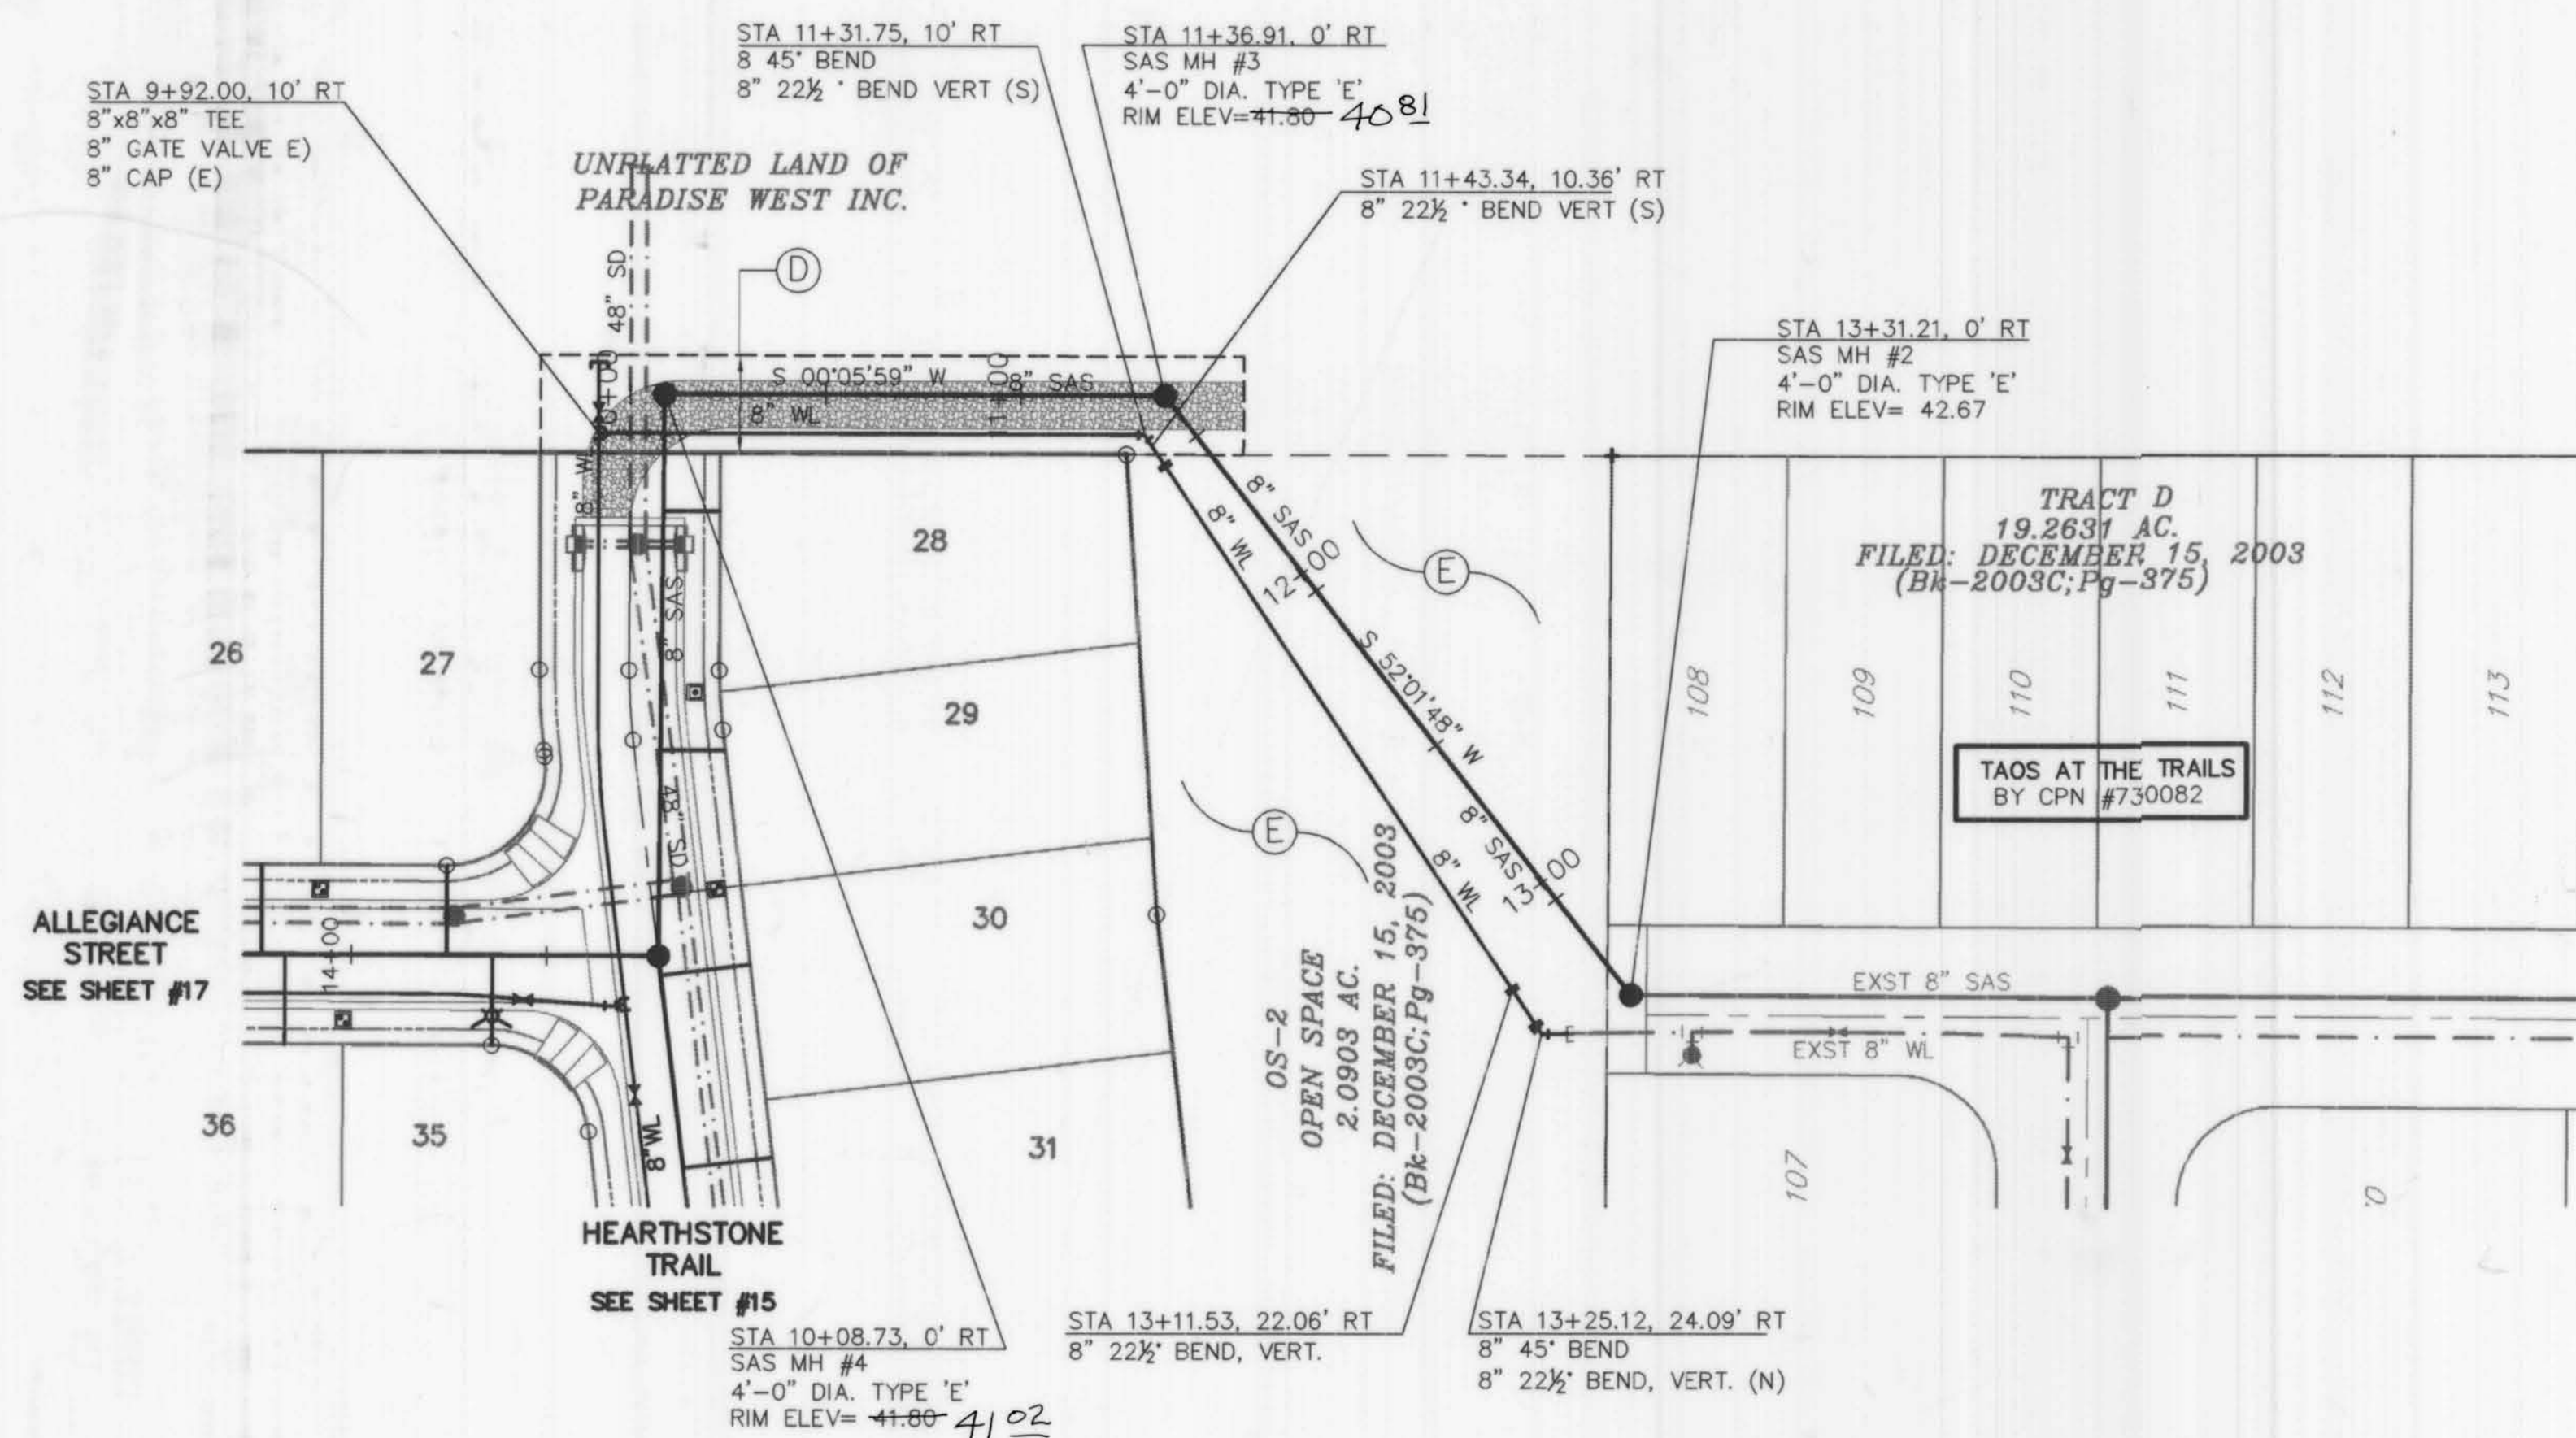

OFFSITE UTILITIES

APPROVED FOR WATER AND
SANITARY SEWER CONSTRUCTION.
(for NEW MEXICO UTILITIES, INC.) DATE 7-15-04

GENERAL NOTES


1. CONSTRUCT SAS SERVICES PER NMUI STANDARD SPECS.
2. CONSTRUCT ALL SINGLE & DOUBLE WATER SERVICES PER NMUI STANDARD SPECS, EXHIBITS A, B, C, & D.
3. SEE SHEET #14 FOR WATER SHUT-OFF PLAN.
4. SEE SHEET #14 FOR RESTRAINED JOINT LENGTHS FOR WATER LINE FITTINGS.
5. CONSTRUCT FIRE HYDRANTS PER DESIGNATED DEPTHS & LENGTHS PER COA STD DWG #2340 AND NMUI STANDARD SPECS.
6. INSTALL VALVE RING & COVER PER COA STD DWG #2328 AND NMUI STANDARD SPECS.
7. INSTALL A CONCRETE COLLAR AROUND ALL SAS MH RIMS AND VALVE BOXES PER NMUI STANDARD SPECS.

LEGEND

- SINGLE WATER METER & BOX
- DOUBLE WATER METER & BOX
- GATE VALVE W/ VALVE BOX
- FIRE HYDRANT
- SAS MANHOLE
- WATER LINE W/ FITTING

SCALES:
1"=40' HOR.
1"=10' VERT.

Elevation Datum: NGVD 29

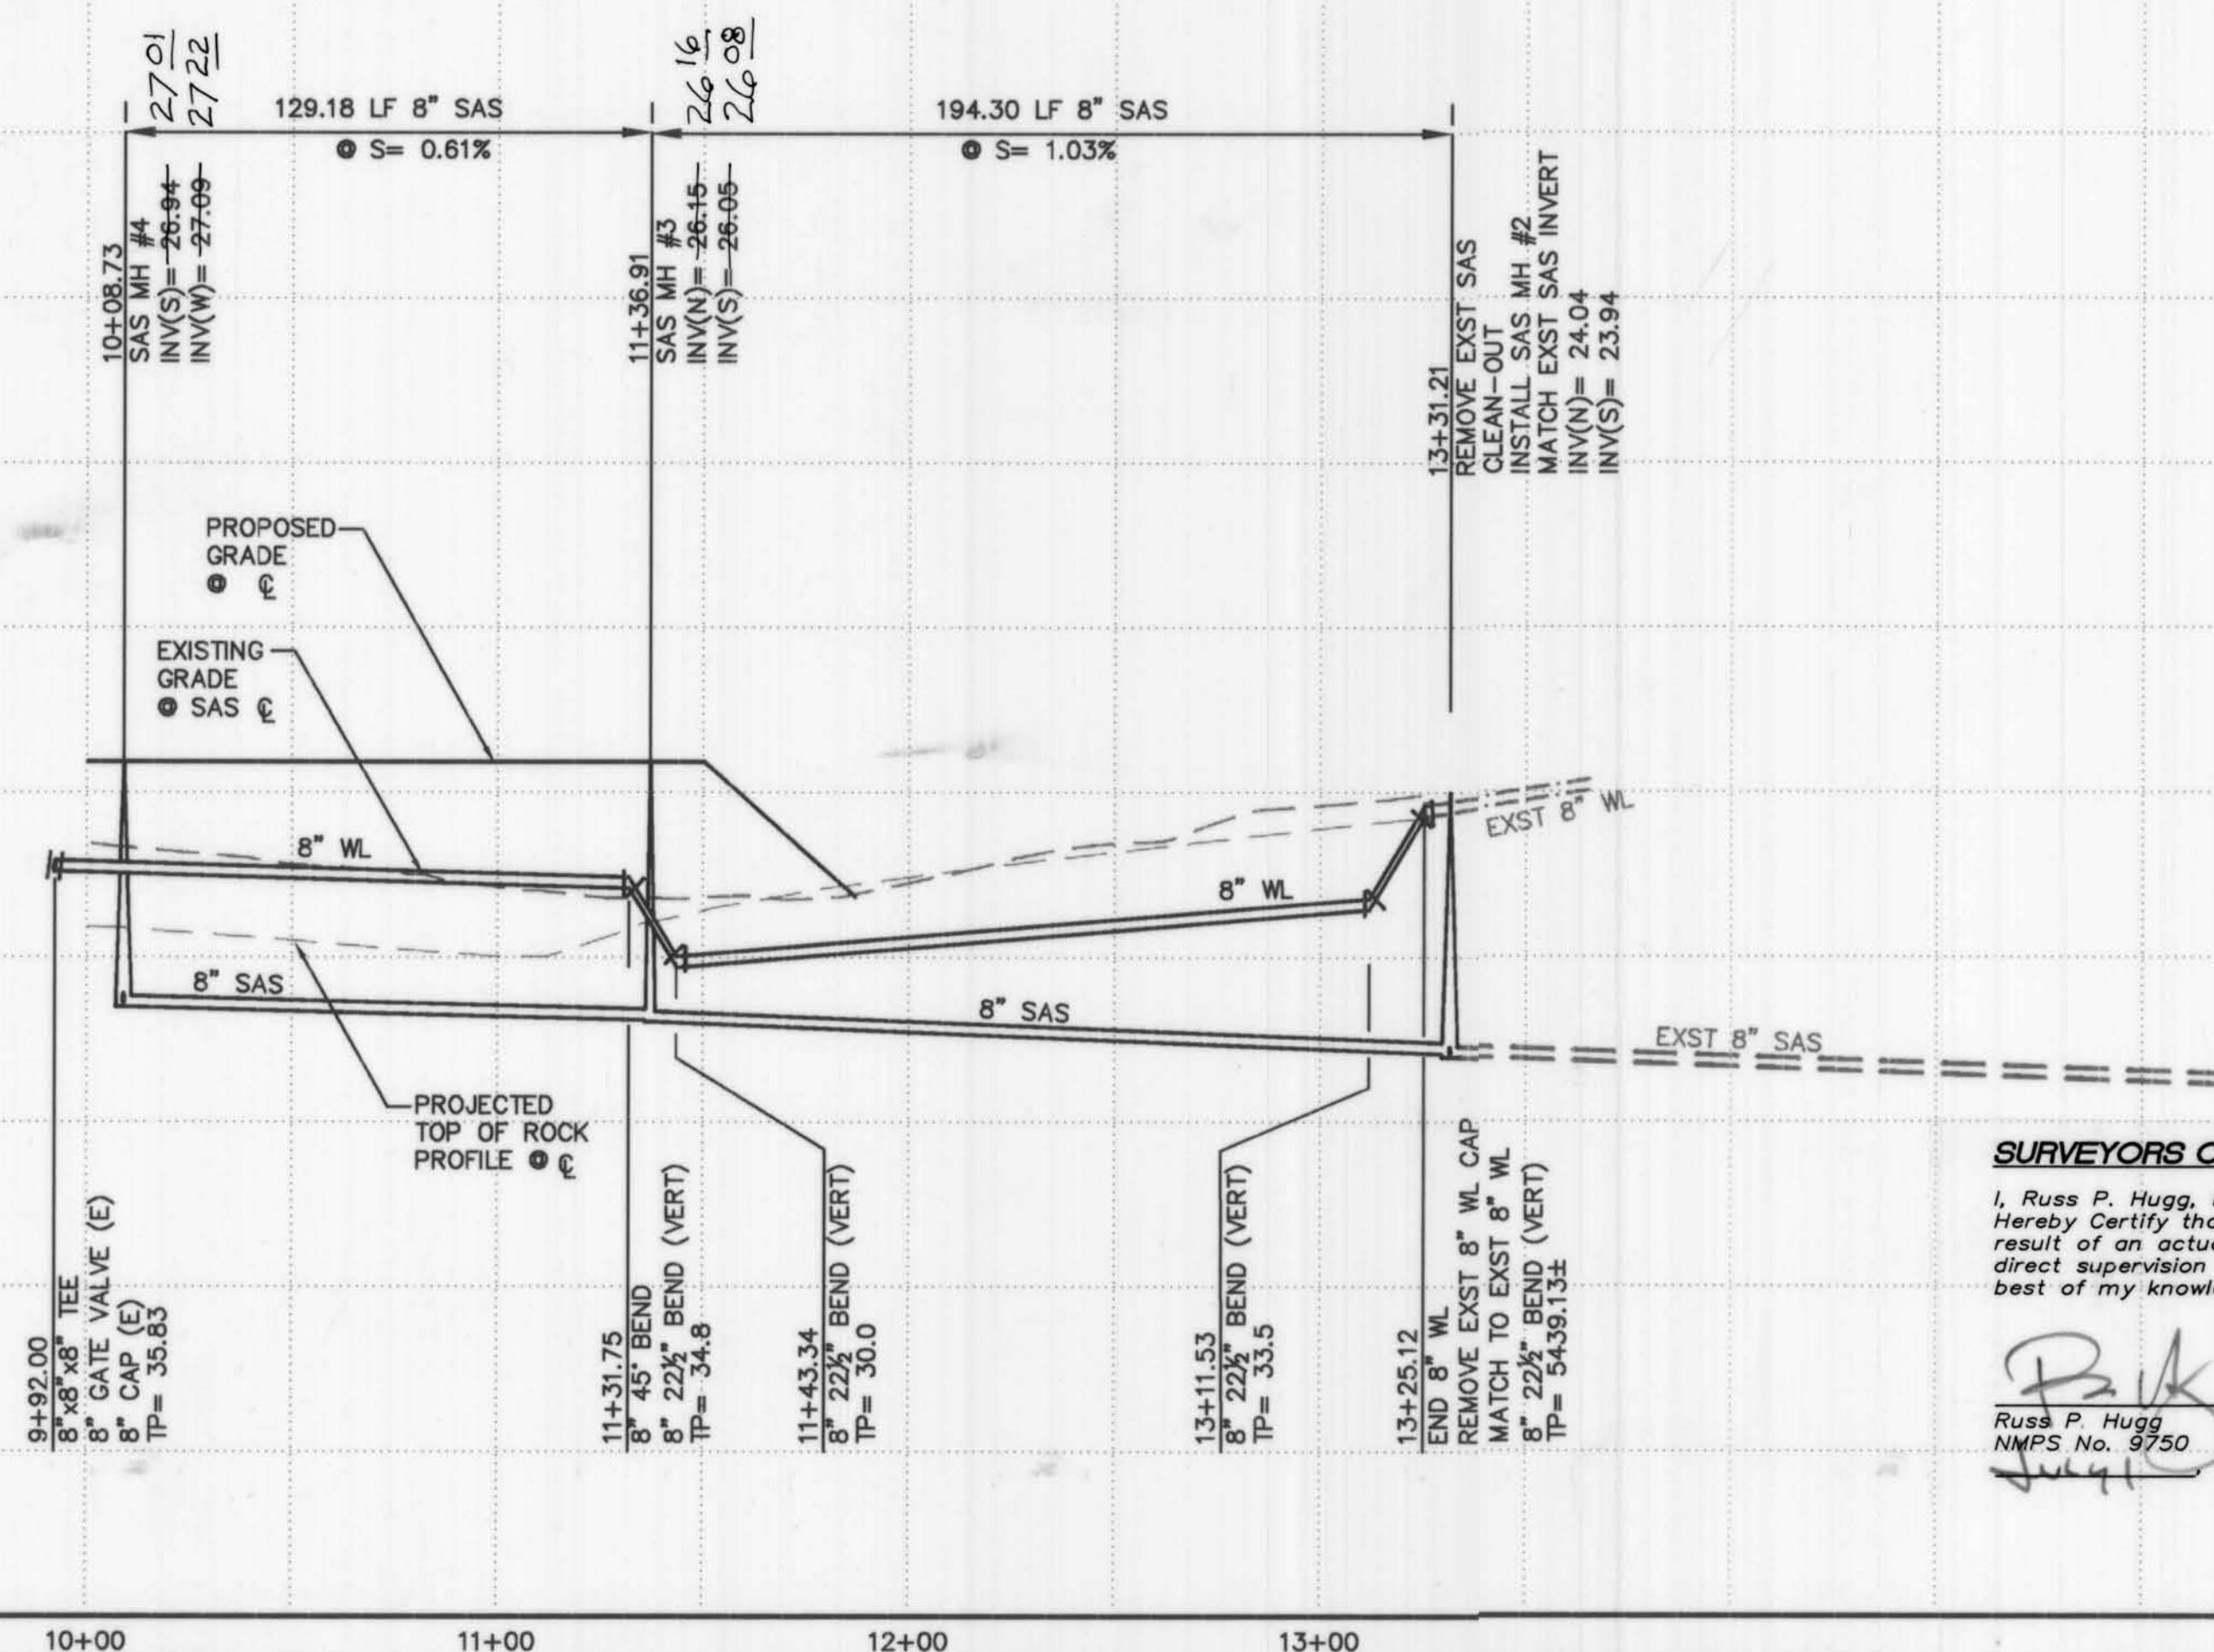

SURVEYORS CERTIFICATION

I, Russ P. Hugg, New Mexico Professional Surveyor Number 9750, Hereby Certify that the as-built information shown hereon is the result of an actual field survey performed by me or under my direct supervision and that the same is true and correct to the best of my knowledge and belief.

Russ P. Hugg
NMPS No. 9750
July 15, 2004



EASEMENT DATA

- ① 25' PUBLIC WATER, SANITARY SEWER, & PEDESTRIAN ACCESS EASEMENT GRANTED BY
- ② BLANKET PUBLIC WATER, SANITARY SEWER & DRAINAGE EASEMENT GRANTED BY BULK LAND PLAT FILED 12/15/2003, BK 2003C, PG 375

ISAACSON & ARFMAN, P.A.
Consulting Engineering Associates
128 Monroe Street N.E.
Albuquerque, New Mexico
1324B-UTIL50Worth 07/07/04

CITY OF ALBUQUERQUE
PUBLIC WORKS DEPARTMENT
ENGINEERING GROUP

TITLE: **HERITAGE AT THE TRAILS UNIT 2
OFFSITE UTILITY
STA 10+00.00 TO END
UTILITY PLAN & PROFILE**

Design Review Committee: **APPROVED** SEP 23 2004
City Engineer Approval: **APPROVED** OCT -4 2004
City Engineer: [Signature]
Last Design Update: [Blank]

City Project No. **738482** Zone Map No. **C-9-Z** Sheet **19** of **19**

AS-BUILT INFORMATION				BENCH MARKS				SURVEY INFORMATION				ENGINEER'S SEAL
CONTRACTOR	WORK STATED BY	DATE	NO.	ACCS MONUMENT "2-B-10" LOCATED 1 MI. WEST OF PARADISE BLVD. AND LA PAZ	ELEVATION: 5429.35 (NGVD 1929)	FIELD NOTES	ALDRICH SURVEYING 104/03	NO.	DATE	REMARKS	BY	
