


CONSTRUCTION PLANS FOR PUBLIC IMPROVEMENTS FOR CUATRO DEVELOPMENT APARTMENTS ALBUQUERQUE, NEW MEXICO

APPROVED AS RECORD DRAWINGS
DESIGN REVIEW SECTIONS
CITY CONSTRUCTION ENGINEER
DATE: 12/14/2016

RECORD
DRAWING

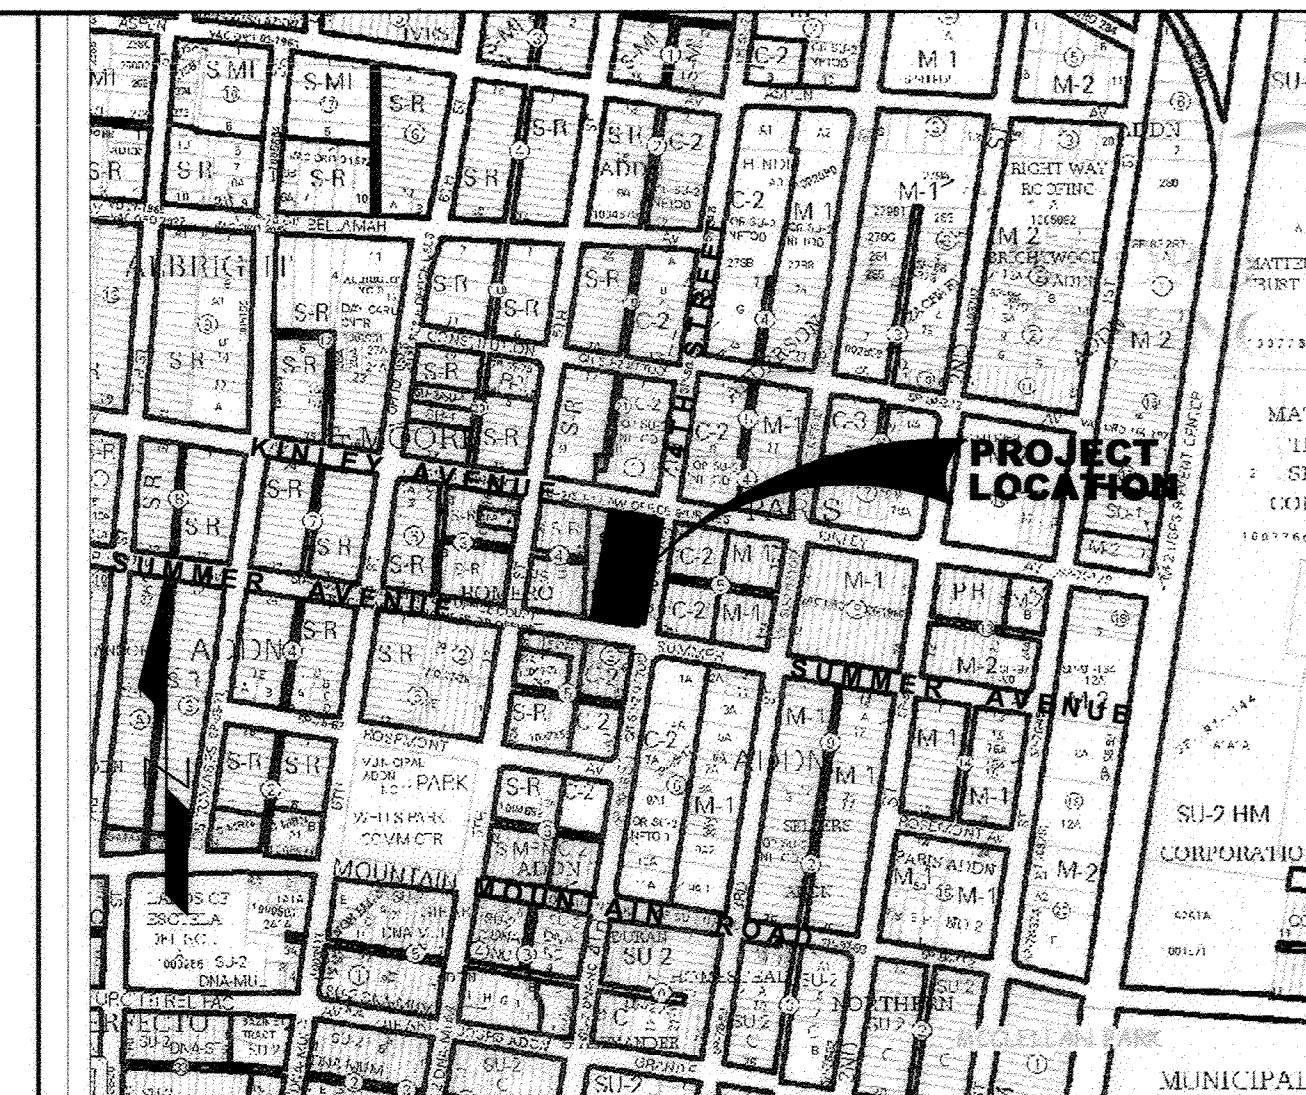

VICINITY MAP (J-14)




GENERAL NOTES NOTICE TO CONTRACTORS

1. ALL WORK DETAILED ON THESE PLANS TO BE PERFORMED UNDER CONTRACT SHALL, EXCEPT AS OTHERWISE STATED OR PROVIDED FOR HEREON, BE CONSTRUCTED IN ACCORDANCE WITH THE CITY OF ALBUQUERQUE STANDARD SPECIFICATIONS FOR PUBLIC WORKS CONSTRUCTION, 1986 EDITION AS REVISED THROUGH UPDATE #8, INCLUDING AMENDMENT No. 1.
2. TWO WORKING DAYS PRIOR TO ANY EXCAVATION, CONTRACTOR MUST CONTACT NEW MEXICO ONE CALL SYSTEM (260-1990) AND DETERMINE LOCATION OF EXISTING UTILITIES.
3. PRIOR TO ANY CONSTRUCTION, THE CONTRACTOR SHALL EXCAVATE AND VERIFY THE HORIZONTAL AND VERTICAL LOCATIONS OF ALL OBSTRUCTION. SHOULD A CONFLICT EXIST, THE CONTRACTOR SHALL NOTIFY THE ENGINEER OR THE SURVEYOR SO THAT THE CONFLICT CAN BE RESOLVED WITHOUT DELAY.
4. ALL EXISTING SIGNS, MARKERS, DELINEATORS, STRIPING, BIKE SYMBOLS, ETC. WITHIN THE CONSTRUCTION LIMITS SHALL BE REMOVED, STORED AND RE-SET BY THE CONTRACTOR.
5. THE CONTRACTOR SHALL NOTIFY THE ENGINEER NOT LESS THAN SEVEN (7) DAYS PRIOR TO STARTING WORK IN ORDER THAT THE ENGINEER MAY TAKE NECESSARY MEASURES TO INSURE THE PRESERVATION OF SURVEY MONUMENTS. CONTRACTOR SHALL NOT DISTURB PERMANENT SURVEY MONUMENTS WITHOUT THE CONSENT OF THE ENGINEER AND SHALL NOTIFY THE ENGINEER AND BEAR THE EXPENSE OF REPLACING ANY THAT MAY BE DISTURBED WITHOUT PERMISSION. REPLACEMENT SHALL BE DONE ONLY BY THE CITY SURVEYOR. WHEN A CHANGE IS MADE IN THE FINISHED ELEVATIONS OF THE PAVEMENT OF ANY ROADWAY IN WHICH A PERMANENT SURVEY MONUMENT IS LOCATED, CONTRACTOR SHALL, AT HIS OWN EXPENSE, ADJUST THE MONUMENT COVER TO THE NEW GRADE UNLESS OTHERWISE SPECIFIED. REFER TO SECTION 4.4 OF THE GENERAL CONDITIONS OF THE STANDARD SPECIFICATIONS.
6. SEVEN (7) WORKING DAYS PRIOR TO BEGINNING CONSTRUCTION, THE CONTRACTOR SHALL SUBMIT TO CONSTRUCTION COORDINATION DIVISION A DETAILED CONSTRUCTION SCHEDULE. TWO (2) WORKING DAYS PRIOR TO THE START OF CONSTRUCTION, THE CONTRACTOR SHALL OBTAIN A BARRICADING PERMIT FROM THE CONSTRUCTION COORDINATION DIVISION; CONTRACTOR SHALL NOTIFY THE CONSTRUCTION COORDINATION ENGINEER (924-3400) PRIOR TO OCCUPYING AN INTERSECTION. REFER TO SECTION 19 OF THE GENERAL CONDITIONS OF THE STANDARD SPECIFICATIONS.
7. THE CONTRACTOR SHALL COORDINATE WITH THE WATER AUTHORITY SEVEN (7) DAY IN ADVANCE OF PERFORMING WORK THAT WILL AFFECT THE PUBLIC WATER OR SANITARY SEWER INFRASTRUCTURE. WORK REQUIRING SHUTOFF OF FACILITIES DESIGNATED AS MASTER PLAN FACILITIES MUST BE COORDINATED WITH THE WATER AUTHORITY 14 DAYS IN ADVANCE OF PERFORMING SUCH WORK. ONLY WATER AUTHORITY CREWS ARE AUTHORIZED TO OPERATE PUBLIC VALVES. SHUTOFF REQUEST MUST BE MADE ONLINE AT http://abcwua.org/Water_Shut_off_and_Turn_on_Procedures.aspx
8. ALL EXCAVATION, TRENCHING, AND SHORING ACTIVITIES MUST BE CARRIED-OUT IN ACCORDANCE WITH OSHA 29CFR 1926.650 SUBPART P.
9. CONTRACTOR WILL BE RESPONSIBLE FOR PROVIDING AND MAINTAINING ALL CONSTRUCTION SIGNING UNTIL PROJECT HAS BEEN ACCEPTED BY COA.
10. IF HUMAN REMAINS ARE ENCOUNTERED, CONSTRUCTION ACTIVITIES SHALL STOP AND CONTACT THE OFFICE OF MEDICAL EXAMINATIONS FOR FURTHER DIRECTION.

CAUTION:
NOTE THAT ALL EXISTING UTILITIES MAY NOT BE SHOWN. ALL EXISTING SERVICE CONNECTIONS ARE NOT SHOWN. ANY EXISTING UTILITIES THAT ARE SHOWN ARE APPROXIMATE LOCATION ONLY. IT SHALL BE THE SOLE RESPONSIBILITY OF THE CONTRACTOR TO CONTACT ALL THE UTILITY OWNERS AND TO CONDUCT ALL NECESSARY FIELD INVESTIGATIONS PRIOR TO ANY EXCAVATIONS TO DETERMINE THE ACTUAL LOCATION OF UTILITIES AND OTHER IMPROVEMENTS. THE CONTRACTOR SHALL BE RESPONSIBLE FOR ANY DAMAGE TO EXISTING UTILITIES, ETC.

SHEET NO.	SHEET TITLE
1	TITLE SHEET
2	SURVEY PLAT
3	OVERALL SITE PLAN (FOR INFORMATION ONLY)
4	GRADING PLAN – NORTH HALF (FOR INFORMATION ONLY)
5	GRADING PLAN – SOUTH HALF (FOR INFORMATION ONLY)
6	REMOVALS WITHIN CITY RIGHT OF WAY
7	WATER AND SEWER OVERALL PLAN
8	WATER AND SEWER – PLAN AND PROFILES
9	STORMDRAIN – PLAN AND PROFILES
10	PAVING, CURB & GUTTER AND SIDEWALK–NORTH HALF
11	PAVING, CURB & GUTTER AND SIDEWALK–SOUTH HALF

I, Gilbert Aldaz of the firm of Applied Engineering & Surveying, Inc., a Registered Professional Engineer in the State of New Mexico, and Project Engineer for the Cuatro Development Apartments, Project No. 744381, Sheets 1-11 as constructed by Tofel Construction, do hereby certify, to the best of my knowledge and belief, that the infrastructure installed as part of this project noted above has been inspected by me or by a qualified person under my direct supervision and has been constructed in accordance with the plans and specifications approved by the City Engineer and that the original design intent of the approved plans has been met, except as noted by me on the as-built construction drawings. This certification is based on site inspections by me or personnel under my direction and survey information provided by Thomas W. Patrick, NMPS 12651.

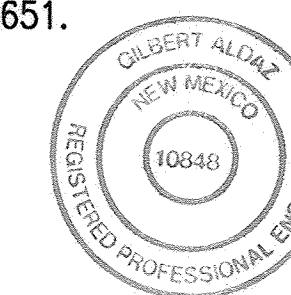

Gilbert Aldaz
GILBERT ALDAZ, NMPE 10848

08/31/16
DATE


THE FOLLOWING NOTES ALSO APPLY WHEN CHECKED

- ☒ ALL UTILITIES AND UTILITY SERVICE LINES SHALL BE INSTALLED PRIOR TO PAVING.
- ☒ BACKFILL COMPACTION SHALL BE ACCORDING TO SPECIFIED STREET USE.
- ☒ TACK COAT REQUIREMENTS SHALL BE DETERMINED BY THE ENGINEER.
- ☒ SIDEWALK AND WHEELCHAIR RAMPS WITHIN THE CURB RETURNS SHALL BE CONSTRUCTED WHEREVER A NEW CURB RETURN IS CONSTRUCTED
- ☐ IF CURB IS DEPRESSED FOR A DRIVEPAD, THE DRIVEPAD SHALL BE CONSTRUCTED PRIOR TO ACCEPTANCE OF CURB AND GUTTER.
- ☒ ALL STORM DRAINAGE FACILITIES SHALL BE COMPLETED PRIOR TO FINAL ACCEPTANCE.
- ☒ THE REQUESTOR OR DEVELOPER SHALL BE RESPONSIBLE FOR REPAIR OR REPLACEMENT OF ALL CURB AND GUTTER OR SIDEWALK DAMAGE AFTER APPROVAL BY THE CITY ENGINEER OR WORK COMPLETED BY THE CONTRACTOR.

DRC TRANSPORTATION STANDARD NOTES:

1. ALL STREET STIPING ALTERED OR DESTROYED SHALL BE REPLACED WITH PLASTIC REFLECTORIZED PAVEMENT MARKING BY CONTRACTOR TO THE SAME LOCATION AS EXISTING OR AS INDICATED BY THIS PLAN SET.
2. ALL WORK AFFECTING ARTERIAL ROADWAYS REQUIRES TWENTY FOUR HOUR CONSTRUCTION.
3. REMOVAL OF EXISTING CURB & GUTTER AND SIDEWALKS SHALL BE TO THE NEAREST JOINT.
4. ANY DAMAGE TO THE EXISTING CURB & GUTTER, PAVEMENT, SIDEWALKS, STRIPING, AND SIGNAGE DURING CONSTRUCTION SHALL BE REPLACED.
5. OVERNIGHT PARKING OF CONSTRUCTION EQUIPMENT SHALL NOT OBSTRUCT DRIVEWAYS OR DESIGNATED TRAFFIC LANES. THE CONTRACTOR SHALL NOT STORE ANY EQUIPMENT OR MATERIAL WITHIN THE PUBLIC RIGHT-OF-WAY.
6. CURB AND GUTTER, SIDEWALKS, AND DRIVE PADS SHALL MATCH THE ELEVATIONS OF ADJUTING EXISTING AREAS AS SHOWN ON THE PLANS OR AS DIRECTED BY THE PROJECT ENGINEER.
7. THE SUBGRADE PREP SHALL EXTEND ONE FOOT BEYOND THE FREE EDGE OF NEW CURB AND GUTTER AND SIDEWALK.
8. CONTRACTOR TO TEST SUBGRADE R-VALUE PRIOR TO CONSTRUCTION. IN THE EVENT THE R-VALUE IS LESS THAN 50, REMOVE 2 FEET OF SUBGRADE MATERIAL AND IMPORT MATERIAL WITH R-VALUE GREATER THAN 50 OR CONTACT THE ENGINEER IMMEDIATELY SO THE PAVEMENT SECTION CAN BE MODIFIED.

SURVEYOR'S CERTIFICATE
I, THOMAS W. PATRICK, A DULY QUALIFIED LICENSED PROFESSIONAL SURVEYOR UNDER THE LAWS OF THE STATE OF NEW MEXICO, DO HEREBY CERTIFY THAT THE AS-BUILT INFORMATION SHOWN ON THESE DRAWINGS WAS OBTAINED FROM FIELD CONSTRUCTION AND "AS-BUILT" SURVEYS PERFORMED BY ME, OR UNDER MY SUPERVISION, THAT THE "AS-BUILT" INFORMATION SHOWN ON THESE DRAWINGS (UNLESS OTHERWISE NOTED) WAS ADDED BY ME, OR BY UNDER MY SUPERVISION, AND THAT THIS "AS-BUILT" INFORMATION IS TRUE AND CORRECT TO THE BEST OF MY KNOWLEDGE AND BELIEF. COMMUNITY SCIENCES CORPORATION IS NOT RESPONSIBLE FOR ANY OF THE DESIGN CONCEPTS, CALCULATIONS, ENGINEERING AND/OR INTENT OF THE "RECORD DRAWINGS."

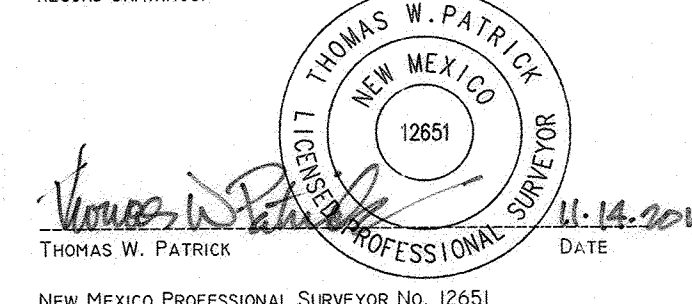

APPLIED Engineering & Surveying, Inc.
1605 BLAIR DRIVE NE
ALBUQUERQUE, NEW MEXICO 87112
PHONE (505)237-1456

DRB – 1007059

REV.	SHEETS	CITY ENGINEER	DATE	USER DEPARTMENT	DATE	USER DEPARTMENT	DATE
ENGINEERS STAMP & SIGNATURE		APPROVALS		ENGINEER			
DRC Chairman		3/9/15		APPROVED FOR CONSTRUCTION			
Transportation		2/26/15					
ABCWUA		03/09/15					
Hydrology		7/27/15					
Parks							
Constr. Mngmt.							
AEHD							
CITY PROJECT No.				744381			
Sheet				Of			
1				11			

GENERAL NOTES

- NORTH FOURTH TRANSIT ORIENTED DEVELOPMENT (NFOOD) HEIGHT: 4 STORIES WITH A MAXIMUM OF 52 FEET 3 STORIES WITH A MAXIMUM OF 40 FEET
- SETBACKS PER SECTOR DEVELOPMENT PLAN: 0'-10' FRONT SETBACK • 4TH STREET (0' PROVIDED) 0'-10' SIDE STREET SETBACK • SUMNER & KINLEY AVE. (4'-8' PROVIDED) 5'-10' REAR SETBACK INCLUDING ALLEY WIDTH
- TOPOGRAPHY/DRAINAGE: SITE IS RELATIVELY FLAT. DRAINAGE IS PREDOMINATELY FROM EAST TO WEST, LEADING FROM THE PARKING LOT TO THE WEST EDGE PLANTER.
- WELLS PARK PROVIDES CHILDREN RECREATION FACILITIES TWO BLOCKS SOUTH AND ONE BLOCK WEST OF PROPERTY.
- SURROUNDINGS USED: TO NORTH, EAST AND SOUTH COMMERCIAL. TO WEST- SINGLE-FAMILY RESIDENTIAL AND COMMERCIAL.

KEYED NOTES

- PATIO AREA WITH BARBECUES AND PICNIC TABLES.
- ROLLING ELECTRICAL GATE.
- REFUSE ENCLOSURE WITH GATE. SEE DETAILS 15 & 16/SITE401.
- 6' CMU BLOCK WALL. SEE SHEET SITE400 & SITE401.
- TYPICAL PROPERTY LINE.
- 4' WALL WITH 4" CAP BLOCK. SEE DETAIL 3/SITE400.
- CONCRETE PAVING.
- CONCRETE WALKWAY.
- ASPHALT PAVING.
- ACCESSIBLE CURB RAMP. TYPICAL.
- FIRE SPRINKLER CLOSET, 6" WATER TAP AND LINE FOR FIRE SUPPRESSION SYSTEM.
- EXISTING POLE LIGHT FIXTURE. TYPICAL.
- PROPOSED NEW CITY BUS SHELTER AT EXISTING ROUTE #10 BUS STOP.
- PERMEABLE PAVING / GRAVEL.
- KITCHEN GARDEN.
- "NO ENTRY" SIGN. SEE SHEET SITE600.
- PUTTING GREEN.
- WATER FEATURE.
- NEW POLE LIGHT FIXTURE.
- EXISTING STRUCTURE.
- PROPOSED STRUCTURE.
- BIKE RACK, EXTERIOR.
- NEW FIRE HYDRANT.
- EXISTING FIRE HYDRANT.
- LANDSCAPE AREA. SEE LANDSCAPE SHEETS.
- FLUSH 12" WIDE CONCRETE RETAINING STRIP.
- NEW CONCRETE DRIVE PAD.
- NEW 6" CONCRETE PARKING CURBS.
- NEW 6" CONCRETE CURBING.
- 6' REBAR FENCE. SEE SHEET SITE400 & SITE401.
- SITE AND BUILDING SIGNAGE SEE SHEET SITE600.
- POUNDING AREA.
- ROOF DRAINAGE / ROOF OVERFLOW DISCHARGE OUTLET.
- NEW 2" WATER LINE AND METER TAP AT THIS LOCATION.
- 3/4" WATER TAP AND METER WITH AUTOMATIC WATERING SYSTEM PER CITY OF ALBUQUERQUE STANDARDS FOR IRRIGATION OF RIGHT-OF-WAY LANDSCAPING AND STREET TREES ONLY.

RESIDENTIAL UNIT SIZES

TOTALS FOR PROJECT - 56 UNITS
13 EFFICIENCIES, 23 ONE BEDROOM, & 20 TWO BEDROOMS
THESE ARE BROKEN DOWN BELOW TO SHOW SIZES

TYPE OF UNIT	# OF UNITS	HEATED SQUARE FOOTAGE PER UNIT
EFFICIENCY 1	8	459
EFFICIENCY 2	2	501
EFFICIENCY 3	3	457
ONE BEDROOM 1	8	566
ONE BEDROOM 2	8	625
ONE BEDROOM 3	4	751
ONE BEDROOM 4	4	636
TWO BEDROOM ONE BATH	12	799
TWO BEDROOM TWO BATH	8	851

BUILDING SCHEDULE

TOWER A FIRST FLOOR 4,545 GROSS SQ. FT. COMMON AREA	TOWER B FIRST FLOOR 4,550 GROSS SQ. FT. COMMON AREA	TOWER C FIRST FLOOR 5,173 GROSS SQ. FT. COMMON AREA
SECOND FLOOR (1) EFFICIENCY 2 (2) ONE BEDROOM 1 (2) ONE BEDROOM 3 (2) TWO BEDROOM 2 BATH TOTAL 573 SQ. FT.	SECOND FLOOR (1) EFFICIENCY 3 (1) ONE BEDROOM 4 (4) TWO BEDROOM 1 BATH TOTAL 4790 SQ. FT.	SECOND FLOOR (2) ONE BEDROOM 1 (2) ONE BEDROOM 2 (1) ONE BEDROOM 3 (2) TWO BEDROOM 2 BATH TOTAL 573 SQ. FT.
THIRD FLOOR (1) EFFICIENCY 1 (2) ONE BEDROOM 1 (2) ONE BEDROOM 2 (1) ONE BEDROOM 3 (2) TWO BEDROOM 2 BATH TOTAL 573 SQ. FT.	THIRD FLOOR (1) EFFICIENCY 2 (1) EFFICIENCY 3 (1) ONE BEDROOM 4 (4) TWO BEDROOM 1 BATH TOTAL 4790 SQ. FT.	THIRD FLOOR (2) EFFICIENCY 1 (2) ONE BEDROOM 1 (2) ONE BEDROOM 2 (1) ONE BEDROOM 3 (2) TWO BEDROOM 2 BATH TOTAL 573 SQ. FT.
FOURTH FLOOR (1) LAUNDRY ROOM (1) EFFICIENCY 3 (1) ONE BEDROOM 4 (4) TWO BEDROOM 1 BATH TOTAL 573 SQ. FT.	FOURTH FLOOR (1) LAUNDRY ROOM (1) EFFICIENCY 3 (1) ONE BEDROOM 4 (4) TWO BEDROOM 1 BATH TOTAL 573 SQ. FT.	FOURTH FLOOR (1) LAUNDRY ROOM (1) EFFICIENCY 3 (1) ONE BEDROOM 4 (4) TWO BEDROOM 1 BATH TOTAL 573 SQ. FT.
PATIO AREA BETWEEN TOWERS A & B: 1,094 SQ. FT. PUTTING GREEN: 419 SQ. FT. KITCHEN GARDEN AREA: 88 SQ. FT.	PATIO AREA BETWEEN TOWERS B & C: 1,167 SQ. FT. ROOF TOP PATIO: 889 SQ. FT.	PATIO AREA BETWEEN TOWERS B & C: 1,167 SQ. FT.

SITE/BUILDING DATA

PROJECT ADDRESS: 1319 4TH NW
SITE ACREAGE: 0.98 ACRES
TOTAL UNITS: 56
TOTAL D.U. - 57.14
TOTAL GROSS SQ. FT. PER TOWER:
TOTAL GROSS SQ. FT.:
CONSTRUCTION TYPE: V-A
BUILDING HEIGHT: TOWER A: 38'-8"
TOWER B: 49'-8"
TOWER C: 38'-8"
ACCESSIBLE PARKING
NEW STREET LIGHTING STANDARD
EXISTING STREET LIGHTING STANDARD
(1) EXISTING & (2) NEW FIRE HYDRANT
MOTORCYCLE PARKING




VICINITY MAP


ZONE ATLAS - J-14-Z ZONING C-2 COMMERCIAL RETAIL

PARKING CALCULATIONS


Note: Parking Calculations are based on the "North 4th Rank III Corridor Plan"
Required Residential Parking:
(13) Efficiencies → 1.5 spaces per = 19.5 spaces
(23) 1 Bedrooms → 1.5 spaces per = 34.5 spaces
(20) 2 Bedrooms → 1.5 spaces per = 30 spaces
Total - 84 Residential Spaces Required
Required Non-Residential Parking:
1,800 Sq. Ft. Multi-purpose (tenants only) = 0 spaces
249 Sq. Ft. Sales Office → 3/1,000 Sq. Ft. = 3 spaces
Shared parking factor 1.4 reduces to = 2.1 = 3 spaces
2,271 Sq. Ft. Exercise Area (tenants only) = 0 spaces
Total - 3 Non-Residential Spaces Required
Parking Reductions:
NFPA 100 10% reduction = -8.7 spaces
ADA 16-3 (ADA) 10% Transit Reduction = -8.7 spaces
ADA 16-3 (ADA) 5% Transit Shelter = -4.4 spaces
Total - 21.8 = 22 spaces
Total Required Parking Spaces = 65
Parking Spaces Provided:
Off-street Parking Provided:
(50) Standard Spaces
(4) Accessible Spaces
54 Off-street Parking Spaces Provided
On-Street Parking Provided:
(15) Standard Spaces (7) Spaces count towards parking
Total Parking Provided 61 ≤ 65 Required Parking Spaces
(4) ACCESSIBLE PARKING SPACES
(4) MOTORCYCLE SPACES
(28) BICYCLE PARKING SPACES

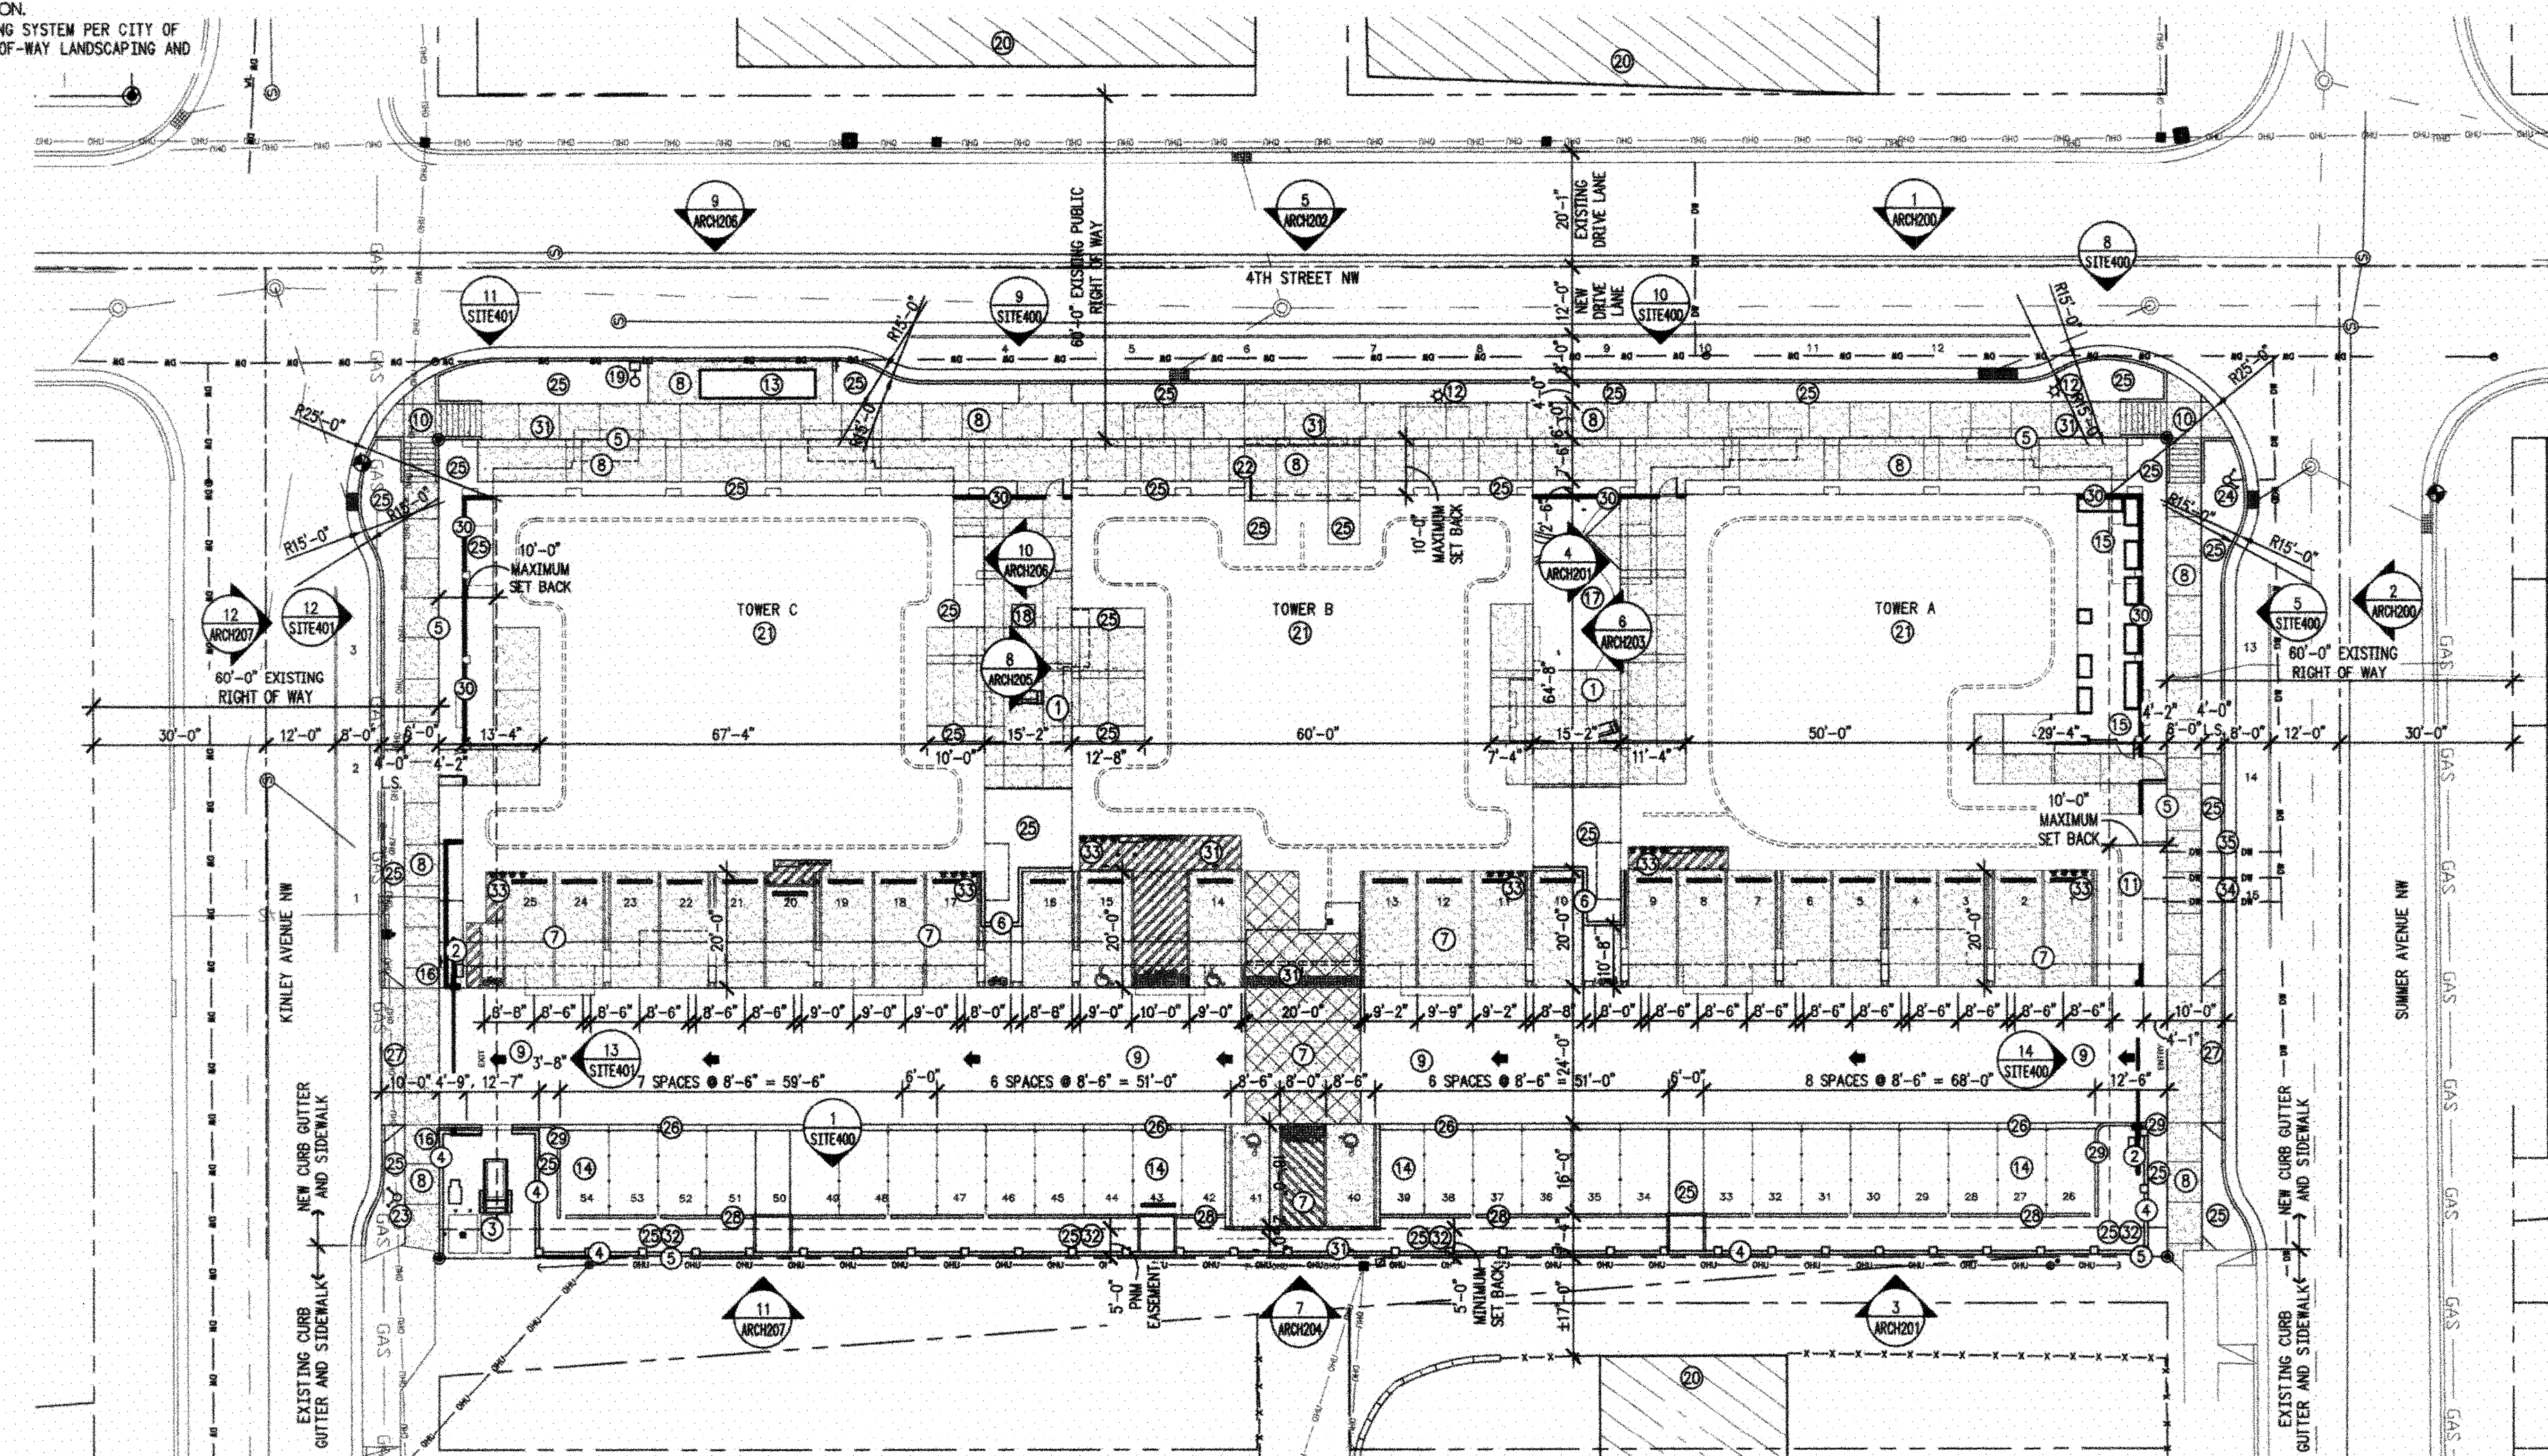

NEW ARCHITECTURAL SITE KEY PLAN

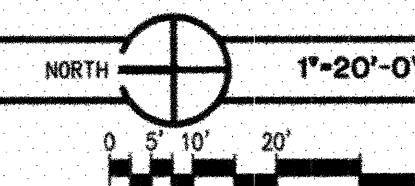

KEY PLAN

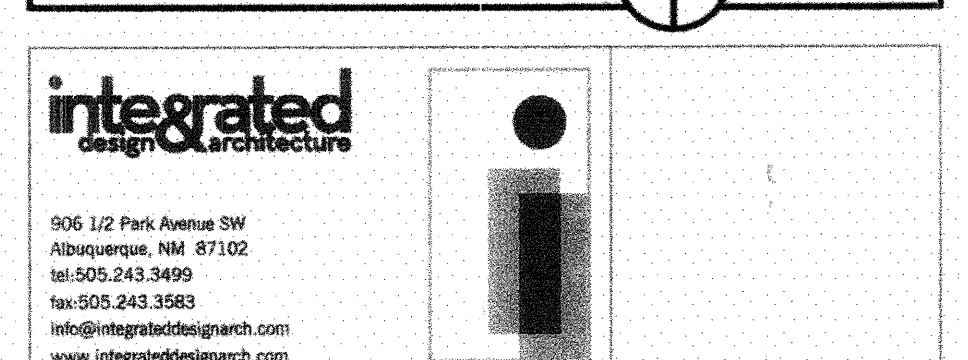

Greater Albuquerque Housing Partnership

CUATRO
Albuquerque, New Mexico

PROJECT ARCHITECT: BOB HALL, AIA Project #: IDA-14-13-P Date: SEPTEMBER 22, 2014


NEW ARCHITECTURAL SITE KEY PLAN

By: KIS File: DRB SITE PLAN.DWG Sheet of 11 Plot Date: 10/29/2014 8:20:30 AM SITE100

FOR INFORMATION ONLY



OVERALL SITE PLAN

City Project No. 744381 Zone Map No. J-14 Sheet 3 of 11

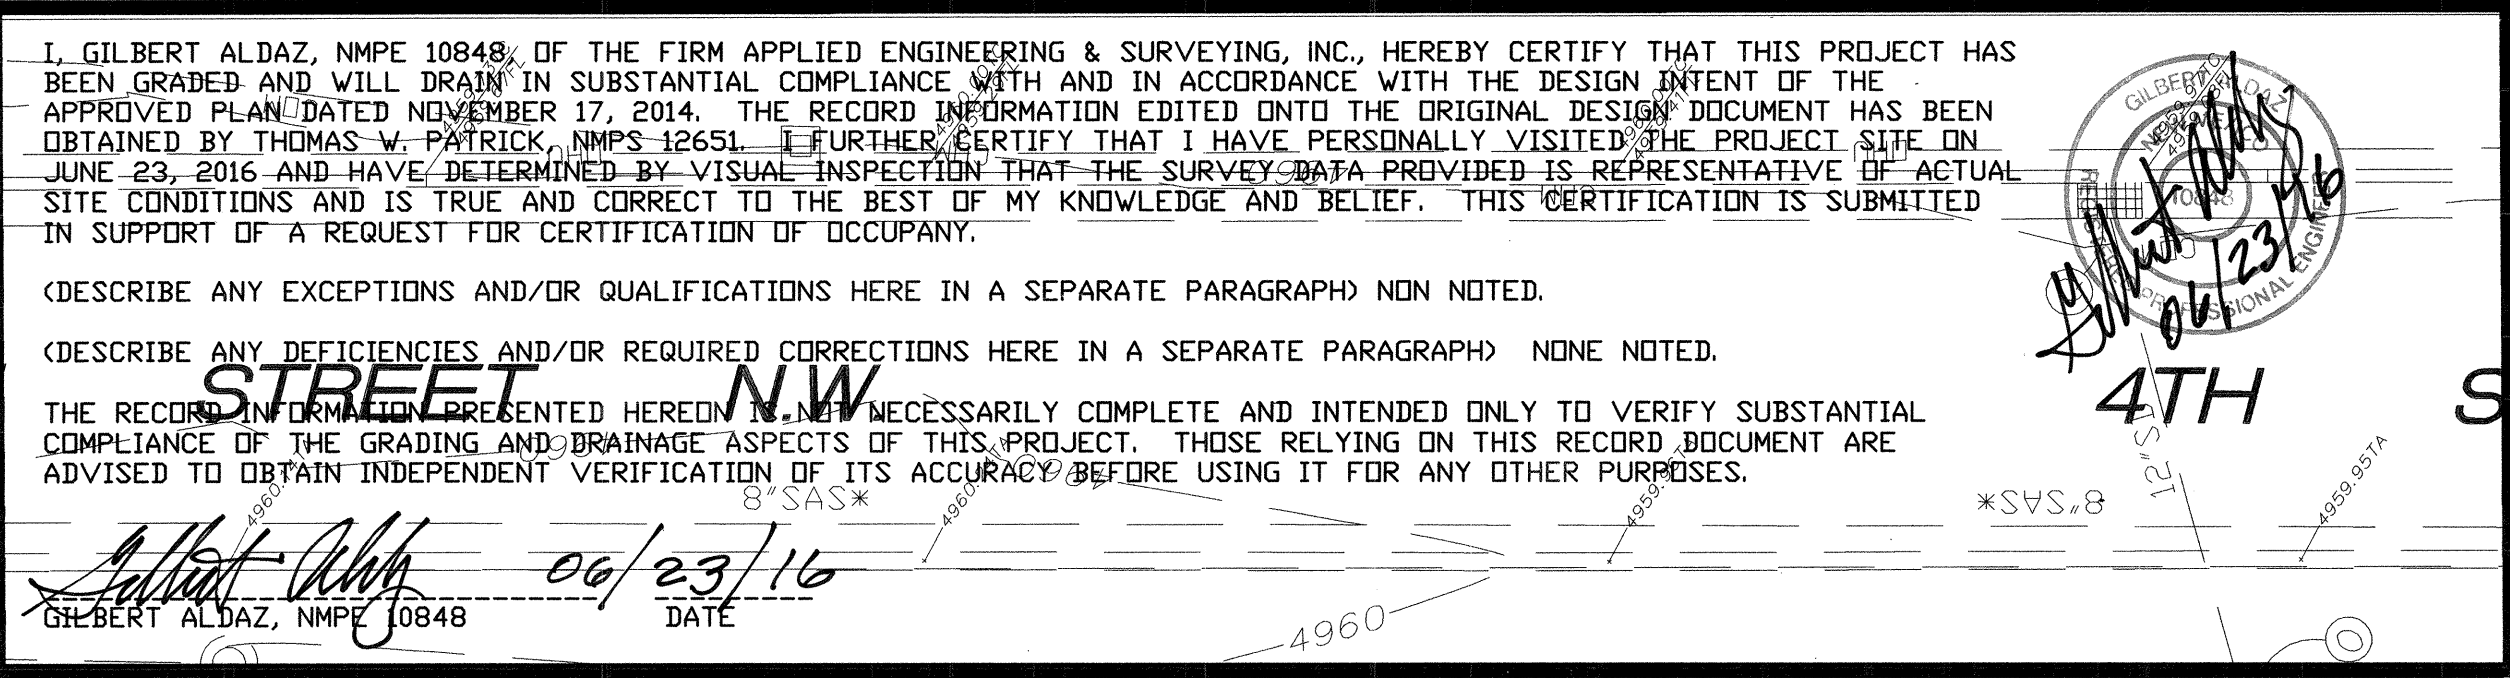

CONSTRUCTION NOTES:

- ① CONSTRUCT SINGLE TYPE "C" INLET
- ② INSTALL 18" STORM DRAIN.
- ③ INSTALL 6" HIGH CONCRETE STEM WALL ABOVE FINISH FLOOR GRADE AT THIS LOCATION WITH ELEVATION =4960.90
- ④ INSTALL GEOPAVE POROUS PAVEMENT SYSTEM WITH POROUS AGGREGATE PER PRESTO GEOSYSTEMS MANUFACTURERS RECOMMENDATIONS (SEE DETAIL SHEET 4).
- ⑤ INSTALL 12" THICK WITH 2-4" ROUND COBBLE DRAIN FIELD.
- ⑥ ASPHALT PAVING, SEE SITE PLAN FOR DETAILS.
- ⑦ 6" CONCRETE CURB WITH 1' OPENING, SEE SITE PLAN FOR DETAILS.
- ⑧ CONCRETE STRIP, SEE SITE PLAN FOR DETAILS.
- ⑨ BLOCK WALL, SEE SITE PLAN FOR DETAILS.
- ⑩ WATER SURFACE ELEVATION = 4960.15 REQUIRED FOR 0.5" RUNOFF DETENTION PRIOR TO SPILLING OVER DRIVEWAY.
- ⑪ FIELD VERIFY THE SIZE, TYPE OF PIPE, INVERT LOCATION OF EXISTING STORMDRAIN LINE SINCE THE AS-BUILTS ARE NOT CLEAR WITH THIS INFORMATION AND SEND TO ENGINEER PRIOR TO CONSTRUCTION OF NEW STORMDRAIN LINE FOR FIELD ADJUSTMENTS IF REQUIRED.
- ⑫ INSTALL NEW 4' ROUND MANHOLE IN EXISTING STORMDRAIN LINE.
- ⑬ OVERTURN ONE CMU BLOCK AT GRADE TO ALLOW DRAINAGE WATER FROM REFUSE AREA TO DRAIN TO LANDSCAPED AREA.

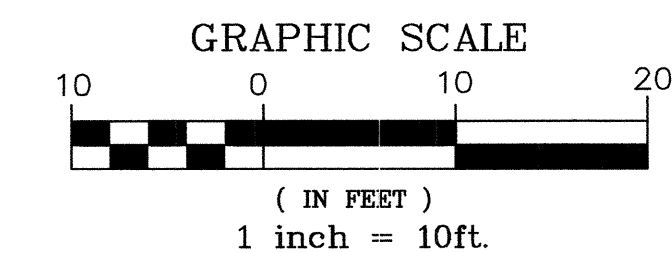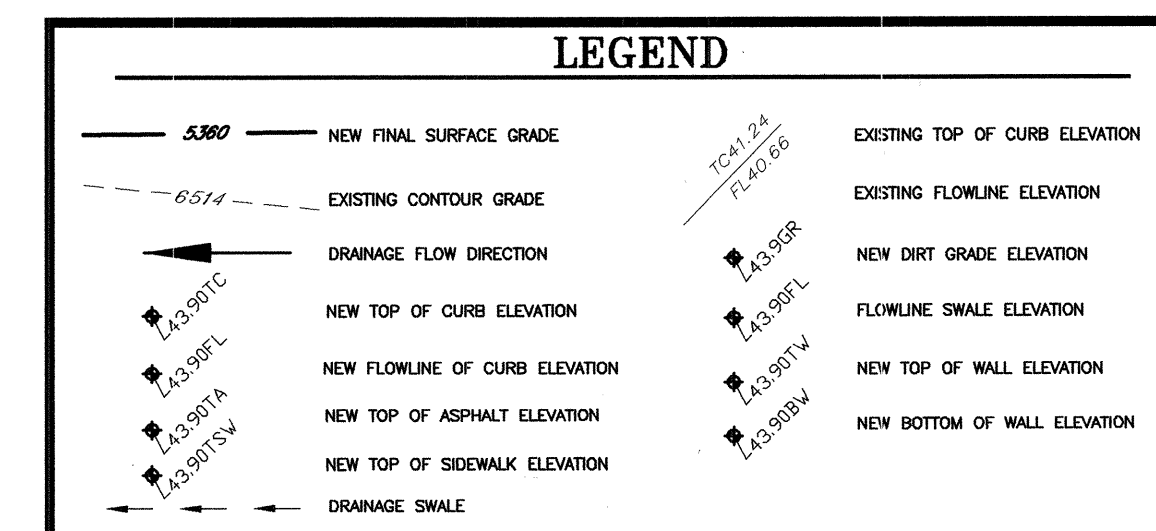

City Project No. 744381

FOR INFORMATION ONLY

DRAINAGE AND GRADING PLAN
CUATRO DEVELOPMENT-NORTH HALF

**APPLIED ENGINEERING AND
SURVEYING, INC.
ENGINEERS AND PLANNERS**
1605 Black Drive NE Albuquerque, New Mexico 87112

4 OF 11


I, GILBERT ALDAZ, NMPE 10848, OF THE FIRM APPLIED ENGINEERING & SURVEYING, INC., HEREBY CERTIFY THAT THIS PROJECT HAS BEEN GRADED AND WILL DRAIN IN SUBSTANTIAL COMPLIANCE WITH AND IN ACCORDANCE WITH THE DESIGN INTENT OF THE APPROVED PLAN DATED NOVEMBER 17, 2014. THE RECORD INFORMATION EDITED ONTO THE ORIGINAL DESIGN DOCUMENT HAS BEEN OBTAINED BY THOMAS W. PATRICK, NMPS 12651. I FURTHER CERTIFY THAT I HAVE PERSONALLY VISITED THE PROJECT SITE ON JUNE 23, 2016 AND HAVE DETERMINED BY VISUAL INSPECTION THAT THE SURVEY DATA PROVIDED IS REPRESENTATIVE OF ACTUAL SITE CONDITIONS AND IS TRUE AND CORRECT TO THE BEST OF MY KNOWLEDGE AND BELIEF. THIS CERTIFICATION IS SUBMITTED IN SUPPORT OF A REQUEST FOR CERTIFICATION OF OCCUPANCY.

(DESCRIBE ANY EXCEPTIONS AND/OR QUALIFICATIONS HERE IN A SEPARATE PARAGRAPH) NONE NOTED.

(DESCRIBE ANY DEFICIENCIES AND/OR REQUIRED CORRECTIONS HERE IN A SEPARATE PARAGRAPH) NONE NOTED.

THE RECORD INFORMATION PRESENTED HEREON IS NOT NECESSARILY COMPLETE AND INTENDED ONLY TO VERIFY SUBSTANTIAL COMPLIANCE OF THE GRADING AND DRAINAGE ASPECTS OF THIS PROJECT. THOSE RELYING ON THIS RECORD DOCUMENT ARE ADVISED TO OBTAIN INDEPENDENT VERIFICATION OF ITS ACCURACY BEFORE USING IT FOR ANY OTHER PURPOSES.

Gilbert Aldaz
GILBERT ALDAZ, NMPE 10848
DATE 06/23/16

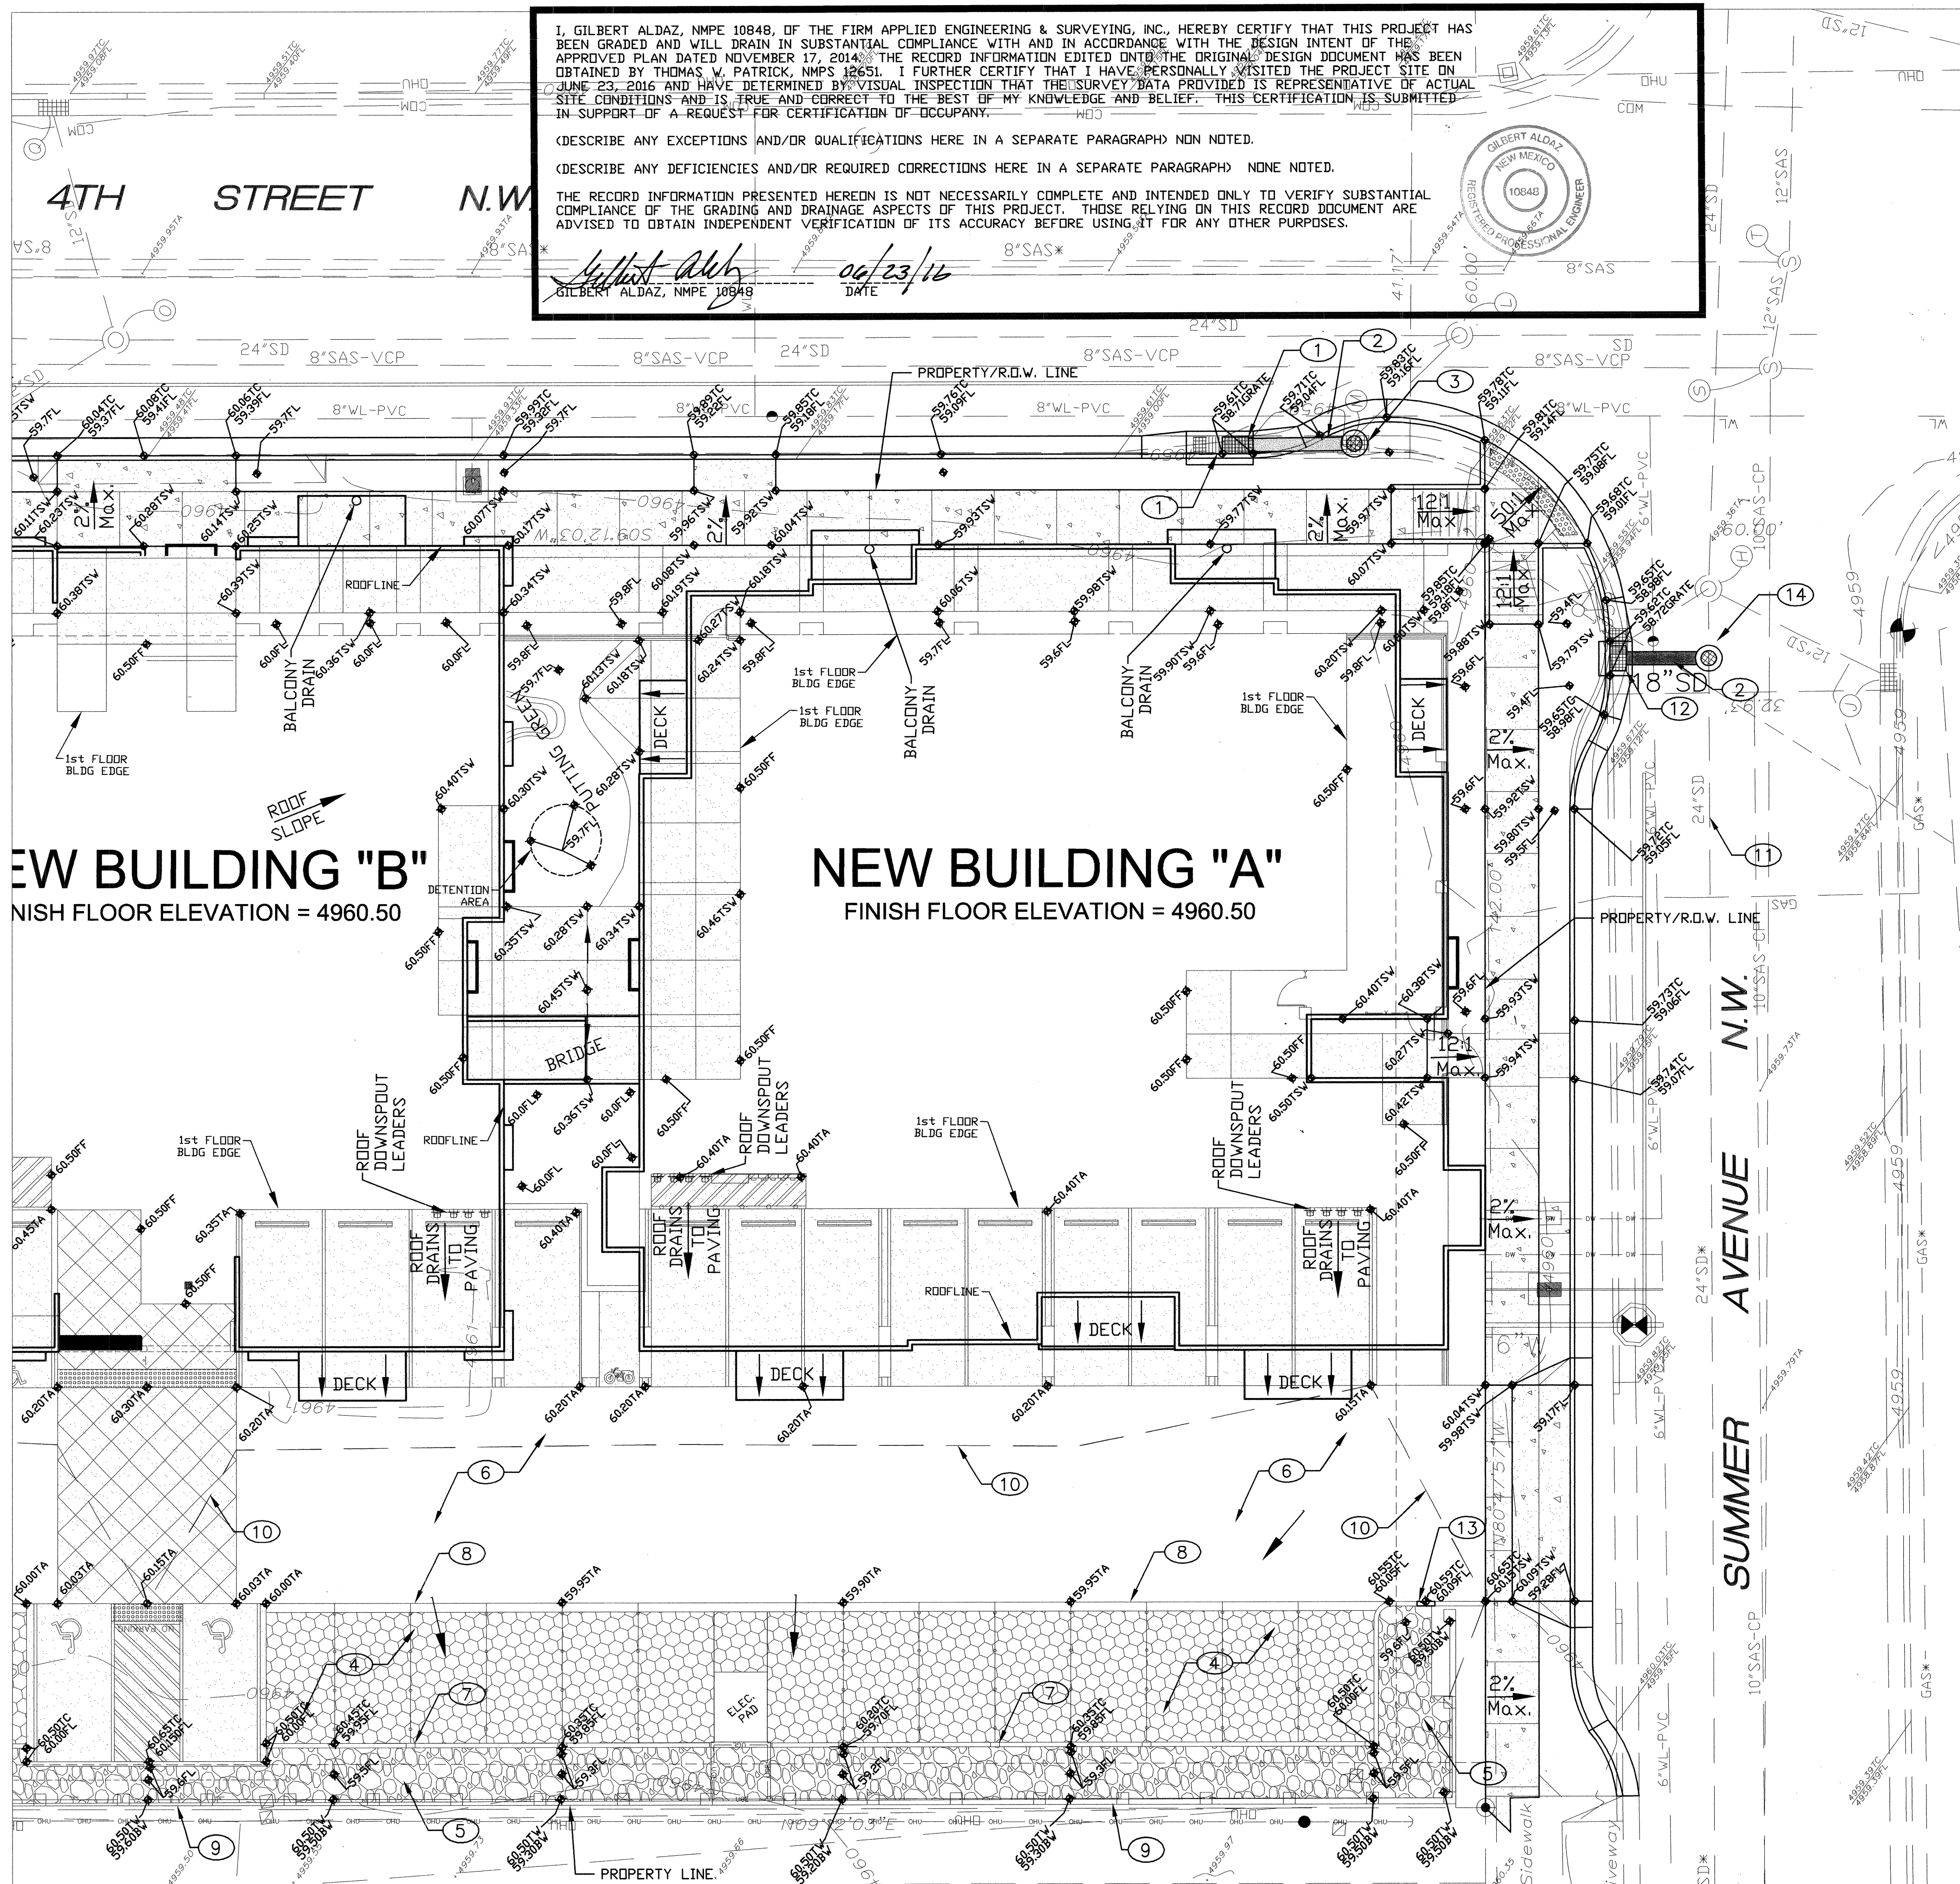


KEYED INVERT DATA

(A) Storm Drain MH Rim = 4960.49' Inv. = 4956.84' (N) Inv. = 4956.69' (S) Inv. = 4956.79' (NE) Inv. = 4956.74' (W)	(J) Storm Drain Inlet Top of Grate = 4958.56' Inv. = 4954.16' (NE)	(R) Sanitary Sewer MH Rim = 4960.52' Inv. = 4950.47' (S) Inv. = 4950.32' (N) Inv. = 4950.22' (E) Inv. = 4950.17' (W)
(B) Storm Drain Inlet Top of Grate = 4959.52' Inv. = 4957.6'	(K) Storm Drain MH Rim = 4959.41' Inv. = 4955.91' (SW) Inv. = 4955.06' (NE) Inv. = 4953.71' (E) Inv. = 4953.66' (W)	(S) Sanitary Sewer MH Rim = 4959.56' Inv. = 4949.41' (S) Inv. = 4949.41' (N) Inv. = 4949.41' (W) Inv. = 4949.41' (E)
(C) Storm Drain MH Rim = 4960.30' Inv. = 4956.38' (N) Inv. = 4956.25' (S) Inv. = 4956.30' (NW)	(L) Storm Drain MH Rim = 4959.61' Inv. = 4959.61' (Lid Cracked) No Access - Lid Cracked	(T) Sanitary Sewer MH Rim = 4959.70' Inv. = 4952.00' (N) Inv. = 4949.55' (W) Inv. = 4949.35' (E)
(D) Storm Drain MH Rim = 4960.06' Inv. = 4956.11' (N) Inv. = 4956.06' (S)	(M) Storm Drain Inlet Top of Grate = 4958.85' Inv. = 4956.35' (SE)	(U) Sanitary Sewer MH Rim = 4960.02' Inv. = 4952.02' (Lid Sealed)
(E) Storm Drain Inlet Top of Grate = 4959.43' Inv. = 4957.5'	(N) Storm Drain MH Rim = 4959.93' Inv. = 4956.13' (NW) Inv. = 4956.13' (NE) Inv. = 4955.93' (N) Inv. = 4955.88' (S)	(V) Sanitary Sewer MH Rim = 4960.30' Inv. = 4955.70' (SW) Inv. = 4952.05' (W)
(F) Storm Drain Inlet Top of Grate = 4959.98' Full of debris	(P) Storm Drain Inlet Top of Grate = 4959.19' Inv. = 4957.29' (SE)	(W) Sanitary Sewer MH Rim = 4959.95' Inv. = 4951.31' (E) Inv. = 4951.31' (W) Inv. = 4951.26' (N) Inv. = 4951.16' (S)
(G) Sanitary Sewer MH Rim = 4959.93' Inv. = 4952.89' (E)	(O) Storm Drain Inlet Top of Grate = 4959.07' Inv. = 4956.97' (SW)	(X) Sanitary Sewer MH Rim = 4959.97' Inv. = 4952.82' (S)

CONSTRUCTION NOTES:


- CONSTRUCT SINGLE TYPE "A" INLET
- INSTALL 18" STORM DRAIN.
- REMOVE EXISTING TYPE "A" INLET AND INSTALL 4' ROUND MANHOLE, EXISTING LATERAL ON 4TH STREET IS TO REMAIN.
- INSTALL GEOPAVE POROUS PAVEMENT SYSTEM WITH POROUS AGGREGATE PER PRESTO GEOSYSTEMS MANUFACTURERS RECOMMENDATIONS (SEE DETAIL SHEET 4).
- INSTALL 12" THICK WITH 2-4" ROUND COBBLE DRAIN FIELD.
- ASPHALT PAVING, SEE SITE PLAN FOR DETAILS.
- 6" CONCRETE CURB WITH 1' OPENING, SEE SITE PLAN FOR DETAILS.
- CONCRETE STRIP, SEE SITE PLAN FOR DETAILS.
- BLOCK WALL, SEE SITE PLAN FOR DETAILS.
- WATER SURFACE ELEVATION = 4960.15 REQUIRED FOR 0.5' RUNOFF DETENTION PRIOR TO SPILLING OVER DRIVEWAY.
- FIELD VERIFY SIZE OF EXISTING STORM DRAIN LINE PRIOR TO CONSTRUCTION, IF DIFFERENT THAN 24" DIAMETER ADVISE ENGINEER PRIOR TO CONSTRUCTION.
- CONSTRUCT SINGLE TYPE "C" INLET.
- 2' WIDE CURB OPENING TO ALLOW DRAINAGE TO OVERFLOW OUT TO DRIVEWAY ON SUMMER AVENUE.
- INSTALL NEW 4' ROUND MANHOLE IN EXISTING STORM DRAIN LINE.

LEGEND			
5.500	NEW FINAL SURFACE GRADE	TCAL 24	EXISTING TOP OF CURB ELEVATION
6.514	EXISTING CONTOUR GRADE	FL 0.00	EXISTING FLOWLINE ELEVATION
6.514	DRAINAGE FLOW DIRECTION	FL 0.00	NEW DIRT GRADE ELEVATION
6.514	NEW TOP OF CURB ELEVATION	FL 0.00	FLOWLINE SWALE ELEVATION
6.514	NEW FLOWLINE OF CURB ELEVATION	FL 0.00	NEW TOP OF WALL ELEVATION
6.514	NEW TOP OF ASPHALT ELEVATION	FL 0.00	NEW BOTTOM OF WALL ELEVATION
6.514	NEW TOP OF SIDEWALK ELEVATION	FL 0.00	
6.514	DRAINAGE SWALE		

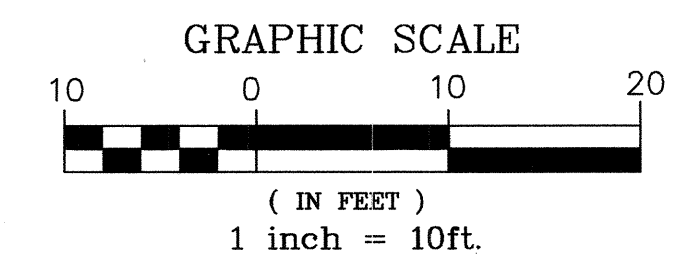

City Project No. 744381


FILE:	DATE/REVISIONS:
DRAINAGE AND GRADING PLAN CUATRO DEVELOPMENT-SOUTH HALF	
APPLIED ENGINEERING AND SURVEYING, INC. ENGINEERS AND PLANNERS 1000 8th Street, Suite 100 Albuquerque, New Mexico 87102 Office: (505) 480-8125 albert@aesinc.com	
SHEET NUMBER: 5 OF 11	

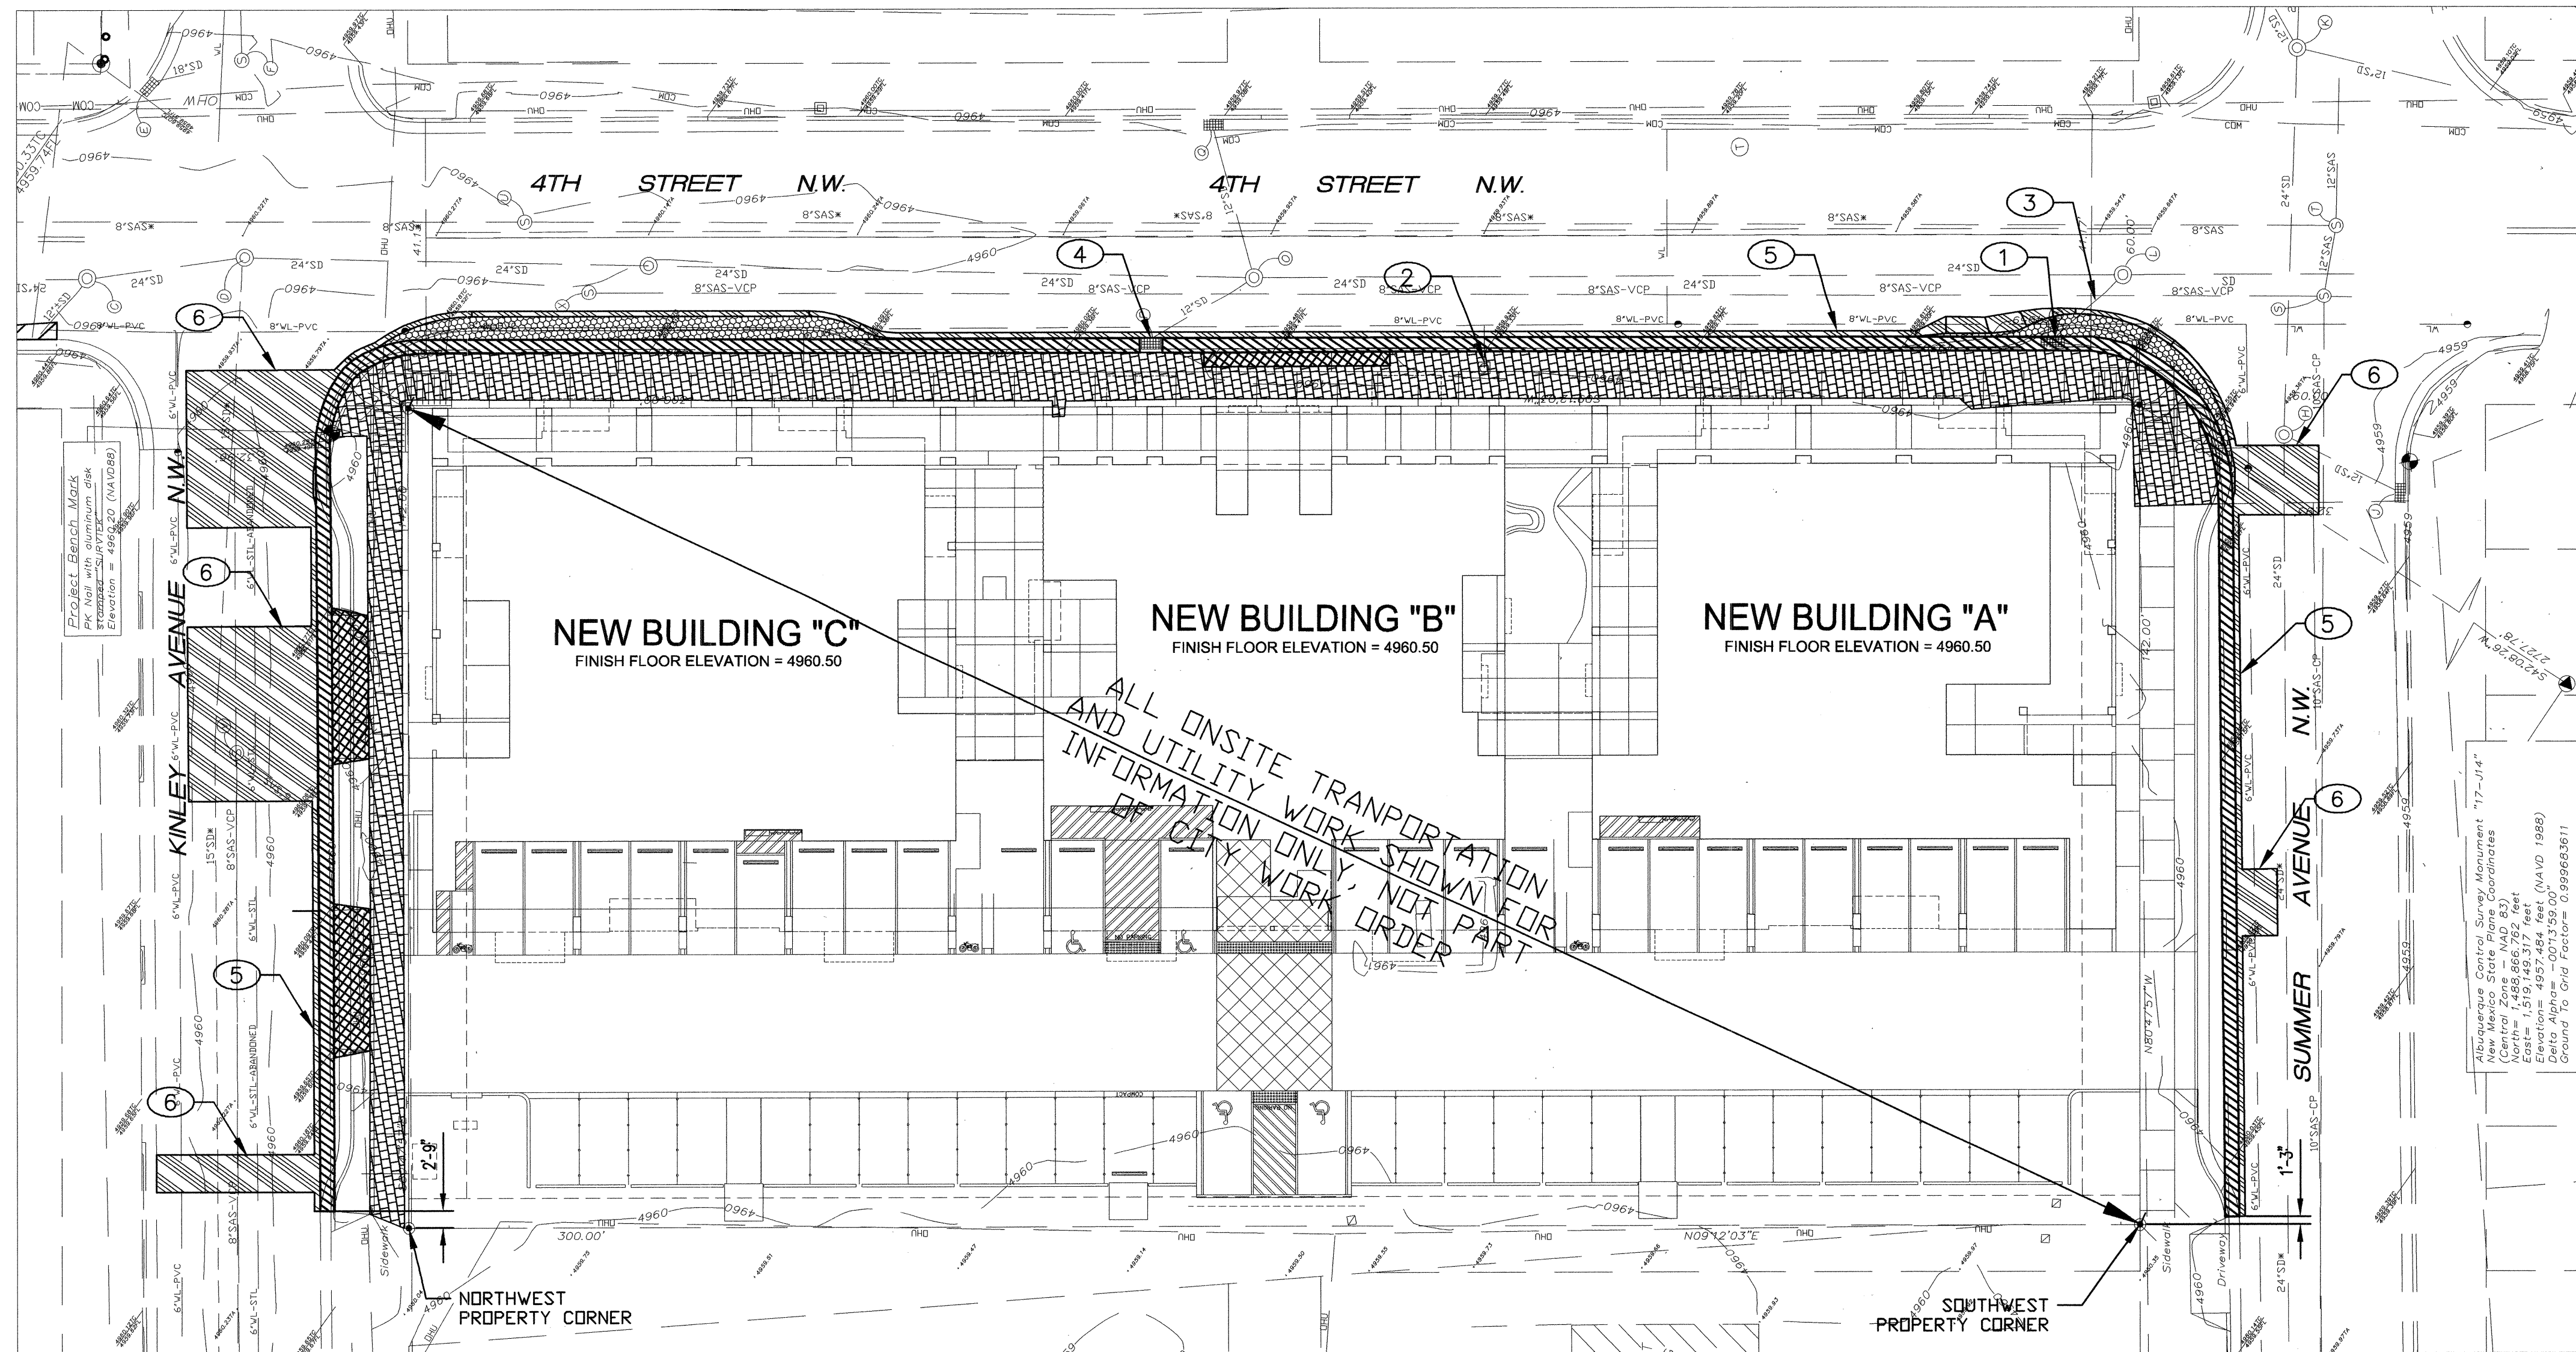

REMOVAL PLAN WITHIN CITY ROW
SCALE: 1" = 20'

CONSTRUCTION NOTES:

- EXISTING DROP INLET TO BE REMOVED.
- REMOVE EXISTING WATERMETER BOX.
- EXISTING STORMDRAIN LINE IS TO BE PROTECTED DURING CONSTRUCTION.
- EXISTING INLET IS TO BE PROTECTED DURING CONSTRUCTION.
- CONTRACTOR SHALL CAREFULLY REMOVE EXISTING CURB AND GUTTER TO HELP MINIMIZE ANY SPALLING OF ASPHALT OR SUBGRADE UNDERMINING. OTHERWISE, 1 FOOT WIDE OF EXISTING ASPHALT PAVEMENT SHALL BE REMOVED AND REPLACED PER STD. DWG. 2465.
- SEE SHEETS 8 AND 9 FOR REMOVAL LIMITS FOR NEW UTILITIES AND NEW STORMDRAIN.

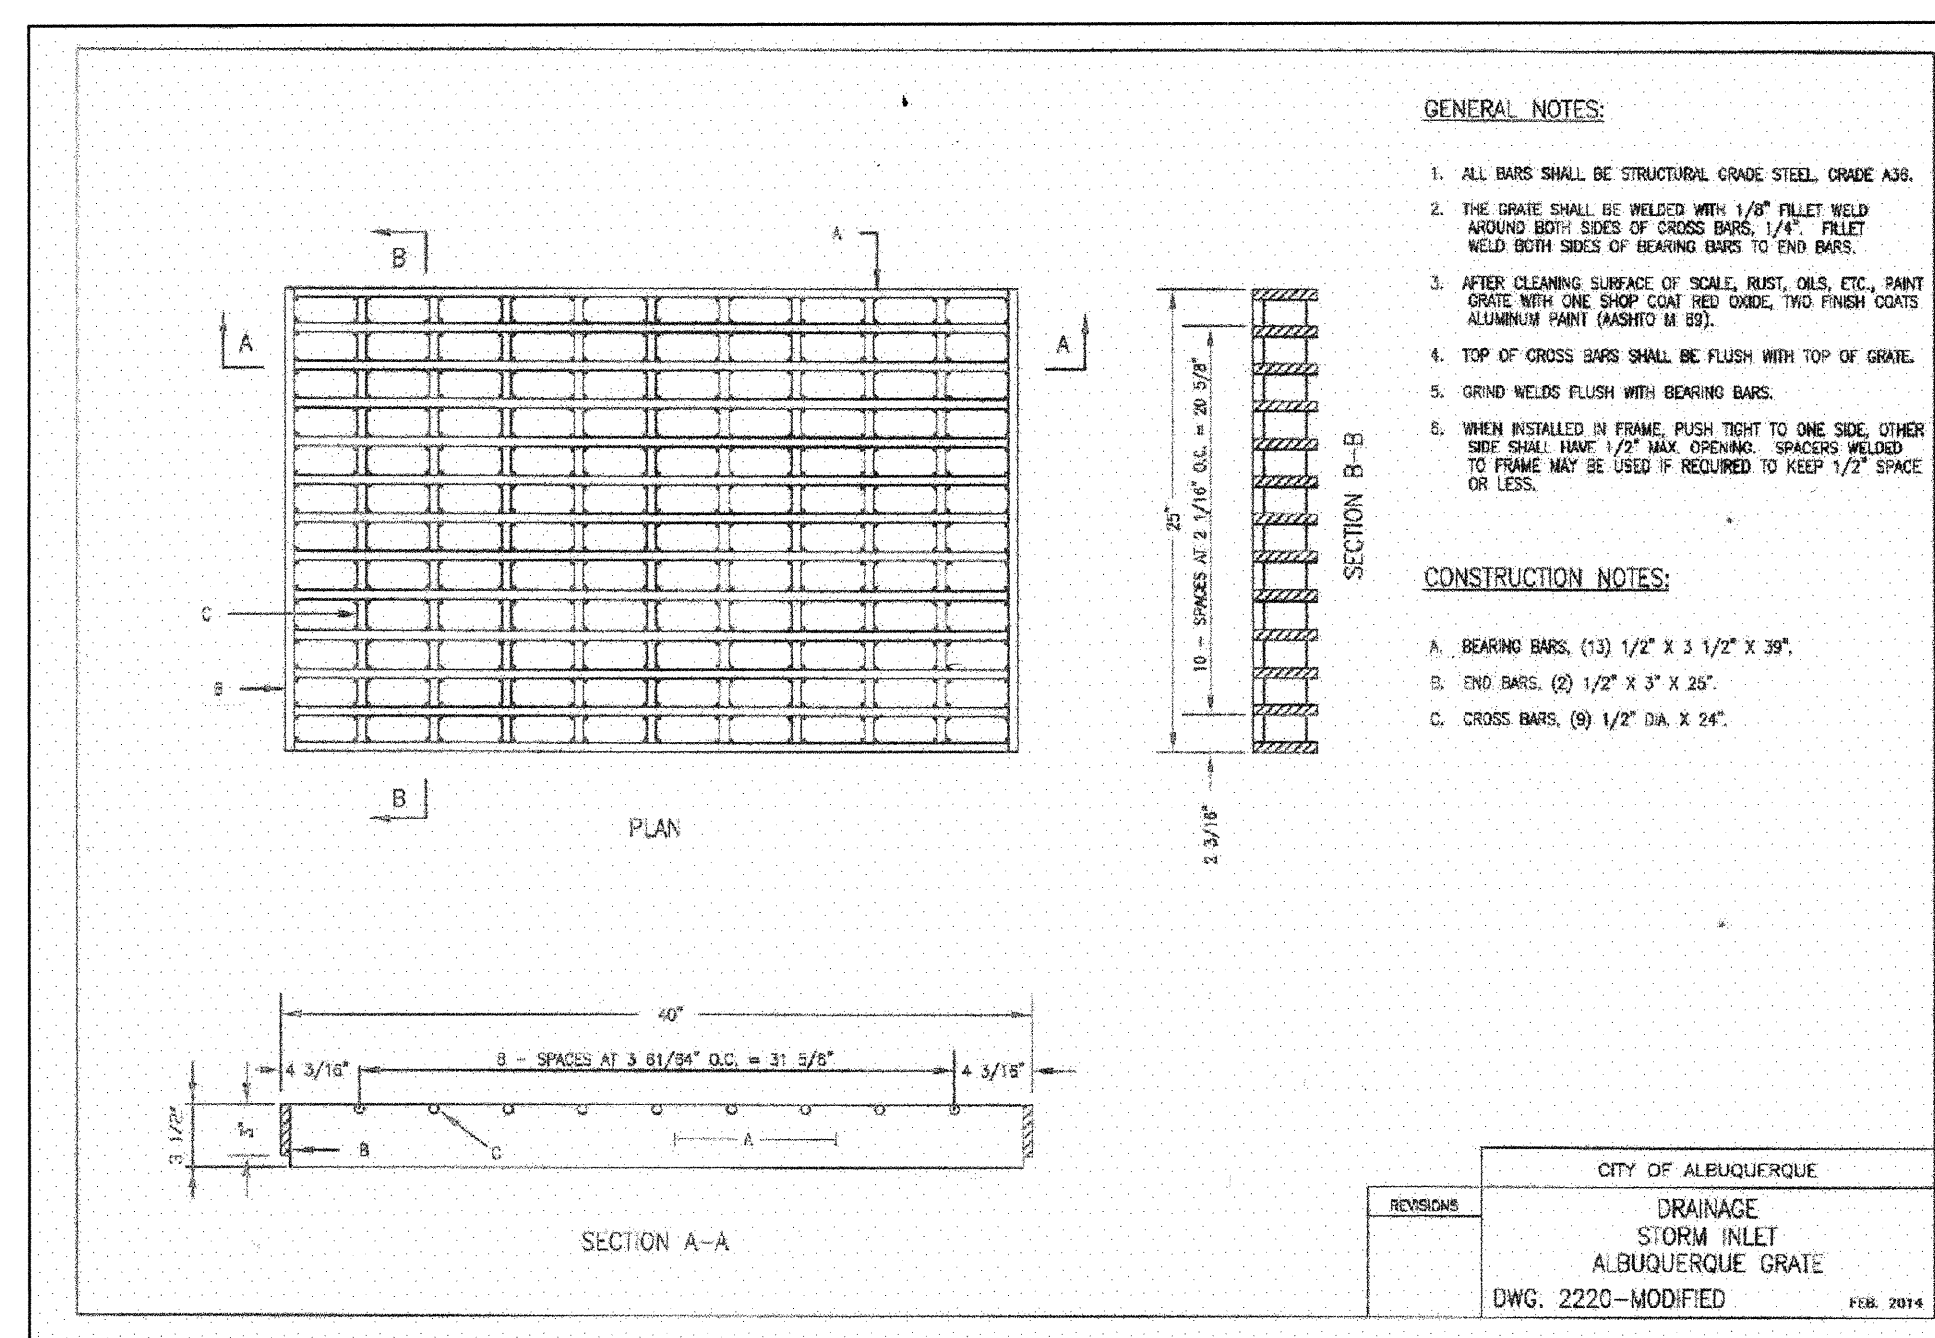


KEYED INVERT DATA

- | | |
|--|---|
| (A) Storm Drain MH
Rim = 4960.49'
Inv. = 4956.84' (N)
Inv. = 4956.69' (S)
Inv. = 4956.79' (NE)
Inv. = 4956.74' (W) | (P) Storm Drain MH
Rim = 4959.93'
Inv. = 4956.13' (NW)
Inv. = 4956.13' (NE)
Inv. = 4955.93' (N)
Inv. = 4955.88' (S) |
| (B) Storm Drain Inlet
Top of Grate = 4959.52'
Inv. = 4957.6' | (Q) Storm Drain Inlet
Top of Grate = 4959.19'
Inv. = 4957.29' (SE) |
| (C) Storm Drain MH
Rim = 4960.30'
Inv. = 4956.38' (N)
Inv. = 4956.25' (S)
Inv. = 4956.30' (NW) | (R) Storm Drain Inlet
Top of Grate = 4959.07'
Inv. = 4956.97' (SW) |
| (D) Storm Drain MH
Rim = 4960.06'
Inv. = 4956.11' (N)
Inv. = 4956.06' (S) | (S) Sanitary Sewer MH
Rim = 4960.52'
Inv. = 4950.47' (S)
Inv. = 4950.32' (N)
Inv. = 4950.22' (E)
Inv. = 4950.17' (W) |
| (E) Storm Drain Inlet
Top of Grate = 4959.43'
Inv. = 4957.5' | (T) Sanitary Sewer MH
Rim = 4959.56'
Inv. = 4949.41' (S)
Inv. = 4949.41' (N)
Inv. = 4949.41' (E)
Inv. = 4949.41' (W)
No Lines Flowing |
| (F) Manhole
Rim = 4959.98'
Full of debris
No Lines Flowing | (U) Sanitary Sewer MH
Rim = 4959.93'
Inv. = 4952.00' (N)
Inv. = 4949.55' (W)
Inv. = 4949.35' (E) |
| (G) Sanitary Sewer MH
Rim = 4959.93'
Inv. = 4952.89' (E) | (V) Sanitary Sewer MH
Rim = 4960.30'
Inv. = 4955.75' (SW)
Inv. = 4952.05' (W) |
| (H) Storm Drain MH
Rim = 4959.29'
Inv. = 4954.34' (W)
Inv. = 4954.24' (E)
Inv. = 4954.29' (SW) | (W) Sanitary Sewer MH
Rim = 4959.95'
Inv. = 4951.31' (E)
Inv. = 4951.31' (W)
Inv. = 4951.26' (N)
Inv. = 4951.16' (S) |
| (I) Storm Drain Inlet
Top of Grate = 4958.56'
Inv. = 4954.16' (NE)
Inv. = 4952.05' (W) | (X) Sanitary Sewer MH
Rim = 4959.97'
Inv. = 4952.82' (S) |
| (J) Storm Drain MH
Rim = 4959.41'
Inv. = 4956.91' (SW)
Inv. = 4955.06' (NE)
Inv. = 4953.71' (E)
Inv. = 4953.66' (W) | |
| (K) Storm Drain MH
Rim = 4959.61'
Inv. = 4955.81'
No Access - Lid Cracked | |
| (L) Storm Drain Inlet
Top of Grate = 4958.85'
Inv. = 4956.35' (SE) | |

REMOVALS LEGEND

- | | |
|--|---|
| | INDICATES EXTENT OF EXISTING CONCRETE DRIVEWAY REMOVALS |
| | INDICATES EXTENT OF EXISTING CONCRETE CURB AND GUTTER REMOVALS |
| | INDICATES EXTENT OF EXISTING CONCRETE SIDEWALK REMOVALS |
| | INDICATES EXTENT OF EXISTING SAWCUTTING AND ASPHALT REMOVALS, REPLACE WITH ASPHALT PER CITY STD. DWG. 2465. |
| | INDICATES EXTENT OF EXISTING ASPHALT REMOVALS |

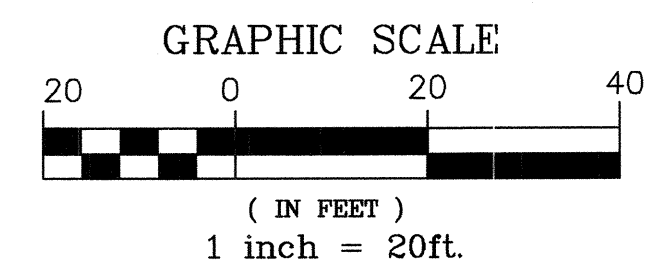


APPLIED ENGINEERING AND SURVEYING, INC.
ENGINEERS AND PLANNERS
1600 Main Street NE
Albuquerque, NM 87106
Office: (505) 237-1406
Fax: (505) 237-1407

CITY OF ALBUQUERQUE
PUBLIC WORKS DEPARTMENT
ENGINEERING DEVELOPMENT GROUP

TITLE: CUATRO DEVELOPMENT APARTMENTS
REMOVAL PLAN WITHIN CITY ROW

Design Review Committee	City Engineer Approval	Mo./Day/Yr.	Mo./Day/Yr.
Last Design Update			


City Project No.	Zone Map No.	Sheet	Of
744381	J-14	6	11

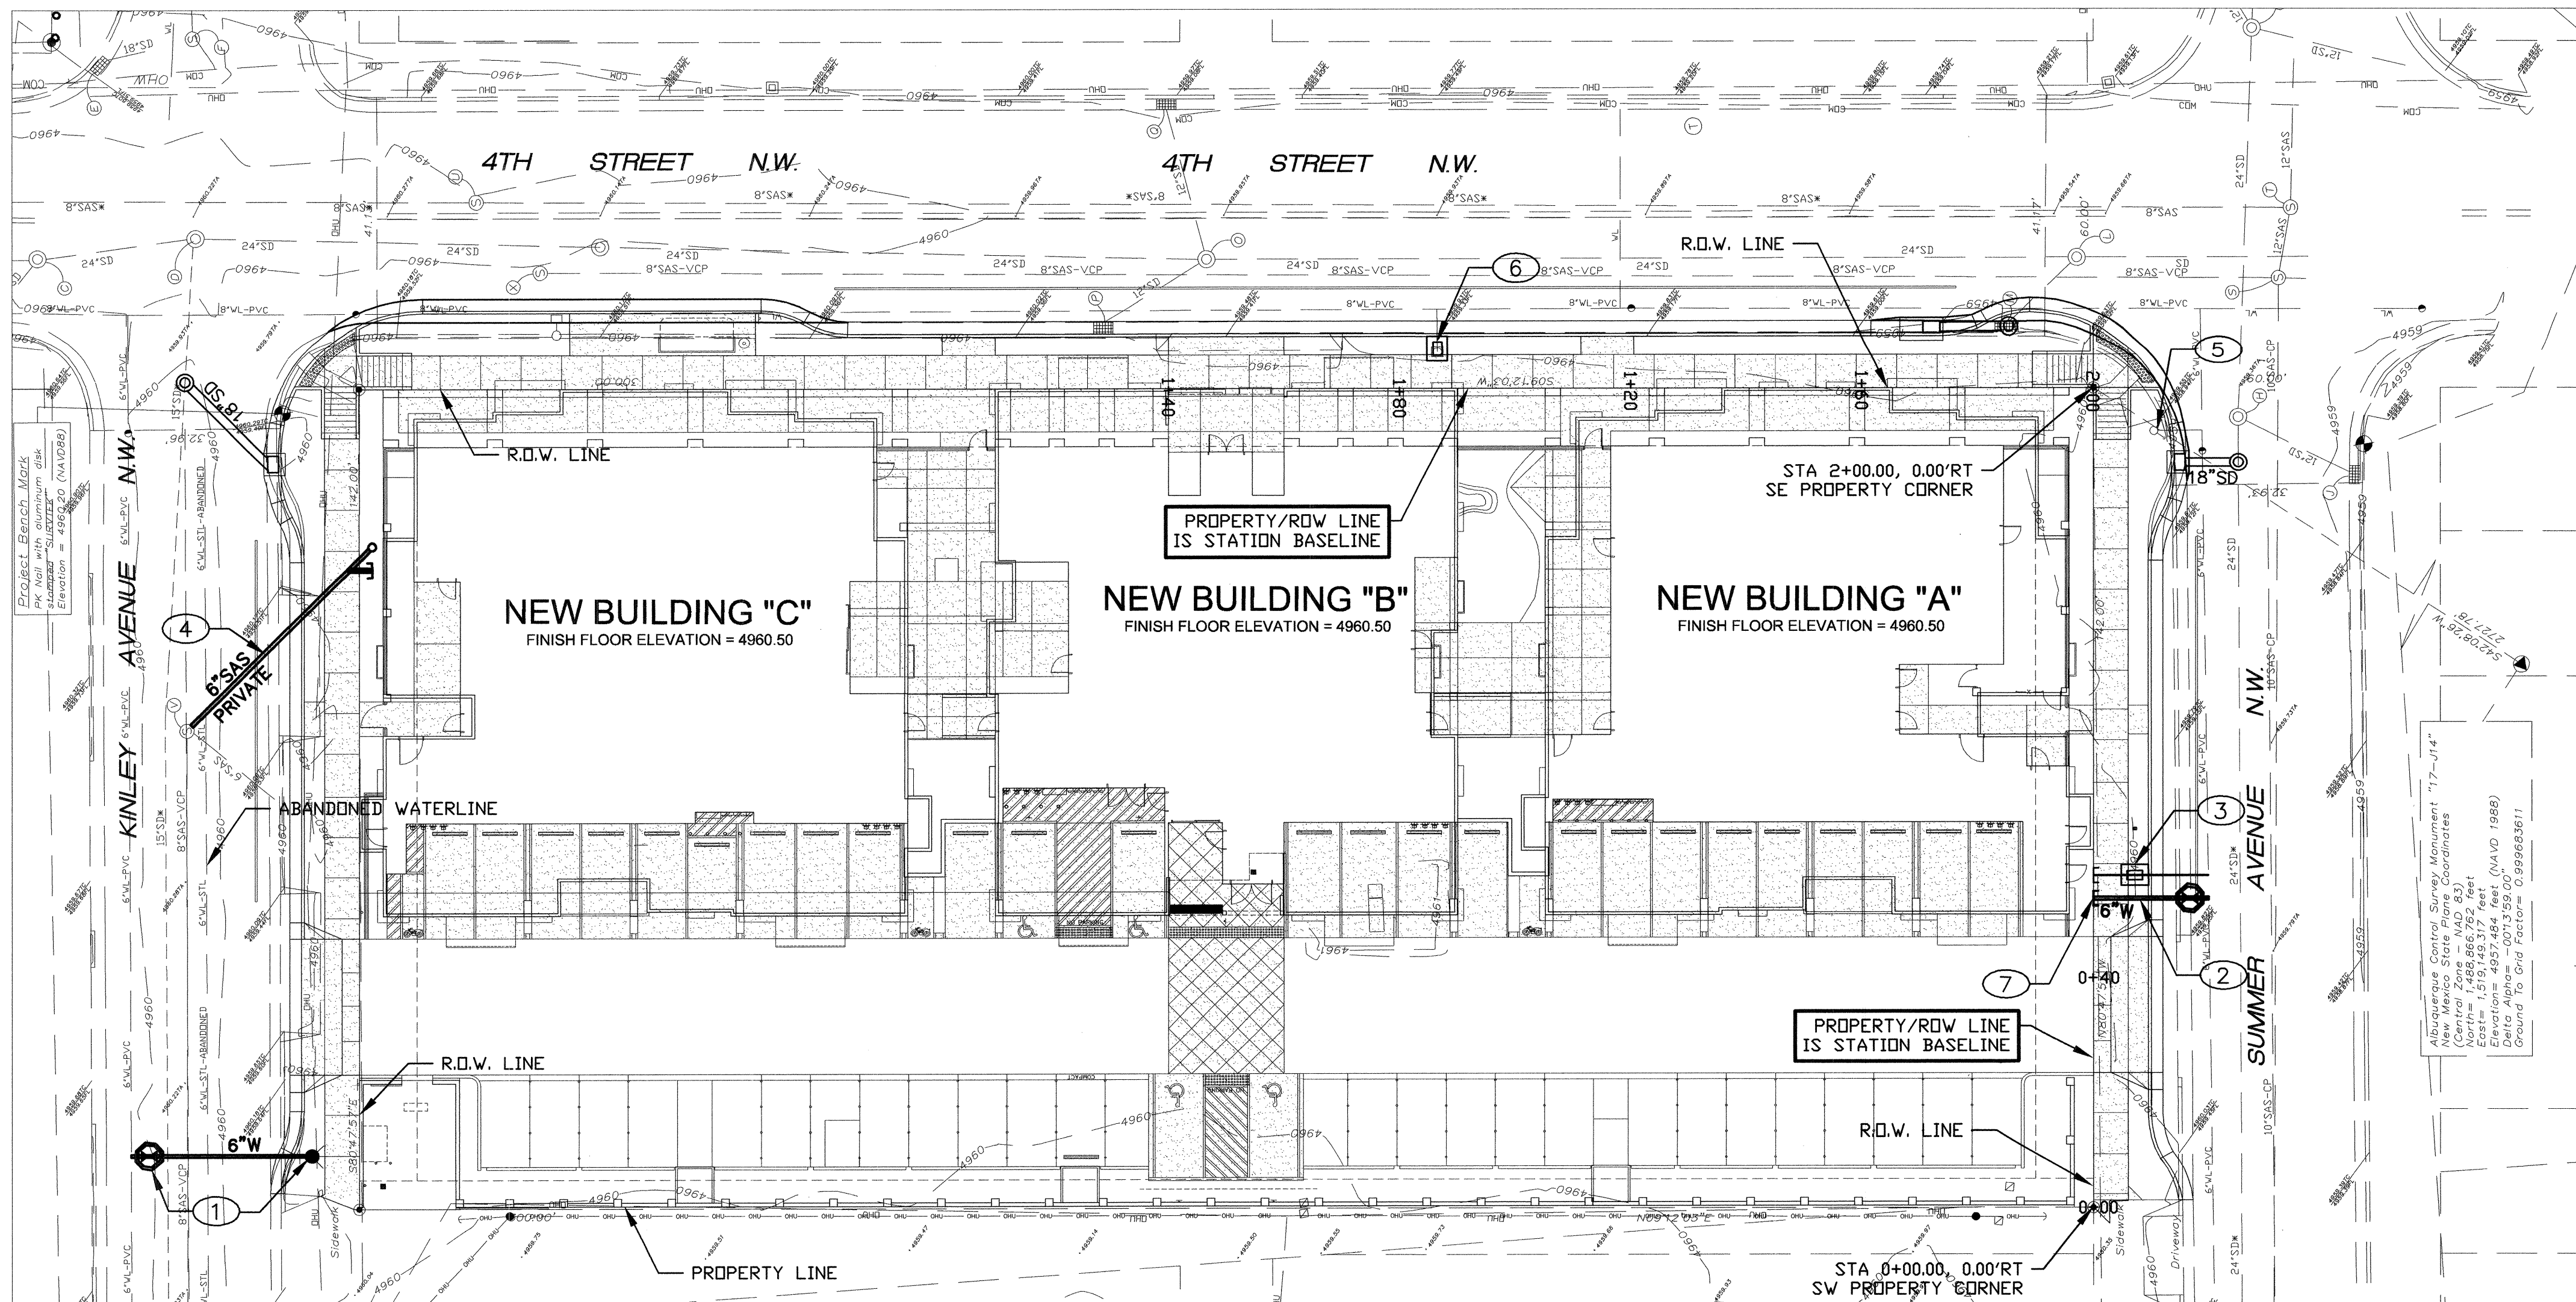

WATER AND SEWER OVERALL PLAN
SCALE: 1" = 20'

CONSTRUCTION NOTES:

- INSTALL FIRE HYDRANT PER STD. DWG. 2340 WITH 6" GATE VALVE AND BOX PER STD. DWG. 2326 AND DWG. 2329.
- INSTALL 6" FIRE LINE FOR BUILDING FIRE SPINKLER SYSTEM WITH 6" GATE VALVE AND BOX.
- INSTALL 2" DOMESTIC METERED WATER SERVICE LINE WITH METER BOX AND LID PER STD. DWG. 2361, DWG. 2363 AND DWG. 2367.
- INSTALL PRIVATE 6" SANITARY SEWER LINE AND CLEANDOUT AND CONNECT INTO EXISTING SANITARY SEWER MANHOLE (SEE SHEET 8 FOR INVERT, SLOPE AND LENGTH), PER STD. DWG. 2118.
- EXISTING 6" FIRE HYDRANT.
- REMOVE EXISTING METER BOX AND INSTALL A NEW 3/4" IRRIGATION METER BOX AND LID PER STD. DWG. 2361, DWG. 2362 AND DWG. 2366 AT STA 0+86.48, 6.5'LT.
- ABCWUA INSPECTOR TO VERIFY PIV CONSTRUCTED TO CODE STANDARDS IN MECHANICAL ROOM PRIOR TO CLOSEDOUT OF WORK ORDER AT STA 0+54.00, 0.0'LT.

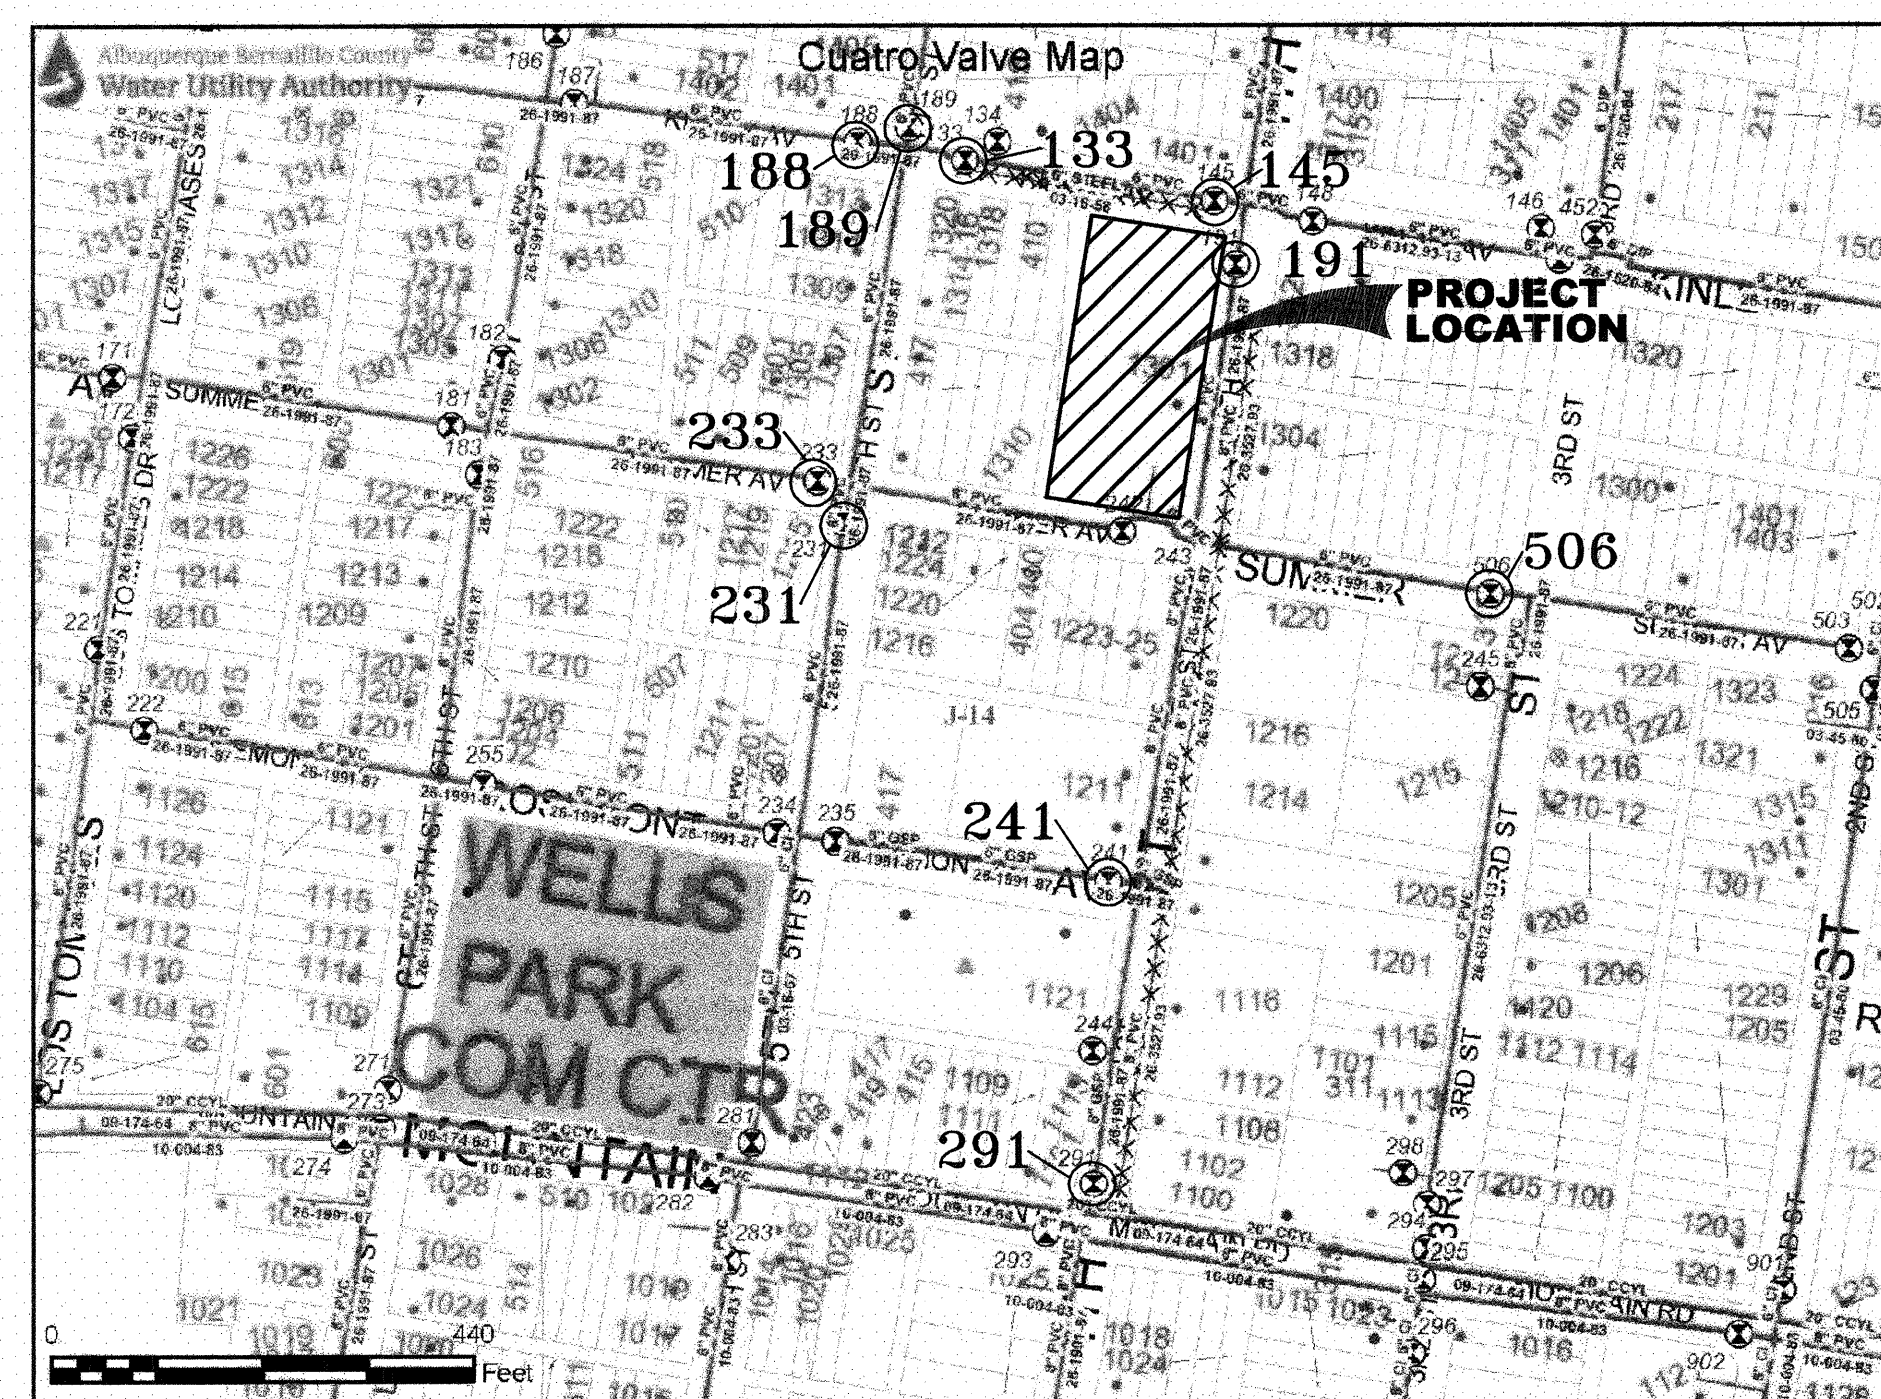

WATER SHUTOFF PLAN
NOT TO SCALE



Water Meter and Fire Line Summary for Multi Family Development				
			Water Meters	
#	Size	Location (Station/Offset)	Use (Domestic/Irrigation)	No. Units Served (applicable to multi-family)
	3/4"	0+86.48, 6.5'LT	Irrigation	56 Units
	2"	0+58.00/7.16'RT	Domestic	
Fire Lines				
#	Size	Location (Station/Offset)		
	6"	0+54.00/0.00'LT		

WATER VALVE SHUT-OFF NOTES

- IN ORDER TO NON-PRESSURIZE THE WATERLINE ON KINLEY AVENUE NW, VALVES 133 AND 145 NEED TO BE SHUT-OFF.
- IN ORDER TO NON-PRESSURIZE THE WATERLINE ON SUMMER AVENUE NW, VALVES 133, 188, 189, 191, 231, 233, 241, 291 AND 506 NEED TO BE SHUT-OFF.

EXISTING SANITARY AND STORMDRAIN KEYED INVERT DATA

- | | |
|--|--|
| <p>(A) Storm Drain MH
Rim= 4960.49'
Inv.= 4956.13' (N)
Inv.= 4956.69' (S)
Inv.= 4956.79' (NE)
Inv.= 4956.74' (W)</p> <p>(B) Storm Drain Inlet
Top of Gate= 4959.52'
Inv.= 4957.6'</p> <p>(C) Storm Drain MH
Rim= 4960.30'
Inv.= 4956.38' (N)
Inv.= 4956.25' (S)
Inv.= 4956.30' (NW)</p> <p>(D) Storm Drain MH
Rim= 4960.06'
Inv.= 4956.11' (N)
Inv.= 4956.06' (S)</p> <p>(E) Storm Drain Inlet
Top of Gate= 4959.43'
Inv.= 4957.5'</p> <p>(F) Manhole
Rim= 4959.98'
Full of debris
No Lines Flowing</p> <p>(G) Sanitary Sewer MH
Rim= 4959.93'
Inv.= 4952.89' (E)</p> <p>(H) Storm Drain MH
Rim= 4959.29'
Inv.= 4954.34' (W)
Inv.= 4954.24' (E)
Inv.= 4954.29' (SW)</p> <p>(I) Storm Drain Inlet
Top of Gate= 4958.56'
Inv.= 4954.16' (NE)</p> <p>(J) Storm Drain MH
Rim= 4959.41'
Inv.= 4956.91' (SW)
Inv.= 4955.06' (NE)
Inv.= 4953.71' (E)
Inv.= 4953.66' (W)</p> <p>(L) Storm Drain MH
Rim= 4959.61'
No Access, Lid Cracked</p> <p>(M) Storm Drain Inlet
Top of Gate= 4958.85'
Inv.= 4956.35' (SE)</p> | <p>(N) Storm Drain MH
Rim= 4959.93'
Inv.= 4956.13' (NW)
Inv.= 4956.13' (NE)
Inv.= 4955.93' (N)
Inv.= 4955.88' (S)</p> <p>(P) Storm Drain Inlet
Top of Gate= 4959.19'
Inv.= 4957.29' (SE)</p> <p>(Q) Storm Drain Inlet
Top of Gate= 4959.07'
Inv.= 4956.97' (SW)</p> <p>(R) Sanitary Sewer MH
Rim= 4960.52'
Inv.= 4950.47' (S)
Inv.= 4950.32' (N)
Inv.= 4950.22' (E)
Inv.= 4950.17' (W)</p> <p>(S) Sanitary Sewer MH
Rim= 4959.56'
Inv.= 4949.41' (S)
Inv.= 4949.41' (N)
Inv.= 4949.41' (W)
No Lines Flowing</p> <p>(T) Sanitary Sewer MH
Rim= 4959.70'
Inv.= 4952.00' (N)
Inv.= 4949.55' (W)
Inv.= 4949.35' (E)</p> <p>(U) Sanitary Sewer MH
Rim= 4960.02'
Lid Sealed</p> <p>(V) Sanitary Sewer MH
Rim= 4960.30'
Inv.= 4955.75' (SW)
Inv.= 4952.05' (W)</p> <p>(W) Sanitary Sewer MH
Rim= 4959.95'
Inv.= 4951.31' (E)
Inv.= 4951.31' (W)
Inv.= 4951.26' (N)
Inv.= 4951.16' (S)</p> <p>(X) Sanitary Sewer MH
Rim= 4959.97'
Inv.= 4952.82' (S)</p> |
|--|--|

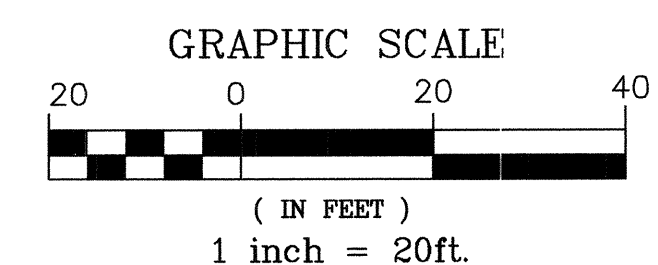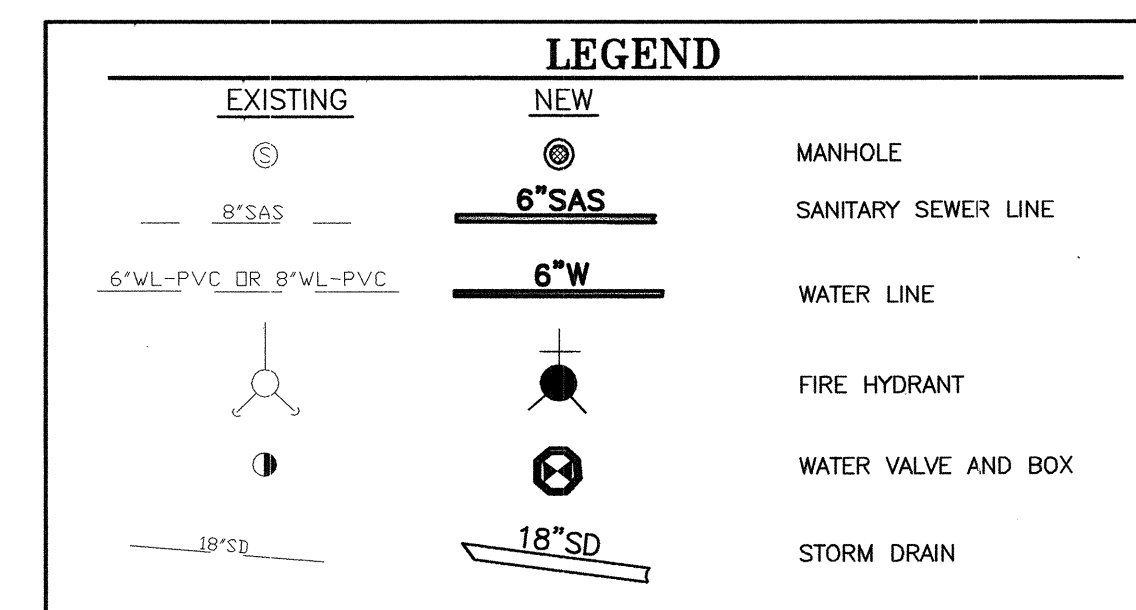

APPLIED ENGINEERING AND SURVEYING, INC.
ENGINEERS AND PLANNERS
Albuquerque, New Mexico 87112
Office: (505) 237-1406

CITY OF ALBUQUERQUE
PUBLIC WORKS DEPARTMENT
ENGINEERING DEVELOPMENT GROUP

**TITLE: WATER AND SEWER OVERALL PLAN
CUATRO DEVELOPMENT**

Design Review Committee	City Engineer Approval	Mo./Day/Yr.	Mo./Day/Yr.
APPROVED MAR 09 2015 DESIGN REVIEW COMMITTEE	APPROVED SEP 29 2015 CITY ENGINEER		
City Project No.	Zone Map No.	Sheet	Of
744381	J-14	7	11

AS-BUILT INFORMATION

CONTRACTOR: **TOPEL** DATE: **07/14**

WORK: **CSC** DATE: **07/14**

INSPECTOR: **CSC** DATE: **07/14**

ACCEPTANCE BY: **A.E.S.** DATE: **07/14**

DRAWINGS BY: **CSC** DATE: **07/14**

REVISIONS BY: **A.E.S.** DATE: **07/14**

ENGINEER'S SEAL







REGISTERED PROFESSIONAL ENGINEER
No. 10000
State of New Mexico


ENGINEER'S SEAL


REGISTERED PROFESSIONAL ENGINEER
No. 10000
State of New Mexico

ENGINEER'S SEAL

REGISTERED PROFESSIONAL ENGINEER
No. 10000
State of New Mexico

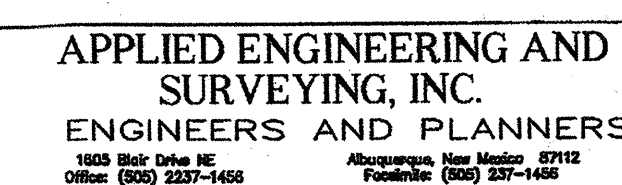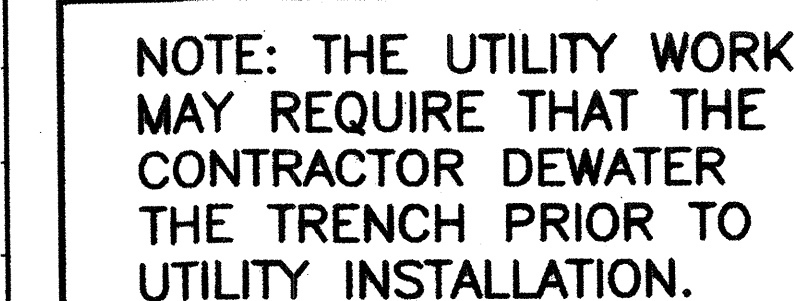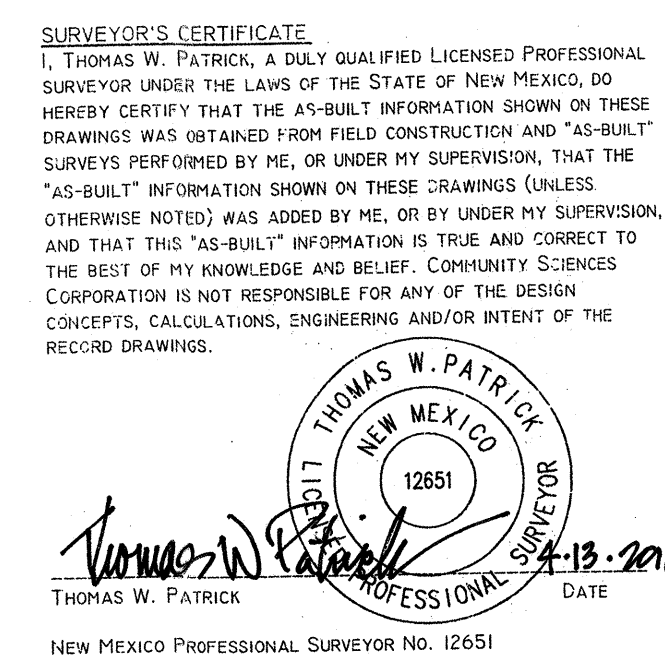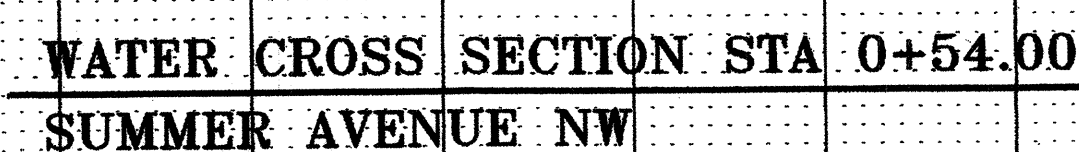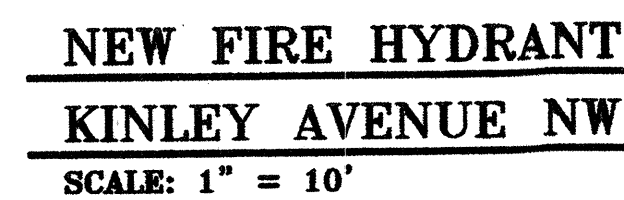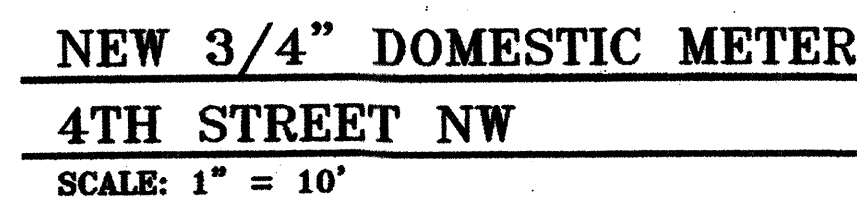

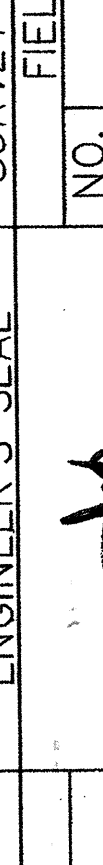PROJECT LOCATION 17-J14, ELEVATION = 4957.484, (NAVD 1988) THE STATION MARK IS A C.O.A. SURVEY CONTROL 3-1/4" ALUMINUM DISC STAMPED "17-J14 1983", SET FLUSH WITH THE TOP OF THE CONCRETE AT THE WEST SIDE OF THE INTERSECTION IN THE MEDIAN OF EIGHTH STREET N.W. AND LOWAS AVENUE N.W.		BENCH MARKS BENCHMARK IS AN A.C.S. MONUMENT "17-J14", ELEVATION = 4957.484, (NAVD 1988) THE STATION MARK IS A C.O.A. SURVEY CONTROL 3-1/4" ALUMINUM DISC STAMPED "17-J14 1983", SET FLUSH WITH THE TOP OF THE CONCRETE AT THE WEST SIDE OF THE INTERSECTION IN THE MEDIAN OF EIGHTH STREET N.W. AND LOWAS AVENUE N.W.		AS BUILT INFORMATION CONTRACTOR TLC MARKED BY CSC ACCEPTANCE BY APPLIED ENGINEERING FIELD DRAWINGS BY CSC CORRECTED BY CSC RECORDED BY NO.	
SURVEY INFORMATION FIELD NOTES NO. BY DATE		ENGINEER'S SEAL 		REMARKS REVISIONS DESIGN	
NO. DATE		BY		DATE	
DESIGNED BY		DATE		DATE	
DRAWN BY		DATE		DATE	
SURVEYED BY		DATE		DATE	

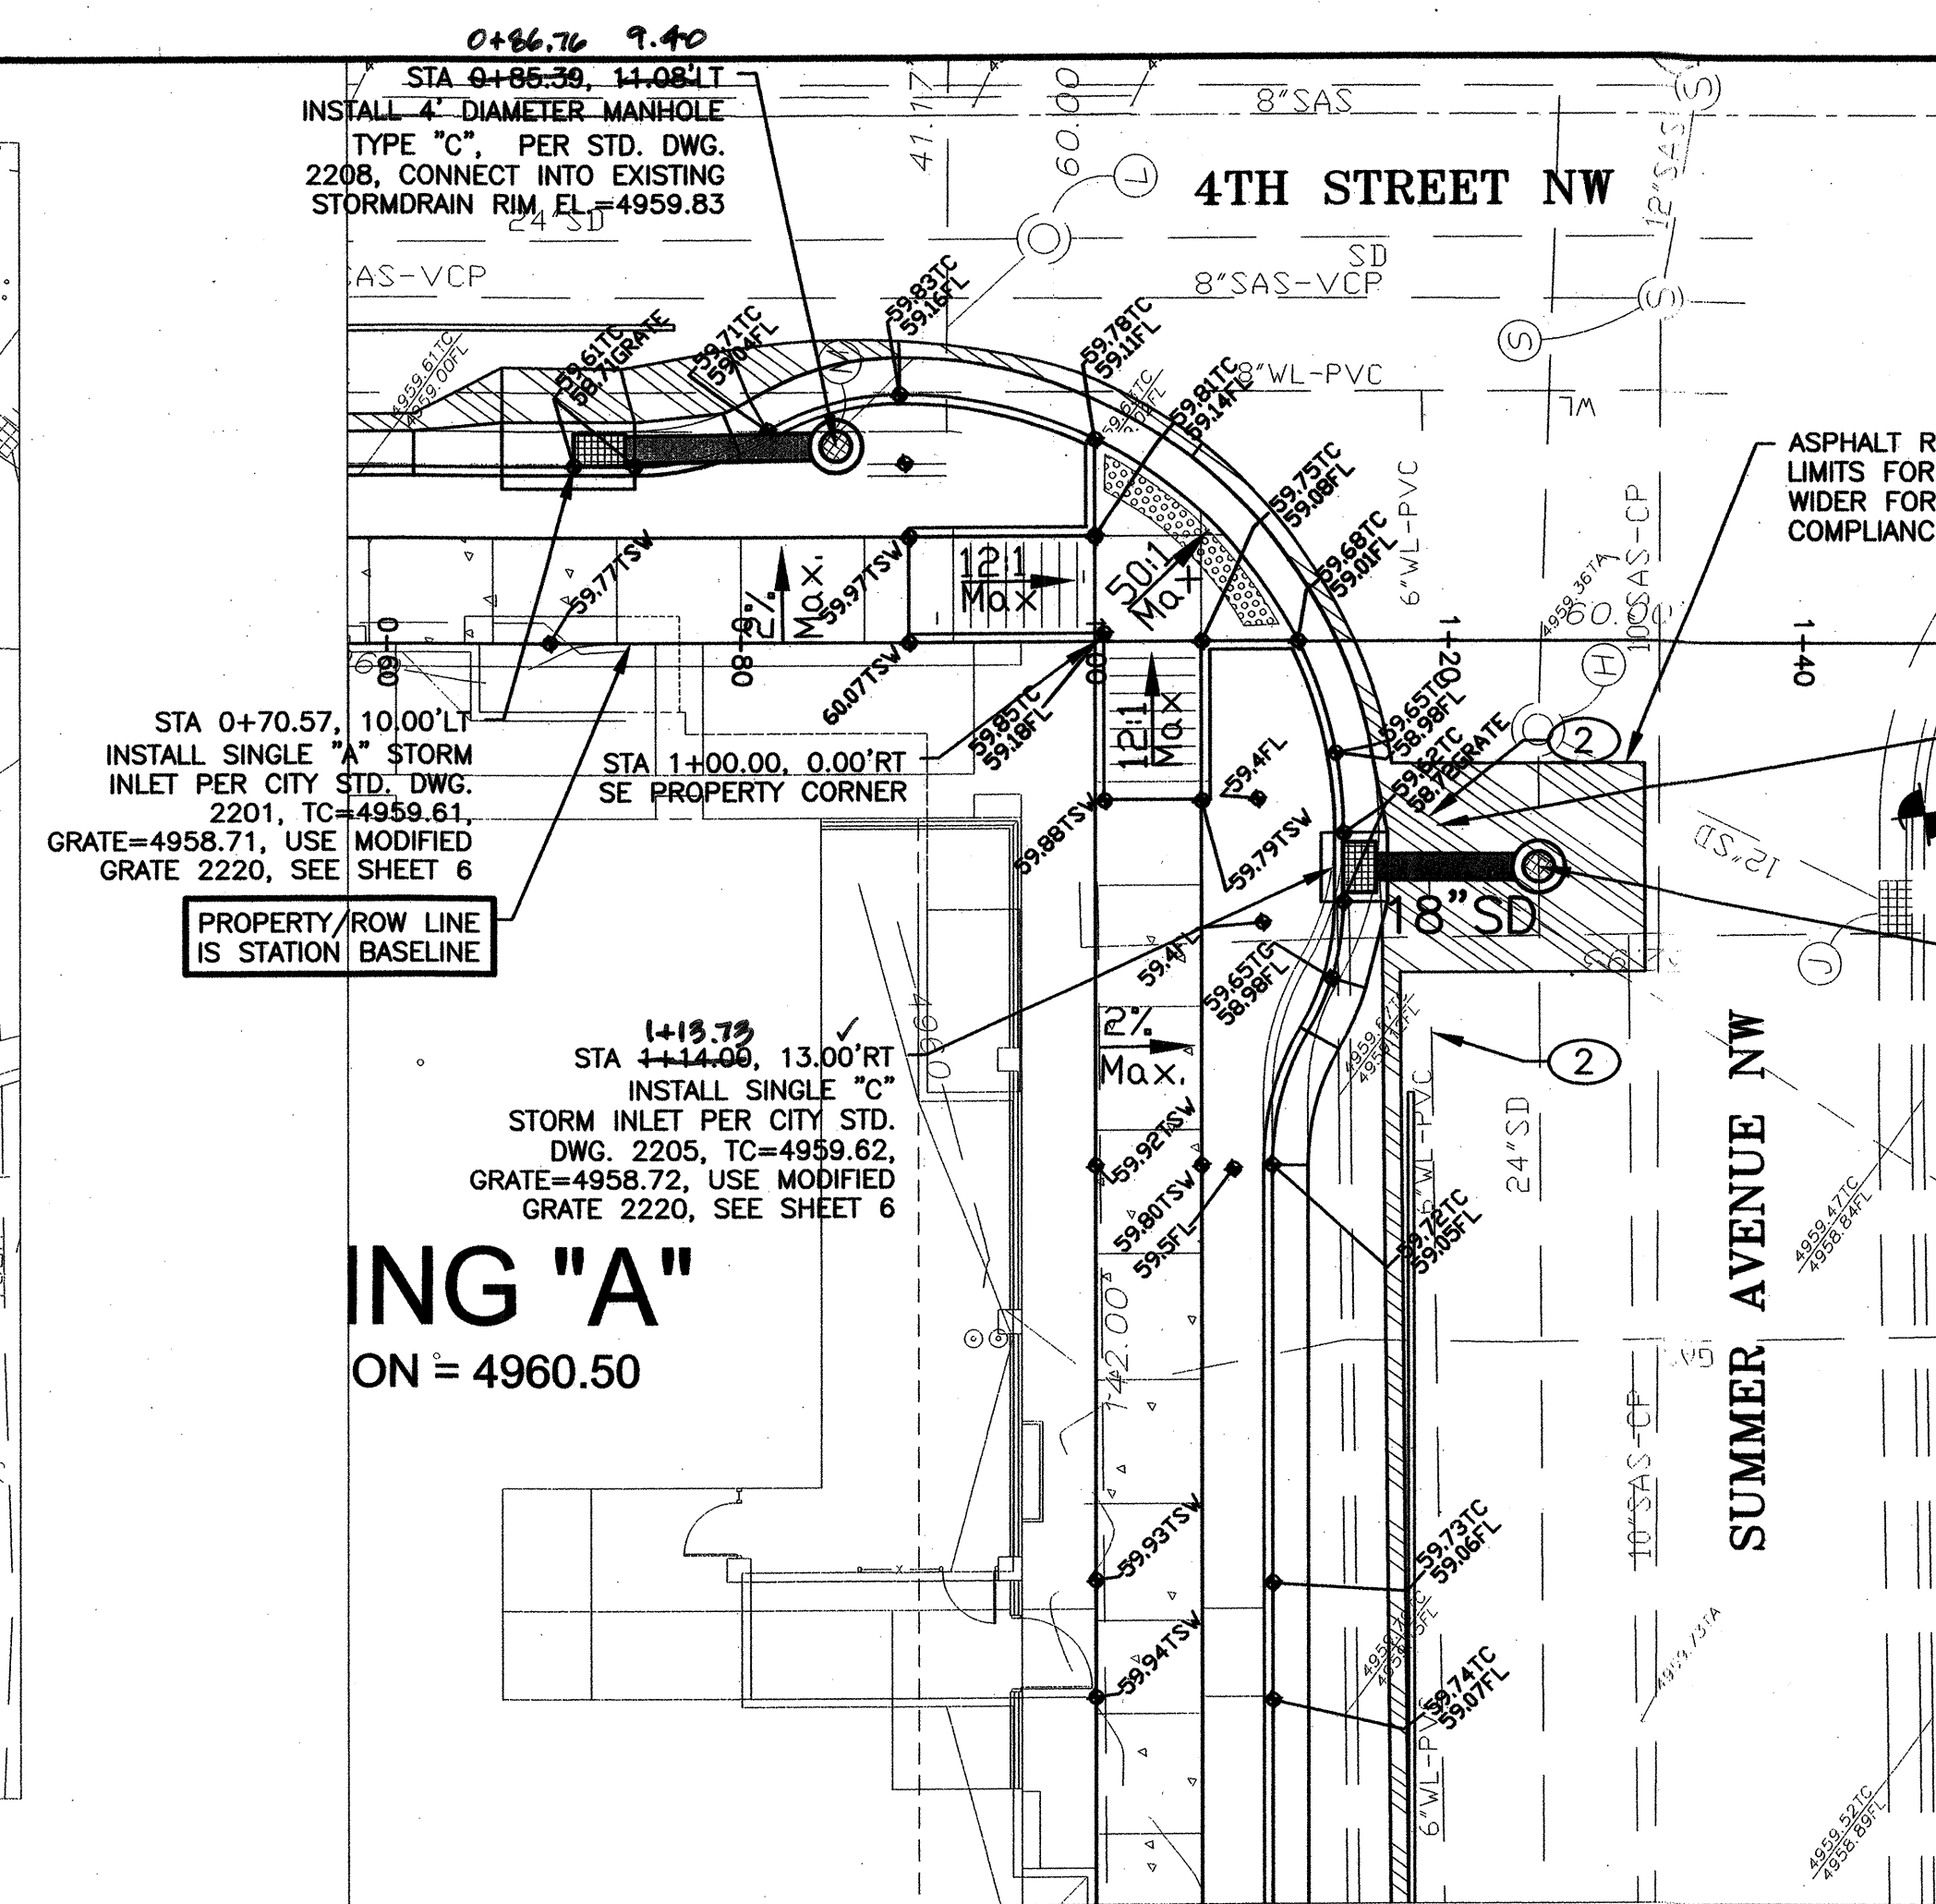


KEYED INVERT DATA

(A) Storm Drain MH Rim = 4960.49' (N) Inv. = 4956.84' (N) Inv. = 4956.69' (S) Inv. = 4956.79' (NE) Inv. = 4956.74' (W)	(J) Storm Drain Inlet Top of Grate = 4958.56' Inv. = 4954.16' (NE)	(R) Sanitary Sewer MH Rim = 4960.52' Inv. = 4950.47' (S) Inv. = 4950.32' (N) Inv. = 4950.22' (E) Inv. = 4950.17' (W)
(B) Storm Drain Inlet Top of Grate = 4959.52' Inv. = 4957.6'	(K) Storm Drain MH Rim = 4959.41' (S) Inv. = 4956.91' (SW) Inv. = 4955.06' (NE) Inv. = 4953.71' (E) Inv. = 4953.66' (W)	(S) Sanitary Sewer MH Rim = 4959.56' Inv. = 4949.41' (N) Inv. = 4949.41' (E) Inv. = 4949.41' (N) Inv. = 4949.41' (W)
(C) Storm Drain MH Rim = 4960.30' Inv. = 4956.38' (N) Inv. = 4956.25' (S) Inv. = 4956.30' (NW)	(L) Storm Drain MH Rim = 4959.61' No Access - Lid Cracked	(T) Sanitary Sewer MH Rim = 4959.70' Inv. = 4952.00' (N) Inv. = 4949.55' (W) No Lines Flowing
(D) Storm Drain MH Rim = 4960.06' Inv. = 4956.11' (N) Inv. = 4956.06' (S)	(M) Storm Drain Inlet Top of Grate = 4958.85' Inv. = 4956.35' (SE)	(U) Sanitary Sewer MH Rim = 4960.02' Lid Sealed
(E) Storm Drain Inlet Top of Grate = 4959.43' Inv. = 4957.5'	(O) Storm Drain MH Rim = 4959.93' Inv. = 4956.13' (NW) Inv. = 4956.13' (NE) Inv. = 4955.93' (S) Inv. = 4955.88' (N)	(V) Sanitary Sewer MH Rim = 4960.30' Inv. = 4955.75' (SW) Inv. = 4952.05' (W)
(F) Manhole Rim = 4959.98' Full of debris	(P) Storm Drain Inlet Top of Grate = 4959.19' Inv. = 4957.29' (SE)	(W) Sanitary Sewer MH Rim = 4959.95' Inv. = 4951.31' (E) Inv. = 4951.31' (W) Inv. = 4951.26' (N) Inv. = 4951.16' (S)
(G) Sanitary Sewer MH Rim = 4959.93' Inv. = 4952.89' (E)	(Q) Storm Drain Inlet Top of Grate = 4959.07' Inv. = 4956.97' (SW)	(X) Sanitary Sewer MH Rim = 4959.97' Inv. = 4952.82' (S)
(H) Storm Drain MH Rim = 4958.21' Inv. = 4954.34' (W) Inv. = 4954.24' (E) Inv. = 4954.29' (SW)		

NOTE: THE UTILITY WORK MAY REQUIRE THAT THE CONTRACTOR DEWATER THE TRENCH PRIOR TO UTILITY INSTALLATION.

CONSTRUCTION NOTES:

- ① FIELD VERIFY THE SIZE, TYPE OF PIPE, INVERT LOCATION OF EXISTING STORMDRAIN LINE SINCE THE AS-BUILTS ARE NOT CLEAR WITH THIS INFORMATION AND SEND TO ENGINEER PRIOR TO CONSTRUCTION OF NEW STORMDRAIN LINE FOR FIELD ADJUSTMENTS IF REQUIRED.
- ② FIELD VERIFY THE VERTICAL LOCATION OF THE EXISTING WATERLINE AND DETERMINE IF THE WATERLINE NEEDS TO BE RE-ROUTED UNDER THE STORMDRAIN OR IF THE NEW 18" STORMDRAIN AND INLET CAN BE RAISED TO CLEAR THE WATERLINE. FOLLOW STD. DWG. 2381 FOR RE-ROUTE OF WATERLINE REQUIREMENTS. MAINTAIN 12" MINIMUM CLEARANCE.
- ③ REMOVE EXISTING ABANDONED WATERLINE AS NEEDED TO INSTALL NEW STORMDRAIN.

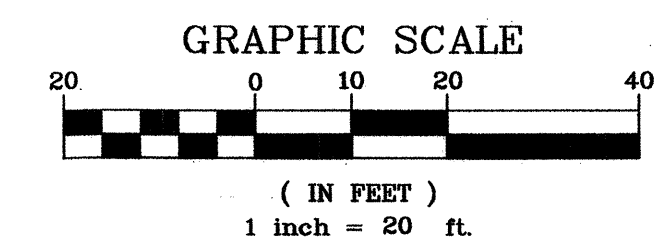

**APPLIED ENGINEERING AND
SURVEYING, INC.**
ENGINEERS AND PLANNERS



1605 Blair Drive NE
Office: (805) 2237-1456

Albuquerque, New Mexico 87112
Foothills: (805) 237-1456


CITY OF ALBUQUERQUE
PUBLIC WORKS DEPARTMENT
ENGINEERING DEVELOPMENT GROUP

TITLE: CUATRO DEVELOPMENT APARTMENTS
STORMDRAIN, PLAN AND PROFILES


Design Review Committee	City Engineer Approval	Last Design Update	Mo./Day/Yr.	Mo./Day/Yr.
City Project No.	744381	Zone Map No.	Sheet 9	Of 11

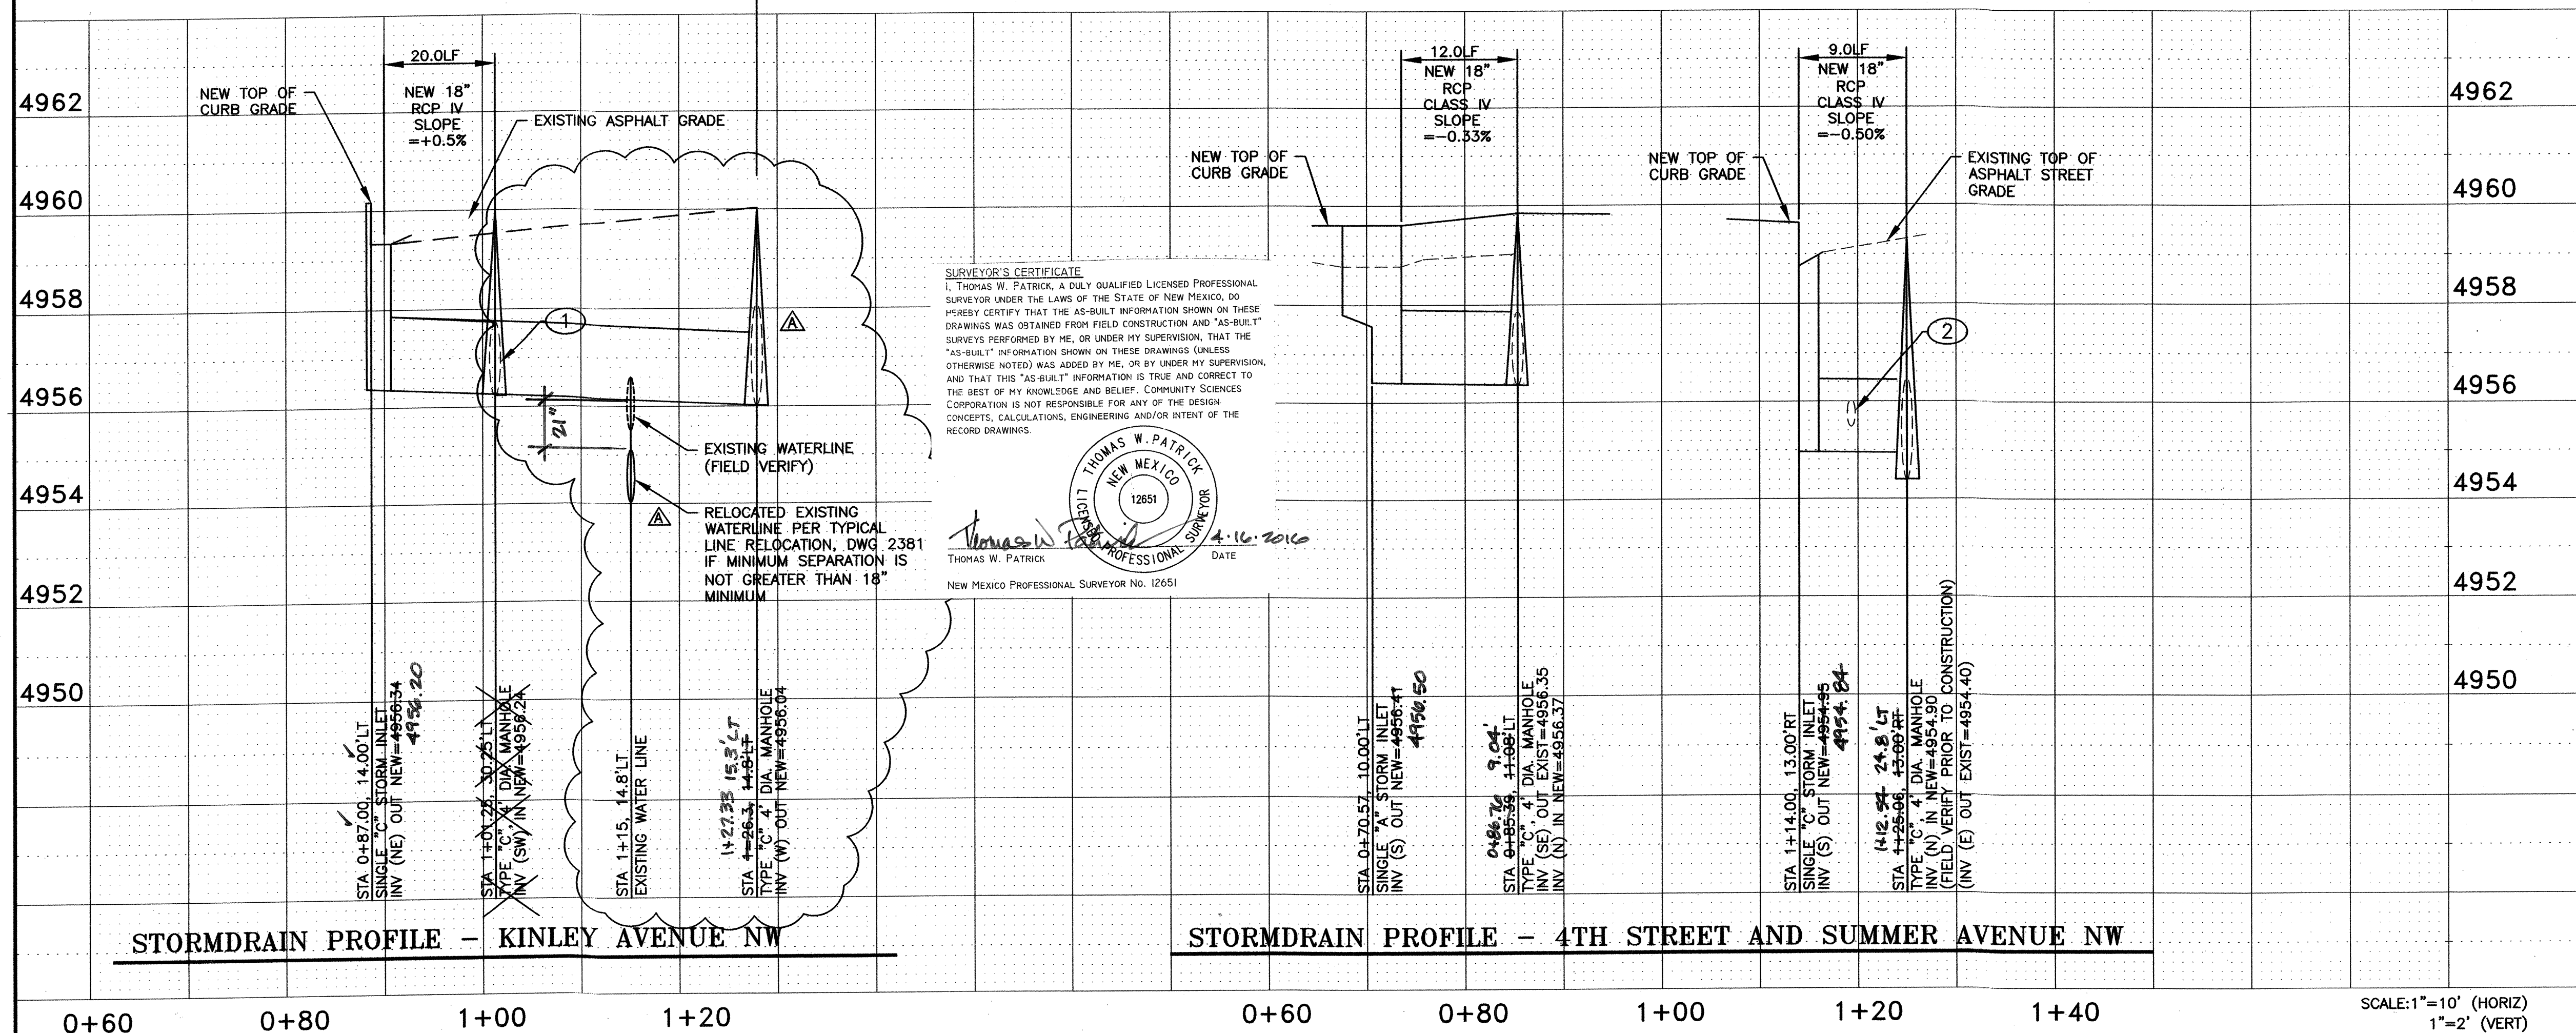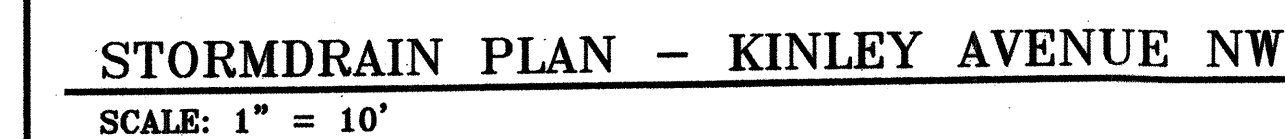

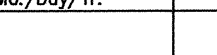

Design Review Committee 		City Engineer Approval 		Mo./Day/Yr. 		Mo./Day/Yr. 	
City Project No. 744381		Zone Map No. J-14		Sheet 10		Of 11	

[illegible]

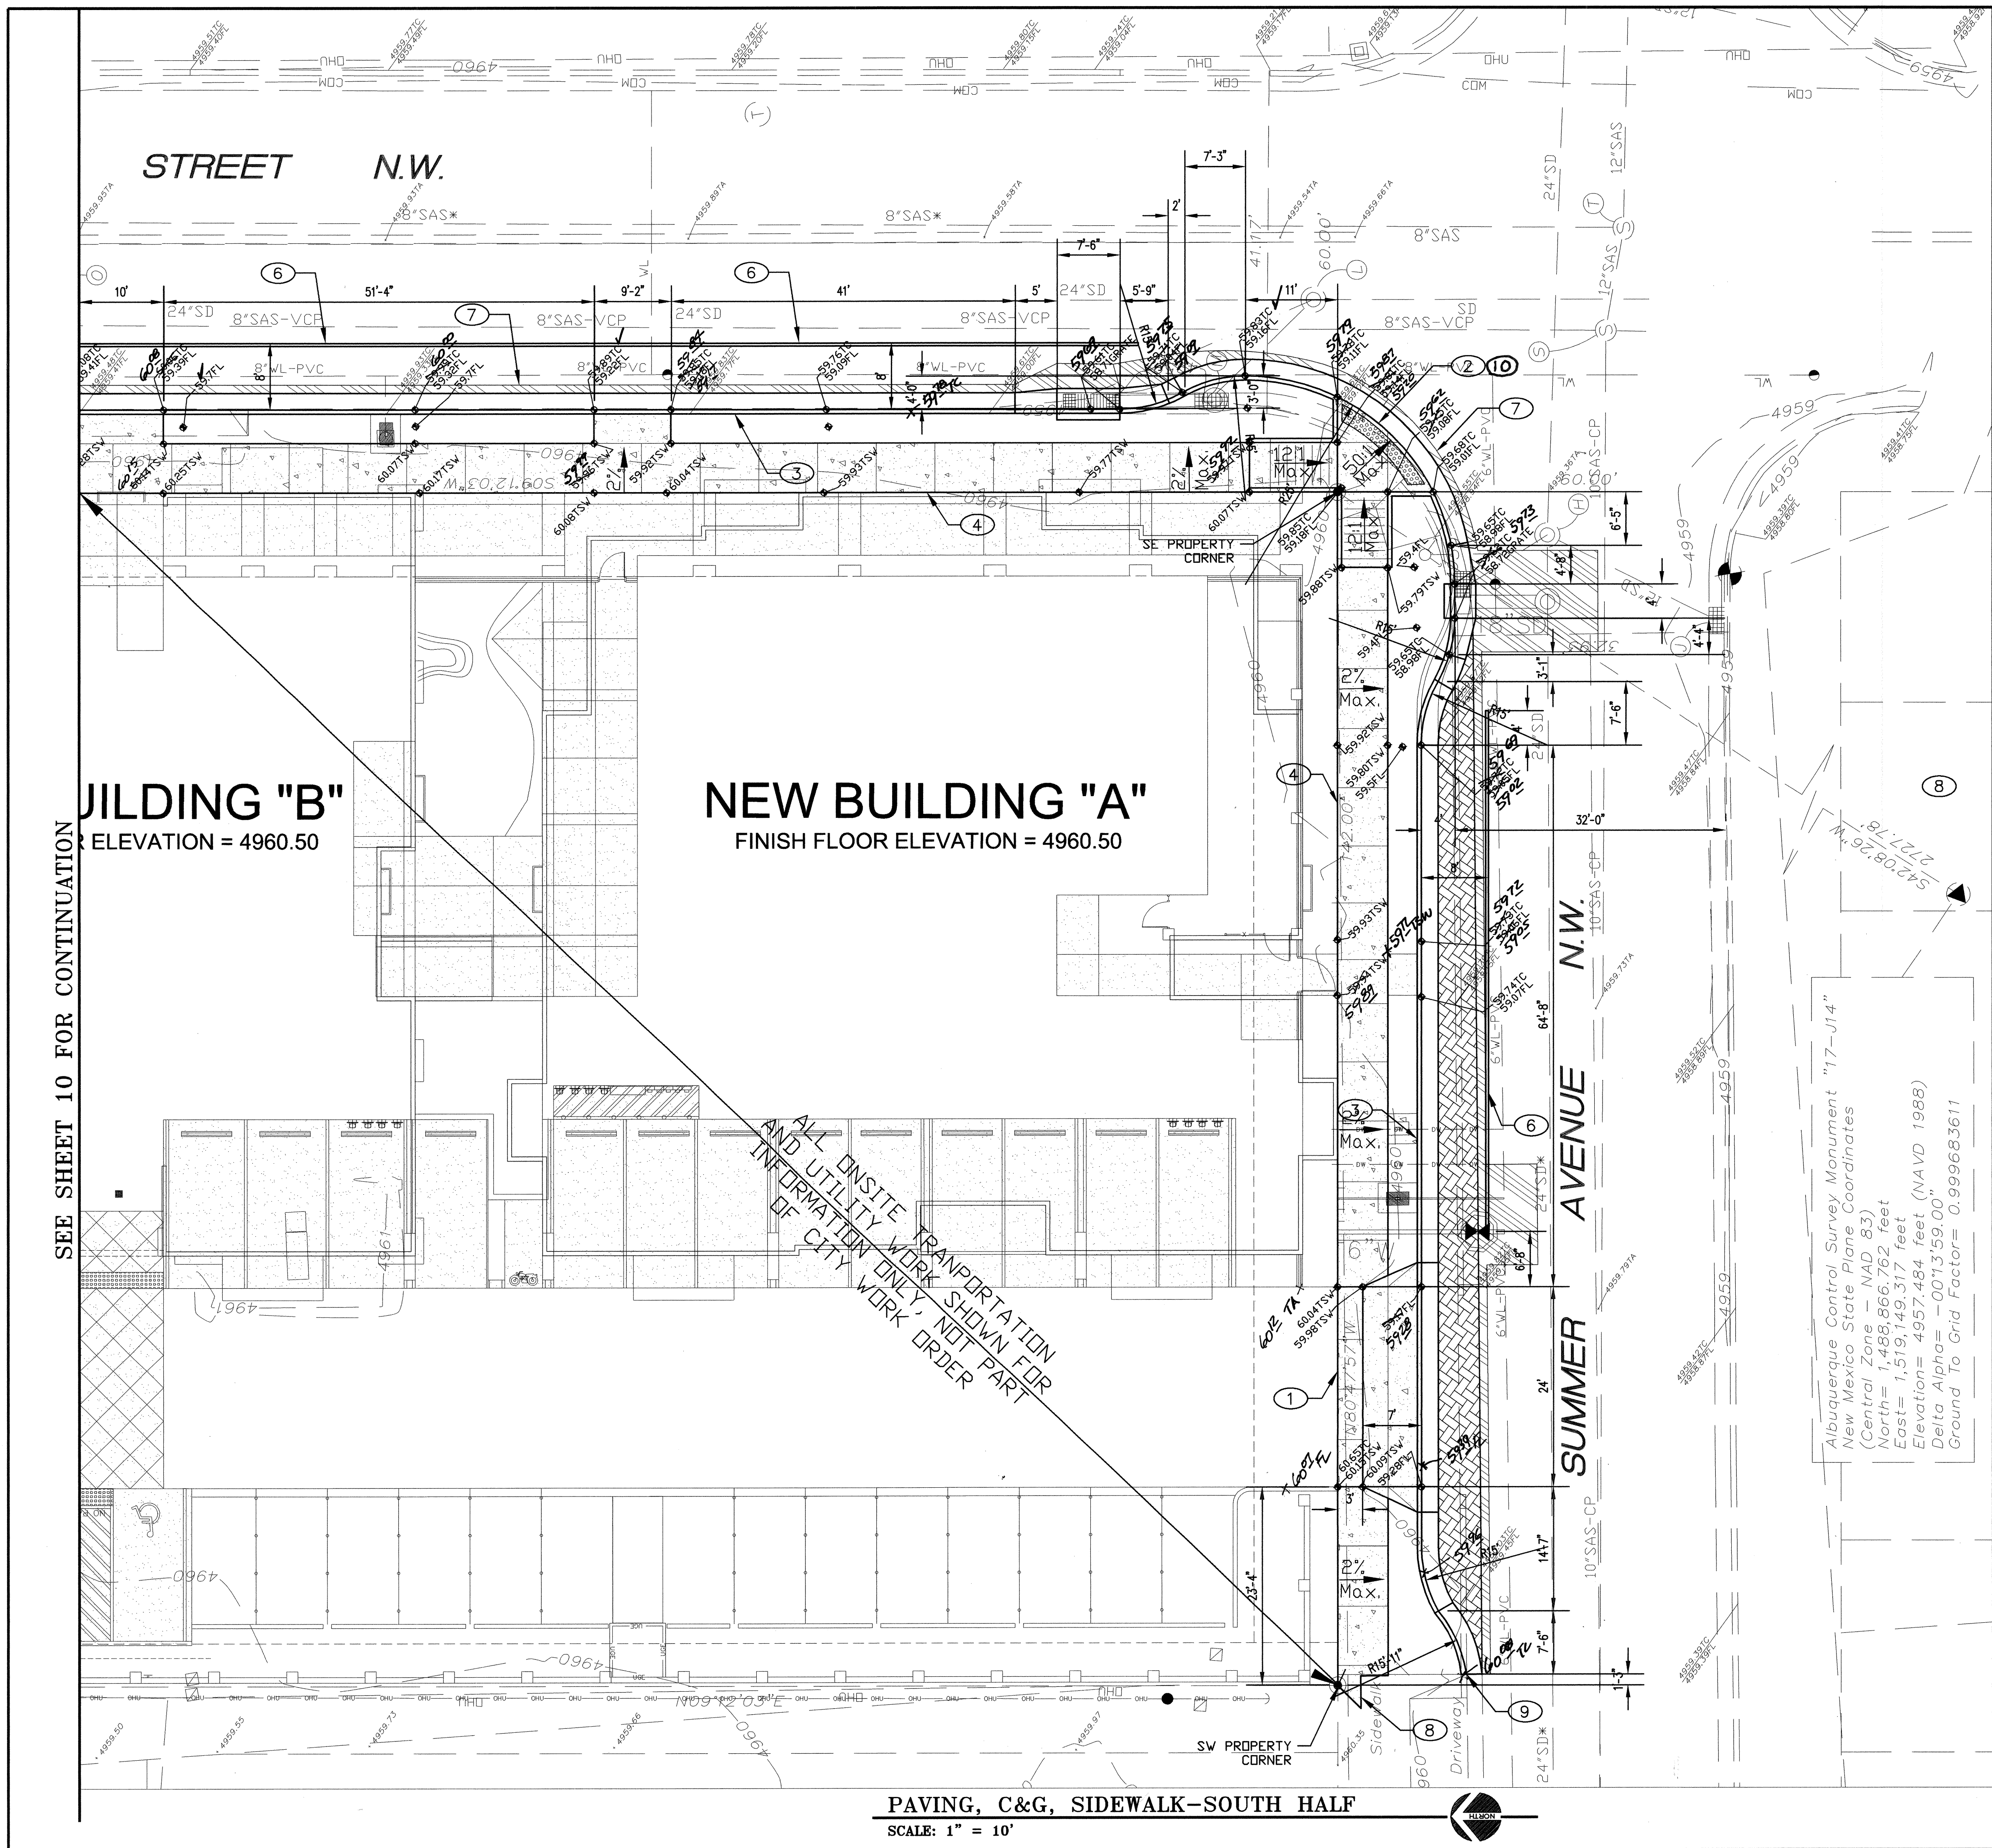

CONSTRUCTION NOTES:


1. CONSTRUCT A CONCRETE DRIVEPAD ENTRANCE PER CITY STD. DWG. 2425.
2. CONSTRUCT 90 DEGREE (WHEELCHAIR) CURB ACCESS RAMPS, WITH THE FOLLOWING TRUNCATED DOMES:
 - * DESIGN PER ADA GUIDELINES
 - * SUBMIT SPECIFICATIONS TO ENGINEER PRIOR TO CONSTRUCTION.
3. CONSTRUCT STANDARD CURB AND GUTTER PER CITY STD. DWG. 2415A.
4. CONSTRUCT A 6' WIDE CONCRETE SIDEWALK PER CITY STD. DWG. 2430.
5. ALL UTILITY PAVEMENT CUTS SHALL BE RE-CONSTRUCTED PER CITY STD. DWG. 2465 - RESIDENTIAL.
6. INSTALL 4" WIDE WHITE STRIPE PER RETROREFLECTIVE PREFORMED PLASTIC PAVEMENT MARKING PER CITY SPEC. SECTION 441.
7. CONTRACTOR SHALL CAREFULLY REMOVE EXISTING CURB AND GUTTER TO HELP MINIMIZE ANY SPALLING OF ASPHALT OR SUBGRADE UNDERMINING. OTHERWISE, 1 FOOT WIDE OF EXISTING ASPHALT PAVEMENT SHALL BE REMOVED AND REPLACED PER STD. DWG. 2465.
8. CONTRACTOR SHALL NEATLY CONNECT NEW SIDEWALK INTO THE NEAREST JOINT OF THE EXISTING SIDEWALK AND ADD AN EXPANSION JOINT.
9. MATCH EXISTING CURB AND GUTTER FLOWLINE ELEVATION.
10. CONSTRUCT RAMPS PER STD. DWG. 2441.

PAVING LEGEND

- LIMITS OF ASPHALT PAVING REMOVAL AND REPLACEMENT, PAVING SECTION PER STD. DWG. 2465.
- LIMITS OF NEW RESIDENTIAL ASPHALT PAVING PER STD. DWG. 2405A.
- LIMITS OF NEW CONCRETE PAVING

LEGEND

- 5.000 NEW FINAL SURFACE GRADE
- 6.514 EXISTING CONTOUR GRADE
- DRAINAGE FLOW DIRECTION
- NEW TOP OF CURB ELEVATION
- NEW FLOWLINE OF CURB ELEVATION
- NEW TOP OF ASPHALT ELEVATION
- NEW TOP OF SIDEWALK ELEVATION
- EXISTING TOP OF CURB ELEVATION
- EXISTING FLOWLINE ELEVATION
- NEW DIRT GRADE ELEVATION
- FLOWLINE SWALE ELEVATION
- NEW TOP OF WALL ELEVATION
- NEW BOTTOM OF WALL ELEVATION

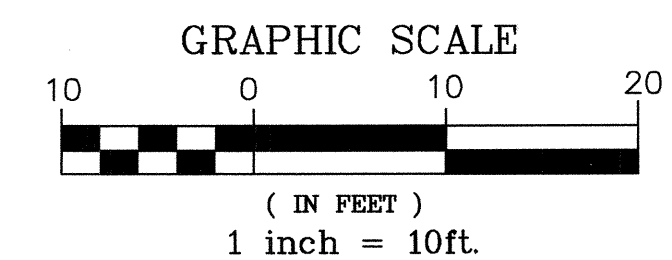

APPLIED ENGINEERING AND SURVEYING, INC.
ENGINEERS AND PLANNERS
1600 West 10th Ave. NE
Albuquerque, NM 87112
Office: (505) 237-1406

CITY OF ALBUQUERQUE PUBLIC WORKS DEPARTMENT ENGINEERING DEVELOPMENT GROUP	
TITLE: PAVING, C&G, SIDEWALK-SOUTH HALF CUATRO DEVELOPMENT	
Design Review Committee APPROVED MAR 09 2015 DESIGN REVIEW COMMITTEE	City Engineer Approval APPROVED SEP 29 2015 CITY ENGINEER
City Project No. 744381	Zone Map No. J-14
Sheet 11	Of 11