

SCANNED BY PLN


SCANNED BY PLN

CONSTRUCTION PLANS FOR WESTERN RIDGE SUBDIVISION (UNIT 2) AT VENTANA RANCH WEST ALBUQUERQUE, NEW MEXICO

26-7494-86 06

INDEX

SHEET NUMBER	DESCRIPTION
1	TITLE SHEET
2-6	PLAT
7	SITE DESCRIPTION PLAN
8-15	GRADING PLAN
16-17	RETAINING WALL DETAILS (FOR REFERENCE ONLY)
18	OVERALL PAVING PLAN
19	PAVING PLAN AND PROFILE SHEETS
20	ALIGNMENT "A" 20+00 - 27+00
21	ALIGNMENT "A" 27+00 - 34+00
22	ALIGNMENT "A" 34+00 - 40+00
23	ALIGNMENT "B"
24	ALIGNMENT "C"
25	ALIGNMENT "D"
26	MOSCA DR.
27	TRES HERMANAS / THUNDERBOLT
28	TUSCARORA RD / OSCURA ST ROUNDABOUT
29	SIERRA ALTOS PL / MOGOLLON DR ROUNDABOUT
30	OVERALL UTILITY PLAN
31	UTILITY PLAN AND PROFILE SHEETS
32	ALIGNMENT "A" 20+00 - 27+00
33	ALIGNMENT "A" 27+00 - 34+00
34	ALIGNMENT "A" 34+00 - 40+00
35	ALIGNMENT "B"
36	ALIGNMENT "C"
37	ALIGNMENT "D"
38	MOSCA DR.
39	TRES HERMANAS / THUNDERBOLT

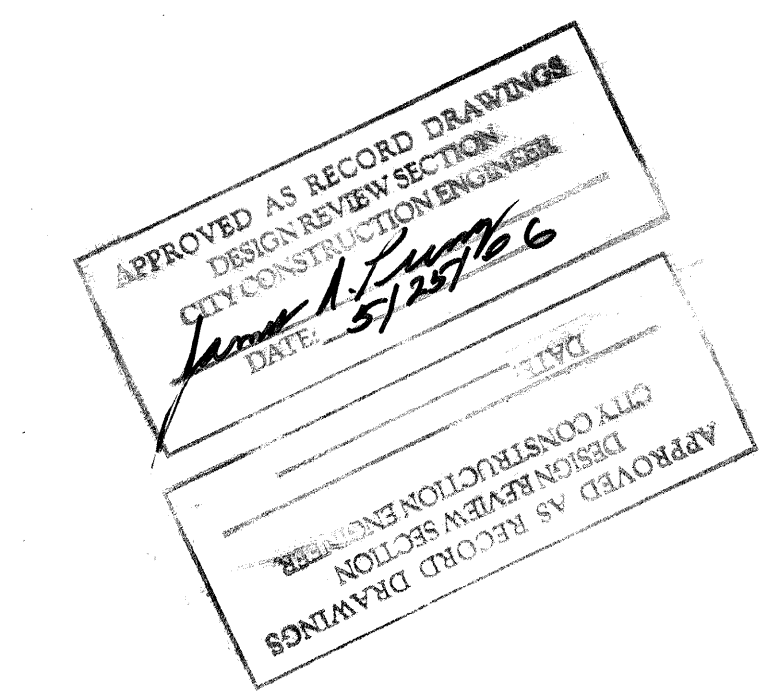

RECORD DRAWINGS


I, PATRICK J. CONLEY, of the firm of Smith Engineering Company, a Registered Professional Engineer in the State of New Mexico, do hereby state that, to the best of my knowledge and belief, the infrastructure for this project as shown on the plans has been constructed in general accordance with the project plans and in general accordance with the City of Albuquerque Standard Specifications for Public Works Construction (including all updates), and that the general intent of the plans has been met except as noted on the as-built construction drawings. The infrastructure construction has been observed by a qualified person from Smith Engineering Company and this statement covers infrastructure installation that was observed while a representative from Smith Engineering was on site. This statement is based on site observations by Smith Engineering Company personnel and on as-built information provided to Smith Engineering Company.

Russ P. Hugg (surveyor's name), NMPS number 9750 (PS #).

SURVEYORS CERTIFICATION


I, Russ P. Hugg, New Mexico Professional Surveyor Number 9750, hereby certify that the as-built information shown hereon is the result of an actual field survey performed by me or under my direct supervision and that the same is true and correct to the best of my knowledge and belief.

Russ P. Hugg
NMPS No. 9750
1-27-06

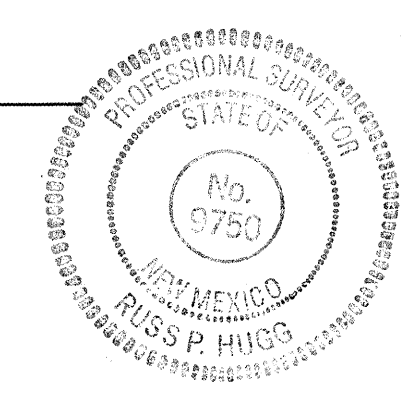

Bohannon & Huston

Courtyard I 7500 Jefferson St. NE Albuquerque, NM 87109-4335
ENGINEERING • SPATIAL DATA • ADVANCED TECHNOLOGIES

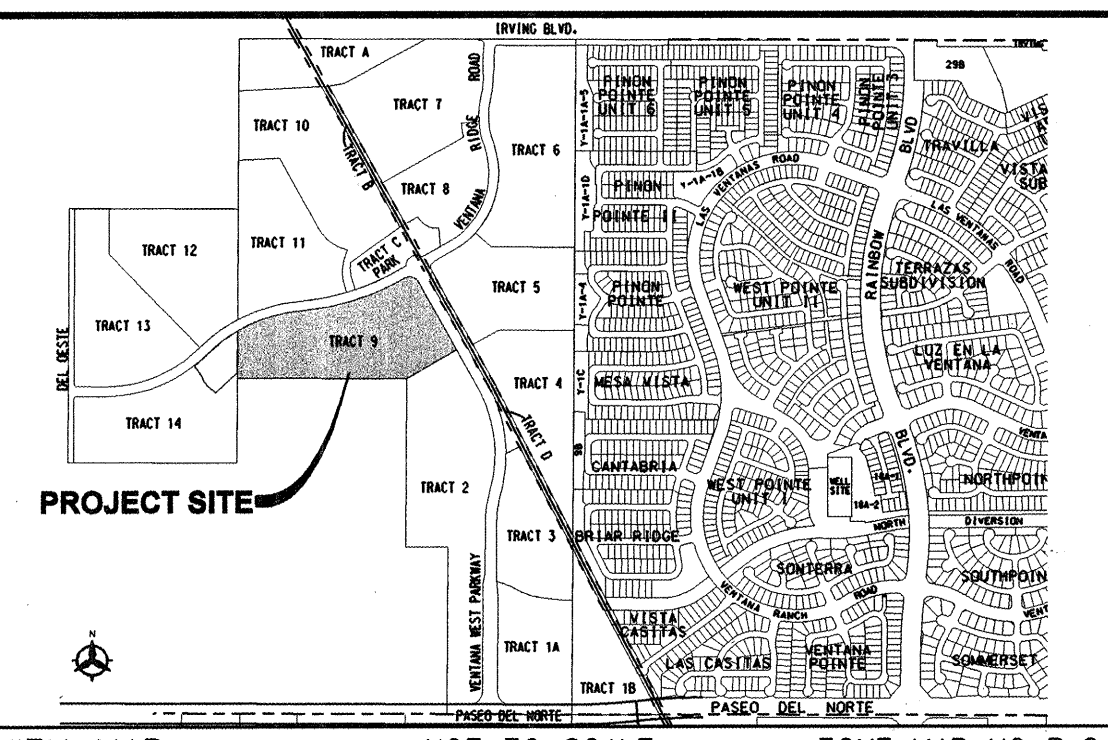

VICINITY MAP: NOT TO SCALE ZONE MAP NO. B-8

NOTICE TO CONTRACTORS

- ALL WORK DETAILED ON THESE PLANS TO BE PERFORMED UNDER CONTRACT SHALL, EXCEPT AS OTHERWISE STATED OR PROVIDED FOR HEREON, BE CONSTRUCTED IN ACCORDANCE WITH THE CITY OF ALBUQUERQUE STANDARD SPECIFICATIONS FOR PUBLIC WORKS CONSTRUCTION, 1986 EDITION AND SHALL INCLUDE UPDATE No. 7.
- TWO WORKING DAYS PRIOR TO ANY EXCAVATION, THE CONTRACTOR MUST CONTACT NEW MEXICO ONE CALL SYSTEM (260-1990) FOR LOCATION OF EXISTING UTILITIES.
- PRIOR TO CONSTRUCTION, THE CONTRACTOR SHALL EXCAVATE AND VERIFY THE HORIZONTAL AND VERTICAL LOCATIONS OF ALL OBSTRUCTIONS. SHOULD A CONFLICT EXIST, THE CONTRACTOR SHALL NOTIFY THE ENGINEER OR SURVEYOR IMMEDIATELY SO THAT THE CONFLICT CAN BE RESOLVED WITH A MINIMUM AMOUNT OF DELAY.
- FIVE (5) WORKING DAYS PRIOR TO BEGINNING CONSTRUCTION, THE CONTRACTOR SHALL SUBMIT TO CONSTRUCTION COORDINATION DIVISION A DETAILED CONSTRUCTION SCHEDULE. TWO (2) WORKING DAYS PRIOR TO CONSTRUCTION, THE CONTRACTOR SHALL OBTAIN A BARRICADE PERMIT FROM THE CONST. COORDINATION DIVISION. CONTRACTOR SHALL NOTIFY BARRICADE ENGINEER (924-3400) PRIOR TO OCCUPYING AN INTERSECTION. REFER TO SECTION 19 OF THE GENERAL CONDITIONS OF THE STANDARD SPECIFICATIONS.
- ALL PERMANENT STREET STRIPING ALTERED OR DESTROYED SHALL BE REPLACED W/ PLASTIC REFLECTORIZED PAVEMENT MARKING BY CONTRACTOR TO LOCATION AS EXISTING OR AS INDICATED BY THIS PLAN SET.
- CONTRACTOR SHALL NOTIFY THE ENGINEER NOT LESS THAN SEVEN (7) DAYS PRIOR TO STARTING WORK IN ORDER THAT THE CITY SURVEYOR MAY TAKE NECESSARY MEASURES TO INSURE THE PRESERVATION OF SURVEY MONUMENTS. CONTRACTOR SHALL NOT DISTURB PERMANENT SURVEY MONUMENTS WITHOUT THE CONSENT OF THE CITY SURVEYOR AND SHALL NOTIFY THE CITY SURVEYOR AND BEAR THE EXPENSE OF REPLACING ANY THAT MAY BE DISTURBED WITHOUT PERMISSION. REPLACEMENT SHALL BE DONE ONLY BY THE CITY SURVEYOR. WHEN A CHANGE IS MADE IN THE FINISHED ELEVATIONS OF THE PAVEMENT OF ANY ROADWAY IN WHICH A PERMANENT SURVEY MONUMENT IS LOCATED, CONTRACTOR SHALL AT HIS OWN EXPENSE, ADJUST THE MONUMENT COVER TO THE NEW GRADE, UNLESS OTHERWISE SPECIFIED. REFER TO SECTION 4.4 OF THE GENERAL CONDITIONS OF THE STANDARD SPECIFICATIONS.
- ANY WORK WITHIN AN ARTERIAL ROADWAY REQUIRES TWENTY-FOUR HOUR CONSTRUCTION.
- ALL UTILITY WORK SHALL BE CONSTRUCTED IN ACCORDANCE WITH NEW MEXICO UTILITIES, INC. SPECIFICATIONS FOR WATER AND WASTEWATER FACILITIES (MOST RECENT REVISIONS).
- THE CONTRACTOR SHALL NOTIFY NEW MEXICO UTILITIES, (888-2661) THREE WORKING DAYS PRIOR TO BEGINNING THE CONSTRUCTION OF THE UTILITIES.
- CONTRACTOR SHALL MAINTAIN A GRAFFITI - FREE WORK SITE. CONTRACTOR SHALL PROMPTLY REMOVE ANY GRAFFITI FROM ALL EQUIPMENT, WHETHER PERMANENT OR TEMPORARY.
- FOR STORM DRAIN CONSTRUCTION, RCP PIPE JOINTS SHALL NOT BE GROUTED PRIOR TO FINAL INSPECTION. FINAL INSPECTION WILL DETERMINE JOINTS TO BE GROUTED FOR FINAL ACCEPTANCE OF THE CONSTRUCTION.

THE FOLLOWING NOTES ALSO APPLY WHEN CHECKED

- ☒ ALL UTILITIES AND UTILITY SERVICE LINES SHALL BE INSTALLED PRIOR TO PAVING.
- ☒ BACKFILL COMPACTION SHALL BE ACCORDING TO SPECIFIED STREET USE.
- ☒ TACK COAT REQUIREMENTS SHALL BE DETERMINED BY THE CITY ENGINEER.
- ☒ SIDEWALKS AND WHEELCHAIR RAMPS WITHIN THE CURB RETURNS SHALL BE CONSTRUCTED WHEREVER A NEW CURB RETURN IS CONSTRUCTED.
- ☒ IF CURB IS DERESSED FOR A DRIVEPAD, THE DRIVEPAD SHALL BE CONSTRUCTED PRIOR TO ACCEPTANCE OF CURB AND GUTTER.
- ☒ ALL STORM DRAINAGE FACILITIES SHALL BE COMPLETED PRIOR TO FINAL ACCEPTANCE.
- ☒ THE REQUESTOR OR DEVELOPER SHALL BE RESPONSIBLE FOR REPAIR OR REPLACEMENT OF ALL CURB AND GUTTER OR SIDEWALK DAMAGED AFTER APPROVAL BY THE CITY ENGINEER OF WORK COMPLETED BY THE CONTRACTOR.

REV.	SHEETS	CITY ENGINEER	DATE	USER DEPARTMENT	DATE	USER DEPARTMENT	DATE
ENGINEERS STAMP & SIGNATURE		APPROVALS		ENGINEER		DATE	
		DRC Chairman		3/18/05		3/18/05	
		Transportation		3/18/05		3/18/05	
		Water/Wastewater		3/14/05		3/14/05	
		Hydrology		3/14/05		3/14/05	
		CIP		3/14/05		3/14/05	
Const. Mngmt.		3/14/05		3/14/05		3/14/05	
Const. Coord.		3/14/05		3/14/05		3/14/05	
DRB CASE NUMBER		CITY PROJECT NO.		SHEET		OF	
1003687		749486		1		37	

SCANNED BY PLA

Curve Data					
ID	DELTA	TANGENT	ARC	RADIUS	CHORD
C1	89°53'17"	99.81'	156.88'	100.00'	141.28'
C2	90°00'00"	25.00'	39.27'	25.00'	35.36'
C3	44°38'38"	467.24'	886.71'	1138.00'	864.45'
C4	38°58'22"	428.87'	824.41'	1212.00'	808.61'
C5	23°50'51"	430.36'	848.25'	2038.00'	842.15'
C6	90°00'00"	80.00'	125.66'	80.00'	113.14'
C7	44°15'08"	429.36'	815.60'	1056.00'	795.48'
C8	14°43'55"	147.89'	294.15'	1144.00'	293.34'

Tangent Data		
ID	BEARING	DISTANCE
T1	N89°48'48"W	175.20'
T2	S89°42'11"E	212.50'
T3	N60°46'42"E	7.00'
T4	S12°04'00"W	73.55'








SURVEY NOTES:

- UNLESS OTHERWISE NOTED, ALL BOUNDARY CORNERS SHOWN THUS (●) SHALL BE MARKED BY A #5 REBAR STAMPED "WEAVER LS 6544".
- ALL STREET CENTERLINE MONUMENTATION SHALL BE INSTALLED AT DESIGNATED CENTERLINE PC'S, PT'S, ANGLE POINTS AND STREET INTERSECTIONS AND SHOWN THUS (▲) WILL BE MARKED BY A FOUR (4") ALUMINUM CAP STAMPED "CITY OF ALBUQUERQUE, CENTERLINE MONUMENTATION, DO NOT DISTURB, P.L.S. 6544".
- THE SUBDIVISION BOUNDARY WILL BE TIED TO THE NEW MEXICO STATE PLANE COORDINATE SYSTEM AS SHOWN.
- BASIS OF BEARINGS WILL BE NEW MEXICO STATE PLANE GRID BEARINGS.
- DISTANCES SHALL BE GROUND DISTANCES.
- MANHOLES WILL BE OFFSET AT ALL POINTS OF CURVATURE, POINTS OF TANGENCY, STREET INTERSECTIONS AND ALL OTHER ANGLE POINTS TO ALLOW THE USE OF CENTERLINE MONUMENTATION.

APPROVED FOR MONUMENTATION AND STREET NAMES

[Signature]
CITY SURVEYOR

10-1-04
DATE

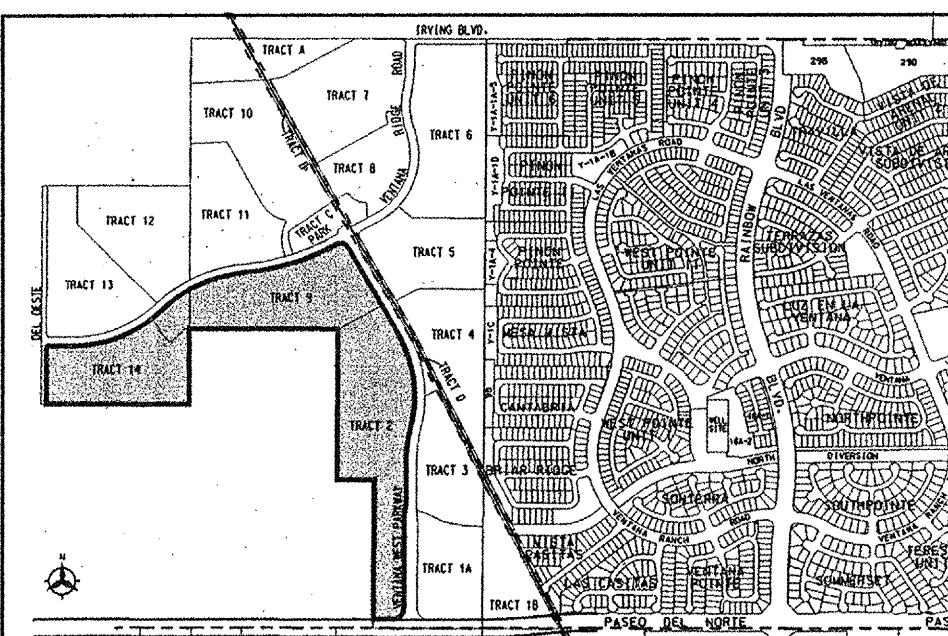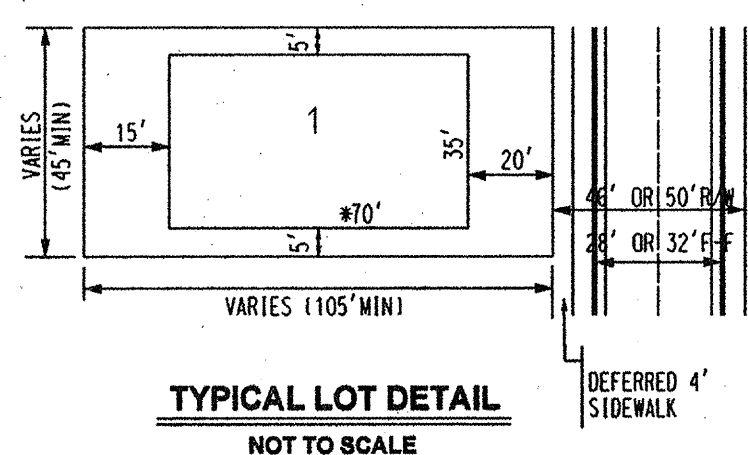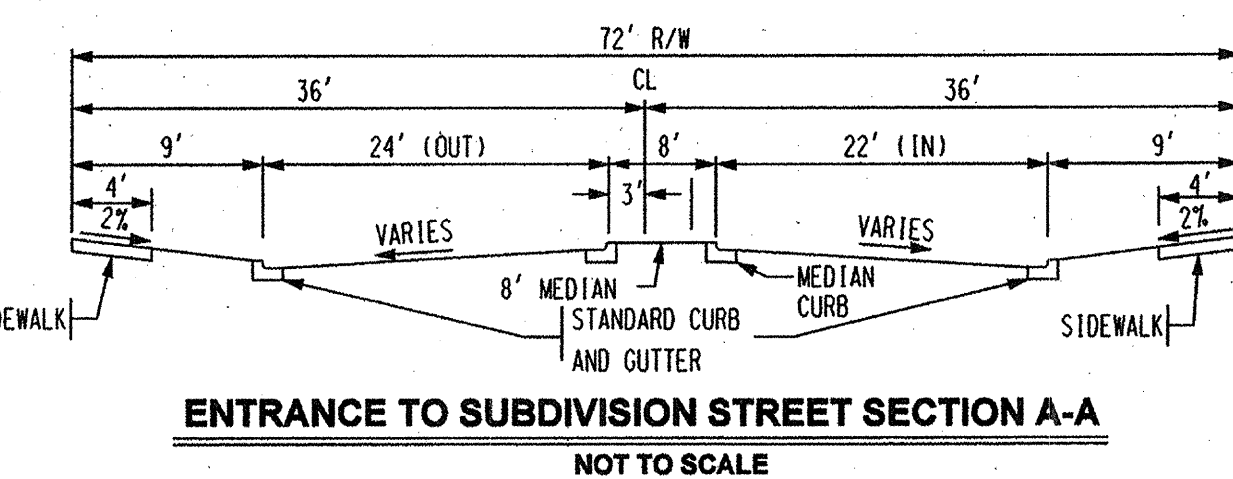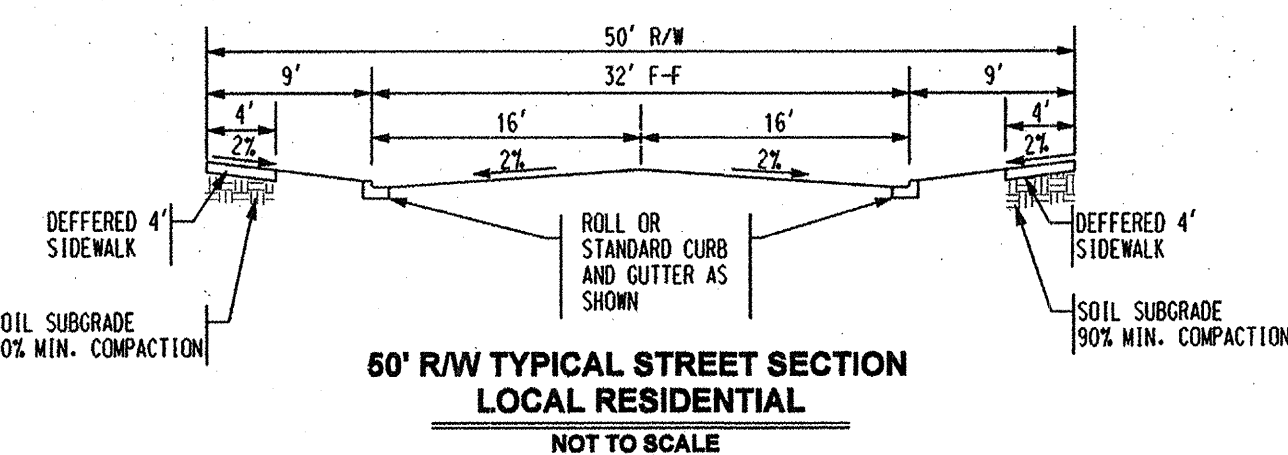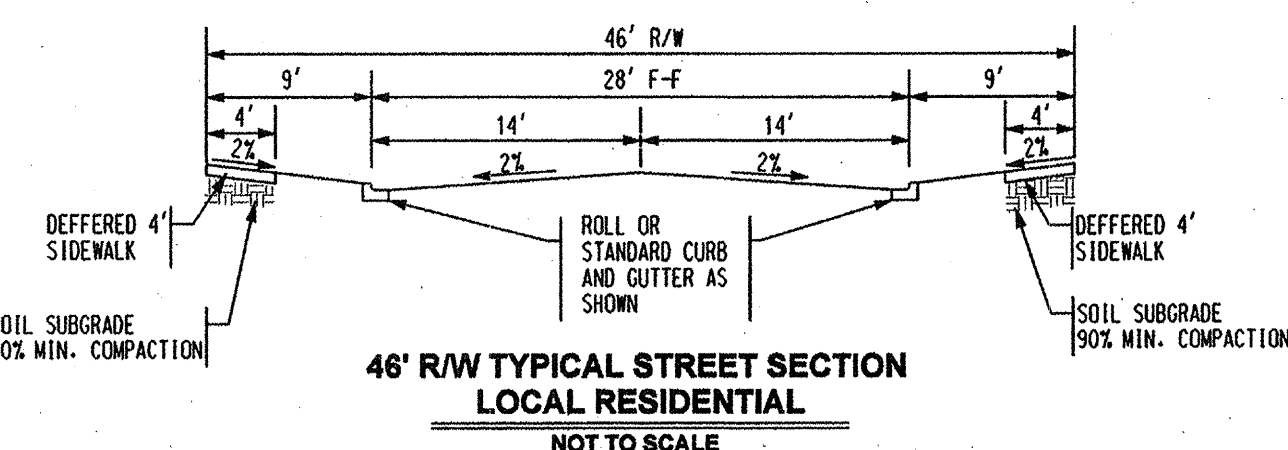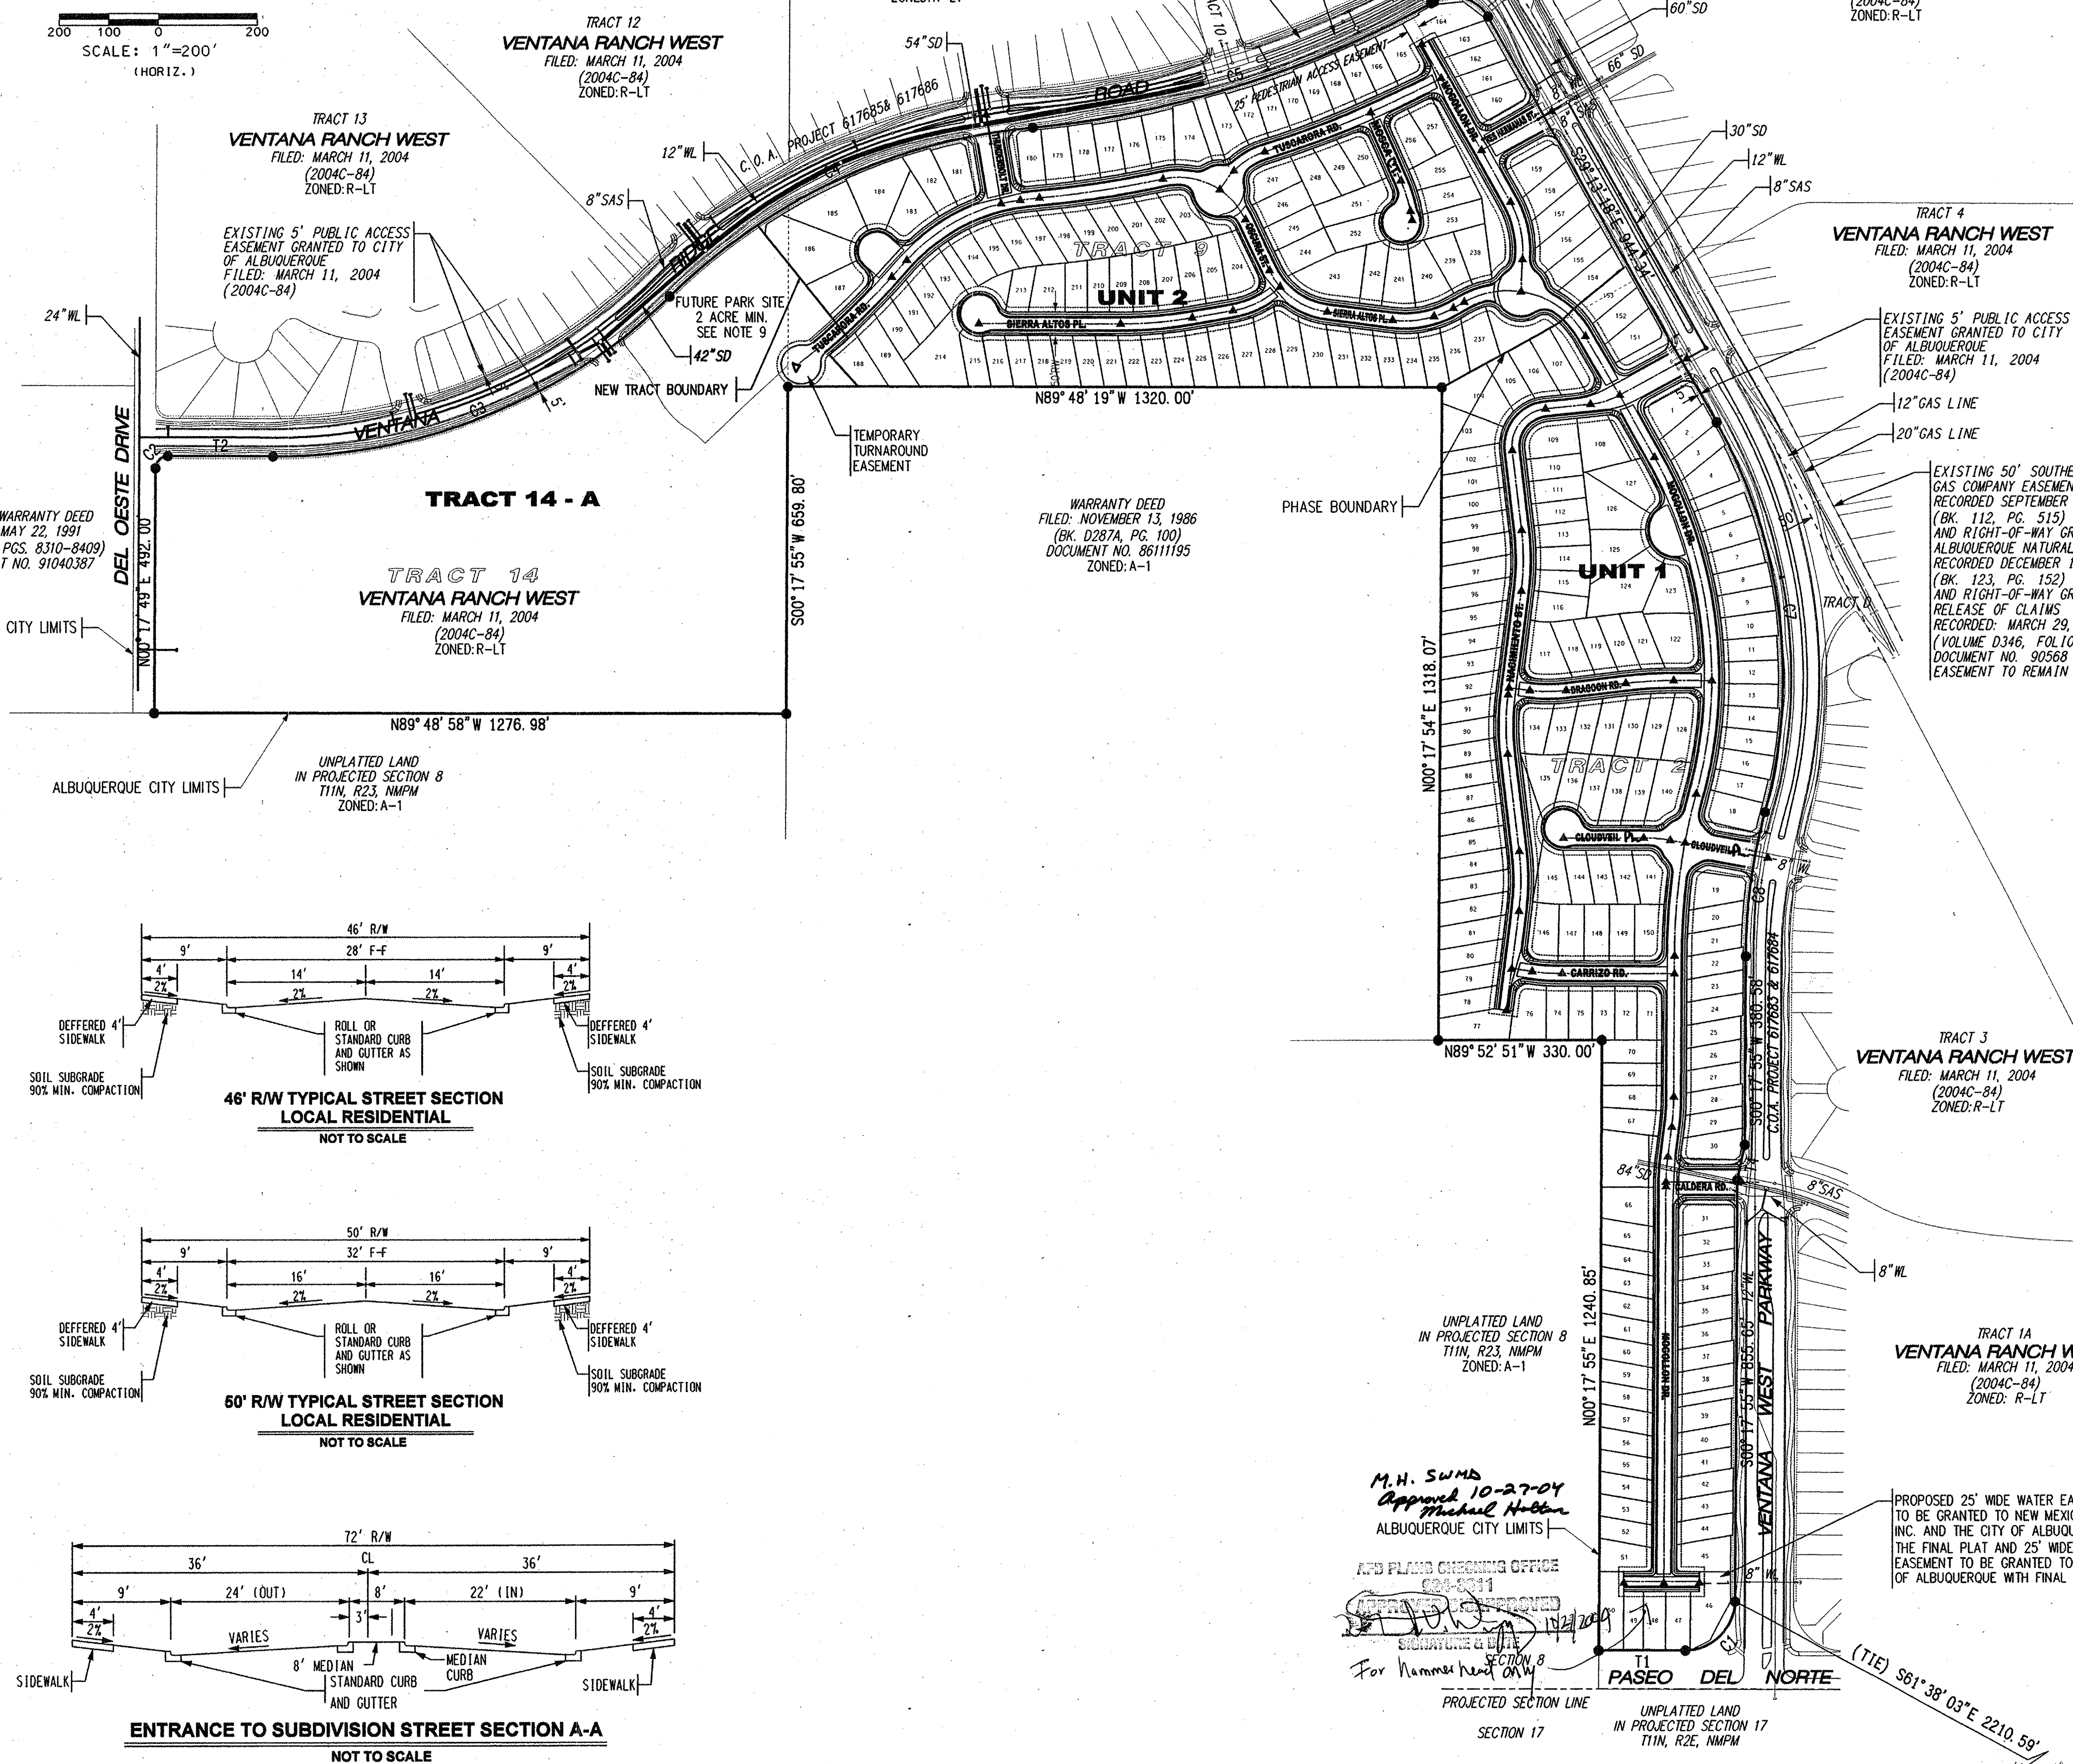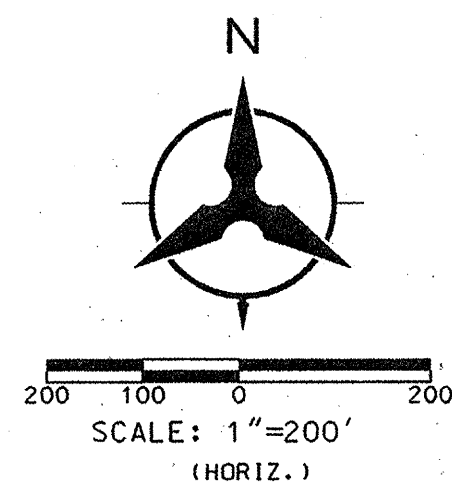

LOCATION MAP
ZONE ATLAS MAP NO. B-8
NOT TO SCALE

PRELIMINARY PLAT WESTERN RIDGE SUBDIVISION UNIT 1 & UNIT 2 (REPLAT OF TRACT 2, 9 & 14 AT VENTANA RANCH WEST) ALBUQUERQUE, NEW MEXICO SEPTEMBER, 2004

LEGAL DESCRIPTION:
TRACTS 2, 9 & 14 OF VENTANA RANCH WEST
FILED: MARCH 11, 2004 (2004C-84)

- EXISTING ZONING: RL
PROPOSED ZONING: RL
PROPOSED DEVELOPMENT:
SINGLE FAMILY DETACHED RESIDENTIAL
- TOTAL ACREAGE: 49.7 (69.10) GROSS ACRES
TOTAL NUMBER OF LOTS: 257 LOTS
PROPOSED DENSITY: 5.17 D.U. PER ACRE
TOTAL NUMBER OF LANDSCAPE / PEDESTRIAN ACCESS TRACTS: 21
TOTAL NUMBER OF BULK PARCELS REMAINING: 1 (TRACT 14-A)
- MINIMUM LOT DIMENSIONS 45' x 105'
- ALL STREETS AND DRAINAGE IMPROVEMENTS ARE TO BE PUBLIC TO BE DEDICATED FOR MAINTENANCE TO THE CITY OF ALBUQUERQUE.
- THIS SUBDIVISION LIES WITHIN THE NEW MEXICO UTILITIES, INC. (NMU) FRANCHISE AREA. WATER AND SANITARY SEWER CAPABILITIES AREA BASED ON NMU'S FACILITIES, AND NOT ON THE CITY OF ALBUQUERQUE'S. WATER AND SANITARY SEWER INFRASTRUCTURE IMPROVEMENTS MUST BE APPROVED BY BOTH THE CITY OF ALBUQUERQUE AND NMU.
- ALL SANITARY AND WATER UTILITIES IN THE STREET R/W ARE TO BE OWNED AND MAINTAINED BY NMU.
- NO INDIVIDUAL LOTS SHALL BE ALLOWED DIRECT ACCESS TO VENTANA WEST PARKWAY, PASEO DEL NORTE, VENTANA RIDGE ROAD OF VENTANA RANCH WEST AND TRACT A THRU R.
- LOT SETBACKS SHALL CONFORM TO RL ZONE REGULATIONS. REQUIRED SETBACKS SHALL INCLUDE:
FRONT YARD: 20' (TYP.)
(15' MIN.) TO GARAGE MIN.)
SIDE YARD: 5' (MIN.)
BACK YARD: 15' (MIN.)
CORNER SIDEYARD: 10' TO R/W
- PARK DEDICATION REQUIREMENTS HAVE BEEN MET WITH PARK SITE AS RESERVED AS A PORTION OF TRACT 14-A / TRACT 9 VENTANA RANCH WEST, IN ACCORDANCE WITH THE PARK DEDICATION AGREEMENT BETWEEN THE CITY OF ALBUQUERQUE AND VENTANA WEST, LLC DATED: MARCH 10, 2004 AS DOCUMENT NO. 2004031336.
- TRACT 2 IS SUBJECT TO AN EXISTING THIRTY (30') WIDE FLOODING PUBLIC STORM DRAIN EASEMENT GRANTED TO THE CITY OF ALBUQUERQUE.
FILED: MARCH 11, 2004 IN BOOK 2004C, PAGE 84. EASEMENT TO BE VACATED BY VACATION ACTION.
- TRACTS A THRU K AND TRACTS M THRU U ARE TO BE DEDICATED TO AND MAINTAINED BY VENTANA RANCH WEST COMMUNITY ASSOCIATION BY SEPARATE DEED AND SOLELY AS PRIVATE OPEN SPACE. PEDESTRIAN ACCESS AND COMMUNITY LANDSCAPING, AN EXCLUSIVE BLANKET STORM DRAIN AND DRAINAGE EASEMENT TO BE GRANTED TO THE CITY OF ALBUQUERQUE WITH THE FINAL PLAT.
- TRACT L IS DEDICATED TO THE CITY OF ALBUQUERQUE IN FEE SIMPLE WITH THE FILING OF THIS PLAT. TRACT L IS ENCOMPASSED WITH A PERMANENT PUBLIC DRAINAGE EASEMENT AND WILL BE MAINTAINED BY THE CITY OF ALBUQUERQUE. FOR THIS PURPOSE, A PRIVATE LANDSCAPE EASEMENT IS RESERVED FOR THE VENTANA RANCH WEST COMMUNITY ASSOCIATION, INC., OVER TRACT L.
- NO INDIVIDUAL LOTS SHALL BE ALLOWED DIRECT ACCESS TO ANY LANDS ADJACENT TO VENTANA RANCH WEST BOUNDARY.

VENTANA WEST, LLC
A NEW MEXICO LIMITED LIABILITY COMPANY
[Signature]
ROBERT M. MURPHY, PRESIDENT
SANDIA PROPERTIES LTD. CO.
MANAGING MEMBER

NGS BRASS TABLET STAMPED "UNION 1969"
GEOGRAPHIC POSITION (NAD 1927)
NM STATE PLANE COORDINATES (CENTRAL ZONE)
X=353,409.02 Y=1,523,440.96
GROUND TO GRID FACTOR = 0.9996044
DELTA ALPHA = -00°16'58"
NGVD 1929 ELEVATION = 5522.0 (TRIG)

SHEET 1 of 3

Bohannon & Huston
Courtyard I 7500 Jefferson St. NE Albuquerque, NM 87109-4335
ENGINEERING • SPATIAL DATA • ADVANCED TECHNOLOGIES

BH1 JOB NO. 050125

COPYRIGHT BOHANNAN HUSTON, INC. 2004

SCANNED BY PLN

EXISTING 5' PUBLIC ACCESS
EASEMENT GRANTED TO CITY
OF ALBUQUERQUE
FILED: MARCH 11, 2004
(2004C-84)

EXISTING 50' SOUTHERN UNION
GAS COMPANY EASEMENT
RECORDED SEPTEMBER 16, 1930
(BK. 112, PG. 515)
AND RIGHT-OF-WAY GRANTED TO
ALBUQUERQUE NATURAL GAS COMPANY
RECORDED DECEMBER 11, 1931
(BK. 123, PG. 152)
AND RIGHT-OF-WAY GRANT AND
RELEASE OF CLAIMS
RECORDED: MARCH 29, 1956
(VOLUME D346, FOLIO 356-360)
DOCUMENT NO. 90568
EASEMENT TO REMAIN


TRACT D
VENTANA RANCH WEST
FILED: MARCH 11, 2004
(2004C-84)

TRACT 3
VENTANA RANCH WEST
FILED: MARCH 11, 2004
(2004C-84)


TRACT 1A
VENTANA RANCH WEST
FILED: MARCH 11, 2004
(2004C-84)

PROPOSED 25' WIDE WATER EASEMENT
TO BE GRANTED TO NEW MEXICO UTILITIES
INC. AND THE CITY OF ALBUQUERQUE WITH
THE FINAL PLAT AND 25' WIDE STORM DRAIN
EASEMENT TO BE GRANTED TO THE CITY
OF ALBUQUERQUE WITH THE FINAL PLAT.

UNIT 2
WESTERN RIDGE SUBDIVISION

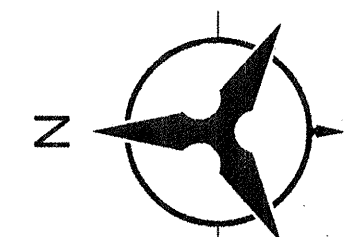

SCALE: 1"=100'
(HORIZ.)

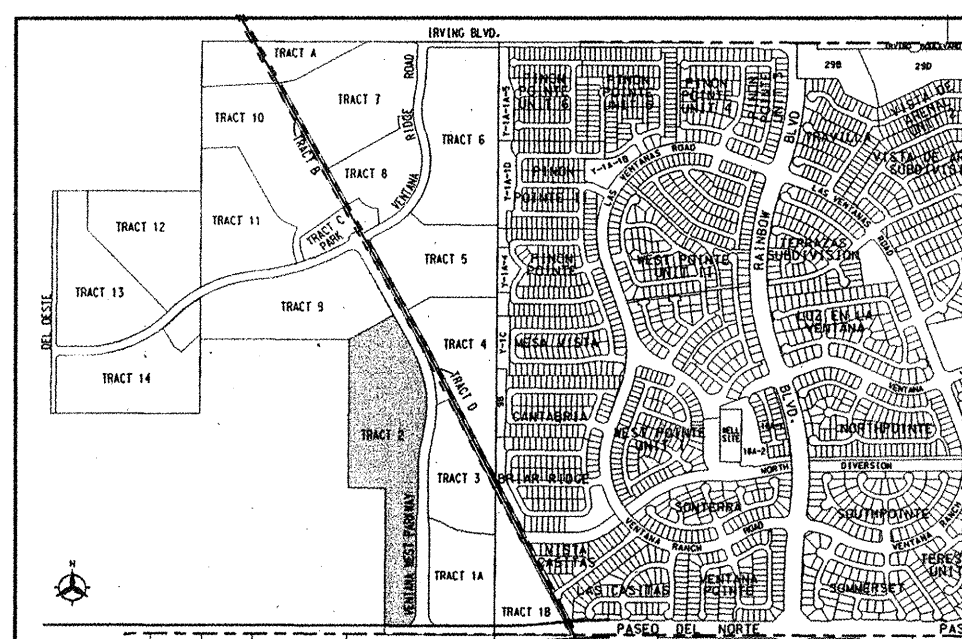

LOCATION MAP

ZONE ATLAS MAP NO. B-8
NOT TO SCALE

PRELIMINARY PLAT
UNIT 1
WESTERN RIDGE SUBDIVISION

**(REPLAT OF TRACT 2, 9 & 14
AT VENTANA RANCH WEST)**

ALBUQUERQUE, NEW MEXICO
SEPTEMBER, 2004

SHEET 2 of 3



Bohannon ▲ Huston

Courtyard I 7500 Jefferson St. NE Albuquerque, NM 87109-4335
ENGINEERING ▲ SPATIAL DATA ▲ ADVANCED TECHNOLOGIES


BHI JOB NO. 050125

COPYRIGHT BOHANNAN HUSTON, INC. 2004

SCANNED
PLAN

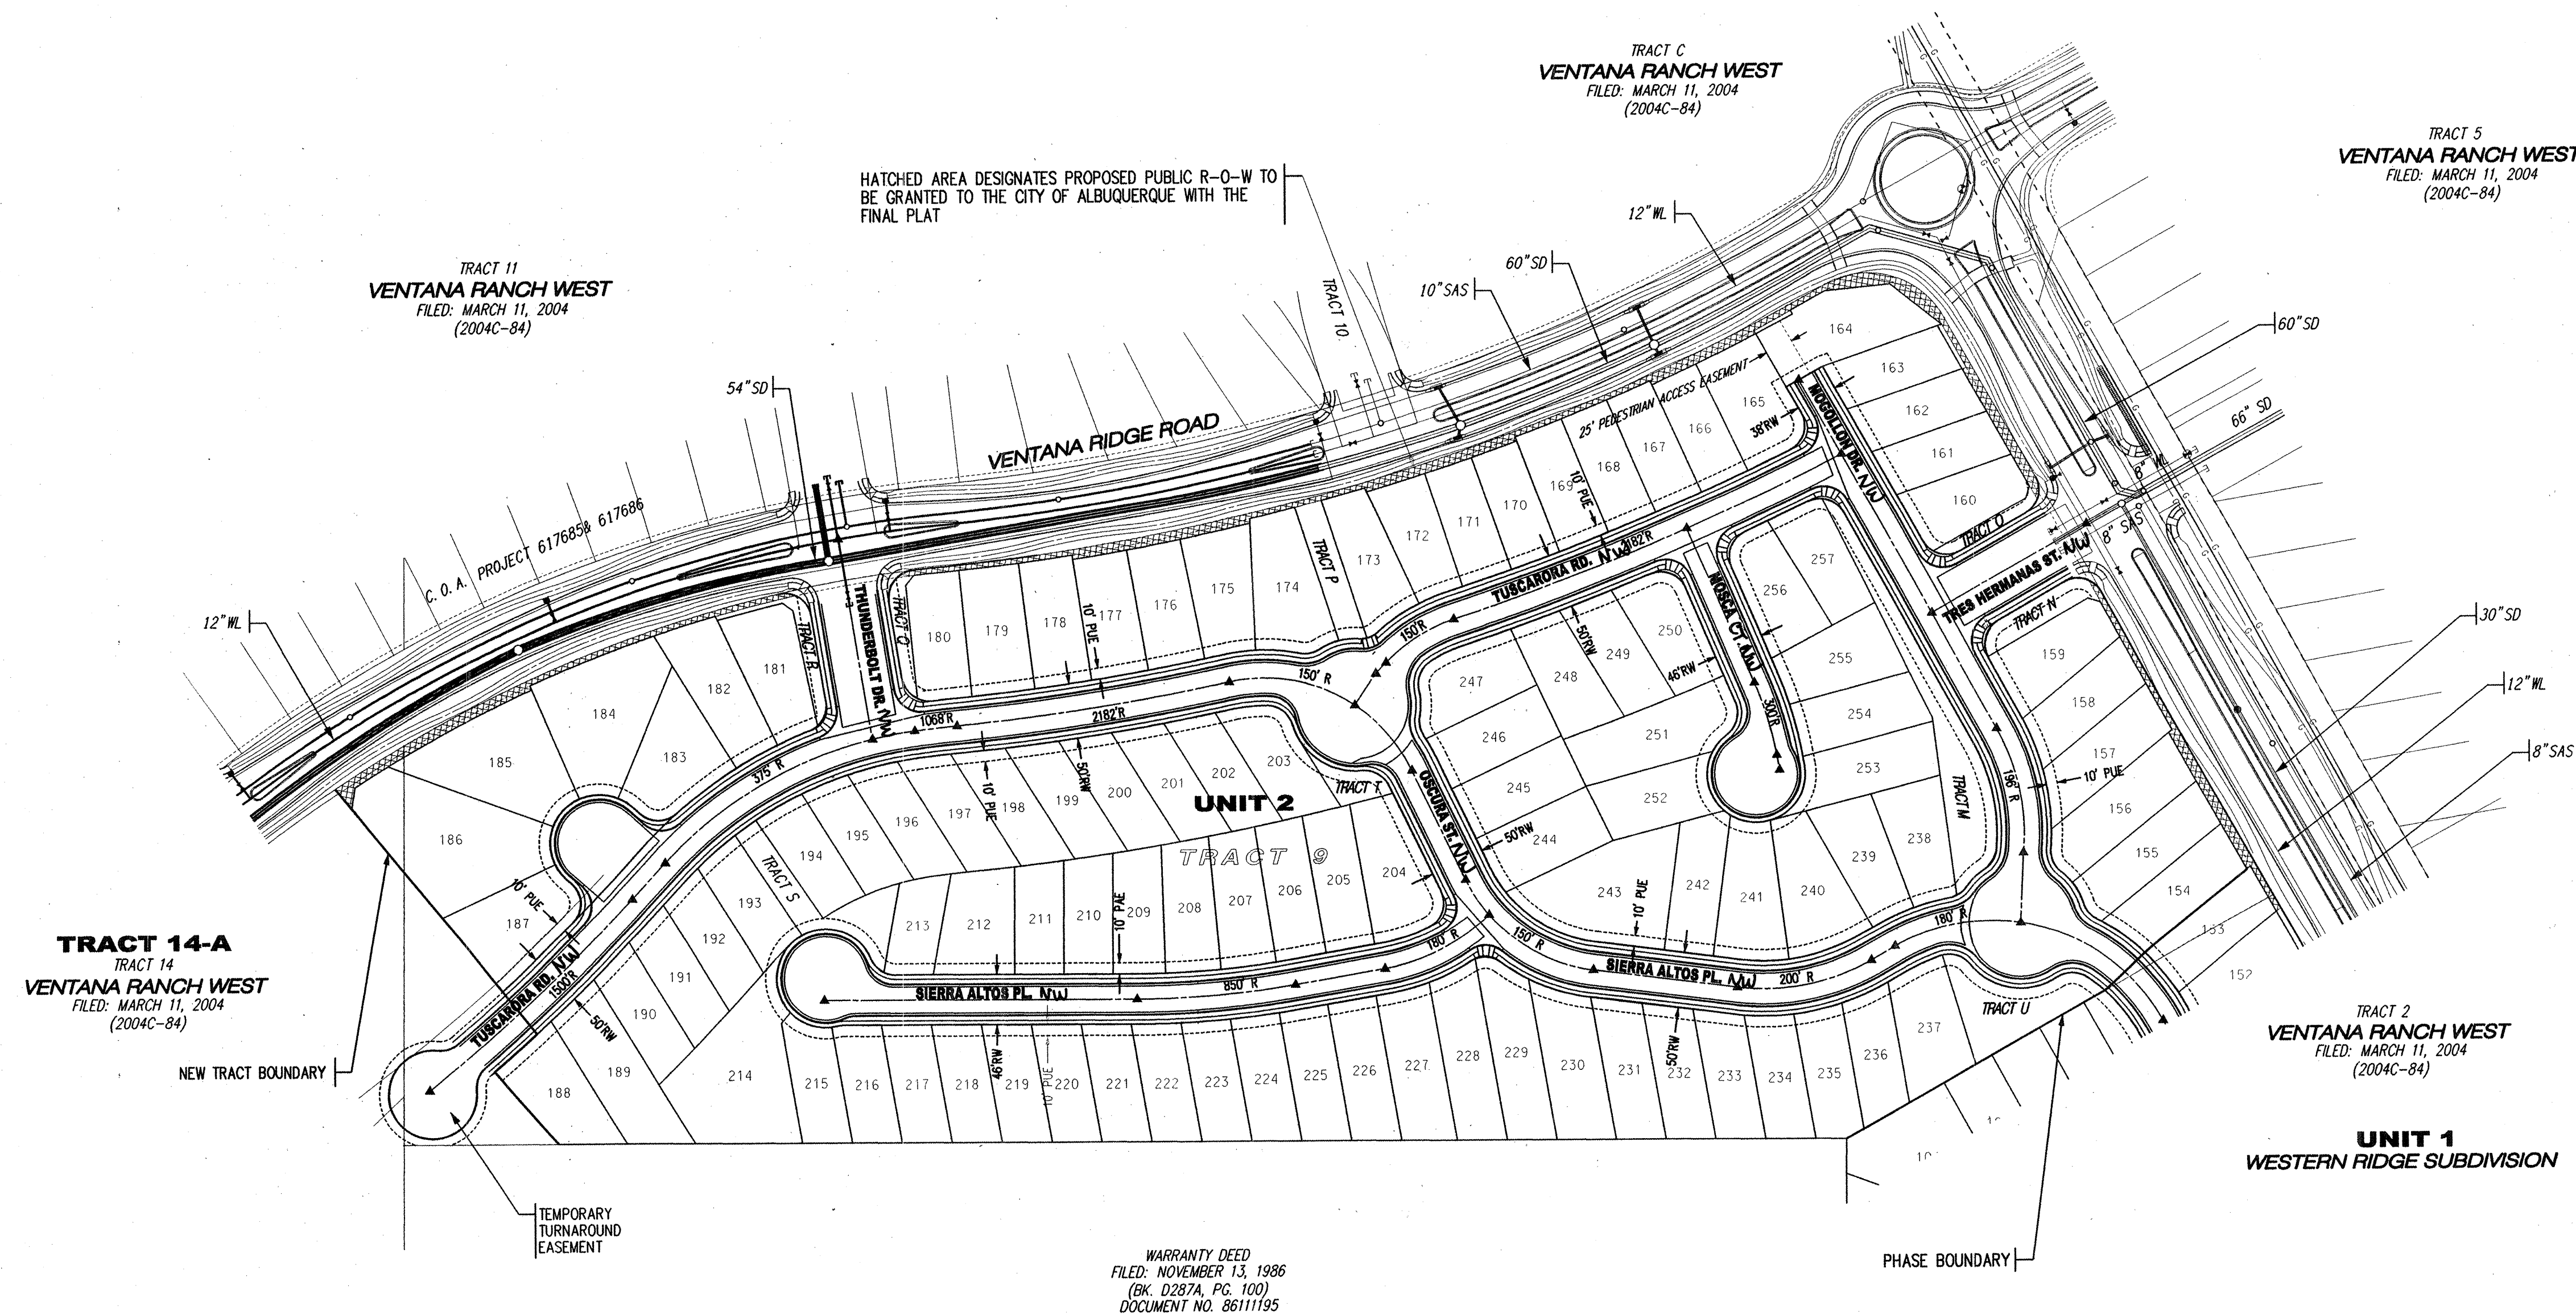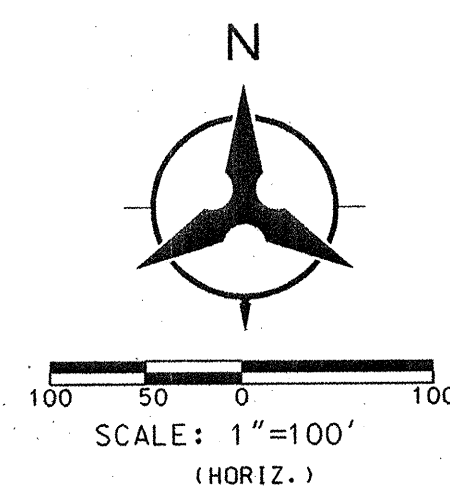

PRELIMINARY PLAT
UNIT 2
WESTERN RIDGE SUBDIVISION
(REPLAT OF TRACT 2, 9 & 14
AT VENTANA RANCH WEST)
ALBUQUERQUE, NEW MEXICO
SEPTEMBER, 2004

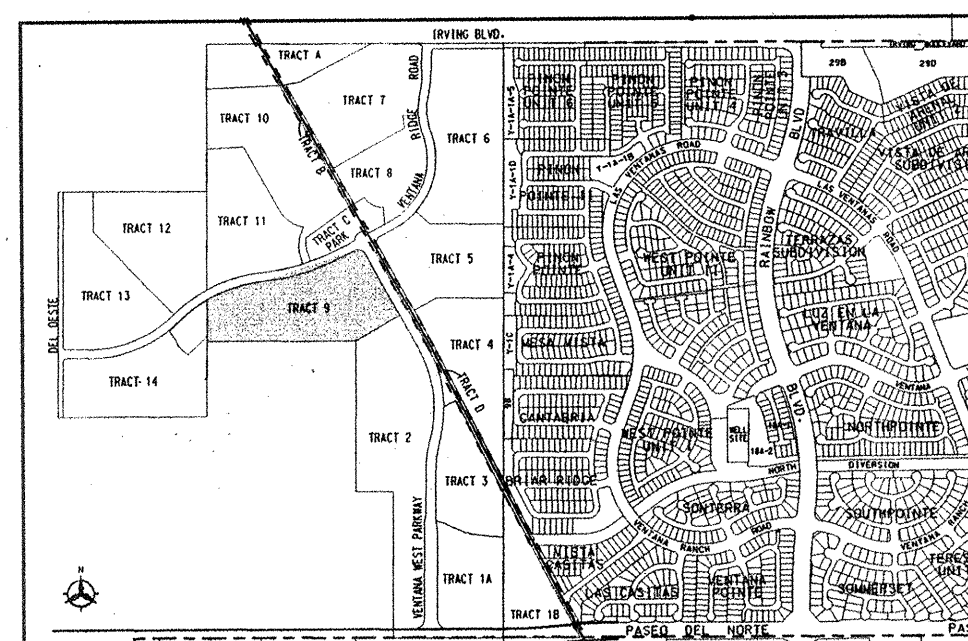

LOCATION MAP
ZONE ATLAS MAP NO. B-8
NOT TO SCALE

SHEET 3 of 3

Bohannon & Huston


Courtyard I 7500 Jefferson St. NE Albuquerque, NM 87109-4335
ENGINEERING • SPATIAL DATA • ADVANCED TECHNOLOGIES

BH1 JOB NO. 050125

COPYRIGHT BOHANNAN HUSTON, INC. 2004

4 of 37

SCANNED BY PLD

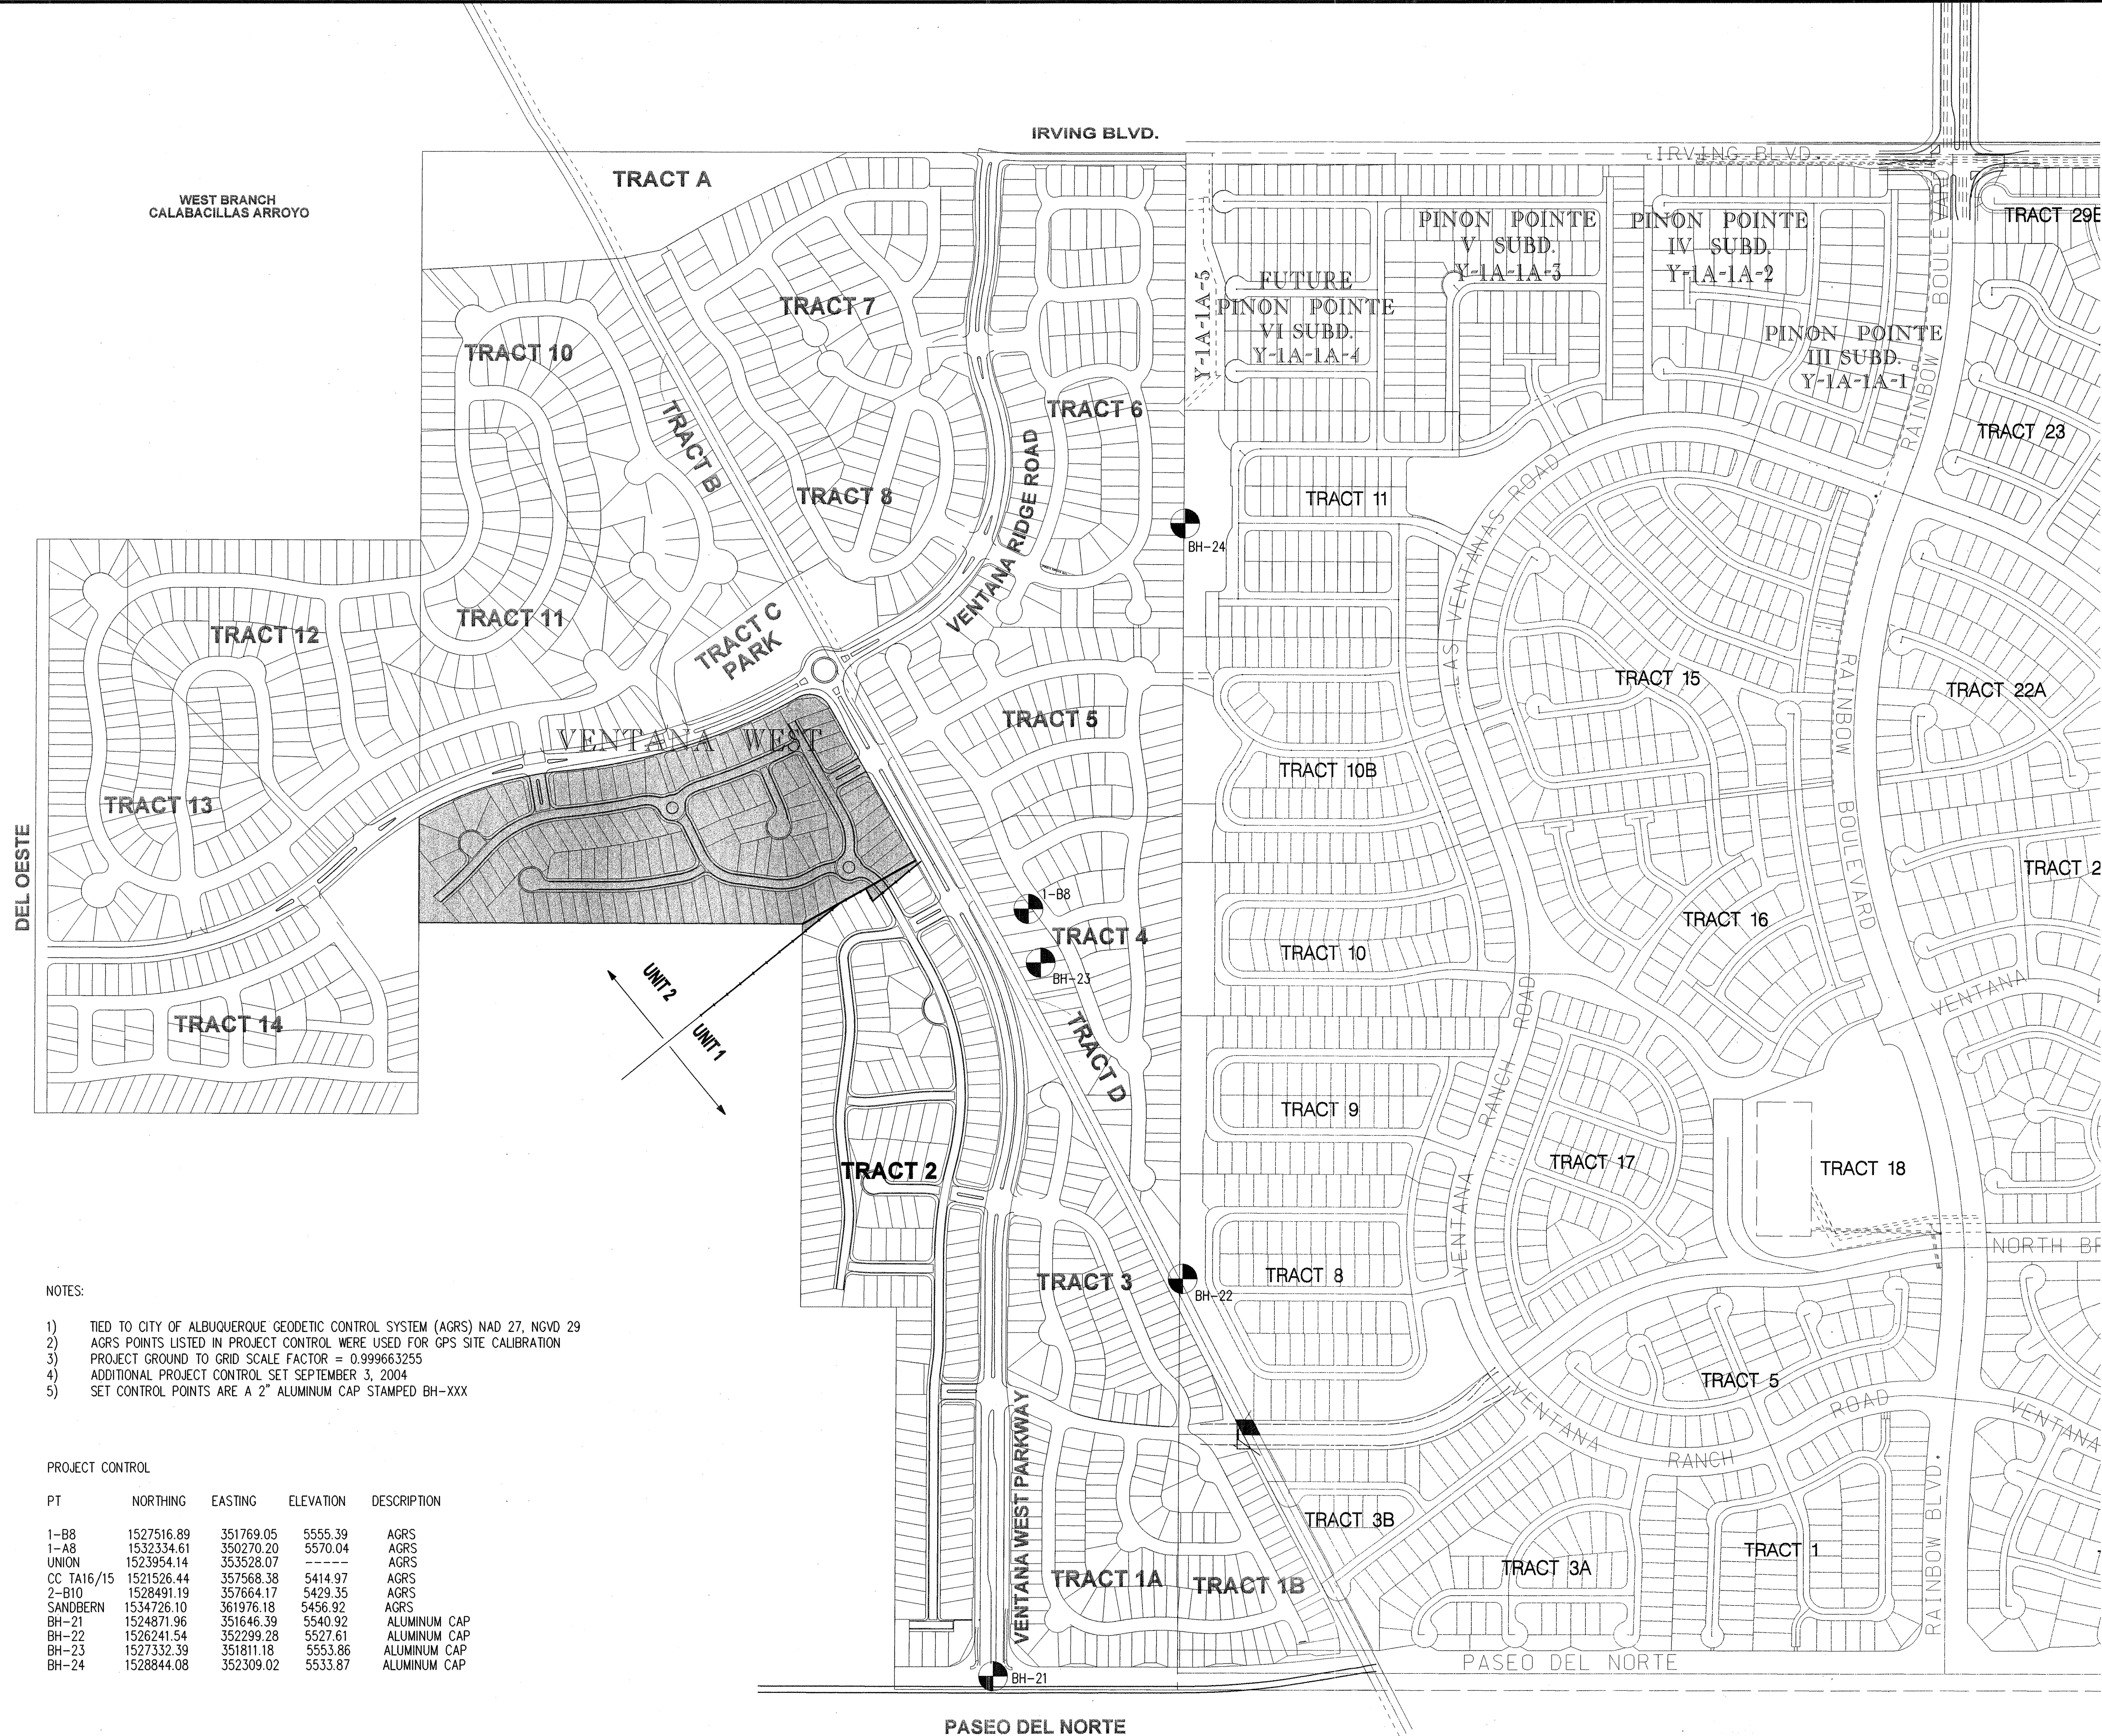

- NOTES:
- 1) TIED TO CITY OF ALBUQUERQUE GEODETIC CONTROL SYSTEM (AGRS) NAD 27, NGVD 29
 - 2) AGRS POINTS LISTED IN PROJECT CONTROL WERE USED FOR GPS SITE CALIBRATION
 - 3) PROJECT GROUND TO GRID SCALE FACTOR = 0.999663255
 - 4) ADDITIONAL PROJECT CONTROL SET SEPTEMBER 3, 2004
 - 5) SET CONTROL POINTS ARE A 2" ALUMINUM CAP STAMPED BH-XXX

PROJECT CONTROL

PT	NORTHING	EASTING	ELEVATION	DESCRIPTION
1-B8	1527516.89	351769.05	5555.39	AGRS
1-A8	1532334.61	350270.20	5570.04	AGRS
UNION	1523954.14	353528.07	—	AGRS
CC TA16/15	1521526.44	357568.38	5414.97	AGRS
2-B10	1528491.19	357664.17	5429.35	AGRS
SANDBERN	1534726.10	361976.18	5456.92	AGRS
BH-21	1524871.96	351646.39	5540.92	ALUMINUM CAP
BH-22	1526241.54	352299.28	5527.61	ALUMINUM CAP
BH-23	1527332.39	351811.18	5553.86	ALUMINUM CAP
BH-24	1528844.08	352309.02	5533.87	ALUMINUM CAP

Bohannon & Huston

Courtyard I 7500 Jefferson St. NE Albuquerque, NM 87109-4335

ENGINEERING • SPATIAL DATA • ADVANCED TECHNOLOGIES



CITY OF ALBUQUERQUE
PUBLIC WORKS DEPARTMENT
ENGINEERING DEVELOPMENT GROUP

WESTERN RIDGE (UNIT 2) SUBDIVISION AT VENTANA RANCH WEST
SITE DESCRIPTION PLAN & SURVEY CONTROL

DESIGN REVIEW COMMITTEE	CITY ENGINEER APPROVAL	MO./DAY/YR.	MO./DAY/YR.
APPROVED MAR 10 2005 DESIGN REVIEW COMMITTEE	APPROVED SEP 8 2005 CITY ENGINEER		
LAST DESIGN UPDATE			


CITY PROJECT NO.	ZONE MAP NO.	SHEET	OF
749486	B-8-Z	7	37

SCANNED BY PLD

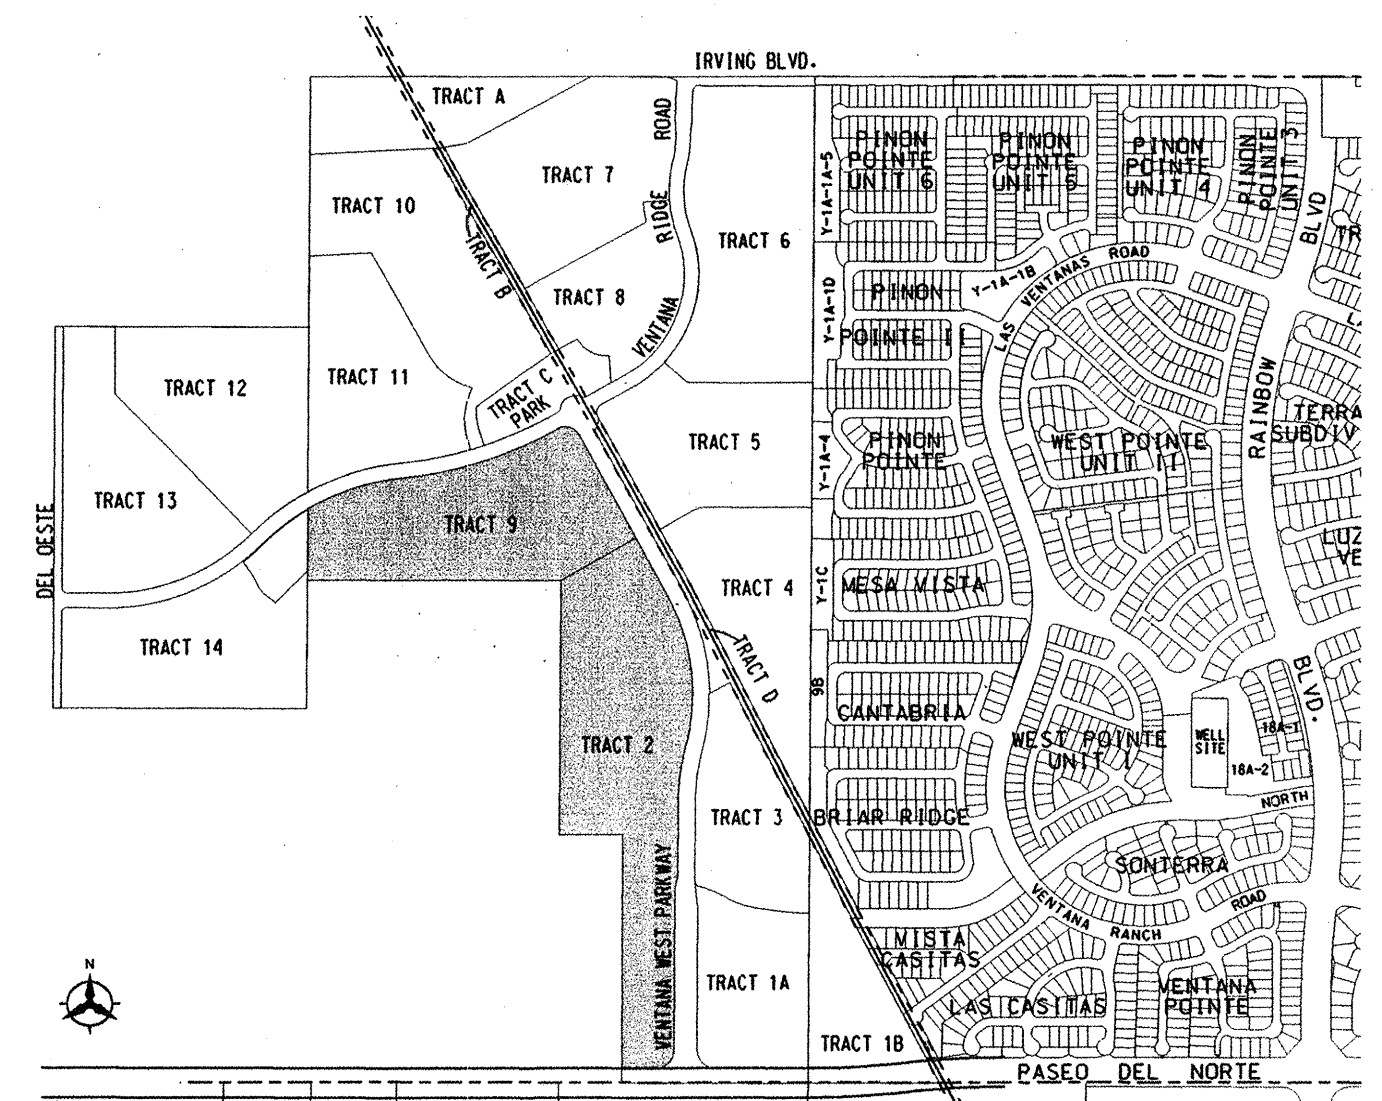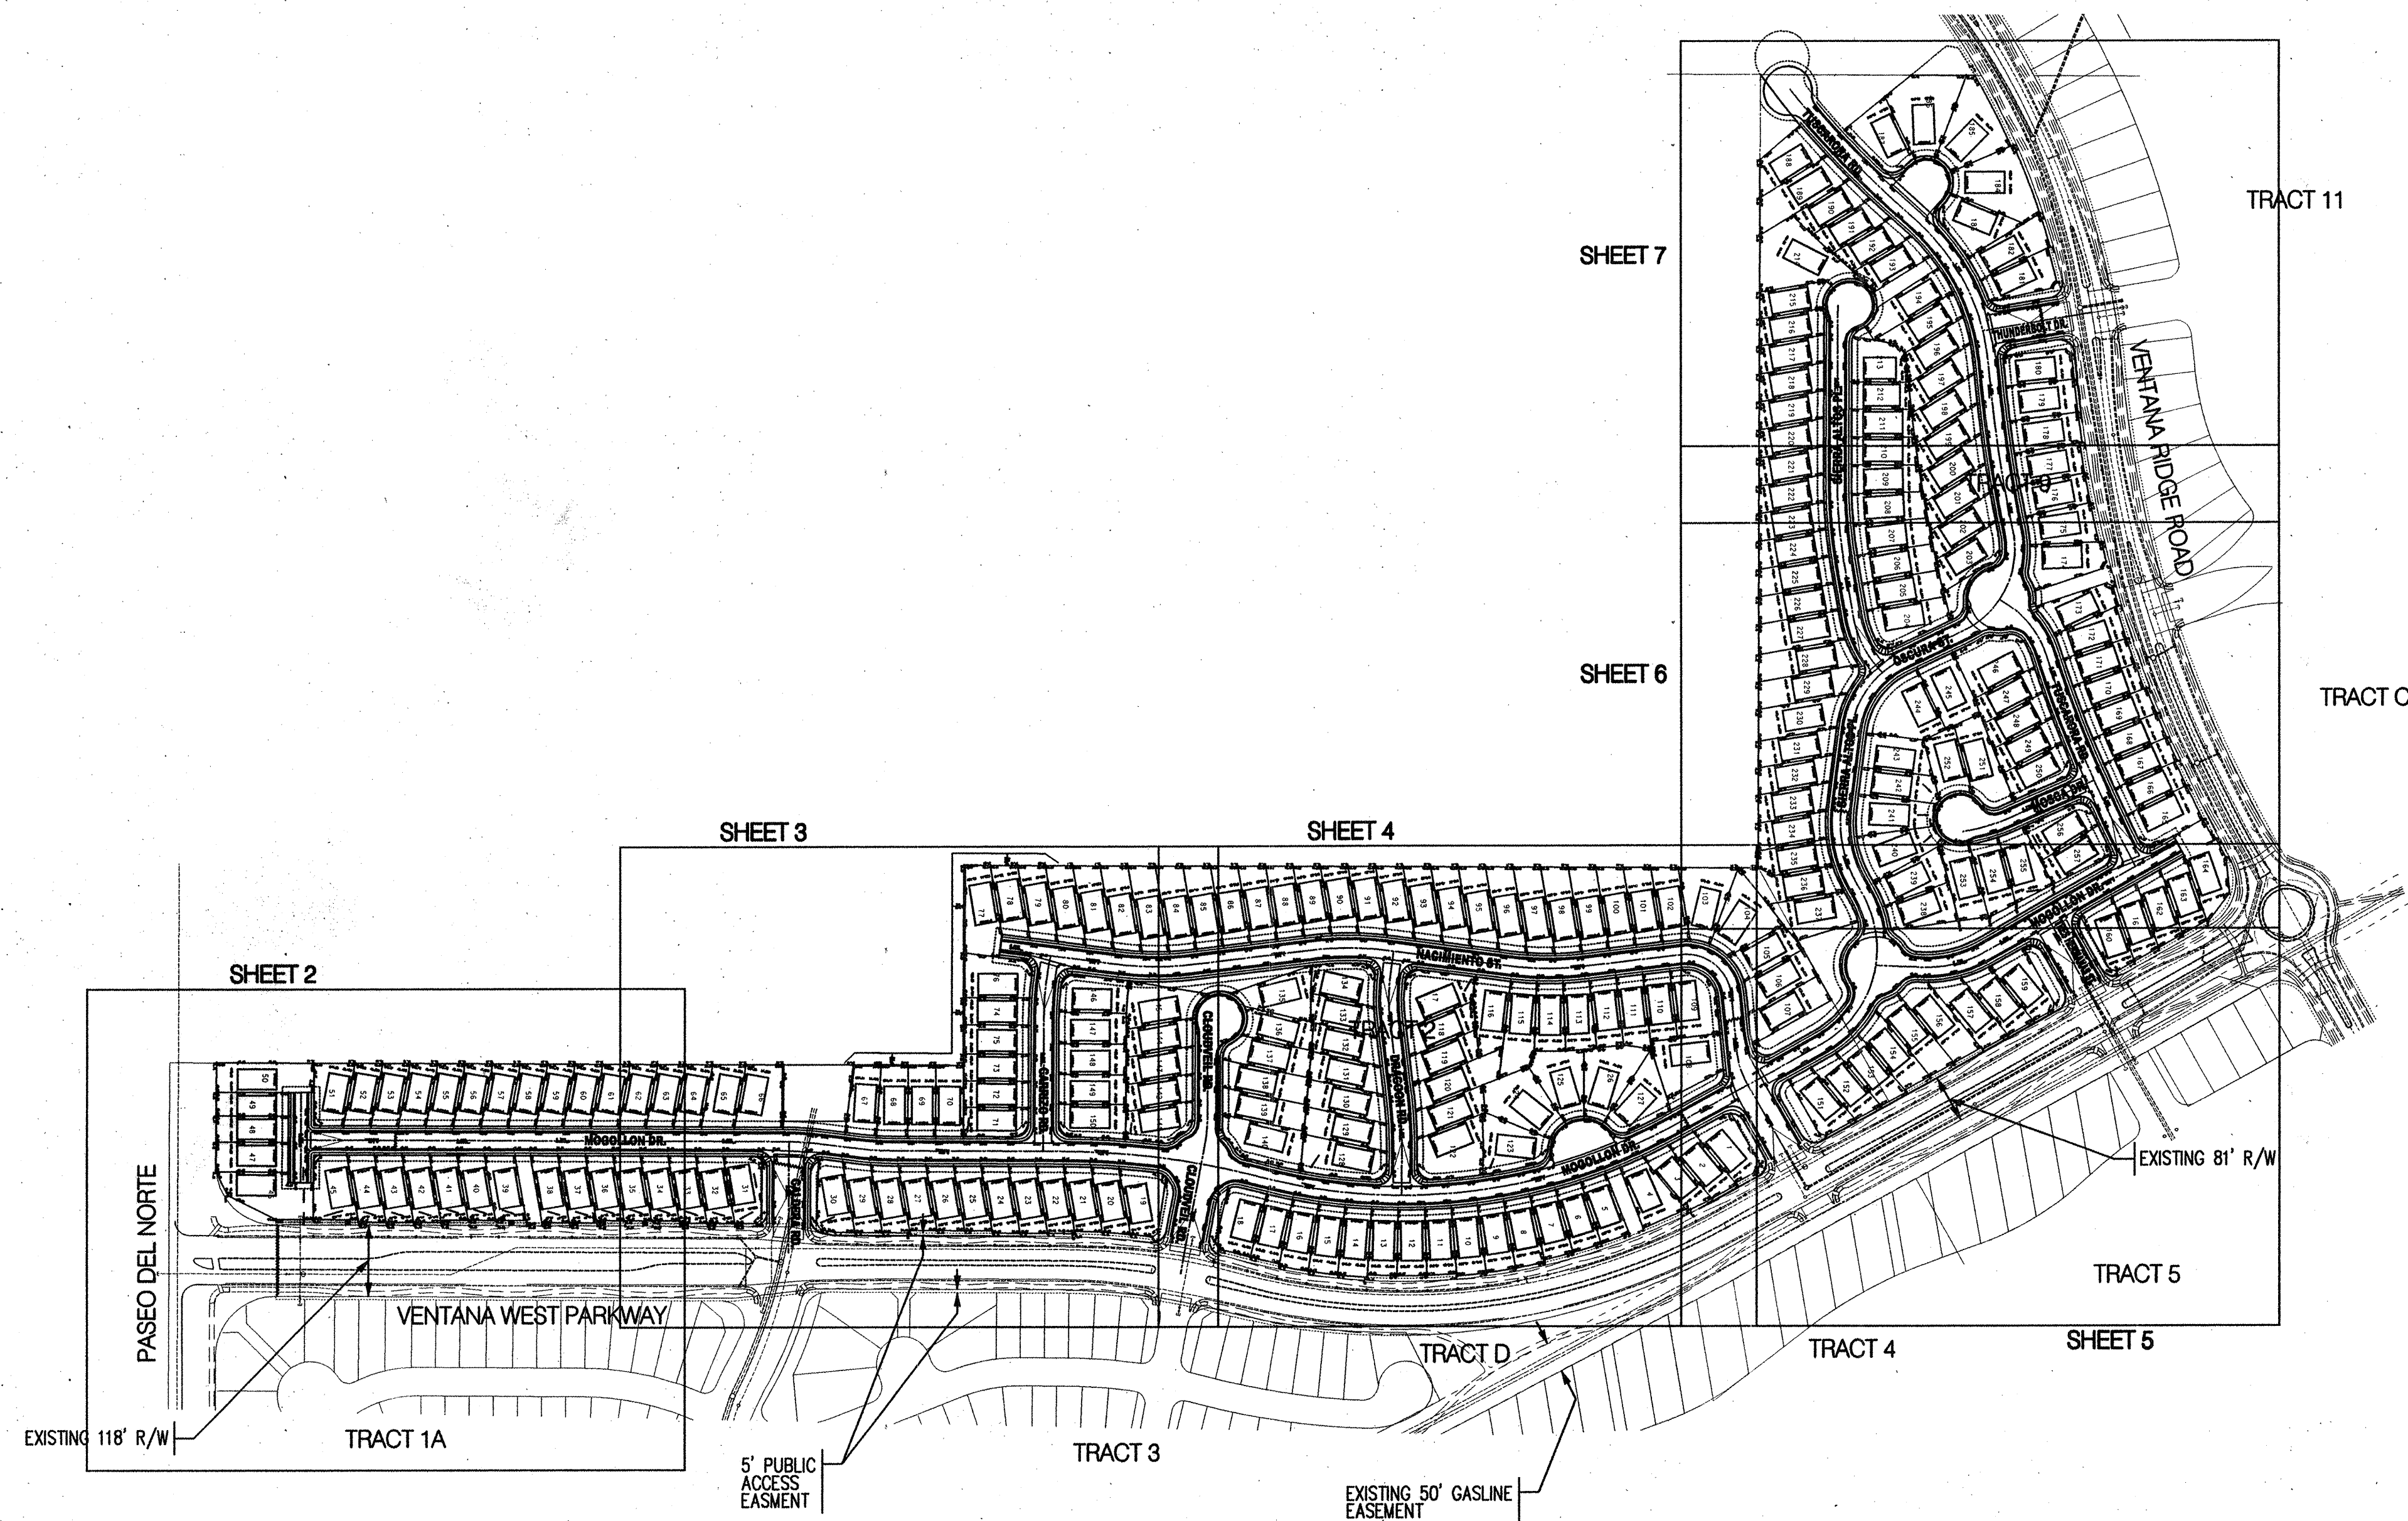

LEGAL DESCRIPTION:
TRACTS 2&9, VENTANA RANCH WEST.

- REFERENCE PROJECTS:
1. VENTANA RANCH WEST PUBLIC IMPROVEMENTS
DISTRICT/ADDITIONAL BACKBONE ROADWAY
AND STORM DRAIN IMPROVEMENTS
PHASE I COA PROJECT # 617683
PHASE II COA PROJECT # 617685
 2. VENTANA RANCH WEST WATER & SANITARY
SEWER IMPROVEMENTS
PHASE I COA PROJECT # 617684
PHASE II COA PROJECT # 617686

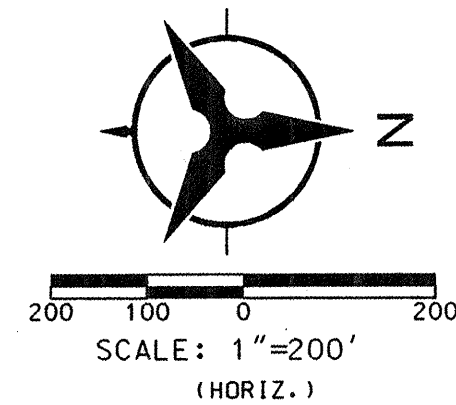

APPROVED FOR ROUGH GRADING _____ DATE _____

Bohannon & Huston Courtney 7500 Jefferson St. NE Albuquerque, NM 87109-4335 ENGINEERING • SPATIAL DATA • ADVANCED TECHNOLOGIES	
CITY OF ALBUQUERQUE PUBLIC WORKS DEPARTMENT ENGINEERING DEVELOPMENT GROUP	
TRACT 2 & 9 SUBDIVISION AT VENTANA RANCH WEST OVERALL GRADING PLAN	
DESIGN REVIEW COMMITTEE N/A for Info	CITY ENGINEER APPROVAL _____
CITY PROJECT NO. XXXXXX	ZONE MAP NO. B-8-Z
DESIGNED BY JPP	DATE SEPT 04
DRAWN BY ARR	DATE SEPT 04
CHECKED BY KGP	DATE SEPT 04

																																																																																																																																																																																																																																																																																																																																																																																																																																																																																																																																																																																																																																																																																																																																																																																																																																																																																																																																																																																																																																																																																																																																																																																																																																																																																																																																																																																																																					</
--	--	----

5545'

5540'

5535'

3600'

BHI JOB NO. 050125


BHI JOB NO. 050125


LEGEND		BENCH MARKS		AS-BUILT INFORMATION	
PROPOSED SPOT ELEVATION	• 5235.25	CONTRACTOR INSPECTOR BY DATE FIELD VERIFICATION BY DATE CORRECTED BY DATE NO. 1929 ELEVATION = 5429.35 DELTA ALPHA = -0016'30" GROUND-TO-GRID FACTOR = .99866354 X=357,543.73 Y=1,527,976.48 N.M. STATE PLANE COORDINATES GEOGRAPHIC POSITION (NAD 1927) ACS BRASS TABLET STAMPED "2-B10 1980"			
PROPOSED SPOT ELEVATION	◊ 5235.25				
EXISTING CONTOUR	---				
PHASE BOUNDARY	---				
DIRECTION OF FLOW	→				
EXISTING STORM DRAIN LINE					
EXISTING STORM DRAIN INLET					
EXISTING WATER LINE	---				
EXISTING SAS LINE	---				
EXISTING SAS MANHOLE					
PROPOSED WATER BLOCK					
RETAINING WALL					
GARDEN WALL					
POND CONTOUR	---				
PAD					
PROPOSED LANDSCAPE TRACT					
TURN BLOCK	TB				



SCALE: 1"=40'

(HORIZ.)

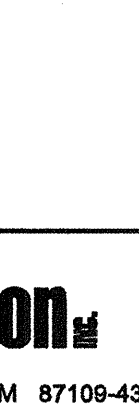

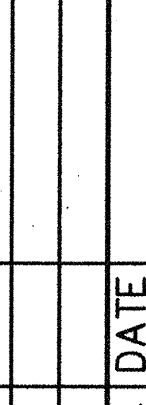ENGINEER'S SEAL		SURVEY INFORMATION		BENCH MARKS	
	NO.	BY	DATE	FIELD NOTES	AS-BUILT INFORMATION
REVISIONS		REMARKS			
DESIGN		BY			
DESIGNED BY		DATE		SEPT 04	
DRAWN BY		ARR		SEPT 04	
CHECKED BY		KGP		SEPT 04	

Bohannon & Huston

Courtyard I 7500 Jefferson St. NE Albuquerque, NM 87109-4335

ENGINEERING • SPATIAL DATA • ADVANCED TECHNOLOGIES


CITY OF ALBUQUERQUE

PUBLIC WORKS DEPARTMENT


ENGINEERING DEVELOPMENT GROUP

TRACT 2 & 9 SUBDIVISION AT VENTANA RANCH WEST			
OVERALL GRADING PLAN			
DESIGN REVIEW COMMITTEE	CITY ENGINEER APPROVAL	MO./DAY/YR.	MO./DAY/YR.
N/A for Info	[Signature]		
LAST DESIGN UPDATE			
CITY PROJECT NO. XXXXXX		ZONE MAP NO. B-8-Z	
SHEET 3		OF 10	

SCANNED BY P71

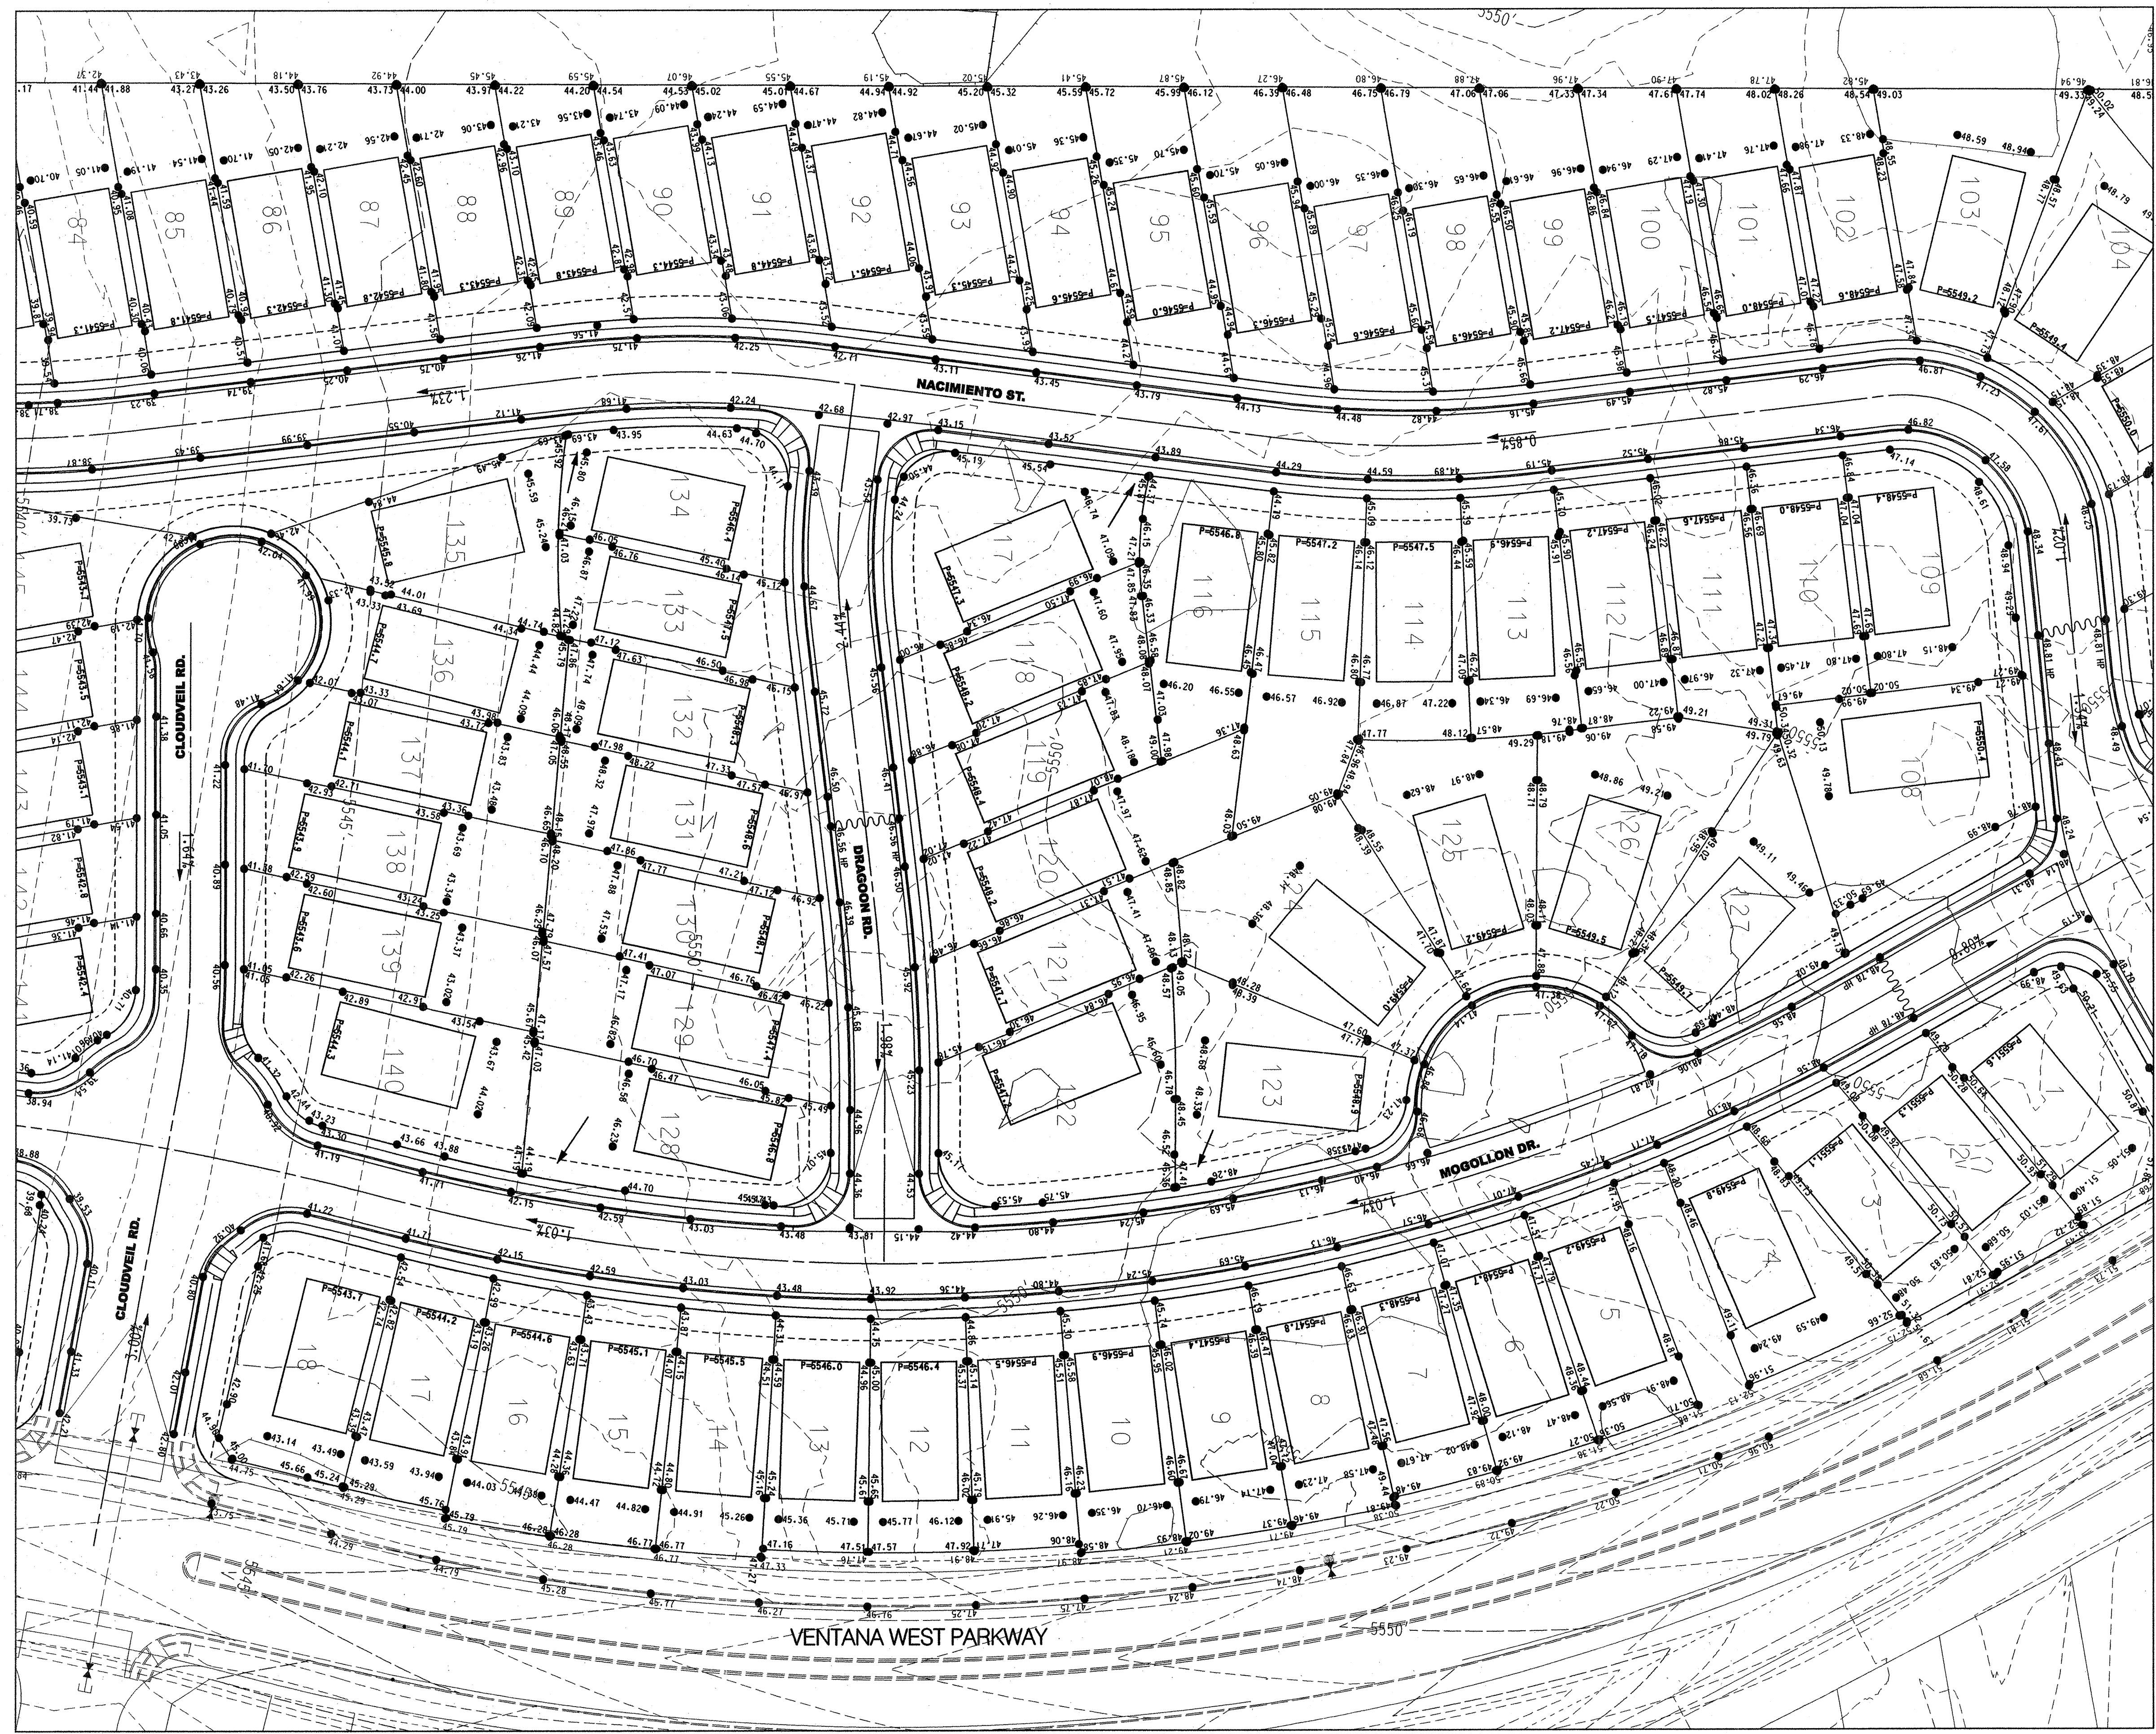

- LEGEND
- PROPOSED SPOT ELEVATION 5235.25
 - PROPOSED SPOT ELEVATION 5235.25
 - EXISTING CONTOUR
 - PHASE BOUNDARY
 - DIRECTION OF FLOW
 - EXISTING STORM DRAIN LINE
 - EXISTING STORM DRAIN INLET
 - EXISTING WATER LINE
 - EXISTING SAS LINE
 - EXISTING SAS MANHOLE
 - PROPOSED WATER BLOCK
 - RETAINING WALL
 - GARDEN WALL
 - POND CONTOUR
 - PAD
 - PROPOSED LANDSCAPE TRACT
 - TURN BLOCK TB

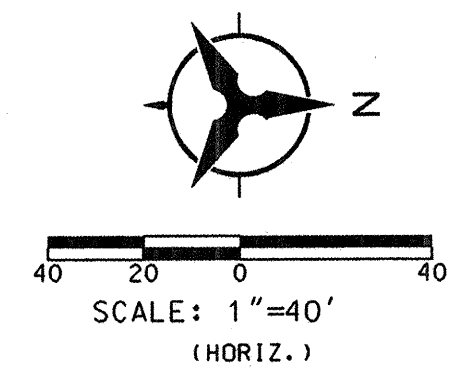




Bohannon & Huston
Court yard 1 7600 Jefferson St. NE Albuquerque, NM 87109-4335
ENGINEERING • SPATIAL DATA • ADVANCED TECHNOLOGIES


CITY OF ALBUQUERQUE
PUBLIC WORKS DEPARTMENT
ENGINEERING DEVELOPMENT GROUP
TRACT 2 & 9 SUBDIVISION AT VENTANA RANCH WEST
OVERALL GRADING PLAN

DESIGN REVIEW COMMITTEE	CITY ENGINEER APPROVAL	MO./DAY/YR.	MO./DAY/YR.
N/A for Info			
CITY PROJECT NO. XXXXXX	ZONE MAP NO. B-8-Z	SHEET 4	OF 10

ENGINEER'S SEAL		SURVEY INFORMATION		BENCH MARKS		AS-BUILT INFORMATION	
BY		DATE		NO.		CONTRACTOR	
REVISIONS		DATE		NO.		WORK ORDER	
DESIGN		DATE		NO.		INSPECTOR'S	
JPP		DATE		NO.		ACCEPTANCE BY	
ARR		DATE		NO.		DATE	
KGP		DATE		NO.		DATE	
DATE SEPT 04		DATE SEPT 04		DATE		DATE	
DATE SEPT 04		DATE SEPT 04		DATE		DATE	
DATE SEPT 04		DATE SEPT 04		DATE		DATE	

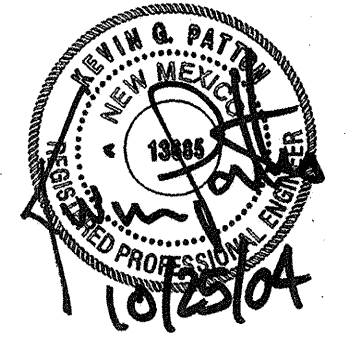

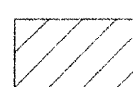 PROPOSED SPOT ELEVATION	● 5235.25
PROPOSED SPOT ELEVATION	◐ 5235.25
EXISTING CONTOUR	----
PHASE BOUNDARY	----
DIRECTION OF FLOW	→
EXISTING STORM DRAIN LINE	----
EXISTING STORM DRAIN INLET	
EXISTING WATER LINE	----
EXISTING SAS LINE	----
EXISTING SAS MANHOLE	(C)
PROPOSED WATER BLOCK	
RETAINING WALL	
GARDEN WALL	----
POND CONTOUR	----
PAD	
PROPOSED LANDSCAPE TRACT	
TURN BLOCK	TB

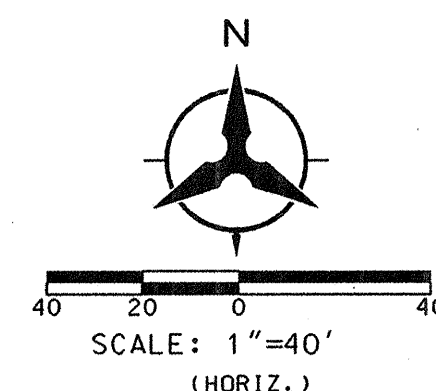

Bohannon ▲ Huston
 Courtyard | 7500 Jefferson St. NE Albuquerque, NM 87109
 ENGINEERING ▲ SPATIAL DATA ▲ ADVANCED TECHNOLOGY



CITY OF ALBUQUERQUE
PUBLIC WORKS DEPARTMENT
ENGINEERING DEVELOPMENT GROUP

TRACT 2 & 9 SUBDIVISION AT VENTANA RANCH WEST
OVERALL GRADING PLAN

DESIGN REVIEW COMMITTEE	CITY ENGINEER APPROVAL	LAST DESIGN UPDATE	MO./DAY/YR.	MO./DAY/YR.
N/A for Info				

CITY PROJECT NO. XXXXXX	ZONE MAP NO. B-8-Z	SHEET 5	OF 10
----------------------------	-----------------------	------------	----------


25-OCT-2004
P:\050125\cdp\canon\050125Grade04.dwg

BHI JOB NO. 050125

BHI JOB NO. 050125

PROPOSED SPOT ELEVATION ● 5235.25
PROPOSED SPOT ELEVATION ⬢ 5235.25
EXISTING CONTOUR
PHASE BOUNDARY
DIRECTION OF FLOW →
EXISTING STORM DRAIN LINE
EXISTING STORM DRAIN INLET
EXISTING WATER LINE
EXISTING GAS LINE
EXISTING GAS MANHOLE
PROPOSED WATER BLOCK
RETAINING WALL
GARDEN WALL
POND CONTOUR
PAD
PROPOSED LANDSCAPE TRACT
TURN BLOCK TB

NO WORK SHALL BE UNDERTAKEN
WITHIN EXISTING 50' GASLINE EASEMENT
WITHOUT FIRST CONTACTING PNM.

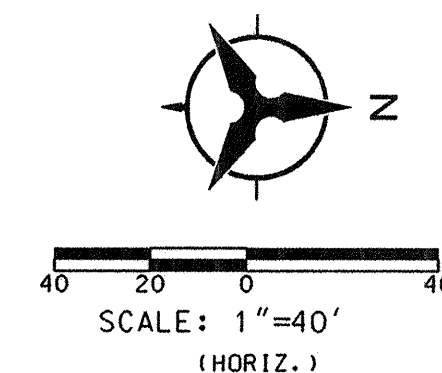

Courtyard | 7500 Jefferson St. NE Albuquerque, NM 87109-4335
ENGINEERING ▲ SPATIAL DATA ▲ ADVANCED TECHNOLOGIES



TRACT 2 & 9 SUBDIVISION AT VENTANA RANCH WEST
OVERALL GRADING PLAN

DESIGN REVIEW COMMITTEE	CITY ENGINEER APPROVAL
-------------------------	------------------------

N/A for Intro

CITY PROJECT NO. XXXXXX

ZONE MAP NO.
B-8-7

SHEET	6	OF
-------	---	----


SURVEY INFORMATION		BENCH MARKS		AS-BUILT INFORMATION	
FIELD NOTES					
NO.	BY	DATE		CONTRACTOR	
			ACS BRASS TABLET STAMPED "2-B10 1980"	WORK	
			GEOGRAPHIC POSITION (NAD 1927)	NOTED BY	
			N.M. STATE PLANE COORDINATES	ACCEPTANCE BY	
			(CENTRAL ZONE)	FIELD	DATE
			X = 357.543.73 Y = 1.527.976.48	ORIENTATION BY	DATE
			GROUND-TO-GRID FACTOR = .99966354	CORRECTED BY	DATE
			DELTA ALPHA = -0°16'30"	MICRO-FILM INFORMATION	
			NGVD 1929 ELEVATION = 5429.35	RECORDED BY	DATE
				NO.	

[illegible]



LEGEND

PROPOSED SPOT ELEVATION	• 5235.25
PROPOSED SPOT ELEVATION	○ 5235.25
EXISTING CONTOUR	---
PHASE BOUNDARY	---
DIRECTION OF FLOW	→
EXISTING STORM DRAIN LINE	---
EXISTING STORM DRAIN INLET	⊥
EXISTING WATER LINE	---
EXISTING SAS LINE	---
EXISTING SAS MANHOLE	⊙
PROPOSED WATER BLOCK	⊥
RETAINING WALL	---
GARDEN WALL	---
POND CONTOUR	---
PAD	□
PROPOSED LANDSCAPE TRACT	▨
TURN BLOCK	TB

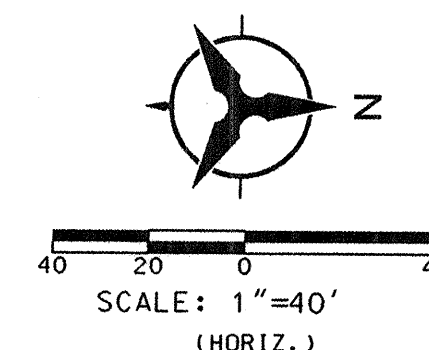

Bohannon & Huston

Courtyard | 7500 Jefferson St. NE Albuquerque, NM 87109-4335
ENGINEERING • SPATIAL DATA • ADVANCED TECHNOLOGIES

CITY OF ALBUQUERQUE
PUBLIC WORKS DEPARTMENT
ENGINEERING DEVELOPMENT GROUP

TRACT 2 & 9 SUBDIVISION AT VENTANA RANCH WEST
OVERALL GRADING PLAN


DESIGN REVIEW COMMITTEE	CITY ENGINEER APPROVAL	MO./DAY/YR.	MO./DAY/YR.
N/A for Info		LAST DESIGN UPDATE	
CITY PROJECT NO.	ZONE MAP NO.	SHEET	OF
XXXXXX	B-8-Z	7	10

BHI JOB NO. 050125


SURVEY INFORMATION		BENCH MARKS		AS-BUILT INFORMATION	
NO.	BY	DATE	DATE	CONTRACTOR	DATE
				STAKED BY	DATE
				INSPECTOR'S	DATE
				FIELD	DATE
				VERIFICATION BY	DATE
				CORRECTED BY	DATE
				MICRO-FILM INFORMATION	
				DELTA ALPHA	DATE
				NOV 1929 ELEVATION = 5429.35	NO.

ENGINEER'S SEAL		REMARKS	
		BY	DATE
		REVISIONS	DATE
		DESIGN	DATE
		JPP	DATE
		ARR	DATE
		KGP	DATE


16 of 37

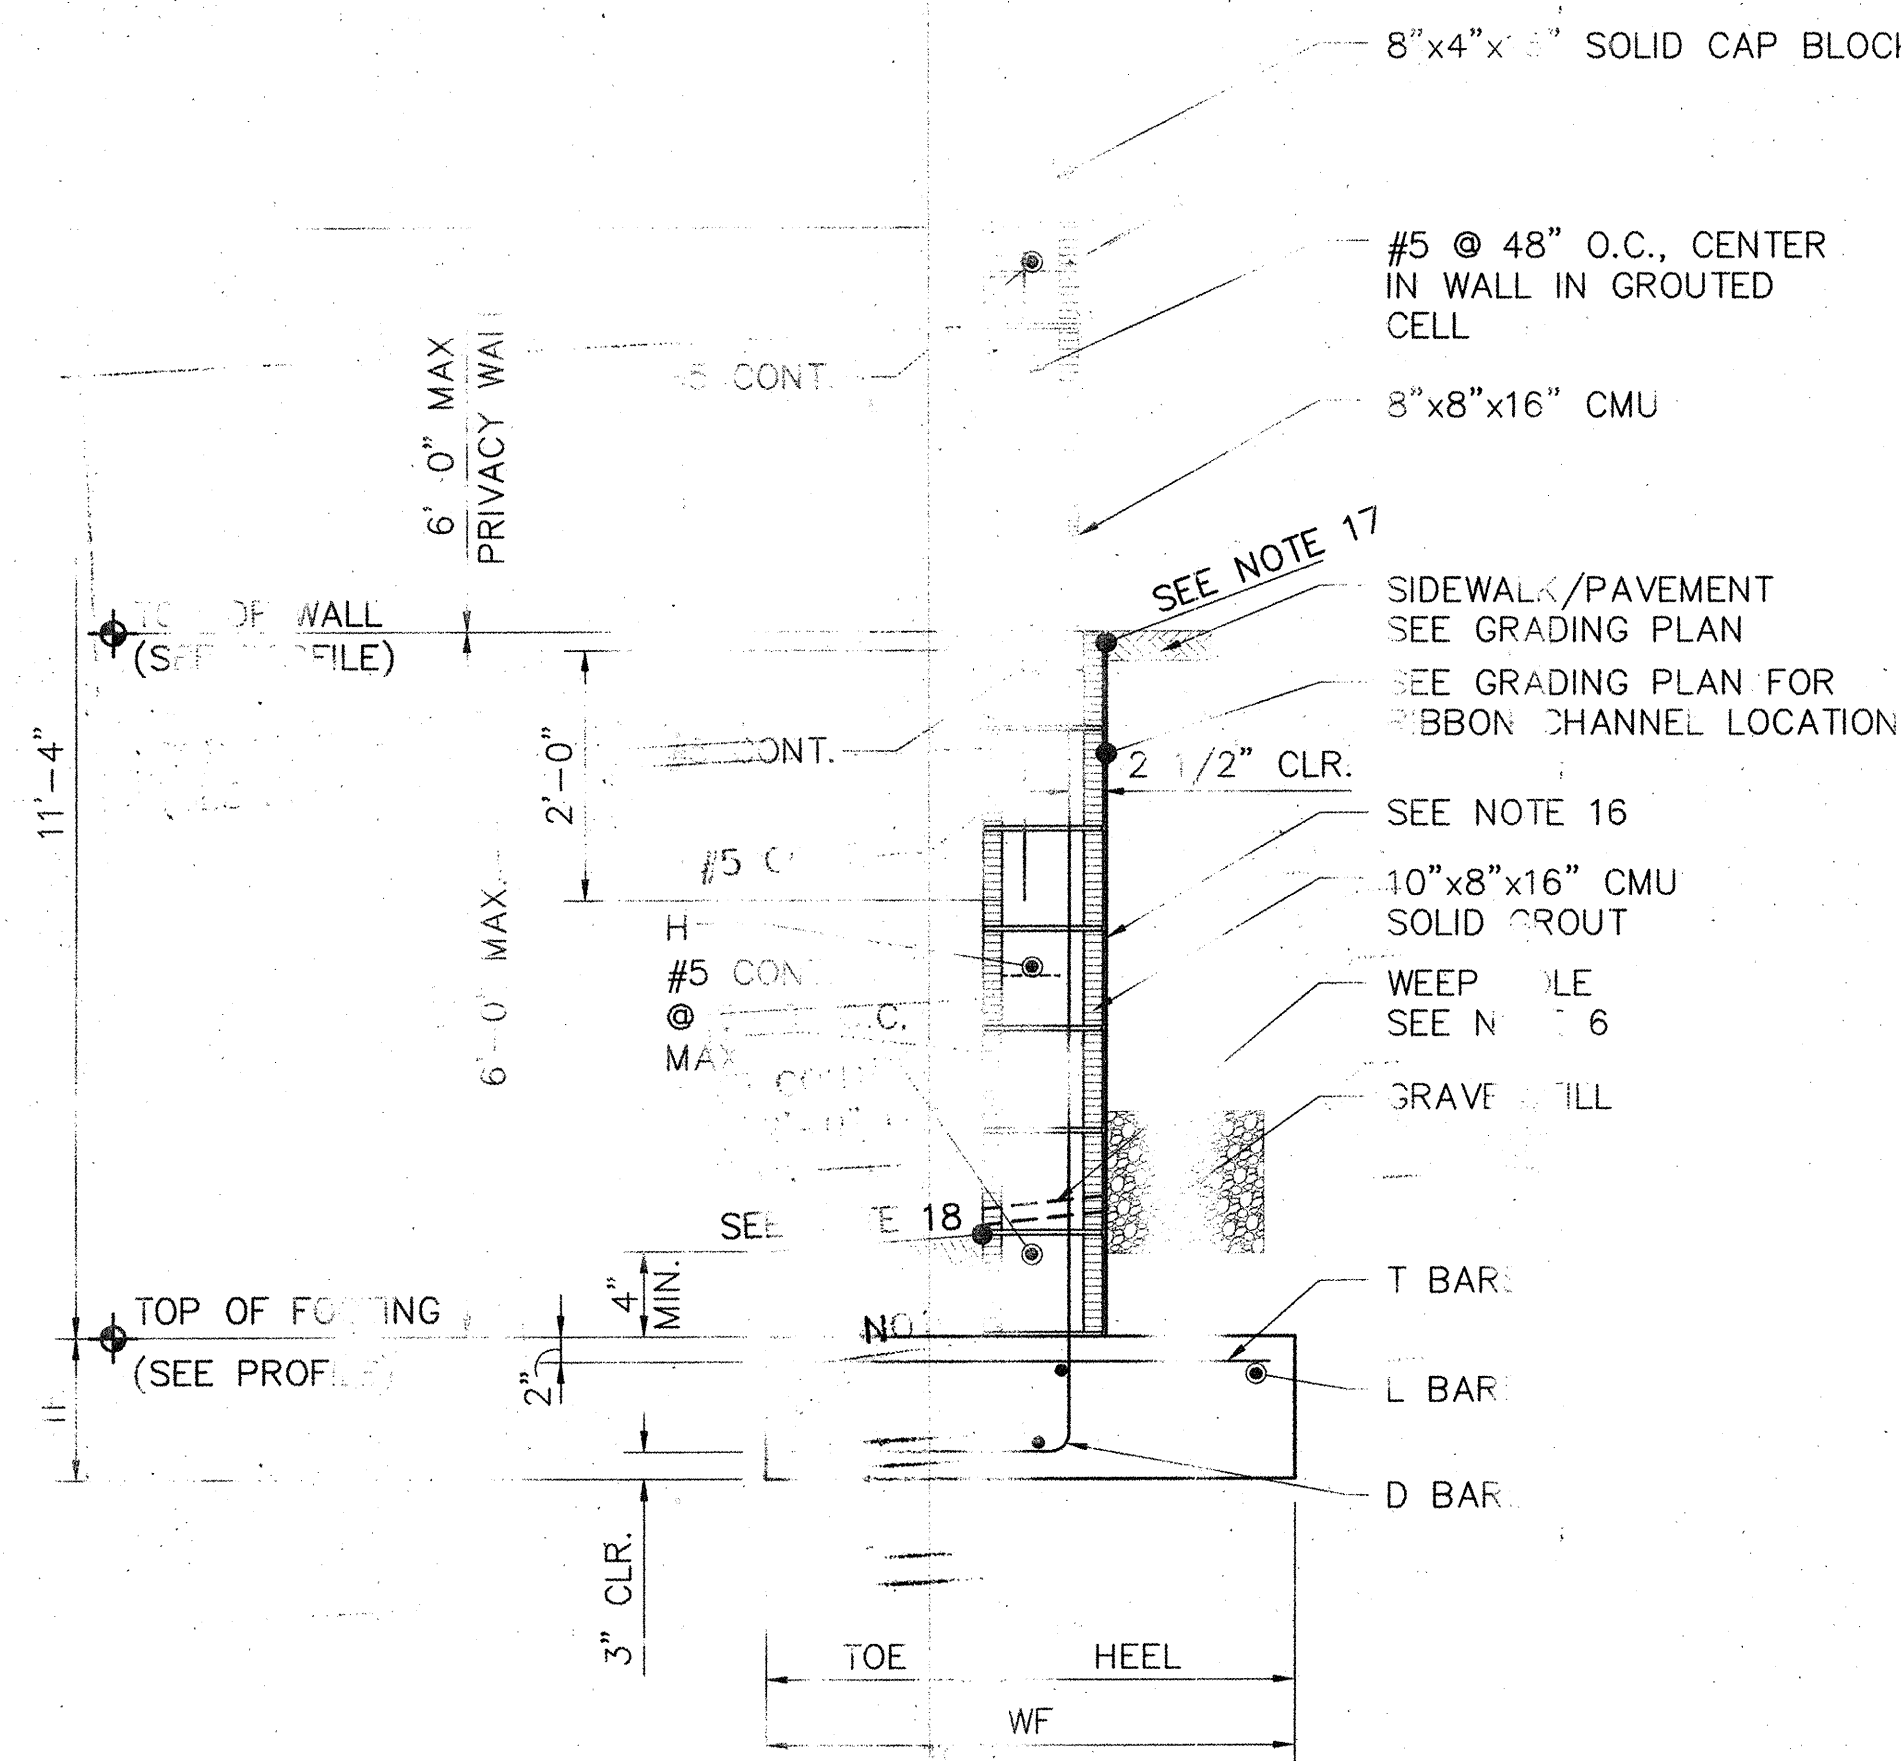

TYPE 5 RETAINING WALL
NO SCALE
TYPICAL RETAINING WALL 6'-0" MAX HEIGHT W/ PRIVACY WALL

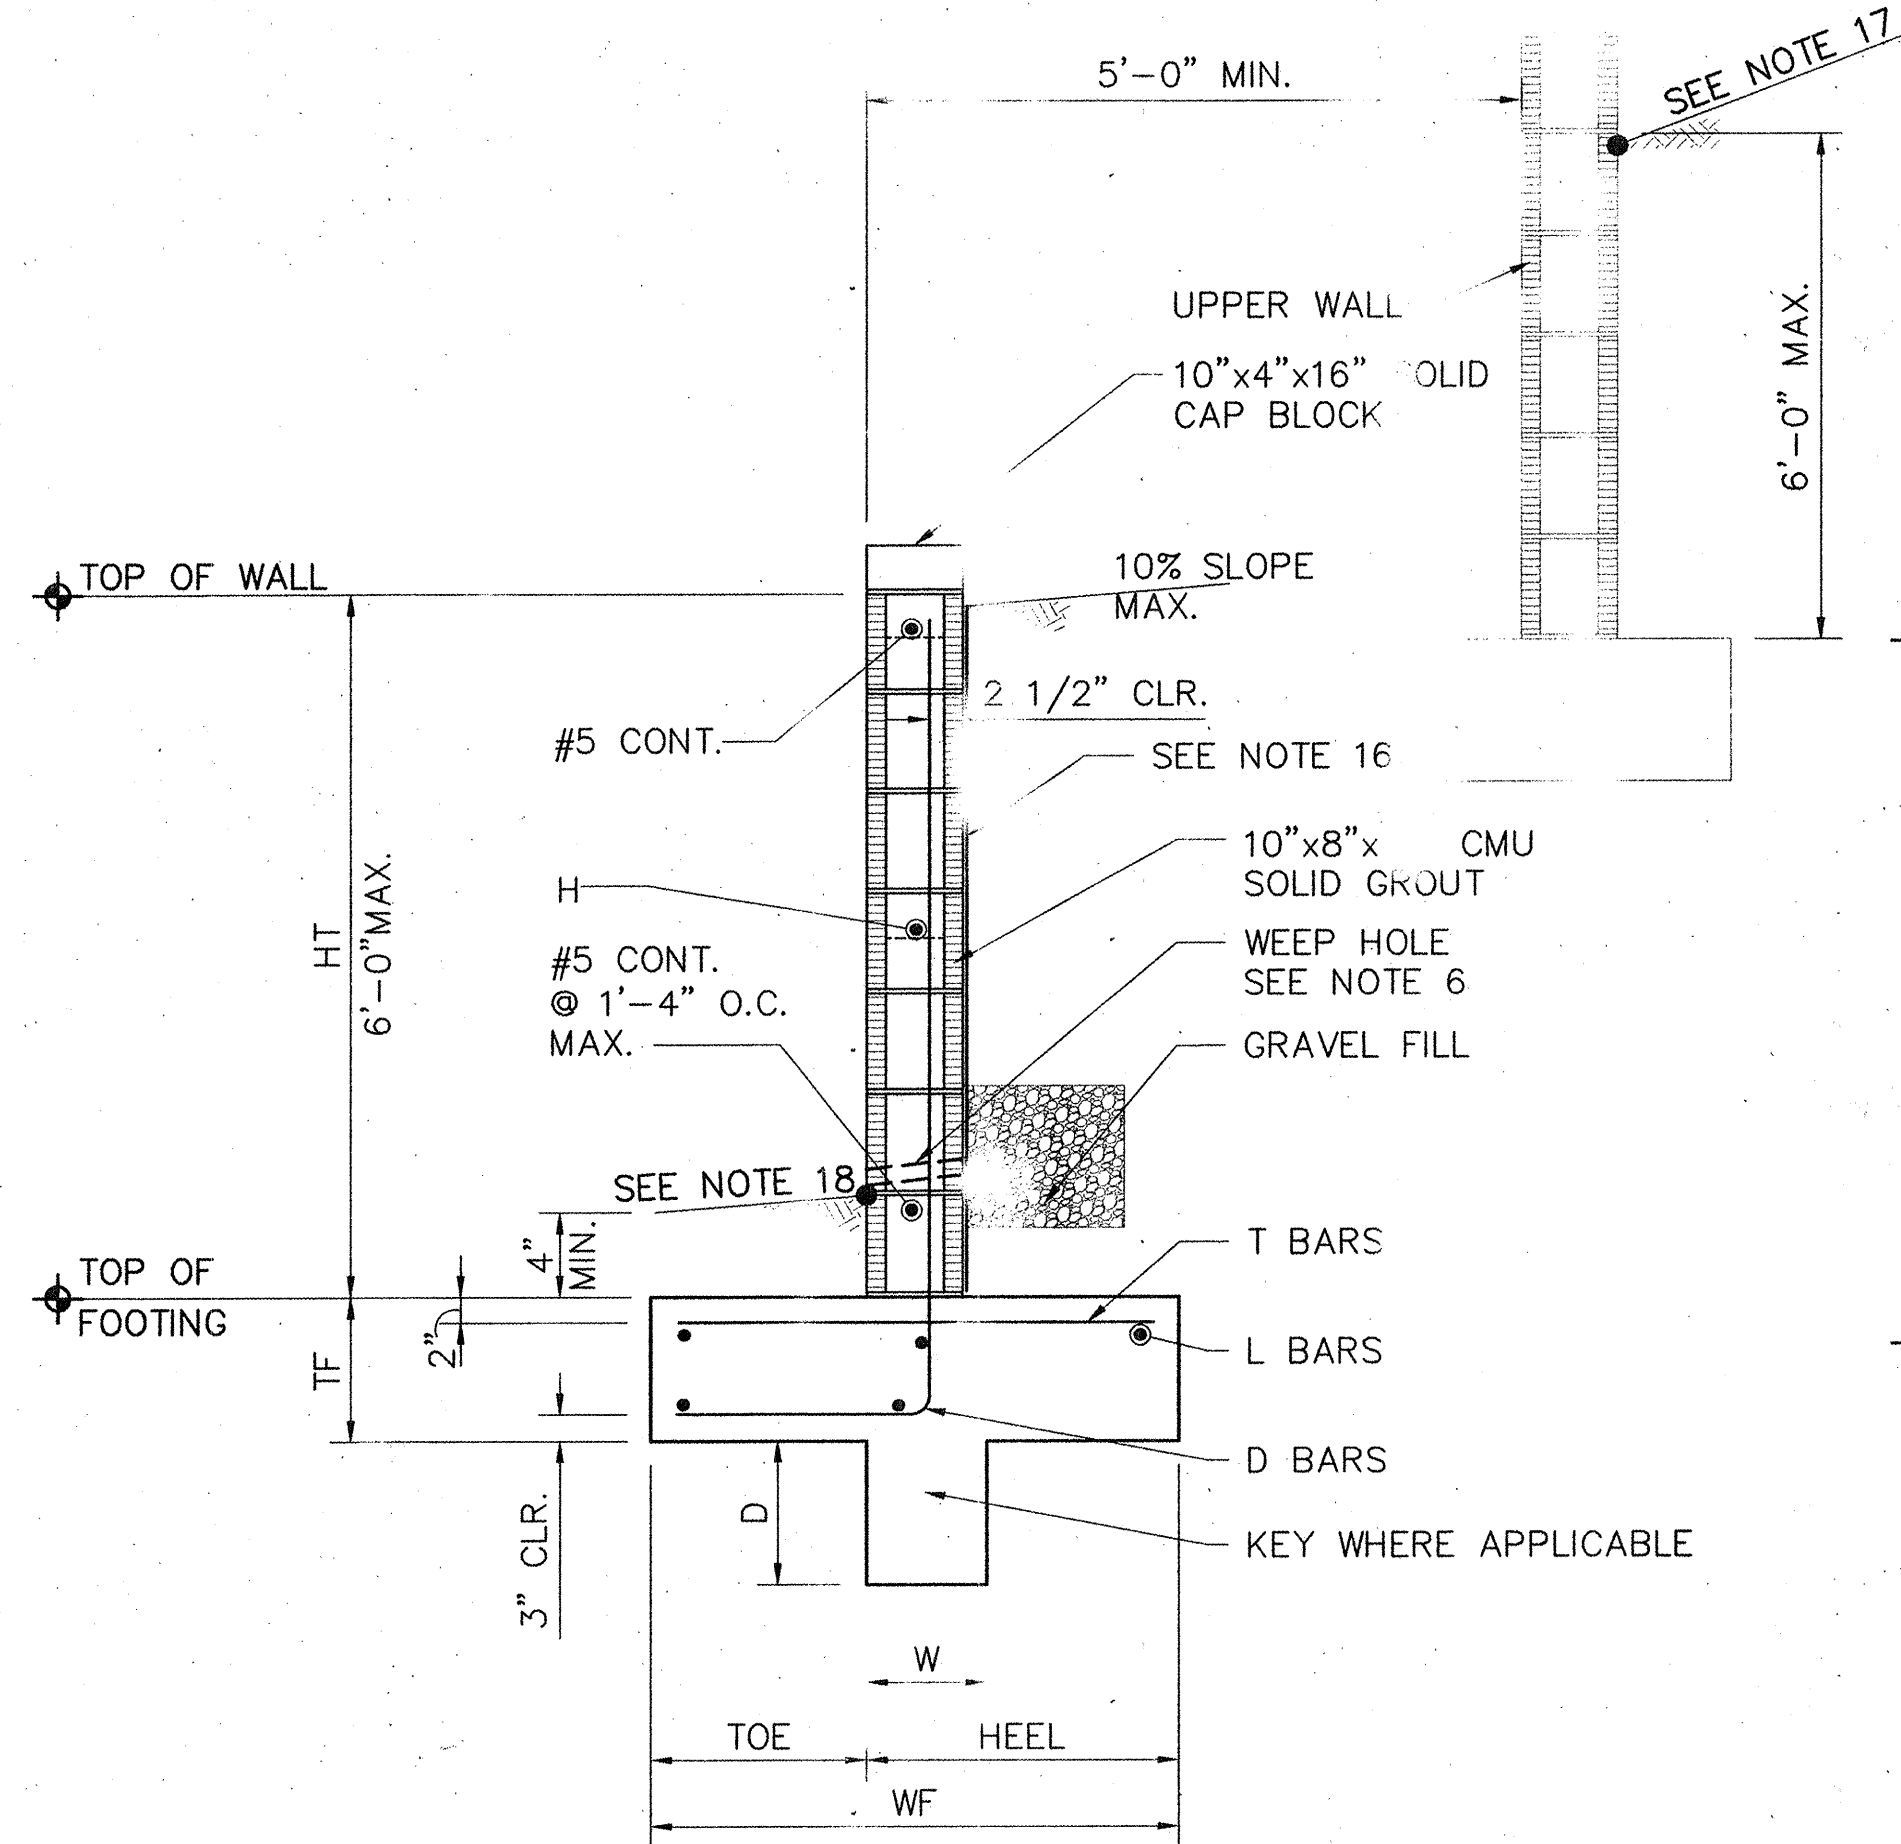

TYPE 6 RETAINING WALL
NO SCALE
TYPICAL RETAINING WALL 6'-0" MAX. HT

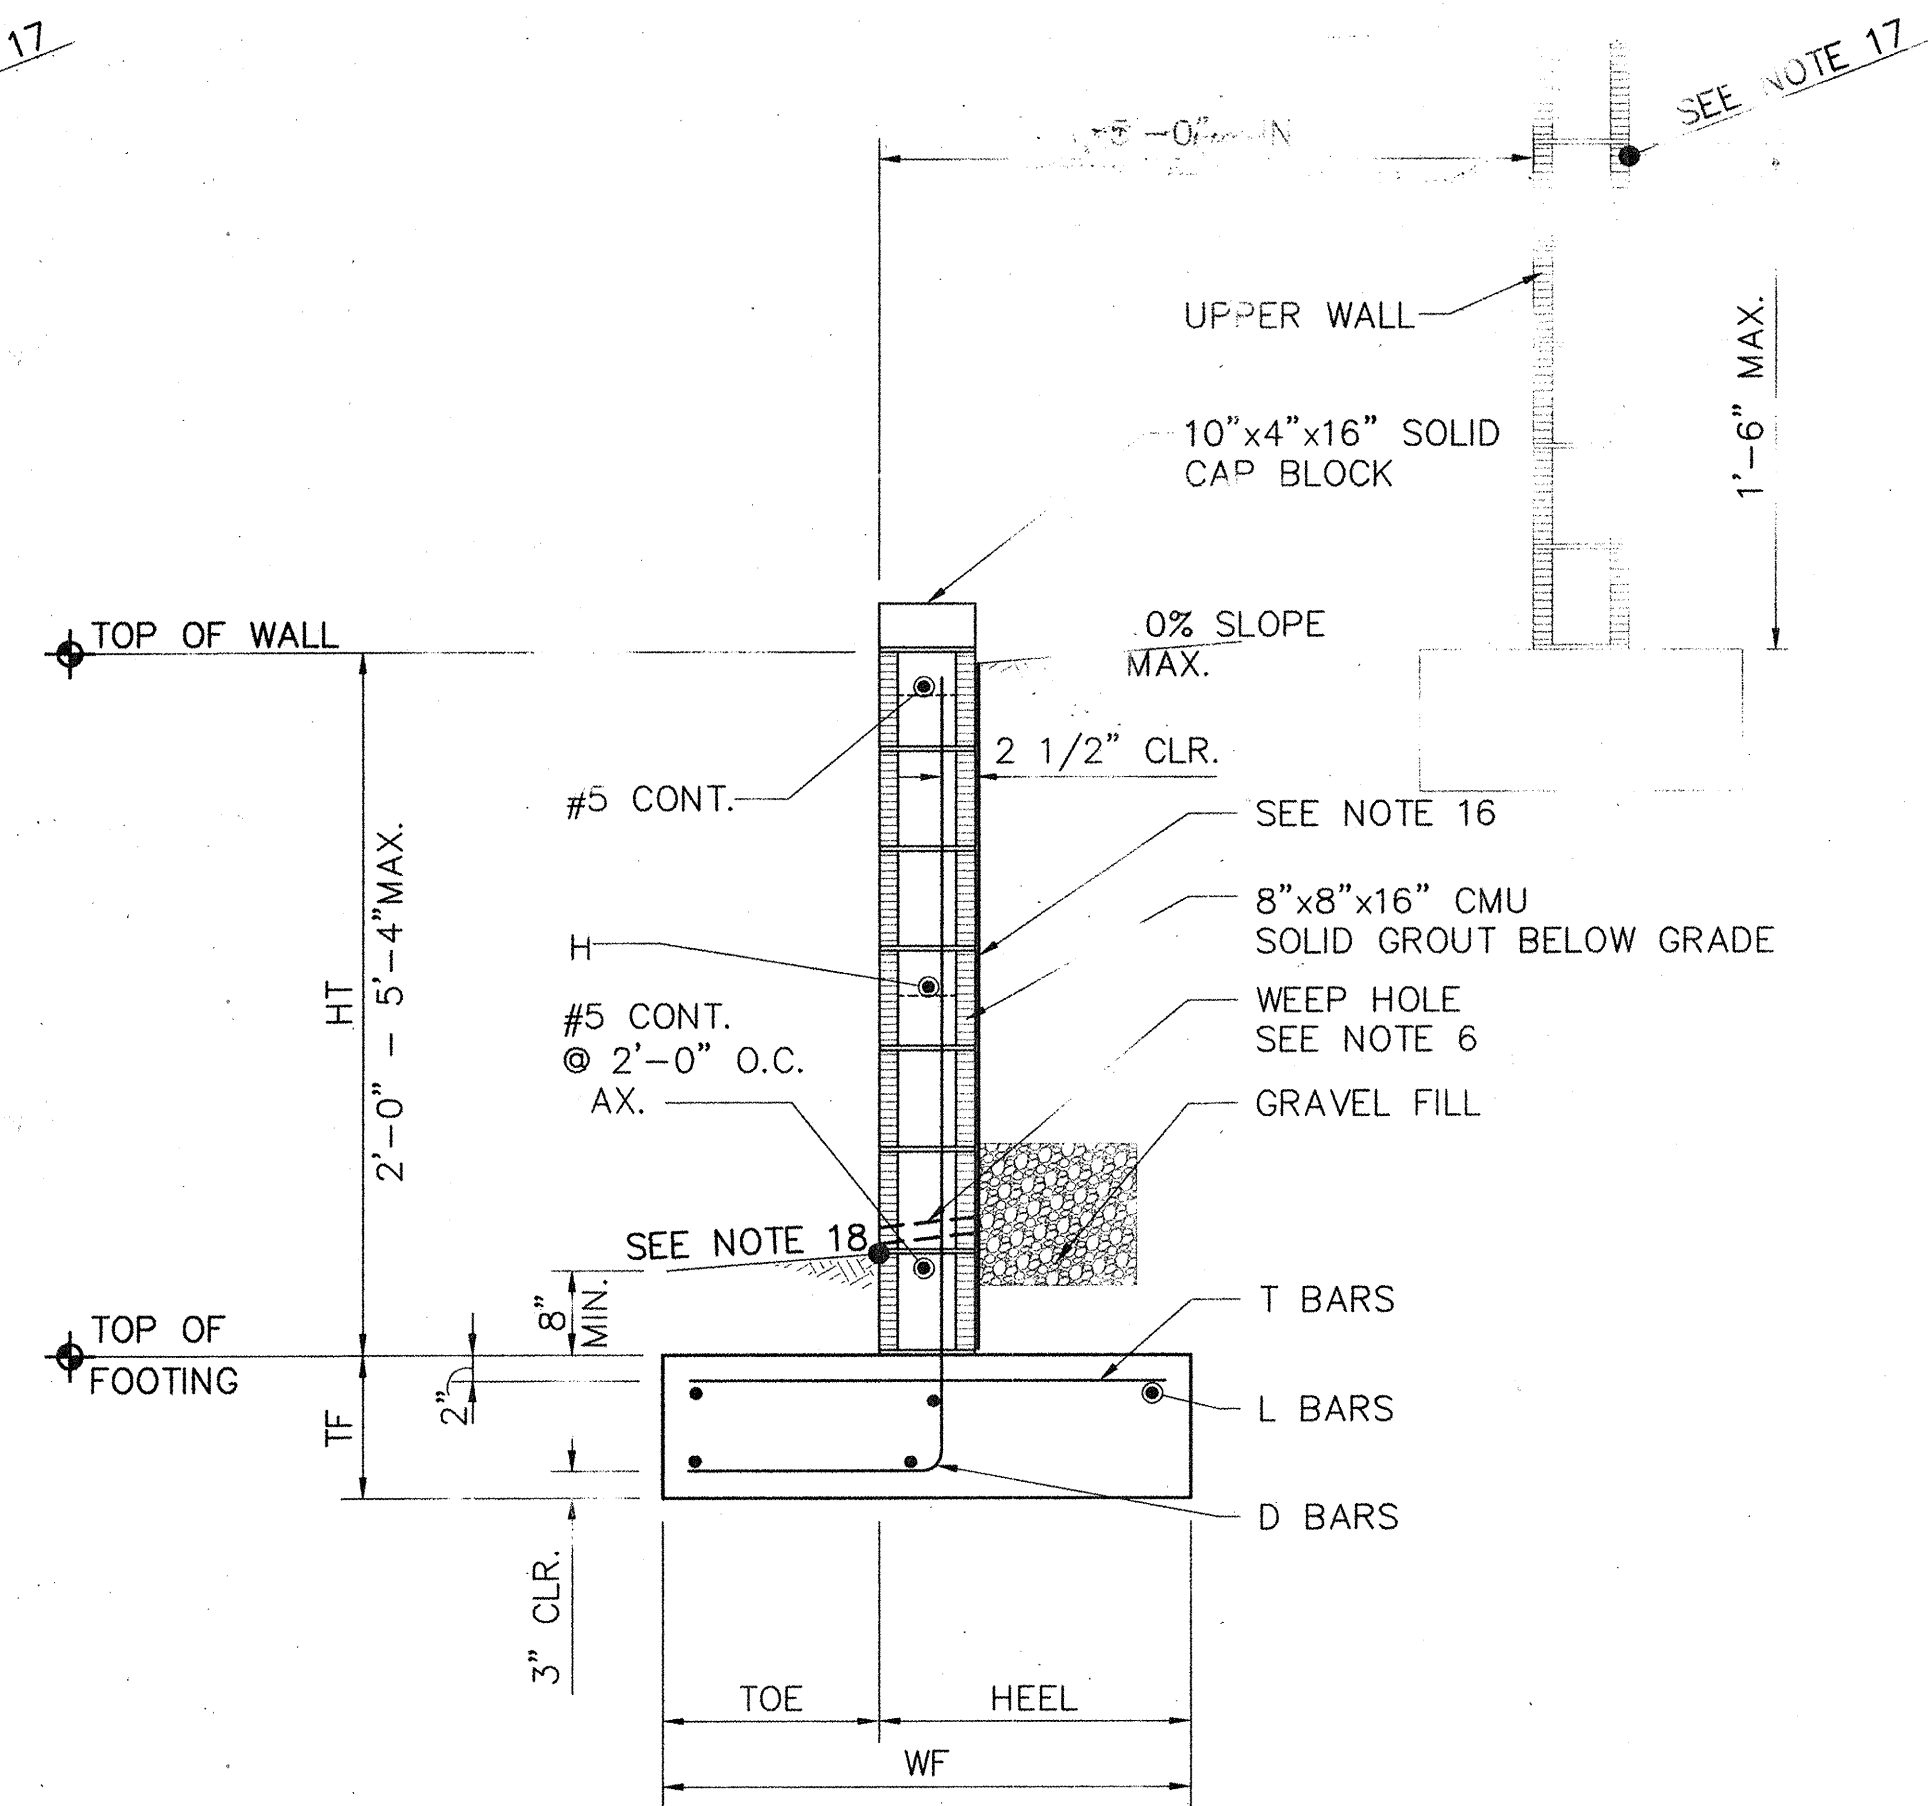

TYPE 7, 8, AND 9 RETAINING WALLS
NO SCALE
TYPICAL RETAINING WALL 6'-0" MAX. HT

REINFORCED CONCRETE TENSION LAP SPLICES

BAR	LENGTH (IN)
4	18
5	22
	26
	44
8	54

NOTE: SEE RETAINING WALL DETAILS, SHEET ____ FOR RETAINING WALL NOTES.

DIMENSIONS

WALL TYPE	HT	TF (IN)	TOE (IN)	HEEL (IN)	WF (IN)	KEY	
						W	D
1	2'-0"	12	10	20	30	-	-
2	4'-0"	12	13	21	34	-	-
3	2'-0"	12	4	14	18	-	-
4	4'-0"	12	12	28	40	-	-
5	6'-0"	14	18	30	48	-	-
6	6'-0"	14	18	30	48	10	12
7	2'-0"	12	4	14	18	-	-
8	4'-0"	12	9	24	33	-	-
9	5'-4"	14	18	30	48	-	-

REINFORCING

WALL TYPE	D		L		T		H	
	SIZE	SPACE	SIZE	NO. REQ'D	SIZE	SPACE	SIZE	SPACE
1	5	48	4	4	4	18	5	24
2	5	48	4	4	4	18	5	24
3	5	48	4	2	4	18	5	24
4	5	24	4	5	4	18	5	24
5	5	24	5	5	4	16	5	16
6	5	24	5	5	4	16	5	16
7	5	48	4	2	4	18	5	24
8	5	48	4	5	4	18	5	24
9	5	24	5	5	4	16	5	24

Bohannon & Hu
Courtney One 7500 JEFFERSON NE ALBUQUERQUE NEW MEXICO 87109
ENGINEERS PLANNERS PHOTOGRAMMETRISTS SURVEYORS SOFTWARE DEVELOPERS

CITY OF ALBUQUERQUE
PUBLIC WORKS DEPARTMENT
ENGINEERING DEVELOPMENT GROUP

WESTERN RIDGE
AT VENTANA RANCH WEST
RETAINING WALL DETAILS

Design Review Committee: City Engineer Approval: Mo./Day/Yr. Mo./Day/Yr.

N/A FOR INFO.

City Project No. 13-8-2 10-10

ENGINEER'S SEAL

AS-BUILT INFORMATION

BENCH MARKS

SURVEY INFORMATION

FIELD NO. 1

NO. 1

DATE

BY

REMARKS

REVISIONS

DESIGN

DATE: 11/10/04

DATE: 11/10/04



DATE: 11/10/04

[illegible]

TRAIL Curve Table				
ID	ARC	RADIUS	DELTA	TANGENT
TC5	23.99'	50.00'	27° 29' 19"	12.23'
TC6	41.67'	50.00'	47° 45' 21"	22.13'
TC7	34.60'	50.00'	39° 38' 37"	18.02'

TRAIL Point Table			
●	EASTING	NORTHING	ELEVATION
10	349987.97	1527760.70	5549.
11	349994.31	1527751.66	5549.
12	350002.95	1527729.53	5549.
13	350024.07	1527694.99	5550.
14	350042.72	1527670.66	5550.
15	350045.40	1527661.56	5549.

●	STATION	OFFSET	ELEVATION
1	22+89.22	41.54' LT.	5551.1
2	22+89.00	57.30' LT.	5551.1
3	22+94.37	77.36' LT.	5551.1
4	23+09.82	92.07' LT.	5550.9
5	23+29.89	97.41' LT.	5550.6
6	23+49.88	92.02' LT.	5550.4
7	23+63.09	77.44' LT.	5550.2
8	23+68.03	57.57' LT.	5550.0
9	23+68.52	39.46' LT.	5549.8

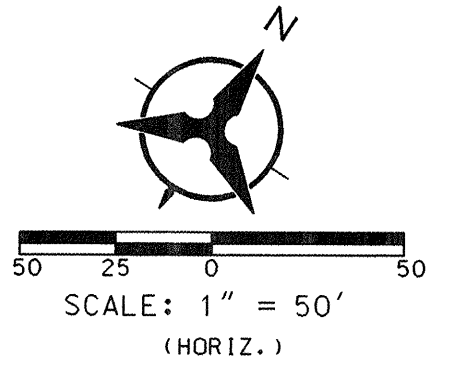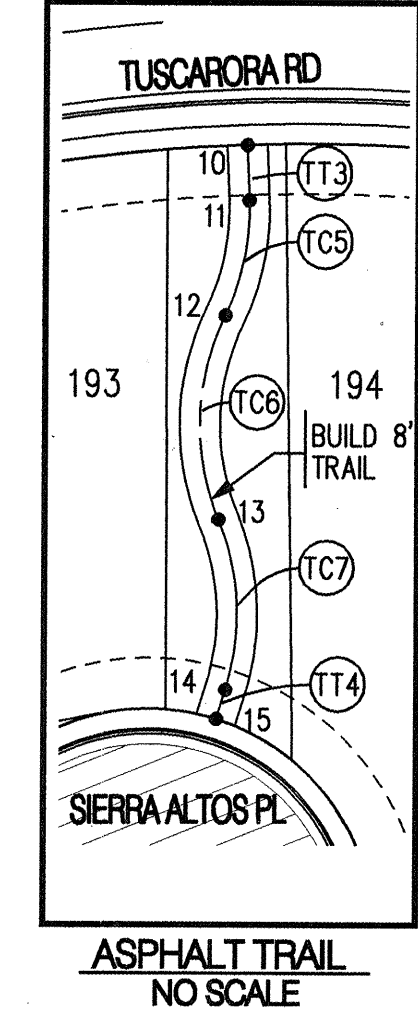

NOTES

1. THE CONTRACTOR SHALL FIELD VERIFY ALL EXISTING UTILITY LOCATIONS AND NOTIFY THE ENGINEER IMMEDIATELY OF ANY DISCREPANCIES.
2. ALL CURB RETURN RADII SHALL BE 25' UNLESS OTHERWISE SPECIFIED.
3. ALL CURVE DATA AND DIMENSIONS REFER TO FACE OF CURB UNLESS OTHERWISE SPECIFIED.
4. GRADE ELEVATIONS, WHERE NOTED, ARE ALONG FLOWLINE OF STANDARD CURB UNLESS OTHERWISE SPECIFIED.
5. CONTRACTOR IS RESPONSIBLE FOR REPAIR AND/OR REPLACEMENT OF ALL UTILITY CONDUITS AND EXISTING LINES.
6. ANY ADDITIONAL GRADING REQUIRED TO MATCH PROPOSED STREET GRADES SHALL BE INCIDENTAL TO PAVING ITEMS.
7. CONTRACTOR SHALL PROVIDE THE INSPECTORS, (CITY AND PRIVATE) WITH THE PROPOSED HYDROSTATIC TESTING PLAN. THE PLAN MUST BE APPROVED BEFORE TESTING OPERATIONS BEGIN.
8. CONTRACTOR SHALL PARK EQUIPMENT AND VEHICLES AS NOT TO INTERFERE WITH NORMAL ACTIVITIES OF RESIDENTS OR OTHER CONTRACTORS ON SITE.
9. ANY DAMAGE TO THE EXISTING FACILITIES (CURB & GUTTER, PAVEMENT, CONDUITS, LANDSCAPING, UTILITY LINES, ETC.) DURING CONSTRUCTION SHALL BE REPLACED AT THE CONTRACTORS' EXPENSE.
10. WHEELCHAIR RAMPS SHALL BE CONSTRUCTED PRIOR TO ACCEPTANCE OF CURB & GUTTER.
11. ALL EXCAVATION, TRENCHING AND SHORING ACTIVITIES MUST BE CARRIED-OUT IN ACCORDANCE WITH OSHA 29 CFR 1926.650 SUBPART P.


KEYED NOTES

- 1 INSTALL 6' CONCRETE VALLEY GUTTER
AS PER STD. DWG. 2420
- 2 STD. CURB & GUTTER AS PER STD. DWG. 2415 A
- 3 MEDIAN CURB & GUTTER AS PER STD. DWG. 2415 B
- 4 ROLL CURB & GUTTER AS PER STD. DWG. 2415 A
- 5 DEFERRED 4' SIDEWALK
- 6 BUILD 4' SIDEWALK AS PER STD. DWG. 2430
- 7 BUILD 8' ASPHALT TRAIL AS PER DETAIL SHEET 18
- 8 BUILD WHEELCHAIR RAMP AS PER DETAIL "A" SHEET 18
- 9 BUILD WHEELCHAIR RAMP AS PER DETAIL "B" SHEET 18
- 10 BUILD WHEELCHAIR RAMP AS PER DETAIL "C" SHEET 18
- 11 INSTALL 12' CONCRETE VALLEY GUTTER
AS PER STD. DWG. 2422
- 12 BUILD 4" TEXTURED MEDIAN PAVEMENT
FROM MEDIAN NOSE TO 10' FROM NOSE (BAJA RED)
MEDIAN NOSES SHALL BE PAINTED YELLOW
TO APPROX. 6' BEHIND PC/PT
PER COA STD. DWG. 2408


SURVEYORS CERTIFICATION

I, Russ P. Hugg, New Mexico Professional Surveyor Number 9750, Hereby Certify that the as-built information shown hereon is the result of an actual field survey performed by me or under my direct supervision and that the same is true and correct to the best of my knowledge and belief.

Russ P. Hugg
NMPs No. 9750
1-27-20

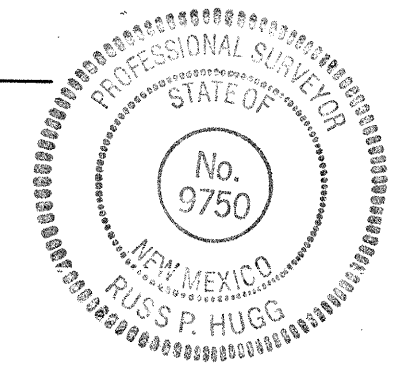**Bohannon ▲ Huston inc.**

Courtyard | 7500 Jefferson St. NE Albuquerque, NM 87109-4335
ENGINEERING ▲ SPATIAL DATA ▲ ADVANCED TECHNOLOGIES

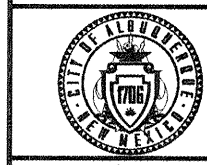


 **CITY OF ALBUQUERQUE**
PUBLIC WORKS DEPARTMENT
ENGINEERING DEVELOPMENT GROUP

WESTERN RIDGE (UNIT 2) SUBDIVISION AT VENTANA RANCH WEST
PAVING PLAN & PROFILE
ALIGNMENT A 20+00 - 27+00

[illegible]

CITY PROJECT NO.	749486	ZONE MAP NO.	B-8-Z	SHEET	19	OF	37
------------------	--------	--------------	-------	-------	----	----	----

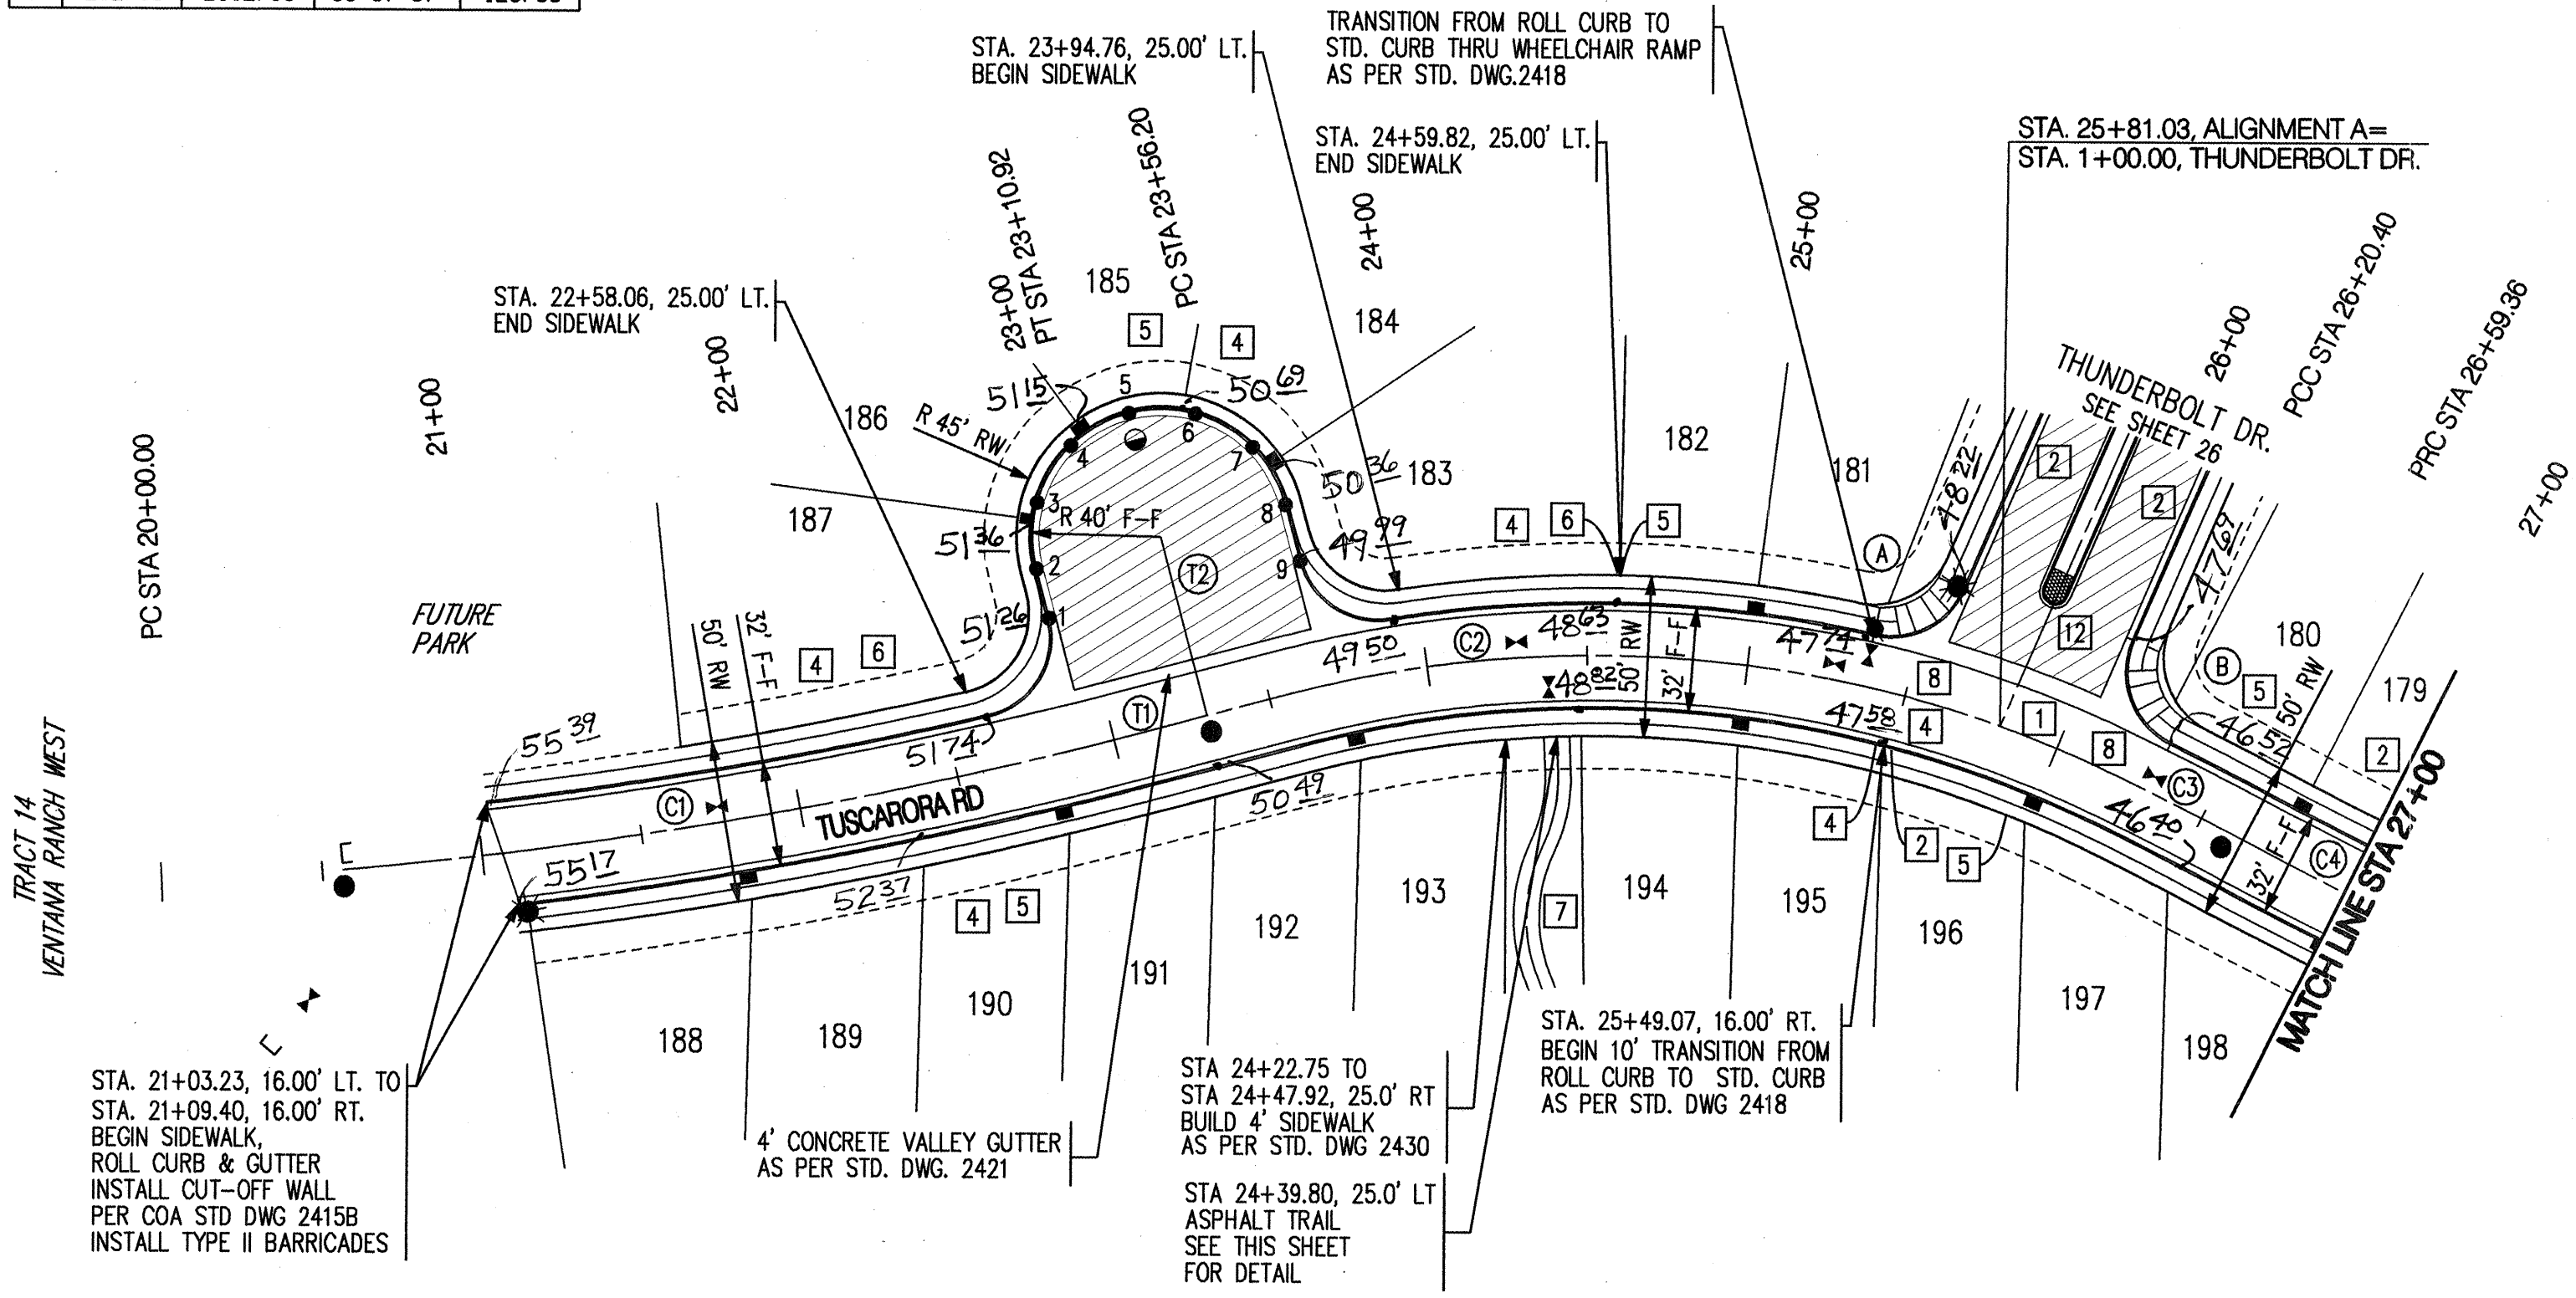

(A) FLOWLINE DATA FOR CURB RETURN


PC	47.96	D = 79°15'29"
1	47.84	R = 25.00'
2	47.73	T = 20.70'
3	47.61	L = 34.58'
PT	47.50	C = 31.89'
PI	47.26	


PC STA. 25+58.64, 37.07' LT.
PT STA. 25+36.28, 16.00' LT.
PI STA. 25+56.04, 16.00' LT.
RAD STA. 25+36.28, 41.00' LT.

(B) FLOWLINE DATA FOR CURB RETURN

PC	46.34	$D = 87^{\circ}18'45''$ $R = 25.00'$ $T = 23.85'$ $L = 38.10'$ $C = 34.52'$
1	46.62	
2	46.90	
3	47.19	
PT	47.47	
PI	46.62	


PC STA. 26+31.14, 16.00' LT.
PT STA. 26+07.90, 40.25' LT.
PI STA. 26+07.99, 16.00' LT.
RAD STA. 26+31.14, 41.00' LT.

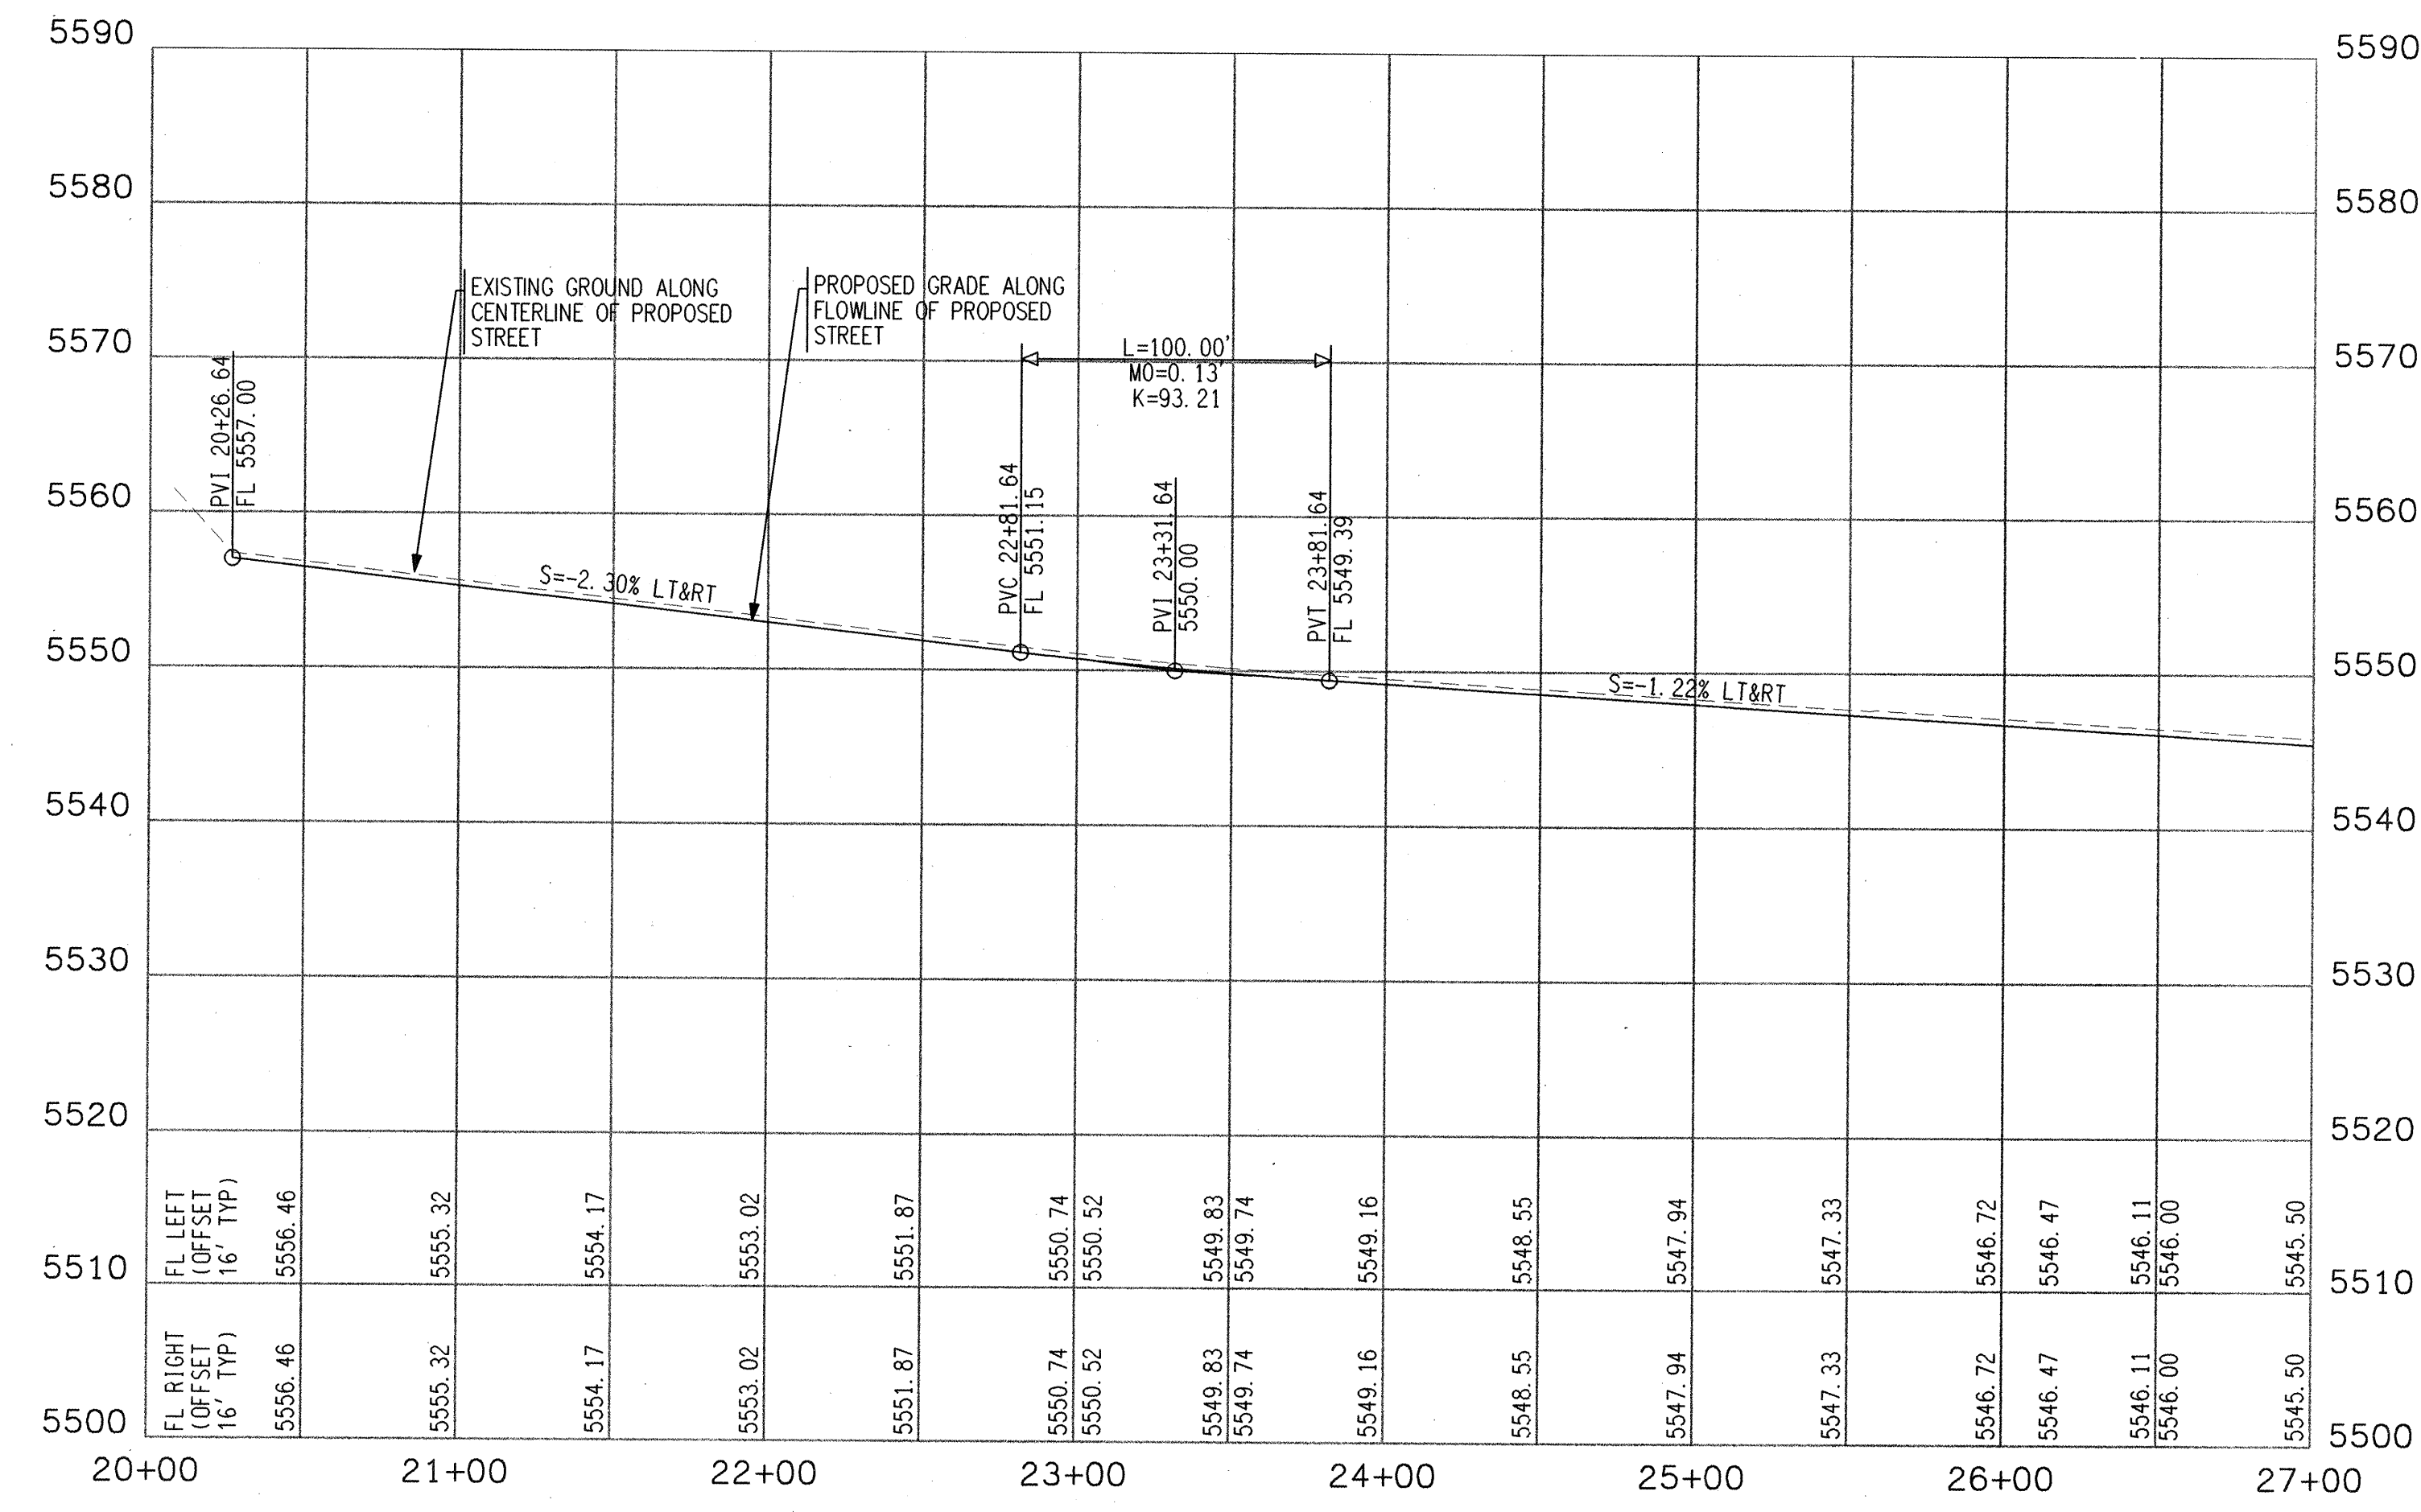

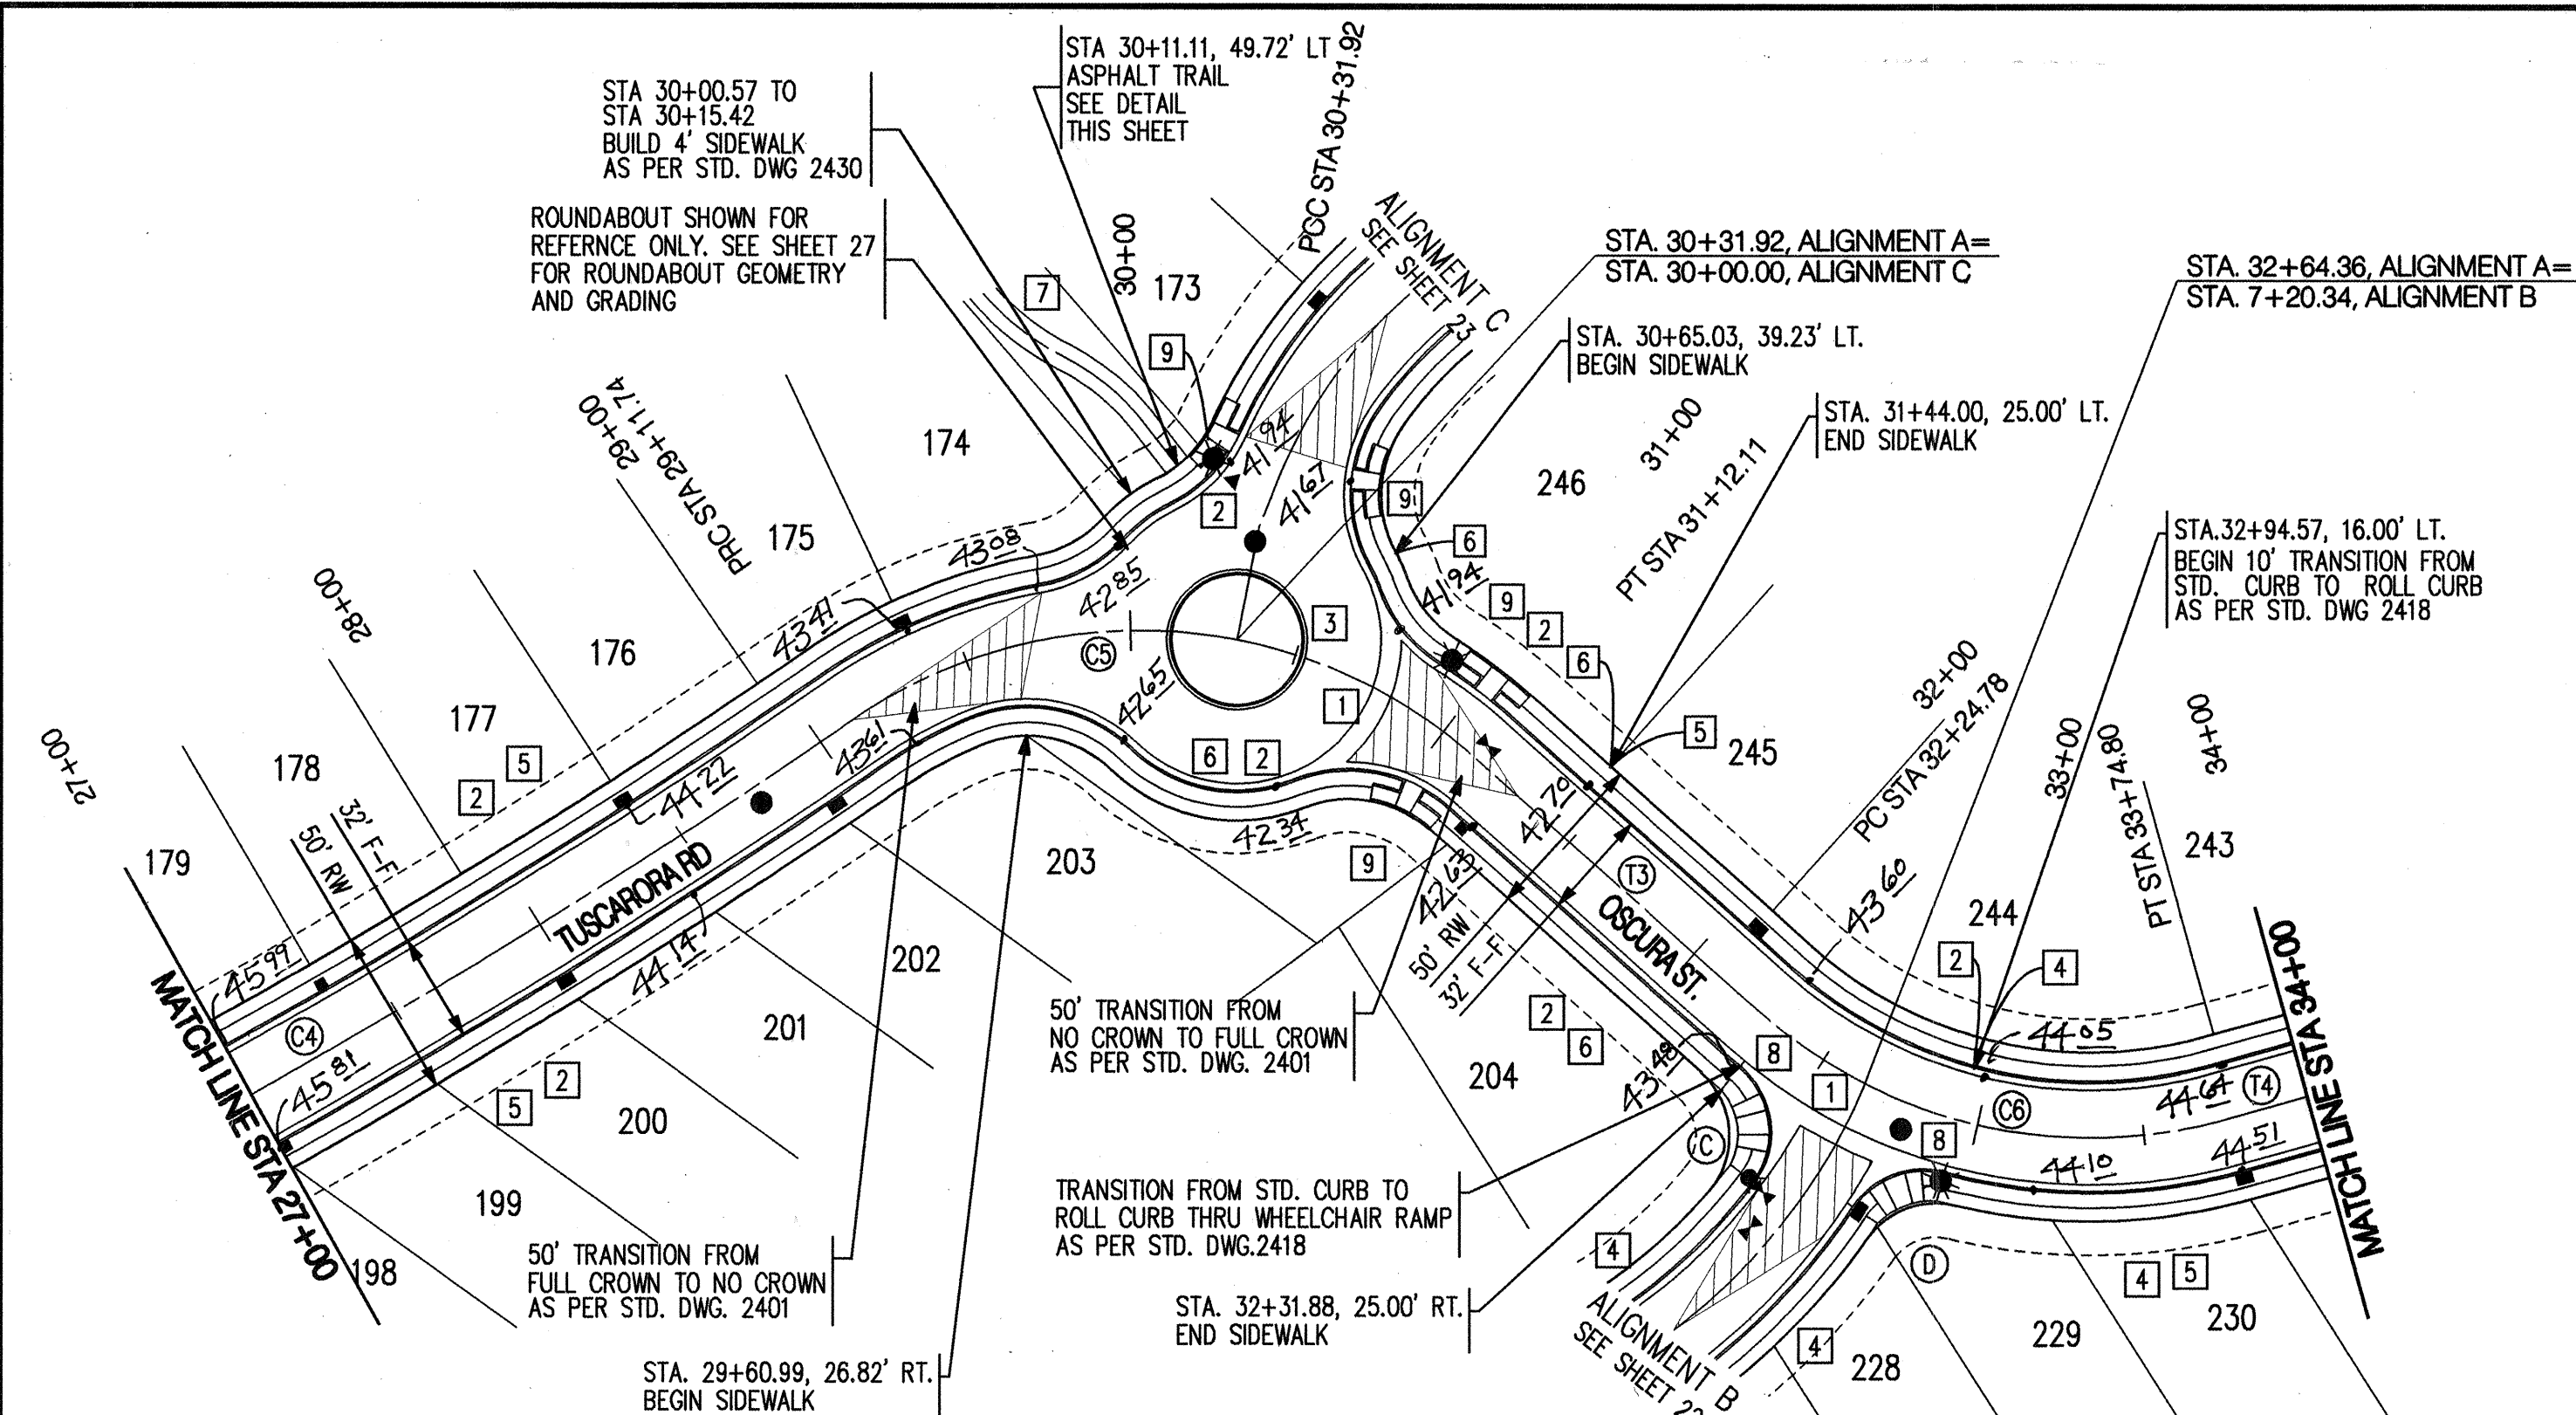

NOTE:
SEE SHEET 22 FOR
QUARTER POINT FLOWLINE
ELEVATION TABLES FOR C & D

ALIGNMENT A 27+00 - 34+00

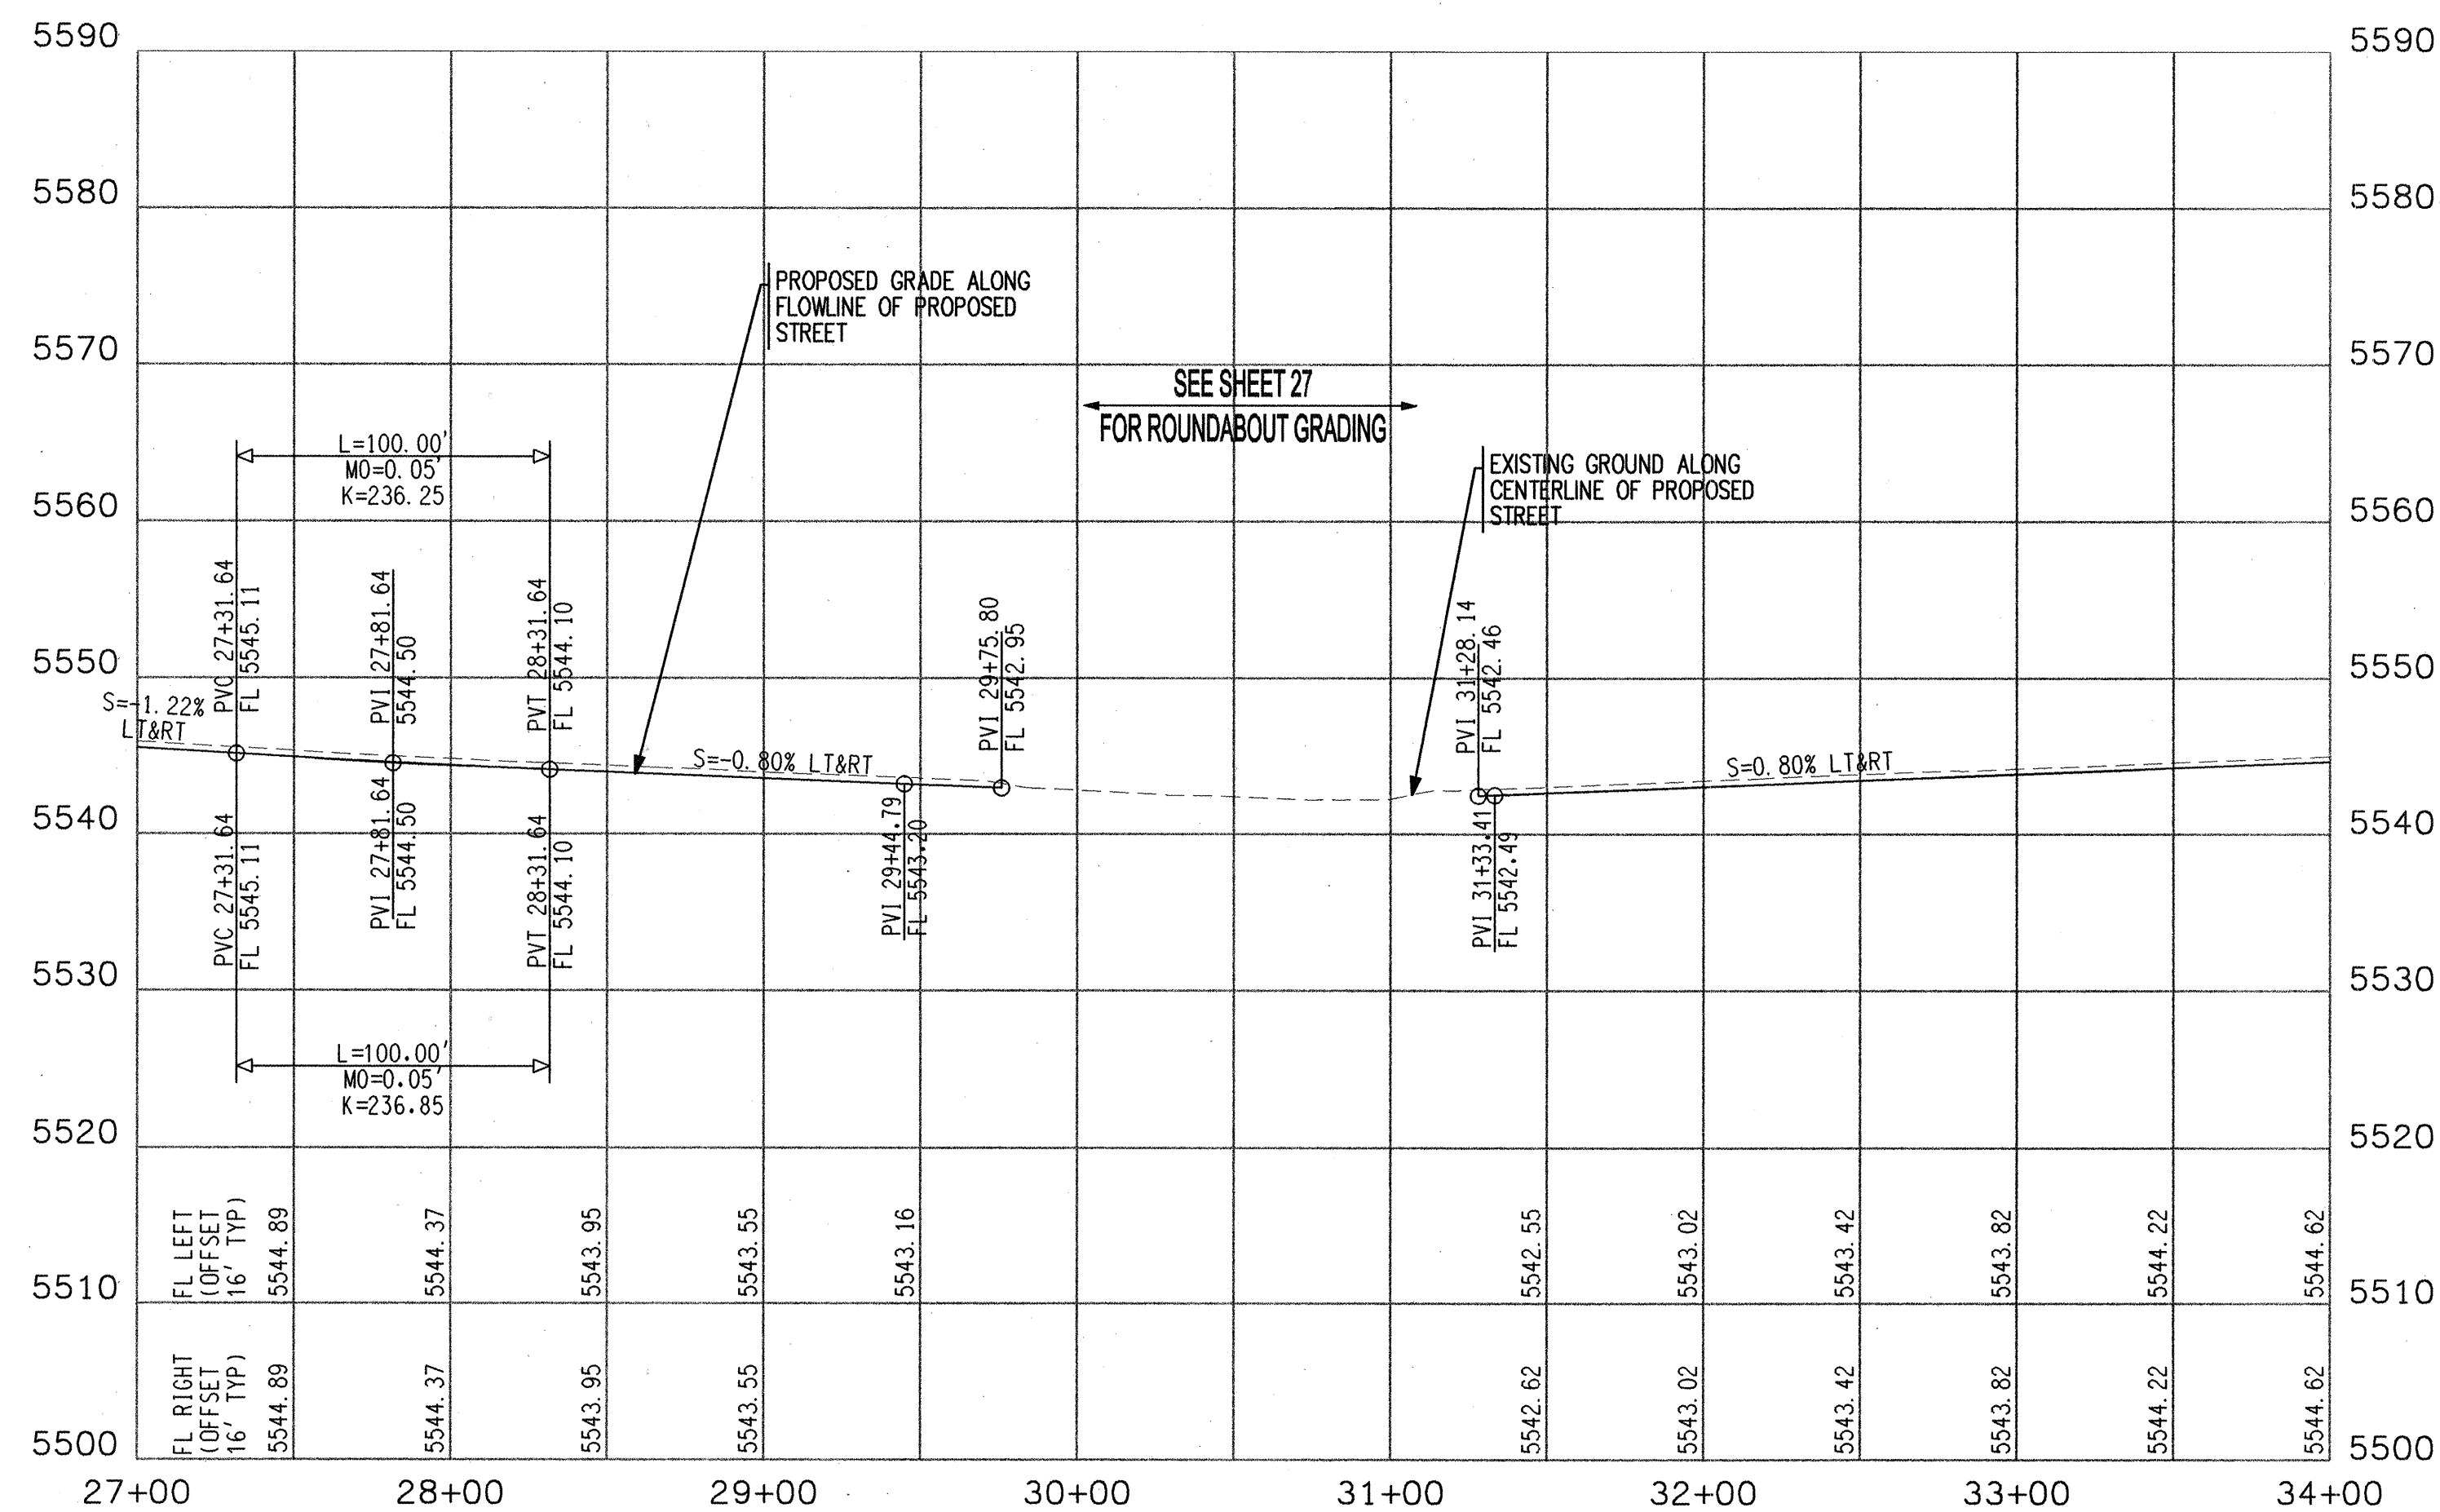


CL Tangent Table		
ID	BEARING	LENGTH
T3	N25° 27' 45" W	112.67'
T4	N82° 45' 49" W	132.80'

ID	BEARING	LENGTH
TT5	N11° 04' 05" W	14.23'
TT6	N15° 13' 11" W	15.00'

CL Curve Table				
ID	ARC	RADIUS	DELTA	TANGENT
C4	252.38'	2182.00'	06° 37' 37"	126.33'
C5	200.38'	150.00'	76° 32' 19"	118.33'
C6	150.01'	150.00'	57° 18' 04"	81.95'

TRAIL Curve Table				
ID	ARC	RADIUS	DELTA	TANGENT
TC8	22.36'	75.00'	17° 05' 06"	11.27'
TC9	60.69'	75.00'	46° 21' 47"	32.12'
TC10	32.89'	75.00'	25° 07' 36"	16.71'

TRAIL Point Table			
●	EASTING	NORTHING	ELEVATION
1	350506.68	1528057.31	5544.07
2	350509.41	1528043.35	5543.96
3	350510.39	1528021.09	5543.76
4	350527.82	1527964.67	5543.25
5	350543.02	1527935.81	5542.87
6	350546.96	1527921.33	5542.85

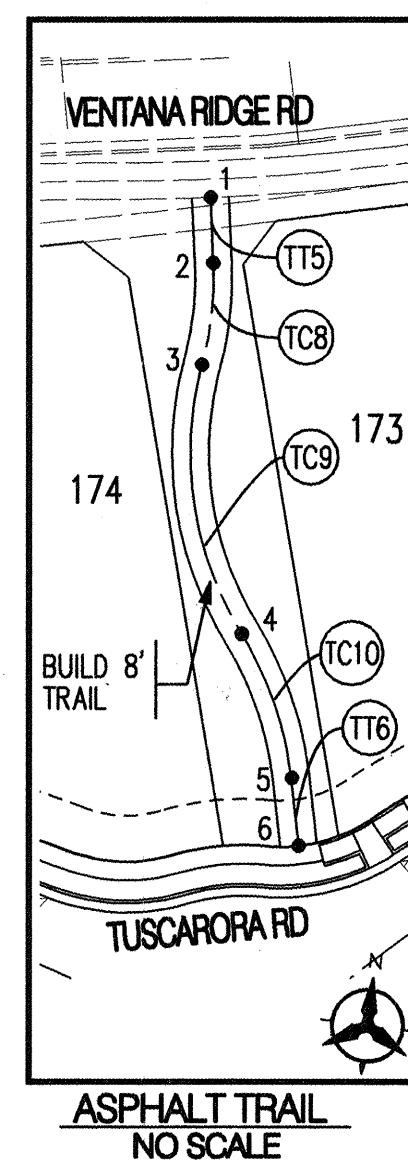


50 25 0 50
SCALE: 1" = 50'
(HORIZ.)

NOTES

1. THE CONTRACTOR SHALL FIELD VERIFY ALL EXISTING UTILITY LOCATIONS AND NOTIFY THE ENGINEER IMMEDIATELY OF ANY DISCREPANCIES.
2. ALL CURB RETURN RADIUS SHALL BE 25' UNLESS OTHERWISE SPECIFIED.
3. ALL CURVE DATA AND DIMENSIONS REFER TO FACE OF CURB UNLESS OTHERWISE SPECIFIED.
4. GRADE ELEVATIONS, WHERE NOTED, ARE ALONG FLOWLINE OF STANDARD CURB UNLESS OTHERWISE SPECIFIED.
5. CONTRACTOR IS RESPONSIBLE FOR REPAIR AND/OR REPLACEMENT OF ALL UTILITY CONDUITS AND EXISTING LINES.
6. ANY ADDITIONAL GRADING REQUIRED TO MATCH PROPOSED STREET GRADES SHALL BE INCIDENTAL TO PAVING ITEMS.
7. CONTRACTOR SHALL PROVIDE THE INSPECTORS, (CITY AND PRIVATE) WITH THE PROPOSED HYDROSTATIC TESTING PLAN. THE PLAN MUST BE APPROVED BEFORE TESTING OPERATIONS BEGIN.
8. CONTRACTOR SHALL PARK EQUIPMENT AND VEHICLES AS NOT TO INTERFERE WITH NORMAL ACTIVITIES OF RESIDENTS OR OTHER CONTRACTORS ON SITE.
9. ANY DAMAGE TO THE EXISTING FACILITIES (CURB & GUTTER, PAVEMENT, CONDUITS, LANDSCAPING, UTILITY LINES, ETC.) DURING CONSTRUCTION SHALL BE REPLACED AT THE CONTRACTORS' EXPENSE.
10. WHEELCHAIR RAMPS SHALL BE CONSTRUCTED PRIOR TO ACCEPTANCE OF CURB & GUTTER.
11. ALL EXCAVATION, TRENCHING AND SHORING ACTIVITIES MUST BE CARRIED-OUT IN ACCORDANCE WITH OSHA 29 CFR 1926.650 SUBPART P.

KEYED NOTES


- 1 INSTALL 6' CONCRETE VALLEY GUTTER
AS PER STD. DWG. 2420
- 2 STD. CURB & GUTTER AS PER STD. DWG. 2415 A
- 3 MEDIAN CURB & GUTTER AS PER STD DWG. 2415 B
- 4 ROLL CURB & GUTTER AS PER STD. DWG. 2415 A
- 5 DEFERRED 4' SIDEWALK
- 6 BUILD 4' SIDEWALK AS PER STD. DWG. 2430
- 7 BUILD 8' ASPHALT TRAIL AS PER DETAIL SHEET 18
- 8 BUILD WHEELCHAIR RAMP AS PER DETAIL "A" SHEET 18
- 9 BUILD WHEELCHAIR RAMP AS PER DETAIL "B" SHEET 18
- 10 BUILD WHEELCHAIR RAMP AS PER DETAIL "C" SHEET 18
- 11 INSTALL 12' CONCRETE VALLEY GUTTER
AS PER STD. DWG 2422
- 12 BUILD 4' TEXTURED MEDIAN PAVEMENT
FROM MEDIAN NOSE TO 10' FROM NOSE (BAJA RED)
MEDIAN NOSES SHALL BE PAINTED YELLOW
TO APPROX. 6' BEHIND PC/PT
PER COA STD. DWG. 2408

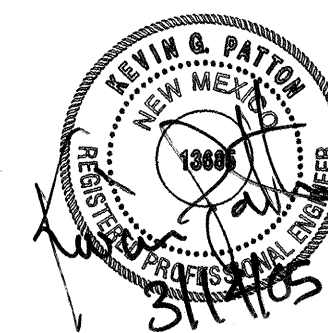

SURVEYORS CERTIFICATION


I, Russ P. Hugg, New Mexico Professional Surveyor Number 9750,
Hereby Certify that the as-built information shown hereon is the
result of an actual field survey performed by me or under my
direct supervision and that the same is true and correct to the
best of my knowledge and belief.

Rules P. Hugg
NMPS No. 9750
1-27-00

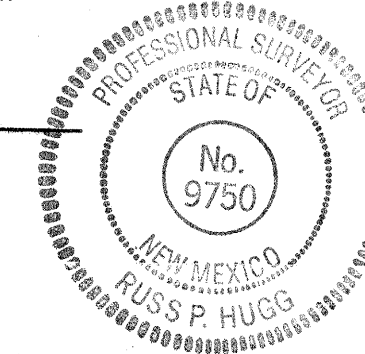



Bohannon ▲ Huston_{INC.}

Courtyard I 7500 Jefferson St. NE Albuquerque, NM 87109-4335
ENGINEERING ▲ SPATIAL DATA ▲ ADVANCED TECHNOLOGIES

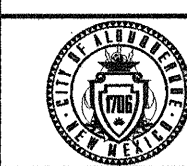

CITY OF ALBUQUERQUE
PUBLIC WORKS DEPARTMENT
ENGINEERING DEVELOPMENT GROUP


WESTERN RIDGE (UNIT 2) SUBDIVISION AT VENTANA RANCH WEST
PAVING PLAN & PROFILE
ALIGNMENT A 27+00 - 34+00

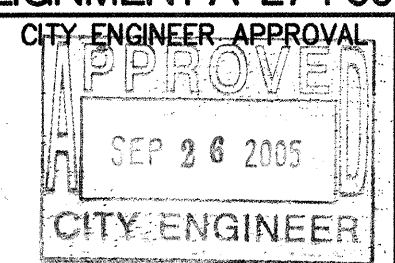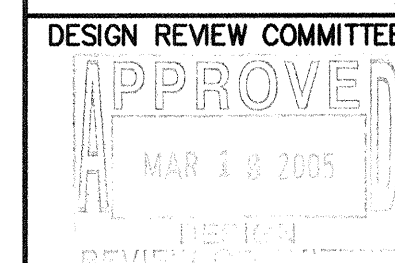

LAST DESIGN
UPDATE


MO./DAY/YR.	MO./DAY/YR.

SCANNED BY PLN

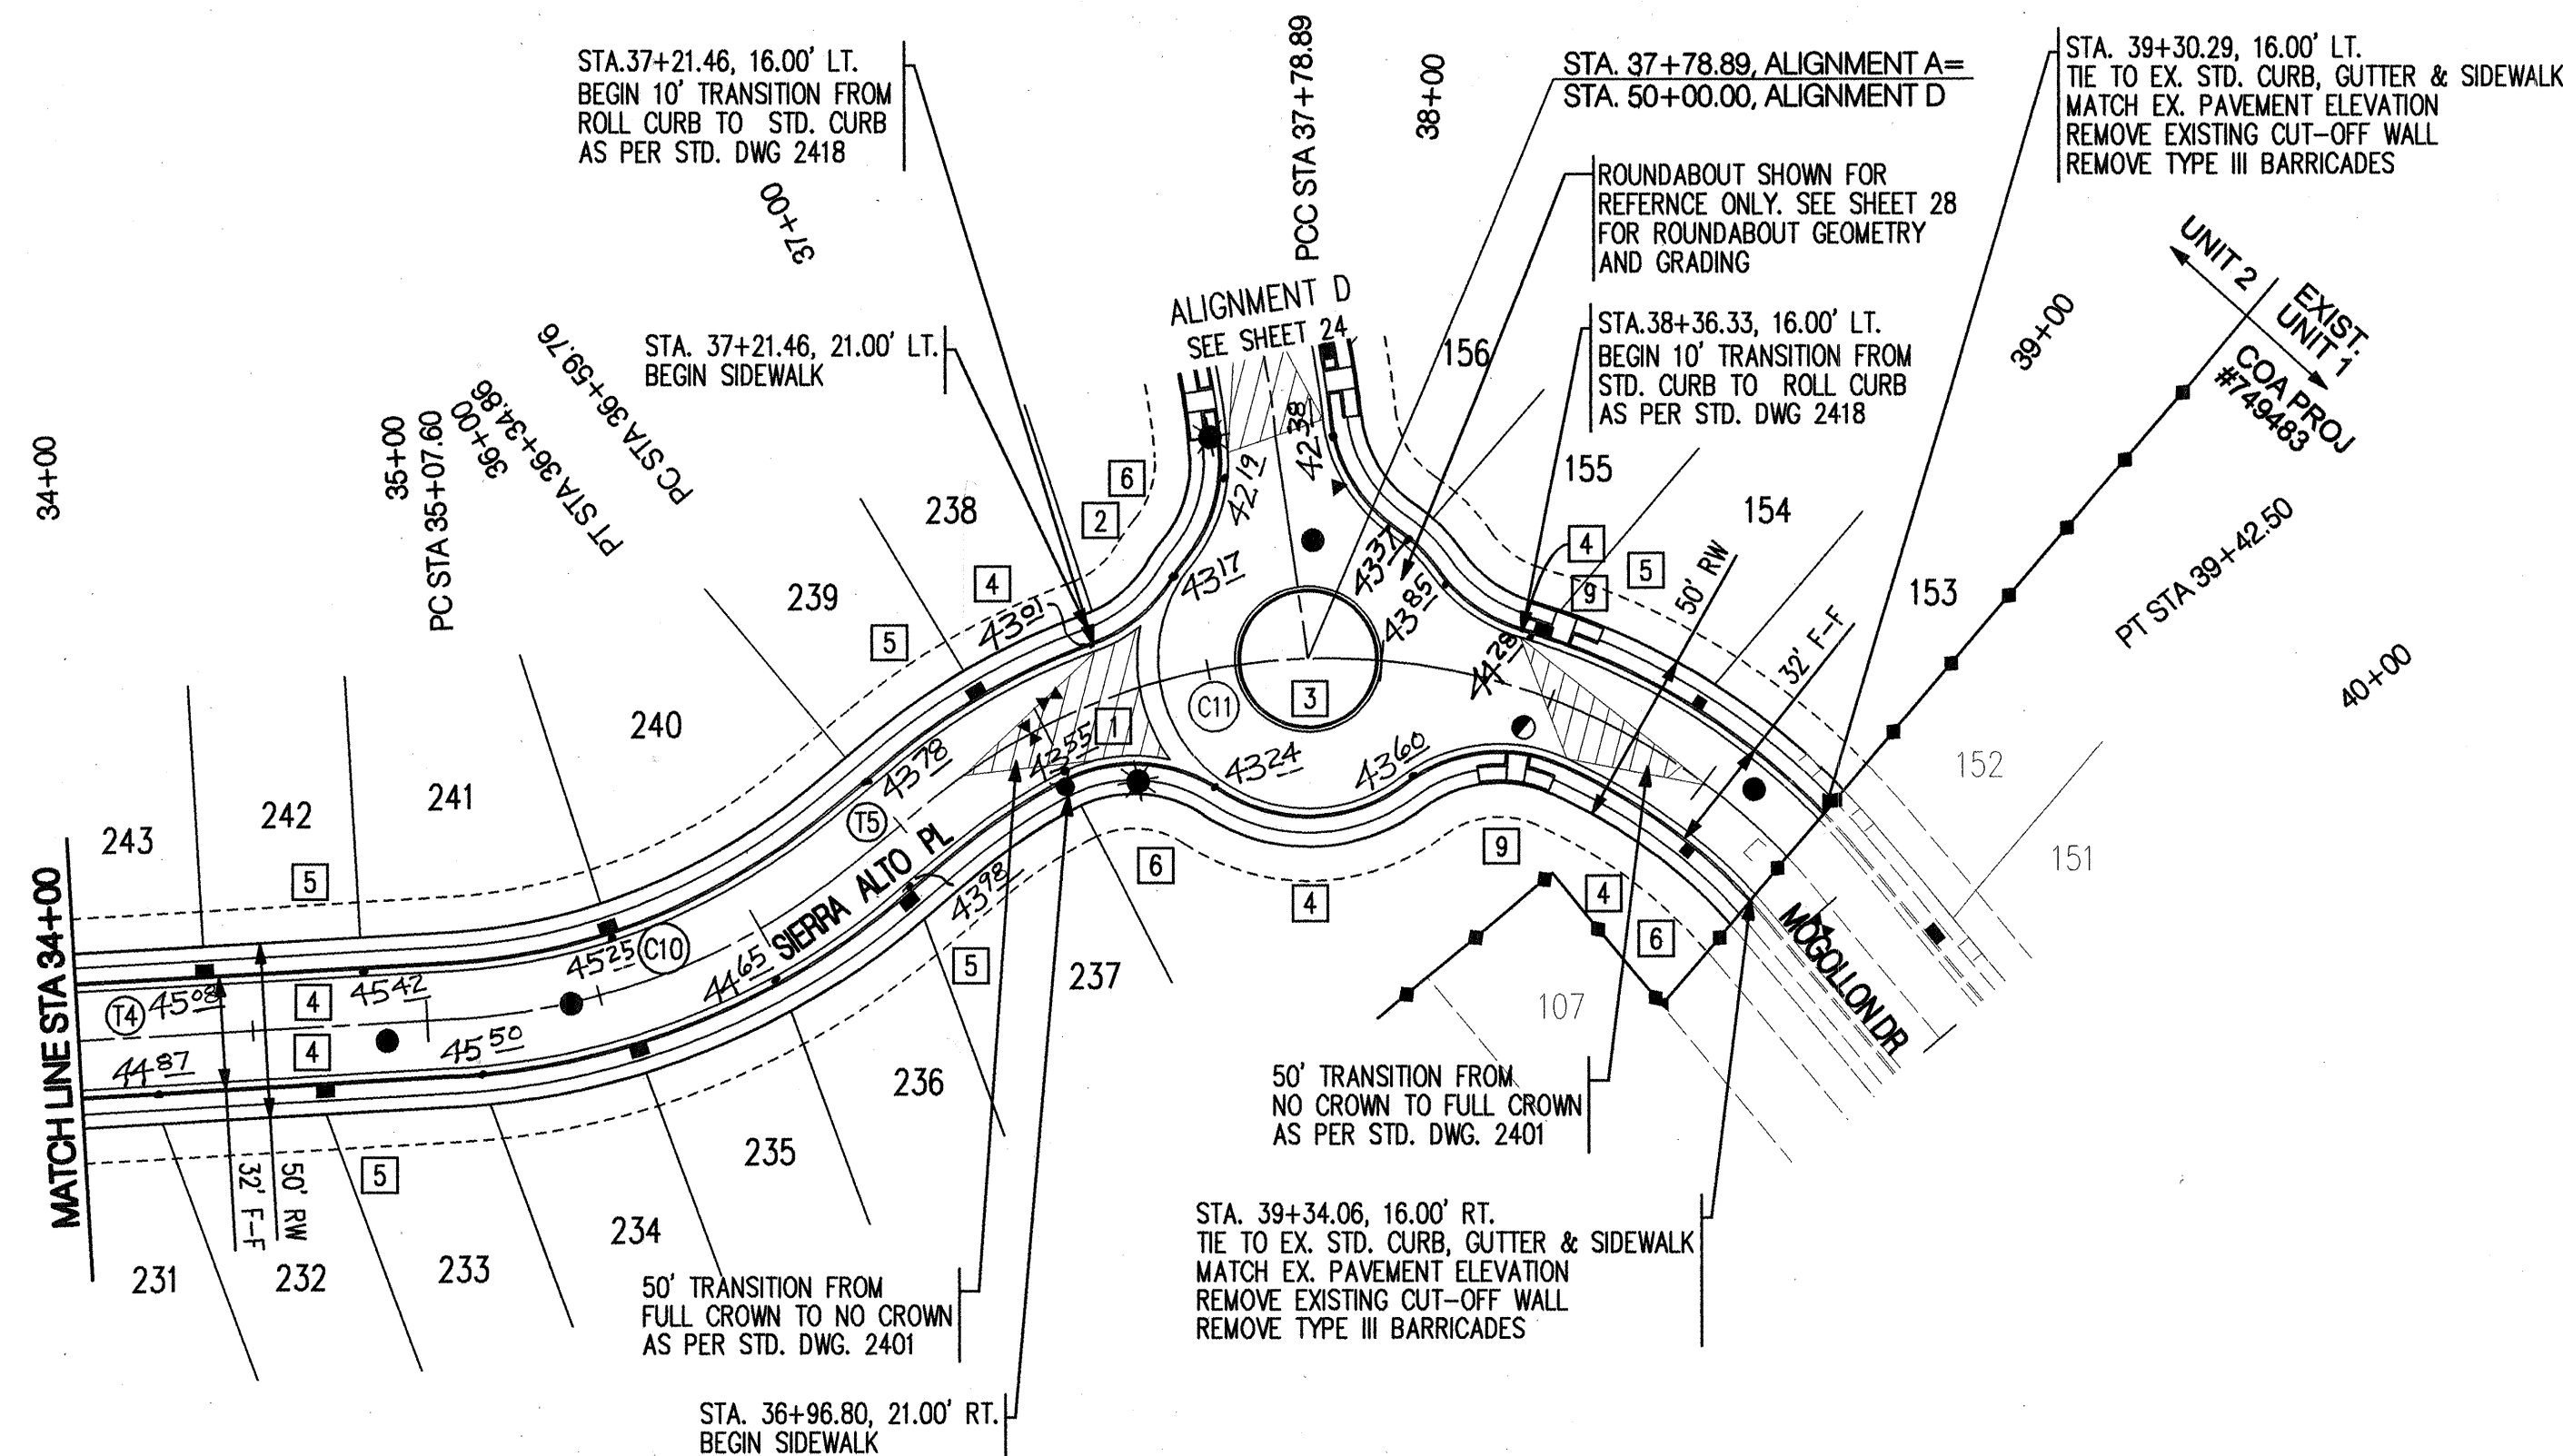


CL Curve Table				
ID	ARC	RADIUS	DELTA	TANGENT
C10	127.26'	200.00'	36°27'29"	65.87'
C11	272.25'	180.00'	86°39'31"	169.80'

CL Tangent Table		
ID	BEARING	LENGTH
T4	S82°45'49"E	132.80'
T5	N60°46'42"E	24.90'

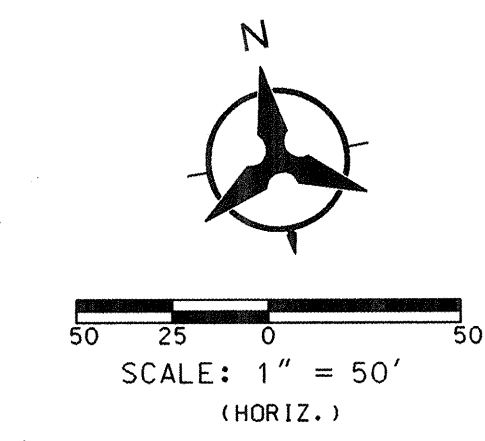


ALIGNMENT A 34+00 - 40+00

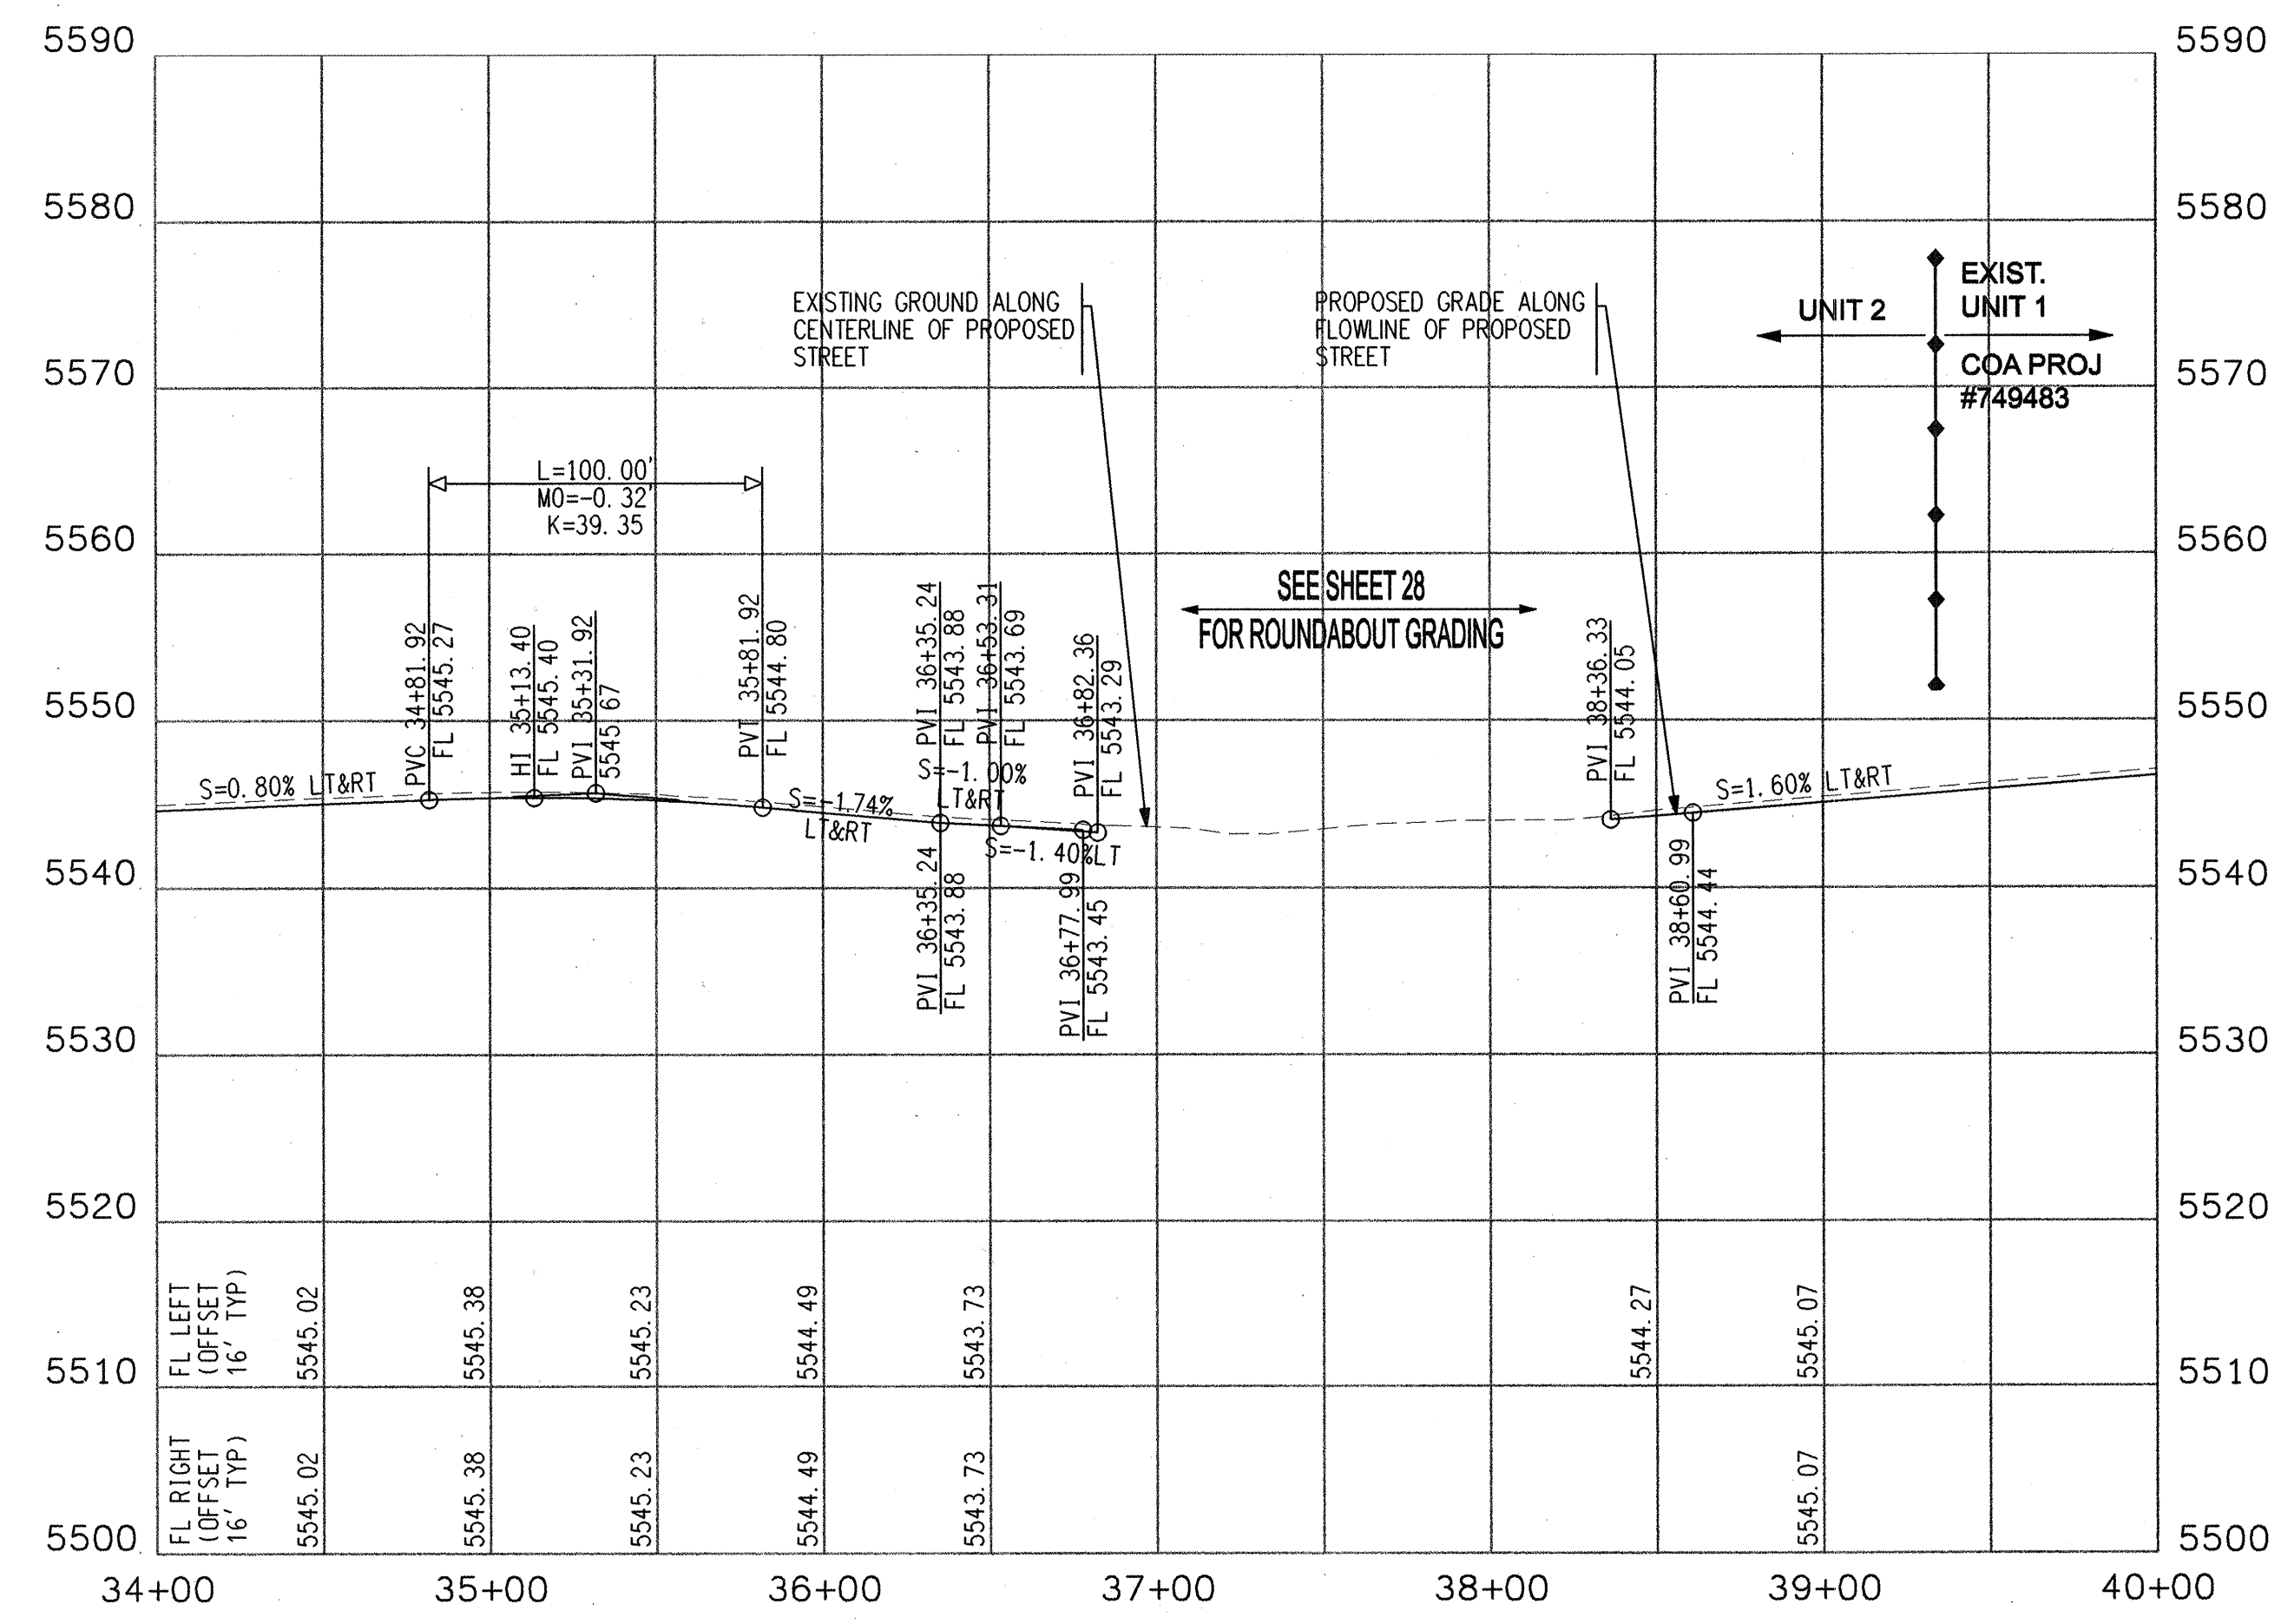

SURVEYORS CERTIFICATION
I, Russ P. Hugg, New Mexico Professional Surveyor Number 9750, Hereby Certify that the as-built information shown hereon is the result of an actual field survey performed by me or under my direct supervision and that the same is true and correct to the best of my knowledge and belief.

Russ P. Hugg
NMPS No. 9750
1-27-06

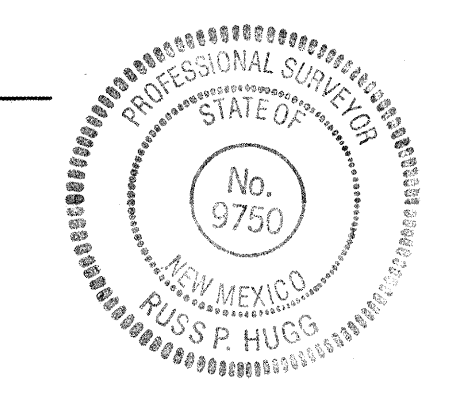

NOTES

1. THE CONTRACTOR SHALL FIELD VERIFY ALL EXISTING UTILITY LOCATIONS AND NOTIFY THE ENGINEER IMMEDIATELY OF ANY DISCREPANCIES.
2. ALL CURB RETURN RADII SHALL BE 25' UNLESS OTHERWISE SPECIFIED.
3. ALL CURVE DATA AND DIMENSIONS REFER TO FACE OF CURB UNLESS OTHERWISE SPECIFIED.
4. GRADE ELEVATIONS, WHERE NOTED, ARE ALONG FLOWLINE OF STANDARD CURB UNLESS OTHERWISE SPECIFIED.
5. CONTRACTOR IS RESPONSIBLE FOR REPAIR AND/OR REPLACEMENT OF ALL UTILITY CONDUITS AND EXISTING LINES.
6. ANY ADDITIONAL GRADING REQUIRED TO MATCH PROPOSED STREET GRADES SHALL BE INCIDENTAL TO PAVING ITEMS.
7. CONTRACTOR SHALL PROVIDE THE INSPECTORS, (CITY AND PRIVATE) WITH THE PROPOSED HYDROSTATIC TESTING PLAN. THE PLAN MUST BE APPROVED BEFORE TESTING OPERATIONS BEGIN.
8. CONTRACTOR SHALL PARK EQUIPMENT AND VEHICLES AS NOT TO INTERFERE WITH NORMAL ACTIVITIES OF RESIDENTS OR OTHER CONTRACTORS ON SITE.
9. ANY DAMAGE TO THE EXISTING FACILITIES (CURB & GUTTER, PAVEMENT, CONDUITS, LANDSCAPING, UTILITY LINES, ETC.) DURING CONSTRUCTION SHALL BE REPLACED AT THE CONTRACTORS' EXPENSE.
10. WHEELCHAIR RAMPS SHALL BE CONSTRUCTED PRIOR TO ACCEPTANCE OF CURB & GUTTER.
11. ALL EXCAVATION, TRENCHING AND SHORING ACTIVITIES MUST BE CARRIED-OUT IN ACCORDANCE WITH OSHA 29 CFR 1926.650 SUBPART P.

KEYED NOTES

- 1] INSTALL 6" CONCRETE VALLEY GUTTER AS PER STD. DWG. 2420
- 2] STD. CURB & GUTTER AS PER STD. DWG. 2415 A
- 3] MEDIAN CURB & GUTTER AS PER STD. DWG. 2415 B
- 4] ROLL CURB & GUTTER AS PER STD. DWG. 2415 A
- 5] DEFERRED 4" SIDEWALK
- 6] BUILD 4' SIDEWALK AS PER STD. DWG. 2430
- 7] BUILD 8" ASPHALT TRAIL AS PER DETAIL SHEET 18
- 8] BUILD WHEELCHAIR RAMP AS PER DETAIL "A" SHEET 18
- 9] BUILD WHEELCHAIR RAMP AS PER DETAIL "B" SHEET 18
- 10] BUILD WHEELCHAIR RAMP AS PER DETAIL "C" SHEET 18
- 11] INSTALL 12' CONCRETE VALLEY GUTTER AS PER STD. DWG 2422
- 12] BUILD 4" TEXTURED MEDIAN PAVEMENT FROM MEDIAN NOSE TO 10' FROM NOSE (BAJA RED) MEDIAN NOSES SHALL BE PAINTED YELLOW TO APPROX. 6' BEHIND PC/PT PER COA STD. DWG. 2408

Bohannon & Huston

Courtyard I 7500 Jefferson St. NE Albuquerque, NM 87109-4335
ENGINEERING & SPATIAL DATA & ADVANCED TECHNOLOGIES

CITY OF ALBUQUERQUE
PUBLIC WORKS DEPARTMENT
ENGINEERING DEVELOPMENT GROUP

WESTERN RIDGE (UNIT 2) SUBDIVISION AT VENTANA RANCH WEST
PAVING PLAN & PROFILE
ALIGNMENT A 34+00 - 40+00

DESIGN REVIEW COMMITTEE	CITY ENGINEER APPROVAL	MO./DAY/YR.	MO./DAY/YR.
APPROVED MAR 18 2005 DESIGN REVIEW COMMITTEE	APPROVED SEP 26 2005 CITY ENGINEER		

CITY PROJECT NO. 749486
ZONE MAP NO. B-8-Z
SHEET 21 OF 37

11/10/00

TRANSITION FROM ROLL CURB TO STD. CURB THRU WHEELCHAIR RAMP AS PER STD. DWG. 2418

50' TRANSITION FROM NO CROWN TO FULL CROWN AS PER STD. DWG. 2401

50' TRANSITION FROM FULL CROWN TO NO CROWN AS PER STD. DWG. 2401

POB STA 0+75.00

STA 0+87.69, 63.28' LT ASPHALT TRAIL SEE SHEET 19

STA 0+69.55, 53.14' LT BEGIN SIDEWALK

NO CROWN

28' F-F

46' RW

SIERRA ALTOS PL.

ALIGNMENT A SEE SHEET 20

SIERRA ALTOS PL.

50' TRANSITION FROM FULL CROWN TO NO CROWN AS PER STD. DWG. 2401

POB STA 7+47.00

PT STA 7+22.40

STA 7+22.40, ALIGNMENT B= STA. 32+64.24, ALIGNMENT A

1+00

2+00

3+00

4+00

5+00

6+00

7+00

194

195

196

5

(C) FLOWLINE DATA FOR CURB RETURN

PC	43.27	D = 87°53'55"
1	43.39	R = 25.00'
2	43.50	T = 24.10'
3	43.62	L = 38.35'
PT	43.73	C = 34.70'
PI	43.43	

PC STA. 7+10.07, 35.90' LT.
PT STA. 6+78.70, 14.00' LT.
PI STA. 7+06.62, 14.00' LT.
RAD STA. 6+78.70, 39.00' LT.

CL Curve Table


ID	ARC	RADIUS	DELTA	TANGENT
C1	145.63'	850.00'	09° 49' 00"	73.00'
C2	108.58'	180.00'	34° 33' 42"	56.00'

CL Tangent Table

ID	BEARING	LENGTH
T1	N89° 48' 19" W	284.93'
T2	S80° 22' 41" W	83.25'

CUL-DE-SAC Point Table

●	STATION	OFFSET	ELEVATION
1	1+16.79	16.31' RT.	5548.83
2	0+93.11	19.40' RT.	5549.09
3	0+71.89	8.46' RT.	5549.34
4	0+60.69	12.62' LT.	5549.48
5	0+63.49	36.33' LT.	5549.51
6	0+79.29	54.22' LT.	5549.41
7	1+02.48	59.92' LT.	5549.19
8	1+24.78	51.40' LT.	5548.93
9	1+38.25	31.69' LT.	5548.68

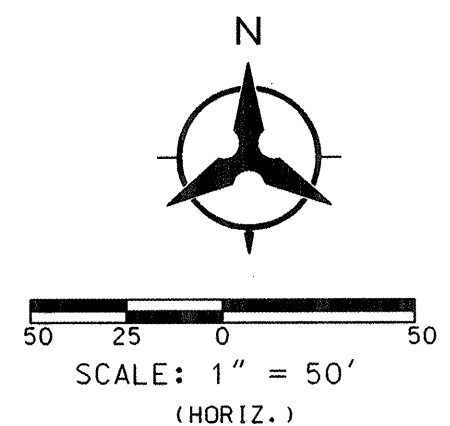

1. THE CONTRACTOR SHALL FIELD VERIFY ALL EXISTING UTILITY LOCATIONS AND NOTIFY THE ENGINEER IMMEDIATELY OF ANY DISCREPANCIES.
2. ALL CURB RETURN RADIUS SHALL BE 25' UNLESS OTHERWISE SPECIFIED.
3. ALL CURVE DATA AND DIMENSIONS REFER TO FACE OF CURB UNLESS OTHERWISE SPECIFIED.
4. GRADE ELEVATIONS, WHERE NOTED, ARE ALONG FLOWLINE OF STANDARD CURB UNLESS OTHERWISE SPECIFIED.
5. CONTRACTOR IS RESPONSIBLE FOR REPAIR AND/OR REPLACEMENT OF ALL UTILITY CONDUITS AND EXISTING LINES.
6. ANY ADDITIONAL GRADING REQUIRED TO MATCH PROPOSED STREET GRADES SHALL BE INCIDENTAL TO PAVING ITEMS.
7. CONTRACTOR SHALL PROVIDE THE INSPECTORS, (CITY AND PRIVATE) WITH THE PROPOSED HYDROSTATIC TESTING PLAN. THE PLAN MUST BE APPROVED BEFORE TESTING OPERATIONS BEGIN.
8. CONTRACTOR SHALL PARK EQUIPMENT AND VEHICLES AS NOT TO INTERFERE WITH NORMAL ACTIVITIES OF RESIDENTS OR OTHER CONTRACTORS ON SITE.
9. ANY DAMAGE TO THE EXISTING FACILITIES (CURB & GUTTER, PAVEMENT, CONDUITS, LANDSCAPING, UTILITY LINES, ETC.) DURING CONSTRUCTION SHALL BE REPLACED AT THE CONTRACTORS' EXPENSE.
10. WHEELCHAIR RAMPS SHALL BE CONSTRUCTED PRIOR TO ACCEPTANCE OF CURB & GUTTER.
11. ALL EXCAVATION, TRENCHING AND SHORING ACTIVITIES MUST BE CARRIED-OUT IN ACCORDANCE WITH OSHA 29 CFR 1926.650 SUBPART P.


- 1 INSTALL 6" CONCRETE VALLEY GUTTER
AS PER STD. DWG. 2420
- 2 STD. CURB & GUTTER AS PER STD. DWG. 2415 A
- 3 MEDIAN CURB & GUTTER AS PER STD DWG. 2415 B
- 4 ROLL CURB & GUTTER AS PER STD. DWG. 2415 A
- 5 DEFERRED 4' SIDEWALK
- 6 BUILD 4' SIDEWALK AS PER STD. DWG. 2430
- 7 BUILD 8' ASPHALT TRAIL AS PER DETAIL SHEET 18
- 8 BUILD WHEELCHAIR RAMP AS PER DETAIL "A" SHEET 18
- 9 BUILD WHEELCHAIR RAMP AS PER DETAIL "B" SHEET 18
- 10 BUILD WHEELCHAIR RAMP AS PER DETAIL "C" SHEET 18
- 11 INSTALL 12' CONCRETE VALLEY GUTTER
AS PER STD. DWG. 2422
- 12 BUILD 4" TEXTURED MEDIAN PAVEMENT
FROM MEDIAN NOSE TO 10' FROM NOSE (BAJA RED)
MEDIAN NOSES SHALL BE PAINTED YELLOW
TO APPROX. 6' BEHIND PC/PT
PER COA STD. DWG. 2408



SURVEYORS CERTIFICATION

I, Russ P. Hugg, New Mexico Professional Surveyor Number 9750, Hereby Certify that the as-built information shown hereon is the result of an actual field survey performed by me or under my direct supervision and that the same is true and correct to the best of my knowledge and belief.

Russ P. Hugg
NMPS No. 9750
1.27 20 06

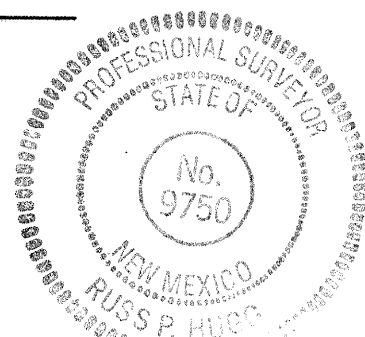

Bohannon ▲ Huston.

Courtyard I 7500 Jefferson St. NE Albuquerque, NM 87109-4335
ENGINEERING ▲ SPATIAL DATA ▲ ADVANCED TECHNOLOGIES

 **CITY OF ALBUQUERQUE**
PUBLIC WORKS DEPARTMENT
ENGINEERING DEVELOPMENT GROUP

WESTERN RIDGE (UNIT 2) SUBDIVISION AT VENTANA RANCH WEST
PAVING PLAN & PROFILE
ALIGNMENT B

DESIGN REVIEW COMMITTEE	CITY ENGINEER APPROVAL	MO./DAY/YR.	MO./DAY/YR.
-------------------------	------------------------	-------------	-------------

[illegible]

CITY PROJECT NO.	749486	ZONE MAP NO.	B-8-Z	SHEET	22	OF	37
------------------	--------	--------------	-------	-------	----	----	----

14-MAR-2005 -
P:\050125\cdp\ppp\Unit2\050125ppp04.doc

BHI JOB NO. 050125


SCALE: 1" = 50' (HORIZ.)
1" = 10' (VERT.)

CITY PROJECT NO.

ZONE MAP NO
B-8-2

SHEET	OF
22	37



SCANNED

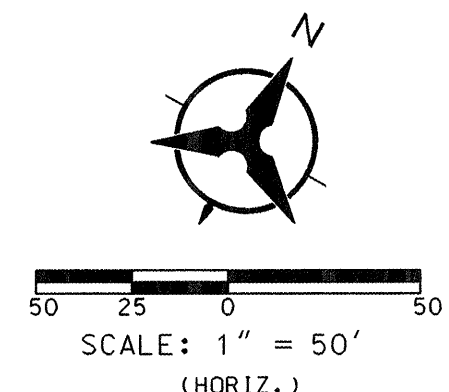

- 1) INSTALL 6" CONCRETE VALLEY GUTTER
AS PER STD. DWG. 2420
- 2) STD. CURB & GUTTER AS PER STD. DWG. 2415 A
- 3) MEDIAN CURB & GUTTER AS PER STD. DWG. 2415 B
- 4) ROLL CURB & GUTTER AS PER STD. DWG. 2415 A
- 5) DEFERRED 4' SIDEWALK
- 6) BUILD 4' SIDEWALK AS PER STD. DWG. 2430
- 7) BUILD 8" ASPHALT TRAIL AS PER DETAIL SHEET 18
- 8) BUILD WHEELCHAIR RAMP AS PER DETAIL "A" SHEET 18
- 9) BUILD WHEELCHAIR RAMP AS PER DETAIL "B" SHEET 18
- 10) BUILD WHEELCHAIR RAMP AS PER DETAIL "C" SHEET 18
- 11) INSTALL 12" CONCRETE VALLEY GUTTER
AS PER STD. DWG 2422
- 12) BUILD 4" TEXTURED MEDIAN PAVEMENT
FROM MEDIAN NOSE TO 10' FROM NOSE (BAJA RED)
MEDIAN NOSES SHALL BE PAINTED YELLOW
TO APPROX. 6' BEHIND PC/PT
PER COA STD. DWG. 2408



I, Russ P. Hugg, New Mexico Professional Surveyor Number 9750,
 Hereby Certify that the as-built information shown hereon is the
 result of an actual field survey performed by me or under my
 direct supervision and that the same is true and correct to the
 best of my knowledge and belief.

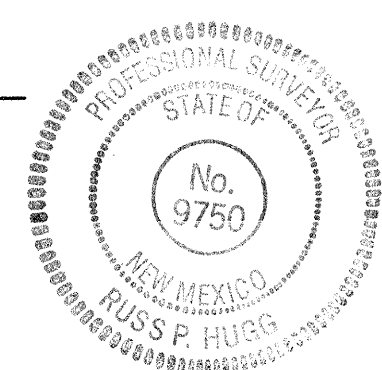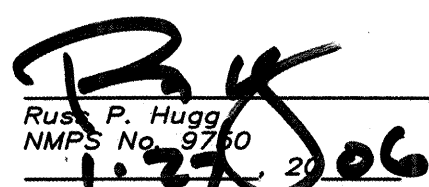

Courtyard I 7500 Jefferson St. NE Albuquerque, NM 87109-4335



CITY OF ALBUQUERQUE
PUBLIC WORKS DEPARTMENT
ENGINEERING DEVELOPMENT GROUP

WESTERN RIDGE (UNIT 2) SUBDIVISION AT VENTANA RANCH WEST
PAVING PLAN & PROFILE
ALIGNMENT C

[illegible]

CITY PROJECT NO.	ZONE MAP NO.	SHEET	OF
749486	B-8-7	23	37

14-MAR-2005 -
P:\050125\cdp\pnp\Unit2\050125pnp05.doc

BHI JOB NO. 050125

SCALE: 1" = 50' (HORIZ.)
1" = 10' (VERT.)


CITY PROJECT NO.

ZONE MAP NO.
B-8-7


SHEET 25

SCANNED BY PLW

SCANNED BY

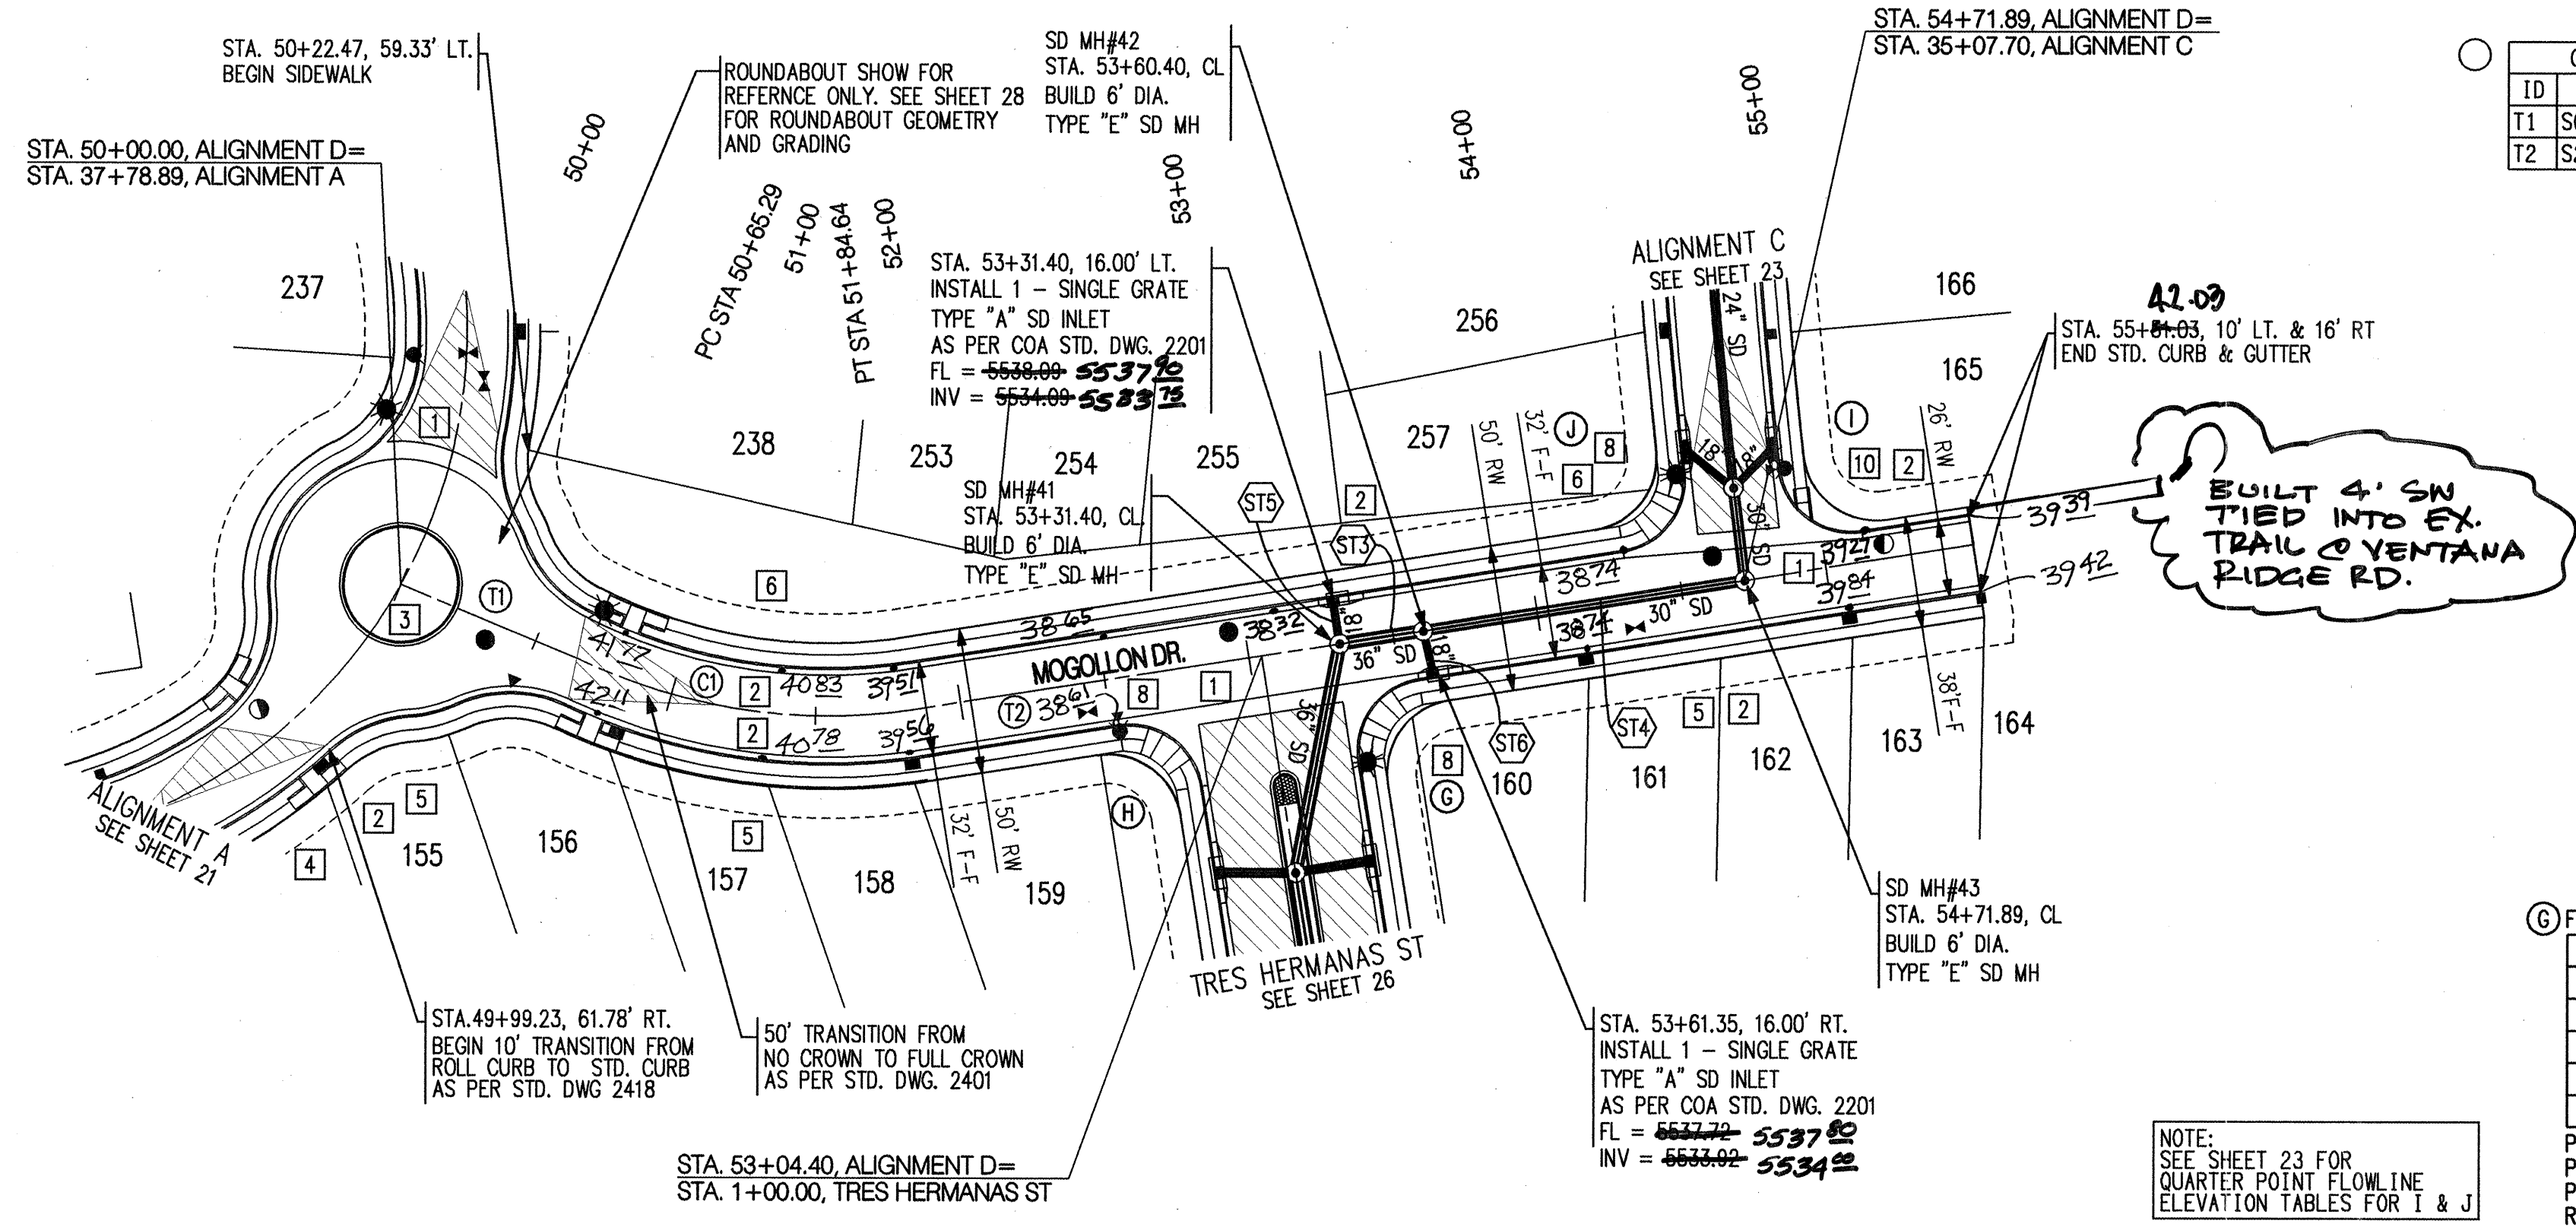


ALIGNMENT D

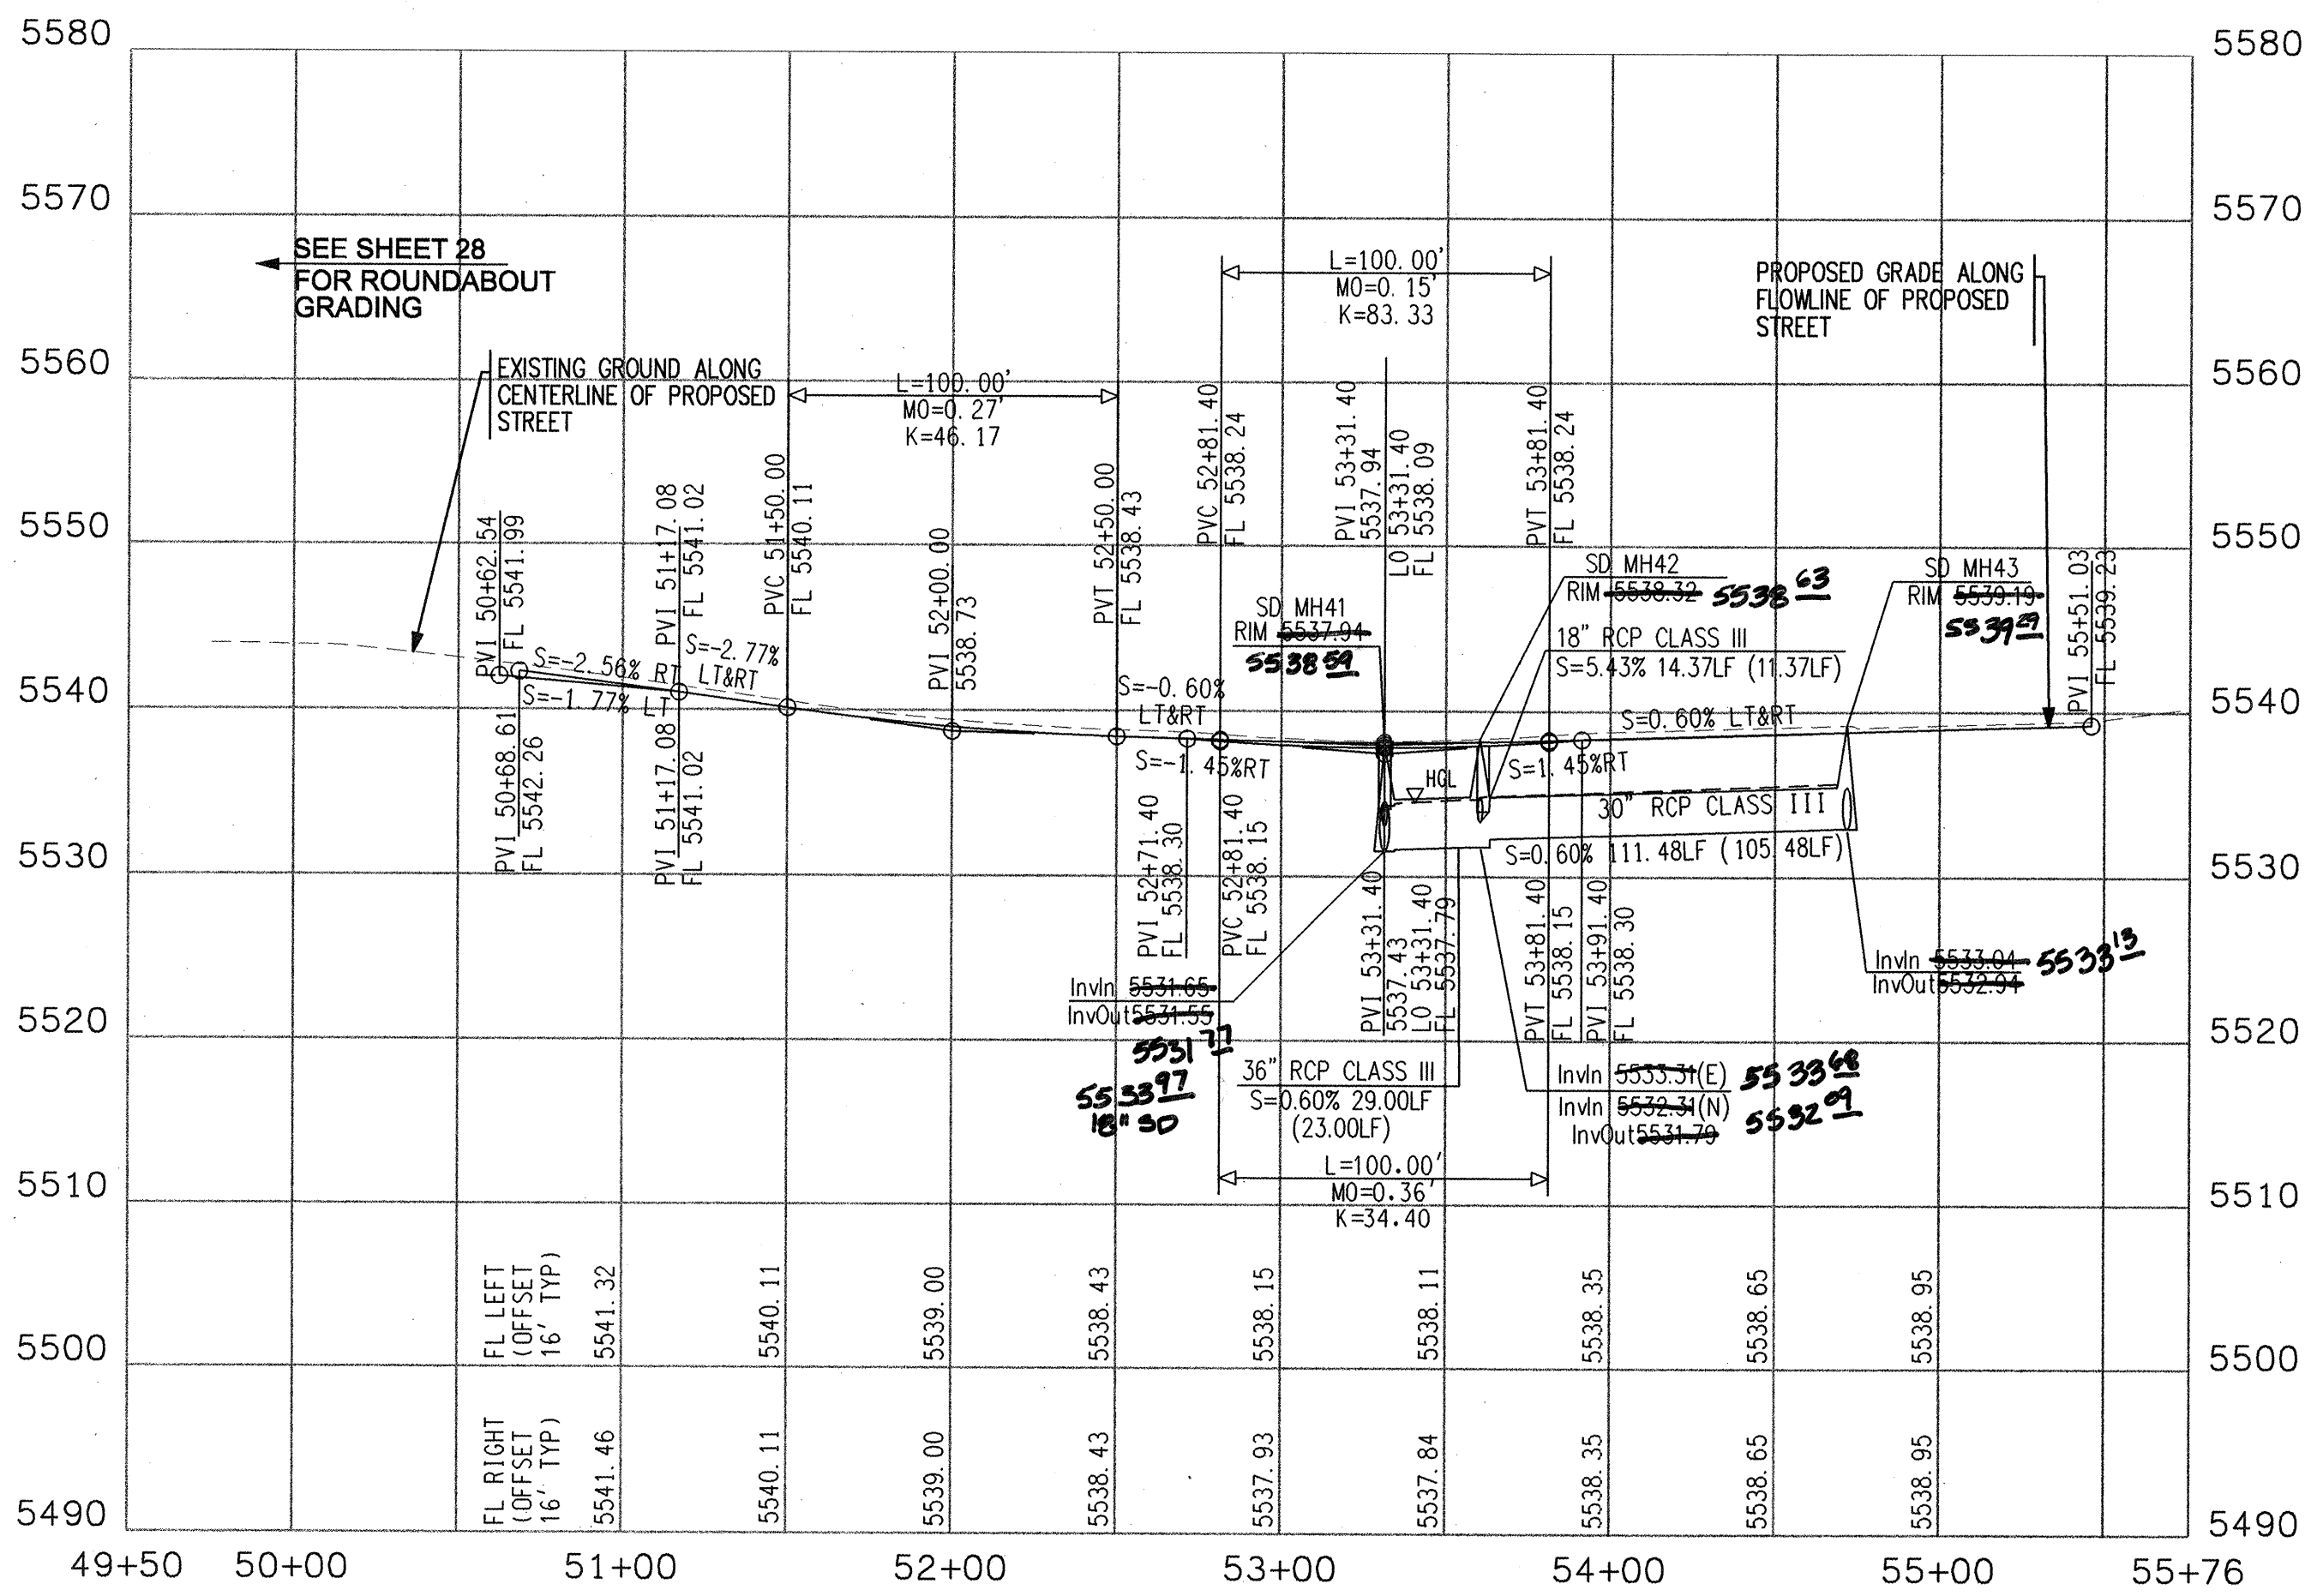

SURVEYORS CERTIFICATION

I, Russ P. Hugg, New Mexico Professional Surveyor Number 9750, Hereby Certify that the as-built information shown herein is the result of an actual field survey performed by me or under my direct supervision and that the same is true and correct to the best of my knowledge and belief.

Russ P. Hugg
NMPs No. 9750

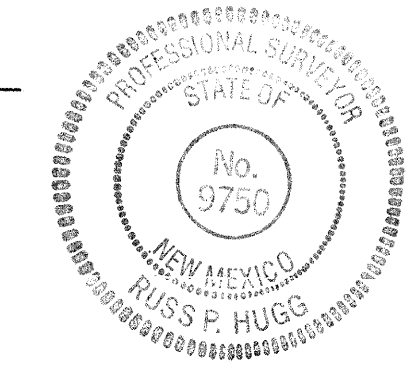

NOTES

- THE CONTRACTOR SHALL FIELD VERIFY ALL EXISTING UTILITY LOCATIONS AND NOTIFY THE ENGINEER IMMEDIATELY OF ANY DISCREPANCIES.
- ALL CURB RETURN RADII SHALL BE 25' UNLESS OTHERWISE SPECIFIED.
- ALL CURVE DATA AND DIMENSIONS REFER TO FACE OF CURB UNLESS OTHERWISE SPECIFIED.
- GRADE ELEVATIONS, WHERE NOTED, ARE ALONG FLOWLINE OF STANDARD CURB UNLESS OTHERWISE SPECIFIED.
- CONTRACTOR IS RESPONSIBLE FOR REPAIR AND/OR REPLACEMENT OF ALL UTILITY CONDUITS AND EXISTING LINES.
- ANY ADDITIONAL GRADING REQUIRED TO MATCH PROPOSED STREET GRADES SHALL BE INCIDENTAL TO PAVING ITEMS.
- CONTRACTOR SHALL PROVIDE THE INSPECTORS, (CITY AND PRIVATE) WITH THE PROPOSED HYDROSTATIC TESTING PLAN. THE PLAN MUST BE APPROVED BEFORE TESTING OPERATIONS BEGIN.
- CONTRACTOR SHALL PARK EQUIPMENT AND VEHICLES AS NOT TO INTERFERE WITH NORMAL ACTIVITIES OF RESIDENTS OR OTHER CONTRACTORS ON SITE.
- ANY DAMAGE TO THE EXISTING FACILITIES (CURB & GUTTER, PAVEMENT, CONDUITS, LANDSCAPING, UTILITY LINES, ETC.) DURING CONSTRUCTION SHALL BE REPLACED AT THE CONTRACTORS' EXPENSE.
- WHEELCHAIR RAMP SHALL BE CONSTRUCTED PRIOR TO ACCEPTANCE OF CURB & GUTTER.
- ALL EXCAVATION, TRENCHING AND SHORING ACTIVITIES MUST BE CARRIED-OUT IN ACCORDANCE WITH OSHA 29 CFR 1926.650 SUBPART P.

KEYED NOTES

- INSTALL 6" CONCRETE VALLEY GUTTER AS PER STD. DWG. 2420
- STD. CURB & GUTTER AS PER STD. DWG. 2415 A
- MEDIAN CURB & GUTTER AS PER STD. DWG. 2415 B
- ROLL CURB & GUTTER AS PER STD. DWG. 2415 A
- DEFERRED 4' SIDEWALK
- BUILD 4' SIDEWALK AS PER STD. DWG. 2430
- BUILD 8" ASPHALT TRAIL AS PER DETAIL SHEET 18
- BUILD WHEELCHAIR RAMP AS PER DETAIL "A" SHEET 18
- BUILD WHEELCHAIR RAMP AS PER DETAIL "B" SHEET 18
- BUILD WHEELCHAIR RAMP AS PER DETAIL "C" SHEET 18
- INSTALL 12" CONCRETE VALLEY GUTTER AS PER STD. DWG. 2422
- BUILD 4" TEXTURED MEDIAN PAVEMENT FROM MEDIAN NOSE TO 10' FROM NOSE (BAJA RED) MEDIAN NOSES SHALL BE PAINTED YELLOW TO APPROX. 6' BEHIND PC/PT PER COA STD. DWG. 2408

Bohannon & Huston

Courtyard I 7500 Jefferson St. NE Albuquerque, NM 87109-4335
ENGINEERING • SPATIAL DATA • ADVANCED TECHNOLOGIES


CITY OF ALBUQUERQUE
PUBLIC WORKS DEPARTMENT
ENGINEERING DEVELOPMENT GROUP

WESTERN RIDGE (UNIT 2) SUBDIVISION AT VENTANA RANCH WEST
PAVING PLAN & PROFILE
ALIGNMENT D

DESIGN REVIEW COMMITTEE	CITY ENGINEER APPROVAL	MO./DAY/YR.	MO./DAY/YR.
APPROVED	APPROVED		
LAST DESIGN UPDATE	SEP 20 2005		
	CITY ENGINEER		

CITY PROJECT NO. 749486
ZONE MAP NO. B-8-Z
SHEET 24 OF 37

SCANNED BY P.N.

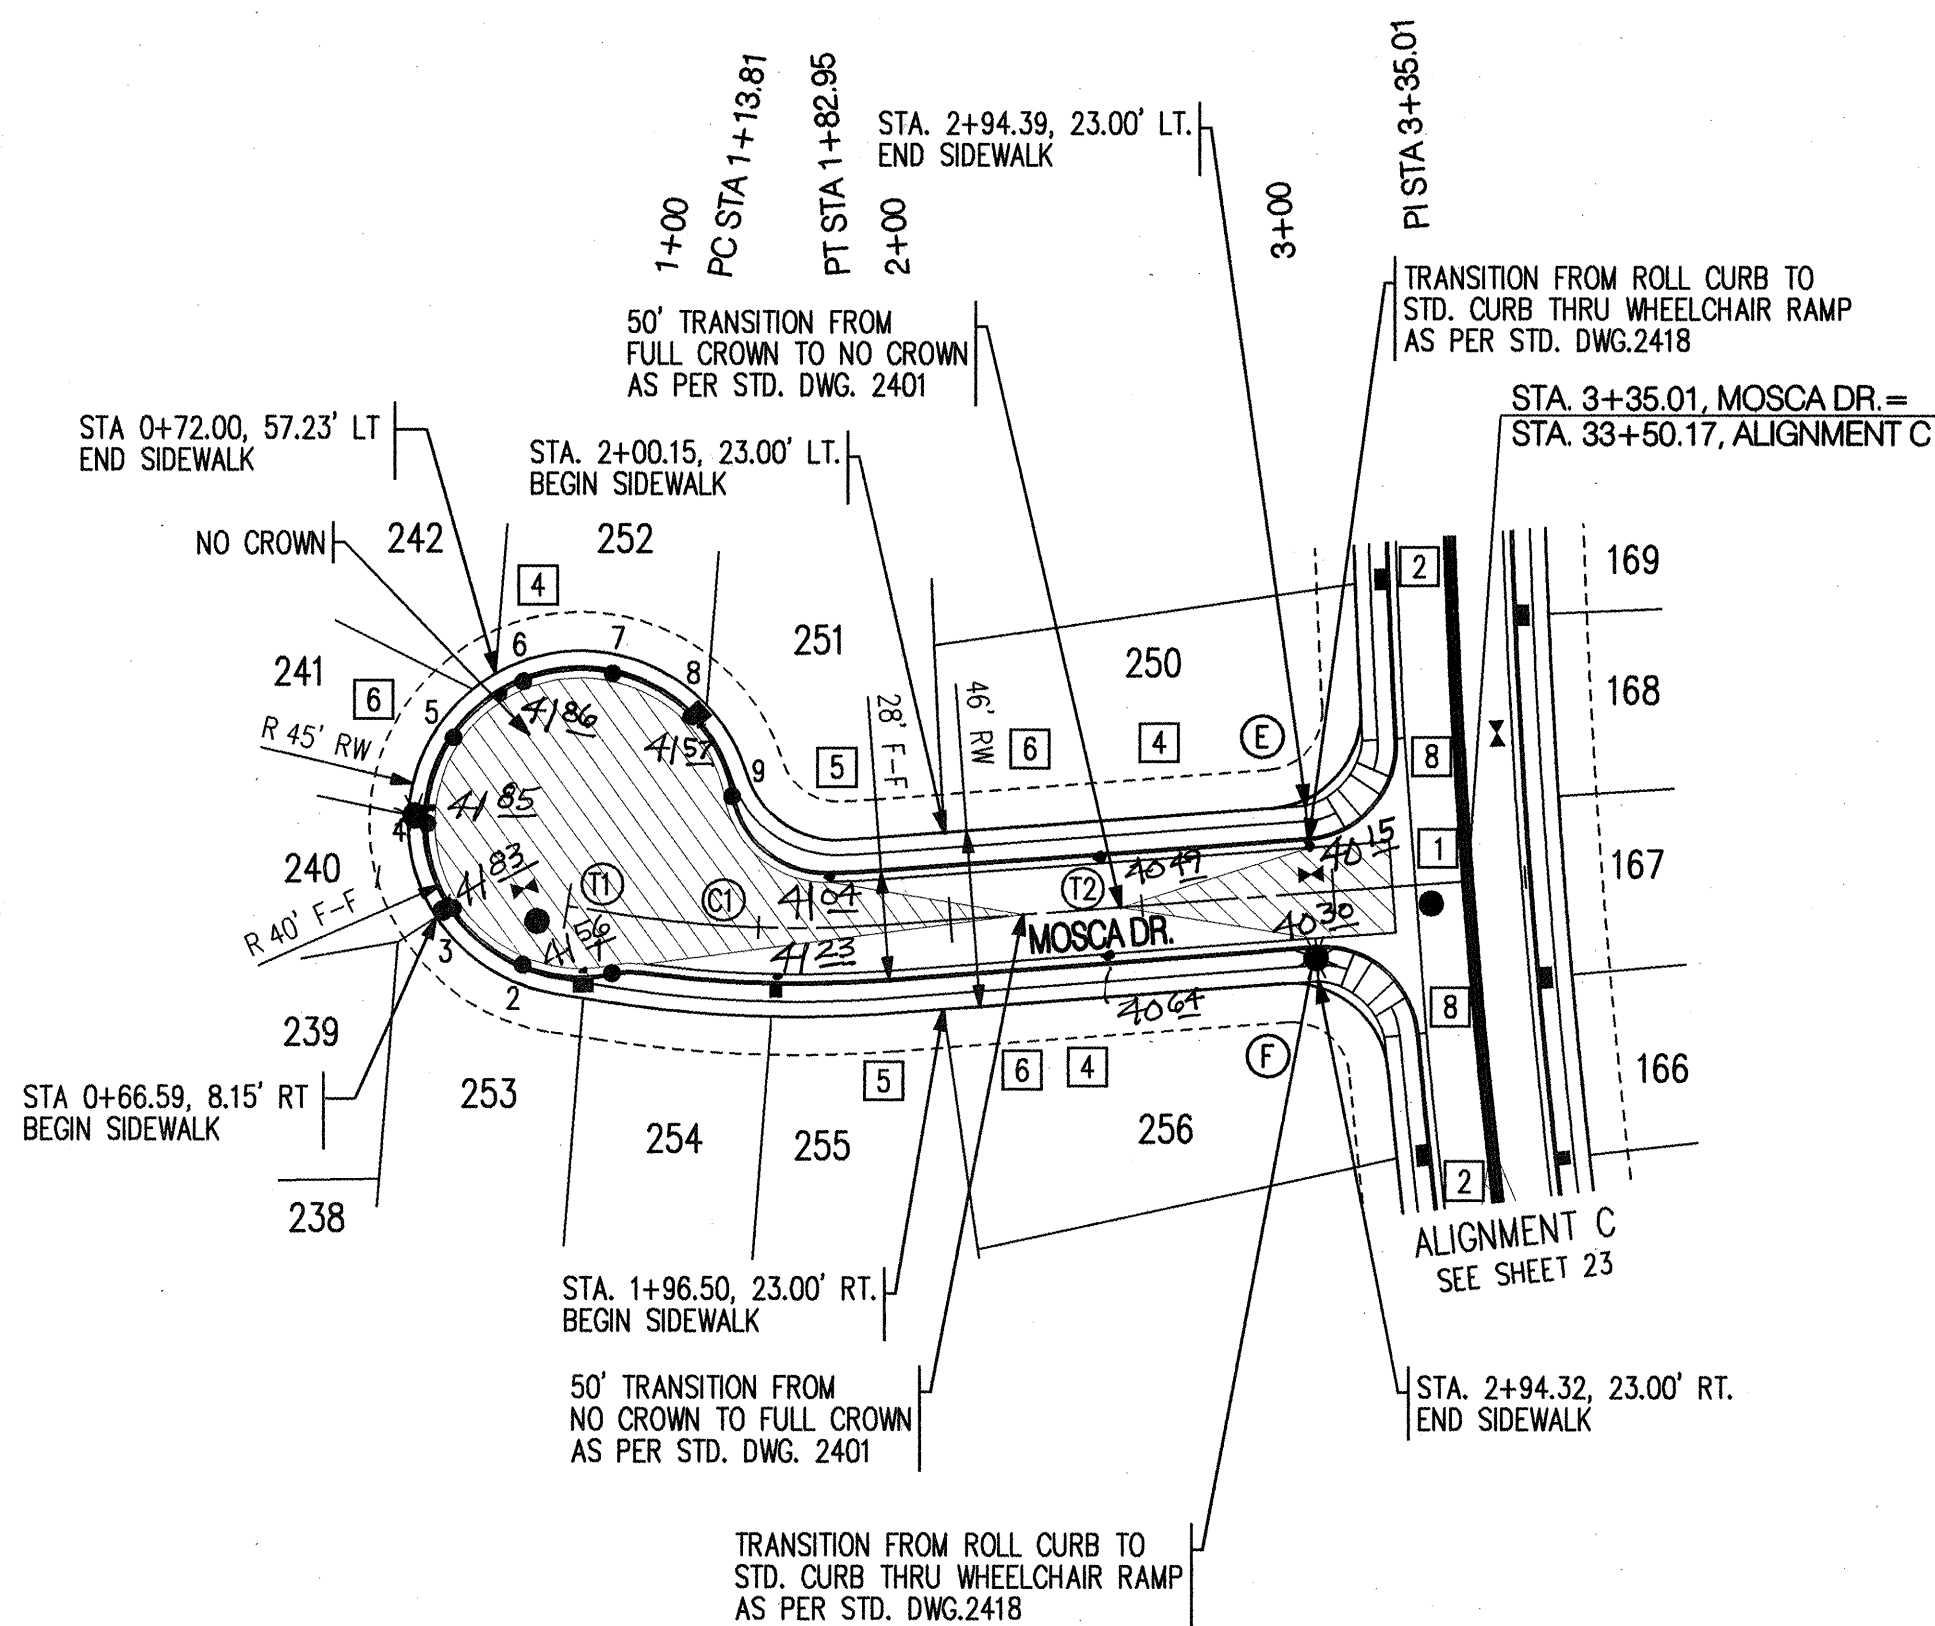

E FLOWLINE DATA FOR CURB RETURN

PC	39.99	D = 88°56'35"
1	40.00	R = 25.00'
2	40.01	T = 24.54'
3	40.01	L = 38.81'
PT	40.02	C = 35.03'
PI	39.85	

PC STA. 3+19.39, 38.54' LT.
PT STA. 2+94.39, 14.00' LT.
PI STA. 3+19.07, 14.00' LT.
RAD STA. 2+94.39, 39.00' LT.

F FLOWLINE DATA FOR CURB RETURN

PC	40.02	D = 89°02'48"
1	39.90	R = 25.00'
2	39.78	T = 24.59'
3	39.65	L = 38.85'
PT	39.53	C = 35.06'
PI	39.68	

PC STA. 2+94.32, 14.00' RT.
PT STA. 3+19.32, 38.58' RT.
PI STA. 3+19.04, 14.00' RT.
RAD STA. 2+94.32, 39.00' RT.

CL Tangent Table


ID	BEARING	LENGTH
T1	S10°26'07"E	13.81'
T2	S23°38'28"E	152.06'

CL Curve Table


ID	ARC	RADIUS	DELTA	TANGENT
C1	69.15'	300.00'	13°12'21"	34.73'

CUL-DE-SAC Point Table

STATION	OFFSET	ELEVATION
1	1+14.00	15.47' RT. 5541.29
2	0+90.73	16.91' RT. 5541.45
3	0+70.59	5.12' RT. 5541.62
4	0+60.47	15.90' LT. 5541.72
5	0+63.79	39.00' LT. 5541.74
6	0+79.44	56.31' LT. 5541.68
7	1+02.08	61.95' LT. 5541.54
8	1+26.24	53.78' LT. 5541.36
9	1+40.88	34.07' LT. 5541.17

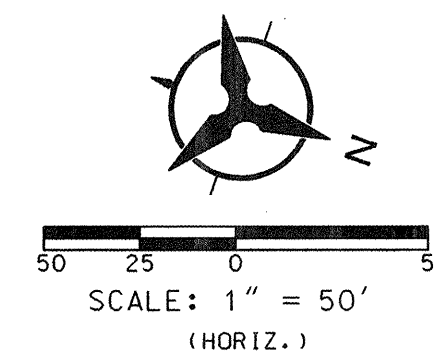


MOSCA DR.

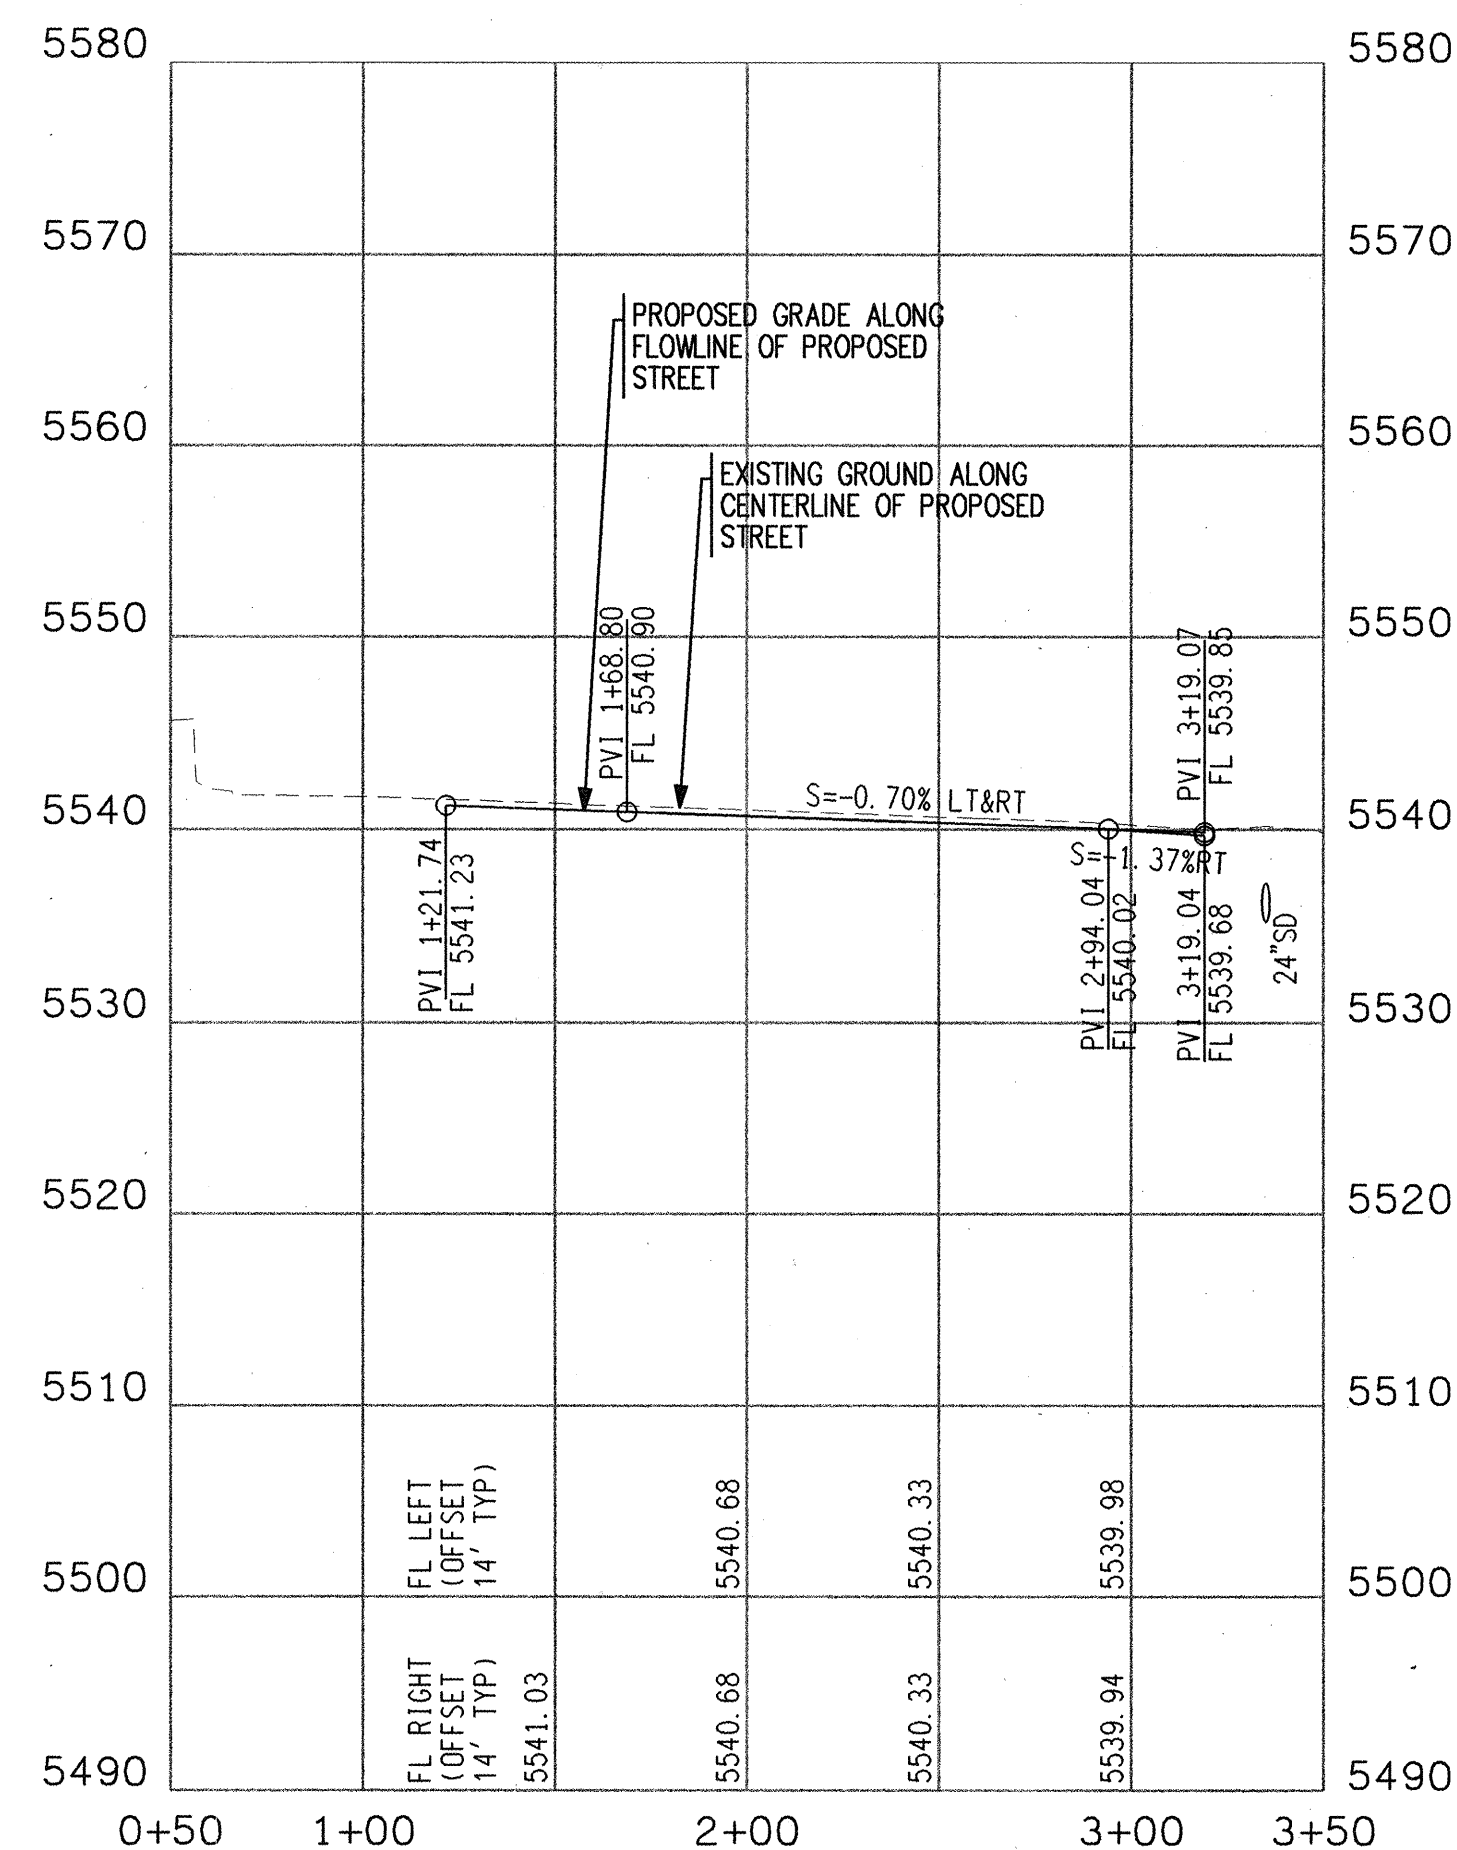

SURVEYORS CERTIFICATION

I, Russ P. Hugg, New Mexico Professional Surveyor Number 9750, Hereby Certify that the as-built information shown hereon is the result of an actual field survey performed by me or under my direct supervision and that the same is true and correct to the best of my knowledge and belief.

Russ P. Hugg
NMPS No. 9750
1-27-06

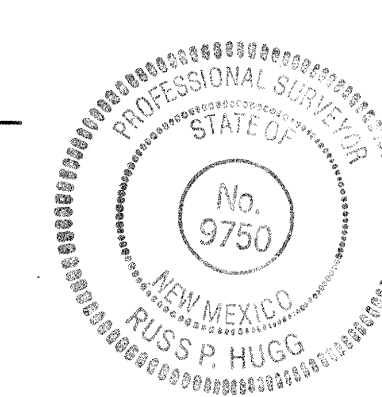

Bohannon & Huston

Courtyard 1 7500 Jefferson St. NE Albuquerque, NM 87109-4335
ENGINEERING • SPATIAL DATA • ADVANCED TECHNOLOGIES



CITY OF ALBUQUERQUE
PUBLIC WORKS DEPARTMENT
ENGINEERING DEVELOPMENT GROUP

WESTERN RIDGE (UNIT 2) SUBDIVISION AT VENTANA RANCH WEST
PAVING PLAN & PROFILE
MOSCA DR.

DESIGN REVIEW COMMITTEE	CITY ENGINEER APPROVAL	MO./DAY/YR.	MO./DAY/YR.
APPROVED MAR 1 3 2005 DESIGN REVIEW COMMITTEE	APPROVED SEP 2 6 2005 CITY ENGINEER		
LAST DESIGN UPDATE			

CITY PROJECT NO. 749486
ZONE MAP NO. B-8-Z
SHEET 25 OF 37

SCANNED BY PLU

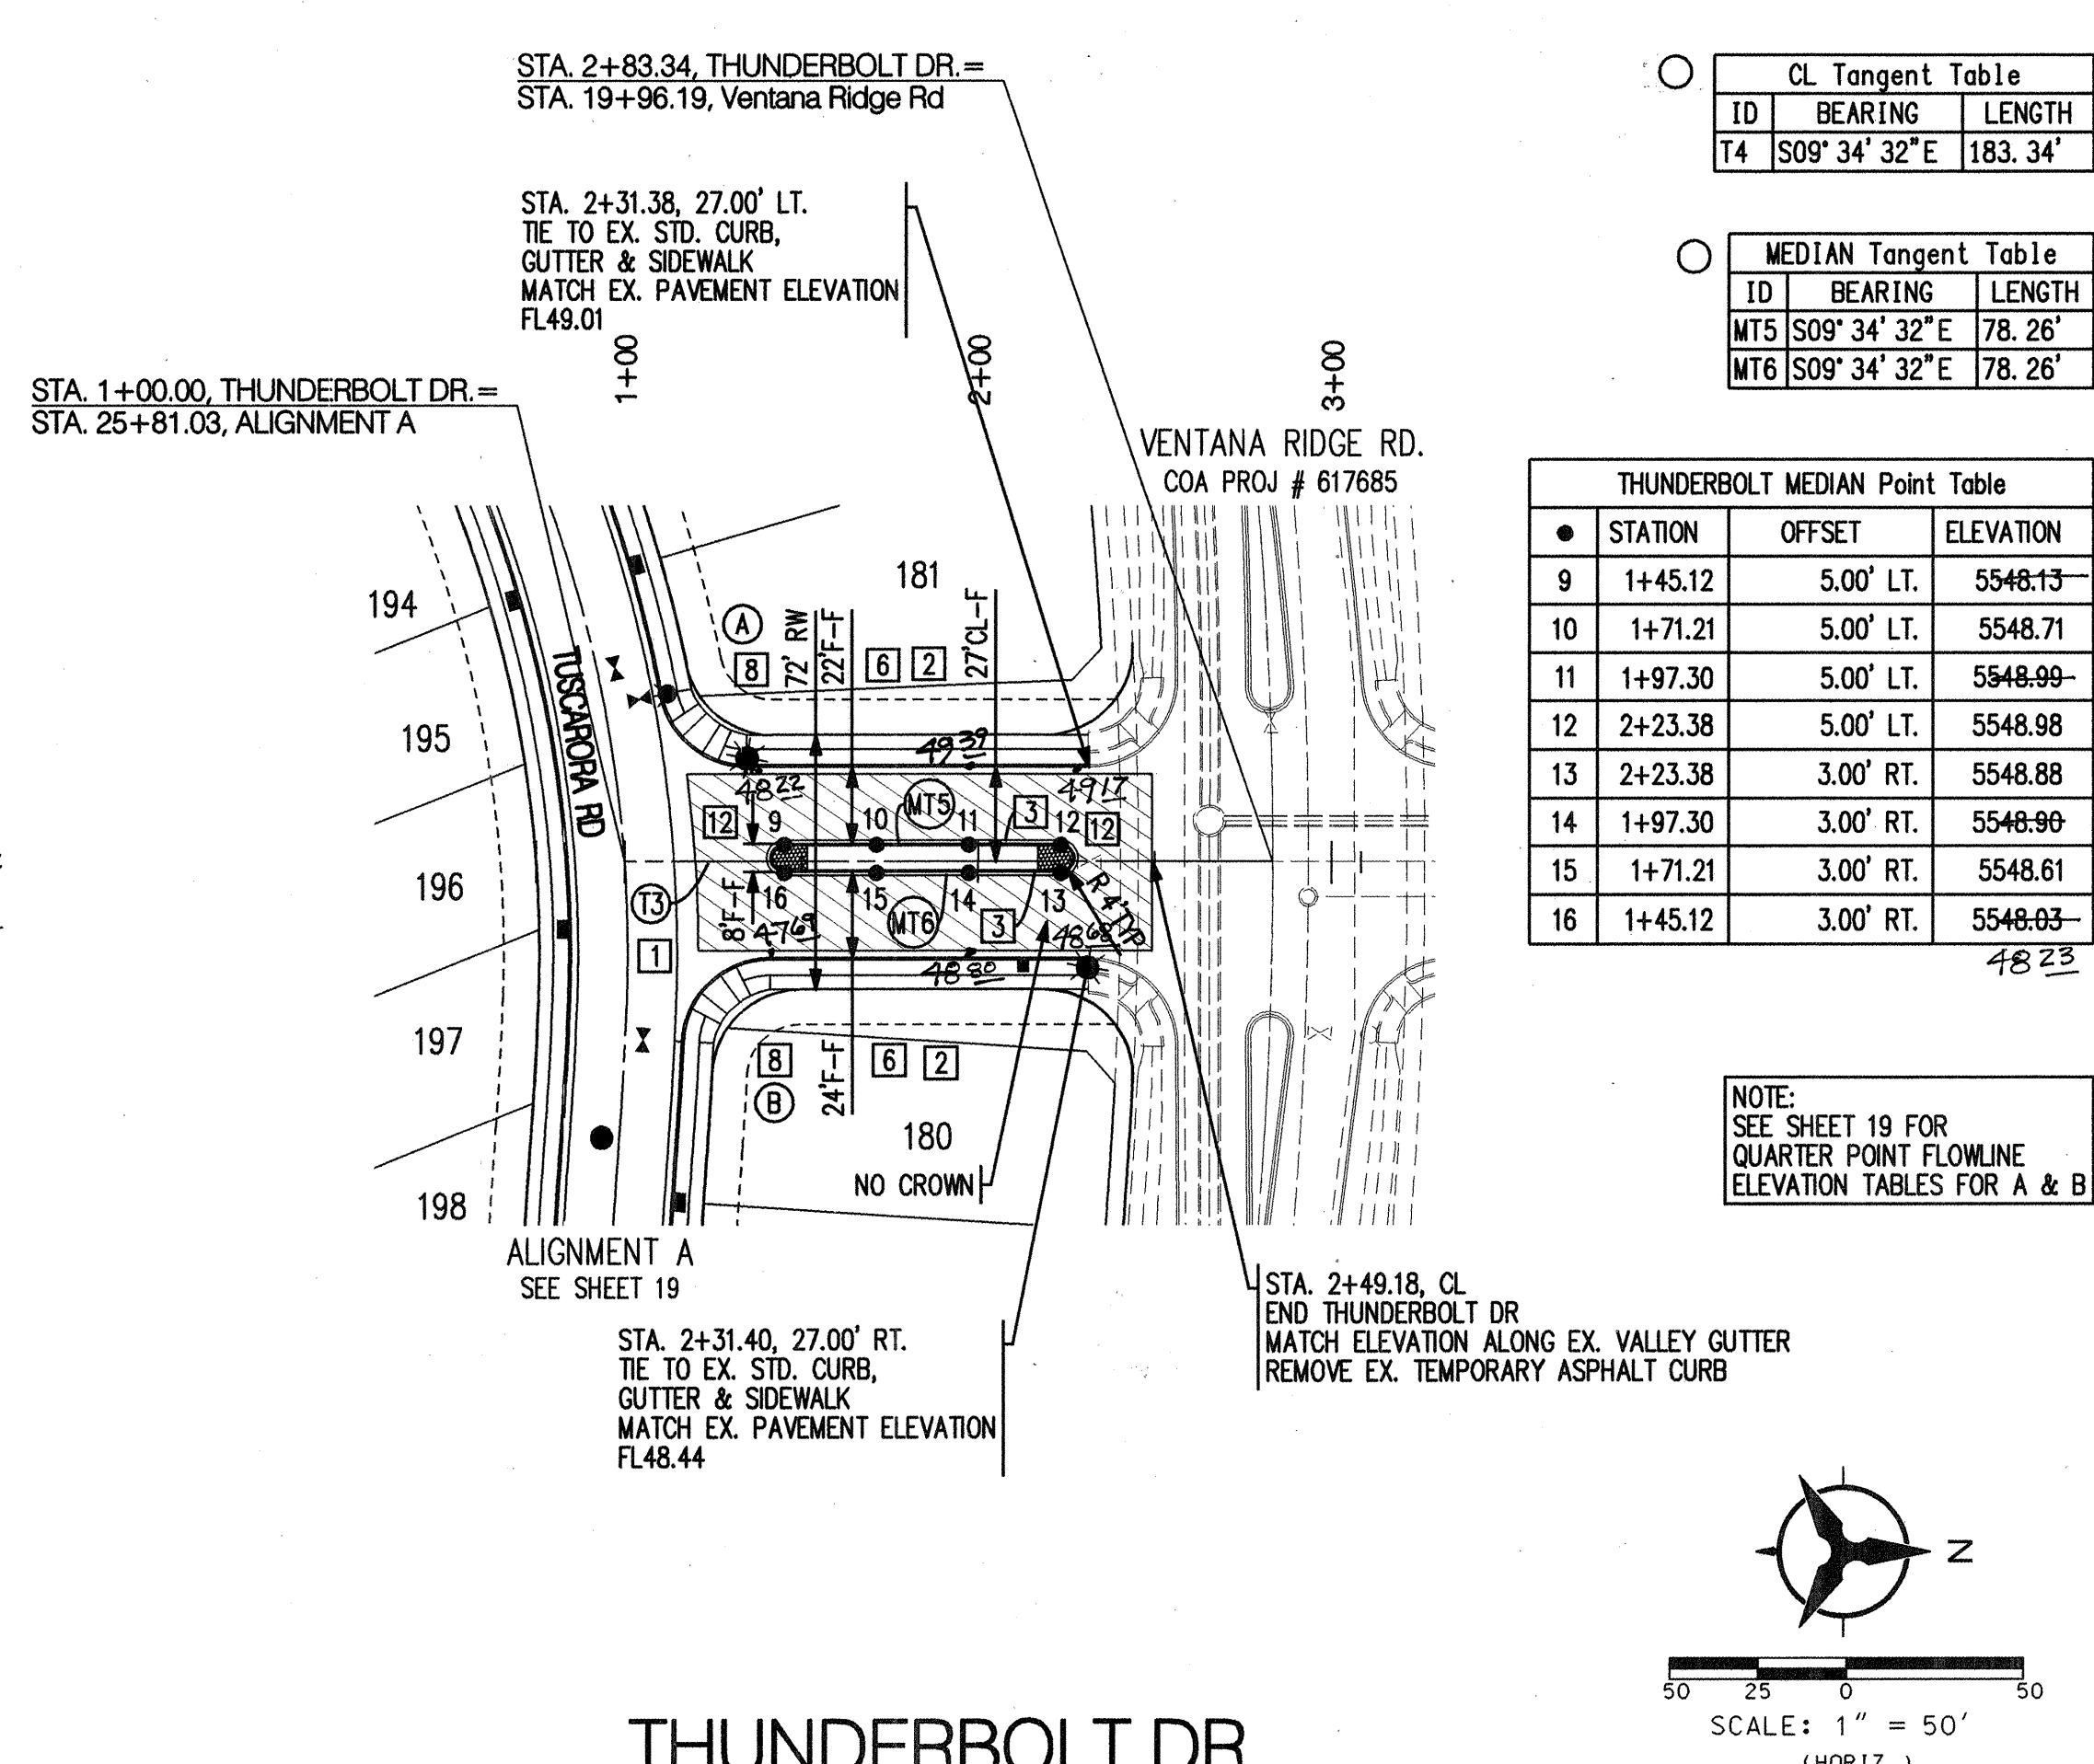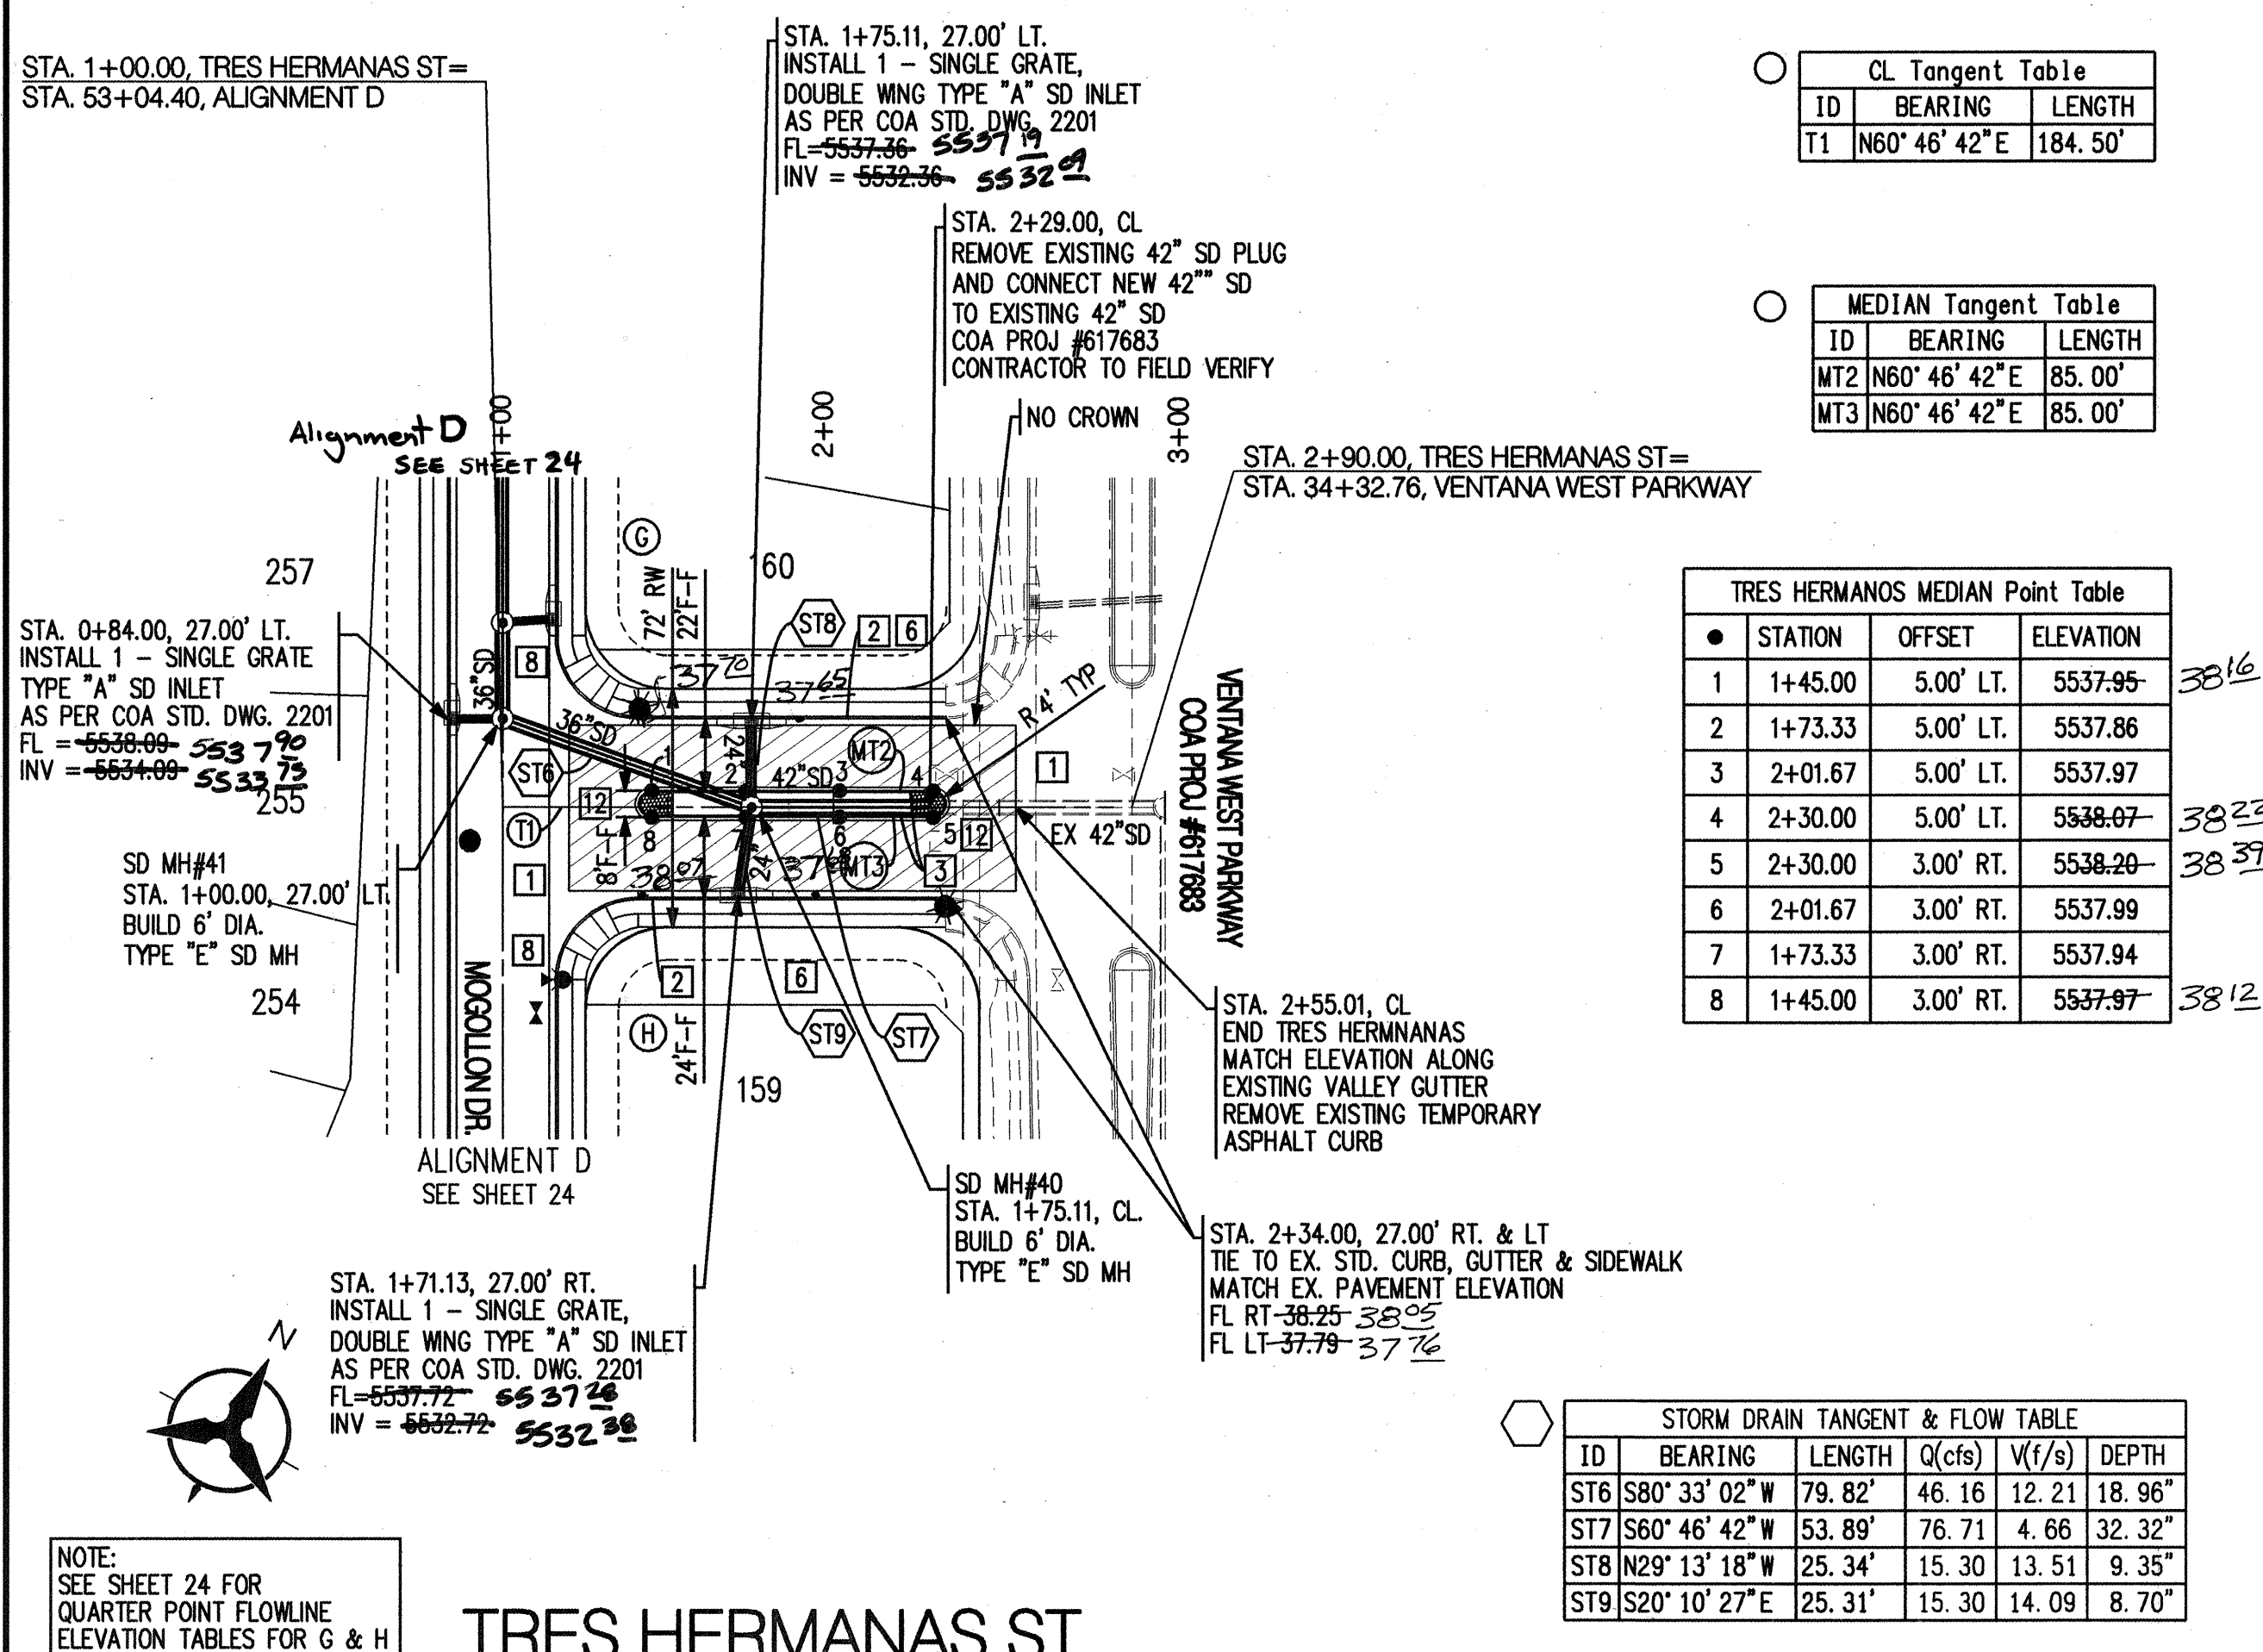

NOTES

- THE CONTRACTOR SHALL FIELD VERIFY ALL EXISTING UTILITY LOCATIONS AND NOTIFY THE ENGINEER IMMEDIATELY OF ANY DISCREPANCIES.
- ALL CURB RETURN RADII SHALL BE 25' UNLESS OTHERWISE SPECIFIED.
- ALL CURVE DATA AND DIMENSIONS REFER TO FACE OF CURB UNLESS OTHERWISE SPECIFIED.
- GRADE ELEVATIONS, WHERE NOTED, ARE ALONG FLOWLINE OF STANDARD CURB UNLESS OTHERWISE SPECIFIED.
- CONTRACTOR IS RESPONSIBLE FOR REPAIR AND/OR REPLACEMENT OF ALL UTILITY CONDUITS AND EXISTING LINES.
- ANY ADDITIONAL GRADING REQUIRED TO MATCH PROPOSED STREET GRADES SHALL BE INCIDENTAL TO PAVING ITEMS.
- CONTRACTOR SHALL PROVIDE THE INSPECTORS, (CITY AND PRIVATE) WITH THE PROPOSED HYDROSTATIC TESTING PLAN. THE PLAN MUST BE APPROVED BEFORE TESTING OPERATIONS BEGIN.
- CONTRACTOR SHALL PARK EQUIPMENT AND VEHICLES AS NOT TO INTERFERE WITH NORMAL ACTIVITIES OF RESIDENTS OR OTHER CONTRACTORS ON SITE.
- ANY DAMAGE TO THE EXISTING FACILITIES (CURB & GUTTER, PAVEMENT, CONDUITS, LANDSCAPING, UTILITY LINES, ETC.) DURING CONSTRUCTION SHALL BE REPLACED AT THE CONTRACTORS' EXPENSE.
- WHEELCHAIR RAMPS SHALL BE CONSTRUCTED PRIOR TO ACCEPTANCE OF CURB & GUTTER.
- ALL EXCAVATION, TRENCHING AND SHORING ACTIVITIES MUST BE CARRIED-OUT IN ACCORDANCE WITH OSHA 29 CFR 1926.650 SUBPART P.

KEYED NOTES

- INSTALL 6" CONCRETE VALLEY GUTTER AS PER STD. DWG. 2420
- STD. CURB & GUTTER AS PER STD. DWG. 2415 A
- MEDIAN CURB & GUTTER AS PER STD. DWG. 2415 B
- ROLL CURB & GUTTER AS PER STD. DWG. 2415 A
- DEFERRED 4' SIDEWALK
- BUILD 4' SIDEWALK AS PER STD. DWG. 2430
- BUILD 8' ASPHALT TRAIL AS PER DETAIL SHEET 18
- BUILD WHEELCHAIR RAMP AS PER DETAIL "A" SHEET 18
- BUILD WHEELCHAIR RAMP AS PER DETAIL "B" SHEET 18
- BUILD WHEELCHAIR RAMP AS PER DETAIL "C" SHEET 18
- INSTALL 12" CONCRETE VALLEY GUTTER AS PER STD. DWG. 2422
- BUILD 4" TEXTURED MEDIAN PAVEMENT FROM MEDIAN NOSE TO 10' FROM NOSE (BAJA RED) MEDIAN NOSES SHALL BE PAINTED YELLOW TO APPROX. 6' BEHIND PC/PT PER COA STD. DWG. 2408

Bohannon & Huston

Courtyard I 7500 Jefferson St. NE Albuquerque, NM 87109-4335

ENGINEERING • SPATIAL DATA • ADVANCED TECHNOLOGIES

CITY OF ALBUQUERQUE

PUBLIC WORKS DEPARTMENT

ENGINEERING DEVELOPMENT GROUP

WESTERN RIDGE (UNIT 2) SUBDIVISION AT VENTANA RANCH WEST

PLAN & PROFILE

TRES HERMANAS ST / THUNDERBOLT DR

DESIGN REVIEW COMMITTEE	CITY ENGINEER APPROVAL	MO./DAY/YR.	MO./DAY/YR.
APPROVED MAR 18 2005	APPROVED SEP 26 2005		

LAST DESIGN UPDATE

CITY PROJECT NO. 749486



ZONE MAP NO. B-8-Z

SHEET 26 OF 37

SCANNED
BY: *plw*

Point Table			
	NORTHING	EASTING	ELEVATION
1	1527872.83	350431.68	5543.46
2	1527875.75	350461.00	5543.20
3	1527848.50	350501.86	5543.00
4	1527821.26	350542.45	5542.71
5	1527795.61	350582.31	5542.37
6	1527813.12	350609.42	5541.99
7	1527836.16	350596.09	5541.83
8	1527864.00	350588.16	5541.85
9	1527870.95	350587.97	5541.81
10	1527914.00	350609.18	5541.35
11	1527927.53	350638.79	5541.13
12	1527958.03	350629.12	5541.13
13	1527922.74	350567.75	5541.65
14	1527911.16	350540.36	5542.28
15	1527907.02	350524.16	5542.56
16	1527903.84	350495.38	5542.93
17	1527904.13	350425.02	5543.46
18	1527882.85	350554.37	5542.32
19	1527886.25	350543.21	5542.44
20	1527880.39	350529.07	5542.63
21	1527876.28	350525.91	5542.68
22	1527866.25	350523.21	5542.73
23	1527852.11	350529.07	5542.67
24	1527846.25	350543.21	5542.58
25	1527852.11	350557.36	5542.42
26	1527854.01	350559.03	5542.38
27	1527866.25	350563.21	5542.24
28	1527880.39	350557.36	5542.28

CURB Curve Table				
ID	ARC	RADIUS	DELTA	TANGENT
C1	29.47'	45.00'	37°31'34"	15.29'
C2	16.83'	45.00'	21°25'22"	8.51'
C3	30.30'	45.00'	38°34'45"	15.75'
C4	50.62'	45.00'	64°27'02"	28.37'
C5	6.96'	45.00'	08°51'37"	3.49'
C6	29.47'	45.00'	37°31'34"	15.29'
C7	49.92'	45.00'	63°33'45"	27.88'
C8	51.68'	45.00'	65°47'43"	29.11'
C9	51.95'	45.00'	66°08'40"	29.30'

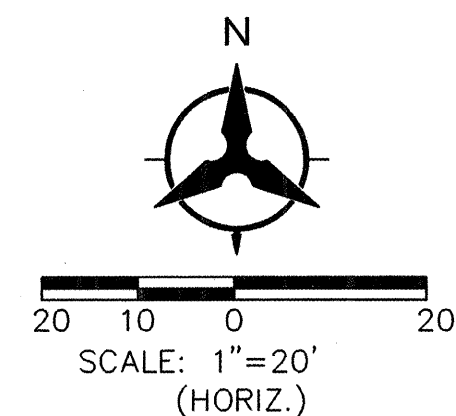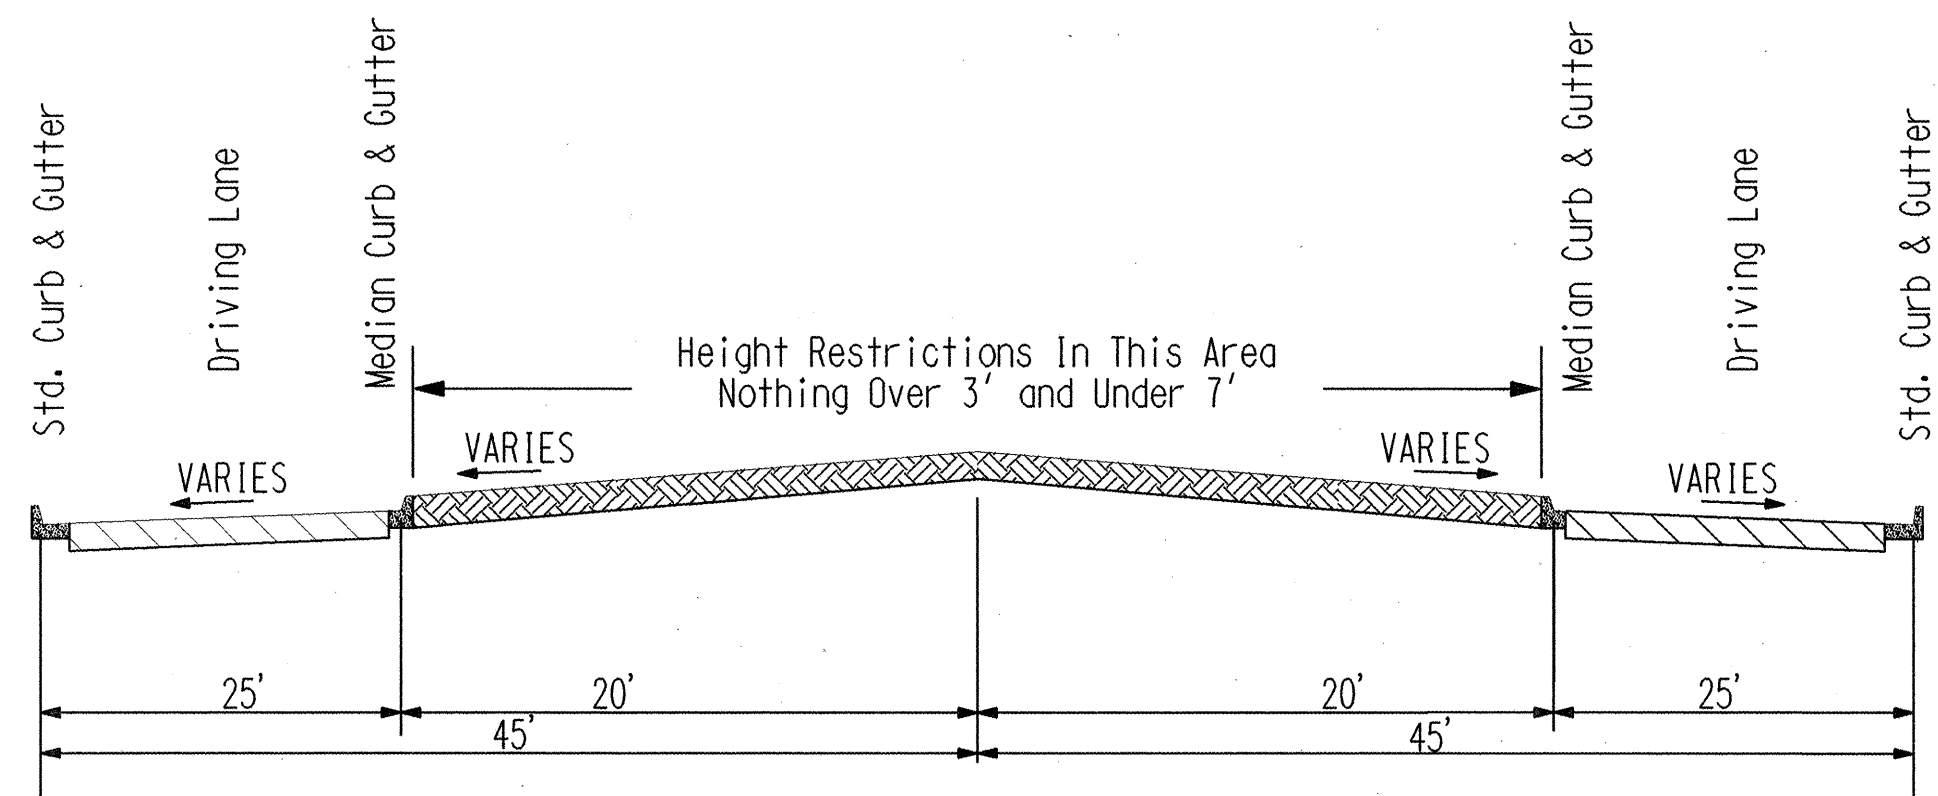

KEYED NOTES

1. INSTALL 6" CONCRETE VALLEY GUTTER AS PER STD. DWG. 2420
2. STD. CURB & GUTTER AS PER STD. DWG. 2415 A
3. MEDIAN CURB & GUTTER AS PER STD DWG. 2415 B
4. ROLL CURB & GUTTER AS PER STD. DWG. 2415 A
5. DEFERRED 4' SIDEWALK
6. BUILD 4' SIDEWALK AS PER STD. DWG. 2430
7. BUILD 8' ASPHALT TRAIL AS PER DETAIL SHEET 18
8. BUILD WHEELCHAIR RAMP AS PER DETAIL "A" SHEET 18
9. BUILD WHEELCHAIR RAMP AS PER DETAIL "B" SHEET 18
10. BUILD WHEELCHAIR RAMP AS PER DETAIL "C" SHEET 18
11. INSTALL 12" CONCRETE VALLEY GUTTER AS PER STD. DWG. 2422
12. BUILD 4" TEXTURED MEDIAN PAVEMENT FROM MEDIAN NOSE TO 10' FROM NOSE (BAJA RED) MEDIAN NOSES SHALL BE PAINTED YELLOW TO APPROX. 6' BEHIND PC/PT PER COA STD. DWG. 2408

TUSCARORA RD / OSCURA ST - ROUNDABOUT

SURVEYORS CERTIFICATION

I, Russ P. Hugg, New Mexico Professional Surveyor Number 9750, Hereby Certify that the as-built information shown hereon is the result of an actual field survey performed by me or under my direct supervision and that the same is true and correct to the best of my knowledge and belief.

Russ P. Hugg
1.27.2006
Russ P. Hugg
NMPS No. 9750



NOTE:
PROPOSED CONTOURS SHOWN FOR REFERENCE ONLY.
CONTOUR INTERVAL 0.1'.

AS-BUILT INFORMATION	BENCH MARKS	SURVEY INFORMATION	ENGINEER'S SEAL
CONTRACTOR: <i>SAUL BDO</i>	ACS BRASS TABLET STAMPED "2-BIO 1980"	FIELD NOTES	
INSPECTED BY: <i>SAUL BDO</i>	GEOGRAPHIC POSITION (NAD 1927)	DATE	
ACCEPTANCE BY: <i>SEC</i>	(CENTRAL ZONE)	NO.	REVISIONS
DATE: <i>11/6/06</i>		BY	DESIGN
VERIFIED BY: <i>SAUL BDO</i>			DATE NOV 04
DRAWN BY: <i>SAUL BDO</i>			DATE NOV 04
CHECKED BY: <i>SAUL BDO</i>			DATE NOV 04
RECORDED BY: <i>SAUL BDO</i>			
NO. 1925 ELEVATION = 5429.35			




Bohannon & Huston Courtney 7500 Jefferson St. NE Albuquerque, NM 87109-4335 ENGINEERING & SPATIAL DATA & ADVANCED TECHNOLOGIES	
CITY OF ALBUQUERQUE PUBLIC WORKS DEPARTMENT ENGINEERING DEVELOPMENT GROUP	
WESTERN RIDGE (UNIT 2) SUBDIVISION AT VENTANA RANCH WEST MOGOLLON DR / OSCURA ST / TUSCARORA RD - ROUNDABOUT	
DESIGN REVIEW COMMITTEE 	CITY ENGINEER APPROVAL
MO. / DAY / YR.	MO. / DAY / YR.
CITY PROJECT NO. 749486	ZONE MAP NO. B-8-Z
SHEET 27	OF 34

SCANNED BY *PLA*

SCANNED BY *PLA*

Point Table			
	EASTING	NORTHING	ELEVATION
1	351028.44	1527653.46	5543.61
2	351091.50	1527675.67	5542.87
3	351117.68	1527690.18	5542.85
4	351122.17	1527694.58	5542.81
5	351137.66	1527723.48	5542.28
6	351170.23	1527727.56	5542.26
7	351183.21	1527692.10	5543.26
8	351192.41	1527678.75	5543.60
9	351213.05	1527657.07	5544.04
10	351217.79	1527617.02	5544.44
11	351171.72	1527620.21	5544.20
12	351119.91	1527628.13	5543.77
13	351074.99	1527638.87	5543.30
14	351151.35	1527680.33	5543.69
15	351152.16	1527680.31	5543.71
16	351165.49	1527674.47	5543.78
17	351171.35	1527660.33	5543.94
18	351170.89	1527656.07	5543.99
19	351165.49	1527646.19	5544.05
20	351151.35	1527640.33	5543.94
21	351137.21	1527646.19	5543.82
22	351131.35	1527660.33	5543.68
23	351131.44	1527662.25	5543.65
24	351137.21	1527674.47	5543.55
25	350540.36	1527911.16	5542.28

CURB Curve Table				
ID	ARC	RADIUS	DELTA	TANGENT
C1	30.52'	45.00'	38°51'22"	15.87'
C2	6.29'	45.00'	08°00'33"	3.15'
C3	33.56'	45.00'	42°43'44"	17.60'
C4	38.97'	45.00'	49°36'48"	20.80'
C5	16.30'	45.00'	20°45'11"	8.24'
C6	30.52'	45.00'	38°51'22"	15.87'
C7	48.50'	45.00'	61°44'55"	26.90'
C8	55.95'	45.00'	71°14'00"	32.24'
C9	48.50'	45.00'	61°44'55"	26.90'
C10	67.18'	196.00'	19°38'21"	33.92'

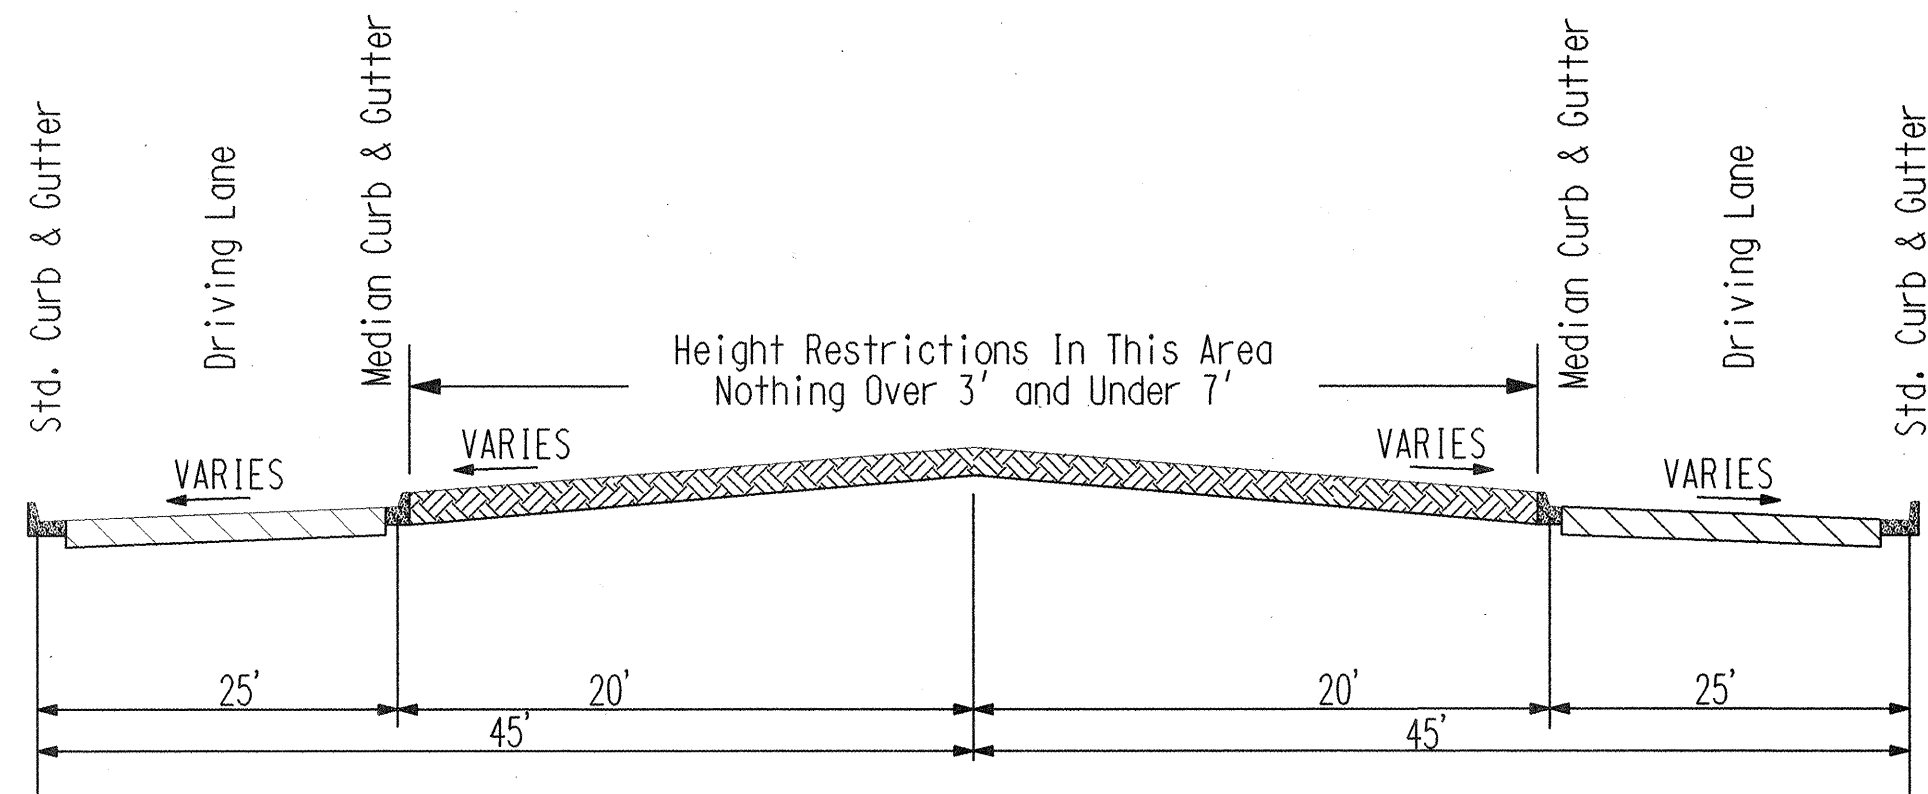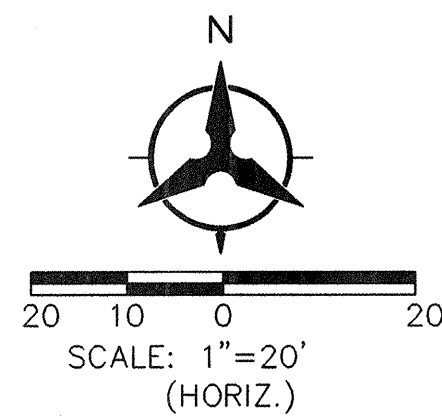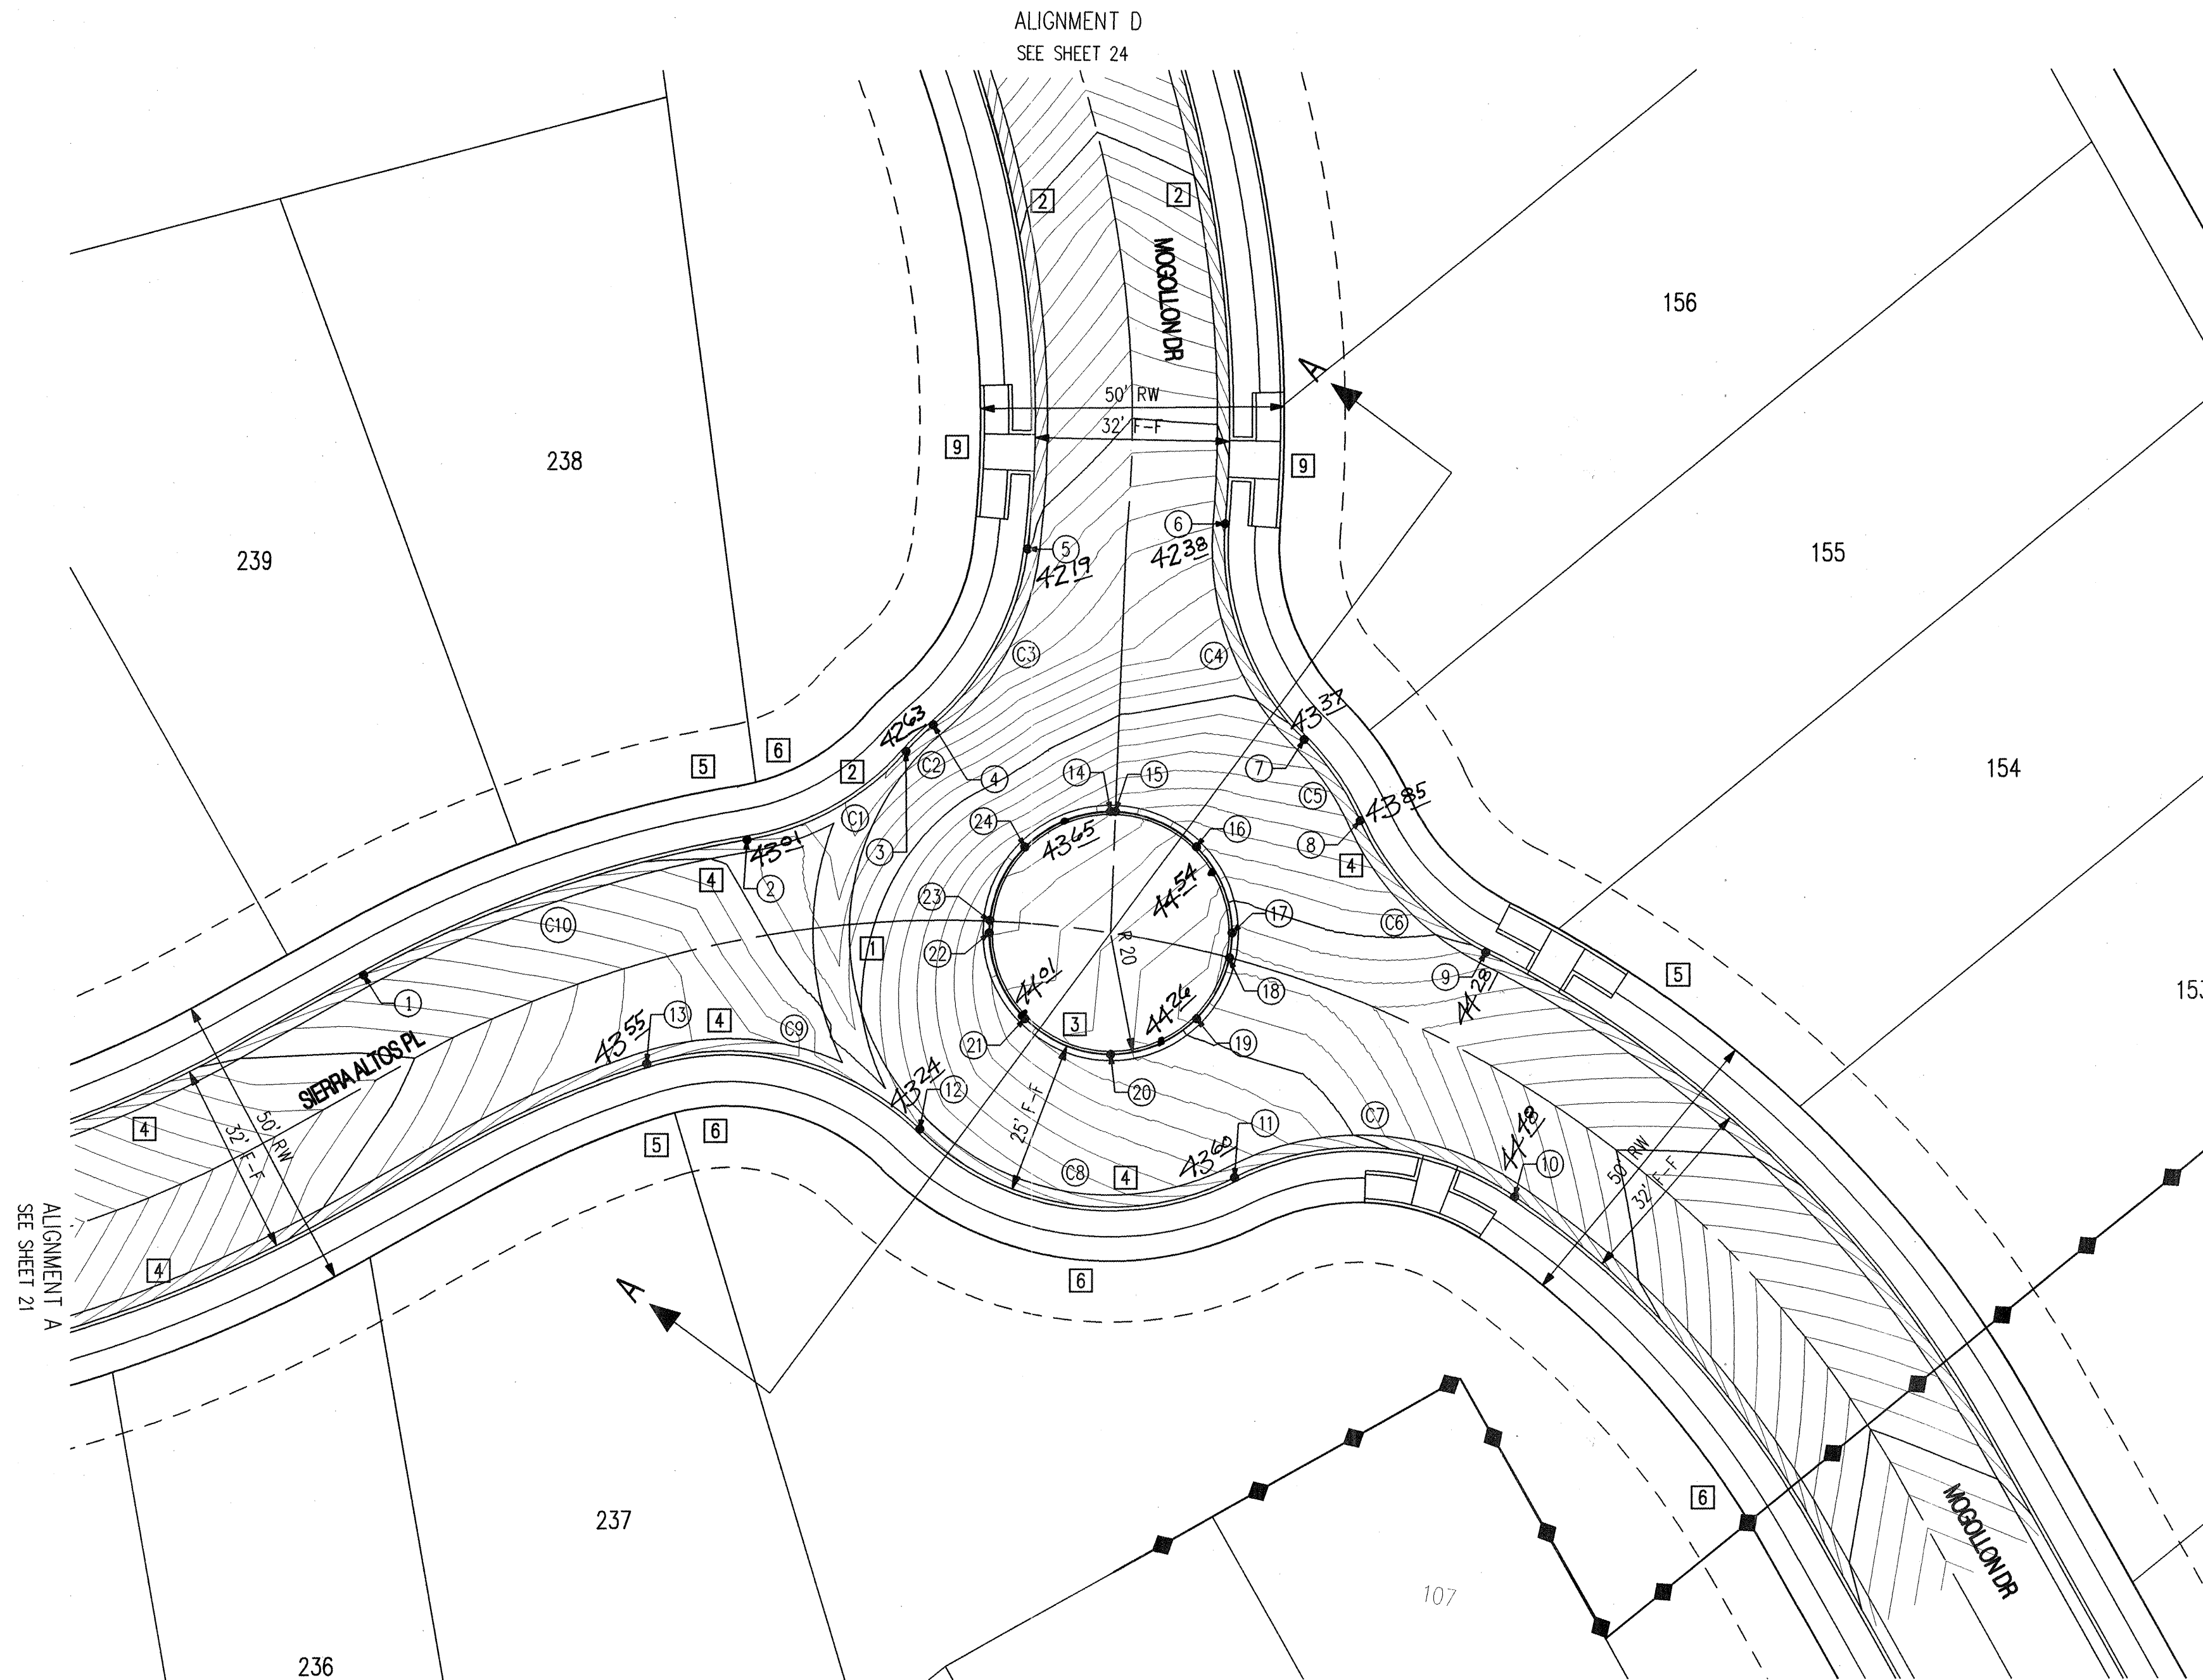


SECTION A-A
NOT TO SCALE

SIERRA ALTOS PL / MOGOLLON DR - ROUNDABOUT

SURVEYORS CERTIFICATION

I, Russ P. Hugg, New Mexico Professional Surveyor Number 9750, Hereby Certify that the as-built information shown hereon is the result of an actual field survey performed by me or under my direct supervision and that the same is true and correct to the best of my knowledge and belief.

Russ P. Hugg
N.M.S.P. No. 9750
1.27.2006

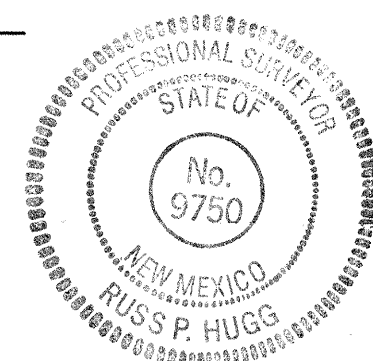

NOTE:
PROPOSED CONTOURS SHOWN FOR REFERENCE ONLY.
CONTOUR INTERVAL 0.1'.

- ### KEYED NOTES
1. INSTALL 6" CONCRETE VALLEY GUTTER AS PER STD. DWG. 2420
 2. STD. CURB & GUTTER AS PER STD. DWG. 2415 A
 3. MEDIAN CURB & GUTTER AS PER STD. DWG. 2415 B
 4. ROLL CURB & GUTTER AS PER STD. DWG. 2415 A
 5. DEFERRED 4' SIDEWALK
 6. BUILD 4' SIDEWALK AS PER STD. DWG. 2430
 7. BUILD 8' ASPHALT TRAIL AS PER DETAIL SHEET 18
 8. BUILD WHEELCHAIR RAMP AS PER DETAIL "A" SHEET 18
 9. BUILD WHEELCHAIR RAMP AS PER DETAIL "B" SHEET 18
 10. BUILD WHEELCHAIR RAMP AS PER DETAIL "C" SHEET 18
 11. INSTALL 12" CONCRETE VALLEY GUTTER AS PER STD. DWG. 2422
 12. BUILD 4" TEXTURED MEDIAN PAVEMENT FROM MEDIAN NOSE TO 10' FROM NOSE (BAJA RED) MEDIAN NOSES SHALL BE PAINTED YELLOW TO APPROX. 6' BEHIND PC/PT PER COA STD. DWG. 2408

Bohannon & Huston

Courtyard I 7500 Jefferson St. NE Albuquerque, NM 87109-4335
ENGINEERING • SPATIAL DATA • ADVANCED TECHNOLOGIES


CITY OF ALBUQUERQUE
PUBLIC WORKS DEPARTMENT
ENGINEERING DEVELOPMENT GROUP

WESTERN RIDGE (UNIT 2) SUBDIVISION AT VENTANA RANCH WEST
SIERRA ALTOS PL / MOGOLLON DR - ROUNDABOUT

DESIGN REVIEW COMMITTEE	CITY ENGINEER APPROVAL	MO./DAY/YR.	MO./DAY/YR.
APPROVED MAR 18 2005	APPROVED SEP 26 2005 CITY ENGINEER		
LAST DESIGN UPDATE			

CITY PROJECT NO.	ZONE MAP NO.	SHEET	OF
749486	B-8-Z	28	34


AS-BUILT INFORMATION		BENCH MARKS		SURVEY INFORMATION		ENGINEER'S SEAL	
CONTRACTOR	SALES PRO	ACS BRASS	TABLE STAMPED 2-B10 1980"	FIELD NOTES	NO.	NO.	NO.
WORK	SALES PRO	GEOGRAPHIC POSITION	(NAD 1927)	BY	DATE	BY	DATE
ACCEPTANCE	SALES PRO	(CENTRAL ZONE)					
DATE	11/16						
FIELD VERIFICATION	BY SURV. TEL. DATE 11/16						
CORRECTED BY	SALES PRO						
MICRO-FILM INFORMATION							
RECORDED BY							
NO.							

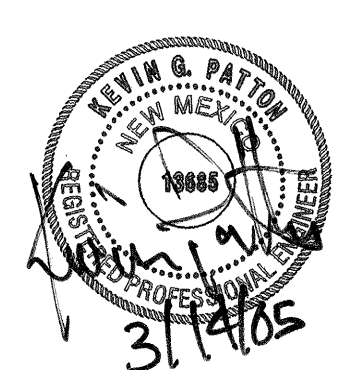


REVISIONS			
DESIGN			
NO.	DATE	REMARKS	BY

SCANNED
BY: [initials]

SCANNED
BY: [initials]

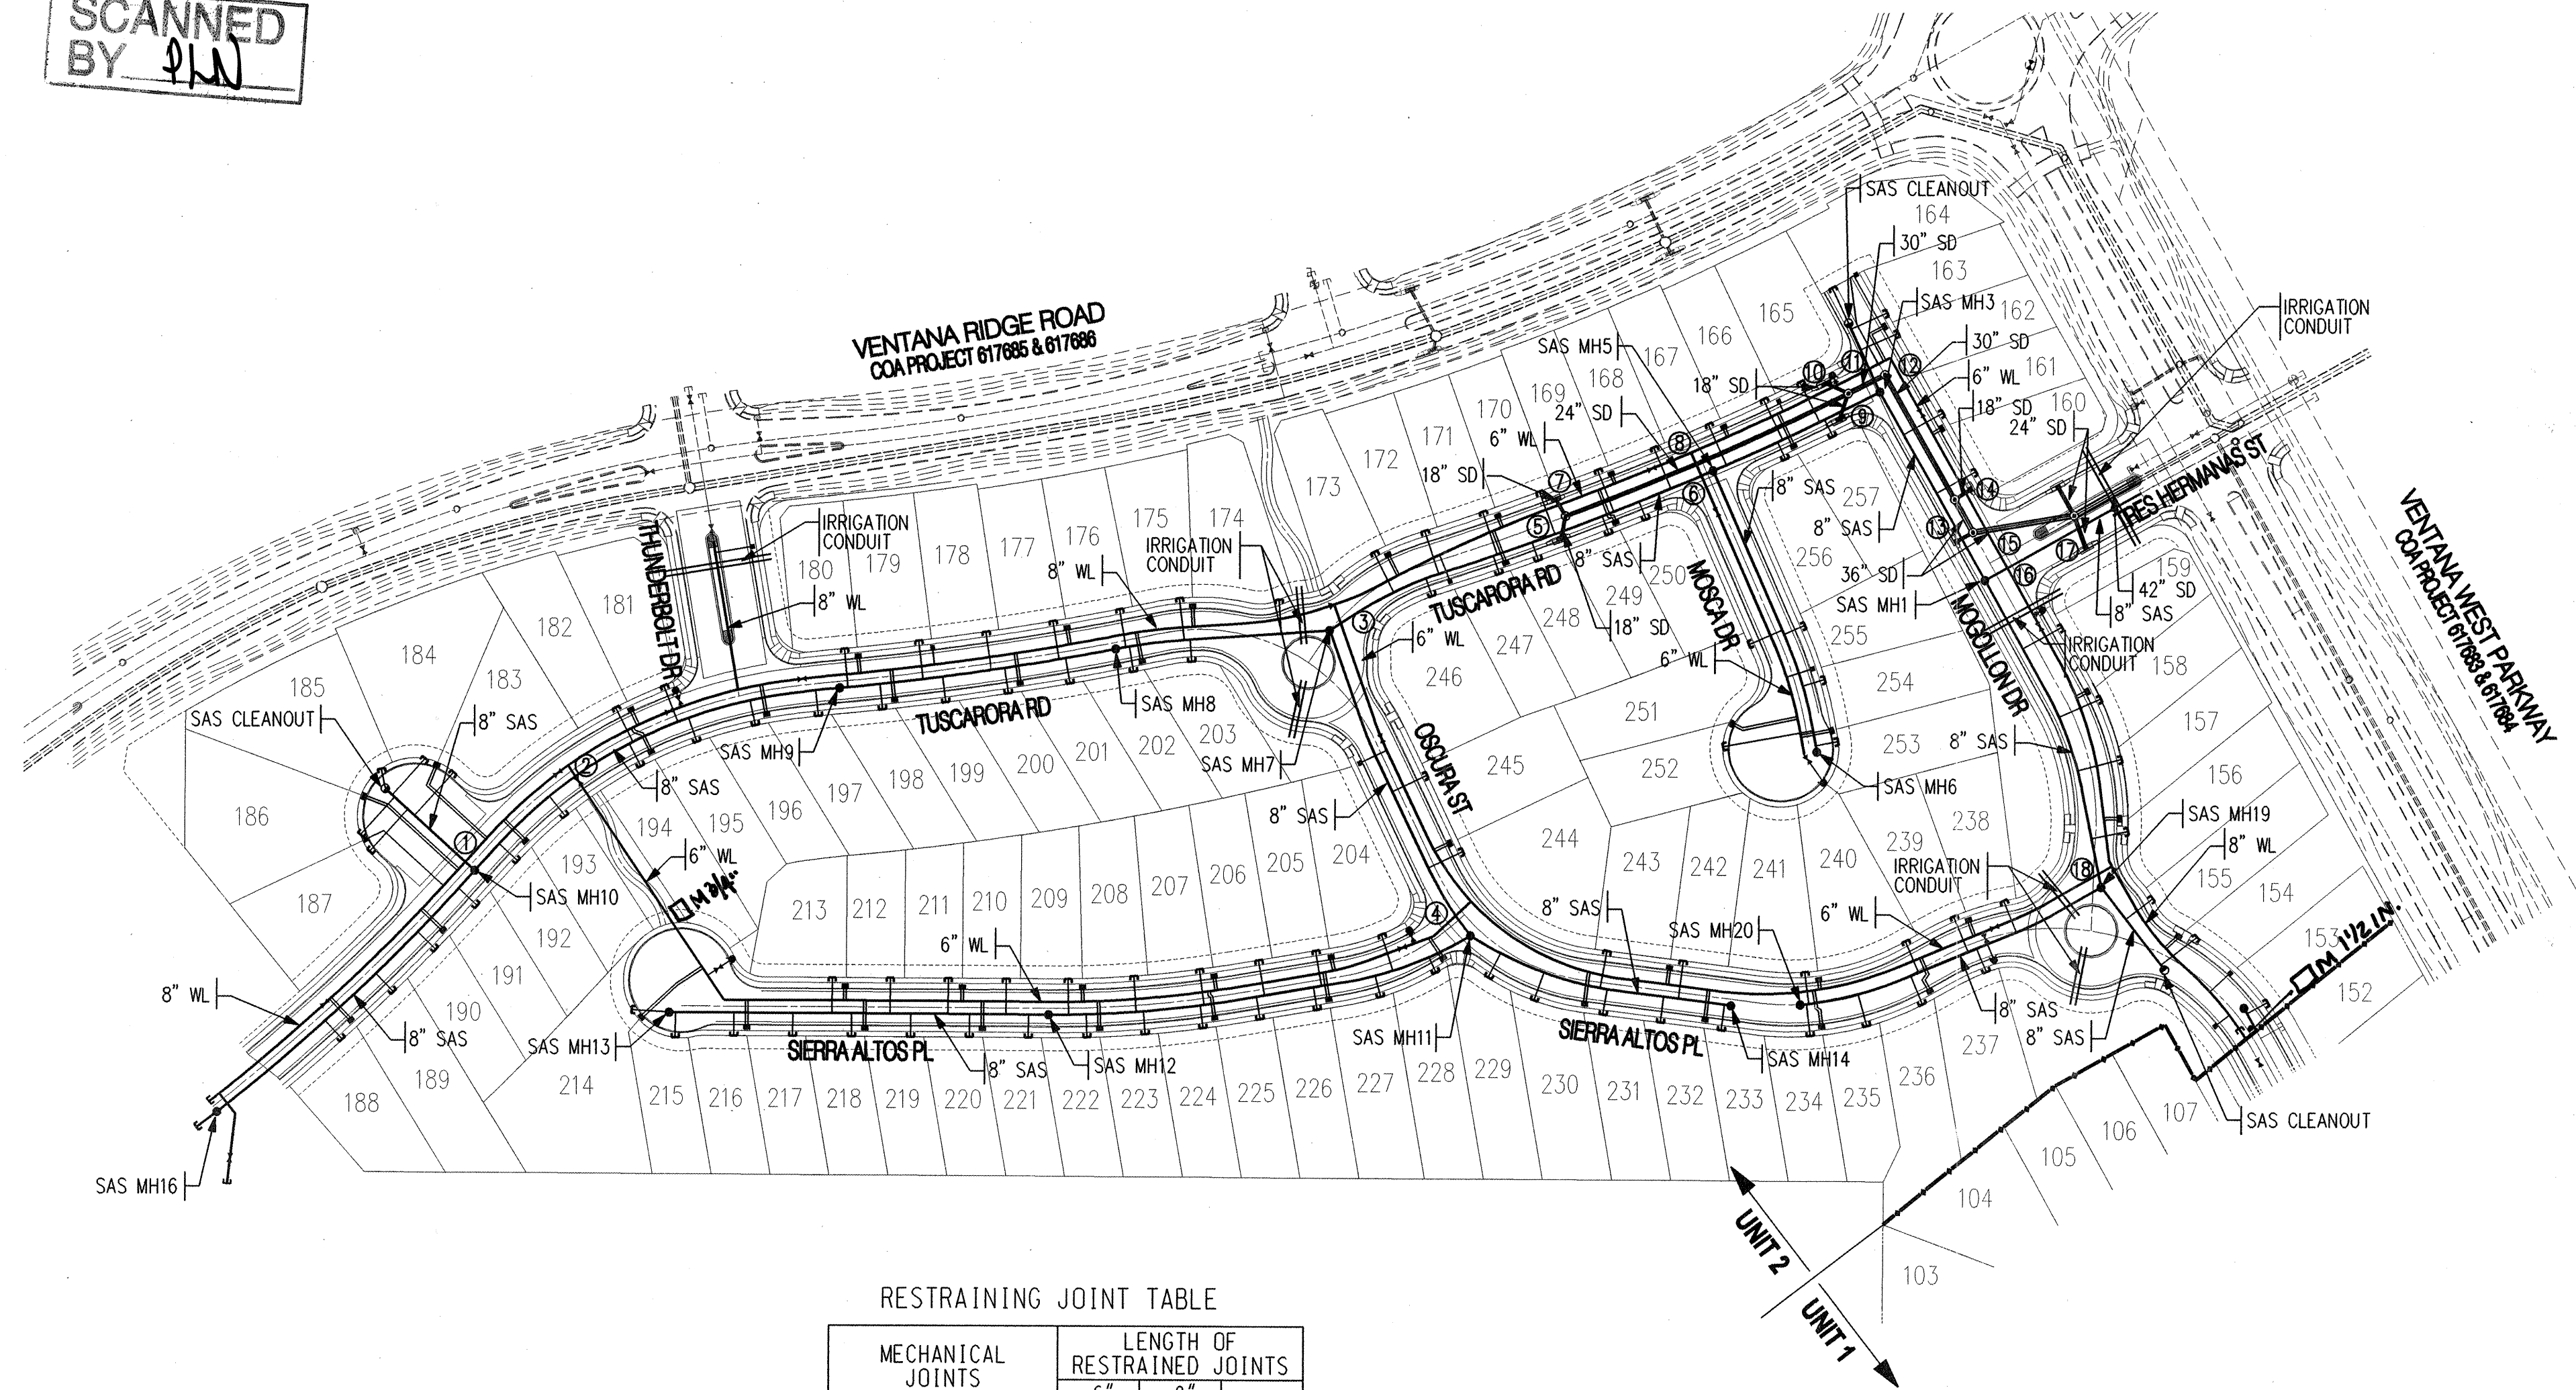

DES	SAS	Crossings		Clearance
		SD	WL	
1	8" TP 43.29	---	8" BP 45.84	2.55
2	8" TP 41.79	---	6" BP 44.44	2.65
3	8" TP 34.44	---	6" BP 37.37	2.93
4	8" TP 36.42	---	6" BP 39.19	2.77
5	8" TP 33.21	18" BP 36.26	---	3.05
6	8" TP 32.44	---	6" BP 33.88	1.43
7	---	18" BP 36.55	6" TP 35.55	1.00
8	---	24" BP 34.98	6" TP 33.82	1.16
9	8" TP 31.57	18" BP 35.13	---	3.56
10	---	18" BP 35.15	6" TP 33.75	1.40
11	8" TP 31.43	---	6" BP 33.50	2.08
12	8" TP 31.37	30" BP 32.97	---	1.60
13	8" TP 30.45	18" BP 33.49	---	3.04
14	---	18" BP 33.79	6" TP 32.16	1.62
15	---	36" BP 31.04	6" TP 29.63	1.41
16	8" TP 30.01	---	6" BP 33.46	3.45
17	8" TP 29.57	24" BP 31.56	---	2.00
18	8" TP 35.93	---	6" BP 38.31	2.39




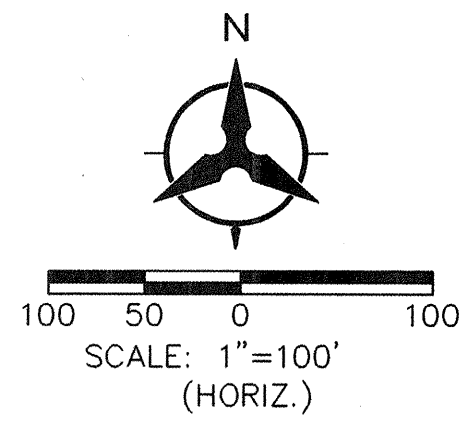


RESTRAINING JOINT TABLE

MECHANICAL JOINTS	LENGTH OF RESTRAINED JOINTS	
	6"	8"
6" X 6" TEE	1	-
8" X 6" TEE	1	1
8" X 8" CROSS	-	1
8" X 6" REDUCER	-	30
90° HORIZ. BEND	20	26
45° HORIZ. BEND	8	11
22.5° HORIZ. BEND	4	5
11.25° HORIZ. BEND	2	3
GATE VALVE/CAP	55	72
22.5° VERT. BEND	-	14
UPPER	-	2
LOWER	-	2


LEGEND

- PROPOSED STORM DRAIN MANHOLE
- PROPOSED SANITARY SEWER MANHOLE
- PROPOSED SANITARY SEWER CLEANOUT
- EXISTING SANITARY SEWER MANHOLE
- PROPOSED FIRE HYDRANT
- EXISTING FIRE HYDRANT
- PROPOSED GATE VALVE
- EXISTING GATE VALVE
- PROPOSED SANITARY SEWER LINE
- EXISTING SANITARY SEWER LINE
- PROPOSED WATER LINE
- EXISTING WATER LINE
- PROPOSED SANITARY SEWER SERVICE
- PROPOSED STORM DRAIN LINE
- EXISTING STORM DRAIN LINE
- PROPOSED WATER METER SERVICE
- PROPOSED STREET LIGHT

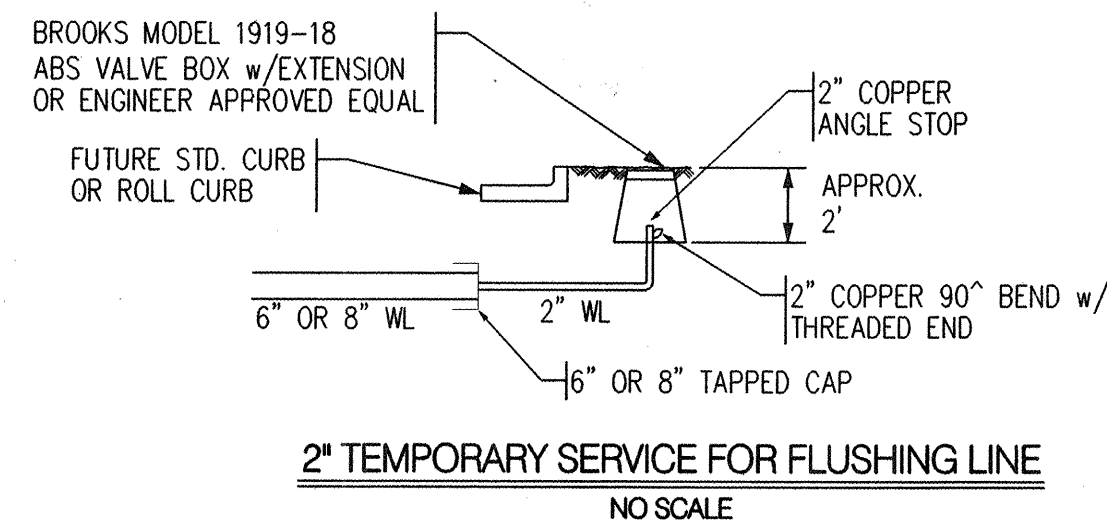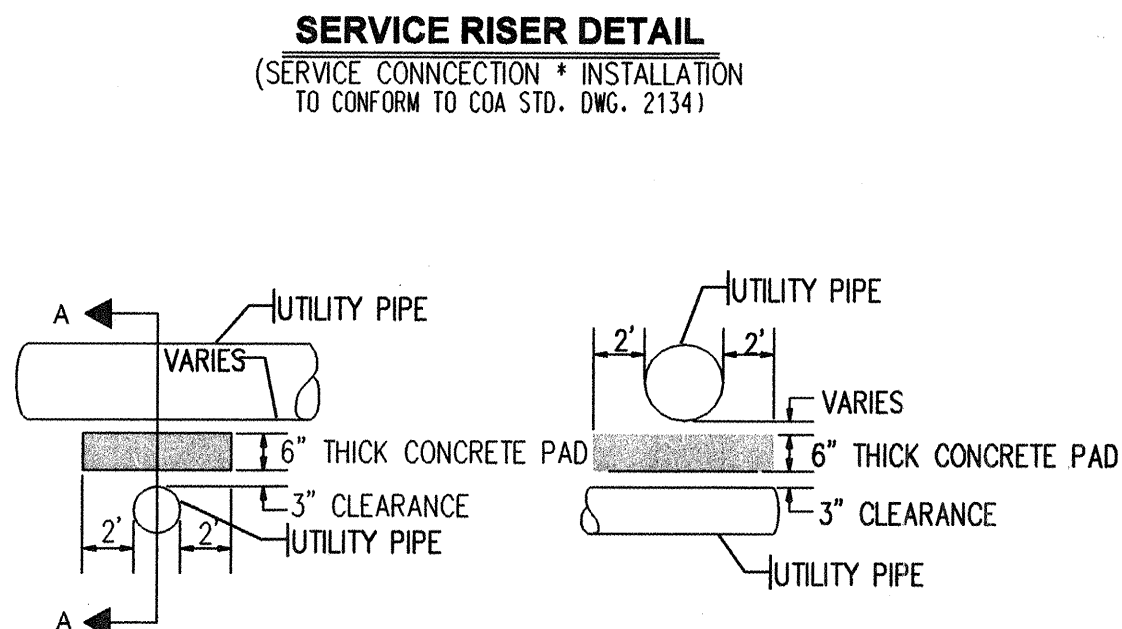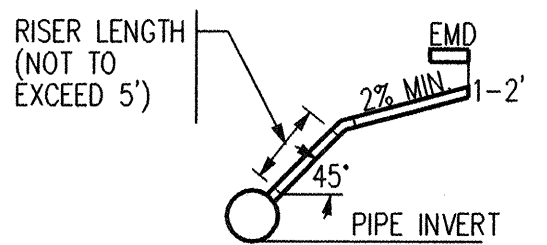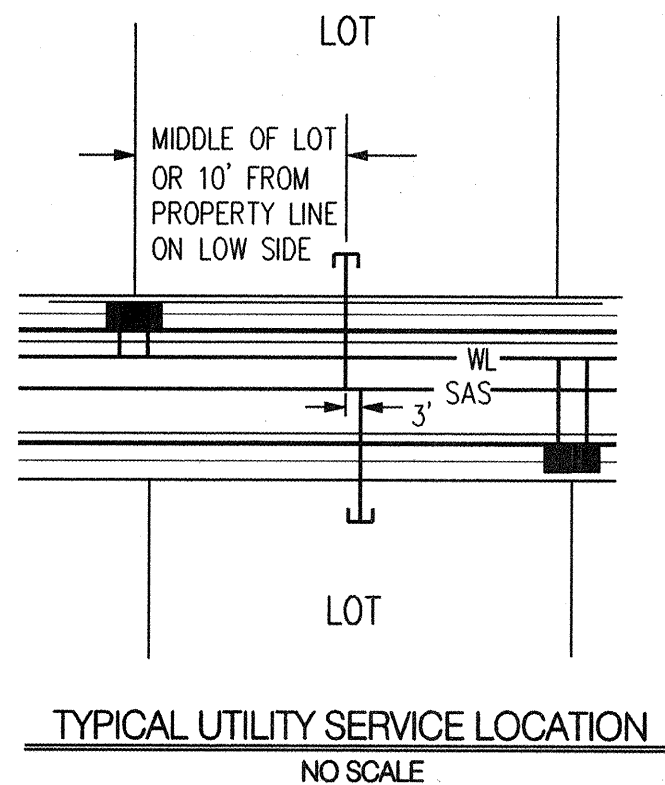

NOTE:

- ALL MECHANICAL JOINTS SHALL BE RESTRAINED AT THE FITTING.
- THE CONTRACTOR SHALL PROVIDE A MINIMUM PIPE LENGTH OF 20 LF FROM ALL MECHANICAL JOINTS. ALL PIPE POINTS WITHIN 20 LF OF MJ SHALL BE RESTRAINED AT THE CONTRACTOR'S EXPENSE.
- THE CONTRACTOR SHALL RESTRAIN ALL PIPE JOINTS IN THE SPECIFIED DISTANCE LISTED IN THE TABLE ABOVE. (SEE NOTE 2 ABOVE).
- THE CONTRACTOR SHALL RESTRAIN ALL FIRE HYDRANTS JOINTS FROM THE TEE ON THE MAIN TO THE FIRE HYDRANT FLANGE.
- ALL CAPS SHALL UTILIZE PCC BLOCKING, UNLESS OTHERWISE NOTED.
- RESTRAINED LENGTH IN ON LARGE SIDE ON ALL REDUCERS
- RESTRAIN ALL JOINTS BETWEEN UPPER AND LOWER VERTICAL BENDS.
- ALL LENGTHS ARE MEASURED IN FEET.

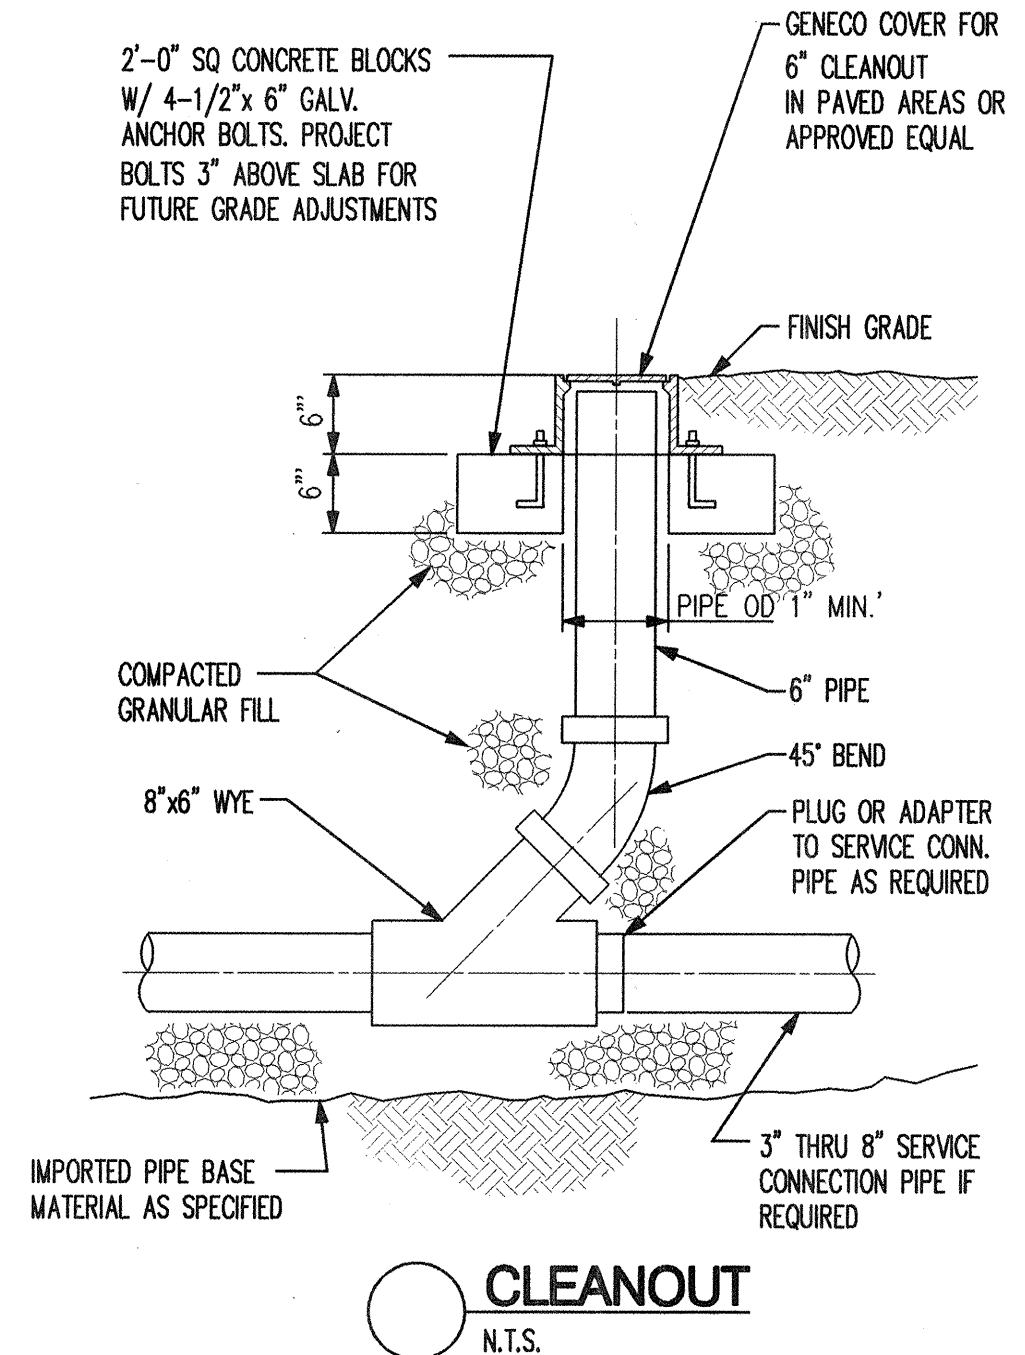

APPROVED: [Signature] 3-14-05
DATE


Bohannon & Huston
Courtney | 7500 Jefferson St. NE Albuquerque, NM 87109-4335
ENGINEERING • SPATIAL DATA • ADVANCED TECHNOLOGIES

CITY OF ALBUQUERQUE
PUBLIC WORKS DEPARTMENT
ENGINEERING DEVELOPMENT GROUP

WESTERN RIDGE (UNIT 2) SUBDIVISION AT VENTANA RANCH WEST
OVERALL UTILITY PLAN

DESIGN REVIEW COMMITTEE	CITY ENGINEER APPROVAL	MO./DAY/YR.	MO./DAY/YR.
APPROVED MAR 18 2005 DESIGN REVIEW COMMITTEE	APPROVED SEP 26 2005 CITY ENGINEER		
LAST DESIGN UPDATE			

CITY PROJECT NO. 749486 ZONE MAP NO. B-8-Z SHEET 29 OF 37

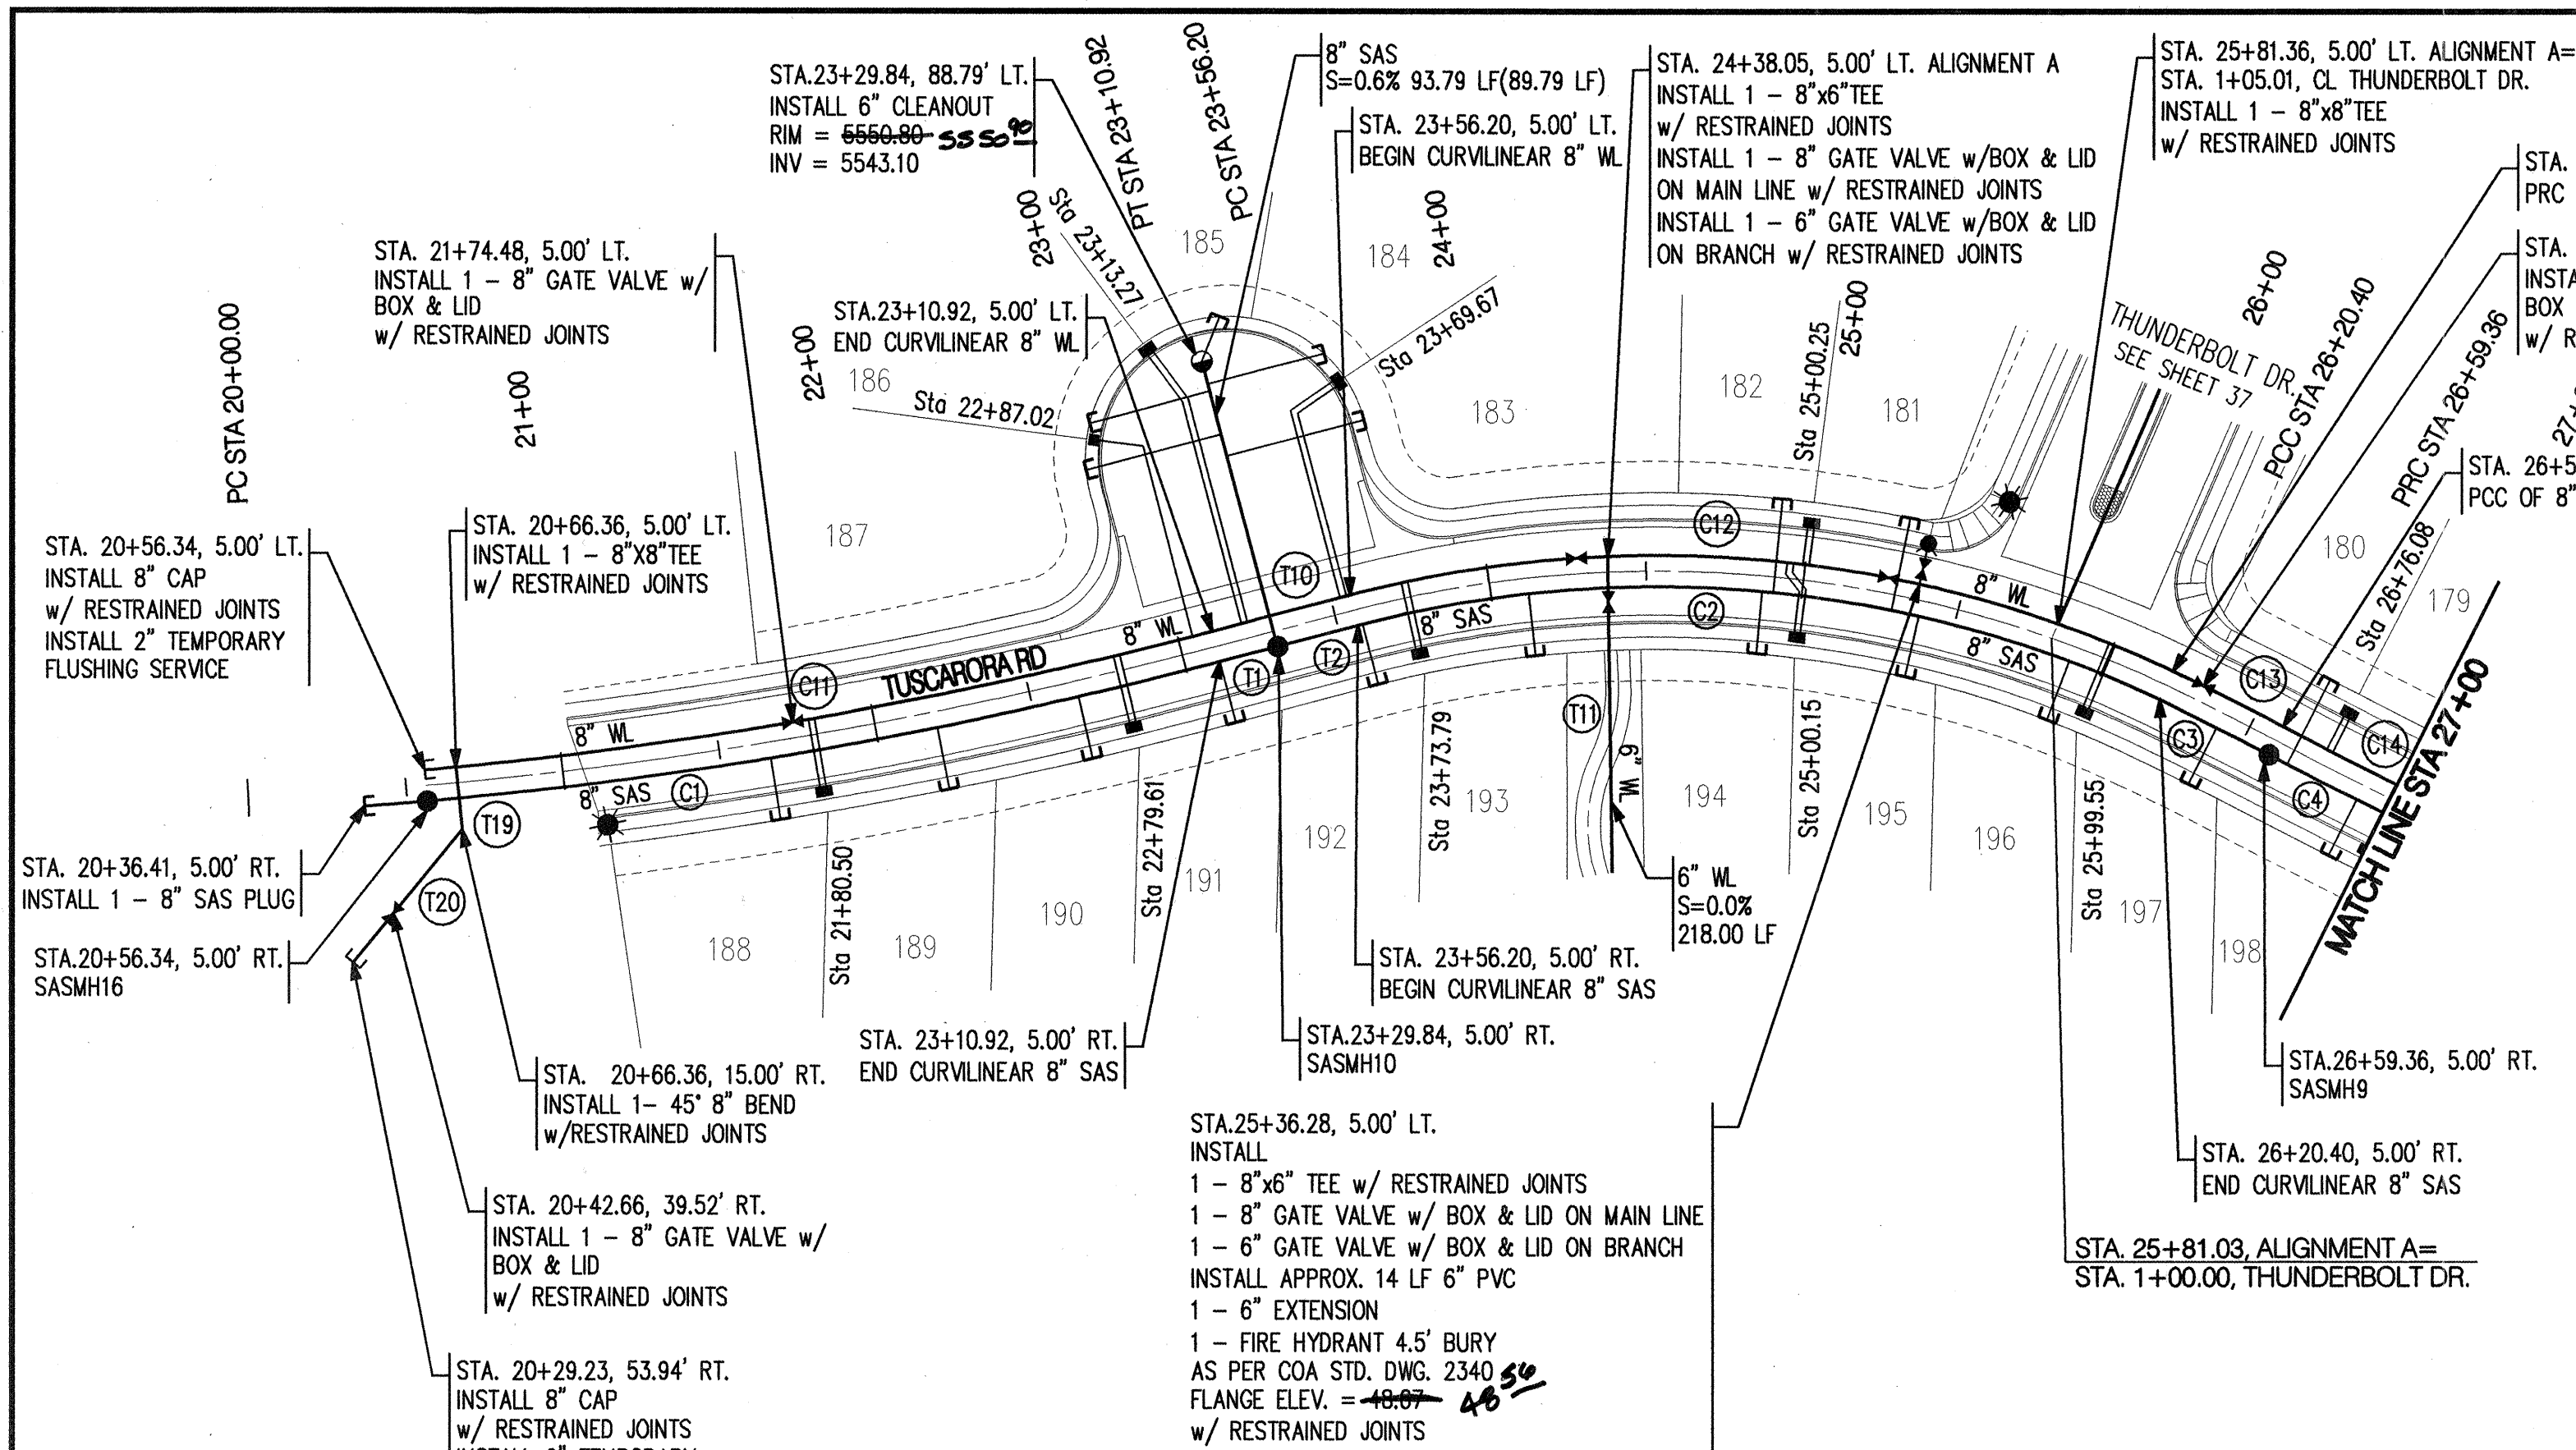

ID	ARC	RADIUS	DELTA	TANGENT
C1	255.42'	1505.00'	09°43'26"	128.02'
C2	260.68'	370.00'	40°22'00"	136.01'
C3	38.78'	1063.00'	02°05'24"	19.39'
C4	216.36'	2187.00'	05°40'06"	108.27'


ID	BEARING	LENGTH
T1	S42°10'09"W	18.92'
T2	S42°10'09"W	26.36'

ID	ARC	RADIUS	DELTA	TANGEN
C11	253.72'	1495.00'	09°43'26"	127.17'
C12	267.72'	380.00'	40°22'00"	139.69'
C13	39.14'	1073.00'	02°05'24"	19.57'
C14	215.38'	2177.00'	05°40'06"	107.78'


ID	BEARING	LENGTH
T10	N42°10'09"E	45.29'
T11	S33°49'02"E	218.00'
T19	S38°29'23"E	20.00'
T20	S06°30'37"W	54.40'

SANITARY SEWER SERVICES				
LOT ID	SAS STATION & OFFSET	SAS LENGTH	TOP OF PIPE AT PLUG (W/RISE)	
180	26+65.96, 5.00'RT.	30.00'		5540.22
181	25+29.30, 5.00'RT.	30.00'		5541.9
182	24+90.87, 5.00'RT.	30.00'		5542.3
183	23+29.84, 57.79'LT.	45.00'		5545.1
184	23+29.84, 81.36'LT.	38.09'		5545.1
185	23+29.84, 88.79'LT.	15.64'		5544.7
186	23+29.84, 78.99'LT.	39.48'		5545.1
187	23+29.84, 64.89'LT.	44.37'		5545.2
188	21+65.75, 5.00'RT.	20.00'		5546.6
189	22+19.20, 5.00'RT.	20.00'		5545.8
190	22+64.85, 5.00'RT.	20.00'		5545.2
191	23+10.86, 5.00'RT.	20.00'		5544.8
192	23+57.72, 5.00'RT.	20.00'		5543.8
193	24+12.04, 5.00'RT.	20.00'		5543.1
194	24+87.29, 5.00'RT.	20.00'		5542.2
195	25+38.35, 5.00'RT.	20.00'		5541.6
196	25+88.84, 5.00'RT.	20.00'		5540.9
197	26+40.69, 5.00'RT.	20.00'		5540.3
198	26+90.73, 5.00'RT.	20.00'		5539.2

NOTE: WATER METER LOCATIONS ARE DESIGNATED
BY STATIONING AT PROPERTY CORNERS.

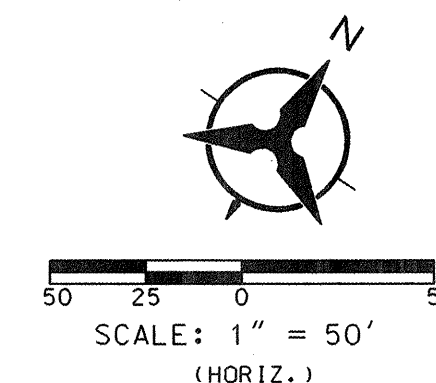

ALIGNMENT A 20+00 - 27+00

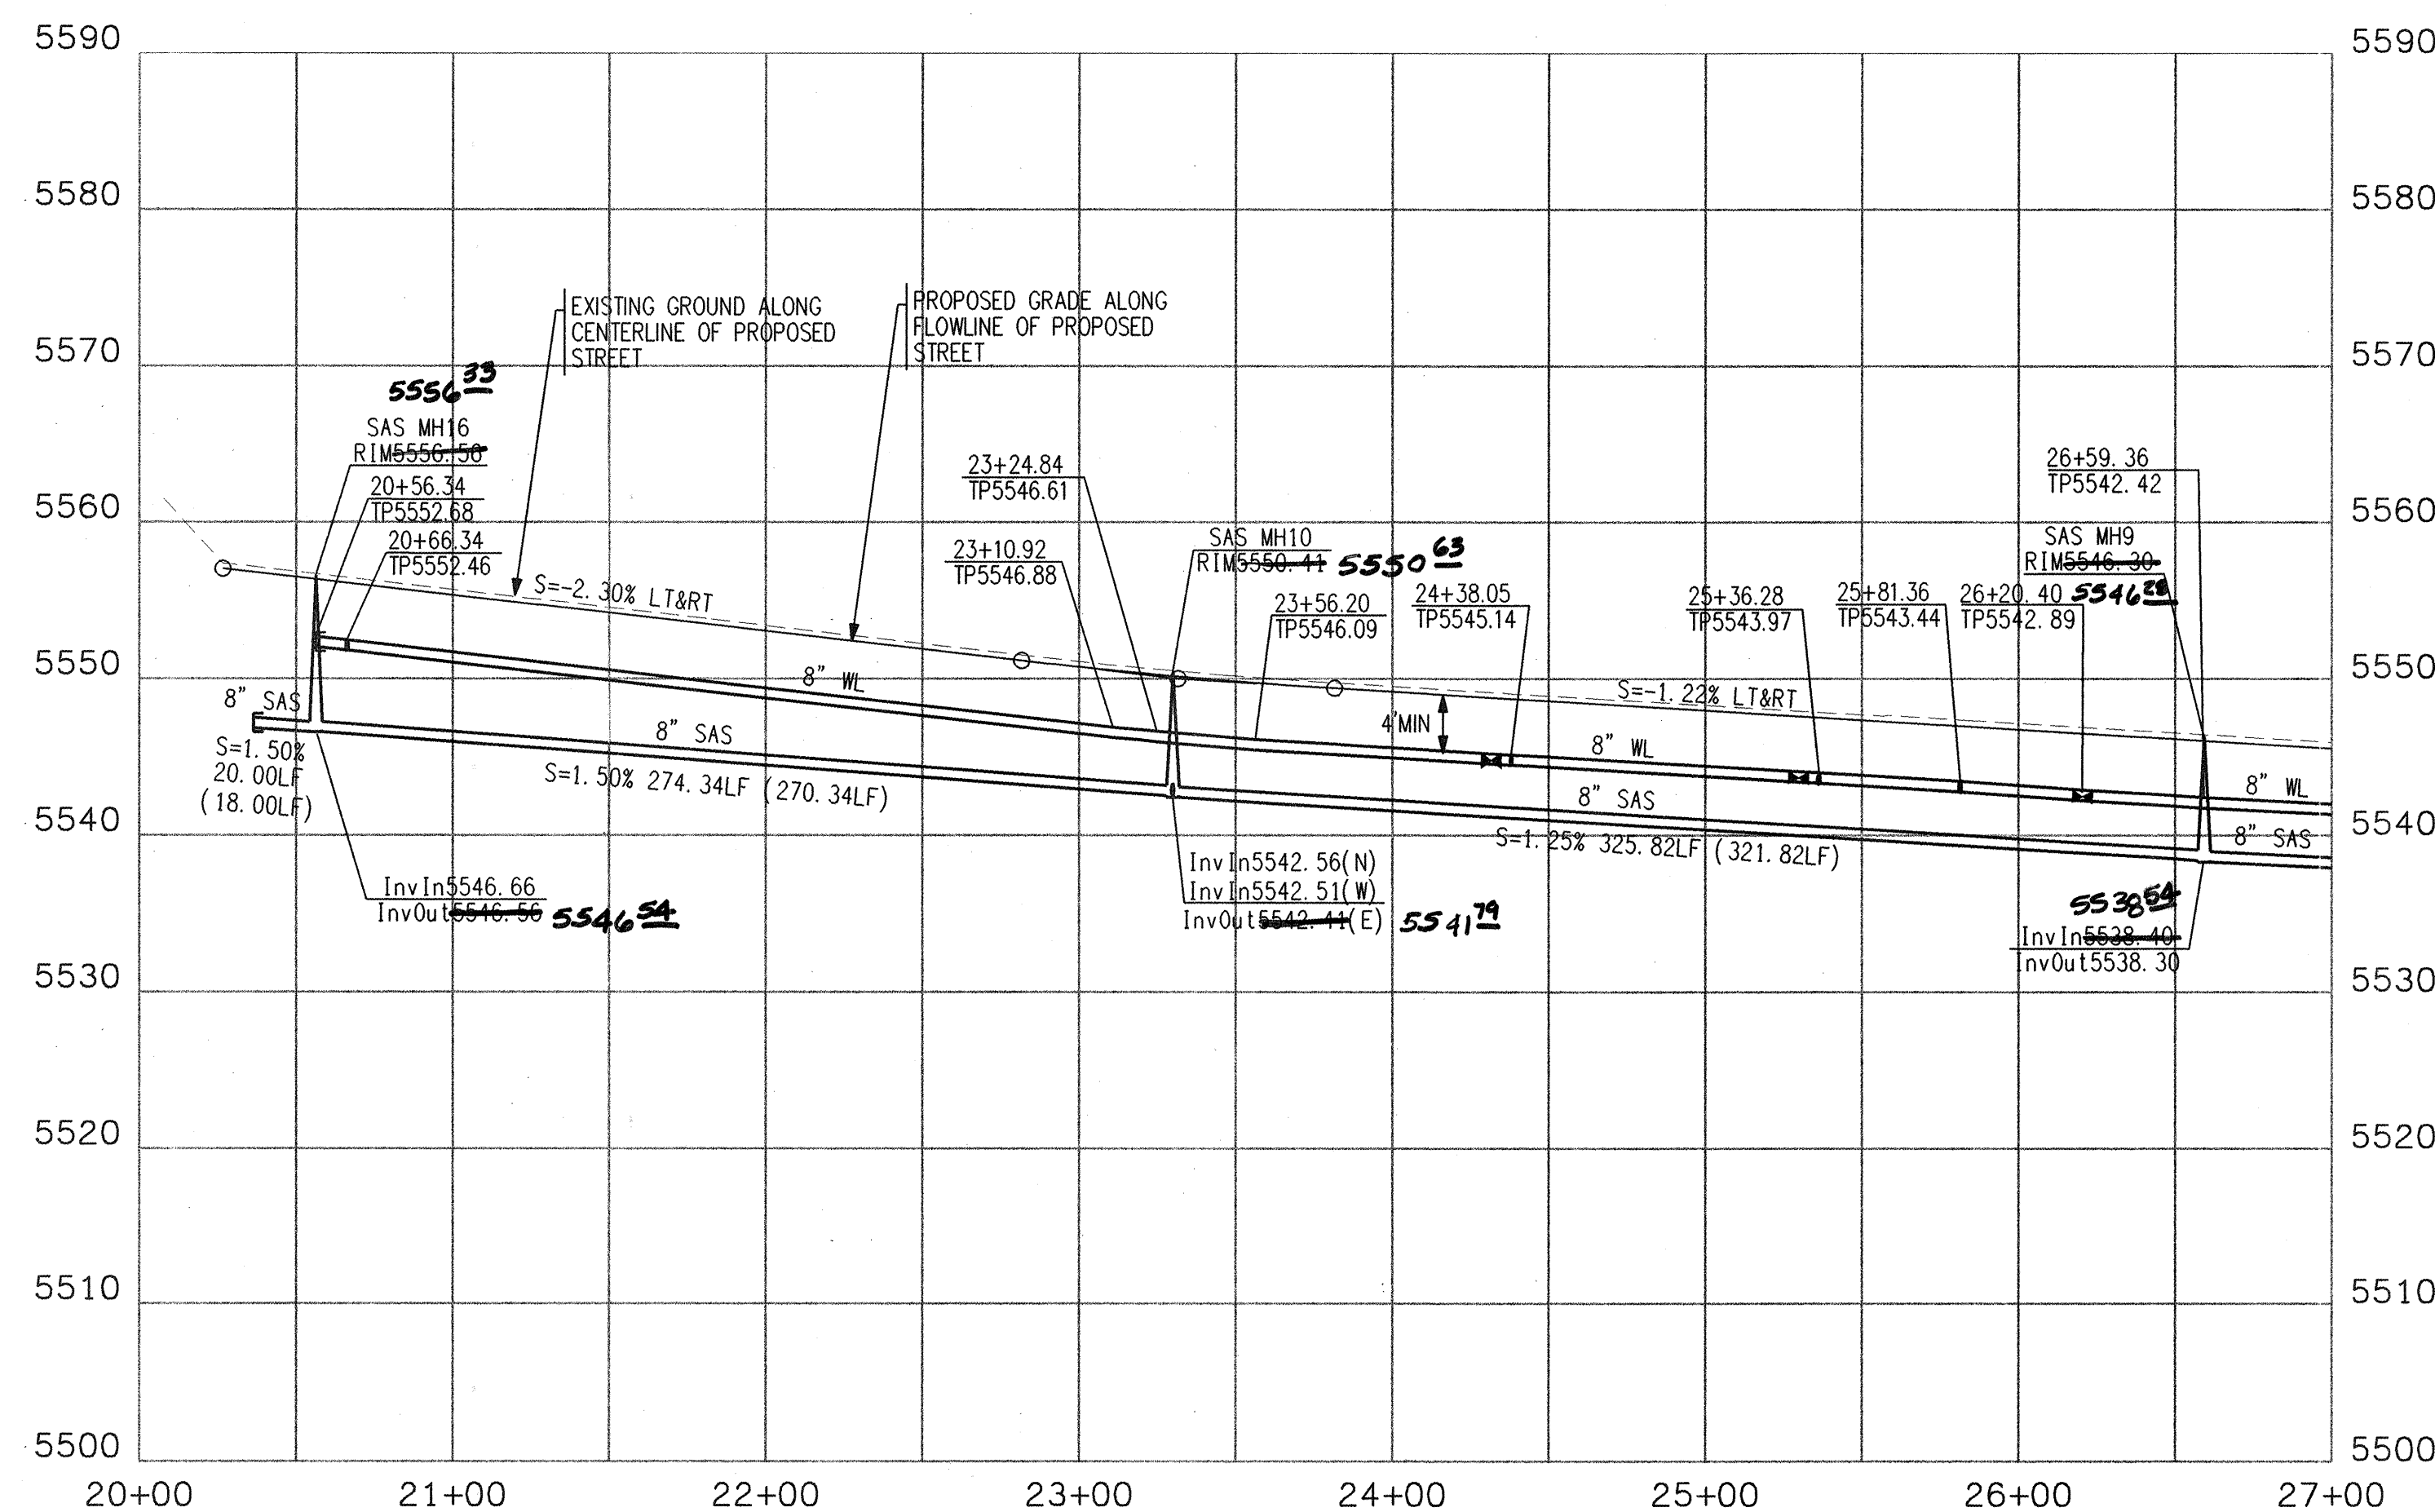

SURVEYORS CERTIFICATION

I, Russ P. Hugg, New Mexico Professional Surveyor Number 9750,
Hereby Certify that the as-built information shown hereon is the
result of an actual field survey performed by me or under my
direct supervision and that the same is true and correct to the
best of my knowledge and belief.

Russ P. Hugg
NMPs No. 9750
1.27 20.06



NOTES

1. THE CONTRACTOR SHALL FIELD VERIFY ALL EXISTING UTILITY LOCATIONS AND NOTIFY THE ENGINEER IMMEDIATELY OF ANY DISCREPANCIES.
2. ALL CURB RETURN RADII SHALL BE 25' UNLESS OTHERWISE SPECIFIED.
3. ALL CURVE DATA AND DIMENSIONS REFER TO FACE OF CURB UNLESS OTHERWISE SPECIFIED.
4. GRADE ELEVATIONS, WHERE NOTED, ARE ALONG FLOWLINE OF STANDARD CURB UNLESS OTHERWISE SPECIFIED.
5. CONTRACTOR IS RESPONSIBLE FOR REPAIR AND/OR REPLACEMENT OF ALL UTILITY CONDUITS AND EXISTING LINES.
6. ANY ADDITIONAL GRADING REQUIRED TO MATCH PROPOSED STREET GRADES SHALL BE INCIDENTAL TO PAVING ITEMS.
7. CONTRACTOR SHALL PROVIDE THE INSPECTORS, (CITY AND PRIVATE) WITH THE PROPOSED HYDROSTATIC TESTING PLAN. THE PLAN MUST BE APPROVED BEFORE TESTING OPERATIONS BEGIN.
8. CONTRACTOR SHALL PARK EQUIPMENT AND VEHICLES AS NOT INTERFERE WITH NORMAL ACTIVITIES OF RESIDENTS OR OTHER CONTRACTORS ON SITE.
9. ANY DAMAGE TO THE EXISTING FACILITIES (CURB & GUTTER, PAVEMENT, CONDUITS, LANDSCAPING, UTILITY LINES, ETC.) DURING CONSTRUCTION SHALL BE REPLACED AT THE CONTRACTORS' EXPENSE.
10. WHEELCHAIR RAMPS SHALL BE CONSTRUCTED PRIOR TO ACCEPTANCE OF CURB & GUTTER.
11. ALL EXCAVATION, TRENCHING AND SHORING ACTIVITIES MUST BE CARRIED-OUT IN ACCORDANCE WITH OSHA 29 CFR 1926.650 SUBPART P.

ENGINEER'S SEAL	SURVEY INFORMATION		BENCH MARKS	AS-BUILT INFORMATION	
	FIELD NOTES				
 KEVIN O. PATTON NEW MEXICO 18801 REGISTERED PROFESSIONAL ENGINEER STATE OF NEW MEXICO	NO.	BY DATE	ACS BRASS TABLET STAMPED 2-BIT 1980"	CONTRACTOR	
			GEOGRAPHIC POSITION (NAD 1927)	STAKED BY	
			(CENTRAL ZONE)	INSPECTOR'S ACCEPTANCE BY	DATE
				VERIFICATION BY	DATE
				DRAWINGS CONTROLLED BY	DATE
				MICRO-FILM INFORMATION	
			RECORDED BY	DATE	
			NGVD 1929 ELEVATION = 5429.35	NO.	

GENERAL NOTE:
***ALL SANITARY SEWER MANHOLES SHALL BE**
4' DIAMETER TYPE "E" AS PER NM APWA
STANDARD DRAWING 2102
UNLESS OTHERWISE NOTED.

APPROVED FOR NMU 3-17-05
DATE

Bohannon Huston

Courtyard I 7500 Jefferson St. NE Albuquerque, NM 87109-4335
ENGINEERING • SPATIAL DATA • ADVANCED TECHNOLOGIES



CITY OF ALBUQUERQUE
PUBLIC WORKS DEPARTMENT
ENGINEERING DEVELOPMENT GROUP

WESTERN RIDGE (UNIT 2) SUBDIVISION AT VENTANA RANCH WEST
UTILITY PLAN & PROFILE
ALIGNMENT A 20+00 - 27+00



DESIGN REVIEW COMMITTEE		CITY ENGINEER APPROVAL		LAST DESIGN UPDATE	MO./DAY/YR.	MO./DAY/YR.
 DESIGN REVIEW COMMITTEE APPROVED MAR 18 2005 DESIGN REVIEW COMMITTEE	 CITY ENGINEER APPROVED SEP 26 2005 CITY ENGINEER					

CITY PROJECT NO.	ZONE MAP NO.	SHEET	OF
749486	B-8-7	30	37

ID	BEARING	LENGTH
T3	S85°58'59"W	111.71'
T4	S19°25'17"E	76.75'
T5	S25°27'45"E	92.24'


ID	BEARING	LENGTH
T11	N85°58'19"E	46.61'
T12	S70°34'43"W	9.84'
T13	N19°25'17"W	94.71'
T14	N25°27'45"W	72.15'

NOTE: WATER METER LOCATIONS ARE DESIGNATED
BY STATIONING AT PROPERTY CORNERS.

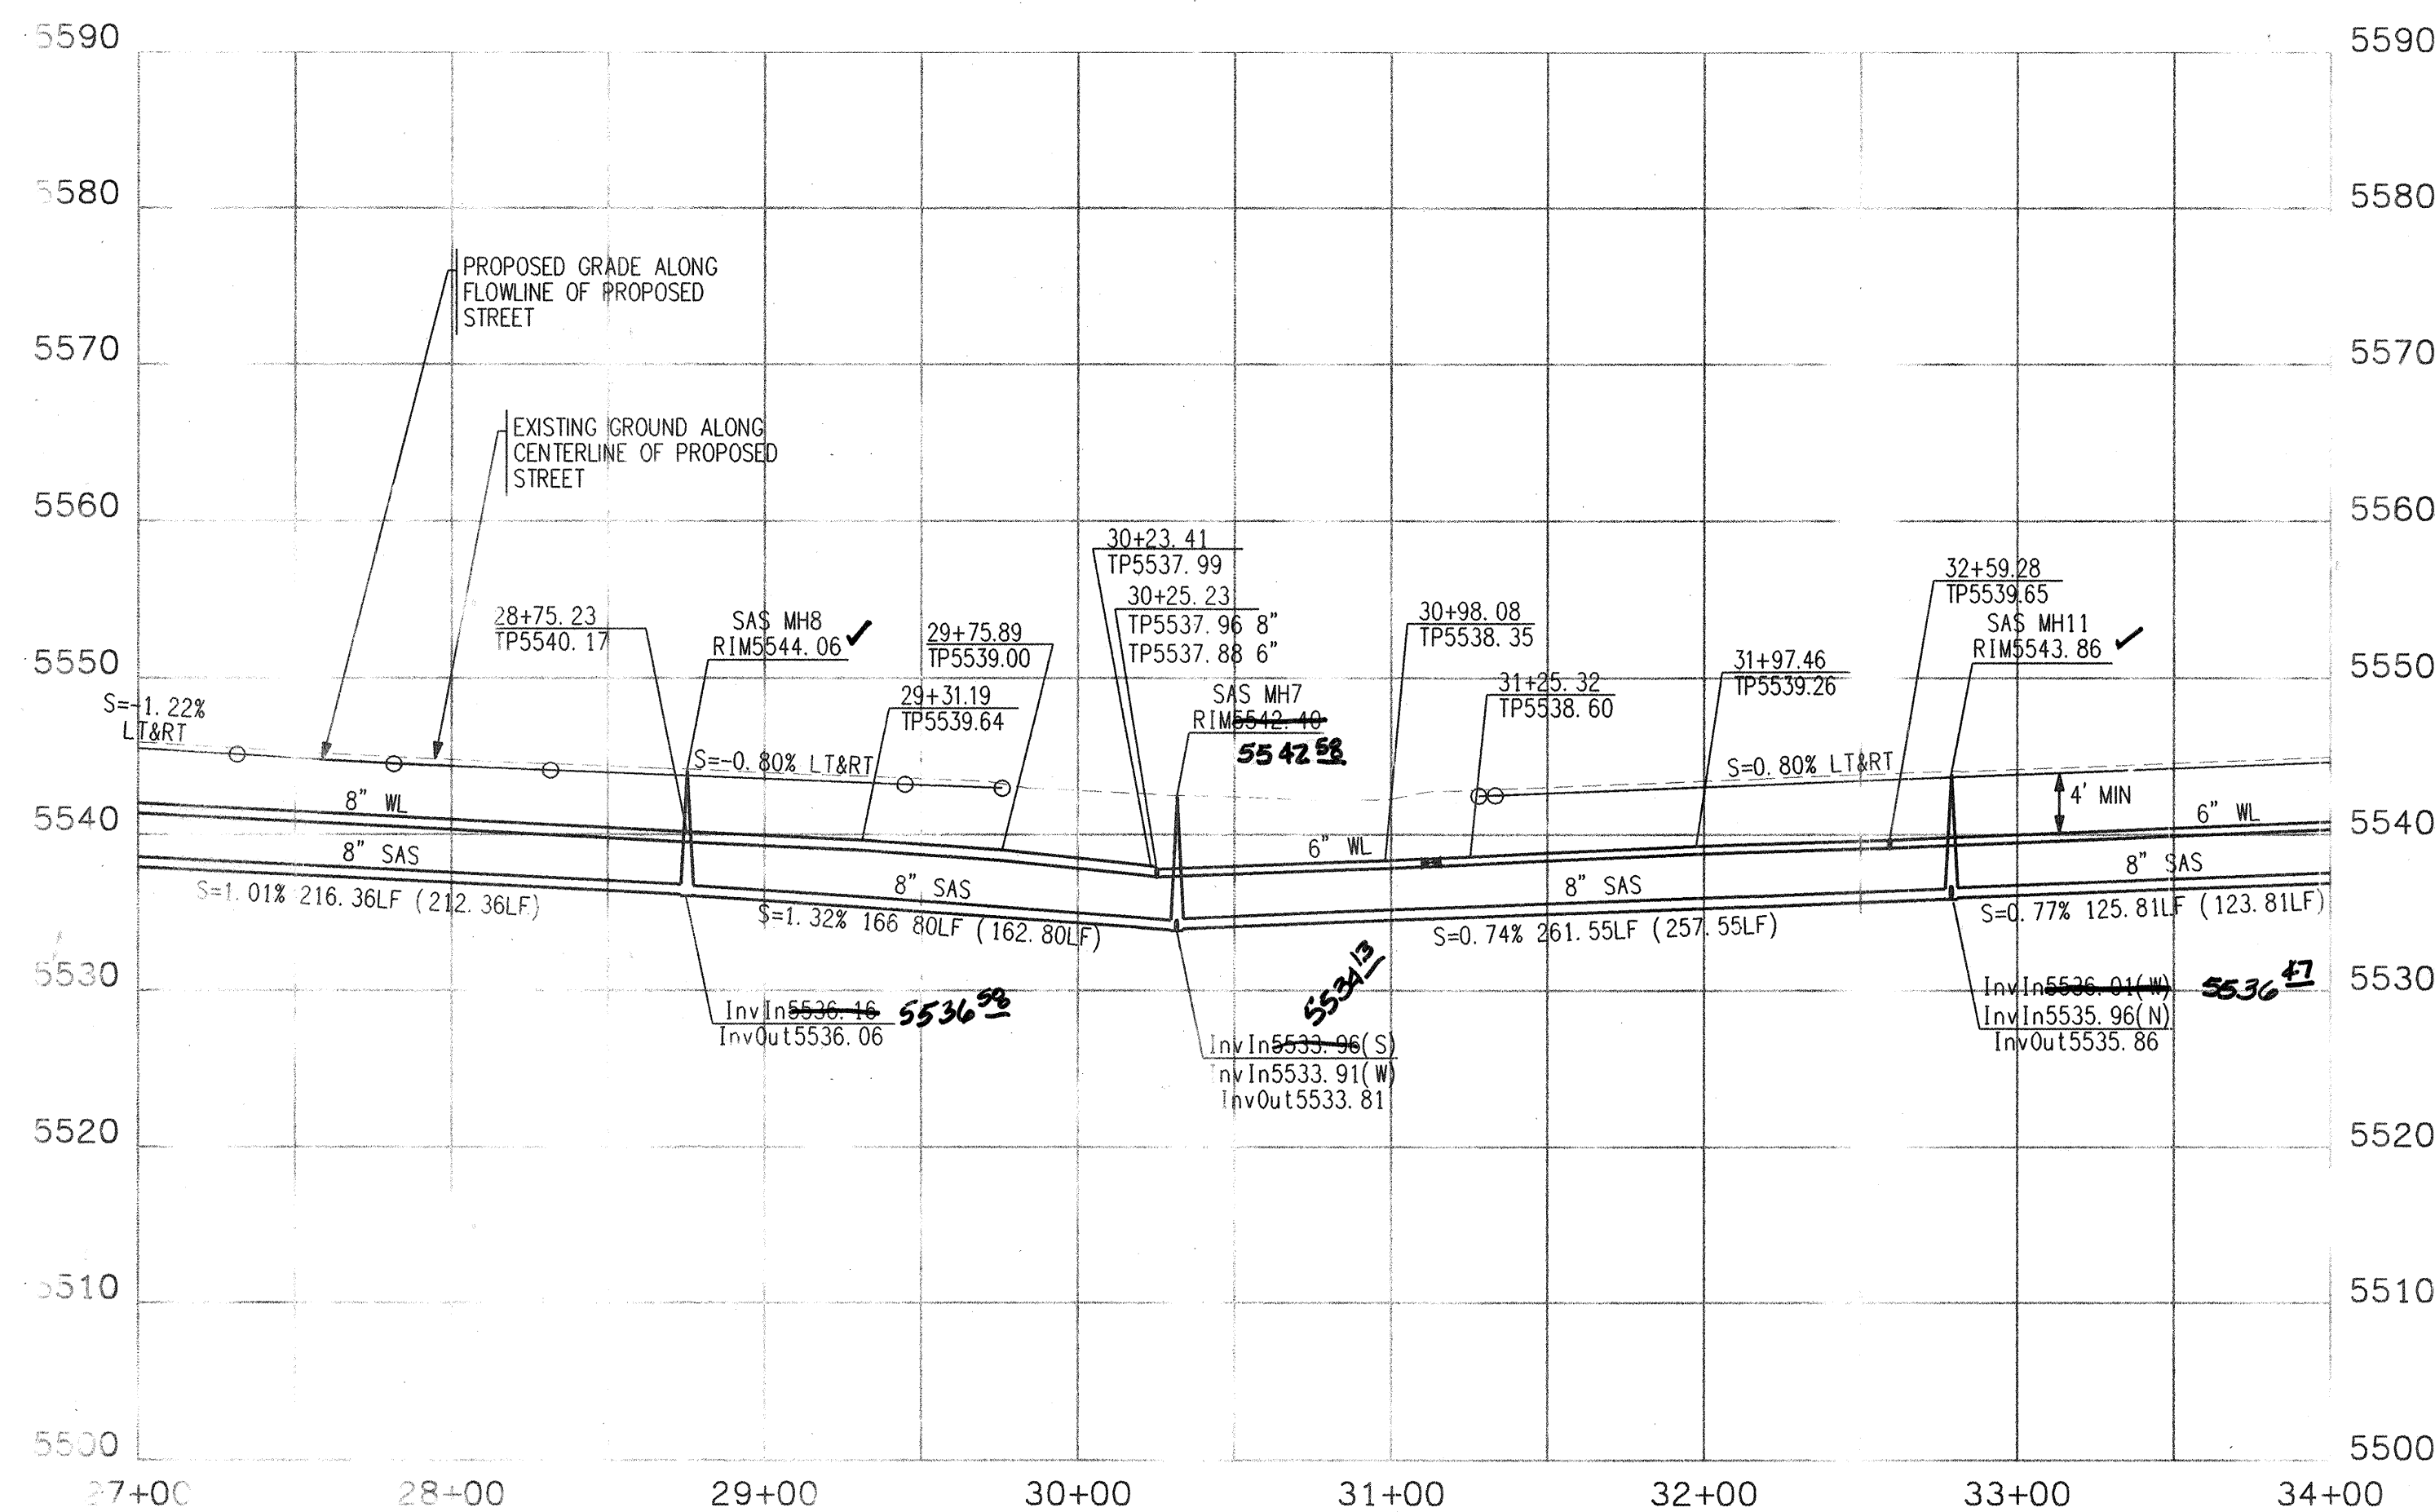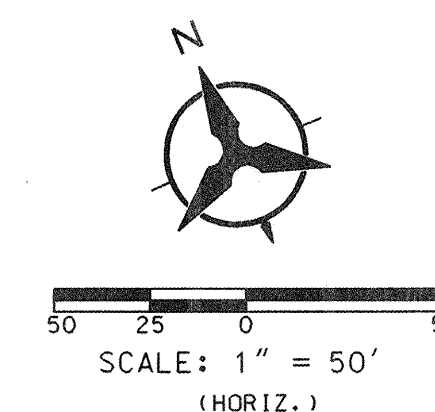

I, Russ P. Hugg, New Mexico Professional Surveyor Number 9750,
Hereby Certify that the as-built information shown hereon is the
result of an actual field survey performed by me or under my
direct supervision and that the same is true and correct to the
best of my knowledge and belief.

Russ P. Hugo
NMPS No. 9750

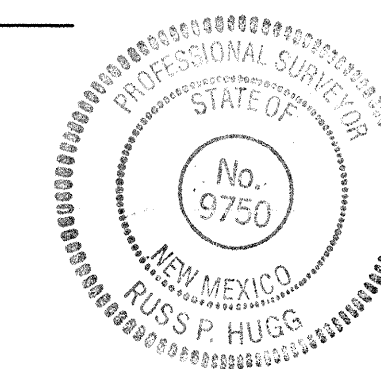

1. THE CONTRACTOR SHALL FIELD VERIFY ALL EXISTING UTILITY LOCATIONS AND NOTIFY THE ENGINEER IMMEDIATELY OF ANY DISCREPANCIES.
2. ALL CURB RETURN RADII SHALL BE 25' UNLESS OTHERWISE SPECIFIED.
3. ALL CURVE DATA AND DIMENSIONS REFER TO FACE OF CURB UNLESS OTHERWISE SPECIFIED.
4. GRADE ELEVATIONS, WHERE NOTED, ARE ALONG FLOWLINE OF STANDARD CURB UNLESS OTHERWISE SPECIFIED.
5. CONTRACTOR IS RESPONSIBLE FOR REPAIR AND/OR REPLACEMENT OF ALL UTILITY CONDUITS AND EXISTING LINES.
6. ANY ADDITIONAL GRADING REQUIRED TO MATCH PROPOSED STREET GRADES SHALL BE INCIDENTAL TO PAVING ITEMS.
7. CONTRACTOR SHALL PROVIDE THE INSPECTORS, (CITY AND PRIVATE) WITH THE PROPOSED HYDROSTATIC TESTING PLAN. THE PLAN MUST BE APPROVED BEFORE TESTING OPERATIONS BEGIN.
8. CONTRACTOR SHALL PARK EQUIPMENT AND VEHICLES AS NOT TO INTERFERE WITH NORMAL ACTIVITIES OF RESIDENTS OR OTHER CONTRACTORS ON SITE.
9. ANY DAMAGE TO THE EXISTING FACILITIES (CURB & GUTTER, PAVEMENT, CONDUITS, LANDSCAPING, UTILITY LINES, ETC.) DURING CONSTRUCTION SHALL BE REPLACED AT THE CONTRACTORS' EXPENSE.
10. WHEELCHAIR RAMPS SHALL BE CONSTRUCTED PRIOR TO ACCEPTANCE OF CURB & GUTTER.
11. ALL EXCAVATION, TRENCHING AND SHORING ACTIVITIES MUST BE CARRIED-OUT IN ACCORDANCE WITH OSHA 29 CFR 1926.850 SUPPORT P.

GENERAL NOTE:
***ALL SANITARY SEWER MANHOLES SHALL BE**
4' DIAMETER TYPE "E" AS PER NM APWA
STANDARD DRAWING 2102
UNLESS OTHERWISE NOTED.

APPROVED FOR NMUI 3-4-05
DATE

Bohannon Custom

Courtyard 7500 Jefferson St. NE Albuquerque, NM 87109-4335



CITY OF ALBUQUERQUE
PUBLIC WORKS DEPARTMENT
ENGINEERING DEVELOPMENT GROUP

EASTERN RIDGE (UNIT 2) JBC ON AT VENTANA BLANCH WEST
UTILITY PLAN & PROFILE
ALIGNMENT A 2 -00 - 74+00


DESIGN REVIEW COMMITTEE	CITY ENGINEER	MO. DAY YR
APPROVED	APPROVED	NO

APPROVE
MAR 18 2005
DESIGN
REVIEW COMMITTEE


SEP 26 2005
CITY ENGINEER

SCALE: 1" = 50' (HORIZ.)
1" = 10' (VERT.)

BHI JOB NO. 050125

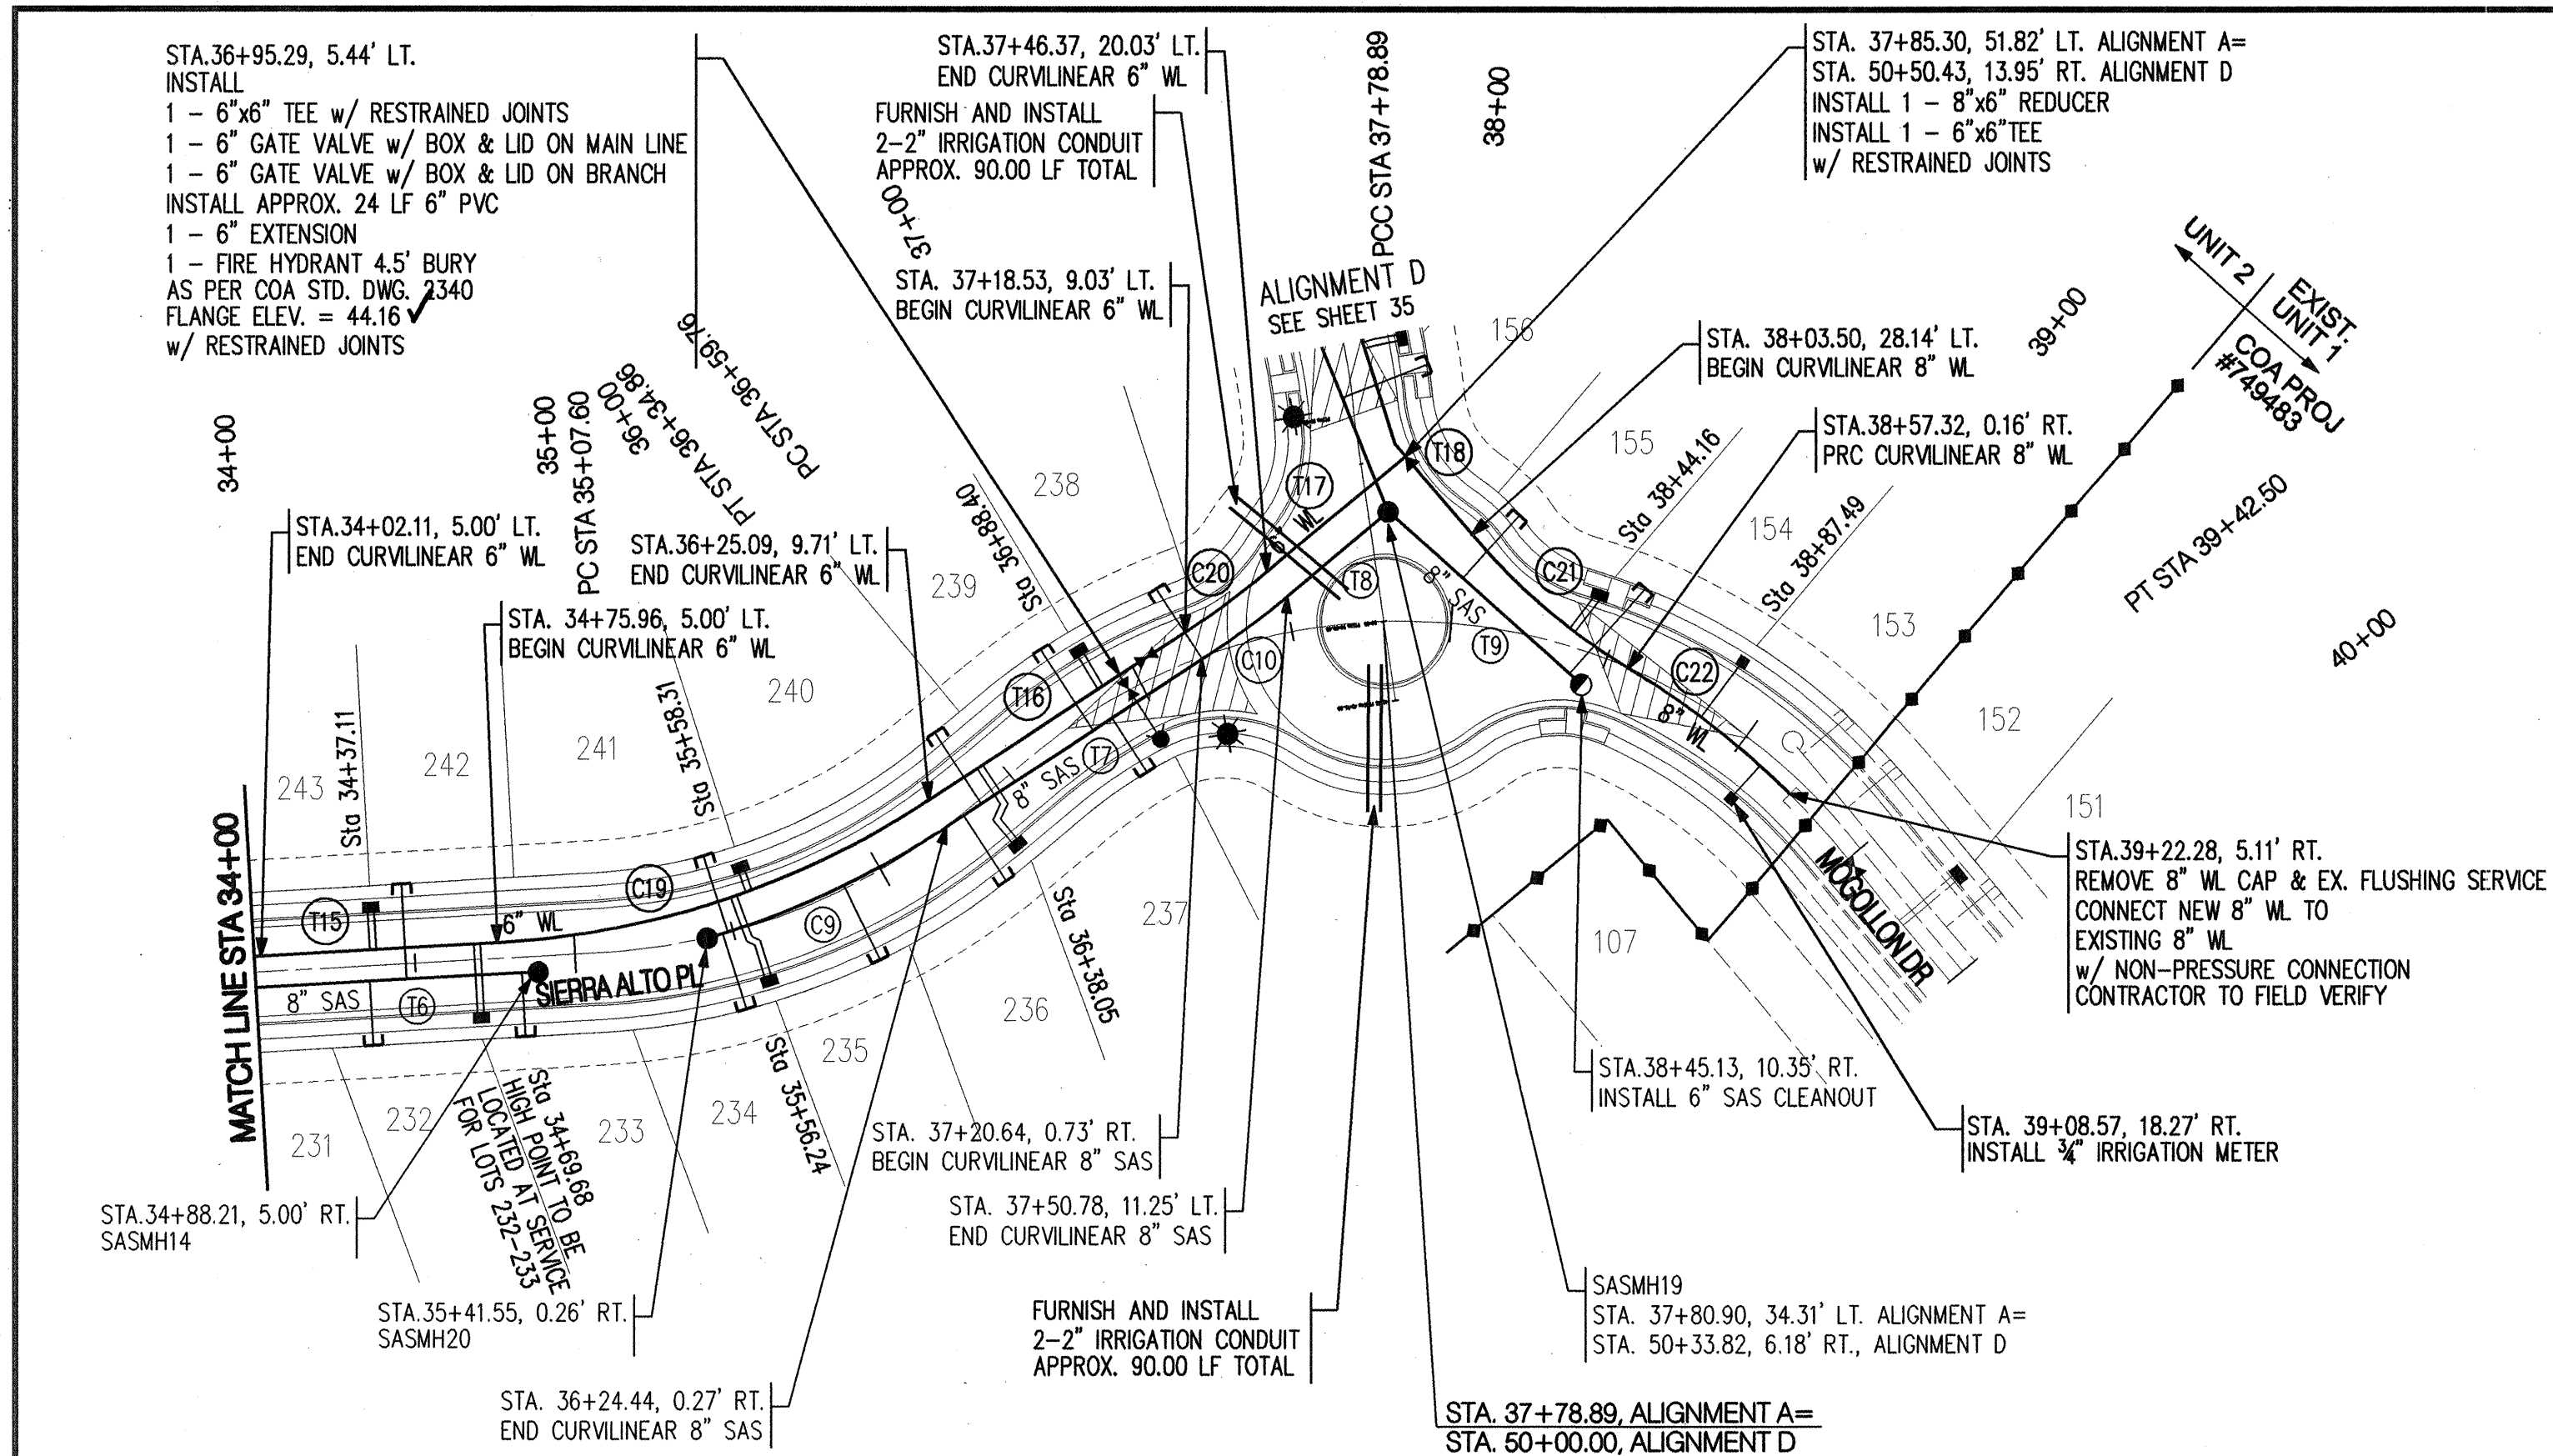

ALIGNMENT A 34+00 - 40+00

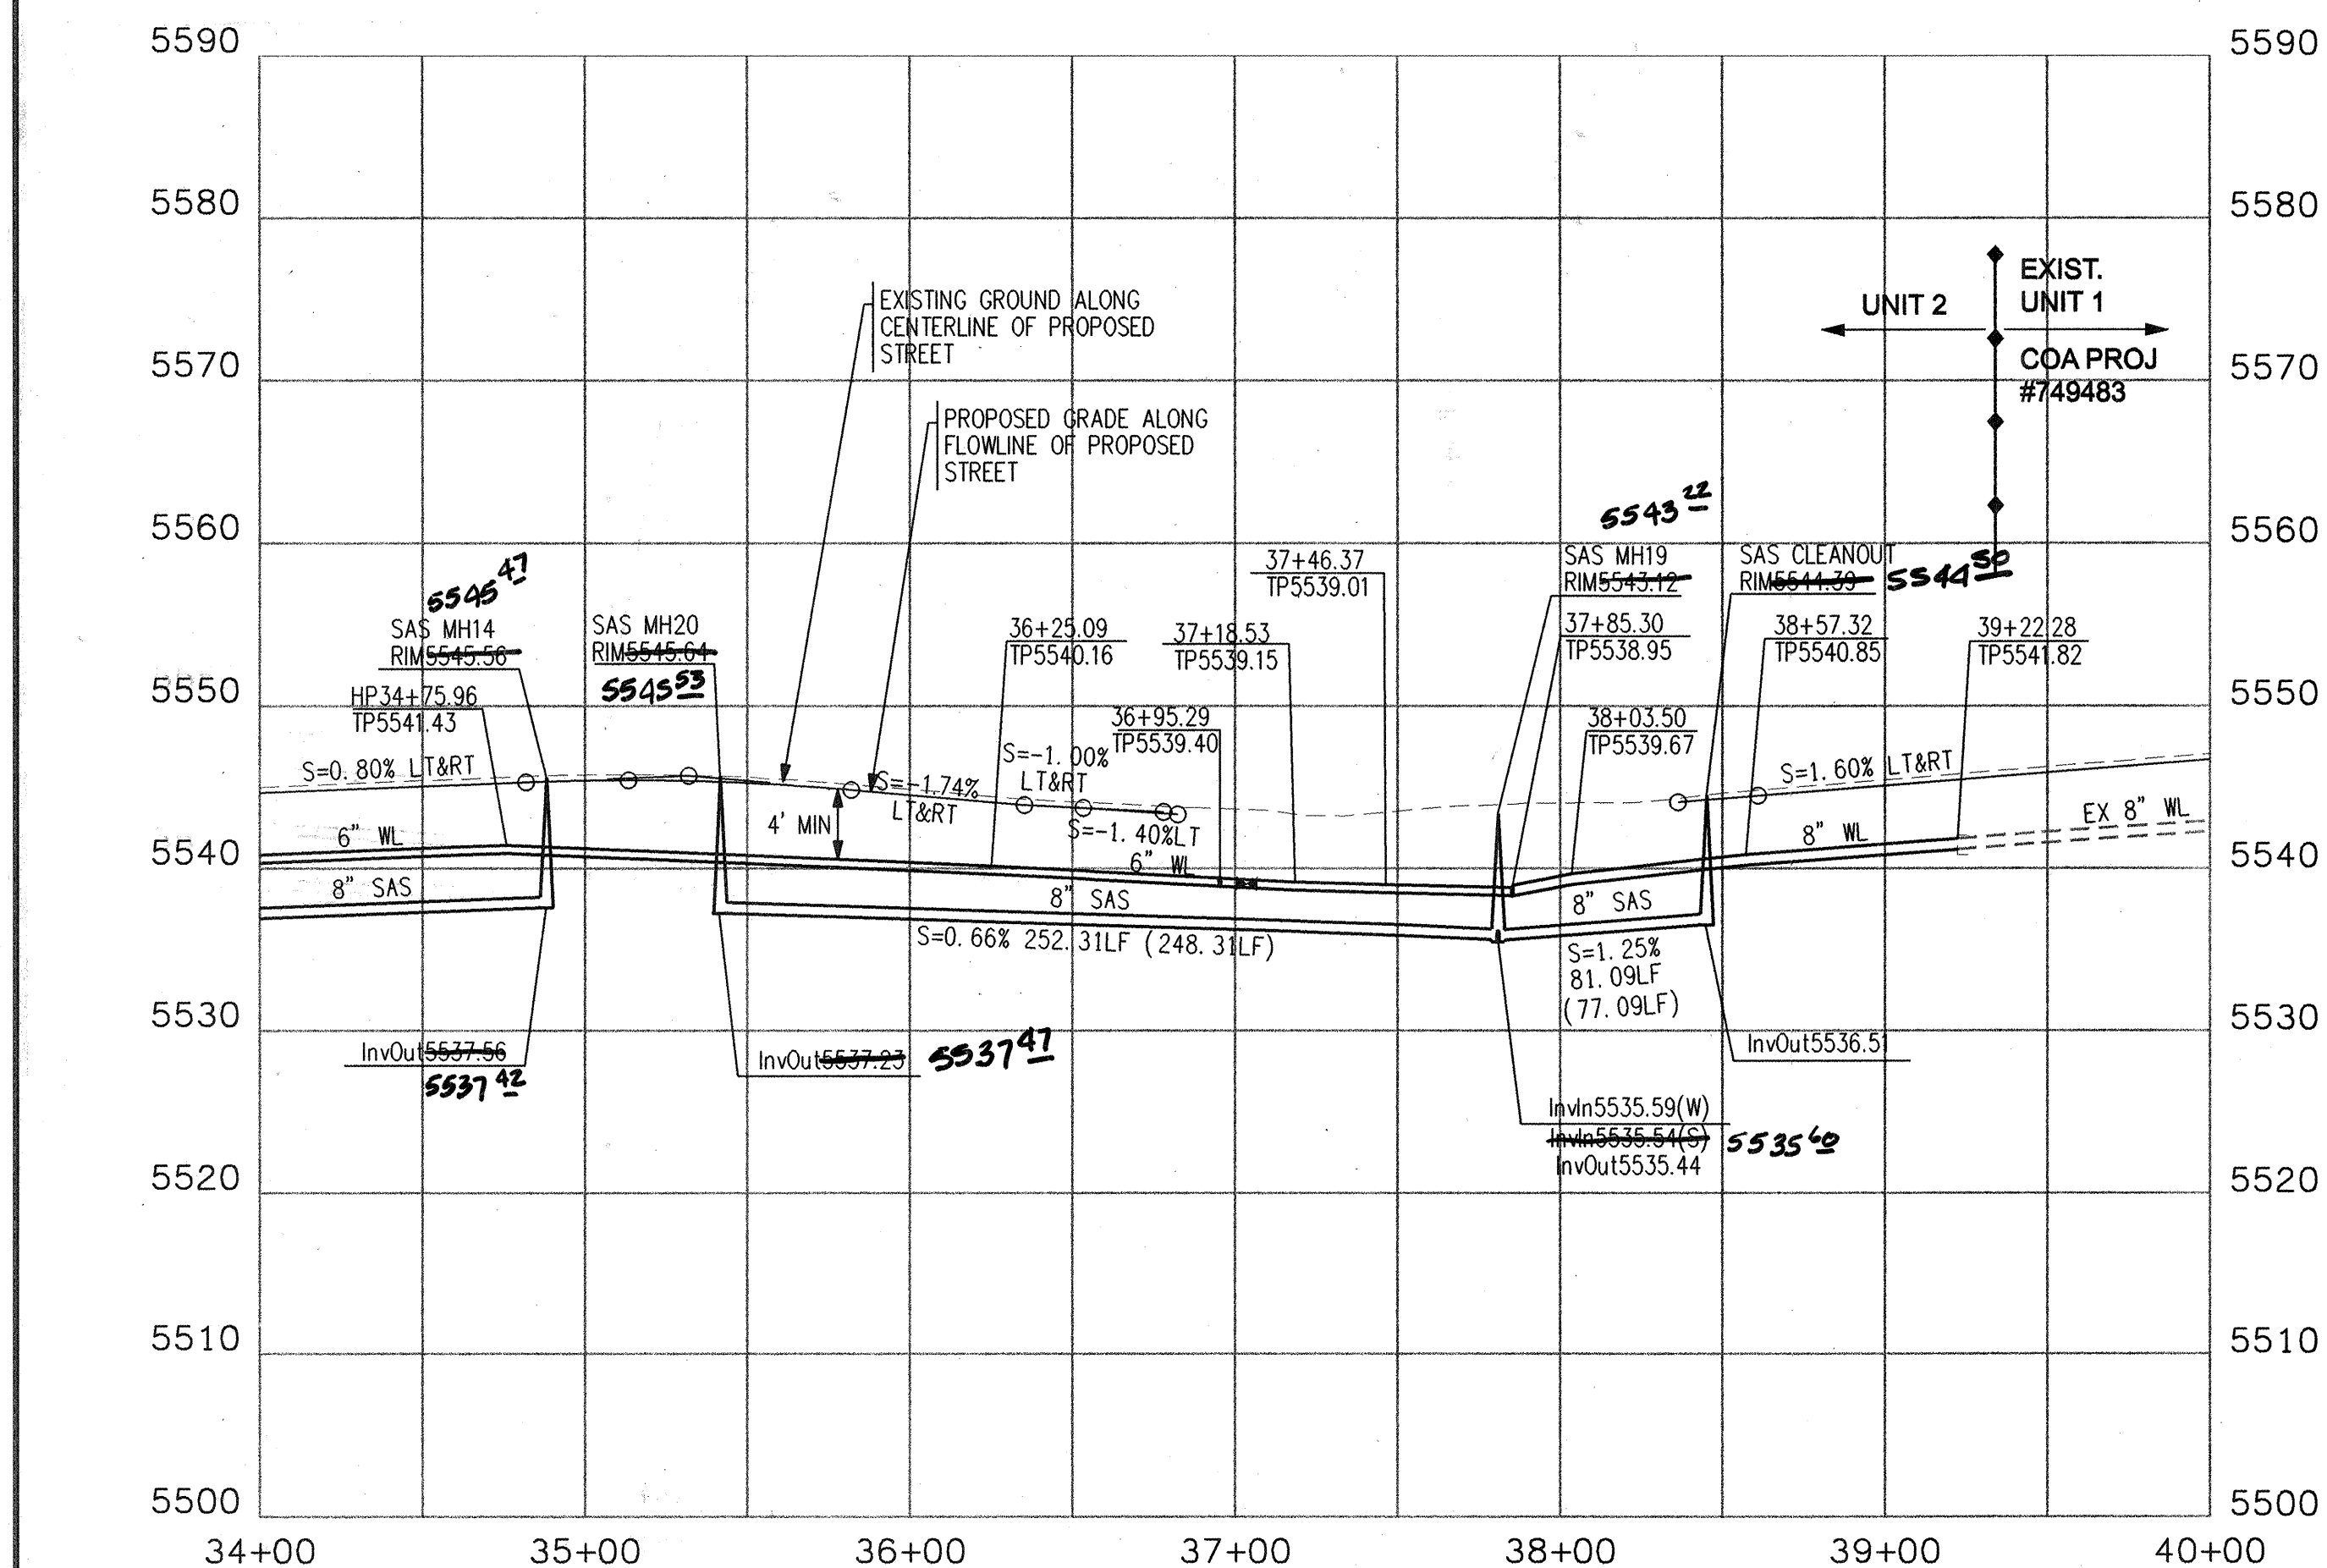

SAS Curve Table				
ID	ARC	RADIUS	DELTA	TANGENT
C9	82.69'	285.00'	16°37'25"	41.64'
C10	33.22'	275.00'	06°55'15"	16.63'

ID	BEARING	LENGTH
T6	S82°45'49"E	86.09'
T7	S67°19'54"W	95.45'
T8	S60°24'38"W	40.95'
T9	S37°37'13"E	81.09'

W.L. Curve Table				
ID	ARC	RADIUS	DELTA	TANGEN
C19	143.53'	275.00'	29°54'17"	73.44'
C20	32.01'	265.00'	06°55'14"	16.02'
C21	64.50'	195.00'	18°57'09"	32.55'
C22	64.01'	285.00'	13°50'22"	32.16'

ID	BEARING	LENGTH
T15	S82°45'49"E	73.85'
T16	N67°19'54"E	95.45'
T17	N60°24'38"E	56.32'
T18	N29°35'22"W	37.45'

SANITARY SEWER SERVICES			
LOT ID	SAS STATION & OFFSET	SAS LENGTH	TOP OF PIPE AT PLUG (W/RISE)
154	38+40.29, 8.37'RT.	35.98'	5538.5
155	38+02.21, 14.24'LT.	26.70'	5537.9
232	34+35.62, 5.00'RT.	20.00'	5538.9
233	34+83.21, 5.00'RT.	20.00'	5539.2
234	35+46.64, 0.04'LT.	25.05'	5539.0
235	35+87.63, 1.01'LT.	26.01'	5538.8
236	36+30.85, 0.77'RT.	24.33'	5538.4
237	36+86.68, 5.09'RT.	19.92'	5538.0
238	37+20.62, 0.73'RT.	26.31'	5537.9
239	36+79.49, 5.20'RT.	30.20'	5538.2
240	36+37.39, 1.48'RT.	26.66'	5538.4
241	35+48.36, 0.13'LT.	24.91'	5539.0
242	34+47.11, 5.00'RT.	30.00'	5539.2

NOTE: WATER METER LOCATIONS ARE DESIGNATED
BY STATIONING AT PROPERTY CORNERS.



50 25 0 5
SCALE: 1" = 50'
(HORIZ.)

NOTES

1. THE CONTRACTOR SHALL FIELD VERIFY ALL EXISTING UTILITY LOCATIONS AND NOTIFY THE ENGINEER IMMEDIATELY OF ANY DISCREPANCIES.
2. ALL CURB RETURN RADII SHALL BE 25' UNLESS OTHERWISE SPECIFIED.
3. ALL CURVE DATA AND DIMENSIONS REFER TO FACE OF CURB UNLESS OTHERWISE SPECIFIED.
4. GRADE ELEVATIONS, WHERE NOTED, ARE ALONG FLOWLINE OF STANDARD CURB UNLESS OTHERWISE SPECIFIED.
5. CONTRACTOR IS RESPONSIBLE FOR REPAIR AND/OR REPLACEMENT OF ALL UTILITY CONDUITS AND EXISTING LINES.
6. ANY ADDITIONAL GRADING REQUIRED TO MATCH PROPOSED STREET GRADES SHALL BE INCIDENTAL TO PAVING ITEMS.
7. CONTRACTOR SHALL PROVIDE FOR THE INSPECTORS, (CITY AND PRIVATE) WITH THE PROPOSED HYDROSTATIC TESTING PLAN. THE PLAN MUST BE APPROVED BEFORE TESTING OPERATIONS BEGIN.
8. CONTRACTOR SHALL PARK EQUIPMENT AND VEHICLES AS NOT TO INTERFERE WITH NORMAL ACTIVITIES OF RESIDENTS OR OTHER CONTRACTORS ON SITE.
9. ANY DAMAGE TO THE EXISTING FACILITIES (CURB & GUTTER, PAVEMENT, CONDUITS, LANDSCAPING, UTILITY LINES, ETC.) DURING CONSTRUCTION SHALL BE REPLACED AT THE CONTRACTOR'S EXPENSE.
10. WHEELCHAIR RAMPS SHALL BE CONSTRUCTED PRIOR TO ACCEPTANCE OF CURB & GUTTER.
11. ALL EXCAVATION, TRENCHING AND SHORING ACTIVITIES MUST BE CARRIED-OUT IN ACCORDANCE WITH OSHA 29 CFR 1926.650 SUBPART P.

SURVEY INFORMATION		BENCH MARKS		AS-BUILT INFORMATION	
FIELD NOTES					
NO.	BY	DATE	GEOGRAPHIC POSITION (NAD 1927)	CONTRACTOR	
			ACS BRASS TABLET STAMPED "2-BIT 1980"	WORK STARTED BY	
				ACCEPTANCE BY	DATE
			(CENTRAL ZONE)	FIELD LOCATION BY	DATE
				DRAWINGS CORRECTED BY	DATE
			MICRO-FILM INFORMATION		
				RECORDED BY	DATE
			NOVD 1929 ELEVATION = 5429.35	NO.	




GENERAL NOTE:
***ALL SANITARY SEWER MANHOLES SHALL BE**
4' DIAMETER TYPE "E" AS PER NM APWA
STANDARD DRAWING 2102
UNLESS OTHERWISE NOTED.

APPROVED FOR NMJL 3-4-95
DATE

Bohannon ▲ Huston

Courtyard I 7500 Jefferson St. NE Albuquerque, NM 87109-4335
ENGINEERING • SPATIAL DATA • ADVANCED TECHNOLOGIES

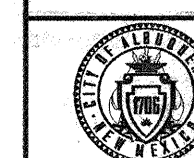

CITY OF ALBUQUERQUE
PUBLIC WORKS DEPARTMENT
ENGINEERING DEVELOPMENT GROUP

WESTERN RIDGE (UNIT 2) SUBDIVISION AT VENTANA RANCH WEST
UTILITY PLAN & PROFILE
ALIGNMENT A 34+00 - 40+00


DESIGN REVIEW COMMITTEE		CITY ENGINEER APPROVAL	MO./DAY/YR.	MO./DAY/YR.
		LAST DESIGN UPDATE		

CITY PROJECT NO.	ZONE MAP NO.	SHEET	OF
749486	B-8-Z	32	37

SURVEYORS CERTIFICATION


I, Russ P. Hugg, New Mexico Professional Surveyor Number 9750,
Hereby Certify that the as-built information shown hereon is the
result of an actual field survey performed by me or under my
direct supervision and that the same is true and correct to the
best of my knowledge and belief.

Russ P. Hugg
Russ P. Hugg
NMPS No. 9750
1:27 0.00

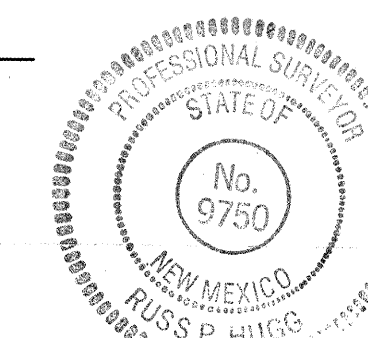


SCANNED BY PLW

SCANNED BY PLW

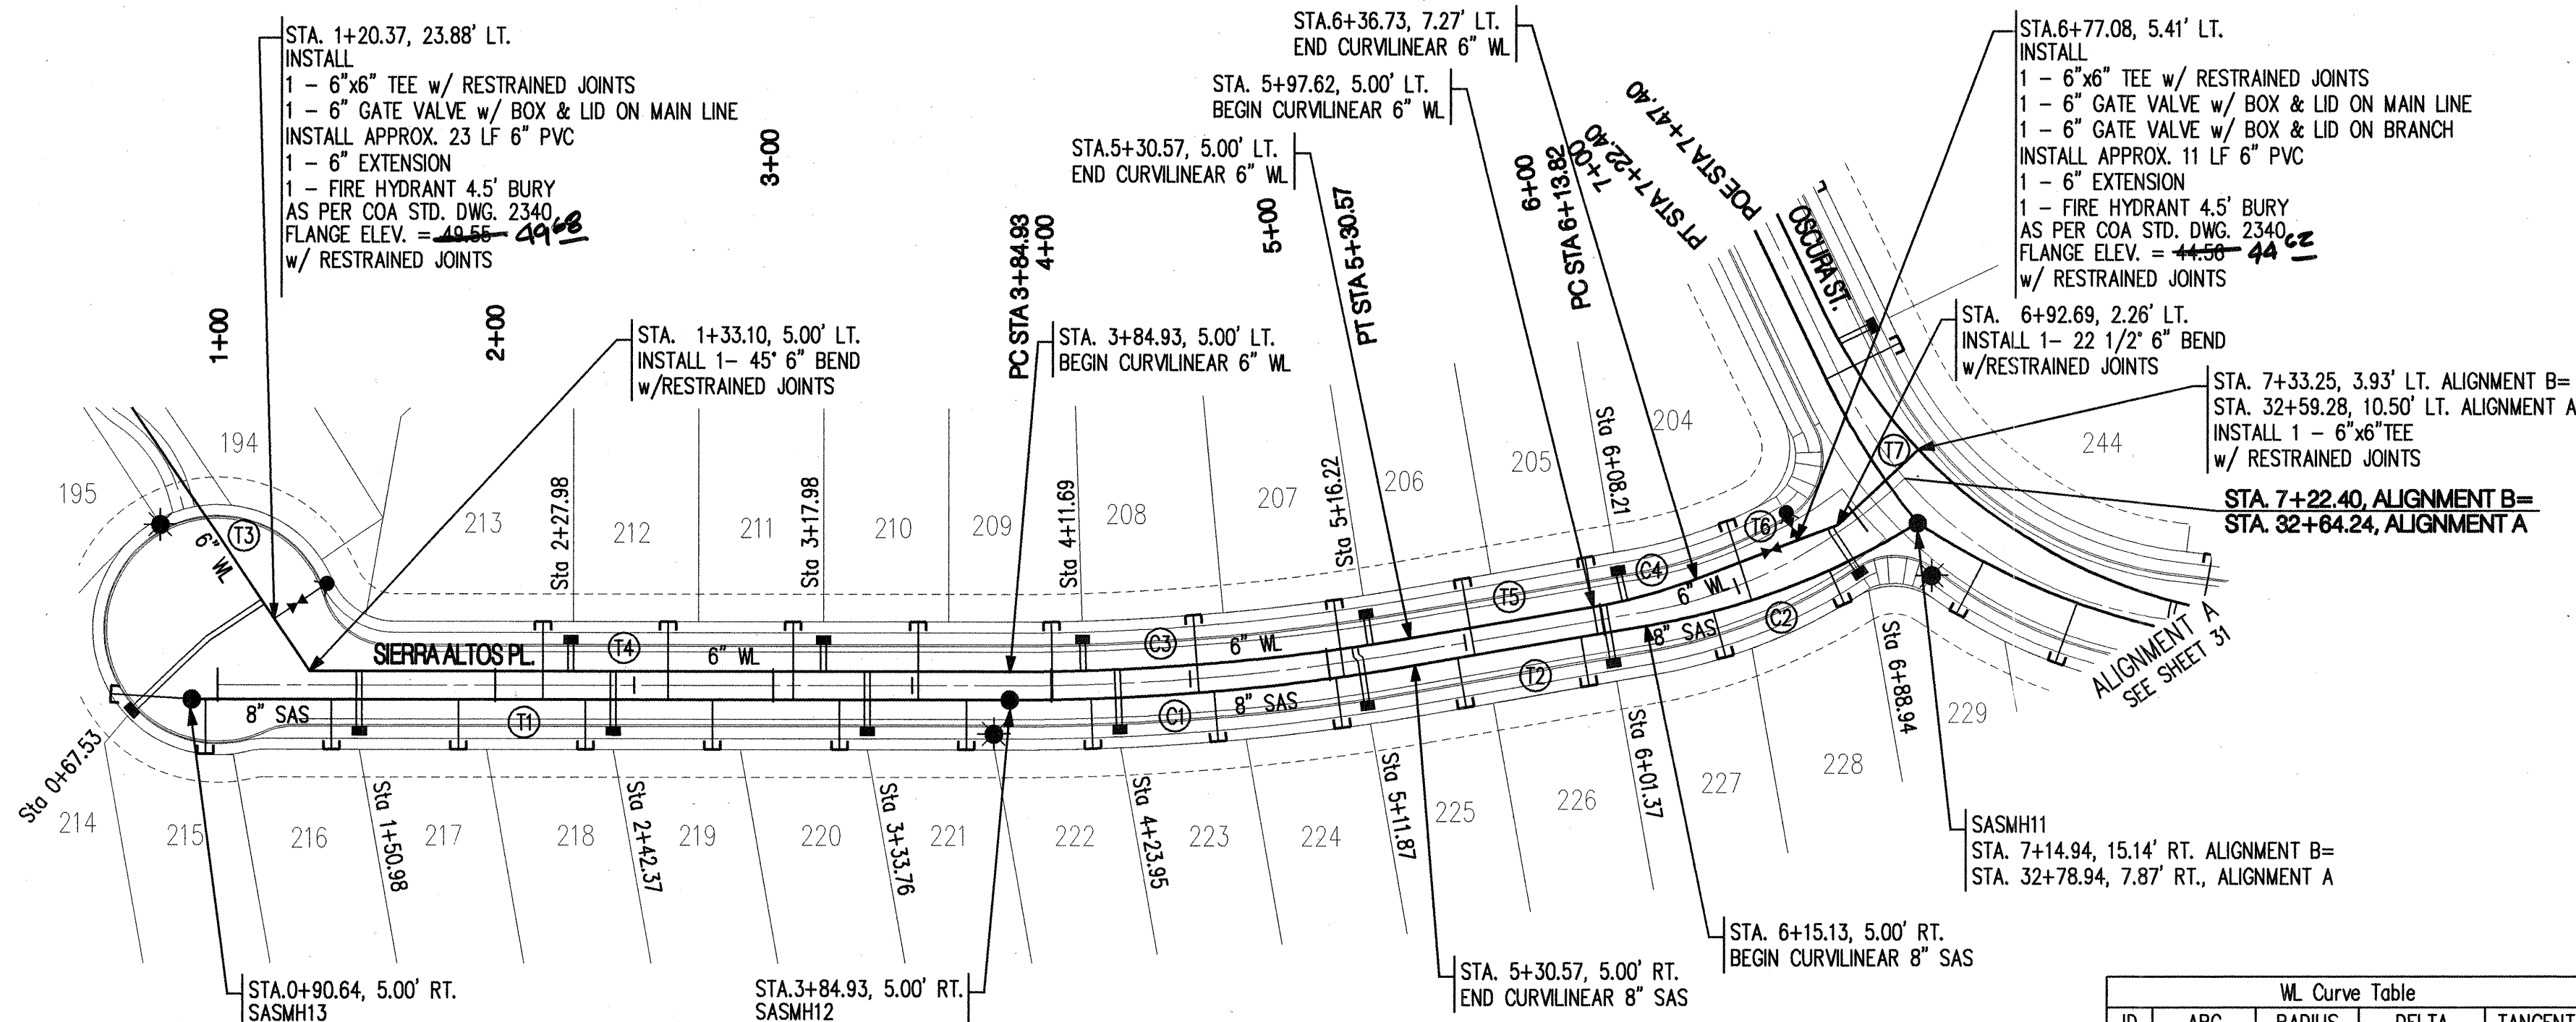

SANITARY SEWER SERVICES			
LOT ID	SAS STATION & OFFSET	SAS LENGTH	TOP OF PIPE AT PLUG (W/ RISER)
204	6+53.10, 6.64' RT.	29.74'	5538.37
205	5+97.65, 5.00' RT.	28.00'	5538.71
206	5+52.65, 5.00' RT.	28.00'	5539.01
207	5+05.25, 5.00' RT.	28.00'	5539.32
208	4+52.85, 5.00' RT.	28.00'	5539.67
209	4+00.44, 5.00' RT.	28.00'	5540.02
210	3+52.08, 5.00' RT.	28.00'	5540.53
211	3+07.08, 5.00' RT.	28.00'	5541.00
212	2+62.08, 5.00' RT.	28.00'	5541.47
213	2+17.08, 5.00' RT.	28.00'	5541.94
214	0+90.64, 5.00' RT.	29.24'	5543.29
215	0+95.65, 5.00' RT.	19.79'	5543.05
216	1+40.98, 5.00' RT.	18.00'	5542.54
217	1+86.68, 5.00' RT.	18.00'	5542.06
218	2+32.37, 5.00' RT.	18.00'	5541.58
219	2+78.07, 5.00' RT.	18.00'	5541.10
220	3+23.76, 5.00' RT.	18.00'	5540.63
221	3+69.46, 5.00' RT.	18.00'	5540.15
222	4+14.21, 5.00' RT.	18.00'	5539.73
223	4+58.26, 5.00' RT.	18.00'	5539.43
224	5+02.14, 5.00' RT.	18.00'	5539.14
225	5+46.37, 5.00' RT.	18.00'	5538.85
226	5+91.37, 5.00' RT.	18.00'	5538.55
227	6+39.21, 5.73' RT.	17.29'	5538.22
228	6+81.60, 9.65' RT.	13.45'	5537.85

NOTE: WATER METER LOCATIONS ARE DESIGNATED BY STATIONING AT PROPERTY CORNERS.

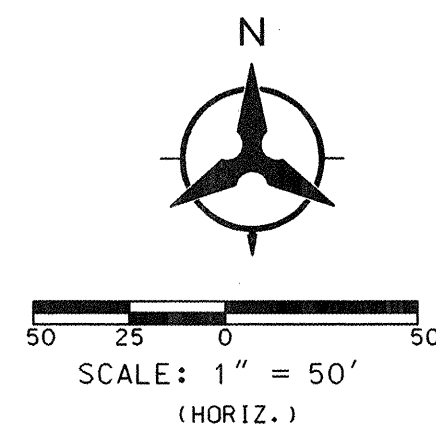


SAS Curve Table				
ID	ARC	RADIUS	DELTA	TANGENT
C1	146.49'	855.00'	09°49'00"	73.42'
C2	105.15'	275.00'	21°54'25"	53.22'

SAS Tangent Table		
ID	BEARING	LENGTH
T1	N89°48'19"W	294.29'
T2	S80°22'41"W	84.60'

WL Curve Table				
ID	ARC	RADIUS	DELTA	TANGENT
C3	144.78'	845.00'	09°49'00"	72.57'
C4	38.36'	200.00'	10°59'22"	19.24'

WL Tangent Table		
ID	BEARING	LENGTH
T3	S33°49'02"E	218.00'
T4	S89°48'19"E	251.83'
T5	N80°22'41"E	67.05'
T6	N69°23'19"E	54.49'
T7	N46°53'19"E	40.06'

ALIGNMENT B

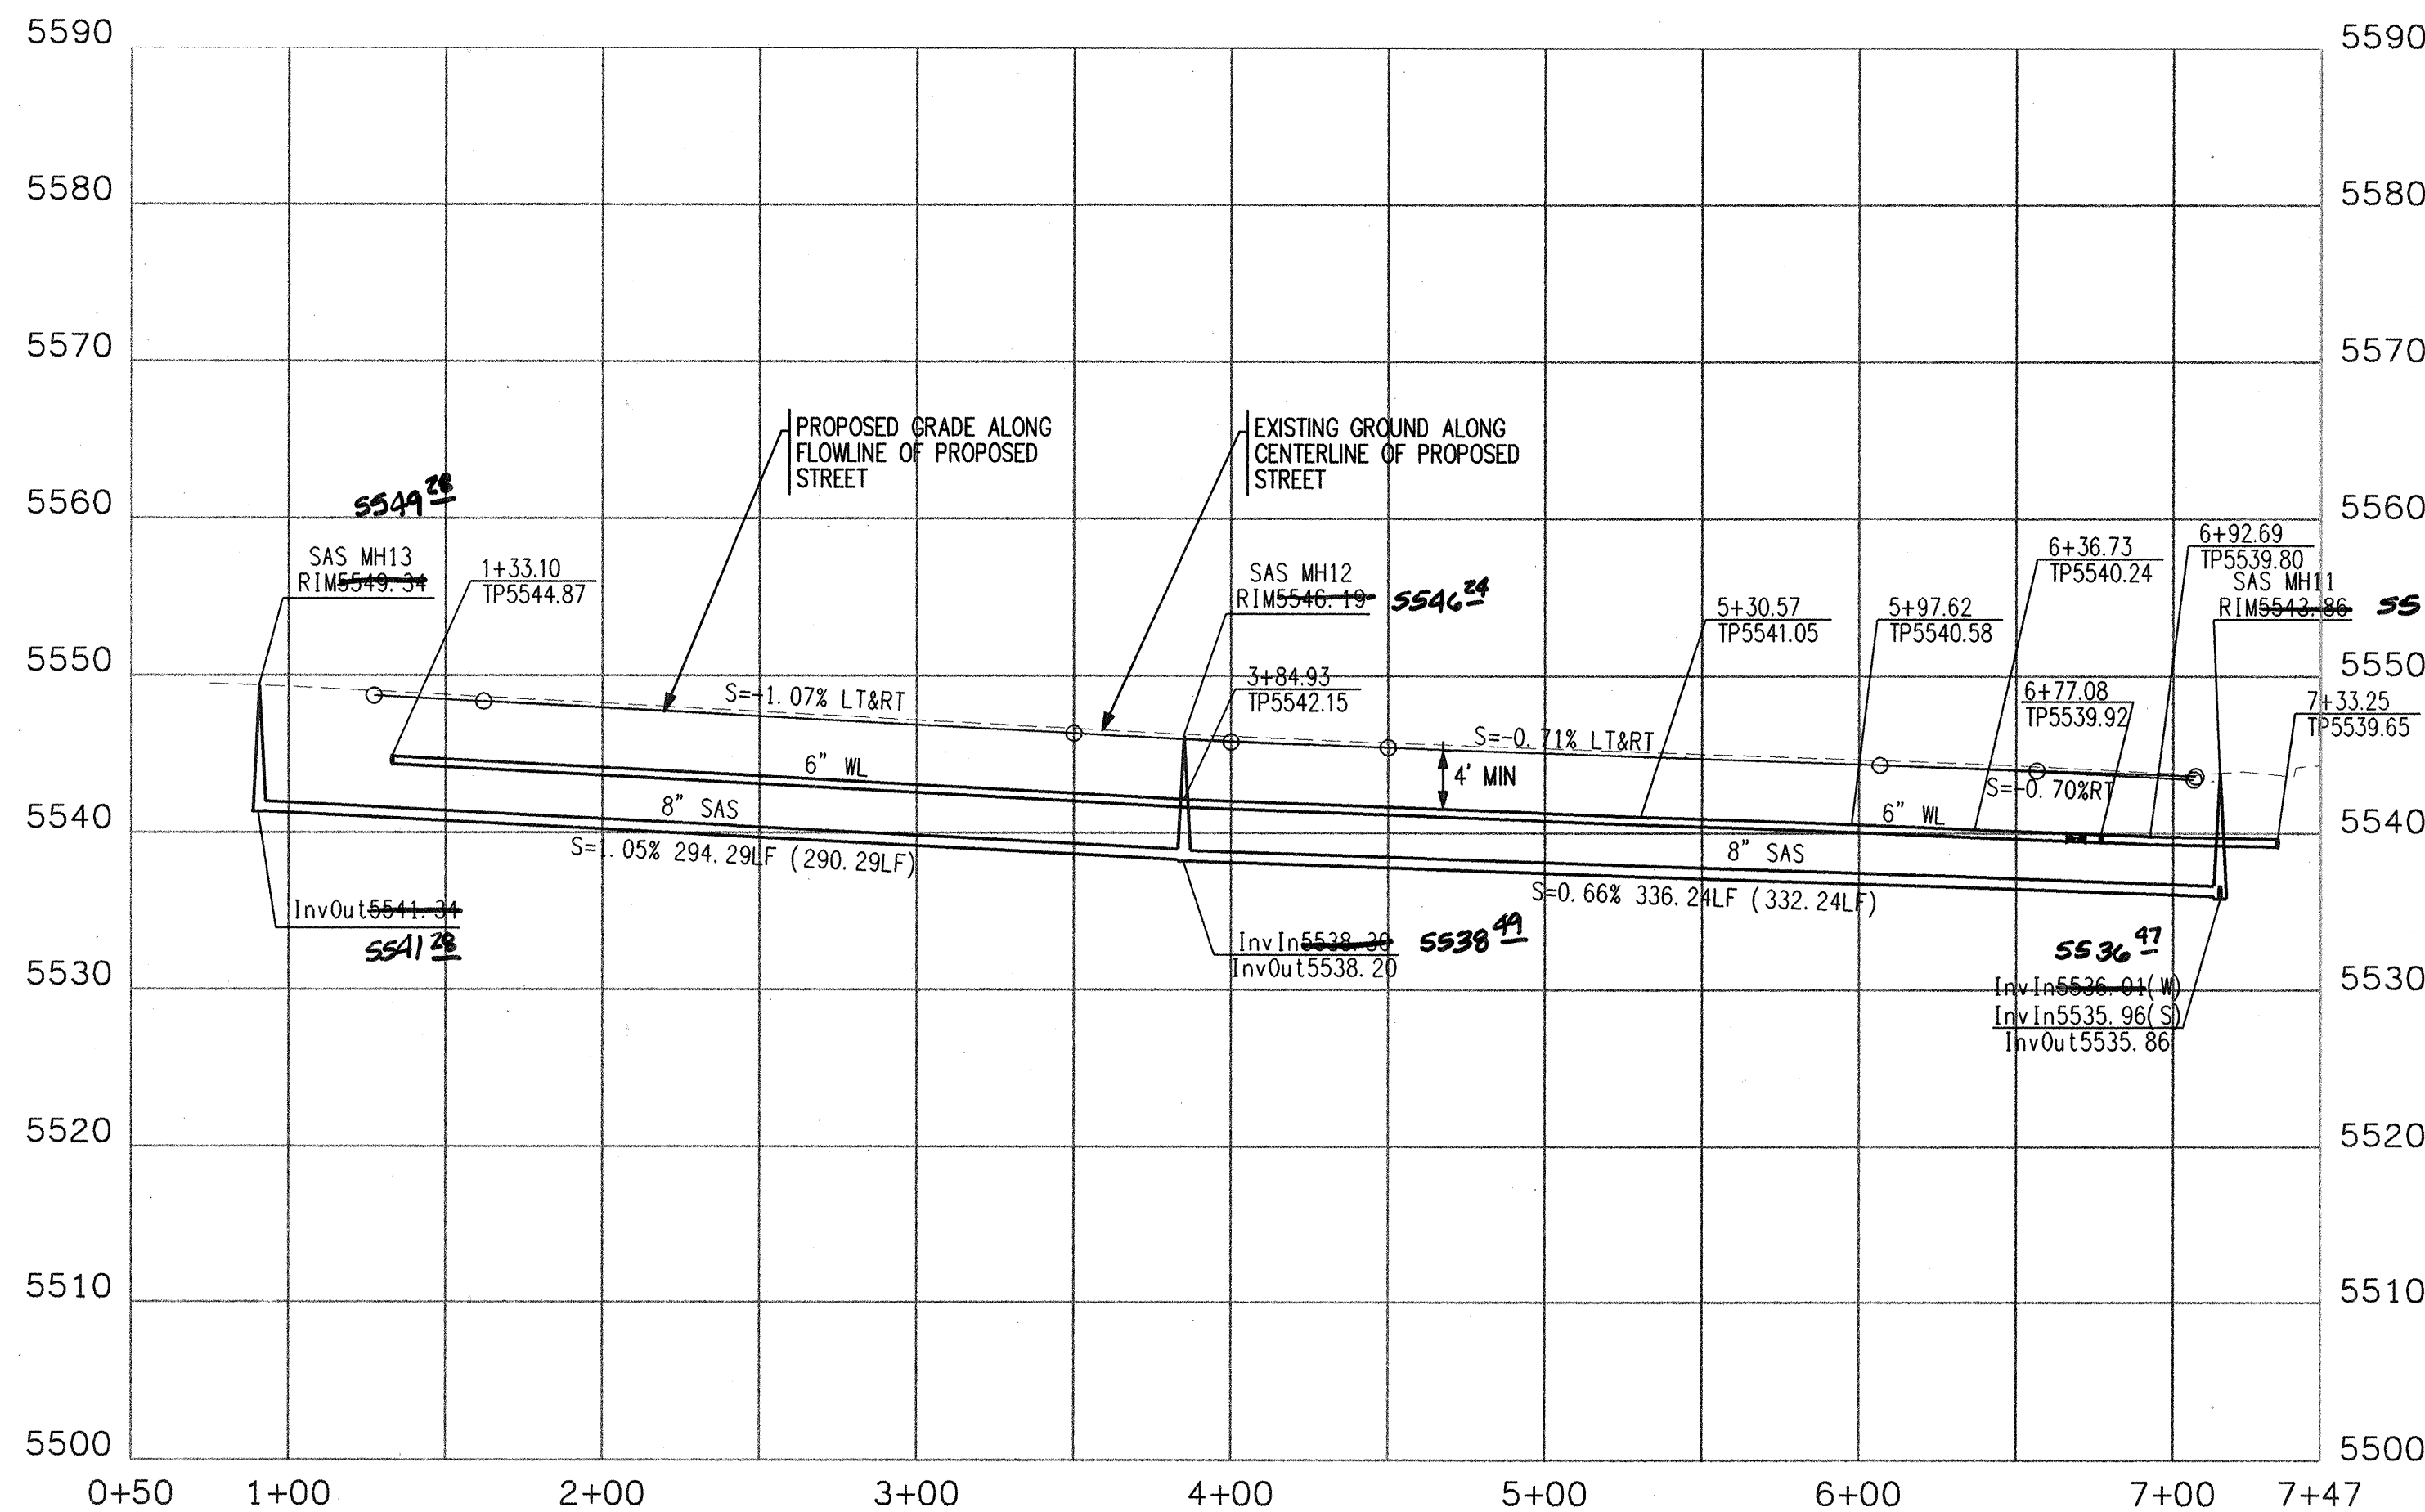

SURVEYORS CERTIFICATION

I, Russ P. Hugg, New Mexico Professional Surveyor Number 9750, Hereby Certify that the as-built information shown hereon is the result of an actual field survey performed by me or under my direct supervision and that the same is true and correct to the best of my knowledge and belief.

Russ P. Hugg
NMPS No. 9750
1-27-2006



GENERAL NOTE:
*ALL SANITARY SEWER MANHOLES SHALL BE 4' DIAMETER TYPE "E" AS PER NM APWA STANDARD DRAWING 2102 UNLESS OTHERWISE NOTED.

APPROVED: [Signature] DATE: 3-14-05

Bohannon & Huston

Courtyard I 7500 Jefferson St. NE Albuquerque, NM 87109-4335
ENGINEERING • SPATIAL DATA • ADVANCED TECHNOLOGIES

CITY OF ALBUQUERQUE
PUBLIC WORKS DEPARTMENT
ENGINEERING DEVELOPMENT GROUP


WESTERN RIDGE (UNIT 2) SUBDIVISION AT VENTANA RANCH WEST
UTILITY PLAN & PROFILE
ALIGNMENT B

DESIGN REVIEW COMMITTEE	CITY ENGINEER APPROVAL	MO./DAY/YR.	MO./DAY/YR.
APPROVED MAR 18 2005 DESIGN REVIEW COMMITTEE	APPROVED SEP 26 2005 CITY ENGINEER		
LAST DESIGN UPDATE			

ZONE MAP NO. 749486
B-8-Z
SHEET 33 OF 37

SCANNED BY PLW

SCANNED BY

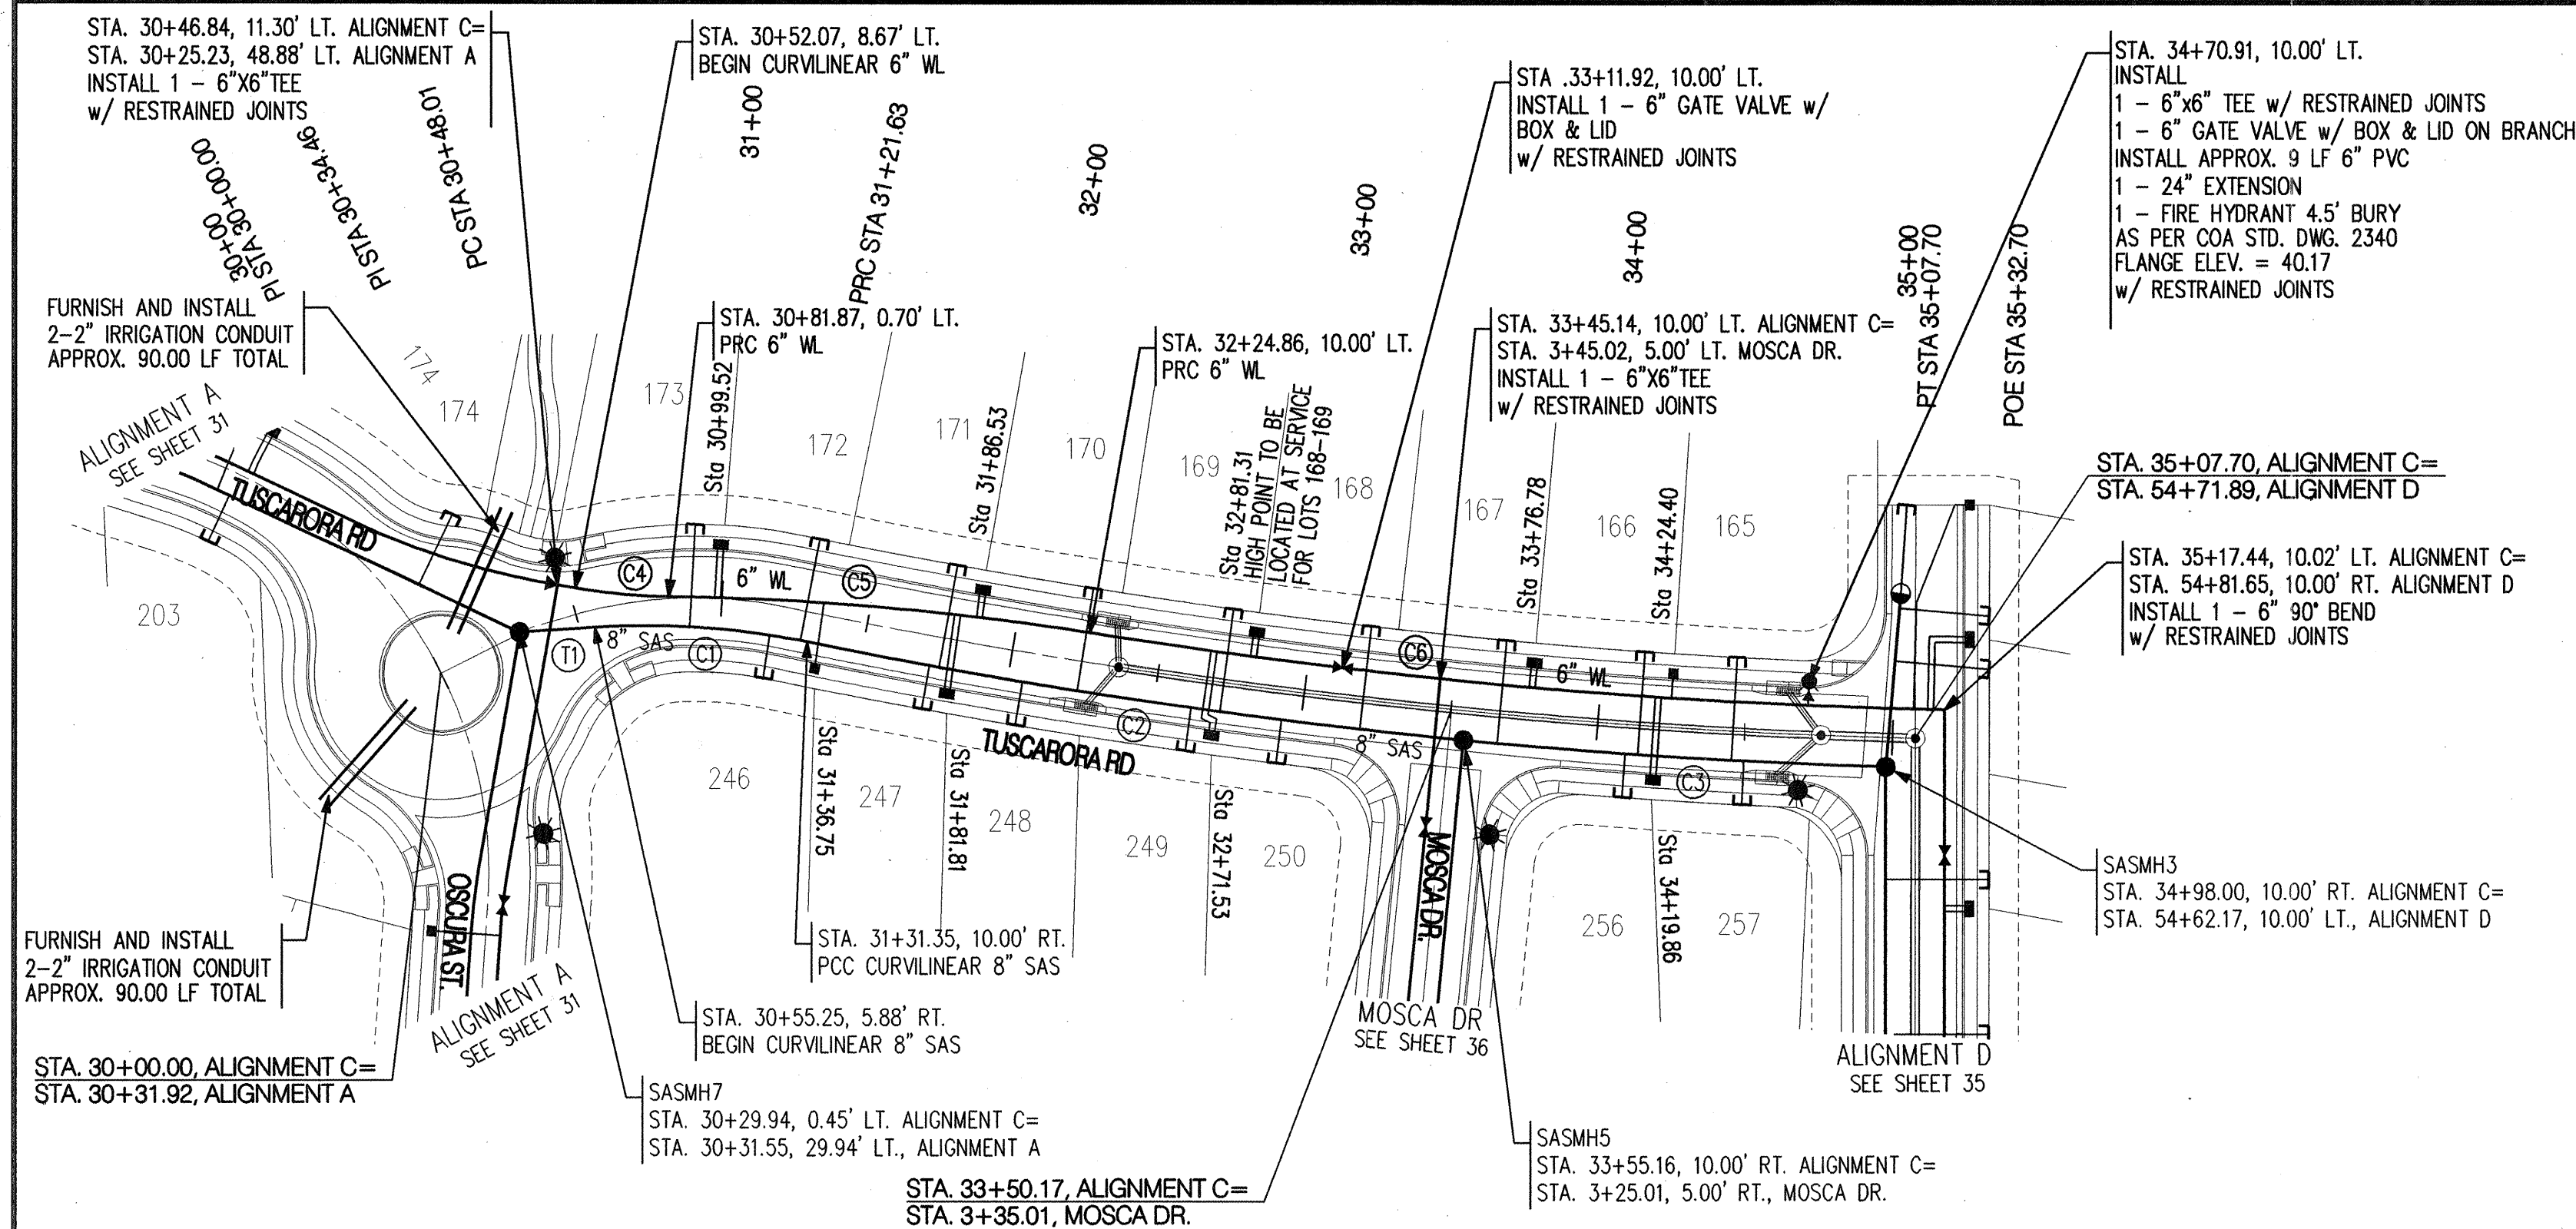


SANITARY SEWER SERVICES			
LOT	SAS	SAS	TOP OF PIPE AT
ID	STATION & OFFSET	LENGTH	PLUG (W/RISER)
165	34+45.92, 10.00' RT.	35.00'	5533.94
166	34+14.29, 10.00' RT.	35.00'	5533.27
167	33+66.67, 10.00' RT.	35.00'	5533.58
168	33+20.03, 10.00' RT.	35.00'	5533.97
169	32+72.41, 10.00' RT.	35.00'	5534.28
170	32+23.81, 10.00' RT.	35.00'	5536.34 (3.00')
171	31+76.58, 10.00' RT.	35.00'	5534.92
172	31+28.96, 10.01' RT.	35.01'	5535.23
173	30+88.95, 9.78' RT.	34.84'	5535.48
246	31+18.14, 10.31' RT.	14.67'	5534.90
247	31+73.33, 10.00' RT.	15.00'	5534.54
248	32+05.11, 10.00' RT.	15.00'	5534.33
249	32+62.68, 10.00' RT.	15.00'	5533.95
250	32+93.40, 10.00' RT.	15.00'	5533.74
256	34+09.97, 10.00' RT.	15.00'	5532.90
257	34+50.17, 10.00' RT.	15.00'	5532.63

NOTE: WATER METER LOCATIONS ARE DESIGNATED BY STATIONING AT PROPERTY CORNERS.


SAS Curve Table				
ID	ARC	RADIUS	DELTA	TANGENT
C1	72.36'	275.00'	15°04'31"	36.39'
C2	224.84'	2192.00'	05°52'37"	112.52'
C3	143.50'	2192.00'	03°45'03"	71.78'

SAS Tangent Table		
ID	BEARING	LENGTH
T1	S57°04'56" W	25.66'

W. Curve Table				
ID	ARC	RADIUS	DELTA	TANGENT
C4	31.72'	200.00'	09°05'18"	15.90'
C5	143.33'	1000.00'	08°12'43"	71.79'
C6	291.29'	2172.00'	07°41'02"	145.86'

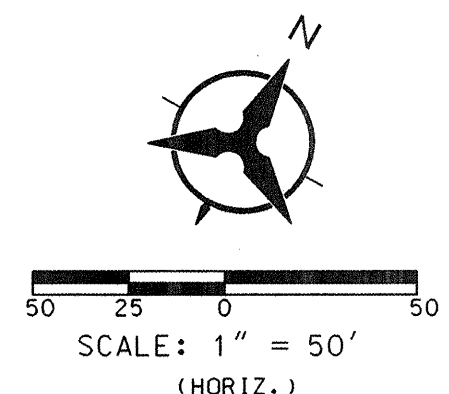


ALIGNMENT C

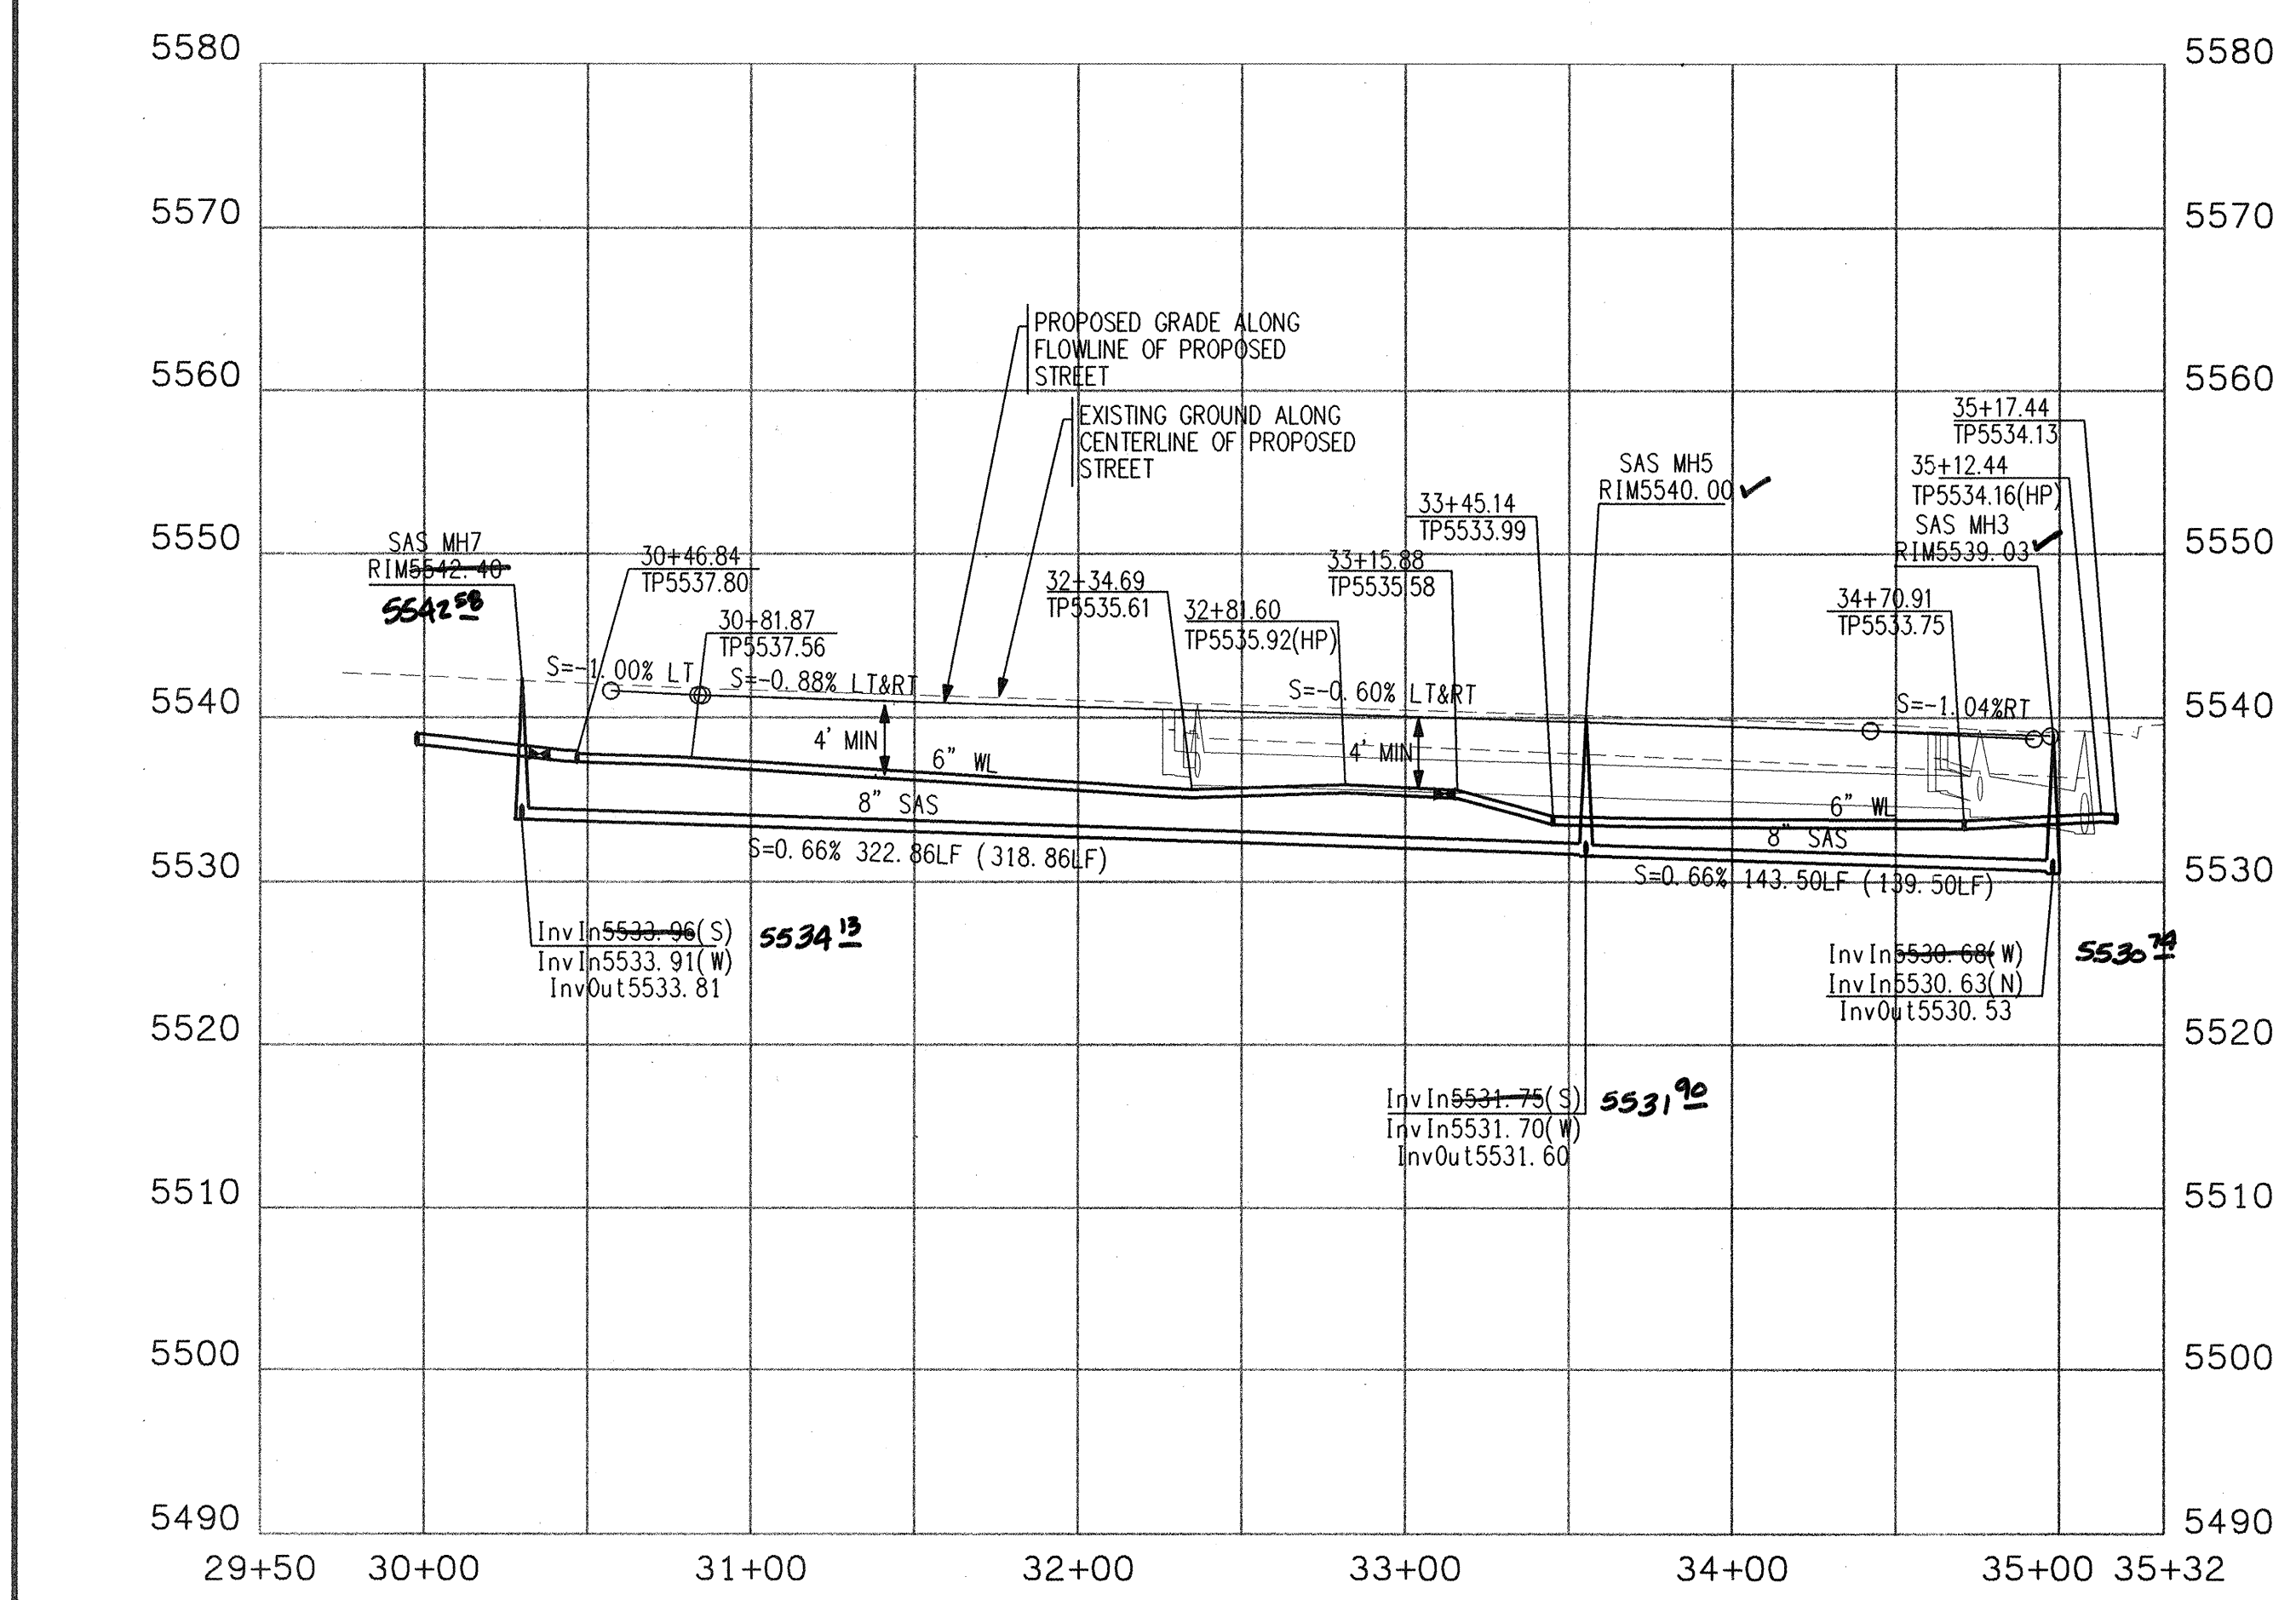

SURVEYORS CERTIFICATION
I, Russ P. Hugg, New Mexico Professional Surveyor Number 9750, hereby certify that the as-built information shown hereon is the result of an actual field survey performed by me or under my direct supervision and that the same is true and correct to the best of my knowledge and belief.

Russ P. Hugg
Russ P. Hugg
NMPS No. 9750

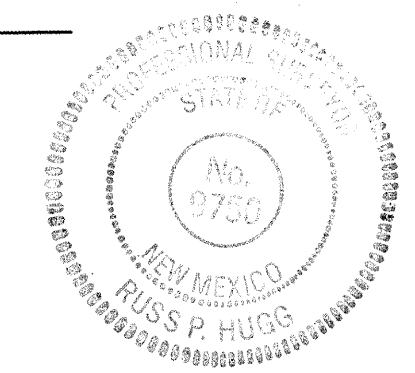

GENERAL NOTE:
*ALL SANITARY SEWER MANHOLES SHALL BE 4' DIAMETER TYPE "E" AS PER NM APWA STANDARD DRAWING 2102 UNLESS OTHERWISE NOTED.

APPROVED: *[Signature]* DATE: 3-14-05

Bohannon & Huston
Courtney I. 7500 Jefferson St. NE Albuquerque, NM 87109-4335
ENGINEERING • SPATIAL DATA • ADVANCED TECHNOLOGIES


CITY OF ALBUQUERQUE
PUBLIC WORKS DEPARTMENT
ENGINEERING DEVELOPMENT GROUP

WESTERN RIDGE (UNIT 2) SUBDIVISION AT VENTANA RANCH WEST
PLAN & PROFILE
ALIGNMENT C

DESIGN REVIEW COMMITTEE: APPROVED MAR 18 2005
CITY ENGINEER APPROVAL: APPROVED SEP 26 2005
LAST DESIGN UPDATE: CITY ENGINEER

MO./DAY/YR. SHEET 34 OF 37

SCANNED BY: PLW

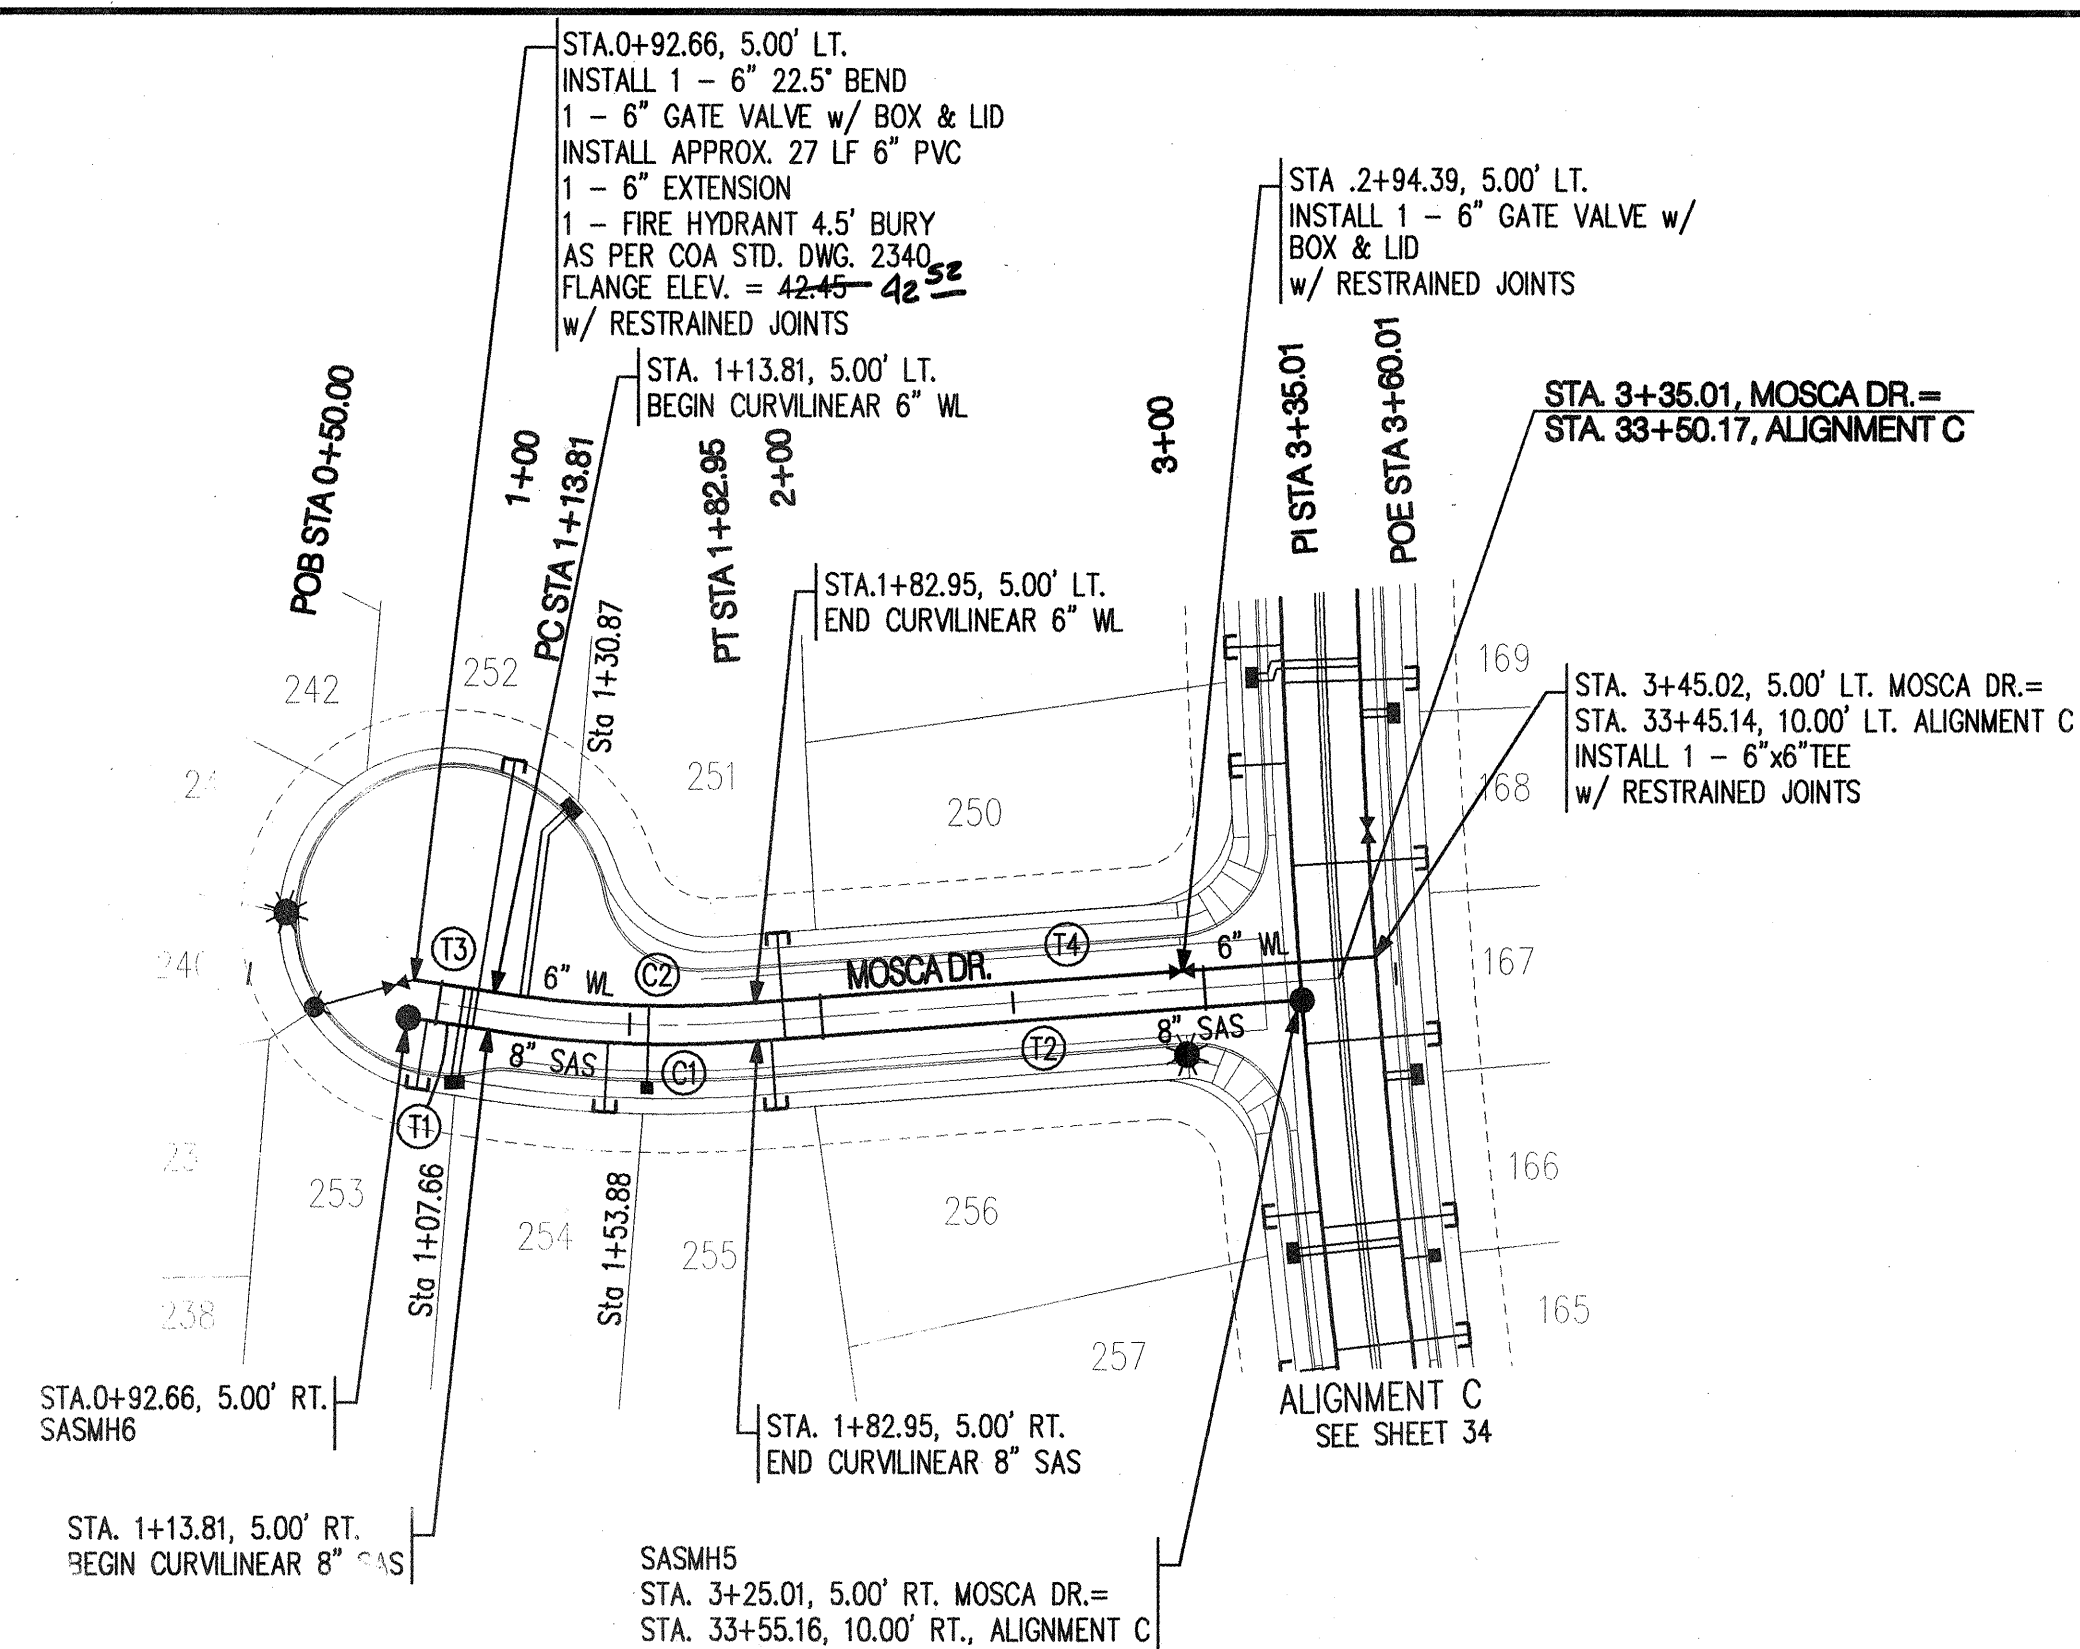

SAS Curve Table				
ID	ARC	RADIUS	DELTA	TANGENT
C1	70.30'	305.00'	131°2'21"	35.31'


SAS Tangent Table		
ID	BEARING	LENGTH
T1	S10°26'07"E	21.15'
T2	S23°38'28"E	142.06'

WL Curve Table				
ID	ARC	RADIUS	DELTA	TANGENT
C2	67.99'	295.00'	131°2'21"	34.15'


WL Tangent Table		
ID	BEARING	LENGTH
T3	N10°26'07"W	21.15'
T4	N23°38'28"W	162.07'

SANITARY SEWER SERVICES			
LOT	SAS	SAS	TOP OF PIPE AT
ID	STATION & OFFSET	LENGTH	PLUG (W/ RISER)
251	1+90.15, 5.00' RT.	28.00'	5534.79
252	1+09.66, 5.00' RT.	70.95'	5536.38
253	0+97.66, 5.00' RT.	17.94'	5535.42
254	1+44.59, 5.00' RT.	18.00'	5535.00
255	1+86.50, 5.00' RT.	18.00'	5534.62

NOTE: WATER METER LOCATIONS ARE DESIGNATED BY STATIONING AT PROPERTY CORNERS.

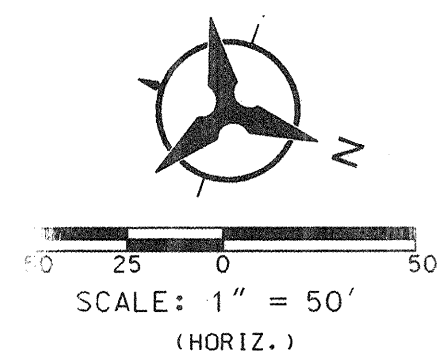


MOSCA DR.

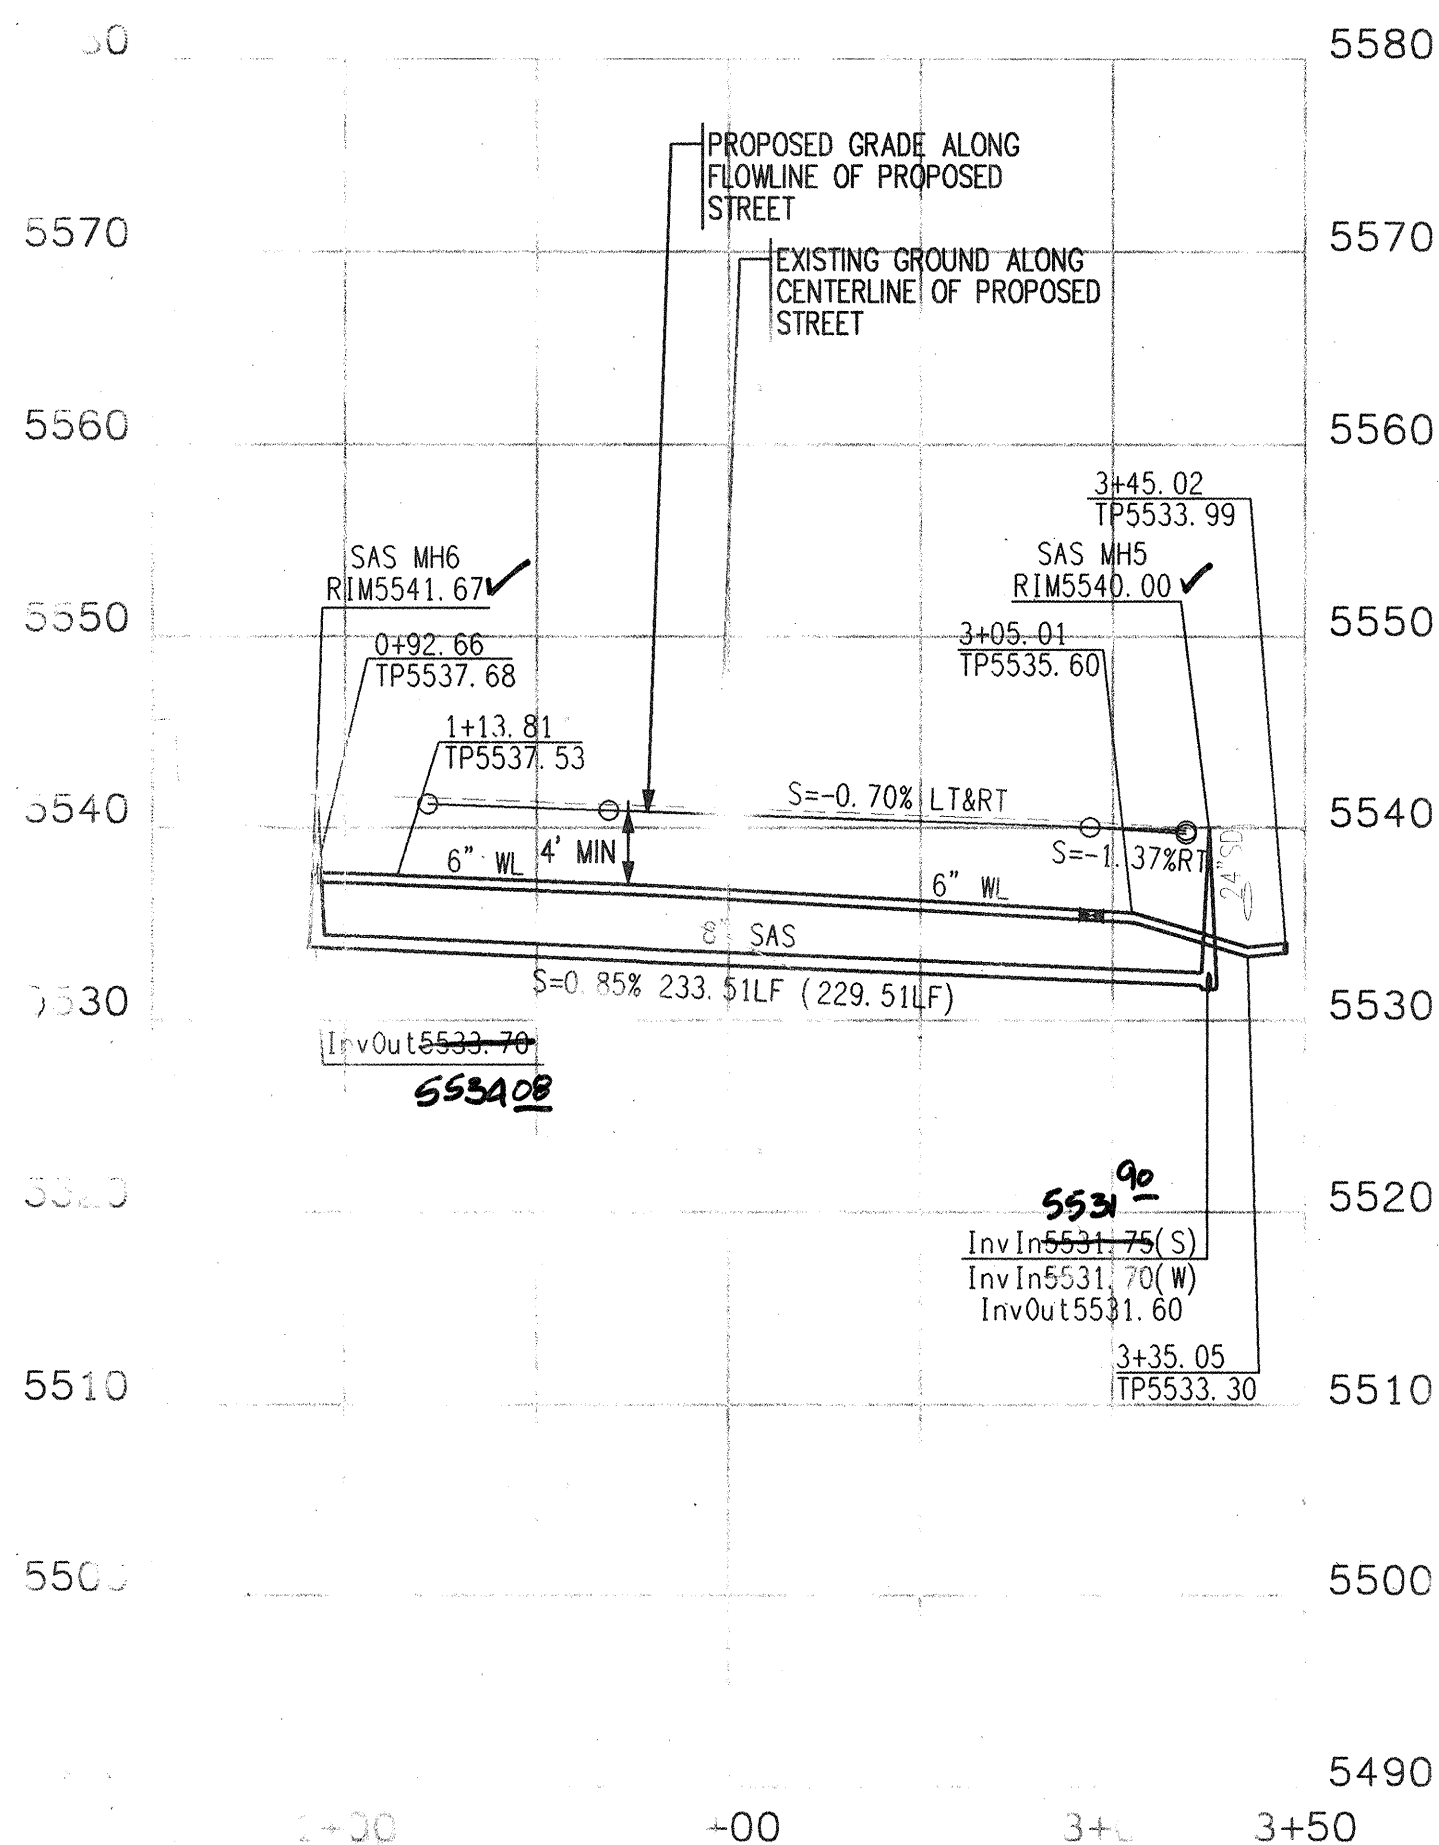

SURVEYORS CERTIFICATION

I, Russ P. Hugg, New Mexico Professional Surveyor Number 9750, Hereby Certify that the as-built information shown hereon is the result of an actual field survey performed by me or under my direct supervision and that the same is true and correct to the best of my knowledge and belief.

Russ P. Hugg
NMPS No. 9750
1.27.06

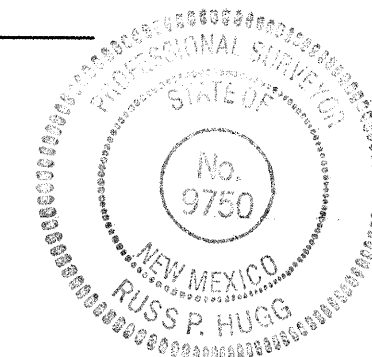

SCALE

BHI JOB NO. 050125

NOTES

- THE CONTRACTOR SHALL FIELD VERIFY ALL EXISTING UTILITY LOCATIONS AND NOTIFY THE ENGINEER IMMEDIATELY OF ANY DISCREPANCIES.
- ALL CURB RETURN RADI SHALL BE 25' UNLESS OTHERWISE SPECIFIED.
- ALL CURVE DATA AND DIMENSIONS REFER TO FACE OF CURB UNLESS OTHERWISE SPECIFIED.
- GRADE ELEVATIONS, WHERE NOTED, ARE ALONG FLOWLINE OF STANDARD CURB UNLESS OTHERWISE SPECIFIED.
- CONTRACTOR IS RESPONSIBLE FOR REPAIR AND/OR REPLACEMENT OF ALL UTILITY CONDUITS AND EXISTING LINES.
- ANY ADDITIONAL GRADING REQUIRED TO MATCH PROPOSED STREET GRADES SHALL BE INCIDENTAL TO PAVING ITEMS.
- CONTRACTOR SHALL PROVIDE THE INSPECTORS, (CITY AND PRIVATE) WITH THE PROPOSED HYDROSTATIC TESTING PLAN. THE PLAN MUST BE APPROVED BEFORE TESTING OPERATIONS BEGIN.
- CONTRACTOR SHALL PARK EQUIPMENT AND VEHICLES AS NOT TO INTERFERE WITH NORMAL ACTIVITIES OF RESIDENTS OR OTHER CONTRACTORS ON SITE.
- ANY DAMAGE TO THE EXISTING FACILITIES (CURB & GUTTER, PAVEMENT, CONDUITS, LANDSCAPING, UTILITY LINES, ETC.) DURING CONSTRUCTION SHALL BE REPLACED AT THE CONTRACTORS' EXPENSE.
- WHEELCHAIR RAMPS SHALL BE CONSTRUCTED PRIOR TO ACCEPTANCE OF CURB & GUTTER.
- ALL EXCAVATION, TRENCHING AND SHORING ACTIVITIES MUST BE CARRIED-OUT IN ACCORDANCE WITH OSHA 29 CFR 1926.650 SUBPART P.

BENCH MARKS		AS-BUILT INFORMATION	
CONTRACTOR	WORK	CONTRACTOR	WORK
STAKED BY	DATE	STAKED BY	DATE
ACCEPTANCE BY	DATE	ACCEPTANCE BY	DATE
FIELD VERIFICATION BY	DATE	FIELD VERIFICATION BY	DATE
DRAWINGS CORRECTED BY	DATE	DRAWINGS CORRECTED BY	DATE
MICRO-FILM INFORMATION		MICRO-FILM INFORMATION	
RECORDED BY		RECORDED BY	
NO.		NO.	


ACS BRASS TABLE STAMPED 2-B10 1980

GEOGRAPHIC POSITION (NAD 1927)

DATE

(CENTRAL ZONE)

NO. 1979 ELEVATION = 5429.35

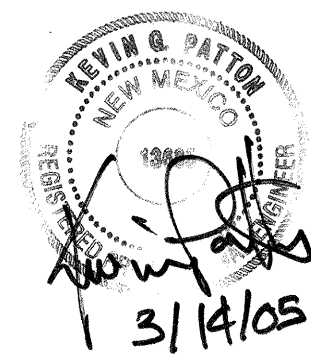

GENERAL NOTE:
ALL SANITARY SEWER MANHOLES SHALL BE 4' DIAMETER TYPE "E" AS PER NM APWA STANDARD DRAWING 2102 UNLESS OTHERWISE NOTED.

APPROVED: [Signature] DATE: 3-14-05

Bohannon & Huston

Courtesy: 7500 Jefferson St. NE Albuquerque, NM 87109-4331
ENGINEERING • SPATIAL DATA • ADVANCED TECHNOLOGIES


CITY OF ALBUQUERQUE
PUBLIC WORKS DEPARTMENT
ENGINEERING DEVELOPMENT

WEST RIDGE UNIT 2 JBDIVISION
UTILITY PLAN & PRO MOSCA DR.


DESIGN APPROVED
MAR 16 2005

REVIEW APPROVED
SEP 26 2005
CITY ENGINEER

STA. 1+00.00, TRES HERMANAS ST=
STA. 53+04.40, ALIGNMENT D

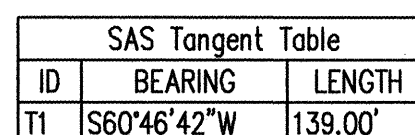


TRES HERMANAS ST

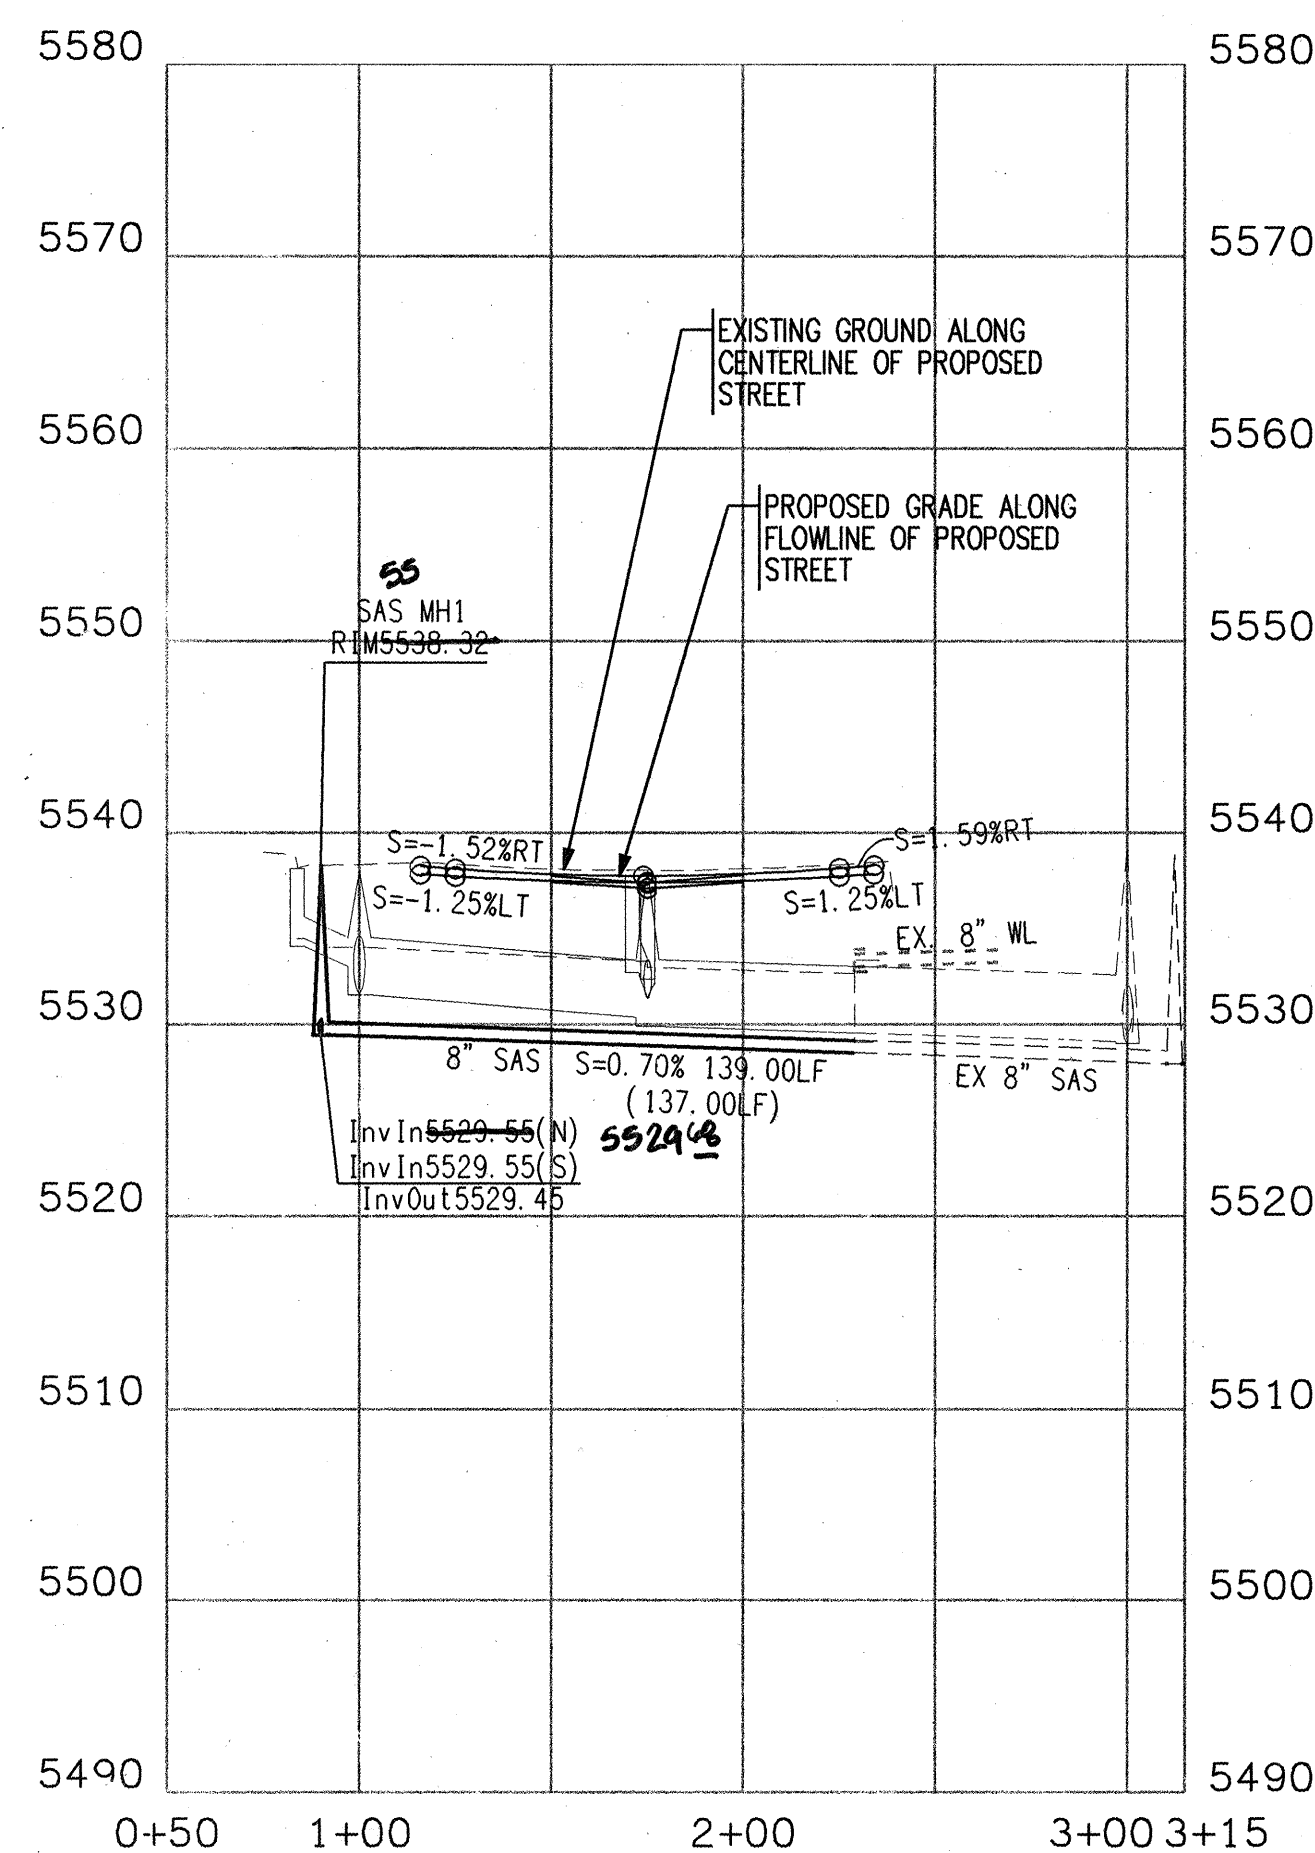


SURVEYORS CERTIFICATION

I, Russ P. Hugg, New Mexico Professional Surveyor Number 9750,
Hereby Certify that the as-built information shown hereon is the
result of an actual field survey performed by me or under my
direct supervision and that the same is true and correct to the
best of my knowledge and belief.

Russ P. Hugg
NMPS No. 9750
1-27-20

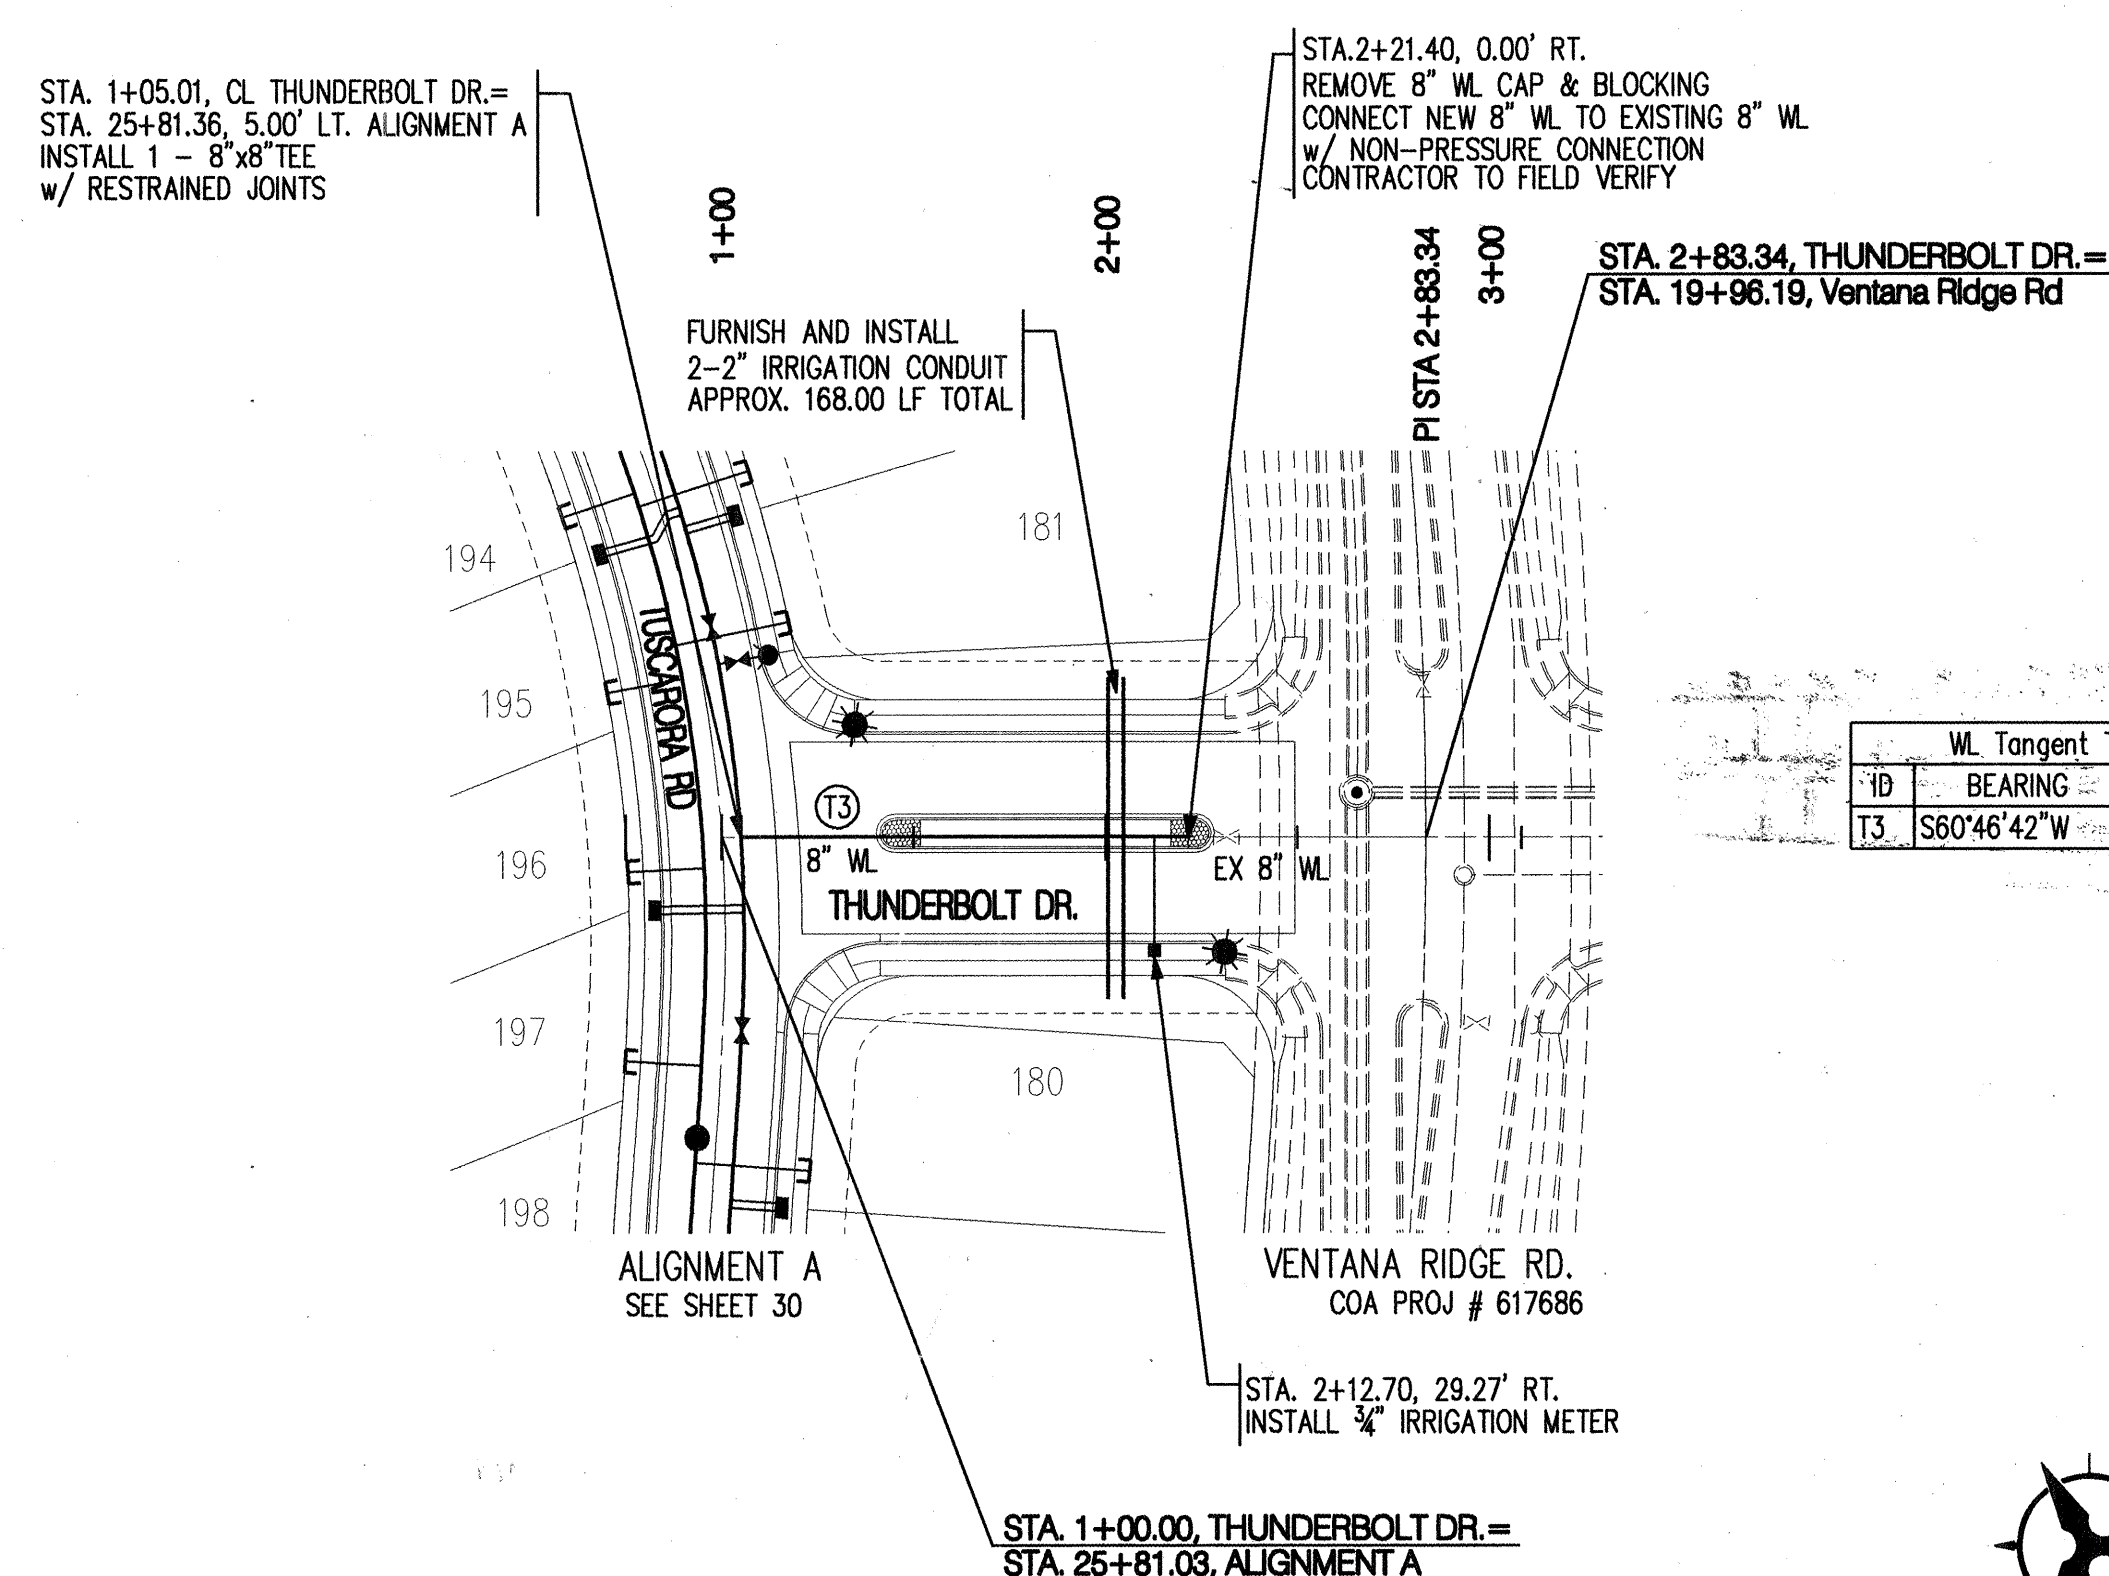


WL Tangent Table		
ID	BEARING	LENGTH
T3	S60°46'42"W	116.39'

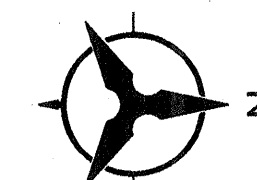

50 25 0 5
SCALE: 1" = 50'
(HORIZ.)


THUNDERBOLT DR

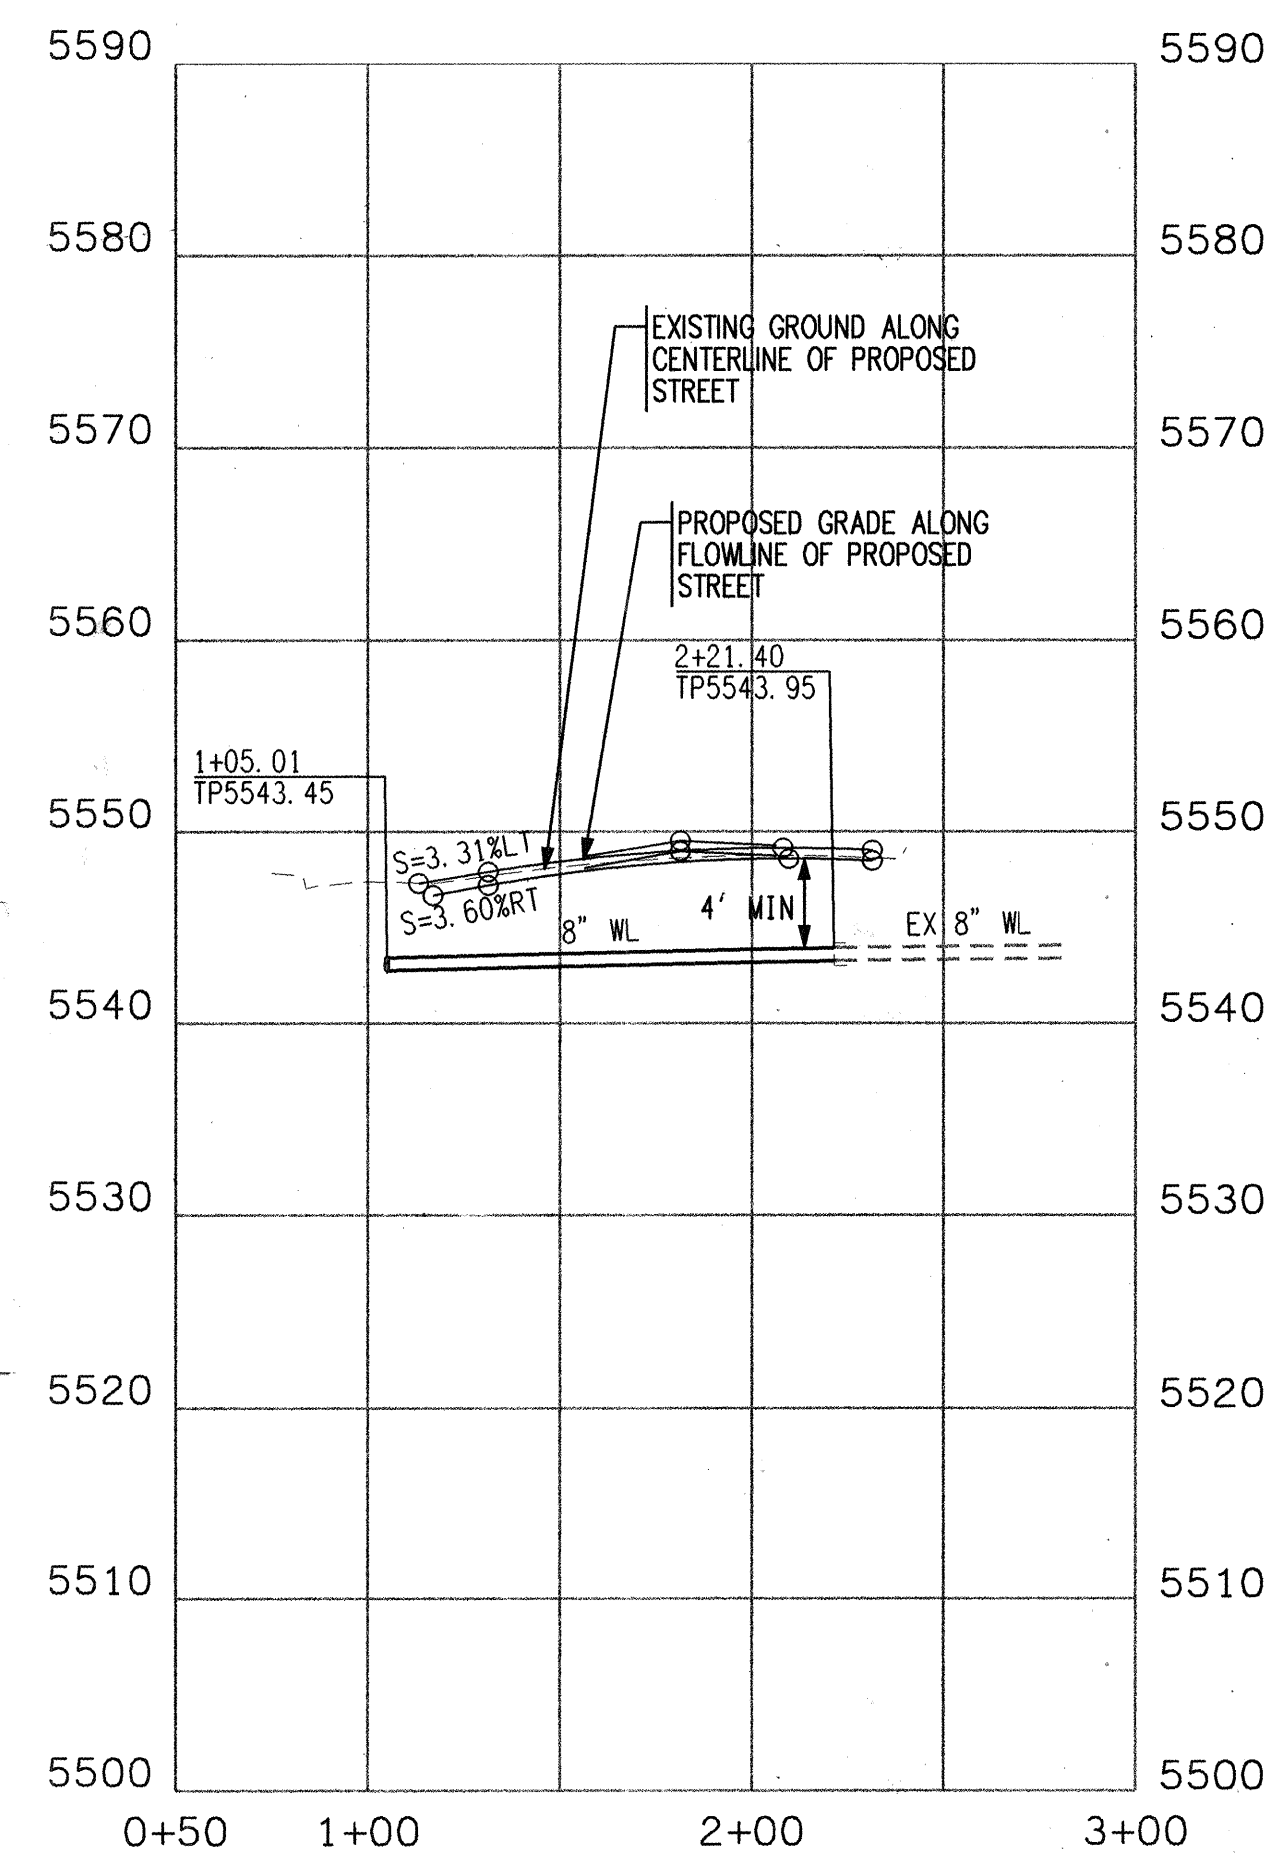

NOTES

1. THE CONTRACTOR SHALL FIELD VERIFY ALL EXISTING UTILITY LOCATIONS AND NOTIFY THE ENGINEER IMMEDIATELY OF ANY DISCREPANCIES.
2. ALL CURB RETURN RADII SHALL BE 25' UNLESS OTHERWISE SPECIFIED.
3. ALL CURVE DATA AND DIMENSIONS REFER TO FACE OF CURB UNLESS OTHERWISE SPECIFIED.
4. GRADE ELEVATIONS, WHERE NOTED, ARE ALONG FLOWLINE OF STANDARD CURB UNLESS OTHERWISE SPECIFIED.
5. CONTRACTOR IS RESPONSIBLE FOR REPAIR AND/OR REPLACEMENT OF ALL UTILITY CONDUITS AND EXISTING LINES.
6. ANY ADDITIONAL GRADING REQUIRED TO MATCH PROPOSED STREET GRADES SHALL BE INCIDENTAL TO PAVING ITEMS.
7. CONTRACTOR SHALL PROVIDE THE INSPECTORS, (CITY AND PRIVATE) WITH THE PROPOSED HYDROSTATIC TESTING PLAN. THE PLAN MUST BE APPROVED BEFORE TESTING OPERATIONS BEGIN.
8. CONTRACTOR SHALL PARK EQUIPMENT AND VEHICLES AS NOT TO INTERFERE WITH NORMAL ACTIVITIES OF RESIDENTS OR OTHER CONTRACTORS ON SITE.
9. ANY DAMAGE TO THE EXISTING FACILITIES (CURB & GUTTER, PAVEMENT, CONDUITS, LANDSCAPING, UTILITY LINES, ETC.) DURING CONSTRUCTION SHALL BE REPLACED AT THE CONTRACTOR'S EXPENSE.
10. WHEELCHAIR RAMPS SHALL BE CONSTRUCTED PRIOR TO ACCEPTANCE OF CURB & GUTTER.
11. ALL EXCAVATION, TRENCHING AND SHORING ACTIVITIES MUST BE CARRIED-OUT IN ACCORDANCE WITH OSHA 29 CFR 1926.650 SUBPART P.

SURVEY INFORMATION			BENCH MARKS	AS-BUILT INFORMATION
FIELD NOTES				
NO.	BY	DATE		
			ACS BRASS TABLET STAMPED "2-B10 1980"	CONTRACTOR
			GEOGRAPHIC POSITION (NAD 1927)	WORK STARTED BY
				DATE OF WORK ACCEPTANCE
			(CENTRAL ZONE)	DATE
				FIELD LOCATION BY
				DRAWINGS
				CORRECTED BY
				DATE
				MICRO-FILM INFORMATION
				RECORDED BY
				DATE
			NGVD 1929 ELEVATION = 5429.35	NO.

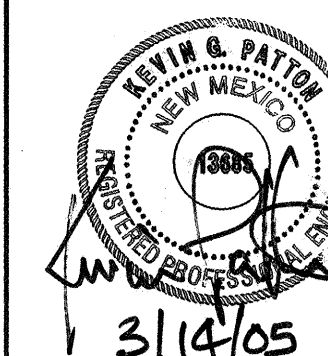

3/14/0

[illegible]


GENERAL NOTE:

***ALL SANITARY SEWER MANHOLES SHALL BE 4' DIAMETER TYPE "E" AS PER NM APWA STANDARD DRAWING 2102 UNLESS OTHERWISE NOTED.**

APPROVED FOR NMUI 3-17-00
DATE

Bohannon ▲ Huston

Courtyard I 7500 Jefferson St. NE Albuquerque, NM 87109-4335
ENGINEERING ▲ SPATIAL DATA ▲ ADVANCED TECHNOLOGIES

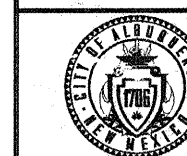
CITY OF ALBUQUERQUE
PUBLIC WORKS DEPARTMENT
ENGINEERING DEVELOPMENT GROUP

WESTERN RIDGE (UNIT 2) SUBDIVISION AT VENTANA RANCH WEST
UTILITY PLAN & PROFILE
TRES HERMANAS ST / THUNDERBOLT DR

DESIGN REVIEW COMMITTEE

APPROVE

MAR 16 2005

DESIGN REVIEW COMMITTEE

CITY ENGINEER APPROVAL
APPROVED
SEP 26 2005
CITY ENGINEER

LAST DESIGN UPDATE	MO./DAY/YR.	MO./DAY/YR.

14-MAR-2005 -
P:\050125\opvnp...2\050125upnp08.dgn

BHI JOB NO. 050125

SCALE: 1" = 50' (HORIZ.)
1" = 10' (VERT.)

CITY PROJECT NO.	
------------------	--

749486

ZONE MAP NO.
B-8-Z

EET 37 OF 37