



SCANNED BY
PLANNING

RECORD DRAWING
FOR CERTIFICATION, SEE SHEET 1

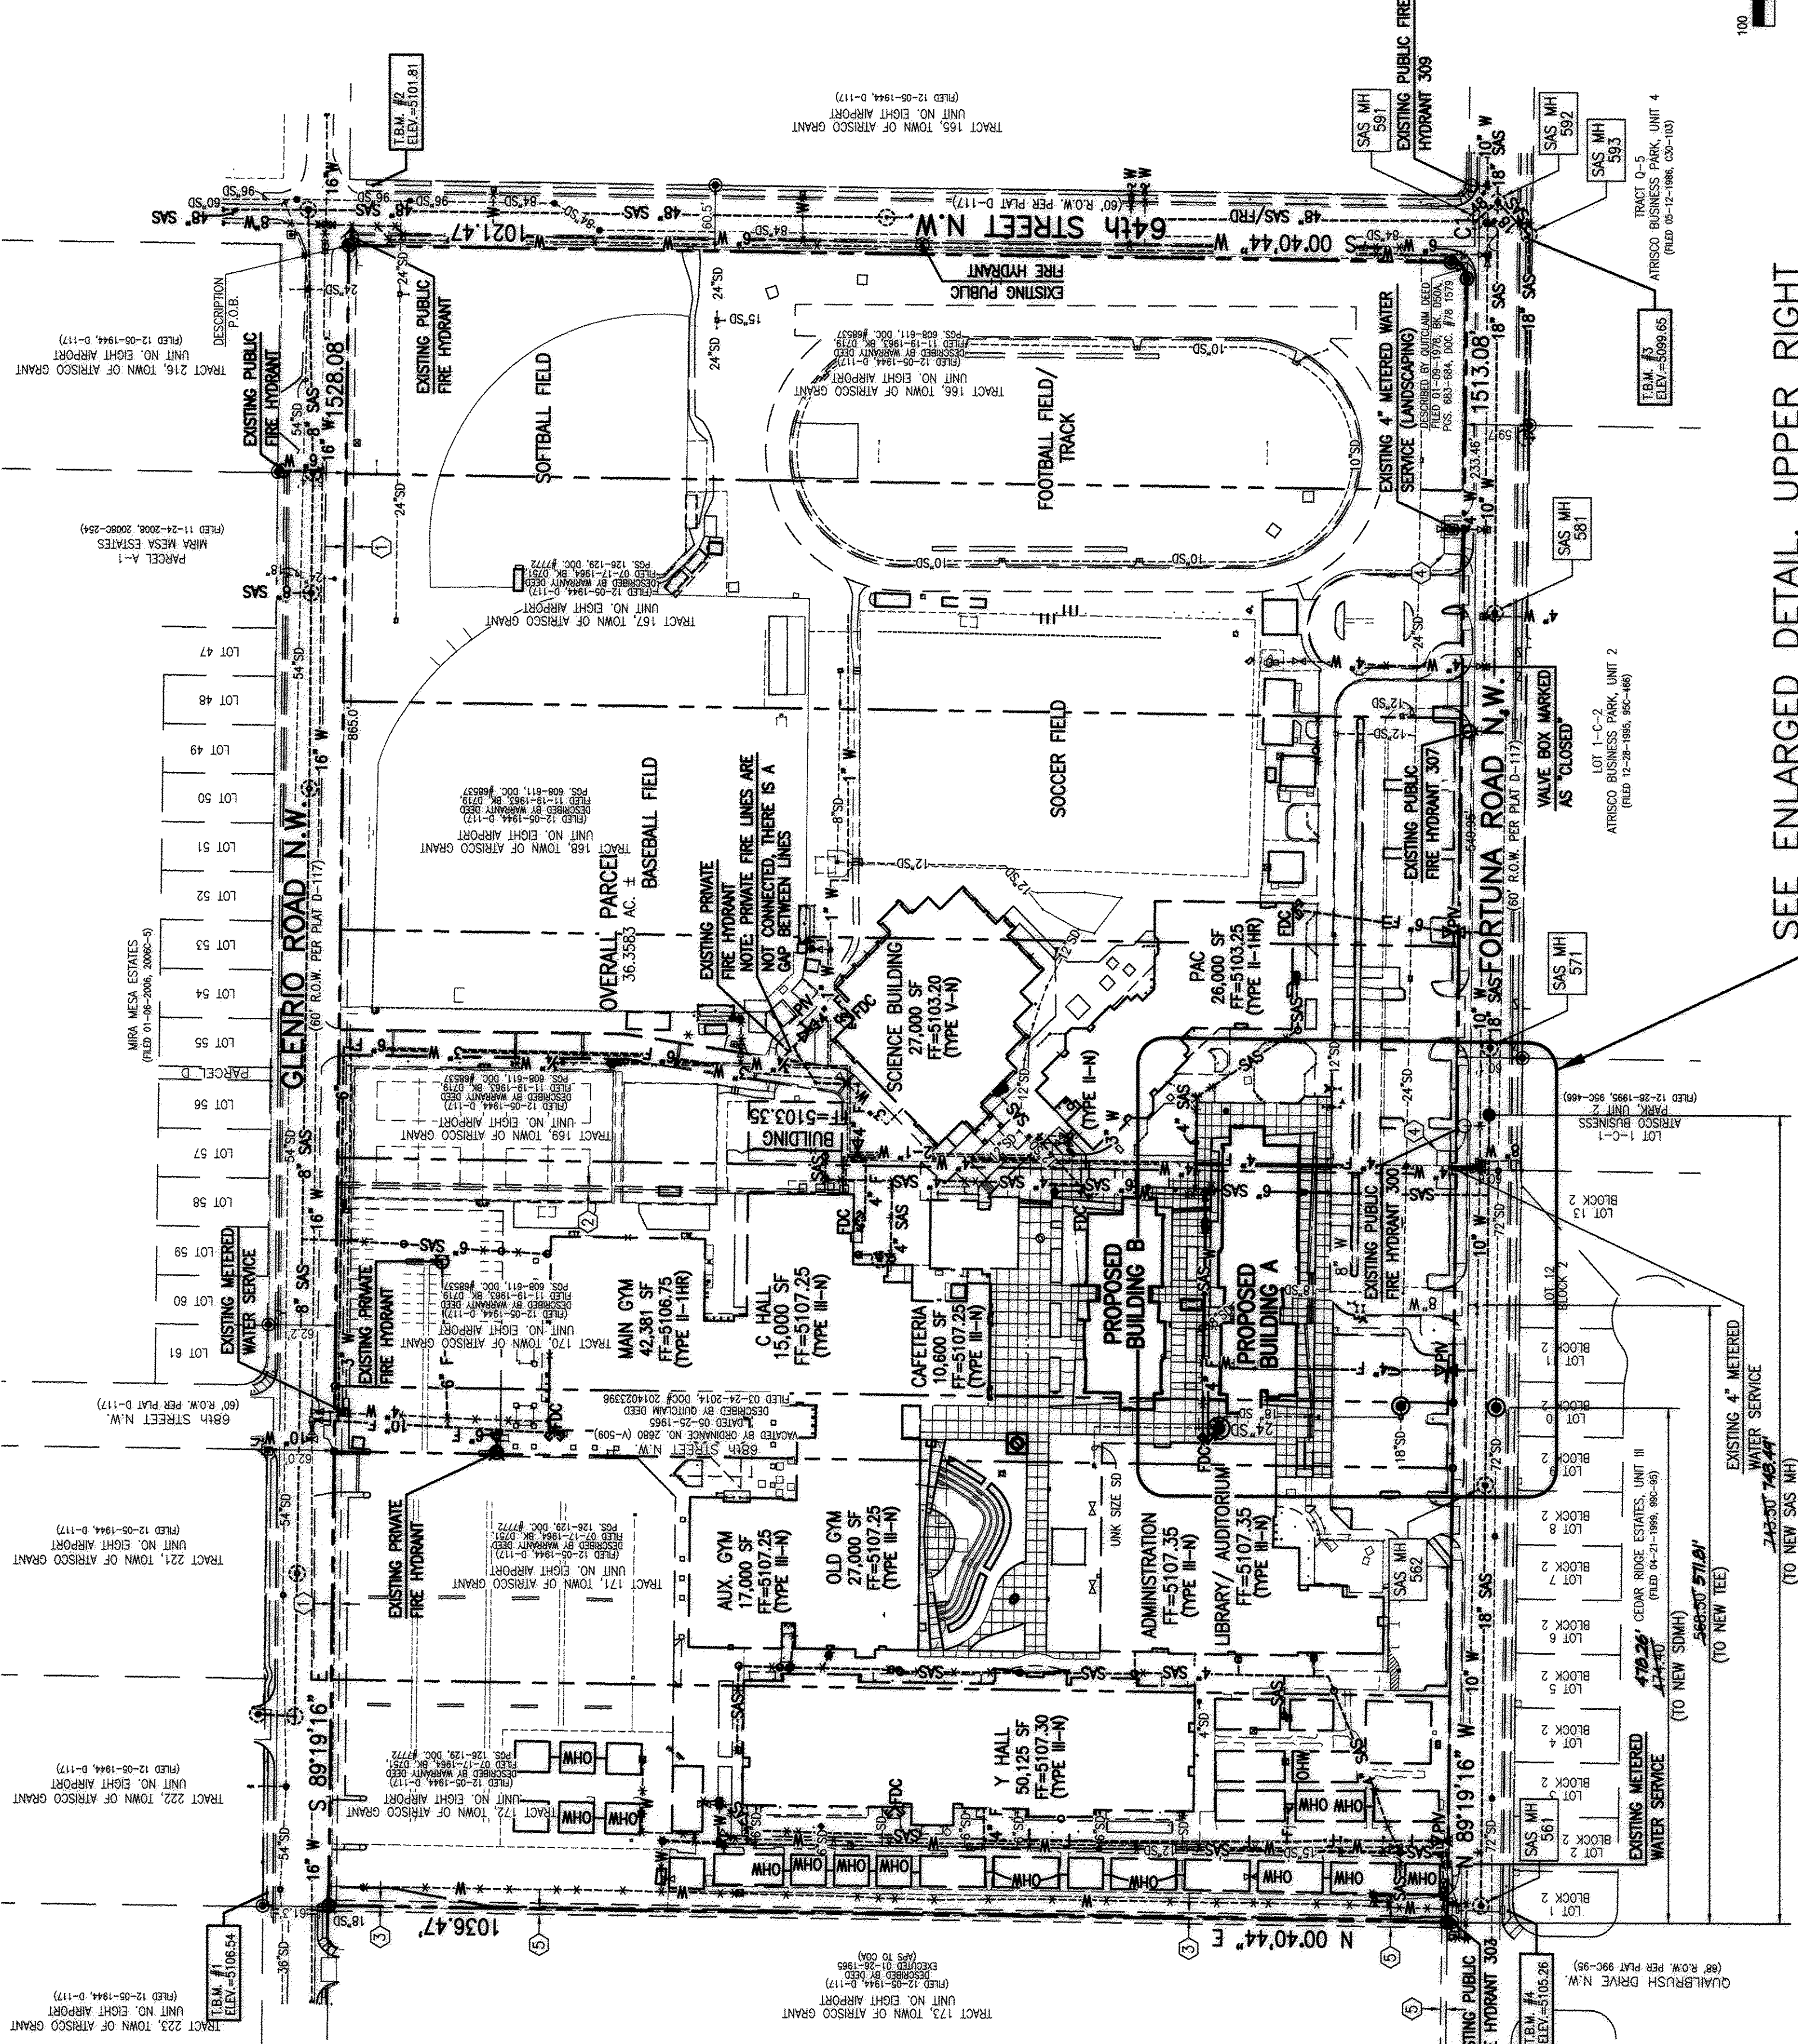

SEE ENLARGED DETAIL, UPPER RIGHT
FOR EXISTING AND PROPOSED
IMPROVEMENTS IN THIS AREA

NOTE:
THIS IS NOT A BOUNDARY SURVEY. APPARENT PROPERTY CORNERS ARE SHOWN FOR ORIENTATION ONLY.
THE BOUNDARY AND TOPOGRAPHIC INFORMATION DEPICTED HEREON IS BASED UPON THE BOUNDARY,
TOPOGRAPHIC AND UTILITY SURVEYS PREPARED BY HIGH MESA CONSULTING GROUP, NMPS NO. 11184,
DATED 03/28/2014 (2013.180.3).

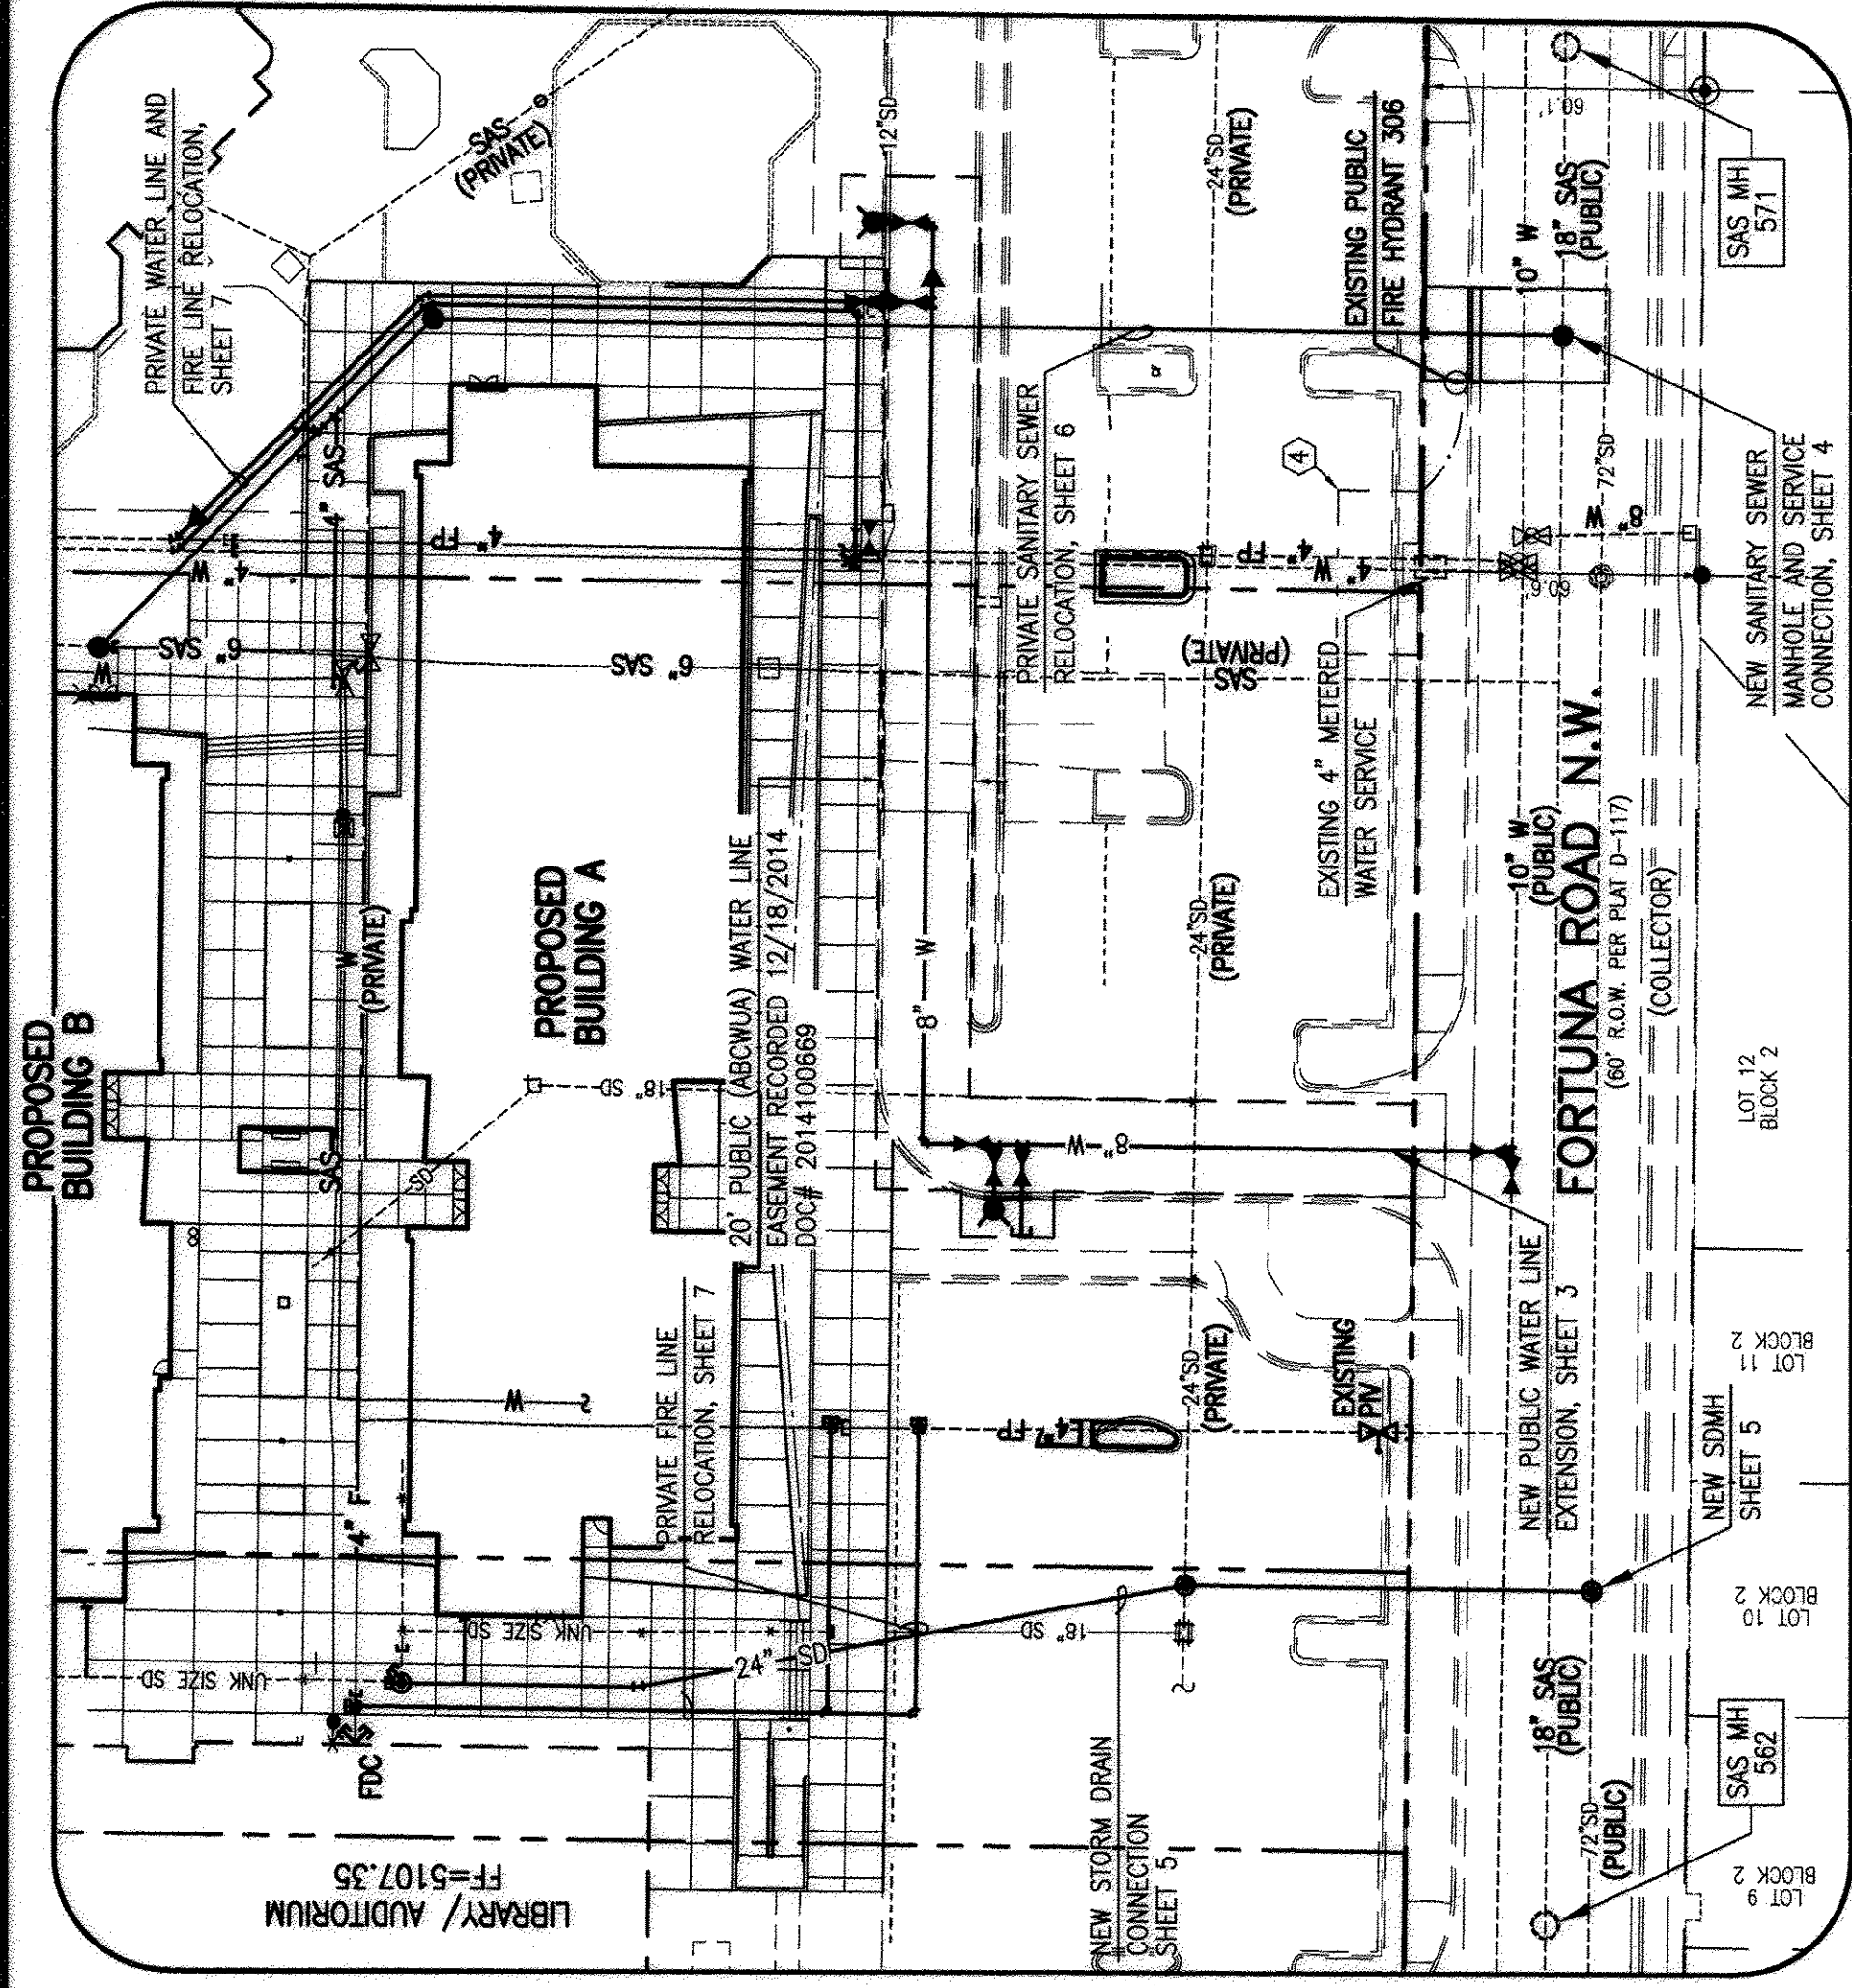

ENLARGED DETAIL
SCALE: 1" = 40'

LEGEND

- EXISTING FIRE HYDRANT
- PROPOSED FIRE HYDRANT
- FIRE DEPARTMENT CONNECTION (FDC)
- EXISTING SANITARY SEWER MANHOLE
- PROPOSED SANITARY SEWER MANHOLE
- EXISTING GATE VALVE
- PROPOSED GATE VALVE
- EXISTING DOUBLE CLEANOUT
- PROPOSED DOUBLE CLEANOUT
- EXISTING SINGLE CLEANOUT
- PROPOSED SINGLE CLEANOUT
- EXISTING WATER SERVICE
- PROPOSED WATER SERVICE
- EXISTING WATER LINE
- PROPOSED WATER LINE
- EXISTING SANITARY SEWER LINE
- PROPOSED SANITARY SEWER LINE
- EXISTING FIRE LINE
- PROPOSED FIRE LINE
- EXISTING POST INDICATOR VALVE (PIV)
- PROPOSED POST INDICATOR VALVE

BENCHMARKS

PROJECT BENCHMARK
AN A.G.R.S. BRASS DISK STAMPED "18-J11", SET FLUSH
IN THE SIDEWALK, LOCATED IN THE NORTHEAST QUADRANT
OF THE INTERSECTION OF COOKS ROAD AND GLENRIO
ROAD. ELEVATION = 5099.609 FEET (NAVD 1986)

LEGAL DESCRIPTION

TRACTS 165 THROUGH 172, INCLUSIVE, TOWN OF ATRISCO
GRANT, AIRPORT UNIT, ALBUQUERQUE, NEW MEXICO.


EXISTING EASEMENTS

- 7' PNM AND MST&T EASEMENT GRANTED BY DOCUMENT
EXECUTED 09-08-1965
- 5' PNM AND MST&T EASEMENT GRANTED BY DOCUMENT
EXECUTED 09-08-1965
- 5' PNM AND MST&T EASEMENT GRANTED BY DOCUMENT
EXECUTED 04-07-1969
- ABQWUA PUBLIC WATER LINE EASEMENT FOR WATER
METERS GRANTED BY DOCUMENT FILED 07-20-2010,
DOC. #2010072287
- 5' PNM AND MST&T EASEMENT DEPICTED BY DOCUMENT
EXECUTED 04-07-1969

NOTE:

REFER TO WATER VALVE SHUTOFF PLAN, SHEET 4, FOR EXISTING
WATER VALVE NUMBERS

HIGH MESA Consulting Group
6010-B MIDWAY PARK BLVD. NE • ALBUQUERQUE, NEW MEXICO 87109
PHONE: 505.345.4250 • FAX: 505.345.4254 • www.hghmesacg.com

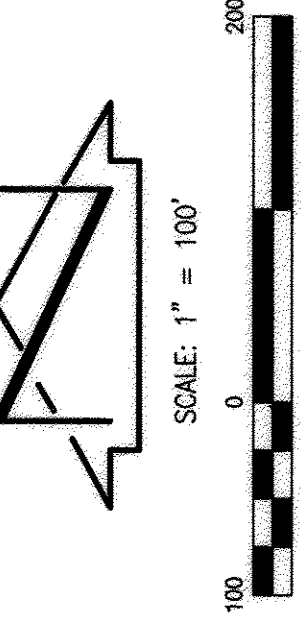


CITY OF ALBUQUERQUE
PUBLIC WORKS DEPARTMENT
ENGINEERING DEVELOPMENT GROUP

OVERALL IMPROVEMENTS PLAN
PUBLIC AND PRIVATE WATER, SANITARY SEWER
AND STORM DRAIN LINE EXTENSIONS AND RELOCATIONS
WEST MESA HIGH SCHOOL

APPROVE
DESIGN
REVIEW COMMITTEE
CITY ENGINEER
CITY OF ALBUQUERQUE
MAY 3 2015

City Project No. 749982
Zone Map No. J-10
Sheet 2 of 8

2013.187.8

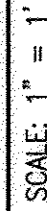

6010-B MIDWAY PARK BLVD. NE • ALBUQUERQUE, NEW MEXICO 87109
PHONE: 505.345.4250 • FAX: 505.345.4254 • www.highmesacg.com

2013.1878