


7515.20




NOTES

1. BASE MAPPING IS SCHEMATIC ONLY AND IS BASED ON G.I.S. DATA.

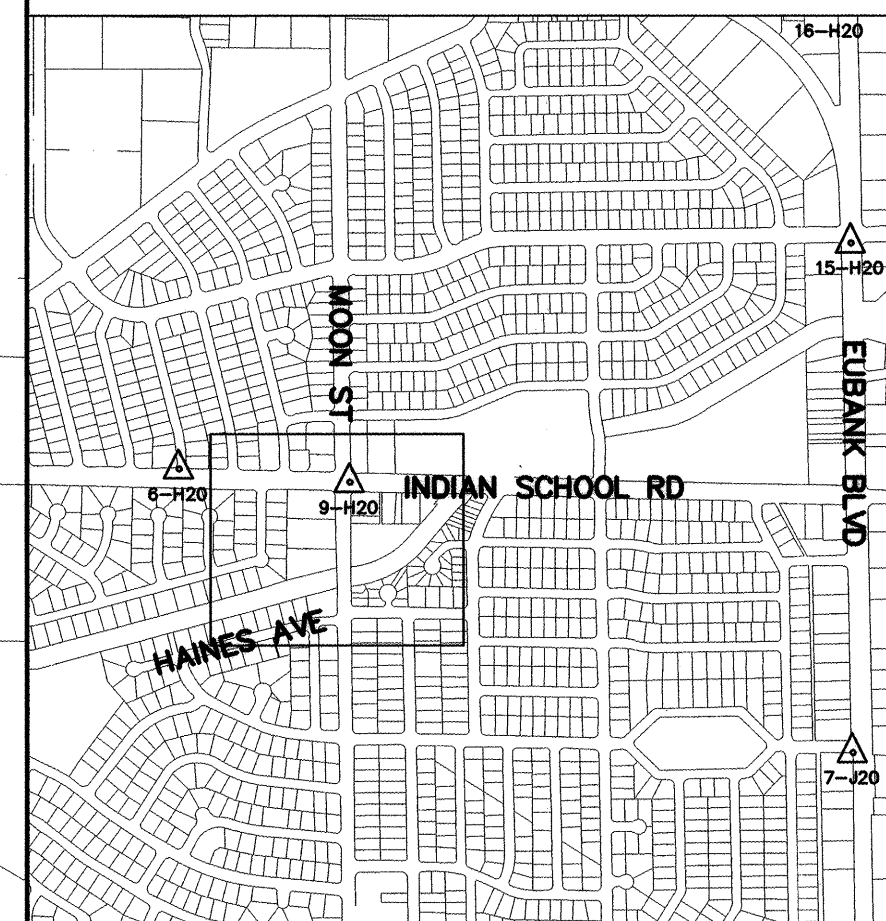

VICINITY MAP
SCALE: 1" = 1000'

Receipt
APPROVAL OF RECORD DRAWINGS
CHIEF CONSTRUCTION ENGINEER
Principal
Robert W. Strong
DATE *September 5, 2007*

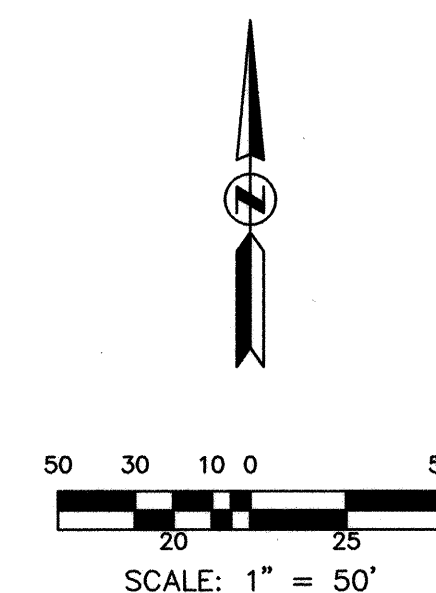

CITY OF ALBUQUERQUE
WATER UTILITY DEPARTMENT

TITLE: EMERGENCY SANITARY SEWER
MOON FROM INDIAN SCHOOL TO HAINES &
INDIAN SCHOOL FROM MOON TO PARSIFAL

Design Review Committee

City Engineer Approval

Q	Mo./Day/Yr.	Mo./Day/

City Project No.

7515.20

Zone Map No.	
--------------	--

J-20-

Sheet 0

Sheet 1 of 1

<i>AS BUILT INFORMATION</i>	
CONTRACTOR	TLC
WORK	DATE 7-05
INSPECTOR'S	DATE 7-05
ACCEPTANCE BY R. DURAN	DATE 7-05
VERIFICATION BY C. SPENCER	DATE 7-05
REMARKS	DATE
<i>MICRO-FILM INFORMATION</i>	
RECORDED BY	DATE
NO.	

[illegible]

NO.	DATE	REMARKS	BY
<i>REVISED</i>			
UTILITY PROJECT MANAGER			
CONTRACTOR PROJECT MANAGER			
OWNER PROJECT MANAGER			