

CITY OF ALBUQUERQUE PLANS FOR CONSTRUCTION




BLUEWATER POINTE SUBDIVISION

INDEX OF SHEETS

- 1 TITLE SHEET
2 PLAT
3 GRADING PLAN
4 TYPICAL SECTIONS
5 TYPICAL SECTIONS & DETAILS
6 OVERALL PAVING PLAN
7 BLUEWATER POINTE ROAD PAVING PLAN & PROFILE
8 ADONAI ROAD PAVING PLAN & PROFILE
9 ELOHIM COURT PAVING PLAN & PROFILE
10 EL SHADDAI STREET PAVING & STORM DRAIN PLAN & PROFILE
11 OVERALL UTILITY PLAN
12 BLUEWATER POINTE ROAD UTILITY PLAN & PROFILE
13 ADONAI ROAD UTILITY PLAN & PROFILE
14 ELOHIM COURT UTILITY PLAN & PROFILE
15 EL SHADDAI STREET UTILITY PLAN & PROFILE
16 WEST RIDGE STREET UTILITY PLAN & PROFILE
17 WEST RIDGE STREET UTILITY PLAN & PROFILE
18 VOLCANO ROAD UTILITY PLAN & PROFILE
19 WATERLINE EASEMENT UTILITY PLAN & PROFILE
20 SERVICE LINE TABLE & WATER-SHUT-OFF PLAN

DRB NO. 1001182

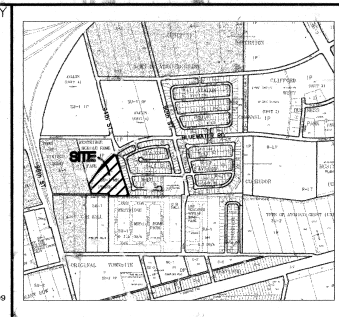

ZONE ATLAS MAP K-9-Z



CERTIFICATE OF SUBSTANTIAL COMPLIANCE ON PLANS

I, Davis Soule, of the firm of Rio Grande Engineering,
do hereby certify that I am duly qualified by education and experience to act as a
Registered Professional Engineer in the State of New Mexico, do hereby certify that to the best of
my knowledge and belief, that the infrastructure installed as part of this project has been constructed
in accordance with the plans and specifications approved by the City Engineer and that the construction
is in accordance with the approved plans has been met, except as noted on the drawings. The design
original design intent of the approved plans has been met, except as noted on the drawings. The design
construction drawings. This Certification is based on a site inspection by me or personnel under my
my direction and survey information provided by Sandiego Ramon. NMPIS
87-24



AS-BELTS



Thompson
Engineering
Consultants, Inc.
tccnra@yahoo.com

4800 JUAN TABO NE. SUITE C PHONE: (505) 271-2199
ALBUQUERQUE, NEW MEXICO 87111 FAX: (505) 237-8422

Record Drawing

[illegible]

PRELIMINARY PLAT OF
BLUEWATER POINTE SUBDIVISION
ALBUQUERQUE, BERNALILLO COUNTY, NEW MEXICO

COUNTY CLERK RECORDING LABEL HERE

APPROVALS as specified by the City of Albuquerque Subdivision Ordinance:
PROJECT NO. _____ APPLICATION NO. _____

PUBLIC UTILITY EASEMENTS
Public Utility Easements shown on this plat are granted for the common and joint use of:

- [illegible]

SUBDIVISION DATA

- SUBDIVISION DATA**
1. DRB Proj. No. _____
 2. Zone Alias Index No. K-9
 3. Current Zoning R-D
 4. Gross acreage 7.1331 Acres
 5. Total Number of Lots created - 53 -
 6. No. of existing tracts: 1
 7. Miles of full width streets created: 0.2858 mi.
 8. Date of Survey: March 2004
 9. TALOS LOG NO.: 2004062093

PURPOSE OF PLAT:
The purpose of this plat is to replot three existing lots into twenty residential lots, dedicate public right of way and grant easements.

OTES
Bearings are Grid Bearings, Central Zone, NAD 1927, based upon ACS monuments "8-Kg" and "10-Lg", found monuments and adjacent subdivision plats.
All distances are ground.

Monuments recovered and accepted or set are noted on plat.

Ten foot (10') Public Utility Easement along all street rights of way is hereby granted with the filing of this plat.

Twenty-five foot (25') Public drainage and sewer line easement is granted to the City of Albuquerque in fee simple with warranty covenants with the filing of this plat.

Twenty foot (20') Public drainage and water line easement is granted to the City of Albuquerque in fee simple with warranty covenants with the filing of this plat.

[illegible]

FREE CONSENT AND DEDICATION:

NOTE: CENTERLINE Δ (IN LIEU OF R/W) MONUMENTATION IS TO BE INSTALLED AT ALL CENTERLINE PC'S, PT'S, ANGLE POINTS AND STREET INTERSECTIONS AS SHOWN HEREON, AND WILL CONSIST OF A FOUR INCH (4") ALUMINUM ALLOY CAP STAMPED "CITY OF ALBUQUERQUE", "CENTERLINE MONUMENT", "DO NOT DISTURB", "PLS #13240".

FOR BERNALILLO COUNTY TREASURER'S OFFICE USE ONLY

PROPERTY OWNER OF RECORD:
WEST RIDGE LIMITED PARTNERSHIP
BIERNALILLO COUNTY TREASURER'S OFFICE

Read Rules: Minutes Minutes of Union Proceedings 110

PRELIMINARY PLAT APPROVAL:

Glen B. Holkin, P.S., City Surveyor, City of Albuquerque

Date _____


A M SURVEYING CO.
612 CERRO DE ORTEGA
RIO RANCHO, NM 87124
PHONE: (505) 896-1716 FAX: (505) 896-1718

bln	SCALE:	FILE NO.
-----	--------	----------

1" = 50'

	26 APR 2004	SHEET 2 OF 2
--	-------------	--------------


PRELIMINARY PLAT OF
BLUEWATER POINTE SUBDIVISION
 ALBUQUERQUE, BERNALILLO COUNTY, NEW MEXICO
 A REPLAT OF WESTRIDGE MOBILE HOME PHASE 2, TRACT E
 WITHIN PROJECTED SECTION 21, T. 10 N., R. 2E., NMPM

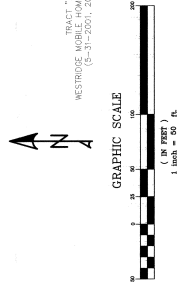

BOUNDARY CURVE DATA				
CURVE	DELTA	RADIUS	LENGTH	TANGENT
C1	13°40'22"	1324.17	316.00	158.75
C1e	01°27'10"	1290.17	32.71	16.36

CENTRELINE CURVE DATA			
CURVE	DELTA	RADIUS	TANGENT
C2	37°14'08"	100.00	33.89
C3	74°41'59"	75.00	57.24
C4	27°17'35"	100.00	24.28

R/W CURVE DATA				
CURVE	DELTA	RADIUS	LENGTH	TANGENT
C5	110°50'12"	30.00	58.03	43.52
C6	01°41'59"	77.00	2.28	1.14

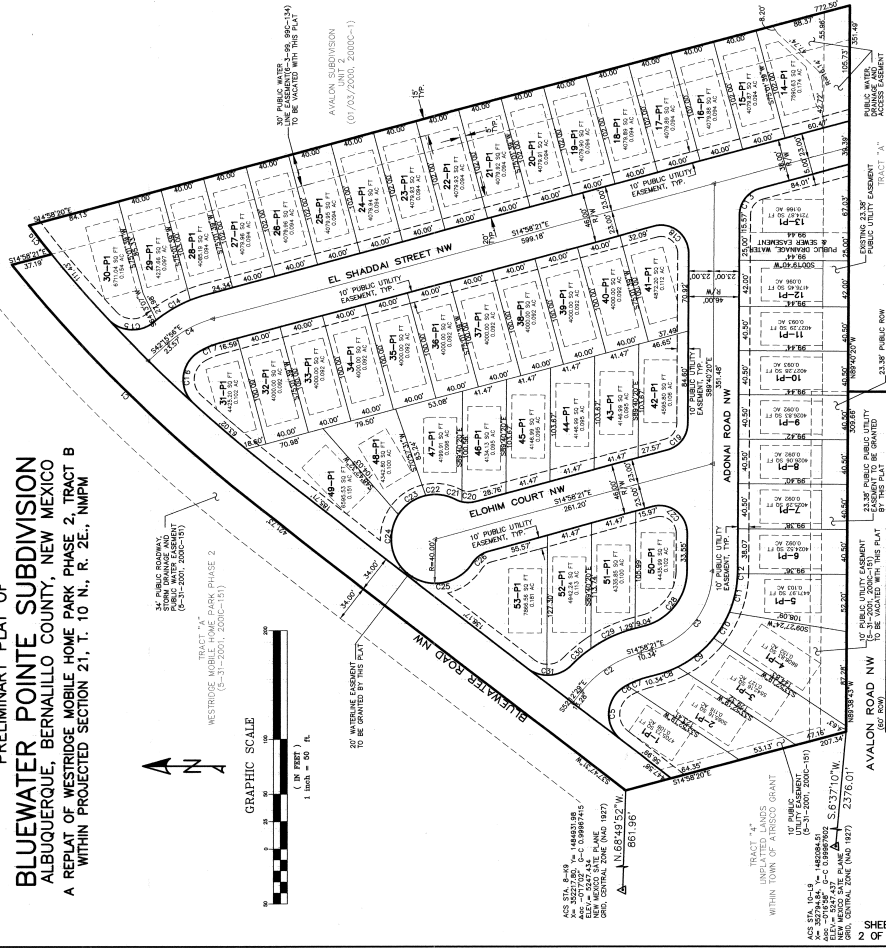


612 CERRO DE ORTEGA
RIO RANCHO, NM 87124
PHONE: (505) 896-1716 FAX: (505) 896-1711

bln	SCALE:	FILE NO.
-----	--------	----------


DATE	FILE NO.
SCALE	XX-XX-XX-XX
1" = 50'	
BY: M. Shook	

1	26 APR 2004	XX-XX-XX-XX
2	26 APR 2004	SHEET 2 OF 2

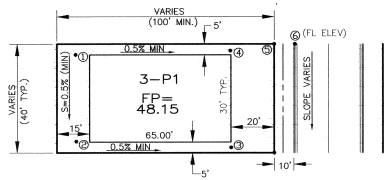

TYPICAL LOT GRADING PLAN

TO SET SPOT ① - SUBTRACT 0.25' FROM THE PAD ELEV.
TO SET SPOT ② - SUBTRACT 0.2' FROM SPOT ①
TO SET SPOTS ③ & ④ - SUBTRACT 0.4' FROM SPOTS ② & ① RESPECTIVELY
TO SET SPOT ⑤ - MULTIPLY D1 BY 2.0%, ADD CURB HEIGHT, AND ADD TO SPOT

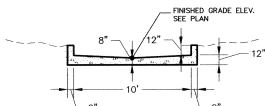

NOTE: 3500 PSI CONCRETE, MIN.

TYPICAL CHANNEL SECTION

LEGAL DESCRIPTION

WESTRIDGE DEVELOPMENT TRACT (A)
SOUTHERLY PORTION OF TRACTS 1, 2 & 3
UNPLATTED LANDS WITHIN TOWN OF ATRISCO GRANT

NOTES

1.) ALL ELEVATIONS IN ROAD ARE
FLOWLINE UNLESS NOTED OTHERWISE.

APPROVED FOR ROUGH GRADING


SIGNATURE _____ DATE _____

LEGEND


- FP=16.30
15.90
TW=12.51
BW=11.84
- FINISHED PAD SITE ELEVATION
- PROPOSED SPOT ELEVATION
- TOP OF WALL AND
BOTTOM OF WALL ELEVATIONS
- EXISTING MAJOR CONTOUR
- EXISTING MINOR CONTOUR
- PROPOSED BASIN NUMBER
- PROPOSED STANDARD CURB AND GUTTER
- PROPOSED MOUNTABLE CURB AND GUTTER
- PROPOSED EXTRUDED ASPHALT CURB
- PROPOSED STREET LIGHT LOCATION
- PROPOSED SIDEWALK - DEFERRED *
- PROPOSED RETAINING WALL
- PROPOSED CROWN TRANSITION
- PROPOSED WHEEL CHAIR RAMPS
- PROPOSED 6' VALLEY GUTTER

* NOTE: DEFERRED SIDEWALK IS FOR SUBDIVISION ONLY

* AS
RESULTS CORRECTED
BY JORDAN - GALLAGHER
RS '0911'

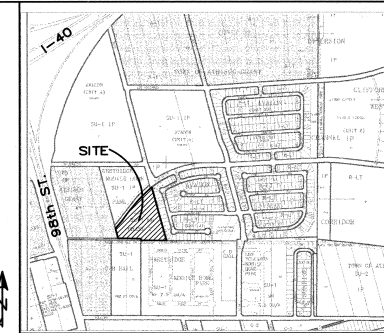

ZONE ATLAS K-9-Z

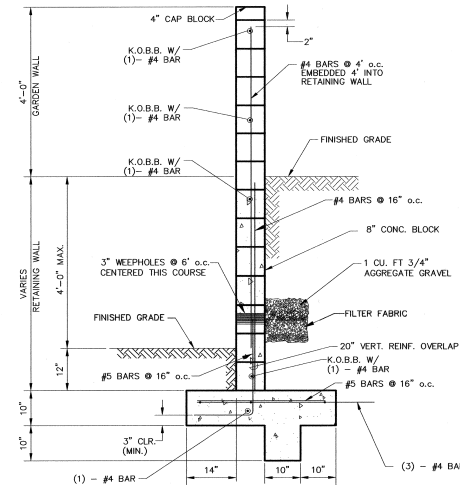



TYPICAL RETAINING WALL
W/ GARDEN WALL EXTENSION




CITY OF ALBUQUERQUE
PUBLIC WORKS DEPARTMENT
TRANSPORTATION DEVELOPMENT
BLUEWATER POINTE SUBDIVISION
GRADING AND DRAINAGE PLAN

DESIGN REVIEW COMMITTEE	CITY ENGINEER APPROVAL	NO. DAY/HR	NO. DAY/HR
For Information Only	Record Drawing		
City Project No. 751681	Zone Map No. K-9-Z	Sheet 3	Of 20


		ENGINEER'S SEAL		SURVEY INFORMATION		BENCH MARK		AS BUILT INFORMATION	
					NO.	FIELD	NOTES	CONTRACTOR	DATE
								ACS STA. 8-K9	
								X = 352217.80, Y = 1484931.98	
								WORK BY	DATE
								DESIGNED BY	DATE
								CHECKED BY	DATE
								NO. DATE	
								REMARKS	
								BY	
								DESIGN	
								DESIGNED BY DBT	DATE 02-03-05
								DRAWN BY DBT	DATE 02-03-05
								CHECKED BY DBT	DATE 02-03-05
DIVISION									
PAGE PLAN									
M5/DAY/YR									
M5/DAY/YR									
M5/DAY/Y									

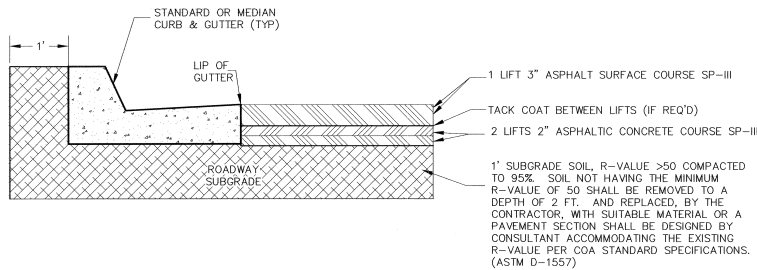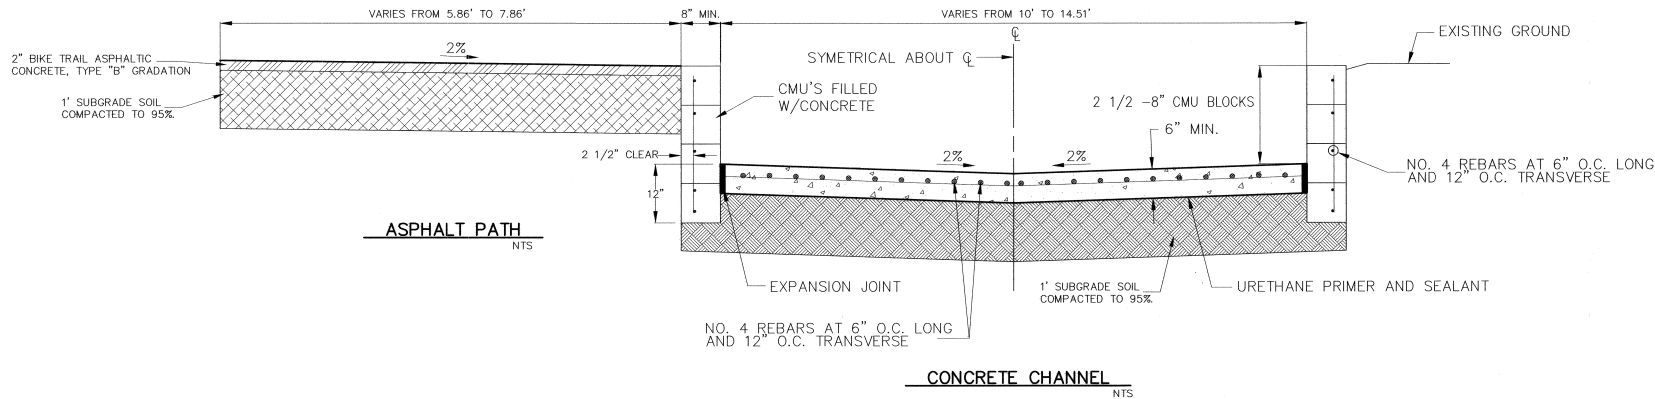

BLUEWATER ROAD, PAVING SECTION
COA PROJECT NO. 663881 NTS

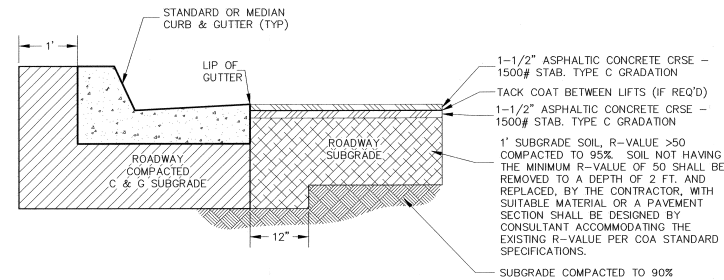


RESIDENTIAL PAVING SECTION - STANDARD CURB & GUTTER
(PER COA STD. DWG. No. 2405A) NTS

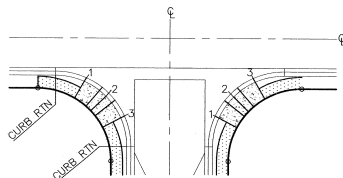

NOTE:
QUARTER POINT GRADES ARE REFERENCED AS 1, 2, & 3
ALONG THE FACE OF CURB IN A CLOCKWISE DIRECTION.

QUARTER POINT DETAIL
NTS

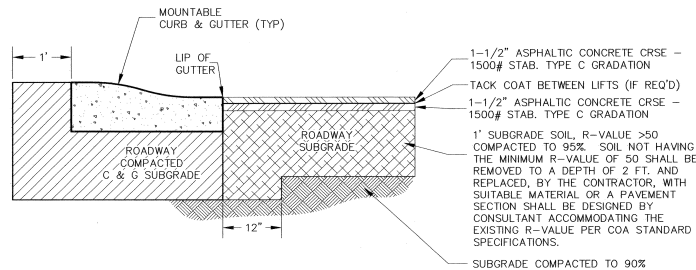

RESIDENTIAL PAVING SECTION - ROLLED CURB & GUTTER
(PER COA STD. DWG. No. 2405A) NTS


THOMPSON ENGINEERING CONSULTANTS, Inc. 4800 JUAN TABO RD. SUITE C ALBUQUERQUE, NEW MEXICO 87111 PHONE: (505) 271-0190 FAX: (505) 271-0422		CITY OF ALBUQUERQUE PUBLIC WORKS DEPARTMENT TRANSPORTATION DEVELOPMENT BLUEWATER POINTE TYPICAL SECTION DETAILS	
DESIGN REVIEW COMMITTEE APPROVED FEB 23 2005 DESIGN REVIEW COMMITTEE	CITY ENGINEER APPROVAL APPROVED FEB 23 2005 CITY ENGINEER	MS. DAY/HR. MS. DAY/HR.	MS. DAY/HR. MS. DAY/HR.
City Project No. 751681	Zone Map No. K-9-Z	Sheet 5	Of 20

Record Drawing AS BUILT INFORMATION CONTRACTOR: AS BUILT DRAWN BY: AS BUILT CHECKED BY: AS BUILT DATE: AS BUILT		BENCH MARKS ACS STA. B-10 X = 35217.80, Y = 1484931.98 ELEV. 5247.43 NEW MEXICO STATE PLANE GRID, CENTRAL ZONE (NAD 1927)	
---	--	---	--


SURVEY INFORMATION FIELD NOTES NO. AS BUILT DATE AS BUILT BY AS BUILT		ENGINEER'S SEAL [Seal]	
---	--	----------------------------------	--

REMARKS NO. AS BUILT DATE AS BUILT BY AS BUILT		DESIGN NO. AS BUILT DATE AS BUILT BY AS BUILT	
---	--	--	--

DESIGNED BY DBT		DRAWN BY DBT	
CHECKED BY DBT		DATE 02-17-05	

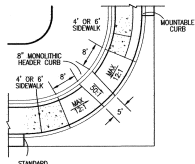


ARTERIAL WHEELCHAIR RAMP DETAIL
NTS (MODIFIED COA STD DWG#2441 CASE II)

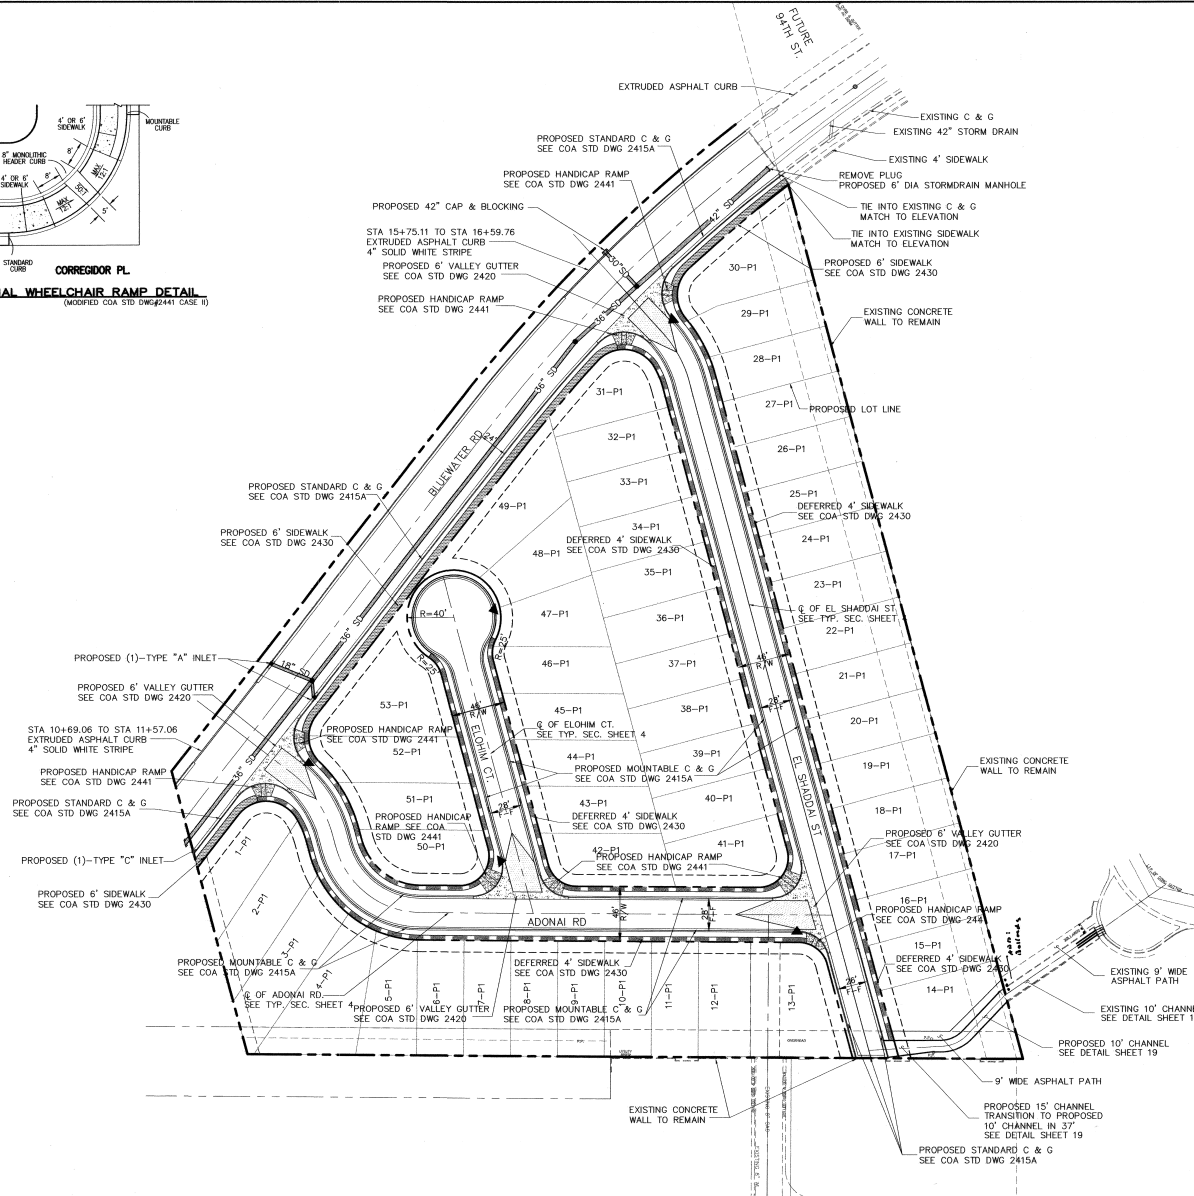

NOTE:
SIDEWALK ON BLUEWATER WILL NOT BE DEFERRED. DEFERRED SIDEWALK IS FOR SUBDIVISION ONLY.

LEGEND

- | | |
|---|---|
| 16 | LOT NUMBER |
|  | PROPOSED STORM DRAIN |
|  | PROPOSED STORM DRAIN MANHOLE |
|  | PROPOSED STORM INLETS |
|  | PROPOSED STREET LIGHT LOCATION |
|  | CENTERLINE OF STREET |
|  | PROPOSED PROPERTY BOUNDARY |
|  | PROPOSED MOUNTABLE CURB & GUTTER |
|  | PROPOSED STANDARD CURB & GUTTER |
|  | PROPOSED EXTRUDED ASPHALT CURB |
|  | PROPOSED 6' SIDEWALK |
|  | PROPOSED SIDEWALK - DEFERRED |
|  | SEE NOTE THIS SHEET. |
|  | PROPOSED VALLEY GUTTER |
|  | PROPOSED CROWN TO NO CROWN TRANSITION
SEE C&D STD DWG 2401 |
|  | EXISTING CURB & GUTTER |

 

GRAPHIC SCALE

(IN FEET)
1 inch = 50 ft.



4800 JUAN TABO NE. SUITE C PHONE: (505) 271-2199
ALBUQUERQUE, NEW MEXICO 87111 FAX: (505) 237-8422

CITY OF ALBUQUERQUE
PUBLIC WORKS DEPARTMENT
TRANSPORTATION DEVELOPMENT
BLUEWATER POINTE SUBDIVISION
OVERALL PAVING PLAN

DESIGN REVIEW COMMITTEE
APPROVE
FEB 22 2005
DESIGN REVIEW COMMITTEE


CITY ENGINEER APPROV
APPROVE
CITY ENGINEER

City Project No. 351681

Zone Map No.
K 0 3

Sheet	Of
6	20

[illegible]

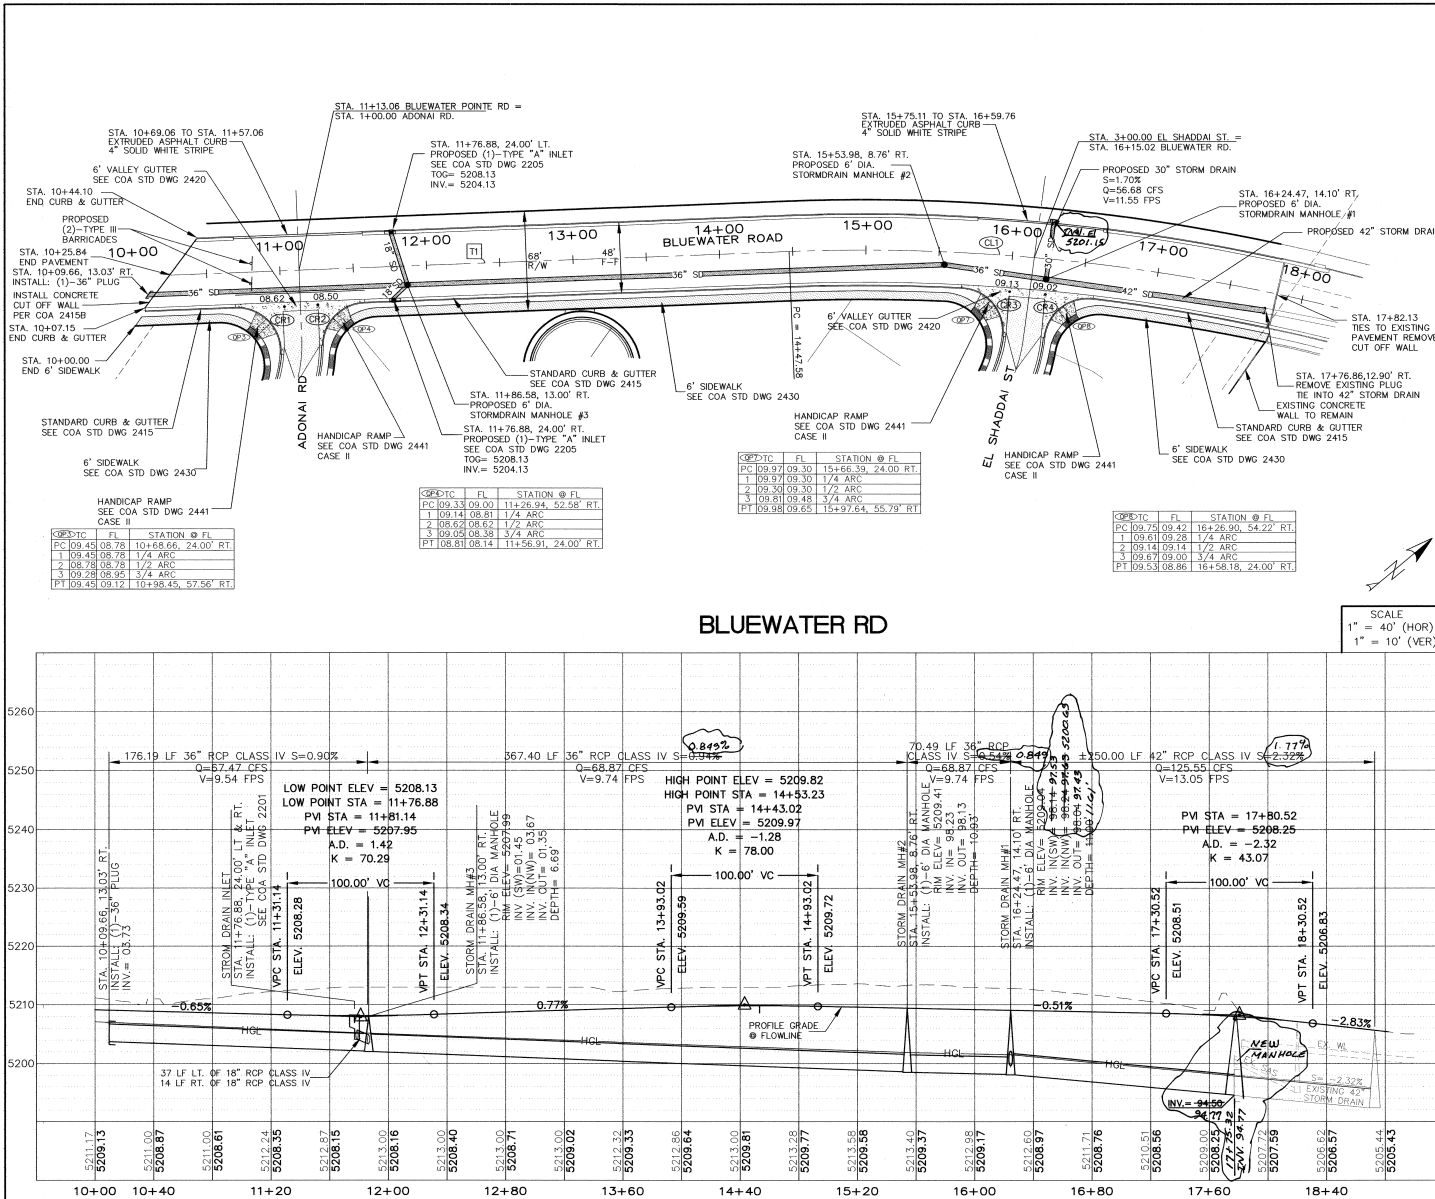

LEGEND

- 16 LOT NUMBER
- PROPOSED STORM DRAIN
- PROPOSED STORM DRAIN MANHOLE
- PROPOSED STREET LIGHT LOCATION
- CENTERLINE OF STREET
- PROPOSED PROPERTY BOUNDARY
- PROPOSED MOUNTABLE CURB & GUTTER
- PROPOSED STANDARD CURB & GUTTER
- PROPOSED EXTRUDED ASPHALT CURB
- PROPOSED 6" SIDEWALK
- PROPOSED VALLEY GUTTER
- PROPOSED CROWN TO NO CROWN TRANSITION
- EXISTING CURB & GUTTER

TANGENT DATA TABLE

TAN #	BEARING	LENGTH
1	N 37° 47' 31" E	447.58'

CURVE DATA TABLE

CURVE #	DELTA	RADIUS	TAN LENGTH
CL1	17° 01' 17"	1324.17'	198.15' 393.38'
CR1	96° 52' 44"	30.00'	33.83' 50.72'
CR2	87° 20' 12"	30.00'	28.64' 45.73'
CR3	94° 08' 38"	30.00'	32.25' 49.29'
CR4	91° 08' 48"	30.00'	30.61' 47.72'

NOTE:

- STRIPING FOR DRIVING AND BIKE LANES SEE SHEET 4, TYPICAL SECTION FOR BLUEWATER
- CONTACT TRAFFIC OPERATIONS OFFICE TO ANY SIGNING AND STRIPING.

SCALE

1" = 40' (HOR)

1" = 10' (VER)

AS-BUILT

AS-BUILT

DESIGNER'S SEAL

DESIGNER'S SEAL

REMARKS

REMARKS

DESIGN

DESIGN

DATE

DATE

CITY OF ALBUQUERQUE

CITY OF ALBUQUERQUE

PUBLIC WORKS DEPARTMENT

PUBLIC WORKS DEPARTMENT

TRANSPORTATION DEVELOPMENT

TRANSPORTATION DEVELOPMENT

BLUEWATER POINT SUBDIVISION

BLUEWATER POINT SUBDIVISION

BLUEWATER RD PAVING PLAN & PROFILE

BLUEWATER RD PAVING PLAN & PROFILE

DESIGN REVIEW COMMITTEE

DESIGN REVIEW COMMITTEE

CITY ENGINEER APPROVAL

CITY ENGINEER APPROVAL

MS/DAY/YR

MS/DAY/YR

City Project No.

City Project No.

Zone Map No.


Zone Map No.

Sheet

Sheet

Of

Of

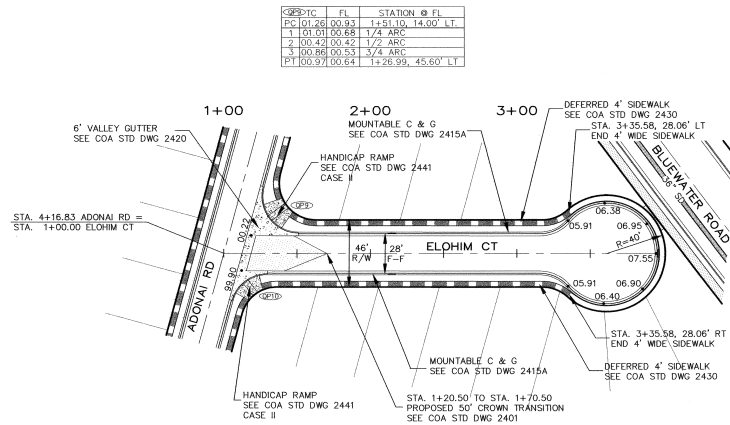


Q-PTC	FL	STATION @ FL
PC	01.26	00.93
1	01.01	00.68
2	00.47	00.43
3	00.86	00.53
PT	00.97	00.64

Q-PTC	FL	STATION @ FL
PC	00.05	99.72
1	00.17	99.84
2	99.95	99.95
3	00.39	00.06
PT	00.50	00.17

ELOHIM COURT

SCALE
1" = 40' (HOR)
1" = 10' (VER)

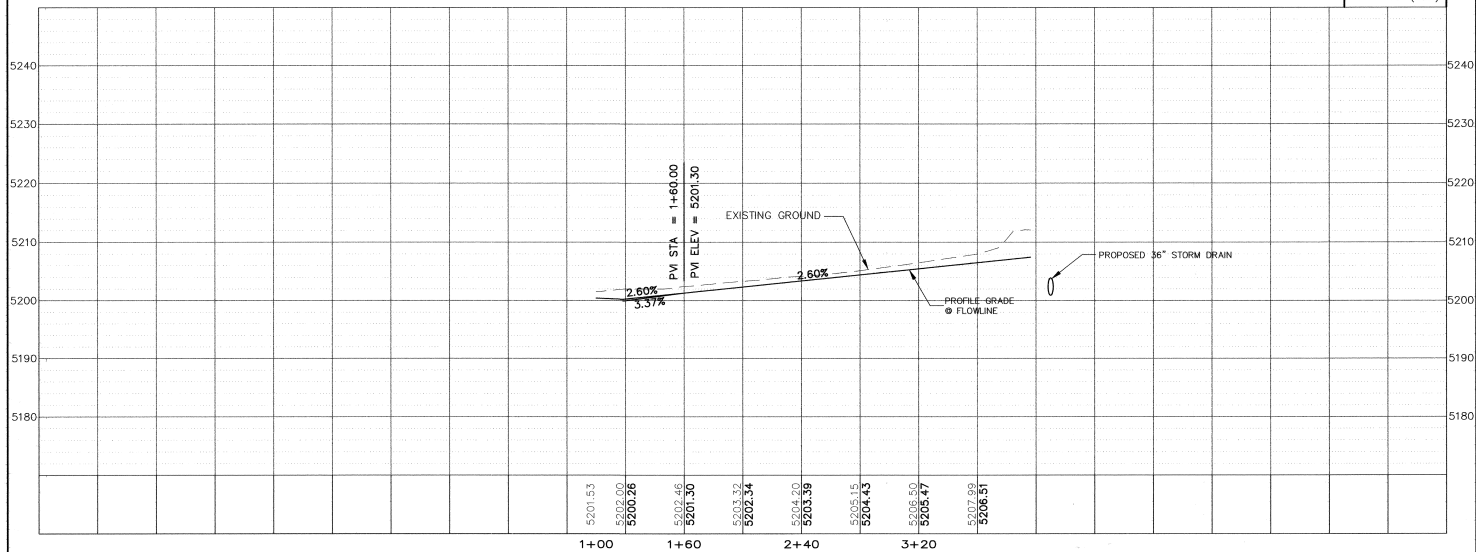

LEGEND

- 16 LOT NUMBER
- PROPOSED STORM DRAIN
- PROPOSED STORM DRAIN MANHOLE
- PROPOSED STORM INLETS
- PROPOSED STREET LIGHT LOCATION
- CENTERLINE OF STREET
- PROPOSED PROPERTY BOUNDARY
- PROPOSED MOUNTABLE CURB & GUTTER
- PROPOSED STANDARD CURB & GUTTER
- PROPOSED 6' SIDEWALK
- PROPOSED VALLEY GUTTER
- PROPOSED CROWN TO NO CROWN TRANSITION
SEE COA STD DWG 2401
- EXISTING CURB & GUTTER
- DEFERRED 4' SIDEWALK

TANGENT DATA TABLE



TAN. #	BEARING	LENGTH
TS	N 14° 58' 21" W	296.20'

RECORD DRAWING AS BUILT INFORMATION CONTRACTOR: ABA Engineering PROJECT: Bluewater Pointe Subdivision SHEET: 9 OF 20 DATE: 02-17-05 DRAWN BY: DBT CHECKED BY: DBT		ENGINEER'S SEAL 	
		DESIGN DATE: 02-17-05 DRAWN BY: DBT CHECKED BY: DBT	
SURVEY INFORMATION FIELD NOTES BY: NO. DATE: NO.		BENCH MARK ACS STA. 8-49 A = 35227.80, Y = 184831.08 G = 0.99997419 ELEV. 5247.43 NEW MEXICO STATE PLANE GRID, CENTRAL ZONE (NAD 1983)	



4800 JUAN TABO NE, SUITE C PHONE: (505) 271-2199
ALBUQUERQUE, NEW MEXICO 87111 FAX: (505) 237-8422

CITY OF ALBUQUERQUE PUBLIC WORKS DEPARTMENT TRANSPORTATION DEVELOPMENT BLUEWATER POINTE SUBDIVISION ELOHIM COURT PAVING PLAN & PROFILE			
DESIGN REVIEW COMMITTEE APPROVED FEB 2 2005 DESIGN REVIEW COMMITTEE	CITY ENGINEER APPROVAL APPROVED FEB 2 2005 CITY ENGINEER	MO. DAY / YR. NO. DAY / YR.	City Project No. 751681
Zone Map No. K-9-Z	Sheet 9	Of 20	

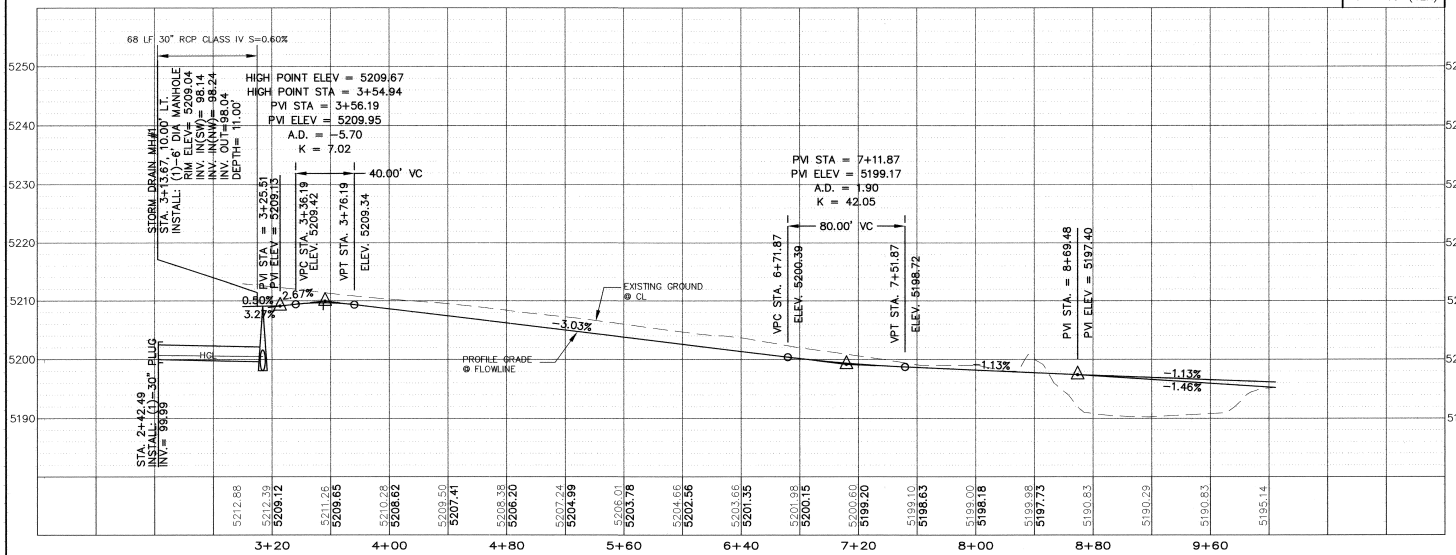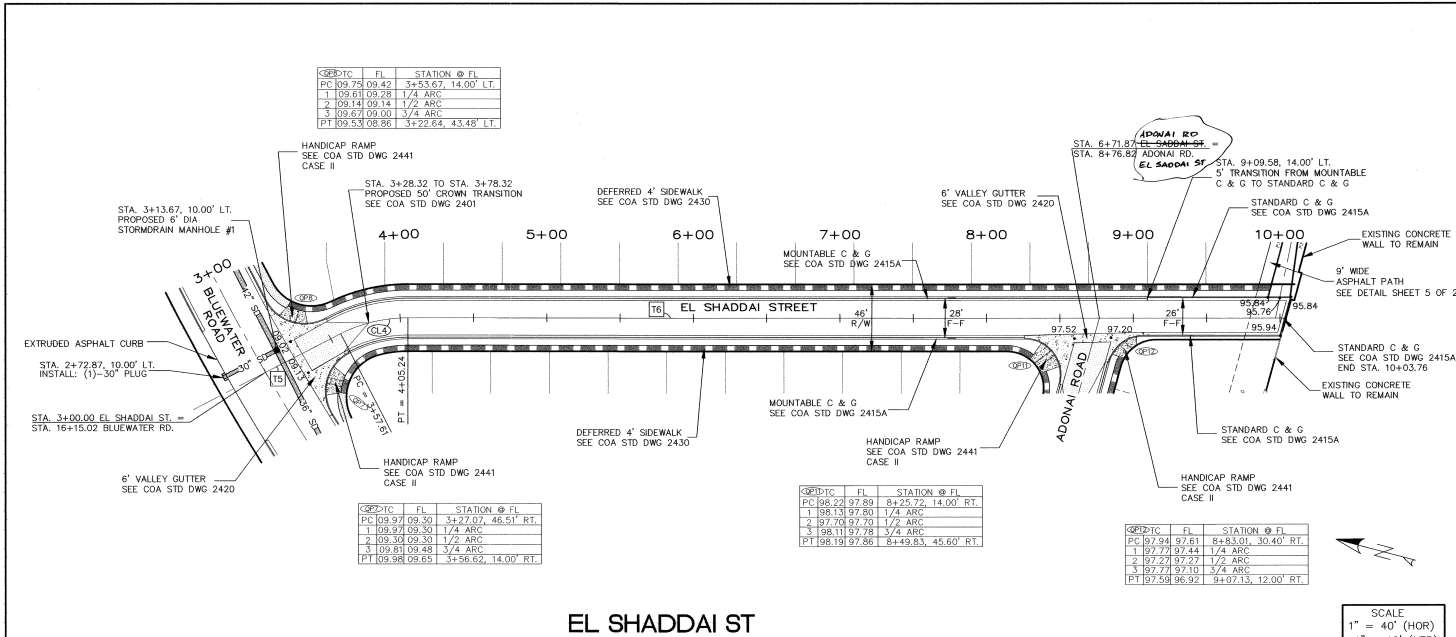

LEGEND

- 16 LOT NUMBER
- PROPOSED STORM DRAIN
- PROPOSED STORM DRAIN MANHOLE
- PROPOSED STORM INLETS
- PROPOSED STREET LIGHT LOCATION
- CENTERLINE OF STREET
- PROPOSED PROPERTY BOUNDARY
- PROPOSED MOUNTABLE CURB & GUTTER
- PROPOSED STANDARD CURB & GUTTER
- PROPOSED EXTRUDED ASPHALT CURB
- PROPOSED 6' SIDEWALK
- PROPOSED VALLEY GUTTER
- PROPOSED CROWN TO NO. CROWN TRANSITION SEE COA STD DWG 2401
- EXISTING CURB & GUTTER
- DEFERRED 4' SIDEWALK

TAN DATA TABLE

TAN #	BEARING	LENGTH
15	S 42° 15' 56" E	112.98'
16	S 14° 58' 21" E	599.18'

CURVE DATA TABLE

CURVE #	DELTA	RADIUS	TAN LENGTH
CL-4	27° 17' 35"	100.00'	24.28', 47.64'

AS BUILT INFORMATION

CONTRACT NO. **2004-0000000000**
 PROJECT NAME **Bluewater Pointe Subdivision**
 DATE **02-17-05**
 DRAWN BY **DEM**
 CHECKED BY **DBT**
 DESIGNER **DEM**
 DATE **02-17-05**
 RECORD BY **DEM**
 DATE **02-17-05**

ENGINEER'S SEAL

AS-BUILT

DESIGNED BY DBT
DRAWN BY DEM
CHECKED BY DBT
DATE 02-17-05
DATE 02-17-05

CITY OF ALBUQUERQUE

PUBLIC WORKS DEPARTMENT
 TRANSPORTATION DEVELOPMENT
 BLUEWATER POINTE SUBDIVISION
EL SHADDAI ST PAVING PLAN & PROFILE

DESIGN REVIEW COMMITTEE	CITY ENGINEER APPROVAL	MS/DA/7/05	MO/DA/7/05
APPROVED FEB 22 2005 REVIEW COMMITTEE	APPROVED FEB 22 2005 CITY ENGINEER		


City Project No. **751681** Zone Map No. **K-9-Z** Sheet **10** Of **20**

RESTRAINED JOINTS LENGTHS, L _r , FOR REDUCERS, (FT.)		
ALL JOINTS AT THE TEE MUST BE RESTRAINED.		
SIZE	RUN	BRANCH
12x12x12	15	17
12x12x10	10	18
12x12x8	6	19
12x12x6	3	19
12x12x4	1	19
10x10x10	12	18
10x10x8	8	15
10x10x6	4	16
10x10x4	2	4
8x8x8	9	20
8x8x6	5	17
8x8x4	2	15
6x6x6	6	20
6x6x4	2	20

RESTRAINED JOINTS LENGTHS, L _r , FOR REDUCERS, (FT.)		
MINIMUM UNRESTRAINED, STRAIGHT-RUN LENGTH RESTRAIN EITHER LARGE PIPE, OR SMALL PIPE		
SIZE	LARGE SIDE	SMALL SIDE
12x10	24	30
12x8	45	68
12x6	62	121
12x4	74	213
10x8	24	30
10x6	45	68
10x4	58	141
8x6	25	33
8x4	43	83
6x4	24	35

RESTRAINED JOINTS LENGTHS, L _r , FOR HORIZONTAL BENDS, VALVES, AND DEAD ENDS, (FT.)		
HORIZ. BENDS		
SIZE	90°	45°
12	30	22
10	26	11
8	22	9
6	17	7
4	12	5

RESTRAINED JOINTS LENGTHS, L _r , FOR HORIZONTAL BENDS, VALVES, AND DEAD ENDS, (FT.)		
VERT. BENDS		
SIZE	HIGH END	LOW END
8"	27	5
10"	10	10

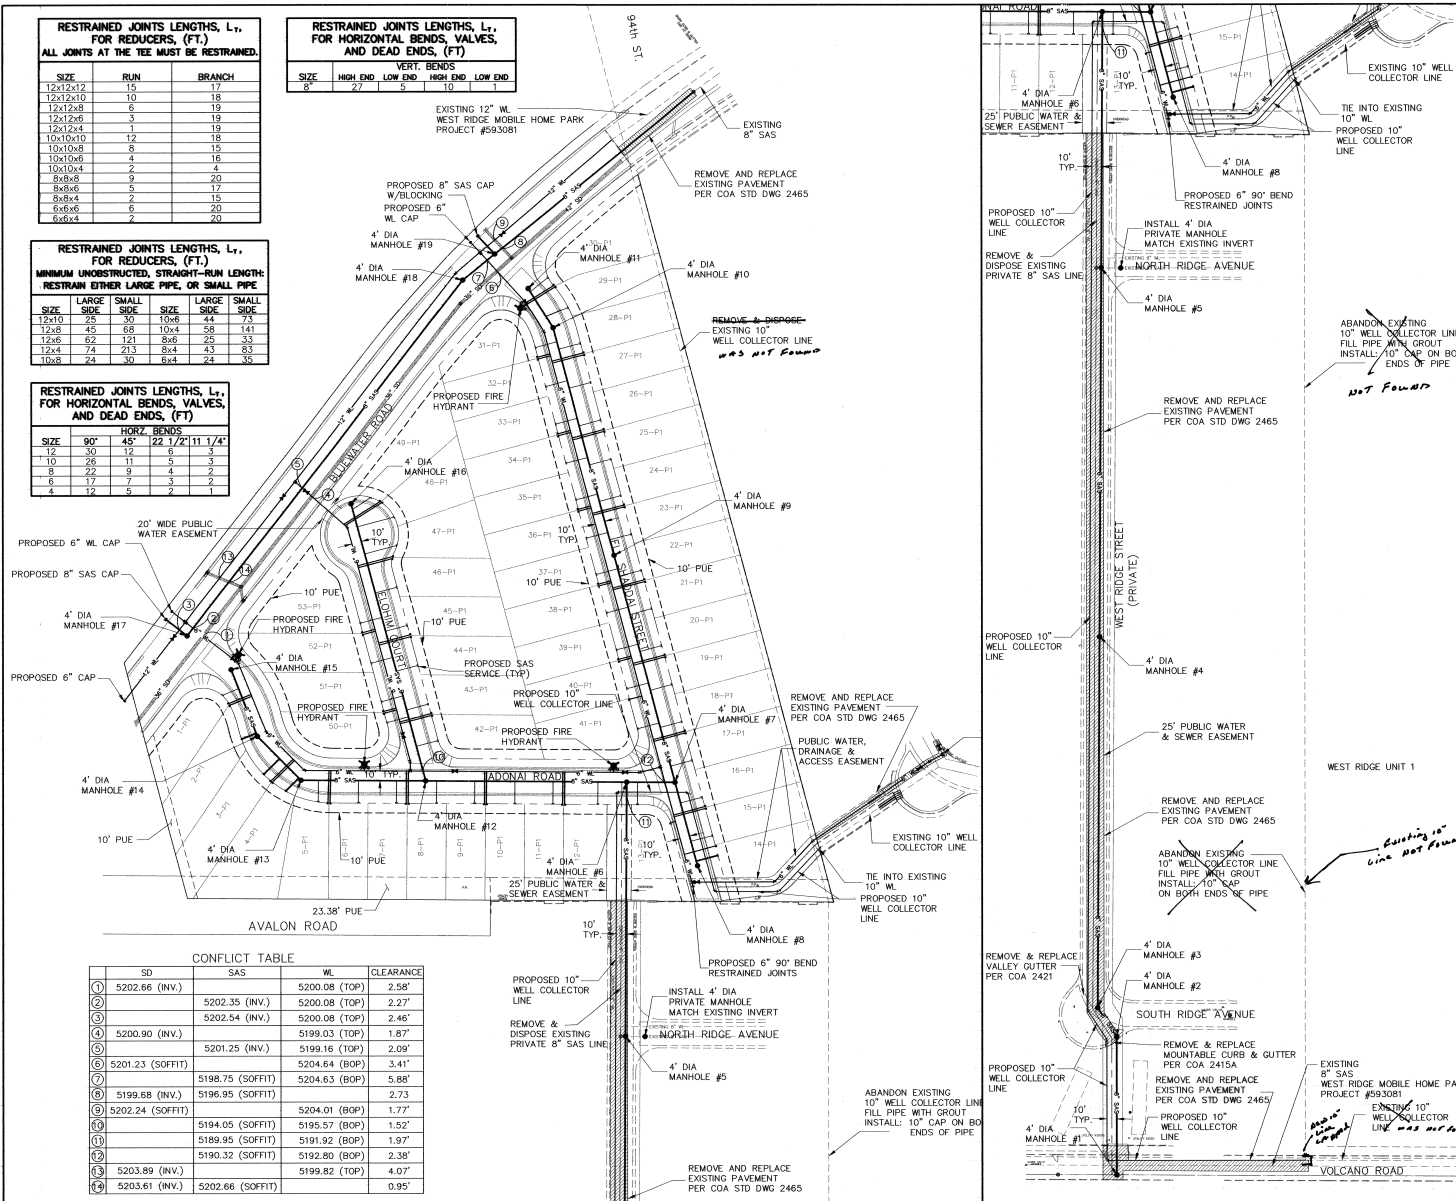

CONFLICT TABLE			
SD	SAS	WL	CLEARANCE
① 5202.66 (INV.)		5200.08 (TOP)	2.58'
②	5202.35 (INV.)	5200.08 (TOP)	2.27'
③ 5202.54 (INV.)		5200.08 (TOP)	2.46'
④ 5200.90 (INV.)		5199.03 (TOP)	1.87'
⑤	5201.25 (INV.)	5199.16 (TOP)	2.09'
⑥ 5201.23 (SOFFIT)		5204.64 (BOP)	3.41'
⑦	5198.75 (SOFFIT)	5204.63 (BOP)	5.88'
⑧ 5199.68 (INV.)		5196.95 (SOFFIT)	2.73'
⑨ 5202.24 (SOFFIT)		5204.01 (BOP)	1.77'
⑩	5194.05 (SOFFIT)	5195.57 (BOP)	1.52'
⑪	5189.95 (SOFFIT)	5191.92 (BOP)	1.97'
⑫	5190.32 (SOFFIT)	5192.80 (BOP)	2.38'
⑬ 5203.89 (INV.)		5199.82 (TOP)	4.07'
⑭ 5203.61 (INV.)		5202.66 (SOFFIT)	0.95'

- LEGEND**
- PROPOSED SANITARY SEWER
 - PROPOSED SAS MANHOLE
 - PROPOSED FIRE HYDRANT
 - PROPOSED GATE VALVE
 - PROPOSED CAP OR PLUG
 - PROPOSED SINGLE METER, WATER SERVICE LINE
 - PROPOSED DOUBLE METER, WATER SERVICE LINES
 - PROPOSED SANITARY SEWER SERVICE LINE
 - PROPOSED CROSS, TEE, OR ELBOW
 - REMOVE AND REPLACE EXISTING PAVEMENT PER COA STD DWG 2465


SCALE 1"=60'

N

Thompson Engineering Consultants, Inc.
 4500 JUAN PABLO NE, SUITE C ALBUQUERQUE, NEW MEXICO 87111
 PHONE: (505) 271-2199 FAX: (505) 237-6422
 tecom@yahoo.com

CITY OF ALBUQUERQUE PUBLIC WORKS DEPARTMENT TRANSPORTATION DEVELOPMENT BLUEWATER POINTE SUBDIVISION OVERALL UTILITY PLAN	
DESIGN REVIEW COMMITTEE FEB 22 2005 DESIGN REVIEW COMMITTEE	CITY ENGINEER APPROVAL 132 88 13 CITY ENGINEER
City Project No. 751681	Zone Map No. K-9-Z
Sheet 11	Of 20

AS BUILT INFORMATION		BENCH MARK		SURVEY INFORMATION		ENGINEER'S SEAL	
CONTRACT NO.	AS STA. 8+49	DATE	NO.	DATE	NO.	DATE	NO.
DESIGNED BY	DATE	BY	DATE	BY	DATE	BY	DATE
CHECKED BY	DATE	CHECKED BY	DATE	CHECKED BY	DATE	CHECKED BY	DATE
REMARKS DESIGNED BY DBT DATE 02-17-05 CHECKED BY DBT DATE 02-17-05				NO. DATE REMARKS 1 02-17-05 2 02-17-05			

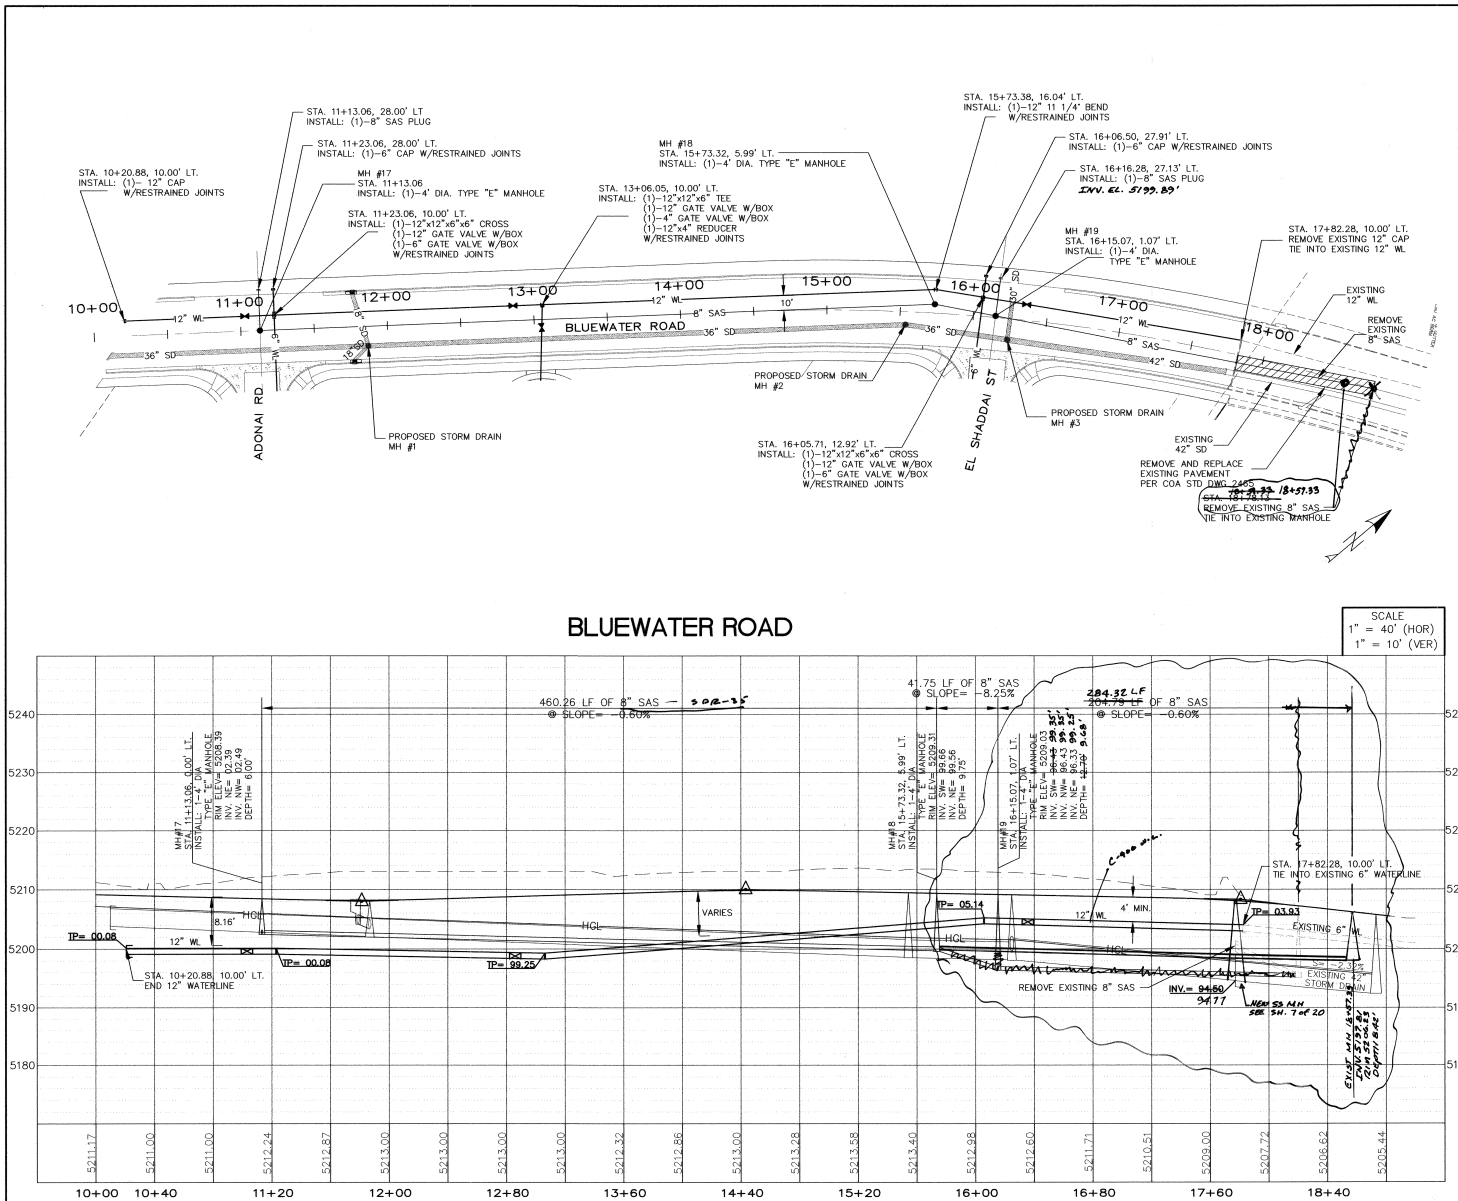

Z:\PROJECTS\BLUEWATER POINTE\PLANSET\12-PNP.DWG 2-18-05 10:52:00 am EST


AS BUILT INFORMATION		BENCH MARK		SURVEY INFORMATION		ENGINEER'S SEAL	
CONTRACT	DATE	AS STA	DATE	NO.	BY	NO.	DATE
CONTRACT 445, 446, 447, 999, 1000	DATE	DATE	DATE	DATE	DATE	DATE	DATE
DESIGNED BY DBT		DATE 02-17-05		DESIGNED BY DBT		DATE 02-17-05	
DRAWN BY DBT		DATE 02-17-05		DRAWN BY DBT		DATE 02-17-05	
CHECKED BY DBT		DATE 02-17-05		CHECKED BY DBT		DATE 02-17-05	

CITY OF ALBUQUERQUE
PUBLIC WORKS DEPARTMENT
TRANSPORTATION DEPARTMENT

BLUEWATER POINTE SUBDIVISION
BLUEWATER RD UTILITY PLAN & PROFILE


DESIGN REVIEW COMMITTEE CITY ENGINEER APPROVAL
FEB 2 2 2005
DESIGN REVIEW COMMITTEE CITY ENGINEER

City Project No. 751681 Zone Map No. K-9-Z Sheet 12 Of 20

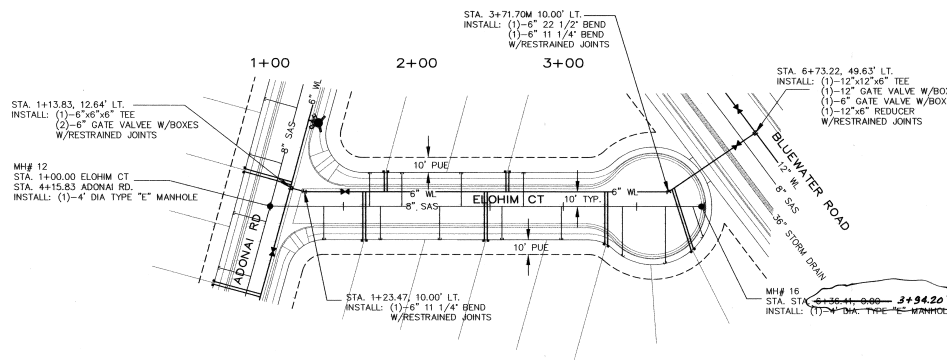


ELOHIM COURT


SCALE
1" = 40' (HOR)
1" = 10' (VER)

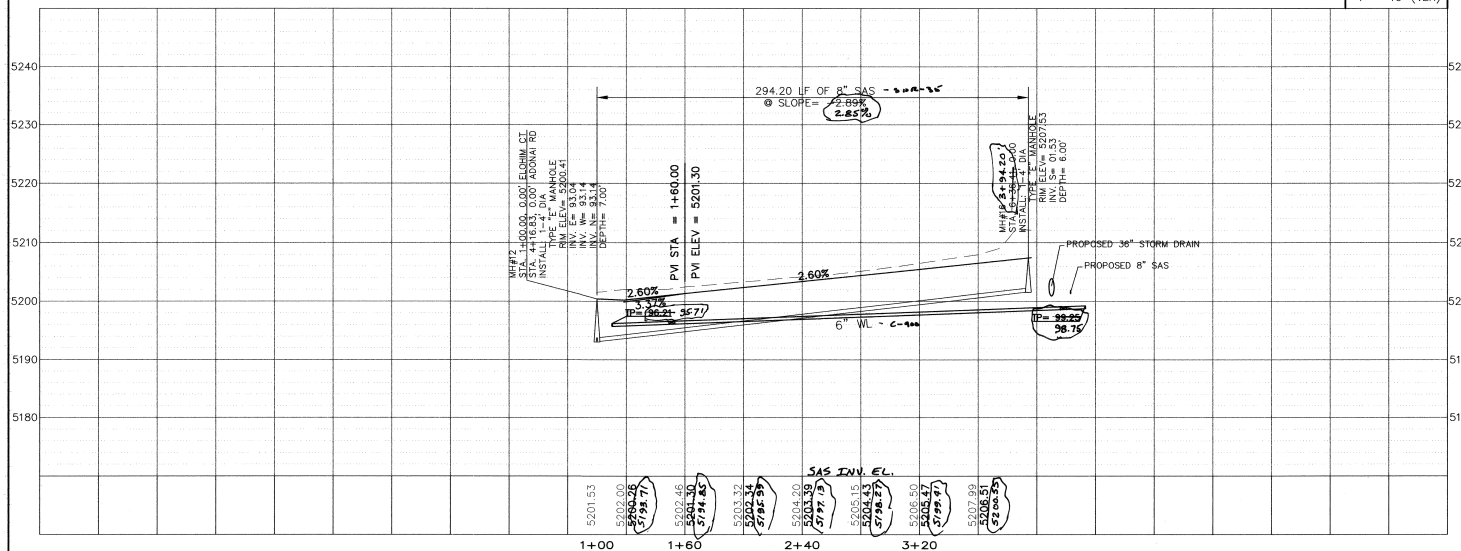

LEGEND		RECORD DRAWING	
	PROPOSED SANITARY SEWER		PROPOSED FIRE HYDRANT
	PROPOSED GATE VALVE		PROPOSED CAP OR PLUG
	PROPOSED SINGLE METER, WATER SERVICE LINE		PROPOSED DOUBLE METER, WATER SERVICE LINES
	PROPOSED SANITARY SEWER SERVICE LINE		PROPOSED CROSS, TEE, OR ELBOW
	EXISTING FIREHYDRANT		EXISTING WATER VALVE
	EXISTING MANHOLE		
AS BUILT INFORMATION CONTRACTOR: <i>AS-BUILT</i> DRAWN BY: <i>S. J. J.</i> CHECKED BY: <i>S. J. J.</i> DATE: <i>1/1/00</i>		BENCH MARK ACS STA. 8-49 X = 35217.80, Y = 148431.98 Δ = 0°17'02" G-D 0.9987415 ELEV. 5247.43 NEW MEXICO STATE PLANE GRID, CENTRAL ZONE (NAD 1983)	
SURVEY INFORMATION FIELD NOTES NO. <i>1</i> BY <i>AS-BUILT</i>		ENGINEER'S SEAL 	
DESIGN DESIGNED BY: DBT DATE: 02-17-05 CHECKED BY: DBT DATE: 02-17-05		REMARKS NO. DATE 1 02-17-05	
CITY OF ALBUQUERQUE PUBLIC WORKS DEPARTMENT TRANSPORTATION DEVELOPMENT BLUEWATER POINTE SUBDIVISION ELOHIM COURT UTILITY PLAN & PROFILE			
DESIGN REVIEW COMMITTEE FEB 2 2 2005 CITY ENGINEER		CITY ENGINEER APPROVAL CITY ENGINEER	
City Project No. 751681		Zone Map No. K-9-Z	
Sheet 14		Of 20	

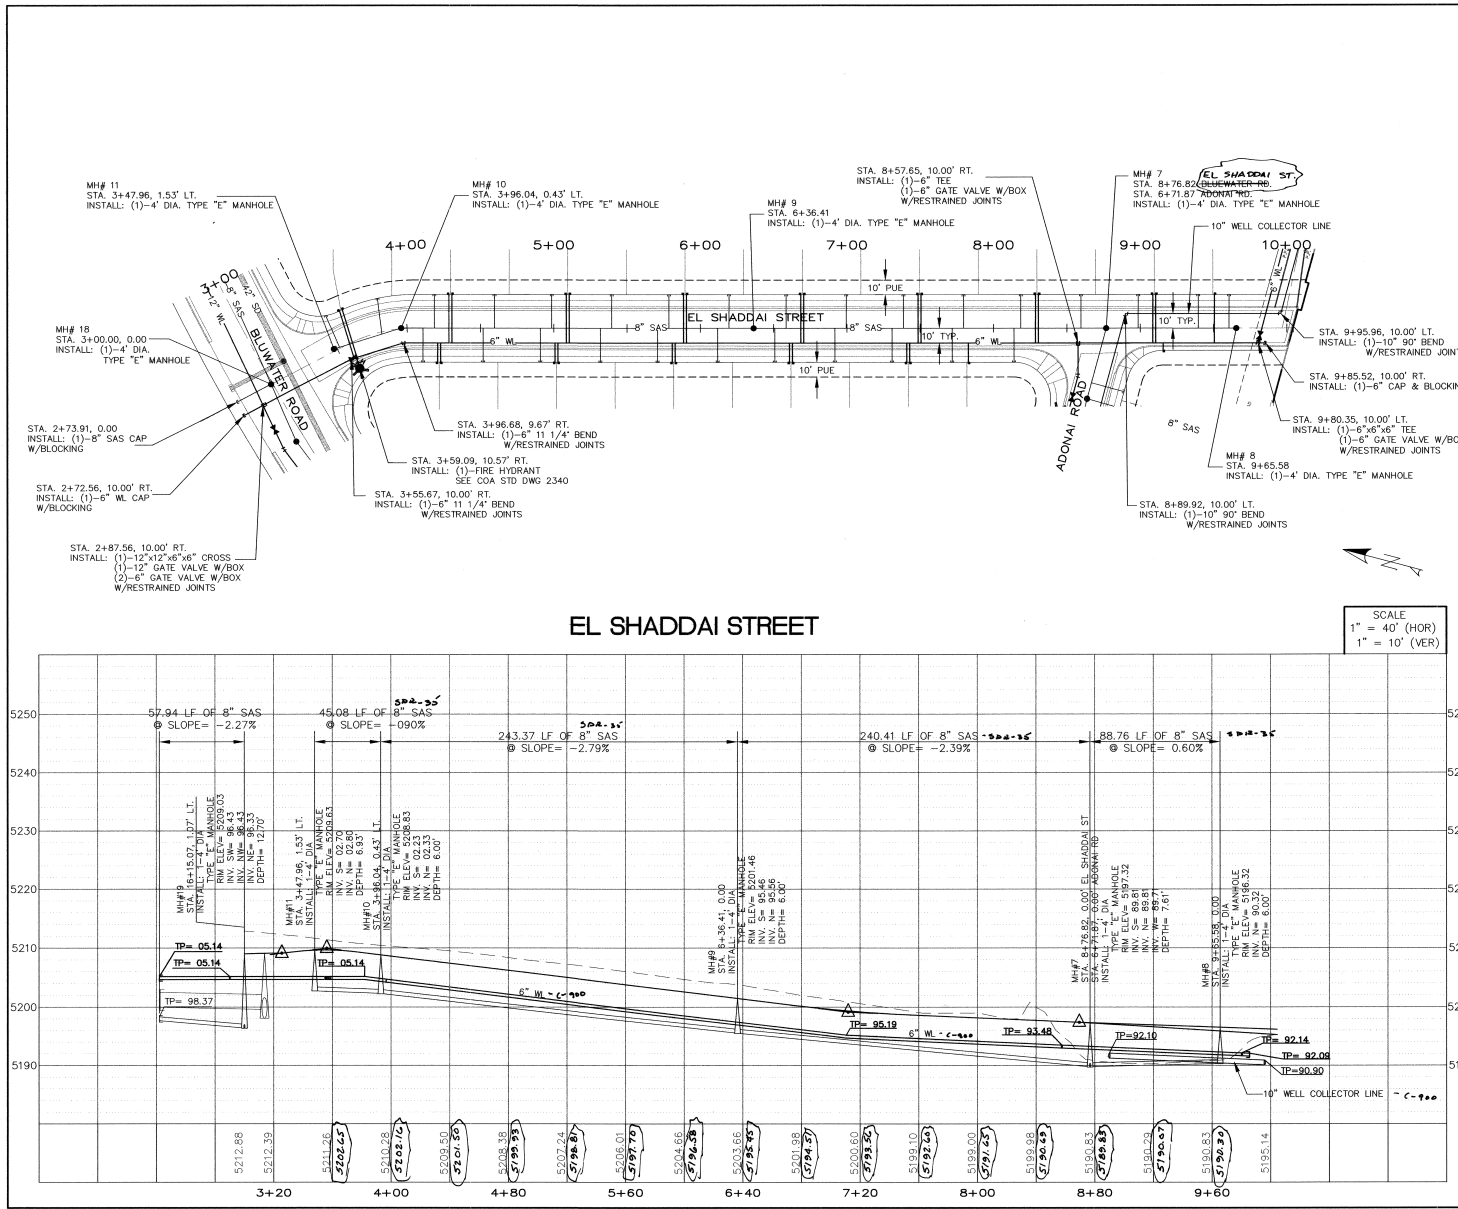


AS BUILT INFORMATION		BENCH MARK		SURVEY INFORMATION		ENGINEER'S SEAL	
CONTRACT NO.	AS BUILT INFORMATION	AS STA. 8+49	DATE	NO.	DATE		REMARKS NO. DATE DESIGNED BY DBT DATE 02-03-05 DRAWN BY DEM DATE 02-03-05 CHECKED BY DBT DATE 02-03-05
PROJECT NO.	AS BUILT INFORMATION	X = 352217.80, Y = 148431.98	DATE	NO.	DATE		
DATE	AS BUILT INFORMATION	AS STA. 8+49	DATE	NO.	DATE	DESIGN NO. DATE DESIGNED BY DBT DATE 02-03-05 DRAWN BY DEM DATE 02-03-05 CHECKED BY DBT DATE 02-03-05	
LEGEND PROPOSED SANITARY SEWER PROPOSED SAS MANHOLE PROPOSED FIRE HYDRANT PROPOSED GATE VALVE PROPOSED CAP OR PLUG PROPOSED SINGLE METER, WATER SERVICE LINE PROPOSED DOUBLE METER, WATER SERVICE LINES PROPOSED SANITARY SEWER SERVICE LINE PROPOSED CROSS, TEE, OR ELBOW EXISTING FIREHYDRANT EXISTING WATER VALVE EXISTING MANHOLE		AS-BUILT 		DESIGN 		CITY OF ALBUQUERQUE PUBLIC WORKS DEPARTMENT TRANSPORTATION DEVELOPMENT BLUEWATER POINTE SUBDIVISION EL SHADDAI ST UTILITY PLAN & PROFILE	
City Project No.	751681	Zone Map No.	K-9-Z	Sheet	15	Of	20

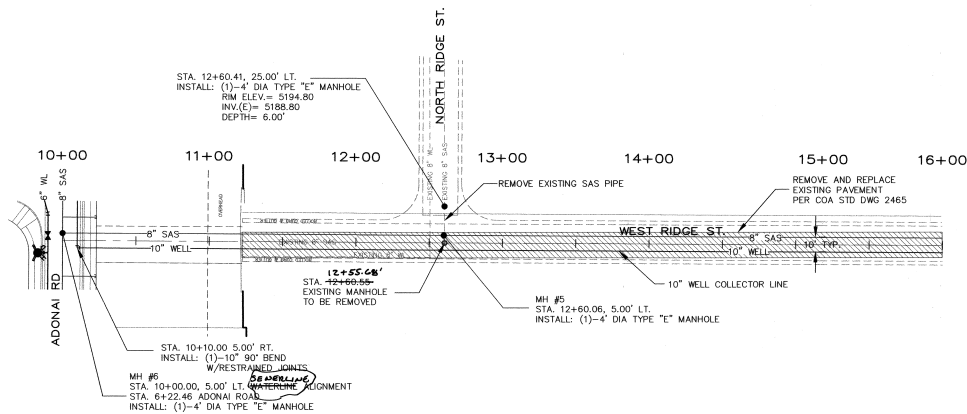

WEST RIDGE ST (PRIVATE)

SCALE
1" = 40' (HOR)
1" = 10' (VER)

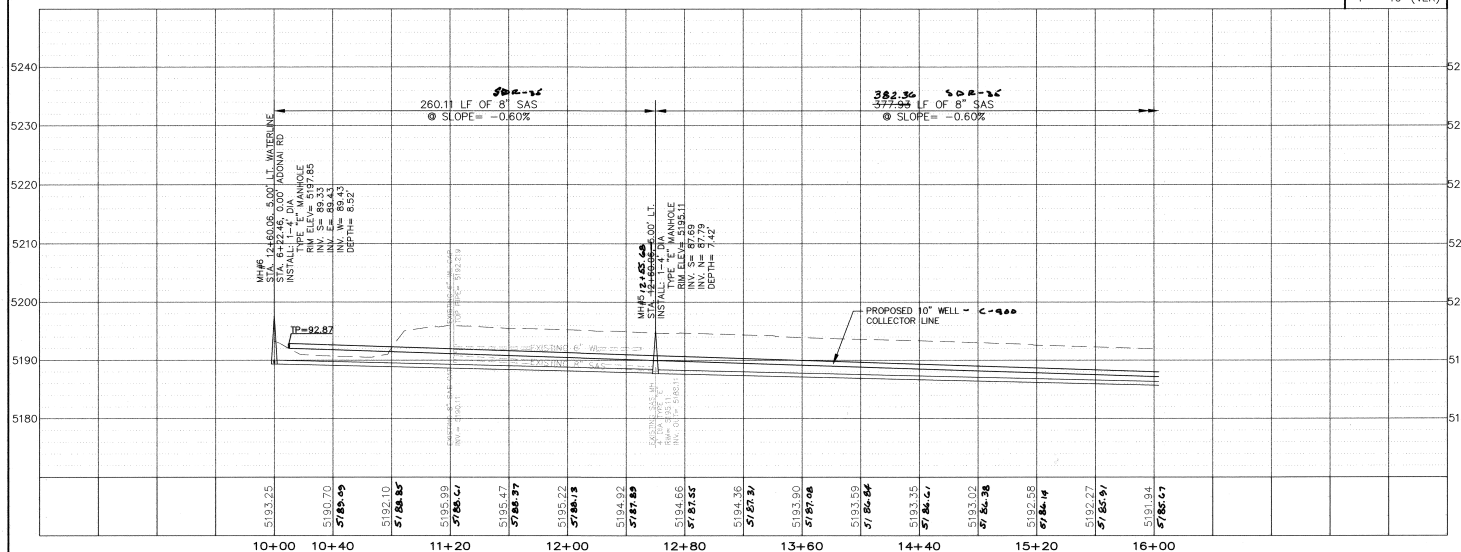

LEGEND

- PROPOSED SANITARY SEWER
- PROPOSED SAS MANHOLE
- PROPOSED FIRE HYDRANT
- PROPOSED GATE VALVE
- PROPOSED CAP OR PLUG
- PROPOSED SINGLE METER, WATER SERVICE LINE
- PROPOSED DOUBLE METER, WATER SERVICE LINES
- PROPOSED SANITARY SEWER SERVICE LINE
- PROPOSED CROSS, TEE, OR ELBOW
- REMOVE AND REPLACE EXISTING PAVEMENT PER COA STD DWG 2465
- EXISTING FIREHYDRANT
- EXISTING WATER VALVE
- EXISTING MANHOLE

Record Drawing

CONTRACTOR	DATE
AS-BUILT	1/1/2005
DESIGNED BY	DATE
AS-BUILT	1/1/2005
CHECKED BY	DATE
AS-BUILT	1/1/2005
RECORDED BY	DATE
AS-BUILT	1/1/2005

BENCH MARK

ACS STA.	DATE
8-49	1/1/2005
DATE	DATE
1/1/2005	1/1/2005
DATE	DATE
1/1/2005	1/1/2005

SURVEY INFORMATION

NO.	DATE
1	1/1/2005
DATE	DATE
1/1/2005	1/1/2005
DATE	DATE
1/1/2005	1/1/2005

ENGINEER'S SEAL


AS-BUILT

AS-BUILT




Tompson Engineering Consultants, Inc.
4000 JUAN TABO NE, SUITE C, ALBUQUERQUE, NEW MEXICO 87111 PHONE: (505) 271-2199 FAX: (505) 237-8422

CITY OF ALBUQUERQUE PUBLIC WORKS DEPARTMENT TRANSPORTATION DEVELOPMENT			
BLUEWATER POINTE SUBDIVISION			
WEST RIDGE ST UTILITY PLAN & PROFILE			
DESIGN REVIEW COMMITTEE APPROVED FEB 2 2005	CITY ENGINEER APPROVAL APPROVED FEB 2 2005	MO. DAY/YR.	MO. DAY/YR.
DESIGN REVIEW COMMITTEE	CITY ENGINEER		
City Project No. 751681	Zone Map No. K-9-Z	Sheet 16	Of 20

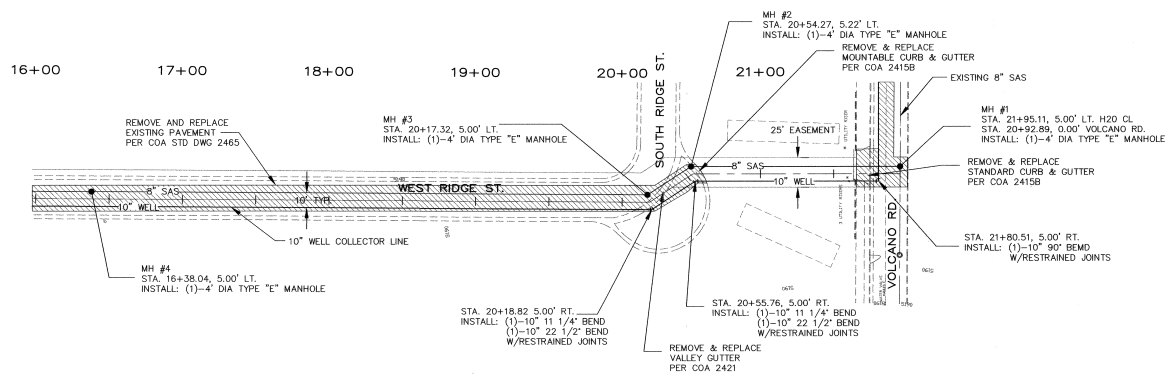


WEST RIDGE ST (PRIVATE)

SCALE
1" = 40' (HOR)
1" = 10' (VER)

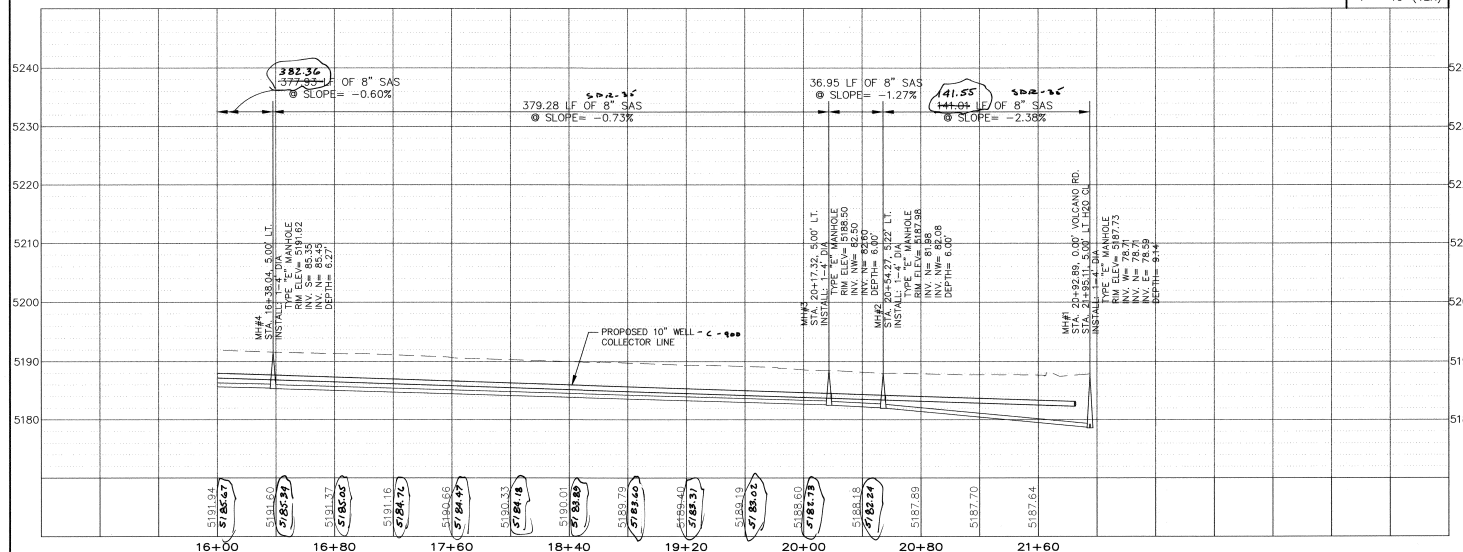

- ## LEGEND
- PROPOSED SANITARY SEWER
 - PROPOSED SAS MANHOLE
 - PROPOSED FIRE HYDRANT
 - PROPOSED GATE VALVE
 - PROPOSED CAP OR PLUG
 - PROPOSED SINGLE METER, WATER SERVICE LINE
 - PROPOSED DOUBLE METER, WATER SERVICE LINES
 - PROPOSED SANITARY SEWER SERVICE LINE
 - PROPOSED CROSS, TEE, OR ELBOW
 - REMOVE AND REPLACE EXISTING PAVEMENT PER COA STD DWG 2465
 - EXISTING FIREHYDRANT
 - EXISTING WATER VALVE
 - EXISTING MANHOLE

AS BUILT INFORMATION		BENCH MARK		SURVEY INFORMATION		ENGINEER'S SEAL	
CONTRACTOR	DATE	AS STA.	DATE	NO.	BY	NO.	DATE
AS-BUILT	1/18/06	8-49	1/18/06				
CONTRACTOR: AS-BUILT		BENCH MARK: AS STA. 8-49		SURVEY INFORMATION: NO. BY		ENGINEER'S SEAL: [Signature]	
DESIGNED BY: [Signature]		CHECKED BY: [Signature]		DESIGNED BY: [Signature]		CHECKED BY: [Signature]	
DATE: 02-03-05		DATE: 02-03-05		DATE: 02-03-05		DATE: 02-03-05	
CITY OF ALBUQUERQUE PUBLIC WORKS DEPARTMENT TRANSPORTATION DEVELOPMENT		BLUEWATER POINTE SUBDIVISION		WEST RIDGE ST UTILITY PLAN & PROFILE		CITY ENGINEER APPROVAL: [Signature]	
DESIGN REVIEW COMMITTEE: [Signature]		CITY ENGINEER: [Signature]		DESIGN REVIEW COMMITTEE: [Signature]		CITY ENGINEER: [Signature]	
City Project No. 751681		Zone Map No. K-9-Z		Sheet 17		Of 20	

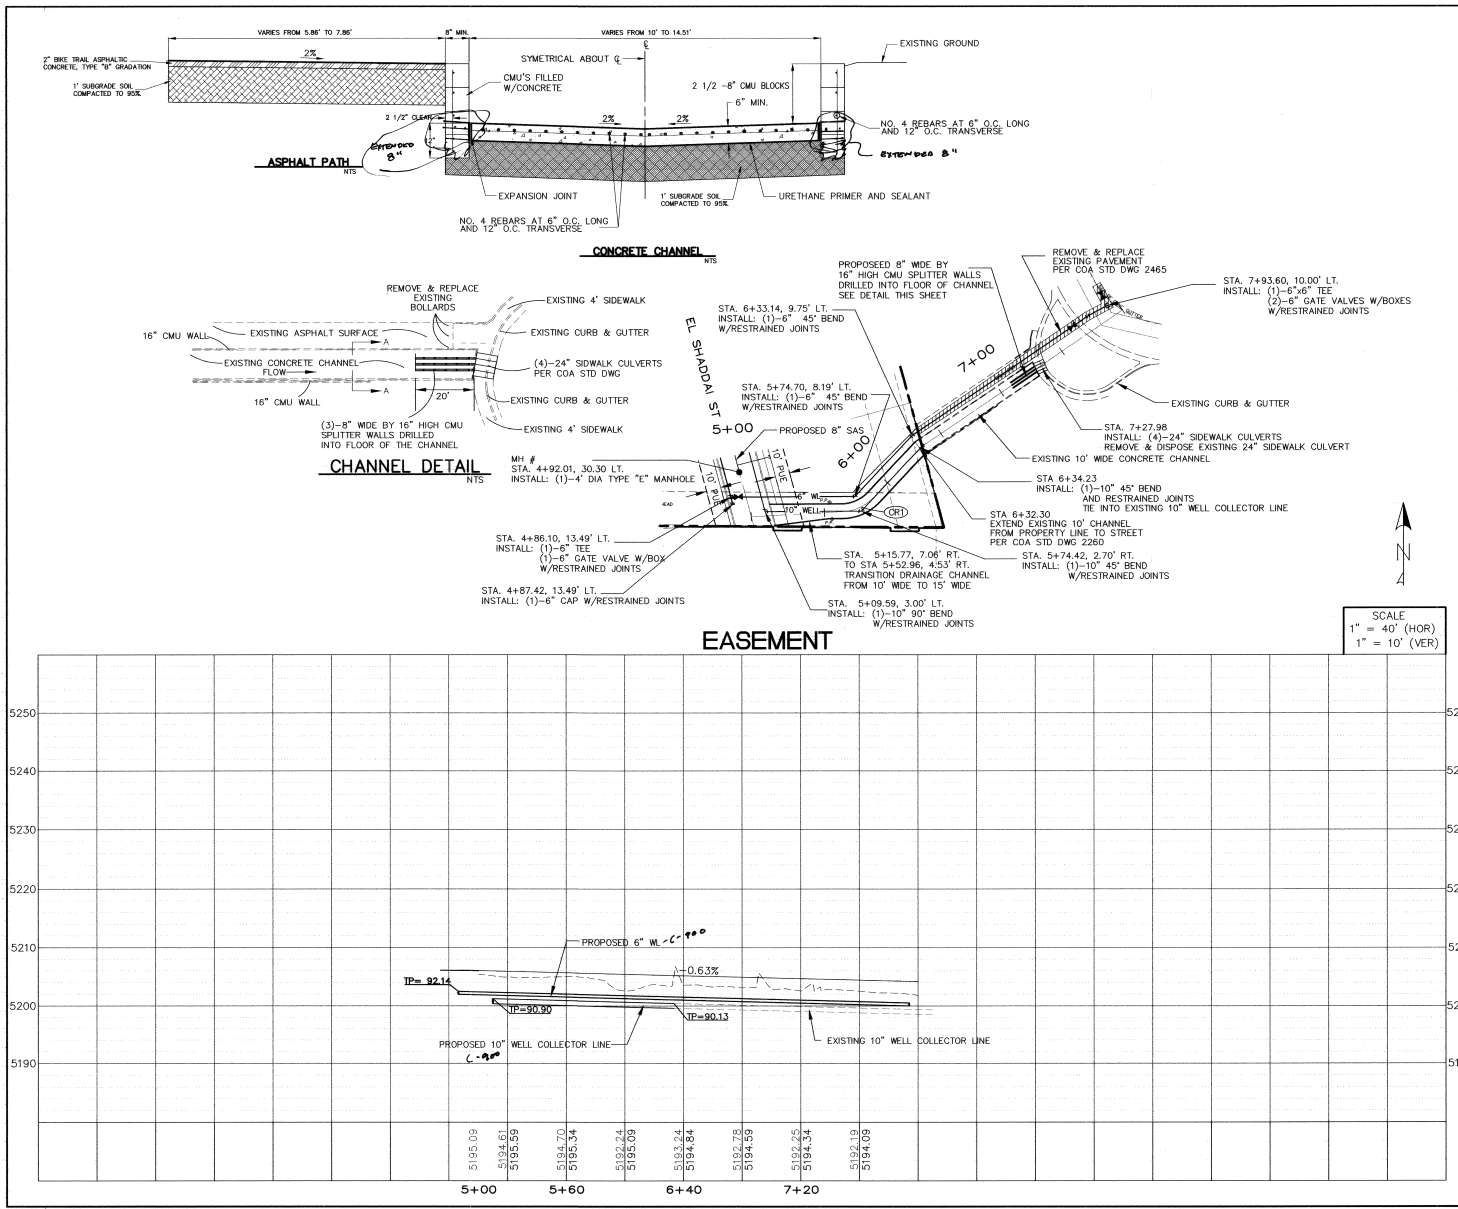

LEGEND

- PROPOSED SANITARY SEWER
- PROPOSED SAS MANHOLE
- PROPOSED FIRE HYDRANT
- PROPOSED GATE VALVE
- PROPOSED CAP OR PLUG
- PROPOSED SINGLE METER, WATER SERVICE LINE
- PROPOSED DOUBLE METER, WATER SERVICE LINES
- PROPOSED SANITARY SEWER SERVICE LINE
- PROPOSED CROSS, TEE, OR ELBOW
- REMOVE AND REPLACE EXISTING PAVEMENT PER COA STD DWG 2465
- EXISTING FIREHYDRANT
- EXISTING WATER VALVE
- EXISTING MANHOLE

CURVE DATA TABLE

CURVE #	DELTA	RADIUS	TAN	LENGTH
(CR1)	190°59"	30.00'	12.05'	22.92'

Record Drawing

CONTRACTOR: **AS - BUILT**

DESIGNED BY: **J. J. Jarama**

DRAWN BY: **J. J. Jarama**

CHECKED BY: **J. J. Jarama**

DATE: **02-17-05**

DATE: **02-17-05**

DATE: **02-17-05**

DATE: **02-17-05**

AS BUILT INFORMATION

ACR STA: **8+09**

X = **350217.80** Y = **1484031.98**

DELTA: **-0717°02'** G-G: **0.98857415**

ELEV: **5247.43**

NEW MEXICO STATE PLANE

GRID: **CENTRAL ZONE (NAD 1983)**

ENGINEER'S SEAL

AS - BUILT

DESIGNED BY: DBT

DRAWN BY: DBT

CHECKED BY: DBT

DATE: 02-17-05

DATE: 02-17-05

DATE: 02-17-05

CITY OF ALBUQUERQUE

PUBLIC WORKS DEPARTMENT

TRANSPORTATION DEVELOPMENT

BLUEWATER POINTE SUBDIVISION

EASEMENT UTILITY PLAN & PROFILE

DESIGN REVIEW COMMITTEE: **FEB 23 2005**

CITY ENGINEER APPROVAL: **NOV 23 2004**

DESIGN REVIEW COMMITTEE: **FEB 23 2005**


CITY ENGINEER: **NOV 23 2004**

City Project No. **751681**

Zone Map No. **K-9-Z**

Sheet **19** of **20**

SAS SERVICE HOOK-UP				WATER MAIN LINE SPIR		
LOT SHADON STREET						
LOT	STATION	OFFSET	ELEV.	STATION	OFFSET	TYPE
13				9+115.64	15.00	R1 SINGLE
14	9+46.50	23.00	L1	9+49.58	23.00	R1 SINGLE
15	9+49.58	23.00	L1	9+49.58	23.00	R1 DOUB
16	8+49.58	23.00	L1	9+101.04		
17	8+52.58	23.00	L1	9+101.04		
18	8+52.58	23.00	L1	8+29.58	23.00	R1 DOUB
19	7+52.58	23.00	L1	8+29.58	23.00	R1 DOUB
20	7+49.58	23.00	L1	7+49.58	23.00	R1 DOUB
21	6+49.58	23.00	L1	6+49.58	23.00	R1 DOUB
22	6+48.58	23.00	L1	5+89.58	23.00	R1 DOUB
23	6+49.58	23.00	L1	5+89.58	23.00	R1 DOUB
24	5+78.58	23.00	L1	5+89.58	23.00	R1 DOUB
25	5+78.58	23.00	L1	5+89.58	23.00	R1 DOUB
26	4+59.58	23.00	L1	4+59.58	23.00	R1 DOUB
27	4+59.58	23.00	L1	4+59.58	23.00	R1 DOUB
28	4+59.58	23.00	L1	4+59.58	23.00	R1 DOUB
29	3+48.58	23.00	L1	3+63.01	23.00	R1 DOUB
30	3+48.58	23.00	L1	3+63.01	23.00	R1 DOUB
190						

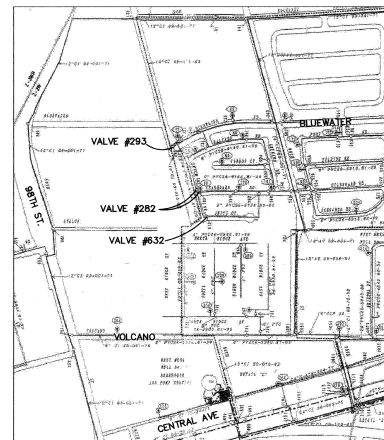

WATER-SHUT-OFF PLAN

- NOTES:
1. CLOSE VALVES - 282, 293, 632
 2. INSTALL 12" WATERLINE IN BLUE
6" WATERLINES IN THE SUBDIVISION
WELL COLLECTOR LINE IN THE
AND WEST RIDGE STREET.
 3. OPEN VALVES - 282, 293, 632

 Thompson Engineering Consultants, Inc. tcecon@bpo.com		4500 JUAN TABO NE, SUITE C PHONE: (505) 271-5199 ALBUQUERQUE, NEW MEXICO 87111 FAX: (505) 237-5422		CITY OF ALBUQUERQUE PUBLIC WORKS DEPARTMENT TRANSPORTATION DEVELOPMENT		BLUEWATER POINTE SERVICE LINE TABLE & WATER-SHUT-OFF PLAN		DESIGN REVIEW COMMITTEE FEB 22 2005 DESIGN REVIEW COMMITTEE		CITY ENGINEER APPROVAL NOV 23 2004 CITY ENGINEER		NO. DATE REMARKS BY		DESIGNED BY DBT DATE 02-17-05 DRAWN BY DBT DATE 02-17-05 CHECKED BY DBT DATE 02-17-05	
ENGINEER'S SEAL 		SURVEY INFORMATION FIELD NOTES NO. BY DATE		BENCH MARKS ACS STA. 6+49 X = 352217.80, Y = 146493.98 G-C 0.99957415 ELEV. 5017.63 NEW MEXICO STATE PLANE GRID, CENTRAL ZONE (NAD 1927)		Record Drawing AS BUILT INFORMATION CONTRACT NO. 444-1-000000000000 SHEET NO. 1 OF 1 DATE 02-17-05 DRAWN BY DBT CHECKED BY DBT DATE 02-17-05									