


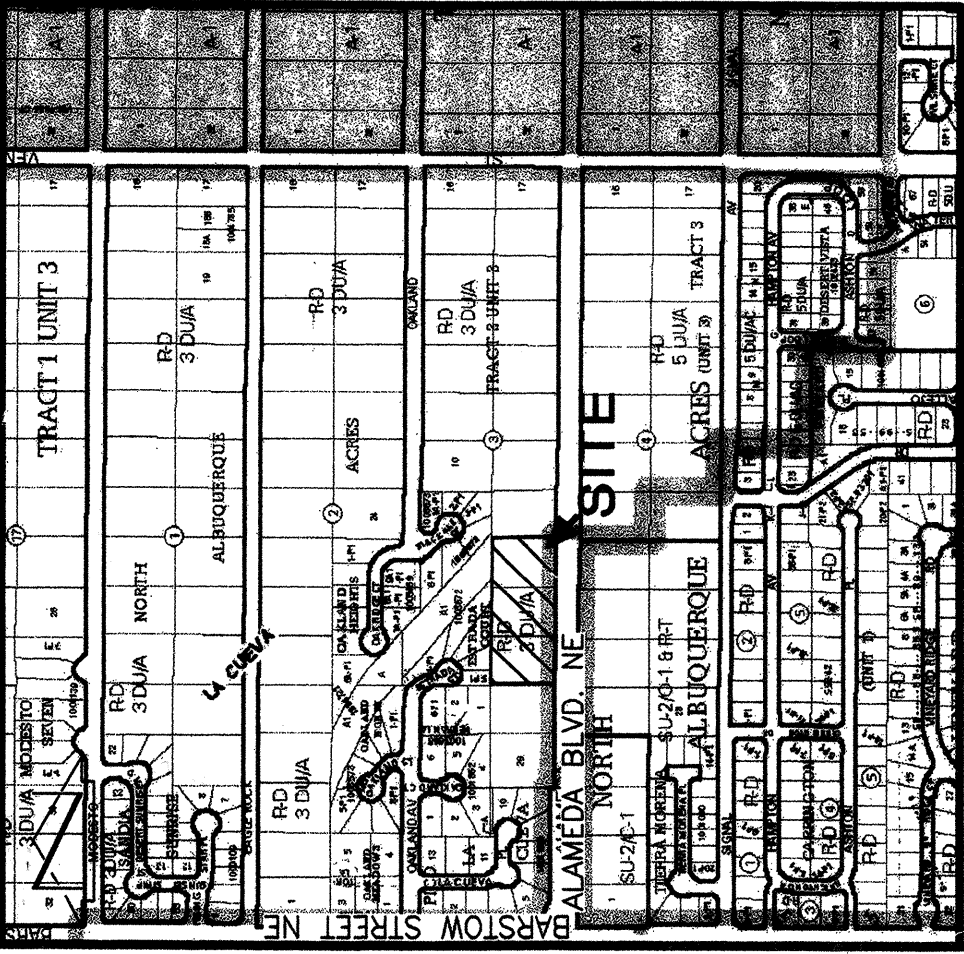

VICINITY MAP
SCALE: 1" = 750'

DEDICATION AND FREE CONSENT

The subdivision hereon is with the free consent and in accordance with the desires of the undersigned owner and does hereby dedicate to the City of Albuquerque in fee simple with warranty covenants the public street rights-of-way with respect to Rich Court N.E., and does hereby dedicate to the City of Albuquerque in fee simple the public street rights-of-way with respect to the north-half of Alameda Boulevard N.E. and does hereby grant the easements as shown on this plat to the City of Albuquerque and the right to trim interfering trees. I hereby warrant that I hold complete and indefeasible title in fee simple to the land subdivided, herein.

Robert Keerlin, President,
Love Development, Inc.

ACKNOWLEDGEMENT


STATE OF NEW MEXICO

COUNTY OF BERNALILLO

This instrument was acknowledged before me on this 19th day of April, 2007, by Robert Keerlin, President,

Love Development, Inc.,

Notary Public

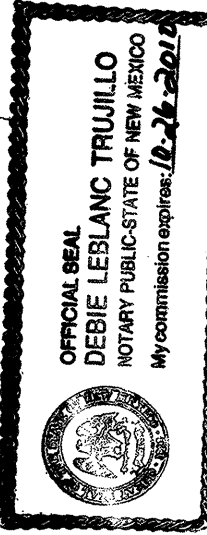

4/19/07
Date



THIS IS TO CERTIFY THAT TAXES ARE CURRENT AND
PAID ON D.P.C. # 10200064-203064-20308
10200064-203064-20308
Love Development Inc
BERNALILLO COUNTY PLANNING OFFICE

Recorded: 5-7-07

PLAT OF
LOTS 1-6 AND TRACT A, RICH COURT
ALBUQUERQUE, BERNALILLO COUNTY, NEW MEXICO
APRIL, 2007

DESCRIPTION

Lots 25, 26 and 27, Block 3, North Albuquerque Acres, Tract 3, Unit 3, Albuquerque, New Mexico, as the same is shown and designated on the plat filed in the Office of the County Clerk of Bernalillo County, New Mexico on September 10, 1931, Book D, Page 121.

C-20

SCALE: 1" = 750'

Public Utility easements shown on this plat are ten (10) feet wide and are granted for the common and joint use of:

1. The P.N.M. Electric Services for the installation, maintenance, and service of overhead and underground electrical lines, transformers, poles and other equipment, fixtures, structures and related facilities reasonably necessary to provide electrical service.
2. The P.N.M. Gas Services for installation, maintenance, and service of natural gas lines, valves and other equipment and facilities reasonably necessary to provide natural gas.
3. Quest Corporation for the installation, maintenance, and service of overhead and underground communication lines and other related equipment, fixtures, structures and related facilities reasonably necessary to provide communication services including, but not limited to, above ground pedestals and closures.
4. Comcast Cable Vision of New Mexico, Inc. for the installation, maintenance, and service of such lines, cables, and other related equipment and facilities reasonably necessary to provide Cable TV service.

Included, is the right to build, rebuild, construct, reconstruct, locate, relocate, change, remove, modify, renew, operate, and maintain facilities for the purposes described above, together with free access to, from, and over said easements, including adjacent working area space for electric transformers, with the right to install and maintain any and all necessary equipment, which interfere with the purposes set forth herein. No building, sign, pool (aboveground or subsurface), hot tub, concrete or wood pool decking, or other structure shall be erected or constructed on said easements, nor shall any well be drilled or operated thereon. Property owners shall be solely responsible for correcting any violations of the National Electric Safety Code and the National Gas Code. The easements shown on this plat are adjacent to within or near easements shown on this plat.

UNAME DEVELOPMENT, INC.
OWNERS
PROJECTED
SEC. 17, T. 11 N., R. 4 E., N.M.P.M.
LOCATION
RICH COURT
SUBMISSION

SCANNED BY
PLANNING

PLAT OF

TRACT A, RICH COURT

ALBUQUERQUE, BERNALILLO COUNTY, NEW MEXICO

APRIL, 2007

DRB PROJECT NUMBER 1003674

APPLICATION NUMBERS 06DRB-01082, 06DRB-01083, 06DRB-01125, 07DRB-00332 + 00533

APPROVALS:

DRB CHAIRPERSON, PLANNING DEPARTMENT, CITY OF ALBUQUERQUE, NEW MEXICO
DATE 05/07/07
UTILITIES DEVELOPMENT, CITY OF ALBUQUERQUE, NEW MEXICO
DATE 5-2-07
CITY ENGINEER, CITY OF ALBUQUERQUE, NEW MEXICO
DATE 5/2/07
A.M.A.F.C.A.
DATE 5/2/07

TRAFFIC ENGINEERING, TRANSPORTATION DIVISION, CITY OF ALBUQUERQUE, NEW MEXICO
DATE 5-2-07

PARKS AND RECREATION DEPARTMENT, CITY OF ALBUQUERQUE, NEW MEXICO
DATE 5/2/07

CITY SURVEYOR, CITY OF ALBUQUERQUE, NEW MEXICO
DATE 4-19-07

REAL PROPERTY DIVISION, CITY OF ALBUQUERQUE, NEW MEXICO
DATE 5-03-07

P.N.M. ELECTRIC SERVICES
DATE 4-30-07


QUEST TELECOMMUNICATIONS
DATE 5/2/07

P.N.M. GAS SERVICES
DATE 4-30-07

COMCAST CABLE VISION OF NEW MEXICO, INC.
DATE 5-1-07

SURVEYORS CERTIFICATION

I, Charles G. Calo, Jr., New Mexico Professional Surveyor No. 11184, do hereby certify, that this Plat and the actual survey on the ground upon which it is based were performed by me or under my direct supervision; that the survey shows all easements made known to me by this owner, with the exception of those shown on the survey plat, and that the survey was conducted in accordance with the minimum requirements for Monumentation and Surveying of the Albuquerque Ordinance; that this survey meets the Minimum Standards for Surveying in New Mexico, and that it is true and correct to the best of my knowledge and belief.

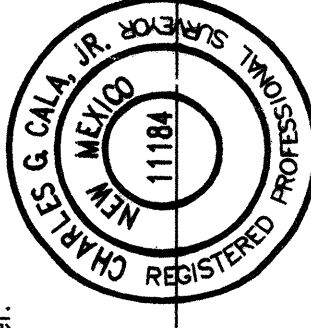

Charles G. Calo, Jr., NMPS 11184

Jeff Mortensen & Associates, Inc.
600-B MIDWAY PARK BLVD. N.E.
ALBUQUERQUE, NM 87109
ENGINEERS & SURVEYORS (SWS) 345-4250
JOB #2005.070.3 FINAL

PLAT OF
LOTS 1-6 AND TRACT A, RICH COURT
ALBUQUERQUE, BERNALILLO COUNTY, NEW MEXICO
APRIL, 2007

- Notes:
1. A boundary survey was performed in April, 2006. Property corners were found or set as indicated.
 2. All distances are ground distances.
 3. Site located within projected Section 1/4, Township 11 North, Range 4 East, N.M.P.M. (Elena Gallegos Grant).
 4. Bearings shown hereon are New Mexico State Plane Grid Bearings, Central Zone. These bearings are positioned from A.C.S.'s Control Station 7-C19.
 5. Record bearings and distances are shown in parenthesis.
 6. Public street mileage created by this plat = 0.05 miles (full-width) and 0.09 (half-width).
 7. The purpose of this plat is to:
 - a. Create 6 (six) residential lots and 1 (one) tract within Lots 25-27, inclusive, Block 3, North Albuquerque Acres, Tract 3, Unit 3.
 - b. Eliminate the interior property lines between former Lots 25-27, inclusive.
 - c. Dedicate in fee simple, with warranty covenants, the necessary public street rights-of-way for Rich Court; and also dedicate in fee simple the half-width for Alameda Boulevard as shown.
 - d. Grant the necessary private drainage, public utility, public roadway, public drainage and City of Albuquerque public water line, public sanitary sewer and public storm drainage easements as shown.
 - e. Vacate the nonspecific easements and/or right-of-ways for road and/or pipeline purposes (water, gas or sewage), telephone and electrical energy as noted, affecting the properties partitioned hereon, and grant by the following plat, Book 2005C, Page 104, the necessary public street rights-of-way for Rich Court, Bernalillo County, New Mexico by this request (07DRB-00533).
 - f. Vacate a portion of the public rights-of-way of Alameda Boulevard N.E. by 06DRB-01082 as shown hereon.
 8. The following documents and instruments were used for the performance and preparation of this survey:
 - a. Plat of North Albuquerque Acres, Tract 3, Unit 3, filed 09-10-1931, Book D, Page 121, Records of Bernalillo County, New Mexico.
 - b. Plat of Oakland South, filed 01-13-2005, Book 2005C, Page 12, Records of Bernalillo County, New Mexico.
 - c. Plat of Estrada Court, filed 08-06-2005, Book 2005C, Page 299, Records of Bernalillo County, New Mexico.
 - d. Plat of Keller Lane, filed 04-06-2005, Book 2005C, Page 104, Records of Bernalillo County, New Mexico.
 - e. Plat of Oakland Court, filed 08-05-2002, Book 2002C, Page 262, Records of Bernalillo County, New Mexico.
 - f. Plat of Pico La Cueva, filed 01-25-2002, Book 2002C, Page 29, Records of Bernalillo County, New Mexico.
 - g. Proposed Plat of Hattom Court, dated 11-2004, prepared by Terametrics of New Mexico (unrecorded).
 - h. Warranty Deed filed 06-19-2003, Book A58, Page 5177, Doc. No. 2003105410, Records of Bernalillo County, New Mexico (Lot 25).
 - i. Title Insurance Policy No. J1664467 prepared by First American Title Insurance Company dated June 19, 2003 (Lot 25).
 - j. Warranty Deed filed 06-25-2003, Book A58, Page 8377, Doc. No. 2003108619, Records of Bernalillo County, New Mexico (Lot 26).
 - k. Title Insurance Policy No. J1664621 prepared by First American Title Insurance Company dated June 25, 2003 (Lot 26).
 - l. Warranty Deed filed 04-07-2006, Book A114, Page 9481, Doc. No. 2006049642, Records of Bernalillo County, New Mexico (Lot 27).
 - m. Commitment for Title Insurance File No. 807531-AL01, MLC prepared by First American Title Insurance Company dated April 21, 2006 (Lots 25, 26 & 27).
 - n. Boundary Survey, dated 05-09-2006, prepared by this firm for lots 25-27, inclusive (unrecorded).
 9. Upon completion of the construction of the streets, City of Albuquerque approved centerline monuments shall be placed at all intersections or as otherwise indicated in lieu of subdivision block corner monumentation. Location of said monuments are designated with a symbol.

- Notes (continued):
10. Monholes will be offset at points of curvature, points of tangency, street intersections, and other angle points where practical to allow use of centerline monumentation.
 11. Gross subdivision acreage = 2.9939 acres.
 12. Current Zoning on site is R-D 3DU/A, based upon review of the City of Albuquerque Zone Atlas.
 13. A portion of this subdivision is located within a 100-year flood plain as shown on the national flood insurance program "Flood Insurance Rate Map". A Letter of Map Revision (LOMR) will be requested from the Federal Emergency Management Agency (FEMA) to remove the existing flood plain. Until the LOMR is issued by FEMA, property owners may be required to purchase flood insurance.
 14. All open space requirements shall be met on the lot with the dwelling per the provisions of Section 14-16-3-8 (A) (1).
 15. The owner acknowledges and agrees that the approval of this subdivision plat shall not be considered an administrative decision to establish a default City subdivision. The owner acknowledges and agrees that the approval of this subdivision plat shall not be used by the owner against the City in New Mexico Court of Appeals Cause No. 27604, or any other case involving Section 5.2 of the La Cueva Sector Development Plan.

Owner's Signature
Robert Keerlin
Date 4/19/07

BOUNDARY TABLES

LINE	DIRECTION	DISTANCE
L1	N 05°20'26" E	7.42'
L2	S 89°39'34" E	29.64'
CL1	N 42°06'28" W	20.73'


CURVE	RADIUS	LENGTH	CHORD BEARING	CHORD	DELTA
C1	25.00'	9.09'	S 05°04'40" E	9.04'	20°50'11"
C2	30.00'	44.51'	S 47°50'26" W	40.54'	85°00'00"
C3	45.00'	62.14'	S 04°05'17" W	57.32'	79°06'57"
C4	25.00'	8.72'	S 25°28'58" E	8.67'	19°58'26"
C5	45.00'	38.56'	S 68°11'34" W	37.39'	49°05'35"
C6	25.00'	17.87'	N 69°10'53" W	17.49'	40°57'21"
C7	45.00'	30.28'	N 87°58'56" W	29.71'	38°33'26"
C8	1462.00'	70.48'	N 82°59'42" W	70.48'	02°45'44"
C9	1462.00'	58.75'	N 85°31'38" W	58.74'	02°18'08"
C10	30.00'	48.18'	N 40°40'08" W	43.17'	92°01'08"
C11	51.30'	78.40'	N 47°50'26" E	69.59'	85°00'00"
C12	1462.00'	183.91'	N 78°00'37" W	183.79'	07°12'26"
C13	45.00'	17.81'	N 15°03'53" W	17.43'	40°48'37"
C14	45.00'	128.96'	N 49°11'58" E	89.15'	16°41'13"
C15	1462.00'	337.78'	N 81°36'47" W	366.81'	14°24'47"
C16	1462.00'	21.43'	S 89°14'22" E	21.43'	00°50'23"
CL1	75.00'	55.70'	N 26°36'59" E	54.43'	42°33'06"
CL2	75.00'	55.56'	N 69°06'59" E	54.30'	42°26'54"

EASEMENT TABLES

LINE	DIRECTION	DISTANCE	EASEMENT
E1	N 56°27'44" W	23.89'	1
E2	N 42°48'46" W	30.62'	1
E3	N 28°39'54" W	31.25'	1
E4	N 86°39'34" W	80.41'	4/5
E5	S 89°39'34" E	317.85'	4
E6	S 00°20'26" W	32.00'	4
E7	S 00°20'26" W	19.50'	5

CURVE	RADIUS	LENGTH	CHORD BEARING	CHORD	DELTA	EASEMENT
EC1	1462.00'	230.38'	N 72°09'50" W	230.14'	09°01'43"	4
EC2	30.00'	9.51'	N 77°55'55" W	9.47'	18°09'35"	4
EC3	1462.00'	82.76'	N 76°01'41" W	82.74'	03°14'36"	5

SP #2006243550

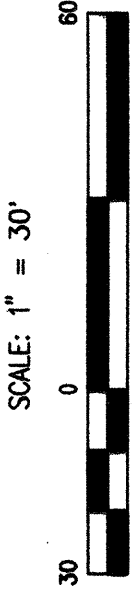

**PLAT OF
LOTS 1-6 AND TRACT A, RICH COURT
ALBUQUERQUE, BERNALILLO COUNTY, NEW MEXICO
APRIL, 2007**



COUNTY CLERK FILING DATA

LOT 1-KELLEY LANE
(FILED 04-06-2005, 2005C-104)

LOT 5-P1
ESTRADA COURT
(FILED 09-06-2005, 2005C-263)

LOT 4-P1
ESTRADA COURT
(FILED 09-06-2005, 2005C-260)

LOT 2-P1
ESTRADA COURT
(FILED 09-06-2005, 2005C-260)


TRACT A-1
ESTRADA COURT
(FILED 09-06-2005, 2005C-299)

LOT 4-P1
OAKLAND SOUTH
(FILED 01-13-2005, 2005C-12)

NEW MEXICO CENTRAL ZONE-NAD 1927
A.C.S. STA. 77+01.69
ELEVATION=5483.076 (NVD 29)
COMBINED FACTOR=0.999847655
ELEVATION=5483.076 (NVD 29)

LOT 28, BLOCK 3
NORTH ALBUQUERQUE ACRES
TRACT 3, UNIT 3
(FILED 08-10-1931, 0-121)

LOT 24, BLOCK 3
NORTH ALBUQUERQUE ACRES
TRACT 3, UNIT 3
(FILED 08-10-1931, 0-121)

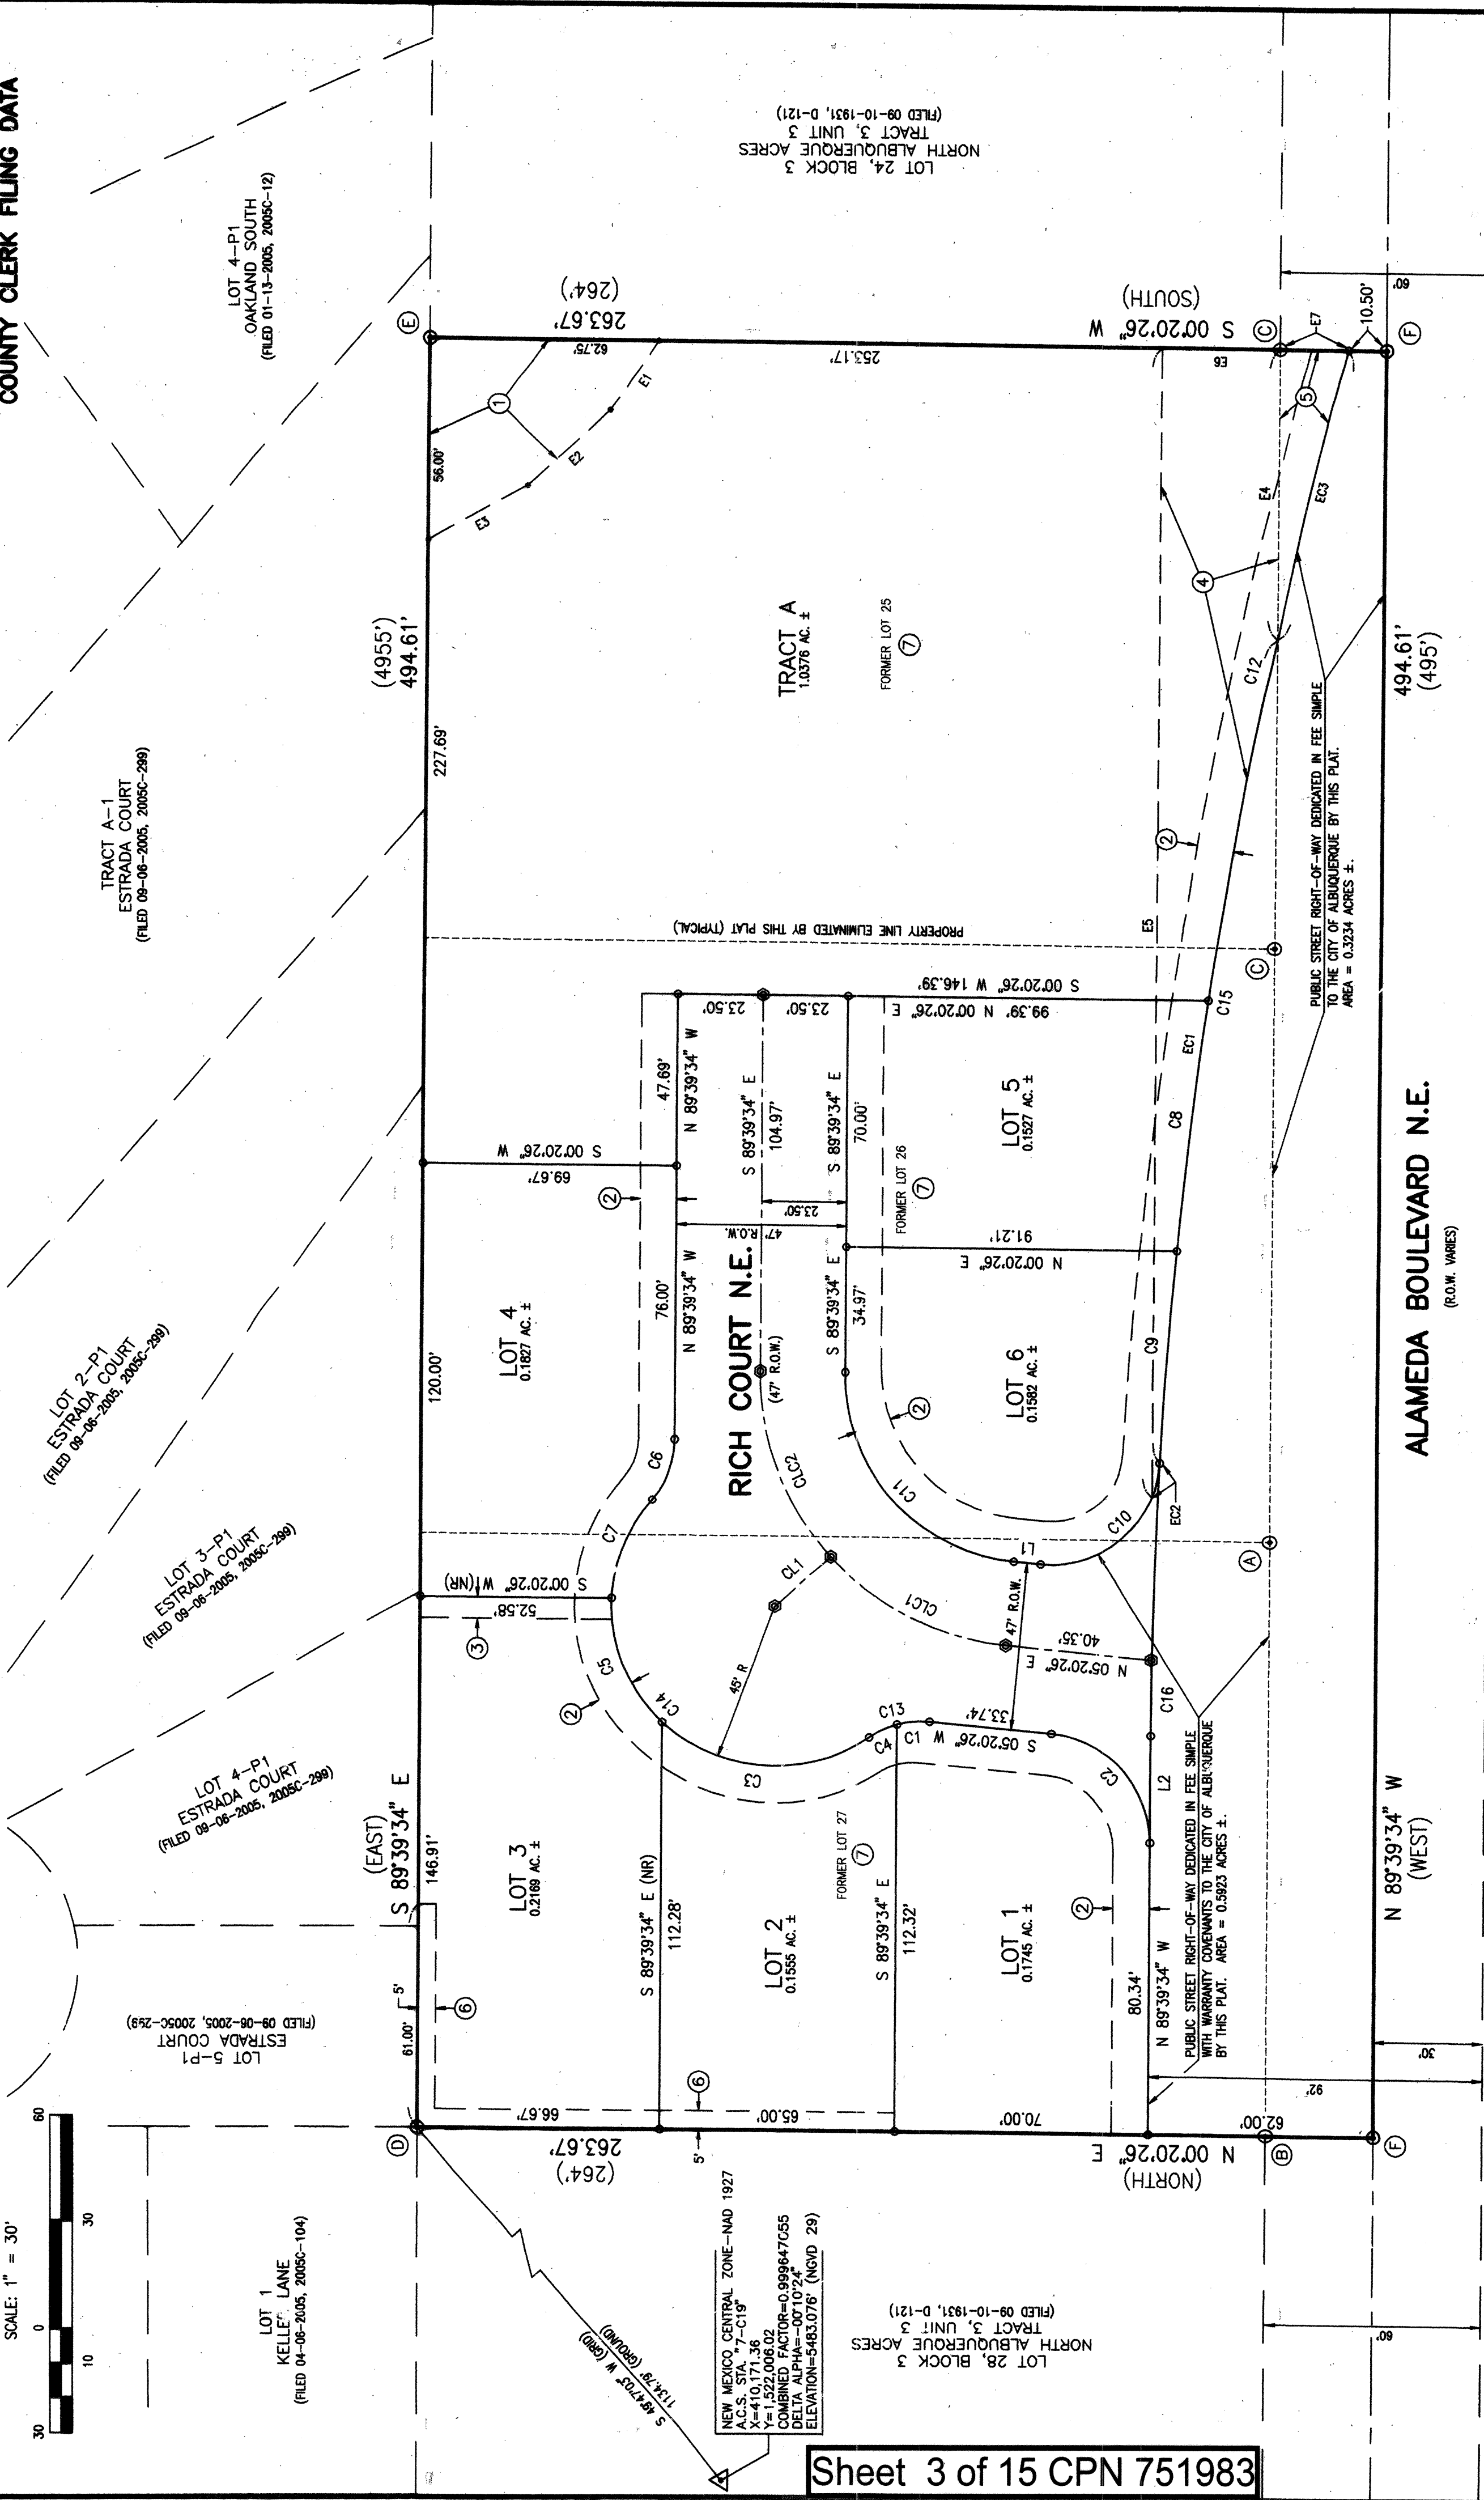

ALAMEDA BOULEVARD N.E.
(R.O.W. VARIES)

N 89°39'34" W
(WEST)

494.61'
(495')

AA

RECORD DRAWING



JEFF MORTENSEN & ASSOCIATES, INC.
1000 ALBUQUERQUE BLVD. N.W.
ALBUQUERQUE, NEW MEXICO 87109
ENGINEERS SURVEYORS (C005) 345-4250
JOB #2005.070.3 FINAL

EXISTING EASEMENT

① TEMPORARY PUBLIC DRAINAGE EASEMENT GRANTED BY DOCUMENT FILED
04-19-2005, BOOK A95, PAGE 3821, DOC. #2005053982

NEW EASEMENTS

- ② PUBLIC UTILITY EASEMENT
- ③ 6' PUBLIC DRAINAGE EASEMENT
- ④ PUBLIC ROADWAY EASEMENT (TO BE VACATED AT A LATER DATE
UPON DEDICATED RE-ALIGNMENT OF ALAMEDA BOULEVARD N.E.)
- ⑥ PRIVATE DRAINAGE EASEMENT

VACATED RIGHT-OF-WAY

- ⑤ FORMER ALAMEDA BOULEVARD N.E. STREET RIGHT-OF-WAY,
PUBLIC ROADWAY EASEMENT (TO BE VACATED AT A LATER DATE
UPON DEDICATED RE-ALIGNMENT OF ALAMEDA BOULEVARD N.E.)

LOT 3-P1
 BUTARA COUNTY
 LTD. 09-06-2005, 2005C-299

CONCRETE CHANNEL UNDER
CONSTRUCTION BY CPN 75778

LET 2-PI
NOTRADA SUBST
(FILED 08-06-2005 2005C-288)

TRUST A-1
STANDARD TRUST
08-06-2005 2005C-2801

LOT 4-P1
BARLAND SOUTH
(FILED 01-13-2005, 2005C-12)

PROJECT BENCHMARK

AN ACS 1 3/4" ALUMINUM DISK STAMPED "ACS BM, 11-C19"
EPOXIED TO TOP OF A CONCRETE CURB LOCATED AT THE NNW
RETURN OF BARSTOW ST. AND OAKLAND AVENUE N.E.
ELEVATION = 5480.97 FEET (NGVD 1929)

T.B.M.

T.B.M. #1
A SPIKE WITH JMA RED CAP LOCATED APPROXIMATELY 114 FEET
NORTH OF THE NORTH EDGE OF ALAMEDA BLVD. N.E. AND
APPROXIMATELY 80 FEET EAST OF A CMU WALL AS SHOWN HEREON

ELEVATION = 5515.76 FEET

T.B.M. #2
A SPIKE WITH JMA RED CAP LOCATED NORTH OF THE SITE AS
SHOWN HEREON.
ELEVATION = 5522.79 FEET

LEGEND

CMU	CONCRETE MASONRY UNIT
EA	EDGE OF ASPHALT
NG	NATURAL GROUND
OMC(1)	OVERHEAD COMMUNICATION (NO. OF LINES)
OME(2)	OVERHEAD ELECTRIC (NO. OF LINES)
TA	TOP OF ASPHALT
TR	TELEPHONE RISER
TW	TOP OF WALL
WPP	WOOD POWER POLE
+ 19.6	EXISTING SPOT ELEVATION
	EXISTING CONTOUR
	EXISTING CONIFEROUS TREE

	PROPOSED ASPHALT PAVEMENT
	PROPOSED CONCRETE
	PROPOSED TEMPORARY PAVEMENT
	PERIMETER WALL
	RIP-RAP (BY CPN 757781)

LOT 24, BLOCK 3
SOUTH ALABAMA TRACT
TRACT 3, UNIT 3
(FILED 09-10-1931, D-121)

THIS IS NOT A BOUNDARY SURVEY. APPARENT PROPERTY CORNERS ARE SHOWN HEREON FOR ORIENTATION PURPOSES ONLY. BOUNDARY AND TOPOGRAPHIC DATA SHOWN HEREON IS FROM A SURVEY DATED 5/09/06 BY THIS OFFICE, NWMP 11184. PROPOSED LOTS AND EASEMENTS ARE FROM THE PRELIMINARY PLAT PREPARED BY THIS OFFICE. NWMP 11184.

RECORD DRAWING



File Path:	E:\DATA\2006\1A\20060724	Plot Date:	07-24-2006
File Name:	50704GR.DWG	Plot Time:	4:29 pm



JEFF HORTENSEN & ASSOCIATES, INC.
☐ 6010-B MIDWAY PARK BLVD. N.E.
☐ ALBUQUERQUE ☐ NEW MEXICO 87109
☐ ENGINEERS ☐ SURVEYORS (505) 345-4250
☐ FAX: 505 345-4254 ☐ ESTABLISHED 1977

APPROVED FOR ROUGH GRADING

CITY HYDROLOGY _____ DATE _____

GRADING PLAN

RICH COURT

DESIGNED BY J.D.S./G.M.
DRAWN BY S.G.H.
APPROVED BY G.M.

REVISIONS			SHEET NO.
NO.	DATE	BY	2005.070.4
1	2.09.97	G.M.	
2	12.10.97	G.M.	DATE
			07-2006
			SHEET
			4 OF 11

JOB NO. 2005.070.4



DATE 07-2006

SHEET 4 OF 11

- RECORD DRAWING LEGEND
- | | |
|-------------|--|
| CONSTRUCT | RECORD INFORMATION (VERIFIED BY ENGINEER) |
| ✓ | AS-CONSTRUCTED = AS-DESIGNED (VERIFIED BY ENGINEER) |
| 28" (7.9') | RECORD INFORMATION (VERIFIED BY ENGINEER) |
| 31.23' (22) | RECORD INFORMATION (VERIFIED BY ENGINEER) |
| ✓ | AS-CONSTRUCTED = AS-DESIGNED (VERIFIED BY AS-BUILT SURVEY) |
| 28' 31.8" | RECORD INFORMATION FROM AS-BUILT SURVEY |
- KEYED NOTES
- EXISTING EASEMENT
- ① TEMPORARY PUBLIC DRAINAGE EASEMENT GRANTED BY DOCUMENT FILED 04-19-2005, BOOK A95, PAGE 3821, DOC. #2005053982
- NEW EASEMENTS
- ② PUBLIC UTILITY EASEMENT
- ③ 6" PUBLIC DRAINAGE EASEMENT
- ④ PUBLIC ROADWAY EASEMENT (TO BE VACATED AT A LATER DATE UPON DEDICATED RE-ALIGNMENT OF ALAMEDA BOULEVARD N.E.)
- ⑥ PRIVATE DRAINAGE EASEMENT
- VACATED RIGHT-OF-WAY
- ⑤ FORMER ALAMEDA BOULEVARD N.E. STREET RIGHT-OF-WAY, PUBLIC ROADWAY EASEMENT (TO BE VACATED AT A LATER DATE UPON DEDICATED RE-ALIGNMENT OF ALAMEDA BOULEVARD N.E.)

STRIPING AND SIGNAGE NOTES:

1. ALL PAVEMENT MARKINGS SHALL BE REFLECTIVE PLASTIC AND COMPLY WITH COA TRAFFIC OPERATIONS THIRD DRAFT SPECIFICATIONS AND CONTRACT LISTING AND THE M.U.T.C.D. (LATEST EDITION).
2. ALL TRAFFIC SIGNS SHALL COMPLY WITH THE M.U.T.C.D. (LATEST EDITION).
3. CONTRACTOR SHALL OBLITERATE ALL EXISTING PAVEMENT MARKINGS WITHIN PROJECT LIMITS PER SECTION 443 OF THE THIRD DRAFT SPECIFICATIONS AND CONTRACT ITEM LISTING BY COA TRAFFIC ENGINEERING OPERATIONS, JUNE 1994, PRIOR TO INSTALLATION OF NEW MARKINGS.
4. BROKEN LANE STRIPES SHALL BE TEN FEET IN LENGTH WITH 30 FOOT GAPS.
5. DOTTED LINES SHALL BE TWO FEET IN LENGTH WITH FOUR FOOT GAPS.
6. CONTRACTOR SHALL APPLY REFLECTORIZED YELLOW PAINT TO ALL MEDIAN NOSES PRIOR TO FINAL ACCEPTANCE OF PROJECT.
7. ALL PAVEMENT MARKINGS AND SIGNAGE SHALL BE INSTALLED PRIOR TO FINAL ACCEPTANCE OF PROJECT.
8. STATIONING SHOWN HEREON IS BASED UPON STREET CENTERLINE.
9. CONTRACTOR SHALL INVENTORY ALL TRAFFIC CONTROL SIGNS TO BE REMOVED UNDER THIS CONTRACT WITH TRAFFIC OPERATIONS PRIOR TO CONSTRUCTION COMMENCEMENT.
10. CONTRACTOR MUST REVIEW STRIPING AND SIGNAGE LAYOUT WITH CITY OF ALBUQUERQUE TRAFFIC ENGINEERING DIVISION PRIOR TO INSTALLATION.

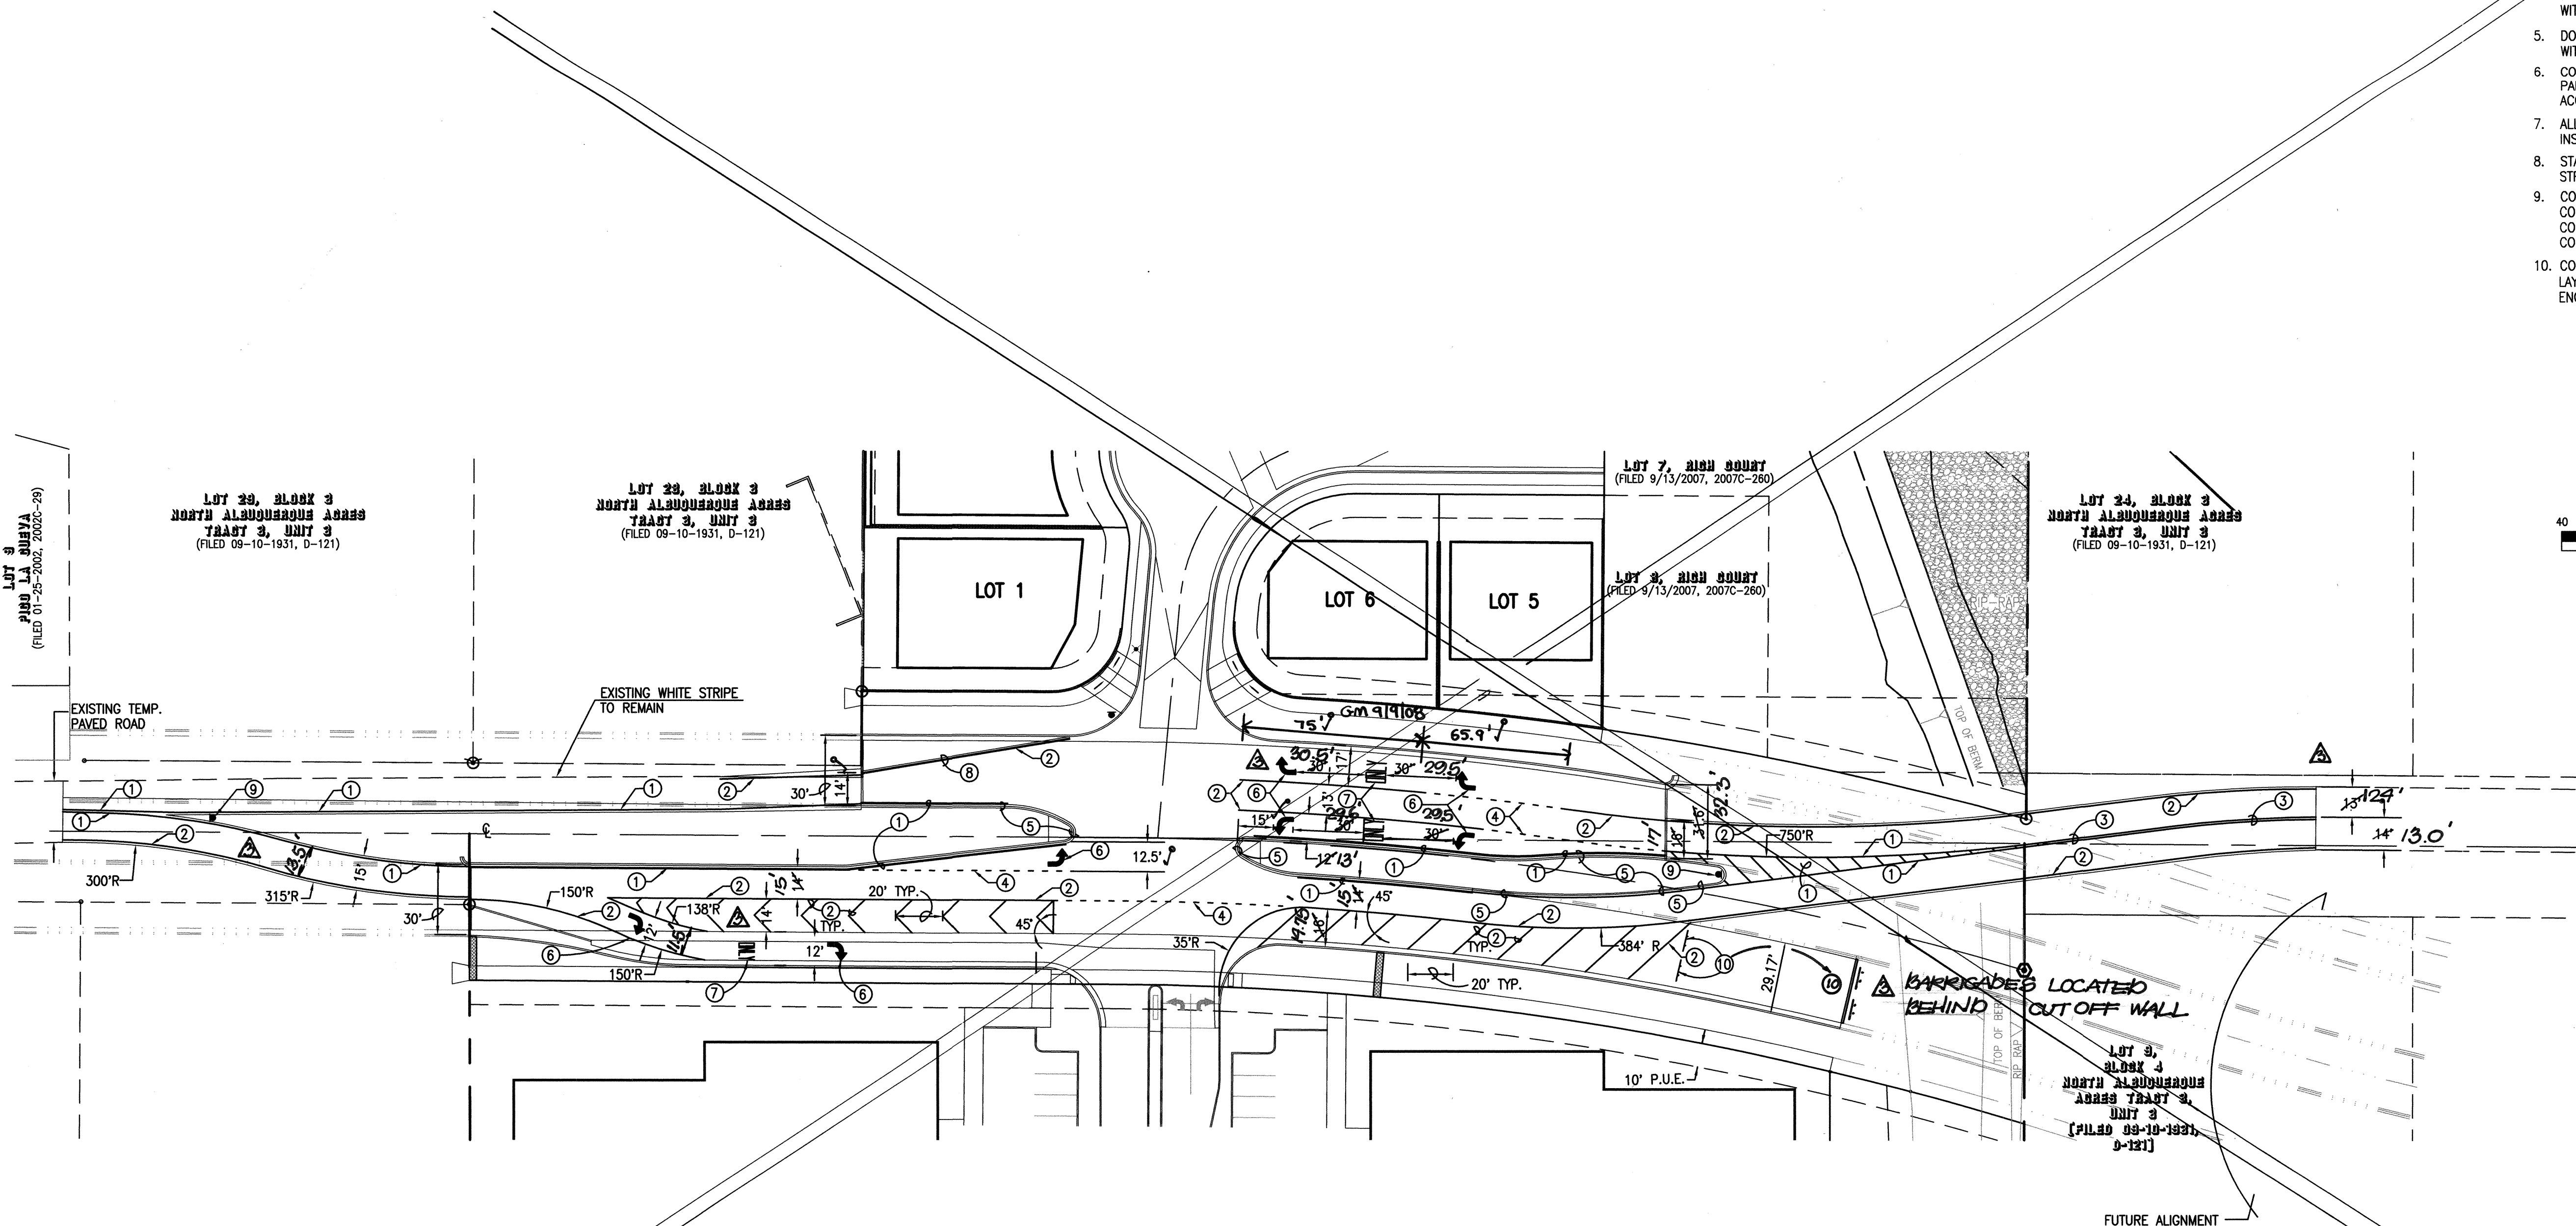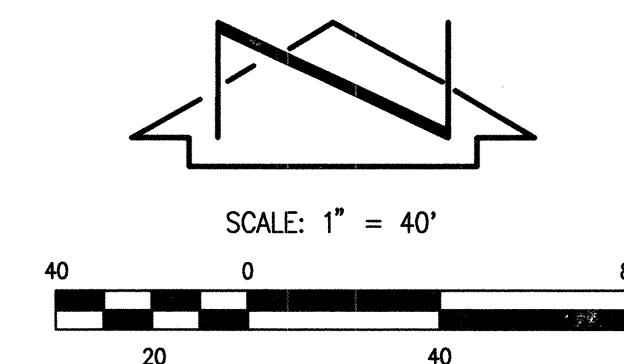


**RECORD DRAWING
FOR CERTIFICATION, SEE SHEET 1**

*ALAMEDA BLVD BY SEPARATE
PROJECT (CPN 745782)*

KEYED STRIPING AND SIGNAGE NOTES:

1. INSTALL 4" YELLOW CONTINUOUS PLASTIC STRIPE
2. INSTALL 4" WHITE CONTINUOUS PLASTIC STRIPE
3. INSTALL 4" YELLOW CONTINUOUS DOUBLE PLASTIC STRIPE
4. INSTALL 4" WHITE DOTTED PLASTIC STRIPE
5. PAINT TEMP CURB AND MEDIAN NOSES YELLOW ✓
6. INSTALL 8" PLASTIC TURN ARROW
7. INSTALL 8" PLASTIC WORD "ONLY"
8. PAINT CURB FACE WITH REFLECTORIZED WHITE PAINT ✓
9. INSTALL "KEEP RIGHT" SIGN (R4-7)
10. INSTALL TWO (2) TYPE III BARRICADES WITH "ROAD CLOSED" (R11-2)

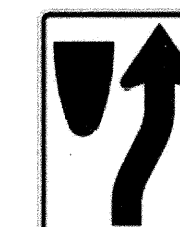

R4-7

CONSTRUCT	RECORD INFORMATION (VERIFIED BY ENGINEER)
✓	AS-CONSTRUCTED = AS-DESIGNED (VERIFIED BY ENGINEER)
8" (7.9")	RECORD INFORMATION (VERIFIED BY ENGINEER)
✓	AS-CONSTRUCTED = AS-DESIGNED (VERIFIED BY AS-BUILT SURVEY)
XX 31.8	RECORD INFORMATION FROM AS-BUILT SURVEY

1. SEE SHEETS 2-3 FOR SUBDIVISION PLAT
2. SEE SHEET 4 FOR GRADING PLAN
3. SEE SHEET 6R FOR SECTIONS AND DETAILS

HIGH MESA Consulting Group
FORMERLY JEFF MORTENSEN AND ASSOCIATES, INC.
6010-B MIDWAY PARK BLVD. NE • ALBUQUERQUE, NEW MEXICO 87109
PHONE: 505.345.4250 • FAX: 505.345.4254 • www.highmesacg.com

2005.070.12 2010.035.1



CITY OF ALBUQUERQUE
PUBLIC WORKS DEPARTMENT
ENGINEERING DEVELOPMENT GROUP

TITLE: **COMPOSITE STRIPING PLAN
RICH COURT \ HOPE PLAZA**

Design Review Committee	City Engineer Approval	Ms./Dm./Tr.	Ms./Dm./Tr.
APPROVED OCT 03 2008 DESIGN REVIEW COMMITTEE	APPROVED OCT 09 2008 CITY ENGINEER		
City Project No. 751983	Zone Map No. C-20	Sheet 5S	Of 15

NOTE
THIS IS NOT A BOUNDARY SURVEY. BOUNDARY AND EASEMENT DATA FROM PLATS PREPARED BY THIS OFFICE, NMPS NO. 11184, FOR RICH COURT AND HOPE PLAZA RECORDED 05/07/07 AND 01/09/08, RESPECTIVELY. TOPOGRAPHIC INFORMATION (FOR ALAMEDA AND RICH COURT) IS BASED UPON THE TOPOGRAPHIC SURVEY BY THIS FIRM, NMPS NO. 11184, DATED 08/16/06 AND UPDATED IN SEPTEMBER, 2007. TOPOGRAPHIC INFORMATION FOR THE SOUTH SIDE OF ALAMEDA IS BASED UPON A TOPOGRAPHIC SURVEY PREPARED BY HIGH MESA CONSULTING GROUP (FORMERLY JEFF MORTENSEN & ASSOCIATES, INC.), NMPS NO. 11184, DATED 05-09-2006.

SCANNED BY
PLANNING

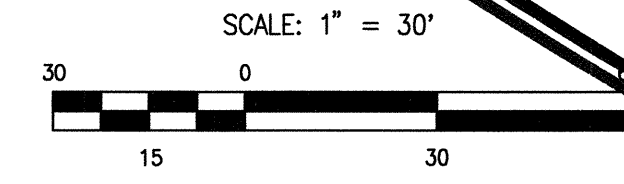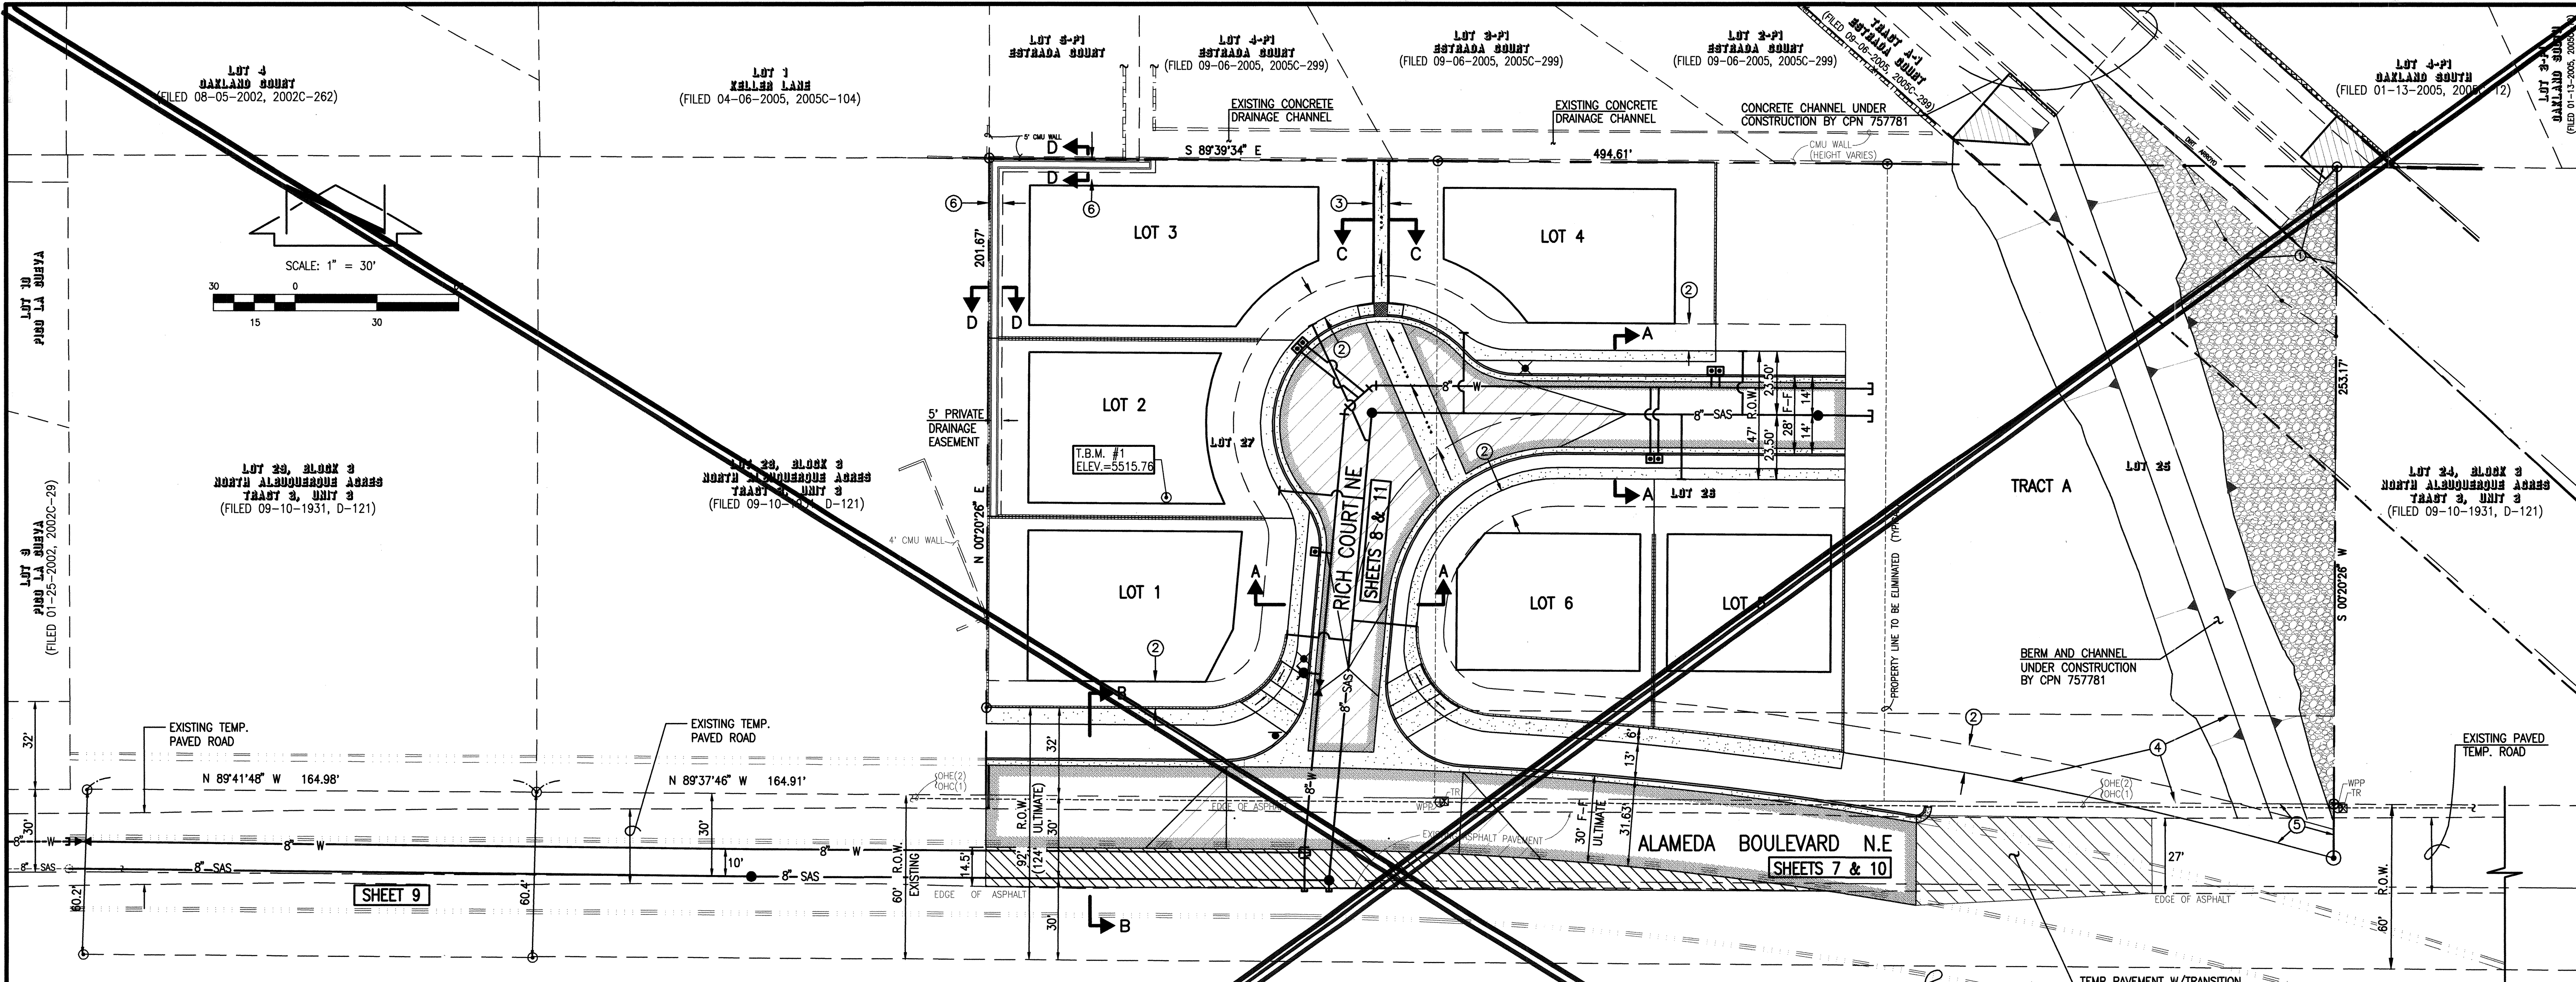


LOT 29, BLOCK 3
NORTH ALBUQUERQUE ADRES
TRACT 3, UNIT 3
(FILED 09-10-1931, D-121)

LOT 29, BLOCK 3
NORTH ALBUQUERQUE ADRES
TRACT 3, UNIT 3
(FILED 09-10-1931, D-121)

LOT 24, BLOCK 3
NORTH ALBUQUERQUE ADRES
TRACT 3, UNIT 3
(FILED 09-10-1931, D-121)

SHEET 9

ALAMEDA BOULEVARD N.E.
SHEETS 7 & 10

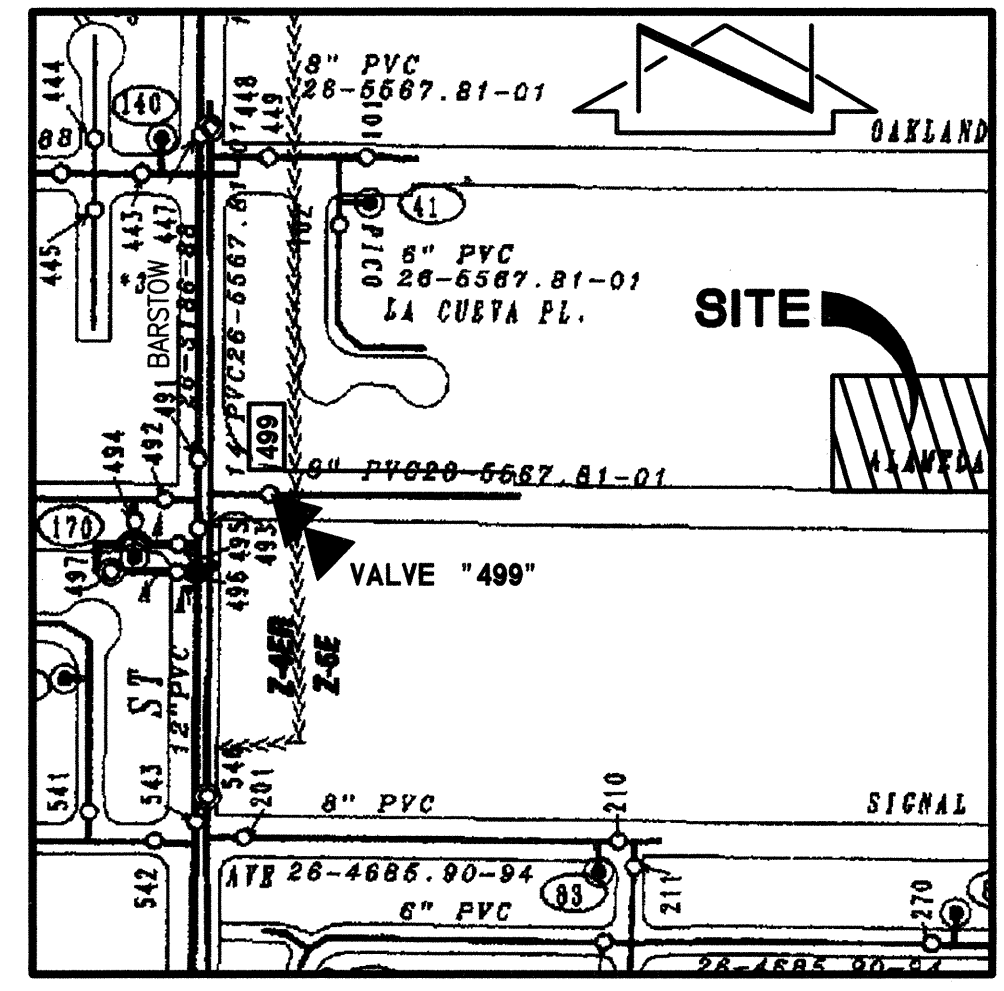

WATER VALVE SHUTOFF PLAN
SCALE: 1" = 300'±
C-20

WATER VALVE SHUTOFF PLAN NOTES

1. THE FOLLOWING VALVE MAY NEED TO BE CLOSED TO FACILITATE THE PROPOSED PRESSURE CONNECTION: 499
2. WATER SYSTEMS PERSONNEL SHALL PERFORM ALL SHUTOFFS. THE CONTRACTOR SHALL NOT OPERATE ANY VALVES THAT MAY AFFECT SYSTEM OPERATIONS.
3. THE CONTRACTOR SHALL REQUEST A WATER SHUTOFF IN WRITING, A MINIMUM OF SEVEN (7) DAYS IN ADVANCE PER STANDARD CITY OF ALBUQUERQUE PROCEDURES.
4. WITHIN FIVE (5) DAYS AFTER RECEIPT OF CONTRACTOR'S SHUTOFF REQUEST, TRIAL SHUTOFFS WILL BE CONDUCTED. CITY TO FURNISH LABOR AND APPURTENANCES NECESSARY TO VERIFY COMPLETENESS OF SHUTOFFS.
5. THE CONTRACTOR SHALL HAVE ALL FITTINGS, MATERIALS AND EQUIPMENT ON SITE PRIOR TO VALVE SHUTOFF. ALL EXCAVATION SHALL BE COMPLETE EXCEPT AS NECESSARY TO MAINTAIN SAFE SYSTEM OPERATION WHILE UNDER PRESSURE.
6. THE CONTRACTOR SHALL PROVIDE ALL RESTRAINTS AND THRUST BLOCKS NECESSARY TO EFFECT ALL NECESSARY SHUTOFFS AND CONNECTIONS.
7. EXISTING WATER VALVE AND WATER LINE INFORMATION OBTAINED FROM CITY OF ALBUQUERQUE AUTOMATED WATER DISTRIBUTION SYSTEM SECTIONAL MAP, MAP GRID C-20.
8. AT THE TIME OF WATER SHUTOFF APPLICATION, THE CONTRACTOR SHALL REQUEST THAT WATER SYSTEMS DIVISION NOTIFY ALL AFFECTED PROPERTY OWNERS AT LEAST TWENTY-FOUR (24) HOURS IN ADVANCE OF THE RESPECTIVE SHUTOFFS.
9. CONTRACTOR SHALL COORDINATE WITH THE WATER SYSTEM DIVISION FOR THE EXECUTION OF THE VALVE SHUTOFF PLAN, NOT LESS THAN SEVEN (7) WORKING DAYS IN ADVANCE OF ANY WORK THAT MAY AFFECT THE EXISTING PUBLIC WATER UTILITIES. ONLY WATER SYSTEM DIVISION PERSONNEL SHALL OPERATE EXISTING VALVES. REFER TO SECTION 18 OF THE SPECIFICATIONS. THE WATER SYSTEM DIVISION PHONE NUMBER IS 857-8200.


KEYED NOTES

- EXISTING EASEMENT
- ① TEMPORARY PUBLIC DRAINAGE EASEMENT GRANTED BY DOCUMENT FILED 04-19-2005, BOOK A95, PAGE 3821, DOC. #2005053982
- NEW EASEMENTS
- ② PUBLIC UTILITY EASEMENT
 - ③ 6' PUBLIC DRAINAGE EASEMENT
 - ④ PUBLIC ROADWAY EASEMENT (TO BE VACATED AT A LATER DATE UPON DEDICATED RE-ALIGNMENT OF ALAMEDA BOULEVARD N.E.)
 - ⑥ PRIVATE DRAINAGE EASEMENT
- VACATED RIGHT-OF-WAY
- ⑤ FORMER ALAMEDA BOULEVARD N.E. STREET RIGHT-OF-WAY, PUBLIC ROADWAY EASEMENT (TO BE VACATED AT A LATER DATE UPON DEDICATED RE-ALIGNMENT OF ALAMEDA BOULEVARD N.E.)

PAVING LEGEND

- STOP AND STREET NAME SIGN
- PROPOSED PERMANENT ASPHALT PAVEMENT
- PROPOSED CONCRETE
- PROPOSED TEMPORARY PAVEMENT
- CROWN TRANSITION
- CMU WALL (NIC)
- NEW LIGHT POLE INSTALLED BY PNM UNDER CONTRACT WITH OWNER
- PROPOSED FIRE HYDRANT
- PROPOSED GATE VALVE
- PROPOSED SANITARY SEWER MANHOLE

1. SEE SHEETS 2-3 FOR SUBDIVISION PLAT
2. SEE SHEET 4 FOR GRADING PLAN
3. SEE SHEET 6 FOR SECTIONS AND DETAILS

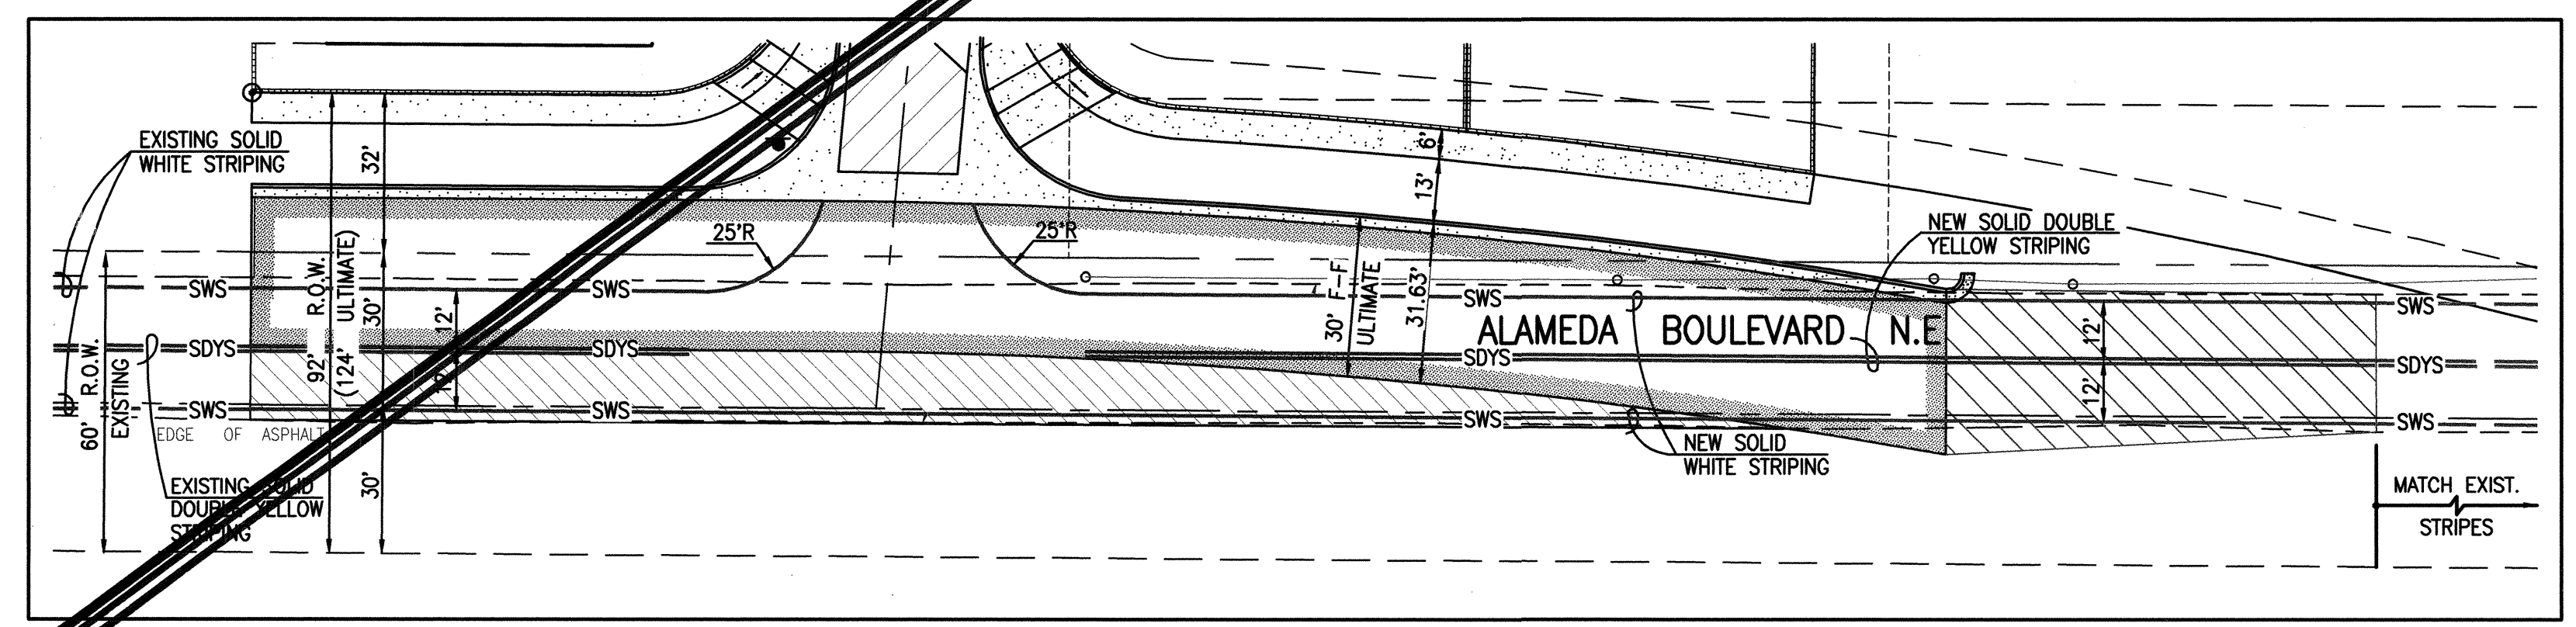

PAVEMENT STRIPING PLAN
SCALE: 1" = 30'

STRIPING LEGEND

SWS	SOLID WHITE STRIPE
SDYS	SOLID DOUBLE YELLOW STRIPE

RECORD DRAWING

△ SHEET REPLACED BY NEW SHEETS 5R AND 5S

AS BUILT INFORMATION		BENCH MARKS		PROJECT BENCHMARK		SURVEY INFORMATION		ENGINEER'S SEAL	
CONTRACTOR	DATE	CONTRACTOR	DATE	AN ACS 1 3/4" ALUMINUM DISK STAMPED "ACS BM 11-C19" EXPOSED TO TOP OF A CONCRETE CURB LOCATED AT THE NW CORNER OF BARSTOW ST. AND OAKLAND AVENUE N.E. ELEVATION = 5480.97 FEET (NGVD 1929)	DATE	NO.	BY	NO.	BY
FILED 01-15-2006, 2006C-12		FILED 01-15-2006, 2006C-12			05/06	50702	JMA, NMPIS 11184		
MICRO-FILM INFORMATION		MICRO-FILM INFORMATION		MICRO-FILM INFORMATION		MICRO-FILM INFORMATION		MICRO-FILM INFORMATION	
RECORDED BY	DATE	RECORDED BY	DATE	RECORDED BY	DATE	RECORDED BY	DATE	RECORDED BY	DATE

ENGINEER'S SEAL

11/21/2006

DESIGNED BY	DATE	DRAWN BY	DATE	CHECKED BY	DATE
GM/JJS	10-2006	RR/V/J.P.	10-2006	GM	11-2006

12/0 RECORD DRAWING

06/08 RECORD DRAWING

2010.035.1

2005.070.32

JEFF MORTENSEN & ASSOCIATES, INC.

1000 900-9 MIDWAY PARK BLVD. N.W.

ALBUQUERQUE, N.M. 87106

PH: 505-263-4500 FAX: 505-263-4504

CITY OF ALBUQUERQUE

PUBLIC WORKS DEPARTMENT

ENGINEERING DEVELOPMENT GROUP

TITLE: COMPOSITE SITE PLAN & STRIPING PLAN

RICH COURT

Design Review Committee

DEC 01 2006

CITY ENGINEER APPROVAL


PROVED

CITY ENGINEER

City Project No. 751983

Zone Map No. C-20


Sheet 5 of 11

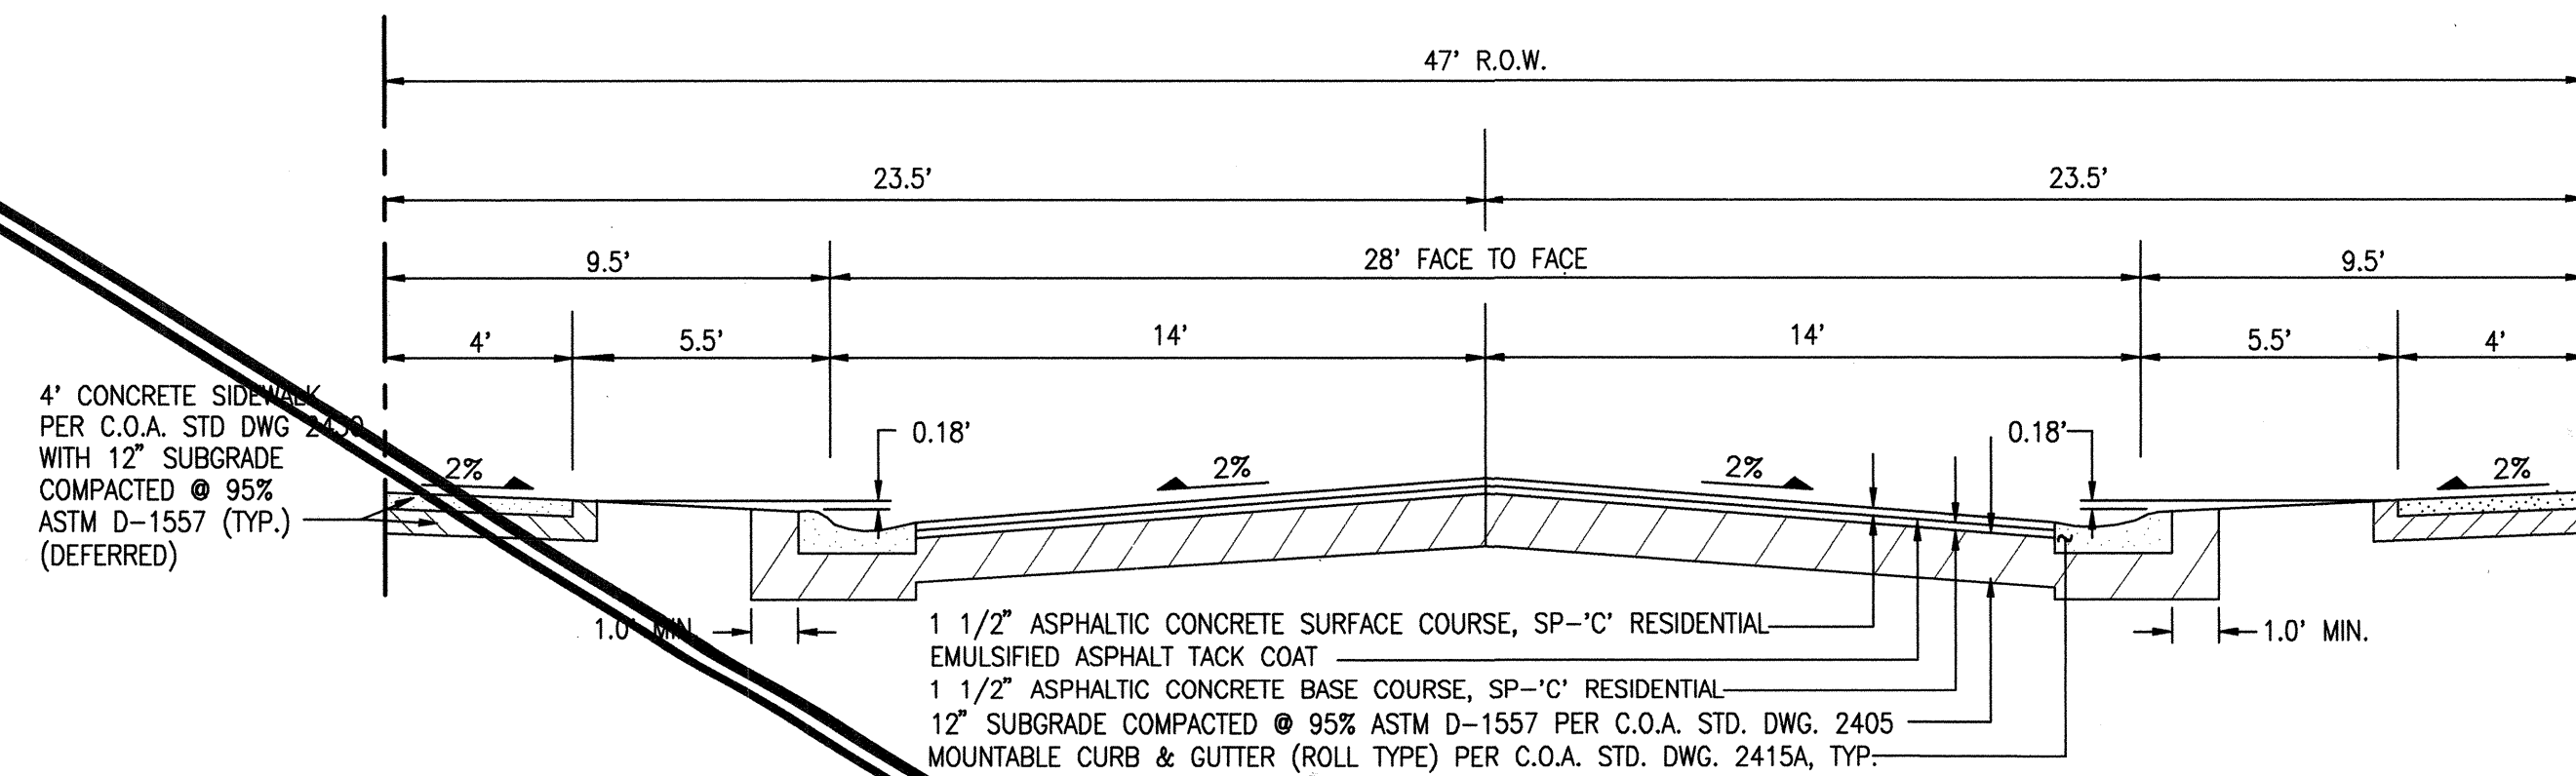

SECTION A-A (RICH COURT)

SCALE: 1" = 4'

NOTE: SUBGRADE MATERIAL NOT HAVING THE MINIMUM R-VALUE OF 50 SHALL BE REMOVED TO A DEPTH OF 2 FT. AND REPLACED WITH SUITABLE MATERIAL.

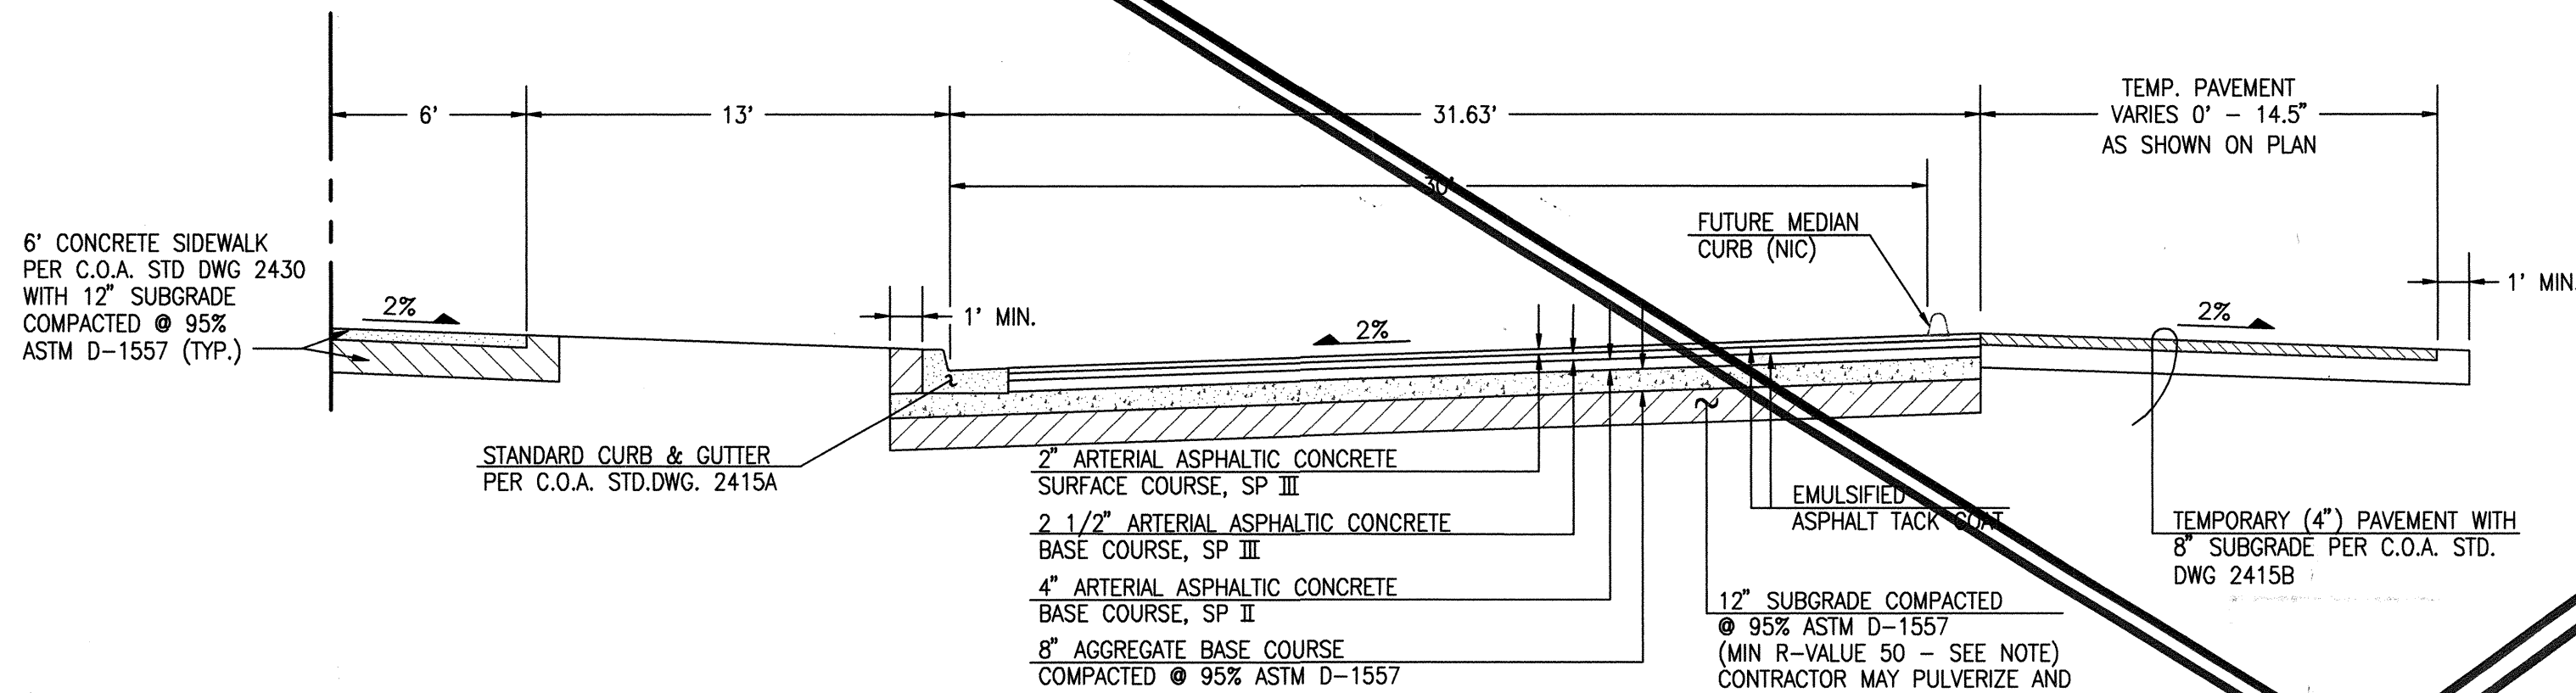

SECTION B-B (ALAMEDA BLVD)


SCALE: 1" = 5'

NOTE: SUBGRADE MATERIAL NOT HAVING THE MINIMUM R-VALUE OF 50 SHALL BE REMOVED TO A DEPTH OF 2 FT. AND REPLACED WITH SUITABLE MATERIAL.

NOTE: PAVEMENT DESIGN FROM CPN 702482


RETAINING WALL NOTES:

1. 8"x8"x16" CMU OF UBC STD. 24-4 OR 24-5.
2. USE KNOCK-OUT BOND BEAM BLOCK AT 4'-0" MAX C.C., VERTICALLY, AND 1 #4 CONTINUOUS.
3. FILL ALL BLOCK VOIDS WITH 3000 PSI CONCRETE.
4. REINFORCING TO BE INTERMEDIATE GRADE STEEL. $f_s=20,000$ psi
5. IN LIEU OF CONTINUOUS KNOCK-OUT BOND BEAMS, CONTRACTOR MAY INSTALL DUR-O-WALL REINFORCING EVERY SECOND COURSE.
6. SPICE SHALL BE 40 BAR DIA. MINIMUM FOR VERTICAL BARS. ALL OTHER SHALL BE 20 BAR DIA. MINIMUM.
7. CONCRETE FILL SHALL BE 21 DAYS OLD OR ACHIEVE 70% OF DESIGN STRENGTH PRIOR TO BACKFILLING.
8. INSTALL MASONRY CONTROL JOINTS PER TYPICAL DETAIL AT UNIFORM SPACINGS OF 20' (MIN.) TO 24' (MAX.).

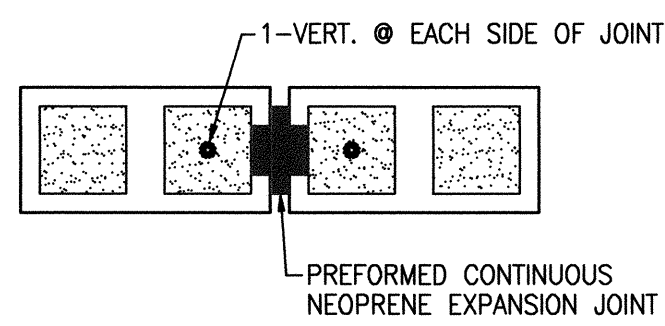

TYPICAL MASONRY CONTROL JOINT DETAIL


SCALE: 1" = 1'-0"

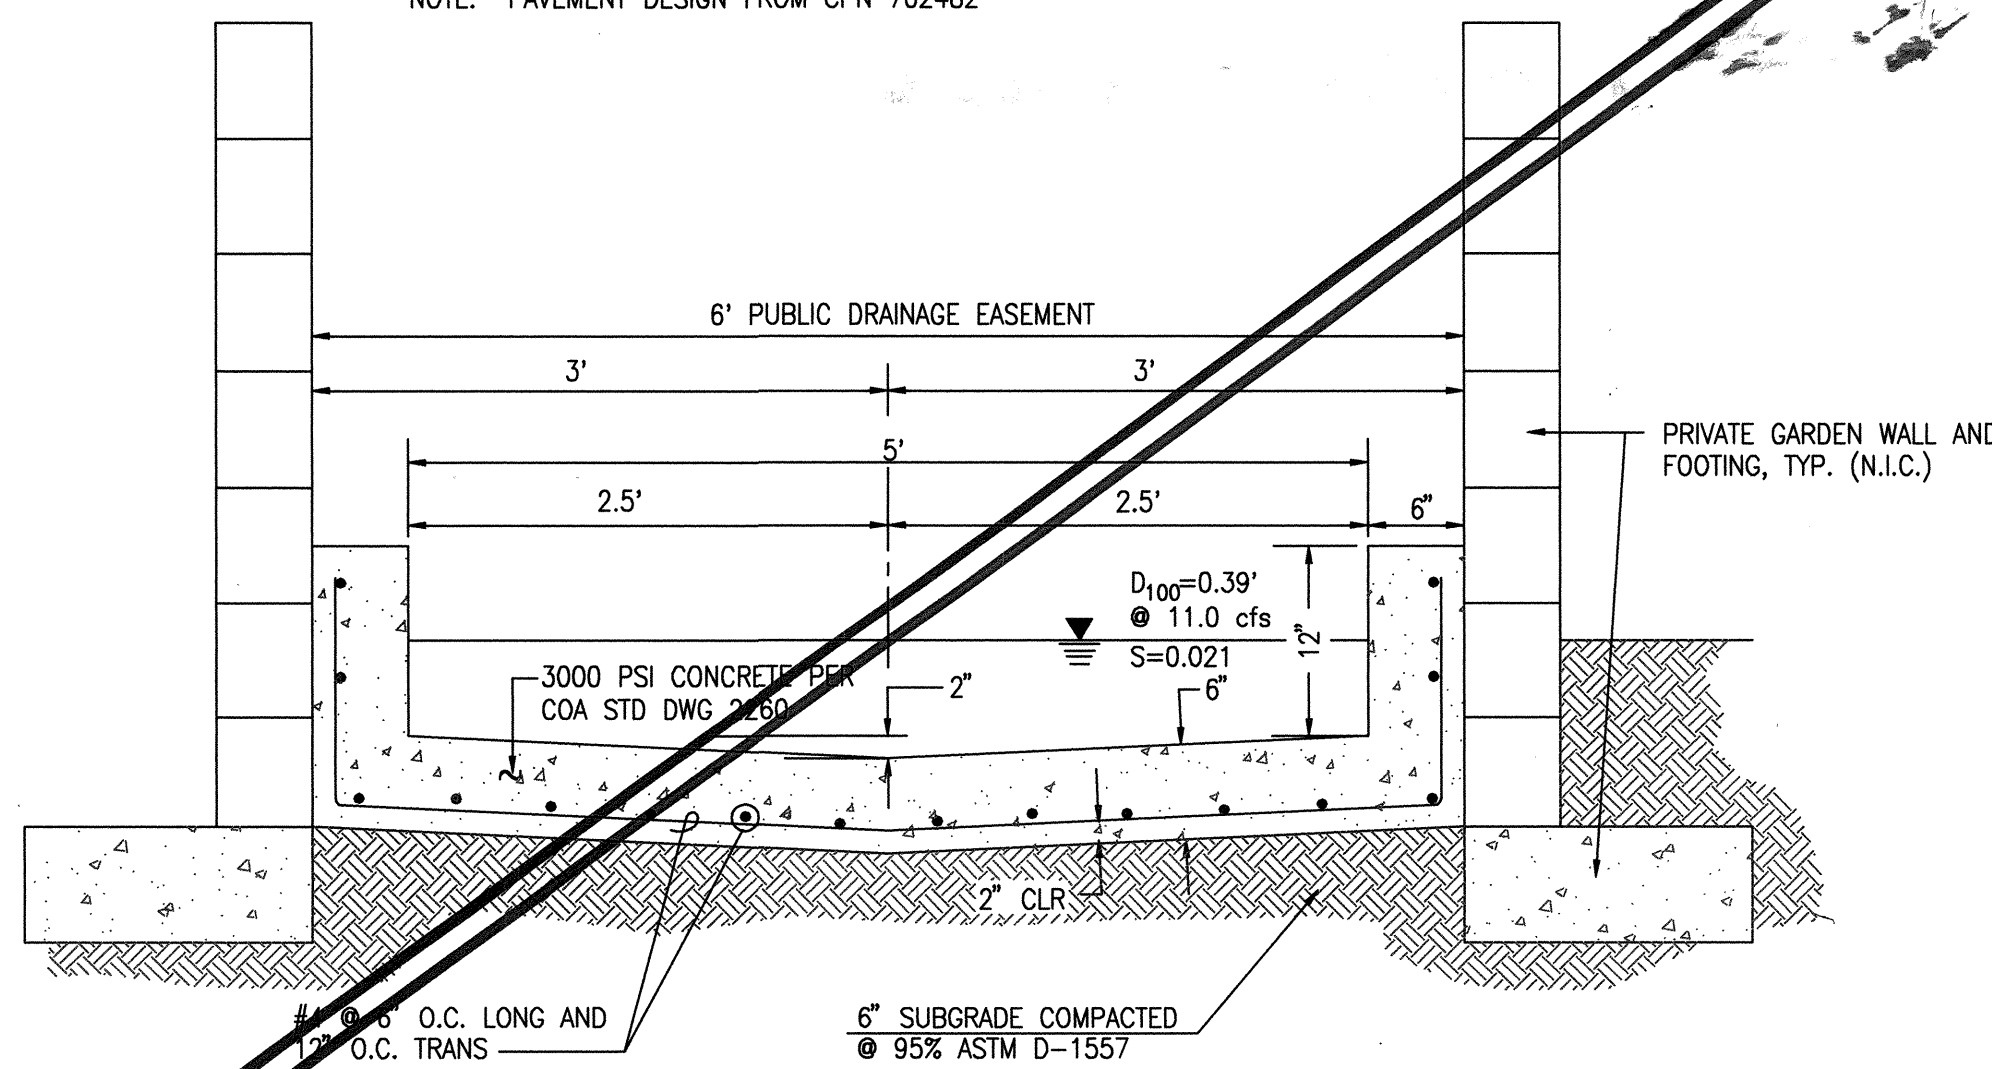

SECTION C-C


SCALE: 1" = 1'-0"

NOTE: REFER TO C.O.A. STD. DWG. 2280 FOR GENERAL NOTES AND CONSTRUCTION NOTES (TYPE "B" LINING)

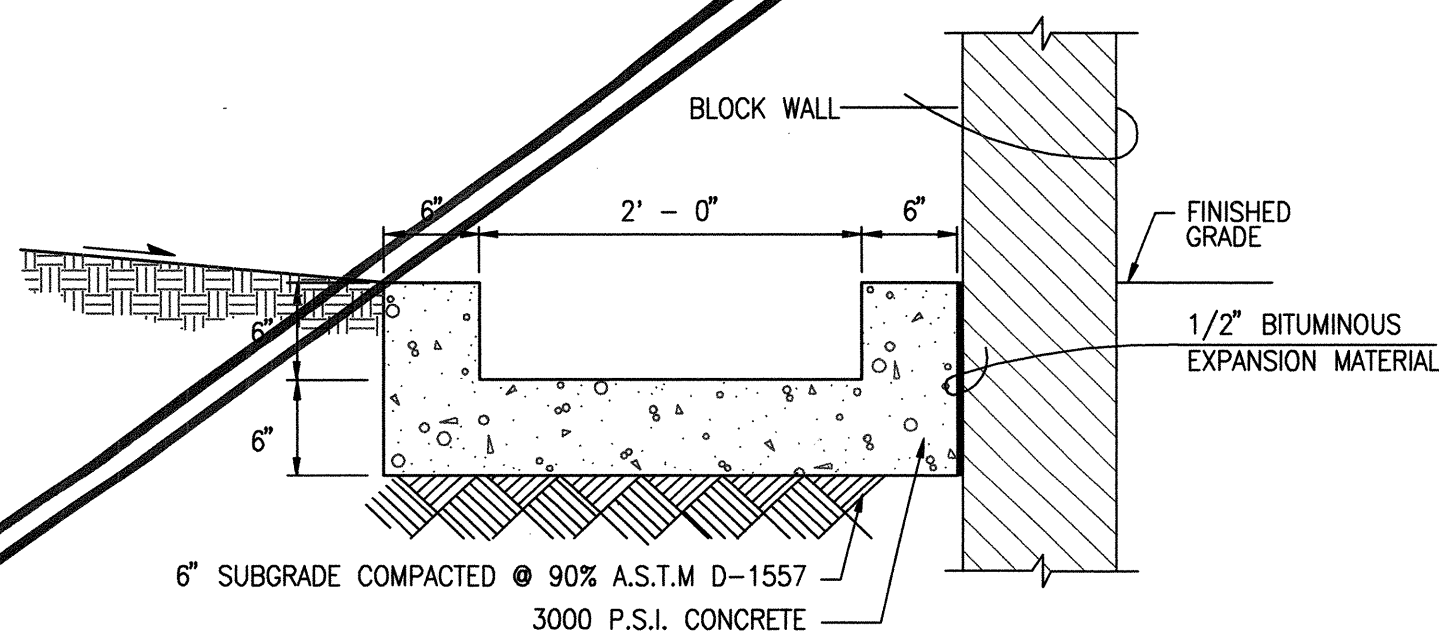


SECTION D-D (NIC)

SCALE: 1" = 1'-0"

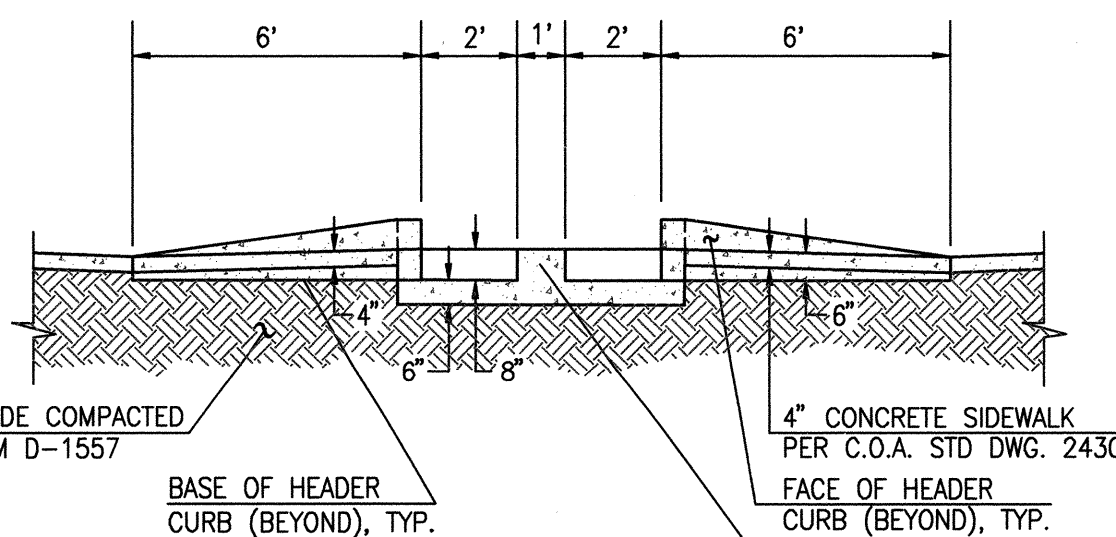


SECTION E-E

SCALE: 1" = 4'

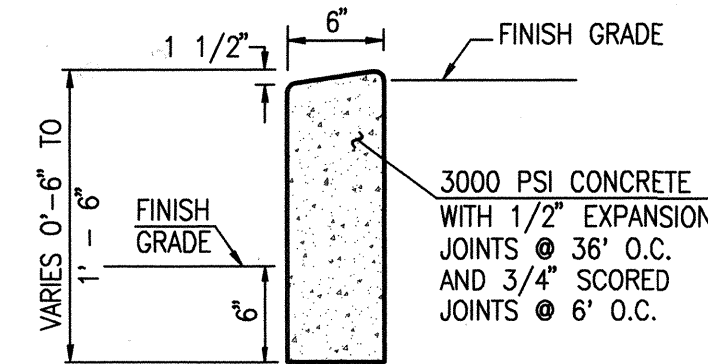


HEADER CURB

SCALE: 1" = 1'-0"

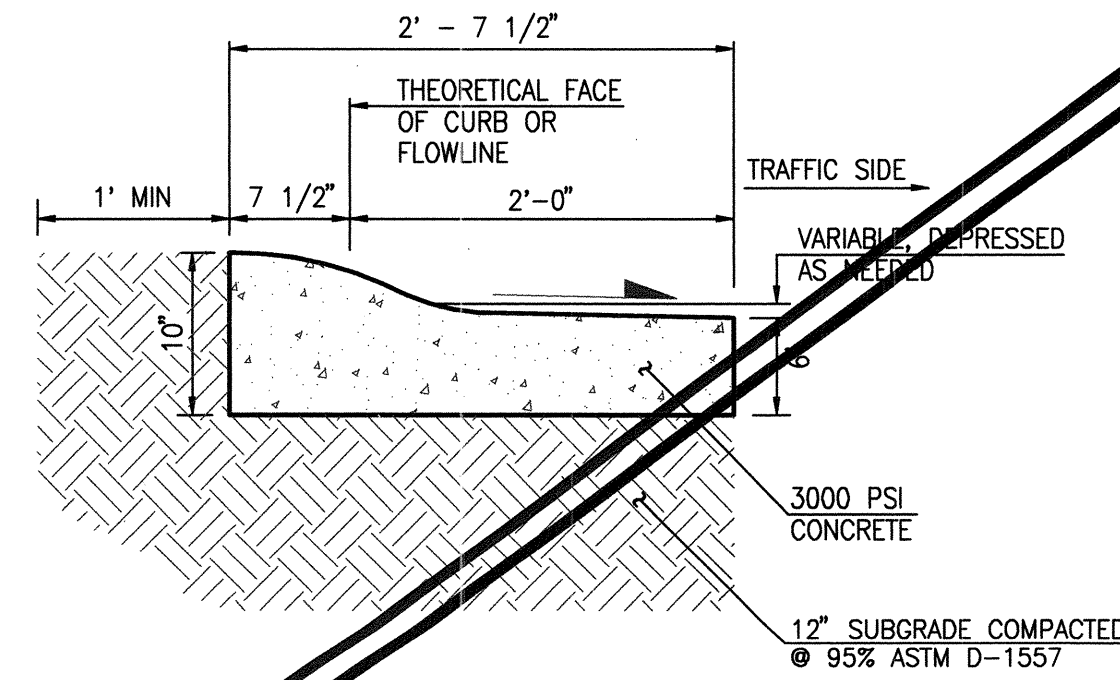

DEPRESSED MOUNTABLE CURB - ROLL TYPE

SCALE: 1" = 1'-0"

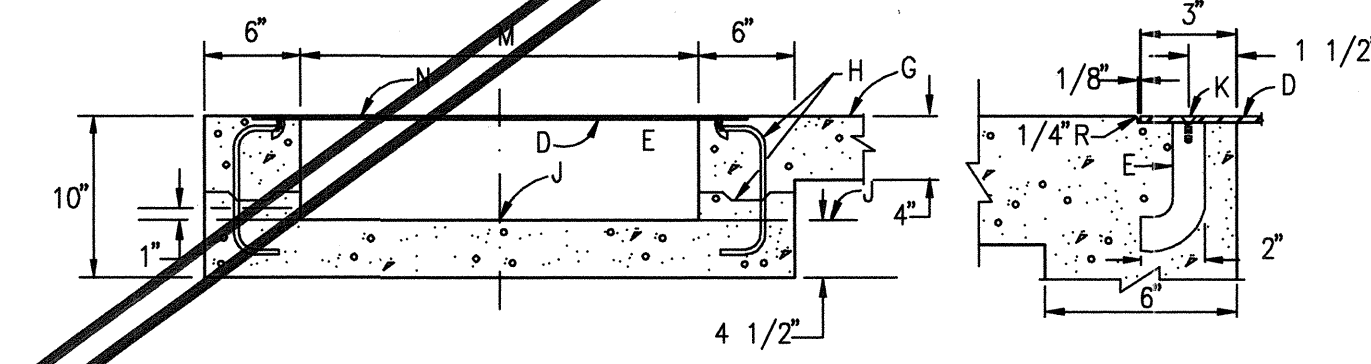


DOWEL DETAIL

CONSTRUCTION NOTES:

- A. 3" RADIUS, (TYPICAL).
- B. 3/8" CHECKERED STEEL PLATE.
- C. ROD ANCHOR 1" x 5"
- D. SIDEWALK GRADE
- E. DOWEL AND JOINT, (OPTIONAL).
- F. GUTTER FLOWLINE ELEV.
- G. 3/8" x 1" F.H. C/SUNK STAINLESS STEEL MACHINE SCREW.
- H. DRAIN WIDTH, 24" MAX. 12" MIN.
- I. AFTER CLEANING SURFACE OF SCALE, RUST, OILS, ETC., PAINT GRATE WITH ONE SHOP COAT RED OXIDE, TWO FINISH COATS OF ALUMINUM PAINT (ASHTO M 69).

TYPICAL SIDEWALK CULVERT DETAILS

NOT TO SCALE

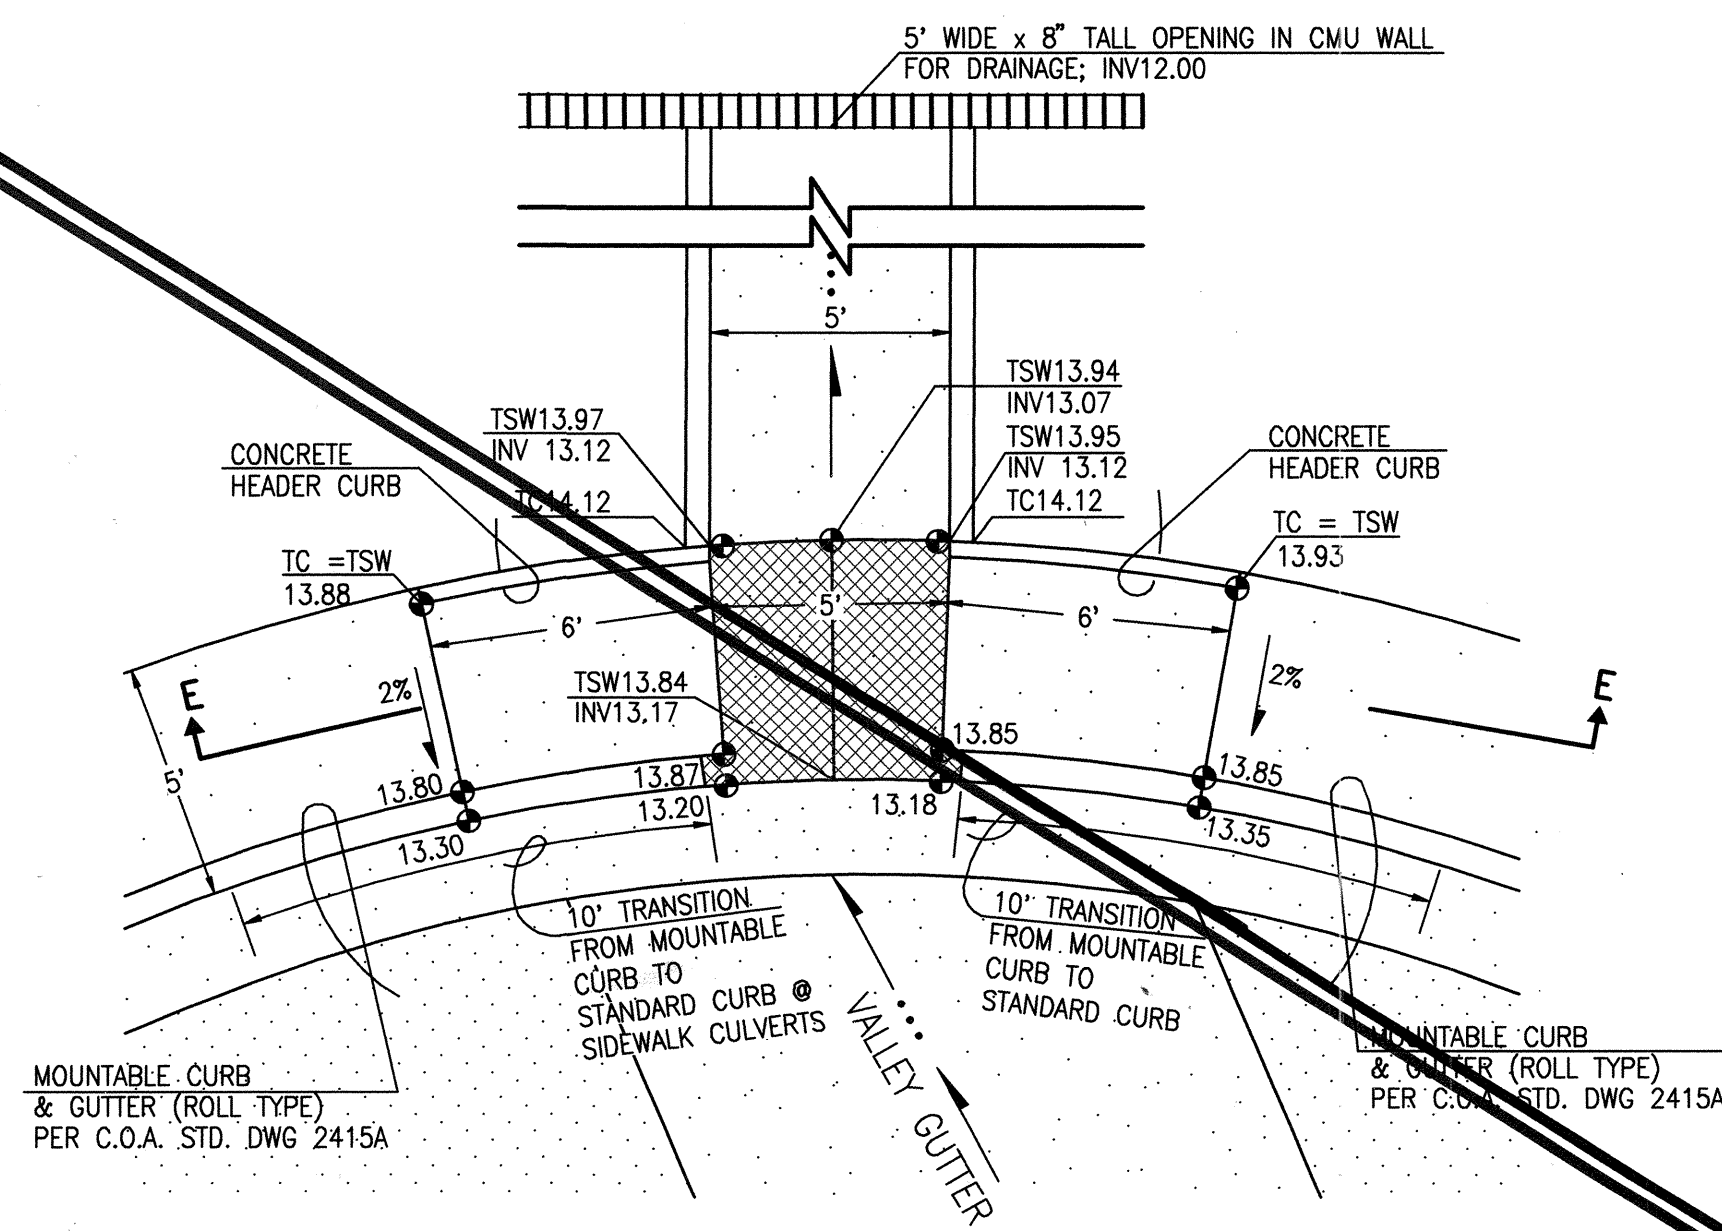

RECORD DRAWING

DETAIL
SCALE: 1" = 4'-0"

SHEET REPLACED BY NEW SHEET 6R

2005.070.59

2010.035.1

CITY OF ALBUQUERQUE
PUBLIC WORKS DEPARTMENT
ENGINEERING DEVELOPMENT GROUP

TITLE: SECTIONS AND DETAILS
RICH COURT

Design/Review Committee
DEC 01 2006
DESIGN REVIEW CO


City Engineer Approval
MAR 14 2006
CITY ENGINEER

City Project No. 751983 Zone Map No. C-20 Sheet 6 Of 11


AS BUILT INFORMATION	
CONTRACTOR	DATE
DESIGNED BY	DATE
CHECKED BY	DATE
INSP. BY	DATE
FIELD BY	DATE
VERIFIED BY	DATE
CORRECTED BY	DATE
RECORDED BY	DATE


PROJECT BENCHMARK	
AN ACS 1 3/4" ALUMINUM DISK STAMPED "ACS BM, 11-C18" EXPOSED TO TOP OF A CONCRETE CURB LOCATED AT THE NW CORNER OF BARSTOW ST. AND OAKLAND AVENUE N.E. ELEVATION = 5480.97 FEET (NGVD 1929)	DATE
DATE	NO.


SURVEY INFORMATION	
NO.	DATE
50702	05/06
JMA, NIPS 11184	DATE
DATE	NO.

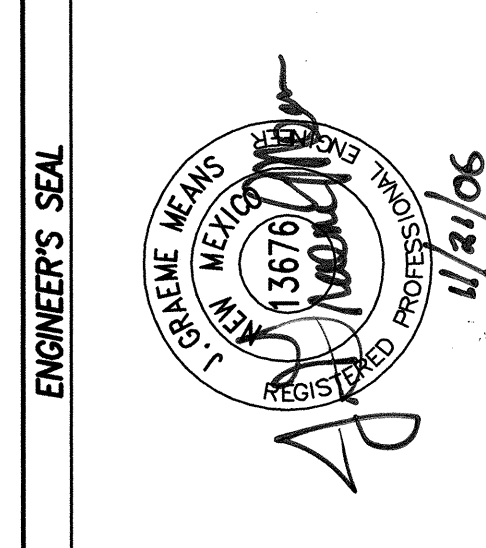

REVISIONS	
NO.	DATE
1	10-2006
2	10-2006
3	11-2006

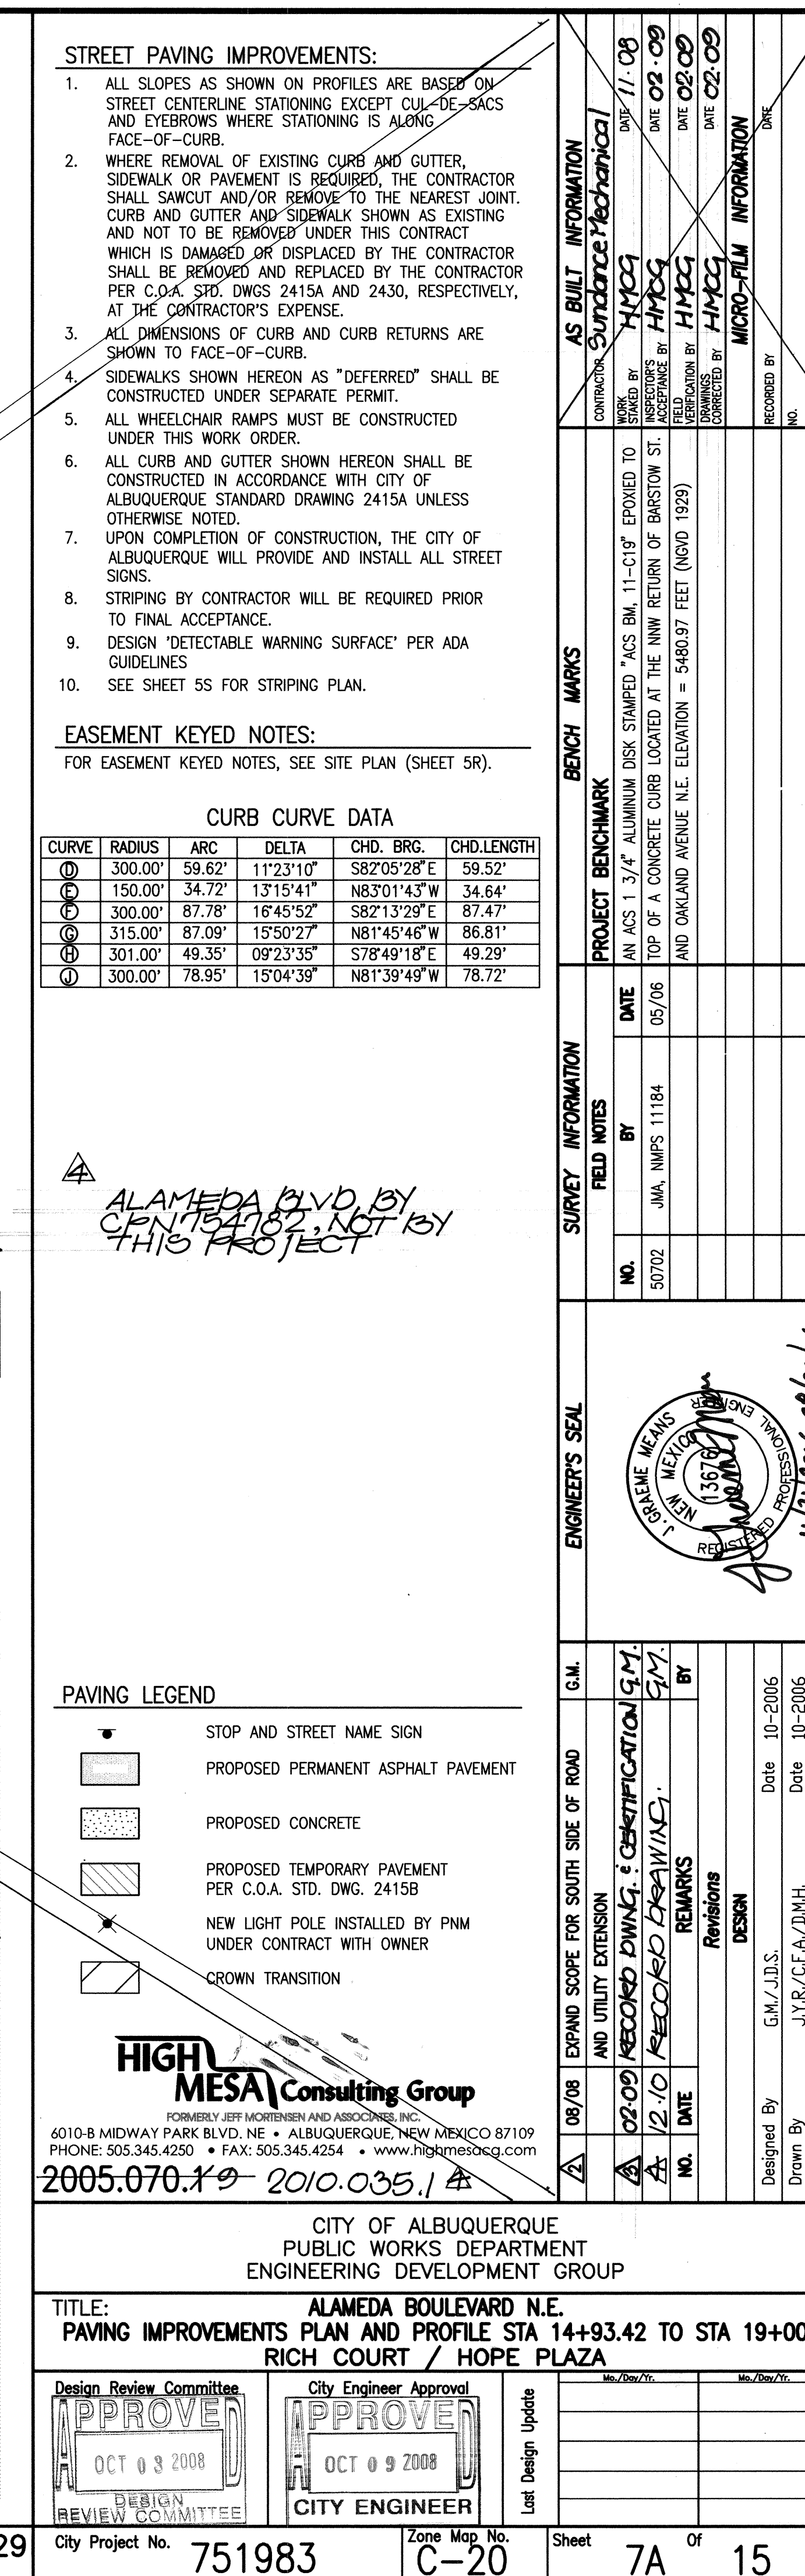

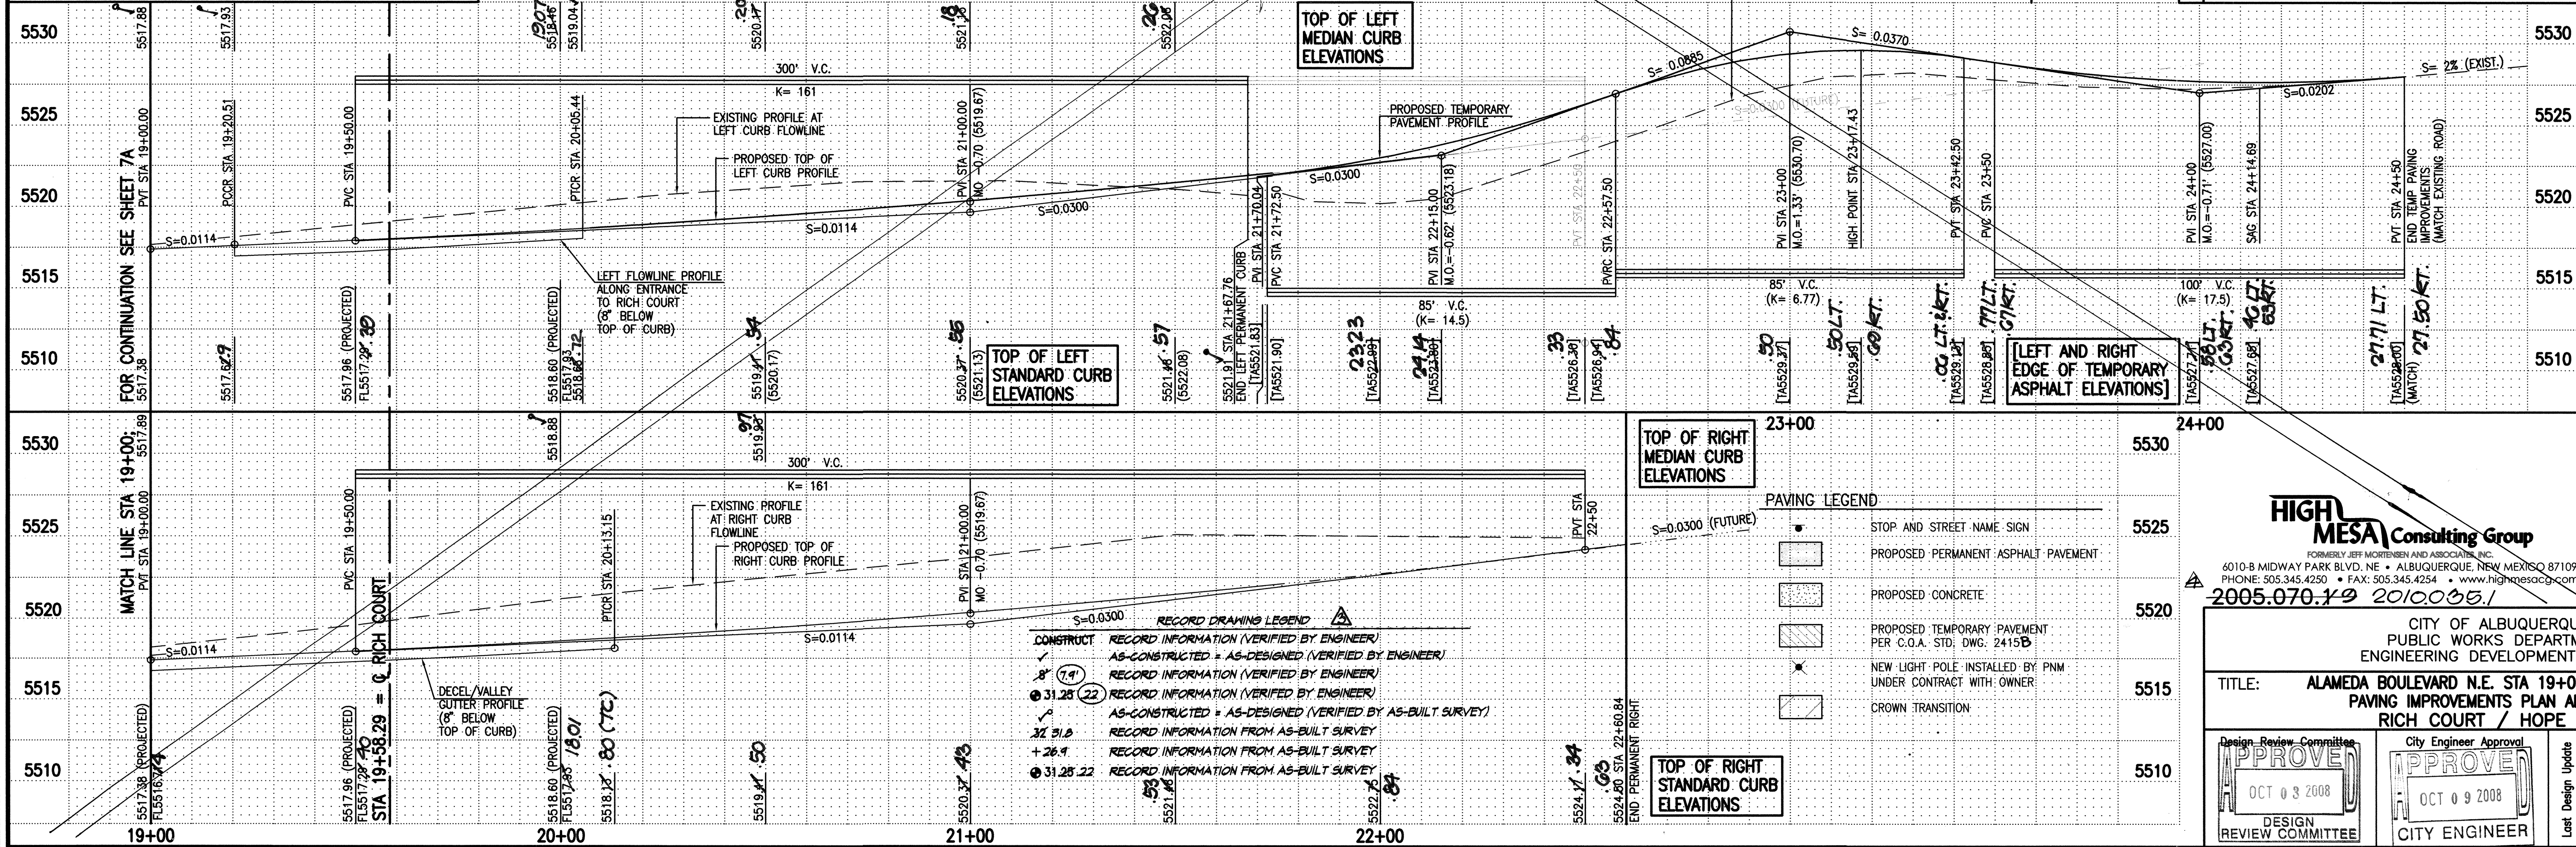[illegible]

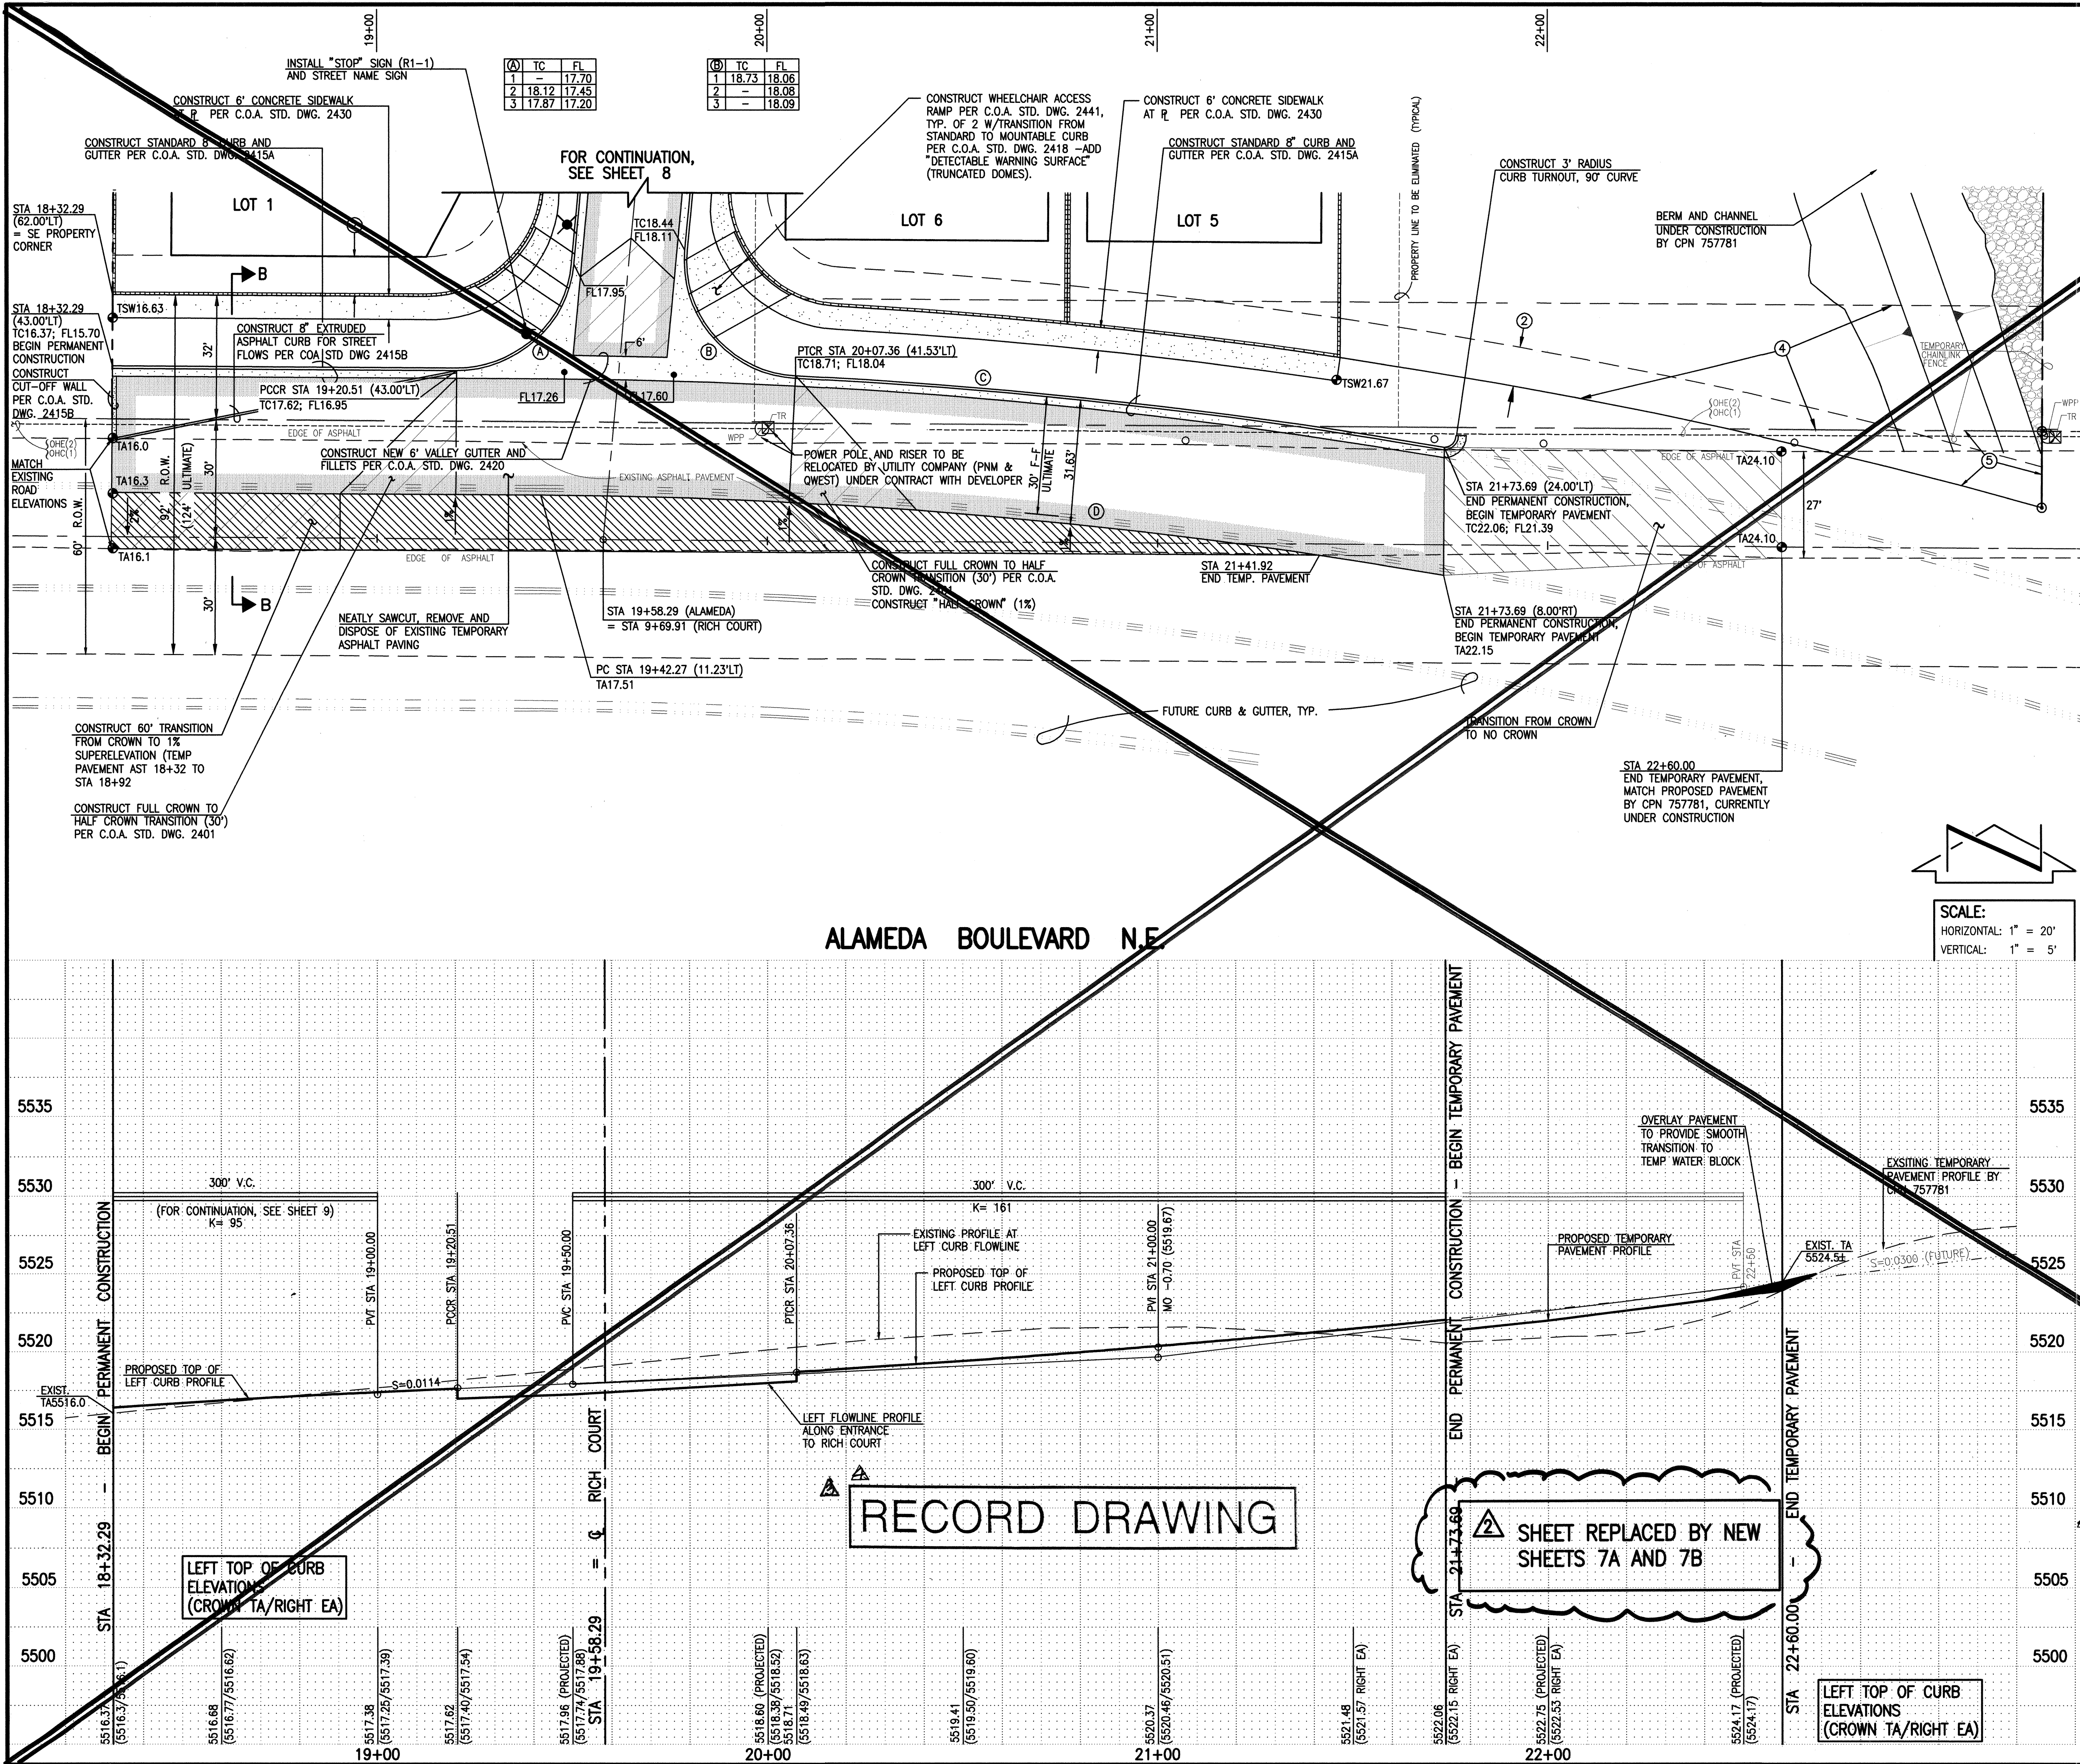

- STREET PAVING IMPROVEMENTS:**
- ALL SLOPES AS SHOWN ON PROFILES ARE BASED ON STREET CENTERLINE STATIONING EXCEPT CURB SACS AND EYEBROWS WHERE STATIONING IS ALONG FACE-OF-CURB.
 - WHERE REMOVAL OF EXISTING CURB AND GUTTER, SIDEWALK OR PAVEMENT IS REQUIRED, THE CONTRACTOR SHALL SAWCUT AND/OR REMOVE TO THE NEAREST JOINT. CURB AND GUTTER AND SIDEWALK SHOWN AS EXISTING AND NOT TO BE REMOVED UNDER THIS CONTRACT WHICH IS DAMAGED OR DISPLACED BY THE CONTRACTOR SHALL BE REMOVED AND REPLACED BY THE CONTRACTOR PER C.O.A. STD. DWGS 2415A AND 2430, RESPECTIVELY, AT THE CONTRACTOR'S EXPENSE.
 - ALL DIMENSIONS OF CURB AND CURB RETURNS ARE SHOWN TO FACE-OF-CURB.
 - SIDEWALKS SHOWN HEREON AS "DEFERRED" SHALL BE CONSTRUCTED UNDER SEPARATE PERMIT.
 - ALL WHEELCHAIR RAMPS MUST BE CONSTRUCTED UNDER THIS WORK ORDER.
 - ALL CURB AND GUTTER SHOWN HEREON SHALL BE CONSTRUCTED IN ACCORDANCE WITH CITY OF ALBUQUERQUE STANDARD DRAWING 2415A UNLESS OTHERWISE NOTED.
 - UPON COMPLETION OF CONSTRUCTION, THE CITY OF ALBUQUERQUE WILL PROVIDE AND INSTALL ALL STREET SIGNS.
 - STRIPING BY CONTRACTOR WILL BE REQUIRED PRIOR TO FINAL ACCEPTANCE.
 - DESIGN "DETECTABLE WARNING SURFACE" PER ADA GUIDELINES
 - SUBMIT "DETECTABLE WARNING SURFACE" SPECS TO CITY CONSTRUCTION ENGINEER PRIOR TO CONSTRUCTION FOR EVALUATION

ALAMEDA BLVD. BY
CPN 754782, NOT BY
THIS PROJECT

SCALE:
HORIZONTAL: 1" = 20'
VERTICAL: 1" = 5'

CURB CURVE DATA

CURVE	RADIUS	ARC	DELTA	CHD. BRG.	CHD. LENGTH
(A)	30.00	44.51	85°00'00"	N47°50'26"E	40.54
(B)	30.00	48.39	92°24'53"	N40°52'01"W	43.31
(C)	1443.00	232.42	09°13'42"	S85°02'43"E	232.17
(D)	1411.33	168.78	06°51'08"	S83°38'53"E	168.68

- PAVING LEGEND**
- STOP AND STREET NAME SIGN
 - PROPOSED PERMANENT ASPHALT PAVEMENT
 - PROPOSED CONCRETE
 - PROPOSED TEMPORARY PAVEMENT PER C.O.A. STD. DWG. 2415
 - NEW LIGHT POLE INSTALLED BY PNM UNDER CONTRACT WITH OWNER
 - CROWN TRANSITION

JMA
JEFF MORTENSEN & ASSOCIATES, INC.
6010-B MIDWAY PARK N.E.
ALBUQUERQUE, NM 87109
ENGINEERS & SURVEYORS REG. NO. 345-4250
FAX: 505 345-4254 □ ESTABLISHED 1977

2005-070-51 2010.0351


CITY OF ALBUQUERQUE
PUBLIC WORKS DEPARTMENT
ENGINEERING DEVELOPMENT GROUP

TITLE: **ALAMEDA BOULEVARD N.E.
PAVING IMPROVEMENTS PLAN AND PROFILE
RICH COURT**

Design Review Committee APPROVED DEC 01 2006 DESIGN REVIEW COMMITTEE	City Engineer Approval APPROVED CITY ENGINEER
---	---

City Project No. 751983
Zone Map No. C-20


AS BUILT INFORMATION		BENCH MARKS		SURVEY INFORMATION		ENGINEER'S SEAL	
CONTRACTOR	DATE	PROJECT BENCHMARK	DATE	FIELD NOTES	NO.	ENGINEER'S SEAL	REMARKS
INSPECTOR	DATE	AN ACS 1 3/4" ALUMINUM DISK STAMPED "ACS BM, 11-C18" EXPOSED TO TOP OF A CONCRETE CURB LOCATED AT THE N.W. CORNER OF BARSTOW ST. AND OAKLAND AVENUE N.E. ELEVATION = 5480.97 FEET (NGVD 1929)	05/06	BY JMA; NIP'S 11184	50702		DESIGN
REPERFOR	DATE	REVISIONS	NO.	DATE	DATE		DESIGNED BY
REPERFOR	DATE	REVISIONS	NO.	DATE	DATE		DRAWN BY
REPERFOR	DATE	REVISIONS	NO.	DATE	DATE		CHECKED BY

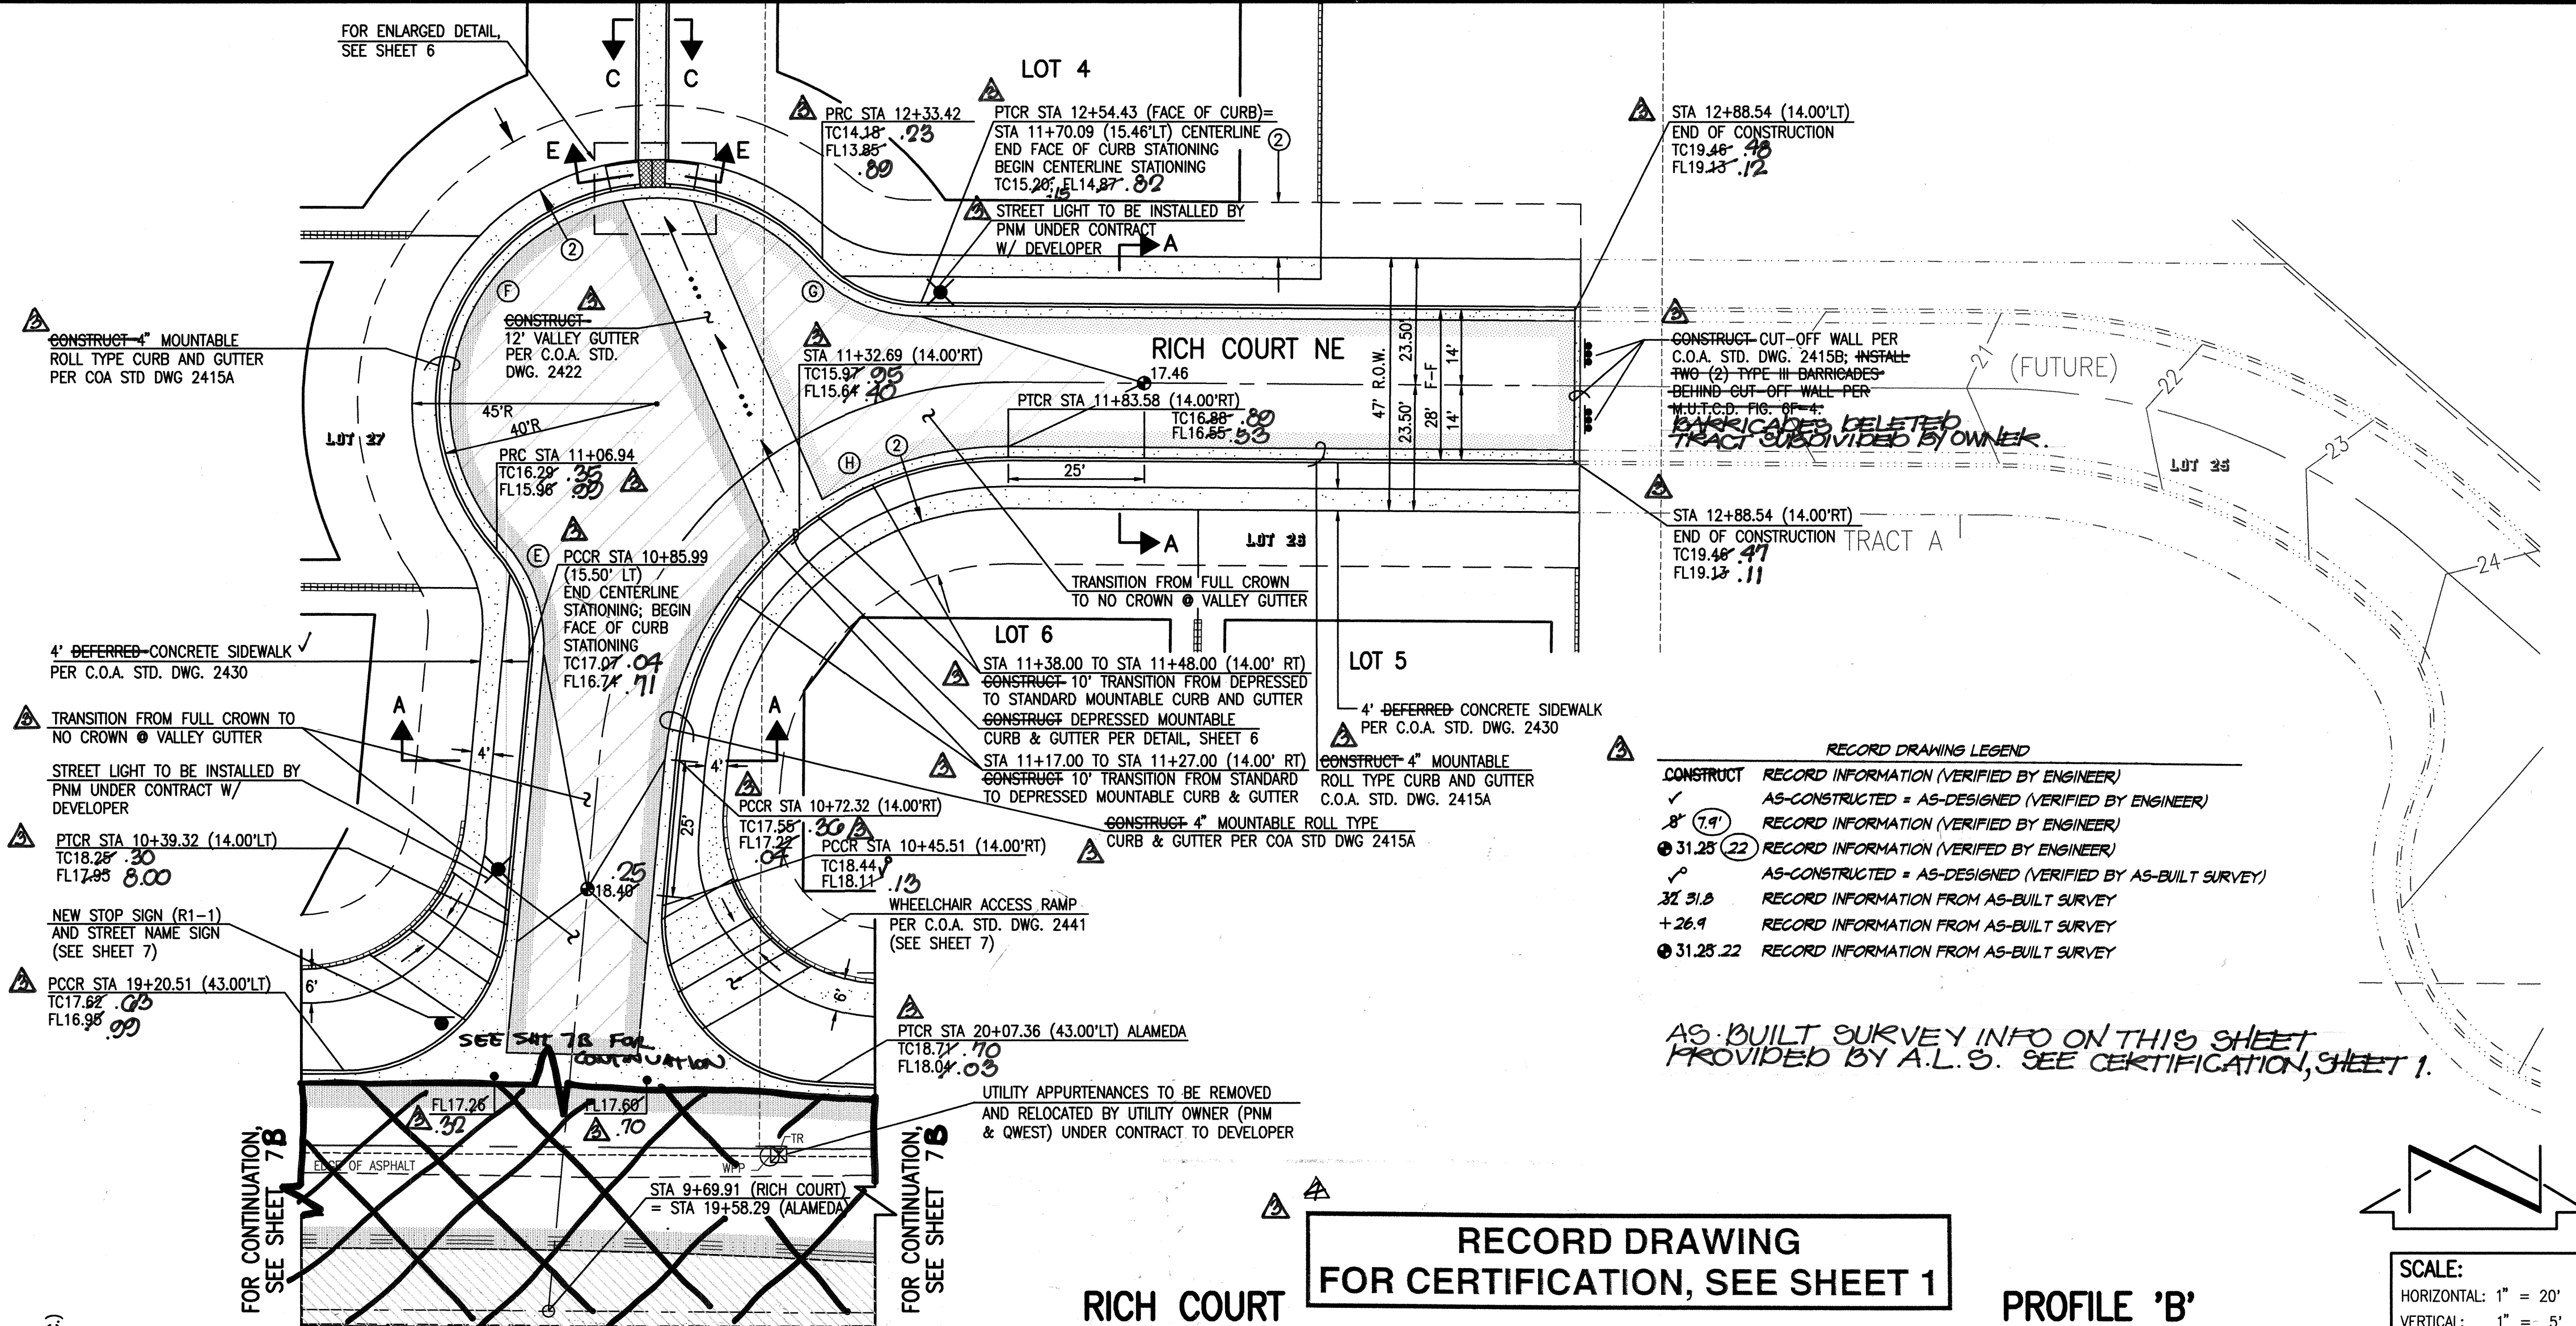

**RECORD DRAWING
FOR CERTIFICATION, SEE SHEET 1**

PROFILE 'B'

SCALE:
HORIZONTAL: 1" = 20'
VERTICAL: 1" = 5'

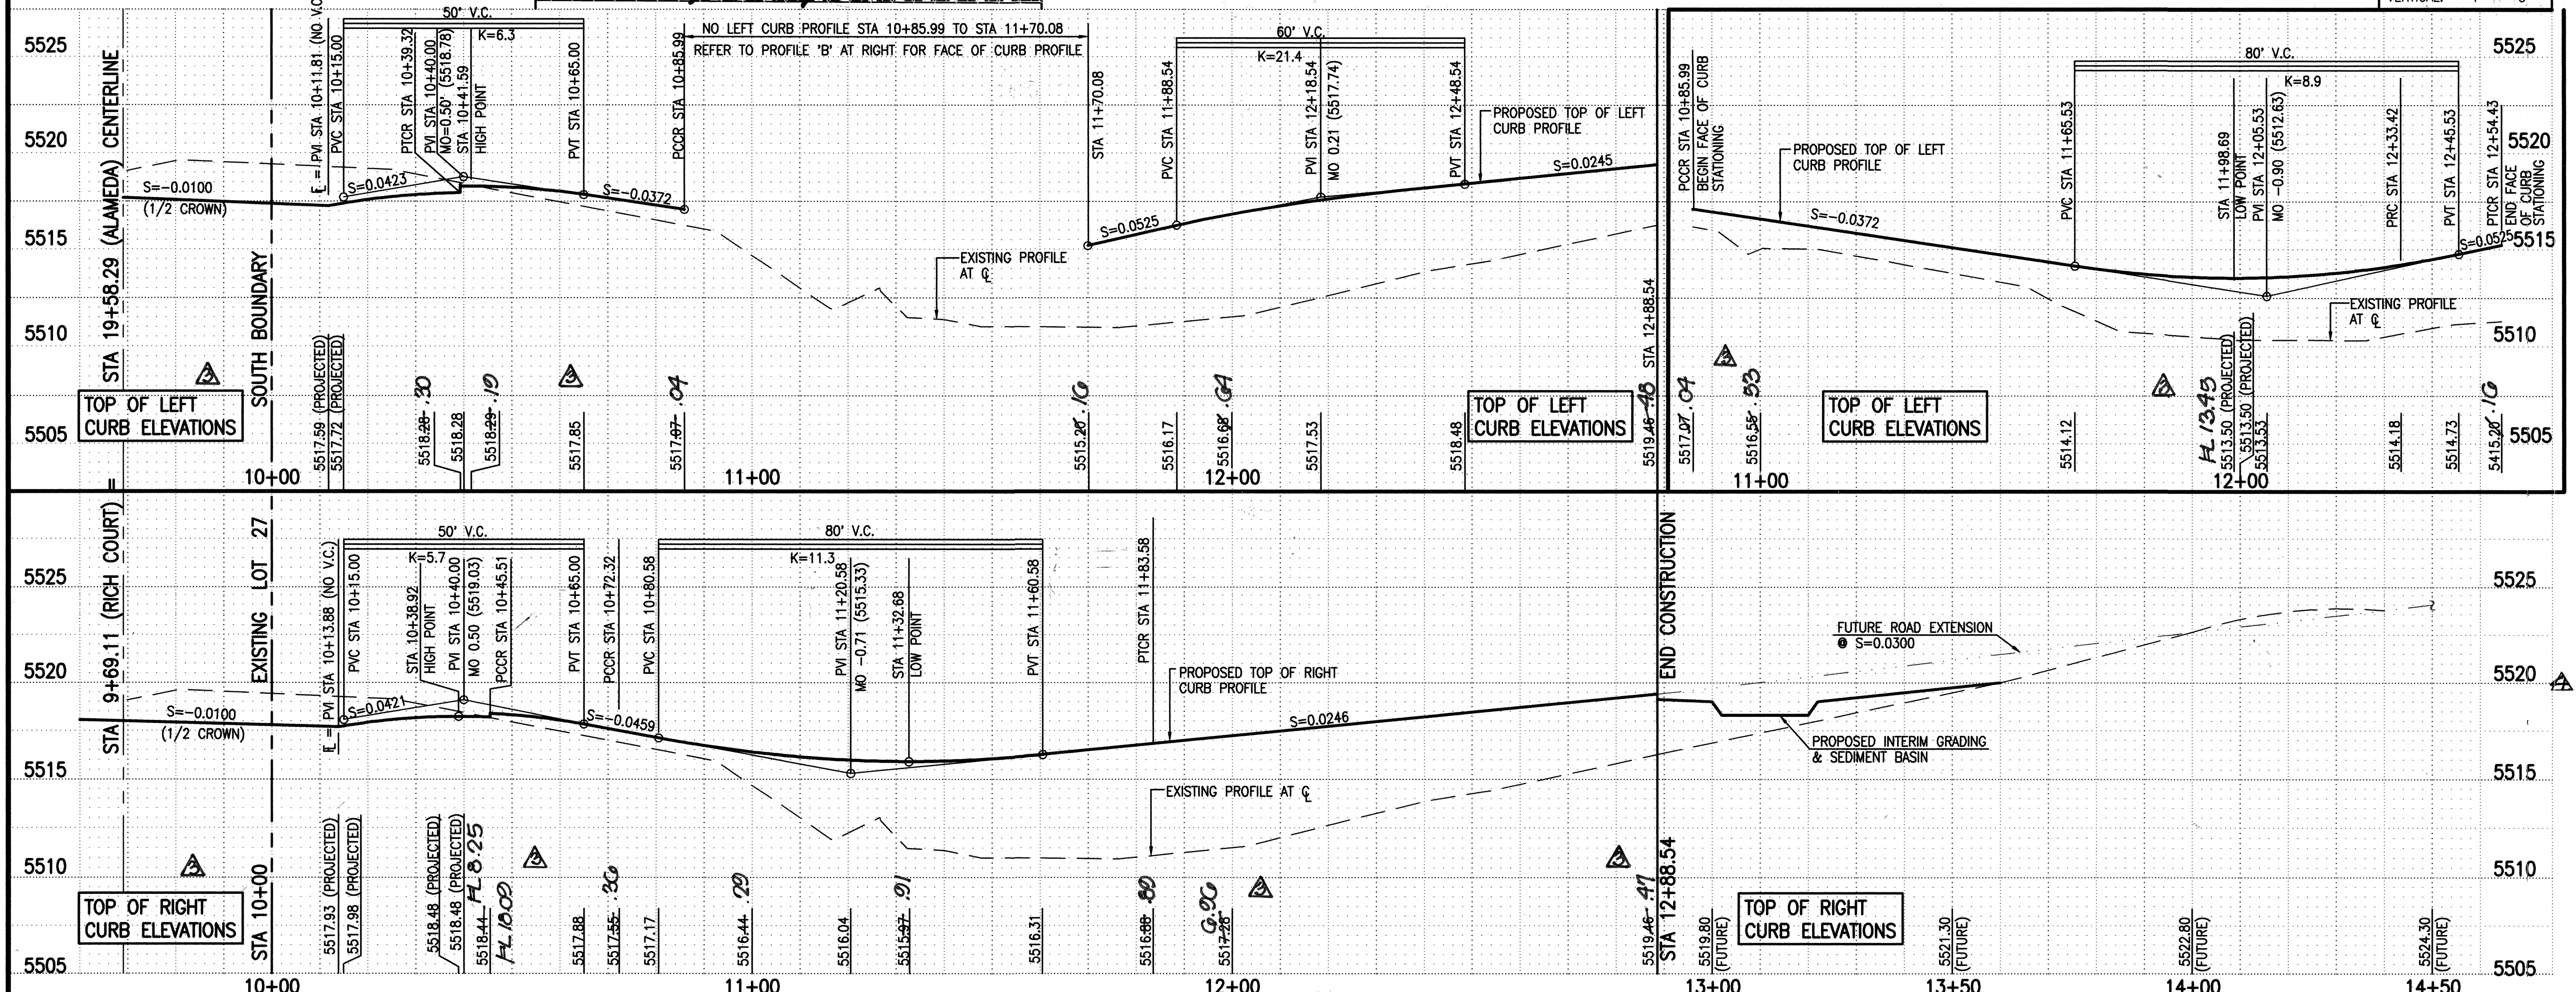

PAVING LEGEND

- STOP AND STREET NAME SIGN
- PROPOSED ASPHALT PAVEMENT
- PROPOSED CONCRETE
- PROPOSED TEMPORARY PAVEMENT
- NEW LIGHT POLE INSTALLED BY PNM UNDER CONTRACT WITH OWNER
- CROWN TRANSITION

CURB CURVE DATA

CURVE	RADIUS	ARC	DELTA	CHD. BRG.	CHD. LENGTH
1	25.00	20.95	48°00'52"	N18°40'00"	20.34
2	40.00	126.48	181°10'00"	N47°54'34"E	80.00
3	25.00	21.01	48°09'08"	N65°35'00"W	20.40
4	61.00	90.50	85°00'00"	N47°50'26"E	82.42

Jma
2005.070.51 2010.035.1

CITY OF ALBUQUERQUE
PUBLIC WORKS DEPARTMENT
ENGINEERING DEVELOPMENT GROUP

TITLE:
RICH COURT N.E.
PAVING IMPROVEMENTS PLAN AND PROFILE
RICH COURT

Design Review Committee: DEC 01 2006
City Engineer Approval: MAR 14 2007

City Project No. 751983
Zone Map No. C-20
Sheet 8 of 11

- STREET PAVING IMPROVEMENTS:**
- ALL SLOPES AS SHOWN ON PROFILES ARE BASED ON STREET CENTERLINE STATIONING EXCEPT CUL-DE-SACS AND EYEBROWS WHERE STATIONING IS ALONG FACE-OF-CURB.
 - WHERE REMOVAL OF EXISTING CURB AND GUTTER, SIDEWALK OR PAVEMENT IS REQUIRED, THE CONTRACTOR SHALL SAWCUT AND/OR REMOVE TO THE NEAREST JOINT. CURB AND GUTTER AND SIDEWALK SHOWN AS EXISTING AND NOT TO BE REMOVED UNDER THIS CONTRACT WHICH IS DAMAGED OR DISPLACED BY THE CONTRACTOR SHALL BE REMOVED AND REPLACED BY THE CONTRACTOR PER C.O.A. STD. DWGS 2415A AND 2430, RESPECTIVELY, AT THE CONTRACTOR'S EXPENSE.
 - ALL DIMENSIONS OF CURB AND CURB RETURNS ARE SHOWN TO FACE-OF-CURB.
 - SIDEWALKS SHOWN HEREON AS "DEFERRED" SHALL BE CONSTRUCTED UNDER SEPARATE PERMIT.
 - ALL WHEELCHAIR RAMPS MUST BE CONSTRUCTED UNDER THIS WORK ORDER.
 - ALL CURB AND GUTTER SHOWN HEREON SHALL BE CONSTRUCTED IN ACCORDANCE WITH CITY OF ALBUQUERQUE STANDARD DRAWING 2415A UNLESS OTHERWISE NOTED.
 - STRIPING BY CONTRACTOR WILL BE REQUIRED PRIOR TO FINAL ACCEPTANCE.

AS BUILT INFORMATION		BENCH MARKS		SURVEY INFORMATION	
CONTRACTOR	JMA	PROJECT BENCHMARK	AN ACS 1 3/4" ALUMINUM DISK STAMPED "ACS BM, 11-C16" EXPOSED TO TOP OF A CONCRETE CURB LOCATED AT THE NW CORNER OF BARSTOW ST. AND OAKLAND AVENUE N.E. ELEVATION = 5480.97 FEET (NGVD 1929)	DATE	06-07
INSPECTOR	ALB	NO.	50702	BY	JMA, NIPPS 11184
REVISIONS	ALB	DATE	02-09	DATE	02-09
REVISIONS	ALB	DATE	11-08	DATE	11-08
REVISIONS	ALB	DATE	02-09	DATE	02-09


ENGINEER'S SEAL

12/10 RECORD BNG. CERTIFICATION G.M.
02/09 RECORD BNG. CERTIFICATION G.M.

DESIGN
NO. DATE
REVISIONS
DESIGN
NO. DATE


Designed By: G.M./J.D.S.
Drawn By: RRW/J.P.
Checked By: G.M.



Date: 10-2006
Date: 10-2006
Date: 11-2006

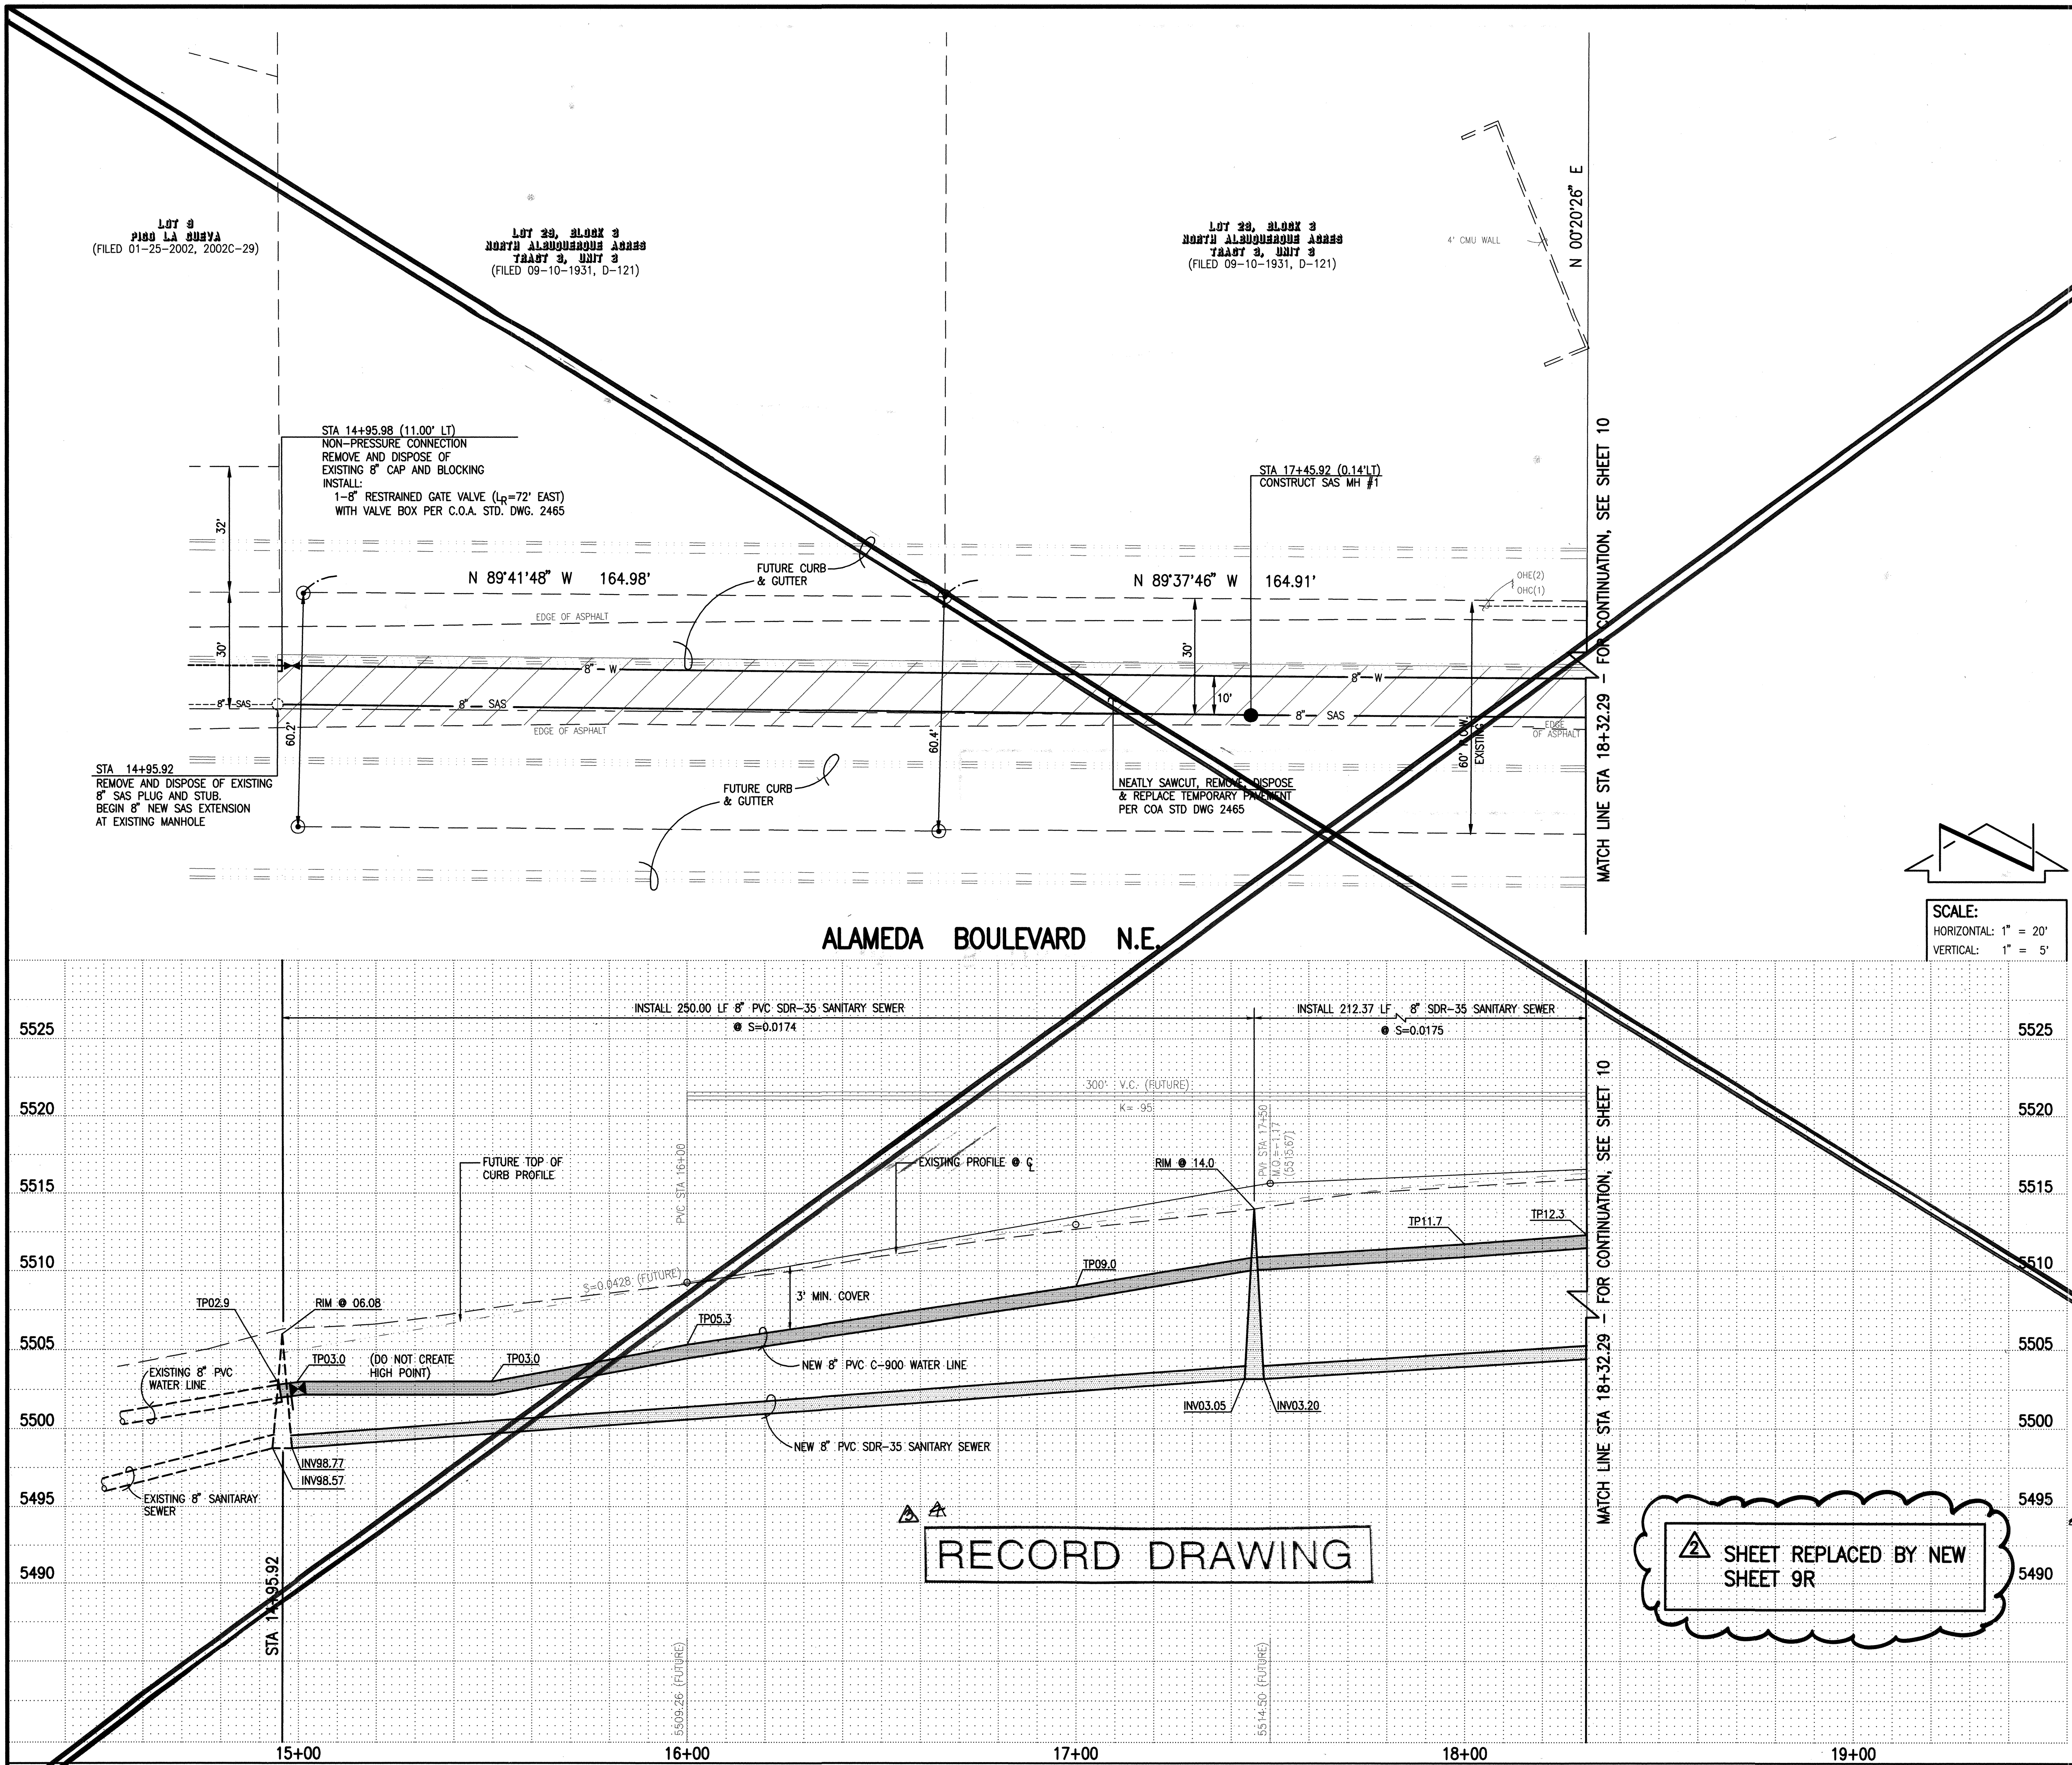




SHEET NO. 1 GROUP 2 TO STA 18+32.29 PLAN AND PROFILE PLAZA	
Mo./Day/Yr. 	Mo./Day/Yr.
Sheet	Of
9R	15

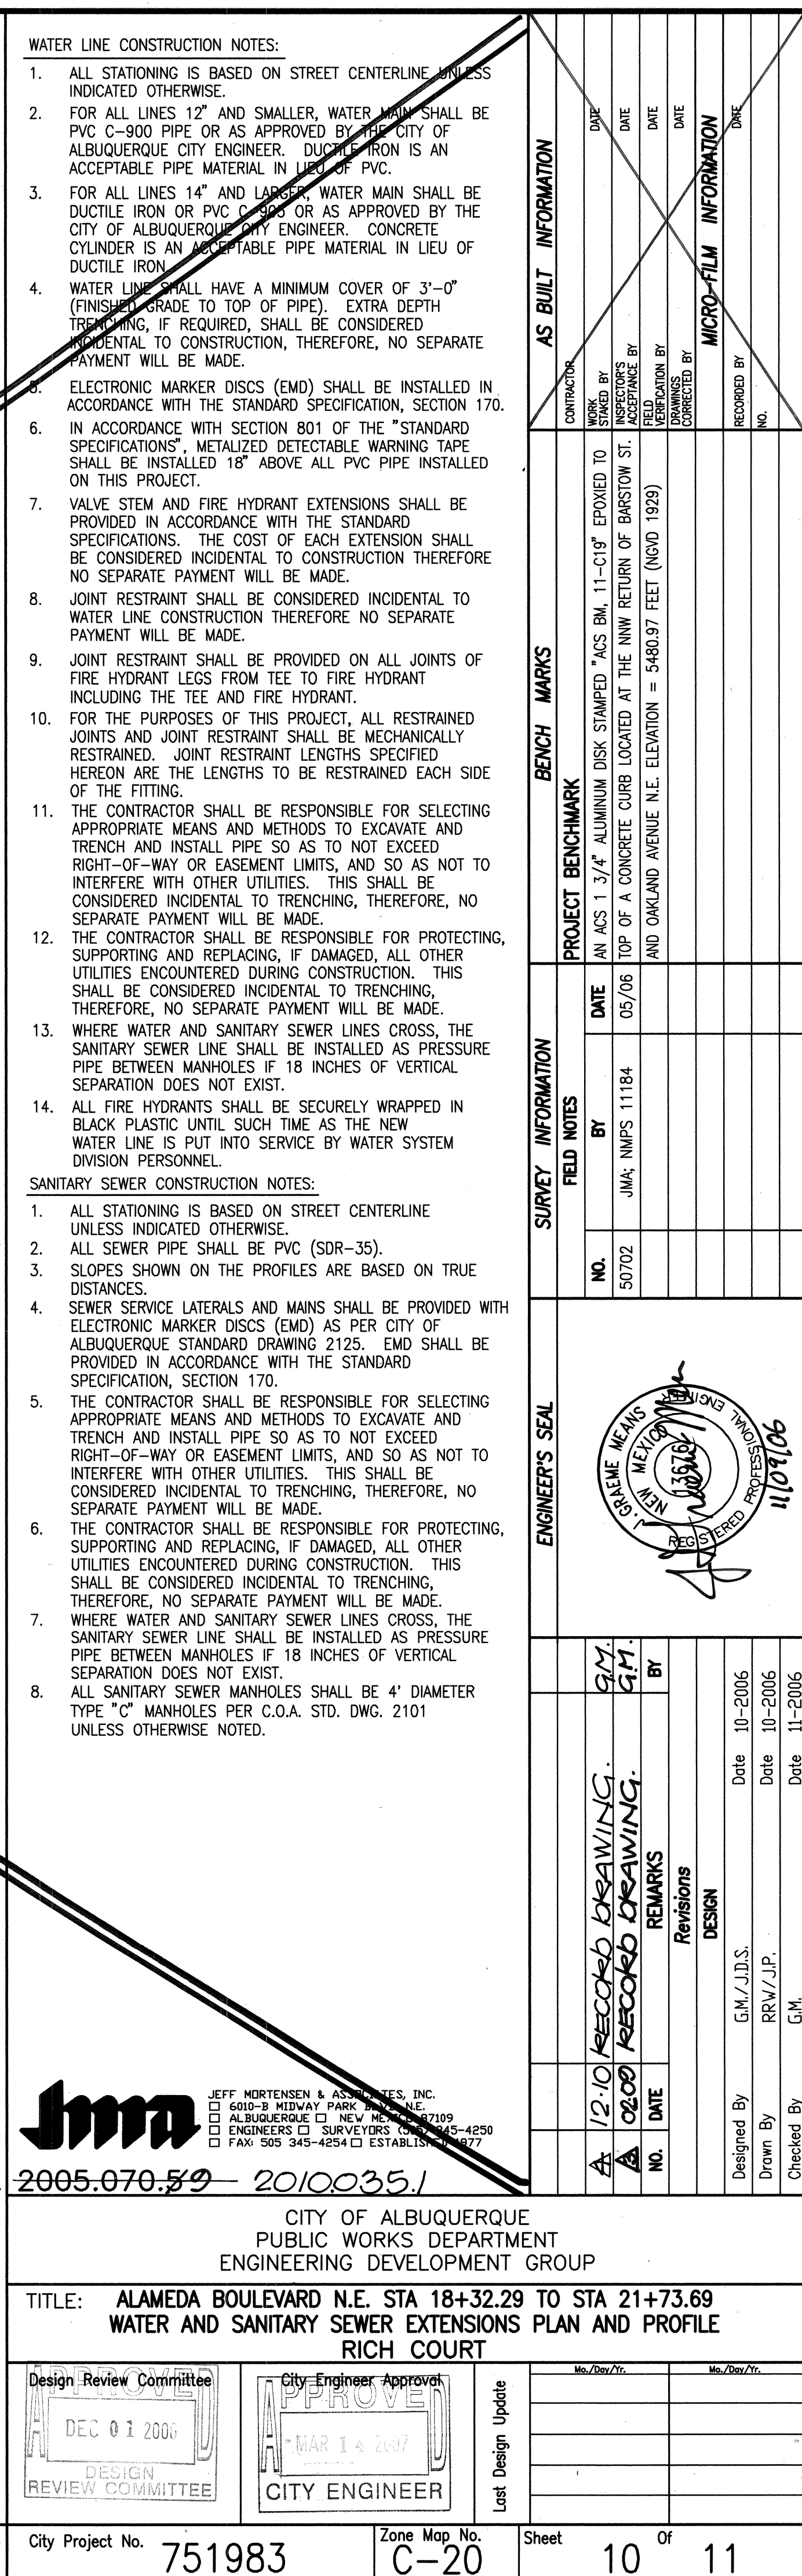

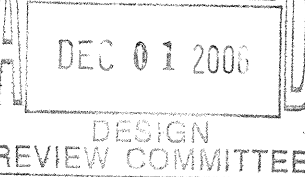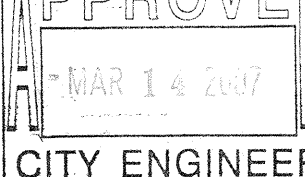		JEFF MORTENSEN & ASSOCIATES, INC. 600-B MIDWAY PARK ALBUQUERQUE, NM 87109 ENGINEERS & SURVEYORS 505 345-4254 • ESTABLISHED 1977		12-10 A 02-00 A		No. DATE No. DATE		Designed By Drawn By Checked By	
2005-070-59-20100351		CITY OF ALBUQUERQUE PUBLIC WORKS DEPARTMENT ENGINEERING DEVELOPMENT GROUP							
TITLE: ALAMEDA AVENUE N.E. STA 18+32.29 TO STA 21+73.69 WATER AND SANITARY SEWER EXTENSIONS PLAN AND PROFILE RICH COURT									
Design Review Committee 		City Engineer Approval 		Last Design Update		Mo./Day/Yr. 		Mo./Day/Yr. 	
City Project No. 751983		Zone Map No. C-20		Sheet 10 Of 11					

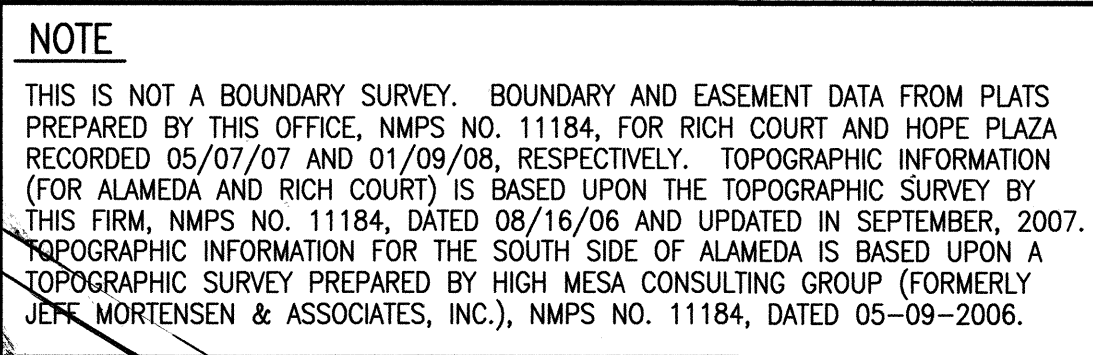

SANITARY SEWER CONSTRUCTION NOTES:

1. ALL STATIONING IS BASED ON STREET CENTERLINE UNLESS INDICATED OTHERWISE.
2. ALL SEWER PIPE SHALL BE PVC (SDR-35).
3. SLOPES SHOWN ON THE PROFILES ARE BASED ON TRUE DISTANCES.
4. SEWER SERVICE LATERALS AND MAINS SHALL BE PROVIDED WITH ELECTRONIC MARKER DISCS (EMD) AS PER CITY OF ALBUQUERQUE STANDARD DRAWING 2125. EMD SHALL BE PROVIDED IN ACCORDANCE WITH THE STANDARD SPECIFICATION, SECTION 170.
5. THE CONTRACTOR SHALL BE RESPONSIBLE FOR SELECTING APPROPRIATE MEANS AND METHODS TO EXCAVATE AND TRENCH AND INSTALL PIPE SO AS TO NOT EXCEED RIGHT-OF-WAY OR EASEMENT LIMITS, AND SO AS NOT TO INTERFERE WITH OTHER UTILITIES. THIS SHALL BE CONSIDERED INCIDENTAL TO TRENCHING, THEREFORE, NO SEPARATE PAYMENT WILL BE MADE.
6. THE CONTRACTOR SHALL BE RESPONSIBLE FOR PROTECTING, SUPPORTING AND REPLACING, IF DAMAGED, ALL OTHER UTILITIES ENCOUNTERED DURING CONSTRUCTION. THIS SHALL BE CONSIDERED INCIDENTAL TO TRENCHING, THEREFORE, NO SEPARATE PAYMENT WILL BE MADE.
7. WHERE WATER AND SANITARY SEWER LINES CROSS, THE SANITARY SEWER LINE SHALL BE INSTALLED AS PRESSURE PIPE BETWEEN MANHOLES. MINIMUM 18 INCHES OF VERTICAL SEPARATION DOES NOT EXIST.
8. ALL SANITARY SEWER MANHOLES SHALL BE 4' DIAMETER TYPE "C" MANHOLES PER C.O.A. STD. DWG. 2101 UNLESS OTHERWISE NOTED.

EASEMENT KEYED NOTES:
FOR EASEMENT KEYED NOTES, SEE SITE PLAN (SHEET 5R).

HIGH MESA Consulting Group
FORMERLY JEFF MCORTENSEN AND ASSOCIATES, INC.
6010-B MIDWAY PARK BLVD. NE • ALBUQUERQUE, NEW MEXICO 87109
PHONE: 505.345.4250 • FAX: 505.345.4254 • www.highmesacg.com
~~2005-070-19~~ 2010.035.1


CITY OF ALBUQUERQUE
PUBLIC WORKS DEPARTMENT
ENGINEERING DEVELOPMENT


TITLE: ALAMEDA BOULEVARD N.E. STA 18+32
WATER AND SANITARY SEWER EXTENSION
RICH COURT / HOPE

Design Review Committee APPROVED OCT 03 2008 DESIGN REVIEW COMMITTEE	City Engineer Approval APPROVED OCT 09 2008 CITY ENGINEER
--	---



City Project No.	751983	Zone Map No.	C-20
------------------	--------	--------------	------

[illegible]

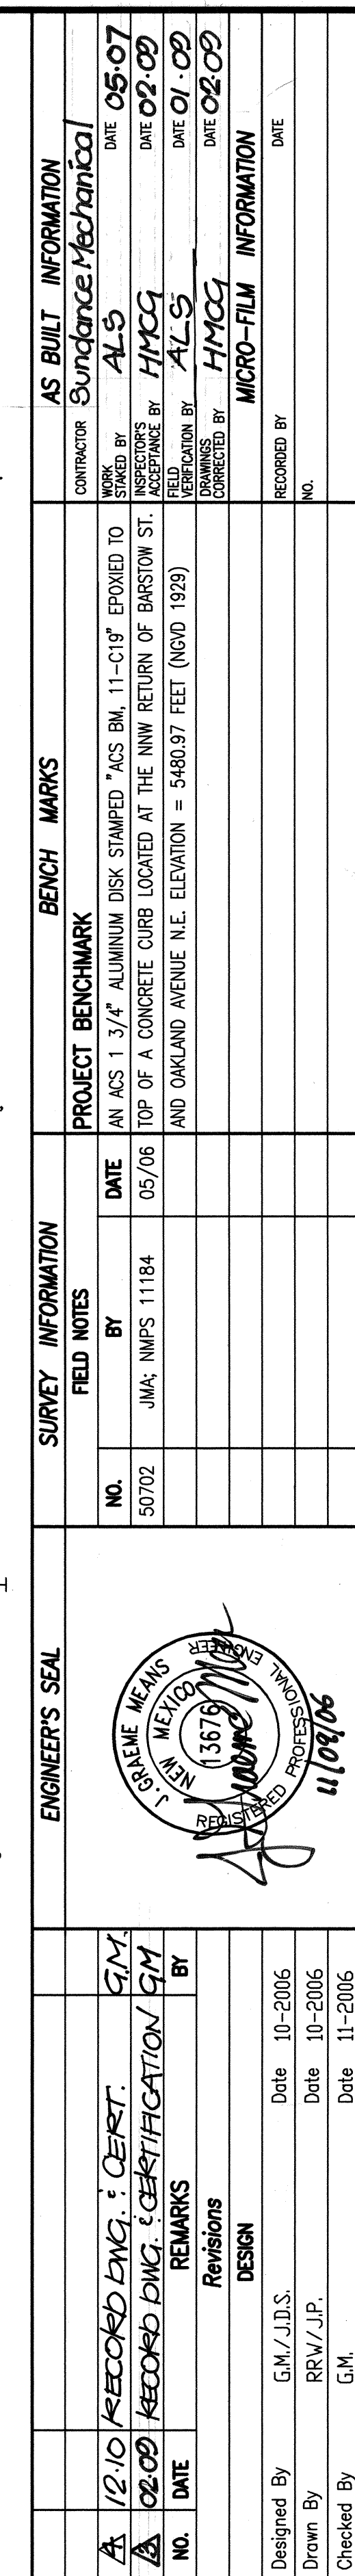

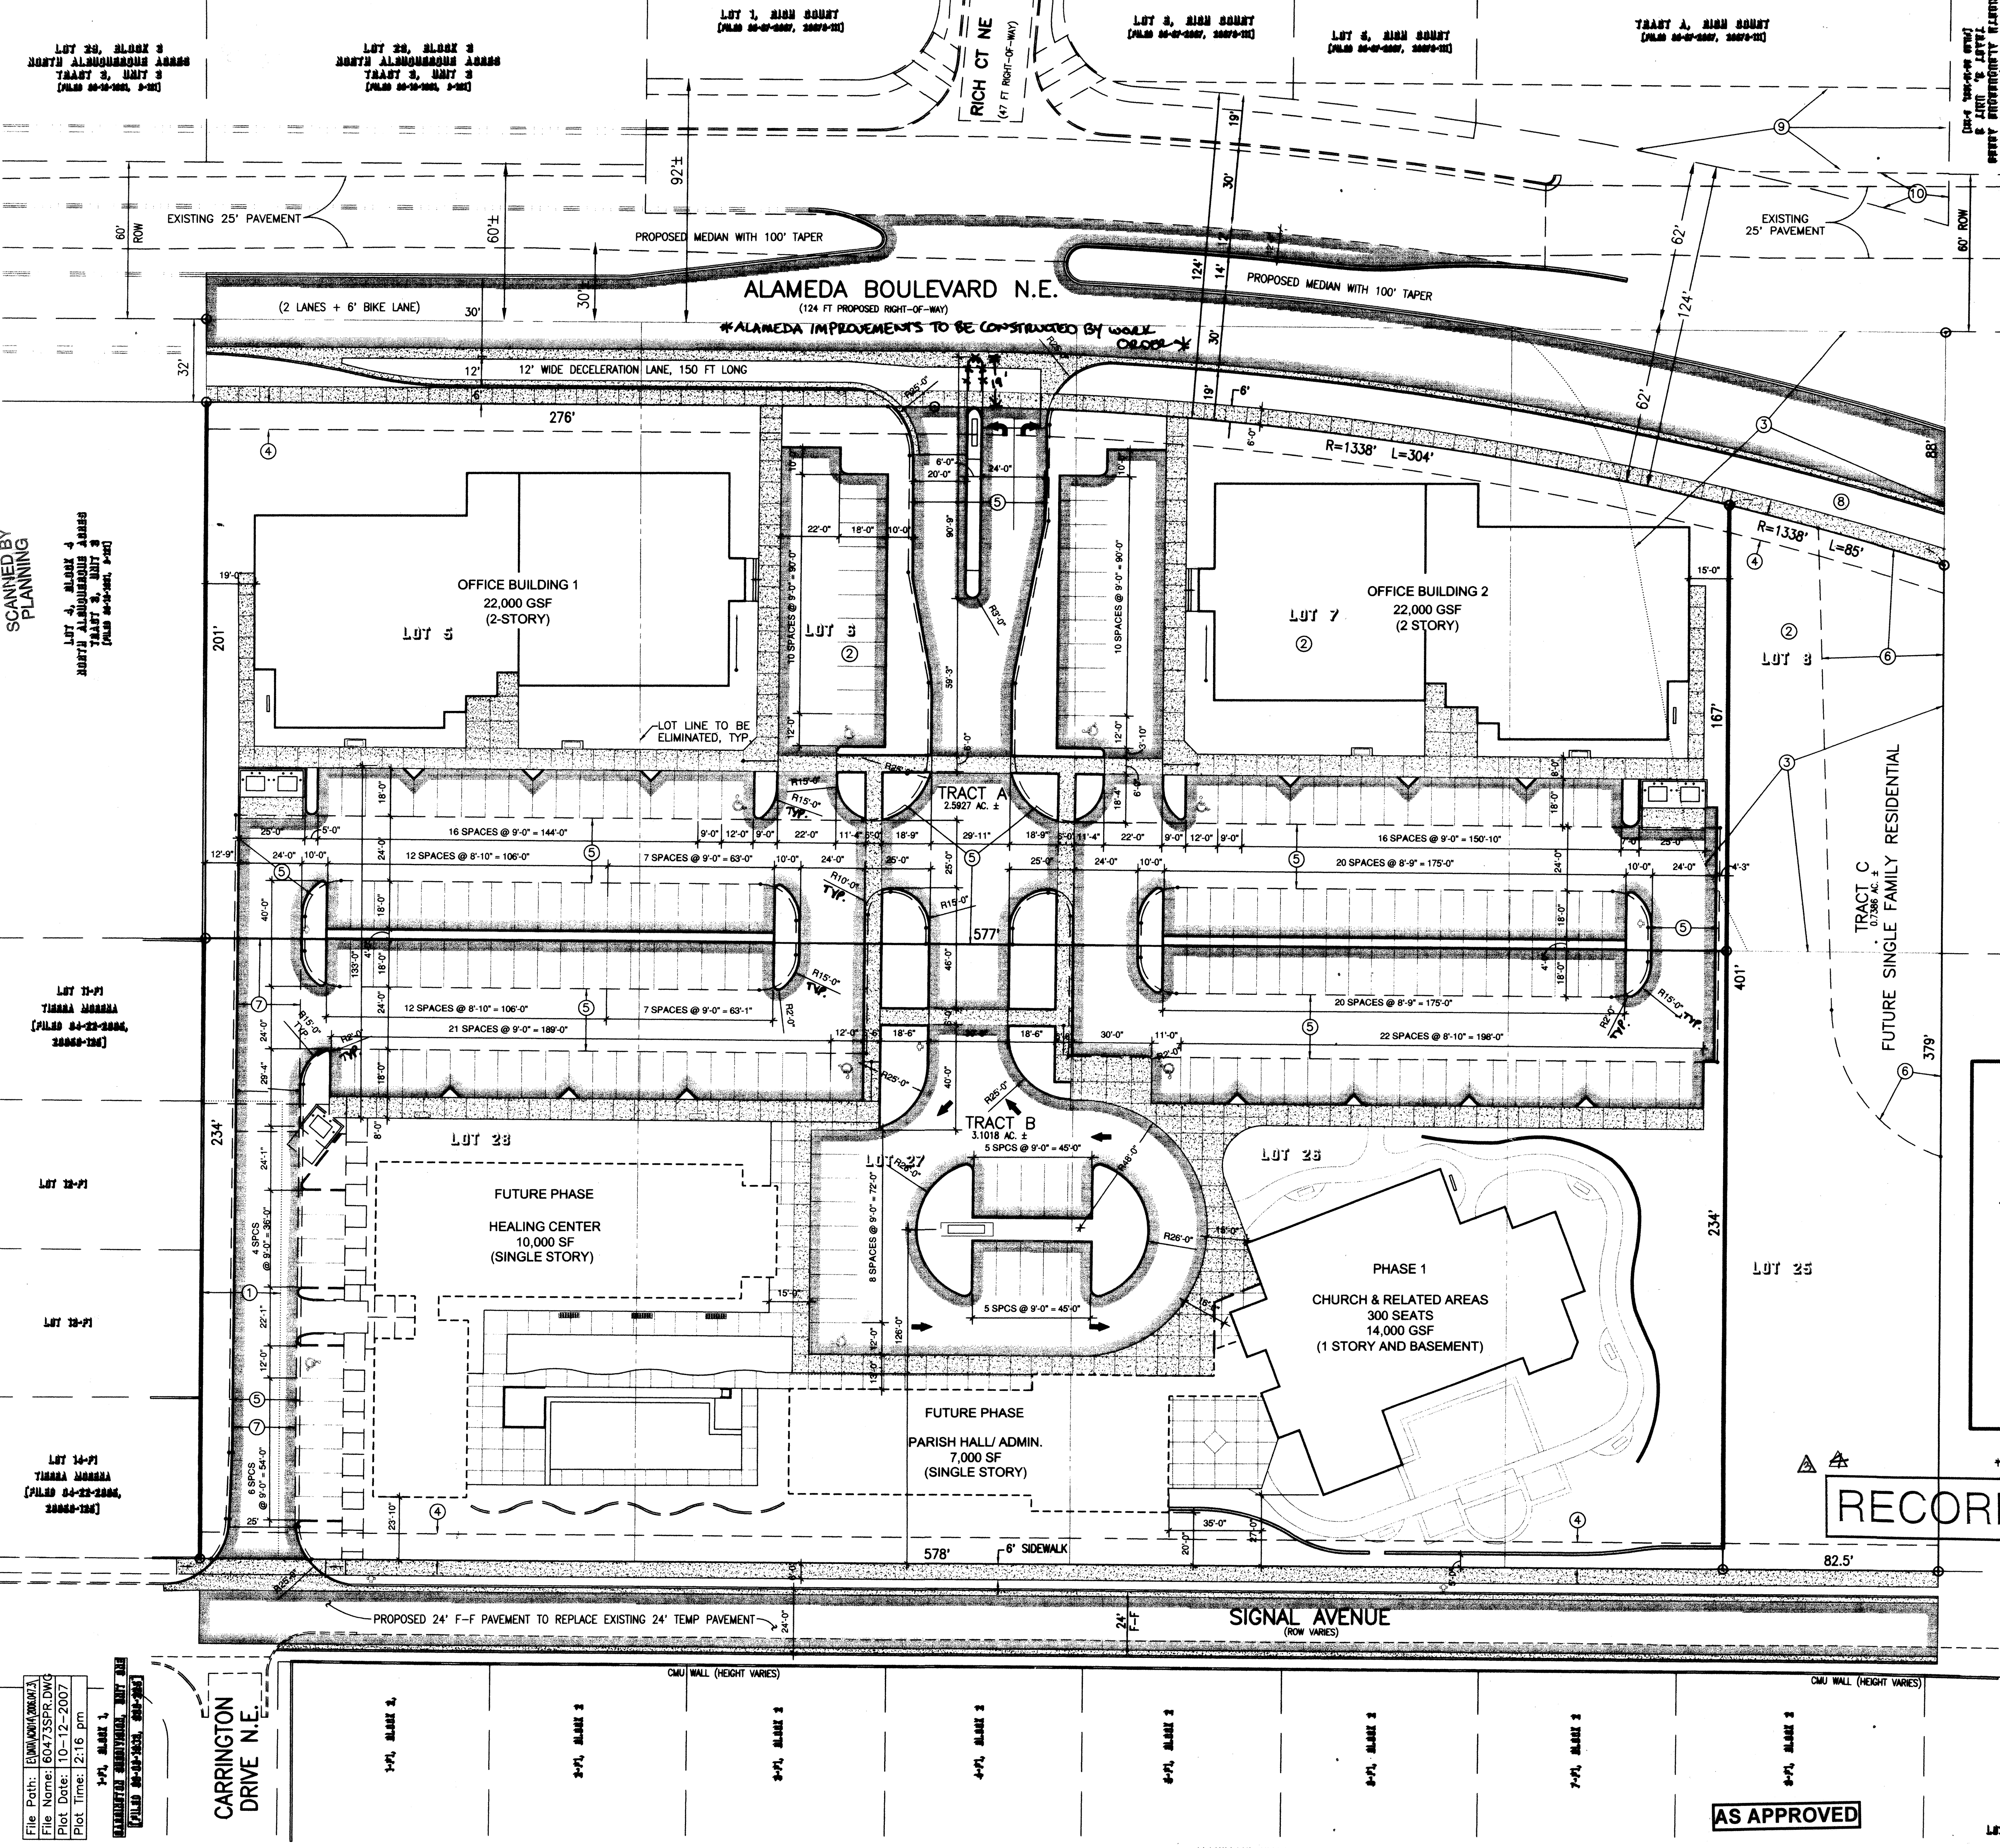

LEGAL DESCRIPTION
LOTS 5-8 AND 25-28, BLOCK 4, NORTH ALBUQUERQUE ACRES, TRACT 3, UNIT 3
ZONING
SU-2 / O-1 & RT (VINEYARD SECTOR PLAN)
LA CUEVA SECTOR PLAN DESIGN GUIDELINES APPLY PER THE VINEYARD SECTOR PLAN
SURVEY INFORMATION
THIS IS NOT A BOUNDARY SURVEY. APPARENT PROPERTY CORNERS ARE SHOWN FOR ORIENTATION ONLY. THE BOUNDARY INFORMATION DEPICTED BY THIS PLAN IS BASED UPON THE BOUNDARY SURVEY CONDUCTED BY THIS FIRM DATED AUGUST 16, 2006 (UNRECORDED), NMPS 11184. TOPOGRAPHIC INFORMATION IS BASED UPON THE TOPOGRAPHIC SURVEY BY THIS FIRM ALSO DATED 08/16/06. EXISTING BERM EAST OF SITE IS FROM CONSTRUCTION PLANS FOR CPN 757781. EXISTING ALAMEDA PAVING AND UTILITY IMPROVEMENTS ARE FROM CONSTRUCTION PLANS FOR CPN 751983.

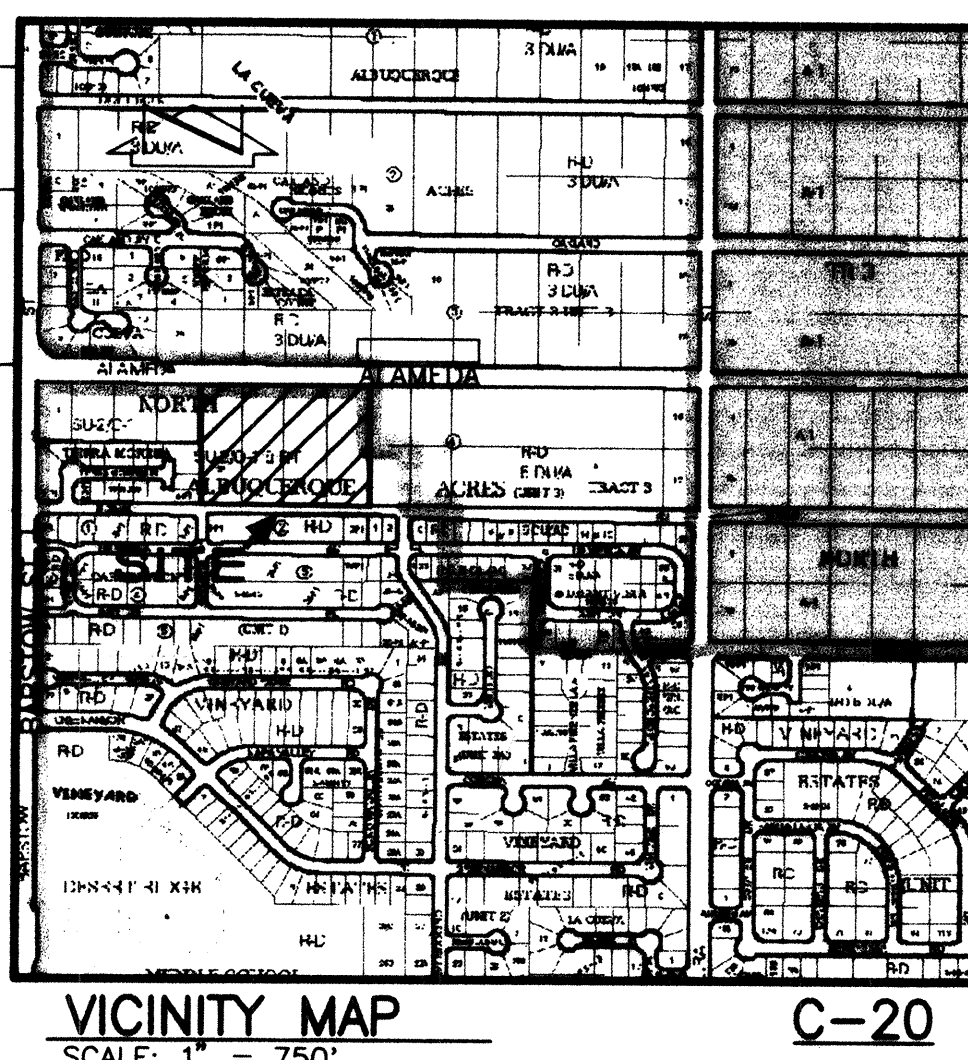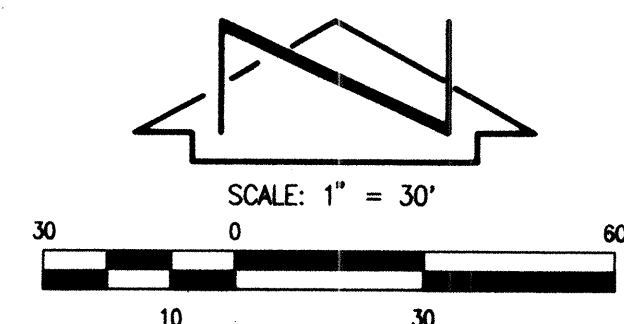

- EASEMENTS AND RESTRICTIONS**
- 1 APPROXIMATE LOCATION OF A PRIVATE DRAINAGE EASEMENT GRANTED BY DOCUMENT FILED 06-09-2004, TO BE VACATED BY FORTHCOMING ACTION.
 - 2 NONSPECIFIC EASEMENTS AND/OR RIGHT-OF-WAYS FOR ROAD AND/OR PIPELINE PURPOSES (WATER, GAS OR SEWAGE), TELEPHONE AND ELECTRICAL ENERGY TO BE VACATED BY FORTHCOMING ACTION.
 - 3 TEMPORARY PUBLIC DRAINAGE EASEMENT GRANTED BY DOCUMENT FILED 08-26-2005, TO BE VACATED BY FORTHCOMING ACTION.
 - 4 10' PUBLIC UTILITY EASEMENT TO BE GRANTED BY PLAT.
 - 5 PRIVATE ACCESS EASEMENT TO BE GRANTED BY PLAT TO SERVE TRACTS A AND B.
 - 6 PUBLIC DRAINAGE EASEMENT TO BE GRANTED BY PLAT TO SERVE THE ALBUQUERQUE METROPOLITAN ARROYO FLOOD CONTROL AUTHORITY.
 - 7 PRIVATE DRAINAGE EASEMENT TO BE GRANTED BY PLAT TO SERVE TRACT A.
 - 8 DIRECT VEHICULAR ACCESS TO TRACT C IS NOT PERMITTED FROM ALAMEDA BOULEVARD N.E. OR FROM TRACTS A AND B. HOPE PLAZA ACCESS EASEMENT TO ALAMEDA BOULEVARD N.E. SHALL BE GRANTED ACROSS LOT 9, BLOCK 4, NORTH ALBUQUERQUE ACRES, TRACT 3, UNIT 3 BY SEPARATE DOCUMENT.
 - 9 PUBLIC ROADWAY EASEMENT GRANTED BY PLAT 2007C-111
 - 10 PUBLIC ROADWAY EASEMENT GRANTED BY PLAT 2007C-111
 - MINIMUM BUILDING SETBACK IS 10 FT FOR TRACTS A AND B
 - BUILDING HEIGHT FOR TRACTS A AND B SHALL COMPLY WITH HEIGHT REGULATIONS FOR THE O-1 ZONE
 - MAXIMUM F.A.R. FOR COMMERCIAL DEVELOPMENT IS 0.4 FOR TRACTS A AND B
 - SETBACKS, DENSITY AND OTHER CRITERIA FOR TRACT C WILL BE ADDRESSED BY SEPARATE EPC SUBMITTAL
 - FUTURE DEVELOPMENT PHASES SHALL NOT BE DELEGATED TO THE DRB
 - ALL FUTURE PHASES SHALL BE IN CONTEXT IN DESIGN, COLOR AND MATERIALS WITH THE PROPOSED MAIN FACILITY
 - LA CUEVA SECTOR DEVELOPMENT PLAN DESIGN REGULATIONS SHALL COMPLY TO ALL TRACTS

LOT 3, BLOCK 4
NORTH ALBUQUERQUE ACRES
TRACT 3, UNIT 3
[FILED 04-23-2006, 2:00PM]

LOT 24, BLOCK 4
NORTH ALBUQUERQUE ACRES
TRACT 3, UNIT 3
[FILED 04-23-2006, 2:00PM]

PROJECT NUMBER: 1006520
Application Number 07EPC-4001

Is an Infrastructure List required? (X) Yes () No
If yes, then a set of approved DRC plans with a work order is required for any construction within Public Right-of-Way or for construction of Public Improvements.

DRB SITE DEVELOPMENT PLAN APPROVAL:

Traffic Engineering, Transportation Division	Date
Water Utility Department	Date
Parks and Recreation Department	Date
City Engineer	Date
Solid Waste Management	Date
DRB Chairperson, Planning Department	Date

HIGH MESA Consulting Group
FORMERLY JEFF MORRIS AND ASSOCIATES, INC.
6010-B MIDWAY PARK BLVD. NE
ALBUQUERQUE, NEW MEXICO 87109
PHONE: 505.345.4250 FAX: 505.345.4254
www.highmesacg.com




Fanning Bard Tatum Architects AIA, Ltd.
6100 Indian School Rd. NE Ste 210
Albuquerque NM 87110
Phone 505/883.5200
Facsimile 505/884.5300
Web www.fblarch.com

HOPE PLAZA
A CO-DEVELOPMENT OF
HOPE EPISCOPAL CHURCH
AND HOECH
REAL ESTATE CORP.
ALBUQUERQUE, NEW MEXICO
JUNE 2007

SHEET TITLE
SITE PLAN FOR
SUBDIVISION

Sheet 12 of 15 CPN 751983


RECORD DRAWING

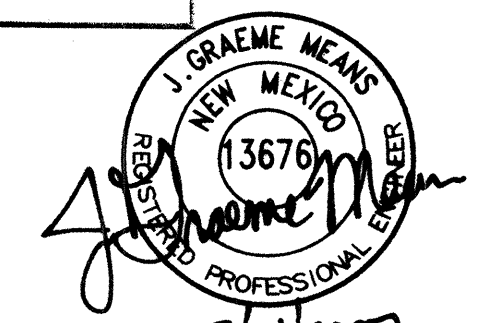

05/31/2007
10/17/2007
11/28/2007

AS APPROVED

File Path: \\AWA\AWA\2006\1006520\1006520.DWG
File Name: 1006520.DWG
Plot Date: 10-12-2007
Plot Time: 2:16 pm
10/12/2007 2:16 PM
10/12/2007 2:16 PM

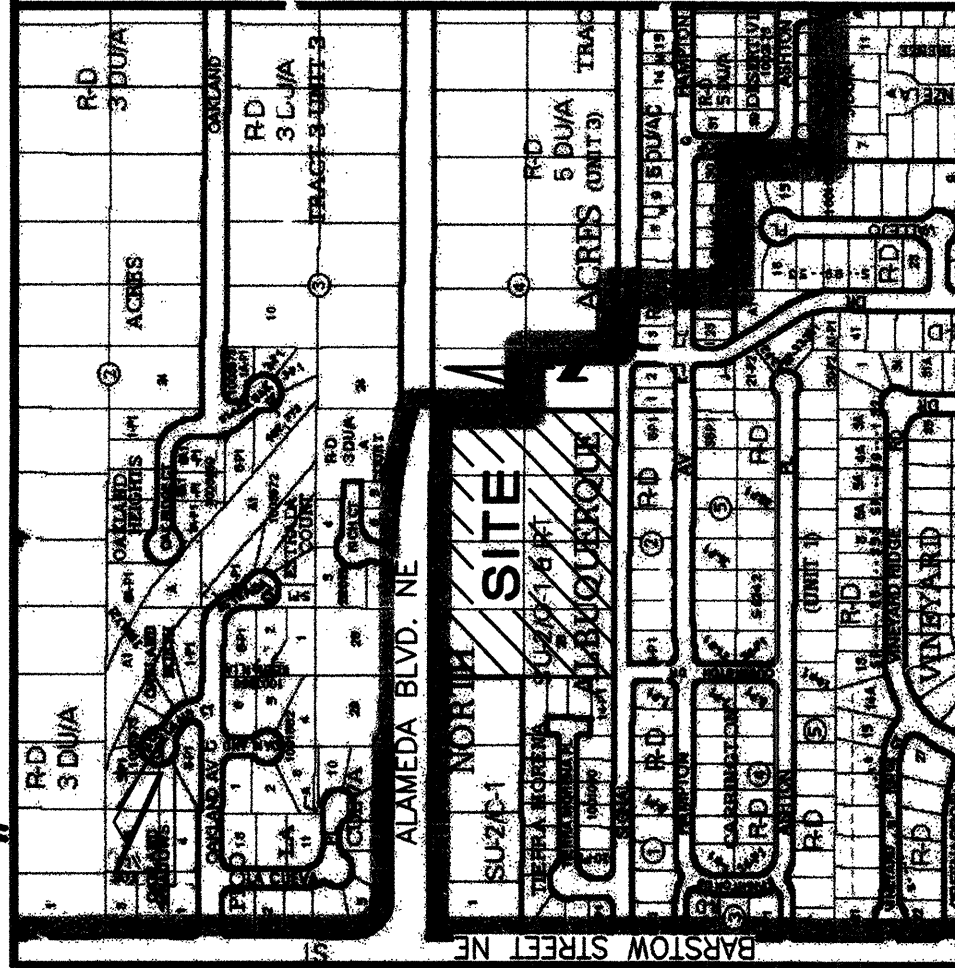VICINITY MAP
SCALE: 1" = 750'

C-20

Lots 5 through 8, inclusive, Block 4 and Lots 25 through 28, inclusive, Block 4, North Albuquerque Acres, Tract 3, Unit 3, Albuquerque, New Mexico, as the same is shown and designated on the plat filed in the Office of the County Clerk of Bernalillo County, New Mexico on September 10, 1931, Book B, Page 121.

Public Utility easements shown on this plat are ten (10) feet wide and are granted for the common and joint use of:

1. The P.N.M. Electric Services for the installation, maintenance, and service of overhead and underground electrical lines, transformers, poles and other equipment, fixtures, structures and related facilities reasonably necessary to provide electrical service.

2. The P.N.M. Gas Services for installation, maintenance, and service of natural gas lines, valves and other equipment and facilities reasonably necessary to provide natural gas.

3. Qwest Corporation for the installation, maintenance, and service of all buried and aerial communication lines and other related equipment and facilities reasonably necessary to provide communication services including, but not limited to, above ground pedestals and closures.

4. Comcast Cable Vision of New Mexico, Inc. for the installation, maintenance, and service of such lines, cables, and other related equipment and facilities reasonably necessary to provide Cable TV service.

Included, is the right to build, rebuild, construct, reconstruct, locate, relocate, change, remove, modify, renew, operate, and maintain facilities for the purposes described above, together with free access to, from, and over said easements, including the right and privilege to trim and remove trees, shrubs or bushes which interfere with the purposes set forth herein. No building, sign, pool (aboveground or subsurface), hot tub, concrete or wood pool decking, or other structure shall be erected or constructed on said easements, nor shall any well be drilled or operated thereon. Property owners shall be solely responsible for any damage caused by construction or pools, decking or any structures adjacent to within or near easements shown on this plat.

Notes:

- A boundary survey was performed in July 2006 and verified in September, 2007. Property corners were found or set as indicated.
- All distances are ground distances.
- Site located within projected Section 17, Township 11 North, Range 4 East, N.M.P.M. (Elena Gallegos Grant).
- Bearings shown hereon are New Mexico State Plane Grid Bearings, Central Zone. These bearings are positioned from A.C.S. Control Station 7-019.
- Record bearings and distances are shown in parenthesis.
- Public street mileage created by this plat = 0.25 miles (half-width).
- Upon completion of the construction of the streets, City of Albuquerque approved centerline monuments shall be placed at all intersections or as otherwise indicated in lieu of subdivision block corner monumentation. Location of said monuments are designated with a * symbol.
- The purpose of this plat is to:
 - Create 3 (three) tracts from former Lots 5-8, inclusive, and 25-28, inclusive, Block 4, North Albuquerque Acres, Tract 3, Unit 3.
 - Eliminate the interior property lines between former Lots 5-8, inclusive and 25-28, inclusive.
 - Dedicate in fee simple, with warranty covenants, the additional public street rights-of-way for Alameda Boulevard (0.6458 AC. ±); and also dedicate in fee simple the half-widths for Alameda Boulevard and Signal Avenue (0.9129 AC. ±) as shown.
 - Grant the necessary public utility, private access, private drainage and public drainage easements as shown.
 - Vacate the nonspecific easements and/or right-of-ways for road and/or pipeline purposes (water, gas or sewage), telephone and electrical energy as noted, affecting the properties platted hereon, granted by the following documents: Book 124, Page 463 and Book D74, Page 109, records of Bernalillo County, New Mexico by this request (07DRB-70360).
- The following documents and instruments were used for the performance and preparation of this survey:
 - Plat of North Albuquerque Acres, Tract 3, Unit 3, filed 09-10-1931, Book D, Page 121, Records of Bernalillo County, New Mexico.
 - Plat of Tierra Morena, filed 04-22-2005, Book 2005C, Page 125, Records of Bernalillo County, New Mexico.
 - Plat of Carrington Subdivision, Unit One, filed 08-06-1993, Book 93C, Page 225, Records of Bernalillo County, New Mexico.
 - Warranty Deed filed 10-09-2002, Book A43, Page 534, Doc. No. 2002130893, Records of Bernalillo County, New Mexico (Lots 5, 6, 7, 25, 26, 27 and 28).
 - Commitment for Title Insurance File No. 833574-AL01, MLC prepared by First American Title Insurance Company dated May 31, 2006 (Lots 5, 6, 7, 25, 26, 27 and 28).
 - Warranty Deed filed 09-26-2005, Book A104, Page 654, Doc. No. 2005141049, Records of Bernalillo County, New Mexico (Lot 8).
 - Title Insurance Policy No. 681342-AL01, MLC prepared by First American Title Insurance Company dated August 17, 2005 (Lot 8).
 - Boundary and Topographic survey of Lots 25, 26, 27, Block 3, North Albuquerque Acres, Tract 3, Unit 3 prepared by this firm dated May, 2005 (unrecorded).
 - Boundary and Topographic survey of Lots 5, 6, 7, 8, 25, 26, 27 and 28, Block 4, North Albuquerque Acres, Tract 3, Unit 3 prepared by this firm dated August, 2006 (unrecorded).
- No property within the area of requested final action shall at any time be subject to a deed restriction, covenant, or binding agreement prohibiting or solar collectors from being installed on buildings or erected on the lots or parcels within the area of the proposed plat.
- No direct vehicular access to Tract C is permitted from Alameda Boulevard or Tracts A and B. An access easement to Alameda Boulevard shall be granted across Lot 9, Block 4 by separate document.
- Gross subdivision acreage = 7.9928 acres.
- Current Zoning of this site is SU-2/O-1 & R-T, based upon review of the City of Albuquerque Zone Atlas.
- No property within the area of requested final action shall at any time be subject to a deed restriction, covenant, or binding agreement prohibiting or solar collectors from being installed on buildings or erected on the lots or parcels within the area of the proposed plat.

TRACTS A, B AND C, HOPE PLAZA

PLAT OF

ALBUQUERQUE, BERNALILLO COUNTY, NEW MEXICO

OCTOBER, 2007

DEDICATION AND FREE CONSENT

The subdivision hereon is with the free consent and in accordance with the desires of the undersigned owners and does hereby dedicate to the City of Albuquerque in fee simple with warranty covenants the public street rights-of-way with respect to the Alameda Boulevard N.E. realignment, and does hereby dedicate to the City of Albuquerque in fee simple the public street rights-of-way with respect to the north-half of Signal Avenue N.E., and the south-half of Alameda Boulevard N.E. and does hereby grant the easements as shown, including the rights of ingress and egress and the right to trim interfering trees. We hereby warrant that we hold complete and indefeasible title in fee simple to the land subdivided, hereon.

Donald G. Hoech
Donald G. Hoech, President
Hoech Real Estate Corporation (Contract Purchaser of Proposed Tract A)
Date 10-11-2007

ACKNOWLEDGEMENT

STATE OF NEW MEXICO)
COUNTY OF BERNALILLO) SS
The instrument was acknowledged before me on this 11th day of October, 2007, by Donald G. Hoech, President,
Hoech Real Estate Corporation.
Debbie Leblanc Trullio
Notary Public

Robert B. Keeran
Robert B. Keeran, President
Llave Development, Inc. (Lot 8; Contract Purchaser of Proposed Tract C)
Date 10-11-2007

ACKNOWLEDGEMENT

STATE OF NEW MEXICO)
COUNTY OF BERNALILLO) SS
This instrument was acknowledged before me on this 11th day of October, 2007, by Robert B. Keeran, President, Llave Development, Inc.
Debbie Leblanc Trullio
Notary Public

Jeffrey N. Steenson
Jeffrey N. Steenson, President
The Trustees of the Property of the Protestant Episcopal Church in New Mexico (Lots 5, 6, 7, 25, 26, 27 and 28; Proposed Tract B retained)
Date 10-11-2007

ACKNOWLEDGEMENT

STATE OF NEW MEXICO)
COUNTY OF BERNALILLO) SS
This instrument was acknowledged before me on this 11th day of October, 2007, by Jeffrey N. Steenson, President,
The Trustees of the Property of the Protestant Episcopal Church in New Mexico.
Debbie Leblanc Trullio
Notary Public

THIS IS TO CERTIFY THAT TAXES ARE CURRENT AND PAID IN FULL FOR THE YEAR OF RECORD.
FOR COUNTY OF BERNALILLO
FOR CITY OF ALBUQUERQUE
FOR BERNALILLO COUNTY HEALTH DEPARTMENT OFFICE
10-11-2007

TRACTS A, B AND C, HOPE PLAZA

PLAT OF

ALBUQUERQUE, BERNALILLO COUNTY, NEW MEXICO

OCTOBER, 2007

BOUNDARY TABLE

CURVE	RADIUS	LENGTH	CHORD	BEARING	DELTA
C1	1338.00'	304.46'	303.81'	S 83°08'26" E	13°02'16"
C2	1338.00'	85.46'	85.45'	S 74°47'31" E	03°39'35"
C11	1400.00'	389.16'	387.91'	S 81°41'46" E	15°55'36"

EASEMENT TABLES

LINE	DIRECTION	DISTANCE	EASEMENT
E1	S 0°24'26" W	36.02'	5
E2	S 0°24'26" W	27.44'	5
E3	S 0°24'26" W	53.47'	5
E4	S 0°24'26" W	6.01'	5
E5	N 89°37'18" W	33.00'	5
E6	N 0°24'26" E	6.03'	5
E7	S 0°24'26" W	53.00'	5
E8	N 89°38'30" W	38.54'	5
E9	N 02°41'03" E	25.07'	5
E10	N 02°41'03" E	27.48'	5
E11	N 10°41'05" W	42.29'	5
E12	N 0°24'26" E	43.92'	5
E13	S 89°38'34" E	17.68'	5
E14	S 0°24'26" W	13.01'	5
E15	N 0°24'26" E	13.01'	5
E16	S 0°24'26" E	13.00'	5
E17	N 0°24'26" E	13.00'	5
E18	S 89°33'50" E	24.00'	7
E19	N 89°38'30" W	34.73'	7
E20	N 02°41'03" E	25.07'	7

RECORD DRAWING

CURVE	RADIUS	LENGTH	CHORD BEARING	CHORD	DELTA	EASEMENT
EC1	1338.00'	45.11'	S 86°41'37" E	45.10'	07°55'53"	5
EC2	23.37'	5.81'	S 10°30'24" W	5.80'	14°15'09"	5
EC3	24.50'	38.48'	S 44°35'34" E	34.65'	90°00'00"	5
EC4	8.50'	13.38'	N 44°31'03" W	12.94'	90°10'13"	5
EC5	13.50'	21.20'	S 45°24'08" W	19.09'	86°59'25"	5
EC6	13.50'	21.20'	N 44°35'17" W	19.09'	86°59'25"	5
EC7	8.50'	13.35'	S 45°24'42" W	12.02'	90°00'37"	5
EC8	13.50'	21.21'	S 45°24'21" W	19.09'	90°00'10"	5
EC9	23.50'	13.99'	S 22°34'24" E	13.21'	32°38'22"	5
EC10	23.50'	16.27'	N 20°11'28" E	15.95'	39°40'11"	5
EC11	24.50'	38.48'	N 45°24'26" E	34.65'	90°00'00"	5
EC12	23.37'	20.74'	N 24°36'20" W	20.07'	50°51'17"	5
EC13	13.50'	21.21'	S 44°35'34" E	19.09'	90°00'00"	5
EC14	13.50'	21.21'	S 45°24'26" W	19.09'	90°00'00"	5
EC15	13.50'	21.21'	N 44°35'34" E	19.09'	90°00'00"	5
EC16	13.50'	21.21'	N 45°24'26" E	19.09'	90°00'00"	5
EC17	13.50'	21.21'	S 44°35'34" E	19.09'	90°00'00"	5
EC18	13.50'	21.21'	S 45°24'26" W	19.09'	90°00'00"	5
EC19	13.50'	21.21'	N 44°35'34" W	19.09'	90°00'00"	5
EC20	13.50'	21.21'	N 45°24'26" E	19.09'	90°00'00"	5
EC21	70.00'	89.36'	N 38°25'28" W	83.41'	75°08'25"	6
EC22	13.8000'	60.53'	S 74°15'29" E	60.52'	02°55'31"	6
EC23	25.00'	13.04'	S 21°11'45" E	12.88'	26°52'55"	7
EC24	25.00'	16.07'	N 18°49'04" E	15.79'	56°49'27"	7

DRB PROJECT NUMBER 1006520

APPLICATION NUMBER 07EPC-40001, 07EPC-40002

APPROVALS:

Andrew Gallek
DRB CHAIRPERSON, PLANNING DEPARTMENT, CITY OF ALBUQUERQUE, NEW MEXICO
DATE 1-9-08

Roger A. Sheen
ABQVIA
CITY ENGINEER, CITY OF ALBUQUERQUE, NEW MEXICO
DATE 11-28-07

Bill D. Day
CITY ENGINEER, CITY OF ALBUQUERQUE, NEW MEXICO
DATE 11-28-07

Shyne M. Mayne
A.M.A.T. C.A.
DATE 12-3-07

N.A.
REAL PROPERTY DIVISION, CITY OF ALBUQUERQUE, NEW MEXICO
DATE 11/28/07

Christina Santoral
TRAFFIC ENGINEERING, TRANSPORTATION DIVISION, CITY OF ALBUQUERQUE, NEW MEXICO
DATE 11/28/07

W. B. Bittell
PARKS AND RECREATION DEPARTMENT, CITY OF ALBUQUERQUE, NEW MEXICO
DATE 11/28/07

W. B. Bittell
CITY SURVEYOR, CITY OF ALBUQUERQUE, NEW MEXICO
DATE 10-12-07

N.A.
REAL PROPERTY DIVISION, CITY OF ALBUQUERQUE, NEW MEXICO
DATE 12/3/2007

Charles G. Cola, Jr.
P.N.M. ELECTRIC SERVICES
DATE 12/3/07

Charles G. Cola, Jr.
QWEST TELECOMMUNICATIONS
DATE 12/3/07

Charles G. Cola, Jr.
P.N.M. GAS SERVICES
DATE 12/3/2007

James P. Carlson
COMCAST CABLE VISION OF NEW MEXICO, INC.
DATE 11-30-07

SURVEYORS CERTIFICATION

I, Charles G. Cola, Jr., New Mexico Professional Surveyor No. 11184, do hereby certify: that this Plat and the actual survey on the ground upon which it is based were performed by me or under my direct supervision; that the survey shows all easements made known to me by this owner, utility companies, or other parties expressing an interest; that this survey complies with the minimum requirements for Monumentation and Surveys of the Albuquerque Subdivision Ordinance; that this survey meets the Minimum Standards for Surveying in New Mexico, and that it is true and correct to the best of my knowledge and belief.

Charles G. Cola, Jr.
Charles G. Cola, Jr., N.M.P.S. 1184
Date 10-11-2007
11/10/07
11/22/07

HIGH MESA Consulting Group
FORNEY, JEFFERSON AND ASSOCIATES, INC.
4010-B MIDWAY PARK BLVD. NE • ALBUQUERQUE, NEW MEXICO 87109
PHONE: 505.346.4250 • FAX: 505.346.4254 • www.highmesa-g.com
JOB #2006.047.4 PLAT

COUNTY CLERK FILING DATA

KEYED NOTES

EXISTING EASEMENT

① APPROXIMATE LOCATION OF A PRIVATE DRAINAGE EASEMENT SERVING FORMER LOTS 29-32, BLOCK 4, NORTH ALBUQUERQUE ACRES, TRACT 3, UNIT 3, NOW PLATTED AS LOTS 1-20, TIERRA MORENA, GRANTED BY DOCUMENT FILED 06-09-2004, BOOK A79, PAGE 278, DOC. #2004080490, RECORDS OF BERNALILLO COUNTY.

VACATED EASEMENTS

② THE NONSPECIFIC EASEMENTS AND/OR RIGHT-OF-WAYS FOR ROAD AND/OR PIPELINE PURPOSES (WATER, GAS OR SEWAGE), TELEPHONE AND ELECTRICAL ENERGY AFFECTING THE PROPERTIES PLATTED HEREON, GRANTED BY THE FOLLOWING DOCUMENTS: BOOK 124, PAGE 463, (LOTS 6 & 7, BLOCK 4) BOOK D74, PAGE 109, (LOT 8, BLOCK 4), RECORDS OF BERNALILLO COUNTY, NEW MEXICO VACATED BY 07DRB-70360

③ TEMPORARY PUBLIC DRAINAGE EASEMENT GRANTED BY DOCUMENT FILED 08-26-2005, BOOK A102, PAGE 4978, DOC. #2005125347, RECORDS OF BERNALILLO COUNTY, NEW MEXICO VACATED BY 07DRB-70360

NEW EASEMENTS

④ 10' PUBLIC UTILITY EASEMENT GRANTED BY THIS PLAT

⑤ PRIVATE ACCESS EASEMENT GRANTED BY THIS PLAT TO SERVE TRACTS A AND B. MAINTENANCE AND OPERATION OF THIS EASEMENT SHALL BE IN ACCORDANCE WITH THE HOPE PLAZA OWNER'S AGREEMENT FILED 01-23-2008 DOCUMENT NO. 2008020394

⑥ PUBLIC DRAINAGE EASEMENT GRANTED BY THIS PLAT TO SERVE THE CITY OF ALBUQUERQUE

⑦ PRIVATE DRAINAGE EASEMENT GRANTED BY THIS PLAT TO SERVE TRACT A. MAINTENANCE AND OPERATION OF THIS EASEMENT SHALL BE IN ACCORDANCE WITH THE HOPE PLAZA OWNER'S AGREEMENT FILED 01-23-2008 DOCUMENT NO. 2008020394

ACCESS CONTROL

⑧ DIRECT VEHICULAR ACCESS TO TRACT C IS NOT PERMITTED FROM ALAMEDA BOULEVARD N.E. OR FROM TRACTS A AND B, HOPE PLAZA. ACCESS EASEMENT TO ALAMEDA BOULEVARD N.E. SHALL BE GRANTED ACROSS LOT 9, BLOCK 4, NORTH ALBUQUERQUE ACRES, TRACT 3, UNIT 3 BY SEPARATE DOCUMENT.

EASEMENT - OFFSITE

⑨ PUBLIC ROADWAY EASEMENT GRANTED BY PLAT 2007C-111

⑩ PUBLIC ROADWAY EASEMENT GRANTED BY PLAT 2007C-111

MONUMENTS

⑪ FOUND #4 REBAR W/CAP STAMPED "NMPS 8127", TAGGED W/WASHER STAMPED "NMPS 11184"

⑫ FOUND #4 REBAR, NO I.D., TAGGED W/WASHER STAMPED "NMPS 11184"

⑬ FOUND #1 REBAR, NO I.D., TAGGED W/WASHER STAMPED "NMPS 11184"

⑭ FOUND #5 REBAR W/CAP STAMPED "LS 7719, TAGGED W/WASHER STAMPED "NMPS 11184"

⑮ FOUND #5 REBAR, NO I.D., (USED FOR NORTH R.O.W. LINE ONLY)

⑯ FOUND ALUMINUM CAP STAMPED "PLS 4972"

⑰ FOUND #5 REBAR W/CAP STAMPED "LS 9801", TAGGED W/WASHER STAMPED "NMPS 11184"


⑱ SET #5 REBAR W/CAP STAMPED "NEW MEXICO PS 11184"

⑲ SET P.K. NAIL W/WASHER STAMPED "NMPS 11184" ON TOP OF WALL


⑳ FOUND AMAFCA BRASS CAP

㉑ SET #5 REBAR W/CAP STAMPED "NEW MEXICO PS 11184"




TRACTS A, B AND C, HOPE PLAZA
ALBUQUERQUE, BERNALILLO COUNTY, NEW MEXICO
OCTOBER, 2007

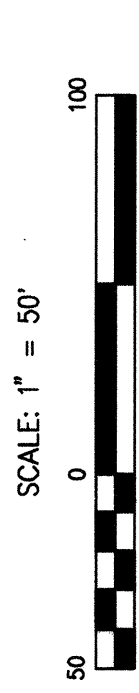


NOTE: FOR EASEMENT ANNOTATIONS SEE SHEET 4 OF 4

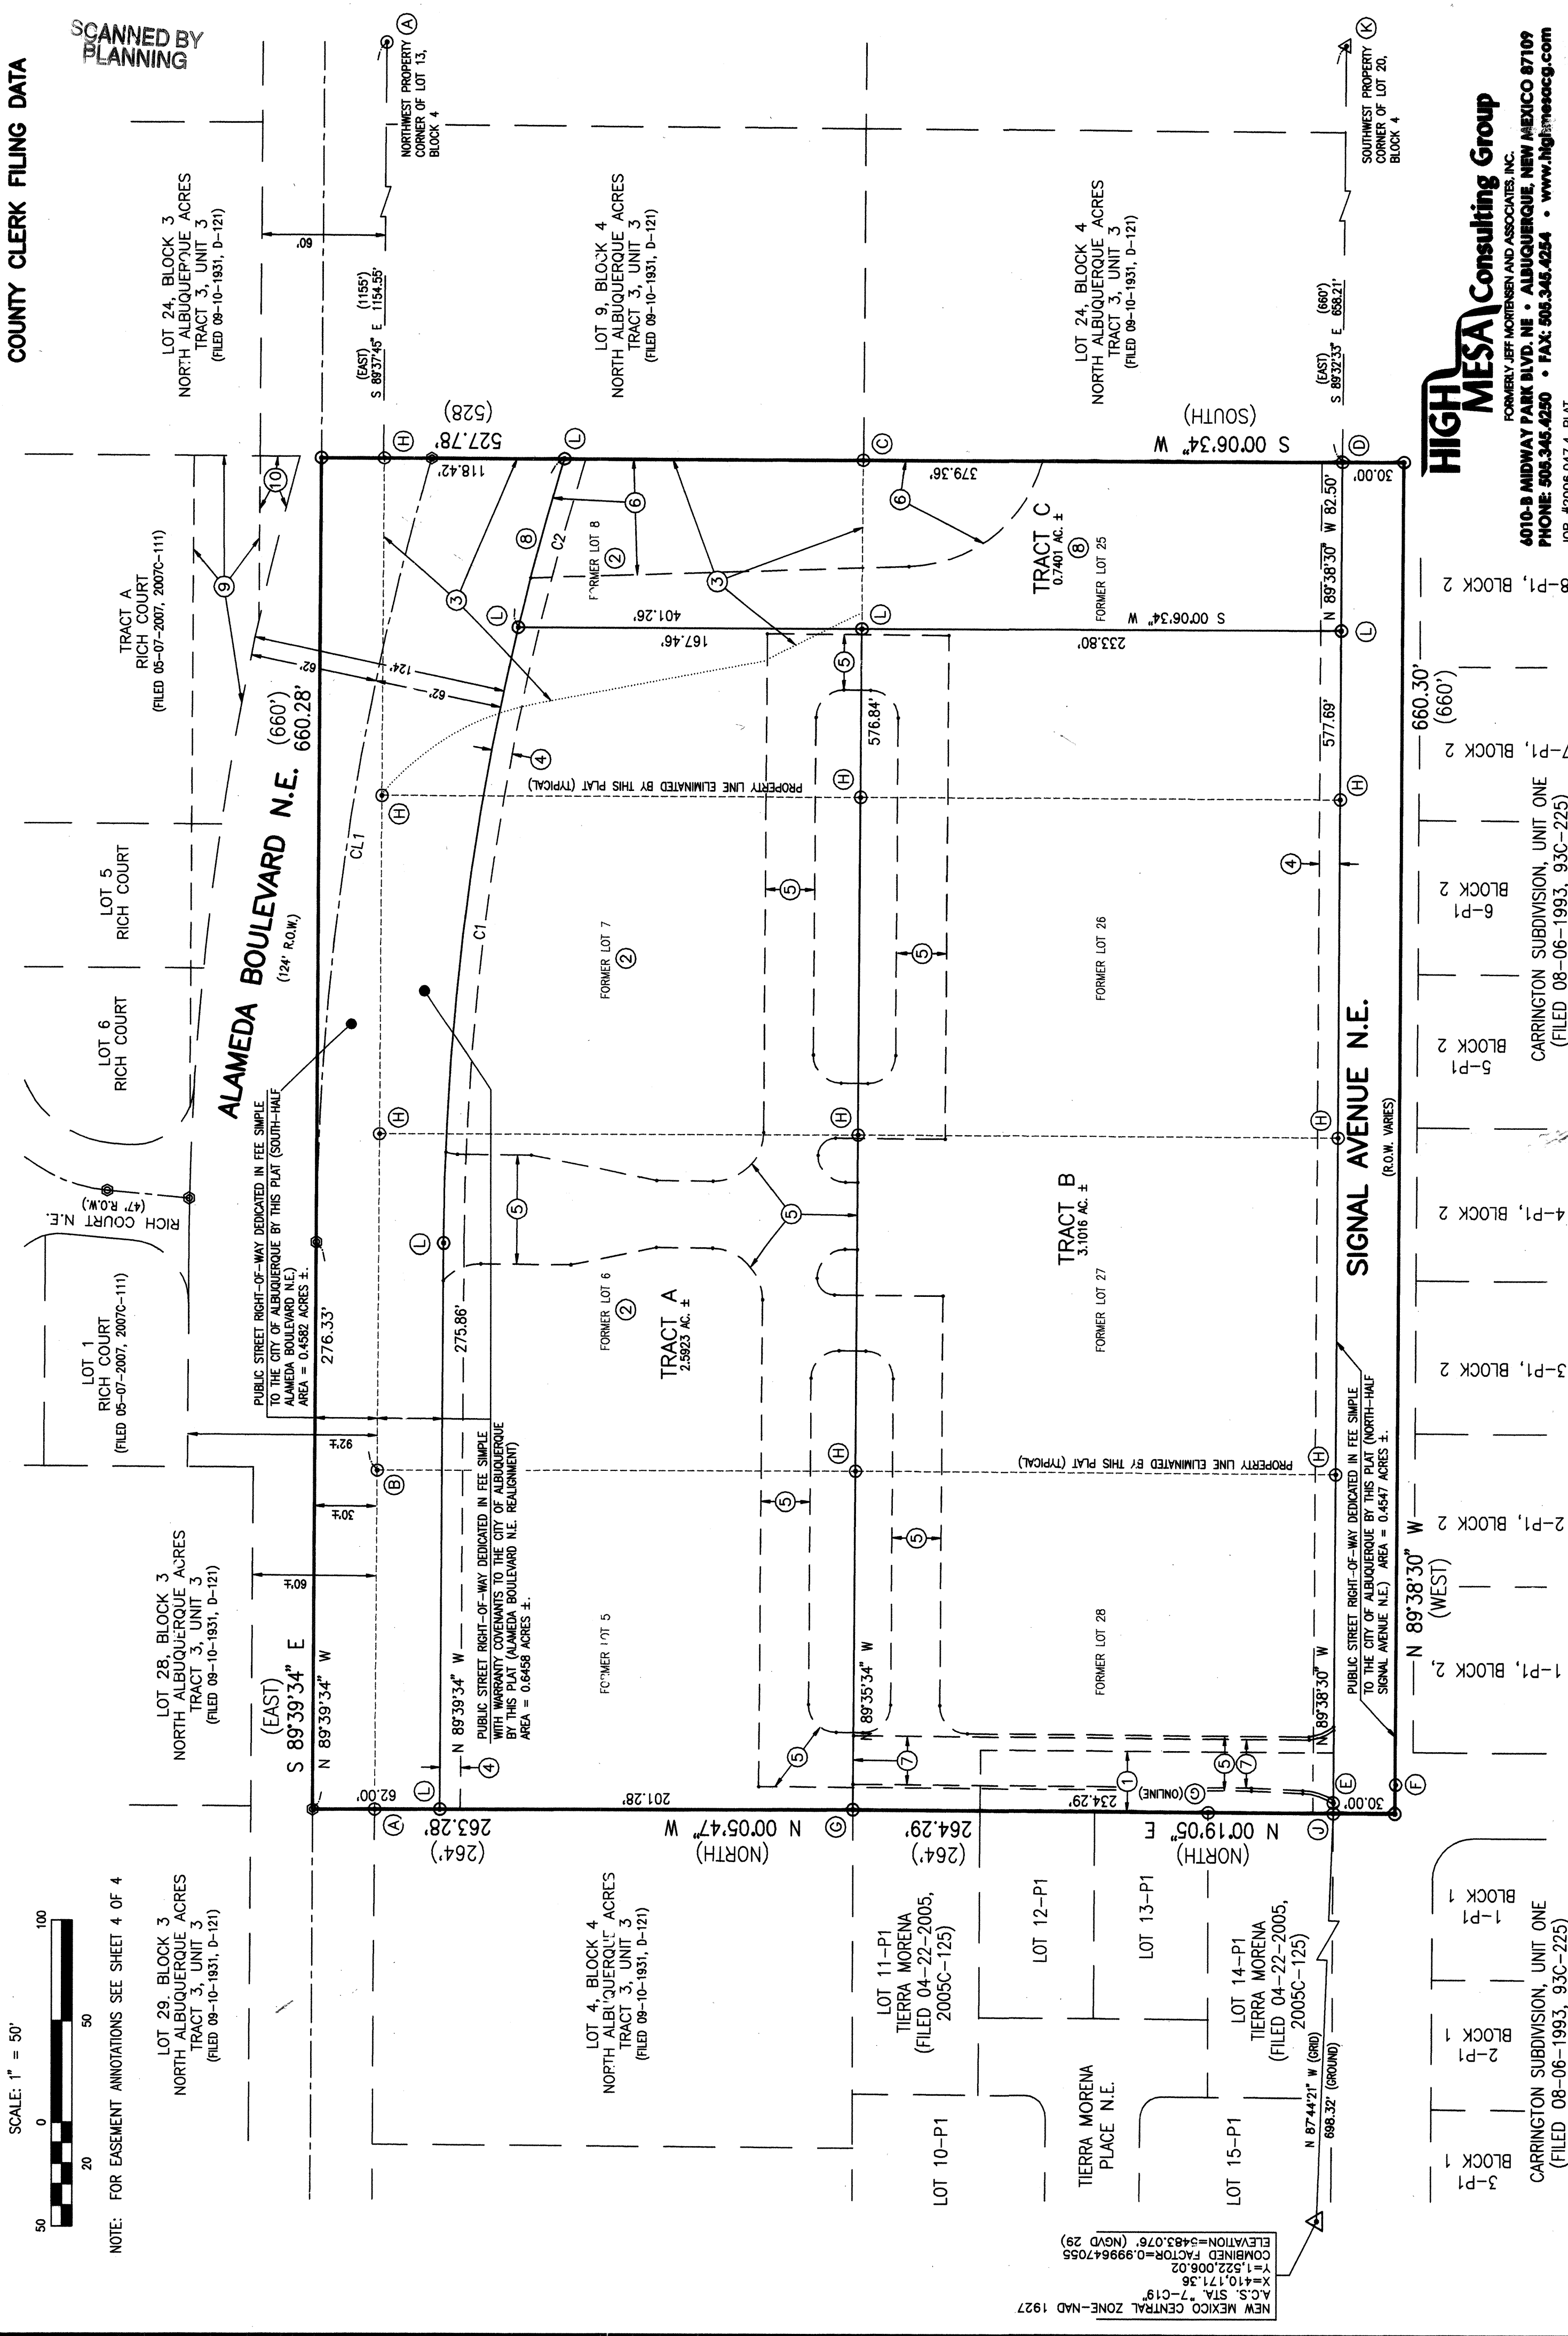

TRACTS A, B AND C, HOPE PLAZA
ALBUQUERQUE, BERNALILLO COUNTY, NEW MEXICO
OCTOBER, 2007

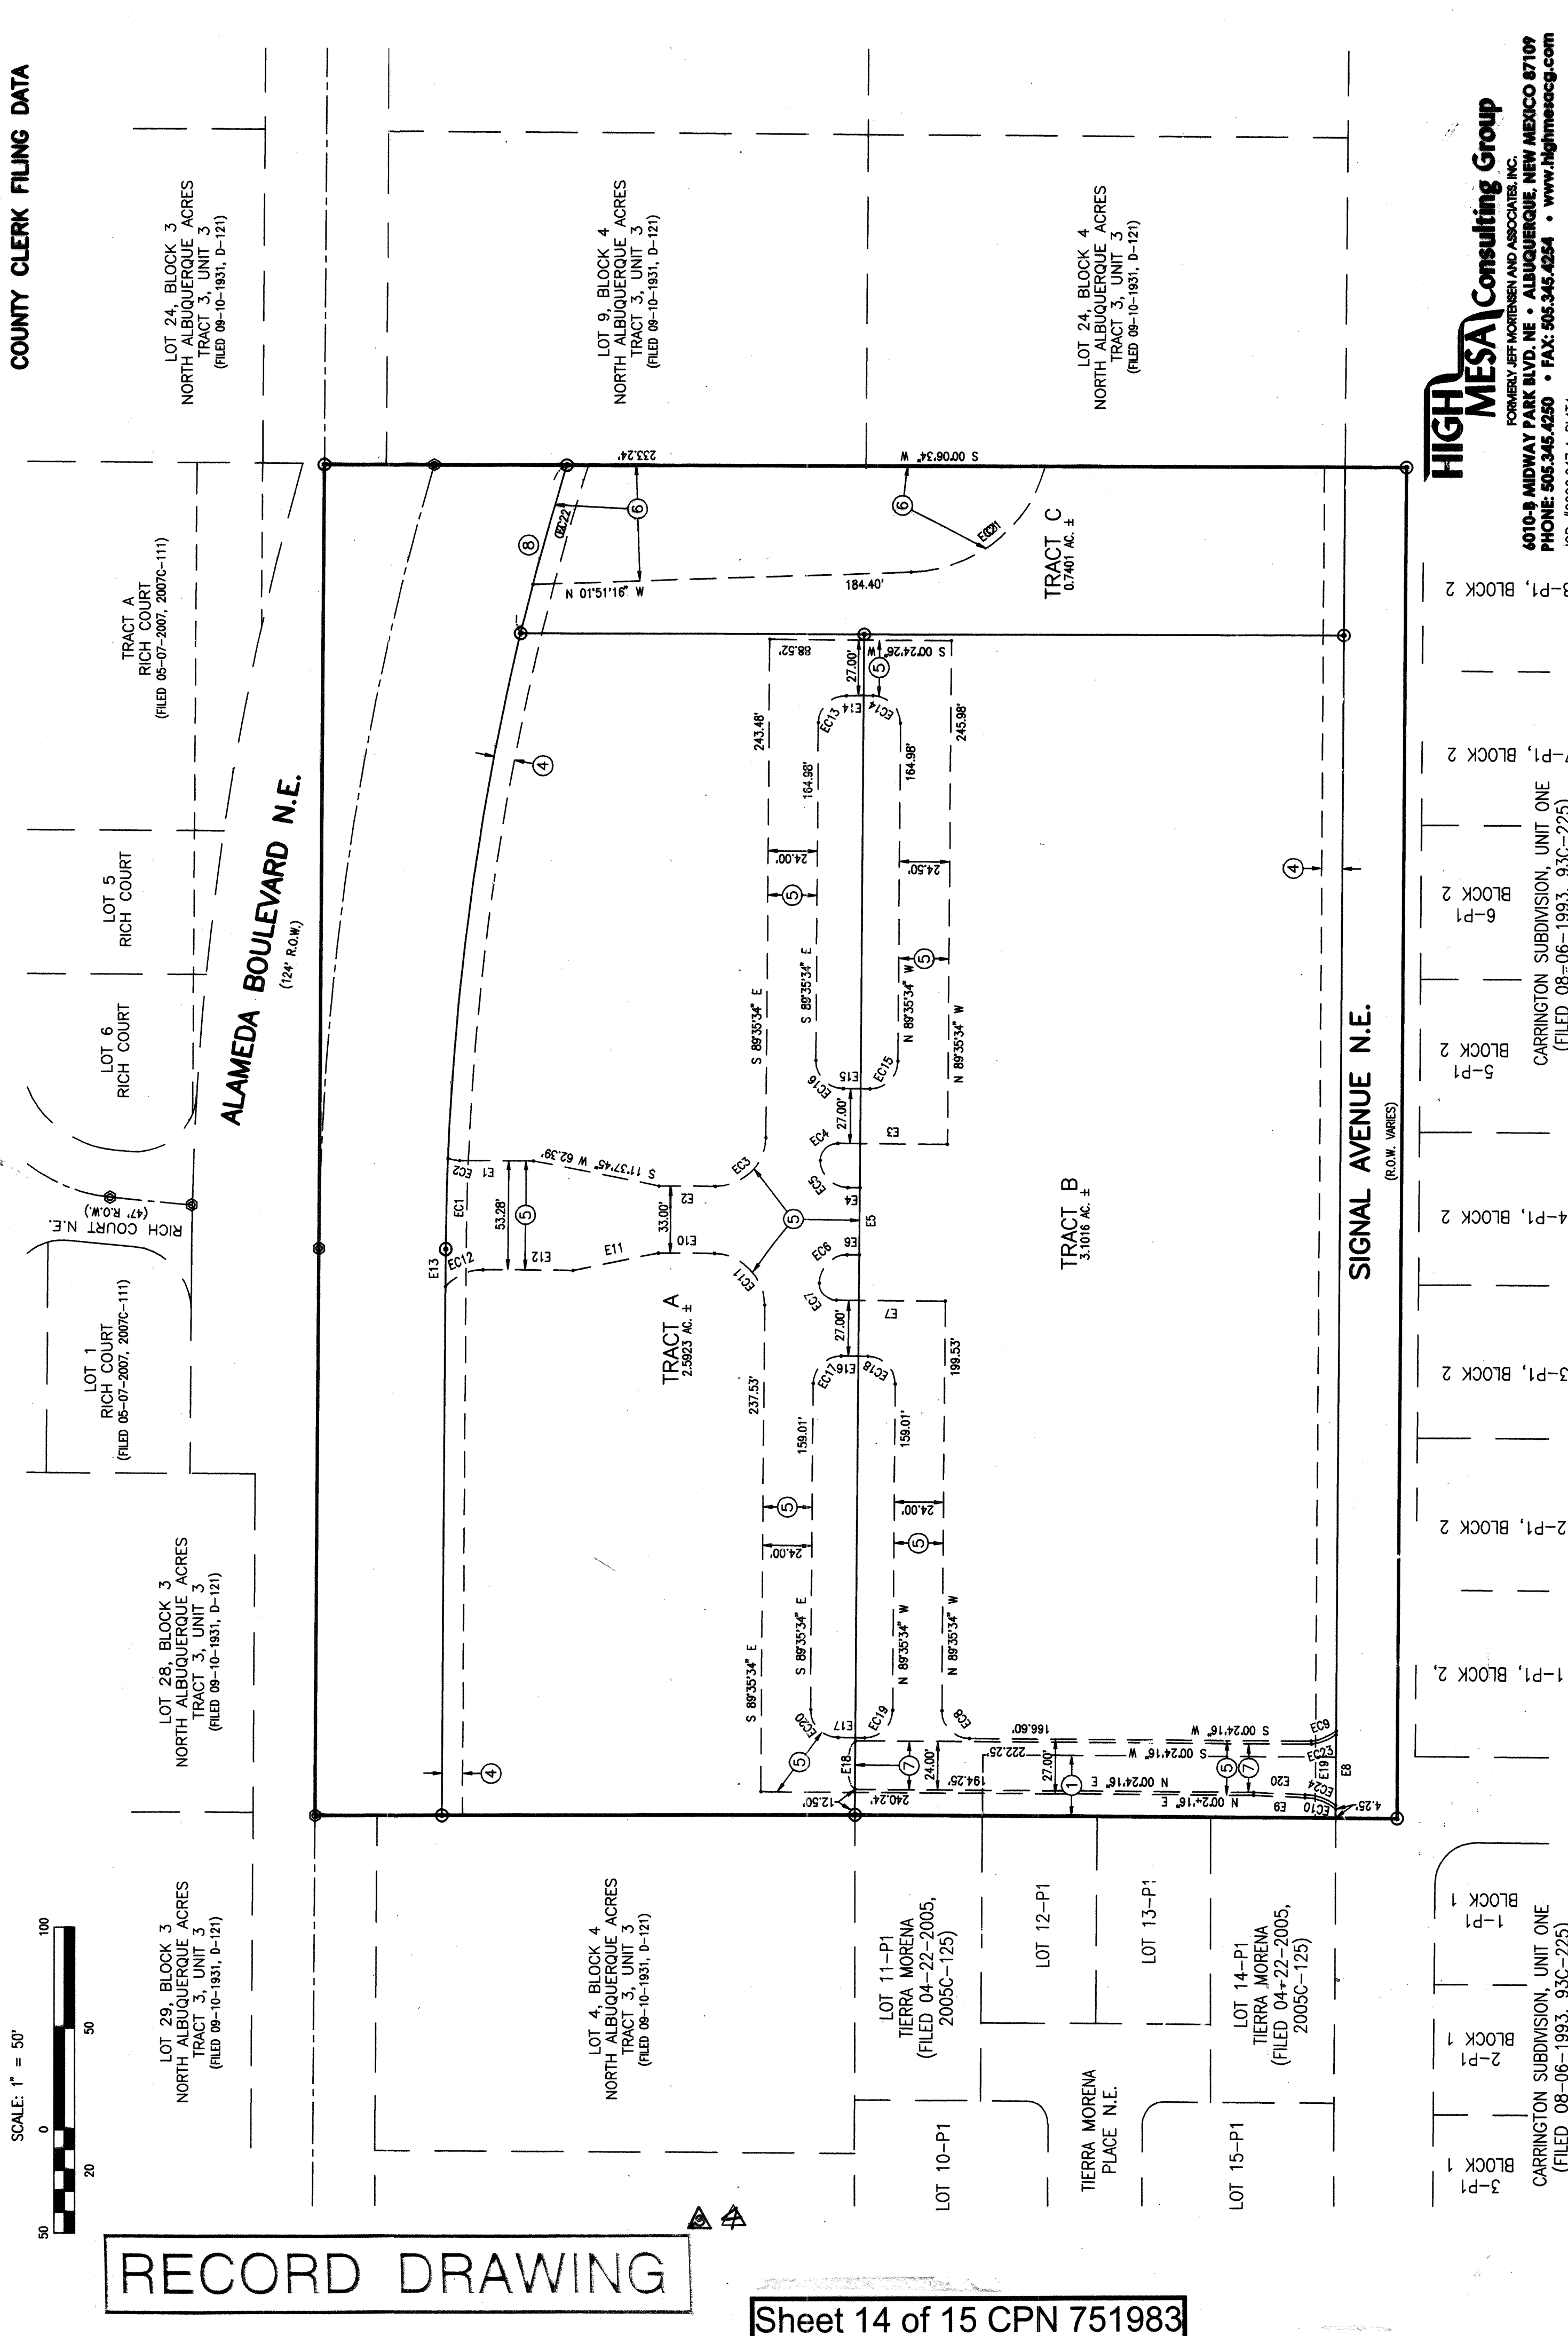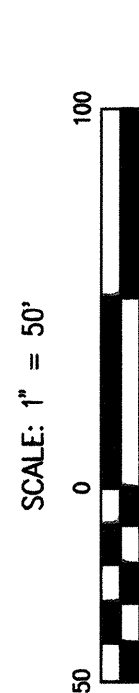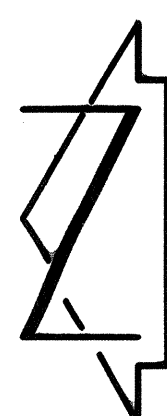

RECORD DRAWING

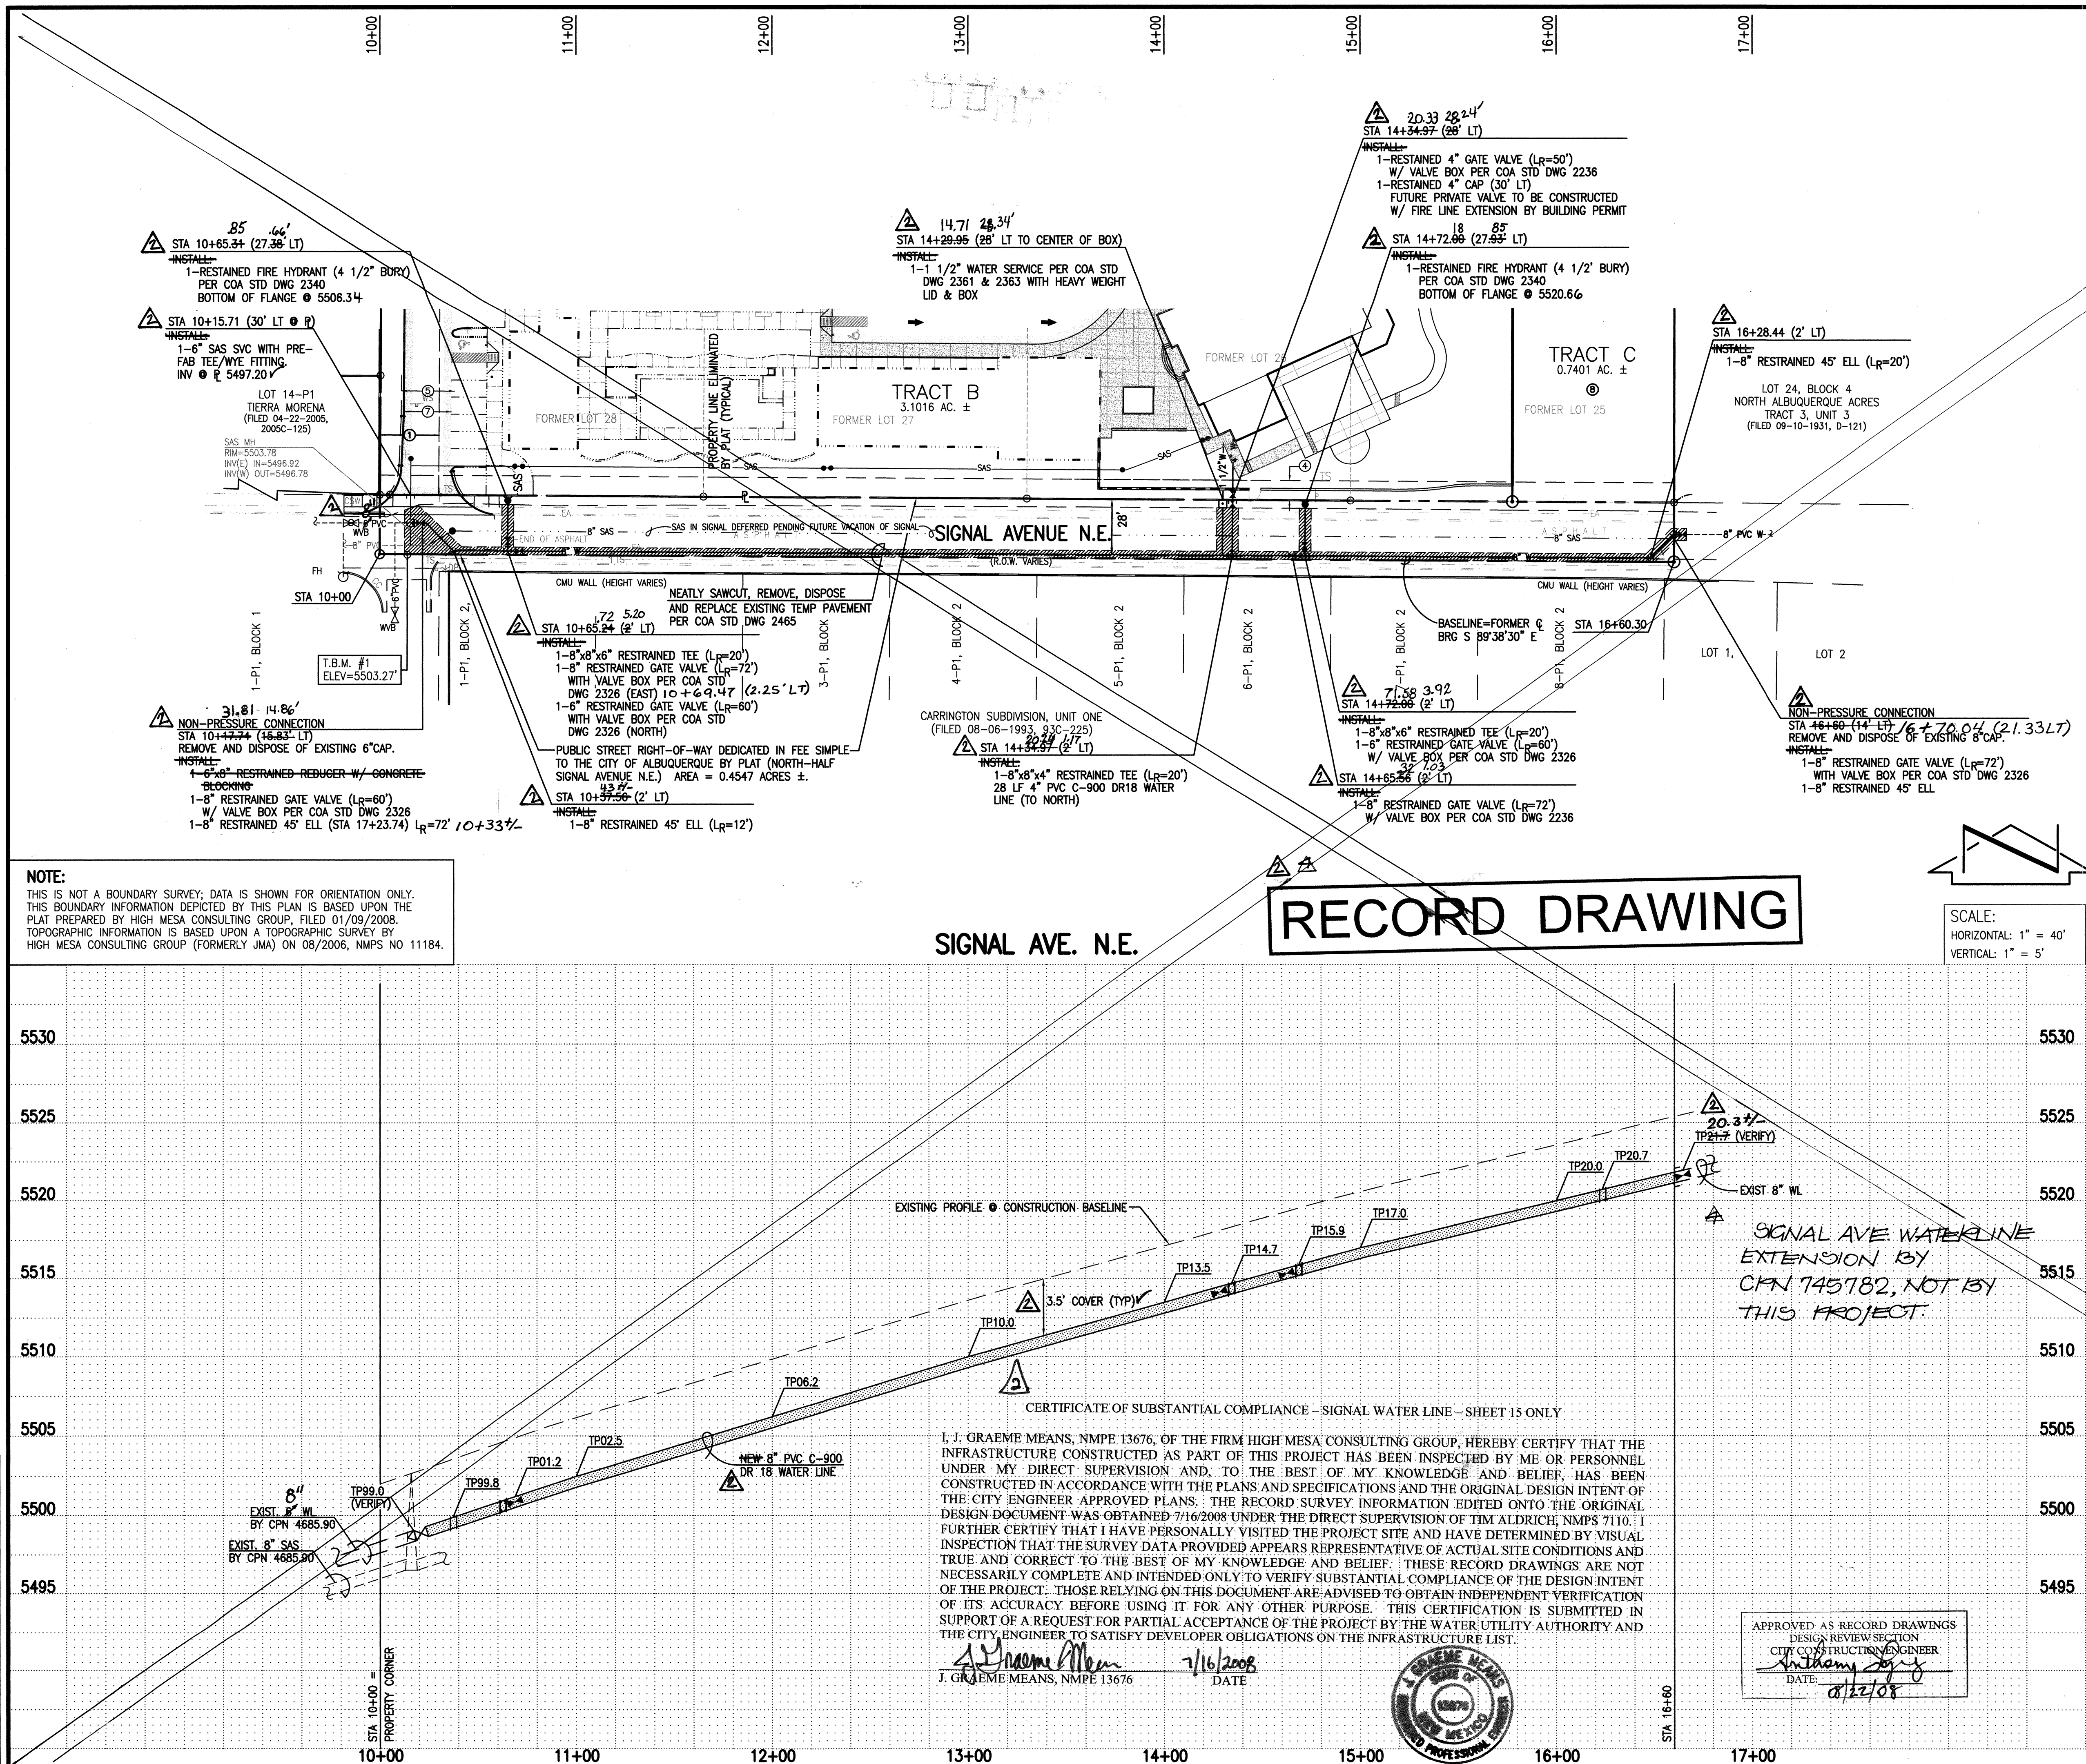

WATER LINE CONSTRUCTION NOTES:

- ALL STATIONING IS BASED ON STREET CENTERLINE UNLESS INDICATED OTHERWISE.
- FOR ALL LINES 12" AND SMALLER, WATER MAIN SHALL BE PVC C-900 DR18 PIPE OR AS APPROVED BY ABCWUA. DUCTILE IRON IS AN ACCEPTABLE PIPE MATERIAL IN LIEU OF PVC.
- FOR ALL LINES 14" AND LARGER, WATER MAIN SHALL BE DUCTILE IRON OR PVC C-905 OR AS APPROVED BY ABCWUA. CONCRETE CULVERT IS AN ACCEPTABLE PIPE MATERIAL IN LIEU OF DUCTILE IRON.
- WATER LINE SHALL HAVE A MINIMUM COVER OF 3'-0" (FINISHED GRADE TO TOP OF PIPE) FOR ALL LINES 12" OR SMALLER; 4'-0" MINIMUM COVER FOR LINES 14" OR LARGER. EXTRA DEPTH TRENCHING, IF REQUIRED, SHALL BE CONSIDERED INCIDENTAL TO CONSTRUCTION, THEREFORE, NO SEPARATE PAYMENT WILL BE MADE.
- ELECTRONIC MARKER DISCS (EMD) SHALL BE INSTALLED IN ACCORDANCE WITH THE STANDARD SPECIFICATION, SECTION 170.
- IN ACCORDANCE WITH SECTION 801 OF THE "STANDARD SPECIFICATIONS", METALIZED DETECTABLE WARNING TAPE SHALL BE INSTALLED 18" ABOVE ALL PVC PIPE INSTALLED ON THIS PROJECT.
- VALVE STEM AND FIRE HYDRANT EXTENSIONS SHALL BE PROVIDED IN ACCORDANCE WITH THE STANDARD SPECIFICATIONS. THE COST OF EACH EXTENSION SHALL BE CONSIDERED INCIDENTAL TO CONSTRUCTION THEREFORE NO SEPARATE PAYMENT WILL BE MADE.
- JOINT RESTRAINT SHALL BE CONSIDERED INCIDENTAL TO WATER LINE CONSTRUCTION THEREFORE NO SEPARATE PAYMENT WILL BE MADE.
- JOINT RESTRAINT SHALL BE PROVIDED ON ALL JOINTS OF FIRE HYDRANT LEGS FROM TEE TO FIRE HYDRANT INCLUDING THE TEE AND FIRE HYDRANT.
- FOR THE PURPOSES OF THIS PROJECT, ALL RESTRAINED JOINTS AND JOINT RESTRAINT SHALL BE MECHANICALLY RESTRAINED. JOINT RESTRAINT LENGTHS SPECIFIED HEREON ARE THE LENGTHS TO BE RESTRAINED EACH SIDE OF THE FITTING.
- THE CONTRACTOR SHALL BE RESPONSIBLE FOR SELECTING APPROPRIATE MEANS AND METHODS TO EXCAVATE AND TRENCH AND INSTALL PIPE SO AS TO NOT EXCEED RIGHT-OF-WAY OR EASEMENT LIMITS, AND SO AS NOT TO INTERFERE WITH OTHER UTILITIES. THIS SHALL BE CONSIDERED INCIDENTAL TO TRENCHING, THEREFORE, NO SEPARATE PAYMENT WILL BE MADE.
- THE CONTRACTOR SHALL BE RESPONSIBLE FOR PROTECTING, SUPPORTING AND REPLACING, IF DAMAGED, ALL OTHER UTILITIES ENCOUNTERED DURING CONSTRUCTION. THIS SHALL BE CONSIDERED INCIDENTAL TO TRENCHING, THEREFORE, NO SEPARATE PAYMENT WILL BE MADE.
- WHERE WATER AND SANITARY SEWER LINES CROSS, THE SANITARY SEWER LINE SHALL BE INSTALLED AS PRESSURE PIPE BETWEEN MANHOLES IF 18 INCHES OF VERTICAL SEPARATION DOES NOT EXIST.
- ALL FIRE HYDRANTS SHALL BE SECURELY WRAPPED IN BLACK PLASTIC UNTIL SUCH TIME AS THE NEW WATER LINE IS PUT INTO SERVICE BY ABCWUA PERSONNEL.

KEYED NOTES

EXISTING EASEMENT

- APPROXIMATE LOCATION OF A PRIVATE DRAINAGE EASEMENT SERVING FORMER LOTS 29-32, BLOCK 4, NORTH ALBUQUERQUE ACRES, TRACT 3, UNIT 3, NOW PLATTED AS LOTS 1-20, TIERRA MORENA, GRANTED BY DOCUMENT FILED 06-09-2004, BOOK A79, PAGE 278, DOC. #2004080490, RECORDS OF BERNALILLO COUNTY.

NEW EASEMENTS

- 10' PUBLIC UTILITY EASEMENT GRANTED BY PLAT 2008C-6
- PRIVATE ACCESS EASEMENT GRANTED BY PLAT TO SERVE TRACTS A AND B. MAINTENANCE AND OPERATION OF THIS EASEMENT SHALL BE IN ACCORDANCE WITH THE HOPE PLAZA OWNER'S AGREEMENT FILED 01-09-2008, DOCUMENT NO. 2008002904.
- PRIVATE DRAINAGE EASEMENT GRANTED BY PLAT TO SERVE TRACT A. MAINTENANCE AND OPERATION OF THIS EASEMENT SHALL BE IN ACCORDANCE WITH THE HOPE PLAZA OWNER'S AGREEMENT FILED 01-09-2008, DOCUMENT NO. 2008002904.

ACCESS CONTROL

- DIRECT VEHICULAR ACCESS TO TRACT C IS NOT PERMITTED FROM ALAMEDA BOULEVARD N.E. OR FROM TRACTS A AND B, HOPE PLAZA. ACCESS EASEMENT TO ALAMEDA BOULEVARD N.E. SHALL BE GRANTED ACROSS LOT 9, BLOCK 4, NORTH ALBUQUERQUE ACRES, TRACT 3, UNIT 3 BY SEPARATE DOCUMENT.

ENGINEER'S SEAL

REVISIONS

NO.	DATE	REVISIONS
1	05/08	Record Drawing for Construction
2	06/08	RECORD DRAWING

DESIGNED BY G.M. **DATE** 02-08
DRAWN BY C.F.A./B.L.E. **DATE** 02-08
CHECKED BY G.M. **DATE** 02-08

HIGH MESA Consulting Group
FORMERLY JEFF MORTENSEN AND ASSOCIATES, INC.
6010-B MIDWAY PARK BLVD. NE • ALBUQUERQUE, NEW MEXICO 87109
PHONE: 505.345.4250 • FAX: 505.345.4254 • www.highmesacg.com

2005.070.1 2010.035.1

CITY OF ALBUQUERQUE
PUBLIC WORKS DEPARTMENT
ENGINEERING DEVELOPMENT GROUP

TITLE: SIGNAL AVENUE NE WATER LINE EXTENSION
PUBLIC WATER LINE PLAN AND PROFILE STA 10+00 TO STA 16+60.22
RICH COURT

APPROVED
DESIGN REVIEW COMMITTEE
JUN 02 2008

APPROVED
CITY ENGINEER
JUN 02 2008

City Project No. 751983 Zone Map No. C-20 Sheet 15 of 15