

SCANNED BY
PLANNING

2 3 4 5 6 7 8 9 10 11 12 13 14 15
20-73311-07


WAL-MART NEIGHBORHOOD MARKET #3317-00

STORM SEWER AND WATER LINE IMPROVEMENTS

CITY OF ALBUQUERQUE
NEW MEXICO
OCTOBER 2004

CERTIFICATE OF SUBSTANTIAL COMPLIANCE ON PLANS

I, Ronald R. Bohannon, of the firm of Tierra West LLC, a Registered Professional Engineer in the State of New Mexico, do hereby certify, to the best of my knowledge and belief, that the infrastructure installed as part of this project has been inspected by me or by a qualified person under my direct supervision and has been constructed in accordance with the plans and specifications approved by the City Engineer and that the original design intent of the approved plans has been met, except as noted by me on the as-built construction drawings. This Certification is based on site inspections by me, or personnel under my direction with survey information provided by J.J. Bordenave, of Baseline Field Services, NMPS number 8100 807.

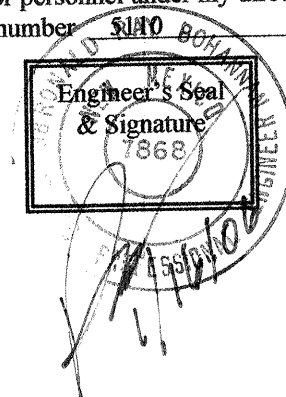


JB

INDEX TO DRAWINGS


1. CITY OF ALBUQUERQUE DEVELOPMENT REVIEW COMMITTEE TITLE SHEET
2. PLAT
3. AMENDED SITE PLAN FOR BUILDING PERMIT
4. GRADING AND DRAINAGE PLAN
5. MASTER UTILITY PLAN
- 5A. MASTER UTILITY PLAN
6. STORM SEWER PLAN
7. STORM SEWER PLAN
8. STRUCTURE DETAILS
9. STRUCTURE DETAILS

APPROVED FOR CONSTRUCTION *Stephen M. Mays* 3-2-05
AMAFCA DATE

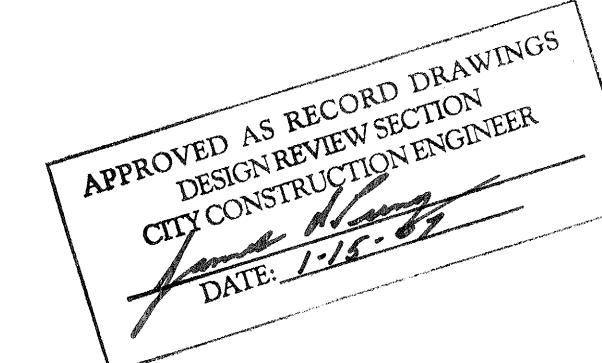


DRB #1000464

TIERRA WEST, LLC
8509 JEFFERSON NE
ALBUQUERQUE, NEW MEXICO 87113
(505)858-3100

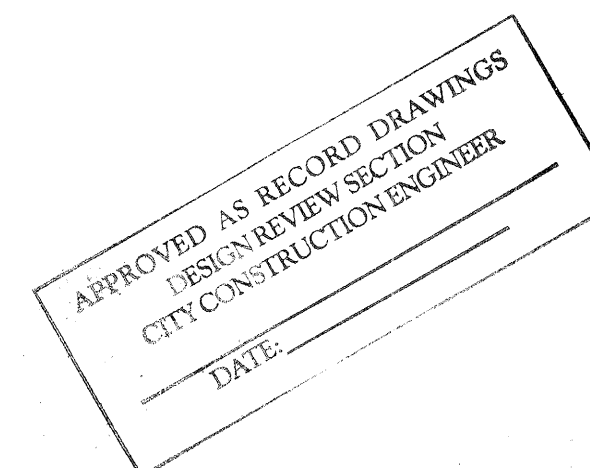

REV	SHEETS	CITY ENGINEER	DATE	USER	DEPT.	DATE	USER	DEPT.	DATE
1	7A-7B	Bradley J. Bingham	11/21/05	Bradley J. Bingham		11/21/05			
2	7A-7B	Bradley J. Bingham	11/21/05	Bradley J. Bingham		11/21/05			
3	7A-7B	Bradley J. Bingham	11/21/05	Bradley J. Bingham		11/21/05			
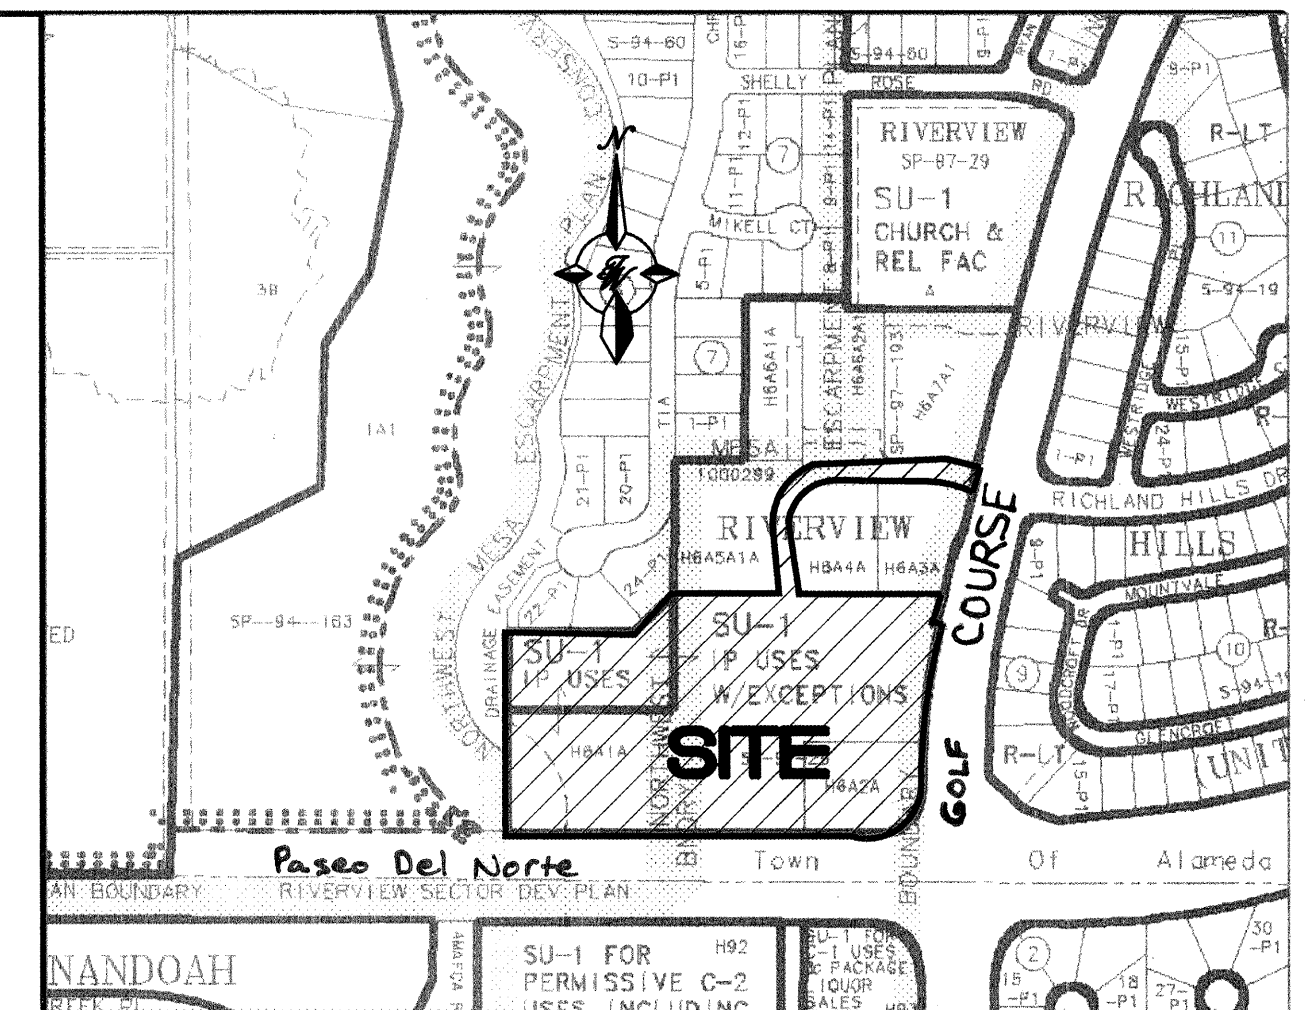

VICINITY MAP C-12-Z

NOTICE TO CONTRACTORS SCALE NONE

1. ALL WORK DETAILED ON THESE PLANS TO BE PERFORMED UNDER CONTRACT SHALL, EXCEPT AS OTHERWISE STATED OR PROVIDED FOR HEREON, BE CONSTRUCTED IN ACCORDANCE WITH THE CITY OF ALBUQUERQUE STANDARD SPECIFICATIONS FOR PUBLIC WORKS CONSTRUCTION, 1986 EDITION (UPDATE #7)
2. TWO WORKING DAYS PRIOR TO ANY EXCAVATION, THE CONTRACTOR MUST CONTACT NEW MEXICO ONE CALL SYSTEM (260-1990) FOR LOCATION OF EXISTING UTILITIES.
3. ANY WORK AFFECTING AN ARTERIAL ROADWAY REQUIRES 24-HOUR CONSTRUCTION.
4. PRIOR TO CONSTRUCTION, THE CONTRACTOR SHALL EXCAVATE AND VERIFY THE HORIZONTAL AND VERTICAL LOCATIONS OF ALL OBSTRUCTIONS. SHOULD A CONFLICT EXIST, THE CONTRACTOR SHALL NOTIFY THE ENGINEER OR SURVEYOR IMMEDIATELY SO THAT THE CONFLICT CAN BE RESOLVED WITH A MINIMUM AMOUNT OF DELAY.
5. SEVEN (7) WORKING DAYS PRIOR TO BEGINNING OF CONSTRUCTION, THE CONTRACTOR SHALL SUBMIT TO CONSTRUCTION COORDINATIONS DIVISION A DETAILED CONSTRUCTION SCHEDULE. TWO(2) WORKING DAYS PRIOR TO CONSTRUCTION, THE CONTRACTOR SHALL OBTAIN A BARRICADING PERMIT FROM THE CONST. COORDINATION DIVISION. CONTRACTOR SHALL NOTIFY BARRICADE ENGINEER (924-3400) PRIOR TO OCCUPYING AN INTERSECTION. REFER TO STANDARD SPECIFICATIONS.
6. ALL STREET STRIPING ALTERED OR DESTROYED SHALL BE REPLACED WITH PLASTIC REFLECTORIZED PAVEMENT MARKINGS BY THE CONTRACTOR TO LOCATION AS EXISTING OR AS INDICATED BY THIS PLAN SET.
7. CONTRACTOR SHALL NOTIFY THE ENGINEER NOT LESS THAN SEVEN (7) DAYS PRIOR TO STARTING WORK IN ORDER THAT THE ENGINEER MAY TAKE NECESSARY MEASURES TO INSURE THE PRESERVATION OF SURVEY MONUMENTS. CONTRACTOR SHALL NOT DISTURB PERMANENT SURVEY MONUMENTS WITHOUT THE CONSENT OF THE ENGINEER AND SHALL NOTIFY THE ENGINEER AND BEAR THE EXPENSE OF REPLACING ANY THAT MAY BE DISTURBED WITHOUT PERMISSION. REPLACEMENT SHALL BE DONE ONLY BY THE CITY SURVEYOR. WHEN A CHANGE IS MADE IN THE FINISHED ELEVATIONS OF THE PAVEMENT OF ANY ROADWAY IN WHICH A PERMANENT SURVEY MONUMENT IS LOCATED, CONTRACTOR SHALL, AT HIS OWN EXPENSE, ADJUST THE MONUMENT COVER TO THE NEW GRADE UNLESS OTHERWISE SPECIFIED. REFER TO SECTION 4.4 OF THE GENERAL CONDITIONS OF THE STANDARD SPECIFICATIONS. ANY PERMANENT SURVEY MONUMENT LOCATED WITHIN 50' OF THIS PROJECT THAT IS NOT SHOWN ON THE PLAN AND IS DESTROYED DURING CONSTRUCTION WILL BE REPLACED AT THE DESIGNERS EXPENSE.
8. CONTRACTOR SHALL MAINTAIN A GRAFFITI-FREE WORK SITE. CONTRACTOR SHALL PROMPTLY REMOVE ANY AND ALL GRAFFITI FROM EQUIPMENT, WHETHER PERMANENT OR TEMPORARY.
9. FOR STORM DRAIN CONSTRUCTION, RCP PIPE JOINTS SHALL NOT BE GROUTED PRIOR TO FINAL INSPECTION. FINAL INSPECTION WILL DETERMINE JOINTS TO BE GROUTED FOR FINAL ACCEPTANCE OF THE CONSTRUCTION.
10. ALL UTILITY WORK SHALL BE CONSTRUCTED IN ACCORDANCE WITH NEW MEXICO UTILITIES, INC. SPECIFICATIONS FOR WATER AND WASTEWATER FACILITIES (MOST RECENT REVISIONS).
11. THE CONTRACTOR SHALL NOTIFY NEW MEXICO UTILITIES (898-2881) THREE(3) WORKING DAYS PRIOR TO BEGINNING THE CONSTRUCTION OF THE UTILITIES.

- THE FOLLOWING NOTES ALSO APPLY WHEN CHECKED
- ☒ ALL UTILITIES AND UTILITY SERVICE LINES SHALL BE INSTALLED PRIOR TO PAVING.
 - ☒ BACKFILL COMPACTION SHALL BE ACCORDING TO SPECIFIED STREET USE.
 - ☒ SIDEWALKS AND WHEELCHAIR RAMPS WITHIN THE CURB RETURNS SHALL BE CONSTRUCTED WHEREVER A NEW CURB RETURN IS CONSTRUCTED.
 - ☐ IF CURB IS DEPRESSED FOR A DRIVEPAD, THE DRIVEPAD SHALL BE CONSTRUCTED PRIOR TO ACCEPTANCE OF CURB AND GUTTER.
 - ☒ ALL STORM DRAINAGE FACILITIES SHALL BE COMPLETED PRIOR TO FINAL ACCEPTANCE.



753181 SHEET 1 OF 9
4 OF 27

CONDITIONS

- THE FOLLOWING PUBLIC WORKS CONDITIONS SHALL BE MET BEFORE FINAL DRB SIGN OFF:
 - INCLUSION OF A NOTE ON THE SITE PLAN WHICH STATES THAT DIRECT ACCESS ONTO PASEO DEL NORTE IS PROHIBITED.
 - CONSTRUCTION OF REQUIRED PAVEMENT, MEDIAN, CURBS, GUTTERS AND 6 FOOT SIDEWALK ON PASEO DEL NORTE.
 - PROVISION OF A 30 FOOT UNOBSTRUCTED SERVICE DRIVE FOR LARGE VEHICLES FROM THE STREET ENTRANCE TO LOADING DOCK AREAS. CONSTRUCTION OF 25 FOOT CORNER RADI ARE REQUIRED FOR THE SERVICE ROUTE. A MINIMUM OF A 3 FOOT SETBACK IS REQUIRED TO PROTECT BUILDINGS AND WALLS.
 - PROVISION OF ADEQUATE TURNAROUND AREA FOR LARGE VEHICLES ADJACENT TO THE DOCK AREA.
 - THE SITE PLAN MUST IDENTIFY SURROUNDING USES AND PROVIDE DIMENSIONS WHERE APPROPRIATE, I.E., STRUCTURES, STREETS, MEDIANS, DRIVE AISLES, PARKING SPACES, WALLS, SIGNS, ETC.
 - LOCATION AND DIMENSION OF PROPOSED FIRE LANES MUST MEET FIRE CODE REQUIREMENTS AS PER THE DPM.
 - COORDINATION WITH THE SOLID WASTE DEPARTMENT WITH REGARD TO REFUSE CONTAINER LOCATION AND ACCESS.
- THE FOLLOWING SITE PLAN CONDITIONS SHALL BE MET BEFORE FINAL DRB SIGN OFF:
 - INDICATION OF THE BOUNDARIES OF THE NORTHWEST MESA ESCARPMENT PLAN IMPACT ARE AND VIEW AREAS OVERLAY ZONES.
 - A NOTE WHICH INDICATES THAT LIGHTING SHALL HAVE THE MINIMUM EFFECT UPON ADJACENT RESIDENTIAL AREAS.
 - PROVIDE DIMENSIONS OF ALL MAJOR SITE ELEMENTS, INCLUDING ALL SIDEWALKS AND PEDESTRIAN PATHS.
 - REVISION OR ELIMINATION OF PARKING SPACES ON THE WEST SIDE OF THE SITE, BEHIND THE FURR'S SUPERMARKET BUILDING.
 - THE DRIVE AISLE/PARKING/LANDSCAPE CONFIGURATION ON THE SOUTH SIDE OF THE FURR'S SHALL BE REVISED TO AVOID VEHICLE OVERHANG. THE SIDEWALK ALONG THE SOUTH SIDE OF FURR'S SHALL BE A MINIMUM OF 6 FEET WIDE AND SHALL INCLUDE A CONTINUATION TO THE TRAIL ALONG PASEO DEL NORTE.
- THE FOLLOWING PEDESTRIAN RELATED CHANGES SHALL BE MADE TO THE SITE PLAN, TO THE SATISFACTION OF THE PLANNING DEPARTMENT, BEFORE FINAL DRB SIGN OFF:
 - PROVISION OF SIDEWALKS TO THE PARKING SPACES ON THE WEST AND SOUTH SIDE OF FURR'S.
 - REVISE THE PEDESTRIAN PATH BETWEEN THE FURR'S AND SHOP B TO MAKE IT HANDICAP ACCESSIBLE AND CONSISTENT WITH THE LANDSCAPING PLAN.
 - THERE SHALL BE A MINIMUM 15 FOOT WIDE SIDEWALK AND LANDSCAPE AREA SETBACK FROM THE FRONT FACADE OF THE BUILDING TO THE DRIVE AISLE OR PARKING AREA. THE SIDEWALK SHALL BE SHADED WITH PORTALS, CANOPIES OR SHADE TREES.
 - PROVIDE A MINIMUM OF 15 FOOT SIDEWALK AND LANDSCAPE AREA ALONG THE ENTIRE EAST FRONT OF FURR'S. THE SIDEWALK SHALL BE SHADED WITH PORTALS, CANOPIES OR SHADE TREES AT 20 TO 30 FEET ON CENTER IN 5 FOOT BY 5 FOOT PLANTERS.
- THE FOLLOWING CHANGES SHALL BE MADE TO THE ELEVATIONS, TO THE SATISFACTION OF THE PLANNING DEPARTMENT, BEFORE FINAL DRB SIGN OFF:
 - 70% OF THE BUILDING MATERIALS SHALL BE SPLIT FACED CMU BLOCK, AS IS CONSISTENT WITH THE "PAD ARCHITECTURE STANDARDS."
 - A NOTE SHALL BE ADDED TO THE ELEVATIONS WHICH INDICATES THAT ALL GUIDELINES OF THE "PAD ARCHITECTURE STANDARDS" SHALL BE FOLLOWED.
 - A NOTE SHALL BE ADDED TO THE "PAD ARCHITECTURE STANDARDS" WHICH STATES VINYL COATED PLASTIC REFLECTIVE TYPE AWNINGS SHALL NOT BE PERMITTED.
- THE FOLLOWING CHANGES TO THE LANDSCAPING PLAN SHALL BE MADE TO THE SATISFACTION OF THE PLANNING DEPARTMENT BEFORE FINAL DRB SIGN OFF:
 - PROVISION OF TREES ALONG PASEO DEL NORTE IN COMPLIANCE WITH THE STREET ORDINANCE.
 - THE LANDSCAPE BUFFER ALONG THE WEST SIDE, ADJACENT TO THE RESIDENTIAL PROPERTY, SHALL CONSIST PRIMARILY OF TREES AT LEAST EIGHT FEET HIGH AT THE TIME OF PLANTING AND CAPABLE OF REACHING A HEIGHT AT MATURITY OF AT LEAST 25 FEET. SPACING OF THE TREES SHALL BE EQUAL TO 75% OF THE MATURE CANOPY DIAMETER.
 - REVISION OF THE LANDSCAPING ON THE PEDESTRIAN PATH BETWEEN FURR'S AND SHOP B SUCH THAT IT IS CONSISTENT WITH THE SITE DEVELOPMENT PLAN AND THAT IT IS HANDICAP ACCESSIBLE.
 - THE LANDSCAPING PALATE SHALL BE CONSISTENT WITH THAT OF THE NORTHWEST MESA ESCARPMENT PLAN.
 - PROVISION OF THE STREET TREES/LANDSCAPING IN THE AREAS BETWEEN THE CURB AND THE SIDEWALKS ALONG PASEO DEL NORTE AND GOLF COURSE ROAD.
- THE GRADING AND DRAINAGE PLAN MUST BE APPROVED BY THE CITY ENGINEER BEFORE FINAL DRB SIGN OFF:
- A WATER AVAILABILITY STATEMENT FROM NEW MEXICO UTILITIES, INC. MUST BE APPROVED BY THE PUBLIC WORKS DEPARTMENT BEFORE FINAL DRB SIGN OFF. REQUIRED INFRASTRUCTURE MUST BE FINANCIALLY GUARANTEED PRIOR TO SITE PLAN AND PLAT APPROVAL BY THE DRB. ALL PUBLIC INFRASTRUCTURE MUST BE DESIGNED TO CITY OF ALBUQUERQUE STANDARDS, INCLUDING WATER AND/OR SANITARY SEWER LINES OWNED AND OPERATED BY NMU.
- NO FREESTANDING WIRELESS TELECOMMUNICATIONS FACILITIES SHALL BE PERMITTED. ALL ANTENNAS SHALL BE ARCHITECTURALLY INTEGRATED INTO THE BUILDING ARCHITECTURE OR LIGHT STANDARDS.
- OUTDOOR PATIO SPACE SHALL BE PROVIDED WITH ADEQUATE SHADING PROVIDED BY TREES AND/OR CONSTRUCTED SHADE STRUCTURE. A PATIO WHICH IS A MINIMUM OF 400 SQUARE FEET IN SIZE SHALL BE PROVIDED ON THE FURR'S PAD, AND A PATIO WHICH IS A MINIMUM OF 200 SQUARE FEET SHALL BE PROVIDED ON PAD B. THE PATIO SHALL HAVE ADEQUATE SHADING PROVIDED BY TREES AND/OR CONSTRUCTED SHADE STRUCTURE THAT INTEGRATES INTO THE ARCHITECTURE.
- THIS IS A DESIGNATED SHOPPING CENTER SITE. THEREFORE OFF-PREMISE SIGNS SHALL NOT BE PERMITTED.
- THE FUTURE TRAIL EXTENSION SHOWN ALONG THE SOUTHERN BOUNDARY OF THE SITE PLAN AND THE CURBED TRAIL ADJACENT TO THE PIEDRAS MERCADAS ARROYO SHALL BE CONSTRUCTED TO THE SATISFACTION OF THE DRB.

BUILDING DATA


GROSS BUILDING AREA: 39,690± S.F.
BUILDING SETBACKS REQD: BY SITE PLAN
BUILDING HEIGHT: Structures height up to 26 feet is permitted at any legal location. The height and width of the structure over 26' shall fall within 45° angle planes drawn from the horizontal at the mean grade along each internal boundary of the premises and adjacent public right-of-way centerline. To protect solar access, a structure over 26' may not exceed the northern boundary of these 45° planes, but may be sighted in any other direction within planes drawn at 60° angle from the same boundaries or centerline.
BUILDING COVERAGE: NEIGHBORHOOD MARKET20% ±

PROJECT NUMBER: Z-99-11
APPLICATION NUMBER: 00450-00000-00525

DRB SITE DEVELOPMENT PLAN APPROVAL:

Traffic Engineer, Transportation Division	Date
Utilities Development	Date
Parks & Recreation Department	Date
City Engineer	Date
* Environmental Health Department (conditional)	Date
Solid Waste Management	Date
DRB Chairperson, Planning Department	Date

* Environmental Health, if necessary 12/16/03

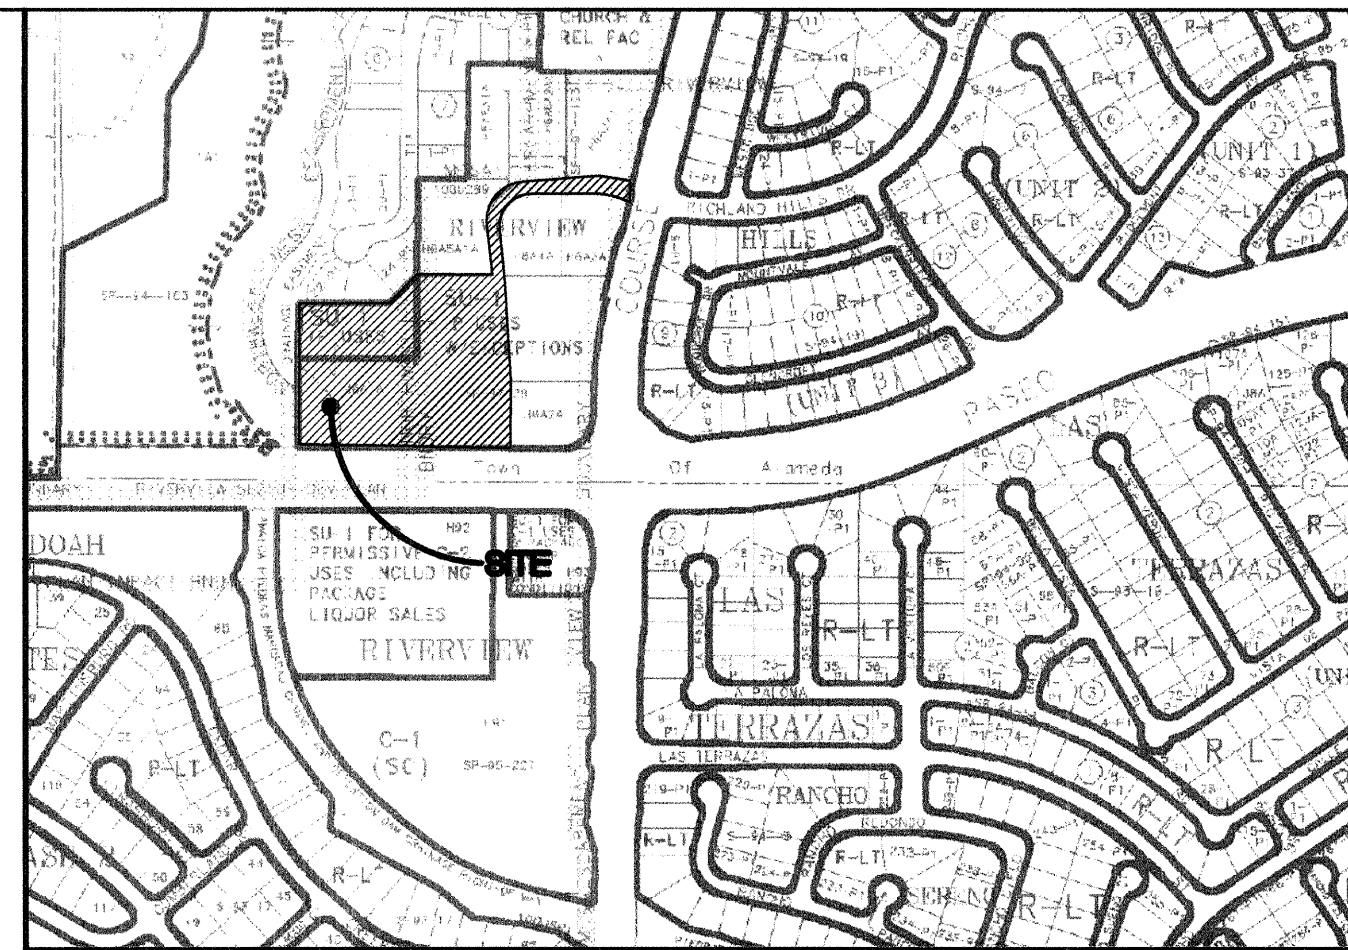

VICINITY MAP

C-12-Z

KEYED NOTES

- BIKE RACK(TYP.)
- PEDESTRIAN CROSSWALK WITH 4" WIDE PAINTED YELLOW STRIPING PARALLEL TO DIRECTION OF TRAFFIC AT 2'-0" O.C. UNLESS NOTED OTHERWISE. SEE SITE PLAN FOR WIDTH
- 6" MEDIAN CURB & GUTTER
- UNIDIRECTIONAL HANDICAP RAMP PER COA STD DWG #2426
- CART CORRAL (TYP)
- TRASH COMPACTOR
- 6" DIA. PIPE BOLLARD(TYP)
- AWNINGS (PER ARCHITECTUAL PLANS)
- 2'-0" LOADING ZONE AT ALL CURBED PARKING SPACES. 4" PAINTED YELLOW STRIPING AT 2'-0" O.C. PERPENDICULAR TO THE PARKING SPACE(TYP.)
- "YIELD" PAINTED YELLOW ON PAVEMENT TYP.
- HANDICAP PARKING SIGN
- PAINTED 6" RED STRIPE W/ 4" WHITE LETTERS "NO PARKING FIRE ZONE"
- 8" CONCRETE SIDEWALK
- 10'x15' STRIPED AREA PAINTED SYS/4" AT 45° @ 2'-0" O.C. AT JIB CRANE LOCATION. SEE ARCH. PLANS
- ELECTRICAL TRANSFORMER
- PEDESTRIAN CROSSING SIGN W1a-2 and W1a-2p TYPICAL AT PEDESTRIAN CROSSWALKS AS NOTED ON PLANS
- PAINTED DIRECTIONAL ARROW (TYP)
- SMALL CAR MAKER, "COMPACT" PAINTED YELLOW ON PAVEMENT (TYP)
- ACCESSIBLE PARKING SPACE (TYP.) SEE DETAIL SHEET FOR ACCESSIBLE PARKING SPACE SIZE, SIGN AND SYMBOL ("VAN" INDICATES VAN ACCESSIBLE SPACE).
- 5'x5' LANDSCAPE PLANTERS
- 400 SF TREE SHADED PATIO AREA
- 6" CONCRETE SIDEWALK
- STANDARD CURB AND GUTTER
- 12" PAINTED (WHITE) STOP BAR W/PAVEMENT MAKING "STOP" IN 6" LETTERS

HUBBELL CATALOG NO.: MSWA400PBP-ARGS
2 luminaires per location, 44000 initial lumens per lamp
Light Loss Factor = 0.750, watts per luminaire = 452
mounting height = 25 ft
number locations = 6, number luminaires = 12
kw all locations = 5.4

HUBBELL CATALOG NO.: MSWA400P-BW-AR
2 luminaires per location, 44000 initial lumens per lamp
Light Loss Factor = 0.750, watts per luminaire = 452
mounting height = 25 ft
number locations = 4, number luminaires = 8
kw all locations = 3.6

HUBBELL CATALOG NO.: MSWA400P-BW-AR
2 luminaires per location, 44000 initial lumens per lamp
Light Loss Factor = 0.750, watts per luminaire = 452
mounting height = 25 ft
number locations = 4, number luminaires = 8
kw all locations = 3.6

HUBBELL CATALOG NO.: MSWA400P-BP-AR
2 luminaires per location, 44000 initial lumens per lamp
Light Loss Factor = 0.750, watts per luminaire = 452
mounting height = 25 ft
number locations = 3, number luminaires = 3
kw all locations = 1.4

LEGEND


- PROPOSED CURB & GUTTER
- SETBACK
- BOUNDARY LINE
- EASEMENT
- PROPOSED SIDEWALK
- PROPOSED RETAINING WALL
- PROPOSED PARKING SPACES
- CART CORRAL
- MULTIPLE OCCUPANCY VEHICLE SPACE
- SMALL CAR PARKING SPACE
- HEAVY DUTY ASPHALTIC CONCRETE PAVEMENT
- HEAVY DUTY CONCRETE PAVEMENT
- STANDARD DUTY CONCRETE
- STANDARD DUTY ASPHALTIC CONCRETE PAVEMENT
- PROPOSED LIGHTING

PARCEL DATA

PARCEL H-6A1A-1	5.1472 ± AC
PARCEL H-6A1A-2	1.3483 ± AC
TOTAL	6.4955 ± AC
LAND USE CLASSIFICATION:	COMMERCIAL
ZONING CLASSIFICATION:	SU-1 FOR IP WITH EXCEPTIONS DRIVE-UP WINDOW MUST BE 75' MINIMUM FROM NEAREST RESIDENCE
LOCAL JURISDICTION:	CITY OF ALBUQUERQUE
FLOOD ZONE CLASSIFICATION:	ZONED X UNSHADED
PARKING DATA	
PARCEL H-6A1A-1	39,690 S.F./200= 199 SPACES
PARCEL H-6A1A-2	10,080 S.F./200= 50 SPACES
TOTALS	49,770 S.F. 249 SPACES
TOTAL PARKING REQUIRED	249 SPACES
LESS 10% BUS CREDIT	225 SPACES
STANDARD SPACES	254 SPACES(24 SMALL CAR)
MULTIPLE OCCUPANCY VEHICLE SPACES	25 SPACES
ACCESSIBLE SPACES	12 SPACES
CART CORRALS	6 SPACES
TOTAL PARKING REQUIRED	225 SPACES
TOTAL PARKING PROVIDED	254 SPACES
RATIO FOR PARCEL H-6A1A-1	5.04/1,000 S.F.

NOTES

- ALL CALCULATIONS BASED ON TOTAL GROSS SQUARE FOOTAGE OF BUILDING
- WAL-MART PREFERRED PARKING (5.0 SP/1,000 S.F.) CODE REQUIRED PARKING SPACES (5.0/1,000 S.F.)
- PARKING LAYOUT MEETS WAL-MART STANDARDS WHICH IS WITHIN LOCAL REQUIREMENTS.
- CITY OF ALBUQUERQUE DOES NOT ALLOW CREDIT FOR CART CORRALS.
- PARKING SHOWN CONTAINS BOTH 60° AND 90° PARKING SPACES. TYPICAL DIMENSIONS:
WIDTH: 9.5'
DEPTH: 20'
ONE WAY AISLES: 20'
TWO WAY AISLES: 25'
- CONTRACTOR SHALL REFER TO ARCHITECTURAL PLANS (MEP) FOR LOCATION AND SPECIFICATIONS FOR ALL PARKING LOT LIGHTING AND LIGHT POLES.

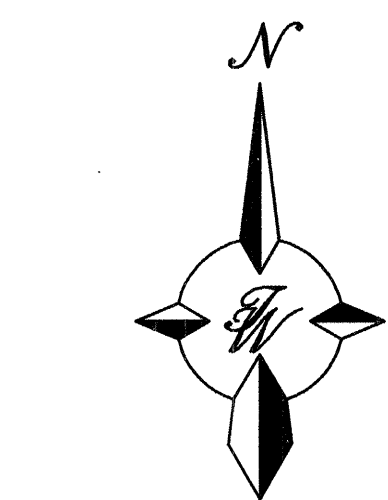

GRAPHIC SCALE


40 20 0 20 40

SCALE: 1"=40'

753181

GENERAL SITE REQUIREMENTS FROM PLANNING DEPARTMENT


- △ DIRECT ACCESS TO PASEO DEL NORTE IS PROHIBITED
- △ LIGHTING SHALL HAVE A MINIMUM EFFECT UPON ADJACENT RESIDENTIAL AREAS
- △ ALL RAISED PEDESTRIAN PATHWAYS SHALL BE A MINIMUM OF 6 FEET WIDE
- △ NO OFF PREMISE SIGNS SHALL BE PERMITTED
- △ NO FREESTANDING WIRELESS TELECOMMUNICATIONS FACILITIES SHALL BE PERMITTED
- △ ALL ANTENNAS SHALL BE ARCHITECTURALLY INTEGRATED INTO THE BUILDING ARCHITECTURE OR LIGHT STANDARDS

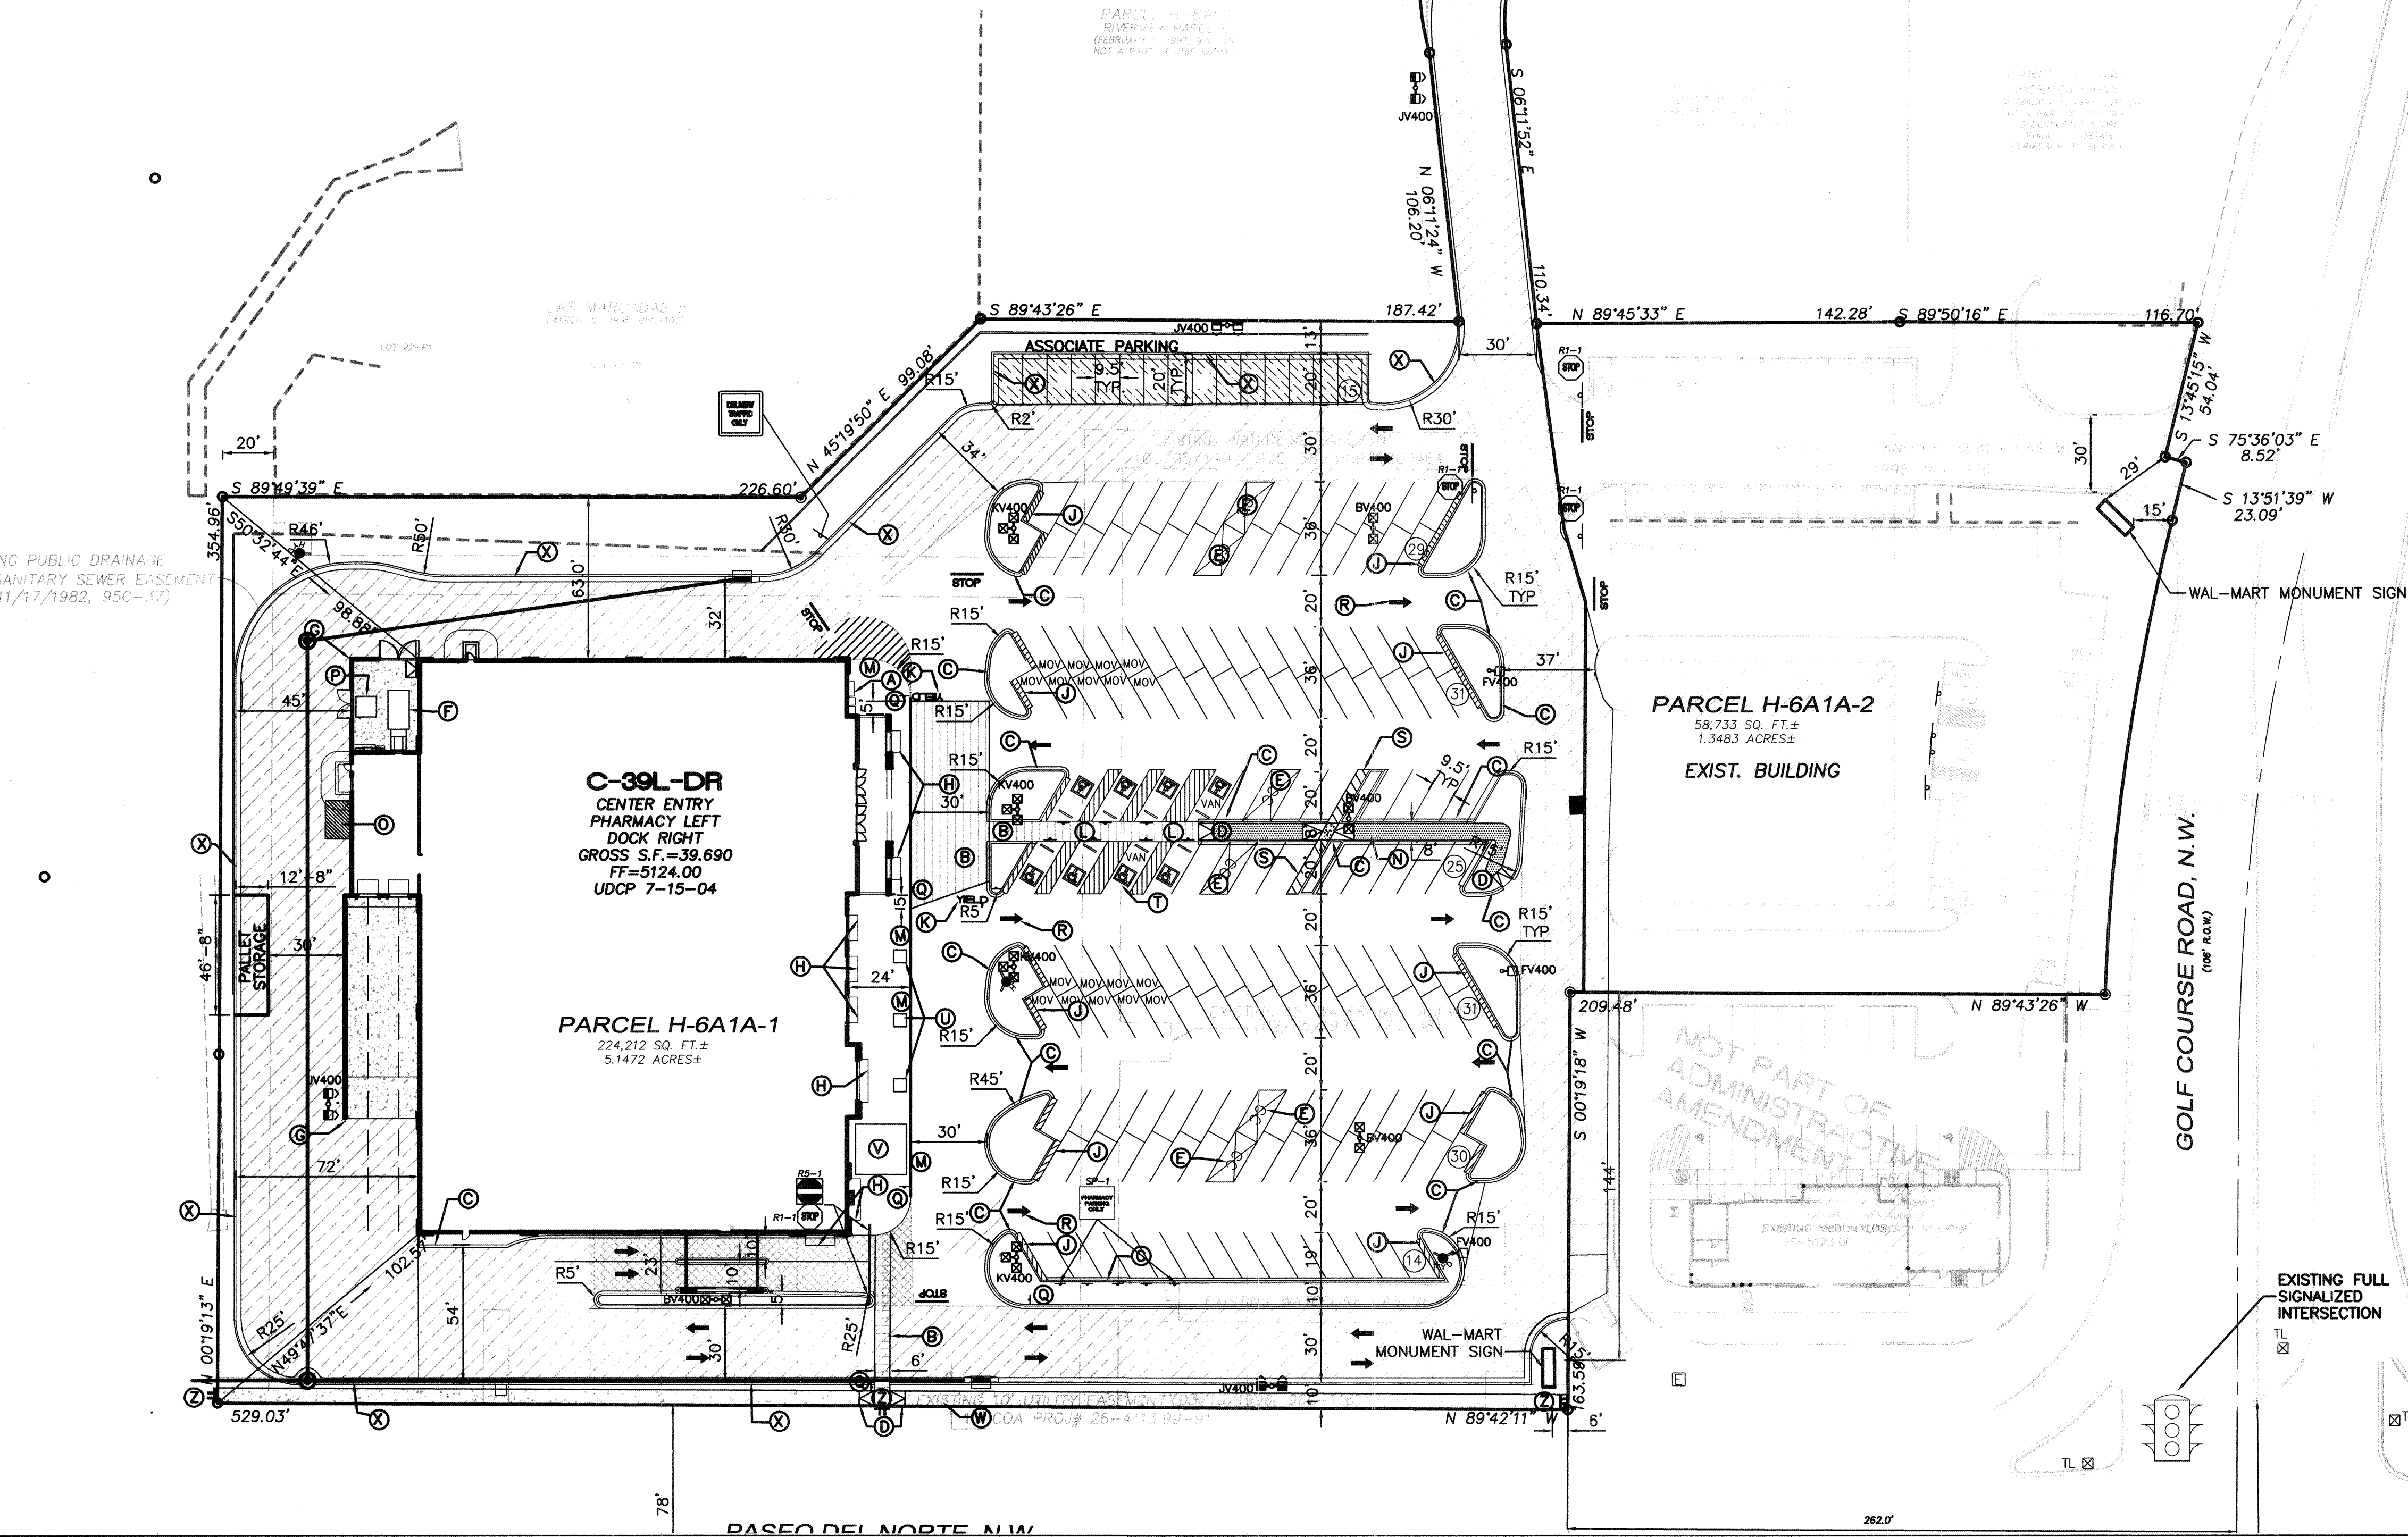


For Reference Only

NO.	DATE	REMARKS	BY
REVISIONS			
ENGINEER'S SEAL		PASEO DEL NORTE AND GOLF COURSE WAL-MART NEIGHBORHOOD MARKET #3317-00 8511 GOLF COURSE RD. NW	DRAWN BY rwm
AMENDED SITE PLAN FOR BUILDING PERMIT		DATE	12-01-2004
ALBUQUERQUE NEW MEXICO		2387SPB-11-12-04X	
TIERRA WEST, LLC		DRC SHEET #	3 OF 9
8509 JEFFERSON NE ALBUQUERQUE, NEW MEXICO 87113 (505)858-3100		OTB SHEET #	7 OF 27
RONALD R. BOHANNAN P.E. #7868		JOB #	230087

DETAIL-A

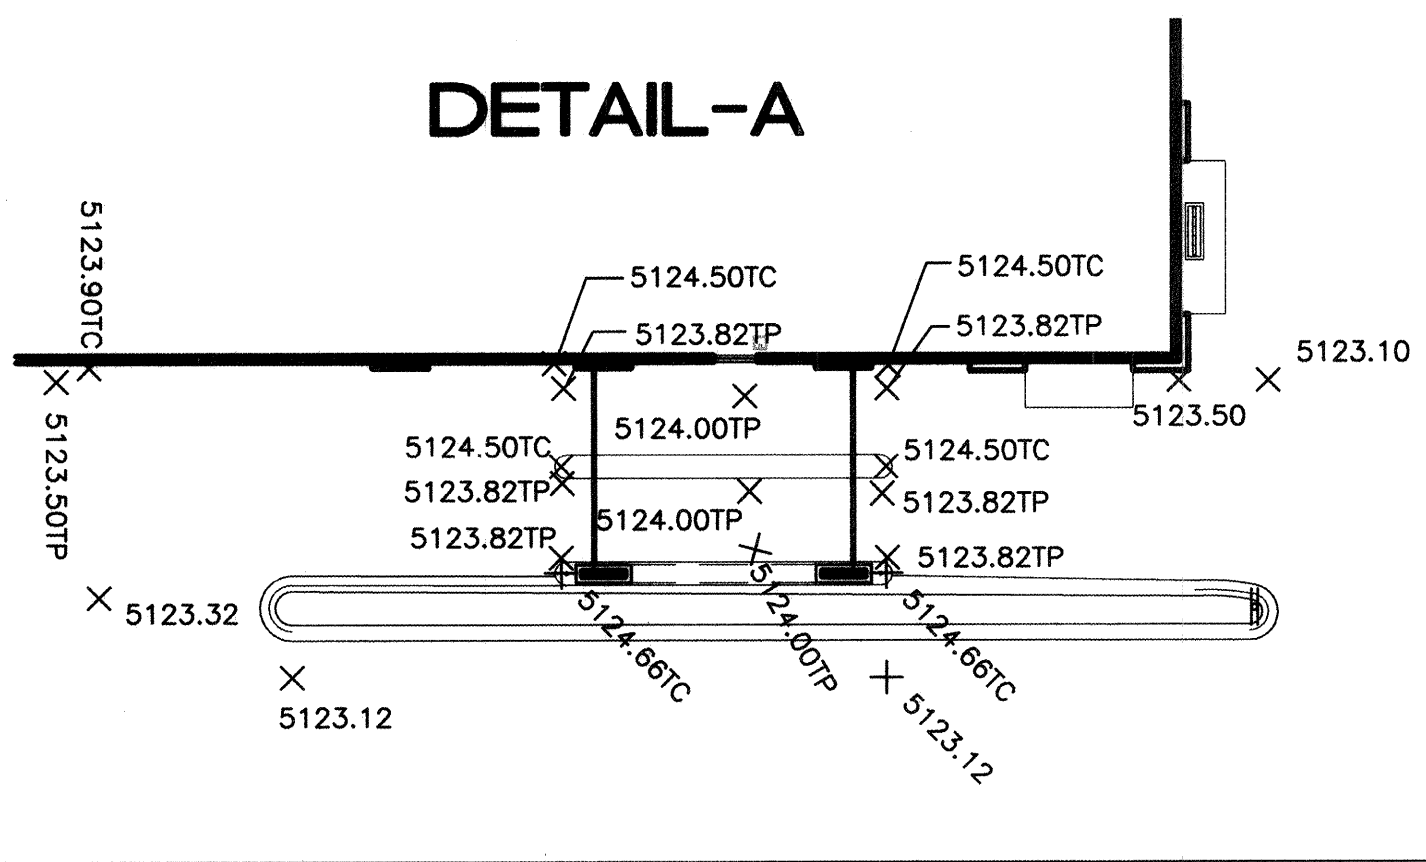

DETAIL-B

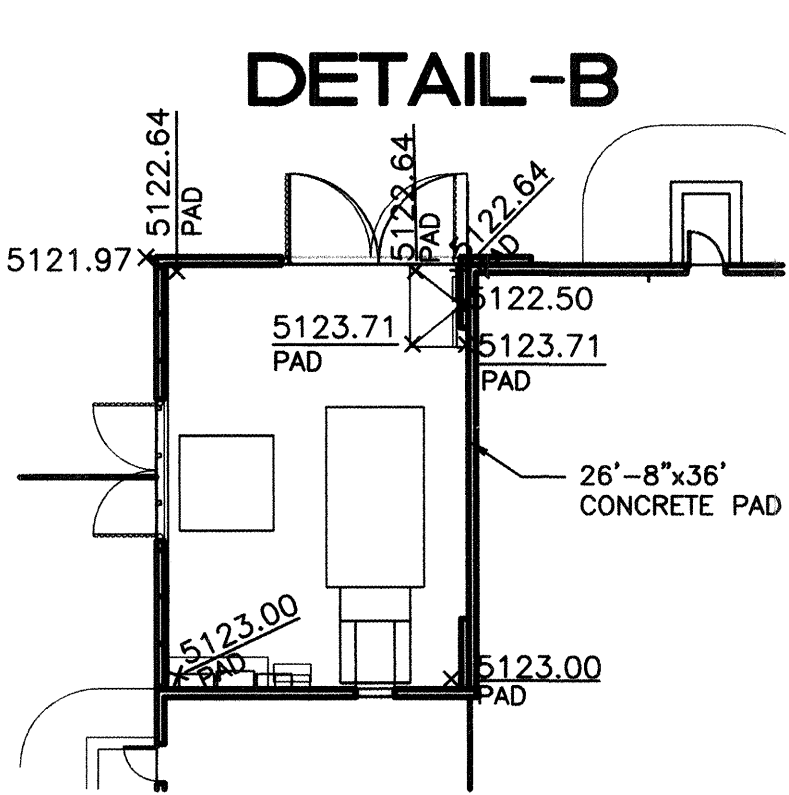

CAUTION:

ALL EXISTING UTILITIES SHOWN WERE OBTAINED FROM RESEARCH, AS-BUILTS, SURVEYS OR INFORMATION PROVIDED BY OTHERS. IT SHALL BE THE SOLE RESPONSIBILITY OF THE CONTRACTOR TO CONDUCT ALL NECESSARY FIELD INVESTIGATIONS PRIOR TO AND INCLUDING ANY EXCAVATION, TO DETERMINE THE ACTUAL LOCATION OF UTILITIES AND OTHER IMPROVEMENTS, PRIOR TO STARTING THE WORK. ANY CHANGES FROM THIS PLAN SHALL BE COORDINATED WITH AND APPROVED BY THE ENGINEER.

FOUNDATION PAD PREPARATION NOTES

Proposed NEIGHBORHOOD CENTER #3317-00
PASO DEL NORTE & GOLF COURSE ROAD
ALBUQUERQUE, NEW MEXICO
Terracon Project No. 66035064

UNLESS SPECIFICALLY INDICATED OTHERWISE IN THE DRAWINGS AND/OR SPECIFICATIONS, THE LIMITS OF THIS SUBSURFACE PREPARATION ARE CONSIDERED TO BE THAT PORTION OF THE SITE DIRECTLY BENEATH AND 10 FEET BEYOND THE CONSTRUCTION LIMITS OF THE PROPOSED SITE.

APPURTENANCES ARE THOSE ITEMS ATTACHED TO THE BUILDING PROPER (REFER TO DRAWING SHEET SP1), TYPICALLY INCLUDING, BUT NOT LIMITED TO, THE BUILDING SIDEWALKS, GARDEN CENTER, PORCHES, RAMPS, STOPS, TRUCK WELLS/DOCKS, CONCRETE APRONS AT THE AUTOMOTIVE CENTER, COMPACTOR PAD, ETC. THE SUBBASE, WHERE REQUIRED, DO NOT EXTEND BEYOND THE LIMITS OF THE ACTUAL BUILDING AND THE APPURTENANCES.

THE FINAL SUBGRADE ELEVATION FOR SLAB-ON-GRADE FLOORS SHALL BE ESTABLISHED AT 10 INCHES BELOW FINISHED FLOOR ELEVATION TO ALLOW FOR A 4 INCH CONCRETE SLAB (OR 11-1/2 INCHES TO ALLOW FOR A 5-1/2 INCH CONCRETE SLAB) AND A 6 INCH SUBBASE. THE SUBBASE SHALL CONSIST OF 4 INCHES OF COARSE AGGREGATE MEETING THE GRADATION REQUIREMENTS OF ASTM D-448, TYPE 57 OR MASHD TYPE VIII-OGS COVERED WITH 2 INCHES OF FINE AGGREGATE MEETING THE GRADATION REQUIREMENTS OF ASTM D-448, NO. 10 WITH 6 TO 12 PERCENT PASSING THE NO. 200 SIEVE OR THE FOLLOWING GRADATION REQUIREMENTS:

STANDARD SIEVE SIZE	PERCENT PASSING
NO. 4	85 - 100
NO. 8	75 - 95
NO. 16	55 - 75
NO. 30	22 - 45
NO. 60	10 - 30
NO. 200	6 - 12

THE CONTRACTOR SHALL BE RESPONSIBLE FOR OBTAINING ACCURATE MEASUREMENTS FOR ALL CUT AND FILL DEPTHS REQUIRED. THE SUBBASE SHALL BE PLACED ON COMPACTED SUBGRADE, ROLLED WITH A VIBRATORY ROLLER, AND VISUALLY INSPECTED FOR INLOCKING OF PARTICLES. THE FINE AGGREGATE WILL BE UNIFORMLY SPREAD ON THE SUBBASE MATERIAL.



EXISTING FOUNDATIONS, SLABS, PAVEMENTS, AND BELOW-GRADE STRUCTURES SHALL BE REMOVED FROM THE BUILDING AREA. REMOVE SURFACE VEGETATIONS, TOPSOIL, ROOT SYSTEMS, ORGANIC MATERIAL, EXISTING FILL, AND SOFT OR OTHERWISE UNSUITABLE MATERIAL FROM THE BUILDING AREA. PROOFROLL EXPOSED SUBGRADE. REMOVE AND REPLACE UNSUITABLE AREAS WITH SUITABLE MATERIAL. SUBGRADE MATERIAL SHALL BE FREE OF ORGANIC AND OTHER DELETERIOUS MATERIALS AND SHALL MEET THE FOLLOWING REQUIREMENTS:

LOCATION WITH RESPECT TO FINAL GRADE	P.I.	L.L.
BUILDING AREA	12 MAX.	35 MAX.
MAX. PRACTICE SIZE (ASTM C136)	PERCENT PASSING	
4"	100	
3"	70 - 100	
NO. 4 SIEVE	50 - 100	
NO. 200 SIEVE	50 (MAX)	

ENGINEERED FILL TO EXTEND A MINIMUM OF 5 FEET BELOW PROPOSED FOOTING BEARING ELEVATION AND COMPACTED TO AT LEAST 95% OF MODIFIED PROCTOR MAXIMUM DRY DENSITY (ASTM D 1557). THE SOILS BENEATH THE SLAB SUBGRADE SHOULD BE REMOVED TO A DEPTH OF 3 FEET BELOW BOTTOM OF SLAB AND REPLACED WITH ENGINEERED FILL. SUBGRADE MATERIAL SHALL BE PLACED IN LOOSE LIFTS NOT EXCEEDING 10 INCHES IN THICKNESS AND COMPACTED TO AT LEAST 95 PERCENT OF THE MODIFIED PROCTOR MAXIMUM DRY DENSITY (ASTM D1557) AT A MOISTURE CONTENT WITHIN 1 PERCENT BELOW TO 3 PERCENT ABOVE THE OPTIMUM FOR SOILS WITH A PLASTICITY INDEX AREA THAN 5 AND AT A MOISTURE CONTENT WITHIN 3 PERCENT BELOW TO 3 PERCENT ABOVE THE OPTIMUM MOISTURE CONTENT FOR ALL OTHER SOILS.

THE FOUNDATION SYSTEM SHALL BE ISOLATED SPREAD FOOTINGS AT COLUMNS AND CONTINUOUS FOOTINGS AT WALLS (PROVIDED BY THE CONTRACTOR). THE SPREAD FOOTINGS AND SLABS-ON-GRADE SHALL BE SUPPORTED ON A MINIMUM OF 5 FEET AND 3 FEET OF ENGINEERED FILL, RESPECTIVELY. THE FILL FOR FOOTINGS SHOULD EXTEND HORIZONTALLY 8 INCHES FOR EACH FOOT OF ENGINEERED FILL BENEATH THE FOOTING. FOOTING EXCAVATIONS SHALL BE EVALUATED BY WAL-MART'S GEOTECHNICAL REPRESENTATIVE PRIOR TO CONCRETE PLACEMENT TO CONFIRM THAT SUITABLE BEARING CONDITIONS EXIST.

THIS FOUNDATION SUBSURFACE PREPARATION DOES NOT CONSTITUTE A COMPLETE SITE WORK SPECIFICATION. IN CASE OF CONFLICT, INFORMATION COVERED IN THIS PREPARATION SHALL TAKE PRECEDENCE OVER THE WAL-MART SPECIFICATIONS. REFER TO THE SPECIFICATIONS FOR SPECIFIC INFORMATION NOT COVERED IN THIS PREPARATION. THIS INFORMATION WAS TAKEN FROM A GEOTECHNICAL REPORT PREPARED BY TERRACON, REVISED OCTOBER 26, 2004 (GEOTECHNICAL REPORT IS FOR INFORMATION ONLY AND IS NOT A CONSTRUCTION SPECIFICATION).

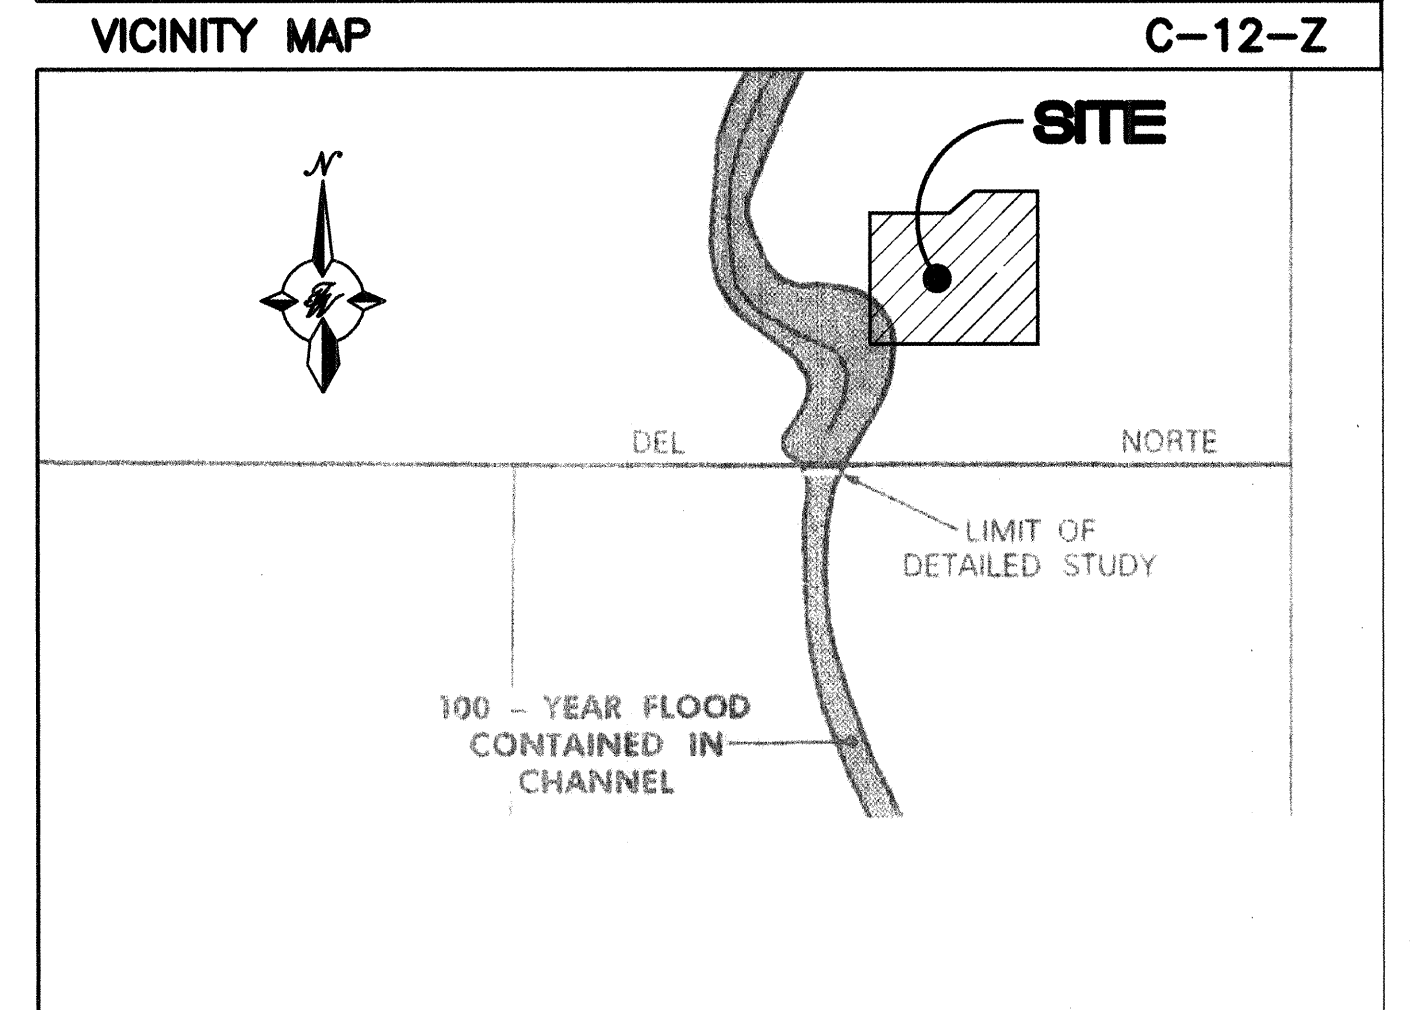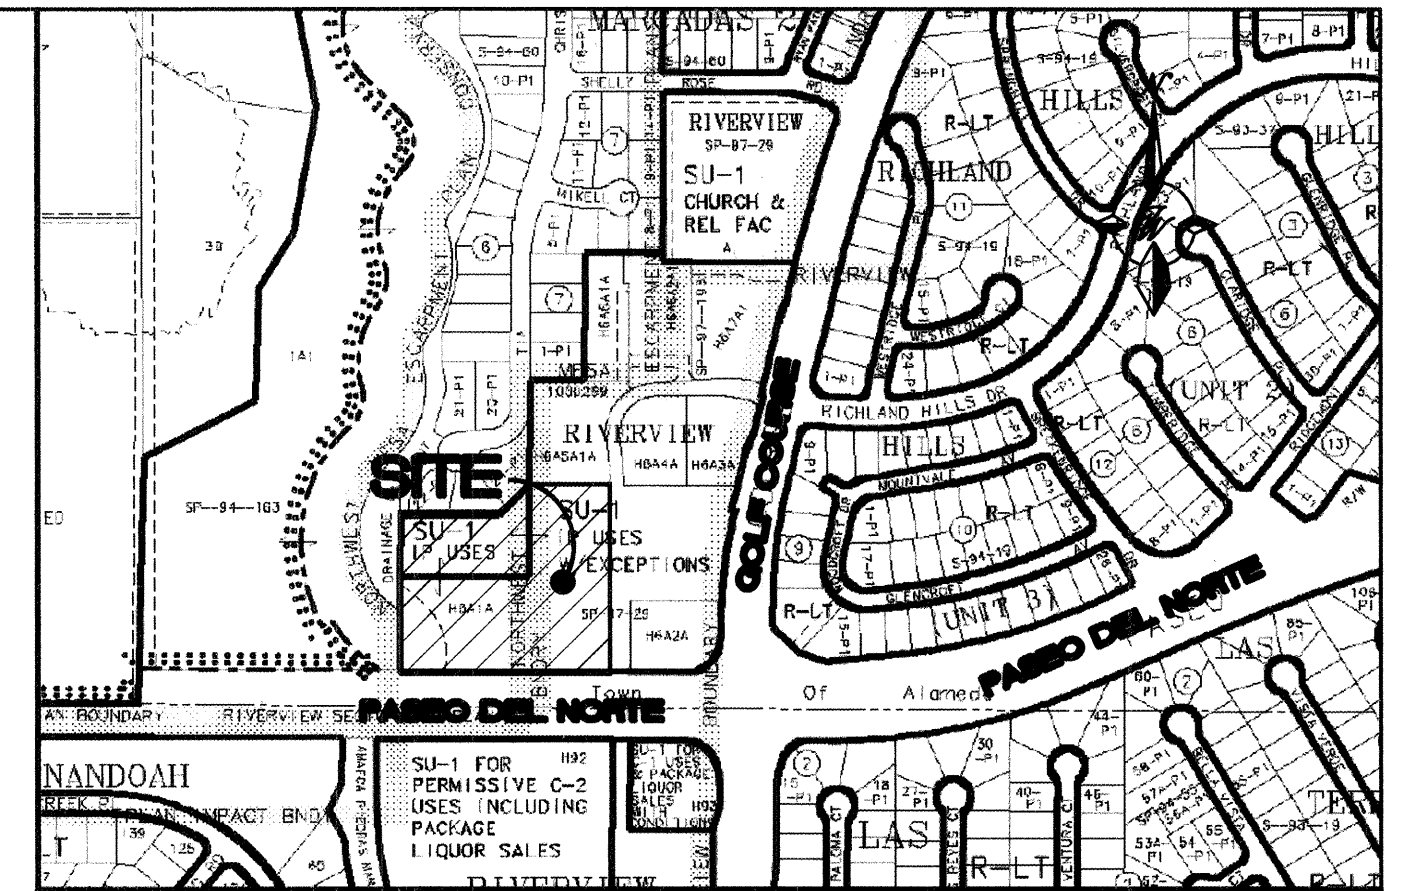

FIRM MAP 35001C0112 D

LEGAL DESCRIPTION
TOWNSHIP 11 NORTH, RANGE 2 EAST, PARCEL H-8A-1-A OF THE PLAT OF RIVERVIEW PARCELS H-8A-1-A THRU H-8A-7-A AND PARCEL "A" CITY OF ALBUQUERQUE, BERNALILLO COUNTY, NEW MEXICO

NOTES
1. ALL SPOT ELEVATIONS REPRESENT FLOWLINE ELEVATION UNLESS OTHERWISE NOTED.

LEGEND	
	PROPOSED STORM SEWER MANHOLE
	PROPOSED CURB INLET
	PROPOSED CATCH BASIN
	PROPOSED STORM SEWER LINE
	EXISTING CURB & GUTTER
	PROPOSED CURB & GUTTER
	BOUNDARY LINE
	EXISTING BOUNDARY LINE
	EASEMENT
	PROPOSED PERIMETER WALL
	PROPOSED RETAINING WALL
	EXISTING CONTOUR
	EXISTING INDEX CONTOUR
	GRADING HIGH POINT
	SLOPE TIE
	EXISTING SPOT ELEVATION
	PROPOSED SPOT ELEVATION

FOR INFORMATION ONLY

NOTICE TO CONTRACTORS


- AN EXCAVATION/CONSTRUCTION PERMIT WILL BE REQUIRED BEFORE BEGINNING ANY WORK WITHIN CITY RIGHT-OF-WAY. AN APPROVED COPY OF THESE PLANS MUST BE SUBMITTED AT THE TIME OF APPLICATION FOR THIS PERMIT.
- ALL WORK DETAILED ON THESE PLANS TO BE PERFORMED, EXCEPT AS OTHERWISE STATED OR PROVIDED HEREON, SHALL BE CONSTRUCTED IN ACCORDANCE WITH CITY OF ALBUQUERQUE INTERIM STANDARD SPECIFICATIONS FOR PUBLIC WORKS CONSTRUCTION, 1985.
- TWO WORKING DAYS PRIOR TO ANY EXCAVATION, CONTRACTOR MUST CONTACT LINE LOCATING SERVICE, 765-1234, FOR LOCATION OF EXISTING UTILITIES.
- PRIOR TO CONSTRUCTION, THE CONTRACTOR SHALL EXCAVATE AND VERIFY THE HORIZONTAL AND VERTICAL LOCATIONS OF ALL CONSTRUCTIONS. SHOULD A CONFLICT EXIST, THE CONTRACTOR SHALL NOTIFY THE ENGINEER SO THAT THE CONFLICT CAN BE RESOLVED WITH A MINIMUM AMOUNT OF DELAY.
- BACK FILL COMPACTION SHALL BE ACCORDING TO RESIDENTIAL STREET USE.
- MAINTENANCE OF THESE FACILITIES SHALL BE THE RESPONSIBILITY OF THE OWNER OF THE PROPERTY SERVED.
- WORK ON ARTERIAL STREETS SHALL BE PERFORMED ON A 24-HOUR BASIS.

GENERAL NOTES:

- 4" MINIMUM BURY REQUIRED FOR ALL UTILITIES UNLESS NOTED.
- REFERENCE ARCHITECTURAL PLANS FOR WATER LINE RISER LOCATION.
- ALL STUBS AND UTILITY LOCATIONS MUST BE FIELD VERIFIED PRIOR TO CONSTRUCTION.
- CLEAN OUTS TO BE BUILT PER UNIFORM PLUMBING CODE STANDARDS.
- CLEAN OUTS & MANHOLE TIE POINTS ARE TAKEN USING THE NW PROPERTY CORNER X=10,000, Y=10,000. SEE TABLE 2.
- SEE ARCHITECTURAL PLANS FOR LIGHTING CONDUITS AND TELEPHONE LINES.

EROSION CONTROL PLAN, NPDES PERMIT AND POLLUTION PREVENTION NOTES


- CONTRACTOR IS RESPONSIBLE FOR OBTAINING A TOPSOIL DISTURBANCE PERMIT PRIOR TO BEGINNING WORK.
- CONTRACTOR IS RESPONSIBLE FOR CLEANING ALL SEDIMENT OUT OF EXISTING RIGHT-OF-WAY.
- CONTRACTOR IS RESPONSIBLE FOR MAINTAINING ALL STORM RUN OFF ON SITE.
- REPAIR OF DAMAGED FACILITIES AND CLEAN-UP OF SEDIMENT ACCUMULATION ON ADJACENT PROPERTIES AND IN PUBLIC FACILITIES IS THE RESPONSIBILITY OF THE CONTRACTOR.
- ALL EXPOSED EARTH SURFACES MUST BE PROTECTED FROM WIND AND WATER EROSION PRIOR TO FINAL ACCEPTANCE OF ANY PROJECT.
- CONTRACTOR IS RESPONSIBLE FOR OBTAINING NPDES PERMIT FOR THE SITE

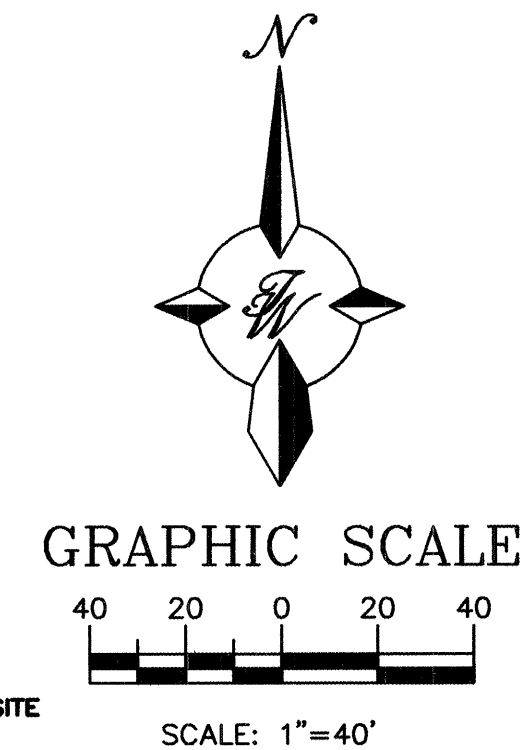

ROUGH GRADING APPROVAL		
For Reference Only		
NO.	DATE	REMARKS
REVISIONS		
ENGINEER'S SEAL	PASO DEL NORTE AND GOLF COURSE WAL-MART NEIGHBORHOOD MARKET #3317-00 8511 GOLF COURSE RD. NW	
GRADING AND DRAINAGE PLAN		DRAWN BY rwm
ALBUQUERQUE NEW MEXICO		DATE 12-01-2004
TERRA WEST, LLC		238760-11-12-04X
8509 JEFFERSON NE ALBUQUERQUE, NEW MEXICO 87113 (505)858-3100		DRC SHEET # 4 OF 9
RONALD R. BOHANNAN P.E. #7868		OTB SHEET # 8 OF 27
		JOB # 230087

753181

FIRE HYDRANT No. AND FLANGE ELEVATION	
FIRE HYDRANT No.	FLANGE ELEV.
FH #1	5124.78
FH #2	5123.90
FH #3	5123.79

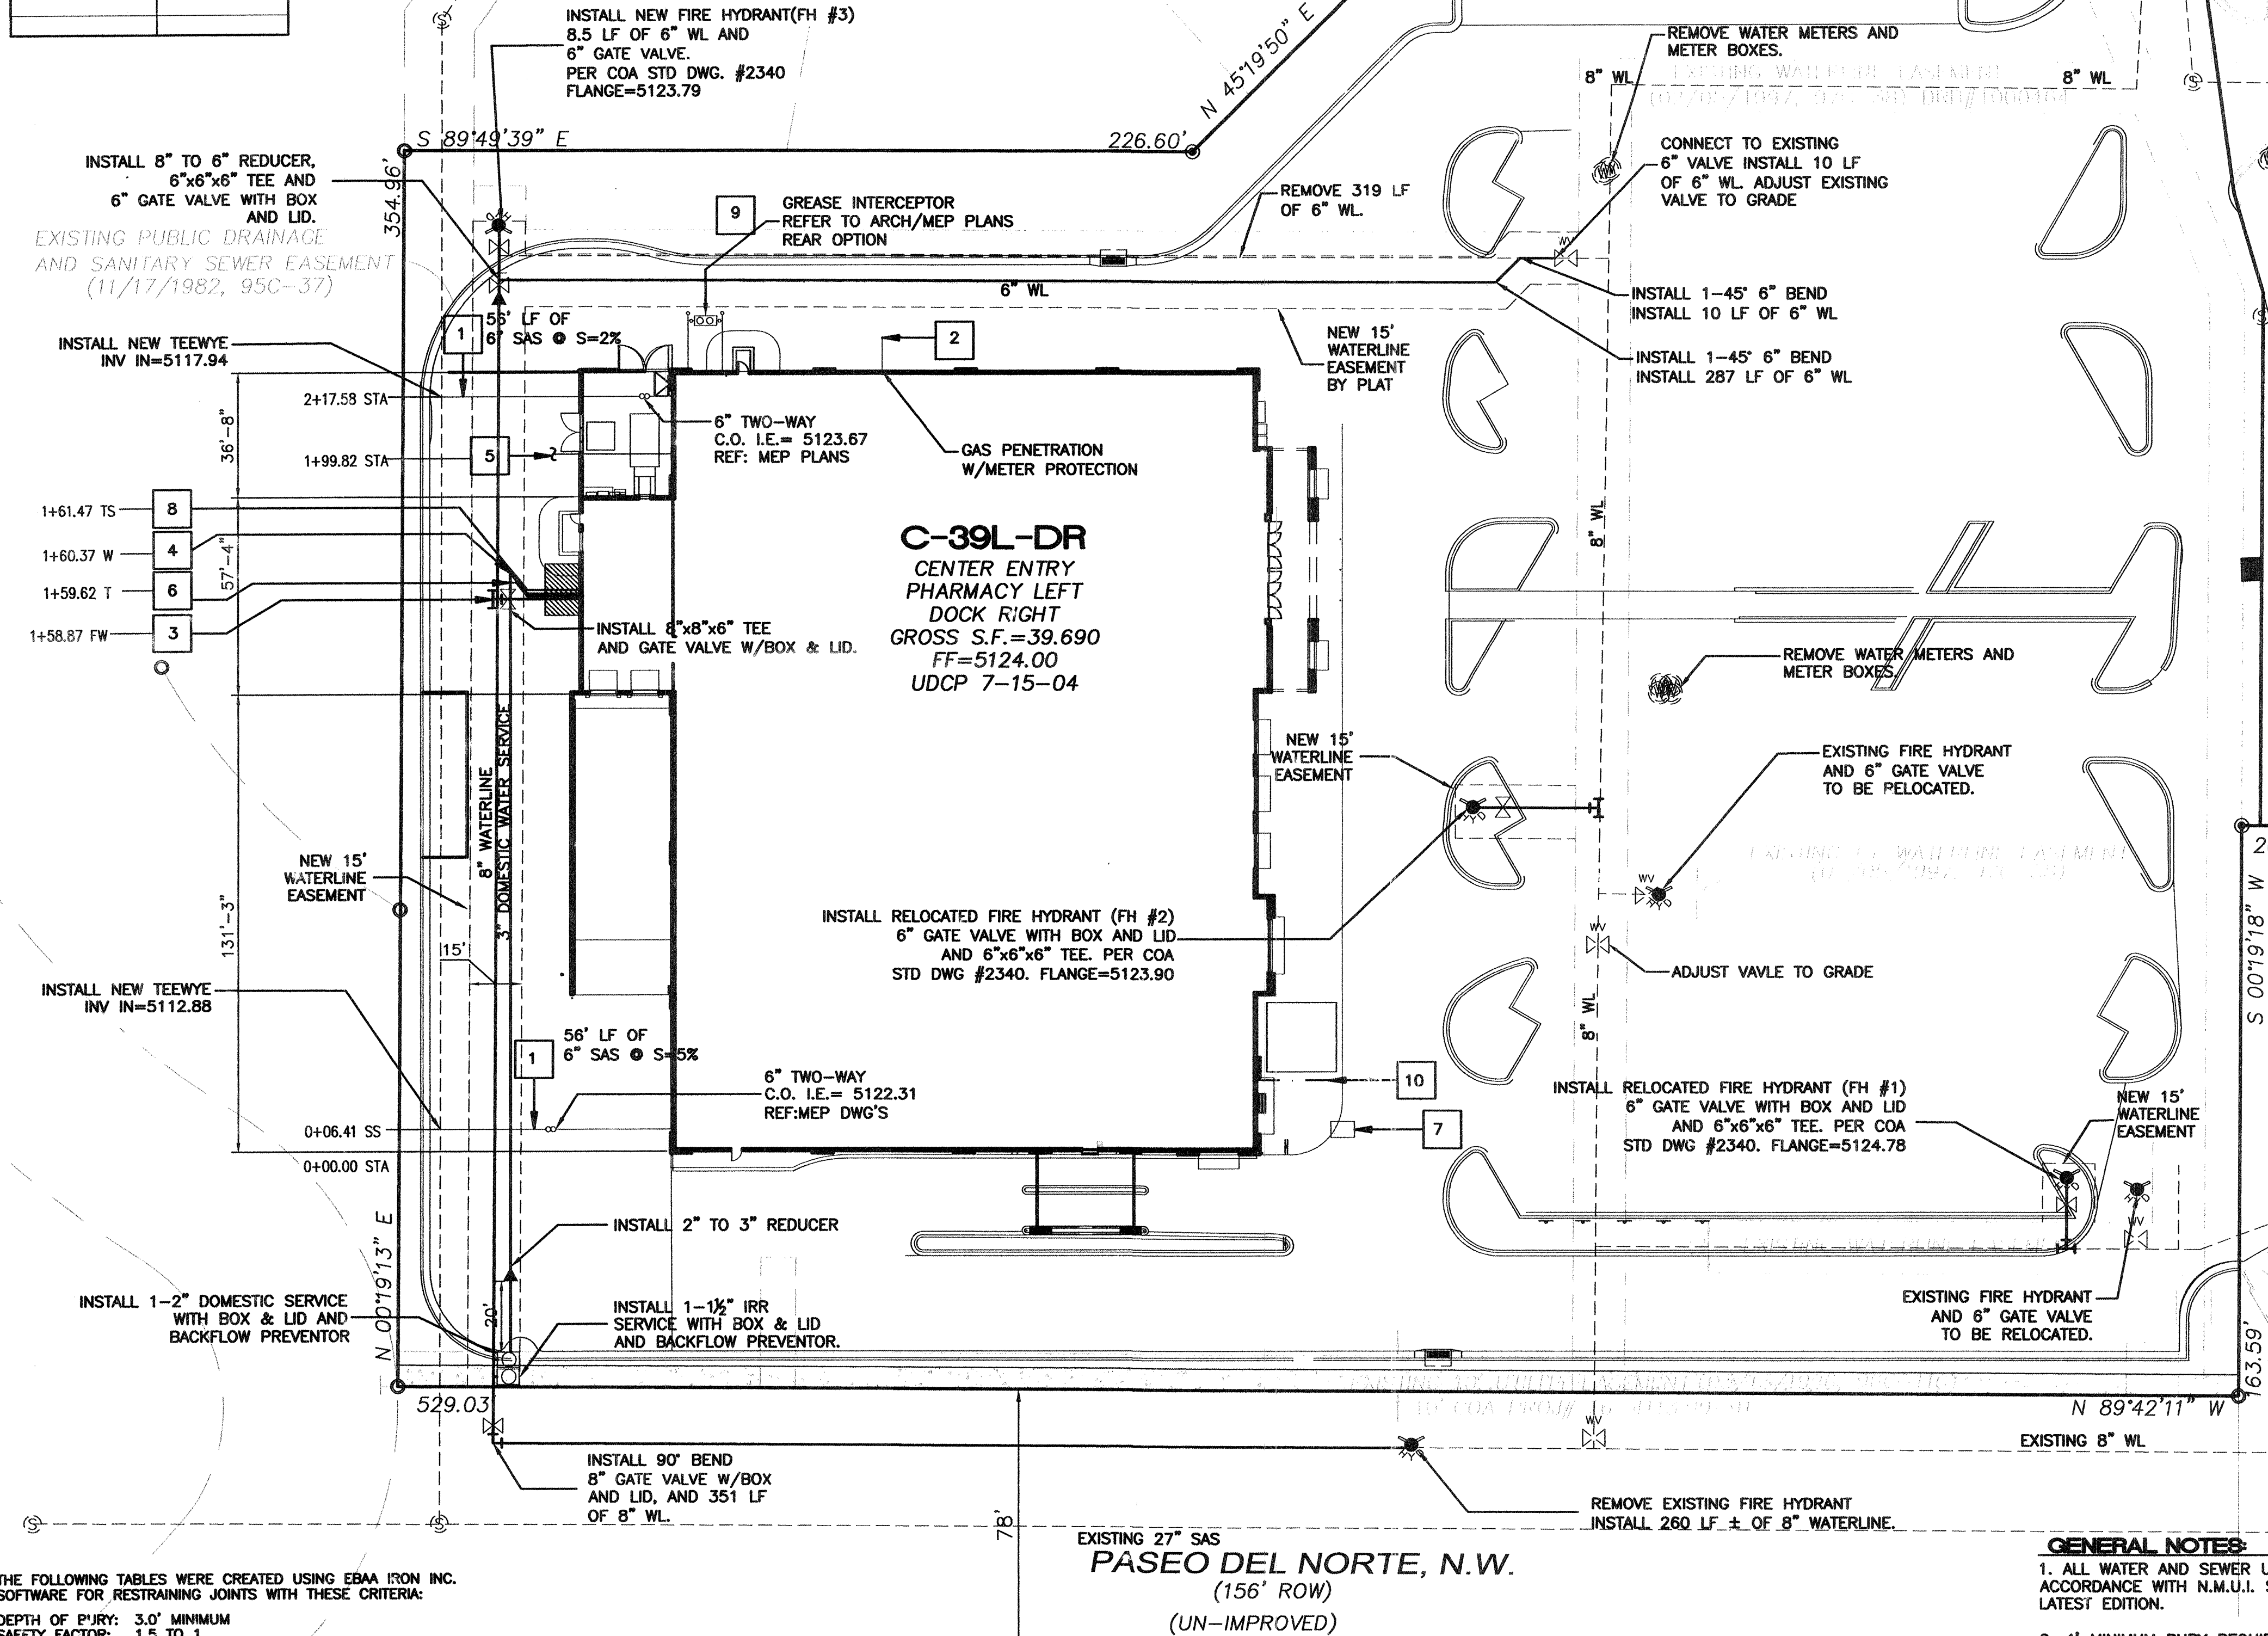

THE FOLLOWING TABLES WERE CREATED USING EBAA IRON INC.
SOFTWARE FOR RESTRAINING JOINTS WITH THESE CRITERIA:

DEPTH OF BURY: 3.0' MINIMUM
SAFETY FACTOR: 1.5 TO 1
PIPE MATERIAL: PVC
SOIL TYPE: GM/SM-SILTY GRAVEL/SILTY SAND, GRAVEL-SAND MIXTURES
TEST PRESSURE: 150 PSI
TRENCH TYPE 3: PIPE BEDDED IN 4" MINIMUM LOOSE SOIL
BACKFILL LIGHTLY CONSOLIDATED TO TOP OF PIPE

THESE LENGTHS WILL BE AFFECTED IF THE TYPE OF MATERIAL,
GREATER DEPTH OF BURY, ETC. CHANGES. THESE MUST BE
RECALCULATED BY THE DESIGN ENGINEER PRIOR TO
CONSTRUCTION.

RESTRAINED JOINT LENGTHS FOR TEES*	
SIZE	LENGTH ALONG RUN**
12x12x12	14 18 22 25 29 33
12x12x10	6 10 14 19 23 28
12x12x8	1 1 7 12 18 23
12x12x6	1 1 1 3 10 18
12x12x4	1 1 1 1 2 12
10x10x10	9 13 17 20 24 28
10x10x8	1 1 5 10 14 19 23
10x10x6	1 1 1 1 1 4 12
10x10x4	1 1 1 1 1 1 2
8x8x8	5 9 13 16 20 23
8x8x6	1 1 3 8 13 18
8x8x4	1 1 1 1 1 1 6
8x8x2	1 3 7 10 14 18
8x8x1	1 1 1 1 1 1 2

*RESTRAINTS ONLY PLACED ON THE BRANCH
**LENGTH ALONG RUN REFERS TO THE LENGTH OF PIPE ON
EITHER SIDE OF THE TEE BEFORE THE NEXT JOINT.

RESTRAINED JOINT LENGTHS FOR HORIZONTAL BENDS, VALVES, AND DEAD ENDS (EACH SIDE)	
SIZE	HORIZONTAL BENDS
12	15 6 3 1 34
10	13 5 3 1 29
8	11 4 2 1 24
6	8 3 2 1 18
4	6 2 1 N/A 13

RESTRAINED JOINT LENGTHS FOR REDUCERS***	
SIZE	L. SIDE
12x10	17 10x6 18
12x8	18 10x4 23
12x6	25 8x6 10
12x4	29 8x4 17
10x8	10 6x4 9

***RESTRAINTS ONLY PLACED ON LARGE LARGE SIDE

THE FOLLOWING TABLES WERE CREATED USING EBAA IRON INC.
SOFTWARE FOR RESTRAINING JOINTS WITH THESE CRITERIA:

DEPTH OF BURY: 3.0' MINIMUM
SAFETY FACTOR: 1.5 TO 1
PIPE MATERIAL: PVC
SOIL TYPE: GM/SM-SILTY GRAVEL/SILTY SAND, GRAVEL-SAND MIXTURES
TEST PRESSURE: 150 PSI
TRENCH TYPE 3: PIPE BEDDED IN 4" MINIMUM LOOSE SOIL
BACKFILL LIGHTLY CONSOLIDATED TO TOP OF PIPE

THESE LENGTHS WILL BE AFFECTED IF THE TYPE OF MATERIAL,
GREATER DEPTH OF BURY, ETC. CHANGES. THESE MUST BE
RECALCULATED BY THE DESIGN ENGINEER PRIOR TO
CONSTRUCTION.

RESTRAINED JOINT LENGTHS FOR VERTICAL OFFSETS/BENDS (EACH SIDE)	
SIZE	HORIZONTAL BENDS
12	14 7 3 1
10	12 6 3 1
8	10 5 2 1
6	8 4 2 1
4	6 3 1 N/A

THESE LENGTHS WILL BE AFFECTED IF THE TYPE OF MATERIAL,
GREATER DEPTH OF BURY, ETC. CHANGES. THESE MUST BE
RECALCULATED BY THE DESIGN ENGINEER PRIOR TO
CONSTRUCTION.

KEYED NOTES

- SANITARY SEWER EXIT
- GAS ENTRY; RE: FUEL STUDY
- 6" FIRE LINE ENTRY
- 3" DOMESTIC WATERLINE
WITH 2" TO 3" REDUCER
- ELECTRICAL ENTRY
PAD LOCATION WITH MEP
TELEPHONE ENTRY
- (1) 1-1/2" CONDUIT FOR
IRRIGATION CONTROL ENTRY
- (1) 1" CONDUIT FOR FIRE
PROTECTION TAMPER SWITCH
COORDINATE NEED FOR T.S.
WITH FIRE PROTECTION
ENGINEER
- 2,000 GAL SANITARY SEWER
GREASE INTERCEPTOR


GENERAL NOTES

- ALL WATER AND SEWER UTILITY WORK TO BE DONE IN
ACCORDANCE WITH N.M.U.I. STANDARDS AND SPECIFICATIONS
LATEST EDITION.
- 4" MINIMUM BURY REQUIRED FOR ALL UTILITIES UNLESS
OTHERWISE NOTED.
- REFERENCE ARCHITECTURAL PLANS FOR WATER LINE RISER
LOCATIONS.
- CLEAN OUTS ARE TO BE BUILT PER UNIFORM PLUMBING
CODE STANDARDS.
- ALL PLUMBING PIPE MATERIAL TO BE USED PER UPC.
- FIRE LINE AND DOMESTIC WATERLINE MUST HAVE
BACKFLOW PREVENTORS PER UPC. IF BACKFLOW PREVENTOR
IS INSTALLED EXTERIOR OF BUILDING A HOT BOX SHALL BE
INSTALLED AND USED.
- ALL EX. SD INLETS AND MH SHALL HAVE CONCRETE
COLLARS POURED AND BE ADJUSTED TO FINISHED GRADE.
- ALL EXCAVATION, TRENCHING AND SHORING ACTIVITIES
MUST BE CARRIED-OUT IN ACCORDANCE WITH OSHA 29
CFR 1926.650 SUBPART P.
- ALL UTILITY DISTANCES SHOWN ARE FOR REFERENCE ONLY.

NMUI APPROVAL

NOTICE TO CONTRACTORS

- AN EXCAVATION/CONSTRUCTION PERMIT WILL BE REQUIRED
BEFORE BEGINNING ANY WORK WITHIN CITY RIGHT-OF-WAY.
AN APPROVED COPY OF THESE PLANS MUST BE SUBMITTED
AT THE TIME OF APPLICATION FOR THIS PERMIT.
- ALL WORK DETAILED ON THESE PLANS TO BE PERFORMED,
EXCEPT AS OTHERWISE STATED OR PROVIDED HEREON, SHALL
BE CONSTRUCTED IN ACCORDANCE WITH NMUI SPECIFICATIONS
FOR WATER AND WASTEWATER FACILITIES (MOST RECENT REVISIONS).
- TWO WORKING DAYS PRIOR TO ANY EXCAVATION, CONTRACTOR
MUST CONTACT NEW MEXICO ONE CALL SYSTEM (260-1999),
FOR LOCATION OF EXISTING UTILITIES. THREE WORKING DAYS PRIOR
THE CONTRACTOR MUST CONTACT NMUI (898-2661).
- PRIOR TO CONSTRUCTION, THE CONTRACTOR SHALL
EXCAVATE AND VERIFY THE HORIZONTAL AND VERTICAL
LOCATIONS OF ALL CONSTRUCTIONS. SHOULD A CONFLICT
EXIST, THE CONTRACTOR SHALL NOTIFY THE ENGINEER SO
THAT THE CONFLICT CAN BE RESOLVED WITH A MINIMUM
AMOUNT OF DELAY.
- BACKFILL COMPACTION SHALL BE ACCORDING TO
RESIDENTIAL STREET USE.
- MAINTENANCE OF THESE FACILITIES SHALL BE THE
RESPONSIBILITY OF THE OWNER OF THE PROPERTY SERVED.
- WORK ON ARTERIAL STREETS SHALL BE PERFORMED ON A
24-HOUR BASIS.
- CONTRACTOR IS RESPONSIBLE TO PROVIDE UTILITY STUBS
5' FROM BUILDING
- CONTRACTOR SHALL DETERMINE LOCATION OF ANY
UNDERGROUND FACILITY IN OR NEAR WORK AREAS, INCLUDING
REQUESTS TO OWNERS/OPERATORS OF SAID FACILITIES PER
SECTION 62-14-5 NMSA 1978.
- CONTRACTOR SHALL PLAN ALL EXCAVATION TO MINIMIZE
INTERFERENCE OR DAMAGE OF UNDERGROUND FACILITIES.
- CONTRACTOR SHALL PROVIDE ADVANCE TELEPHONE
NOTICE OF COMMENCEMENT, EXTENT AND DURATION OF ALL
EXCAVATION WORK TO THE ONE-CALL NOTIFICATION SYSTEM,
OR TO OWNERS/OPERATORS OF ANY EXISTING UNDERGROUND
FACILITY IN OR NEAR THE EXCAVATION AREA THAT ARE NOT
MEMBERS OF THE ONE-CALL NOTIFICATION CENTER; IN ORDER
THAT OWNERS/OPERATORS MAY LOCATE AND MARK
UNDERGROUND FACILITY PER SECTION 62-14-5 NMSA 1978
PRIOR TO ANY COMMENCEMENT OF WORK. CONTRACTOR
SHALL REQUEST REAFFIRMATION OF LOCATION EVERY TEN (10)
WORKING DAYS AFTER INITIAL REQUEST.
- CONTRACTOR SHALL MAINTAIN EIGHTEEN (18) INCHES
BETWEEN EXISTING UNDERGROUND FACILITIES FOR WHICH
HAVE BEEN PREVIOUSLY IDENTIFIED AND MARKED BY THE
OWNERS/OPERATORS OF SAID FACILITIES. CUTTING EDGE OR
POINT OF ANY MECHANICAL EXCAVATING EQUIPMENT UTILIZED
IN EXCAVATION AREA WILL BE USED IN A MANNER
NECESSARY TO PREVENT DAMAGE TO EXISTING UNDERGROUND
FACILITIES.
- CONTRACTOR SHALL PROVIDE SUPPORT FOR EXISTING
UNDERGROUND FACILITIES IN OR NEAR EXCAVATION AREA AS
NECESSARY TO PREVENT DAMAGE TO SAID FACILITIES.
- CONTRACTOR SHALL BACKFILL ALL EXCAVATIONS IN A
MANNER AND WITH MATERIALS AS MAY BE NECESSARY TO
PREVENT DAMAGE TO AND PROVIDE RELIABLE SUPPORT
DURING AND FOLLOWING BACK FILLING ACTIVITIES FOR
PREEXISTING UNDERGROUND FACILITIES IN OR NEAR
EXCAVATION AREA.
- CONTRACTOR SHALL IMMEDIATELY NOTIFY BY TELEPHONE
THE OWNER/OPERATOR OF ANY UNDERGROUND FACILITY
WHICH MAY HAVE BEEN DAMAGED OR DISLODGED DURING
EXCAVATION WORK.
- CONTRACTOR SHALL NOT MOVE OR OBLITERATE MARKINGS
MADE PURSUANT TO CHAPTER 62, ARTICLE 14 NMSA 1978,
OR FABRICATE MARKINGS IN A UNMARKED LOCATION FOR THE
PURPOSE OF CONCEALING OR AVOIDING LIABILITY FOR
VIOLATION OF OR NONCOMPLIANCE WITH THE PROVISIONS OF
CHAPTER 62, ARTICLE 11 NMSA 1978.

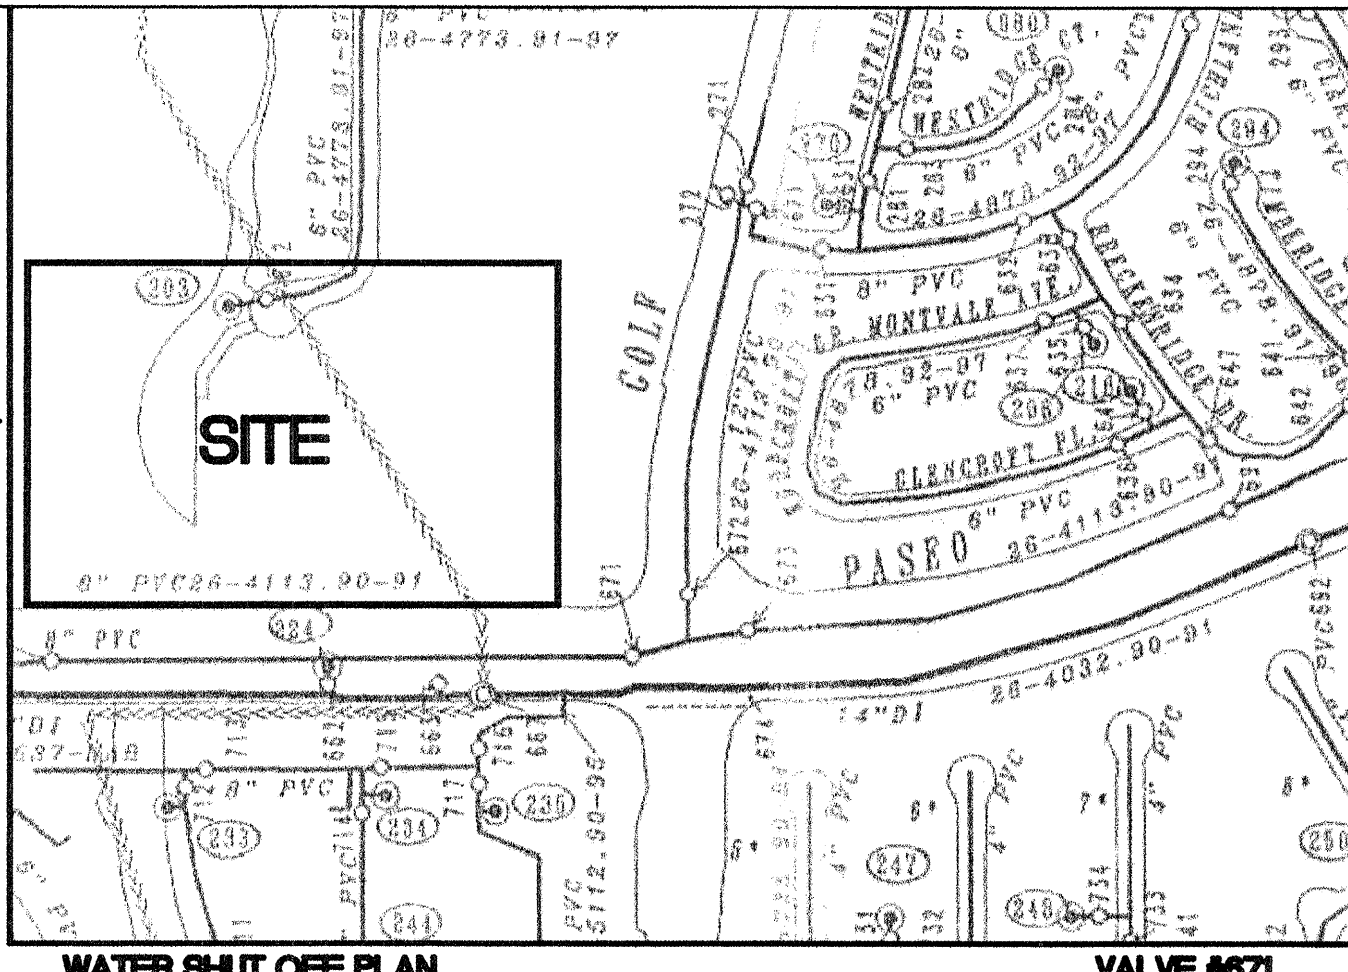

WATER SHUT OFF PLAN

VALVE #671

- NOTES:
- WATER SHUTOFF SHALL BE COORDINATED WITH NEW MEXICO UTILITIES, INC.
 - ONLY WATER SYSTEMS PERSONNEL ARE AUTHORIZED TO OPERATE VALVES.
 - NOTIFY NEW MEXICO UTILITIES (898-2661) THREE(3) WORKING DAYS IN
ADVANCE OF EXECUTION OF THE WATER SHUTOFF PLAN
 - ALL WATERLINE CONNECTIONS, CAP, JOINTS TO BE BLOCKED
PER DETAILS THIS SHEET
 - ALL WATERLINES TO BE PVC, UNLESS OTHERWISE NOTED.
 - SHUTOFF VALVES INDICATED IN THE ABOVE PLAN IN THE EVENT
OF EMERGENCY

LEGEND

- EXISTING SAS MANHOLE
- EXISTING SANITARY SEWER LINE
- PROPOSED SAS MANHOLE
- PROPOSED SAS CLEANOUT
- DIRECTION OF FLOW
- PROPOSED SANITARY SEWER LINE
- SANITARY SEWER SERVICE LINE
- EXISTING METER
- EXISTING VALVE W/BOX
- EXISTING FIRE HYDRANT
- EXISTING WATER LINE
- PROPOSED METER
- PROPOSED VALVE W/BOX
- PROPOSED FIRE HYDRANT
- PROPOSED WATER LINE
- PROPOSED CURB
- BOUNDARY LINE
- PROPOSED STORM SEWER MANHOLE
- PROPOSED SNGL. "D" INLET
- PROPOSED STORM SEWER LINE
- PROPOSED DRY UTILITY TRENCH
- EXISTING DRY UTILITY TRENCH

FOR INFORMATION ONLY

CAUTION:
ALL EXISTING UTILITIES SHOWN WERE OBTAINED FROM
RESEARCH, AS-BUILTS, SURVEYS OR INFORMATION
PROVIDED BY OTHERS. IT SHALL BE THE SOLE
RESPONSIBILITY OF THE CONTRACTOR TO CONDUCT ALL
NECESSARY FIELD INVESTIGATIONS PRIOR TO AND
INCLUDING ANY EXCAVATION, TO DETERMINE THE ACTUAL
LOCATION OF UTILITIES AND OTHER IMPROVEMENTS, PRIOR
TO STARTING THE WORK. ANY CHANGES FROM THIS PLAN
SHALL BE COORDINATED WITH AND APPROVED BY THE
ENGINEER.

NO.	DATE	REMARKS	BY
REVISIONS			
ENGINEER'S SEAL			
WAL-MART NEIGHBORHOOD MARKET #3317 8511 GOLF COURSE RD. N.W.			
MASTER UTILITY PLAN			
DRAWN BY: RW.T DATE: 11-03-2004 2387MUO-10-27-04X			
DRC SHEET # 5 OF 9 OTB SHEET # 9 OF 27 JOB # 230087			


TIERRA WEST, LLC
8509 JEFFERSON NE
ALBUQUERQUE, NEW MEXICO 87113
(505)859-3100


753181

CERTIFICATE OF SUBSTANTIAL COMPLIANCE ON PLANS

1. VERTICAL SURFACES SHALL BE COATED WITH THOROCOAT, COLOR TO BE APPROVED BY ENGINEER.
2. CHANNEL CONCRETE SHALL BE TINTED WITH SAN DIEGO BUFF. ONE POUND PER SACK OF CEMENTITIOUS MATERIAL.

SCALE: HORIZ. 1"=50
VERT. 1"= 5

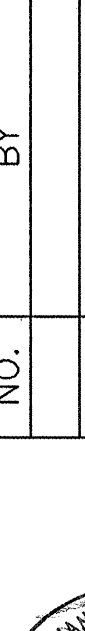1	5-09-06	REVISED 36" SD	EMT	ENGINEER'S SEAL	SURVEY INFORMATION			BENCH MARKS			AS BUILT INFORMATION		
					FIELD NOTES			ACS MONUMENT "NM 448-N8"			CONTRACTOR	200606	
					NO.	BY	DATE	STANDARD ACS BRASS TABLET (FOUND IN PLACE)			STAKED BY	DATE	
		REMARKS	BY					NW STATE PLANE COORDINATES			INSPECTOR'S	DATE	
		REVISIONS						Central Zone - NAD 1927			FIELD ADJUSTANCE BY	DATE	
		DESIGN						X=372,524.25			VERIFICATION BY	DATE	
		DESIGNED BY: BW					Y=1,514,838.11			DATE CORRECTED BY	DATE		
		DRAWN BY: EMT					G-G=0.99967854			RECORDED BY	DATE		
		DATE: 05-09-06					=-00714.44			NO.			
		JOB NO.: 23087					ELEV= 5018.92						
		CHECKED BY: BR											

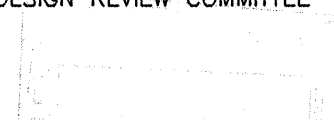CITY OF ALBUQUERQUE PUBLIC WORKS DEPARTMENT ENGINEERING GROUP				
TITLE: WAL-MART NEIGHBORHOOD MARKET # 3317-00 STORM SEWER IMPROVEMENTS PASEO DEL NORTE & GOLF COURSE RD				
DESIGN REVIEW COMMITTEE	CITY ENGINEER APPROVAL	JUST DESIGN UPDATE	MO./DAY/YR.	MO./DAY/YR.
				
CITY PROJECT NO.	ZONE MAP NO.	SHEET	OF	
753181	C-12-Z	6	9	

GENERAL NOTES

-CODES AND MANUALS

- INTERNATIONAL BUILDING CODE 2003

DESIGN CRITERIA

- WIND LOADING = 90 MPH EXPOSURE C
- SEISMIC DESIGN CATEGORY D
 - $S_s = 0.601$
 - $S_1 = 0.179$

CONCRETE REINFORCING

- ALL REINFORCING STEEL SHALL BE NEW STOCK DEFORMED BARS CONFORMING TO ASTM A615 GRADE 60.
- ALL BENDS SHALL BE MADE COLD.
- ALL REINFORCING STEEL SHALL BE SECURELY WIRED AND PROPERLY SUPPORTED ABOVE THE GROUND AND AWAY FROM FORMS.
- PROVIDE CORNER BARS THE SAME SIZE AND SPACING AS THE HORIZ. REINF. AT THE CORNERS AND INTERSECTION OF ALL WALLS.

CONCRETE


- PROTECT CONCRETE FROM DAMAGE OR REDUCED STRENGTH CAUSED BY FROST, FREEZING ACTIONS OR LOW TEMPERATURES IN COMPLIANCE WITH THE FOLLOWING: WHEN THE TEMPERATURE FALLS BELOW 40 DEGREES FAHRENHEIT, UNIFORMLY HEAT WATER AND AGGREGATES BEFORE MIXING TO OBTAIN A CONCRETE MIXTURE TEMPERATURE OF NOT LESS THAN 50 DEGREES FAHRENHEIT AND NOT MORE THAN 60 DEGREES FAHRENHEIT AT POINT OF PLACEMENT.
- PROTECT CONCRETE FROM DAMAGE OR REDUCED STRENGTH CAUSED BY HIGH TEMPERATURES IN COMPLIANCE WITH THE FOLLOWING: UNIFORMLY COOL WATER AND AGGREGATES BEFORE MIXING TO OBTAIN A CONCRETE MIXTURE TEMPERATURE OF NOT MORE THAN 90 DEGREES FAHRENHEIT AT POINT OF PLACEMENT.
- REMOVE ALL DEBRIS FROM FORMS BEFORE POURING.
- THE CONTRACTOR SHALL OBTAIN THE ENGINEERS' APPROVAL OF CONSTRUCTION LOCATION LOCATIONS.
- ALL DIMENSIONS SHOWING THE LOCATION OF REINFORCING STEEL NOT NOTED AS "CLEAR" ARE TO CENTER OF STEEL BARS.
- COVER FOR CONCRETE SHALL BE AS FOLLOWS:

	MIN. COVER	TOLERANCES + OR -
CAST AGAINST PERM. EXPOSED TO EARTH	3"	3/8"
EXPOSED TO EARTH OR WEATHER		
NO. 5 AND SMALLER BARS	1-1/2"	3/8"
NO. 6 AND LARGER BARS	2"	3/8"


CONCRETE QUALITY :

CONCRETE USE	STRENGTH @ 28 DAYS	MAX. SLUMP	AIR	MAX. AGG.	AGG. TYPE
HEADWALL	4000 PSI	4"	4 %	1-1/2"	HARD-- ROCK


- TOLERANCES FOR LONGITUDINAL LOCATION OF BENDS AND ENDS OF REINFORCEMENT SHALL BE PLUS OR MINUS (2) INCHES EXCEPT AT DISCONTINUOUS ENDS OF MEMBERS WHERE TOLERANCE SHALL BE PLUS OR MINUS 1/2 INCH.
- ONE GRADE OF CONCRETE SHALL BE POURED AT THE JOB SITE AT ANY ONE TIME.
- REINFORCING FOR CONCRETE POURED ON GROUND SHALL BE SUPPORTED BY CHAIRS.
- AGGREGATE SIZE SHALL CONFORM TO ASTM C33.
- CEMENT SHALL BE TYPE I OR II AND SHALL CONFORM TO ASTM C130.
- CONCRETE MIXES SHALL BE SUBMITTED IN ACCORDANCE WITH USC REQUIREMENTS FOR DESIGN OR STRENGTH TESTS SHALL BE SUBMITTED TO THE ENGINEER FOR REVIEW PRIOR TO USE.
- NO MORE THAN 90 MINUTES SHALL ELAPSE BETWEEN CONCRETE BATCHING AND CONCRETE PLACEMENT UNLESS APPROVED BY TESTING ENGINEER. CONCRETE SHALL BE PLACED WITHIN 15 MINUTES AFTER DISCHARGE.

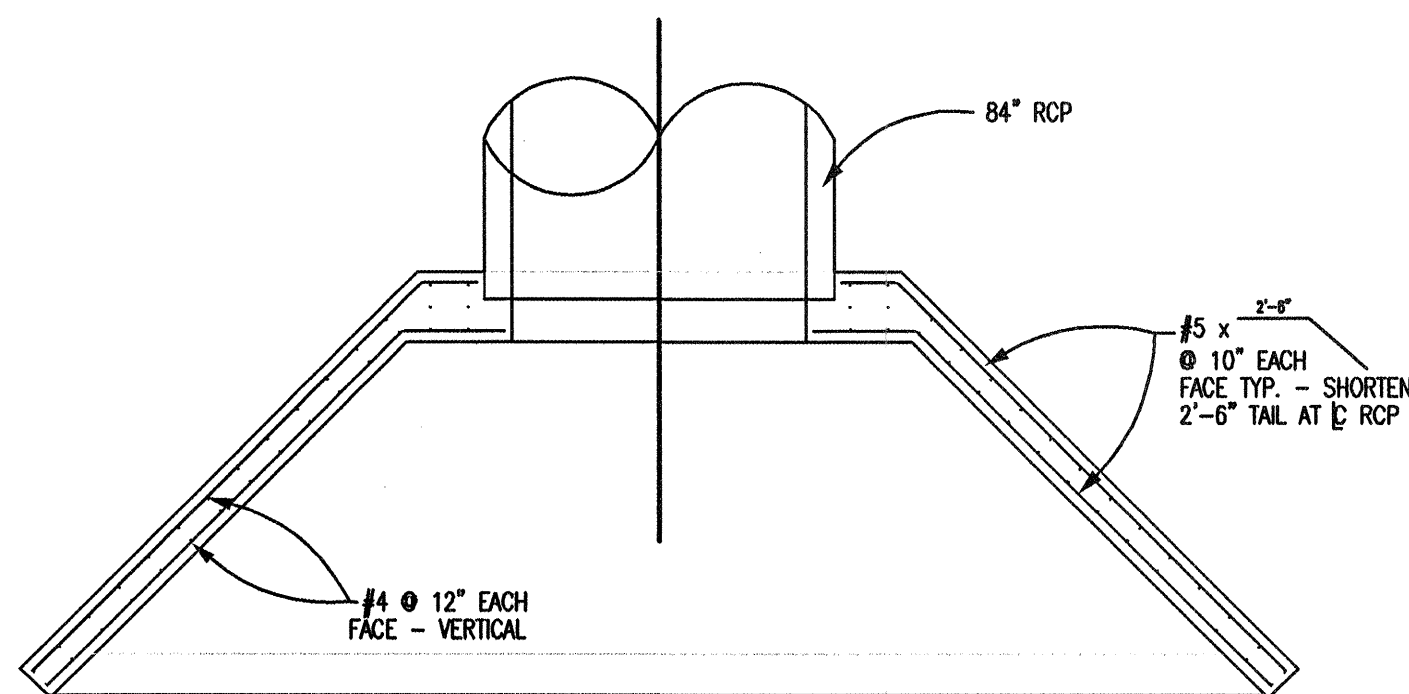


SECTION - B

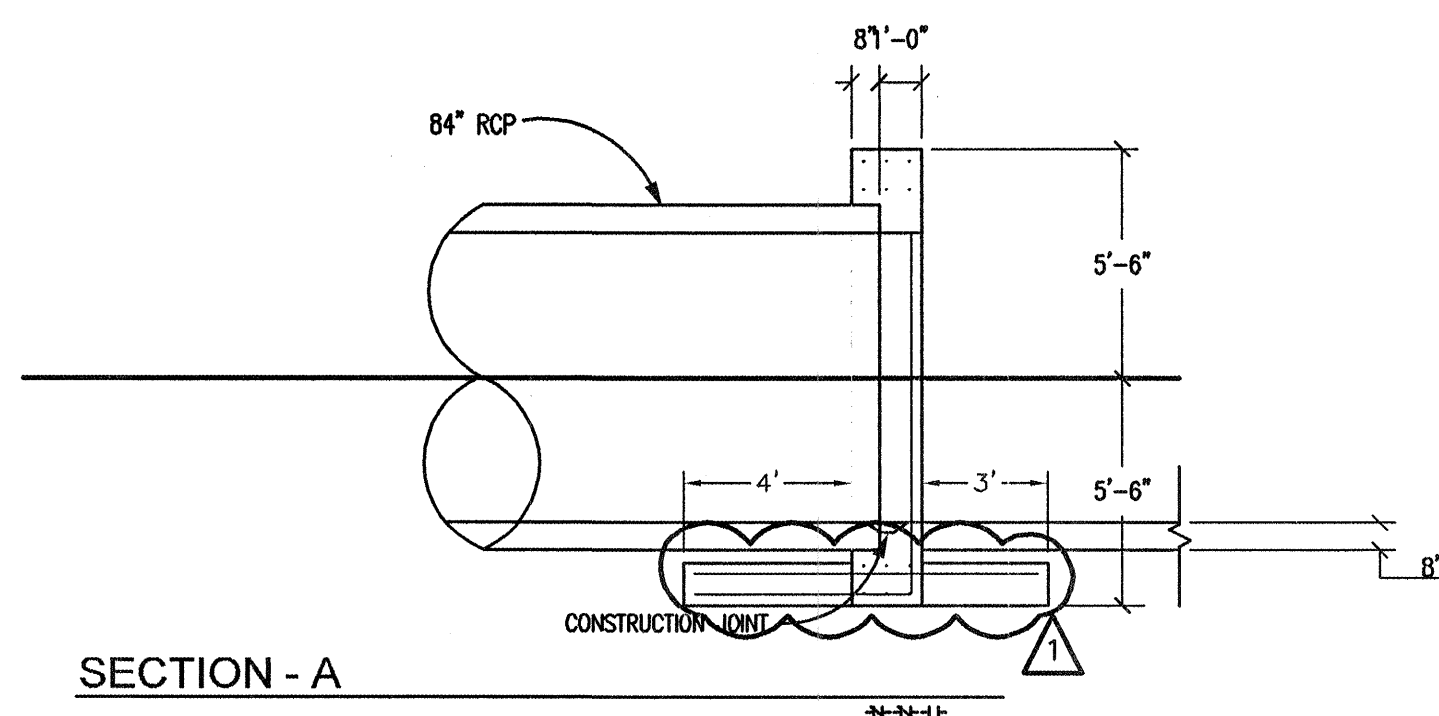


SECTION - A

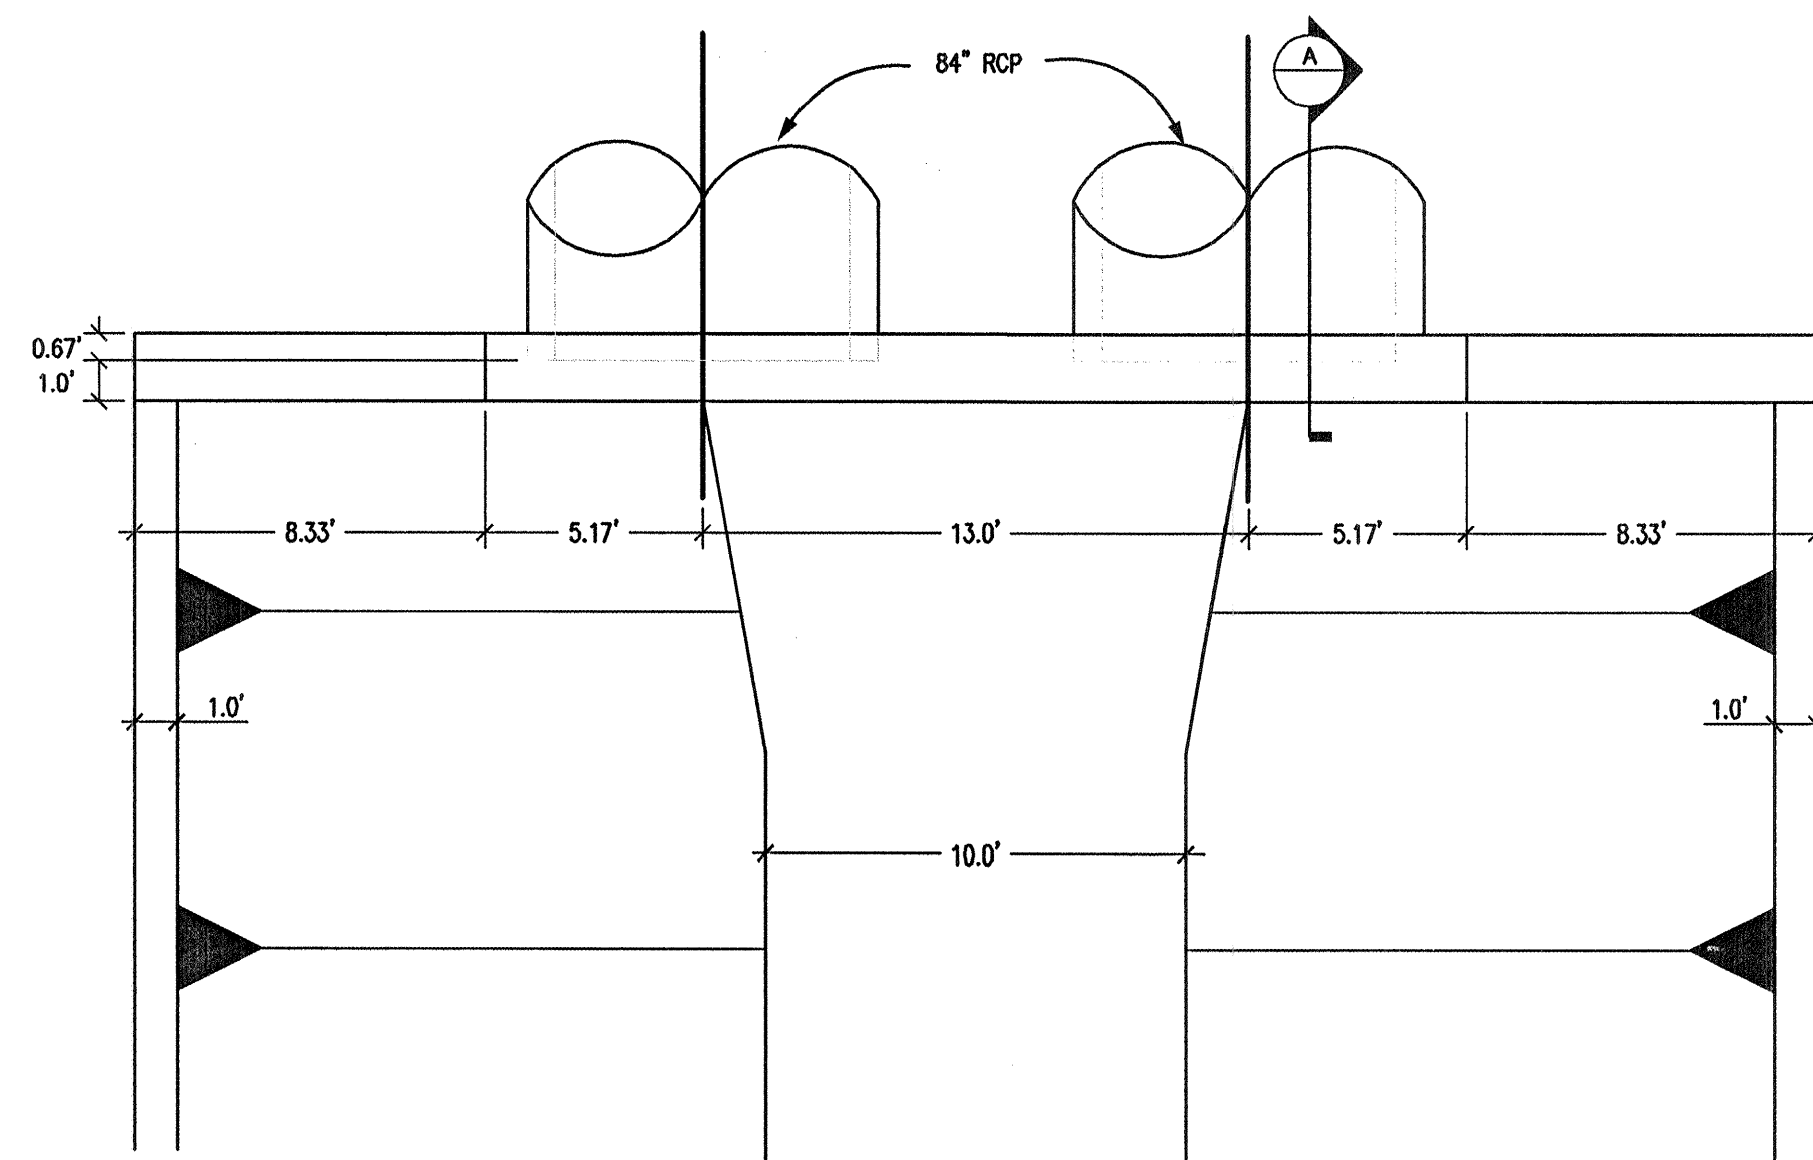


PLAN

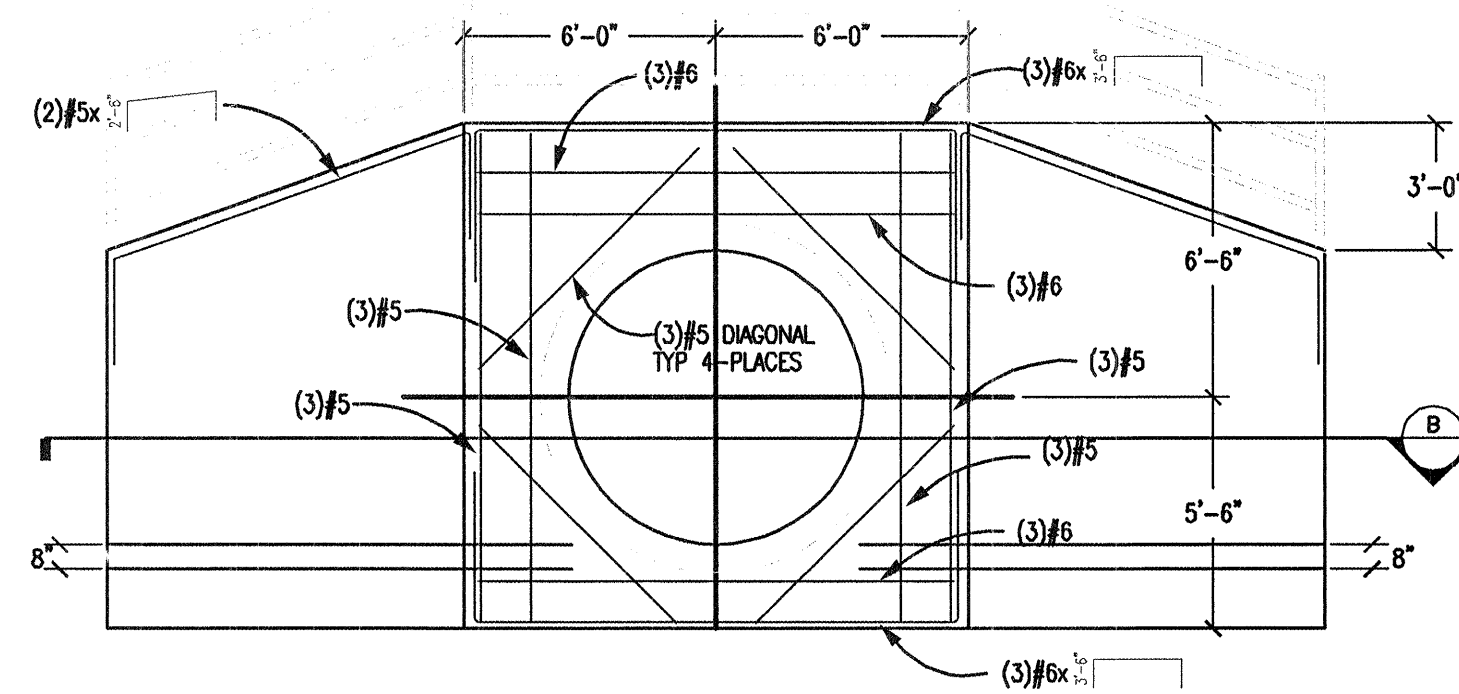


HEADWALL AT STATION 14+14.90

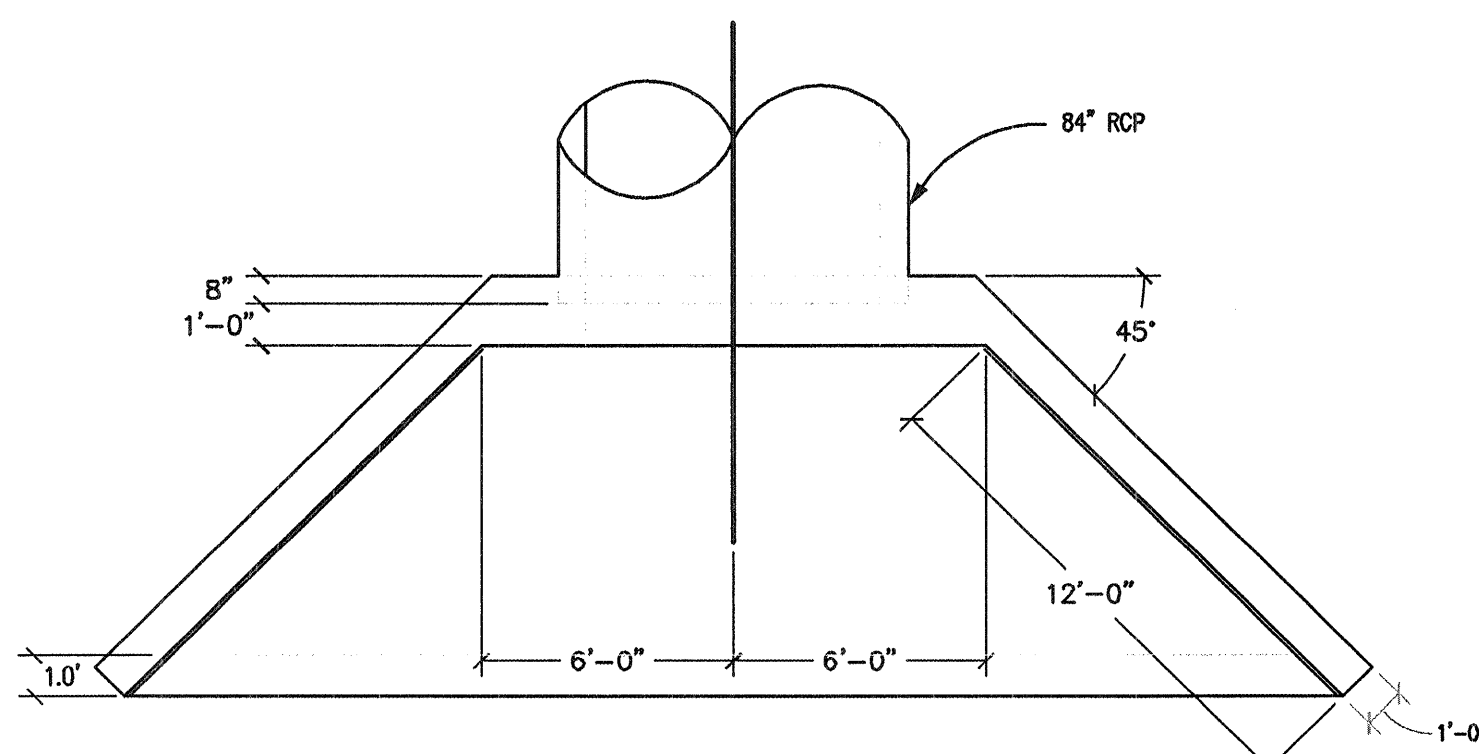

PLAN

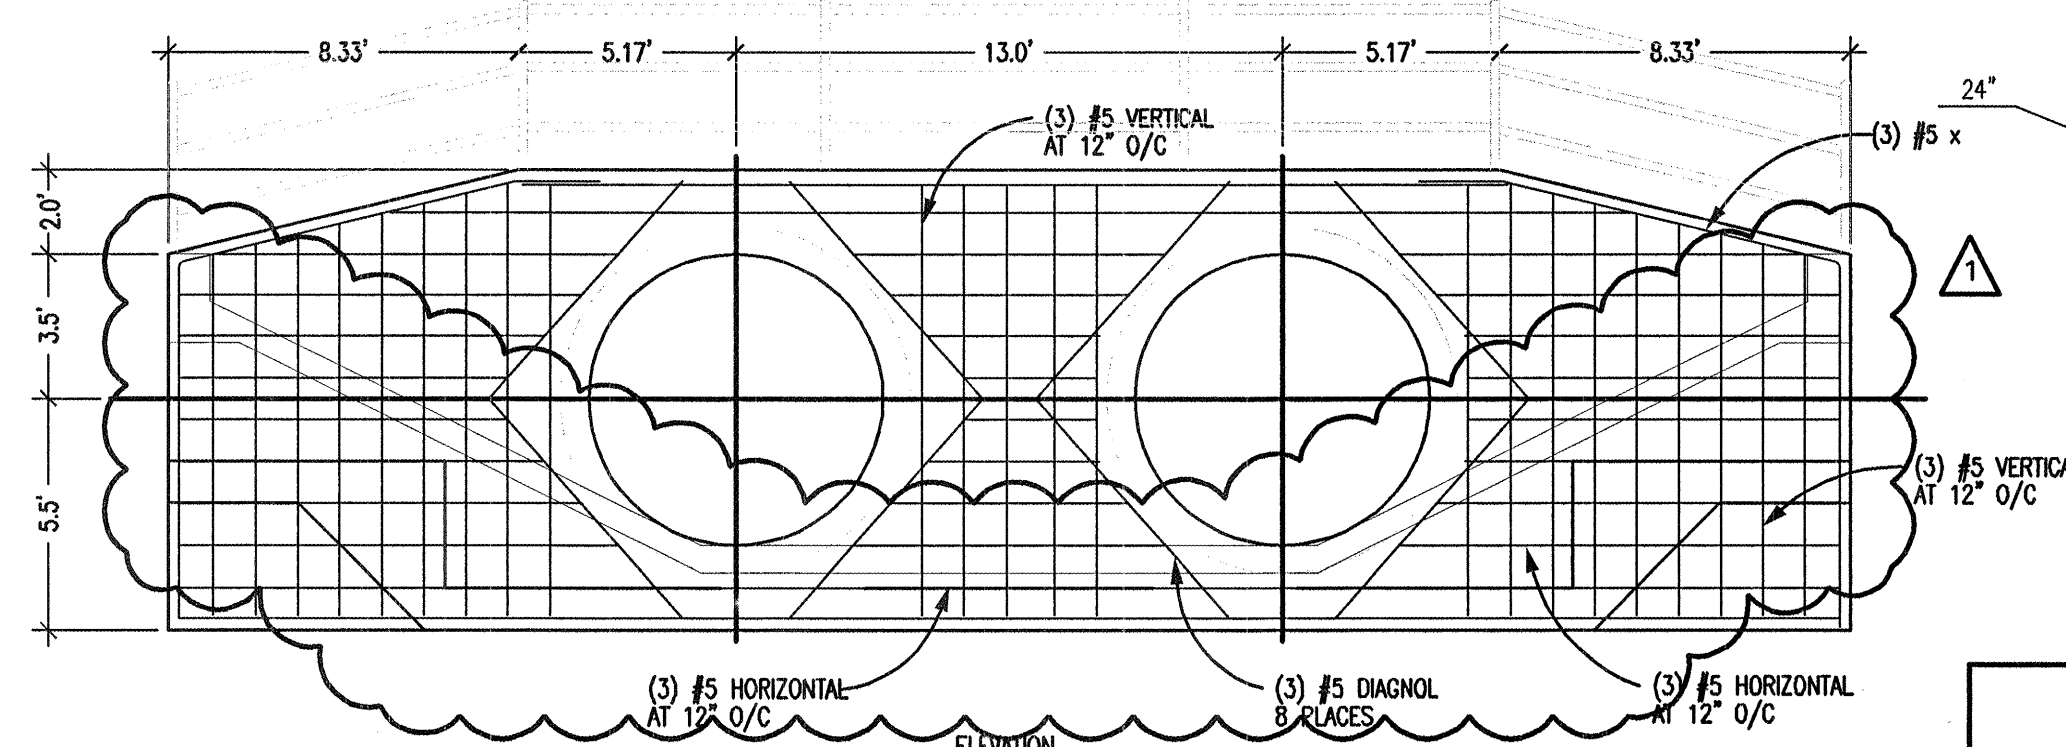

HEADWALL AT STATION 12+10.67

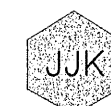

JKK Group, Inc.
Consulting Structural Engineers



3240-C Juan Tabo NE Albuquerque, New Mexico 87111 tel. 505 296 5706 fax 505 296-1672


NOTE TO CONTRACTOR:

1. VERTICAL SURFACES SHALL BE COATED WITH THOROCOAT, COLOR TO BE APPROVED BY ENGINEER.
2. CHANNEL CONCRETE SHALL BE TINTED WITH SAN DIEGO BUFF. ONE POUND PER SACK OF CEMENTITIOUS MATERIAL.

CERTIFICATE OF SUBSTANTIAL COMPLIANCE ON PLANS



I, Ronald R. Bohannon, of the firm of Tierra West LLC, a Registered Professional Engineer in the State of New Mexico, do hereby certify, to the best of my knowledge and belief, that the infrastructure installed as part of this project has been inspected by me or by a qualified person under my direct supervision and has been constructed in accordance with the plans and specifications approved by the City Engineer and that the original design intent of the approved plans has been met, except as noted by me on the as-built construction drawings. This Certification is based on site inspections by me or personnel under my direction with survey information provided by Baseline Field Services NMPLS # 5110
Surv-Tek NMPLS # 9750.

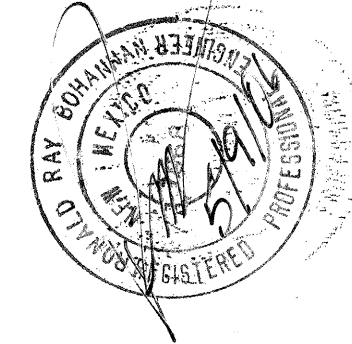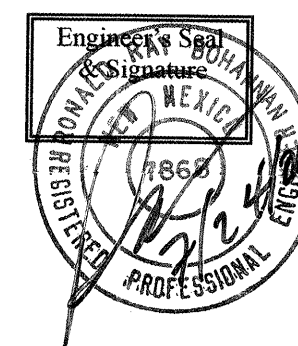[illegible]

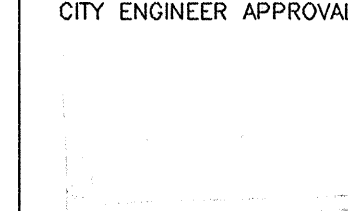
		TIERRA WEST, LLC 8509 JEFFERSON NE ALBUQUERQUE, NEW MEXICO 87113 (505)858-3100				1	5-08	DATE	DESIGNED BY:	DRAWN BY:	CHECKED BY:	DRAWN NAME:
CITY OF ALBUQUERQUE PUBLIC WORKS DEPARTMENT ENGINEERING GROUP												
TITLE: <i>WAL-MART NEIGHBORHOOD MARKET #3317-00</i> <i>8511 GOLF COURSE RD. N.W., ALBUQUERQUE, N.M.</i> HEADWALL DETAILS												
C'DSIGN REVIEW COMMITTEE				CITY ENGINEER APPROVAL				LAST DESIGN UPDATE	MO./DAY/YR.		MO./DAY/YR.	
												
CITY PROJECT NO.				ZONE MAP NO.		SHEET		OF				
753181				C-12-N		8		9				

CERTIFICATE OF SUBSTANTIAL COMPLIANCE ON PLANS


I, Ronald R. Bohman, of the firm of Tierra West LLC, a Registered Professional Engineer in the State of New Mexico, do hereby certify, to the best of my knowledge and belief, that the infrastructure installed as part of this project has been inspected by me or by a qualified person under my direct supervision and has been constructed in accordance with the plans and specifications approved by the City Engineer and that the original design intent of the approved plans has been met, except as noted by me on the as-built construction drawings. This Certification is based on site inspections by me or personnel under my direction with survey information provided by Baseline Field Services NMPLS # 5110
Surv-Tek NMPLS # 9750.

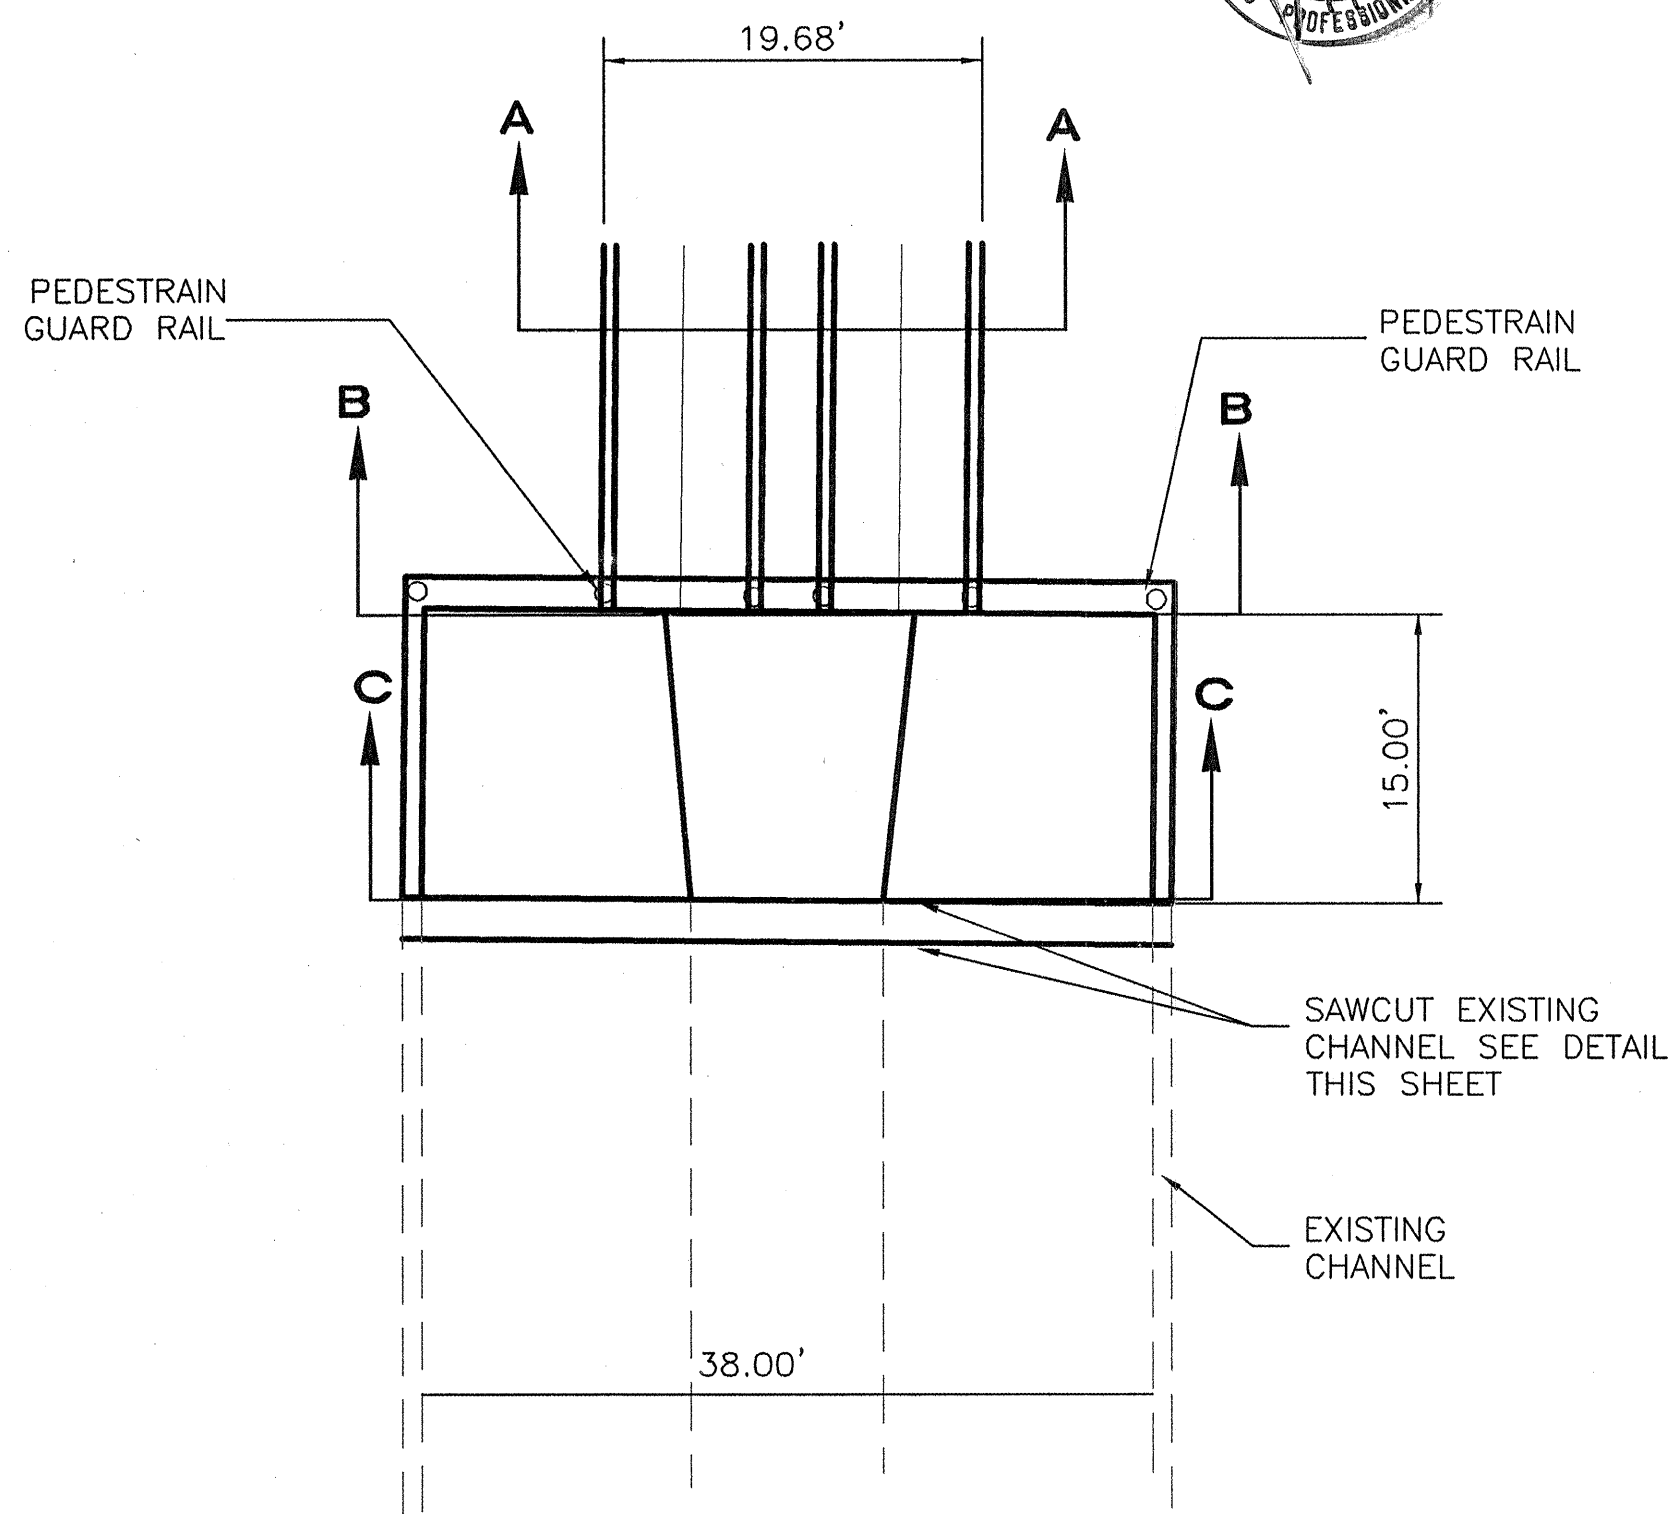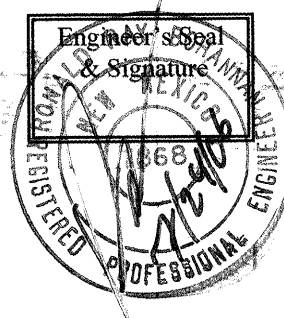


CHANNEL TRANSITION DETAIL STA. 12+00.67 TO 12+15.67

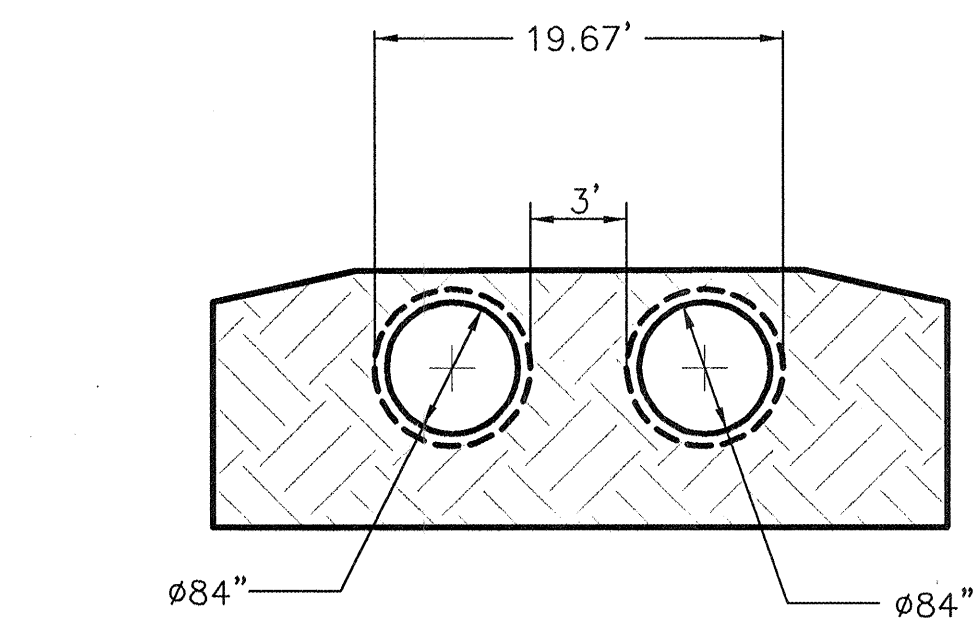


SECTION A-A

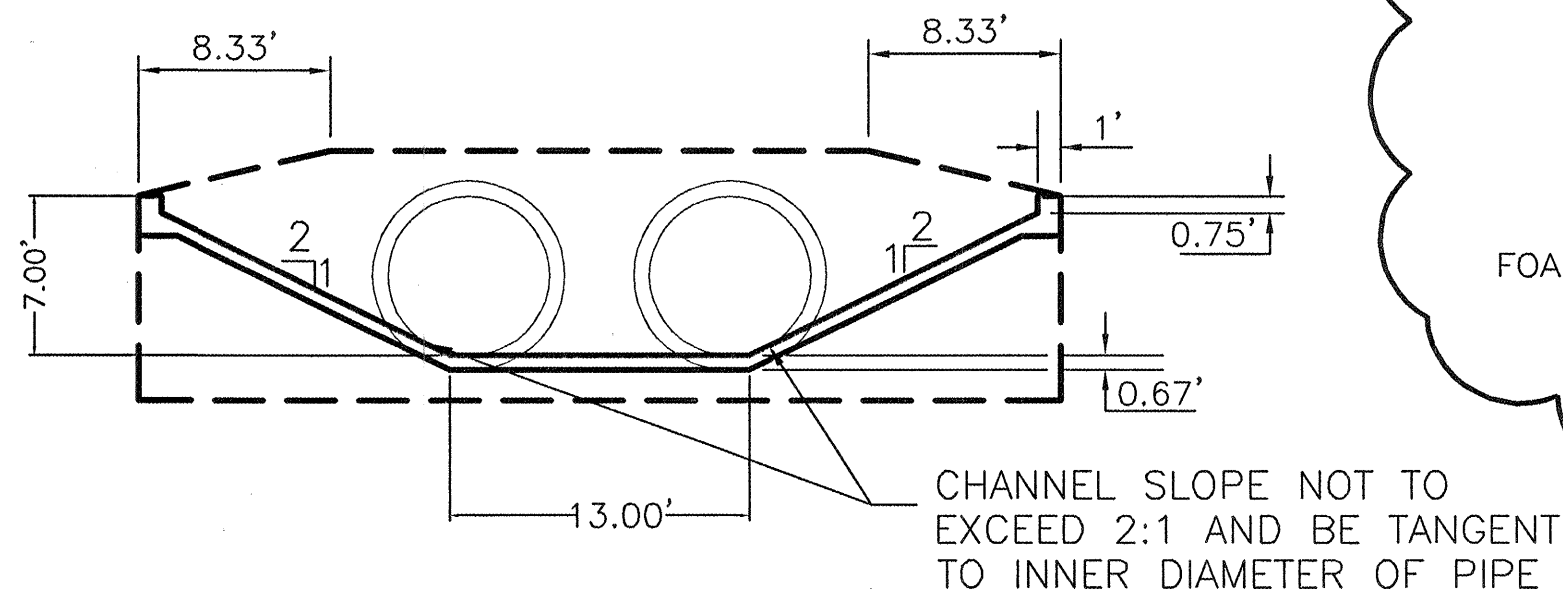


SECTION B-B

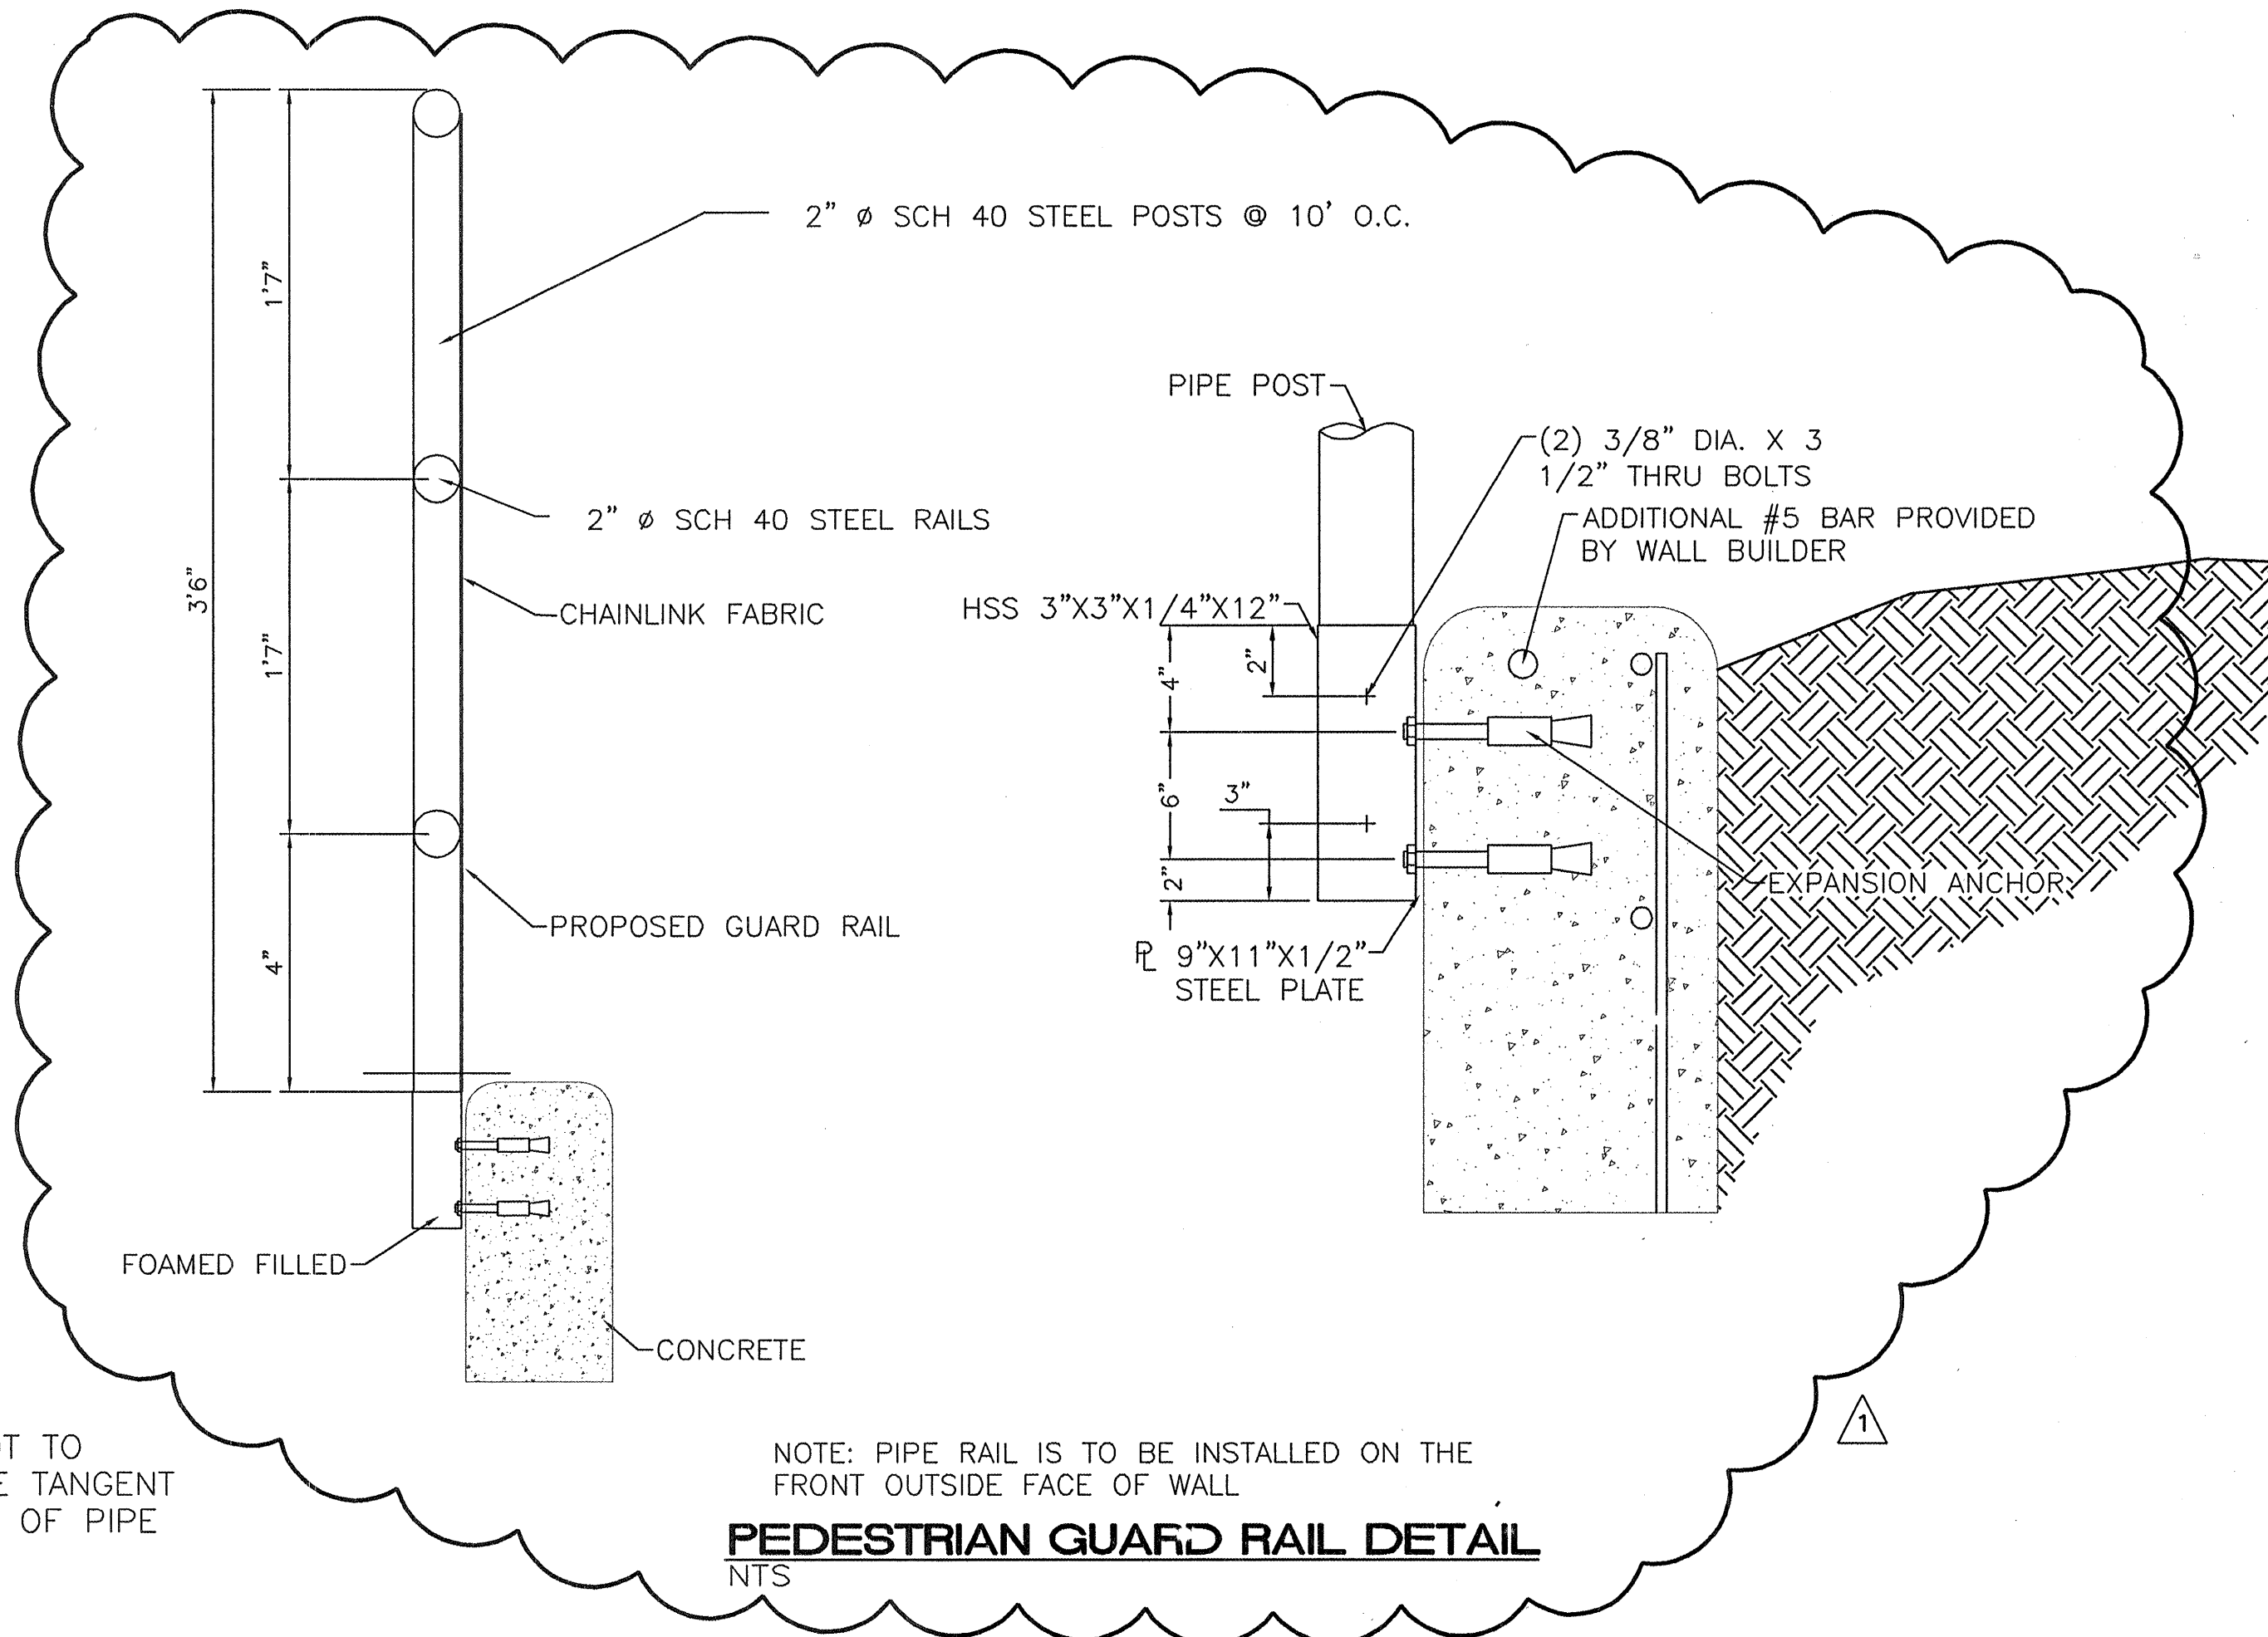


PEDESTRIAN GUARD RAIL DETAIL

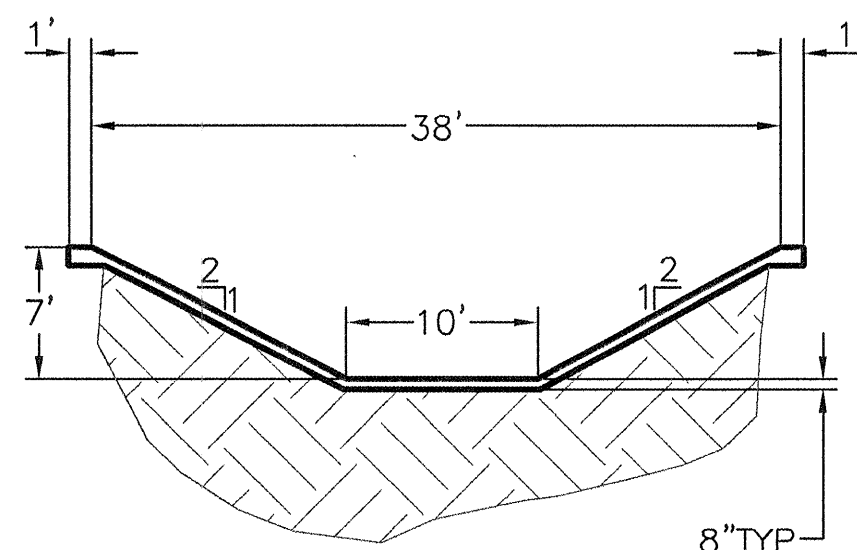


SECTION C-C

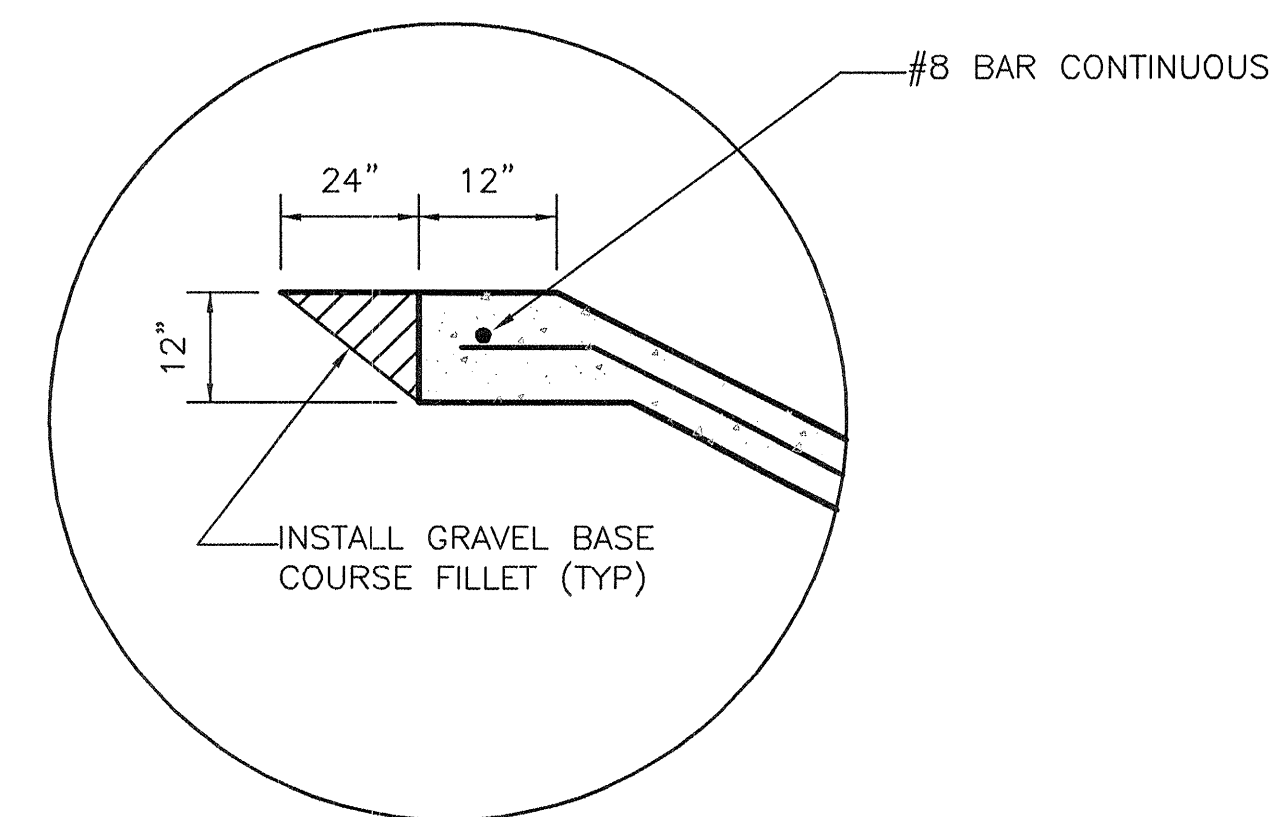

THICKENED EDGE DETAIL

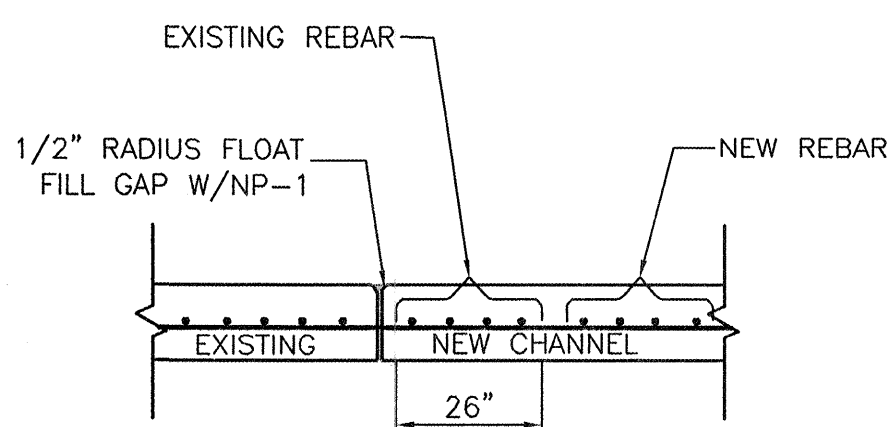

SLOPE PAVING REPLACEMENT DETAIL

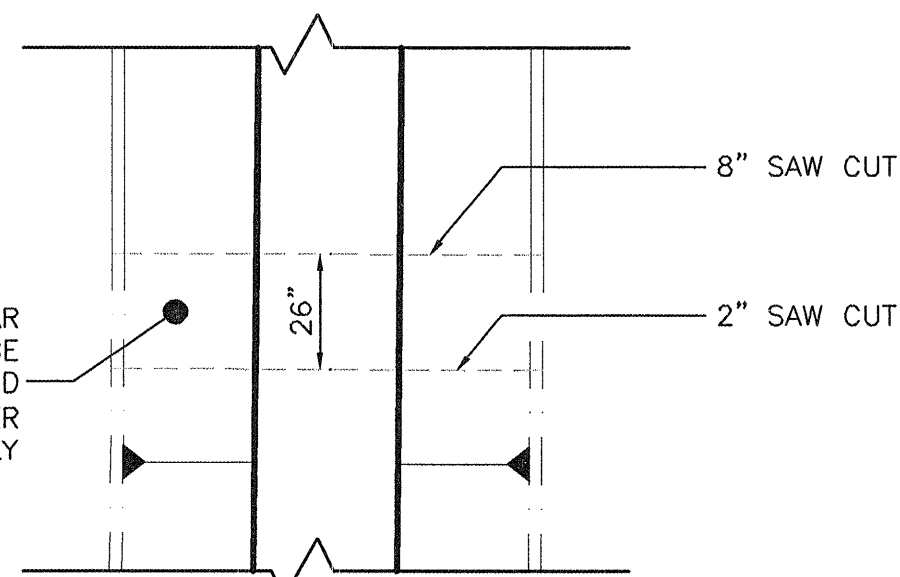

NOTE TO CONTRACTOR:

1. VERTICAL SURFACES SHALL BE COATED WITH THOROCOAT, COLOR TO BE APPROVED BY ENGINEER.
2. CHANNEL CONCRETE SHALL BE TINTED WITH SAN DIEGO BUFF. ONE POUND PER SACK OF CEMENTITIOUS MATERIAL.

CONSTRUCTION WITHIN AMAFCA R.O.W.

1. AMAFCA FIELD ENGINEER SHALL BE NOTIFIED 48-HOURS PRIOR TO ANY WORK WITHIN THE AMAFCA R/W. TEL: 884-2215 JERRY LOVATO.
2. NO WORK WILL BE PERFORMED IN THE AMAFCA R/W BETWEEN APRIL 15 AND OCTOBER 15 WITHOUT WRITTEN PERMISSION FROM AMAFCA.
3. ALL SUBGRADE, BACKFILL AND EMBANKMENT SHALL BE COMPACTED TO 95% (MODIFIED PROCTOR) WITHIN THE AMAFCA R/W. TESTING REPORTS SHALL BE FORWARDED TO PROGRAD TO BE REVIEWED.
4. AMAFCA FIELD ENGINEER WILL BE NOTIFIED 48-HOURS PRIOR TO FINAL INSPECTION OF ANY FACILITIES WITHIN THE AMAFCA R/W.

APPROVED FOR CONSTRUCTION

(FOR AMAFCA) (DATE)

TIERRA WEST, LLC
8509 JEFFERSON NE
ALBUQUERQUE, NEW MEXICO 8
(505)858-3100

CITY OF ALBUQUERQUE
PUBLIC WORKS DEPARTMENT
ENGINEERING GROUP

TITLE: **WAL-MART NEIGHBORHOOD MARKET #3317-00**
8511 GOLF COURSE RD. N.W., ALBUQUERQUE, N.M.
HEADWALL DETAILS

DESIGN REVIEW COMMITTEE

CITY ENGINEER APPROVAL _____

W

MO./DAY/YR.	MO./DAY/YR.
-------------	-------------

CITY PROJECT NO.

753181

ZONE MAP NO	
-------------	--

C-12-Z

SHEET

OF

13 27