

File Path: \\...  
File Name: 518041.DWG  
Plot Date: 01-19-2009  
Plot Time: 09:46 am

# LEGEND

## MATERIALS

CONCRETE  
RIP-RAP

## LINES

SUBDIVISION BOUNDARY  
PROPERTY LINE (PLAN)  
PROPERTY LINE (SECTION)  
CENTERLINE  
EASEMENT LINE  
MATCH LINE  
SECTION CUT LINE

## EARTHWORK

CONTOUR LINE  
SPOT ELEVATION  
PROJECT / PHASE BOUNDARY  
FLOWLINE  
DIRECTION OF FLOW

## MISCELLANEOUS UTILITIES

GAS LINE  
UNDERGROUND TELEPHONE  
UNDERGROUND ELECTRICAL  
STORM DRAIN  
STORM DRAIN MANHOLE  
STORM DRAIN INLET

## SANITARY SEWER

SANITARY SEWER LINE  
SANITARY SEWER MANHOLE  
SAS SERVICE CONNECTIONS  
SAS CAP OR PLUG  
ENCASEMENT

## WATER

WATER LINE  
WATER SERVICE CONNECTIONS  
GATE VALVE  
FIRE HYDRANT  
BUTTERFLY VALVE  
REDUCER  
WATER PRESSURE ZONE BOUNDARY

## WATER FITTINGS

CAPS AND PLUGS  
ELBOW  
CROSS  
TEE

## MISCELLANEOUS

CHAINLINK FENCE  
FIELD FENCE  
COMMON YARD WALL  
RETAINING WALL  
POWER OR TELEPHONE POLE

216-7539-118-20110


SCANNED BY  
PLANNING

# CONSTRUCTION PLANS for

# APS ATRISCO HERITAGE ACADEMY HIGH SCHOOL

# DENNIS CHAVEZ BLVD. S.W./ 118TH STREET S.W. PHASE 1 SIGNALIZATION

ALBUQUERQUE, NEW MEXICO  
JANUARY, 2009

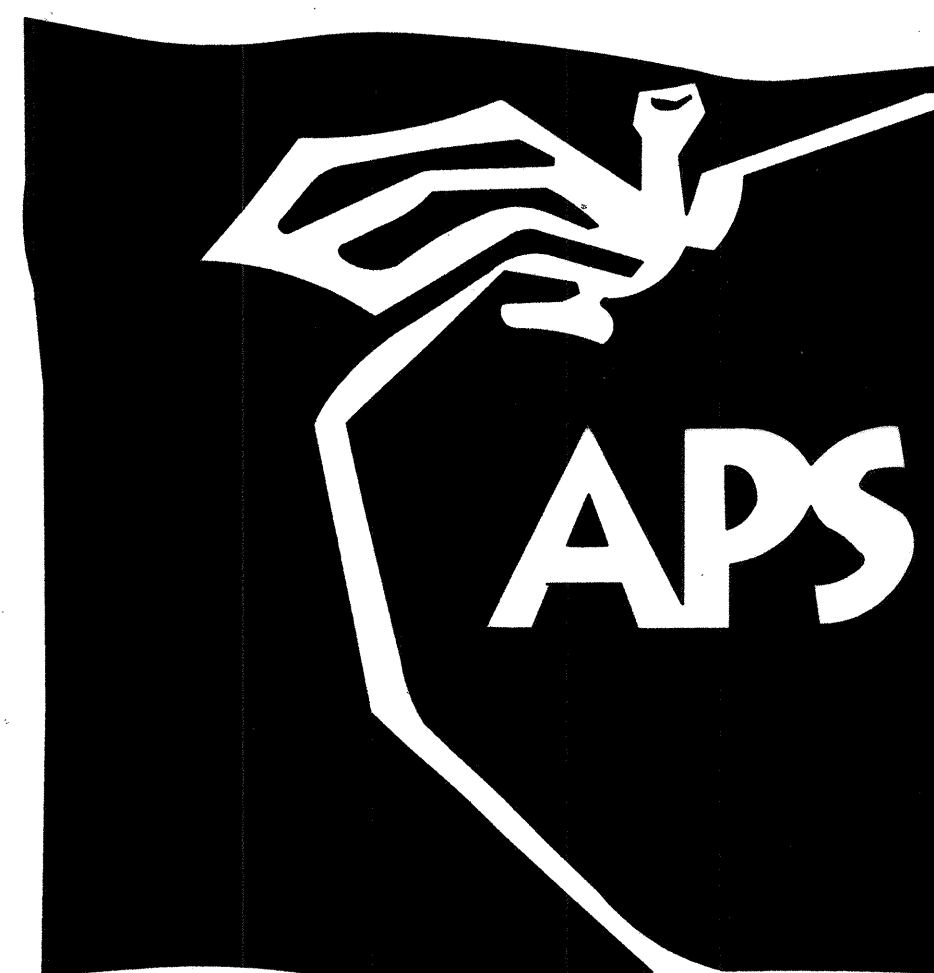

## INDEX OF DRAWINGS

SHEET	DESCRIPTION
1	COVER SHEET, VICINITY MAP, GENERAL NOTES, LEGEND AND INDEX OF DRAWINGS
2	BASELINE AND HORIZONTAL CONTROL PLAN
3	TRAFFIC NOTES, LEGEND, EQUIPMENT REQUIREMENTS AND INCIDENTAL ITEMS
4	TRAFFIC SIGNAL ESTIMATED QUANTITIES, INCIDENTAL ITEMS
5	TRAFFIC SIGNAL PLAN
6	TRAFFIC SIGNAL CABLES AND CONDUITS
7	FUNCTIONS AND DETECTORS
8	STRIPING AND SIGNAGE PLAN

RECORD DRAWING

PWCO 80032

BERNALILLO COUNTY PUBLIC WORKS DIVISION DATE

## CERTIFICATE OF SUBSTANTIAL COMPLIANCE

I, J. GRAEME MEANS, NMPE 13676, OF THE FIRM HIGH MESA CONSULTING GROUP, HEREBY CERTIFY THAT THE PUBLIC INFRASTRUCTURE CONSTRUCTED AS PART OF THIS PROJECT HAS BEEN INSPECTED BY ME OR PERSONNEL UNDER MY DIRECT SUPERVISION AND, TO THE BEST OF MY KNOWLEDGE AND BELIEF, HAS BEEN CONSTRUCTED IN ACCORDANCE WITH THE PLANS AND SPECIFICATIONS AND THE ORIGINAL DESIGN INTENT OF THE CITY ENGINEER APPROVED PLANS.


THE RECORD SURVEY INFORMATION EDITED ONTO THE ORIGINAL DESIGN DOCUMENT WAS OBTAINED UNDER THE DIRECT SUPERVISION OF CHARLES G. CALA, JR., NMPS 11184, ALSO OF HIGH MESA CONSULTING GROUP.

I CERTIFY THAT THIS INFORMATION IS TRUE AND CORRECT TO THE BEST OF MY KNOWLEDGE AND BELIEF. THESE RECORD DRAWINGS ARE NOT NECESSARILY COMPLETE AND INTENDED ONLY TO VERIFY SUBSTANTIAL COMPLIANCE OF THE DESIGN INTENT OF THE PROJECT. THOSE RELYING ON THIS DOCUMENT ARE ADVISED TO OBTAIN INDEPENDENT VERIFICATION OF ITS ACCURACY BEFORE USING IT FOR ANY OTHER PURPOSE. THIS CERTIFICATION IS SUBMITTED IN SUPPORT OF A REQUEST FOR ACCEPTANCE OF THE PROJECT BY THE CITY ENGINEER.

J. Graeme Means, NMPE 13676  
10/08/10 DATE



APPROVED AS RECORD DRAWINGS  
DESIGN REVIEW SECTION  
CITY CONSTRUCTION ENGINEER  
DATE: 10-25-2010

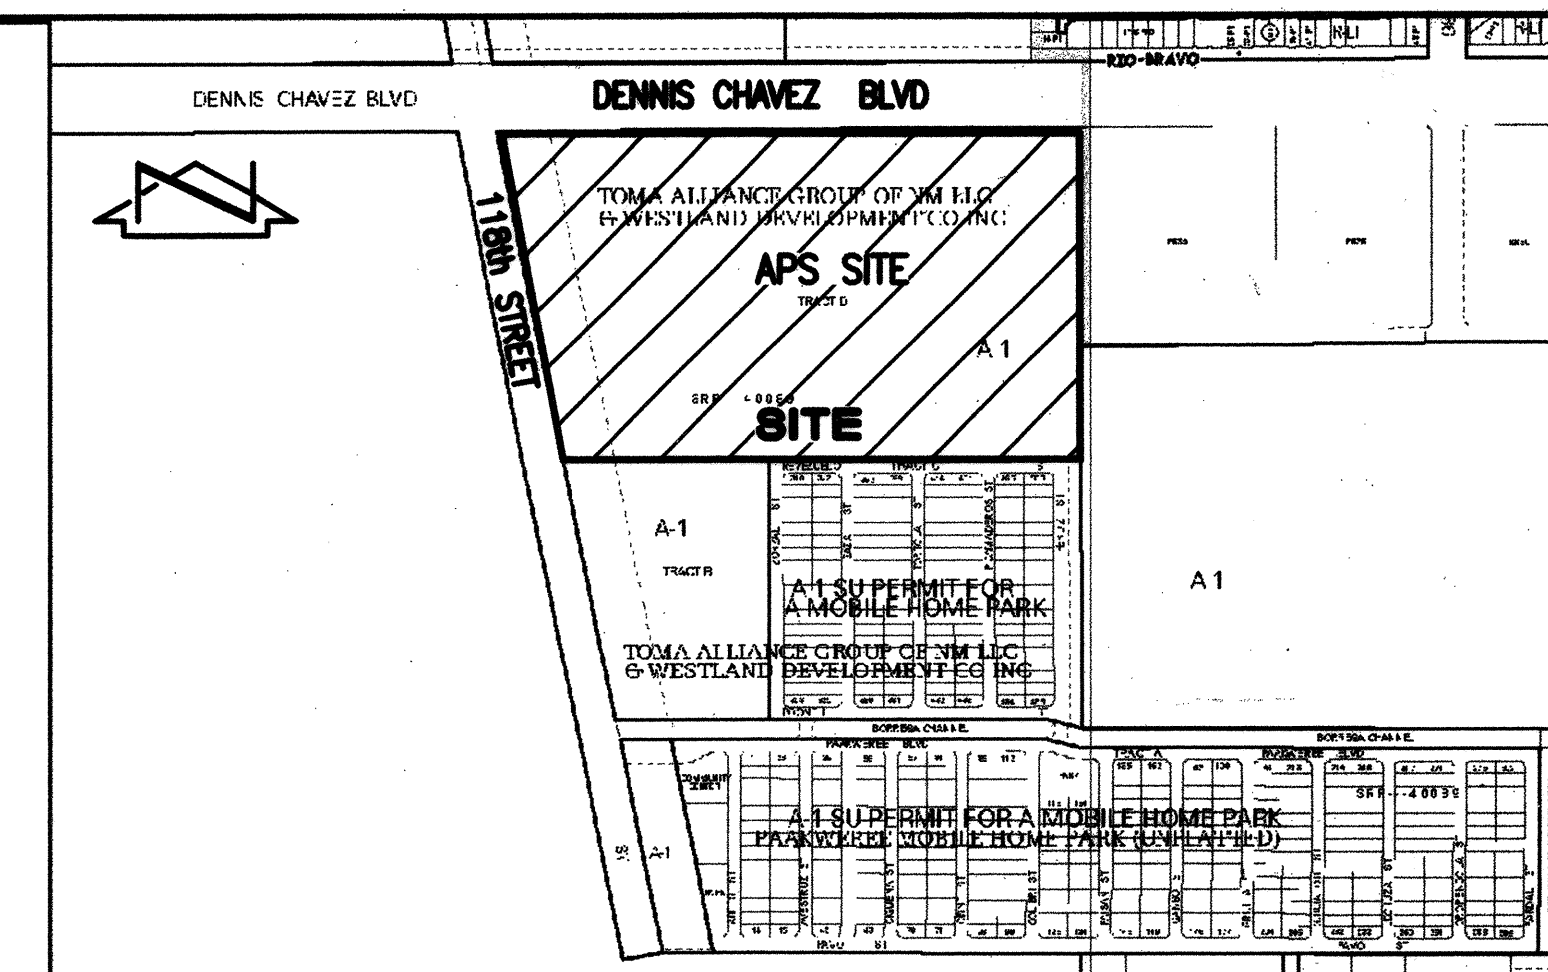

VICINITY MAPS  
SCALE: 1" = 750'

P-8, P-9

## GENERAL NOTES:



- ALL WORK DETAILED ON THESE PLANS TO BE PERFORMED UNDER CONTRACT SHALL, EXCEPT AS OTHERWISE STATED OR PROVIDED FOR HEREON, BE CONSTRUCTED IN ACCORDANCE WITH THE CITY OF ALBUQUERQUE STANDARD SPECIFICATIONS-PUBLIC WORKS CONSTRUCTION-1986 - UPDATE NO. 7, INCLUDING AMENDMENT #1.
- TWO (2) WORKING DAYS PRIOR TO ANY EXCAVATION, CONTRACTOR MUST CONTACT NEW MEXICO ONE CALL SYSTEM, 260-1990, (ALBUQUERQUE AREA) 1-800-321-ALERT (2537) (STATEWIDE) FOR LOCATION OF EXISTING UTILITIES.
- IF ANY UTILITY LINES, PIPELINES, OR UNDERGROUND UTILITY LINES ARE SHOWN ON THESE DRAWINGS, THEY ARE SHOWN IN AN APPROXIMATE MANNER ONLY, AND SUCH LINES MAY EXIST WHERE NONE ARE SHOWN. IF ANY SUCH EXISTING LINES ARE SHOWN, THE LOCATION IS BASED UPON INFORMATION PROVIDED BY THE OWNER OF SAID UTILITY, AND THE INFORMATION MAY BE INCOMPLETE, OR MAY BE OBSOLETE BY THE TIME CONSTRUCTION COMMENCES. THE ENGINEER HAS CONDUCTED ONLY PRELIMINARY INVESTIGATION OF THE LOCATION, DEPTH, SIZE, OR TYPE OF EXISTING UTILITY LINES, PIPELINES, OR UNDERGROUND UTILITY LINES. THIS INVESTIGATION IS NOT CONCLUSIVE, AND MAY NOT BE COMPLETE, THEREFORE, MAKES NO REPRESENTATION PERTAINING THERETO, AND ASSUMES NO RESPONSIBILITY OR LIABILITY THEREFOR. THE CONTRACTOR SHALL INFORM ITSELF OF THE LOCATION OF ANY UTILITY LINE, PIPELINE, OR UNDERGROUND UTILITY LINE IN OR NEAR THE AREA OF THE WORK IN ADVANCE OF AND DURING EXCAVATION WORK. THE CONTRACTOR IS FULLY RESPONSIBLE FOR ANY AND ALL DAMAGE CAUSED BY ITS FAILURE TO LOCATE, IDENTIFY AND PRESERVE ANY AND ALL EXISTING UTILITIES, PIPELINES, AND UNDERGROUND UTILITY LINES. IN PLANNING AND CONDUCTING EXCAVATION, THE CONTRACTOR SHALL COMPLY WITH STATE STATUTES, MUNICIPAL AND LOCAL ORDINANCES, RULES AND REGULATIONS, IF ANY, PERTAINING TO THE LOCATION OF THESE LINES AND FACILITIES.
- SHOULD A CONFLICT EXIST BETWEEN THESE PLANS AND ACTUAL FIELD CONDITIONS, THE CONTRACTOR SHALL PROMPTLY NOTIFY THE ENGINEER IN WRITING SO THAT THE CONFLICT CAN BE RESOLVED WITH A MINIMUM AMOUNT OF DELAY FOR ALL PARTIES.
- THE CONTRACTOR SHALL MAINTAIN ACCESS TO ADJACENT PROPERTIES DURING CONSTRUCTION.
- ALL WORK ON THIS PROJECT SHALL BE PERFORMED IN ACCORDANCE WITH APPLICABLE FEDERAL, STATE AND LOCAL LAWS, RULES AND REGULATIONS CONCERNING SAFETY AND HEALTH.
- ALL UTILITIES AND UTILITY SERVICE LINES SHALL BE INSTALLED PRIOR TO PAVING.
- BACKFILL COMPACTION SHALL BE ACCORDING TO SPECIFIED STREET USE.
- TACK COAT REQUIREMENTS SHALL BE DETERMINED DURING CONSTRUCTION BY THE ENGINEER.
- SIDEWALKS AND WHEELCHAIR RAMPS WITHIN THE CURB RETURNS SHALL BE CONSTRUCTED WHEREVER A NEW CURB RETURN IS CONSTRUCTED.
- IF CURB IS DEEPENED FOR A DRIVEPAD OR A HANDICAP RAMP, THE DRIVEPAD OR RAMP SHALL BE CONSTRUCTED PRIOR TO ACCEPTANCE OF THE CURB AND GUTTER.
- ALL STORM DRAINAGE FACILITIES SHALL BE COMPLETED PRIOR TO FINAL ACCEPTANCE.
- CONTRACTOR SHALL COORDINATE WITH THE ABOQUA WATER SYSTEM DIVISION FOR THE EXECUTION OF THE VALVE SHUT OFF PLAN, NOT LESS THAN SEVEN (7) WORKING DAYS IN ADVANCE OF ANY WORK THAT MAY AFFECT THE EXISTING PUBLIC WATER UTILITIES. ONLY ABOQUA WATER SYSTEM DIVISION PERSONNEL SHALL OPERATE EXISTING VALVES. REFER TO SECTION 18 OF THE SPECIFICATIONS. THE ABOQUA WATER SYSTEM DIVISION PHONE NUMBER IS 857-8200.
- CONTRACTOR SHALL NOTIFY THE CITY SURVEYOR NOT LESS THAN SEVEN (7) DAYS PRIOR TO STARTING WORK IN ORDER THAT THE CITY SURVEYOR MAY TAKE NECESSARY MEASURES TO INSURE THE PRESERVATION OF SURVEY MONUMENTS. CONTRACTOR SHALL NOT DISTURB PERMANENT SURVEY MONUMENTS WITHOUT THE CONSENT OF THE CITY SURVEYOR AND SHALL NOTIFY THE CITY SURVEYOR AND BEAR THE EXPENSE OF REPLACING ANY THAT MAY BE DISTURBED WITHOUT PERMISSION. REPLACEMENT SHALL BE DONE ONLY BY THE CITY SURVEYOR. WHEN A CHANGE IS MADE IN THE FINISHED ELEVATION OF THE PAVEMENT OF ANY ROADWAY IN WHICH A PERMANENT SURVEY MONUMENT IS LOCATED, CONTRACTOR SHALL, AT HIS OWN EXPENSE, ADJUST THE MONUMENT COVER TO THE NEW GRADE UNLESS OTHERWISE SPECIFIED. REFER TO SECTION 4.4 OF THE SPECIFICATIONS.
- SEVEN (7) WORKING DAYS PRIOR TO BEGINNING CONSTRUCTION THE CONTRACTOR SHALL SUBMIT TO THE CONSTRUCTION CO-ORDINATION DIVISION A DETAILED CONSTRUCTION SCHEDULE. TWO (2) WORKING DAYS PRIOR TO CONSTRUCTION THE CONTRACTOR SHALL OBTAIN A BARRICADING PERMIT FROM THE CONSTRUCTION CO-ORDINATION DIVISION. CONTRACTOR SHALL NOTIFY BARRICADE ENGINEER (924-3400) PRIOR TO OCCUPYING AN INTERSECTION. CONTRACTOR MUST REFER TO SECTION 19 OF THE STANDARD SPECIFICATION FOR TRAFFIC CONTROL.
- PRIVATE STREETS REQUIRE STREET NAME SIGNS, STOP SIGNS, AND ANY NECESSARY STRIPING (DEVELOPER'S RESPONSIBILITY).
- PERMANENT PAVEMENT STRIPING WILL BE PLACED BY THE CONTRACTOR. THE ROAD SHALL NOT BE OPENED TO THE TRAFFIC UNTIL IT IS STRIPED. ALL STRIPING, PAVEMENT MARKINGS INCLUDING CROSSWALKS, ARROWS AND LINE MARKINGS ARE TO BE CONSTRUCTED OF HOT PLASTIC OR COLD PLASTIC IN ACCORDANCE WITH THE MANUAL OF UNIFORM TRAFFIC CONTROL DEVICES.
- CAUTION: THESE DRAWINGS DO NOT INCLUDE NECESSARY COMPONENTS FOR CONSTRUCTION SAFETY WHICH SHALL REMAIN THE RESPONSIBILITY OF THE CONTRACTOR. ALL EXCAVATION, TRENCHING AND SHORING ACTIVITIES MUST BE CARRIED-OUT IN ACCORDANCE WITH OSHA 29 CFR 1926, SUBPART P-EXCAVATIONS.
- ANY WORK OCCURRING WITHIN AN ARTERIAL ROADWAY REQUIRES TWENTY-FOUR HOUR CONSTRUCTION.
- CONTRACTOR SHALL BE RESPONSIBLE FOR PROVIDING AND MAINTAINING ALL CONSTRUCTION SIGNING UNTIL PROJECT HAS BEEN ACCEPTED BY THE CITY.
- CONTRACTOR SHALL MAINTAIN A GRAFFITI-FREE WORK SITE. CONTRACTOR SHALL PROMPTLY REMOVE ANY AND ALL GRAFFITI FROM EQUIPMENT, WHETHER PERMANENT OR TEMPORARY.
- WHEN APPLICABLE, CONTRACTOR SHALL SECURE, ON BEHALF OF THE OWNER AND OPERATORS, TOPSOIL DISTURBANCE PERMIT FROM THE CITY AND/OR FILE A NOTICE OF INTENT (N.O.I.) WITH THE EPA PRIOR TO BEGINNING CONSTRUCTION.
- THIS SET OF PLANS SHOWS PRIVATE RETAINING WALLS THAT ARE NOT PART OF THIS WORK ORDER. THOSE WALLS MUST BE REVIEWED, APPROVED AND PERMITTED BY SEPARATE PROCESS. CONTACT 924-3956 (ONLY USE WHEN APPLICABLE)

2008.186.0  
2005.186.4

HIGH MESA Consulting Group

6010-B MIDWAY PARK BLVD. NE • ALBUQUERQUE, NEW MEXICO 87109  
PHONE: 505.345.4250 • FAX: 505.345.4254 • www.highmesacg.com

REV.	SHEETS	CITY ENGINEER	DATE	USER	DEPARTMENT	DATE	USER	DEPARTMENT	DATE
1	8		1-2010						
ENGINEERS STAMP & SIGNATURE				APPROVALS		DATE			
BRC Chairman				Transportation		3-6-09			
Water/Wastewater				Hydrology		02-05-09			
C.I.P.				Const. Mngmt.		1-26-09			
Const. Coord.				City Project No.		753978			
APPROVED FOR CONSTRUCTION				City Engineer		5-12-09			
SHEET 1 OF 8				DATE					

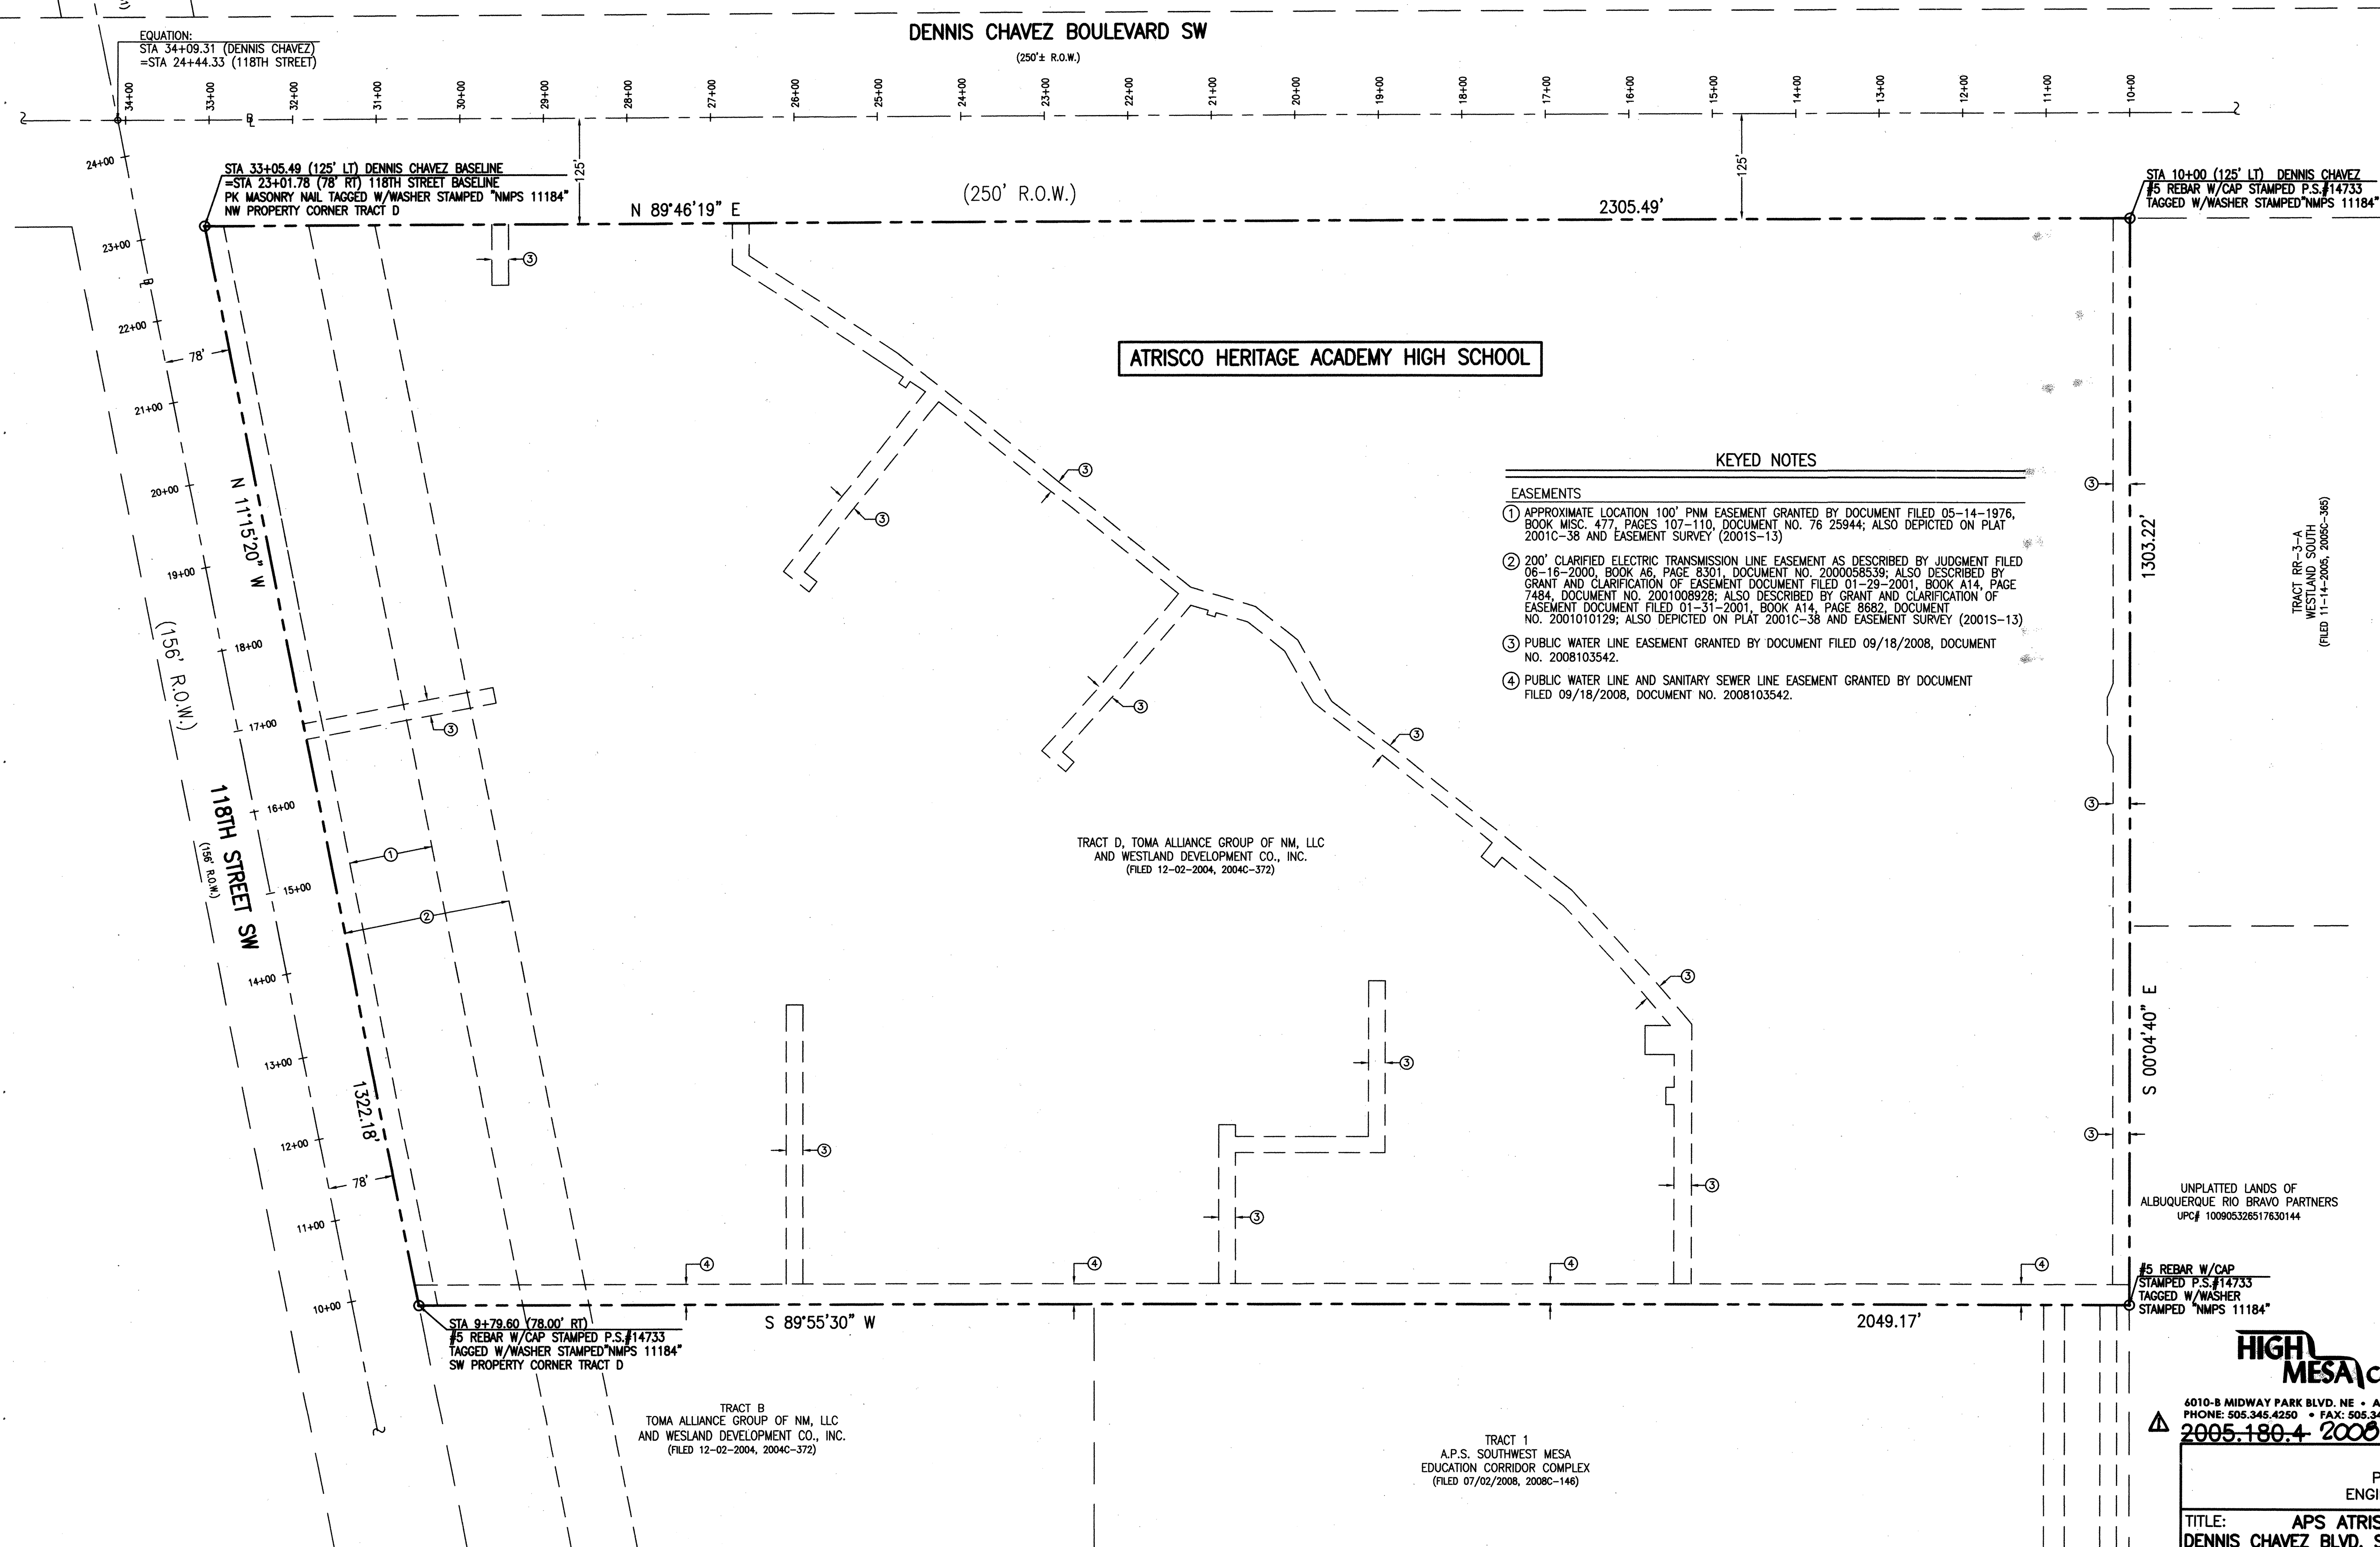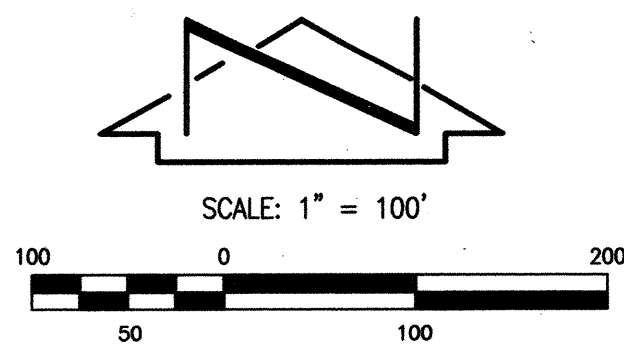

ATRISCO HERITAGE ACADEMY HIGH SCHOOL

KEYED NOTES

- EASEMENTS**
- APPROXIMATE LOCATION 100' PNM EASEMENT GRANTED BY DOCUMENT FILED 05-14-1976, BOOK MISC. 477, PAGES 107-110, DOCUMENT NO. 76 25944; ALSO DEPICTED ON PLAT 2001C-38 AND EASEMENT SURVEY (2001S-13)
  - 200' CLARIFIED ELECTRIC TRANSMISSION LINE EASEMENT AS DESCRIBED BY JUDGMENT FILED 06-16-2000, BOOK A6, PAGE 8301, DOCUMENT NO. 2000058539; ALSO DESCRIBED BY GRANT AND CLARIFICATION OF EASEMENT DOCUMENT FILED 01-29-2001, BOOK A14, PAGE 7484, DOCUMENT NO. 2001008928; ALSO DESCRIBED BY GRANT AND CLARIFICATION OF EASEMENT DOCUMENT FILED 01-31-2001, BOOK A14, PAGE 8682, DOCUMENT NO. 2001010129; ALSO DEPICTED ON PLAT 2001C-38 AND EASEMENT SURVEY (2001S-13)
  - PUBLIC WATER LINE EASEMENT GRANTED BY DOCUMENT FILED 09/18/2008, DOCUMENT NO. 2008103542.
  - PUBLIC WATER LINE AND SANITARY SEWER LINE EASEMENT GRANTED BY DOCUMENT FILED 09/18/2008, DOCUMENT NO. 2008103542.

TRACT D, TOMA ALLIANCE GROUP OF NM, LLC  
AND WESTLAND DEVELOPMENT CO., INC.  
(FILED 12-02-2004, 2004C-372)

TRACT B  
TOMA ALLIANCE GROUP OF NM, LLC  
AND WESTLAND DEVELOPMENT CO., INC.  
(FILED 12-02-2004, 2004C-372)

TRACT 1  
A.P.S. SOUTHWEST MESA  
EDUCATION CORRIDOR COMPLEX  
(FILED 07/02/2008, 2008C-146)

UNPLATTED LANDS OF  
ALBUQUERQUE RIO BRAVO PARTNERS  
UPC# 100905328517630144

#5 REBAR W/CAP  
STAMPED P.S.#14733  
TAGGED W/WASHER  
STAMPED NMPS 11184"

**HIGH MESA Consulting Group**  
6010-S MIDWAY PARK BLVD. NE • ALBUQUERQUE, NEW MEXICO 87109  
PHONE: 505.345.4250 • FAX: 505.345.4254 • www.highmesacg.com

**2005.180.4 2008.180.6**

CITY OF ALBUQUERQUE  
PUBLIC WORKS DEPARTMENT  
ENGINEERING DEVELOPMENT GROUP

TITLE: **APS ATRISCO HERITAGE ACADEMY HIGH SCHOOL  
DENNIS CHAVEZ BLVD. S.W./118TH STREET S.W. PHASE 1 SIGNALIZATION  
BASELINE AND HORIZONTAL CONTROL PLAN**

Design Review Committee  
**APPROVE**  
MAR 06 2009  
DESIGN REVIEW COMMITTEE

City Engineer Approval  
**APPROVE**  
MAY 12 2009  
CITY ENGINEER

City Project No. **753978** Zone Map No. **P-8** Sheet **2** of **8**

**RECORD DRAWING**

**NOTE:**  
THIS IS NOT A BOUNDARY SURVEY; DATA IS SHOWN FOR ORIENTATION ONLY.  
THE BOUNDARY INFORMATION DEPICTED BY THIS PLAN IS BASED UPON  
BOUNDARY AND TOPOGRAPHIC SURVEY - TRACT D, PANKWEREE BULK LAND  
PLAT - SOUTHWEST MESA HIGH SCHOOL SITE BY HIGH MESA CONSULTING  
GROUP, DATED 3/14/2006, NMPS 11184, PUBLIC WATER AND SANITARY SEWER  
EASEMENT ON TRACT D IS BASED ON EASEMENT SURVEY DATED 09/08/2008,  
ALSO PREPARED BY HIGH MESA CONSULTING GROUP, NMPS 11184.

AS BUILT INFORMATION		BENCH MARKS		SURVEY INFORMATION		ENGINEER'S SEAL		REVISIONS		DESIGN		DATE	
CONTRACTOR	Standard Electrical Controls	DATE	6/2009	DATE	3/14/06	DATE	01/19/2009	DATE	10-2008	DATE	10-2008	DATE	01-2009
WORK	ATRISCO HERITAGE ACADEMY HIGH SCHOOL	BY	JMA	BY	JMA	BY	JMA	BY	JMA	BY	JMA	BY	JMA
FIELD	ATRISCO HERITAGE ACADEMY HIGH SCHOOL	DATE	11/2008	DATE	3/14/06	DATE	01/19/2009	DATE	10-2008	DATE	10-2008	DATE	01-2009
REVISIONS	ATRISCO HERITAGE ACADEMY HIGH SCHOOL	DATE	11/2008	DATE	3/14/06	DATE	01/19/2009	DATE	10-2008	DATE	10-2008	DATE	01-2009
CORRECTED BY	ATRISCO HERITAGE ACADEMY HIGH SCHOOL	DATE	11/2008	DATE	3/14/06	DATE	01/19/2009	DATE	10-2008	DATE	10-2008	DATE	01-2009
RECORDED BY	ATRISCO HERITAGE ACADEMY HIGH SCHOOL	DATE	11/2008	DATE	3/14/06	DATE	01/19/2009	DATE	10-2008	DATE	10-2008	DATE	01-2009

1. ALL WORK ON THESE PLANS IS TO BE PERFORMED UNDER THIS CONTRACT SHALL CONFORM TO THE CURRENT NATIONAL ELECTRIC CODE, THE STANDARDS OF THE NATIONAL BOARD OF FIRE UNDERWRITERS FOR ELECTRICAL WIRING AND APPARATUS, THE CITY'S TRAFFIC ENGINEERING OPERATIONS THIRD DRAFT SPECIFICATIONS (JUNE 1994), AND THE CITY OF ALBUQUERQUE STANDARD SPECIFICATIONS FOR PUBLIC WORKS CONSTRUCTION, LATEST UPDATE.
2. LOCATIONS OF CONDUITS, FOUNDATIONS, CONTROL CABINETS, POLES, PULL BOXES, MANHOLES, AND SPLICE CABINETS SHOWN ON THE PLANS ARE SCHEMATIC AND SHALL BE ADJUSTED IN THE FIELD TO MAXIMIZE CLEAR SPACE AVAILABLE FOR PEDESTRIANS AND WHEELCHAIRS TO COMPLY WITH THE AMERICANS WITH DISABILITIES ACT. THE CONTRACTOR SHALL MEET WITH THE CITY'S TRAFFIC ENGINEERING OPERATIONS PERSONNEL IN THE FIELD AT ALL LOCATIONS TO SPOT EQUIPMENT BEFORE BEGINNING THE WORK. ALL SUCH EQUIPMENT SHALL BE INSTALLED WITHIN THE RIGHT-OF-WAY.
3. THE CONTRACTOR IS WARNED THAT EXISTING CONDUITS MAY CONTAIN AC POWER AND CAUTION SHALL BE EXERCISED IN INTERCEPTING OR INSTALLING CABLE IN EXISTING CONDUIT.
4. THE CONTRACTOR SHALL BORE, DRILL, OR PUSH WHEN CROSSING EXISTING PAVEMENTS AND ANY DRIVEWAYS FOR SIDE STREET CROSSINGS. BEFORE CONDUIT CAN BE BORED, DRILLED, OR PUSHED THE CONTRACTOR SHALL LOCATE ALL EXISTING UTILITIES. THE CONTRACTOR SHALL LOCATE AND EXPOSE GAS LINES WHICH CROSS ANY PROPOSED BORES. ALL EXCAVATIONS SHALL REMAIN OPEN UNTIL AFTER THE BORE IS COMPLETE. THE CONTRACTOR SHALL REMOVE AND REPLACE IN KIND ANY SIDEWALK OR PAVEMENT REQUIRED TO EXPOSE SUCH LINES. THE CONTRACTOR MAY CUT, TRENCH, AND REPLACE EXISTING PAVEMENT ONLY WHEN APPROVED BY THE PROJECT MANAGER.
5. SPLICING OF COMMUNICATIONS CABLE WILL NOT BE PERMITTED IN PULL BOXES. SPLICING OF COMMUNICATIONS CABLE (CONNECTIONS) WILL BE PERMITTED ONLY AT SPLICE CABINETS OR CONTROLLER CABINETS WITH SPLICE BARS. SPLICING OF TRAFFIC SIGNALS MCC WILL BE PERMITTED IN LARGE PULL BOXES INCLUDING LARGE MEDIAN PULL BOXES.
6. ALL PULL BOXES SHALL BE REINFORCED POLYMER MORTAR HEAVY DUTY TYPE WITH REINFORCED POLYMER MORTAR HEAVY DUTY COVERS. CONCRETE COVERS, STEEL COVERS, AND CONCRETE PULL BOXES WILL NOT BE ACCEPTABLE.
7. THE CONTRACTOR SHALL NOTIFY THE CITY OF ALBUQUERQUE TRAFFIC ENGINEERING OPERATIONS(857-8000) THREE WORKING DAYS IN ADVANCE OF ANY ANTICIPATED WORK ON SIGNALS, LIGHTING, AND POWER SERVICES. TRAFFIC ENGINEERING OPERATIONS PERSONNEL WILL ASSIST THE CONTRACTOR IN FIELD LOCATION OF EQUIPMENT, COLOR CODING OF WIRING, AND MUST BE PRESENT WHEN SIGNALS AND LIGHTING ARE SHUT-OFF OR TURNED ON. THE CONTRACTOR SHALL ALSO NOTIFY THE CITY OF ALBUQUERQUE TRAFFIC ENGINEERING OPERATIONS EACH TIME A TRAFFIC SIGNAL CONTROL DOOR IS OPENED.
8. THE CONTRACTOR SHALL NOTIFY PUBLIC SERVICE COMPANY 30 DAYS IN ADVANCE OF ANTICIPATED POWER SERVICE CONNECTIONS. THE CONTRACTOR SHALL COORDINATE WITH PUBLIC SERVICE COMPANY TO ESTABLISH ELECTRICAL SERVICE IN THE CITY'S NAME. THE CONTRACTOR SHALL PAY THE LOCAL POWER COMPANY ALL COSTS TO PROVIDE ELECTRICAL SERVICE. THIS WORK WILL BE CONSIDERED INCIDENTAL TO CONSTRUCTION.
9. LIVE UNUSED CONDUCTORS WILL NOT BE ALLOWED AT MASTARM POLES AND PEDESTAL POLES. ALL SUCH UNUSED CONDUCTORS SHALL BE DISCONNECTED AT THE LARGE PULL BOX ADJACENT TO THE POLE.
10. IF TRENCH WIDTHS LESS THAN 12" ARE PROPOSED BY THE CONTRACTOR, APPROVED COMPACTION METHODS SHALL BE USED DURING BACKFILL TO PREVENT LATEL TRENCH FAILURES. THE CONTRACTOR SHALL USE GROUT OR LEAN FILL AS APPROVED BY THE PROJECT MANAGER IN LIEU OF EARTH BACKFILL.
11. FOR CONDUITS CONTAINING ONLY LOW VOLTAGE COMMUNICATIONS CABLES, THE REQUIREMENTS FOR A SINGLE CONDUCTOR BARE COPPER #8 AWG MAY BE WAIVED WHERE PERMITTED BY THE NATIONAL ELECTRIC CODE.
12. THE CITY OF ALBUQUERQUE TRAFFIC ENGINEERING OPERATIONS PERSONNEL WILL PROVIDE TRAFFIC SIGNAL TIMING PLANS AND WILL PROGRAM TRAFFIC SIGNAL CONTROLLERS.
13. THE CONTRACTOR SHALL PROVIDE OFF-DUTY POLICE OFFICERS TO DIRECT TRAFFIC WHEN SIGNALS ARE TURNED OFF.
14. ALL DATA SHOWN HEREIN CONCERNING EXISTING UTILITIES HAS BEEN OBTAINED FROM "AS-BUILT" DRAWINGS AND FROM FIELD OBSERVATIONS WHICH MAY OR MAY NOT BE ACCURATE. THE CONTRACTOR WILL BE RESPONSIBLE FOR EXPLORATORY TRENCHING. IF NECESSARY, TO MORE SPECIFICALLY LOCATE UTILITY LINES, COST OF LOCATING UTILITY LINES INCLUDING EXPLORATORY TRENCHING WILL BE CONSIDERED INCIDENTAL TO CONSTRUCTION.
15. IN THE EVENT THAT LANDFILL DEBRIS IS ENCOUNTERED IN EXCAVATIONS WITHIN THE PUBLIC RIGHT-OF-WAY, THE CONTRACTOR SHALL REMOVE THE DEBRIS WITHIN THE LIMITS OF THE WORK AND DISPOSE IN ACCORDANCE WITH ALBUQUERQUE ENVIRONMENTAL HEALTH DEPARTMENT REQUIREMENTS. THIS WORK WILL BE CONSIDERED INCIDENTAL.
16. THE FOLLOWING CITY OF ALBUQUERQUE STANDARD DRAWINGS SHALL BE USED FOR THIS PROJECT:






2415B	CURB AND GUTTER AND TEMPORARY PAVING SECTION
2550	TRAFFIC SIGNAL PULL BOX DETAIL
2551	TRAFFIC SIGNAL MANHOLE DETAIL
2552	TRAFFIC SIGNAL LOOP DETECTOR DETAILS
2555	TRAFFIC SIGNAL CONTROLLER CABINET & PEDESTAL FOUNDATION DETAIL
2557	TRAFFIC SIGNAL SPLICER CABINET GROUND MOUNT (LARGE)
2558	TRAFFIC SIGNAL FOUNDATION DETAILS TYPE II AND TYPE III STANDARDS
2560	TRAFFIC SIGNAL MISCELLANEOUS DETAILS
2562A	TRAFFIC SIGNAL MASTARM DETAILS, TYPE II STANDARD
2562B	TRAFFIC SIGNAL MASTARM DETAILS, TYPE II STANDARD
2562C	TRAFFIC SIGNAL MASTARM DETAILS, TYPE III STANDARD
2562D	TRAFFIC SIGNAL TYPE III STANDARD MISC. DETAILS
2570	TRAFFIC SIGNAL ELECTRICAL SERVICE DETAILS
2572	TRAFFIC SIGNAL METER PEDESTAL DETAILS COMBINATION SIGNAL & LIGHTING
2580	STREET LIGHTING FOUNDATION & MISCELLANEOUS DETAILS
2581	STREET LIGHTING INSTALLATION & POLE DETAILS
2801	GENERAL NOTES
2802	TRAFFIC CONTROL SIGNING
2803	CONSTRUCTION TRAFFIC CONTROL
2804-2808	SIGNING EXAMPLES (MUTCD)

1. CONTRACTOR SHALL FURNISH AND INSTALL THE FOLLOWING:
  - A. THE TRAFFIC SIGNAL CONTROLLER SUPPLIED FOR THIS PROJECT SHALL BE AS DIRECTED BY COA TRAFFIC ENGINEERING DEPARTMENT (ANDREW GALLEGOS, 857-8004).
  - B. THE TRAFFIC SIGNAL CONTROLLER CABINET SUPPLIED FOR THIS PROJECT SHALL BE AS DIRECTED BY COA.
2. SPICE CABINETS SHALL BE AS DETAILED ON THE PLANS. LOW VOLTAGE SPICE BLOCKS SHALL BE 50 UNITS TO THE FOOT, WITH EACH SPICE BLOCK CAPABLE OF HANDLING 25 PAIR CABLE (NUMBER OF SPICE BLOCKS IN EACH CABINET CAPABLE OF HANDLING NUMBER OF CONDUCTORS AS SHOWN ON PLANS). SPICE BLOCKS SHALL BE BELL SYSTEMS PART #6683-50 OR APPROVED EQUAL ALL COMMUNICATION CABLE PAIRS SHALL BE TERMINATED AT THE SPICE BLOCK INCLUDING INACTIVE PAIRS.
3. INTERCONNECT CABLES SHALL COMPLY WITH REA SPECIFICATION PE-22. INTERCONNECT CABLE SHALL CONTAIN THE NUMBER OF WIRE PAIRS SHOWN ON THE PLANS AND THE INDIVIDUAL CONDUCTORS SHALL BE 19 AWG SOLID.
4. ALL SIGNAL INDICATORS AND PEDESTRIAN SIGNALS SHALL BE LED, AS APPROVED BY THE CITY. PEDESTRIAN SIGNAL SHALL BE COUNTDOWN MODEL AS APPROVED BY THE CITY.

1. ALL SINGLE CONDUCTOR #10 COPPER WIRES CONNECTING THE MAIN CIRCUIT WIRING TO CORRESPONDING LUMINAIRES SHALL BE CONSIDERED INCIDENTAL TO THE COST OF THE MASTARM.
2. THE SIGNAL & LIGHTING SYSTEM INSTALLED AS PART OF THIS PROJECT SHALL BE ACCEPTED AND MAINTAINED BY THE CITY OF ALBUQUERQUE.
3. THE CONTRACTOR SHALL BE RESPONSIBLE FOR MAINTENANCE AND COST OF ENERGIZING THE SYSTEM UNTIL SUCH TIME THAT THE CITY ACCEPTS THE RESPONSIBILITY.
4. THE CONTRACTOR SHALL INSTALL TYPE III, 400 WATT, HIGH PRESSURE SODIUM, FLAT GLASS LUMINAIRES WITHOUT INDIVIDUAL PHOTO CELLS AS INDICATED ON THE PLANS.
5. THE LIGHTING IS TO SERVED BY METER PEDESTAL IN COMBINATION WITH TRAFFIC SIGNALS (SEE SIGNAL PLAN).

1. THE CONTRACTOR SHALL PREPARE A TRAFFIC CONTROL PLAN AND OBTAIN AN EXCAVATION/BARRICADING PERMIT IN ACCORDANCE WITH SECTION 2800 OF THE STANDARD SPECIFICATIONS.
2. THE CONTRACTOR SHALL NOT CLOSE MORE THAN ONE TRAFFIC LANE IN ANY ONE DIRECTION AT A TIME.
3. IN THE EVENT THAT THE CONTRACTOR IS REQUIRED BY THE CITY OR OTHER AUTHORITY TO PERFORM WORK DURING OFF-PEAK OR OVERNIGHT HOURS IN ACCORDANCE WITH THE STANDARD SPECIFICATIONS, ADDED COSTS ASSOCIATED WITH SUCH WORK HOURS WILL BE CONSIDERED INCIDENTAL.
4. CONTRACTOR TO COORDINATE TRAFFIC CONTROL WITH CITY OF ALBUQUERQUE AND APS CONSTRUCTION MANAGER. ACCESS TO BE MAINTAINED THROUGHOUT THE PROJECT.

1. THE CONTRACTOR SHALL VISIT THE SITE PRIOR TO BID, AND DISCREPANCIES IN THE PROJECT DOCUMENTS ARE TO BE ALERTED TO THE PROJECT MANAGER.
2. THE CONTRACTOR SHALL ROUTE ALL PROJECT SCHEDULES, RFI's, CONTRACT INFORMATION, SHOP DRAWINGS, SUBMITTAL SHEETS, WARRANT INFORMATION, AND PAYMENT REQUESTS TO THE PROJECT MANAGER.

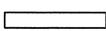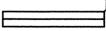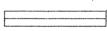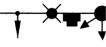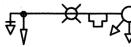NEW	EXISTING	
		PULL BOX
		SERVICE POLE
		METER PEDESTAL
		CONTROLLER CABINET
		CONDUIT RUN (SIGNALS)
		CONDUIT RUN (INTERCONNECT)
		LOOP DETECTOR (SINGLE)
		LOOP DETECTOR (QUAD)
		TRAFFIC SIGNAL PEDESTAL POLE
		CONDUIT RUN NUMBER
		TYPE II STANDARD WITH MASTARM, TRAFFIC SIGNAL, BACK PLATE, AND OPTICAL DETECTOR
		TYPE III STANDARD WITH MASTARM, TRAFFIC SIGNAL, BACK PLATE, OPTICAL DETECTOR, LUMINAIRE, AND VIDEO CAMERA
		PEDESTRIAN PUSH BUTTON (MOUNTED TO SIDE OF POLE WHERE INDICATED)
		PEDESTRIAN SIGNALS (MOUNTED TO SIDE OF POLE WHERE INDICATED)
		SPLICE CABINET
		TRAFFIC MANHOLE
		VIDEO CAMERA

1. "ENGINEER" - FOR THE PURPOSES OF THIS PROJECT, THE TERM "ENGINEER" IS SYNONYMOUS WITH THE TERM "PROJECT MANAGER".

[illegible]

**HIGH MESA Consulting Group**  
6010-B MIDWAY PARK BLVD. NE • ALBUQUERQUE, NEW MEXICO 87109  
PHONE: 505.345.4250 • FAX: 505.345.4254 • [www.highmesacg.com](http://www.highmesacg.com)  
2005.180.4 2008.186.C

CITY OF ALBUQUERQUE  
PUBLIC WORKS DEPARTMENT  
ENGINEERING DEVELOPMENT GROUP

TITLE: APS ATRISCO HERITAGE ACADEMY HIGH SCHOOL  
DENNIS CHAVEZ BLVD. S.W./118TH STREET S.W. PHASE 1 SIGNALIZATION  
TRAFFIC NOTES, LEGEND, EQUIPMENT REQUIREMENTS AND INCIDENTAL ITEMS

[illegible]

City Project No.	753978	Zone Map No.	P-8	Sheet	3	Of	8
------------------	--------	--------------	-----	-------	---	----	---

## RECORD DRAWING

TRAFFIC SIGNAL ESTIMATED QUANTITIES					
		UNIT	TRAFFIC SIGNAL	LIGHTING	TOTAL
0421.01X	METER PEDESTAL (SIGNAL & LIGHTING)	EACH	1		1
0422.016	TRAFFIC SIGNAL MASTARM, 30 FOOT ARM, TYPE II, TROMBONE	EACH	2		2
0422.021	TRAFFIC SIGNAL MASTARM, 40 FOOT ARM, TYPE III, TROMBONE	EACH	2		2
0423.002	TRAFFIC SIGNAL MASTARM FOUNDATION (TYPE B)	EACH	4		4
0423.003	TRAFFIC CONTROLLER FOUNDATION (TYPE M & P CABINETS)	EACH	1		1
0424.006	RIGID ELECTRICAL CONDUIT, 2" INCLUDING TRENCH, BACKFILL PATCHING, PUSHING, BORING & JACKING	LIN FT	65	382	447
0424.011	RIGID ELECTRICAL CONDUIT, 3" INCLUDING TRENCH, BACKFILL PATCHING, PUSHING, BORING & JACKING	LIN FT	932		932
0425.003	ELECTRICAL PULL BOX, (LARGE)	EACH	4	5	9
0426.001	SINGLE CONDUCTOR, 2	LIN FT	243	662	905
0426.004	SINGLE CONDUCTOR, 8	LIN FT		310	310
0426.005	SINGLE CONDUCTOR, 10	LIN FT		872	872
0426.010	MULTI-CONDUCTOR CABLE 5	LIN FT	1069		1069
0426.011	MULTI-CONDUCTOR CABLE 7	LIN FT	190		190
0426.014	MULTI-CONDUCTOR CABLE 20	LIN FT	1060		1060
0427.002	3 SECTION TRAFFIC SIGNAL ASSEMBLY (LED)	EACH	9		9
0427.004	5 SECTION TRAFFIC SIGNAL ASSEMBLY (LED)	EACH	5		5
0427.02X	PEDESTRIAN SIGNAL (COUNTDOWN)	EACH	8		8
0427.031	3 SECTION BACKPLATE	EACH	4		4
0427.033	5 SECTION BACKPLATE	EACH	2		2
0428.001	LOOP VEHICLE DETECTOR	EACH	6		6
0428.010	PEDESTRIAN PUSH BUTTON STATION	EACH	8		8
0428.021	LOOP DETECTOR WIRE	EACH	2218		2218
0428.050	LOOP LEAD-IN CABLE	EACH	675		675
0428.060	DETECTOR SAWCUT	EACH	830		830
0429.001	TRAFFIC ACTUATED CONTROLLER	EACH	1		1
0429.021	EIGHT PHASE DUAL RING CONTROLLER CABINET	EACH	1		1
0432.002	ROADWAY LUMINAIRE, TYPE 400S	EACH		2	2
0441.001	4" REF PLASTIC MARK	LF	110		110
0441.005	24" REF PLASTIC MARK	LF	692		692
0443.101	REMOVE PAVEMENT STRIPE ANY WIDTH	LF	240		240
0450.XXX	ILLUMINATED STREET SIGN	EACH	4		4
0450.XXX	COUNTY TRAFFIC SIGN AND POST	EACH	1		1

INCIDENTAL ITEMS \*

- ANCHOR BOLTS FOR FOUNDATION.
  - GROUND RODS FOR FOUNDATION.
  - UNIVERSAL SUPPORT BRACKETS FOR SERVICE RISERS.
  - CABLE TESTING AND DIAGRAMS.
  - BORING, DRILLING, PUSHING, AND TRENCHING, INCLUDING REMOVAL AND REPLACEMENT OF PAVEMENT, SIDEWALKS, DRIVE PADS, VALLEY GUTTERS, WHEELCHAIR RAMPS, CURB & GUTTER, AND LANDSCAPING (INCLUDING SPRINKLERS), FOR INSTALLATION OF PULL BOXES, CONDUITS, AND SIGNAL FOUNDATIONS, EXCEPT AS NOTED ON THE PLANS.
  - LOCATION OF UTILITY LINES INCLUDING EXPLORATORY TRENCHING AND EXPOSING OF GAS LINES WHEN BORING.
  - DESIGN, MATERIALS, INSTALLATION AND REMOVAL OF SAFETY BARRIER FOR SHIELDING EQUIPMENT OR MATERIAL.
  - APPRIISING PUBLIC THROUGH THE LOCAL NEWS MEDIA.
  - HAULING OF MATERIAL TO BE DISPOSED TO CITY LANDFILL.
  - LEAN FILL FOR CONDUIT TRENCHES.
  - PULL BOX ADJUSTMENT TO GRADE.
  - OFF-DUTY POLICE OFFICER FOR TRAFFIC CONTROL.
- \* ITEMS LISTED ARE ONLY A GENERAL DESCRIPTION OF THE REQUIRED WORK AND MATERIALS, AND MAY NOT BE COMPLETE. THIS LIST DOES NOT INCLUDE ANY INCIDENTAL WORK OR MATERIALS REQUIRED BY THE SPECIAL PROVISIONS SERIALS (STANDARD DETAILS), SUPPLEMENTAL SPECIFICATIONS, OR THE STANDARD SPECIFICATIONS.

RECORD DRAWING

**HIGH MESA Consulting Group**  
6010-S MIDWAY PARK BLVD. NE • ALBUQUERQUE, NEW MEXICO 87109  
PHONE: 505.345.4250 • FAX: 505.345.4254 • www.highmesacg.com  
2005.180.4 2008.182.6

CITY OF ALBUQUERQUE PUBLIC WORKS DEPARTMENT ENGINEERING DEVELOPMENT GROUP	
TITLE: <b>APS ATRISCO HERITAGE ACADEMY HIGH SCHOOL DENNIS CHAVEZ BLVD. S.W./118TH STREET S.W. PHASE 1 SIGNALIZATION TRAFFIC SIGNAL ESTIMATED QUANTITIES, INCIDENTAL ITEMS</b>	
Design Review Committee <b>APPROVED</b> MAR 06 2009 DESIGN REVIEW COMMITTEE	City Engineer Approval <b>APPROVED</b> MAY 12 2009 CITY ENGINEER
City Project No. <b>753978</b>	Zone Map No. <b>P-8</b>
Sheet <b>4</b>	Of <b>8</b>

AS BUILT INFORMATION		BENCH MARKS		SURVEY INFORMATION		ENGINEER'S SEAL	
CONTRACTOR <b>Standard Electrical Services</b>	WORK <b>HMACG</b>	DATE <b>6/2009</b>	DATE <b>3/14/06</b>	BY <b>JMA</b>	NO. <b>2005.180.2</b>		
DESIGNED BY <b>HMACG</b>	CHECKED BY <b>HMACG</b>	DATE <b>11/2009</b>	DATE <b>11/2009</b>	DATE <b>11/2009</b>	DATE <b>11/2009</b>	DATE <b>10-2008</b>	DATE <b>01-2009</b>
RECORDED BY <b>HMACG</b>	DATE <b>11/2009</b>	DATE <b>11/2009</b>	DATE <b>11/2009</b>	DATE <b>11/2009</b>	DATE <b>11/2009</b>	DATE <b>10-2008</b>	DATE <b>01-2009</b>

\* ALL STATIONING BASED ON DENNIS CHAVEZ BASELINE \*

SIGNAL POLES AND MASTARMS

ID#	TYPE	STA	OFFSET
MA1	MASTARM -40' TYPE III W/LUMINAIRE	33+52.40	-36.31' LT
MA2	MASTARM -30' TYPE II	34+43.37	-42.21' LT
MA3	MASTARM -40' TYPE III W/LUMINAIRE	34+52.56	-63.10' RT
MA4	MASTARM -30' TYPE II	33+70.84	-74.72' RT

33+52.13 36.54 LT.  
34+43.92 42.10 LT.  
34+52.53 63.11 RT.  
33+70.74 74.80 RT.

DETECTOR LOOP LEAD-IN CABLE

FROM	TO	CONDUIT TRACE	# PAIR x LENGTH	TOTAL LENGTH
PB4	CONTROLLER	8 - 3	3 @ 121	363
PB3	CONTROLLER	3	1 @ 30	30
PB2	CONTROLLER	5 - 3	2 @ 141	282
			TOTAL	675

PULL BOX  
& CONTROLLER  
LOCATION DATA

ID#	STA	OFFSET	
PB1	33+51.38	97.44' RT	33+51.15 60.01 RT.
PB2	33+50.44	-40.73' LT	33+45.91 34.06 LT.
PB3	33+61.12	-63.13' RT	33+66.13 70.84 RT.
PB4	34+44.35	-65.99' LT	33+40.80 69.09 RT.
PB5	34+43.24	-86.67' RT	34+43.74 62.12 RT.
PB6	34+59.82	-86.30' RT	34+62.03 57.99 RT.
PB7	34+40.99	-36.25' LT	34+47.35 35.31 LT.
PB8	33+40.57	-32.25' LT	34+44.22 30.58 LT.
PB9	34+50.86	-24.82' LT	34+61.31 26.00 LT.
C	33+76.78	-81.51' RT	33+72.53 82.90 RT.
M	33+73.44	-86.72' RT	33+74.05 91.61 RT.

ABBREVIATIONS

MA1	MASTARM NUMBER
PP1	PEDESTAL POLE NUMBER
PPB1	PEDESTRIAN PUSH BUTTON NUMBER
CC1	CONTROL CABINET NUMBER
SC1	SPLICE CABINET NUMBER
PB1	PULL BOX NUMBER (SIGNALS)
PBS1	PULL BOX NUMBER (POWER)
PBC1	PULL BOX NUMBER (INTERCONNECT)
DL1(1)	DETECTOR LOOP PHASE # (LOOP #)
3A	SIGNAL HEAD NUMBER
P1	PEDESTRIAN SIGNAL NUMBER
BP	BACK PLATE
EC	EXTENDED CALL LOOP DETECTOR
SD	SYSTEM LOOP DETECTOR
MH1	TRAFFIC MANHOLE NUMBER

SYMBOL KEY

MA1	SIGNAL & CABINET ID
99	CONDUIT RUN ID
ST	CONDUIT RUN ID (POWER/LIGHTING)

FLASH CONDITION

RED HEADS	4A, 4B, 4M1, 8A, 8B, 8M1
RED HEADS	2M1, 2M2, 2A, 2B, 6M1, 6M2, 6A, 6B

INITIALIZATION



ALL RED, THEN PHASES 2&6 GREEN

NOTES


1. ALL PULL BOXES SHALL BE LARGE SIZE

STREET NAME SIGNS

- SHALL BE PROVIDED ON EACH MASTARM
- SHALL BE INTERNALLY ILLUMINATED LED SIGNS BY CARMANAH TECHNOLOGIES CORPORATION OR AS APPROVED BY THE CITY ALBUQUERQUE TRAFFIC OPERATIONS ENGINEERING.

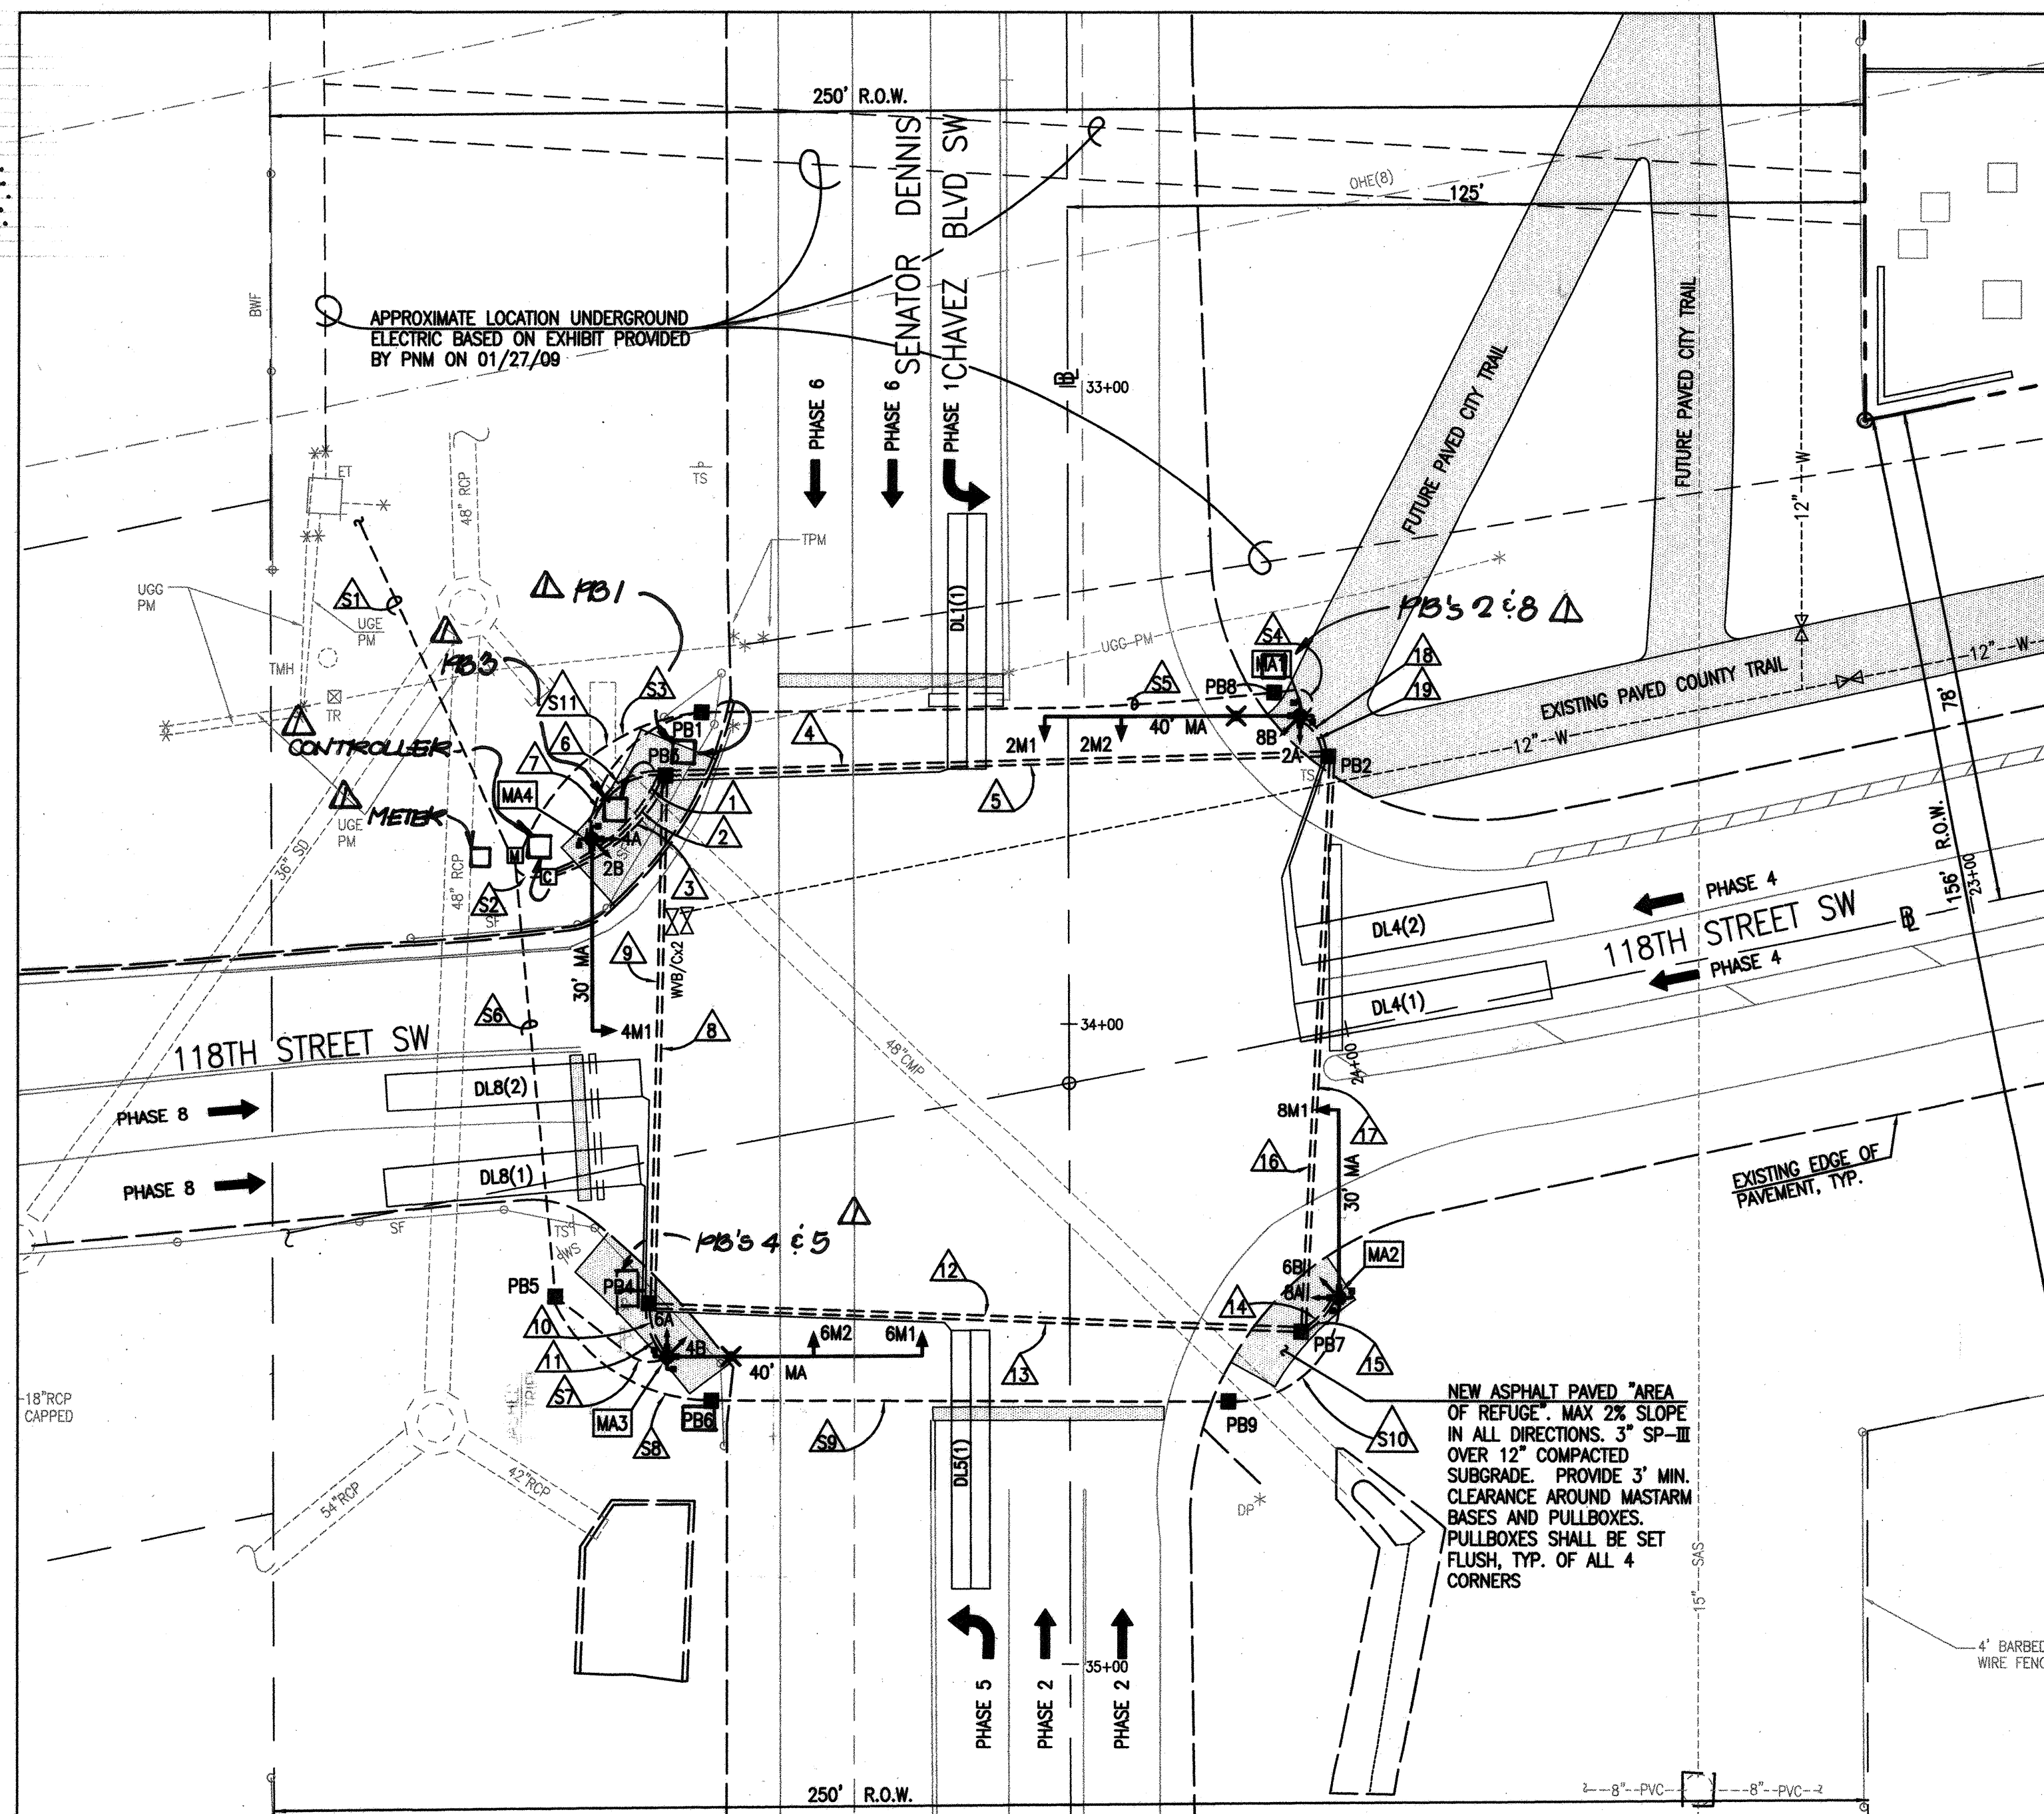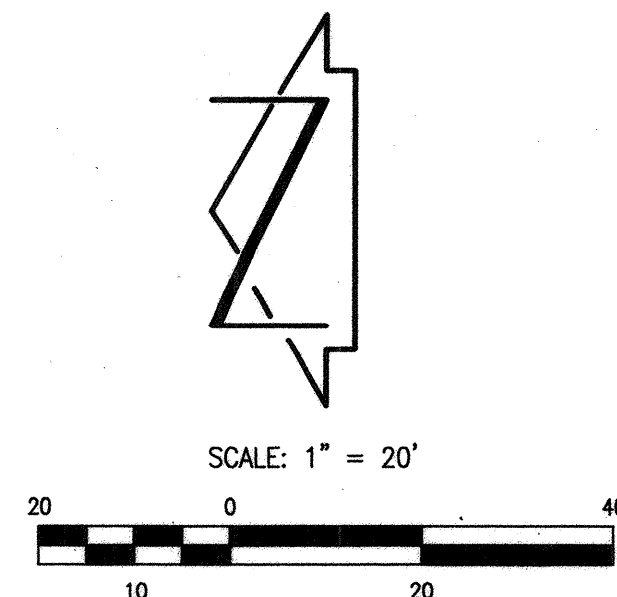


TYPICAL SIGNAL FACE  
LENS ARRANGEMENTS

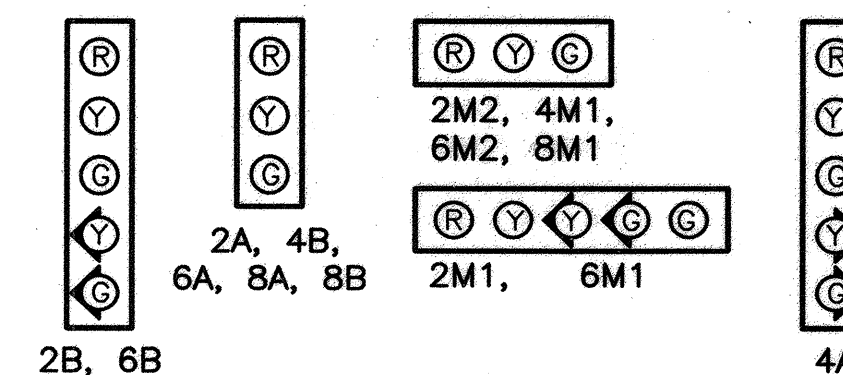

2B, 6B

4A

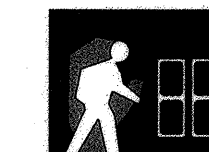


P2A, P2B, P4A,  
P4B, P6A, P6B,  
P8A, P8B

3 SECTION  
BACK PLATE


5 SECTION  
BACK PLATE

SIGNAL PHASING

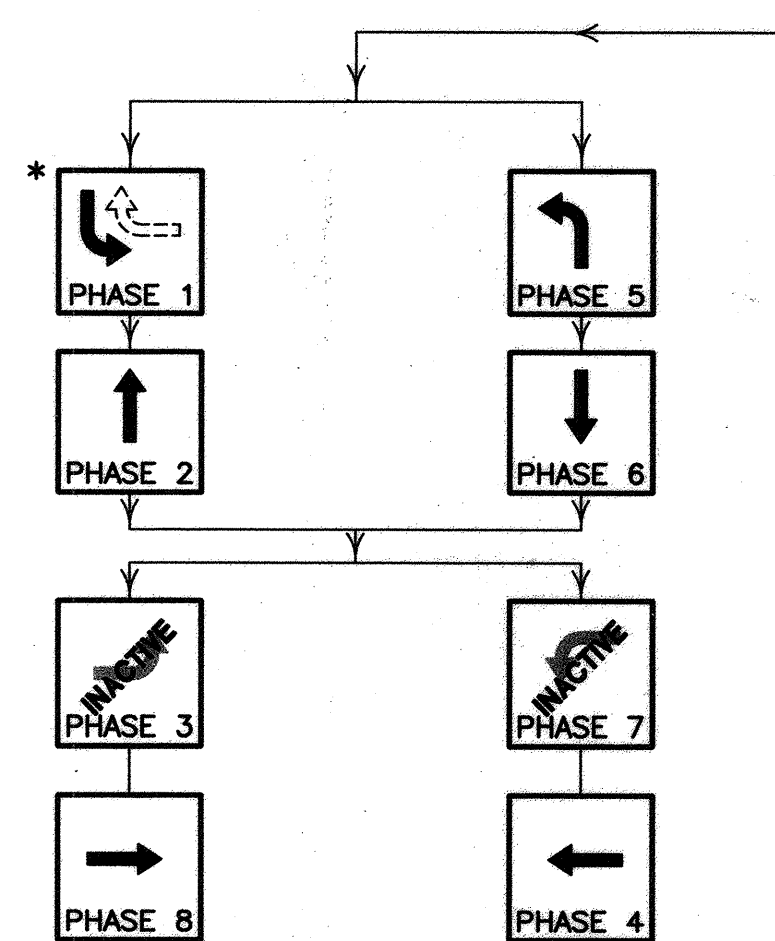

\* #1 - #4 OVERLAP

PEDESTRIAN SIGNAL & PUSHBUTTON ID DETAIL  
(NTS)

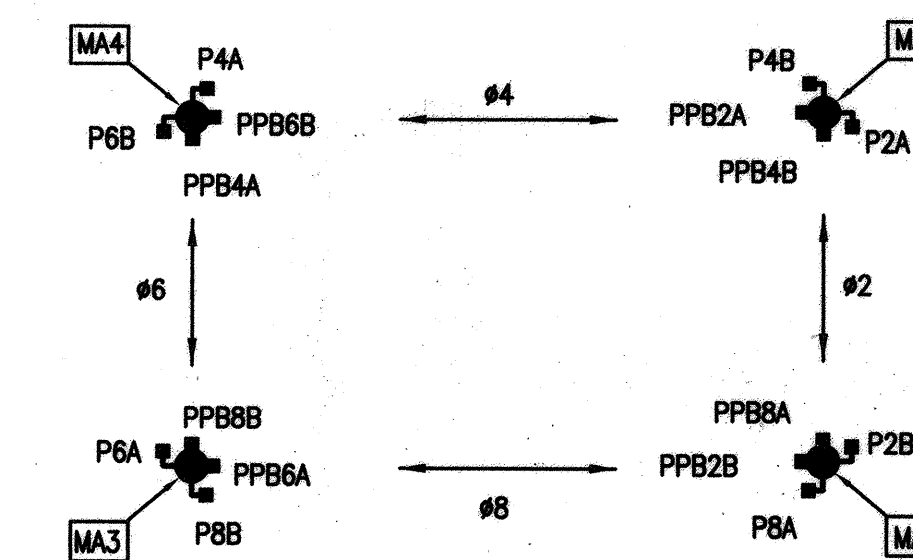


**HIGH MESA Consulting Group**

6010-B MIDWAY PARK BLVD. NE • ALBUQUERQUE, NEW MEXICO 87109  
PHONE: 505.345.4250 • FAX: 505.345.4254 • www.highmesacg.com  
2005.180.4 - 2008.186.G

CITY OF ALBUQUERQUE PUBLIC WORKS DEPARTMENT ENGINEERING DEVELOPMENT GROUP	
TITLE: <b>APS ATRISCO HERITAGE ACADEMY HIGH SCHOOL DENNIS CHAVEZ BLVD. S.W./118TH STREET S.W. PHASE 1 SIGNALIZATION TRAFFIC SIGNAL PLAN</b>	
Design Review Committee <b>APPROVE</b> MAR 06 2009 DESIGN REVIEW COMMITTEE	City Engineer Approval <b>APPROVE</b> MAY 12 2009 CITY ENGINEER
City Project No. <b>753978</b>	Zone Map No. <b>P-8</b>
Sheet <b>5</b> of <b>8</b>	

**RECORD DRAWING**  
FOR CERTIFICATION, SEE SHEET 1

CONDUIT AND CONDUCTOR REQUIREMENTS

CONDUIT LENGTH, SIZE, AND TYPE															CONDUIT FILL BY CONTRACTOR LENGTH AND TYPE														
RUN ID 	SIZE/LENGTH			TYPE	REMARKS	MCC 5 (# @ FT)	MCC 7 (# @ FT)	MCC 20 (# @ FT)	SCC #2 (# @ FT)	SCC #8 (# @ FT)	SCC #10 (# @ FT)	DLIC (# @ FT)	CC #6 (# @ FT)	CC #12 (# @ FT)	OPTICOM (# @ FT)														
	1"	2"	25 3"																										
S1		60		REC	POWER TO METER				3 @ 70																				
S2		5		REC	METER TO CC1				3 @ 11																				
S3		35		REC	METER TO PB1				2 @ 41		2 @ 41																		
S4		5		REC	PB8 TO MA1					2 @ 11	2 @ 11																		
S5		90		REC	PB1 TO PB8				2 @ 96		2 @ 96																		
S6		66		REC	METER TO PB5				2 @ 72		2 @ 72																		
S7		20		REC	PB5 TO MA3					2 @ 26	2 @ 26																		
S8		30		REC	PB5 TO PB6				2 @ 36		2 @ 36																		
S9		80		REC	PB6 TO PB9				2 @ 86		2 @ 86																		
S10		30		REC	PB9 TO MA2					2 @ 36	2 @ 36																		
S11		26		REC	PB1 TO MA4					2 @ 32	2 @ 32																		
1			24	REC	CC1 TO PB3			2 @ 26																					
2			24	REC	CC1 TO PB3			2 @ 26																					
3			24	REC	CC1 TO PB3	1 @ 26						6 @ 30																	
4			105	REC	PB2 TO PB3			2 @ 111																					
5			105	REC	PB2 TO PB3	1 @ 111						2 @ 111																	
6			15	REC	PB3 TO MA4			2 @ 21																					
7			15	REC	PB3 TO MA4	1 @ 21																							
8			85	REC	PB3 TO PB4	1 @ 91						3 @ 91																	
9			85	REC	PB3 TO PB4			2 @ 91																					
10			10	REC	PB4 TO MA3			2 @ 16																					
11			10	REC	PB4 TO MA3	1 @ 16																							
12			105	REC	PB4 TO PB7	1 @ 111																							
13			105	REC	PB4 TO PB7			2 @ 111																					
14			10	REC	PB7 TO MA2	1 @ 16																							
15			10	REC	PB7 TO MA2			2 @ 16																					
16			90	REC	PB7 TO PB2	1 @ 96																							
17			90	REC	PB7 TO PB2			2 @ 96																					
18			10	REC	PB2 TO MA1			2 @ 16																					
19			10	REC	PB2 TO MA1	1 @ 16																							
MA1					BASE TO 2A	1 @ 20																							
MA1					BASE TO 8B	1 @ 20																							
MA1					BASE TO 2M2	1 @ 65																							
MA1					BASE TO 2M1		1 @ 65																						
MA1																													
MA1					BASE TO P2A	1 @ 20																							
MA1					BASE TO P4B	1 @ 20																							
MA1					BASE TO PPB2A	1 @ 10																							
MA1					BASE TO PPB4B	1 @ 10																							
MA4					BASE TO 2B		1 @ 20																						
MA4					BASE TO 4A		1 @ 20																						
MA4					BASE TO 4M1	1 @ 55																							
MA4					BASE TO P4A	1 @ 20																							
MA4					BASE TO P6B	1 @ 20																							
MA4					BASE TO PPB6B	1 @ 10																							
MA4					BASE TO PPB4A	1 @ 10																							
MA3					BASE TO 6A	1 @ 20																							
MA3					BASE TO 4B	1 @ 20																							
MA3					BASE TO 6M2	1 @ 50																							
MA3					BASE TO 6M1		1 @ 65																						
MA3																													
MA3					BASE TO P8B	1 @ 20																							
MA3					BASE TO P6A	1 @ 20																							
MA3					BASE TO PPB8B	1 @ 10																							
MA3					BASE TO PPB6A	1 @ 10																							
MA2					BASE TO 8A	1 @ 20																							
MA2					BASE TO 6B		1 @ 20																						
MA2					BASE TO 8M1	1 @ 55																							
MA2					BASE TO P2B	1 @ 20																							
MA2					BASE TO P8A	1 @ 20																							
MA2					BASE TO PPB8B	1 @ 10																							
TOTAL		447	932			1069	190	1060	905	310	872	675																	

ABBREVIATIONS

CC 6 COMMUNICATION CABLE-6 PAIR  
CC 12 COMMUNICATION CABLE-12 PAIR  
DLIC DETECTOR LOOP LEAD IN CABLE  
MA MASTARM  
MCC MULTI CONDUCTOR CABLE  
PB PULL BOX  
PP PEDESTAL POLE  
PPB PEDESTRIAN PUSH BUTTON  
REC RIGID ELECTRIC CONDUIT  
SCC SINGLE CONDUCTOR CABLE

RECORD DRAWING

HIGH MESA Consulting Group

6010-B MIDWAY PARK BLVD. NE • ALBUQUERQUE, NEW MEXICO 87109  
PHONE: 505.345.4250 • FAX: 505.345.4254 • www.highmesacg.com  
2005-180-4 2005-180-6

CITY OF ALBUQUERQUE  
PUBLIC WORKS DEPARTMENT  
ENGINEERING DEVELOPMENT GROUP  
TITLE: APS ATRISCO HERITAGE ACADEMY HIGH SCHOOL  
DENNIS CHAVEZ BLVD. S.W./118TH STREET S.W. PHASE 1 SIGNALIZATION  
TRAFFIC SIGNAL CABLES AND CONDUITS

APPROVED  
MAR 06 2009  
DESIGN REVIEW COMMITTEE

APPROVED  
MAY 12 2009  
CITY ENGINEER

City Project No. 753978 Zone Map No. P-8 Sheet 6 of 8

# RECORD DRAWING

QUANTITY ESTIMATING ASSUMPTIONS:	
LOOP WIRE	
6' X 40'	REC LOOP = (6*L) + (6*W) + (2*S) + (2*T) + 5 = 281 + 2(S+T)
6' X 40'	QP LOOP = (8*L) + (4*W) + (2*S) + (2*T) + 5 = 349 + 2(S+T)
PAVEMENT SAW CUT	
6' X 40'	REC LOOP = (2*L) + (2*W) + S = 92 + S
6' X 40'	QP LOOP = (3*L) + (2*W) + S = 132 + S
WHERE:	
L = DETECTOR LOOP LENGTH (FROM PLAN)	
W = DETECTOR LOOP WIDTH (FROM PLAN)	
S = SAWCUT LENGTH FROM DETECTOR LOOP TO FACE OF CURB (FROM PLAN)	
T = LOOP WIRE TERMINAL LENGTH FROM FACE OF CURB TO PULL BOX (FROM PLAN)	

\* INCIDENTAL TO CONSTRUCTION

**NOTES:**

---

IDENTIFY CONDUCTORS LISTED AS "115 VOLTS"

WRAP RING 2 CABLE AT EACH SPLICE POINT WITH COLORED ELECTRICAL TAPE. THE IDENTIFICATION MARKING SHALL BE PROVIDED ON EACH RING 2 CABLE AT EACH SPLICE BOX AND LOCATED 6" BACK FROM THE END.

IDENTIFY CONDUCTORS LISTED AS "PPB - LOW VOLTAGE" AT EACH SPLICE POINT. FIVE (5) CONDUCTOR CABLE SHALL BE 24 VOLTS AND USED FOR PUSH BUTTONS ONLY.

## ABBREVIATIONS

DL	DETECTOR LOOP
EC	EXTENDED CALL LOOP
L	DETECTOR LOOP LENGTH
LR	LARGE RECTANGULAR LOOP
W	DETECTOR LOOP WIDTH
S	SAW CUT LOOP TO CURB
T	TERMINAL LOOP
QP	QUADRAPOLE LOOP

**HIGH MESA Consulting Group**  
6010-B MIDWAY PARK BLVD. NE • ALBUQUERQUE, NEW MEXICO 87109  
PHONE: 505.345.4250 • FAX: 505.345.4254 • [www.highmesacg.com](http://www.highmesacg.com)  
**2005.180.4 2005.180.6**



**CITY OF ALBUQUERQUE**  
**PUBLIC WORKS DEPARTMENT**  
**ENGINEERING DEVELOPMENT GROUP**

---

**TITLE: APS ATRISCO HERITAGE ACADEMY HIGH SCHOOL**  
**DENNIS CHAVEZ BLVD. S.W./118TH STREET S.W. PHASE 1 SIGNALIZATION**  
**FUNCTIONS AND DETECTORS**

---

Design Review Committee <div style="border: 2px solid black; padding: 10px; text-align: center;"> <b>APPROVE</b>                      MAR 06 2009                      DESIGN                      REVIEW COMMITTEE                 </div>	City Engineer Approval <div style="border: 2px solid black; padding: 10px; text-align: center;"> <b>APPROVE</b>                      MAY 12 2009                      CITY ENGINEER                 </div>	Last Design Update	<table border="1" style="width: 100%; border-collapse: collapse;"> <tr> <td style="width: 50%; padding: 2px;">Mo./Day/Yr.</td> <td style="width: 50%; padding: 2px;">Mo./Day/Yr.</td> </tr> <tr><td style="height: 20px;"></td><td></td></tr> <tr><td style="height: 20px;"></td><td></td></tr> <tr><td style="height: 20px;"></td><td></td></tr> <tr><td style="height: 20px;"></td><td></td></tr> </table>	Mo./Day/Yr.	Mo./Day/Yr.								
Mo./Day/Yr.	Mo./Day/Yr.												
City Project No.	753978	Zone Map No.	P-8										
		Sheet	7 Of 8										

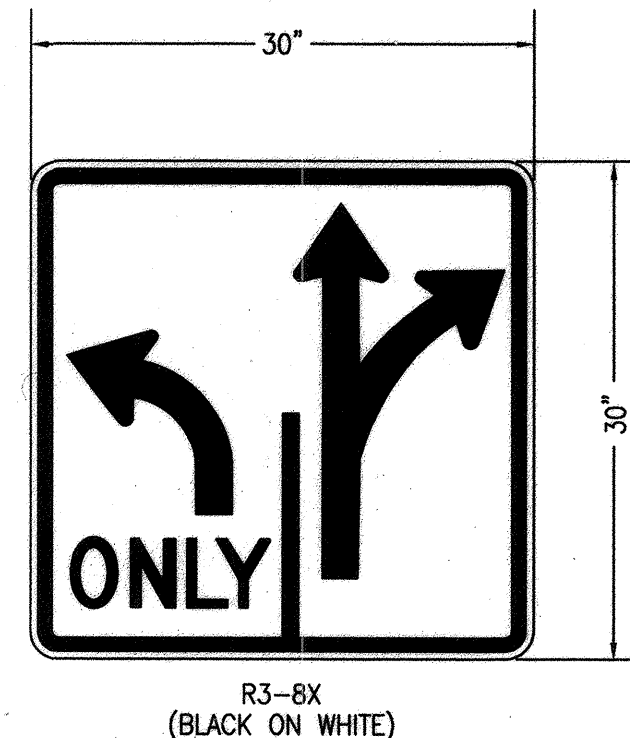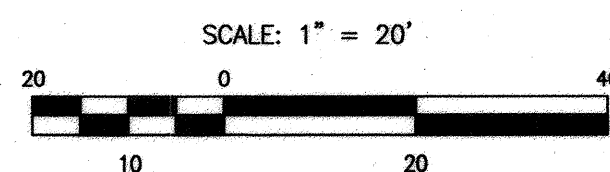


# STRIPING AND SIGNAGE NOTES:

- ALL PAVEMENT MARKINGS SHALL BE REFLECTIVE PLASTIC AND COMPLY WITH CITY SPECIFICATIONS.
- ALL TRAFFIC SIGNS SHALL COMPLY WITH THE M.U.T.C.D. (LATEST EDITION).
- CONTRACTOR SHALL OBLITERATE ALL EXISTING PAVEMENT MARKINGS WITHIN PROJECT LIMITS PER CITY SPECIFICATIONS AND CONTRACT ITEM PRIOR TO INSTALLATION OF NEW MARKINGS.
- BROKEN LANE STRIPES SHALL BE TEN FEET IN LENGTH WITH 30 FOOT GAPS.
- DOTTED LINES SHALL BE THREE FEET IN LENGTH WITH SEVEN FOOT GAPS.
- CONTRACTOR SHALL APPLY REFLECTORIZED YELLOW PAINT TO ALL MEDIAN NOSES PRIOR TO FINAL ACCEPTANCE OF PROJECT.
- ALL PAVEMENT MARKINGS AND SIGNAGE SHALL BE INSTALLED PRIOR TO FINAL ACCEPTANCE OF PROJECT.
- STATIONING SHOWN HEREON IS BASED UPON CONSTRUCTION BASELINE.
- CONTRACTOR SHALL INVENTORY ALL TRAFFIC CONTROL SIGNS TO BE REMOVED UNDER THIS CONTRACT WITH TRAFFIC OPERATIONS PRIOR TO CONSTRUCTION COMMENCEMENT.
- CONTRACTOR MUST REVIEW STRIPING AND SIGNAGE LAYOUT WITH CITY OF ALBUQUERQUE TRAFFIC ENGINEERING DIVISION PRIOR TO INSTALLATION.

## KEYED NOTES

- ERADICATE EXISTING STRIPING BY WATER BLASTING OR SURFACE PLANING IN ACCORDANCE WITH SECTION 443 OF THIS SPECIFICATIONS
- OBLITERATE EXISTING 24" STOP BAR AND INSTALL NEW 24" PLASTIC STOP BAR 2' BEHIND EXISTING LOCATION
- INSTALL NEW 24"x12" PLASTIC CROSSWALK STRIPES W/4" CLEAR SPACING BETWEEN BARS ALIGNED ON LANES PER DETAIL BELOW
- OBLITERATE EXISTING 12" PLASTIC STOP BAR AND INSTALL NEW 24" PLASTIC STOP BAR 2' BEHIND EXISTING LOCATION
- INSTALL/EXTEND NEW 4" WHITE PLASTIC CONTINUOUS STRIPE
- INSTALL ILLUMINATED STREET NAME SIGN ON MASTARM (MASTARMS NOT SHOWN)
- INSTALL NEW 24" PLASTIC STOP BAR OVER EXISTING 12" STOP BAR (HOT THERMO PLASTIC)
- STA 21+00 - INSTALL R3-8X SIGN AND POST PER BERNALILLO COUNTY STANDARDS (1 3/4" SQUARE TUBE POST) AND IMAGE HEREON
- EXTEND EXISTING DOUBLE YELLOW PLASTIC STRIPE

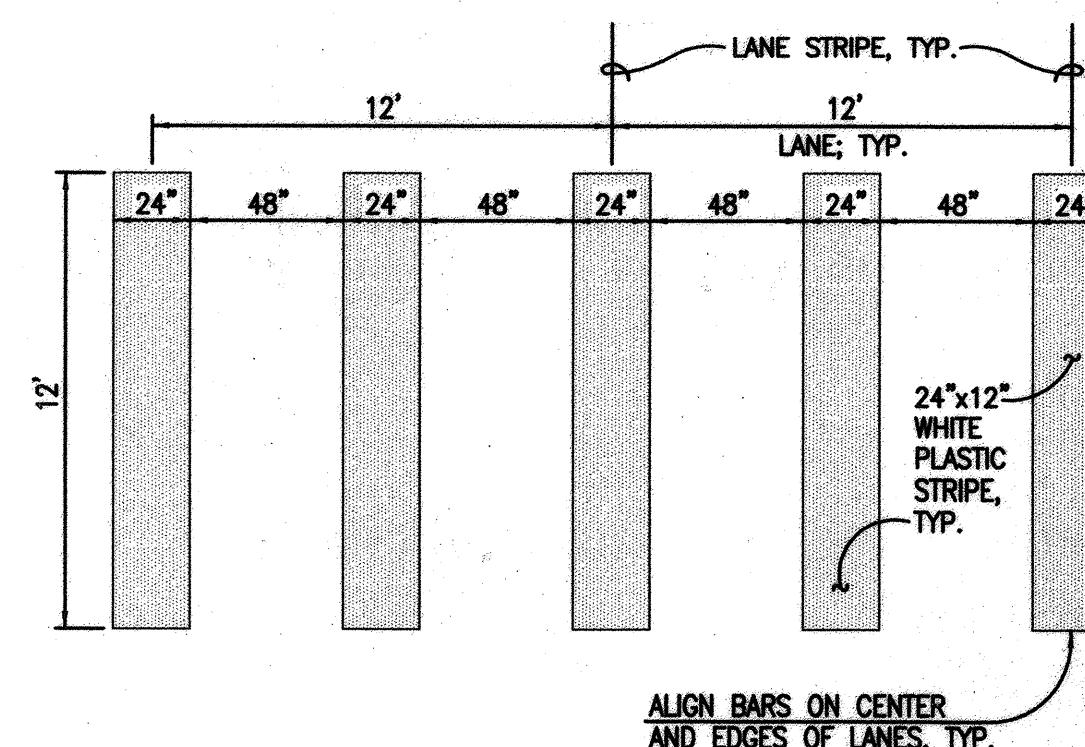

CROSSWALK ALIGNMENT/SPACING DETAIL  
SCALE: 1"=5'

**HIGH MESA Consulting Group**

6010-B MIDWAY PARK BLVD. NE • ALBUQUERQUE, NEW MEXICO 87109  
PHONE: 505.345.4250 • FAX: 505.345.4254 • www.hghmesacg.com  
2005.180.4 2008.186.G

CITY OF ALBUQUERQUE  
PUBLIC WORKS DEPARTMENT  
ENGINEERING DEVELOPMENT GROUP

TITLE: APS ATRISCO HERITAGE ACADEMY HIGH SCHOOL  
DENNIS CHAVEZ BLVD. S.W./118TH STREET S.W. PHASE 1 SIGNALIZATION  
STRIPING AND SIGNAGE PLAN

DESIGN REVIEW COMMITTEE  
APPROVED  
MAR 06 2009  
DESIGN REVIEW COMMITTEE

CITY ENGINEER APPROVAL  
APPROVED  
MAY 12 2009  
CITY ENGINEER

City Project No. 753978 Zone Map No. P-8 Sheet 8 of 8

**RECORD DRAWING**  
FOR CERTIFICATION, SEE SHEET 1