

SCANNED BY
PLANNING

1 2 3 4 5 6 7 8 9 10 11 12 13 14 15
26-115391-86-1081

CONSTRUCTION PLANS

FOR

ANDERSON HEIGHTS SUBDIVISION

UNIT 3

ALBUQUERQUE, NEW MEXICO

SURVEYOR'S CERTIFICATION

I, WILL PLOTNER JR., A DULY QUALIFIED, REGISTERED, PROFESSIONAL LAND SURVEYOR UNDER THE LAWS OF THE STATE OF NEW MEXICO, DO HEREBY CERTIFY THAT THE "AS-BUILT" INFORMATION SHOWN ON THESE DRAWINGS WAS OBTAINED FROM FIELD CONSTRUCTION AND "AS-BUILT" SURVEYS PERFORMED BY ME OR UNDER MY SUPERVISION, THAT THE "AS-BUILT" INFORMATION SHOWN ON THESE DRAWINGS WAS ADDED BY ME OR UNDER MY SUPERVISION, AND THAT THIS "AS-BUILT" INFORMATION IS TRUE AND CORRECT TO THE BEST OF MY KNOWLEDGE AND BELIEF. CARTESIAN SURVEYS IS NOT RESPONSIBLE FOR ANY OF THE DESIGN CONCEPTS, CALCULATIONS, ENGINEERING, OR INTENT OF THE RECORD DRAWINGS.

WILL PLOTNER JR., NMPS 14271

CERTIFICATE OF SUBSTANTIAL COMPLIANCE ON PLANS

I, Diane Hoelzer, NMPE 11967, of the firm Mark Goodwin & Associates, P.A., a Registered Professional Engineer in the State of New Mexico, do hereby certify, to the best of my knowledge and belief, that the infrastructure installed as part of this project has been inspected by me or by a qualified person under my direct supervision, and has been constructed in accordance with the plans and specifications approved by the City Engineer and that the original design intent of the approved plans has been met, except as noted by me on the as-built construction drawings. This Certification is based on site inspections by me or personnel under my direction, and survey information provided by Will Plotner, Jr., NMPS number 14271.

Diane Hoelzer 1-2-08
Diane Hoelzer NMPE 11967

I, Diane Hoelzer, certify that this electronic version is identical to the original reproducible APPROVED FOR CONSTRUCTION drawings signed by me on August 29, 2008.

This set of drawings is accepted for RECORD purposes by _____ on _____, 2007.

1 2 3 4 5 6 7 8 9 10 11 12 13 14 15


INDEX TO DRAWINGS

SHEET NO.	SHEET
1	TITLE SHEET
2-4	PLAT
5-6	GRADING AND DRAINAGE PLAN
7	MASTER PAVING PLAN
8	PAYTON TRAIL S.W. & COVERT LANE S.W. PAVING IMPROVEMENTS
9	GAULT TRAIL S.W. & THAYER LANE S.W. PAVING IMPROVEMENTS
10	HILGENBERG LANE S.W. PAVING IMPROVEMENTS
11	HUMPHRIES LANE S.W. & VANHORNE WAY S.W. PAVING IMPROVEMENTS
12	MORRISSEY STREET S.W. PAVING IMPROVEMENTS
13	MORRISSEY STREET S.W. PAVING IMPROVEMENTS
14	MASTER UTILITY PLAN
15	PAYTON TRAIL S.W. & COVERT LANE S.W. UTILITY IMPROVEMENTS
16	GAULT TRAIL S.W. & THAYER LANE S.W. UTILITY IMPROVEMENTS
17	HILGENBERG LANE S.W. UTILITY IMPROVEMENTS
18	HUMPHRIES LANE S.W. & VANHORNE WAY S.W. UTILITY IMPROVEMENTS
18A	MORRISSEY STREET S.W.

APPROVED AS RECORD DRAWINGS
DESIGN REVIEW SECTION
CITY CONSTRUCTION ENGINEER
DATE: 10-07-2008

DRB NO.

1002739

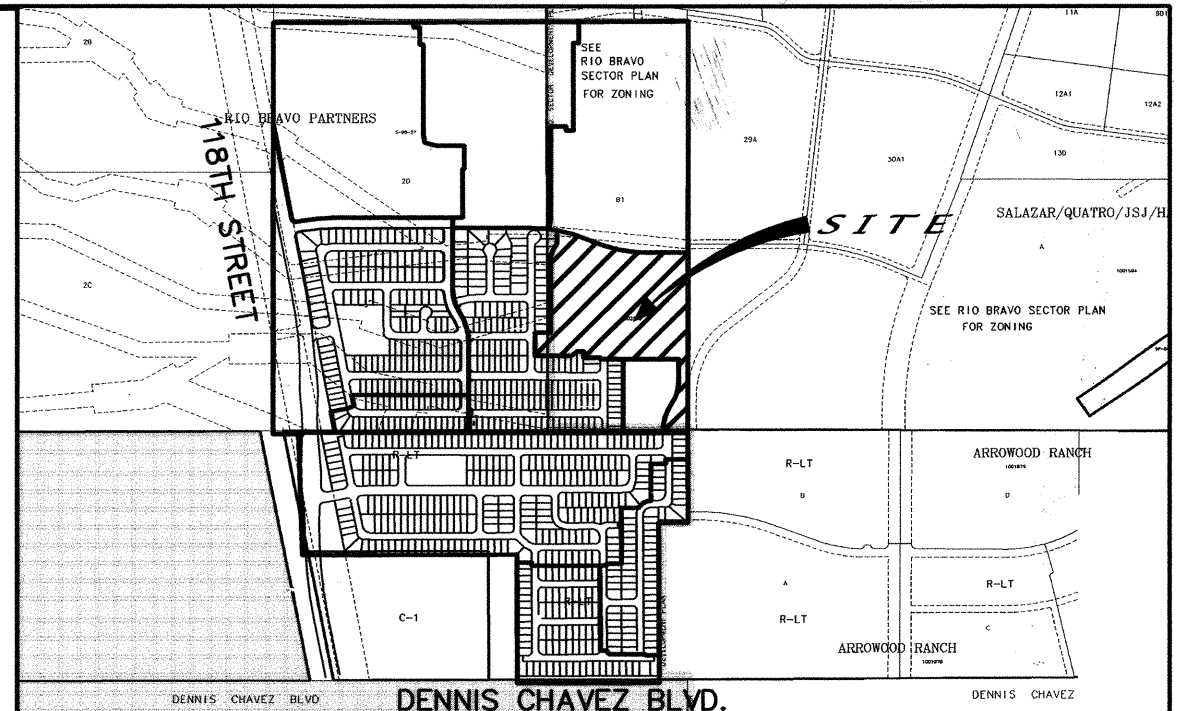

VICINITY MAP ZONE ATLAS #N-8/P-8
GENERAL NOTES SCALE: NONE

NOTICE TO CONTRACTORS

- AN EXCAVATION/CONSTRUCTION PERMIT WILL BE REQUIRED BEFORE BEGINNING ANY WORK WITHIN THE CITY RIGHT-OF-WAY.
- ALL WORK DETAILED ON THESE PLANS TO BE PERFORMED UNDER CONTRACT SHALL, EXCEPT AS OTHERWISE STATED OR PROVIDED FOR HEREON, BE CONSTRUCTED IN ACCORDANCE WITH THE CITY OF ALBUQUERQUE STANDARD SPECIFICATIONS FOR PUBLIC WORKS CONSTRUCTION, 1986 EDITION AS REVISED THROUGH UPDATE #7 INCLUDING AMENDMENT 1.
- TWO WORKING DAYS PRIOR TO ANY EXCAVATION, THE CONTRACTOR MUST CONTACT NEW MEXICO ONE CALL SYSTEM (260-1990) FOR LOCATION OF EXISTING UTILITIES.
- PRIOR TO CONSTRUCTION, THE CONTRACTOR SHALL EXCAVATE AND VERIFY THE HORIZONTAL AND VERTICAL LOCATIONS OF ALL OBSTRUCTIONS. SHOULD A CONFLICT EXIST, THE CONTRACTOR SHALL NOTIFY THE ENGINEER IMMEDIATELY SO THAT THE CONFLICT CAN BE RESOLVED WITH A MINIMUM AMOUNT OF DELAY.
- FIVE (5) WORKING DAYS PRIOR TO BEGINNING OF CONSTRUCTION, THE CONTRACTOR SHALL SUBMIT TO CONSTRUCTION COORDINATION DIVISION A DETAILED CONSTRUCTION SCHEDULE. TWO (2) WORKING DAYS PRIOR TO THE START OF CONSTRUCTION, THE CONTRACTOR SHALL OBTAIN A BARRICADING PERMIT FROM THE CONSTRUCTION COORDINATION DIVISION. CONTRACTOR SHALL NOTIFY THE CONSTRUCTION COORDINATION ENGINEER (824-3400) PRIOR TO OCCUPYING AN INTERSECTION. REFER TO SECTION 19 OF THE GENERAL CONDITIONS OF THE STANDARD SPECIFICATIONS.
- ALL WORK AFFECTING ARTERIAL ROADWAYS REQUIRES TWENTY-FOUR HOUR CONSTRUCTION.
- ALL STREET STRIPING ALTERED OR DESTROYED SHALL BE REPLACED WITH PLASTIC REFLECTORIZED PAVEMENT MARKING BY CONTRACTOR TO THE SAME LOCATION AS WAS EXISTING, OR AS INDICATED BY THIS PLAN SET.
- CONTRACTOR SHALL NOTIFY THE ENGINEER NOT LESS THAN SEVEN (7) DAYS PRIOR TO STARTING WORK IN ORDER THAT THE CITY SURVEYOR MAY TAKE NECESSARY MEASURES TO INSURE THE PRESERVATION OF SURVEY MONUMENTS. CONTRACTOR SHALL NOT DISTURB PERMANENT SURVEY MONUMENTS WITHOUT THE CONSENT OF THE CITY SURVEYOR AND SHALL NOTIFY THE CITY SURVEYOR AND BEAR THE EXPENSE OF REPLACING ANY THAT MAY BE DISTURBED WITHOUT PERMISSION. REPLACEMENT SHALL BE DONE ONLY BY THE CITY SURVEYOR. WHEN A CHANGE IS MADE IN THE FINISHED ELEVATIONS OF THE PAVEMENT OF ANY ROADWAY IN WHICH A PERMANENT SURVEY MONUMENT IS LOCATED, CONTRACTOR SHALL, AT HIS OWN EXPENSE, ADJUST THE MONUMENT TO COVER THE NEW GRADE UNLESS OTHERWISE SPECIFIED. REFER TO SECTION 4.4 OF THE GENERAL CONDITIONS OF THE STANDARD SPECIFICATIONS. UPDATE NO. 7.
- CONTRACTOR SHALL RECORD DATA ON ALL UTILITY LINES AND ACCESSORIES AS REQUIRED BY THE CITY OF ALBUQUERQUE FOR THE PREPARATION OF "AS CONSTRUCTED" DRAWINGS. CONTRACTOR SHALL NOT COVER UTILITY LINES AND ACCESSORIES UNTIL ALL DATA HAVE BEEN RECORDED.
- CONTRACTOR SHALL MAINTAIN A GRAFFITI-FREE WORK SITE. CONTRACTOR SHALL PROMPTLY REMOVE ANY GRAFFITI FROM ALL EQUIPMENT, WHETHER PERMANENT OR TEMPORARY.
- CONTRACTOR SHALL COORDINATE WITH THE CITY OF ALBUQUERQUE WATER SYSTEMS DIVISION (857-8200) SEVEN (7) WORKING DAYS IN ADVANCE OF ANY WORK THAT MAY AFFECT EXISTING PUBLIC WATER OR SEWER UTILITIES. EXISTING VALVES TO BE OPERATED BY CITY PERSONNEL ONLY. CONTRACTOR SHALL CONTACT THE WATER SYSTEMS DIVISION SEVEN (7) WORKING DAYS PRIOR TO NEEDING VALVES TURNED ON OR OFF.
- FOR STORM DRAIN CONSTRUCTION, RCP JOINTS SHALL NOT BE GROUTED PRIOR TO FINAL INSPECTION. FINAL INSPECTION WILL DETERMINE JOINTS TO BE GROUTED FOR FINAL ACCEPTANCE OF THE CONSTRUCTION.
- ALL EXCAVATION, TRANCHING, AND SHORING ACTIVITIES MUST BE CARRIED-OUT IN ACCORDANCE WITH OSHA 29 CFR 1926.650 SUBPART P.
- ELECTRONIC MARKER DISKS (EMD) WILL BE PLACED ACCORDING TO SECTION 170 OF THE CITY OF ALBUQUERQUE STANDARD SPECIFICATIONS FOR PUBLIC WORKS CONSTRUCTION.
- THE CONTRACTOR WILL BE RESPONSIBLE FOR DISPOSING OF ALL DEBRIS, INCLUDING, NOT LIMITED TO HAZARDOUS WASTE TO DISPOSAL SITES APPROVED BY GOVERNMENTAL AGENCIES REGULATING THE DISPOSAL OF SUCH MATERIALS.
- PERMANENT PAVEMENT STRIPING AND MARKINGS WILL BE PLACED BY THE CONTRACTOR. THE ROAD SHALL NOT BE OPENED TO THE TRAFFIC UNTIL IT IS STRIPED. ALL STRIPING, PAVEMENT MARKINGS INCLUDING CROSOWALKS, ARROWS AND LINE MARKINGS ARE TO BE CONSTRUCTED OF HOT PLASTIC OR COLD PLASTIC IN ACCORDANCE WITH THE MANUAL OF UNIFORM TRAFFIC CONTROL DEVICES.
- CONTRACTOR WILL BE RESPONSIBLE FOR PROVIDING AND MAINTAINING ALL CONSTRUCTION SIGNING UNTIL PROJECT HAS BEEN ACCEPTED BY THE CITY.


- THE FOLLOWING NOTES ALSO APPLY WHEN CHECKED
- ☒ ALL UTILITIES AND UTILITY SERVICE LINES SHALL BE INSTALLED PRIOR TO PAVING.
 - ☒ BACKFILL COMPACTION SHALL BE ACCORDING TO SPECIFIED STREET USE.
 - ☒ TACK COAT REQUIREMENTS SHALL BE DETERMINED BY THE ENGINEER.
 - ☒ SIDEWALK AND WHEELCHAIR RAMPS WITHIN THE CURB RETURNS SHALL BE CONSTRUCTED WHEREVER A NEW CURB RETURN IS CONSTRUCTED.
 - ☒ ALL STORM DRAINAGE FACILITIES SHALL BE COMPLETED PRIOR TO FINAL ACCEPTANCE.
 - ☒ PRIVATE STREETS REQUIRE STREET NAME SIGNS, STOP SIGNS, AND ANY NECESSARY STRIPING. (DEVELOPERS RESPONSIBILITY)

CAUTION:

NOTE THAT ALL EXISTING UTILITIES MAY NOT BE SHOWN. ALL EXISTING SERVICE CONNECTIONS ARE NOT SHOWN. ANY EXISTING UTILITIES THAT ARE SHOWN ARE APPROXIMATE LOCATION ONLY. IT SHALL BE THE SOLE RESPONSIBILITY OF THE CONTRACTOR TO CONTACT ALL THE UTILITY OWNERS AND TO CONDUCT ALL NECESSARY FIELD INVESTIGATIONS PRIOR TO ANY EXCAVATIONS TO DETERMINE THE ACTUAL LOCATION OF UTILITIES AND OTHER IMPROVEMENTS.

dmg D. MARK GOODWIN & ASSOCIATES, P.A.
CONSULTING ENGINEERS
P.O. BOX 90666
ALBUQUERQUE, NEW MEXICO 87199
(505) 828-2200, FAX (505) 797-9539

REV.	SHEETS	CITY ENGINEER	DATE	USER DEPARTMENT	DATE	DATE
1	81	102	10/2/07	10/2/07	10/2/07	10/2/07
ENGINEERS STAMP & SIGNATURE						
APPROVALS			DATE	DATE	APPROVED FOR CONSTRUCTION	
DRC CHAIRMAN			10/2/07	10/2/07		
TRANSPORTATION			10/2/07	10/2/07		
WATER/WASTEWATER			10/2/07	10/2/07		
HYDROLOGY			10/2/07	10/2/07		
CIP			10/2/07	10/2/07		
CONSTR. MNGMT.			10/2/07	10/2/07		
CONSTR. COORD.			10/2/07	10/2/07		
CITY PROJECT NO.					SHEET	OF
753986					1	18

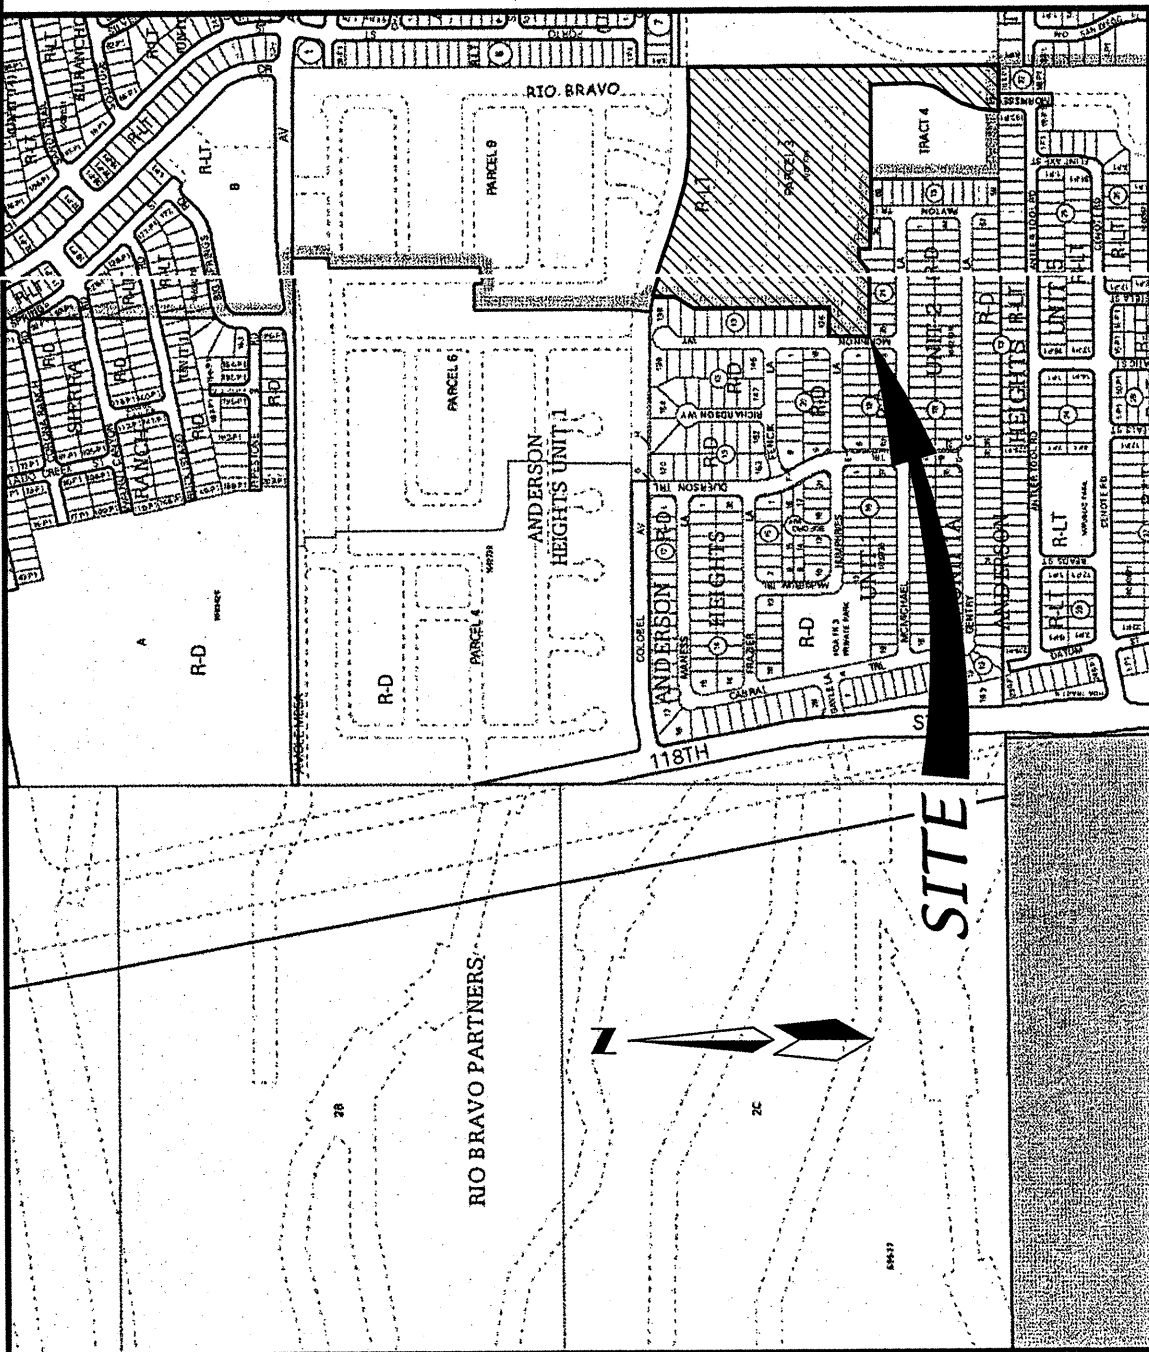

VICINITY MAP SCALE: NTS ZONE ATLAS: N-8

SUBDIVISION DATA

GROSS ACREAGE 17.7805 Acres

ZONE ATLAS NO. N-8-2

NO. OF EXISTING PARCELS 1 PARCEL

NO. OF LOTS/TRACTS/PARCELS CREATED 93 LOTS, 2 TRACTS 0 PARCEL

NO. OF PARCEL EASEMENTS CREATED 0.72

AREA DEDICATED TO CITY OF ALBUQUERQUE 1.6112 Acres

DATE OF SURVEY November, 2003

ZONING R-D

UTILITY CONTROL LOCATION SYSTEM LOG NUMBER 2003473085

FREE CONSENT AND DEDICATION

The subdivision hereon described is with the free consent and in accordance with the desires of the undersigned owner(s) and/or proprietor(s) thereof and said owner(s) and/or proprietor(s) do hereby grant: all access, utility and drainage easements hereon and all public utility easements shown hereon for the common and joint use of gas, electrical power, water, sewer and communication services for buried distribution lines, conduits, and pipes for underground utilities where shown or indicated, and including the right of ingress and egress for construction and maintenance, and the right to trim interfering trees and shrubs. Said owner(s) and/or proprietor(s) do hereby consent to all of the foregoing and do hereby certify that this subdivision is their free act and deed. Said owner(s) warrant that they hold among them complete and indefeasible title in fee simple to the land subdivided.

OWNER: KB HOME New Mexico Inc
BY: Robert Coleman, Director of Land
TITLE: Director of Land

Robert Coleman

DATE

OWNER'S ACKNOWLEDGMENT

STATE OF NEW MEXICO
COUNTY OF BERNALILLO

This instrument was acknowledged before me on
By: Robert Coleman, Director of Land, KB HOME New Mexico Inc, A New Mexico
Corporation on behalf of said corporation.

NOTARY PUBLIC

MY COMMISSION EXPIRES

LEGAL DESCRIPTION

A tract of land situate, within the Town of Atrisco Grant, projected Sections 5 and 8, Township 9 North, Range 2 East, New Mexico Principal Meridian, City of Albuquerque, Bernalillo County, New Mexico being all of PARCEL 3, ANDERSON HEIGHTS UNIT 3 as the same is shown and described on said plat and map in Book 2005C, Page 138 and containing 17.7805 acres more or less.

PURPOSE OF PLAT

- SUBDIVIDE ONE (1) PARCEL INTO NINETY THREE (93) LOTS, TWO (2) TRACTS FOR HOME OWNERS ASSOCIATION AND DRAINAGE.
- GRANT NEW EASEMENTS AS SHOWN HEREON.
- DEDICATE RIGHT-OF-WAY AS SHOWN HEREON.

FEMA FLOODPLAIN AND LOMR NOTES

- FINAL CONFIRMATION AND RELEASE OF A.M.A.F.C.A.'S DRAINAGE EASEMENTS WILL BE COMPLETED UPON ISSUANCE OF A LETTER OF MAP REVISION (LOMR) BY THE FEDERAL EMERGENCY MANAGEMENT AGENCY (FEMA) AND UPON ISSUANCE OF A QUITCLAIM DEED FROM A.M.A.F.C.A.
- UNTIL SUCH TIME THAT THE LOMR IS ISSUED BY FEMA TO REMOVE THE FLOODPLAIN, THIS AREA AND ANY FUTURE LOTS THAT DEVELOP IN THIS AREA, FLOOD INSURANCE MAY BE REQUIRED.

SURVEY NOTES

- Bearings are New Mexico State Plane Grid Bearings (Central Zone).
- Distances are ground distances.
- Bearings and distances in parenthesis are record.
- Basis of boundary are the following plats of record entitled:

- "ANDERSON HEIGHTS UNIT 2", (03-17-2006, BK-2006C PG-87)
- "ANDERSON HEIGHTS UNIT 1", (05-04-2005, BK-2005C PG-138)
- "ANDERSON HEIGHTS UNIT 1-A", (08-05-2005, BK-2005C PG-272)
- "ANDERSON HEIGHTS UNIT 5", (12-21-2005, BK-2005C PG-403)
- "LANDS OF RIO BRAVO PARTNERS", (04-17-96, 96C-160)
- "ROSKER TRACT, TRACT A-1, A-2 AND B-1", (03-27-03, 03C-80)
- "LANDS OF SALAZAR FAMILY TRUST, SALAZAR CUATRO TRUST, JSJ INVESTMENT COMPANY AND FALBA HANNETT", (07-23-03, 03C-223)
- "ANDERSON HEIGHTS, PARCELS A AND B", (12-03-03, 2003C - 361)) all being records of Bernalillo County, New Mexico.
- Field Survey performed on November, 2003.
- Title Report: None provided.
- UTILITY COUNCIL LOCATION SYSTEM LOG NO.: 2003473085

NOTE:

THE REMAINING OPEN SPACE REQUIREMENTS ARE MET VIA THE PROVISION OF DETACHED OPEN SPACE PER THE PROVISIONS OF SECTION 14-16-3-6(A)(3).

PLAT FOR
ANDERSON HEIGHTS UNIT 3
WITHIN THE
TOWN OF ATRISCO GRANT
PROJECTED SECTIONS 5 AND 8
TOWNSHIP 9 NORTH, RANGE 2 EAST, NMMP
CITY OF ALBUQUERQUE
BERNALILLO COUNTY, NEW MEXICO
August, 2006

APPROVED AND ACCEPTED BY:

APPROVAL AND CONDITIONAL ACCEPTANCE as specified by the Albuquerque Subdivision Ordinance, Chapter 14 Article 14 of the Revised Ordinances of Albuquerque, New Mexico, 1994.

Project Number: 1002739

Application Number:

PLAT APPROVAL

Utility Approvals:

PNM Electric Services	Date
PNM Gas Services	Date
Qwest Telecommunications	Date
Comcast	Date

City Approvals:

City Surveyor	Date
Real Property Division	Date
Traffic Engineering, Transportation Division	Date
Water Utility Department	Date
Parks and Recreation Department	Date
AMAFA	Date
City Engineer	Date
DRB Chairperson, Planning Department	Date

SURVEYOR'S CERTIFICATION:

"I, Timothy Aldrich, a duly qualified Registered Professional Land Surveyor under the laws of the State of New Mexico, do hereby certify that this plat and description were prepared by me or under my supervision, shows all easements as shown on the plat of record or made known to me by the owners and/or proprietors of the subdivision shown hereon, utility companies and other parties expressing an interest and meets the minimum requirements for monumentation and surveys of the Albuquerque Subdivision Ordinance, and further meets the Minimum Standards for Land Surveying in the State of New Mexico, and is true and correct to the best of my knowledge and belief."


Timothy Aldrich P.S. No. 7719


ALDRICH LAND
SURVEYING

P.O. BOX 30701, ALBQ., N.M. 87190
505-884-1990

Unit 3 FP_Coversheet.dwg	Drawn: stephen	Checked: ALS	Sheet of 6
Scale: AS SHOWN	Date: 8/10/2006	Job: A03080	1

F:\A03\005\A03080\H\FinalPlat\Unit 3 Unit 3 FP_Coversheet.dwg Last saved by: Stephen; plotted: 8/11/06

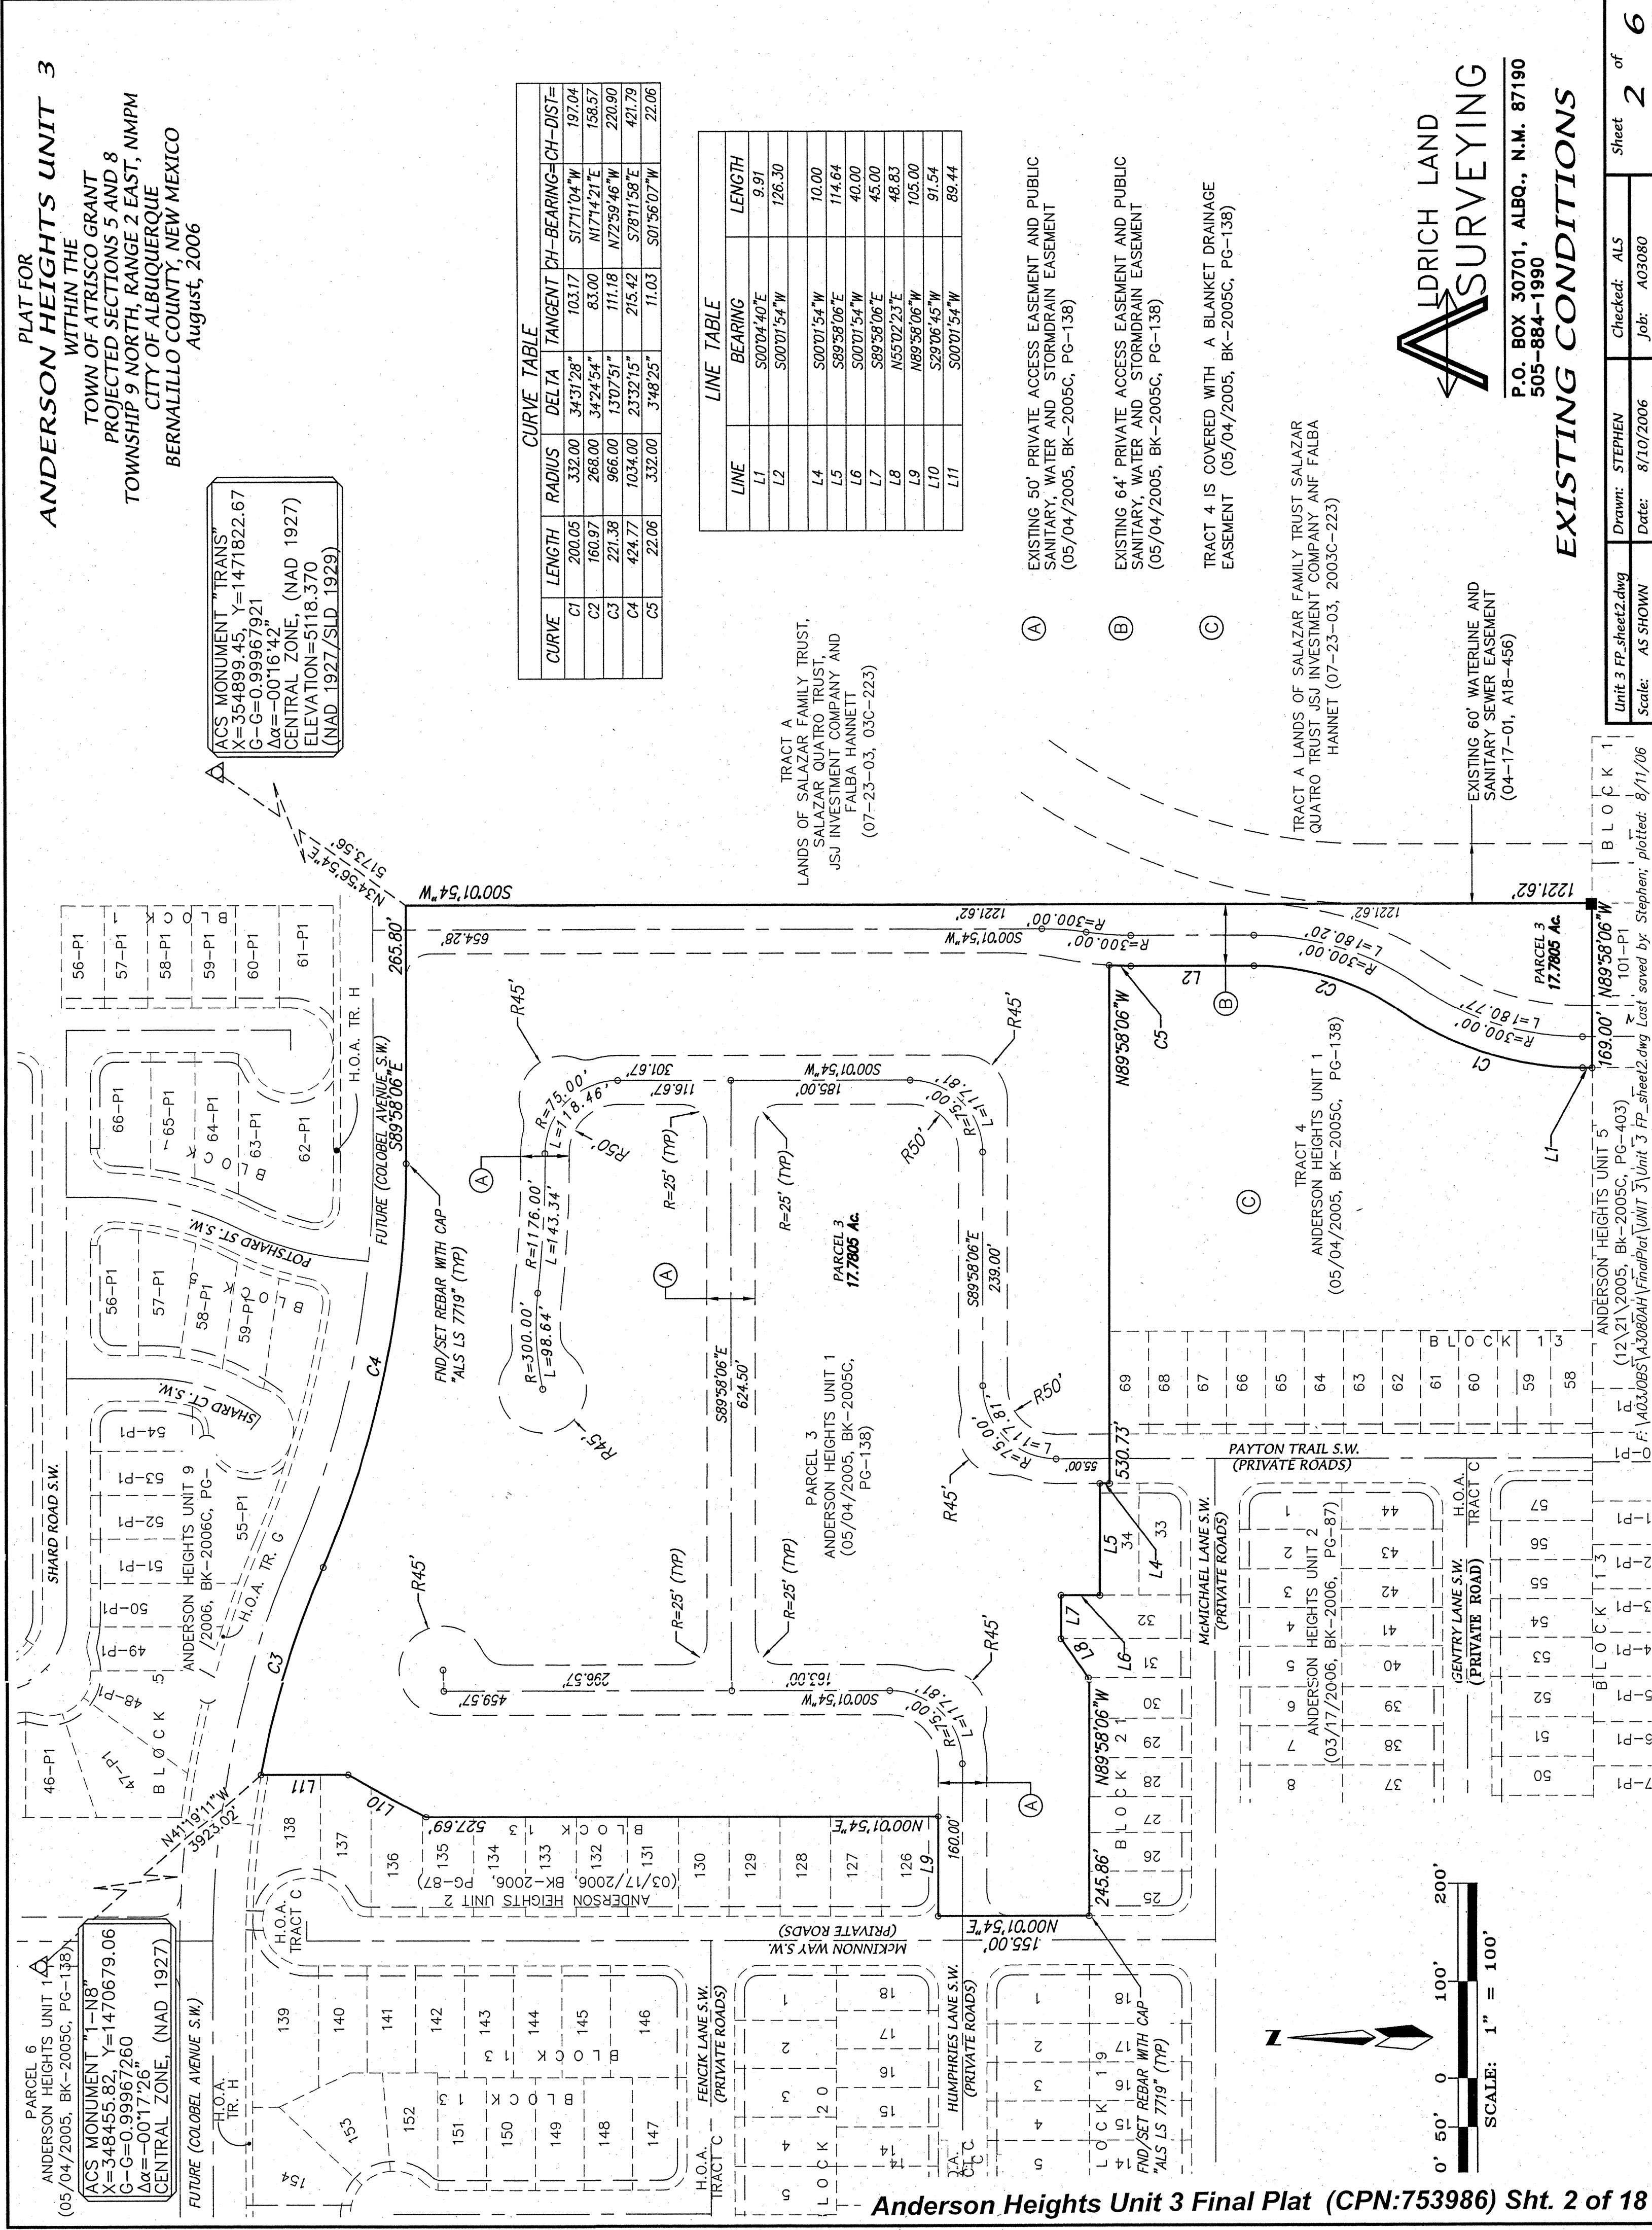

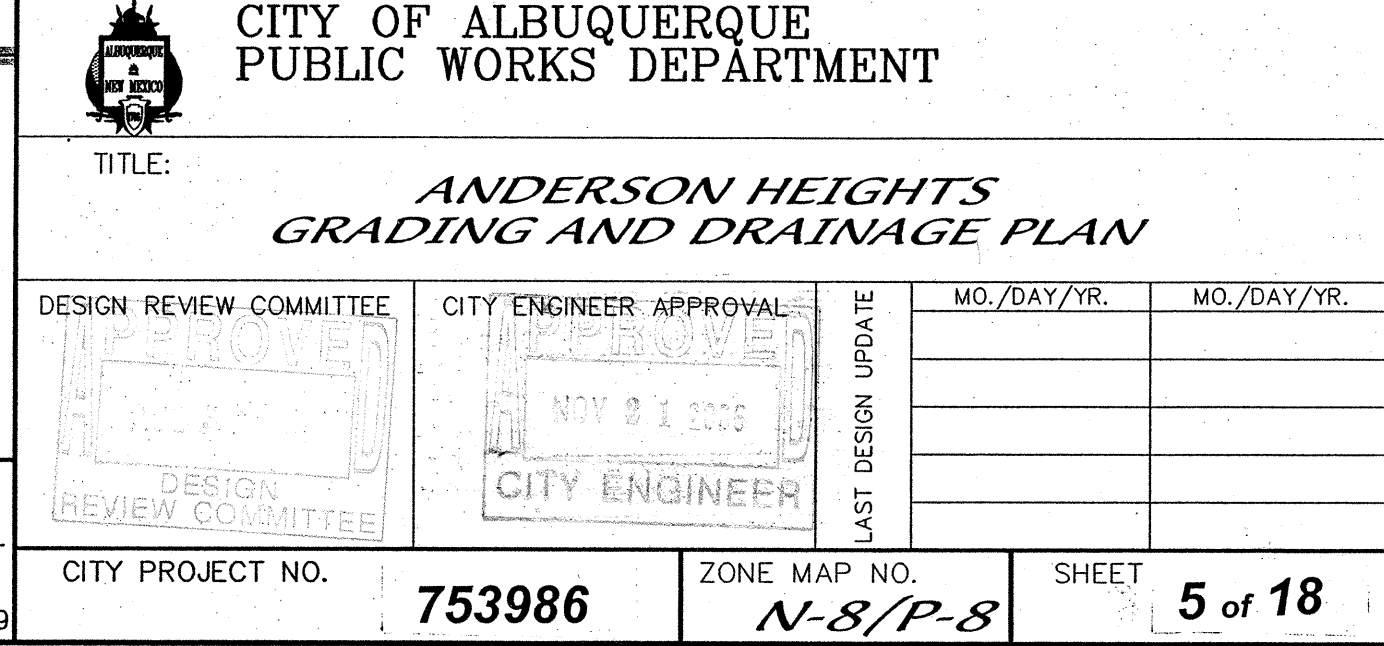

A03080AH\grade n drain\3080GD-50-REVA3\SHEET 7\04-20-06\ MJR ACH CAR







**ANDERSON HEIGHTS
GRADING AND DRAINAGE PLAN**

DESIGN REVIEW COMMITTEE	CITY ENGINEER APPROVAL	LAST DESIGN UPDATE		MO./DAY/YR.	MO./DAY/YR.
DESIGN REVIEW COMMITTEE	CITY ENGINEER				
CITY PROJECT NO.	753986	ZONE MAP NO.	N-8/P-8	SHEET	6 of 18

1. ALL SIDEWALKS PER CITY OF ALBUQUERQUE STANDARD DRAWING 2430.	7. TRANSITION FROM MOUNTABLE CURB TO STANDARD CURB AT INTERSECTIONS SHALL OCCUR THROUGH THE HC. RAMP PER C.O.A. STANDARD DRAWING 2418.
2. ALL 6" VALLEY GUTTERS PER CITY OF ALBUQUERQUE STANDARD DRAWING 2420 WITH REVISIONS AS SHOWN ON THIS SHEET.	8. SOIL NOT HAVING THE MINIMUM R-VALUE OF 50 FOR STREETS SHALL BE REMOVED TO A DEPTH OF 2 FEET AND REPLACED, BY THE CONTRACTOR, WITH SUITABLE MATERIAL. THE REVERSE SECTION SHALL BE DESIGNED BY THE CONSULTANT ACCOMMODATING THE EXISTING R-VALUE PER C.O.A. STANDARD SPECIFICATIONS.
3. ALL 4" VALLEY GUTTER PER C.O.A. STD. DWG 2421 & ALL 12" VALLEY GUTTER PER C.O.A. STD. DWG 2422.	9. TRUNCATED DOWNS DESIGN NEEDS TO FOLLOW ADA GUIDELINES. CONTRACTOR NEEDS TO SUBMIT SPECS TO CITY CONSTRUCTION ENGINEERS FOR EVALUATION PRIOR TO CONSTRUCTION.
4. ALL HANDICAP RAMPS ARE PER C.O.A. DETAIL 2441, CASE II, WITH TRUNCATED DOMES.	
5. TRANSITION FROM MOUNTABLE CURB TO STANDARD CURB SHALL BE 10 FEET.	
6. TRANSITION SECTION FROM FULL CROWN TO NO CROWN TO BE A MINIMUM OF 50 FEET PER C.O.A. STD. DETAIL #2401.	

	NEW MOUNTABLE CURB & GUTTER		NEW FULL CROWN TRANSITION
	NEW STANDARD CURB & GUTTER		NEW 1/2 CROWN TRANSITION
	NEW 4' SIDEWALK (DEFERRED)		UNIT BOUNDARY LINE
	NEW RIGHT-OF-WAY		NEW RETAINING WALL
	NEW CENTERLINE		NEW STREET LIGHT (12)
	NEW LOT LINES		NEW WHEELCHAIR RAMP WITH TRUNCATED DOMES (SEE NOTE 9)
	NEW EASEMENTS		NEW UNI-DIRECTIONAL WHEELCHAIR RAMP
	EXISTING CURB & GUTTER		NEW SIDEWALK
	FUTURE CURB & GUTTER		
	EXISTING WHEELCHAIR RAMP		

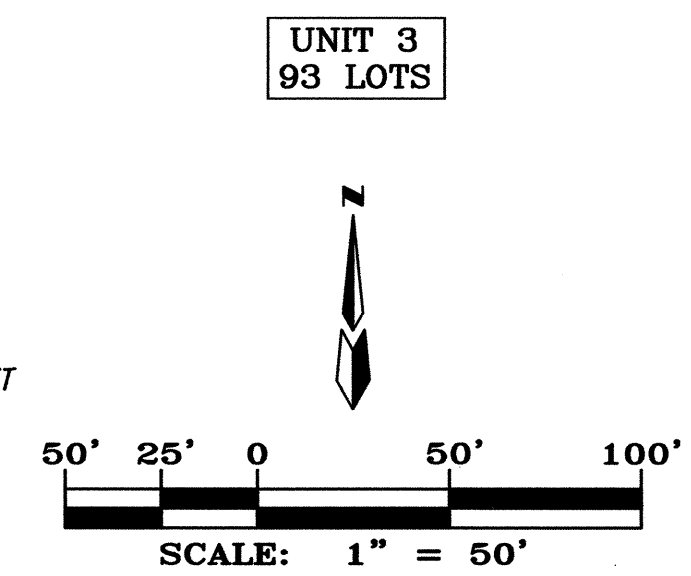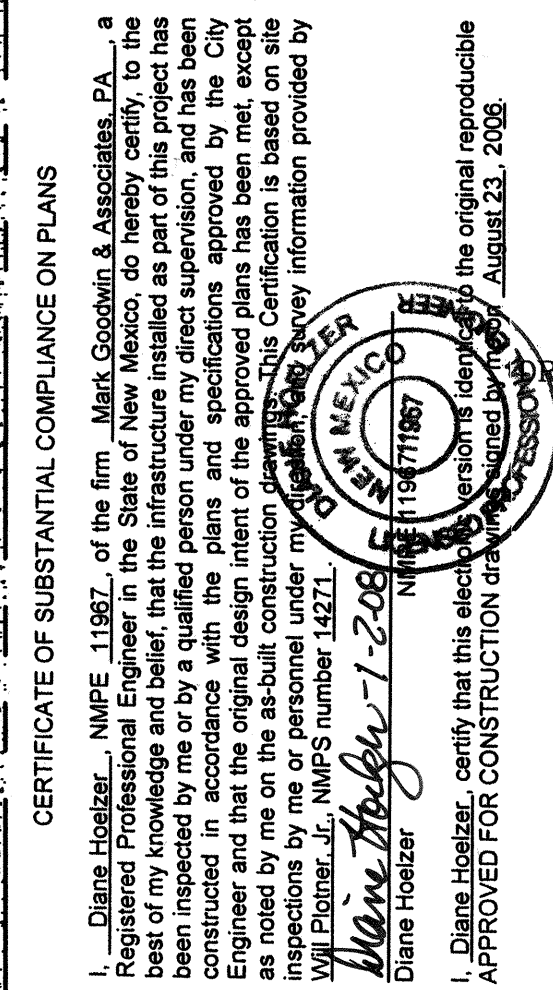[illegible]

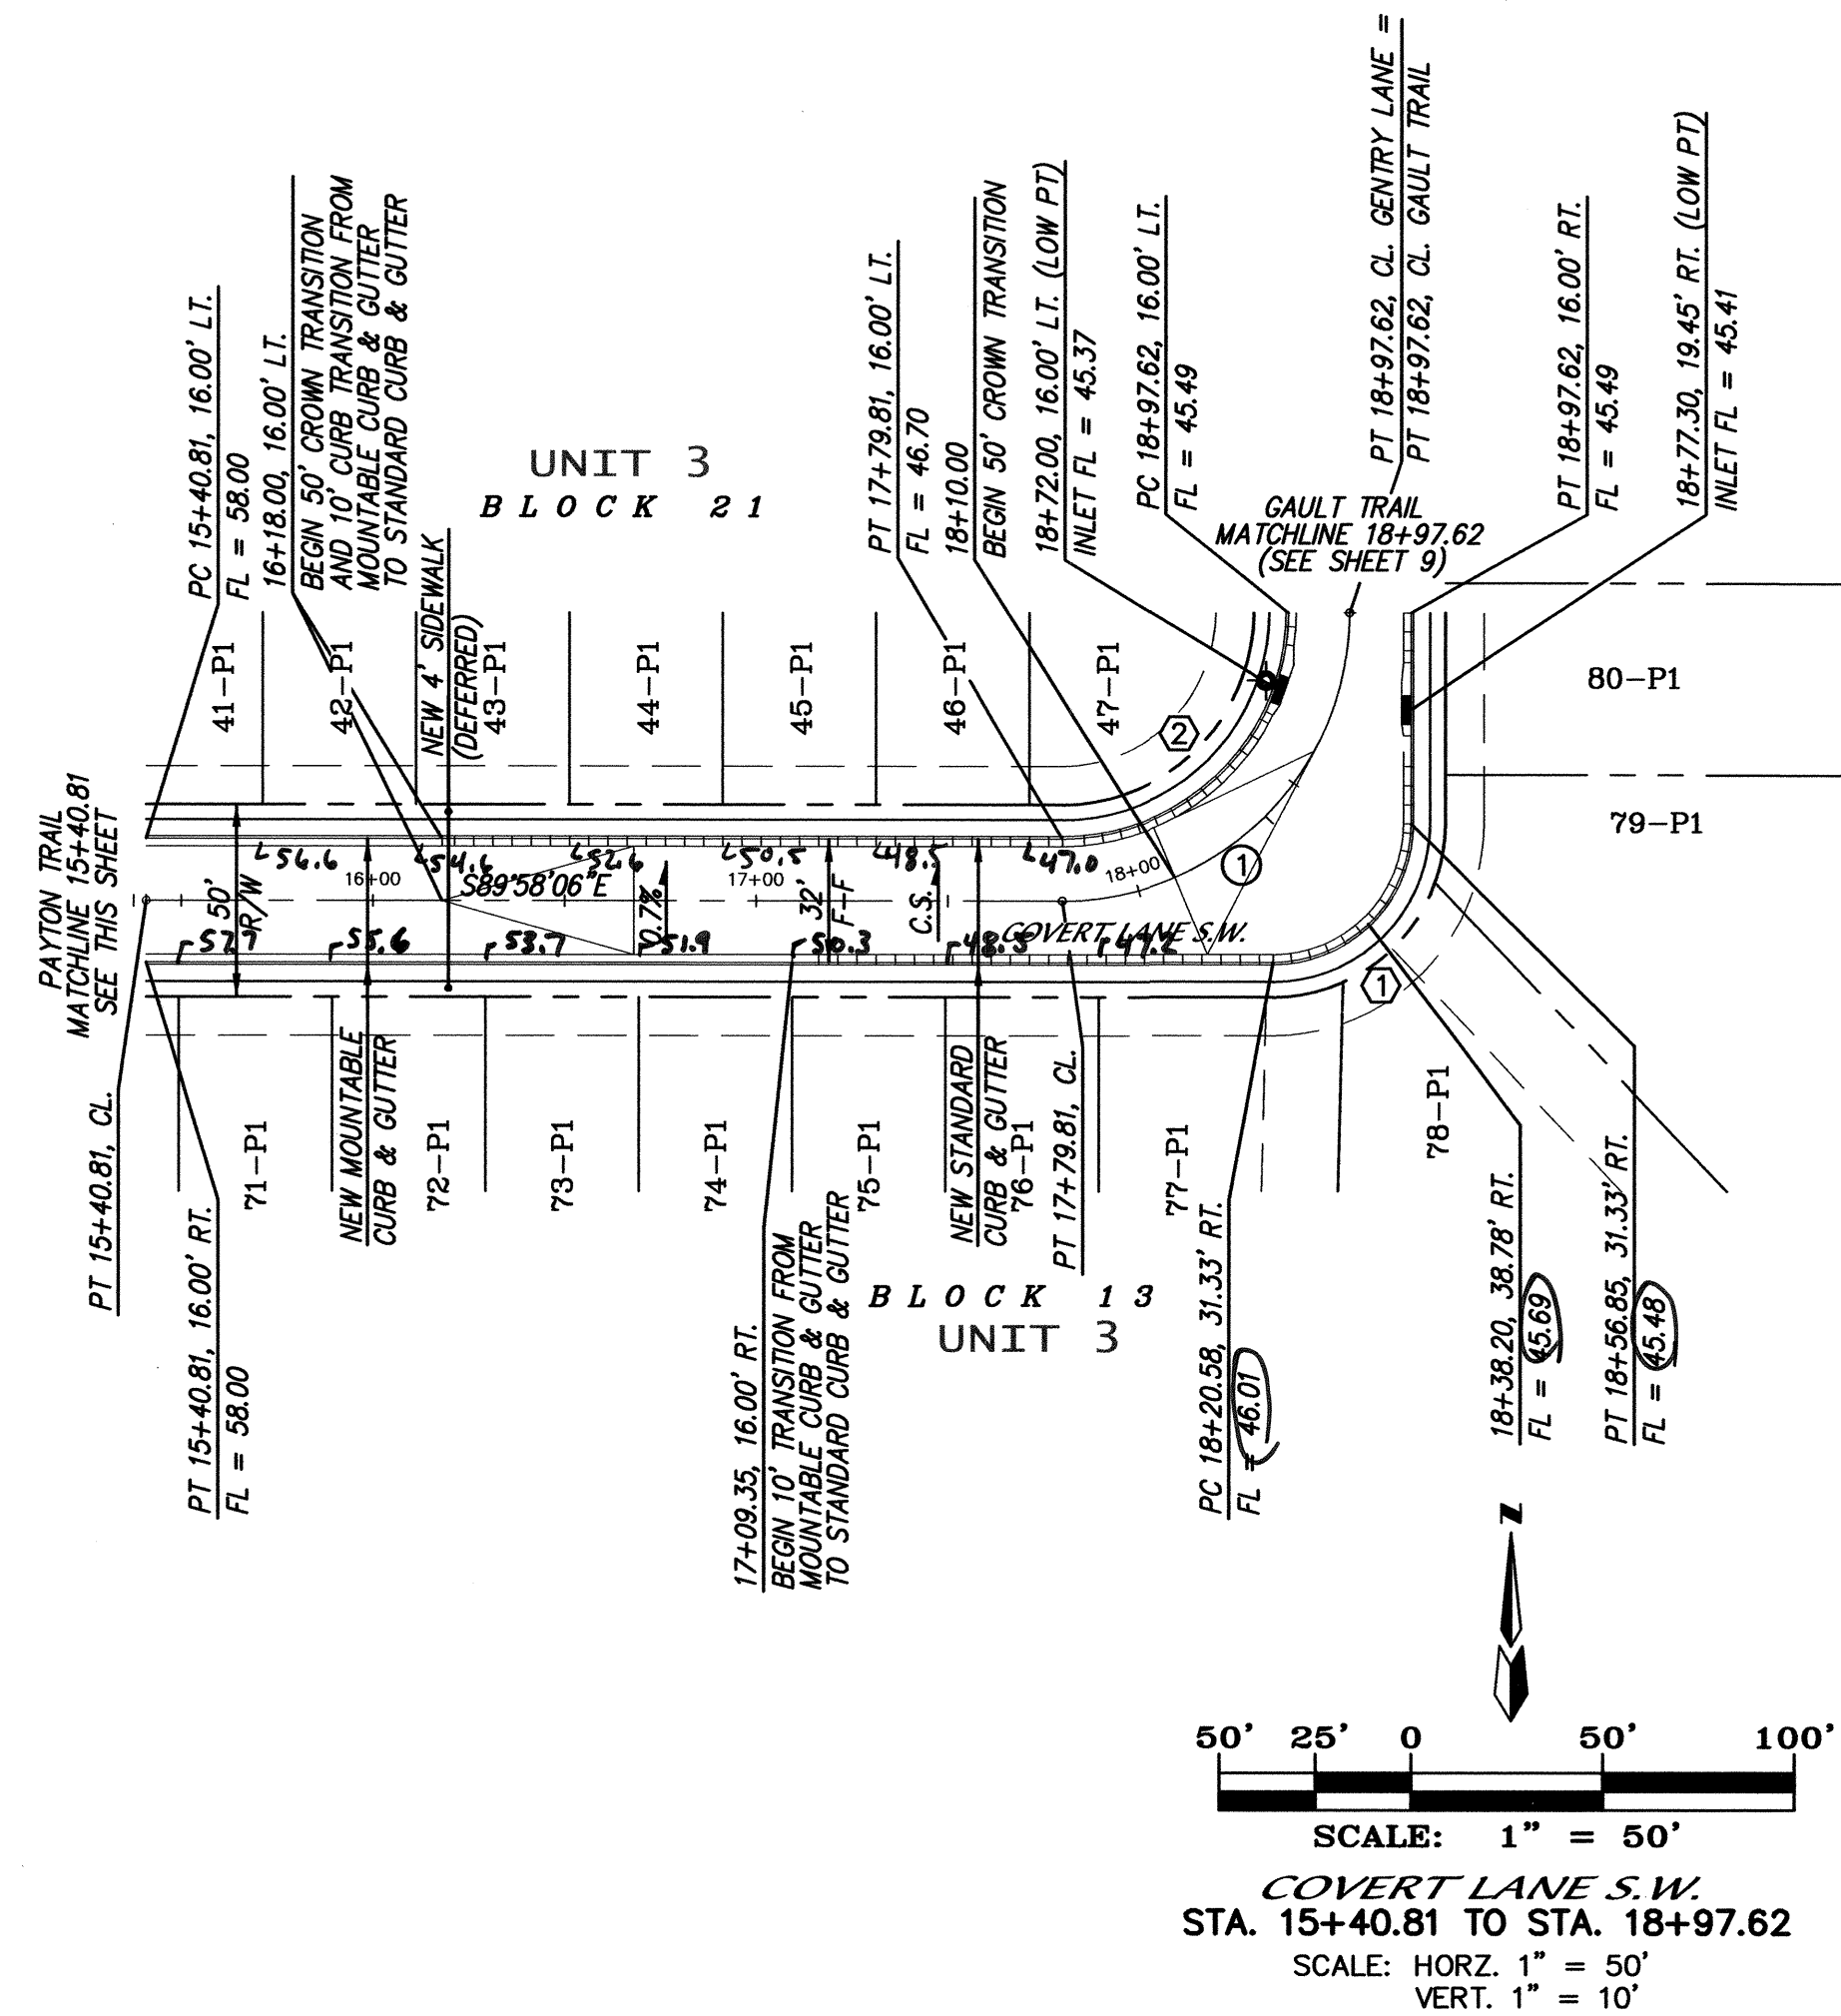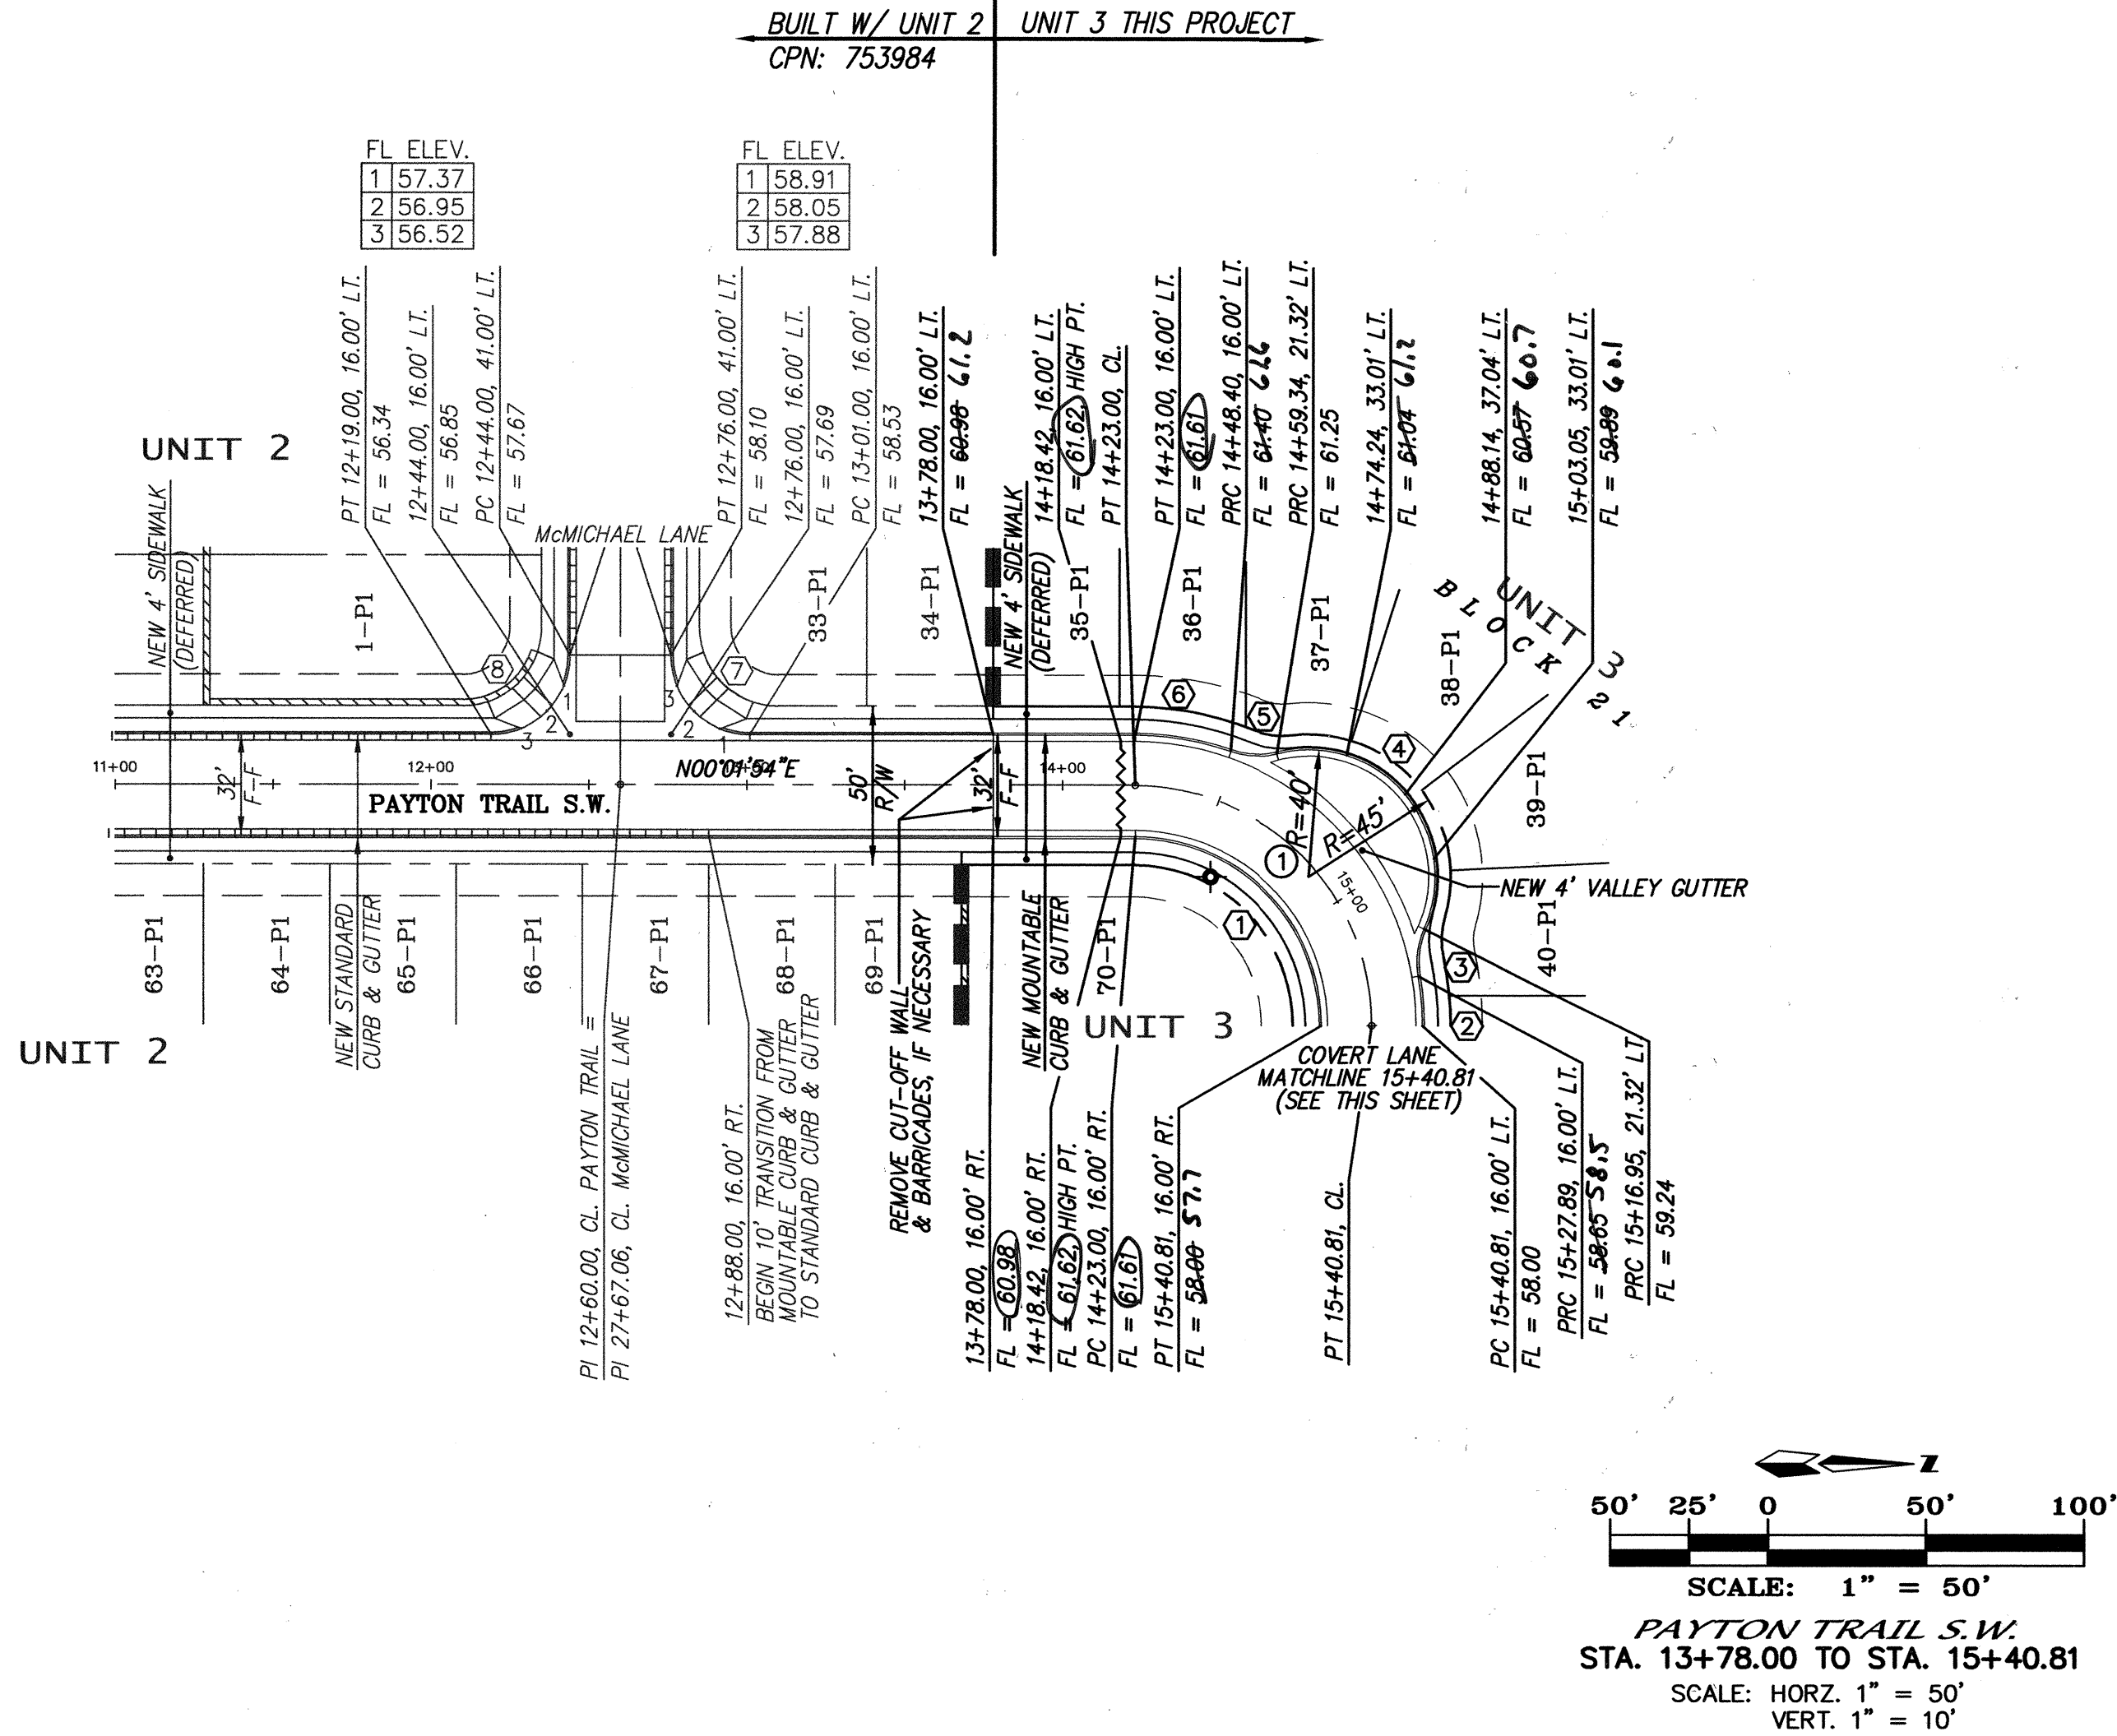

NOTES

1. ALL STATIONING IS CENTERLINE STATIONING.

PAYTON TRAIL S.W.
CURVE DATA - DESCRIBES FACE OF CURB

- ① $\Delta = 90^\circ 00' 00''$ $R = 59.00'$ $L = 92.68'$ $T = 59.00'$
- ② $\Delta = 95^\circ 2' 04''$ $R = 91.00'$ $L = 15.67'$ $T = 7.86'$
- ③ $\Delta = 34^\circ 04' 34''$ $R = 25.00'$ $L = 14.87'$ $T = 7.66'$
- ④ $\Delta = 128^\circ 52' 58''$ $R = 40.00'$ $L = 89.98'$ $T = 83.64'$
- ⑤ $\Delta = 34^\circ 04' 34''$ $R = 25.00'$ $L = 14.87'$ $T = 7.66'$
- ⑥ $\Delta = 19^\circ 24' 06''$ $R = 91.00'$ $L = 30.81'$ $T = 15.56'$
- ⑦ $\Delta = 90^\circ 00' 00''$ $R = 25.00'$ $L = 39.27'$ $T = 25.00'$
- ⑧ $\Delta = 90^\circ 00' 00''$ $R = 25.00'$ $L = 39.27'$ $T = 25.00'$
- ⑨ $\Delta = 90^\circ 00' 00''$ $R = 25.00'$ $L = 39.27'$ $T = 25.00'$
- ⑩ $\Delta = 90^\circ 00' 00''$ $R = 25.00'$ $L = 39.27'$ $T = 25.00'$

CURVE DATA - DESCRIBES CENTERLINE

- ① $\Delta = 90^\circ 00' 00''$ $R = 75.00'$ $L = 117.81'$ $T = 75.00'$

COVERT LANE S.W.
CURVE DATA - DESCRIBES FACE OF CURB

- ① $\Delta = 90^\circ 00' 00''$ $R = 36.00'$ $L = 56.55'$ $T = 36.00'$
- ② $\Delta = 90^\circ 00' 00''$ $R = 59.00'$ $L = 92.68'$ $T = 59.00'$

CURVE DATA - DESCRIBES CENTERLINE

- ① $\Delta = 90^\circ 00' 00''$ $R = 75.00'$ $L = 117.81'$ $T = 75.00'$

Certification
THE CHANGES SHOWN HEREON ARE BASED UPON A FIELD SURVEY CONDUCTED BY ME OR UNDER MY SUPERVISION AND REFLECT THE LOCATIONS (VERTICALLY AND HORIZONTALLY) TO THE BEST OF MY KNOWLEDGE AND BELIEF.

dmg MARK GOODWIN & ASSOCIATES, P.A.
CONSULTING ENGINEERS
P.O. BOX 90606
ALBUQUERQUE, NEW MEXICO 87199
(505) 828-2200, FAX (505) 797-9539

**CITY OF ALBUQUERQUE
PUBLIC WORKS DEPARTMENT**

TITLE: **ANDERSON HEIGHTS - UNIT 3
PAYTON TRAIL S.W. & COVERT LANE S.W.
PAVING IMPROVEMENTS**

DESIGN REVIEW COMMITTEE
APPROVED
AUG 31 2006
DESIGN REVIEW COMMITTEE

CITY ENGINEER APPROVAL
APPROVED
NOV 2 1 2006
CITY ENGINEER

CITY PROJECT NO.

753986

ZONE MAP NO.

N-8/P-8

SHEET

OF

8 18


CERTIFICATE OF SUBSTANTIAL COMPLIANCE ON PLANS


I, Diane Hoelzer, NMPE 11967, of the firm Mark Goodwin & Associates, P.A., a Registered Professional Engineer in the State of New Mexico, do hereby certify, to the best of my knowledge and belief, that the infrastructure installed as part of this project has been inspected by me or by a qualified person under my direct supervision, and has been constructed in accordance with the plans and specifications approved by the City Engineer and that the original design intent of the approved plans has been met, except as noted by me on the as-built construction drawings. This Certification is based on site inspections by me or persons under my direction, and survey information provided by Will Plotner, Jr., NMPS number 14271.

Diane Hoelzer 1-2-08
Diane Hoelzer NMPE 11967

I, Diane Hoelzer, certify that this electronic version is identical to the original reproducible APPROVED FOR CONSTRUCTION drawings signed by me on 1/2/2008.

BUILT W/ UNIT 2 UNIT 3
CPN: 753984

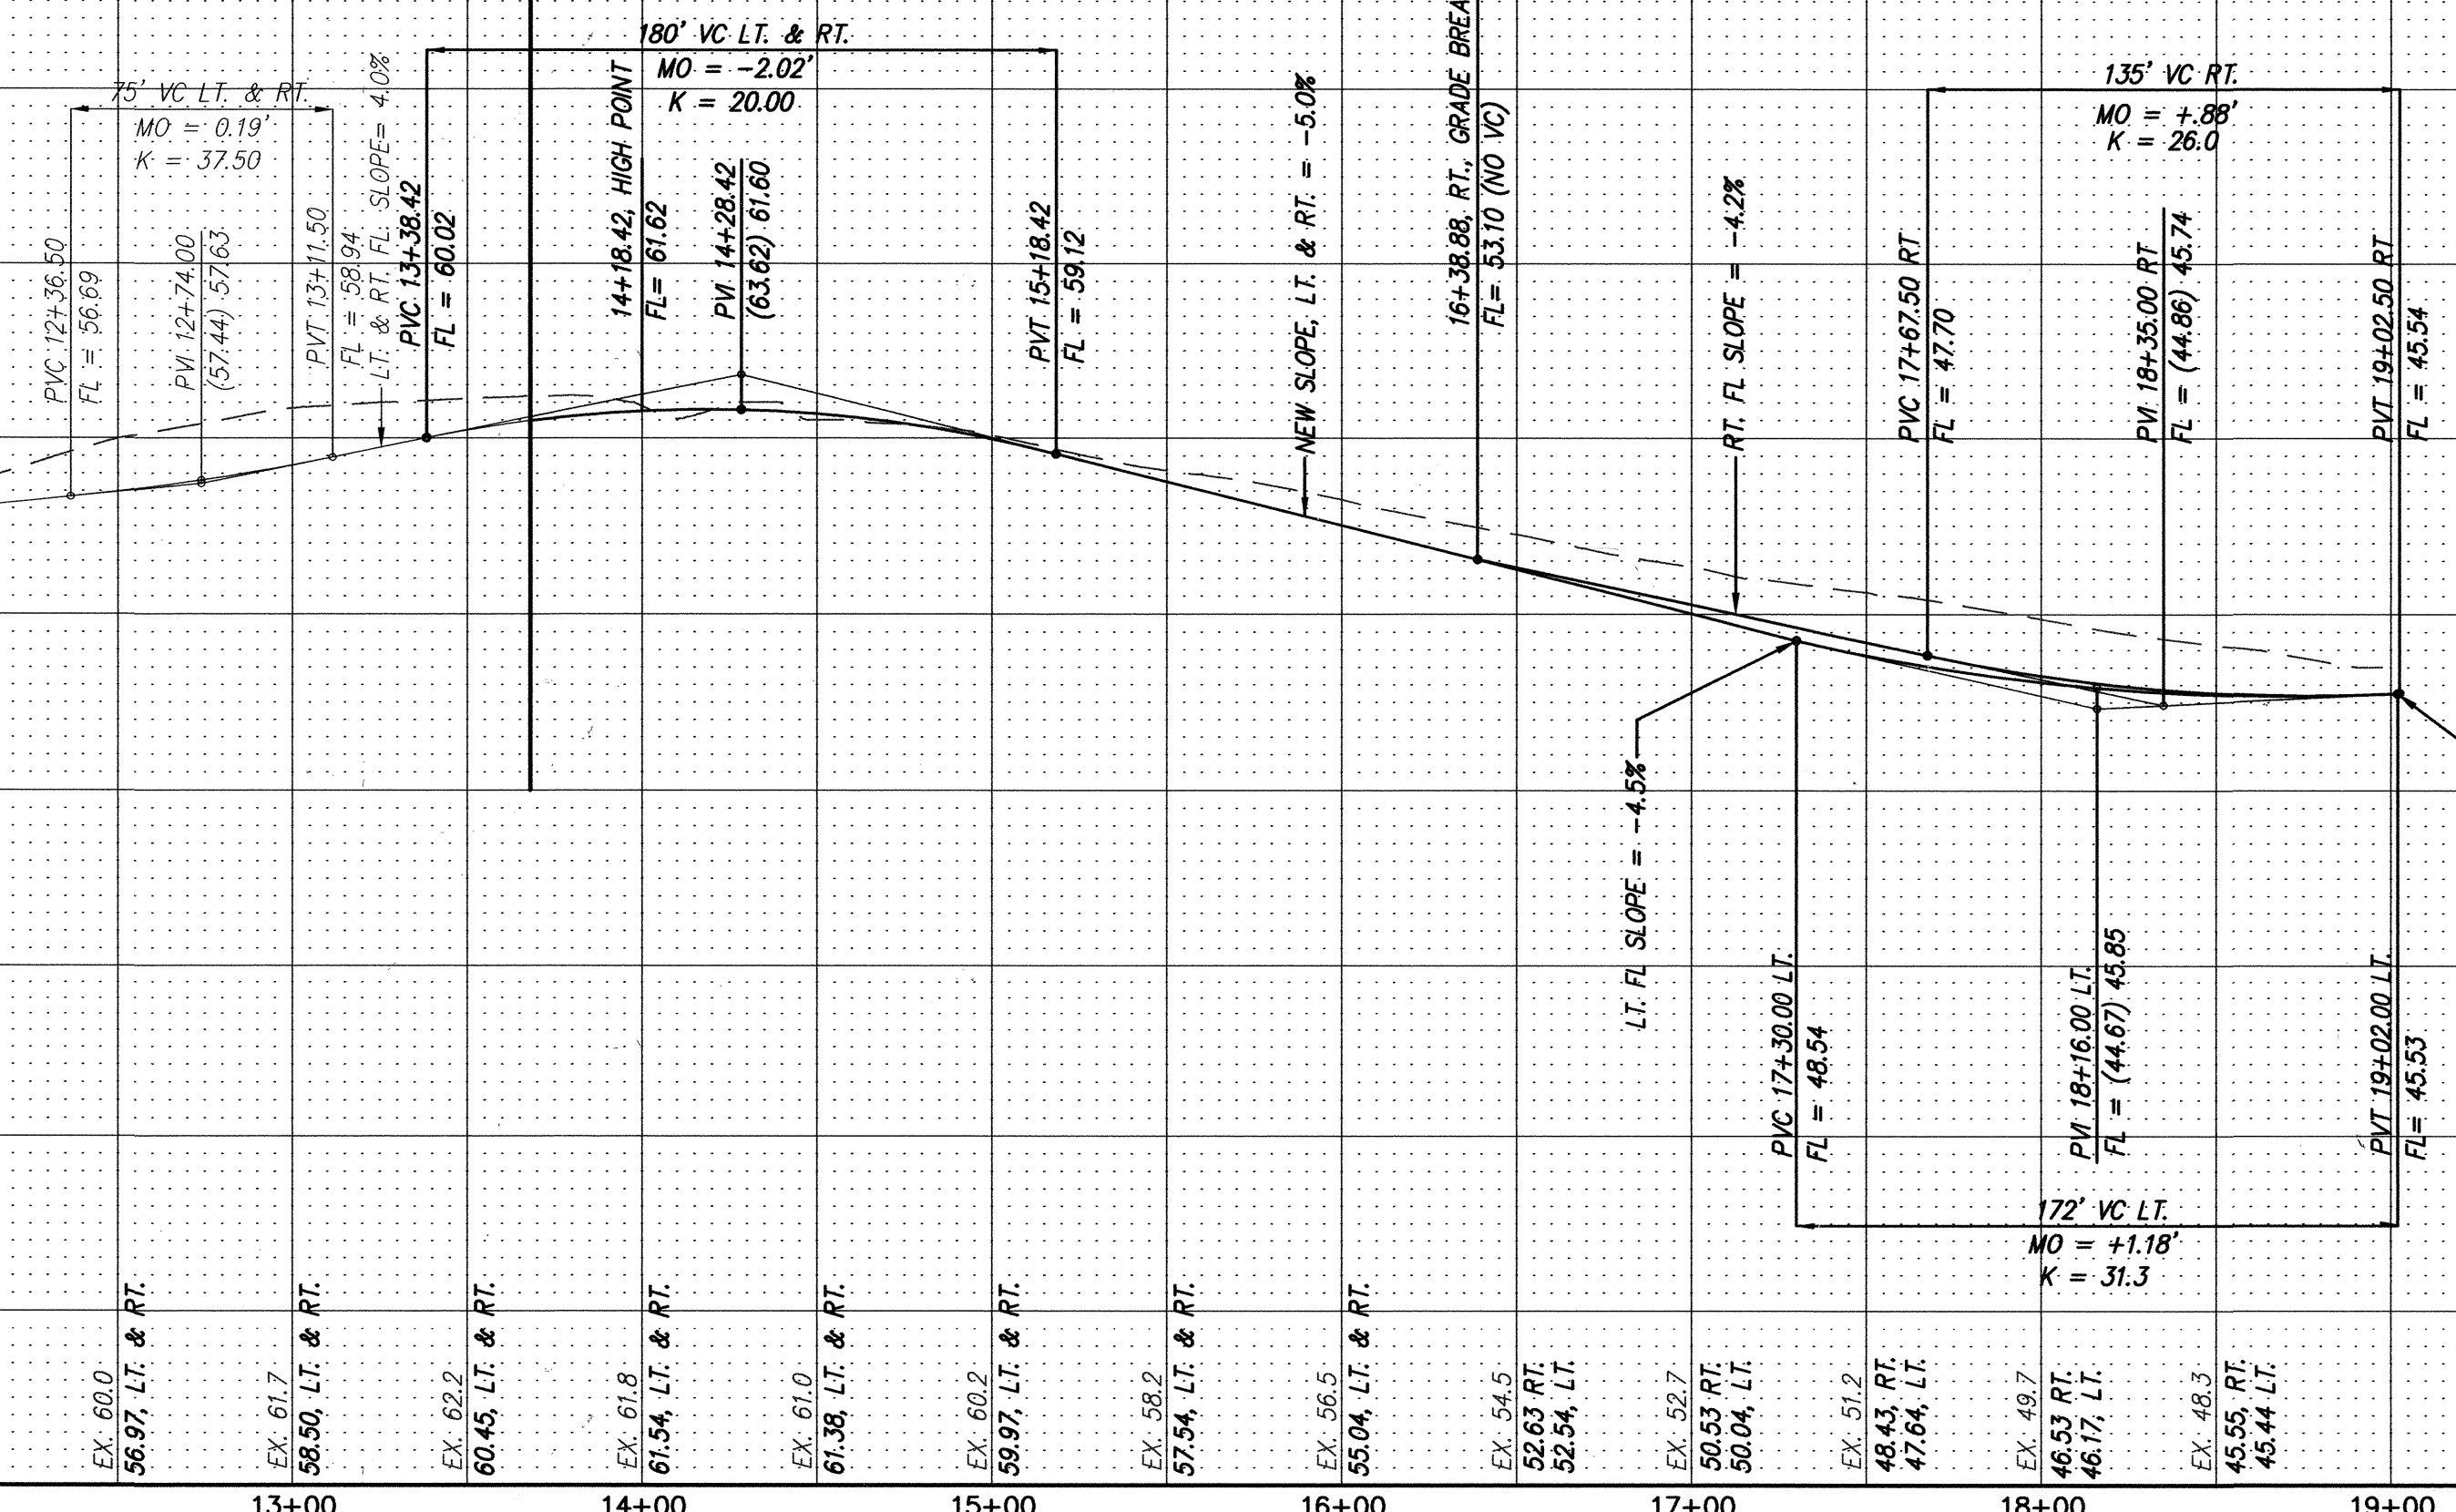

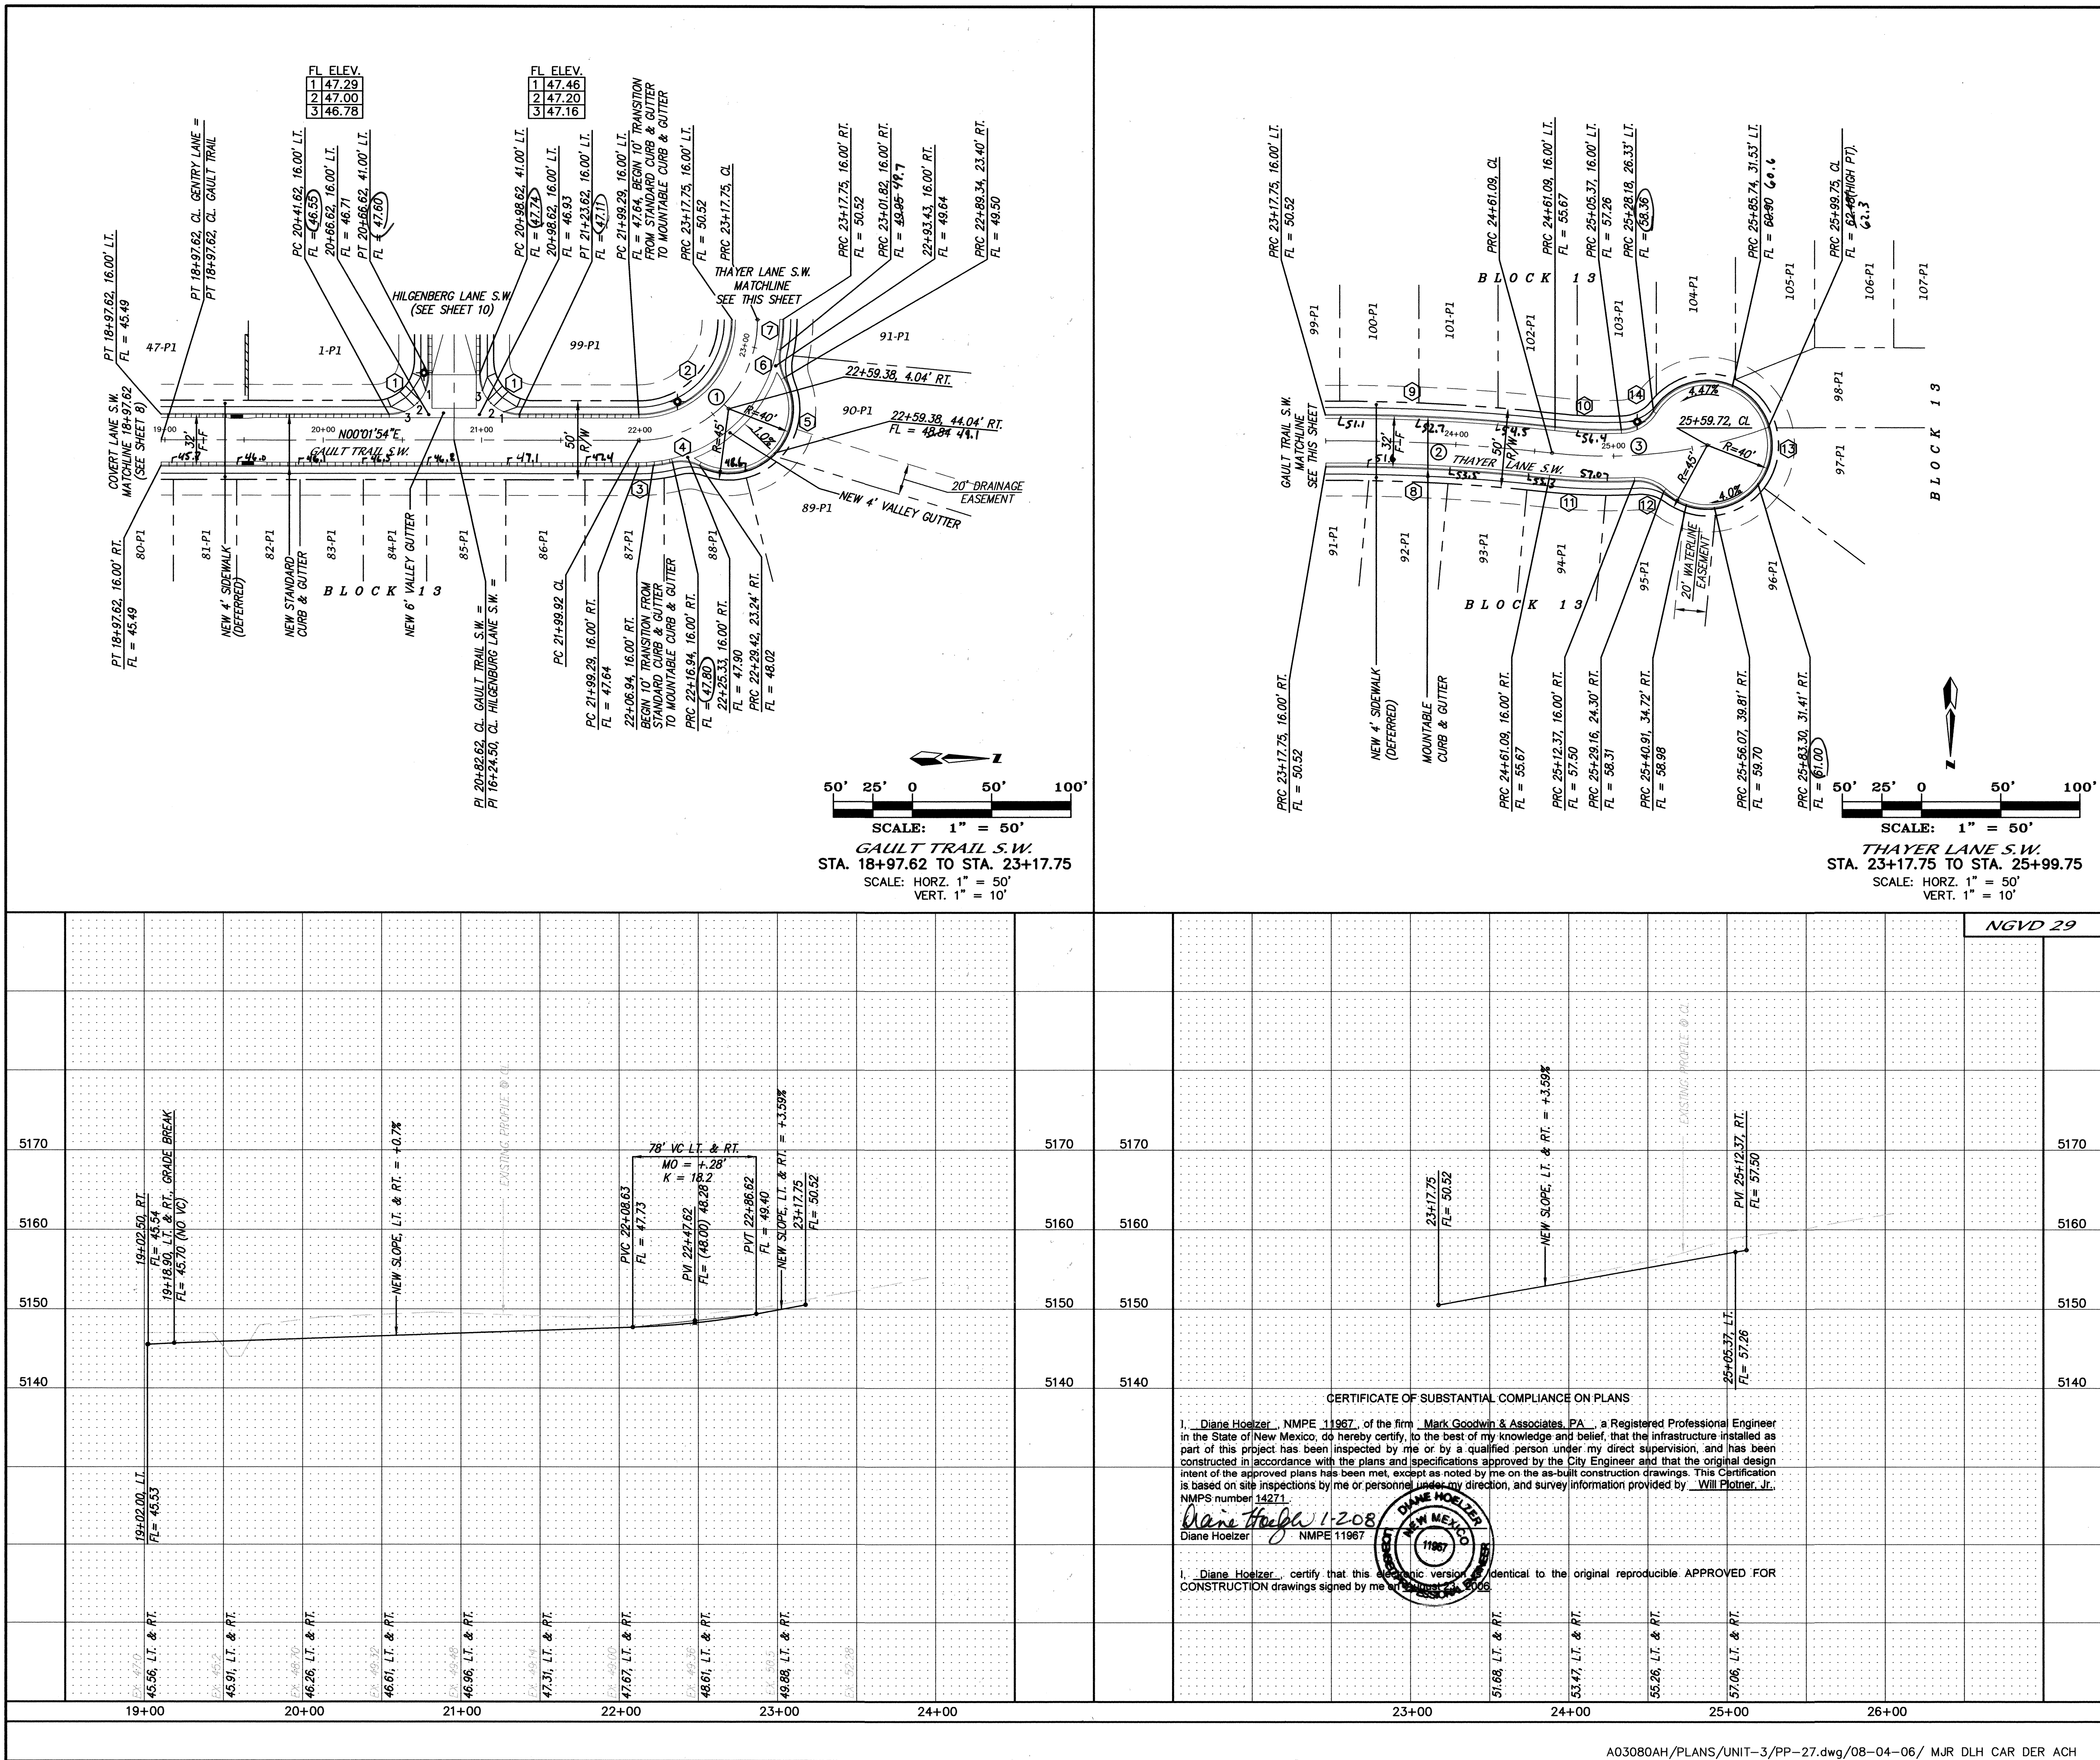

NOTES

- ALL STATIONING IS BASED ON ROAD CENTERLINE.

CURVE DATA - DESCRIBES CENTERLINE

Station	Δ	R	L	T
18+97.62	90°29'41"	75.00'	118.46'	75.65'
20+41.62	06°59'00"	1176.00'	143.34'	71.76'
21+99.29	18°50'19"	300.00'	98.64'	49.77'

CURVE DATA - DESCRIBES FACE OF NEW CURB

Station	Δ	R	L	T
18+97.62	90°00'00"	25.00'	39.27'	25.00'
20+41.62	90°29'41"	59.00'	93.19'	59.51'
21+99.29	13°28'46"	91.00'	21.41'	10.75'

CERTIFICATION

THE CHANGES SHOWN HEREON ARE BASED UPON A FIELD SURVEY CONDUCTED BY ME OR UNDER MY SUPERVISION AND REFLECT THE LOCATIONS (VERTICALLY AND HORIZONTALLY) TO THE BEST OF MY KNOWLEDGE AND BELIEF.

ENGINEER'S SEAL

CITY OF ALBUQUERQUE PUBLIC WORKS DEPARTMENT

TITLE: ANDERSON HEIGHTS - UNIT 3 GAULT TRAIL S.W. & THAYER LANE S.W. PAVING IMPROVEMENTS

DESIGN REVIEW COMMITTEE

CITY ENGINEER APPROVAL

NOV 21 2006

CITY ENGINEER

DESIGNED BY GJK

DRAWN BY MJR

CHECKED BY DMG

DATE 10/04

DATE 10/04

DATE 10/04

CITY PROJECT NO. 753986

ZONE MAP NO. N-8/P-8


SHEET 9 OF 18

CERTIFICATE OF SUBSTANTIAL COMPLIANCE ON PLANS


I, **Diane Hoelzer**, NMPE 11987, of the firm **Mark Goodwin & Associates, P.A.**, a Registered Professional Engineer in the State of New Mexico, do hereby certify, to the best of my knowledge and belief, that the infrastructure installed as part of this project has been inspected by me or by a qualified person under my direct supervision, and has been constructed in accordance with the plans and specifications approved by the City Engineer and that the original design intent of the approved plans has been met, except as noted by me on the as-built construction drawings. This Certification is based on site inspections by me or personnel under my direction, and survey information provided by **Will Plotner, Jr.**, NMPS number 14271.

Diane Hoelzer 11987

I, **Diane Hoelzer**, certify that this electronic version is identical to the original reproducible APPROVED FOR CONSTRUCTION drawings signed by me on **10/04/06**.

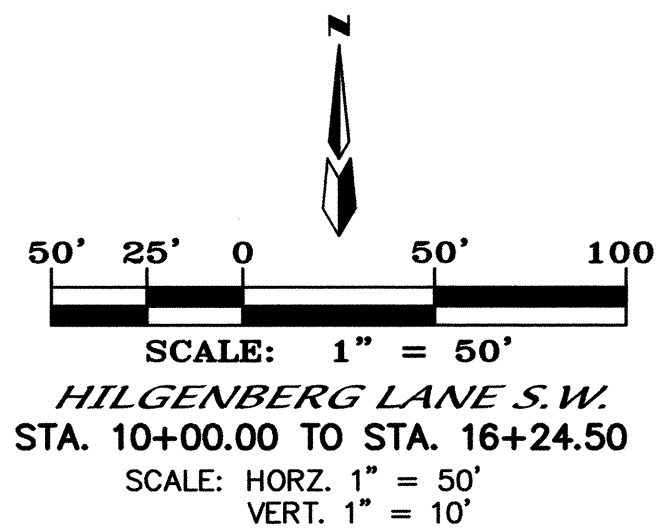

I, Diane Hoelzer, certify that this electronic version is identical to the original reproducible
APPROVED FOR CONSTRUCTION drawings signed by me on August 23, 2006.

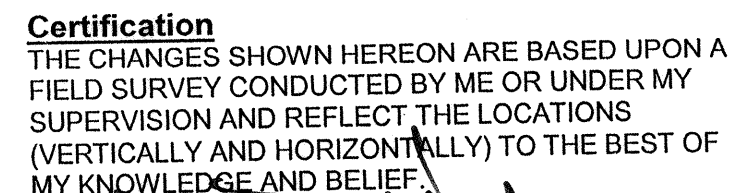



CITY ENGINEER APPROVAL
APPROVED
NOV 21 2006
CITY ENGINEER

SHEET OF

10

Professional Engineer Seal for Danie Hoelzer, New Mexico, License No. 11987, dated 11/1/98.

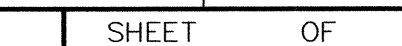

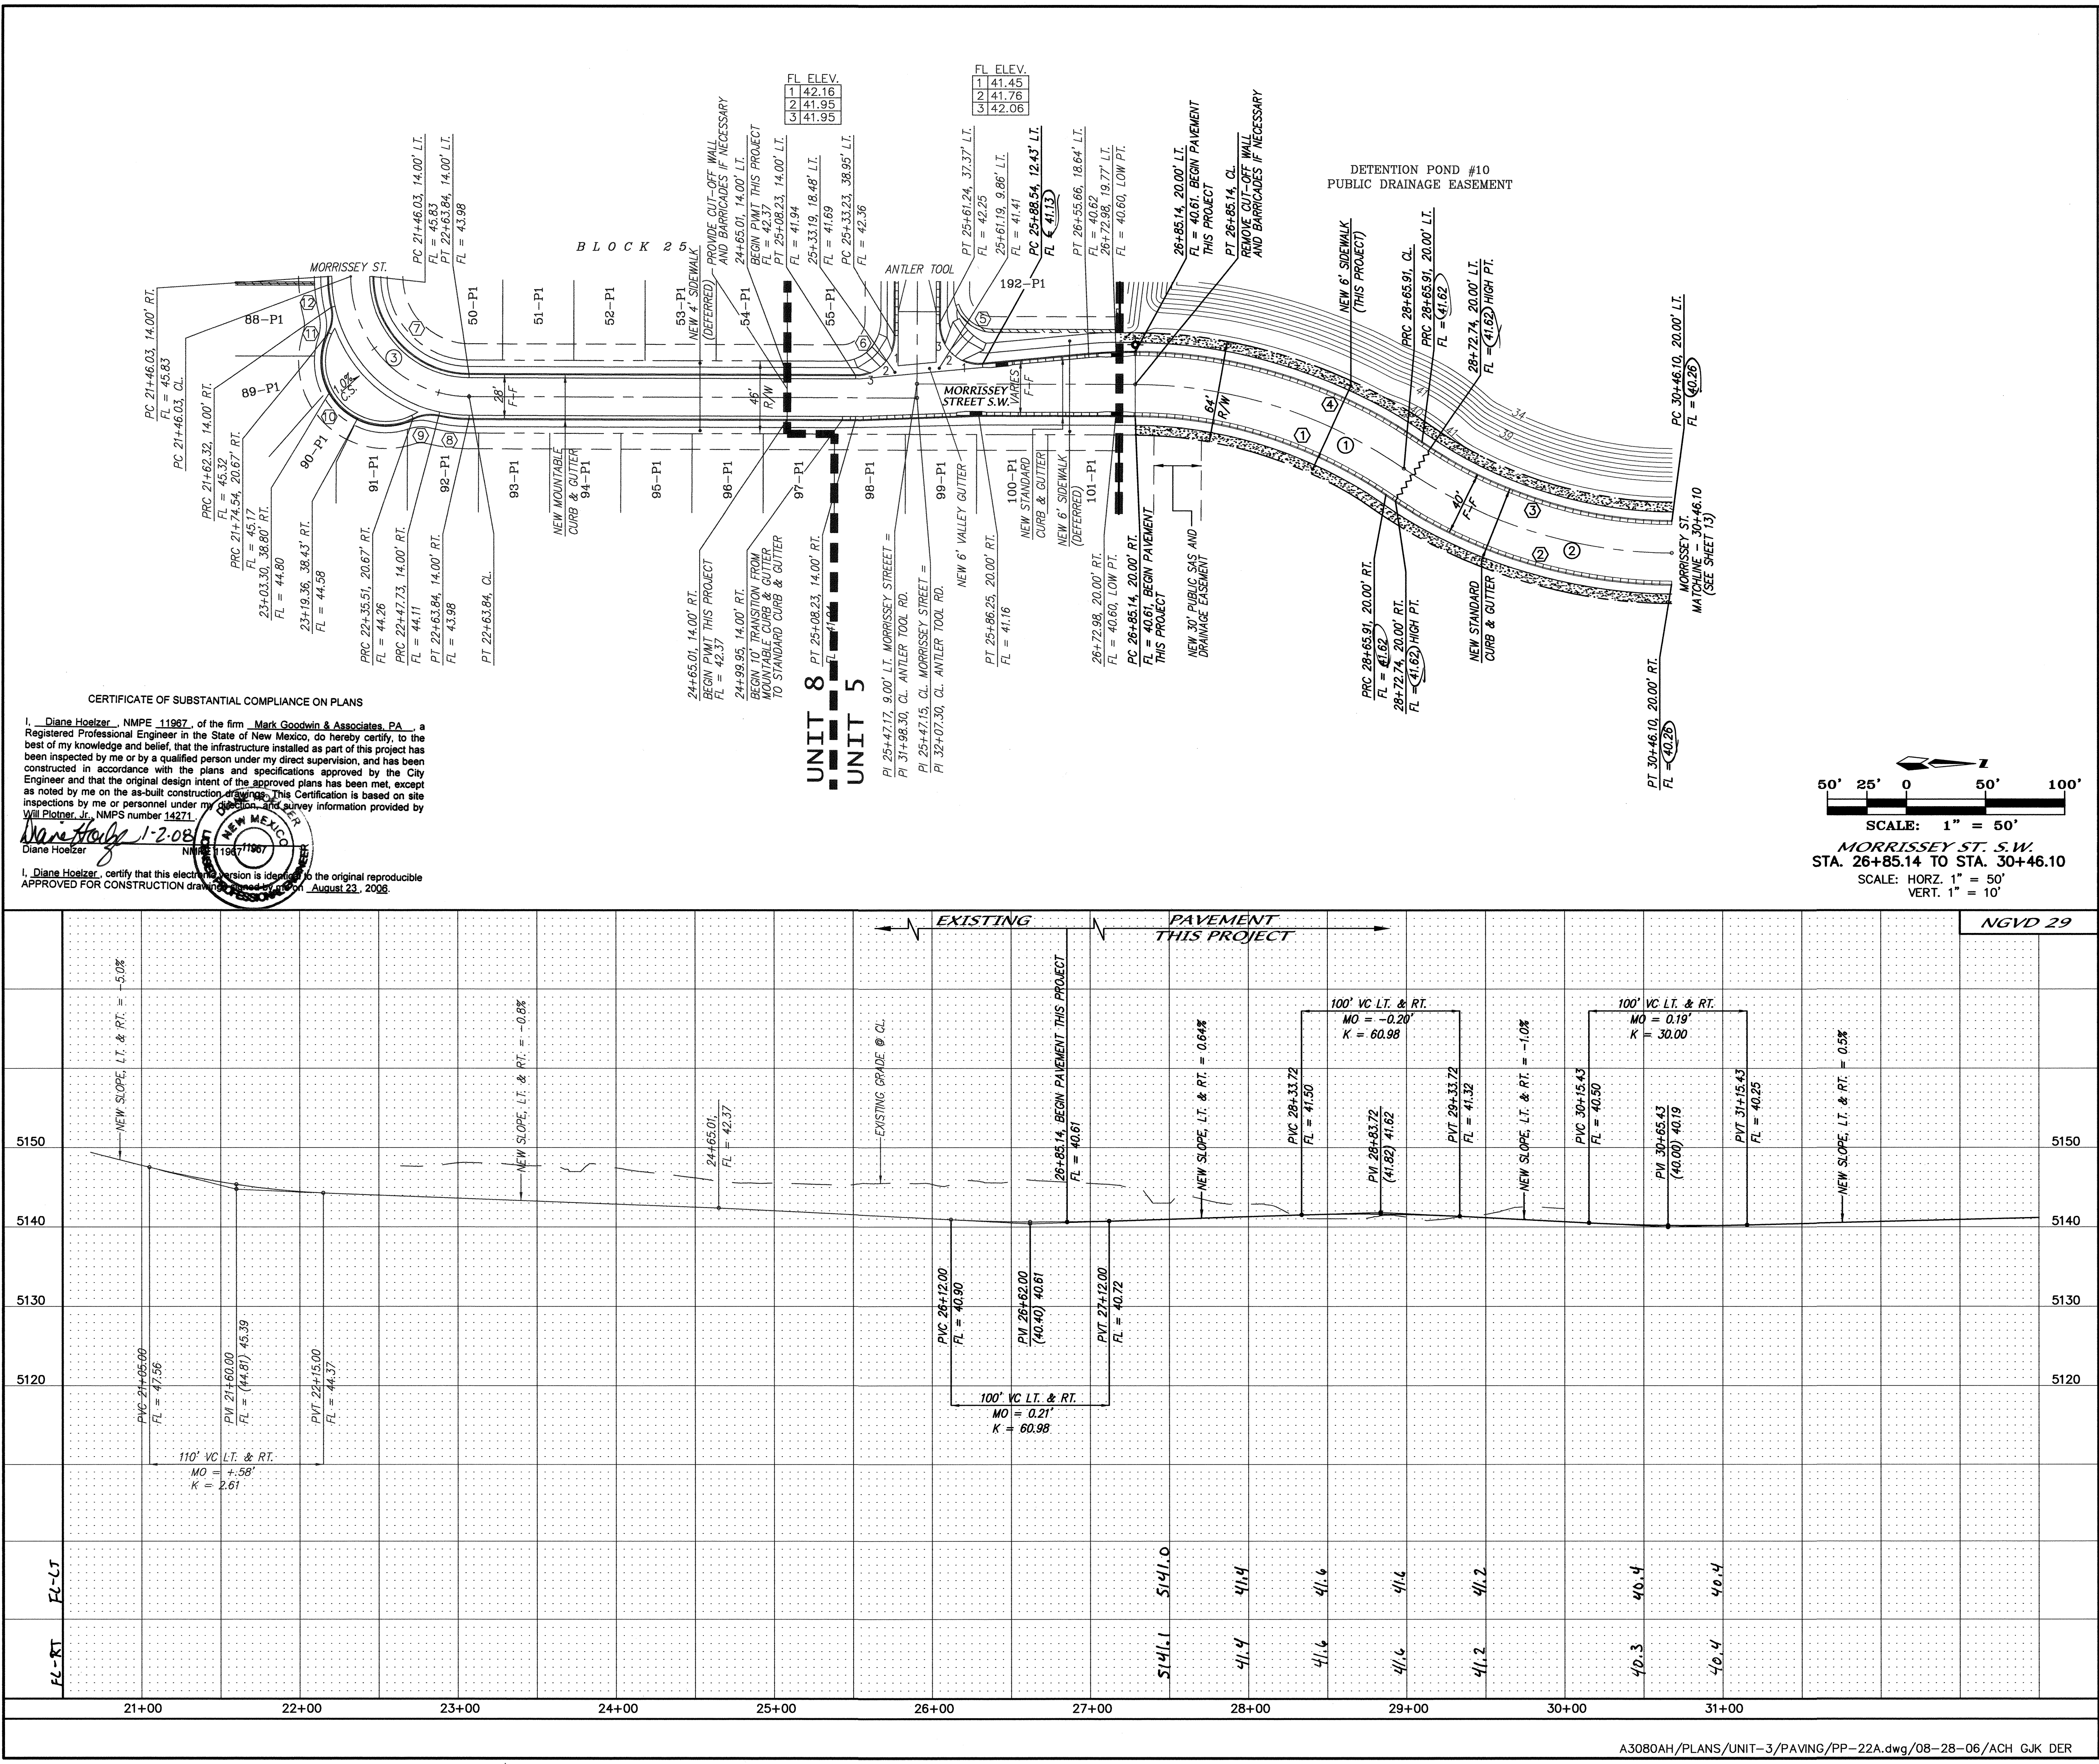

NOTES

1. ALL STATIONING IS BASED ON CENTERLINE OF MORRISSEY ST.

CURVE DATA - DESCRIBES FACE OF CURB

- | | | |
|---|--|--|
| ① $\Delta = 34^{\circ}31'28''$
$R = 280.00'$
$L = 168.72'$
$T = 87.01'$ | ② $\Delta = 34^{\circ}24'54''$
$R = 320.00'$
$L = 192.21'$
$T = 99.10'$ | ③ $\Delta = 34^{\circ}24'54''$
$R = 280.00'$
$L = 168.18'$
$T = 86.71'$ |
| ④ $\Delta = 39^{\circ}48'36''$
$R = 320.00'$
$L = 222.34'$
$T = 115.87'$ | ⑤ $\Delta = 95^{\circ}23'42''$
$R = 25.00'$
$L = 41.62'$
$T = 27.47'$ | ⑥ $\Delta = 89^{\circ}53'25''$
$R = 25.00'$
$L = 39.22'$
$T = 24.95'$ |
| ⑦ $\Delta = 90^{\circ}00'00''$
$R = 61.00'$
$L = 95.82'$
$T = 61.00'$ | ⑧ $\Delta = 12^{\circ}18'13''$
$R = 89.00'$
$L = 19.11'$
$T = 9.59'$ | ⑨ $\Delta = 38^{\circ}23'03''$
$R = 25.00'$
$L = 16.75'$
$T = 8.70'$ |
| ⑩ $\Delta = 142^{\circ}01'07''$
$R = 40.00'$
$L = 99.15'$
$T = 116.23'$ | ⑪ $\Delta = 38^{\circ}23'03''$
$R = 25.00'$
$L = 16.75'$
$T = 8.70'$ | ⑫ $\Delta = 12^{\circ}26'45''$
$R = 89.00'$
$L = 19.33'$
$T = 9.70'$ |

CURVE DATA - DESCRIBES CENTERLINE

- | | | |
|--|--|---|
| ① $\Delta = 34^{\circ}31'28''$
$R = 300.00'$
$L = 180.77'$
$T = 93.22'$ | ② $\Delta = 34^{\circ}24'54''$
$R = 300.00'$
$L = 180.20'$
$T = 92.91'$ | ③ $\Delta = 90^{\circ}00'00''$
$R = 75.00'$
$L = 117.81'$
$T = 75.00'$ |
|--|--|---|



SCALE: 1" = 50'
MORRISSEY ST. S.W.
STA. 26+85.14 TO STA. 30+46.10
SCALE: HORZ. 1" = 50'
VERT. 1" = 10'

CERTIFICATE OF SUBSTANTIAL COMPLIANCE ON PLANS
I, Diane Hoelzer, NMPE 11967, of the firm Mark Goodwin & Associates, P.A., a Registered Professional Engineer in the State of New Mexico, do hereby certify, to the best of my knowledge and belief, that the infrastructure installed as part of this project has been inspected by me or by a qualified person under my direct supervision, and has been constructed in accordance with the plans and specifications approved by the City Engineer and that the original design intent of the approved plans has been met, except as noted by me on the as-built construction drawings. This Certification is based on site inspections by me or personnel under my direction, and survey information provided by Will Plummer, Jr., NMPS number 14271.
Diane Hoelzer
1-2-08
N.M.P.E. 11967
I, Diane Hoelzer, certify that this electronic version is identical to the original reproducible APPROVED FOR CONSTRUCTION drawing of this project, August 23, 2006.

Certification
THE CHANGES SHOWN HEREON ARE BASED UPON A FIELD SURVEY CONDUCTED BY ME OR UNDER MY SUPERVISION AND REFLECT THE LOCATIONS (VERTICALLY AND HORIZONTALLY) TO THE BEST OF MY KNOWLEDGE AND BELIEF.
Wm Plummer Jr.

dmg MARK GOODWIN & ASSOCIATES, P.A.
CONSULTING ENGINEERS
P.O. BOX 90606
ALBUQUERQUE, NEW MEXICO 87199
(505) 828-2200, FAX (505) 797-9539

CITY OF ALBUQUERQUE
PUBLIC WORKS DEPARTMENT


TITLE: ANDERSON HEIGHTS - UNIT 3
MORRISSEY STREET S.W.
PAVING IMPROVEMENTS

DESIGN REVIEW COMMITTEE
APPROVED
AUG 31 2006
DESIGN REVIEW COMMITTEE

CITY ENGINEER APPROVAL
APPROVED
NOV 21 2006
CITY ENGINEER

MO./DAY/YR.
MO./DAY/YR.
LAST DESIGN UPDATE

CITY PROJECT NO. 753986 ZONE MAP NO. N-8/P-8 SHEET 12 OF 18

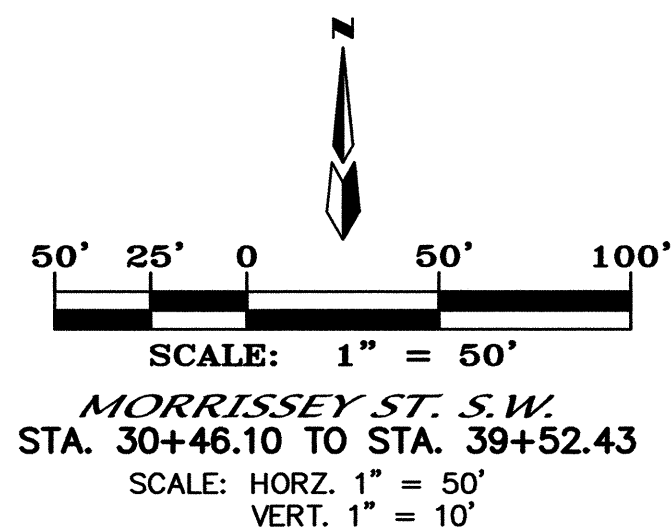

CERTIFICATE OF SUBSTANTIAL COMPLIANCE ON PLANS

I, Diane Hoelzer, NMPE 11967, of the firm Mark Goodwin & Associates, PA, a registered Professional Engineer in the State of New Mexico, do hereby certify, to the best of my knowledge and belief, that the infrastructure installed as part of this project has been inspected by me or by a qualified person under my direct supervision, and has been constructed in accordance with the plans and specifications approved by the City Engineer and that the original design intent of the approved plans has been met, except as noted by me on the as-built construction drawings. The Certification is based on site inspections by me or persons that I have authorized to inspect. Any other information provided by Will Plotter, Jr., NMPS number 14271

Diane Hoelzer 11-2-06

Diane Hoelzer NMPE 11967

I, Diane Hoelzer, certify that this electronic version is identical to the original reproducible **APPROVED FOR CONSTRUCTION** drawings and was signed on August 23, 2006.

Certification
THE CHANGES SHOWN HEREON ARE BASED UPON A
FIELD SURVEY CONDUCTED BY ME OR UNDER MY
SUPERVISION AND REFLECT THE LOCATIONS
(VERTICALLY AND HORIZONTALLY) TO THE BEST OF
MY KNOWLEDGE AND BELIEF.

Wm. J. Kelly

dmg MARK GOODWIN & ASSOCIATES, P.A.
CONSULTING ENGINEERS
P.O. BOX 90606
ALBUQUERQUE, NEW MEXICO 87199
(505) 828-2200, FAX (505) 797-9539



**ANDERSON HEIGHTS - UNIT 3
MORRISSEY ST. S.W.
PAVING IMPROVEMENTS**

DESIGN REVIEW COMMITTEE

APPROVED

AUG 31 2006

DESIGN
REVIEW COMMITTEE

CITY ENGINEER APPROVAL
APPROVED
NOV 21 2006
CITY ENGINEER

LAST DESIGN UPDATE	MO./DAY/YR.	MO./DAY/YR.

CITY PROJECT NO.

ZONE MAP NO.

SHEET	OF
-------	----

753986


N-8/P-8



13 18

[illegible]

A circular library stamp from the University of New Mexico. The outer ring contains the text "UNIVERSITY OF NEW MEXICO" at the top and "DANE HOELZER" at the bottom. The inner circle contains the year "1967". Handwritten in black ink over the stamp is "H-2-2-8" in a large, stylized font, and "H-2-2-8" in a smaller font below it.

REVISIONS		
DESIGN		
DESIGNED BY	<i>G/K</i>	DATE <i>06/04</i>
DRAWN BY	<i>ACH</i>	DATE <i>06/04</i>
CHECKED BY	<i>DMG</i>	DATE <i>06/04</i>

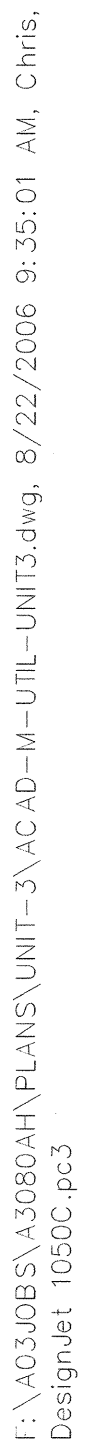

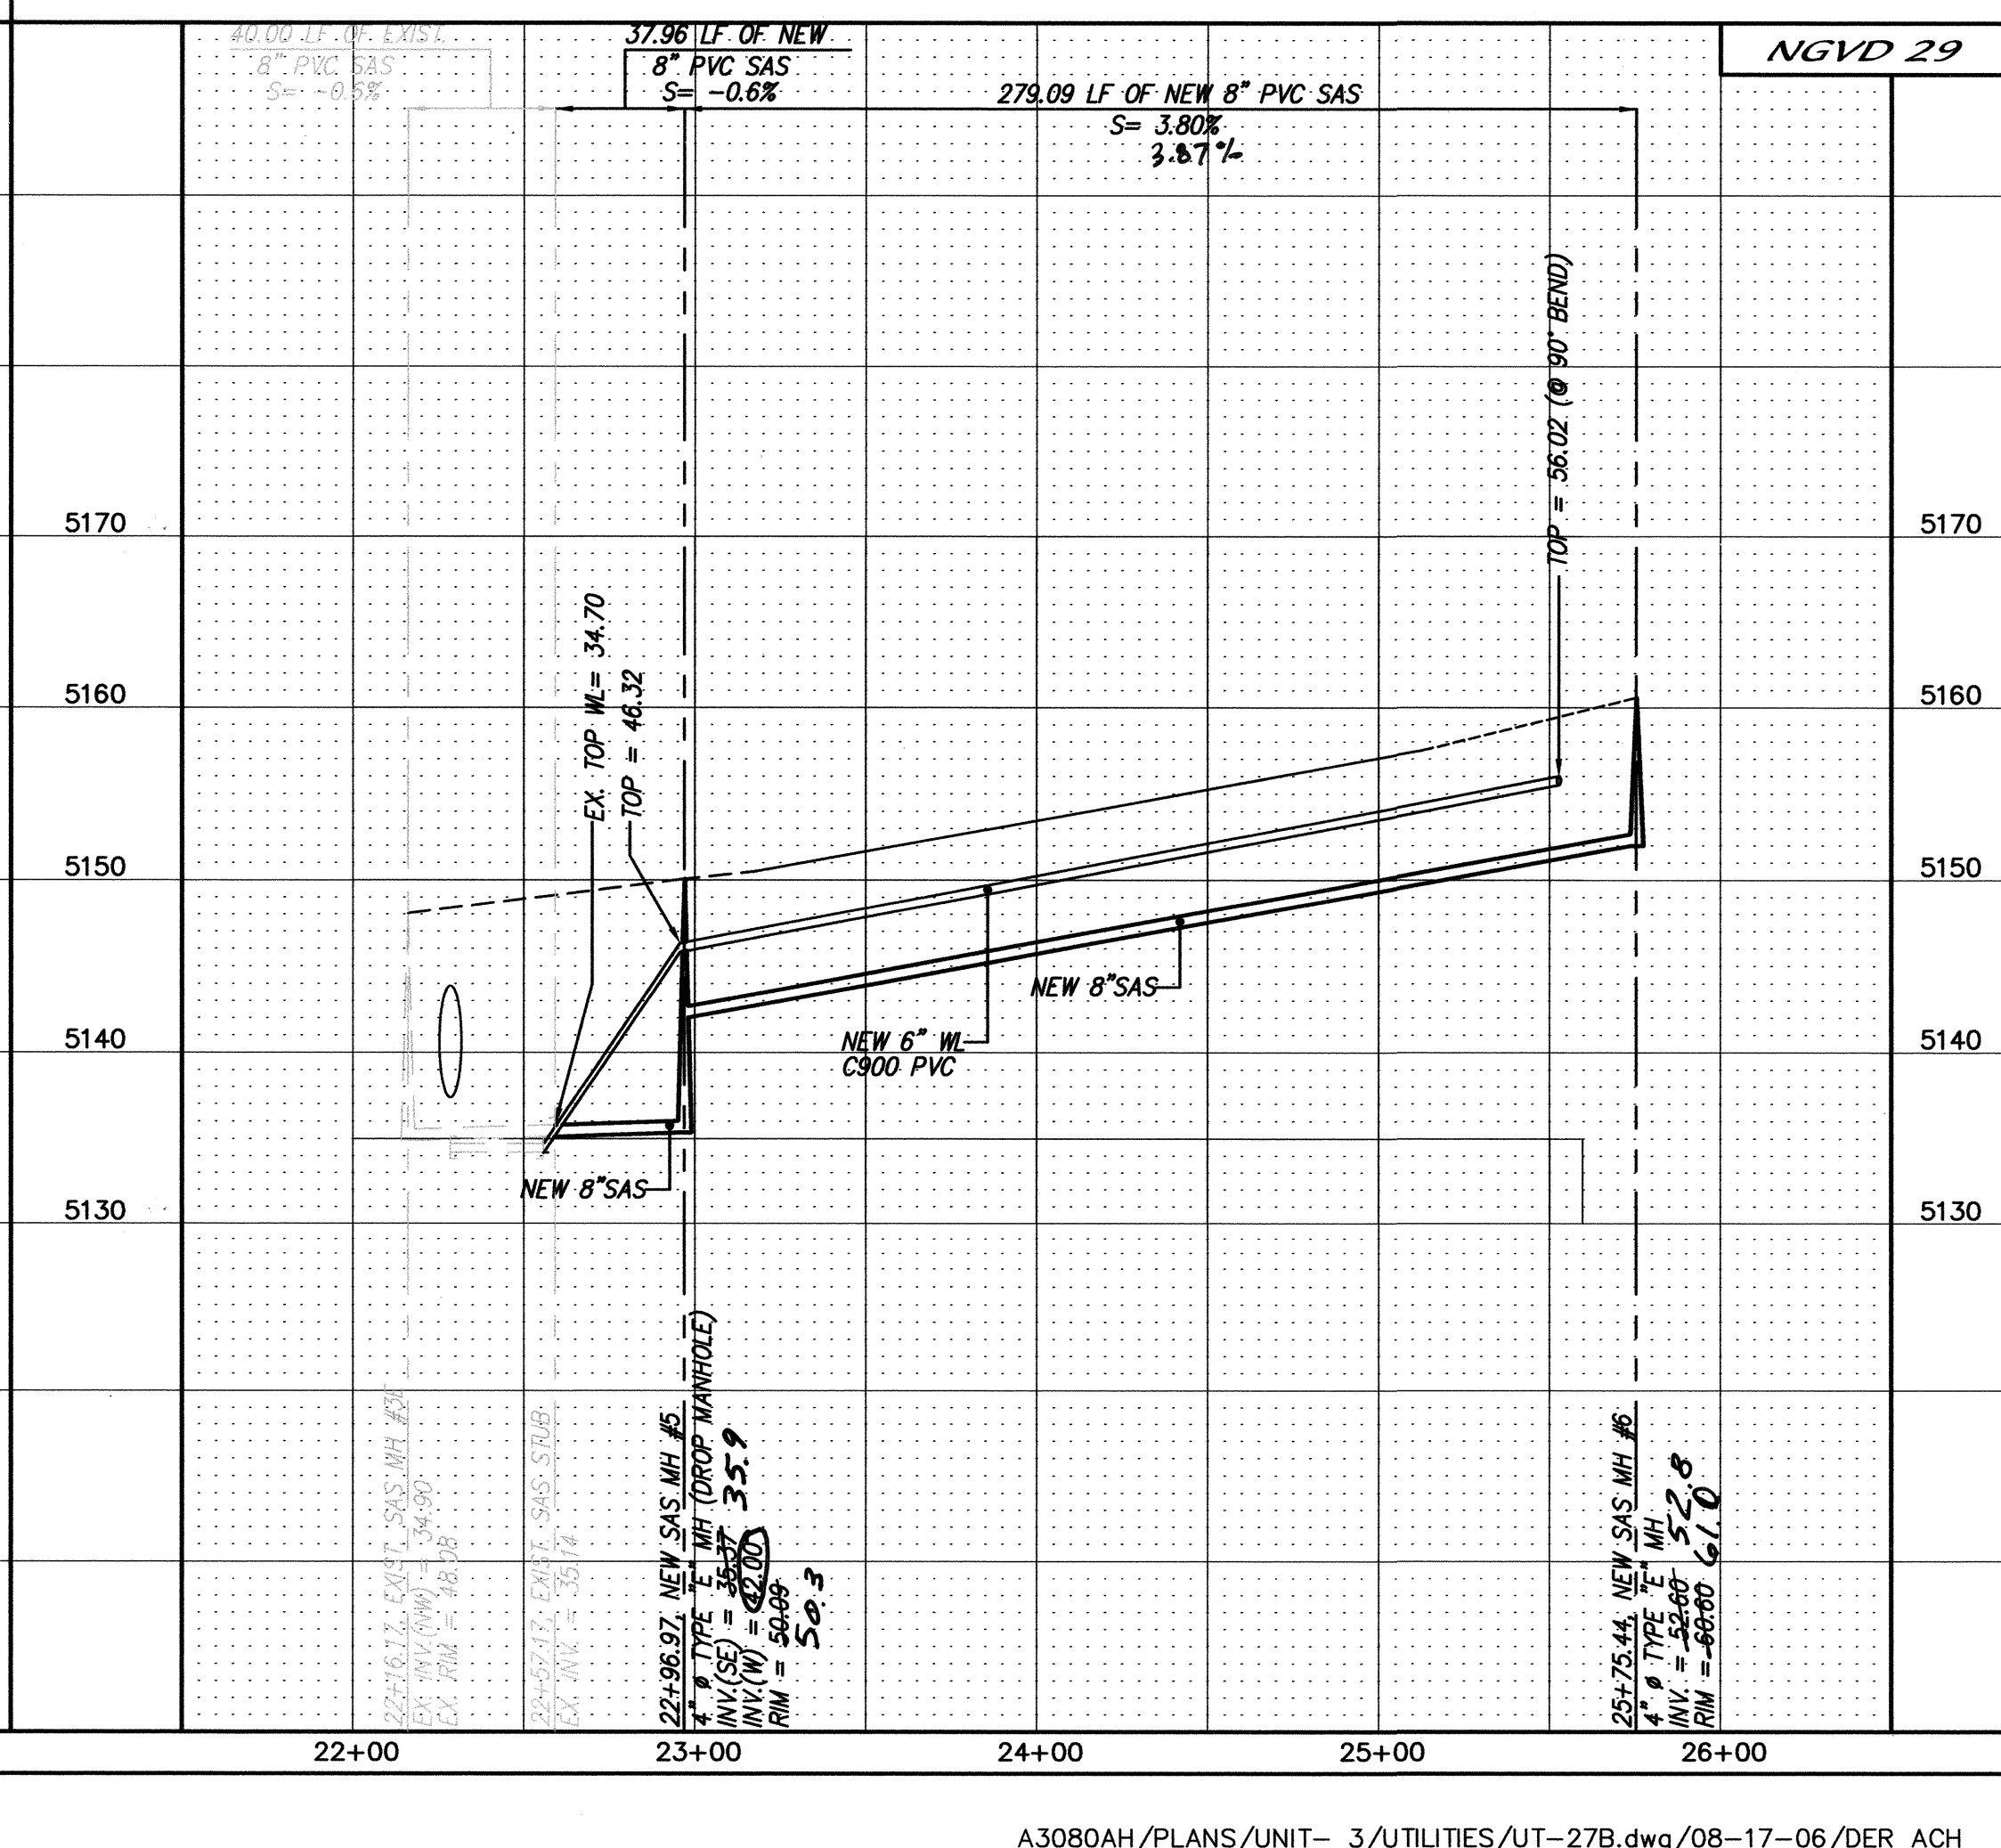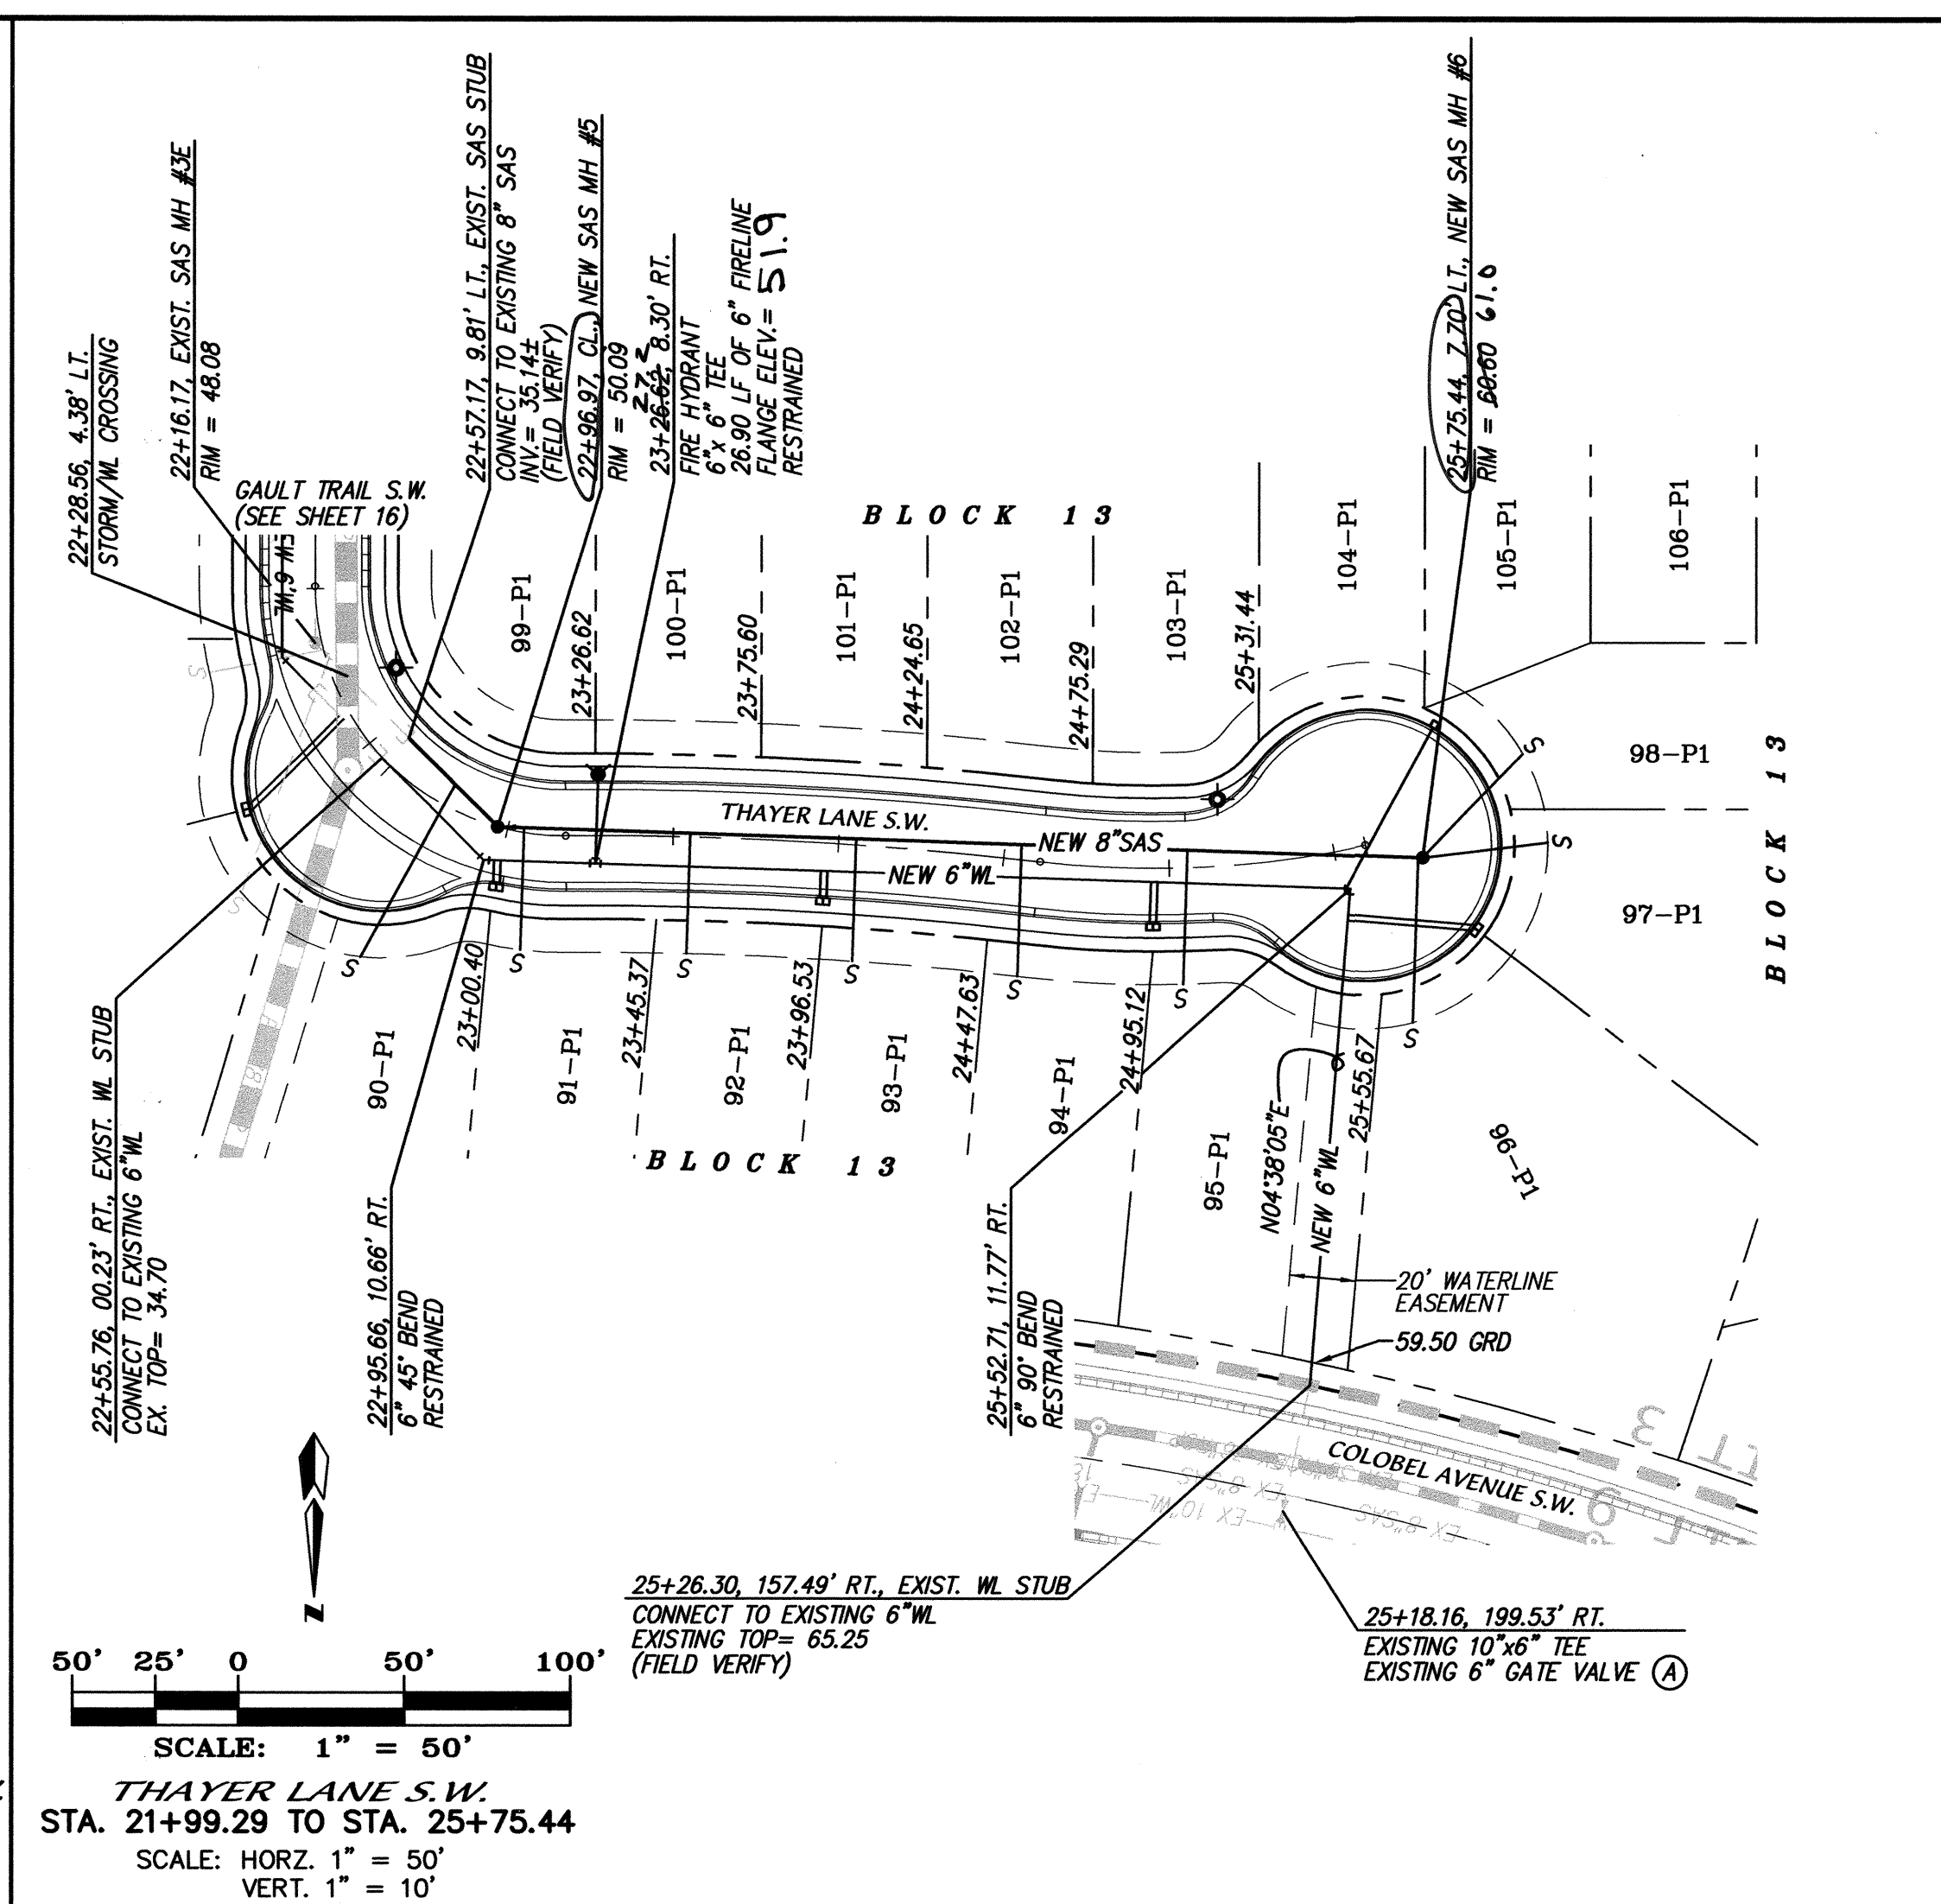

1. ALL STATIONING IS BASED ON COVERT & THAYER CENTERLINE
2. ALL STORM DRAIN PIPE LENGTHS ARE BASED ON CENTERLINE OF MANHOLES.

Certification
THE CHANGES SHOWN HEREON ARE BASED UPON A
FIELD SURVEY CONDUCTED BY ME OR UNDER MY
SUPERVISION AND REFLECT THE LOCATIONS
(VERTICALLY AND HORIZONTALLY) TO THE BEST OF
MY KNOWLEDGE AND BELIEF.

Will Flesher 7/10/11

SANITARY SEWER SERVICES				
BLOCK	LOT	STATION AT PUE	INV. ELEV. AT PUE	LENGTH AT PUE
13	70-P1	15+38.08	53.06	35.03'
13	71-P1	15+79.35	50.99	35.00'
13	72-P1	16+19.35	48.98	35.00'
13	73-P1	16+59.35	47.17	35.00'
13	74-P1	16+99.35	45.48	35.00'
13	75-P1	17+39.35	43.80	35.00'
13	76-P1	17+79.35	42.15	35.00'
13	77-P1	18+05.69	41.32	41.00'
13	90-P1	22+79.42	44.65	59.29'
13	91-P1	23+08.14	45.32	36.67'
13	92-P1	23+54.91	46.85	36.12'
13	93-P1	24+06.50	48.70	36.79'
13	94-P1	24+58.04	50.55	39.65'
13	95-P1	25+03.30	52.17	40.42'
13	96-P1	25+61.93	54.94	49.52'
13	97-P1	26+11.23	54.93	37.97'
13	98-P1	26+14.56	55.54	43.57'
21	36-P1	14+40.20	56.53	33.12'
21	37-P1	14+64.13	56.10	50.17'
21	38-P1	14+83.89	55.53	61.73'
21	39-P1	14+95.76	54.97	59.04'
21	40-P1	15+27.42	53.59	33.35'
21	41-P1	15+61.27	51.90	35.00'
21	42-P1	16+01.27	49.89	35.00'
21	43-P1	16+41.27	47.83	35.00'
21	44-P1	16+81.27	46.24	35.00'
21	45-P1	17+21.27	44.56	35.00'
21	46-P1	17+61.27	42.88	35.00'
21	47-P1	17+82.54	42.03	35.00'

RESTRAINED JOINT LENGTH FOR BENDS, VALVES, DEAD ENDS (FT.)					
PIPE SIZE	90°	45°	22.5°	11.25°	VALVE
6"	17'	7'	—	—	46"
10"	—	11'	5'	3'	72"

LENGTH OF RESTRAINED PIPE ON EACH SIDE OF THE BEND. RESTRAIN BRANCH AT FITTING ONLY MINIMUM ATTACHED PIPE LENGTH, RUN SIDE OF TEE: 10.00 FEET.

RESTRAINED JOINT LENGTHS FOR REDUCERS (FT.)		
PIPE SIZE	LARGE SIDE	SMALL SIDE
10" X 6"	44'	—

RESTRAINED JOINT LENGTH FOR TEES (FT.)		
PIPE SIZE	RUN	BRANCH
10"x10"x10"	15'	5'
10"x10"x6"	6'	1'
6"x6"x6"	10'	2'

dmg MARK GOODWIN & ASSOCIATES, P.A.
CONSULTING ENGINEERS
P.O. BOX 90606
ALBUQUERQUE, NEW MEXICO 87199
(505) 828-2200, FAX (505) 797-9531



CITY OF ALBUQUERQUE
PUBLIC WORKS DEPARTMENT

TITLE: *ANDERSON HEIGHTS UNIT 3
PAYTON TRAIL, COVERT LANE & THAYER LANE S.W.
UTILITY IMPROVEMENTS*



DESIGN REVIEW COMMITTEE
APPROVED
AUG 31 2006
DESIGN REVIEW COMMITTEE

CITY ENGINEER APPROVAL

APPROVE

NOV 21 2006

CITY ENGINEER

LAST DESIGN UPDATE	MO./DAY/YR.	MO./DAY/YR.

CITY PROJECT NO.	ZONE MAP NO.	SHEET	OF
753986	N-8/P-8	15	18

SURVEY INFORMATION	BENCH MARKS	AS BUILT INFORMATION
NO.	DATE BY FIELD NOTES	CONTRACTOR WORKED BY DATE INSPECTOR'S SIGNATURE DATE FIELD ACCEPTANCE BY VERIFICATION & Christian Surveys Inc. DATE CORRECTED BY MICRO-FILM INFORMATION
	STATION "3-P10" IS LOCATED 59 MI SW OF DOWNTOWN ALBUQUERQUE TO REACH STATION FROM INT. OF COOPS AND DENNIS CHAVEZ BLVD. (FORMERLY RIO BRAVO), GO S. ON COOPS BLVD., 0.62 MI. TO THE STATION WHICH IS ON AN EARTHEN BEAM 182.2' WEST OF THE CENTERLINE OF COOPS BLVD. THE STATION IS A STANDARD ACS 3 1/4" ALUMINUM CAP LIMITED TO A PIPE 0.25' ABOVE THE GROUND AND IS STAMPED "3"-P10, 1988".	RECORDED BY NO.
X=80723.56, Y=1462437.46 (NAD 27)	ELEV=4935.735 (SLD 29)	

ENGINEER'S SEAL


DIANE HOELZER
NEW MEXICO
1967
LICENSED PROFESSIONAL ENGINEER
8-23-06

NO.		DATE	REMARKS	BY
<i>REVIEWS</i>				
<i>DESIGN</i>				
DESIGNED BY	<i>DLH</i>		DATE	<i>03/06</i>
DRAWN BY	<i>DER</i>		DATE	<i>03/06</i>

UNIT 3	
THAYER LANE S.W.	
MENTS	
MO./DAY/YR.	MO./DAY/YR.
O.	SHEET OF
2-8	15 18

SCANNED BY
PLANNING

CERTIFICATE OF SUBSTANTIAL COMPLIANCE ON PLANS
I, Diane Hoelzer, NMPE 11967, of the firm Mark Goodwin & Associates, P.A., a Registered Professional Engineer in the State of New Mexico, do hereby certify, to the best of my knowledge and belief, that the infrastructure installed as part of this project has been inspected by me or by a qualified person under my direct supervision, and has been constructed in accordance with the plans and specifications approved by the City Engineer and that the original design intent of the approved plans has been met, except as noted by me on the as-built construction drawings. Certification is based on site inspections by me or personnel under my direction and survey information provided by Will Platter, Jr., NMPS number 14277.
Diane Hoelzer
August 23, 2006

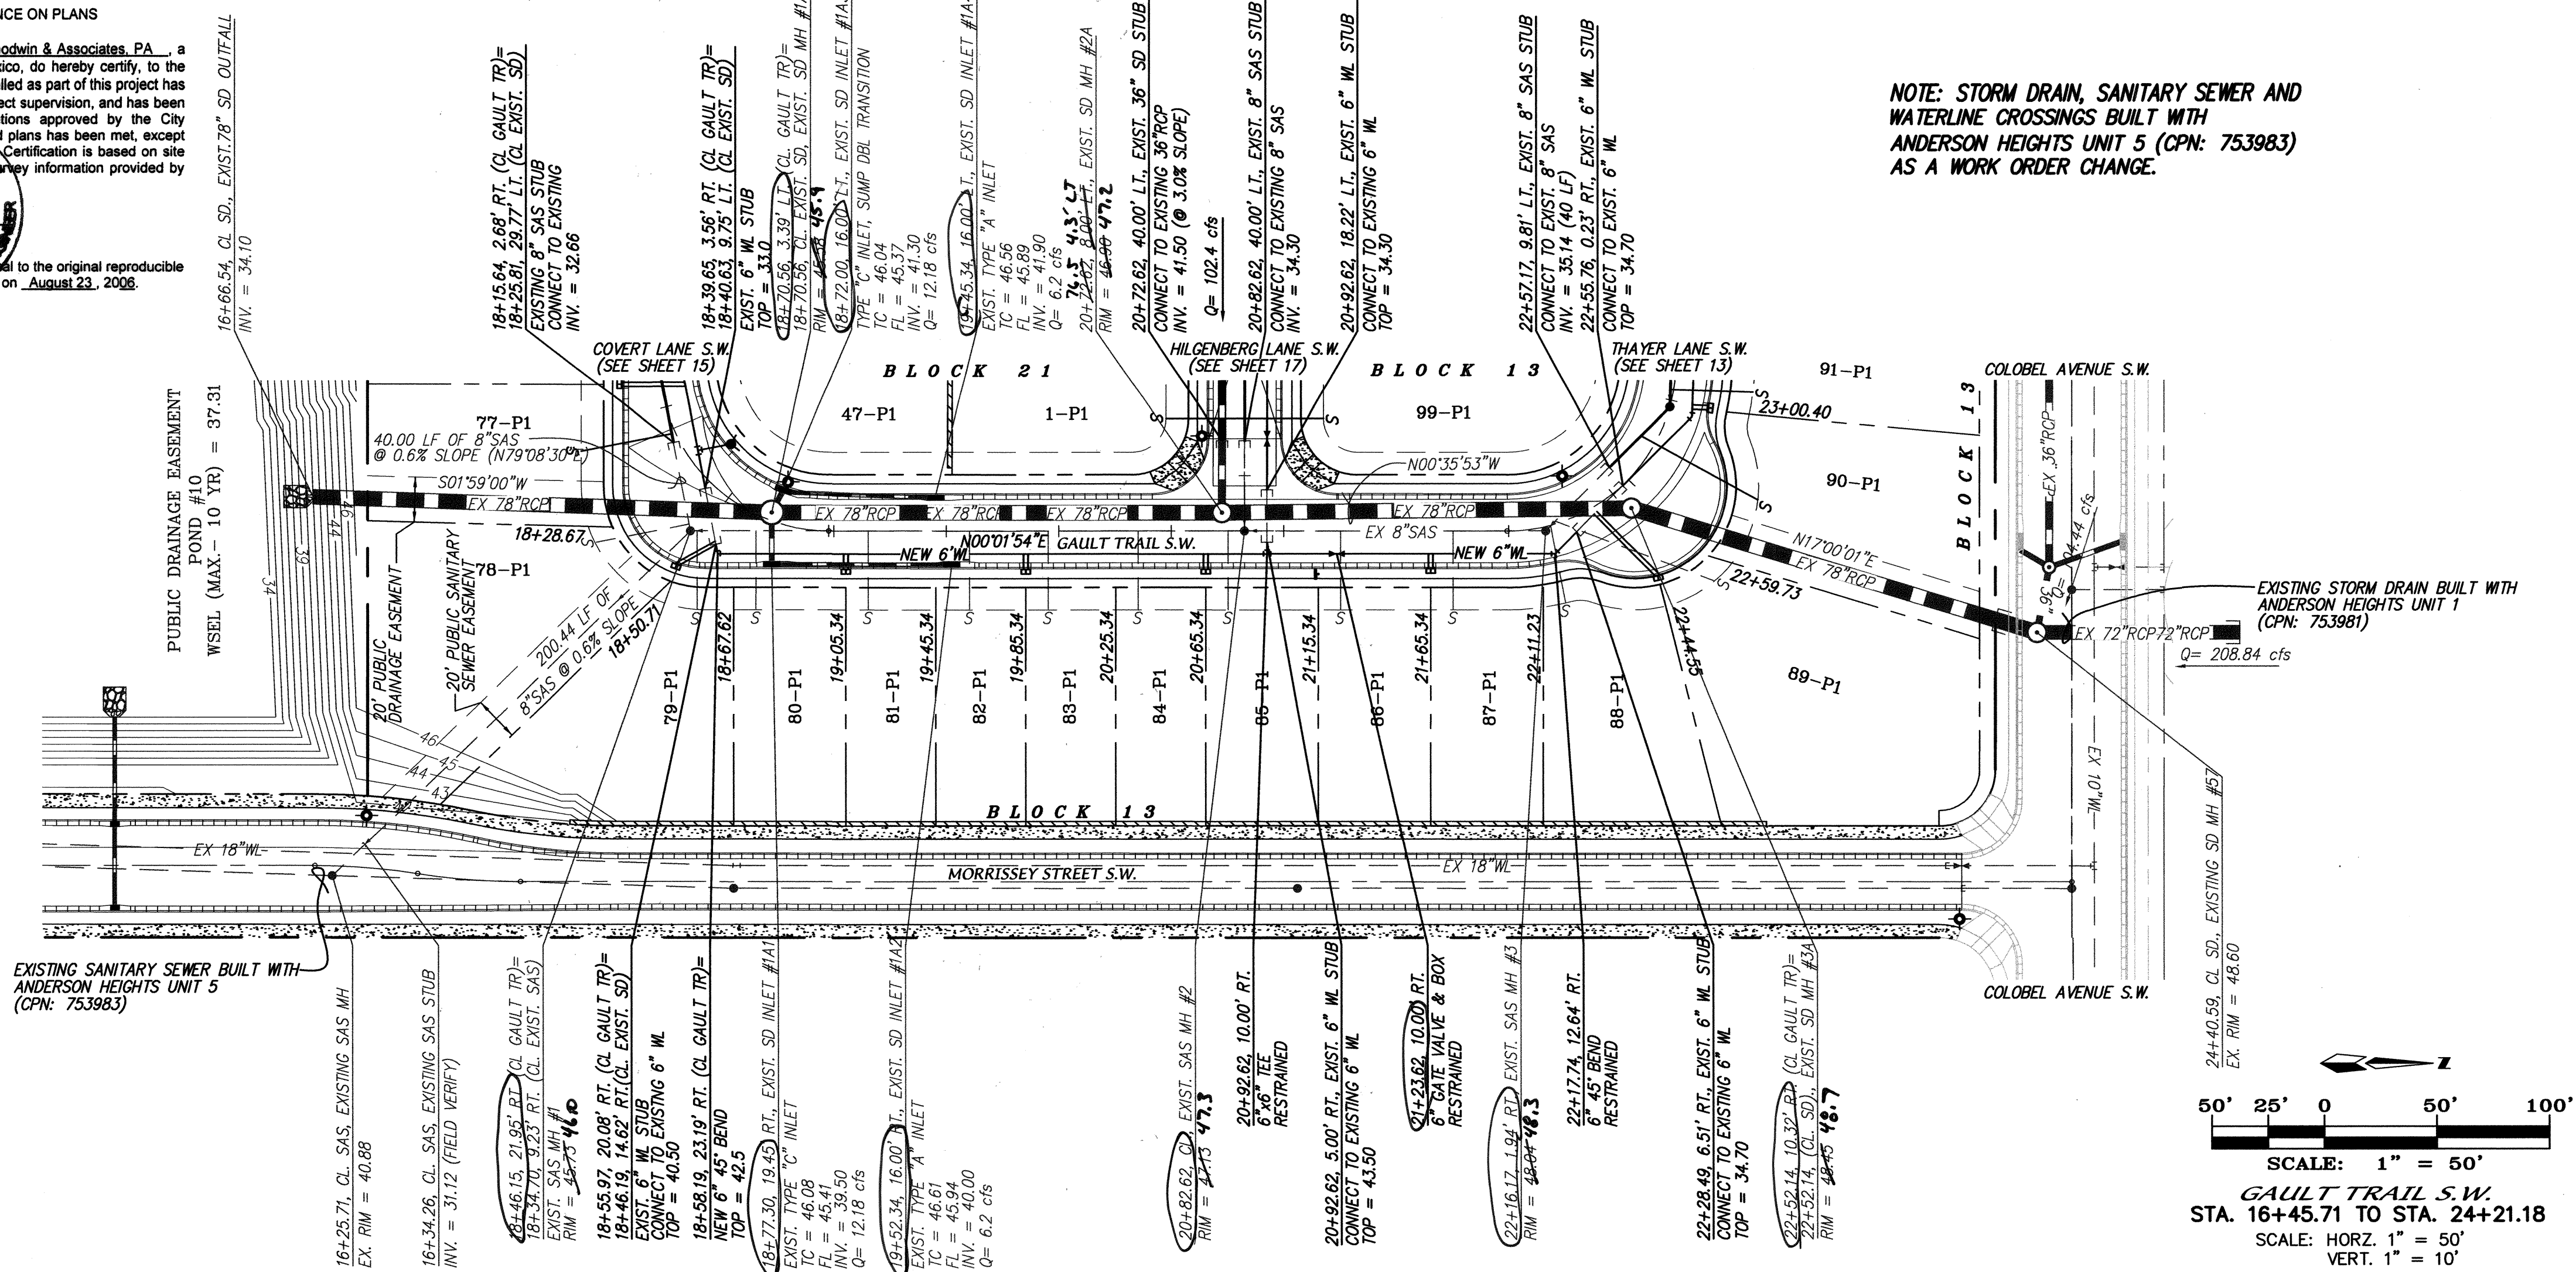


SCANNED BY
PLANNING

CERTIFICATE OF SUBSTANTIAL COMPLIANCE ON PLANS

I, Diane Hoelzer, NMPE 11967, of the firm Mark Goodwin & Associates, P.A., a Registered Professional Engineer in the State of New Mexico, do hereby certify, to the best of my knowledge and belief, that the infrastructure installed as part of this project has been inspected by me or by a qualified person under my direct supervision, and has been constructed in accordance with the plans and specifications approved by the City Engineer and that the original design intent of the approved plans has been met, except as noted by me on the as-built construction drawings. Certification is based on site inspections by me or personnel under my direct supervision and the information provided by Will Plotner, Jr., NMPS number 14271.


Diane Hoelzer
NMPE 11967

I, Diane Hoelzer, certify that this electronic signature is identical to the original reproducible approved for construction drawing signed on August 23, 2008.

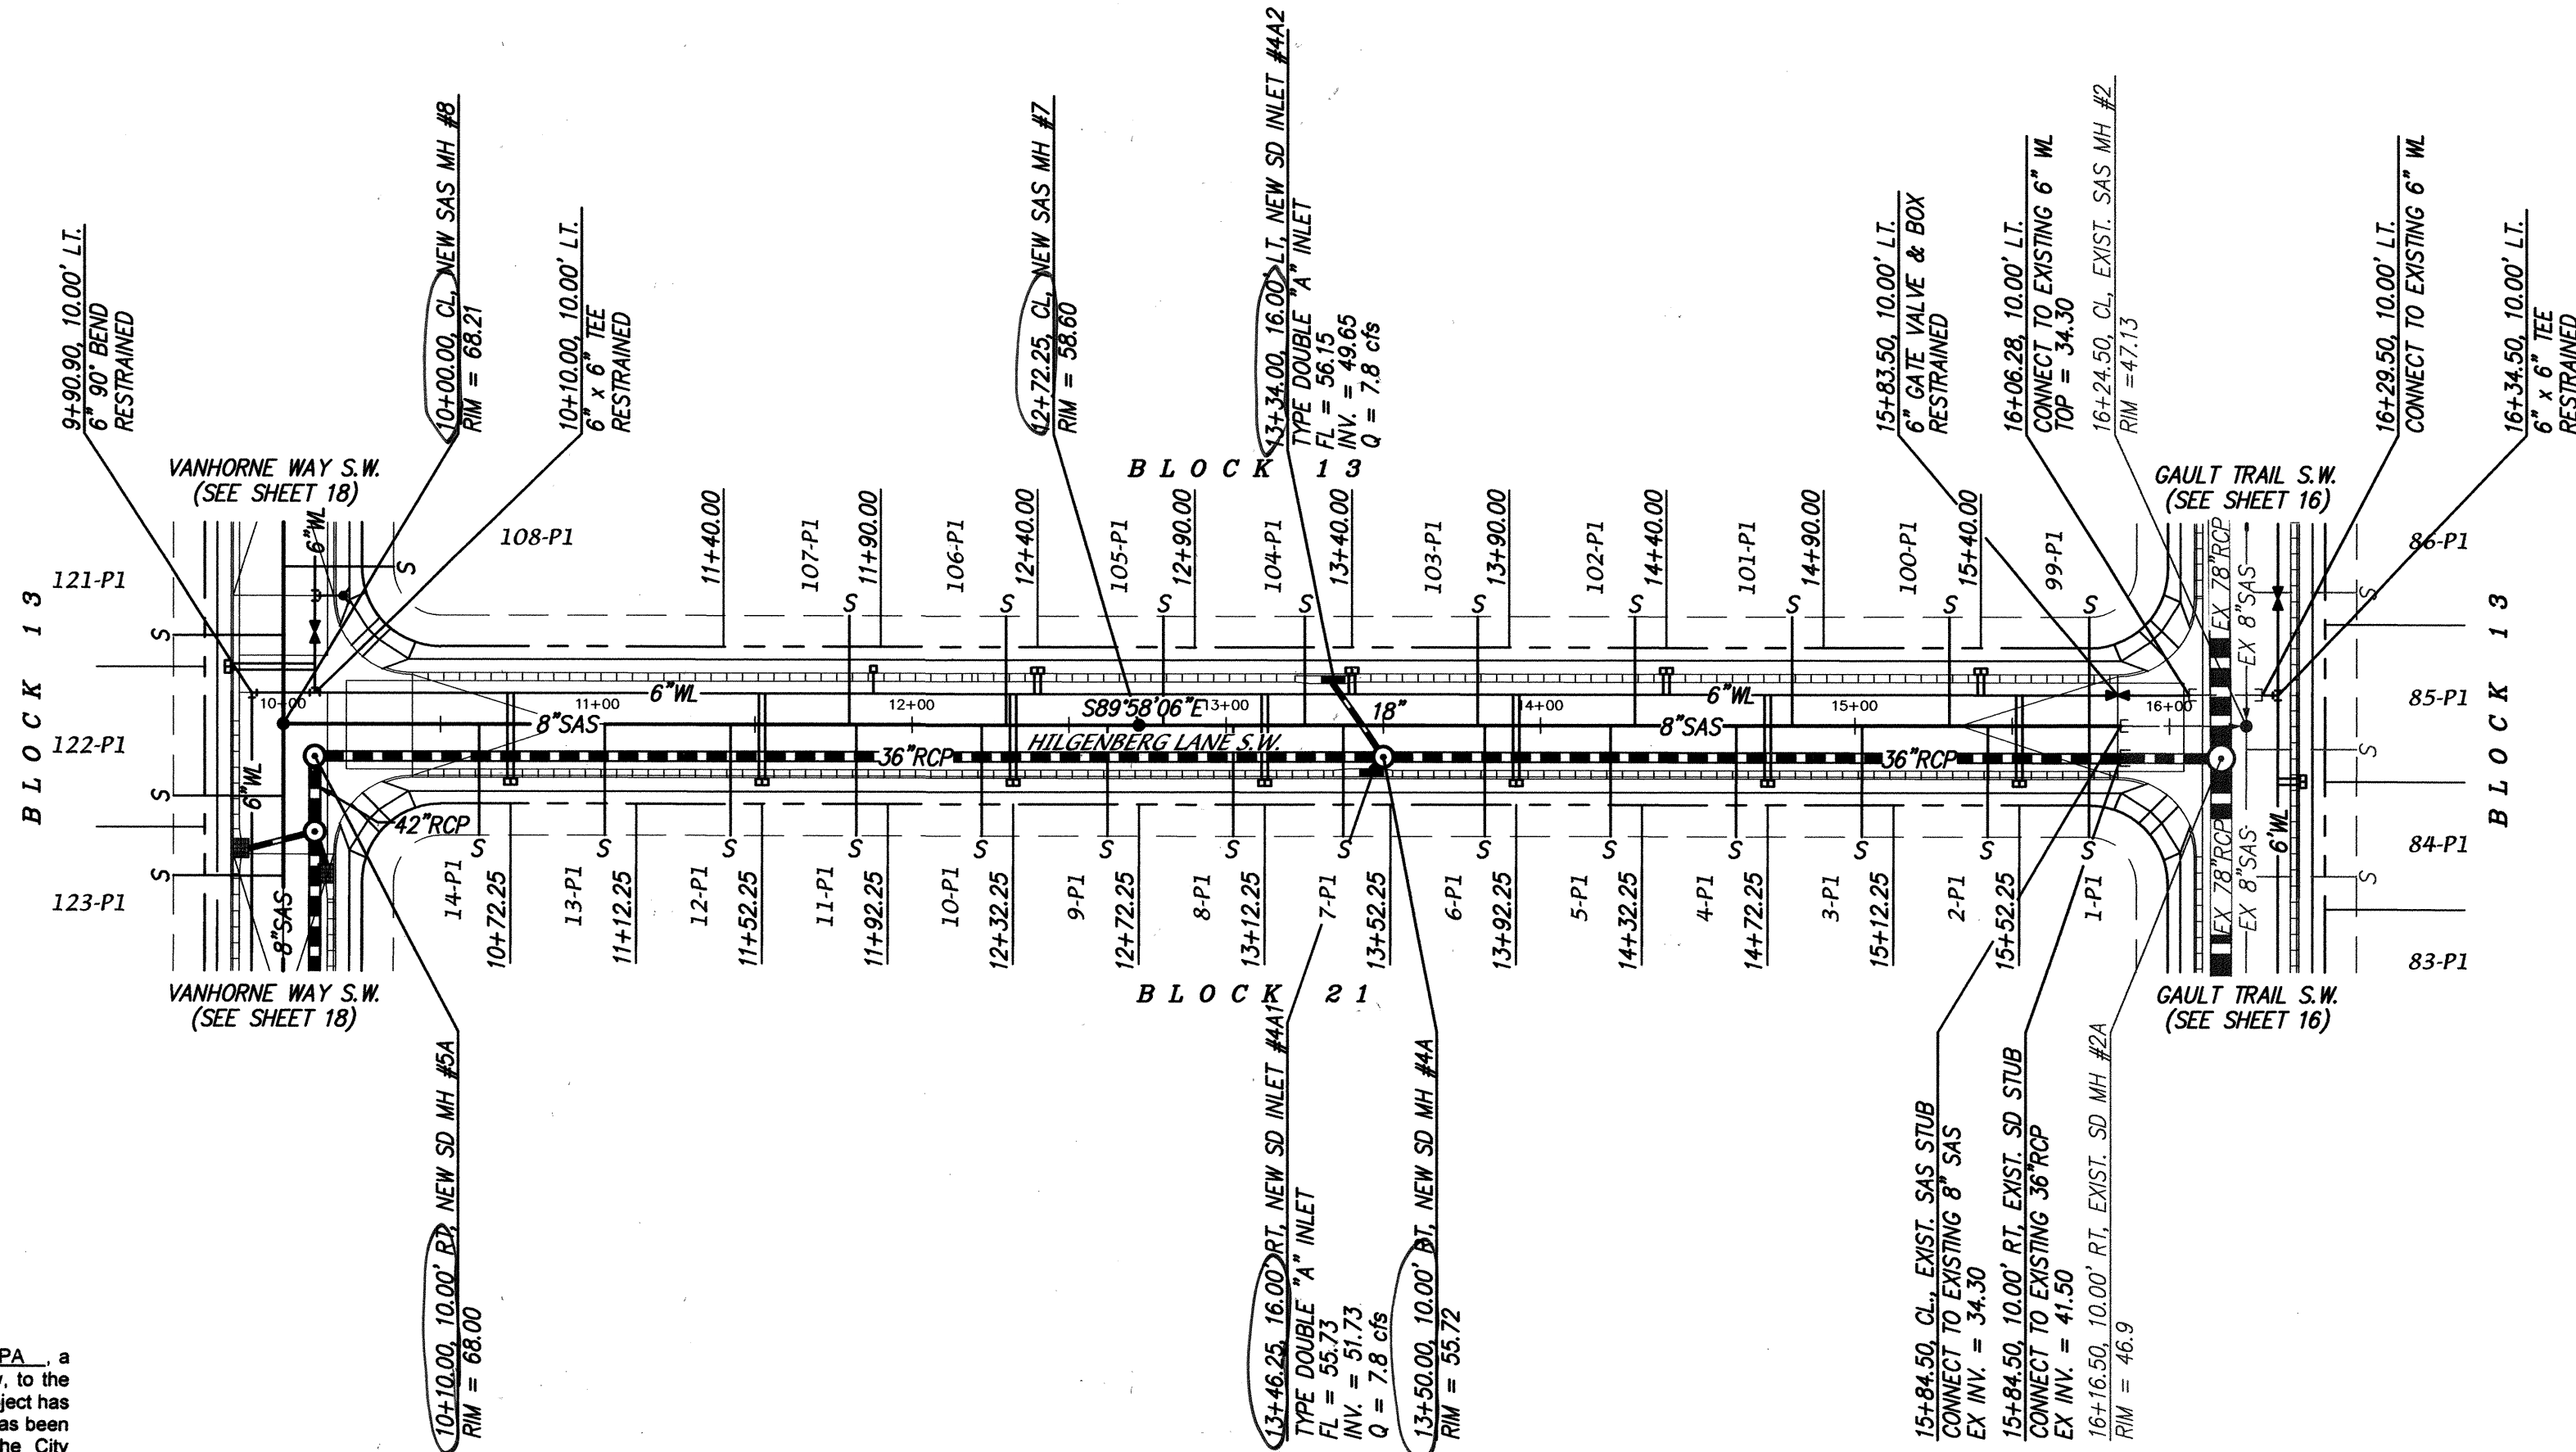

Certification
THE CHANGES SHOWN HEREON ARE BASED UPON A FIELD SURVEY CONDUCTED BY ME OR UNDER MY SUPERVISION AND REFLECT THE LOCATIONS (VERTICALLY AND HORIZONTALLY) TO THE BEST OF MY KNOWLEDGE AND BELIEF.

Will Plotner

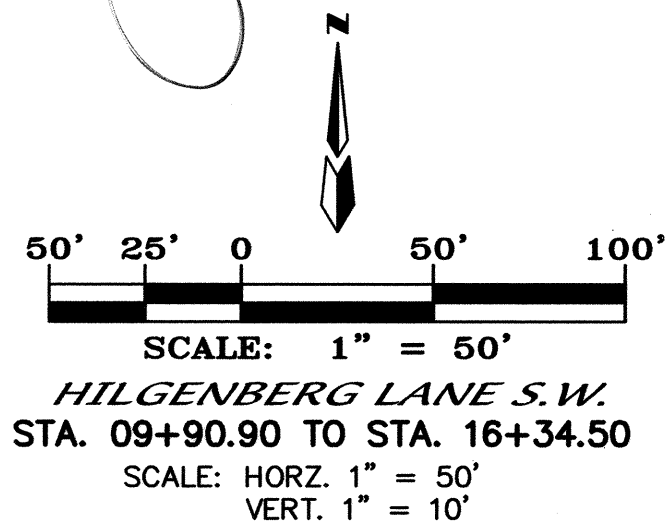

NOTES

1. ALL STATIONING IS CENTERLINE STATIONING BASED ON HILGENBERG LANE CENTERLINE.

STORM DRAIN SUMMARY TABLE					
LOCATION	Q100	VELOCITY	UPSTREAM	DOWNSTREAM	
UPSTRM	DNSTRM	(cfs)	(fps)	GRD	HGL
MH#4A	MH#2A	102.4	14.5	55.72	51.98
MH#5A	MH#4A	86.8	12.3-17.6	68.00	62.63

SANITARY SEWER SERVICES					
BLOCK	LOT	STATION AT PUE	INV. ELEV. AT PUE	LENGTH AT PUE	
13	99-P1	15+74.50	42.88	35.00'	
13	100-P1	15+30.00	44.41	35.00'	
13	101-P1	14+80.00	46.13	35.00'	
13	102-P1	14+30.00	47.85	35.00'	
13	103-P1	13+80.00	49.57	35.00'	
13	104-P1	13+25.00	51.46	35.00'	
13	105-P1	12+80.00	53.01	35.00'	
13	106-P1	12+30.00	54.73	35.00'	
13	107-P1	11+80.00	56.51	35.00'	
21	1-P1	15+74.50	42.88	35.00'	
21	2-P1	15+42.25	43.99	35.00'	
21	3-P1	15+02.25	45.37	35.00'	
21	4-P1	14+62.25	46.74	35.00'	
21	5-P1	14+22.25	48.12	35.00'	
21	6-P1	13+82.25	49.49	35.00'	
21	7-P1	13+37.25	51.04	35.00'	
21	8-P1	13+02.25	52.25	35.00'	
21	9-P1	12+62.25	53.62	35.00'	
21	10-P1	12+22.25	55.00	35.00'	
21	11-P1	11+82.25	56.42	35.00'	
21	12-P1	11+42.25	58.02	35.00'	
21	13-P1	11+02.25	59.62	35.00'	
21	14-P1	10+62.25	61.15	35.00'	

RESTRAINED JOINT LENGTH FOR BENDS, VALVES, DEAD ENDS (FT.)					
PIPE SIZE	90°	45°	22.5°	11.25°	VALVE
6"	17'	7'	-	-	46'

LENGTH OF RESTRAINED PIPE ON EACH SIDE OF THE BEND. RESTRAIN BRANCH AT FITTING ONLY MINIMUM ATTACHED PIPE LENGTH, RUN SIDE OF TEE: 10.00 FEET.

RESTRAINED JOINT LENGTH FOR TEES (FT.)		
PIPE SIZE	RUN	BRANCH
6"x6"x6"	10'	2'

dmg MARK GOODWIN & ASSOCIATES, P.A.
CONSULTING ENGINEERS
P.O. BOX 90606
ALBUQUERQUE, NEW MEXICO 87199
(505) 828-2200, FAX (505) 797-9539

**CITY OF ALBUQUERQUE
PUBLIC WORKS DEPARTMENT**

TITLE: **ANDERSON HEIGHTS - UNIT 3
HILGENBERG LANE S.W.
UTILITY IMPROVEMENTS**

DESIGN REVIEW COMMITTEE
APPROVED
AUG 31 2008
DESIGN REVIEW COMMITTEE

CITY ENGINEER APPROVAL
APPROVED
NOV 21 2008
CITY ENGINEER

CITY PROJECT NO.

ZONE MAP NO.

SHEET OF

753986

N-8/P-8


17 18

SCANNED BY
PLANNING

PIPE SIZE	90°	45°	22.5°	11.25°	VALVE
18"	37'	15'	7'	4'	132'
4"	12'	5'	2'	1'	32'
12"	30'	12'	6'	3'	85'
LENGTH OF RESTRAINED PIPE ON EACH SIDE OF THE BEND.					

I, Diane Hoeltzer, MPPE 11967, of the firm Mark Goodwin & Associates, PA, a Registered Professional Engineer in the State of New Mexico, do hereby certify, to the best of my knowledge and belief, that the infrastructure installed as part of this project has been inspected by me or by a qualified person under my direct supervision, and has been constructed in accordance with the plans and specifications approved by the City Engineers, and that the original design intent of the approved plans has been maintained, except as noted, and that the civil construction drawings. This Certification is based on site inspections by me or personnel under my direction and survey information provided by Will Plotner, Jr., NPIS number 14271.

I, Diane Hoelzer, certify that this electronic version is identical to the original reproducible
APPROVED FOR CONSTRUCTION drawings signed by me on August 23, 2006.

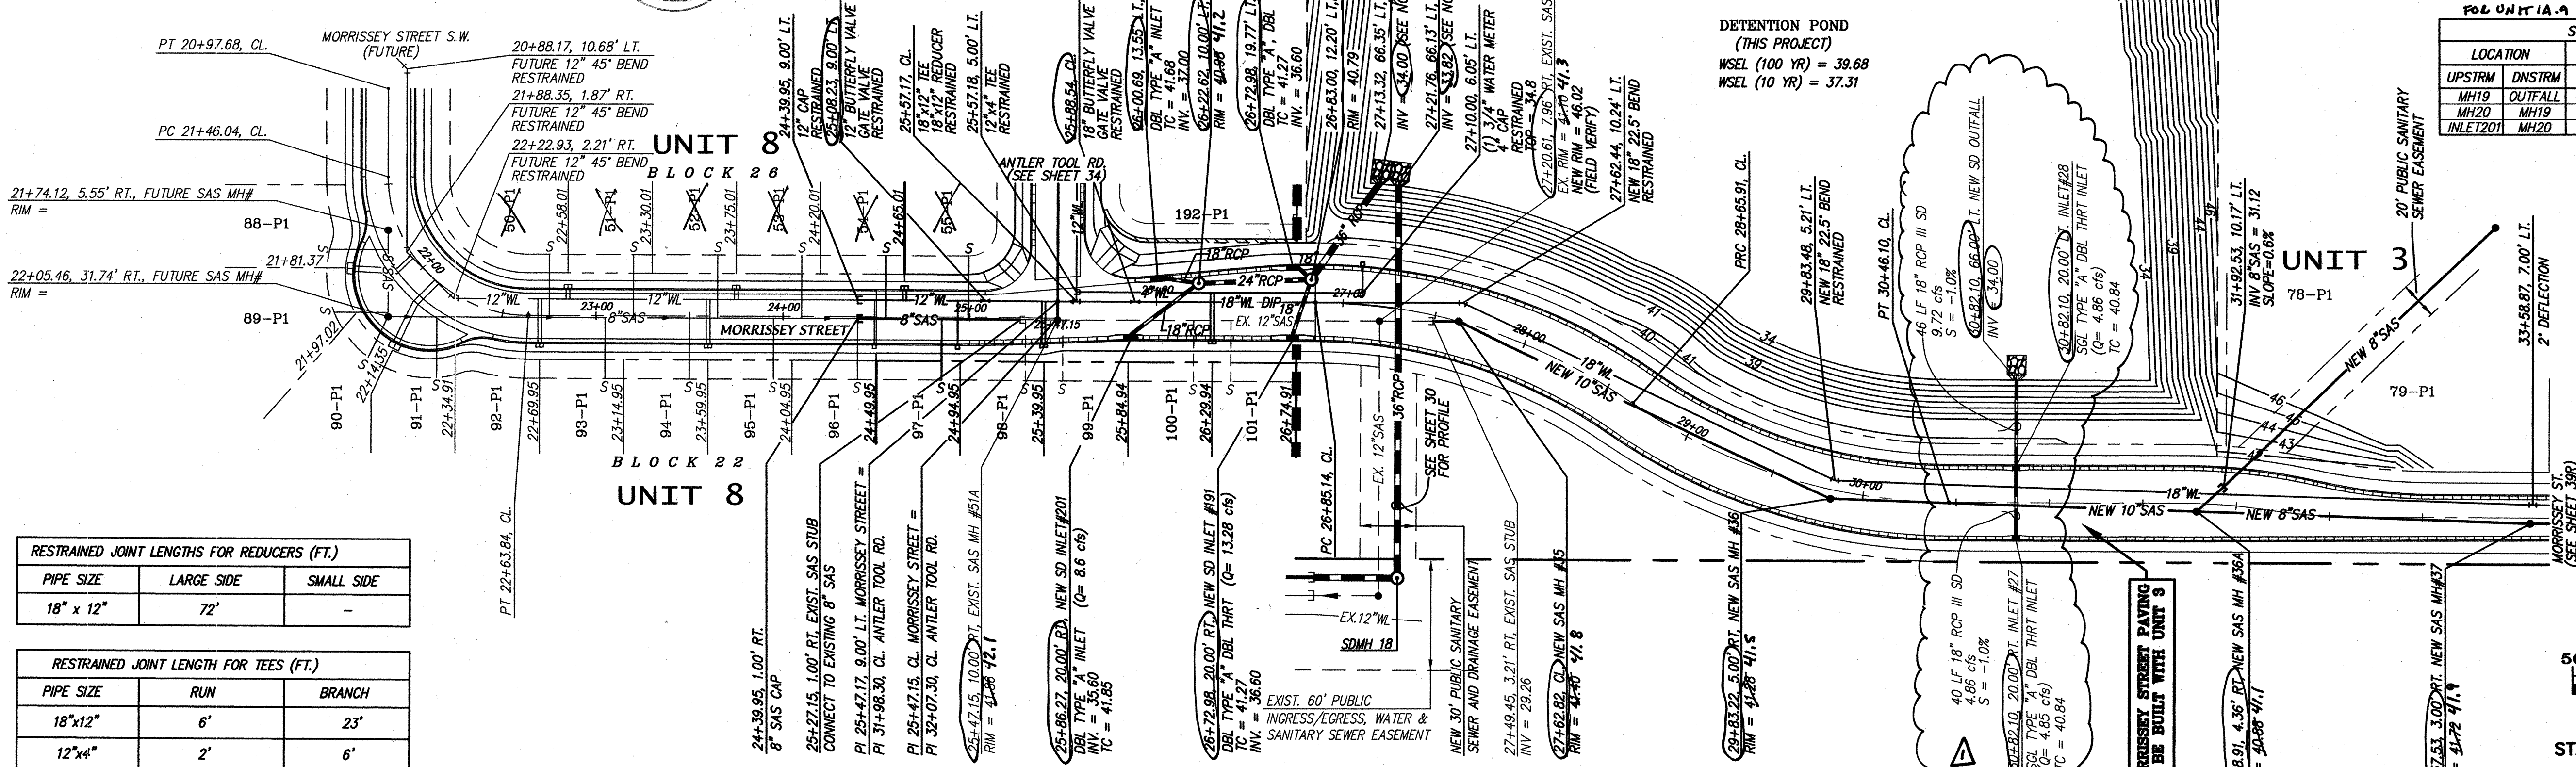

RESTRAINED JOINT LENGTHS FOR REDUCERS (FT.)		
PIPE SIZE	LARGE SIDE	SMALL SIDE
18" x 12"	72'	-



RESTRAINED JOINT LENGTH FOR TEES (FT.)		
PIPE SIZE	RUN	BRANCH
18"x12"	6'	23'
12"x4"	2'	6'

NOTES

1. ALL STATIONING IS BASED ON CENTERLINE OF MORRISSEY STREET.
2. THE DETENTION POND IS PART OF THIS WORK ORDER.
3. SEE SHEET 39 FOR HEADWALL DETAILS.

SANITARY SEWER SERVICES				
BLOCK	LOT	STATION AT PUE	INV. ELEV. AT PUE	LENGTH AT PUE
22	97-P1	24+84.95	37.16	32.00'
26	54-P1	24+55.02	37.40	34.00'
26	56-P4	24+99.25	37.02	34.00'

LOCATION		Q100	VELOCITY	UPSTREAM		DOWNSTREAM	
UPSTREAM	DNSTREAM	(cfs)	(fps)	GRD	HGL	GRD	HGL
MH19	OUTFALL	43.76	6.2	40.79	37.70	41.00	37.33
MH20	MH19	17.20	5.5	40.98	38.62	40.79	38.23
INLET201	MH20	8.6	4.9	41.85	39.21	40.98	38.80

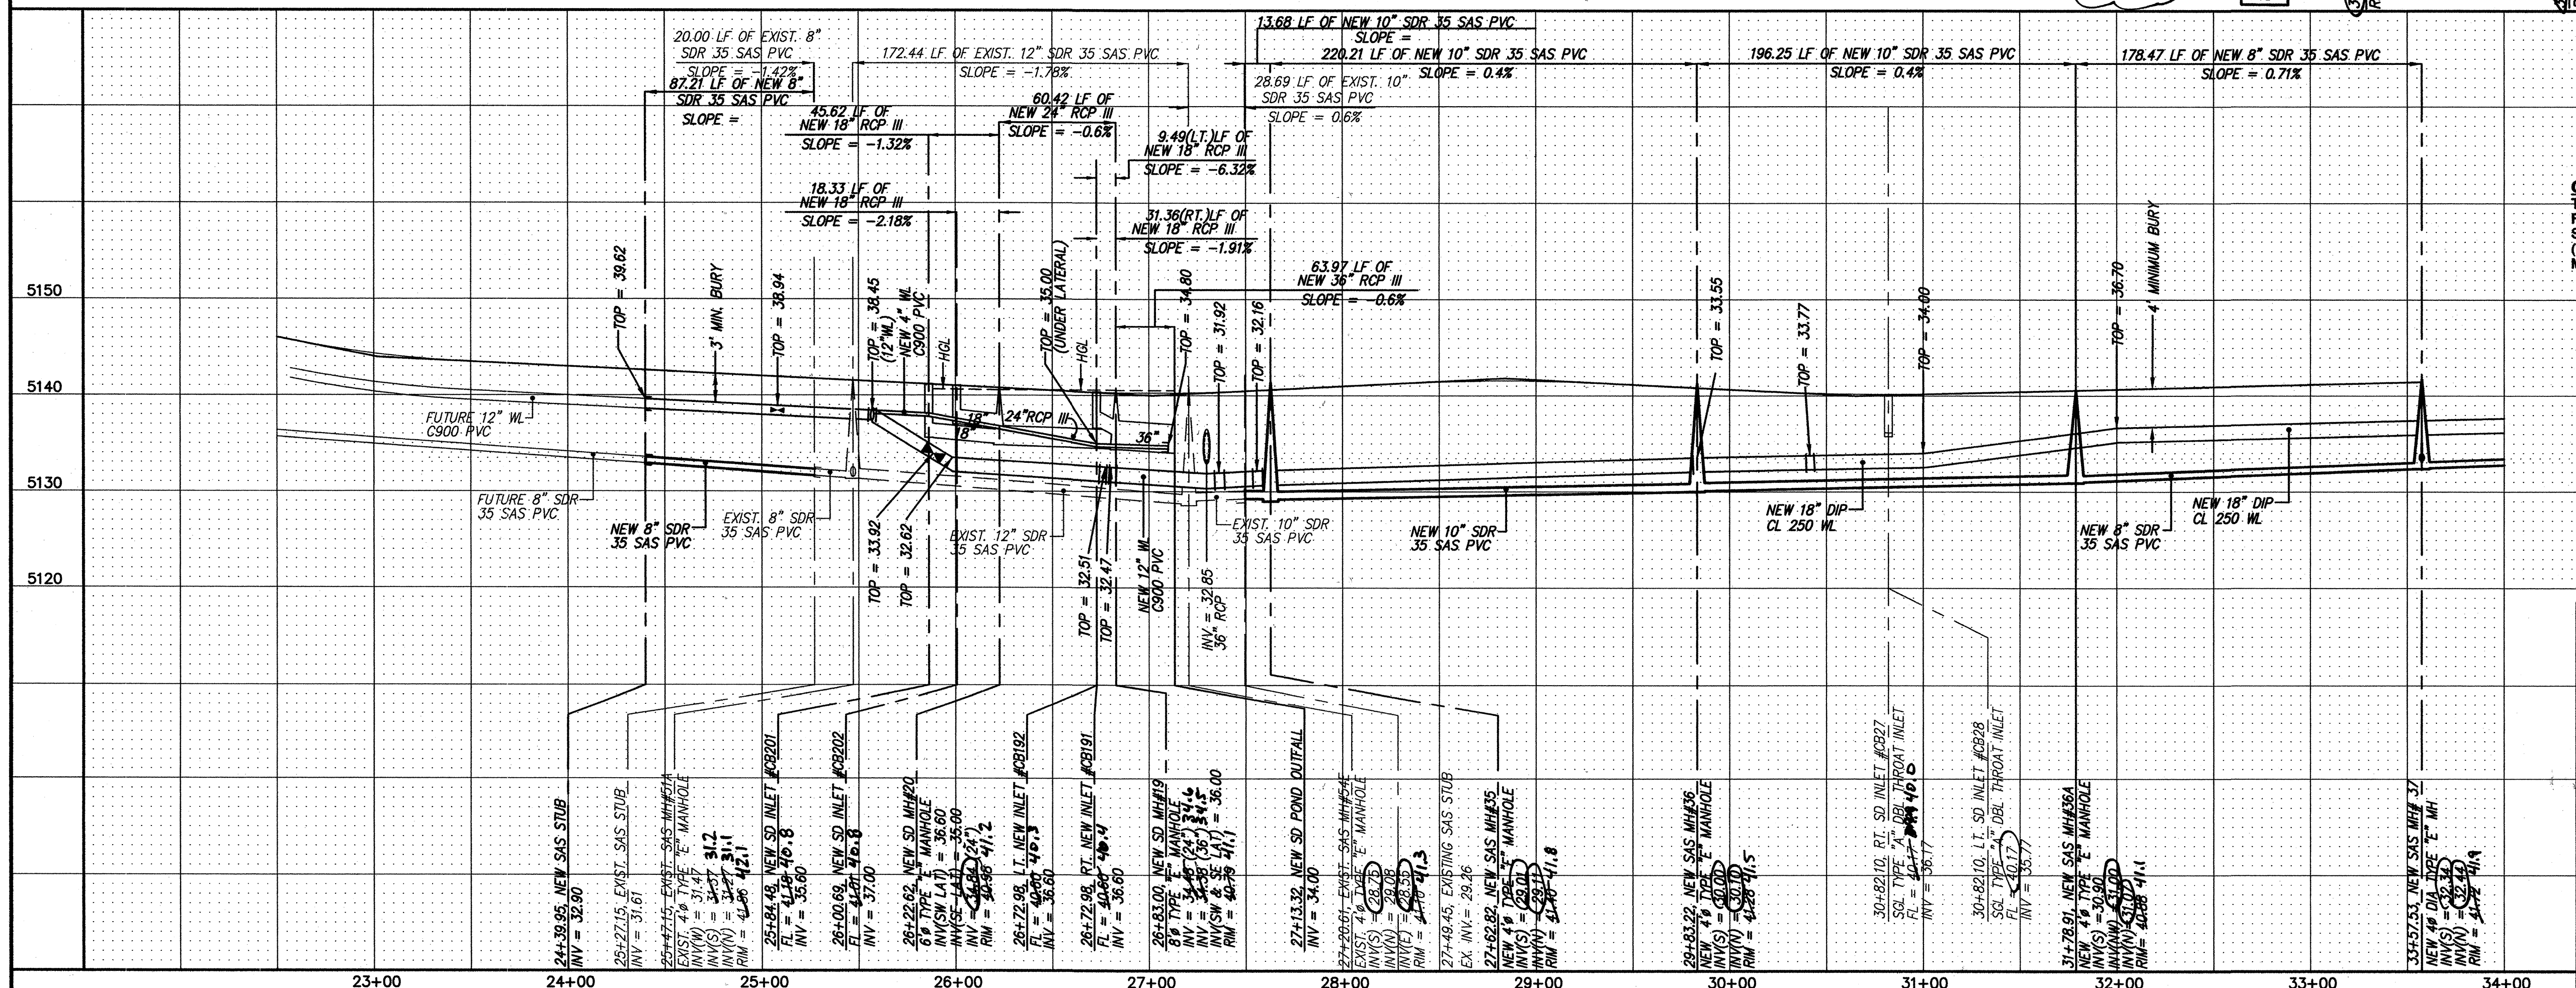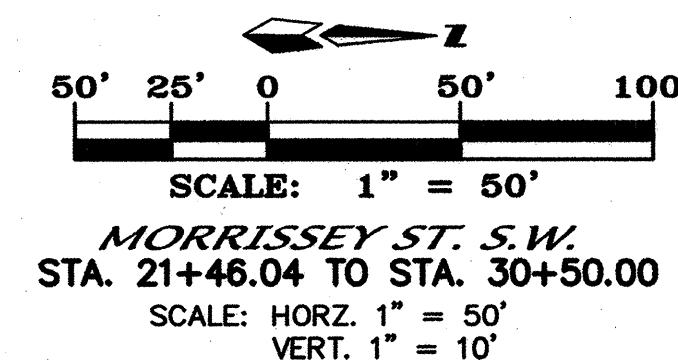

Certification
THE CHANGES SHOWN HEREON ARE BASED UPON
FIELD SURVEY CONDUCTED BY ME OR UNDER MY
SUPERVISION AND REFLECT THE LOCATIONS
(VERTICALLY AND HORIZONTALLY) TO THE BEST OF
MY KNOWLEDGE AND BELIEF

Wall Paper

13+00 **14+00**

 **MARK GOODWIN & ASSOCIATES, P.A.**
CONSULTING ENGINEERS

P.O. BOX 90606
ALBUQUERQUE, NEW MEXICO 87199
(505) 828-2200, FAX (505) 797-9539

	CITY OF ALBUQUERQUE PUBLIC WORKS DEPARTMENT	
	TITLE:	ANDERSON HEIGHTS - UNIT 3 MORRISSEY STREET S.W. UTILITY IMPROVEMENTS

DESIGN REVIEW COMMITTEE	CITY ENGINEER APPROVAL	LAST DESIGN UPDATE	MO./DAY/YR.	MO./DAY/YR.

CITY PROJECT NO.	ZONE MAP NO.	SHEET
7539886	N-8/P-8	18A OF 18 38R 39

A3080AH/PLANS/UNIT-1A & 5/Unit 5/UTILITIES/UP-12R.dwg/04-24-06/ACH DER CAR DLH