


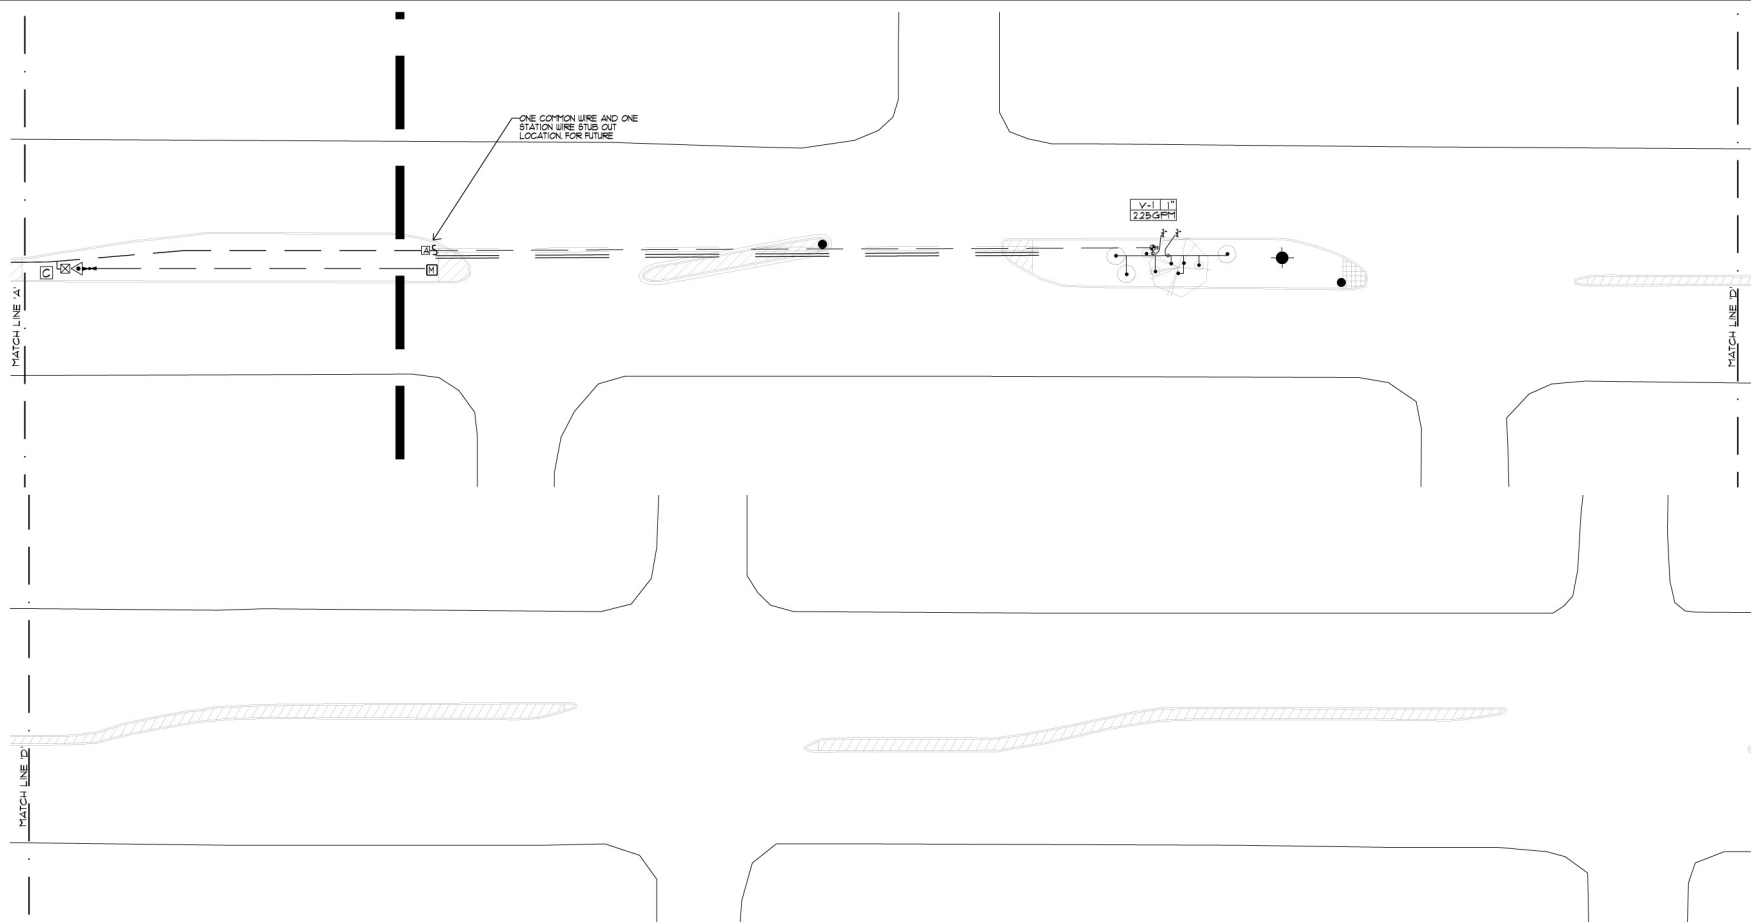


IRRIGATION LEGEND

- [H]** EXISTING 1" WATER METER
- +---
+---+
24-VOLT WIRE SLEEVES, SIZE 2".
- SLEEVE PIPING FOR IRRIGATION MAIN LINE, CLASS 20 SDR-21, SOLVENT WELD PVC. SLEEVE SHALL BE TWO TIMES LONGER THAN PIPES TO BE SLEAVED
SLEEVE DEPTH FOR IRRIGATION MAIN SHALL BE 18".
- 1 1/4" IRRIGATION MAIN LINE, SCH 40 BELL END, SOLVENT WELD PVC. DEPTH OF BURRY SHALL BE 18". NON-CONTINUOUS PRESSURE.
- LATERAL PIPING, SCH 40, BELL END, SOLVENT WELD PVC. DEPTH OF BURRY, 18"
- [I]** REMOTE CONTROL VALVE ASSEMBLY, RAINBIRD PPE PLASTIC BODY 2"X40" AUTOMATIC VALVE WITH 2"X40" GPM. DRAWING NO. 2703. (SIMILAR - SEE IRRIGATION NOTES R04 AND R25, SHEET 2.)
- [J]** SOLVENT WELD CAP, SCH. 40 PVC, LINE SIZE
- PRESSURE COMPENSATING BURRY ASSEMBLIES, RAIN BIRD 1400 SERIES, AS FOLLOWS: INSTALL PER C.O.A. DRAWING NUMBERS 2710, 2711-A AND 2712.
- MODEL NO. GPM
- 1401 25 30
- [A]** EXISTING WIRE SLEUT OUT

AS-BUILT

1/16/2006

IRRIGATION PLAN

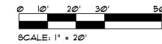

CITY OF ALBUQUERQUE
CAPITAL IMPLEMENTATION PROGRAM
DEPARTMENT OF MUNICIPAL DEVELOPMENT

PROTOTYPE MEDIAN AND INTERSTATE LANDSCAPES FY04-A
LOMAS: LAFAYETTE TO CARLISLE
IRRIGATION PLAN: WORK ORDER #6

Design Review Committee	City Engineer Approval	Last Design Update	Mo./Day/Yr.	Mo./Day/Yr.
City Project No.	Zone Map No.	Sheet		
754504	J16, K16	1 of 1		

[illegible]ARCHITECTURAL SEAL[illegible][illegible]

AS-BUILT INFORMATION	
CONTRACTOR	
WORK	DATE
DESIGNED BY	DATE
CHECKED BY	DATE
ACCEPTANCE BY	DATE
FIELD	DATE
VERIFICATION BY	DATE
REMARKS	DATE 01.16.2006
CONNECTED BY	
MICRO-FILM INFORMATION	
RECORDED BY	DATE
INDEXED BY	DATE