


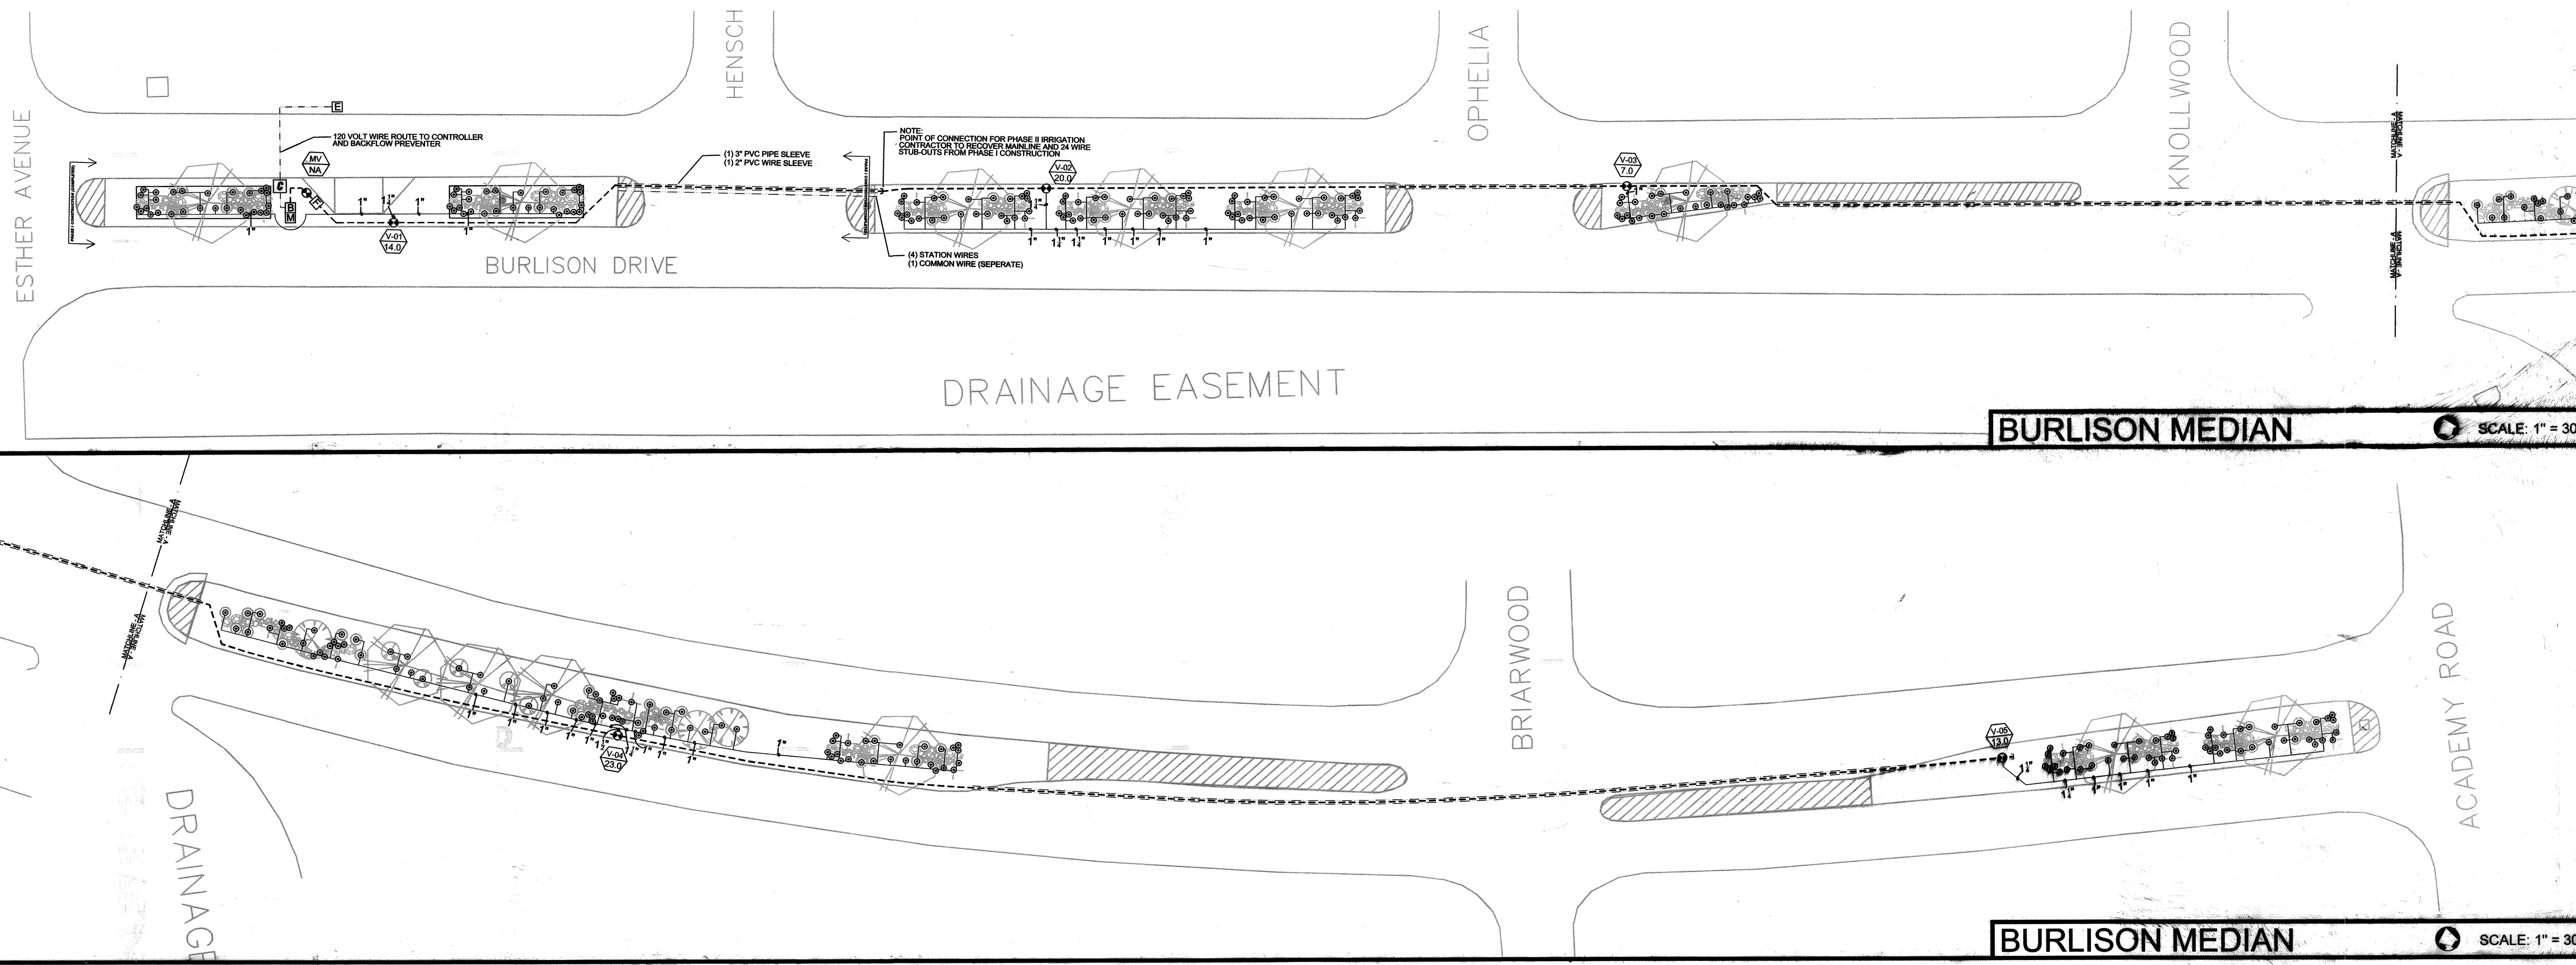


IRRIGATION LEGEND

- RAINBIRD #1401 .25 GPM FULL CIRCLE TRICKLE PATTERN BUBBLER (SEE COA STANDARD DETAIL DRAWINGS: 2710, 2711, 2711-A & 2712)
- WEATHERMATIC #11024FCR-10 1" PLASTIC ELECTRIC VALVE WITH FLOW CONTROL (SEE COA STANDARD DETAIL DRAWING: 2703)
- SCORPIO AC - 8 STATION CONTROLLER WITH INTERSPEC ENCLOSURE, KEYPAD AND DOMED ANTENNA. UNIT SHALL COMMUNICATE ON COA RADIO FREQUENCY (WIDE BAND). (SEE DETAIL DRAWING: B/4 & D/4)
- FEBCO #860U 1" REDUCED PRESSURE BACKFLOW PREVENTER INSTALLED IN HOTBOX #HR2 "HOT ROK" HEATED AND INSULATED BACKFLOW DEVICE ENCLOSURE. (SEE DETAIL DRAWING: C/4)
- MASTER METER ASSEMBLY (FLOW METER WITH OUTPUT REGISTER)
- 1" WATER METER ASSEMBLY (SEE COA STANDARD DETAIL DRAWING: 2362 OR 2363) WATER METER ADDRESS: 6214 BURLISON NE
- ELECTRICAL METER - INSTALLED NEW METER AND TWO BREAKERS ON BACKSIDE OF AN EXISTING ELECTRICAL METER SUPPORT BASE (SIDE B) ELECTRICAL METER ADDRESS: 6214-B BURLISON NE
- SCH.40 PVC SOLVENT WELD CAP (PIPE SIZE)
- MAINLINE PIPING - 2" SCH.40 PVC SOLVENT WELD
- LATERAL PIPING - SCH.40 PVC SOLVENT WELD (SIZE INDICATED ON PLAN - UNSIZED PIPE IS 3/4")
- SLEEVE PIPING - CLASS 200 PVC SOLVENT WELD (SEE AS-BUILT NOTES ON PLAN)
- 120 VOLT ELECTRICAL POWER ROUTE
- CONTROLLER STATION NUMBER
- FLOW IN GALLONS PER MINUTE

SURVEY INFORMATION		AS-BUILT INFORMATION	
FIELD NOTES		CONTRACTOR: Mountain West GolfScapes	
NO.	BY	DATE	WORK STAKED BY: Foy
			INSPECTOR'S APPROVAL: J.C.
			FIELD VERIFICATION BY: Foy
			DRAWING CORRECTED BY: IS
			MICRO-FILM INFORMATION
			RECORDED BY
			DATE
			NO.

Prototype Median Landscapes
Burlison Medians Hensch to
Academy
754603

CITY OF ALBUQUERQUE PARKS AND RECREATION DEPARTMENT DESIGN DEVELOPMENT DIVISION	
TITLE: PROTOTYPE MEDIAN LANDSCAPES BURLISON MEDIANS: HENSCH TO ACADEMY AS-BUILT IRRIGATION SYSTEM	
Design Review Committee	City Engineer Approval
MO./DAY/YR. 05/05/05	MO./DAY/YR. 05/05/05
City Project No. 754603	Zone Map No. E-18
Sheet 1	Of 1

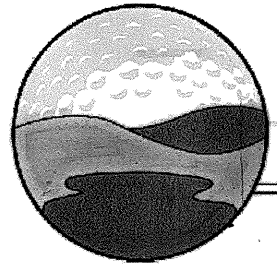

Mountain West GolfScapes, Inc.
IRRIGATION DESIGNERS & CONSULTANTS
2180 HWY 304 BELEN, NM 87002
PHONE: (505) 881-1536
FAX: (505) 884-3212
E-MAIL: irrservices@mtwest.com
WEB SITE: www.irrigationservicesinc.com

Irrigation Services
2180 HWY 304 BELEN, NM 87002
PHONE: (505) 881-1536
FAX: (505) 884-3212
E-MAIL: irrservices@mtwest.com
WEB SITE: www.irrigationservicesinc.com