


GOLD AVE.

AS-BUILT
12/3/12



5604 Wilshire Ave NE
Albuquerque, NM 87113
(505)822-8722

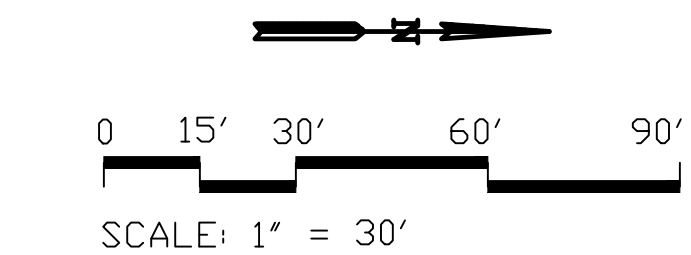

CITY OF ALBUQUERQUE
CAPITAL IMPLEMENTATION PROGRAM
DEPARTMENT OF MUNICIPAL DEVELOPMENT

PROTOTYPE MEDIAN AND INTERSTATE LANDSCAPES FY-13A
UNIVERSITY BOULEVARD: CENTRAL TO COAL (WORK ORDER #2)
IRRIGATION PLAN

Design Review Committee	City Engineer Approval	Last Design Update	Mo./Day/Yr.	Mo./Day/Yr.

City Project No. 755302	Zone Map No. K15	Sheet 1 OF 1
-----------------------------------	----------------------------	------------------------

[illegible]