


[illegible]

BENCH MARKS	AS-BUILT INFORMATION
	CONTRACTOR LEE LANGSHARES, INC.
	WORK PERFORMED BY
	INSPECTOR'S BY
	FIELD OBSERVATION BY
	DATE
	DATE
	DATE 5/29/13
	CONNECTED BY
	CHANNING
	NO.
	RECORDED BY
	DATE
	NO.

[illegible]

ARCHITECTURAL SEAL

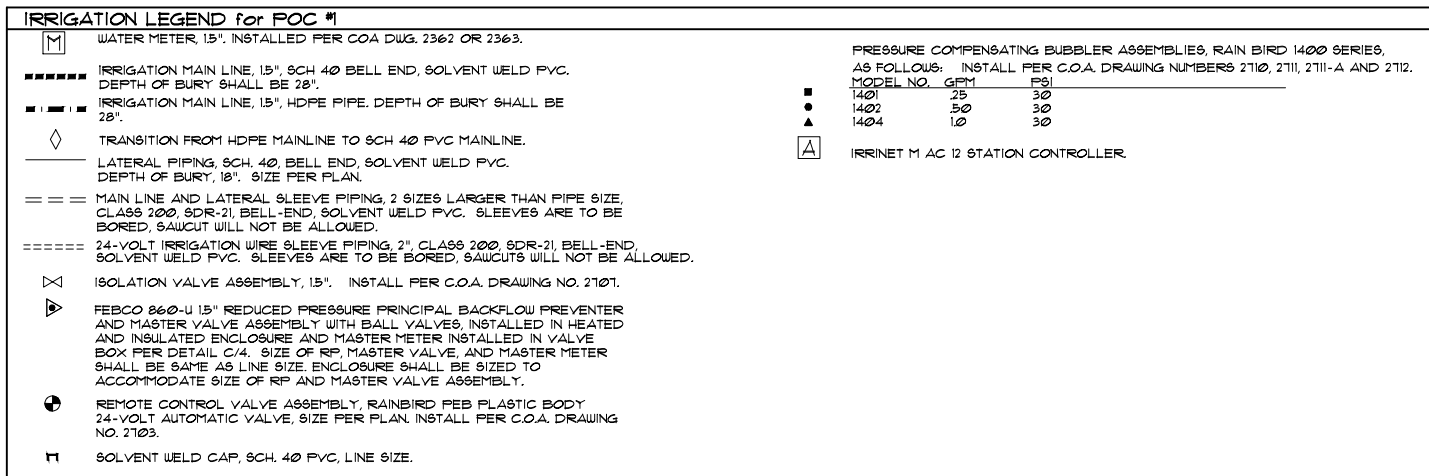

REVISIONS		BY	
NO.	DATE	REMARKS	BY

