


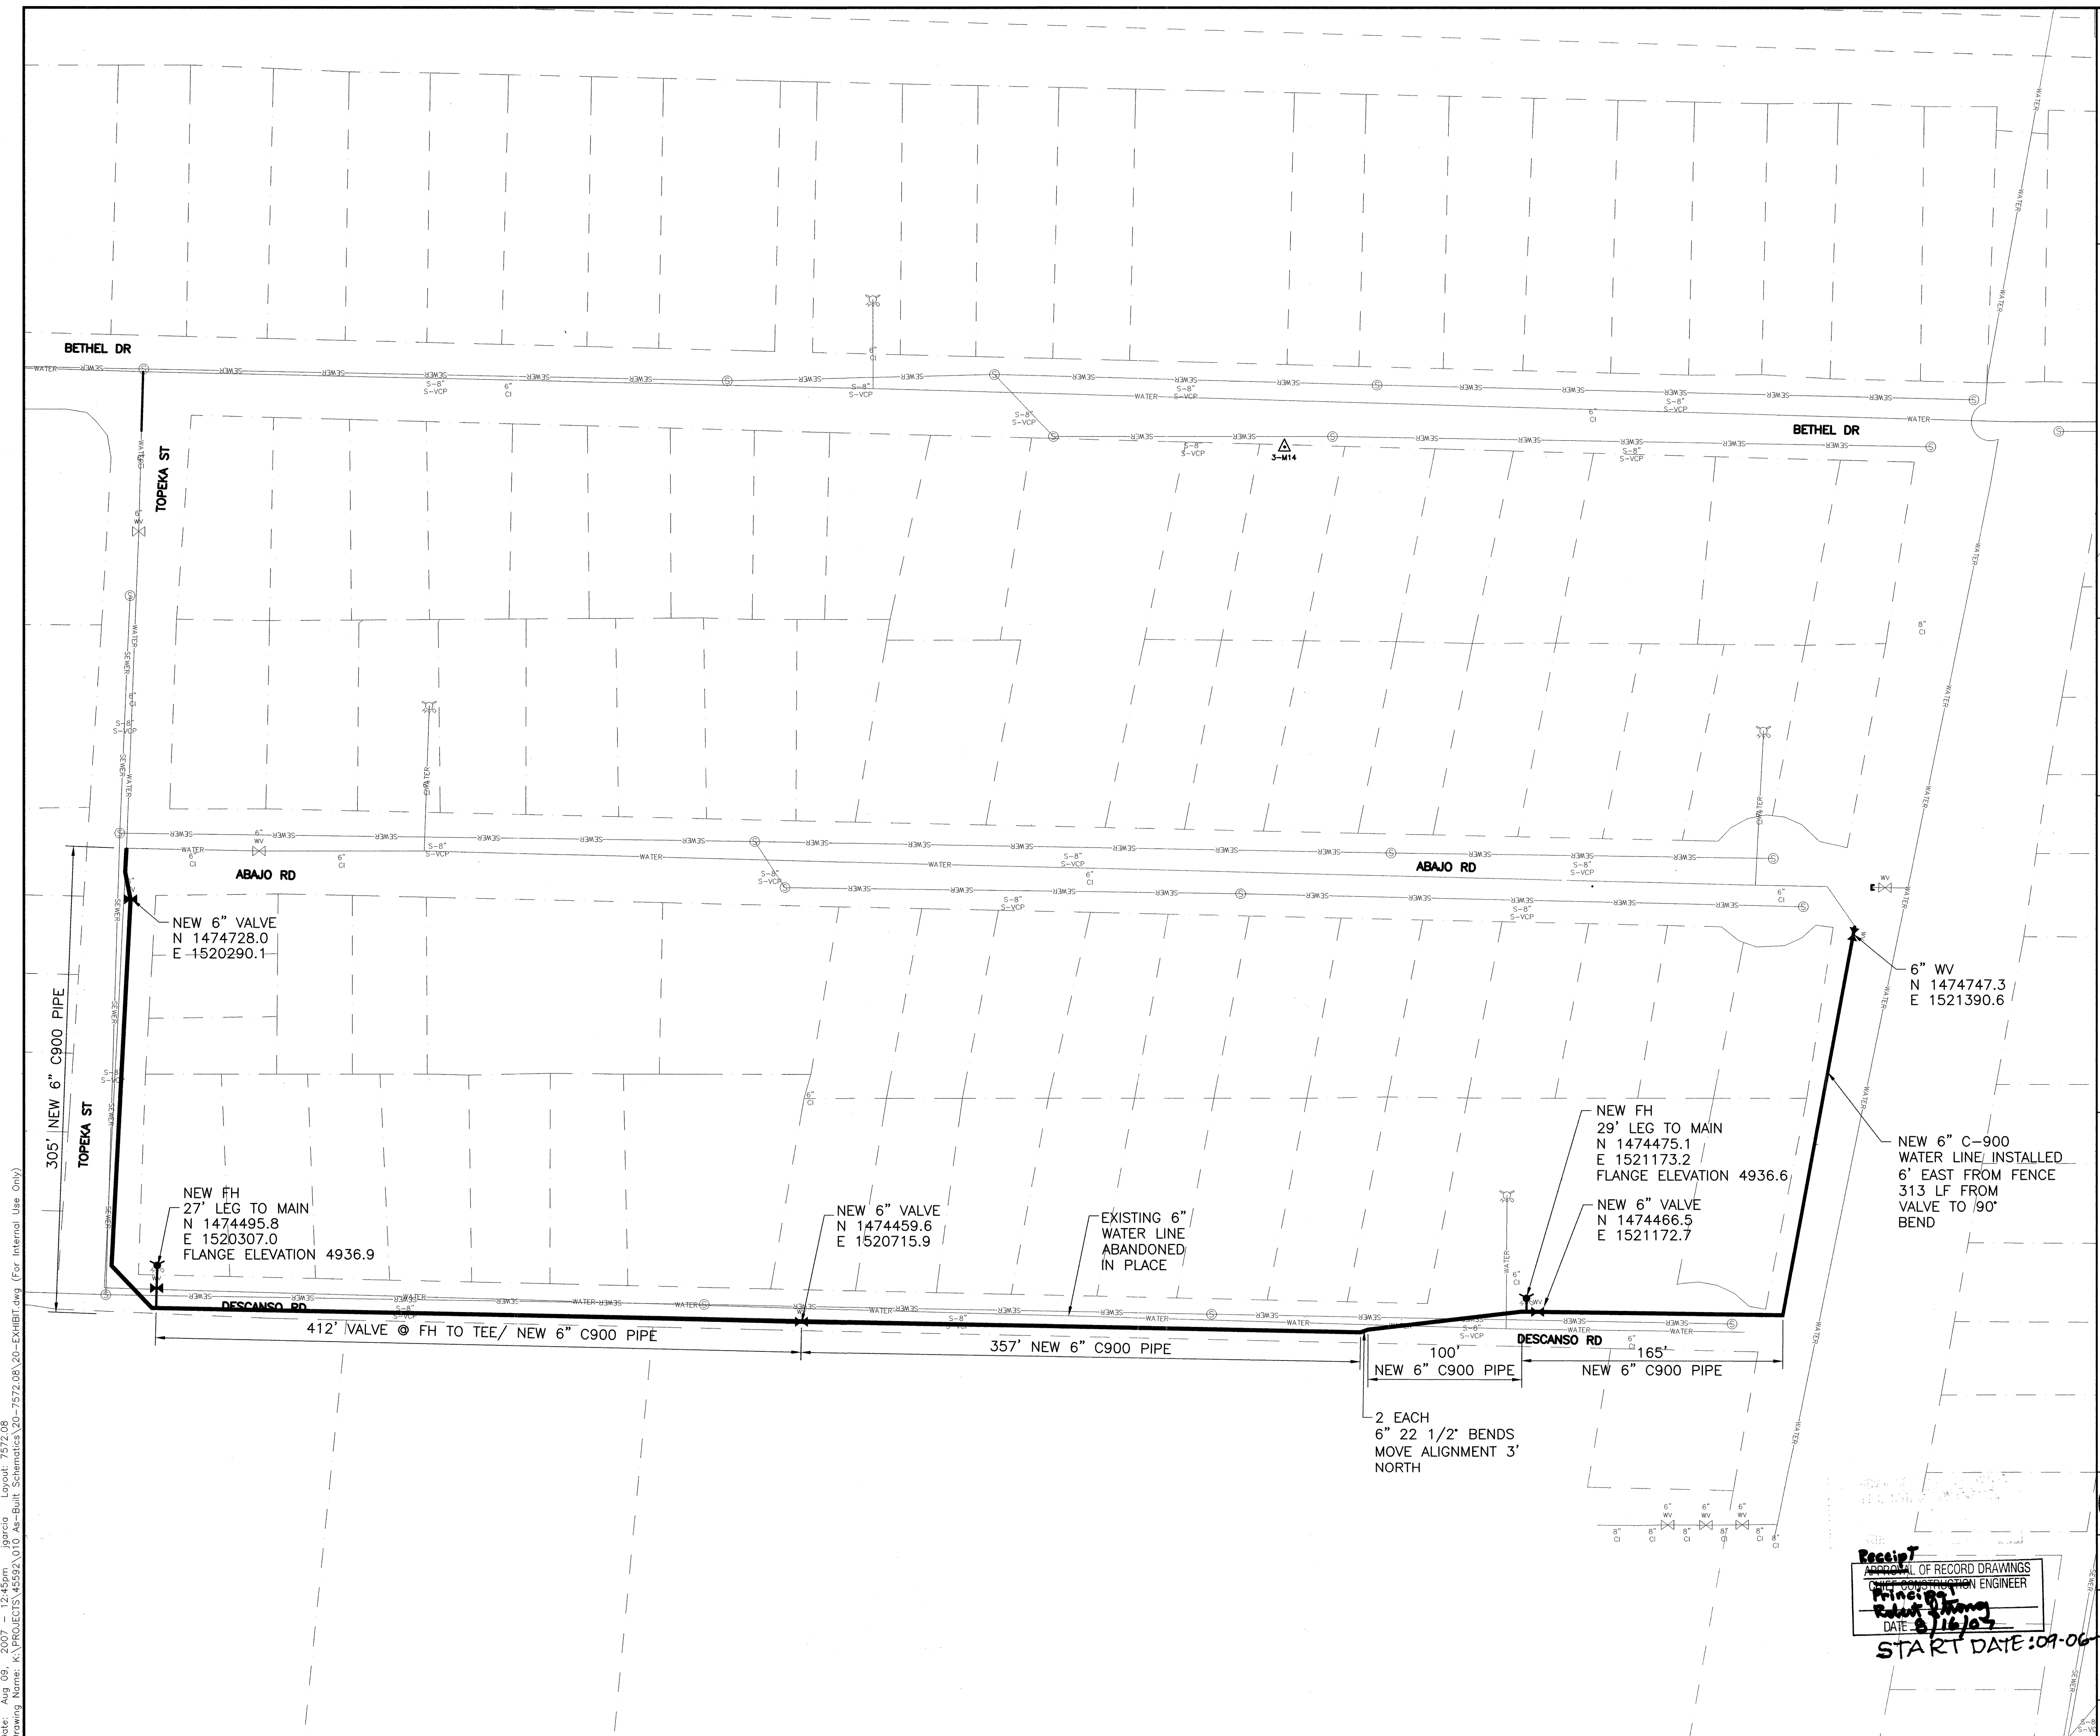

NOTES
1. BASE MAPPING IS SCHEMATIC ONLY AND IS BASED ON G.I.S. DATA.

VICINITY MAP
SCALE: 1" = 1000'

TIE IN AT EAST ABAJO RD.

CLOSE VALVE
REMOVE CAN
INSTALL 6" PLUG
IN VALVE

EXISTING TAPPING SLEEVE ON EXISTING 8" D.I.

6" 45° BENDS

NEW WATER LINE

REVISIONS

NO.	DATE	REMARKS	BY

AS BUILT INFORMATION

CONTRACTOR	TLC	PLUMBING & UTILITIES	DATE

MICRO-FILM INFORMATION

STAMPED BY	DATE

REVISIONS

NO.	DATE	REMARKS	BY

UTILITY PROJECT MANAGER: JERRY JONES
CONTRACTOR FOREMAN: ARTURO MENDIOLA

CITY OF ALBUQUERQUE
WATER UTILITY DEPARTMENT

TITLE: WATERLINE REPLACEMENT
DESCANSO ROAD & ABAJO ROAD

Design Review Committee City Engineer Approval

City Project No. 7572.08 Zone Map No. M-14-Z Sheet 1 Of 1

Date: Aug 09, 2007 - 12:45pm, igarcia Layout: 7572.08
Drawing Name: K:\PROJECTS\45592\010 As-Built Schematics\20-7572.08-20-EXHIBIT.dwg (For Internal Use Only)