

STATEMENT OF CERTIFICATION

I, JOHN P. GERSCHKE, PE, of JPC ENGINEERING, LLC, do hereby certify to the best of my knowledge and belief, that the information contained in this drawing was prepared by JPC ENGINEERING, LLC, and that the information was prepared in accordance with the standards and specifications of the City of Albuquerque, New Mexico, and that the information was prepared in accordance with the standards and specifications of the City of Albuquerque, New Mexico, and that the information was prepared in accordance with the standards and specifications of the City of Albuquerque, New Mexico.



2/15/22

CERTIFYING ENGINEER
JPC ENGINEERING, LLC
(FOR CONSULTANT TO ASPHALT PAVING, LLC)
JOHN P. GERSCHKE, PE
NO. 10083

PUBLIC IMPROVEMENT PLANS

FOR

ASPIRE SUBDIVISION, UNIT 1

ALBUQUERQUE, NEW MEXICO

FEBRUARY 2021

PREPARED FOR:
HERITAGE TRAILS DEVELOPMENT I, LLC.
303 ROMA AVE NW
ALBUQUERQUE, NM 87102

PREPARED BY:
ISAACSON & ARFMAN, INC.
128 MONROE ST. NE
ALBUQUERQUE, NM 87108

GENERAL NOTES

- ALL WORK DETAILED ON THESE PLANS, EXCEPT AS OTHERWISE STATED OR PROVIDED HEREON, SHALL BE CONSTRUCTED IN ACCORDANCE WITH CITY OF ALBUQUERQUE STANDARD SPECIFICATIONS FOR PUBLIC WORKS CONSTRUCTION, 2020 EDITION, AND WILL BE REFERRED TO HEREIN AS "STANDARD SPECIFICATIONS".
- ALL WORK ON THIS PROJECT SHALL BE PERFORMED IN ACCORDANCE WITH APPLICABLE FEDERAL, STATE, AND LOCAL LAWS, ORDINANCES, RULES, AND REGULATIONS CONCERNING CONSTRUCTION SAFETY AND HEALTH.
- CONTRACTOR SHALL ASSUME THE SOLE AND COMPLETE RESPONSIBILITY FOR THE JOB SITE CONDITIONS DURING THE COURSE OF CONSTRUCTION OF THIS PROJECT, INCLUDING SAFETY OF ALL PERSONS AND PROPERTY. THE REQUIREMENT SHALL APPLY CONTINUOUSLY AND NOT BE LIMITED TO NORMAL WORKING HOURS. CONTRACTOR SHALL DEFEND, INDEMNIFY, AND HOLD HARMLESS THE OWNER AND ENGINEER FROM ANY AND ALL LIABILITY REAL OR ALLEGED, IN CONNECTION WITH THE PERFORMANCE OF WORK ON THIS PROJECT, EXCEPT LIABILITY ARISING FROM THE SOLE NEGLIGENCE OF THE OWNER OR ENGINEER.
- AN EXCAVATION/CONSTRUCTION PERMIT WILL BE REQUIRED BEFORE BEGINNING ANY WORK WITHIN CITY RIGHT-OF-WAY.
- CONTRACTOR SHALL NOTIFY THE CONSTRUCTION ENGINEER (OR PROJECT MANAGER) NOT LESS THAN SEVEN (7) DAYS PRIOR TO STARTING WORK IN ORDER THAT THE CITY SURVEYOR MAY TAKE NECESSARY MEASURES TO INSURE THE PRESERVATION OF SURVEY MONUMENTS. CONTRACTOR SHALL NOT DISTURB PERMANENT SURVEY MONUMENTS WITHOUT THE CONSENT OF THE CITY SURVEYOR AND SHALL NOTIFY THE CITY SURVEYOR AND BEAR THE EXPENSE OF REPLACING ANY THAT MAY BE DISTURBED WITHOUT PERMISSION. ONLY THE CITY SURVEYOR SHALL REPLACE SURVEY MONUMENTS. WHEN A CHANGE IS MADE IN THE FINISHED ELEVATIONS OF THE PAVEMENT OF ANY ROADWAY IN WHICH A PERMANENT SURVEY MONUMENT IS LOCATED, CONTRACTOR SHALL, AT HIS OWN EXPENSE, ADJUST THE MONUMENT COVER TO THE NEW GRADE UNLESS OTHERWISE SPECIFIED. REFER TO STANDARD SPECIFICATIONS SECTION 4.4.
- EXISTING UTILITY LINE LOCATIONS ARE SHOWN IN AN APPROXIMATE MANNER ONLY, AND LINES MAY EXIST WHERE NONE ARE SHOWN. TWO (2) WORKING DAYS PRIOR TO ANY EXCAVATION, CONTRACTOR SHALL CONTACT NEW MEXICO ONE CALL SYSTEM (260-1990) FOR LOCATION OF EXISTING UTILITIES. CONTRACTOR SHALL THEN EXCAVATE AND VERIFY THE HORIZONTAL AND VERTICAL LOCATIONS OF ALL PERTINENT EXISTING UTILITIES AND/OR OBSTRUCTIONS. SHOULD A CONFLICT EXIST, THE CONTRACTOR SHALL NOTIFY THE ENGINEER SO THE CONFLICT CAN BE RESOLVED WITH A MINIMUM AMOUNT OF DELAY. CONTRACTOR SHALL THEN COORDINATE RELOCATION OF UTILITY LINES WITH THE CITY OF ALBUQUERQUE. ANY DAMAGE CAUSED BY FAILURE TO LOCATE, IDENTIFY, AND PRESERVE ANY EXISTING UTILITIES IS THE FULL RESPONSIBILITY OF THE CONTRACTOR.
- CONTRACTOR SHALL ASSIST THE ENGINEER/INSPECTOR IN THE RECORDING OF DATA ON ALL UTILITY LINES OR STRUCTURES EXPOSED AS REQUIRED BY THE CITY OF ALBUQUERQUE FOR THE PREPARATION OF "AS-BUILT" DRAWINGS. CONTRACTOR SHALL NOT COVER UTILITY LINES AND ACCESSORIES UNTIL ALL DATA HAS BEEN RECORDED.
- CONTRACTOR SHALL ASSUME FINANCIAL RESPONSIBILITY FOR ANY DAMAGE TO EXISTING PAVEMENT, PAVEMENT MARKINGS, SIGNAGE, CURB AND GUTTER, HANDICAP RAMPS, AND SIDEWALK DURING CONSTRUCTION APART FROM THOSE SECTIONS INDICATED ON THE PLANS, AND SHALL REPAIR OR REPLACE, PER THE STANDARD SPECIFICATIONS, ANY SUCH DAMAGE.
- CONTRACTOR SHALL MAINTAIN A GRAFFITI-FREE WORK SITE. CONTRACTOR SHALL PROMPTLY REMOVE AND ALL GRAFFITI FROM EQUIPMENT, WHETHER PERMANENT OR TEMPORARY.
- CONTRACTOR SHALL BE RESPONSIBLE TO PROVIDE AND MAINTAIN ALL CONSTRUCTION SIGNING UNTIL THE PROJECT HAS BEEN ACCEPTED BY THE CITY AND OTHER JURISDICTIONAL AUTHORITIES WHERE APPLICABLE.
- CONSTRUCTION ACTIVITY SHALL BE LIMITED TO THE PROPERTY AND/OR PROJECT LIMITS SHOWN ON THESE PLANS. ANY CONSTRUCTION PROPERTIES RESULTING FROM THE CONSTRUCTION PROCESS IS THE RESPONSIBILITY OF THE CONTRACTOR, INCLUDING ANY SUCH COSTS INCURRED.
- REMOVALS SHALL BE DISPOSED OF OFF-SITE AND SHALL BE THE RESPONSIBILITY OF THE CONTRACTOR.

WATER & SEWER

- ALL UTILITIES AND UTILITY SERVICE LINES SHALL BE INSTALLED PRIOR TO PAVING. EXISTING VALVES AND MANHOLES SHALL NOT BE BURIED OR PAVED OVER BUT RIMS SHALL BE ADJUSTED TO MATCH NEW GRADE PER COA STANDARD DRAWINGS 2460 AND 2461.
- MANHOLE RIMS, FIRE HYDRANT ELEVATIONS, AND FLANGE ELEVATIONS SHOWN ARE APPROXIMATE. CONTRACTOR SHALL FIELD VERIFY AND ADJUST TO FINAL PAVEMENT OR SURFACE GRADES.
- THE CONTRACTOR SHALL COORDINATE WITH THE WATER AUTHORITY SEVEN (7) DAYS IN ADVANCE OF PERFORMING WORK THAT WILL AFFECT THE EXISTING WATER OR SANITARY SEWER INFRASTRUCTURE. WORK REQUIRING SHUTOFF OF FACILITIES DESIGNATED AS MASTER PLAN 14 DAYS IN ADVANCE OF PERFORMING SUCH WORK. ONLY WATER AUTHORITY CREWS ARE AUTHORIZED TO OPERATE PUBLIC VALVES. SHUTOFF REQUEST MUST BE MADE ONLINE AT [HTTP://ABQWA.ORG/WATER_SHUT_OFF_AND_TURN_ON_PROCESSES.ASPX](http://abqwa.org/water_shut_off_and_turn_on_procedures.aspx)
- PROPOSED WATERLINE MATERIALS SHALL BE PVC PIPE MEETING AWWA C-900, DR18 REQUIREMENTS (8"-12") OR DUCTILE IRON PIPE MEETING AWWA C-150 REQUIREMENTS (8"-48").
- ALL WATERLINE FITTINGS, VALVES, BENDS, TEES, CROSSES AND APPURTENANCES SHALL HAVE RESTRAINED JOINTS UNLESS OTHERWISE NOTED ON THE PLANS. THE JOINT RESTRAINT REQUIREMENTS SHOULD BE DELINEATED WITHIN A JOINT RESTRAINT TABLE.
- ALL SANITARY SEWER LINE STATIONING REFERS TO SANITARY SEWER CENTERLINE STATIONING, EXCEPT WHEN PROVIDED WITHIN A PROPOSED OR EXISTING STREET, WHERE STREET STATIONING SHALL GOVERN.
- ALL FINAL BACKFILL FOR TRENCHES SHALL BE COMPACTED TO A MINIMUM OF 95% MAXIMUM DENSITY PER ASTM D-1557 AND AS DIRECTED BY STANDARD SPECIFICATIONS SECTION 701.14.2 AND STANDARD DRAWING NUMBER 2465.
- ELECTRONIC MARKER SPHERES (EMS) WILL BE PLACED ACCORDING TO THE CITY OF ALBUQUERQUE SPECIFICATIONS FOR PUBLIC WORKS CONSTRUCTION, 1996 EDITION AS REVISED THROUGH UPDATE #2. THE CONTRACTOR SHALL INSTALL A 4" X 4" POST AND EMS AT THE END OF EACH SANITARY SEWER SERVICE.
- TRACER WIRE SHALL BE INCLUDED FOR ALL PUBLIC WATER AND SEWER MAINS AND FOR WATER SERVICES IN ACCORDANCE WITH WATER AUTHORITY DETAILS.
- CONTRACTOR SHALL PROVIDE THE PROPOSED HYDRO TESTING PLANS TO THE WUA INSPECTORS FOR APPROVAL PRIOR TO BEGINNING TESTING OPERATIONS.
- AT UTILITY CROSSINGS, WHERE LESS THAN 18" OF VERTICAL SEPARATION FROM STORM DRAIN, PIPE OR STRUCTURE IS PROPOSED, LEAN FILL CONSTRUCTION (PER SECTION 207 OF THE STANDARD SPECIFICATIONS) SHALL BE USED TO PROTECT THE WATER OR SEWER LINE. LEAN FILL SHALL EXTEND A PERPENDICULAR DISTANCE OF 3 FEET ON EACH SIDE OF THE STORM PIPE OR STRUCTURE.
- ALL DESIGNS AND CONSTRUCTION OF ANY UNDERGROUND UTILITIES SHALL COMPLY WITH ADMINISTRATIVE INSTRUCTION NO. 9 FOR WORK NEARBY OR AFFECTING SANITARY SEWER LINES. THE WATER AUTHORITY SHALL PROVIDE THE INFORMATION TO THE WATER AUTHORITY ONE (1) MONTH IN ADVANCE OF THE CONSTRUCTION START DATE. INFORMATION CAN BE FOUND AT [HTTP://WWW.ABQWA.ORG/WATER_SHUT_OFF_AND_TURN_ON_PROCESSES.ASPX](http://www.abqwa.org/water_shut_off_and_turn_on_procedures.aspx)

TRANSPORTATION

- ANY STREET STRIPING ALTERED OR DESTROYED SHALL BE REPLACED WITH THERMO-PLASTIC REFLECTORIZED PAVEMENT MARKING BY CONTRACTOR TO THE SAME LOCATION AS EXISTING OR AS INDICATED BY THIS PLAN SET.
- REMOVAL OF EXISTING CURB & GUTTER AND SIDEWALKS SHALL BE TO THE NEAREST JOINT.
- OVERNIGHT PARKING OF CONSTRUCTION EQUIPMENT SHALL NOT OBSTRUCT DRIVEWAYS OR DESIGNATED TRAFFIC LANES. THE CONTRACTOR SHALL NOT STORE ANY EQUIPMENT OR MATERIAL WITHIN THE PUBLIC RIGHT-OF-WAY.

- CURB AND GUTTER, SIDEWALKS, AND DRIVE PADS SHALL MATCH THE LINE AND GRADE OF ADJUTING EXISTING AREAS AS SHOWN ON THE PLANS OR AS DIRECTED BY THE PROJECT ENGINEER.
- THE SUBGRADE PREP SHALL EXTEND ONE FOOT BEYOND THE FREE EDGE OF NEW CURB AND GUTTER AND SIDEWALK.
- CONTRACTOR TO TEST SUBGRADE R-V-VALUE PRIOR TO CONSTRUCTION. IN THE EVENT THE R-V-VALUE IS LESS THAN 50, REMOVE 2 FEET OF SUBGRADE MATERIAL AND IMPORT MATERIAL WITH R-V-VALUE GREATER THAN 50 OR CONTACT THE ENGINEER IMMEDIATELY SO THE PAVEMENT SECTION CAN BE MODIFIED.
- AT ALL PAVEMENT REMOVAL AND REPLACEMENTS, SAW-CUT EDGES SHALL BE STRAIGHT AND CLEAN, AND LONGITUDINAL JOINTS SHALL NOT BE PLACED WITHIN WHEEL PATHS. PATCHES SHALL BE REGULAR AND SQUARE OR RECTANGULAR, WITH FOUR STRAIGHT SIDES. FINISHED PAVEMENT SURFACE SHALL BE FLUSH WITH EXISTING PAVEMENT SURFACE, WITH NO SPLOPPER OF ASPHALT OR TACK COAT. CARE MUST BE TAKEN TO AVOID DAMAGING THE INTEGRITY OR APPEARANCE OF SURROUNDING PAVEMENTS; IF DAMAGED, THE ENTIRE SURFACE PATCH MUST BE EXPANDED TO COVER DAMAGES.
- CONTRACTOR WILL ENSURE THE ASPHALT HAS A SMOOTH, UNIFORM EDGE WHEN REMOVING AND REPLACING CURB AND GUTTER. IF THE ASPHALT EDGE IS NOT SMOOTH AND UNIFORM, CONTRACTOR WILL SAW CUT AND REPLACE A ONE-FOOT STRIP OF ASPHALT ALONG THE FULL SECTION BEING REPLACED; REFER TO C.O.A. STANDARD DRAWING # 2465 WITH THE APPROPRIATE PAVING SECTION BASED ON ROADWAY CLASSIFICATION.

HYDROLOGY

- ALL STORM DRAINS SHALL BE RCP CLASS III UNLESS OTHERWISE NOTED ON THE PLANS.
- RCP SHALL BE INSTALLED SO THAT THE JOINT GAP AT THE HOME POSITION SHALL CONFORM TO THE APPROVED MANUFACTURER'S RECOMMENDATION. MANUFACTURER'S RECOMMENDED JOINT GAP TOLERANCES FOR EACH PIPE SIZE AND TYPE SHALL BE SUBMITTED TO THE ENGINEER FOR APPROVAL PRIOR TO PLACEMENT OF PIPE. RCP JOINTS SHALL NOT BE GROUDED UNLESS DIRECTED BY THE ENGINEER AND WITH CITY APPROVAL.

OTHER COMMON NOTES

- ALL EXCAVATION, TRENCHING, AND SHORING ACTIVITIES MUST BE ACCOMPLISHED IN ACCORDANCE WITH OSHA 290CF 1926.650 SUBPART P.
- WHEN DISTURBING MORE THAN 1/4 ACRES, CONTRACTOR SHALL SECURE A TOPSOIL DISTURBANCE PERMIT PRIOR TO BEGINNING CONSTRUCTION.
- IN ADVANCE OF CONSTRUCTION, CONTRACTOR SHALL DETERMINE IF OVERHEAD UTILITY LINES, SUPPORT STRUCTURES, POLES, GUYS, ETC. ARE AN OBSTRUCTION TO CONSTRUCTION OPERATIONS. IF ANY ARE AN OBSTRUCTION TO CONSTRUCTION OPERATIONS, CONTRACTOR SHALL BE RESPONSIBLE FOR COORDINATING WITH THE APPROPRIATE UTILITY OWNER TO REMOVE OR SUBMIT THE UTILITY OBSTRUCTION. ANY COST ASSOCIATED WITH THIS EFFORT SHALL BE THE RESPONSIBILITY OF CONTRACTOR.
- PNM WILL PROVIDE AT NO COST TO THE CITY OR THE CONTRACTOR THE REQUIRED PERSONNEL FOR INSPECTION OR OBSERVATION (DEEMED NECESSARY BY PNM) WHILE THE CONTRACTOR IS EXPOSING PNM'S CABLES. HOWEVER, THE CONTRACTOR SHALL BE CHARGED THE TOTAL COST ASSOCIATED WITH REPAIRS TO DAMAGED CABLES OR FOR ANY COST ASSOCIATED WITH SUPPORTING OR RELOCATING THE POLES AND CABLES DURING CONSTRUCTION.
- CONTRACTOR SHALL SUPPORT AND PROTECT ALL EXISTING UNDERGROUND UTILITY LINES WHOSE DEPTH IS EXPOSED DURING CONSTRUCTION. PAYMENT FOR SUPPORTING WORK SHALL BE INCIDENTAL TO WATERLINE AND/OR SEWER LINE COSTS.
- CONTRACTOR IS TO SUPPORT, PROTECT, AND MAINTAIN THE INTEGRITY OF ALL UNDERGROUND TELEPHONE, ELECTRIC CABLES AND CABLE TELEVISION UTILITIES AT NO ADDITIONAL COST TO THE OWNER. CABLE IS TO BE SUPPORTED AT A MAXIMUM SPACING OF FIFTEEN (15) FEET. CONTRACTOR SHALL COORDINATE WITH AND MAKE NECESSARY PAYMENT (IF ANY) TO UTILITY OWNER FOR DE-ENERGIZATION OF CABLES OR SUPPORT OF CABLES BY THE UTILITY OWNER.
- CONTRACTOR SHALL PROMPTLY CLEAN UP ANY MATERIAL EXCAVATED WITHIN THE PUBLIC RIGHT-OF-WAY OR PRIVATE ROADWAY EASEMENTS TO PREVENT ANY EXCAVATED MATERIAL BEING WASHED DOWN THE STREET OR INTO ANY PUBLIC DRAINAGE FACILITY.

APPROVED RECORD DRAWINGS

City Inspector	Matt Garduno
Contractor	Sells Brothers Construction, Inc.
Construction Engineer	David Bishop
Date	9/8/2022

SURVEYOR'S CERTIFICATION

I, BRIAN J. MARTINEZ, A DULY QUALIFIED, REGISTERED, PROFESSIONAL LAND SURVEYOR UNDER THE LAWS OF THE STATE OF NEW MEXICO, DO HEREBY CERTIFY THAT THE "AS-BUILT" INFORMATION SHOWN ON THESE DRAWINGS WAS OBTAINED FROM FIELD CONSTRUCTION AND "AS-BUILT" INFORMATION SHOWN ON THESE DRAWINGS WAS ADDED BY ME OR UNDER MY SUPERVISION, AND THAT THIS "AS-BUILT" INFORMATION IS TRUE AND CORRECT TO THE BEST OF MY KNOWLEDGE AND BELIEF. CARTESIAN SURVEYS, INC. IS NOT RESPONSIBLE FOR ANY OF THE DESIGN CONCEPTS, CALCULATIONS, ENGINEERING, OR INTENT OF THE RECORD DRAWINGS.

B. J. Martinez 2/15/22



RECORD DRAWING



INDEX TO DRAWINGS

Sheet Number	Sheet Title
1	COVER SHEET
2A	PLAT
2B	PLAT
2C	PLAT
	APPROVED GRADING & DRAINAGE PLAN
3	OVERALL GRADING & DRAINAGE PLAN
4	GRADING & DRAINAGE PLAN 1
5	GRADING & DRAINAGE PLAN 2
6	GRADING & DRAINAGE PLAN 3
7	GRADING & DRAINAGE DETAILS
8	UNIT 1 INTERIM GRADING SHEET 1
9	UNIT 1 INTERIM GRADING SHEET 2
10	UNIT 1 INTERIM GRADING SHEET 3
	PAVING
11	MASTER PAVING & SIGNAGE PLAN
12	STREET SECTIONS AND DETAILS
13	ASPIRE WAY
14	CERRO ALTO WAY
15	ASPIRATION LANE
16	ASPIRATION LANE (CONT.)
17	CARESSO LOOP
18	CARESSO LOOP (CONT.)
19	SABINO LOOP
20	HALFMOON WAY & ARRIBA LANE
21	EMERGENCY ACCESS ROAD
	LIGHTING
22	ROADWAY LIGHTING GENERAL NOTES AND STANDARDS
23	STREET LIGHTING PLAN
24	STREET LIGHTING PHOTOMETRIC PLAN
25	ELECTRICAL DETAILS
26	ELECTRICAL DETAILS
27	ELECTRICAL DETAILS
28	UTILITY
29	AS-BUILT COORDINATES
30	ASPIRE WAY
31	CERRO ALTO WAY
32	ASPIRATION LANE
33	ASPIRATION LANE (CONT.)
34	CARESSO LOOP
35	CARESSO LOOP (CONT.)
36	SABINO LOOP
37	HALFMOON WAY & ARRIBA LANE




DRB NO. PR-2019-00241

Isaacson & Arfman, Inc.
Civil Engineering Consultants

128 Monroe Street NE
Albuquerque, NM 87108
505-268-9829 | www.isacivil.com


REV.	SHEETS	CITY ENGINEER	DATE	USER DEPARTMENT	DATE	APPROVED FOR CONSTRUCTION
		ENGINEERS STAMP & SIGNATURE		ENGINEER	DATE	
		APPROVALS				
		DRG Chairman			3/29/21	
		Transportation			3/2/2021	
		ARC/MIA		Robert W. Strong	3/8/21	
		Hydrology		David C. Bishop	3/3/2021	
		Approved by Albuquerque				
		Design Review Committee				
		Civil Engineering				
		City Project No.				
		757580				
		City Engineer			6/28/2021	
		Sheet			1	37

**Plat for
Aspire Subdivision Unit 1**
Being Comprised of
Tracts A-1-A and B-1
Anderson Heights, Unit 4
City of Albuquerque
Bernalillo County, New Mexico
January 2021

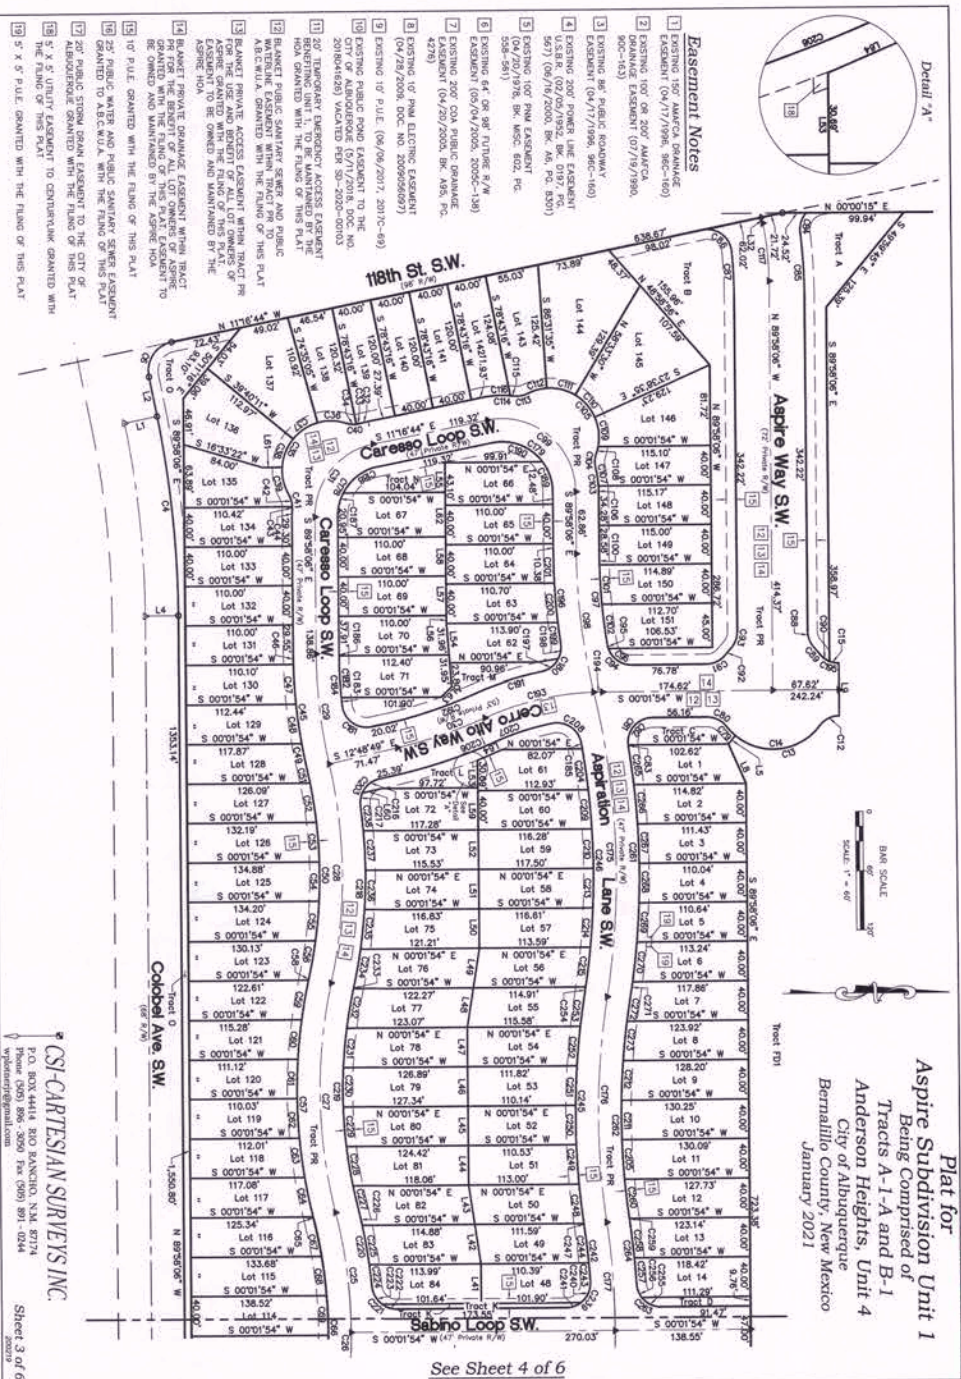

RECORD DRAWING

**Plat for
Aspire Subdivision Unit 1**
Being Comprised of
Tracts A-1-A and B-1
Anderson Heights, Unit 4
City of Albuquerque
Bernalillo County, New Mexico
January 2021

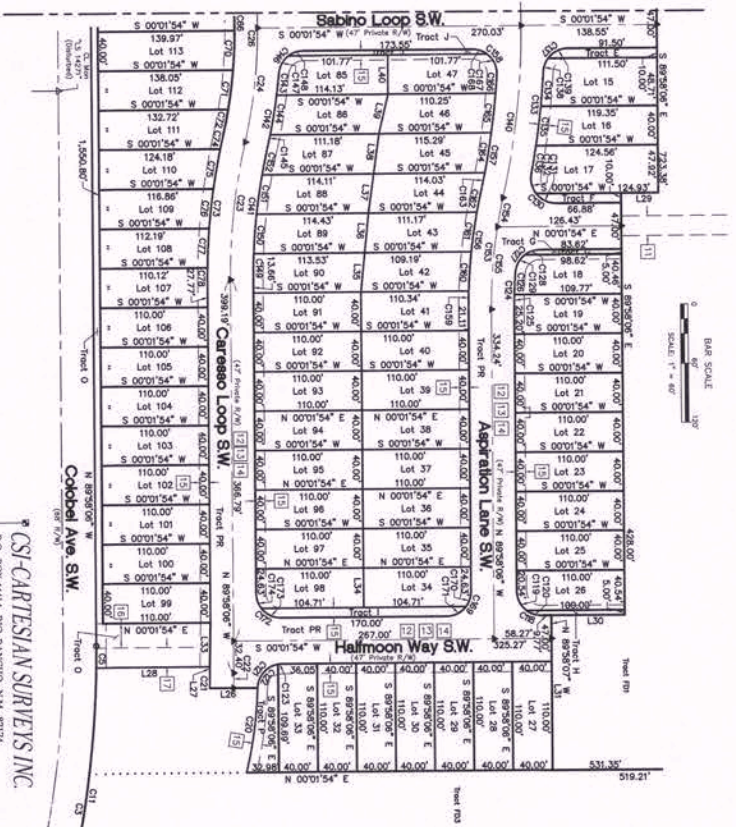

See Sheet 3 of 6

See Sheet 4 of 6

CSI-CARTESIAN SURVEYS INC.

P.O. BOX 4414 BEO ALBUQUERQUE, NM 87104
Phone (505) 296-3050 Fax (505) 891-0344
wpsurveys@gmail.com

Sheet 4 of 6
20210128

RECORD DRAW

Plat for
Aspire Subdivision Unit 1
Being Comprised of
Tracts A-1-A and B-1
Anderson Heights, Unit 4
City of Albuquerque
Bernalillo County, New Mexico
January 2021

Line #	Line Name		Line #	Line Name	
	Direction	Length (ft)		Direction	Length (ft)
L1	S 17°52'30" E	54.92	L46	N 69°38'30" W	40.60
L2	S 79°44'25" W (S 79°42'30" W)	54.94 (50.72)	L47	N 69°38'30" W	40.60
L3	S 80°21'15" E (E 80°15'30" E)	44.60	L48	N 60°05'15" W	40.62
L4	S 50°15'30" W	44.60	L49	N 60°05'15" W	40.62
L5	N 69°38'30" W	116.67	L50	N 69°38'30" W	40.60
L6	N 69°38'30" W	116.67 (119.81)	L51	N 69°38'30" W	40.60
L7	N 60°05'15" W	55.20 (50.57)	L52	N 69°38'30" W	27.68
L8	N 69°38'30" W	55.20 (50.57)	L53	N 69°38'30" W	40.60
L9	S 69°38'30" W	53.07	L54	N 69°38'30" W	40.60
L10	S 69°38'30" W	125.39	L55	S 69°38'30" W	8.17
L11	S 69°38'30" W	125.39	L56	S 69°38'30" W	8.17
L12	N 60°05'15" W	12.07	L57	N 69°38'30" W	44.60
L13	N 62°46'15" W	7.60	L58	N 69°38'30" W	44.60
L14	S 80°20'17" W	15.60	L59	S 69°38'30" W	43.60
L15	N 11°34'34" E	106.31	L60	N 12°48'45" W	20.50
L16	N 69°38'30" W	14.60	L61	S 60°05'15" W	20.60
L17			L62		44.60

[illegible]

CSI-CARTESIAN SURVEYS INC.
P.O. BOX 44414 RIO RANCHO, N.M. 87174
Phone (505) 896-3050 Fax (505) 891-0244
webmaster@csisurveys.com

Sheet 5 of 6
200719

**Plat for
Aspire Subdivision Unit 1
Being Comprised of
Tracts A-1-A and B-1
Anderson Heights, Unit 4
City of Albuquerque
Bernalillo County, New Mexico
January 2021**

[illegible]

Period: 1990-2000			Period: 2001-2010			Period: 2011-2020			Period: 2021-2030		
Period Name	Start Date	End Date (Yr. F.)	Period Name	Start Date	End Date (Yr. F.)	Period Name	Start Date	End Date (Yr. F.)	Period Name	Start Date	End Date (Yr. F.)
Lat 1	0.9997	0.9998	Lat 31	0.9105	0.9105	Lat 61	0.9107	0.9107	Lat 91	0.9107	0.9107
Lat 2	0.9107	0.9108	Lat 32	0.9107	0.9107	Lat 62	0.9107	0.9107	Lat 92	0.9107	0.9107
Lat 3	0.9108	0.9108	Lat 33	0.9107	0.9107	Lat 63	0.9107	0.9107	Lat 93	0.9107	0.9107
Lat 4	0.9108	0.9108	Lat 34	0.9107	0.9107	Lat 64	0.9107	0.9107	Lat 94	0.9107	0.9107
Lat 5	0.9108	0.9108	Lat 35	0.9107	0.9107	Lat 65	0.9107	0.9107	Lat 95	0.9107	0.9107
Lat 6	0.9096	0.9095	Lat 36	0.9107	0.9107	Lat 66	0.9107	0.9107	Lat 96	0.9107	0.9107
Lat 7	0.9111	0.9111	Lat 37	0.9108	0.9108	Lat 67	0.9108	0.9108	Lat 97	0.9108	0.9108
Lat 8	0.9154	0.9154	Lat 38	0.9107	0.9107	Lat 68	0.9107	0.9107	Lat 98	0.9107	0.9107
Lat 9	0.9188	0.9188	Lat 39	0.9107	0.9107	Lat 69	0.9107	0.9107	Lat 99	0.9107	0.9107
Lat 10	0.9197	0.9197	Lat 40	0.9104	0.9104	Lat 70	0.9107	0.9107	Lat 100	0.9107	0.9107
Lat 11	0.9180	0.9180	Lat 41	0.9108	0.9108	Lat 71	0.9108	0.9108			
Lat 12	0.9154	0.9154	Lat 42	0.9109	0.9109	Lat 72	0.9107	0.9107			
Lat 13	0.9107	0.9107	Lat 43	0.9109	0.9109	Lat 73	0.9107	0.9107			
Lat 14	0.9098	0.9097	Lat 44	0.9109	0.9109	Lat 74	0.9107	0.9107			
Lat 15	0.9098	0.9098	Lat 45	0.9109	0.9109	Lat 75	0.9107	0.9107			
Lat 16	0.9098	0.9098	Lat 46	0.9109	0.9109	Lat 76	0.9107	0.9107			
Lat 81	0.9100	0.9100									
Lat 82	0.9100	0.9100									
Lat 83	0.9100	0.9100									
Lat 84	0.9100	0.9100									
Lat 85	0.9100	0.9100									
Lat 86	0.9100	0.9100									
Lat 87	0.9100	0.9100									
Lat 88	0.9100	0.9100									
Lat 89	0.9100	0.9100									
Lat 90	0.9100	0.9100									
Lat 91	0.9100	0.9100									
Lat 92	0.9100	0.9100									
Lat 93	0.9100	0.9100									
Lat 94	0.9100	0.9100									
Lat 95	0.9100	0.9100									
Lat 96	0.9100	0.9100									
Lat 97	0.9100	0.9100									
Lat 98	0.9100	0.9100									
Lat 99	0.9100	0.9100									
Lat 100	0.9100	0.9100									

[illegible]



CS-CARTESIAN SURVEYS INC.

P.O. BOX 44414 BO RANCHO, NM 87134


Phone (505) 896-3500 Fax (505) 891-0244

Cart #	Length	Inside	Draw	Base	Cart Length	Draw Direction
C241	16.00	20.00	197.32	13.51	N 197.41° W	
C242	56.40	746.50	739.52	56.30	N 193.01° W	
C243	18.30	746.50	724.67	18.10	N 189.21° W	
C244	18.30	746.50	724.67	18.10	N 189.21° W	
C245	326.81	773.50	773.29	326.60	N 189.20° W	
C246	46.00	756.50	754.10	45.80	N 189.20° W	
C247	27.71	773.50	770.17	27.57	N 193.11° E	
C248	40.00	773.50	770.17	39.80	N 193.12° E	
C249	40.00	773.50	770.17	39.80	N 193.07° E	
C250	40.01	773.50	770.17	39.80	N 193.04° E	
C252	40.10	773.50	770.17	39.80	N 193.06° E	
C253	31.86	773.50	770.17	31.66	N 193.05° E	
C254	32.80	756.50	759.27	32.60	N 189.40° W	
C255	32.80	756.50	759.27	32.60	N 189.44° W	
C256	14.67	20.00	191.11	14.70	N 189.23.23° E	
C257	24.37	743.50	735.50	24.31	N 189.42° W	
C258	0.34	743.50	735.50	0.34	N 189.20° E	
C259	0.34	726.50	710.30	0.34	N 189.20° E	
C260	40.37	726.50	710.30	40.15	N 189.44° W	
C261	250.43	726.50	710.30	249.55	N 189.47° W	
C262	31.86	726.50	710.30	31.66	N 189.47° W	
C263	31.86	726.50	710.30	31.66	N 189.47° W	
C264	16.37	743.50	744.71	16.37	N 189.11° W	
C265	33.00	743.50	744.71	33.00	N 189.17° W	
C266	40.01	743.50	744.71	39.81	N 189.17° W	
C267	40.01	743.50	744.71	39.81	N 189.17° W	
C268	40.01	743.50	744.71	39.81	N 189.17° W	
C269	40.01	743.50	744.71	39.81	N 189.17° W	
C270	40.01	743.50	744.71	39.81	N 189.17° W	
C271	19.07	743.50	744.71	19.01	N 189.10° W	
C272	19.07	743.50	744.71	19.01	N 189.10° W	
C273	40.37	726.50	710.30	40.15	N 189.20° E	

Gene		Gene Name		Gene Length		Gene Position	
Chr	Length	Start	End	Chr	Length	Start	End
CH1	42.12	70000	89750	CH2	42.08	89750	13200
CH3	42.08	41900	83700	CH4	42.08	83700	12600
CH5	42.07	41900	83700	CH6	42.07	83700	12600
CH7	42.06	41900	83700	CH8	42.06	83700	12600
CH95	41.62	41900	83700	CH96	41.62	83700	12600

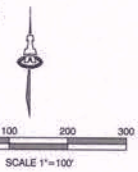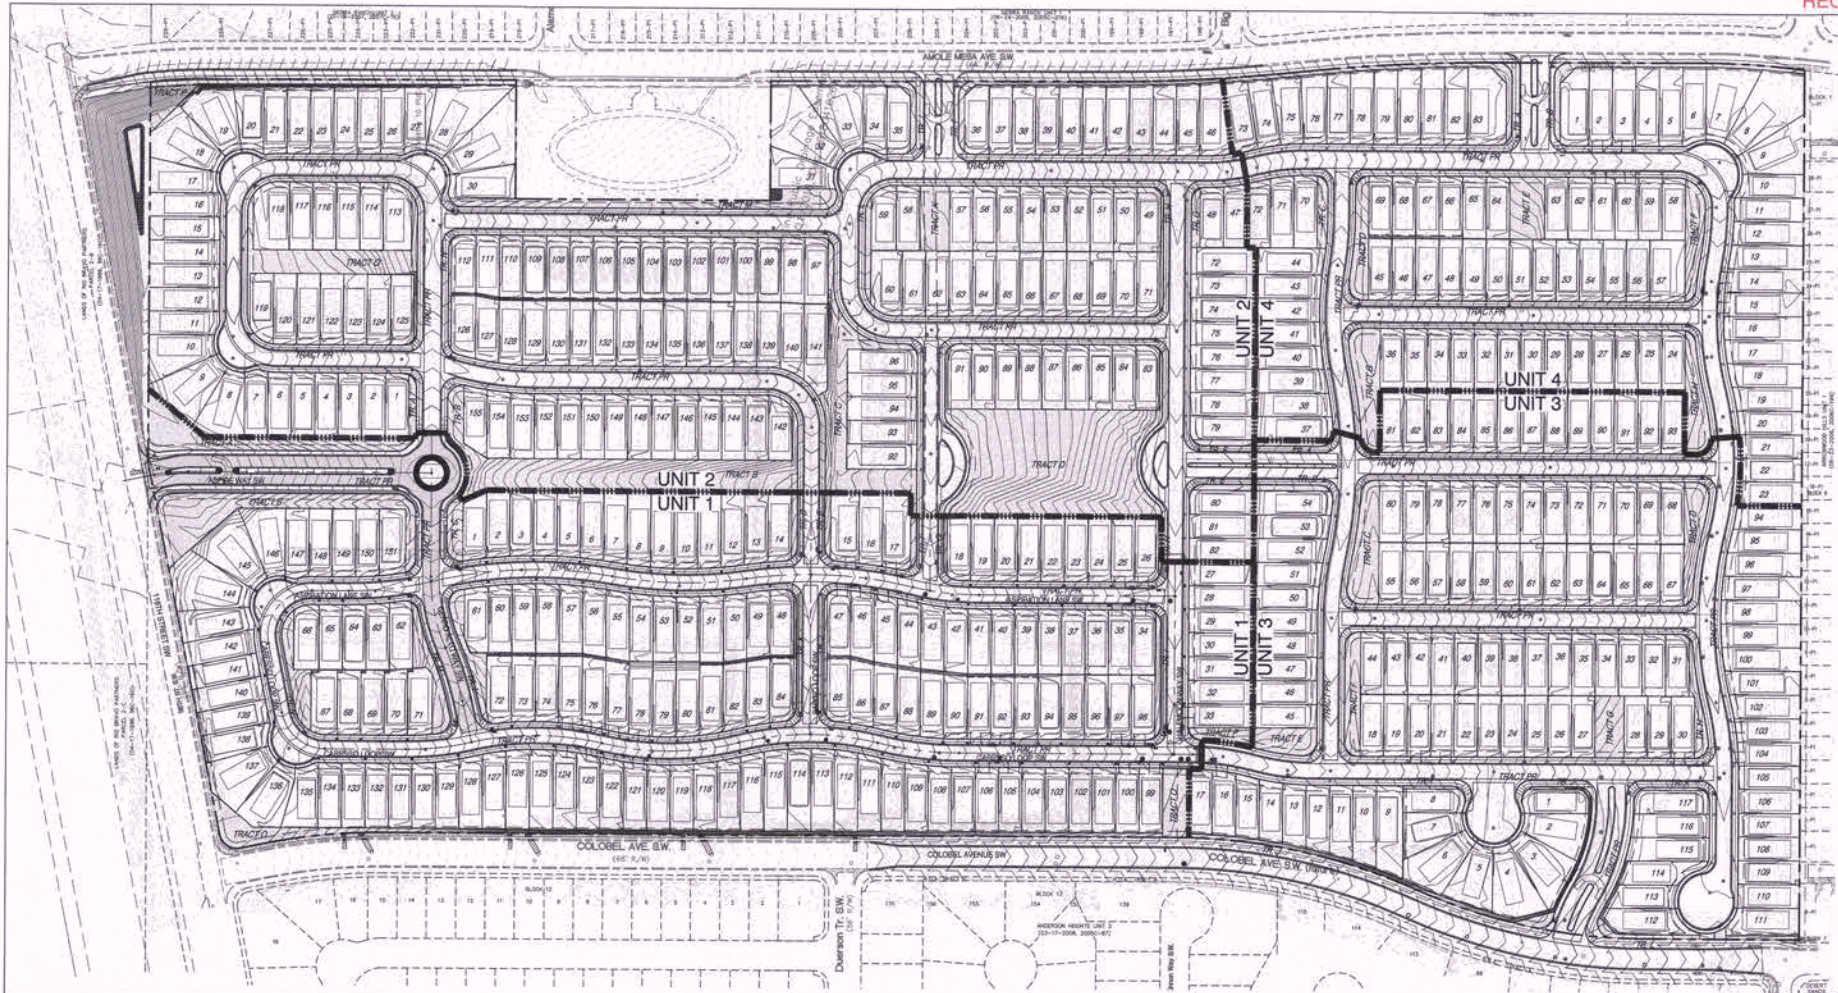

SITE KEY

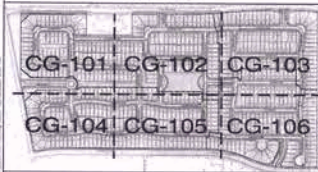

GENERAL NOTES

- GRADING SHALL BE PERFORMED AT THE ELEVATIONS AND IN ACCORDANCE WITH THE DETAILS SHOWN ON THIS PLAN.
- ALL SITE PREPARATION, GRADING OPERATIONS, FOUNDATION CONSTRUCTION, AND PAVEMENT INSTALLATION WORK SHALL BE CONSTRUCTED IN ACCORDANCE WITH THE GEOTECHNICAL REPORT, WHICH WILL BE PROVIDED BY THE OWNER. ALL OTHER WORK SHALL, UNLESS OTHERWISE NOTED IN THE PLANS, BE CONSTRUCTED IN ACCORDANCE WITH THE CITY OF ALBUQUERQUE STANDARD SPECIFICATIONS FOR PUBLIC WORKS CONSTRUCTION.
- PROPOSED SPOT AND CONTOUR ELEVATIONS SHOWN REPRESENT TOP OF FINISH MATERIAL (I.E. TOP OF CONCRETE, TOP OF CONCRETE BUILDING PAD, TOP OF PAVEMENT MATERIAL, TOP OF LANDSCAPING MATERIAL, ETC.). CONTRACTOR SHALL GRADE, COMPACT, SUBGRADE AND DETERMINE EARTHWORK ESTIMATES BASED ON ELEVATIONS SHOWN MINUS FINISH MATERIAL THICKNESSES.
- IF FIELD GRADE ADJUSTMENTS ARE REQUIRED, THE CONTRACTOR SHALL NOTIFY THE ENGINEER.
- THE ENVIRONMENTAL PROTECTION AGENCY (EPA) AND THE CITY OF ALBUQUERQUE REQUIRE A STORM WATER POLLUTION PREVENTION PLAN (SWPPP), AN NPDES PERMIT FOR PROJECTS WHERE CONSTRUCTION ACTIVITIES MEET THE EPA THRESHOLD. (SWPPP, NPDES PERMIT BY OTHERS). CONTRACTOR SHALL COORDINATE WITH OWNER TO DETERMINE WHO WILL PREPARE SWPPP AND INSPECT REQUIRED ELEMENTS.
- ALL NEW PAVEMENT SURFACES SHALL BE CONSTRUCTED WITH POSITIVE SLOPE AWAY FROM BUILDINGS AND POSITIVE SLOPE TOWARD EXISTING AND/OR PROPOSED DRAINAGE PATHS. PAVING AND ROADWAY GRADES SHALL BE $\pm 0.1'$ FROM PLAN ELEVATIONS. BUILDING PAD ELEVATION SHALL BE $\pm 0.05'$ FROM PLAN ELEVATION.
- WHERE GRADES BETWEEN NEW AND EXISTING ARE SHOWN AS "MATCH" OR "S", TRANSITIONS SHALL BE SMOOTH.
- PAD ELEVATIONS SHALL BE WITHIN 0.1%.
- POND DESIGN PARAMETERS AND STORMWATER CONTROL MEASURES SHOWN ON THIS PLAN (TOP OF POND, BOTTOM OF POND, SIZE OF ORIFICE, AREA OF POND, ETC.) TO BE STRICTLY ADHERED TO FOR CERTIFICATION PURPOSES. SEE DETAIL SHEET FOR ADDITIONAL INFORMATION.
- POST-CONSTRUCTION MAINTENANCE FOR PRIVATE STORMWATER FACILITIES WILL BE THE RESPONSIBILITY OF THE FACILITIES OWNER. ENGINEER RECOMMENDS THAT OWNER INSPECT SITE YEARLY AND AFTER EACH RAINFALL TO IDENTIFY NEW AREAS OF EROSION AND INSTALL ADDITIONAL EROSION PROTECTION AS NEEDED BASED ON ACTUAL OCCURRENCES.
- EXISTING UTILITY LINES ARE SHOWN IN AN APPROXIMATE MANNER ONLY AND MAY BE INCOMPLETE OR OBSOLETE. SUCH LINES MAY OR MAY NOT EXIST WHERE SHOWN OR NOT SHOWN. CONTRACTOR SHALL CONTRACT M-81 FOR UTILITY LINE SPOTS FIVE WORKING DAYS PRIOR TO COMMENCEMENT OF ANY CONSTRUCTION. CONTRACTOR IS FULLY RESPONSIBLE FOR ANY AND ALL DAMAGE CAUSED BY ITS FAILURE TO LOCATE, IDENTIFY AND PRESERVE ANY AND ALL EXISTING UTILITIES, PIPELINES, AND UNDERGROUND UTILITY LINES. THE CONTRACTOR SHALL BE RESPONSIBLE FOR COORDINATION OF NECESSARY DRY UTILITY ADJUSTMENTS.
- FOR ENGINEER'S CERTIFICATION OF SUBSTANTIAL COMPLIANCE (FOR CERTIFICATE OF OCCUPANCY) CONTRACTOR SHALL PROVIDE AN AUTOCAD FORMAT AS-BUILT SURVEY PREPARED BY A LICENSED SURVEYOR WHICH INCLUDES:
 - AS-BUILT SPOT ELEVATIONS AT EACH DESIGN SPOT ELEVATION SHOWN ON THE APPROVED PLAN;
 - TOP AND BOTTOM ELEVATIONS AS REQUIRED TO DEFINE THE PERIMETER OF PONDS (TO BE USED BY ENGINEER TO CALCULATE AS-BUILT VOLUME PROVIDED);
 - ALL CONSTRUCTION, INCLUDING DRAIN INLETS, PIPES AND PONDS SHOWN ON THIS PLAN MUST BE CONSTRUCTED IN SUBSTANTIAL COMPLIANCE WITH THE APPROVED PLAN IN ORDER TO RECEIVE ENGINEER'S CERTIFICATION.
- UPON WRITTEN REQUEST, THE ELECTRONIC FILE OF THE GRADING AND DRAINAGE WILL BE PROVIDED TO THE CONTRACTOR FOR VERTICAL CONTROL.
- SITE CONSTRUCTION LAYOUT / STAKING SHALL BE COORDINATED WITH THE OWNER.

VICINITY MAP





Isaacson & Artman, Inc.
Civil Engineering Consultants

128 Monroe Street NE
Albuquerque, NM 87109
505-268-8828 | www.iacivil.com

ASPIRE SUBDIVISION
UNITS 1-4
SUCCESS LAND HOLDINGS, LLC

OVERALL GRADING & DRAINAGE PLAN

Date:	08/20/20	Revised:	12/20/20	Job No.:	2290
Drawn By:	thor	Checked By:		Project:	CG-100
Old By:	AKW	Scale:	1"=100'	Sheet:	SH OF



KEYED NOTES

1. TURN EVERY OTHER BLOCK OVER 10' TO PROVIDE OPENINGS FOR DRAINAGE.
2. GRADE RETENTION POND PER PLAN AT 3:1 SIDE SLOPES. DO NOT COMPACT POND BOTTOM. PLACE 1" THICK 4" AVG. DIA (4"-6") FRACTURED FACE ROCK OVER NON-WOVEN GEOTEXTILE FABRIC ON SIDE SLOPES FROM BOTTOM ELEV.=54.0 TO TOP ELEV.=56.3. SEE SECTION 5-D ON SHEET CG-501.

LEGEND

- EXISTING CONTOUR
- EXISTING SPOT ELEVATION
- PROPOSED CONTOUR
- PROPOSED SPOT ELEVATION
- PAD GRADE ELEVATION
- FLOW ARROW
- STORM DRAIN
- STORM INLET
- RETAINING WALL


SITE KEY

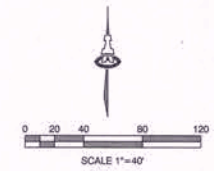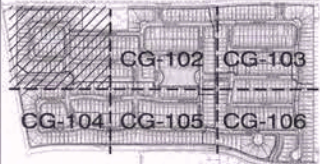

The design, calculations, and contents are owned by and remain the property of Isaac & Arfman, Inc., and no part thereof shall be utilized by any person, firm or corporation for any purpose whatsoever without the written permission of Isaac & Arfman, Inc. ©

**ASPIRE SUBDIVISION
UNITS 1-4**
SUCCESS LAND HOLDINGS, LLC

Grading & Drainage Plan 1			
Drawn By	Thor	Job No.	2280
Check By	ANW	Sheet	CG-101
City	Albuquerque	Scale	1"=40'

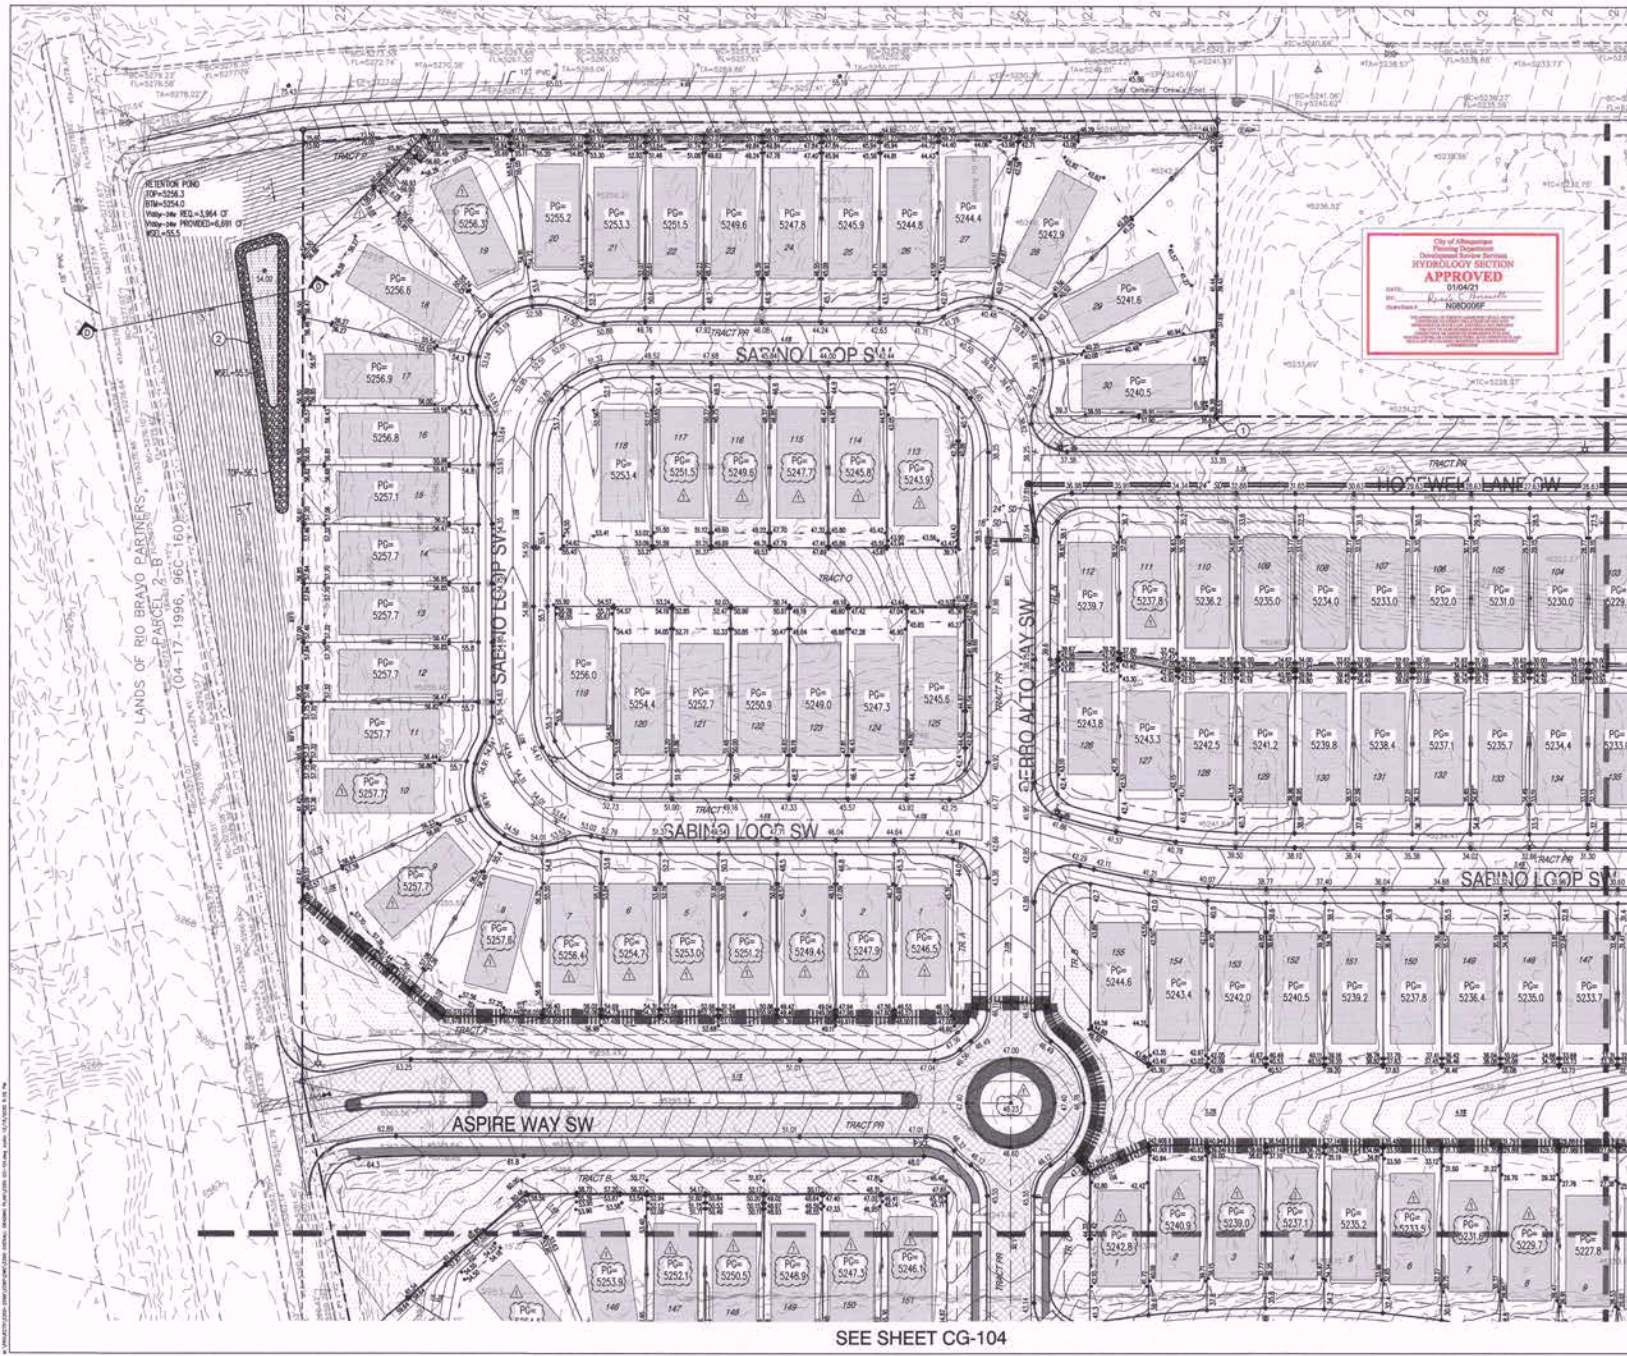











SEE SHEET CG-102

SEE SHEET CG-104



SEE SHEET CG-101



LEGEND

- | | |
|---|--|
|  | EXISTING CONTOUR |
|  | EXISTING SPOT ELEVATION |
|  | PROPOSED CONTOUR |
|  | PROPOSED SPOT ELEVATION |
|  | PAD GRADE ELEVATION |
|  | FLOW ARROW |
|  | STORM DRAIN |
|  | STORM INLET |
|  | RETAINING WALL |
|  | DRIVEWAY LOCATION DESIGNATED TO AVOID CONFLICT WITH STORM INLETS |

SITE KEY

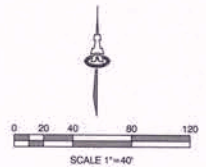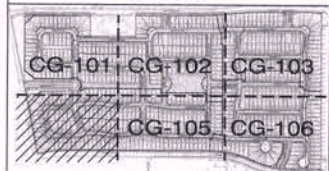
ASPIRE SUBDIVISION
UNITS 1-4

SUCCESS LAND HOLDINGS, LLC

GRADING & DRAINAGE PLAN 4

Date:	No. Revision:	Date:	Job No.
08/2020	1 REVISED LOT GRADES	12/2020	2220
Drawn By:			CG-104
thor			
Old By:			
ANW			SH. OF


CPN# 757580 FOR INFORMATION ONLY SHEET 5 OF 37

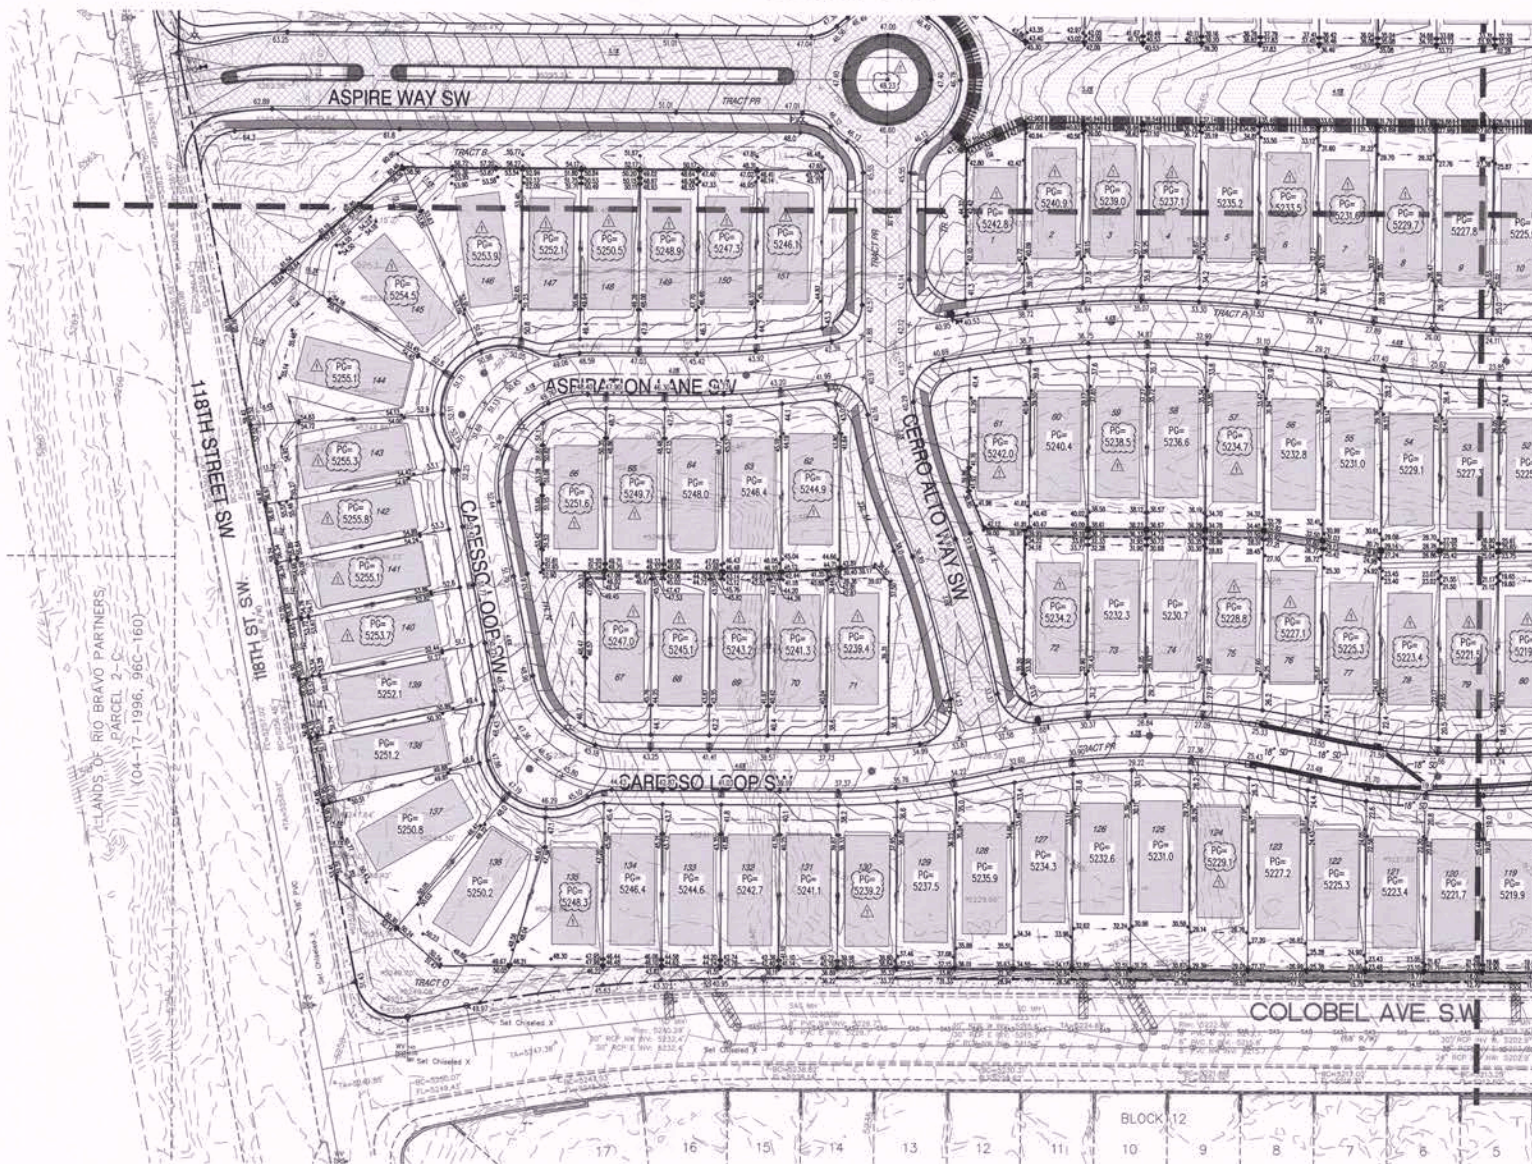

SEE SHEET CG-105

Approved by Alderperson	City Engineer
Design: _____	Date: 08/2020
City Engineer	Drawn By

SEE SHEET CG-102

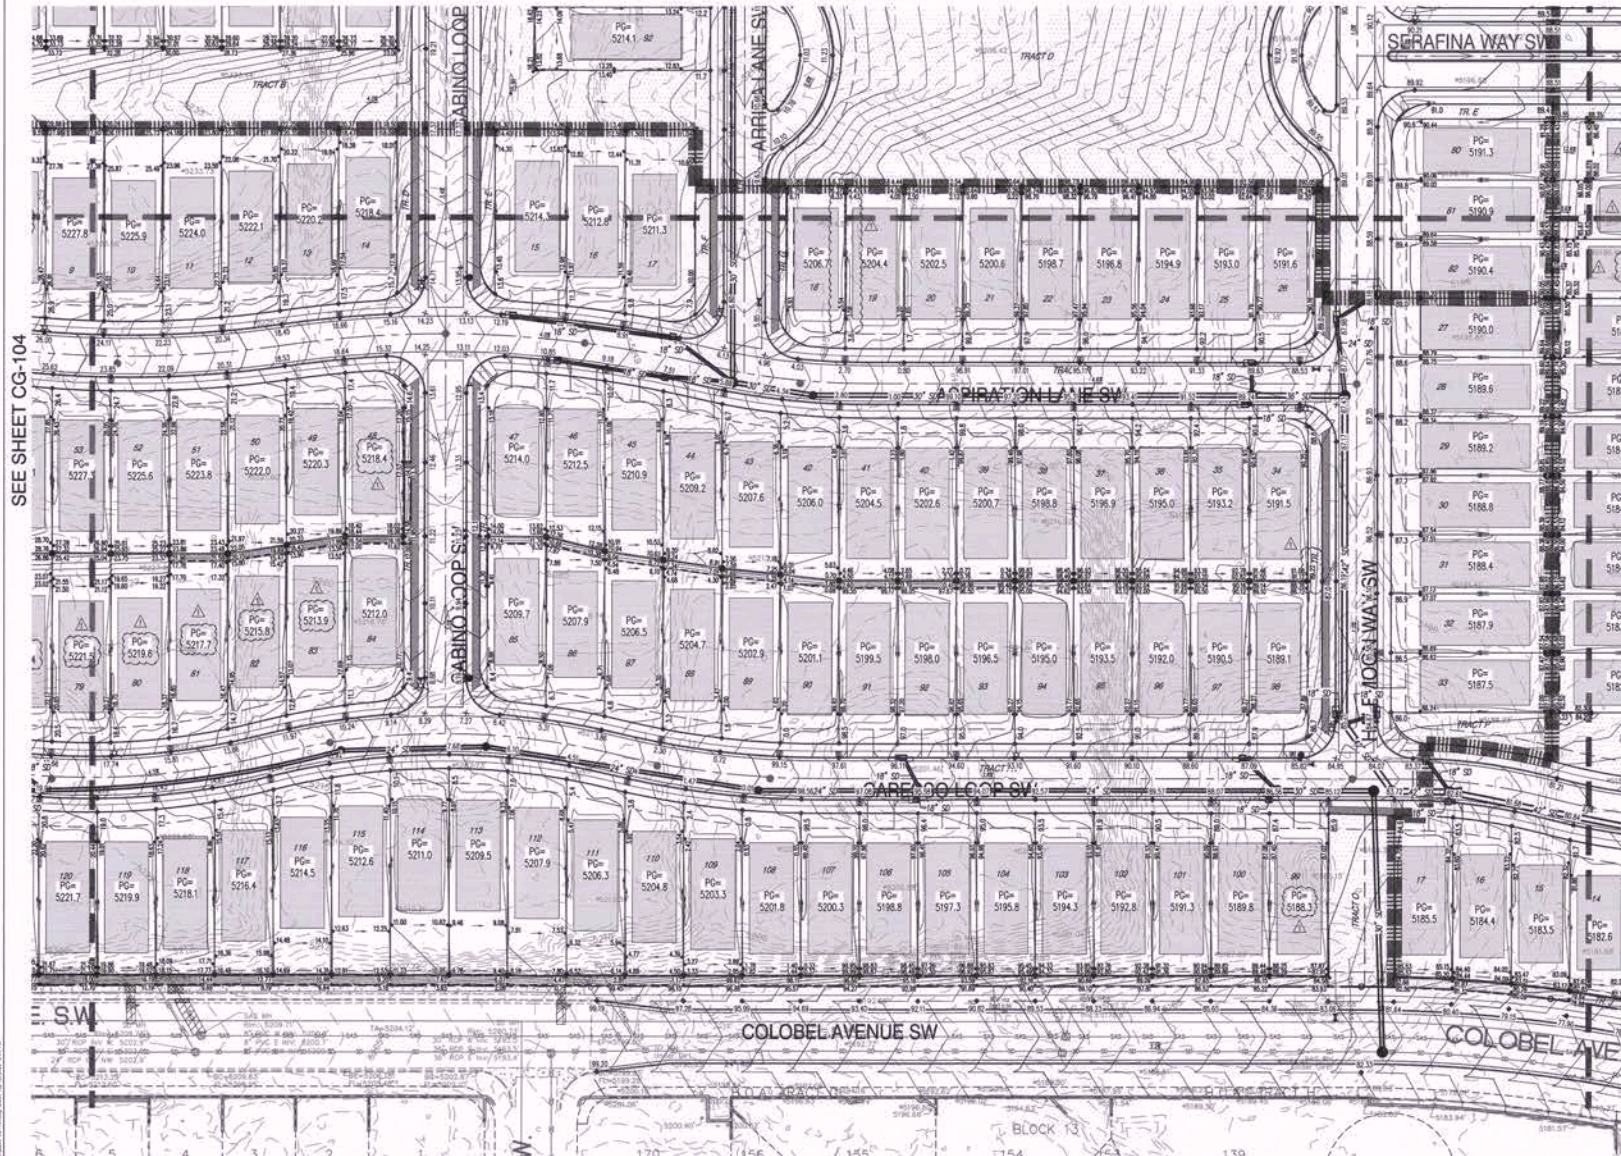

SEE SHEET CG-104



SEE SHEET CG-106



LEGEND

- EXISTING CONTOUR
- EXISTING SPOT ELEVATION
- PROPOSED CONTOUR
- PROPOSED SPOT ELEVATION
- PG= 5240.5 PAD GRADE ELEVATION
- FLOW ARROW
- STORM DRAIN
- STORM INLET
- RETAINING WALL
- DRIVEWAY LOCATION DESIGNATED TO AVOID CONFLICT WITH STORM INLETS

SITE KEY

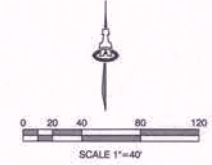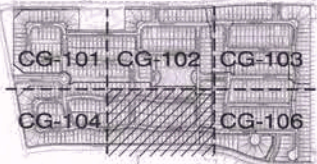


This design, specification, and contract are used by and remain the property of Isaacson & Artman, Inc. and no part thereof shall be utilized by any person, firm, or corporation for any purpose whatsoever without the written permission of Isaacson & Artman, Inc.

ASPIRE SUBDIVISION
UNITS 1-4
SUCCESS LAND HOLDINGS, LLC


GRADING & DRAINAGE PLAN 5

Design	Date	Revised	Date	Job No.
08/2020	08/2020	12/2020	2220	
Drawn By	thor			CG-105
Old By	ANW			SH OF 37

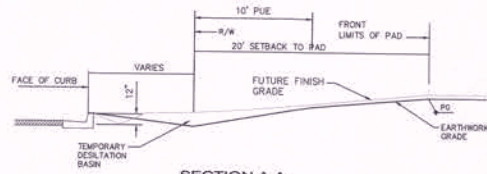


SECTION A-A
FRONT YARD GRADING

SCALE: 1"=5'-0"
FRONT YARD GRADES AT COMMON LOT LINES SHALL BE AT FINISH GRADE TO SET WATER METERS AND DRY UTILITY EQUIPMENT.

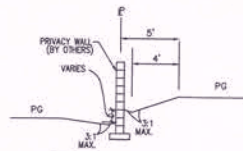


SECTION B-B
TYPICAL SIDEYARD GRADING

SCALE: 1"=5'

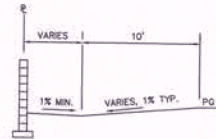


SECTION C-C
TYPICAL BACKYARD GRADING

SCALE: 1"=5'

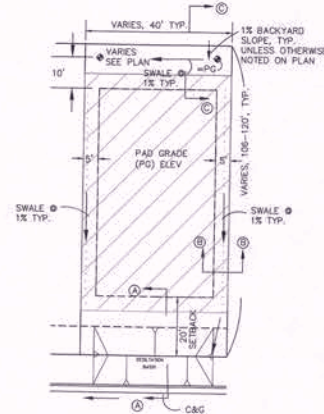


TYPICAL LOT GRADING DETAIL


SCALE: 1"=20' NOTE: 10' SIDEYARD SETBACK ADJACENT TO STREETS.

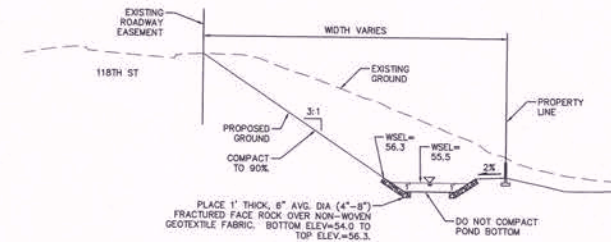

SECTION D-D
SCALES: 1"=20' (HORIZ.)
1"=10' (VERT.)

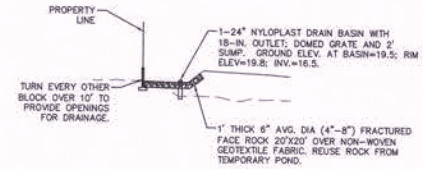

SECTION E-E
SCALES: 1"=20' (HORIZ.)
1"=10' (VERT.)

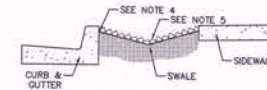


1. SWALE TO BE 6" DEEP WHEN THE DISTANCE BETWEEN BACK OF CURB AND THE SIDE WALK IS 5 FEET.
2. SWALE TO BE 1" DEEPER THAN THE DISTANCE IN FEET BETWEEN THE BACK OF CURB AND THE SIDEWALK FOR LANDSCAPE BUFFERS DIFFERENT THAN 5 FEET WIDE.
3. FOR WIDE LANDSCAPE BUFFERS, GREATER THAN 10 FEET, THE MAXIMUM DEPTH IS 10".
4. FINAL GRADE OF DIRT TO BE 1" TO 2" BELOW TOP OF CURB AND TOP OF SIDEWALK GRADE.
5. SURFACE BETWEEN BACK OF CURB AND SIDEWALK TO BE COVERED WITH GRAVEL, MULCH (MINIMUM 2"), COBBLES OR RIP-RAP. DO NOT FILL ENTIRE SWALE. A CHECK DAM WILL BE REQUIRED FOR SWALES ON STEEPER LONGITUDINAL SLOPES AND LONGER SECTIONS. THE ENGINEER WILL DETERMINE LOCATION.
6. LANDSCAPE FABRIC IS RECOMMENDED, BUT NOT REQUIRED. BETWEEN THE DIRT AND THE STONE, IF LANDSCAPE FABRIC IS TO BE USED, IT IS TO BE PERMEABLE.
7. DETAIL IS TO BE BUILT WITH ALL NEW HOME CONSTRUCTION. IN THE CASE WHERE SIDEWALK IS EXISTING AND THE LANDSCAPE BUFFER IS IMPROVED WITH LANDSCAPING AND/OR SOME FORM OF EROSION PROTECTION, THIS REQUIREMENT DOES NOT APPLY.

LANDSCAPE BUFFER SWALE
REVISION TO CITY STANDARD DRAWINGS
2405A & 2405B



ASPIRE SUBDIVISION UNITS 1-4 SUCCESS LAND HOLDINGS, LLC			
GRADING & DRAINAGE DETAILS			
Design	10/2020	11/2020	12/2020
Drawn By	thor		
Check By	ANW		
Job No.	CG-501		
Scale	SH OF		

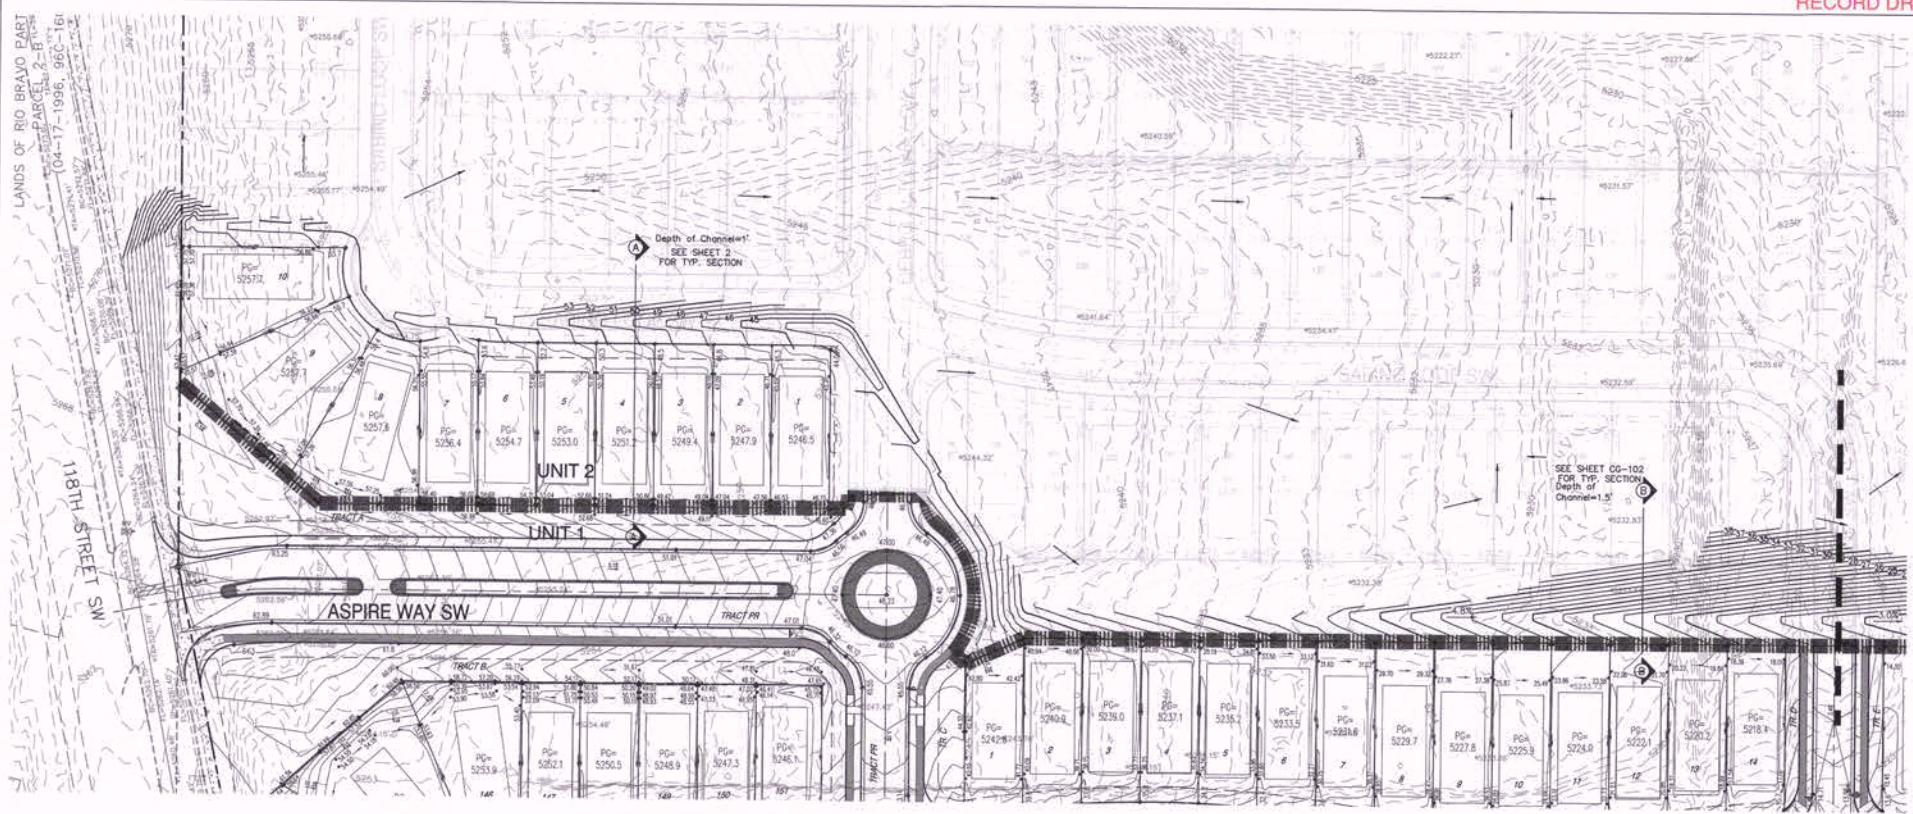

STORM WATER QUALITY VOLUMES


UNIT 1 STORM WATER QUALITY VOLUMES (SWQV) IN-LEU FEE SHALL BE PAID FOR THE VOLUME DISCHARGED TO THE EASEMENT STORM DRAIN SYSTEM.

THE REMAINING UNIT 1 SWQV SHALL BE PAID WITH UNIT 2 WHEN THE INTERIM POND IS FILLED IN AND THE CRESTONE STORM DRAIN SYSTEM IS CONSTRUCTED.

UNIT 1 STORM WATER QUALITY VOLUMES					
NO.	AREA (AC)	NO.	DEPTH (IN)	WATER QUAL. VOLUME (CU)	
REF. 1001	10.000	10.00	1.00	0.10	
TOTAL UNIT 1					
TOTAL UNIT 1	10.000	10.00	1.00	0.10	
TOTAL UNIT 1	10.000	10.00	1.00	0.10	
REMARKS: UNIT 1					
REMARKS: UNIT 2					

GENERAL NOTES

- UNDISTURBED AREAS:** PRIOR TO GRADING, BRUSH REMOVAL, OR SITE CONSTRUCTION, THE CONTRACTOR SHALL COORDINATE WITH THE DEVELOPER AT THE SITE TO ASCERTAIN THE AREAS OF THE PROJECT SITE THAT ARE TO BE PROTECTED AND PRESERVED.
- TESTING:** ALL EARTHWORK OPERATIONS SHALL BE OBSERVED AND TESTED BY THE GEOTECHNICAL ENGINEER FOR CONFORMANCE WITH THE REQUIREMENTS SET FORTH IN THE GEOTECHNICAL STUDY.
- STRIPPING AND DEBRIS REMOVAL:** THE BUILDING PAD SITES, AREAS TO BE PAVED, AND ALL AREAS THAT ARE TO RECEIVE FILL MATERIAL SHALL BE STRIPPED OF VEGETATION, TREES, ROOTS, STUMPS, DEBRIS, AND OTHER ORGANIC MATERIAL. THE DEPTH OF STRIPPING IS ESTIMATED TO BE ON THE ORDER OF SIX (6) INCHES IN ORDER TO REMOVE THE SURFACE SOIL CONTAINING ORGANIC MATERIAL. THE ACTUAL STRIPPING DEPTH SHALL BE BASED ON FIELD OBSERVATIONS. STRIPPED TOPSOIL SHALL BE STOCKPILED IN A LOCATION ON-SITE APPROVED BY THE DEVELOPER. ALL WASTE PRODUCTS FROM THE CONSTRUCTION SITE SHALL BE APPROPRIATELY DISPOSED OF OFF-SITE. IT SHALL BE THE CONTRACTOR'S RESPONSIBILITY TO OBTAIN PERMITS REQUIRED TO HAIL OR DISPOSE OF WASTE PRODUCTS. IT SHALL BE THE CONTRACTOR'S RESPONSIBILITY TO ENSURE THAT THE WASTE DISPOSAL SITE COMPLIES WITH GOVERNMENT REGULATIONS. ALL COSTS ASSOCIATED WITH DISPOSAL OF MATERIAL SHALL BE INCLUDED IN THE CONTRACT AMOUNT.
- PROOF ROLLING:** UPON COMPLETION OF STRIPPING OPERATIONS, AND PRIOR TO PLACEMENT OF ANY FILL MATERIALS, THE STRIPPED AREAS SHOULD BE OBSERVED TO DETERMINE IF ADDITIONAL EXCAVATION IS REQUIRED TO REMOVE WEAR OR OTHERWISE OBJECTIONABLE MATERIALS THAT WOULD ADVERSELY AFFECT THE FILL PLACEMENT. THE SUBGRADE SHOULD BE FIRM AND ABLE TO SUPPORT CONSTRUCTION EQUIPMENT WITHOUT DISPLACEMENT. SOFT OR YIELDING SUBGRADE SHOULD BE CONNECTED AND MADE STABLE BEFORE CONSTRUCTION PROCEEDS. PROOF ROLLING SHOULD BE PERFORMED USING A HEAVY PNEUMATIC TIRE ROLLER, LOADED DUMP TRUCK, OR SIMILAR PIECE OF EQUIPMENT WEIGHING AT LEAST 20 TONS. THE PROOF ROLLING OPERATIONS SHOULD BE OBSERVED BY THE GEOTECHNICAL ENGINEER OR HIS REPRESENTATIVE.
- UNSTABLE MATERIAL:** WHEN CLAY OR OTHER UNSTABLE MATERIAL IS PRESENT IN AREAS OF PROPOSED BUILDING PADS OR PAVED AREAS, THE GEOTECHNICAL ENGINEER SHALL OBSERVE THE STABILITY OF ANY EXISTING CLAY OR WEATHERED MATERIAL THAT IS PRESENT IN THE SUBGRADE, AND SHALL DETERMINE WHETHER ADDITIONAL EXCAVATION OF THESE MATERIALS WILL BE REQUIRED. IF THIS MATERIAL IS DEEMED SUITABLE FOR SUBGRADE MATERIAL, THE SUBGRADE SHALL BE SCARIFIED TO A DEPTH OF EIGHT (8) INCHES. ITS MOISTURE CONTENT ADJUSTED AS RECOMMENDED BY THE GEOTECHNICAL ENGINEER, AND THEN RE-COMPACTED TO ONE HUNDRED (100) PERCENT OF THE OPTIMUM DENSITY DETERMINED BY THE STANDARD PROCTOR TEST, ASTM D 1557.
- CONTROLLED FILL:** ALL SOILS USED FOR CONTROLLED FILL SHALL BE FREE OF ROOTS, VEGETATION, AND OTHER DELETERIOUS OR UNDESIRABLE MATTER. ROCKS LESS THAN 4 INCHES IN LARGEST DIMENSION WITHIN 15" OF PROPOSED SUBGRADE ELEVATION, LESS THAN 4 INCHES IN SIZE FROM 15" TO 36" OF PROPOSED SUBGRADE ELEVATION, LESS THAN 12 INCHES IN SIZE FROM 36" TO 12" OF PROPOSED SUBGRADE ELEVATION, AND LESS THAN 18 INCHES IN LARGEST DIMENSION FOR FILLS IN EXCESS OF 12" FROM SUBGRADE ELEVATION, WILL BE ALLOWED AS ACCEPTABLE FILL MATERIAL. ROCK FILLS SHOULD BE SUPPLEMENTED WITH A SUFFICIENT AMOUNT OF FINE MATERIAL TO PREVENT VOIDING. SOILS IMPORTED FROM OFF-SITE FOR USE AS FILL SHOULD BE APPROVED BY THE GEOTECHNICAL ENGINEER. THE FILL MATERIAL SHOULD BE PLACED IN LEVEL, UNIFORM LIFTS, WITH EACH LIFT COMPACTED TO MINIMUM DRY DENSITY WITHIN THE COMPACTION SOIL MOISTURE RANGES RECOMMENDED. THE LOOSE LIFT THICKNESS SHOULD NOT EXCEED 10 INCHES. EACH LAYER SHOULD BE PROPERLY PLACED, MIXED, SPREAD, AND COMPACTED TO BETWEEN 90 AND 100 PERCENT OF STANDARD PROCTOR DENSITY AS DETERMINED BY ASTM D 1557.
- PROPOSED GRADES:** THE PROPOSED CONTOURS AND SPOT ELEVATIONS INDICATED ON THE GRADING PLAN ARE FINISHED GRADES AND CONTOURS ARE SHOWN AT ONE-FOOT INTERVALS UNLESS NOTED. SPOT ELEVATIONS SHOWN IN PAVED AREAS ARE FLOWLINE, UNLESS NOTED OTHERWISE.
- MASS GRADE ELEVATIONS:** THE CONTRACTOR SHALL BE RESPONSIBLE FOR MASS GRADES OF THE SITE BASED ON THE THICKNESSES PROVIDED FOR HEAVY PAVEMENT, STANDARD PAVEMENT, SIDEWALK, LANDSCAPING, ETC.
- EARTHWORK QUANTITIES:** THE CONTRACTOR SHALL BE RESPONSIBLE FOR CALCULATING THE EARTHWORK QUANTITIES BASED ON THE EXISTING CONTOURS SHOWN ON THESE PLANS. PROPOSED SPOT AND CONTOUR ELEVATIONS SHOWN REPRESENT TOP OF FINISH MATERIAL, I.E. TOP OF CONCRETE, TOP OF BUILDING PAD, TOP OF PAVEMENT MATERIAL, TOP OF LANDSCAPING MATERIAL, ETC.). CONTRACTOR SHALL GRADE, COMPACT SUBGRADE AND DETERMINE EARTHWORK ESTIMATES BASED ON PROPOSED ELEVATIONS SHOWN MINUS FINISH MATERIAL THICKNESSES.
- TRANSITION TO EXISTING:** WHERE GRADES BETWEEN NEW AND EXISTING ARE SHOWN AS MATCH OR 'Y', TRANSITIONS SHALL BE SMOOTH.
- STORMWATER FACILITIES:** POND DESIGN PARAMETERS AND STORMWATER CONTROL MEASURES SHOWN ON THIS PLAN TOP OF POND, BOTTOM OF POND, AREA OF POND, ETC.) TO BE STRICTLY ADHERED TO FOR CERTIFICATION PURPOSES. POST-CONSTRUCTION MAINTENANCE FOR PRIVATE STORMWATER FACILITIES WILL BE THE RESPONSIBILITY OF THE FACILITIES OWNER. PERIODIC INSPECTION AND CERTIFICATIONS OF THE FACILITIES MAY BE REQUIRED. ENGINEER RECOMMENDS THAT OWNER INSPECT SITE YEARLY AND AFTER EACH RAINFALL TO IDENTIFY NEW AREAS OF EROSION AND INSTALL ADDITIONAL EROSION PROTECTION AS NEEDED.
- AS-BUILT SURVEY:** FOR ENGINEER'S CERTIFICATION OF SUBSTANTIAL COMPLIANCE, CONTRACTOR SHALL PROVIDE AN AUTOCAD FORMAT AS-BUILT SURVEY PREPARED BY A LICENSED SURVEYOR WHICH INCLUDES:
 - AS-BUILT SPOT ELEVATIONS AT DESIGN SPOT ELEVATION SHOWN ON THE APPROVED GRADING AND DRAINAGE PLAN;
 - TOP AND BOTTOM AREAS AND ELEVATIONS AS REQUIRED TO CONFIRM THE VOLUMES OF PONDS;
 - ALL CONSTRUCTION, INCLUDING PONDS SHOWN ON THIS PLAN MUST BE CONSTRUCTED IN SUBSTANTIAL COMPLIANCE WITH THE APPROVED PLAN IN ORDER TO RECEIVE ENGINEER'S CERTIFICATION.
- ELECTRONIC FILES:** UPON WRITTEN REQUEST COORDINATED THROUGH THE PROJECT ENGINEER, THE ELECTRONIC FILE OF THE GRADING AND DRAINAGE MAY BE PROVIDED TO THE CONTRACTOR FOR VERTICAL CONTROL.

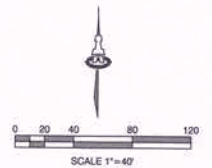



LEGEND

- 52.33.34' --- EXISTING CONTOUR
- 52.40.5 EXISTING SPOT ELEVATION
- PROPOSED CONTOUR
- 52.40.5 PROPOSED SPOT ELEVATION
- PAD GRADE ELEVATION
- FLOW ARROW
- STORM DRAIN
- STORM INLET
- RETAINING WALL
- DRIVEWAY LOCATION DESIGNATED TO AVOID CONFLICT WITH STORM INLETS




ASPIRE SUBDIVISION
UNIT 1 INTERIM GRADING PLAN
 HERITAGE TRAILS DEVELOPMENT I, LLC


NORTHWEST EDGE			
Date	City	Sheet	Job No.
12/20/2009	Albuquerque	CG-101	2379
Drawn by	thor		
Check by	AW		
City	AW		

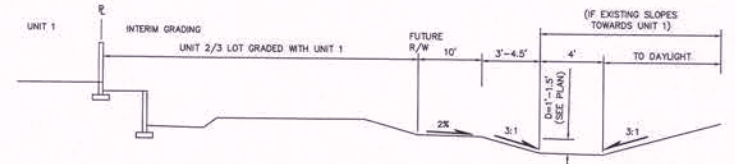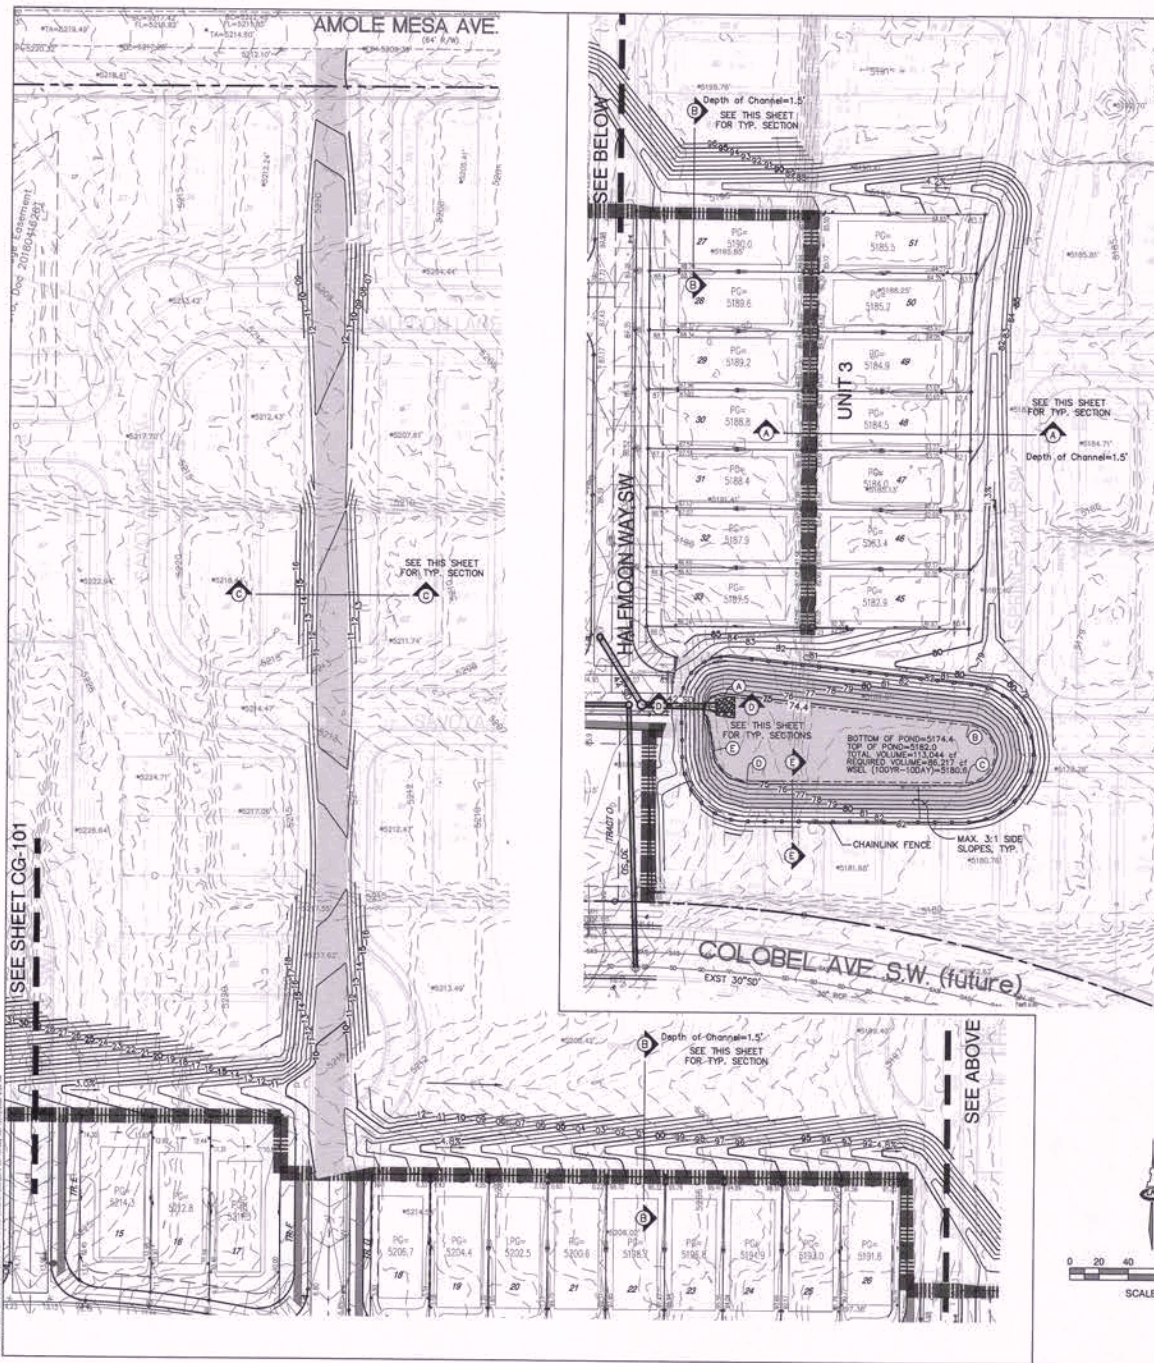


SECTION A-A
NTS

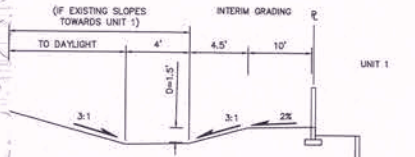


SECTION B-B
NTS

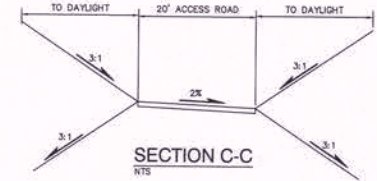

SECTION C-C
NTS

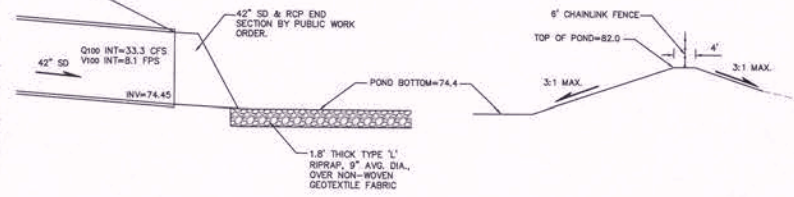

SECTION D-D
NTS

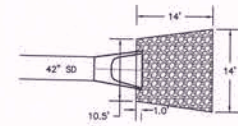

SECTION E-E
NTS



EROSION PROTECTION LIMITS
NTS

GRADING NOTES

- GRADE POND AND CHANNEL SIDE SLOPES AT 3:1 MAX AND COMPACT TO 90%.
- DO NOT COMPACT POND BOTTOM.


POND BOTTOM COORDINATES					
A	X = 1491193.02	Y = 1468019.29	Z = 5174.4		
B	X = 1491360.48	Y = 1468001.53	Z = 5174.4		
C	X = 1491358.43	Y = 1467984.64	Z = 5174.4		
D	X = 1491210.26	Y = 1467982.70	Z = 5174.4		
E	X = 1491186.57	Y = 1467982.90	Z = 5174.4		



ASPIRE SUBDIVISION
UNIT 1 INTERIM GRADING PLAN
HERITAGE TRAILS DEVELOPMENT I, LLC

EAST EDGE & DETAILS

Date	No.	Revision	Date	Job No.
12/2020				2379
Drawn by				CG-102
Check by				SH OF

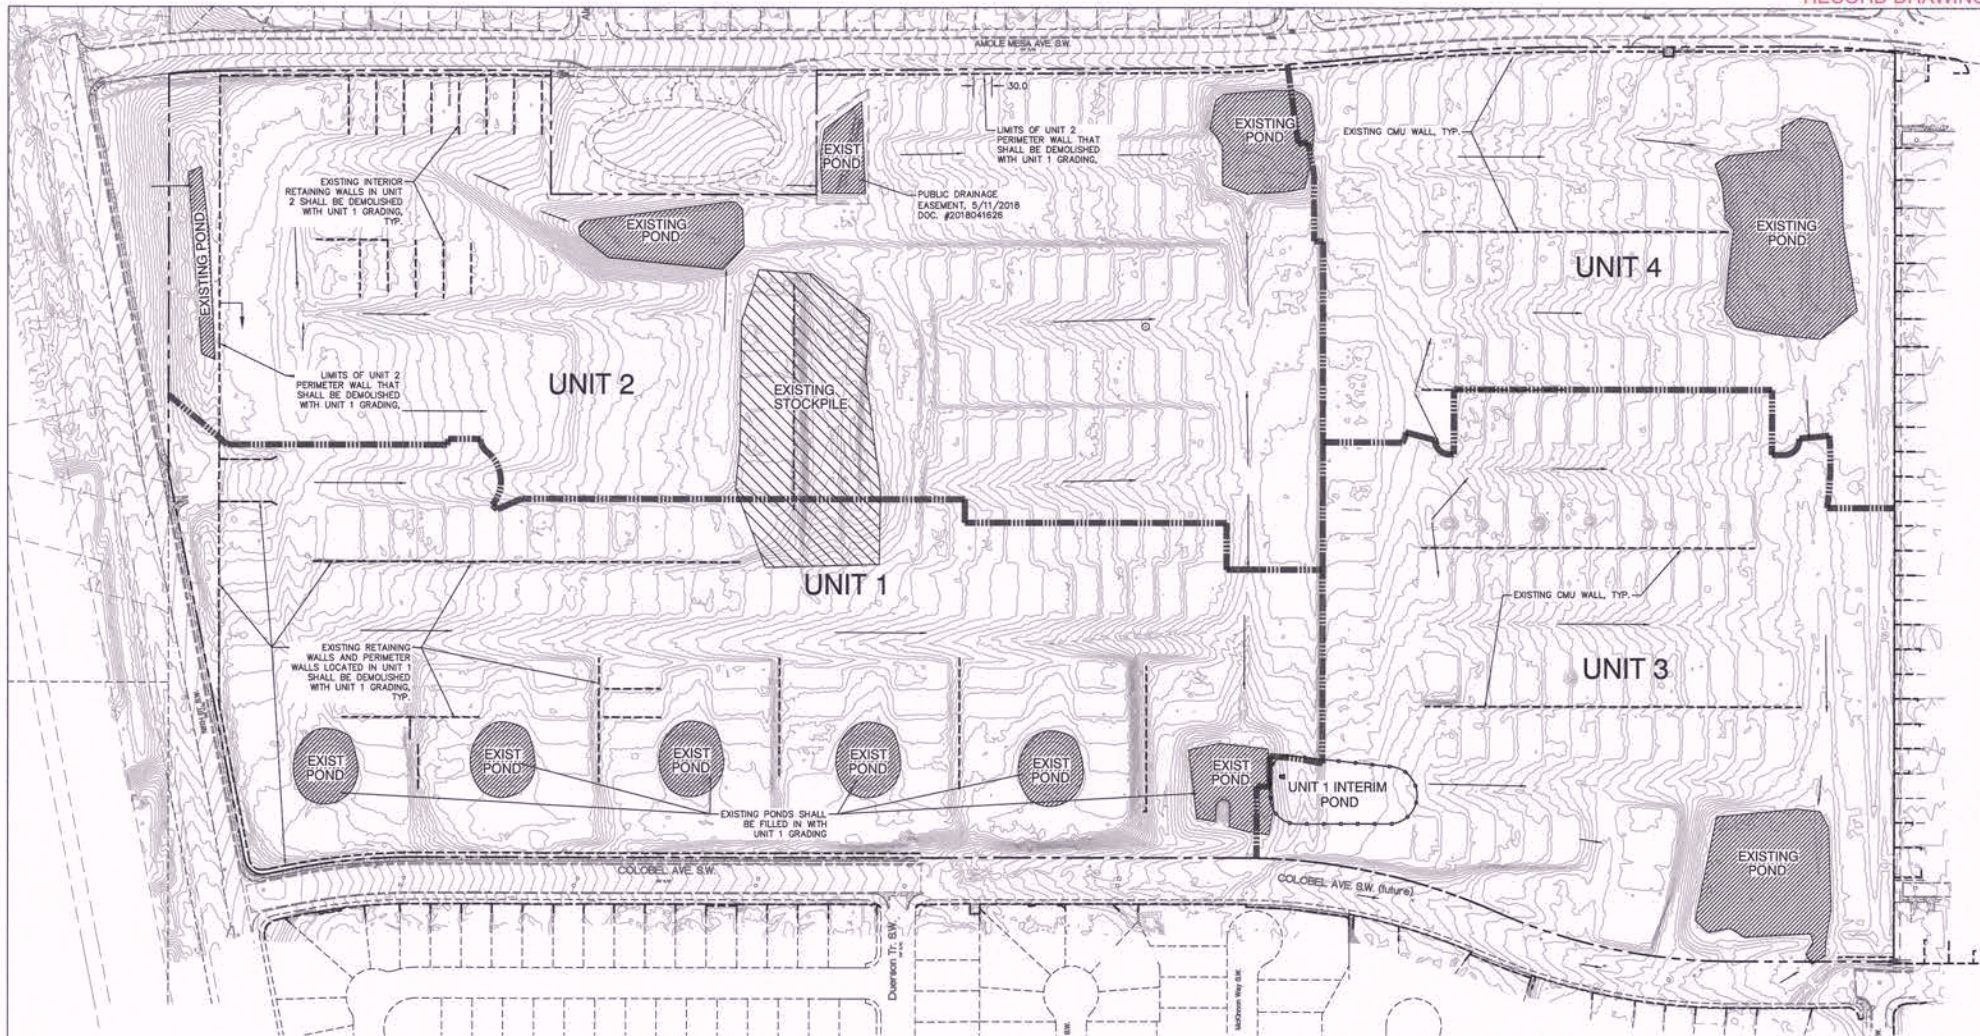

WALL DEMOLITION NOTES

1. ALL WALLS SHALL TO BE DEMOLISHED WITH UNIT 1 ARE NOTED ON PLAN. REMAINING WALLS SHALL REMAIN IN PLACE.
2. THE CONTRACTOR SHALL VERIFY ALL CONDITIONS WITHIN THE CONTRACT LIMITS AND NOTIFY THE ENGINEER IN WRITING OF ANY VIOLATION FROM CONTRACT DOCUMENTS NECESSITATED BY FIELD CONDITIONS OR ITEMS NOT COVERED.
3. ALL DEMOLITION SHALL BE PERFORMED IN A SAFE AND ACCEPTABLE MANNER TO ALL AUTHORITIES HAVING JURISDICTION AND THE OWNER.
4. THOROUGHLY CLEAN ADJACENT AREAS OF DEBRIS CAUSED BY DEMOLITION WORK.
5. PRIOR TO ANY DEMOLITION, THE CONTRACTOR SHALL COORDINATE BRACING AND MAINTAIN THE STRUCTURAL INTEGRITY OF THE WALLS TO REMAIN.
6. THE CONTRACTOR SHALL PROVIDE ALL TEMPORARY BRACING, SHORING, SCAFFOLDING, ETC., WHICH ARE NECESSARY TO PREVENT COLLAPSE, SUBSIDENCE, DEFLECTION OR ANY OTHER TYPE OF DAMAGE.
7. CONTRACTOR SHALL REVIEW ALL WALLS TO BE DEMOLISHED WITH OWNER TO IDENTIFY ANY ITEMS TO BE SALVAGED AND DETERMINE SALVAGE LOCATION. UNSALVAGEABLE WALL BLOCKS AND FOOTINGS SHALL BE REMOVED FROM SITE AND LEGALLY DISPOSED.

POND NOTES

1. ALL PONDS TO BE FILLED IN WITH UNIT 1 ARE NOTED ON PLAN. REMAINING PONDS SHALL REMAIN IN PLACE AND NOT BE DISTURBED.



NTS





The design, construction, and contents are owned by and remain the property of Isaacson & Arfman, Inc. and no part thereof shall be utilized by any person, firm or corporation for any purpose whatsoever without the written permission of Isaacson & Arfman, Inc. ©


ASPIRE SUBDIVISION
UNIT 1 INTERIM GRADING PLAN
 HERITAGE TRAILS DEVELOPMENT I, LLC

EXISTING POND AND WALL PLAN

Date:	No.:	Revision:	Date:	Job No.:
12/2020				2379
Drawn By:				CG-103
Check By:				
App'd By:				SH OF

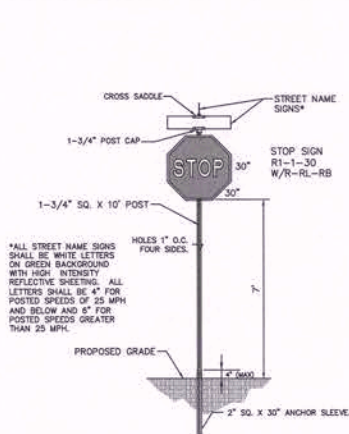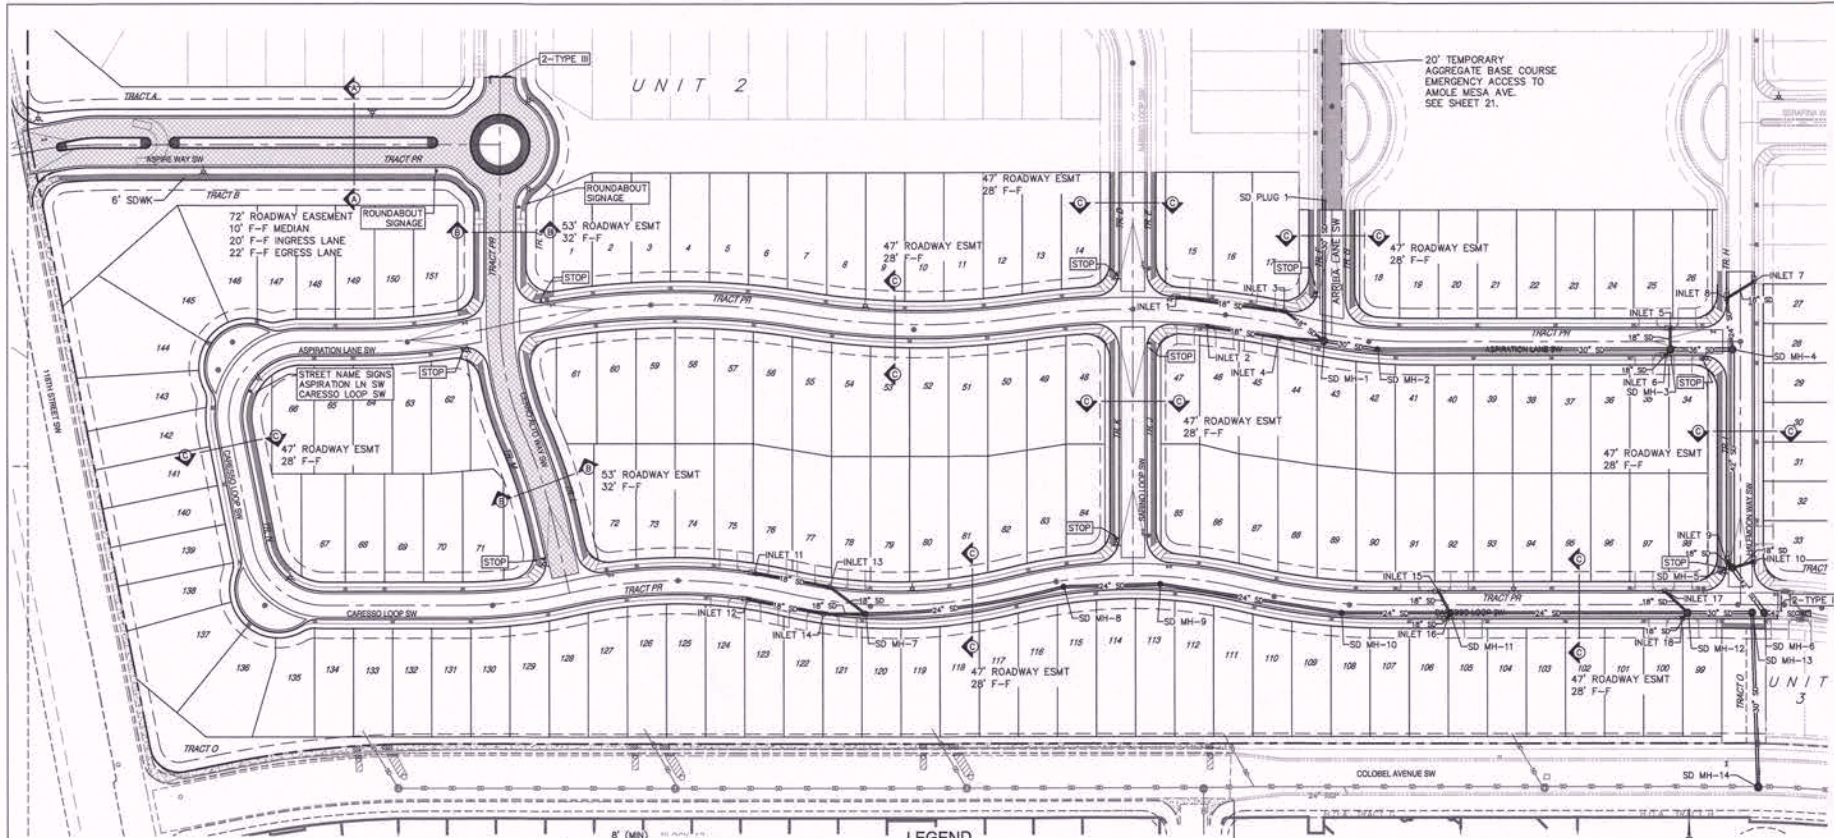

STOP & STREET NAME SIGNS AND SIGN POST DETAIL
NTS

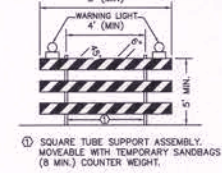

TYPE III BARRICADE
NTS E. END CARESSO LOOP;
N. END CERRO ALTO WAY

YIELD SIGN
R1-2
R/W



ROUNDABOUT SIGNAGE
NTS

LEGEND

- EXISTING STREET IMPROVEMENTS
- PROPOSED STD CURB & GUTTER
- DEFERRED SIDEWALK (BY HOME BUILDER)
- SIDEWALK THIS CONTRACT
- WHEEL CHAIR RAMP
- VALLEY GUTTER
- DRIVEWAY
- CROWN TO NO-CROWN TRANSITION
- 4" MAJOR LOCAL PAVING SECTION
- LOT NO.
- PROPOSED STREET LIGHT-SEE SHEETS XX-XX
- STORM DRAIN INLET
- STORM DRAIN MANHOLE
- STOP & STREET NAME SIGNS
- STREET NAME SIGNS
- ROUNDABOUT SIGNAGE
- 2-TYPE III BARRICADES
- WATER METER
- SAS MANHOLE

GENERAL PAVING NOTES

- A. SEE SHEET 12 FOR STREET SECTIONS AND DETAILS.
- B. CONSTRUCT 4" MAJOR LOCAL ASPHALT PAVING IN CROSS-HATCHED AREAS PER COA STD DWG 2405B.
- C. CONSTRUCT 3" LOCAL ASPHALT PAVING IN ALL OTHER STREETS PER COA STD DWG 2405A.
- D. CONSTRUCT SIDEWALKS PER COA STD DWG 2430, ALL INTERIOR SIDEWALKS ARE 5' WIDE, EXCEPT AT ASPIRE WAY WHERE SIDEWALK IS 6' WIDE AS NOTED ON PLAN.
- E. SIDEWALKS FRONTING LOTS ARE DEFERRED (SEE LEGEND).
- F. CONSTRUCT STANDARD CURB PER COA STD DWG 2415A.
- G. CONSTRUCT CROWN-NO CROWN TRANSITION PER COA STD DWG 2401.
- H. REMOVE & REPLACE PAVING FOR UTILITY CONSTRUCTION PER COA STD DWG 2465.
- I. ALL STREETS AND STORM DRAIN SHALL BE PRIVATELY MAINTAINED.



CITY OF ALBUQUERQUE
PUBLIC WORKS DEPARTMENT
ENGINEERING DEVELOPMENT GROUP
ASPIRE SUBDIVISION, UNIT 1

MASTER PAVING & SIGNAGE PLAN

DESIGN REVIEW COMMITTEE	CITY ENGINEER APPROVAL	Mo./DAY/YR	Mo./DAY/YR
Approved by: [Signature] Design Review Committee and City Engineer June 28, 2021			
City Project No. 757580	Zone Map No. N-8-Z	Sheet 11	Of 37

AS-BUILT INFORMATION	REVISIONS
DATE: 02/20/21 BY: [Signature] CHECKED BY: [Signature]	NO. DATE REVISIONS

FIELD NOTES	ENGINEER'S SEAL
1. (S-CROWN STRIPS SEE 12/2020)	Professional Engineer Seal for [Name], State of New Mexico, No. 147074, Exp. 12/31/2022

AS-BUILT INFORMATION	REVISIONS
DATE: 02/20/21 BY: [Signature] CHECKED BY: [Signature]	NO. DATE REVISIONS

AS-BUILT INFORMATION	REVISIONS
DATE: 02/20/21 BY: [Signature] CHECKED BY: [Signature]	NO. DATE REVISIONS


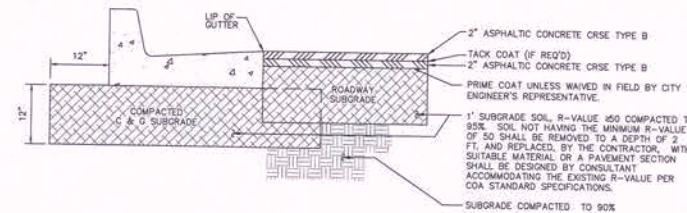

SCALE: 1" = 1'-0"
(PER COA STD DWG # 2405B)

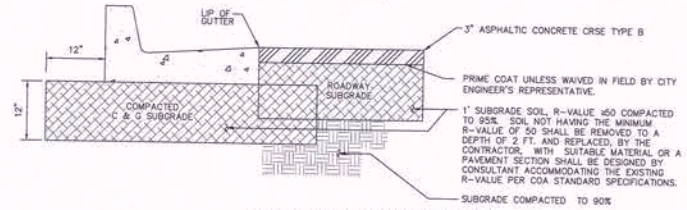


SCALE: 1" = 1'-0"
(PER COA STD DWG # 2405A)

SCALE: 1"=5'
(CERRO ALTO WAY)

Diagram illustrating the dimensions and components of a standard C & G window frame. The frame is shown in cross-section, with dimensions in feet and inches. Key dimensions include:


- Overall width: $2'-7\frac{1}{2}"$
- Overall height: $2'-0"$
- Top rail thickness: $5\frac{1}{2}"$
- Side rail thickness: $2"$
- Bottom rail thickness: $2"$
- Frame components: G&M (Glass and Mullion), E (Ends), H&M (Head and Muntin).
- Frame material: STANDARD C & G.

SEE COA STD DWG #2415A & 2415B
FOR GENERAL NOTES AND
CONSTRUCTION NOTES

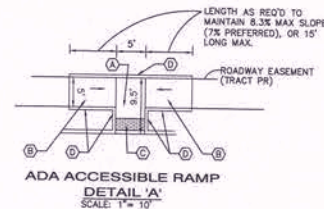

ADA ACCESSIBLE RAMP
DETAIL 'A'
SCALE: 1" = 10'

SCALE: 1"=5'
(ASPRATION LANE, CARESSO LOOP, SABINO LOOP, ARRIBA LANE, HALFMoon WAY)

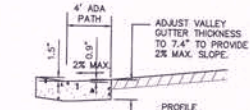

VALLEY GUTTER MODIFICATION
ADA PATH SECTION X-X

1°=4' HOR.
1°=2' VERT

ADA RAMP KEYED NOTES

- GENERAL NOTES

- DETECTABLE WARNING SURFACE (DWS)

- LANDSCAPE BUFFER SWALE
-
- REVISION TO CITY STANDARD DRAWINGS

REVISION TO CITY STANDARD DRAWINGS
2405A & 2405B

SWALE @ DEFERRED SIDEWALKS SHALL BE
CONSTRUCTED BY HOME BUILDER--NOT PART OF
CERTIFICATION FOR PWO.

NOTE:
ALL SIDEWALKS FRONTING LOTS ARE DEFERRED.




Isaacson & Arfman, Inc.
Civil Engineering Consultants

128 Monroe Street NE
Albuquerque, NM 87108
505-268-8828 | www.iacivil.com

CITY OF ALBUQUERQUE
PUBLIC WORKS DEPARTMENT
ENGINEERING DEVELOPMENT GROUP
ASPIRE SUBDIVISION, UNIT 1

STREET SECTIONS AND DETAILS

DESIGN REVIEW COMMITTEE		CITY ENGINEER APPROVAL		LAST DESIGN UPGRADE Mo./DAY/YR Mo./DAY/YR	
Approved by <u>Albuquerque</u> Design Review Committee and City Engineer June 28, 2021					
City Project No. 757580 Zone Map No. N-8-Z					
				Sheet	Of
				12	37

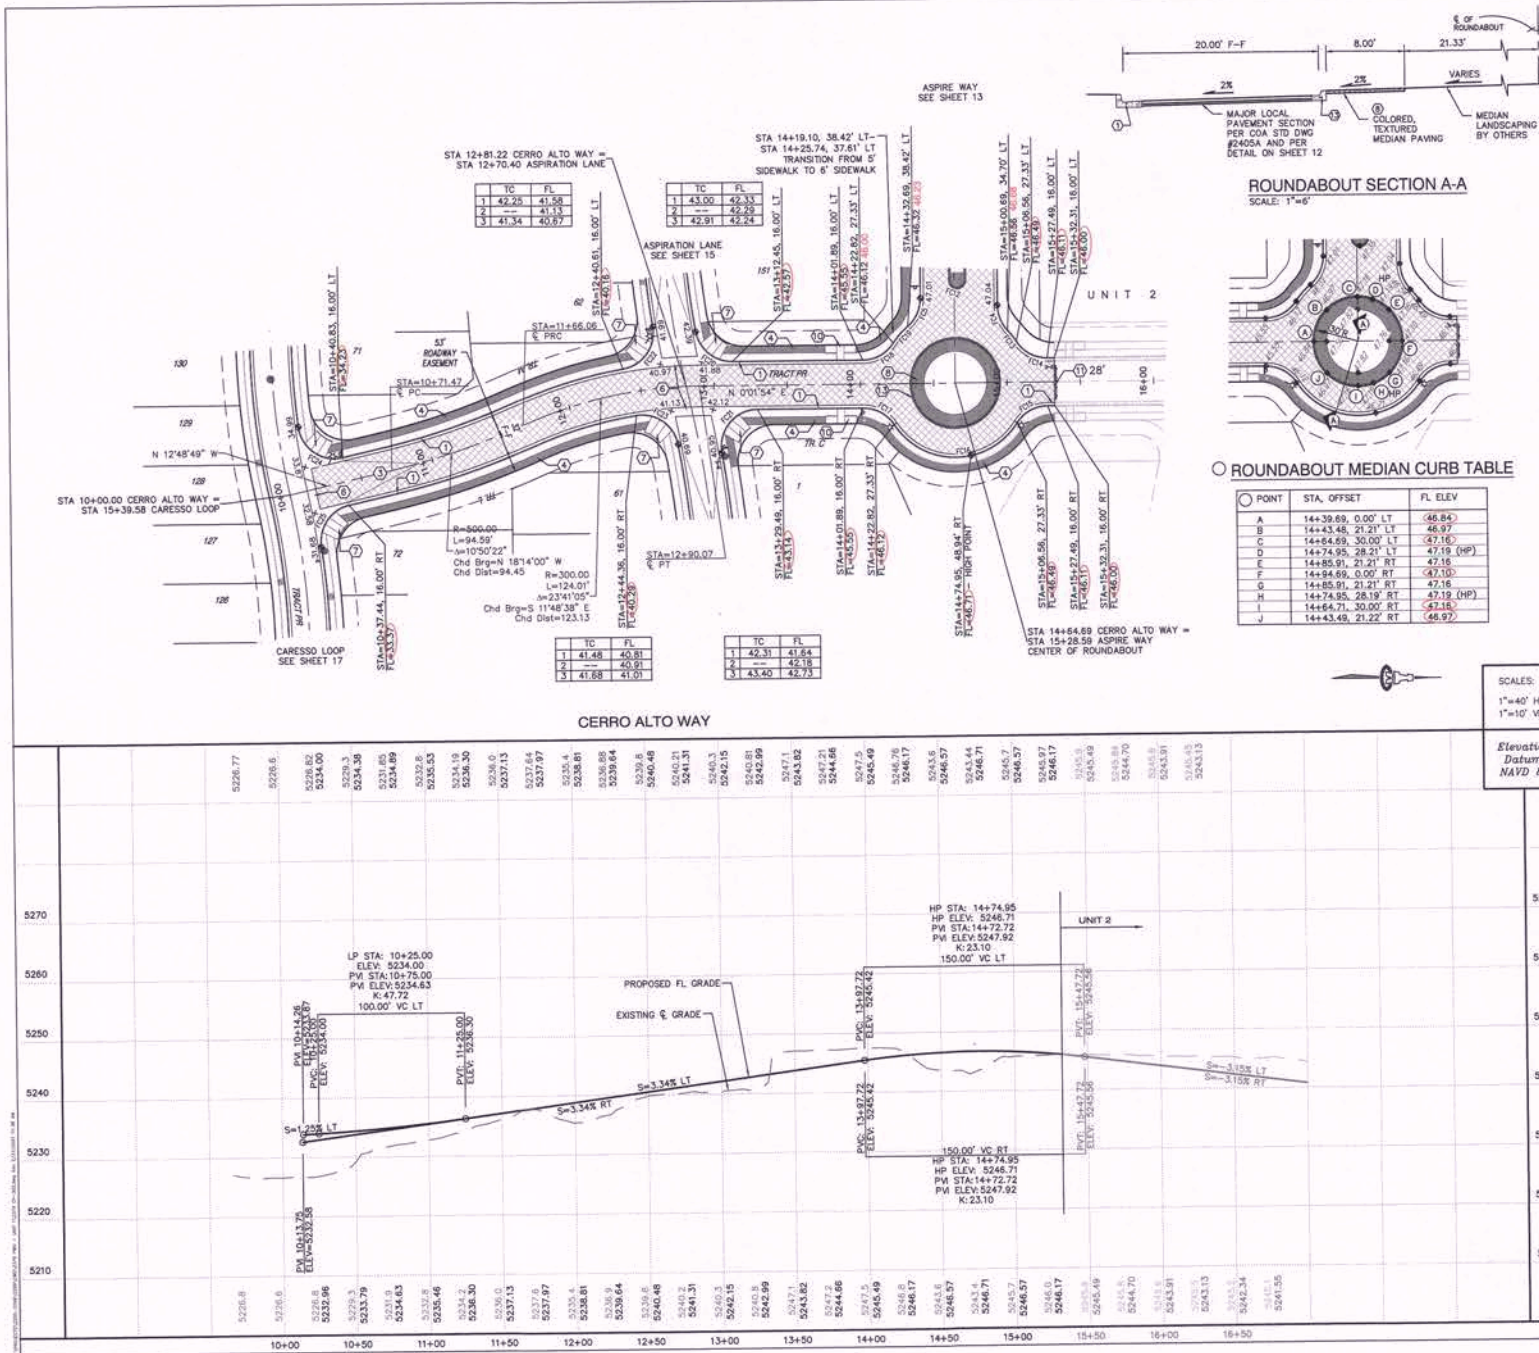

GENERAL NOTES

- CONSTRUCT 4' WIDE ADA PATH BETWEEN ALL ADA RAMPS PER DETAIL ON SHEET 12.
- SIDEWALK CONSTRUCTION IS DEFERRED WHERE NOTED BY *

KEYED CONSTRUCTION NOTES

- CONSTRUCT STANDARD CURB & GUTTER PER DETAIL ON SHEET 12.
- CONSTRUCT MEDIAN CURB & GUTTER PER COA STD DWG #2415B.
- CROWN TO NO-CROWN TRANSITION OVER 50' MIN. PER COA STD DWG #2401.
- 5' SIDEWALK PER COA STD DWG #2430. SEE GENERAL NOTE B.
- CONSTRUCT 6' SIDEWALK PER COA STD DWG #2430. SEE GENERAL NOTE B.
- CONSTRUCT PCC VALLEY GUTTER 6' WIDE, 1 1/2" INVERT PER COA STD DWG #2403. MOODY GUTTER THICKNESS PER DETAIL ON SHEET 12.
- CONSTRUCT ADA RAMP PER COA STD DWG #2441, CASE II. INSTALL CAST IN PLACE REPLACEABLE TRUNCATED CONES, SURVEY SPECIFICATIONS. CONSTRUCTION ENGINEER FOR EVALUATION PRIOR TO CONSTRUCTION.
- CONSTRUCT 4" TEXTURED, COLORED MEDIAN PAVEMENT FROM MEDIAN NOSE TO 15' FROM NOSE. AT ROUNDABOUT INSTALL 8" CONCRETE FROM BACK OF CURB, COLOR AND PATTERN TO BE DETERMINED PRIOR TO PLACEMENT. PAINT MEDIAN NOSE YELLOW TO APPROXIMATELY 6' BEHIND PCC/PT PER COA STD DWGS 2408 & 2502.
- CONSTRUCT PCC VALLEY GUTTER 4' WIDE, 1 1/2" INVERT PER COA STD DWG #2421.
- INSTALL ADA RAMP PER DETAIL 'A' ON SHEET 12.
- CONSTRUCT 24" CUT-UP WALL PER COA STD DWG #2415B.
- INSTALL THERMOPLASTIC MARKINGS:
4" SOLID WHITE STRIPE (45 LFS)
1-RIGHT TURN ARROW
1-LEFT TURN ARROW
- CONSTRUCT MOUNTABLE MEDIAN CURB & GUTTER PER COA STD DWG #2415B.

AS-BUILT INFORMATION

DATE	BY	REVISIONS
02/20/21	ANW	DESIGN
02/02/21	THR	CHKD
02/02/21	ANW	CHKD

ENGINEER'S SEAL

Isaacson & Arfman, Inc.
Civil Engineering Consultants
128 Monroe Street NE
Albuquerque, NM 87108
505-268-8828 | www.isacil.com

CITY OF ALBUQUERQUE

PUBLIC WORKS DEPARTMENT
ENGINEERING DEVELOPMENT GROUP
ASPIRE SUBDIVISION, UNIT 1
CERRO ALTO WAY
PAVING PLAN & PROFILE

DESIGN REVIEW COMMITTEE	CITY ENGINEER APPROVAL	DATE	DATE
		02/24/21	02/24/21

Approved by Albuquerque Design Review Committee and City Engineer June 28, 2021

City Project No. **757580** Zone Map No. **N-8-Z** Sheet **14** of **37**



— — —
MATCHLINE
SEE SHEET 16



128 Monroe Street NE
Albuquerque, NM 87108
505-268-8828 | www.iacivil.com

ASPIRATION LANE
PAVING PLAN & PROFILE

NEW COMMITTEE	CITY ENGINEER APPROVAL	DATE

No.	Zone Map No.
-----	--------------


757580	Zone Map No. N-8-Z	Sheet 15	Of 37
--------	-----------------------	-------------	----------

KEYED CONSTRUCTION NOTES

- A. CONSTRUCT 4' WIDE ADA PATH BETWEEN ALL ADA RAMPS PER DETAIL ON SHEET 12.
 - B. SIDEWALK CONSTRUCTION IS DEFERRED WHERE NOTED BY *
- ## KEYED CONSTRUCTION NOTES
1. CONSTRUCT STANDARD CURB & GUTTER PER DETAIL ON SHEET 12.
 2. CONSTRUCT MEDIAN CURB & GUTTER PER COA STD DWG #2415B.
 3. GROW TO NO-GROWN TRANSITION OVER 50' MIN. PER COA STD DWG #2401.
 4. 5' SIDEWALK PER COA STD DWG #2430. SEE GENERAL NOTE B.
 5. CONSTRUCT 6' SIDEWALK PER COA STD DWG #2430. SEE GENERAL NOTE B.
 6. CONSTRUCT PCC VALLEY GUTTER 6' WIDE, 1 1/2" INVERT PER COA STD DWG #2420. MODIFY GUTTER THICKNESS PER DETAIL ON SHEET 12.
 7. CONSTRUCT ADA RAMP PER COA STD DWG #2441. INSTALL ADA COMPLIANT, 1/2" THICK, REPLACEABLE TRUNCATED DOMES. SUBMIT SPECS TO CONSTRUCTION ENGINEER FOR EVALUATION PER TO CONSTRUCTION.
 8. CONSTRUCT 4' TEXTURED, COLORED MEDIAN PAVEMENT FROM MEDIAN NOSE TO 10' FROM NOSE. AT ROUNDABOUT INSTALL 6" CONCRETE FROM BACK OF CURB. COLOR AND PATTERN TO BE DETERMINED PRIOR TO PLACEMENT. PAVEMENT DEPTH TO APPROXIMATELY 6" AND MATCH PC/PFT PER COA STD DWG 2408 & 2502.
 9. CONSTRUCT PCC VALLEY GUTTER 4' WIDE, 1 1/2" INVERT PER COA STD DWG #2421.
 10. INSTALL ADA RAMP DETAIL "A" ON SHEET 12.
 11. CONSTRUCT 24" CUT-OFF WALL PER COA STD DWG #2415B
 12. INSTALL THERMOPLASTIC MARKINGS:
 - a. SOLID WHITE STRIPE (4S LF±)
 - b. RIGHT TURN ARROW
 - c. LEFT TURN ARROW
 13. CONSTRUCT MOUNTABLE MEDIAN CURB & GUTTER PER COA STD DWG #2415B.

CURVE	LENGTH	RADIUS	DELTA
FC20	34.84'	25.00'	79°51'24"
FC21	43.60'	25.00'	99°54'58"
FC22	39.21'	25.00'	89°52'02"
FC23	38.39'	25.00'	87°59'41"
FC26	16.97'	25.00'	38°53'24"
FC27	114.56'	44.00'	149°10'23"
FC28	16.97'	25.00'	38°53'24"

ENGINEER'S SEAL		SURVEY INFORMATION		BENCH MARKS		AS-BUILT INFORMATION	
BY		FIELD NOTES				CONTRACT NO.	DATE
NO.	DATE	REMARKS:				PROJECT: 15-03-03000 SURVEY INC.	02/20/21
		DESCRIPTION				AGRS MONUMENT AND BENCHMARK "1-NB"	
ENGINEER BY	DATE					FIELD MONUMENT ELEVATION 1460.70' AS	
CHECKED BY	DATE					G-1-0-3 9988971646	
DRAWN BY	DATE					GEN-007 7727.70'	
CHECKED BY	DATE					CENTRAL ZONE	
DRAWN BY	DATE					ELEVATION 5507.25	
CHECKED BY	DATE					(NABBS/ANW288)	

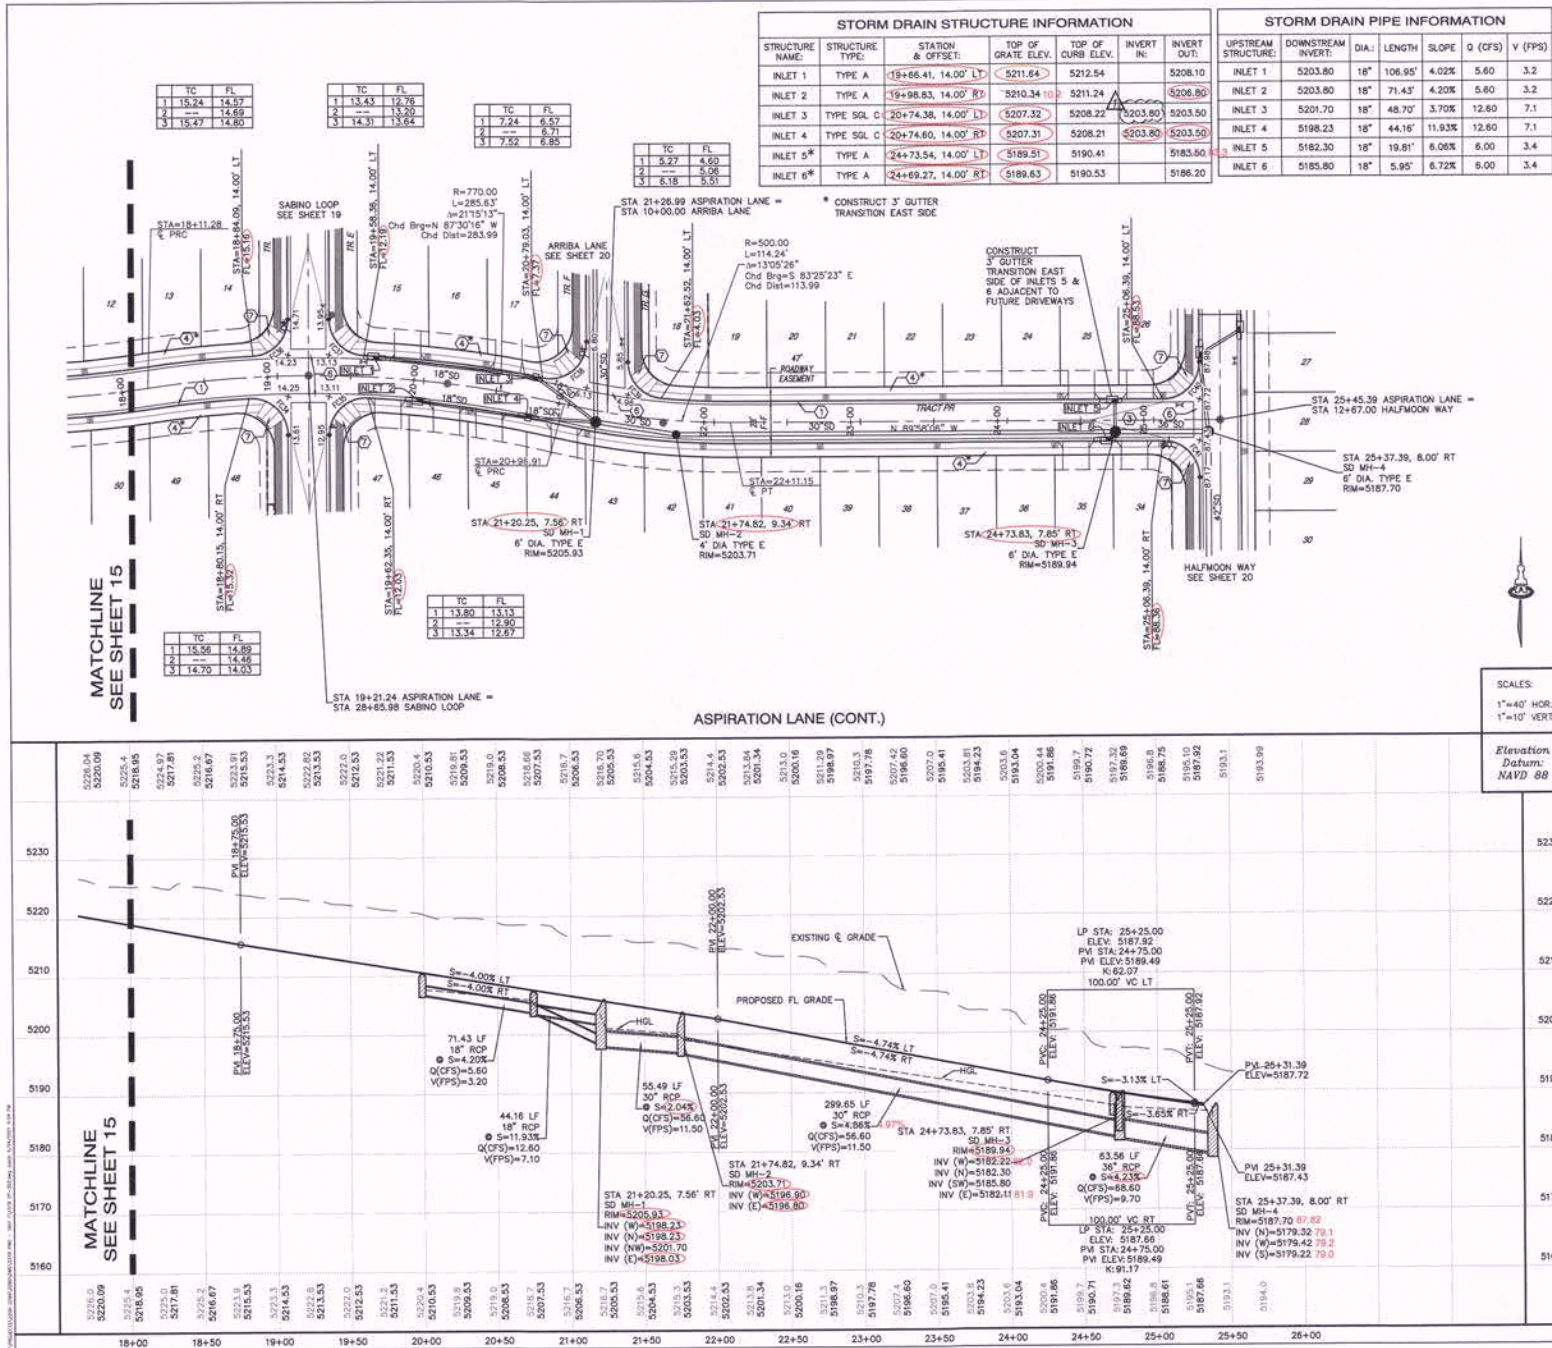

STORM DRAIN STRUCTURE INFORMATION									
STRUCTURE NAME	TYPE	STATION & OFFSET	TOP OF GRADE ELEV.	TOP OF CURB ELEV.	INVERT IN	INVERT OUT			
INLET 1	TYPE A	19+66.41, 14.00' LT	5211.64	5212.54	5208.10	5208.10			
INLET 2	TYPE A	19+96.83, 14.00' RT	5210.34	5211.24	5208.80	5208.80			
INLET 3	TYPE SGL	20+74.38, 14.00' LT	5207.32	5208.22	5203.80	5203.80			
INLET 4	TYPE SGL	20+74.60, 14.00' RT	5207.31	5208.21	5203.80	5203.80			
INLET 5*	TYPE A	24+73.54, 14.00' LT	5189.51	5190.41	5183.50	5183.50			
INLET 6*	TYPE A	24+69.27, 14.00' RT	5189.63	5190.53	5186.20	5186.20			

STORM DRAIN PIPE INFORMATION									
UPSTREAM STRUCTURE	DOWNSIDE INVERT	DIA.	LENGTH	SLOPE	Q (CFS)	V (FPS)			
INLET 1	5203.80	18"	106.95'	4.02%	5.60	3.2			
INLET 2	5203.80	18"	71.43'	4.20%	5.60	3.2			
INLET 3	5201.70	18"	48.70'	3.70%	12.60	7.1			
INLET 4	5188.23	18"	44.16'	11.93%	12.60	7.1			
INLET 5	5182.30	18"	19.81'	6.06%	6.00	3.4			
INLET 6	5185.80	18"	5.95'	6.72%	6.00	3.4			

GENERAL NOTES

- CONSTRUCT 4' WIDE ADA PATH BETWEEN ALL ADA RAMPS PER DETAIL ON SHEET 12.
- SIDEWALK CONSTRUCTION IS DEFERRED WHERE NOTED BY *.

KEYED CONSTRUCTION NOTES

- CONSTRUCT STANDARD CURB & GUTTER PER COA STD DWG #24158.
- CONSTRUCT MEDIAN CURB & GUTTER PER COA STD DWG #24158.
- CROWN TO NO-CROWN TRANSITION OVER 50' MIN. PER COA STD DWG #2401.
- 5' SIDEWALK PER COA STD DWG #2430. SEE GENERAL NOTE 8.
- CONSTRUCT 6" SIDEWALK PER COA STD DWG #2430. SEE GENERAL NOTE 8.
- CONSTRUCT PCC VALLEY GUTTER 4' WIDE, 1 1/2" INVERT PER COA STD DWG #2420. MODIFY GUTTER THICKNESS PER DETAIL ON SHEET 12.
- CONSTRUCT ADA RAMP PER COA STD DWG #2441. CASE II. INSTALL CAST IN PLACE REPLACEABLE TRUNCATED DOMES. SUBMIT SPECS TO CONSTRUCTION ENGINEER FOR EVALUATION PRIOR TO CONSTRUCTION.
- CONSTRUCT 4" TEXTURED, COLORED MEDIAN PAVEMENT FROM MEDIAN NOSE TO 10' FROM NOSE. AT ROUNDABOUT INSTALL 8" CONCRETE FROM BACK OF CURB. COLOR AND PATTERN TO BE DETERMINED PRIOR TO PLACEMENT. PAINT MEDIAN NOSE YELLOW TO APPROXIMATELY 6' BEHIND PCC/PT PER COA STD DWGS 2408 & 2502.
- CONSTRUCT PCC VALLEY GUTTER 4' WIDE, 1 1/2" INVERT PER COA STD DWG #2421.
- INSTALL ADA RAMP PER DETAIL 'A' ON SHEET 12.
- CONSTRUCT 24" CUT-OFF WALL PER COA STD DWG #24158.
- INSTALL THERMOPLASTIC MARKINGS:
4" SOLID WHITE STRIPE (45 L/F)
1-RIGHT TURN ARROW
1-LEFT TURN ARROW
- CONSTRUCT MOUNTABLE MEDIAN CURB & GUTTER PER COA STD DWG #24158.

STORM DRAIN NOTES

- CONSTRUCT STORM DRAIN MANHOLES PER COA STD DWGS #2101 & 2102 WITH COVER PER COA STD DWG #2110.
- CONSTRUCT INLETS PER COA STD DWGS #2201, 2202, 2207, 2215 & 2216 WITH GRATE PER COA STD DWG #2220.
- INLET STATIONING IS TO MIDPOINT OF DOWNSIDE GRATE @ FACE OF CURB.

FACE OF CURB CURVE TABLE

CURVE	LENGTH	RADIUS	DELTA
FC34	40.60'	25.00'	93°02'18"
FC35	40.61'	25.00'	93°04'41"
FC36	38.07'	25.00'	87°15'17"
FC37	38.06'	25.00'	87°17'08"
FC40	39.27'	25.00'	90°00'00"
FC41	39.27'	25.00'	90°00'00"

Isaacson & Arfman, Inc.

Civil Engineering Consultants

128 Monroe Street NE
Albuquerque, NM 87108
505-268-8828 | www.isaacson.com


CITY OF ALBUQUERQUE

PUBLIC WORKS DEPARTMENT
ENGINEERING DEVELOPMENT GROUP
ASPHTE SUBDIVISION, UNIT 1
ASPIRATION LANE (CONT.)
PAVING PLAN & PROFILE


DESIGN REVIEW COMMITTEE	CITY ENGINEER APPROVAL	Mo./Day/Yr.	Mo./Day/Yr.

Approved by Albuquerque Design Review Committee and City Engineer June 28, 2021

City Project No. **757580** Zone Map No. **N-8-Z** Sheet **16** of **37**

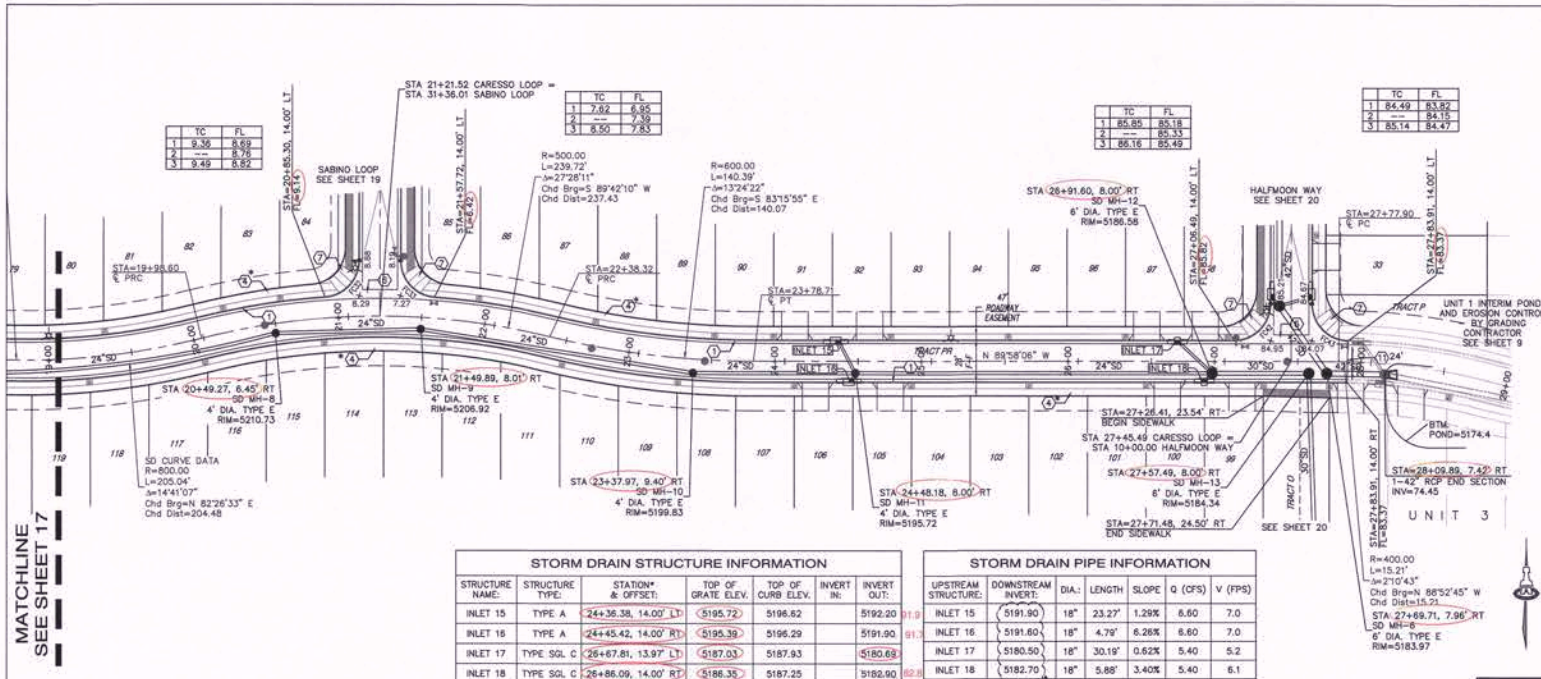

CARESSO LOOP (CONT.)

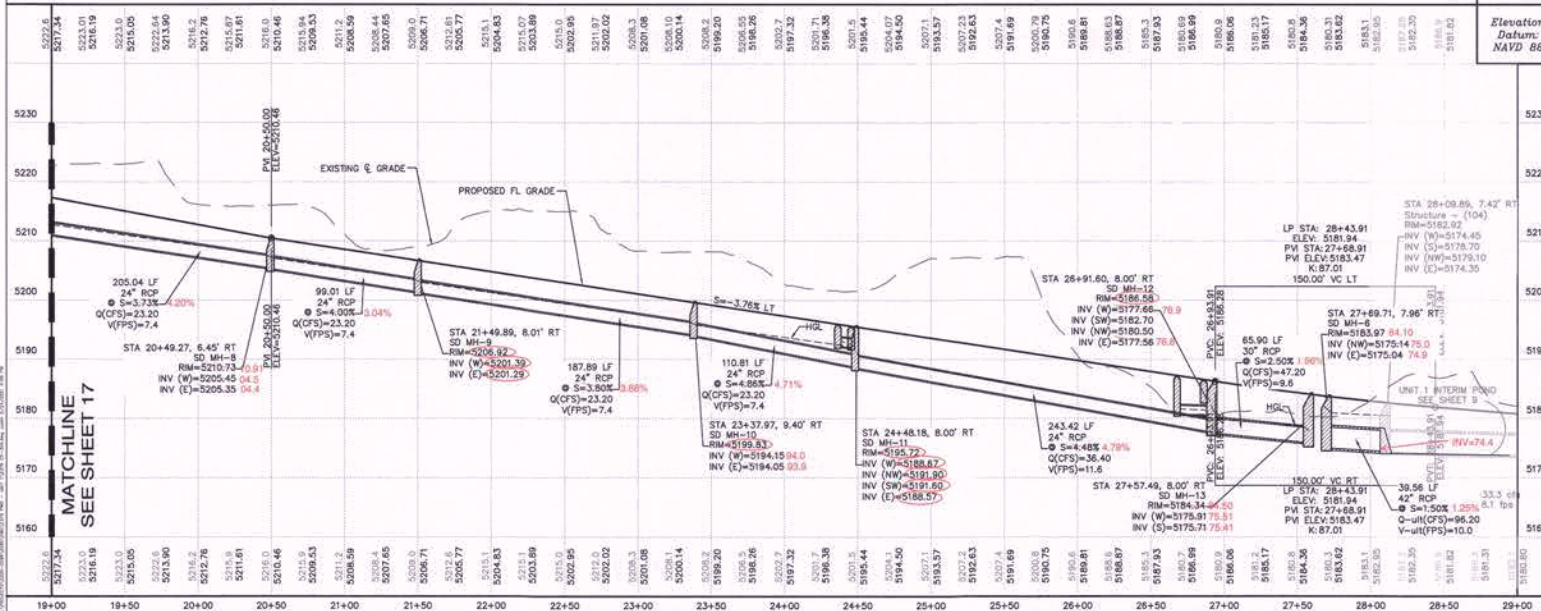

GENERAL NOTES

- CONSTRUCT 4' WIDE ADA PATH BETWEEN ALL ADA RAMP PER DETAIL ON SHEET 12.
- SIDEWALK CONSTRUCTION IS DEFERRED WHERE NOTED BY *

KEYED CONSTRUCTION NOTES

- CONSTRUCT STANDARD CURB & GUTTER PER DETAIL ON SHEET 12.
- CONSTRUCT MEDIAN CURB & GUTTER PER COA STD DWG #2415B.
- CROWN TO NO-CROWN TRANSITION OVER 50' MIN. PER COA STD DWG #2401.
- 5' SIDEWALK PER COA STD DWG #2430. SEE GENERAL NOTE B.
- CONSTRUCT 6' SIDEWALK PER COA STD DWG #2430. SEE GENERAL NOTE B.
- CONSTRUCT PCC VALLEY GUTTER 6' WIDE, 1 1/2" INVERT PER COA STD DWG #2420. MODIFY GUTTER THICKNESS PER DETAIL ON SHEET 12.
- CONSTRUCT ADA RAMP PER COA STD DWG #2441. CASE 1: INSTALL CURB IN PLACE REPLACEMENT TRUNCATED DOWNS. SUBMIT SPEC TO CONSTRUCTION ENGINEER FOR EVALUATION PRIOR TO CONSTRUCTION.
- CONSTRUCT 4" TEXTURED, COLORED MEDIAN PAVEMENT FROM MEDIAN NOSE TO 10' FROM NOSE. AT ROUNDABOUT INSTALL 8" CONCRETE FROM BACK OF CURB. COLOR AND PATTERN TO BE DETERMINED PRIOR TO PLACEMENT. PAINT MEDIAN NOSE YELLOW TO APPROXIMATELY 6' BEHIND PC/PT PER COA STD DWGS 2408 & 2502.
- CONSTRUCT PCC VALLEY GUTTER 4' WIDE, 1 1/2" INVERT PER COA STD DWG #2421.
- INSTALL ADA RAMP PER DETAIL 'A' ON SHEET 12.
- CONSTRUCT 24" CUT-OFF WALL PER COA STD DWG #2415B.
- INSTALL THERMOPLASTIC MARKINGS: 4" SOLID WHITE STRIPE (45 LPS) 1-RIGHT TURN ARROW 1-LEFT TURN ARROW
- CONSTRUCT MOUNTABLE MEDIAN CURB & GUTTER PER COA STD DWG #2415B.

SCALES:

1"=40' HOR.

1"=10' VERT.

Elevation

NAVD 88

STORM DRAIN NOTES

- CONSTRUCT STORM DRAIN MANHOLES PER COA STD DWGS #2101 & 2102 WITH COVER PER COA STD DWG #2110.
- CONSTRUCT INLETS PER COA STD DWGS #2201, 2202, 2207, 2215 & 2216 WITH GRATE PER COA STD DWG #2220.
- INLET STATIONING IS TO MIDPOINT OF DOWNSTREAM GRATE @ FACE OF CURB.

Isaacson & Artman, Inc.
Civil Engineering Consultants

128 Monroe Street NE
Albuquerque, NM 87108
505-268-8828 | www.isaacsonartman.com


CITY OF ALBUQUERQUE
PUBLIC WORKS DEPARTMENT
ENGINEERING DEVELOPMENT GROUP
ASPIRE SUBDIVISION, UNIT 1

CARESSO LOOP (CONT.)
PAVING PLAN & PROFILE

DESIGN REVIEW COMMITTEE	CITY ENGINEER APPROVAL	DATE	DATE
		02/20/2021	02/20/2021
City Project No.	Zone Map No.	Sheet	Of
757580	N-8-Z	18	37



SCALES:
1"=40' HOR.
1"=10' VERT.

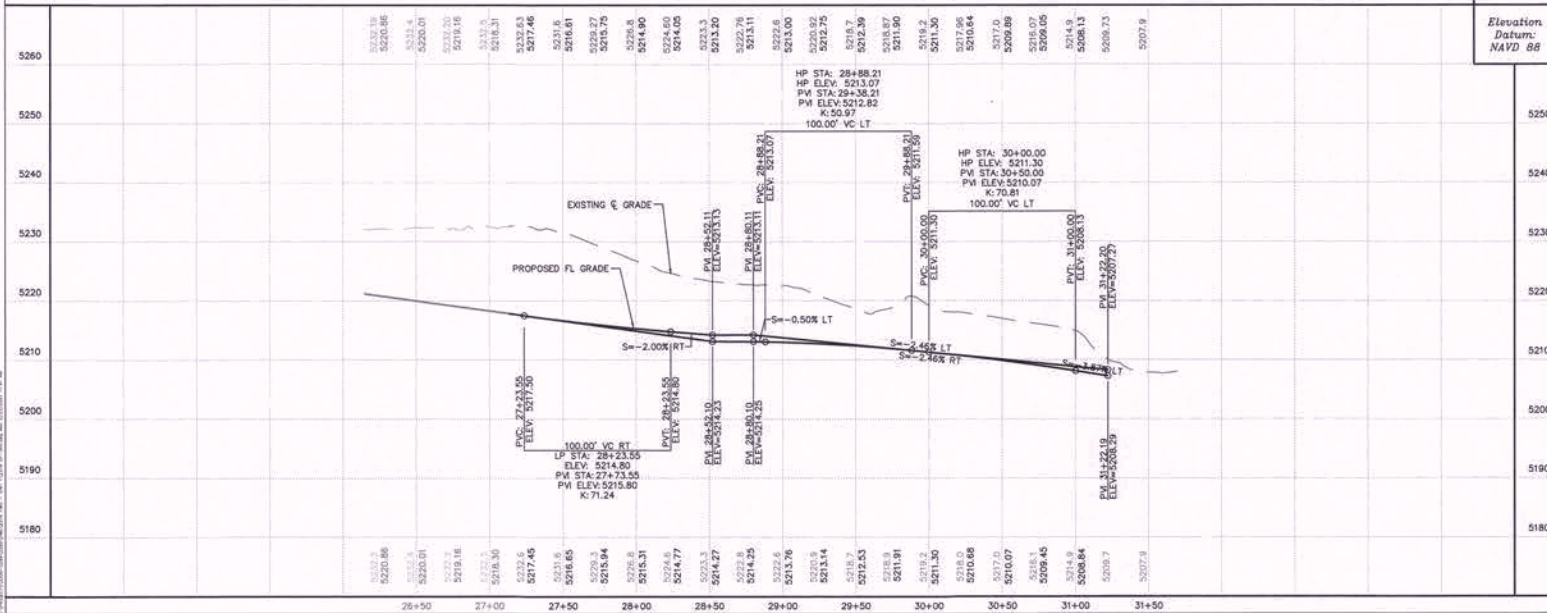

KEYED CONSTRUCTION NOTES

1. CONSTRUCT STANDARD CURB & GUTTER PER DETAIL ON SHEET 12.
2. CONSTRUCT MOUNTAIN CURB & GUTTER PER COA STD DWG #2415B.
3. CROWN TO NO-CROWN TRANSITION OVER 50' MIN. PER COA STD DWG #2401.
4. 5' SIDEWALK RAMP COA STD DWG #2430. SEE GENERAL NOTE B.
5. CONSTRUCT 6" SIDEWALK RAMP COA STD DWG #2430. SEE GENERAL NOTE B.
6. CONSTRUCT PCC VALLEY GUTTER 4" WIDE, 1 1/2" INVERT PER COA STD DWG #2420. MODIFY GUTTER THICKNESS PER DETAIL ON SHEET 12.
7. CONSTRUCT ADA RAMP PER COA STD DWG #2441. CASE II. INSTALL CAST IN PLACE REPLACEABLE TRUNCATED DOMES. SUBMIT SPECS TO STRUCTURAL ENGINEER FOR EVALUATION PRIOR TO CONSTRUCTION.
8. CONSTRUCT 4" TEXTURED, COLORED MOUNTAIN PAVEMENT FROM MOUNTAIN NOSE TO 10' FROM NOSE. AT ROUNDABOUT INSTALL 8" CONCRETE FROM BASE OF CURB. COLOR AND PATTERN TO BE DETERMINED PRIOR TO PLACEMENT. PAINT MOUNTAIN NOSE YELLOW TO APPROXIMATELY 6" BEHIND PC/PT PER COA STD DWGS 2408 & 2502.
9. CONSTRUCT PCC VALLEY GUTTER 4" WIDE, 1 1/2" INVERT PER COA STD DWG #2421.
10. INSTALL ADA RAMP PER DETAIL "A" ON SHEET 12.
11. CONSTRUCT 24" CUT-OFF WALL PER COA STD DWG #2415B.
12. INSTALL THERMOPLASTIC MARKINGS:
a. SOLID WHITE STRIPE (45 Lf±)
1--RIGHT TURN ARROW
1--LEFT TURN ARROW
13. CONSTRUCT MOUNTAIN MOUNTAIN CURB & GUTTER PER COA STD DWG #2415B.

CURVE	LENGTH	RADIUS	DELTA
FC32	37.47'	25.00'	85°52'18"
FC33	37.45'	25.00'	85°49'47"
FC34	40.60'	25.00'	93°02'18"
FC35	40.61'	25.00'	93°04'41"
FC36	38.07'	25.00'	87°15'17"
FC37	38.06'	25.00'	87°13'08"

Isaacson & Arfman, Inc.
Civil Engineering Consultants

128 Monroe Street NE
Albuquerque, NM 87108
505-258-8628 | www.lacivil.com

CITY OF ALBUQUERQUE
PUBLIC WORKS DEPARTMENT
ENGINEERING DEVELOPMENT GROUP
ASPIRE SUBDIVISION, UNIT 1

SABINO LOOP
PAVING PLAN & PROFILE



DESIGN REVIEW COMMITTEE	CITY ENGINEER APPROVAL	RE	Mo./DAY/YR.	Mo./DAY/YR.
-------------------------	------------------------	----	-------------	-------------

Approved by Albuquerque
Design Review Committee and
City Engineer June 23, 2021

City Project No.	757580	Zone Map No.	N-8-Z	Sheet	19	Of	37
------------------	--------	--------------	-------	-------	----	----	----

STORM DRAIN STRUCTURE INFORMATION							
STRUCTURE NAME	STRUCTURE TYPE	STATION & OFFSET	TOP OF GRADE ELEV.	TOP OF CURB ELEV.	INVERT IN.	INVERT OUT.	
INLET 7	TYPE A	13+27.81, 14.00' RT	(5187.97)	5188.87	04.2	5184.40	
INLET 8	TYPE A	13+10.75, 14.00' LT	(5187.80)	5188.70	5184.10	5182.00	
INLET 9	TYPE A	10+43.75, 14.00' LT	(5185.03)	5185.93	81.3	5181.50	
INLET 10	TYPE A	10+43.70, 14.00' RT	(5184.55)	5185.45	80.9	5181.00	

STORM DRAIN PIPE INFORMATION							
UPSTREAM STRUCTURE	DOWNSTREAM INVERT	DIA.	LENGTH	SLOPE	Q (CFS)	V (FPS)	
INLET 7	5184.10	18"	29.13'	1.03%	7.40	4.2	
INLET 8	5179.32	24"	50.54'	5.30%	14.80	4.7	
INLET 9	5181.00	18"	6.97'	7.17%	6.40	3.6	
INLET 10	5179.70	18"	20.86'	6.23%	6.40	3.6	

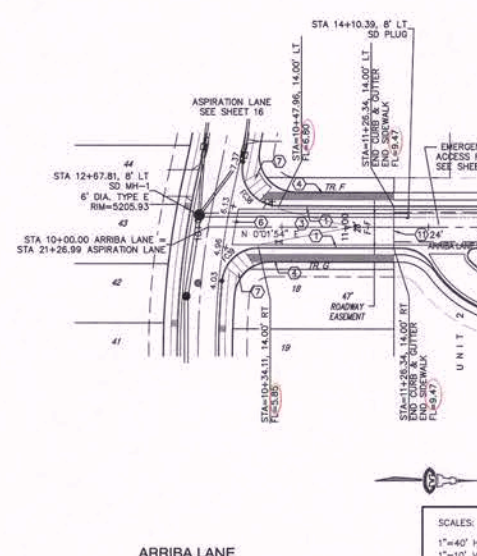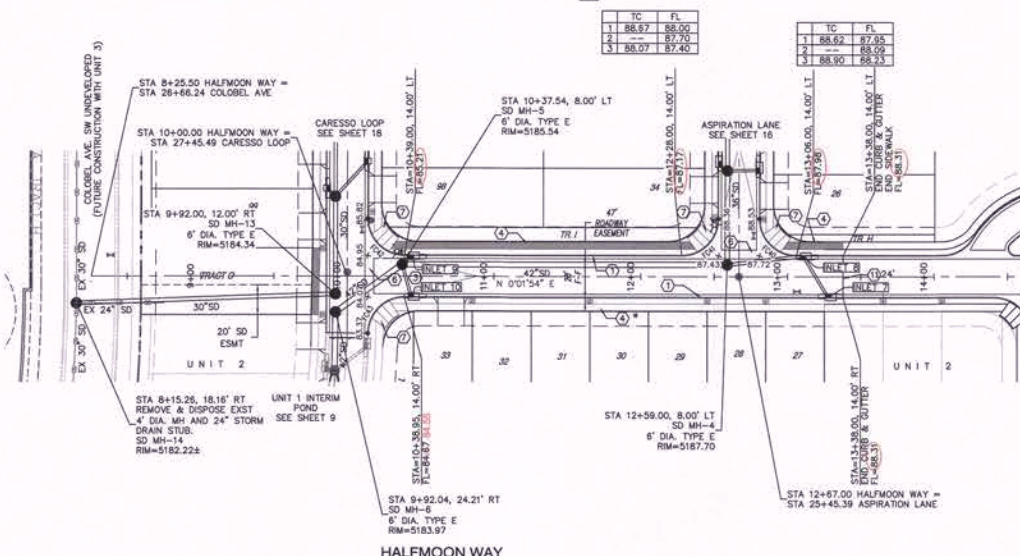

- ### GENERAL NOTES
- CONSTRUCT 4' WIDE ADA PATH BETWEEN ALL ADA RAMPS PER DETAIL ON SHEET 12.
 - SIDEWALK CONSTRUCTION IS DEFERRED WHERE NOTED BY *

- ### KEYED CONSTRUCTION NOTES
- CONSTRUCT STANDARD CURB & GUTTER PER DETAIL ON SHEET 12.
 - CONSTRUCT MEDIAN CURB & GUTTER PER COA STD DWG #2415B.
 - CROWN TO NO-CROWN TRANSITION OVER 50' MIN. PER COA STD DWG #2401.
 - 5' SIDEWALK PER COA STD DWG #2430. SEE GENERAL NOTE B.
 - CONSTRUCT 6' SIDEWALK PER COA STD DWG #2430. SEE GENERAL NOTE B.
 - CONSTRUCT PCC VALLEY GUTTER 6' WIDE, 1 1/2" INVERT PER COA STD DWG #2420. MODIFY GUTTER THICKNESS PER DETAIL ON SHEET 12.
 - CONSTRUCT ADA RAMP PER COA STD DWG #2441. CASE IT INSTALL CASE IN PLACE REPAIRABLE TRUNCATED DOWNS. SUBMIT SPECS TO CONSTRUCTION ENGINEER FOR EVALUATION PRIOR TO CONSTRUCTION.
 - CONSTRUCT 4" TEXTURED, COLORED MEDIAN PAVEMENT FROM MEDIAN NOSE TO 10' FROM NOSE. AT ROUNDABOUT INSTALL 6" CONCRETE FROM BACK OF CURB. COLOR AND PATTERN TO BE DETERMINED PRIOR TO PLACEMENT. PAINT MEDIAN NOSE YELLOW TO APPROXIMATELY 6' BEHIND PC/PT PER COA STD DWGS 2408 & 2502.
 - CONSTRUCT PCC VALLEY GUTTER 4' WIDE, 1 1/2" INVERT PER COA STD DWG #2421.
 - INSTALL ADA RAMP PER DETAIL 'A' ON SHEET 12.
 - CONSTRUCT 24" CUT-OFF WALL PER COA STD DWG #2415B.
 - INSTALL THERMOPLASTIC MARKINGS:
4" SOLID WHITE STRIPE (45 LPS)
1-RIGHT TURN ARROW
1-LEFT TURN ARROW.
 - CONSTRUCT MOUNTABLE MEDIAN CURB & GUTTER PER COA STD DWG #2415B.

- ### STORM DRAIN NOTES
- CONSTRUCT STORM DRAIN MANHOLES PER COA STD DWGS #2101 & #2102 WITH COVER PER COA STD DWG #2110.
 - CONSTRUCT INLETS PER COA STD DWGS #2201, #2202, #2207, #2215 & #2216 WITH GRATE PER COA STD DWG #2220.
 - INLET STATIONING IS TO MIDPOINT OF DOWNSTREAM GRATE @ FACE OF CURB.

SCALES:
1"=40' HOR.
1"=10' VERT.

Elevation Datum: NAVD 88


FACE OF CURB CURVE TABLE			
CURVE	LENGTH	RADIUS	DELTA
FC38	44.40'	25.00'	101°45'35"
FC39	36.84'	25.00'	84°25'41"
FC40	39.27'	25.00'	90°00'00"
FC41	39.27'	25.00'	90°00'00"
FC42	39.27'	25.00'	90°00'00"
FC43	38.89'	25.00'	89°08'20"

Isaacson & Arfman, Inc.
Civil Engineering Consultants
128 Monroe Street NE
Albuquerque, NM 87108
505-268-8929 | www.isaefirm.com

CITY OF ALBUQUERQUE
PUBLIC WORKS DEPARTMENT
ENGINEERING DEVELOPMENT GROUP
ASPIRE SUBDIVISION, UNIT 1
HALFMOON WAY & ARRIBA LANE
PAYING PLAN & PROFILE

DESIGN REVIEW COMMITTEE: CITY ENGINEER APPROVAL
Approved By: [Signature]
Design Review Committee and City Engineer June 28, 2021

City Project No. 757580 Zone Map No. N-8-Z Sheet 20 of 37

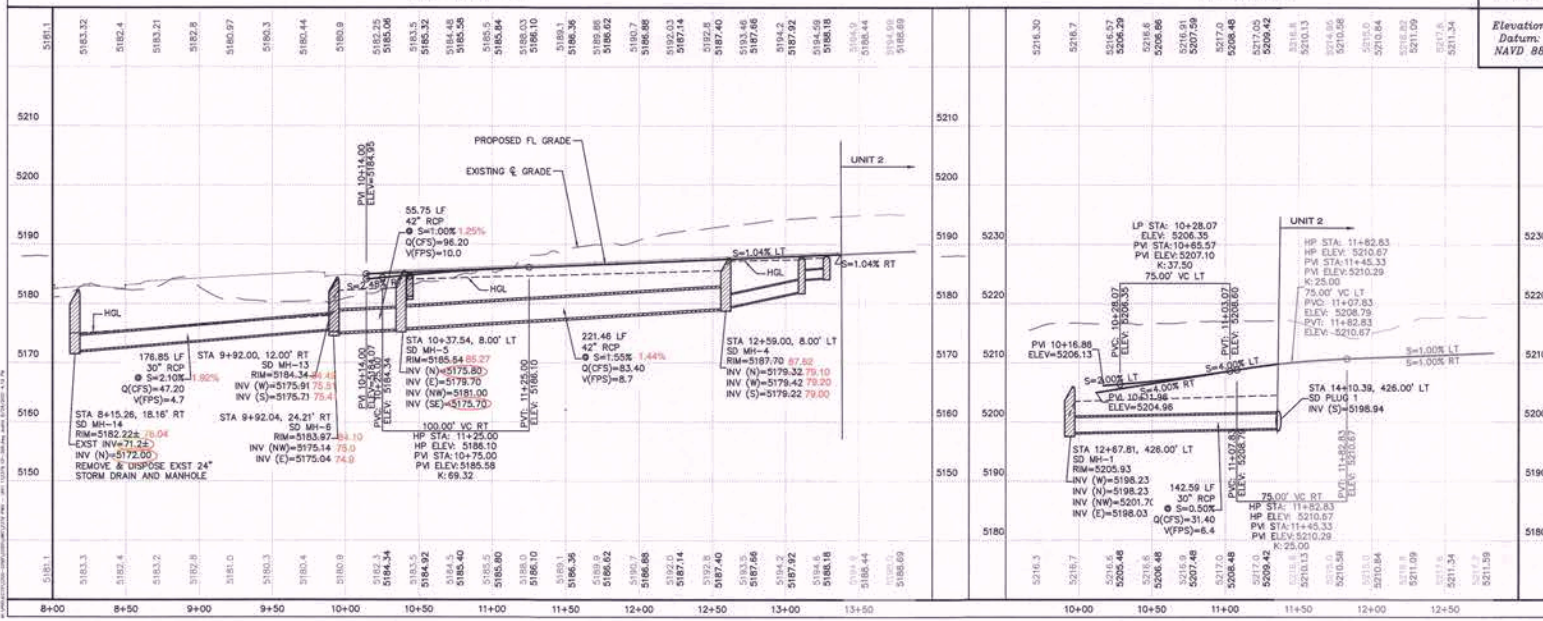

DATE: 06/28/21
DRAWN BY: [Signature]
CHECKED BY: [Signature]
DESIGNED BY: [Signature]
REVISIONS: [Table]
NO. DATE

Elevation
Datum:

CITY OF ALBUQUERQUE
PUBLIC WORKS DEPARTMENT
ENGINEERING DEVELOPMENT GROUP
ASPIRE SUBDIVISION, UNIT 1
EMERGENCY ACCESS ROAD
PAVING PLAN & PROFILE

Approved by Minneapolis
Design Review Committee and
City Engineer June 28, 2021

City Project No.	757580	Zone Map No.	N-8-Z	Sheet	21	Of	37
------------------	--------	--------------	-------	-------	----	----	----

[illegible]

[illegible]




1. ALL ELECTRICAL TO MEET NATIONAL, STATE AND LOCAL CODES.
2. ALL GROUNDING TO COMPLY WITH ARTICLE 250 OF THE NEC AND STATE OF NEW MEXICO ELECTRIC CODE.
3. SEE DRAWINGS 25 AND 26 FOR INSTALLATION, POLE BASE, SERVICE PEDISTAL/CONTROL CABINET AND PULL BOX DETAILS.

- | CLIMATE CONTROL - POLE
Aspire - Street Light Plan | | | | | |
|--|-------------------|------------------|----------------------|-------------|---------------------------|
| Type | Manufacturer | Catalog Number | ECT / lumens / Watts | Mounting | Description |
| A | AMERICAN ELECTRIC | ATB86MVL7K2N6LP7 | 4000K/4771/40 | 23°-4° POLE | FULL CUTOFF LED COBRAHEAD |
| B | AMERICAN ELECTRIC | ATB4MVL7K3N3LP7 | 4000K/1574/330 | 30°-6° POLE | FULL CUTOFF LED COBRAHEAD |
| C | AMERICAN ELECTRIC | ATB86MVL7K2N7LP7 | 3000K/3125/23 | 23°-4° POLE | FULL CUTOFF LED COBRAHEAD |

5101 Coors Blvd. NW
Suite "F"
Albuquerque, New Mexico 87120
(505)262-1766
(505)255-0468 fax

DESIGN REVIEW COMMITTEE		CITY ENGINEER, APPROVAL		Mo./DAY/YR.	
Approved by Design Review Committee and City Engineer June 28, 2021		Albuquerque Committee and June 28, 2021		LAST DESIGN UPDATE	
City Project No.		Zone Map No.		Sheet Of	
757580		N-8-Z		23 37	

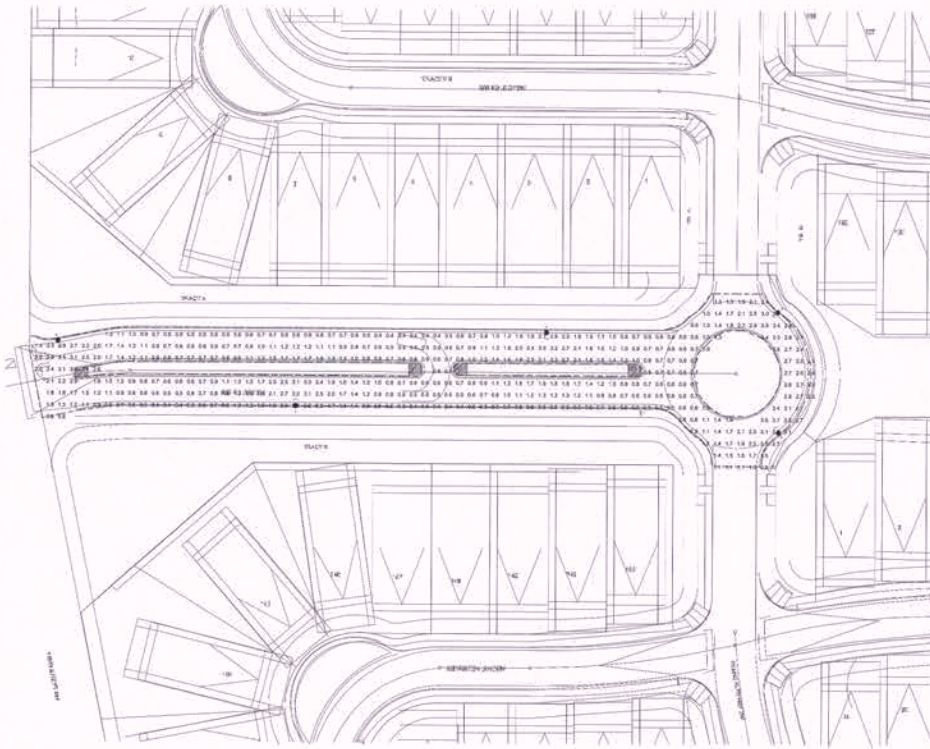

STREET LIGHTING PHOTOMETRIC PLAN



SCALE 1"=40'

Symbol	Label	Quantity	Manufacturer	Catalog Number	Description	Number Lamps	Filename	Lumens Per Lamp	Light Loss Factor	Wattage
⬆	B	5	American Electric Lighting	ATBH P30 XXXXX R3 4K/5K	ATBH, Performance Package P30, Type 3, 4000K/5000K CCT	1	ATBH_P30_XXXXX_R3_4K_5K.xls	15452	1	118

Description	Symbol	Avg	Max	Min	Max/Min	Avg/Min
GRADE LEVEL	+	1.3 ft	3.7 ft	0.4 ft	9.3:1	3.3:1


Note
1. Heads are 30' above grade.




5101 Coors Blvd. NW
Suite 101
Albuquerque, New Mexico 87120
(505)255-1788
(505)255-0486 fax

CITY OF ALBUQUERQUE PUBLIC WORKS DEPARTMENT ENGINEERING DEVELOPMENT GROUP			
ASPIRE SUBDIVISION, UNIT 1 STREET LIGHTING PHOTOMETRIC PLAN			
DESIGN REVIEW COMMITTEE	CITY ENGINEER APPROVAL	Mo./DAY/YR.	Mo./DAY/YR.
Approved by Design Review Committee and City Engineer June 28, 2021	Albuquerque June 28, 2021		
City Project No.	Zone Map No.	Sheet	Of
757580	N-8-Z	24	37

AS-BUILT INFORMATION	BENCH MARKS	SURVEY INFORMATION	ENGINEER'S SEAL	REVISIONS	NO.	DATE	BY
OWNER: SALL DESIGNER: SPINELLO & ASSOCIATES, P.C. PROJECT: ASPIRE SUBDIVISION, UNIT 1 SHEET: 24 OF 37 DATE: 06/28/21	AGRI MONUMENT AND BENCHMARK "1-NR" N=1470741.879 ; E=1480703.82 G-C=0.999874466 Az=107.727 70° ELEVATION=5307.25 (MARS/MA008)	1. 10-03-2021 SPINELLO & ASSOCIATES, P.C. FIELD NOTES: 10-03-2021 SPINELLO & ASSOCIATES, P.C.		REMARKS DESIGN			

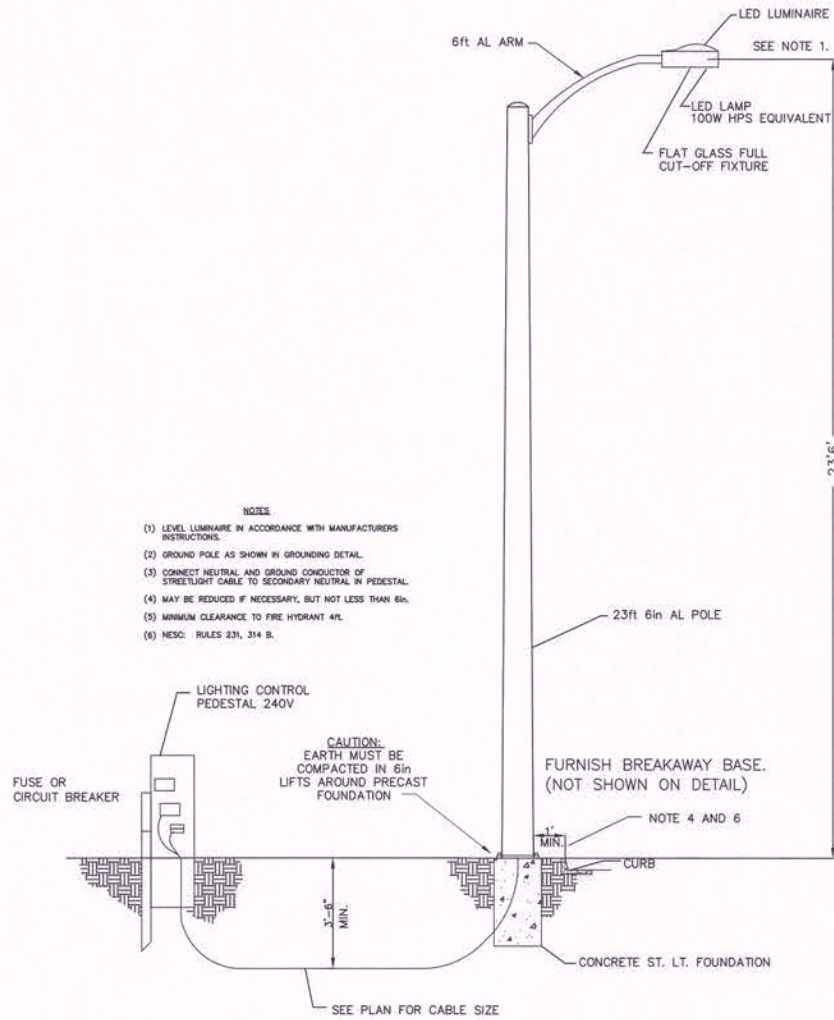

- NOTES
- (1) LEVEL LUMINAIRE IN ACCORDANCE WITH MANUFACTURERS INSTRUCTIONS.
 - (2) GROUND POLE AS SHOWN IN GROUNDING DETAIL.
 - (3) CONNECT NEUTRAL AND GROUND CONDUCTOR OF STREETLIGHT CABLE TO SECONDARY NEUTRAL IN PEDESTAL.
 - (4) MAY BE REDUCED IF NECESSARY, BUT NOT LESS THAN 6in.
 - (5) MINIMUM CLEARANCE TO FIRE HYDRANT 4ft.
 - (6) NESC: RULES 231, 314 B.


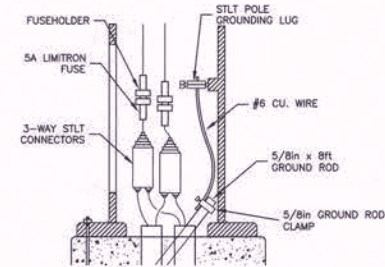


FUSING AND GROUNDING DETAIL

AEDI
5101 Coors Blvd NW
Suite "P"
Albuquerque, New Mexico 87120
(505)262-1766
(505)255-0466 fax

CITY OF ALBUQUERQUE PUBLIC WORKS DEPARTMENT ENGINEERING DEVELOPMENT GROUP ASPIRE SUBDIVISION, UNIT 1			
ELECTRICAL DETAILS			
DESIGN REVIEW COMMITTEE	CITY ENGINEER APPROVAL	Mo./DAY/YR.	Mo./DAY/YR.
Approved by Design Review Committee and City Engineer June 28, 2021		LAST DESIGN UPDATE	
City Project No.	Zone Map No.	Sheet	Of
757580	N-8-Z	25	37

AS-BUILT INFORMATION		BENCH MARKS		SURVEY INFORMATION		ENGINEER'S SEAL	
DATE: 06/28/2021 DRAWN BY: AEDI CHECKED BY: DLS/DWG		AGS MONUMENT AND BENCHMARK "1-NB" N=1470241.879 E=1488701.82 C=5-0.999678406 AZ=001727.707 ELEVATION=5307.25 (NAD83/NAVB83)		1 13P-08330M SPACES NE 10/2020		[Seal] [Signature] [Stamp]	
SALS DATE: 06/28/2021 DRAWN BY: AEDI CHECKED BY: DLS/DWG		SPINELLO DCS 06/28/2021 DATE: 06/28/2021 CHECKED BY: DLS/DWG		MICRO-FILM INFORMATION DATE: 06/28/2021 CHECKED BY: DLS/DWG		NO. DATE BY: AEDI DATE: 02/2021 DATE: 02/2021	

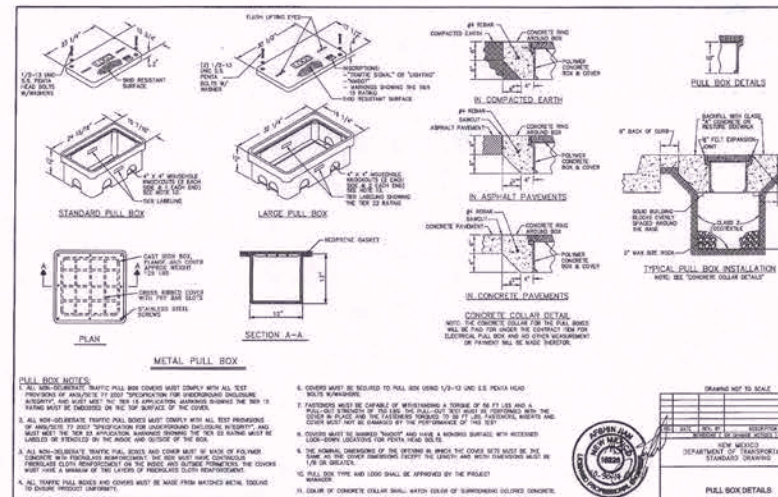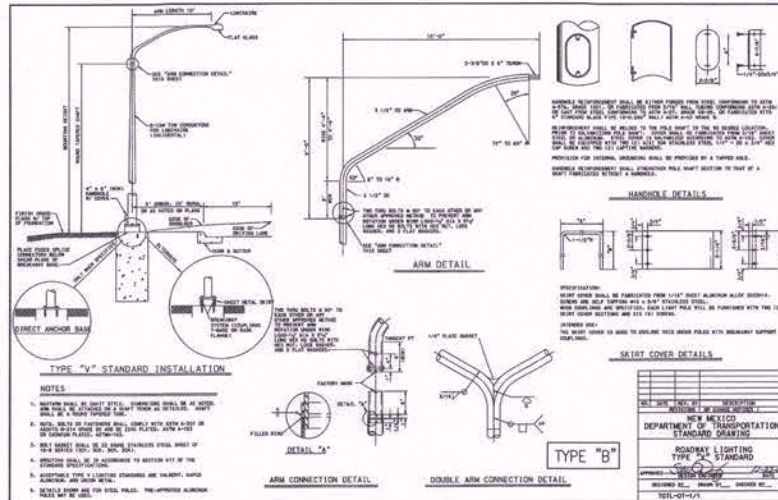

PULL BOX COVER INSCRIPTION
SHALL READ "STREET LIGHTING"

5101 Coors Blvd. NW
Suite P
Albuquerque, New Mexico 87120
(505)262-1786
(505)255-0466 fax

DESIGN REVIEW COMMITTEE		CITY ENGINEER APPROVAL		Mo./DAY/YR.		Mo./DAY/YR.	
Approved by Design Review City Engineer		Allouette Committee and June 28, 2021.		LAST DESIGN UPDATE			
City Project No.		Zone Map No.		Sheet		Of	
757580		N-8-Z		26		37	

[illegible]



SCALE: NONE




SERVICE PEDESTAL EQUIPMENT SCHEDULE

SERVICE PEDESTAL MANUFACTURED BY TESCO CONTROLS INC.
WITH THE FOLLOWING EQUIPMENT FACTORY INSTALLED AND WIRED.

1. METER SOCKET 120/240V, 1PH, 3W, 200 AMP WITH BYPASS.
MUST MEET PNM ELECTRIC UTILITY STANDARD.
2. POWER DISTRIBUTION PANEL 120/240V, 200 AMP MAIN
BREAKER. COPPER BUS, 22,000 AIC, MINIMUM 6 CIRCUITS.
3. PAINTED STEEL ENCLOSURE.
4. LIGHTING CONTACTOR, 20A-6P
WITH HAND/OFF/AUTO SWITCH
5. PHOTOCELL

AEDI 5101 Coors Blvd. NW
Suite "P"
Albuquerque, New Mexico 87120
(505)262-1766
(505)255-0466 fax

DESIGN REVIEW COMMITTEE	QTY ENGINEER APPROVAL	LAST DESIGN UPDATE	Mo./DAY/YR.	Mo./DAY/YR.
<p>Approved by <u>Albinaporn</u> Design Review Committee and City Engineer</p> <p>June 28, 2021</p>				
City Project No.	Zone Map No.	Sheet	Of	
757580	N-8-Z	27	37	

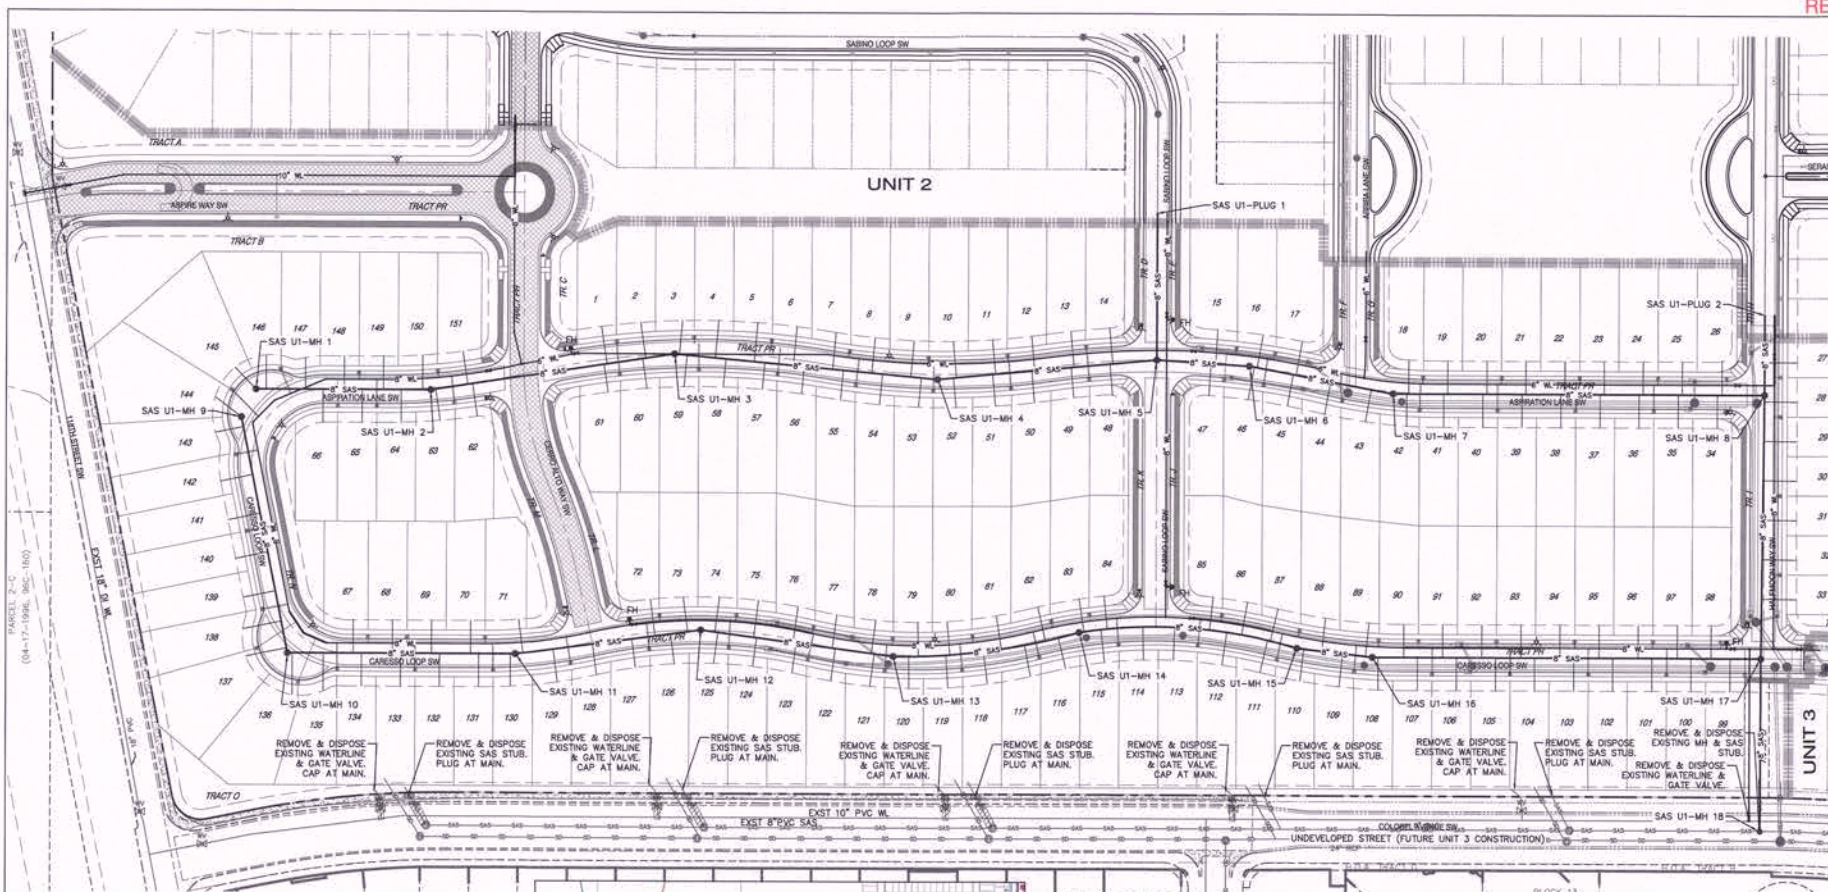

SIZE	HORZ. BENDS				VALVES & DEAD ENDS
	90°	45°	22 1/2°	11 1/4°	
12"	37	15	8	4	102
10"	31	13	7	4	87
8"	27	11	6	3	75
6"	20	9	4	2	54
4"	15	6	3	2	38

RESTRAINED JOINT LENGTHS, L_r , FOR REDUCERS, (FT.)				
MINIMUM UNOBTSTRUCTED, STRAIGHT-RUN LENGTH; RESTRAIN EITHER LARGE PIPE, OR SMALL PIPE.				
SIZE	LARGE SIDE	SIZE	LARGE SIDE	
12x10	30	10x8	53	
12x8	54	10x4	71	
12x6	74	8x6	31	
12x4	89	8x4	52	

THESE TABLES ARE BASED UPON THE FOLLOWING CRITERIA:


DEPTH OF BURY: 3.0 FT. MINIMUM
FACTOR OF SAFETY: 1.50
MATERIAL: PVC
SOIL TYPE: GM/SW - SILTY GRAVELS AND SILTY SANDS, GRAVEL-SAND-SILT MIXTURES, 150 PSI
TEST PRESSURE: PIPE BEDDED IN SAND, GRAVEL, OR CRUSHED STONE TO DEPTH OF 1/8 PIPE DIAMETER, 4 INCH MINIMUM; BACKFILL COMPACTED TO TOP OF PIPE.

DIFFERENT CRITERIA, E.G., GREATER DEPTH OF BURY, ETC., WILL REQUIRE DIFFERENT RESTRAINED LENGTHS. THESE MUST BE CALCULATED BY A QUALIFIED PROFESSIONAL ENGINEER AND APPROVED BY ARCMIA.

NOTES:

1. ALL MECHANICAL JOINTS SHALL BE RESTRAINED AT THE FITTING.
2. THE CONTRACTOR SHALL PROVIDE A MINIMUM PIPE LENGTH OF 20 LF FROM ALL MECHANICAL JOINTS. ALL PIPE JOINTS WITHIN 20 LF OF A MECHANICAL JOINT SHALL BE RESTRAINED AT THE CONTRACTOR'S EXPENSE.
3. THE CONTRACTOR SHALL RESTRAIN ALL PIPE JOINTS IN THE SPECIFIED DISTANCE LISTED IN THE TABLE ON THIS SHEET.
4. THE CONTRACTOR SHALL RESTRAIN ALL FIRE HYDRANT JOINTS FROM THE TEE ON THE MAIN TO THE FIRE HYDRANT FLANGE.

RESTRAINED JOINT LENGTHS FOR WATERLINE FITTINGS

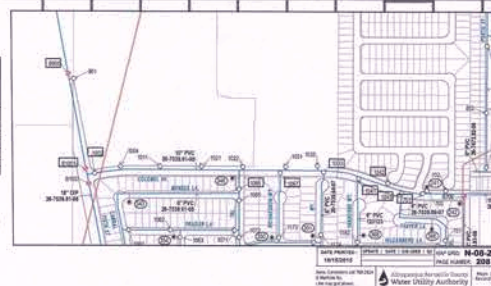

WATER SHUT-OFF PLAN

- 1 - NON-PRESSURE CONNECTION IN COLOREL AVE.
SHUT OFF VALVES 701, 1002, 1066, 1067, 1041, 1042 & 1043.
- 2 - NON-PRESSURE CONNECTION IN 116TH ST.
SHUT OFF VALVES B1001 & B900.

THE CONTRACTOR SHALL COORDINATE WITH THE WATER AUTHORITY SEVEN (7) DAYS IN ADVANCE OF PERFORMING WORK THAT WILL AFFECT THE PUBLIC WATER OR SANITARY SEWER INFRASTRUCTURE. WORK REQUIRING SHUTOFF OF FACILITIES DESIGNATED AS MASTER PLAN FACILITIES MUST BE COORDINATED WITH THE WATER AUTHORITY 14 DAYS IN ADVANCE OF PERFORMANCE OF SUCH WORK. ONLY WATER AUTHORITY CREWS ARE AUTHORIZED TO OPERATE PUBLIC VALLS. SHUTOFF REQUESTS MUST BE MADE ONLINE AT: http://www.ocbwgva.org/Water_Shut_off_and_Turn-on_Procedures.aspx.

GENERAL NOTES

- A. ALL WATER AND SEWER WORK SHALL BE CONSTRUCTED IN ACCORDANCE WITH THE CITY OF ALBUQUERQUE SPECIFICATIONS.
- B. SEE SHEET ZC FOR EASEMENT NOTES.
- C. SEE THIS SHEET FOR WATER SHUT-OFF PLAN.
- D. ALL FITTINGS AND VALVES SHALL HAVE JOINT RESTRAINTS. SEE THIS SHEET FOR
- E. ALL CROSSINGS OF WATER AND SEWER LINES SHALL HAVE 18" MIN CLEARANCE. IF 18" CLEARANCE IS NOT POSSIBLE, BOTH PIPES SHALL BE ENCASED IN CONCRETE AND NOTED ON THIS PAGE.
- F. DRY UTILITY LOCATIONS AND DESIGN ARE NOT A PART OF THIS PLAN. CONTRACTOR SHALL COORDINATE WITH THE LOCAL DRY UTILITY AGENCIES.
- G. SURVEYOR SHALL VERIFY ALL TP ELEVATIONS, RIM AND INVERT ELEVATIONS ON MANHOLES.

COLOBEL AVE.
WL & SAS REMOVALS

- REMOVE & DISPOSE WATERLINE STUBS WITH FITTINGS (180 LF±) AND VALVE BOXES;
- REMOVE & SALVAGE GATE VALVES (6 EA) AND CAP AT MAIN WHERE INDICATED ON PLAN.
- REMOVE & DISPOSE SANITARY SEWERLINE STUBS (285 LF±) AND PLUG AT MAIN WHERE INDICATED ON PLAN.
- REMOVE AND REPLACE 93 SY± MAJOR LOCAL ASPHALT.
- REMOVE & REPLACE 46 SY± PCC SIDEWALK.
- REMOVE & REPLACE 54 LF± CURB & GUTTER.

LEGEND

- | | |
|--|---|
| | PROPOSED 8" SANITARY SEWER LINE W/ MANHOLE |
| | PROPOSED 4" SANITARY SEWER SERVICE |
| | PROPOSED WATERLINE |
| | PROPOSED FIRE HYDRANT |
| | PROPOSED GATE VALVE |
| | DOUBLE / SINGLE WATER METER |
| | PROPOSED STORM DRAIN W/ MANHOLE |
| | EXISTING SANITARY SEWER LINE |
| | EXISTING WATERLINE |
| | EXISTING STORM DRAIN |
| | REMOVE & REPLACE MAJOR LOCAL PAVING |
| | REMOVE & REPLACE CURB & GUTTER AND CONCRETE STORM/VALLEY GUTTER |



128 Monroe Street NE
Albuquerque, NM 87108
505.268.8828 • www.jackall.com


CITY OF ALBUQUERQUE
PUBLIC WORKS DEPARTMENT
ENGINEERING DEVELOPMENT GROUP
ASPIRE SUBDIVISION, UNIT 1

MASTER UTILITY PLAN

DESIGN REVIEW COMMITTEE	CITY ENGINEER APPROVAL	Mo./DAY/YR	Mo./DAY/YR
Approved by Albuquerque Design Review Committee and City Engineer June 28, 2021		LAST DESIGN UPDATE	
City Project No.	Zone Map No.	Sheet	Of
757580	N-8-Z	28	37




D. DATE		REMARKS	ANW BY
05/21		REMOVED STORM DRAIN TABLES	ANW
REVISIONS			
DESIGN			
DESIGNED BY	ANW	DATE	02/20/2021
CHECKED BY	thor	DATE	02/20/2021
IN CHARGE	ANW	DATE	02/20/2021

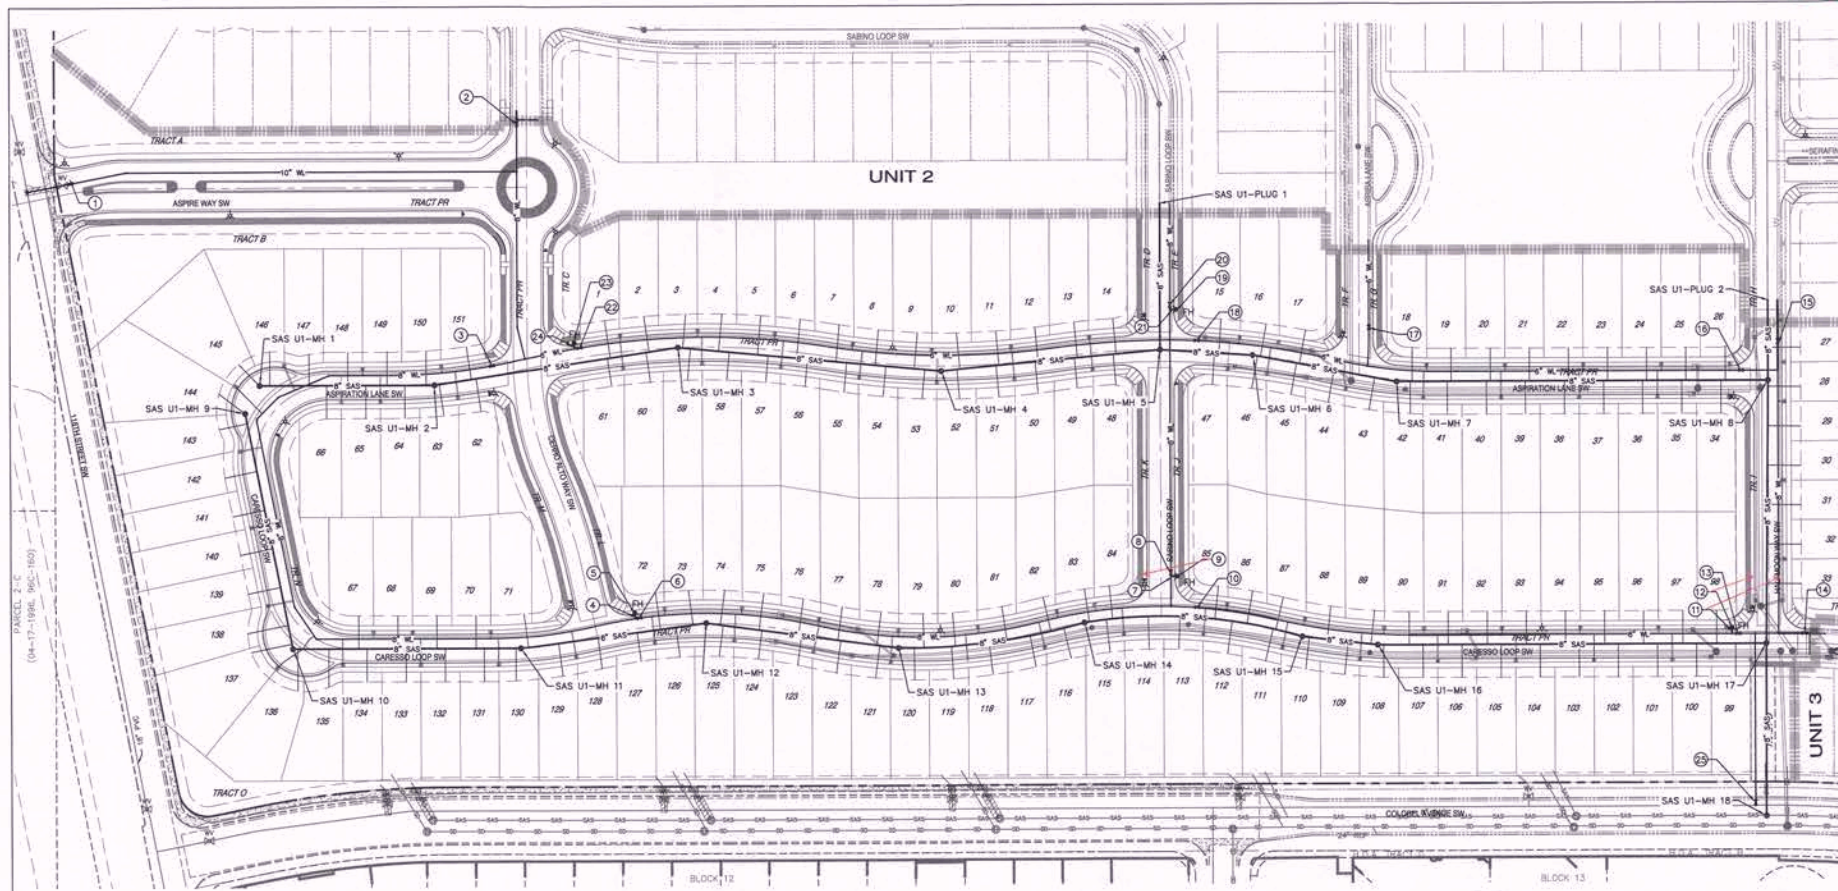

① AS-BUILT COORDINATES			
NOS.	X	Y	Z
1	14690537.7	14690496.8	5262.6
2	14690536.7	14690535.4	5261.6
3	14690535.3	14690535.3	5261.6
4	14690537.0	14690500.8	5261.8
5	14690535.6	14690527.6	5261.6
6	14690535.8	14690527.6	5261.6
7	14690501.7	14690691.6	5268.7
8	14690499.9	14690577.7	5268.6
9	14690512.2	14690559.1	5268.6
10	14690513.7	14690559.1	5268.6
11	1491123.7	14690502.0	5188.6
12	1491123.9	14690502.0	5188.6
13	14911065.0	14690330.7	5188.7
14	1491146.3	14690321.1	5188.3
15	1491104.4	14690321.4	5188.3
16	14911093.1	14690279.8	5189.1
17	14690708.5	14690435.3	5265.6
18	14690708.9	14690435.3	5265.6
19	14690749.1	14690395.2	5271.9
20	14690596.7	14690670.0	5214.6
21	14690596.7	14690670.0	5214.6
22	14690590.1	14690537.5	5260.7
23	14690994.1	14690331.7	5262.9
24	14690994.1	14690331.7	5262.9
25	14691101.7	14690693.4	5178.1

LEGEND

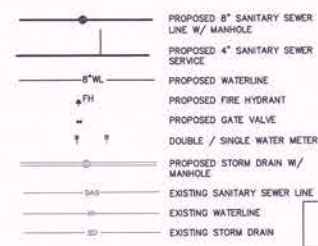

CITY OF ALBUQUERQUE
PUBLIC WORKS DEPARTMENT
ENGINEERING DEVELOPMENT GROUP
ASPIRE SUBDIVISION, UNIT 1

AS-BUILT COORDINATES

DESIGN REVIEW COMMITTEE	CITY ENGINEER APPROVAL	LAST DESIGN POINT	Mo./DAY/YR	Mo./DAY/YR
Approved by <i>Albuquerque</i> Design Review Committee and City Engineer June 28, 2011				
City Project No.	757580	Zone Map No.	Sheet	Of
		N-8-Z	29	37

Approved by Albuquerque
Design Review Committee and
City Engineer June 29, 2021

City Project No. 757580	Zone Map No. N-8-Z	Sheet 29 Of 37
-----------------------------------	------------------------------	------------------------------

UTILITY NOTES

1. CONSTRUCT 4" SAS SERVICES PER ABCMUA STD DWG #2125.
2. CONSTRUCT SAS MANHOLES W/ FRAME & COVER PER ABCMUA STD DWG #2102 & #2109 (CONCENTRIC).
3. WATERLINE CONNECTIONS PER ABCMUA STD DWG 2301.
4. INSTALL NON-PRESSURE CONNECTIONS PER ABCMUA STD DWG 2301.
5. INSTALL WATER VALVE BOX WITH RING AND COVER PER ABCMUA STD DWG 2326 & 2328.
6. CONSTRUCT 3/4" WATER SERVICES AND METER BOXES PER ABCMUA STD DWG #2361, 2362, 2366 & 2368.
7. CONSTRUCT FIRE HYDRANTS PER DESIGNATED DEPTHS & LENGTHS PER ABCMUA STD DWG #2340.
8. SEE SHEET 28 FOR WATER SHUT-OFF PLAN.
9. SEE SHEET 28 FOR RESTRAINED JOINT LENGTHS FOR WATER LINE FITTINGS.
10. SEE SHEET 29 FOR AS-BUILT COORDINATE TABLES.
11. ALL WATERLINES SHALL BE C-900 UNLESS OTHERWISE NOTED.
12. ALL SANITARY SEWER LINES SHALL BE SDR-35.
13. TRACER WIRE AND APPURTENANCES SHALL BE INSTALLED PER ABCMUA STD DWGS 2190, 2191, 2302, 2327, 2365, 2343, 2375, 2740 & 2741. COST FOR TRACER WIRES & APPURTENANCES SHALL BE INCLUDED IN WATER & SEWER LINE PIPE PAY ITEMS.
14. REMOVE & REPLACE ARTERIAL PAVING PER COA STD DWG 2465.

WATER METER TABLE			
TR.B	SIZE	STATION & OFFSET	ALIGNMENT
IRREG. METER	1.5" *	12+75.00, 25.8' RT	ASPIRE WAY

NOTES:
STATIONING IS TO CENTER OF METER BOX. WATER METERS DOUBLE UNLESS NOTED WITH * FOR SINGLE METERS.

WATER METER COORDINATES			
	X	Y	
IRREG. METER			

SCALES:
1"=40' HOR.
1"=10' VERT.

Elevation
Datum:
NAVD 88

Isaacson & Artman, Inc.
Civil Engineering Consultants


128 Monroe Street NE
Albuquerque, NM 87108
505-265-8828 | www.isacvil.com

CITY OF ALBUQUERQUE
PUBLIC WORKS DEPARTMENT
ENGINEERING DEVELOPMENT GROUP
ASPIRE SUBDIVISION, UNIT 1


ASPIRE WAY
UTILITY PLAN & PROFILE

DESIGN REVIEW COMMITTEE	CITY ENGINEER APPROVAL	DATE	BY


City Project No. 757580 Zone Map No. N-8-Z Sheet 30 of 37

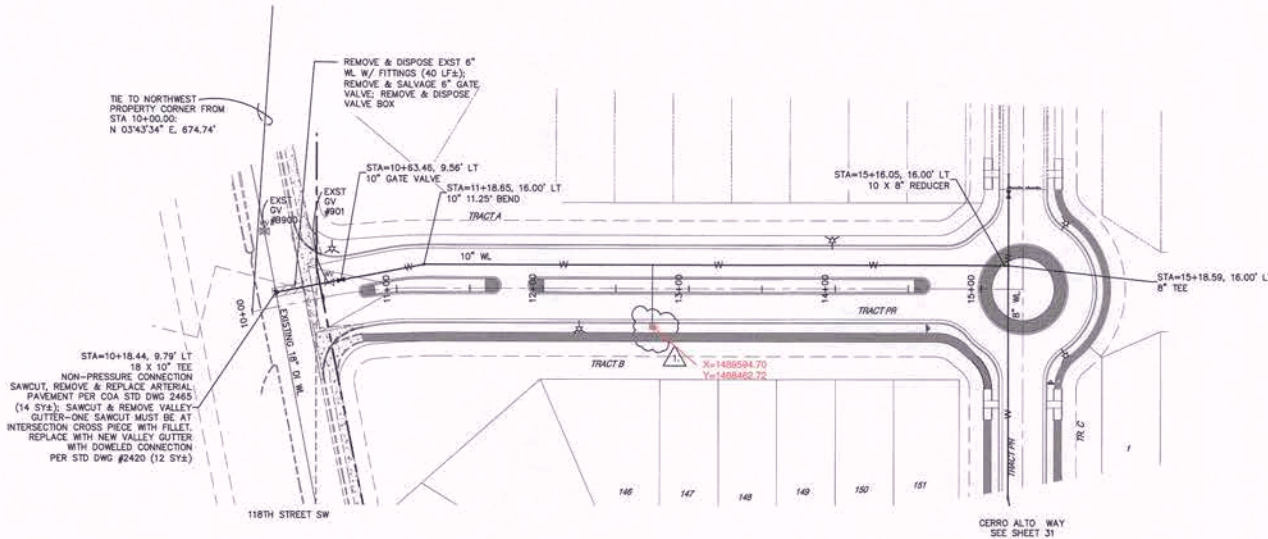

ASPIRE WAY

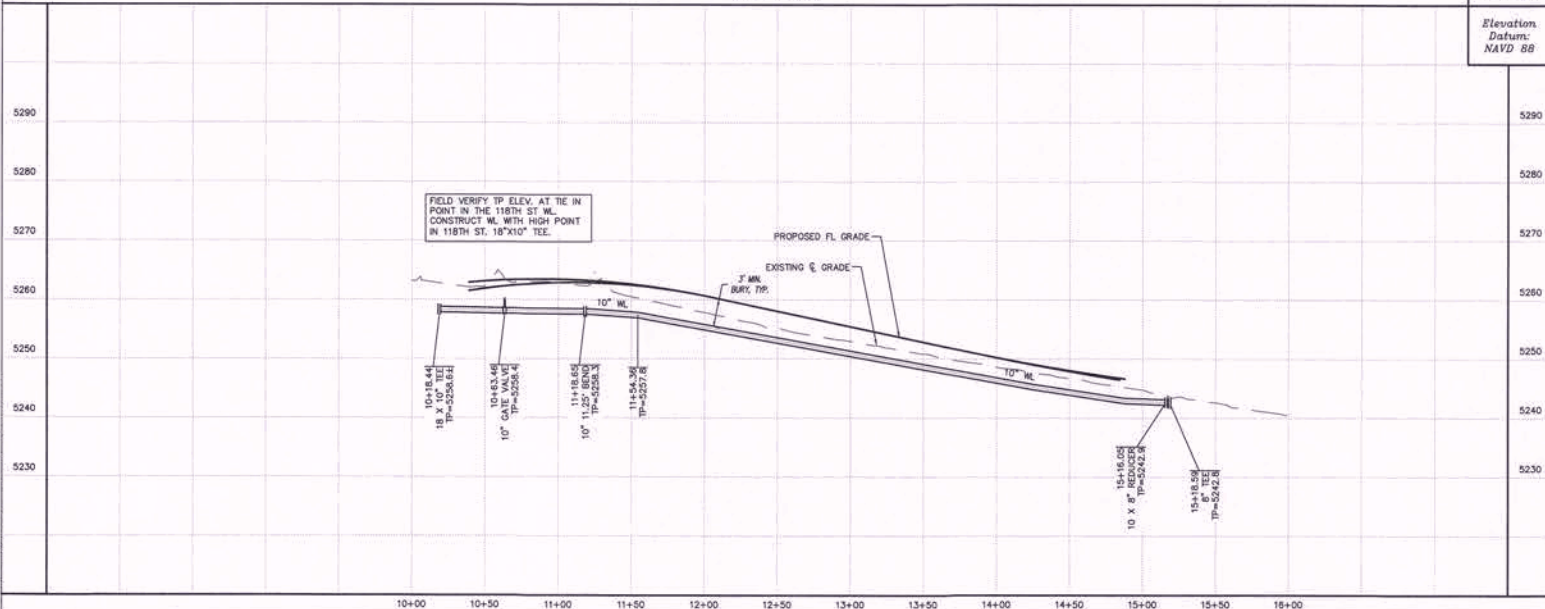


10+00 10+50 11+00 11+50 12+00 12+50 13+00 13+50 14+00 14+50 15+00 15+50 16+00

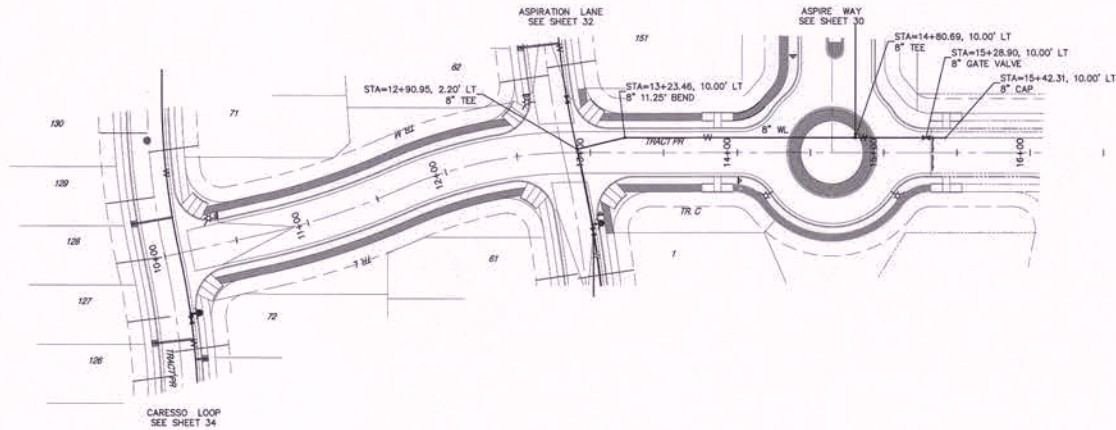

CERRO ALTO WAY

SCALES:
1"=40' HOR.
1"=10' VERT.

Elevation
Datum:
NAVD 88

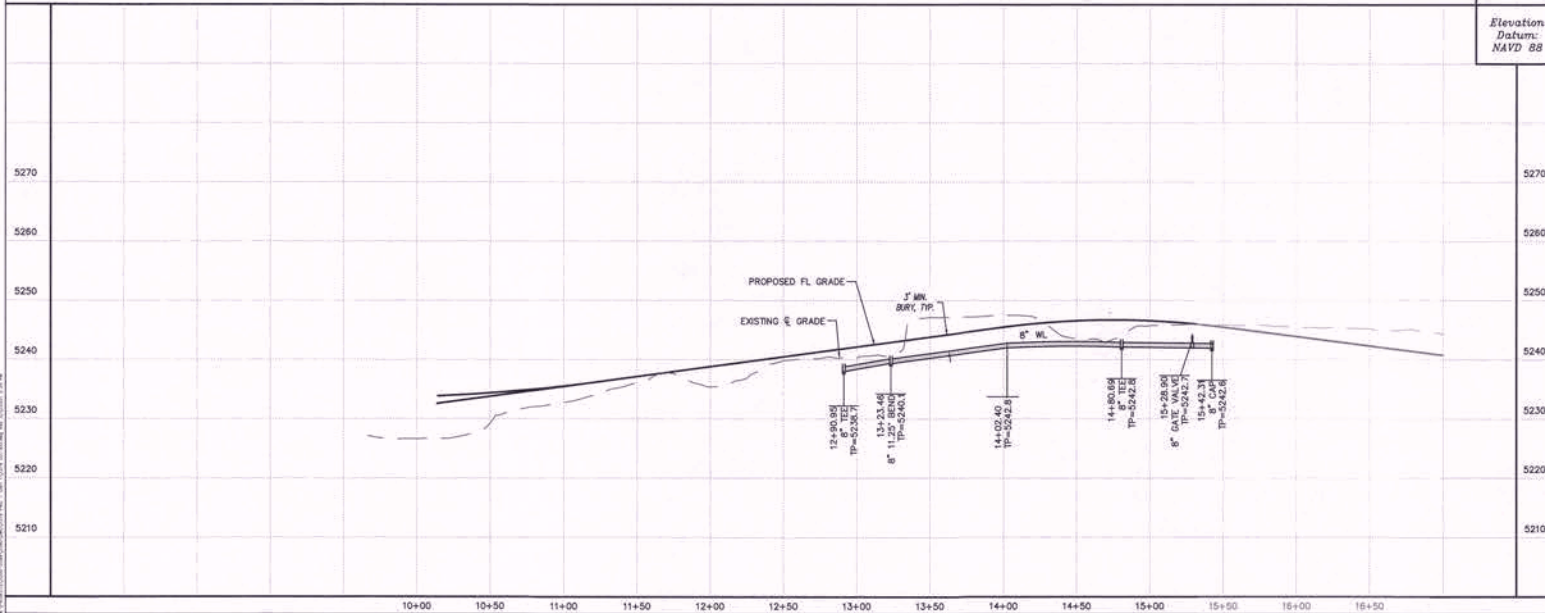

UTILITY NOTES

1. CONSTRUCT 4" SAS SERVICES PER ABCWUA STD DWG #2125.
2. CONSTRUCT SAS MANHOLES W/ FRAME & COVER PER ABCWUA STD DWG #2102 & #2106 (CONCENTRIC).
3. WATERLINE CONNECTIONS PER ABCWUA STD DWG 2301.
4. INSTALL NON-PRESSURE CONNECTIONS PER ABCWUA STD DWG 2301.
5. INSTALL WATER VALVE BOX WITH RING AND COVER PER ABCWUA STD DWG 2328 & 2328.
6. CONSTRUCT 3/4" WATER SERVICES AND METER BOXES PER ABCWUA STD DWG #2361, 2362, 2366 & 2368.
7. CONSTRUCT FIRE HYDRANTS PER DESIGNATED DEPTHS & LONGTOS PER ABCWUA STD DWG #2340.
8. SEE SHEET 28 FOR WATER SHUT-OFF PLAN.
9. SEE SHEET 28 FOR RESTRAINED JOINT LENGTHS FOR WATER LINE FITTINGS.
10. SEE SHEET 29 FOR AS-BUILT COORDINATE TABLES.
11. ALL WATERLINES SHALL BE C-900 UNLESS OTHERWISE NOTED.
12. ALL SANITARY SEWER LINES SHALL BE SDR-35.
13. TRACER WIRE AND APPURTENANCES SHALL BE INSTALLED PER ABCWUA STD DWGS 2190, 2191, 2302, 2327, 2365, 2366, 2379, 2740 & 2741. COST FOR TRACER WIRES & APPURTENANCES SHALL BE INCLUDED IN WATER & SEWER LINE PIPE PAY ITEMS.
14. REMOVE & REPLACE ARTERIAL PAVING PER COA STD DWG 2465.


AS-BUILT INFORMATION		BENCH MARKS		SURVEY INFORMATION		ENGINEER'S SEAL	
CONTRACTOR	DATE	AGS MONUMENT	BENCHMARK "1-NR"	FIELD NOTES	DATE	SEAL	DATE
CONTRACTOR	DATE	AGS MONUMENT	BENCHMARK "1-NR"	FIELD NOTES	DATE	SEAL	DATE
CONTRACTOR	DATE	AGS MONUMENT	BENCHMARK "1-NR"	FIELD NOTES	DATE	SEAL	DATE
CONTRACTOR	DATE	AGS MONUMENT	BENCHMARK "1-NR"	FIELD NOTES	DATE	SEAL	DATE

Isaacson & Artman, Inc.
Civil Engineering Consultants
128 Monroe Street NE
Albuquerque, NM 87108
505-268-8828 | www.isacivil.com

CITY OF ALBUQUERQUE
PUBLIC WORKS DEPARTMENT
ENGINEERING DEVELOPMENT GROUP
ASPIRE SUBDIVISION, UNIT 1
CERRO ALTO WAY
UTILITY PLAN & PROFILE

DESIGN REVIEW COMMITTEE	CITY ENGINEER APPROVAL	Ms./DAY/YR	Ms./DAY/YR
DESIGNED BY	DATE	CHECKED BY	DATE
DRAWN BY	DATE	DATE	DATE
LAST DESIGN UPDATE	DATE	DATE	DATE

City Project No. 757580 Zone Map No. N-8-Z Sheet 31 of 37

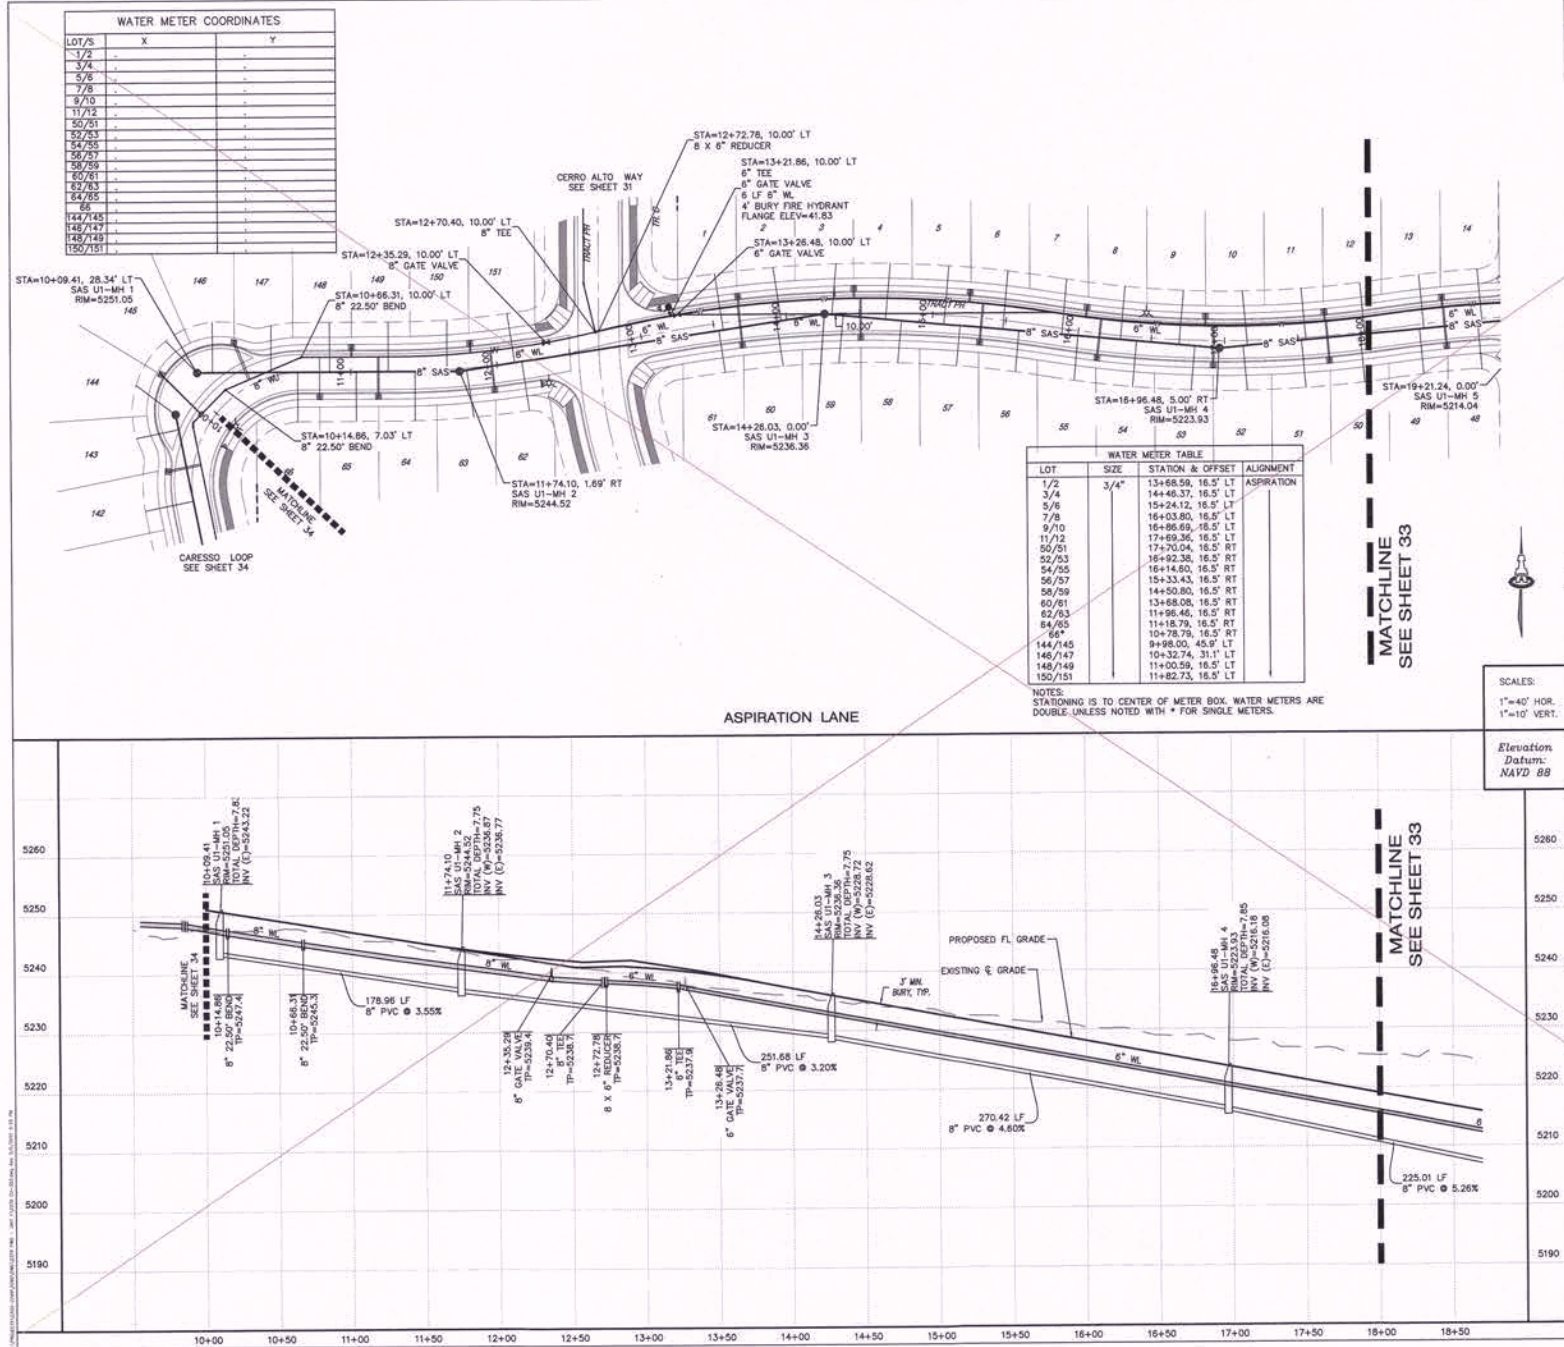

UTILITY NOTES

- CONSTRUCT 4" SAS SERVICES PER ABCWIA STD DWG #2125.
- CONSTRUCT SAS MANHOLES W/ FRAME & COVER PER ABCWIA STD DWG #2102 & #2109 (CONCENTRIC).
- WATERLINE CONNECTIONS PER ABCWIA STD DWG 2301.
- INSTALL NON-PRESSURE CONNECTIONS PER ABCWIA STD DWG 2301.
- INSTALL WATER VALVE BOX WITH RING AND COVER PER ABCWIA STD DWG 2326 & 2328.
- CONSTRUCT 3/4" WATER SERVICES AND METER BOXES PER ABCWIA STD DWG #2361, 2362, 2364 & 2366.
- CONSTRUCT FIRE HYDRANTS PER DESIGNATED DEPTHS & LENGTHS PER ABCWIA STD DWG #2340.
- SEE SHEET 28 FOR WATER SHUT-OFF PLAN.
- SEE SHEET 28 FOR RESTRAINED JOINT LENGTHS FOR WATER LINE FITTINGS.
- SEE SHEET 29 FOR AS-BUILT COORDINATE TABLES.
- ALL WATERLINES SHALL BE C-900 UNLESS OTHERWISE NOTED.
- ALL SANITARY SEWER LINES SHALL BE SDR-35.
- TRACER WIRE AND APPURTENANCES SHALL BE INSTALLED PER ABCWIA STD DWGS 2190, 2191, 2302, 2327, 2350, 2342, 2379, 2740 & 2741. COST FOR TRACER WIRES & APPURTENANCES SHALL BE INCLUDED IN WATER & SEWER LINE PIPE PAY ITEMS.
- REMOVE & REPLACE ARTERIAL PAVING PER COA STD DWG 2465.

WATER METER TABLE

LOT	SIZE	STATION & OFFSET	ALIGNMENT
1/2	3/4"	13+68.59, 16.5" LT	ASPIRATION
3/4	3/4"	14+46.37, 16.5" LT	ASPIRATION
5/8	3/4"	15+24.12, 16.5" LT	ASPIRATION
7/8	3/4"	16+03.80, 16.5" LT	ASPIRATION
9/10	3/4"	16+86.68, 16.5" LT	ASPIRATION
11/12	3/4"	17+69.56, 16.5" LT	ASPIRATION
50/51	3/4"	17+70.04, 16.5" LT	ASPIRATION
52/53	3/4"	18+62.38, 16.5" LT	ASPIRATION
54/55	3/4"	18+14.60, 16.5" LT	ASPIRATION
56/57	3/4"	19+33.43, 16.5" LT	ASPIRATION
58/59	3/4"	14+50.80, 16.5" LT	ASPIRATION
60/61	3/4"	13+68.00, 16.5" LT	ASPIRATION
62/63	3/4"	11+96.46, 16.5" LT	ASPIRATION
64/65	3/4"	11+16.76, 16.5" LT	ASPIRATION
66	3/4"	10+78.78, 16.5" LT	ASPIRATION
144/145	3/4"	9+98.00, 45.9" LT	ASPIRATION
146/147	3/4"	10+32.74, 31.1" LT	ASPIRATION
148/149	3/4"	11+00.59, 16.5" LT	ASPIRATION
150/151	3/4"	11+82.73, 16.5" LT	ASPIRATION

SAS SERVICE TABLE

LOT #	SIZE	STATION & OFFSET	INV @ END
1	4"	13+55.21, 33.5" LT	5235.6
2	4"	13+81.09, 33.5" LT	5233.9
3	4"	14+35.00, 33.5" LT	5231.9
4	4"	14+70.44, 33.5" LT	5230.0
5	4"	15+08.87, 33.5" LT	5228.2
6	4"	15+47.46, 33.5" LT	5226.3
7	4"	15+86.68, 33.5" LT	5224.6
8	4"	16+28.11, 33.5" LT	5222.7
9	4"	16+70.75, 33.5" LT	5220.7
10	4"	17+12.62, 33.5" LT	5218.8
11	4"	17+54.78, 33.5" LT	5216.8
12	4"	17+96.73, 33.5" LT	5215.2
13	4"	17+91.77, 33.5" LT	5215.1
14	4"	17+53.22, 33.5" LT	5216.7
15	4"	17+14.86, 33.5" LT	5218.7
16	4"	16+78.22, 33.5" LT	5220.3
17	4"	16+39.85, 33.5" LT	5222.1
18	4"	16+01.39, 33.5" LT	5224.1
19	4"	15+60.97, 33.5" LT	5225.7
20	4"	15+18.81, 33.5" LT	5227.7
21	4"	14+76.90, 33.5" LT	5229.7
22	4"	14+34.08, 33.5" LT	5231.6
23	4"	13+95.21, 33.5" LT	5233.2
24	4"	13+53.69, 33.5" LT	5235.1
25	4"	12+17.13, 33.5" LT	5238.6
26	4"	11+81.03, 33.5" LT	5239.6
27	4"	11+43.02, 33.5" LT	5241.1
28	4"	11+03.79, 33.5" LT	5242.8
29	4"	10+61.75, 33.5" LT	5244.4
30	4"	10+19.06, 33.5" LT	5247.4
31	4"	10+28.23, 49.8" LT	5246.5
32	4"	10+51.96, 33.5" LT	5244.9
33	4"	10+85.59, 33.5" LT	5243.6
34	4"	11+25.40, 33.5" LT	5241.9
35	4"	11+67.82, 33.5" LT	5240.2
36	4"	12+11.61, 33.5" LT	5238.2

NOTES:

- STATIONING IS TO CENTER OF METER BOX. WATER METERS ARE DOUBLE UNLESS NOTED WITH * FOR SINGLE METERS.

SCALE:

- 1"=40' HOR.
- 1"=10' VERT.

Elevation Datum: NAVD 88


AS-BUILT INFORMATION

NO.	DATE	REVISIONS
1	02/20/21	DESIGN
2	02/20/21	REVISION
3	02/20/21	REVISION
4	02/20/21	REVISION

City Project No. 757580

Zone Map No. N-8-Z

Sheet 32 of 37

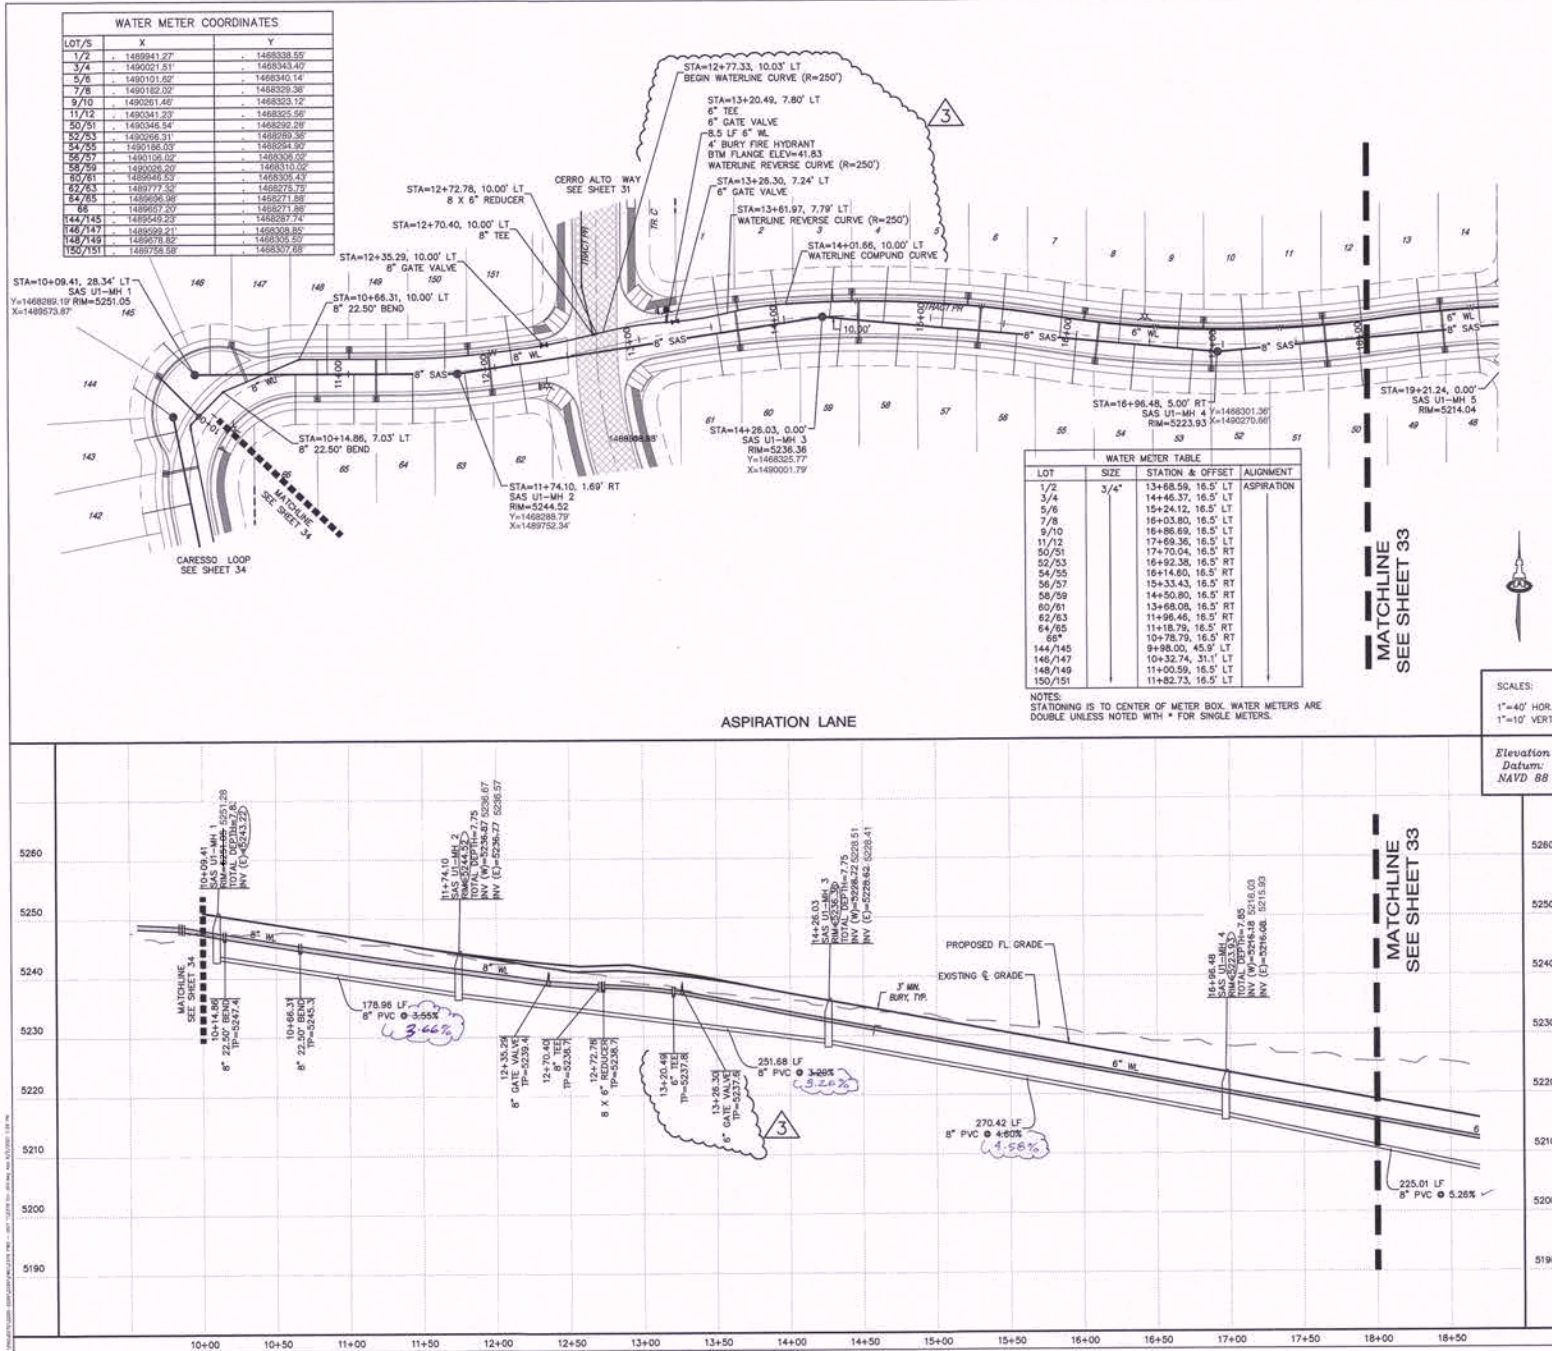

UTILITY NOTES

- CONSTRUCT 4" SAS SERVICES PER ABCWIA STD DWG #2125.
- CONSTRUCT SAS MANHOLES W/ FRAME & COVER PER ABCWIA STD DWG #2102 & #2109 (CONCENTRIC).
- WATERLINE CONNECTIONS PER ABCWIA STD DWG 2301.
- INSTALL NON-PRESSURE CONNECTIONS PER ABCWIA STD DWG 2301.
- INSTALL WATER VALVE BOX WITH RING AND COVER PER ABCWIA STD DWG 2326 & 2328.
- CONSTRUCT 3/4" WATER SERVICES AND METER BOXES PER ABCWIA STD DWG #2301, 2326, 2328, 2329, 2345, 2346, 2347, 2348 & 2349. COST FOR TRACER WIRES & APPURTENANCES SHALL BE INCLUDED IN WATER & SEWER LINE PIPE PAY ITEMS.
- CONSTRUCT FIRE HYDRANTS PER DESIGNATED DEPTHS & LENGTHS PER ABCWIA STD DWG #2340.
- SEE SHEET 28 FOR WATER SHUT-OFF PLAN.
- SEE SHEET 28 FOR RESTRAINED JOINT LENGTHS FOR WATER LINE FITTINGS.
- SEE SHEET 29 FOR AS-BUILT COORDINATE TABLES.
- ALL WATERLINES SHALL BE C=900 UNLESS OTHERWISE NOTED.
- ALL SANITARY SEWER LINES SHALL BE SDR-35.
- TRACER WIRE AND APPURTENANCES SHALL BE INSTALLED PER ABCWIA STD DWGS 2190, 2191, 2322, 2327, 2345, 2346, 2347, 2348 & 2349. COST FOR TRACER WIRES & APPURTENANCES SHALL BE INCLUDED IN WATER & SEWER LINE PIPE PAY ITEMS.
- REMOVE & REPLACE ARTERIAL PAVING PER COA STD DWG 2465.

AS-BUILT INFORMATION

FIELD NOTES

ENGINEER'S SEAL

REVISIONS

NO.	DATE	BY	REVISIONS
1	07/21	AW	ADJUSTED AS-BUILT COORDINATE TABLES
2	07/21	AW	ADJUSTED AS-BUILT COORDINATE TABLES


Isaacson & Arfman, Inc.
Civil Engineering Consultants
128 Monroe Street NE
Albuquerque, NM 87108
505-266-8828 • www.isac.com

CITY OF ALBUQUERQUE
PUBLIC WORKS DEPARTMENT
ENGINEERING DEVELOPMENT GROUP
ASPIRE SUBDIVISION, UNIT 1
ASPIRATION LANE
UTILITY PLAN & PROFILE

DESIGN REVIEW COMMITTEE

DESIGN REVIEW COMMITTEE	CITY ENGINEER APPROVAL	W.D./DAY/VR	W.D./DAY/VR

City Project No. **757580** Zone Map No. **N-8-Z** Sheet **32** Of **37**

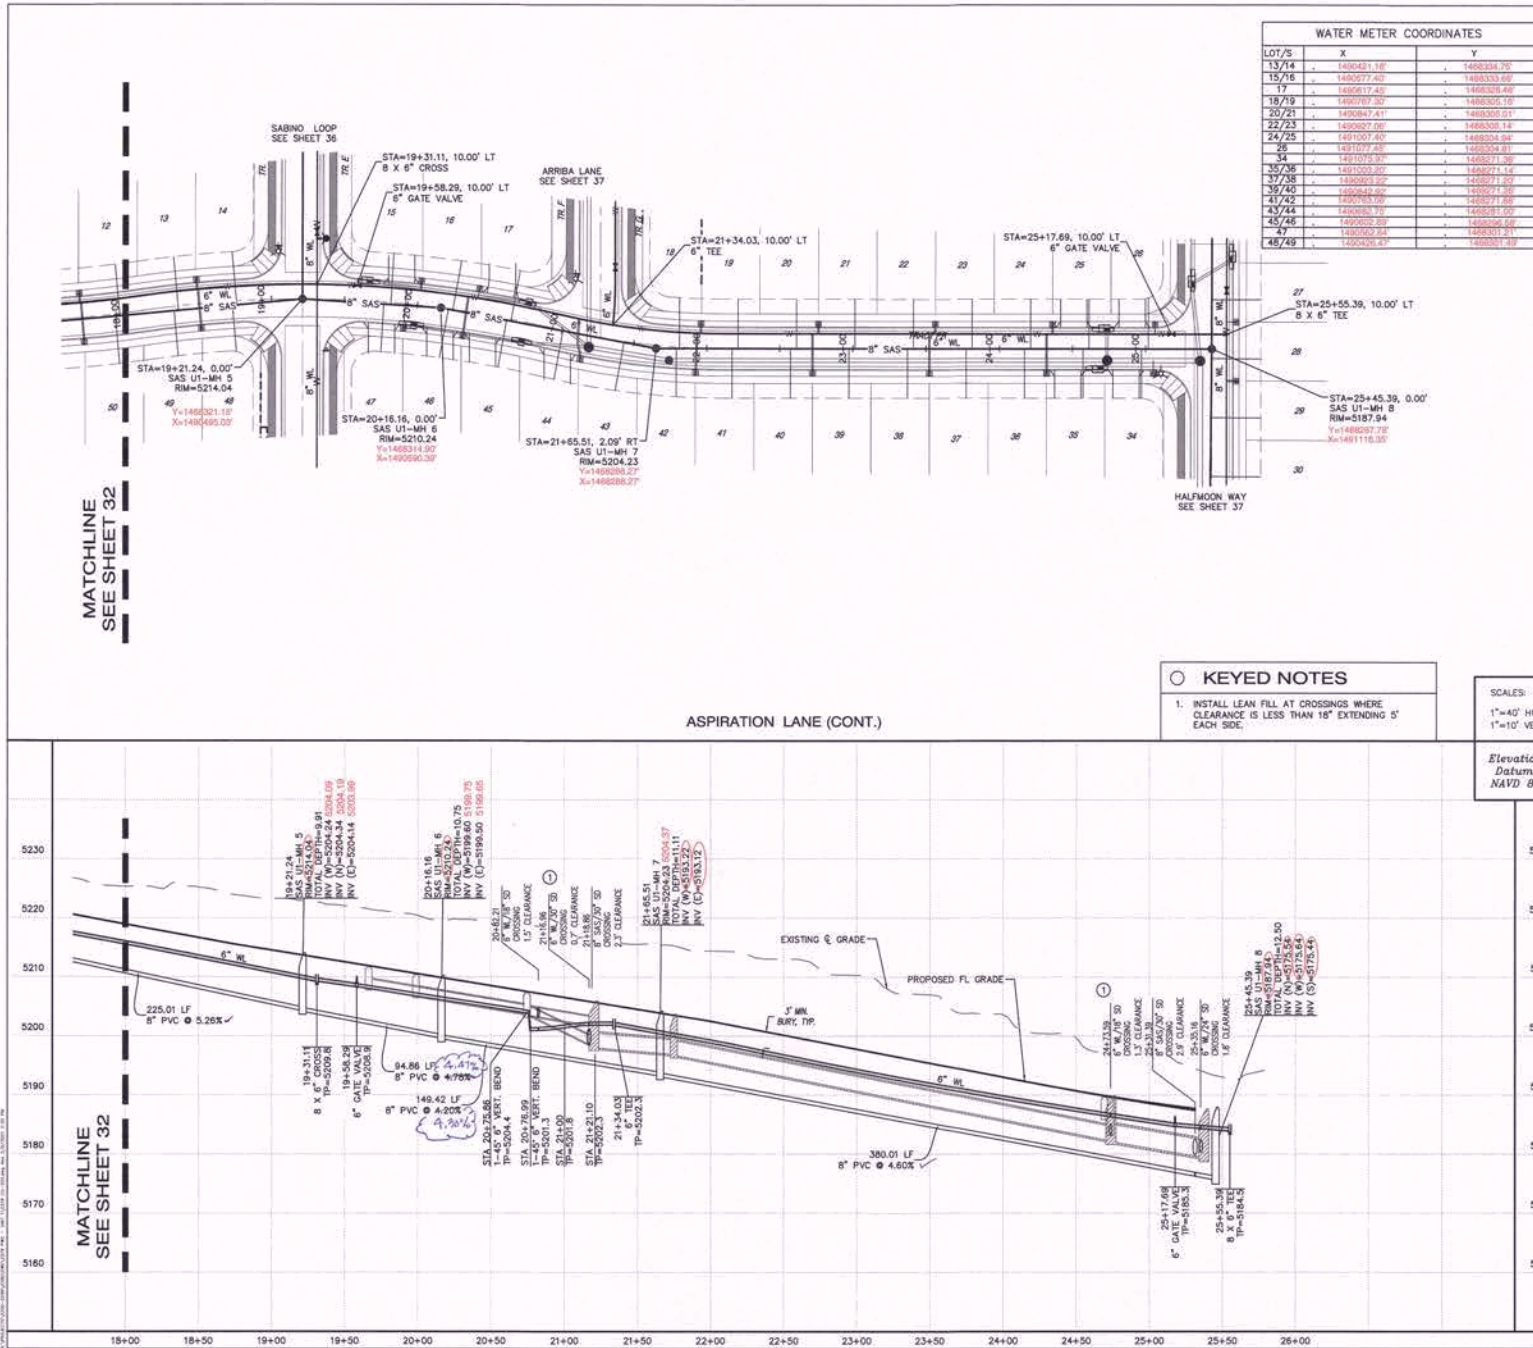

WATER METER COORDINATES		
LOT/S	X	Y
13/14	148048.11E	1480304.75
15/16	148057.40	1480333.69
17	1480517.43	1480328.49
18/19	148057.30	1480326.18
20/21	148064.41	1480305.51
22/23	148067.06	1480308.14
24/25	1481007.40	1480304.84
26	148107.23	1480304.81
34	148107.30	1480271.39
35/36	1481003.30	1480271.14
37/38	148093.02	1480271.80
39/40	148068.92	1480271.30
41/42	148063.50	1480271.89
43/44	148063.31	1480281.00
45/46	148063.29	1480306.69
47	148062.84	1480301.21
48/49	148056.87	148021.19

UTILITY NOTES

- CONSTRUCT 4" SAS SERVICES PER ABQWIA STD DWG #2125.
- CONSTRUCT GAS MANHOLES W/ FRAME & COVER PER ABQWIA STD DWG #2102 & #2109 (CONCENTRIC).
- WATERLINE CONNECTIONS PER ABQWIA STD DWG 2301.
- INSTALL NON-PRESSURE CONNECTIONS PER ABQWIA STD DWG 2301.
- INSTALL WATER VALVE BOX WITH RING AND COVER PER ABQWIA STD DWG 2336 & 2338.
- CONSTRUCT 3/4" WATER SERVICES AND METER BOXES PER ABQWIA STD DWG #2361, 2362, 2366 & 2368.
- CONSTRUCT FIRE HYDRANTS PER DESIGNATED DEPTHS & LENGTHS PER ABQWIA STD DWG #2340.
- SEE SHEET 28 FOR WATER SHUT-OFF PLAN.
- SEE SHEET 28 FOR RESTRAINED JOINT LENGTHS FOR WATER LINE FITTINGS.
- SEE SHEET 29 FOR AS-BUILT COORDINATE TABLES.
- ALL WATERLINES SHALL BE C-900 UNLESS OTHERWISE NOTED.
- ALL SANITARY SEWER LINES SHALL BE SDR-35.
- TRACER WIRE AND APPURTENANCES SHALL BE INSTALLED PER ABQWIA STD DWGS 2190, 2191, 2302, 2327, 2365, 2340, 2379, 2740 & 2741. COST FOR TRACER WIRE & APPURTENANCES SHALL BE INCLUDED IN WATER & SEWER LINE PIPE PAY ITEMS.
- REMOVE & REPLACE ARTERIAL PAVING PER COA STD DWG 2465.

WATER METER TABLE		
LOT	SIZE	STATION & OFFSET ALIGNMENT
13/14	3/4"	18+50.05, 16.5' LT ASPIRATION
15/16		20+01.15, 16.5' LT
17		20+41.17, 16.5' LT
18/19		21+95.60, 16.5' LT
20/21		22+76.34, 16.5' LT
22/23		23+56.34, 16.5' LT
24/25		24+36.34, 16.5' LT
26		25+06.49, 16.5' LT
34		25+05.34, 16.5' RT
35/36		24+32.26, 16.5' RT
37/38		23+52.26, 16.5' RT
39/40		22+72.26, 16.5' RT
41/42		21+93.09, 16.5' RT
43/44		21+16.11, 16.5' RT
45/46		20+33.57, 16.5' RT
47		19+91.81, 16.5' RT
48/49		18+50.83, 45.9' RT

NOTES:
STATIONING IS TO CENTER OF METER BOX. WATER METERS ARE DOUBLE UNLESS NOTED WITH * FOR SINGLE METERS.

SAS SERVICE TABLE		
LOT #	SIZE	STATION & OFFSET INV @ END
13	4"	18+36.56, 33.5' LT 5213.3
14		18+74.98, 33.5' LT 5211.3
15		19+81.16, 33.5' LT 5207.1
16		20+25.82, 33.5' LT 5205.4
17		20+64.75, 33.5' LT 5203.7
18		21+79.20, 33.5' LT 5199.2
19		22+21.34, 33.5' LT 5197.4
20		22+61.34, 33.5' LT 5195.7
21		23+01.34, 33.5' LT 5193.7
22		23+41.34, 33.5' LT 5191.7
23		23+81.34, 33.5' LT 5189.9
24		24+21.34, 33.5' LT 5188.0
25		24+61.34, 33.5' LT 5186.0
26		25+01.34, 33.5' LT 5184.5
27		24+97.26, 33.5' LT 5184.6
35		24+57.26, 33.5' RT 5188.4
36		24+17.26, 33.5' RT 5188.1
37		23+77.26, 33.5' RT 5190.1
38		23+37.26, 33.5' RT 5192.0
39		22+97.26, 33.5' RT 5192.0
40		22+57.26, 33.5' RT 5193.7
41		22+17.26, 33.5' RT 5197.6
42		21+02.50, 33.5' RT 5199.2
43		21+41.78, 33.5' RT 5200.4
44		21+81.25, 33.5' RT 5202.2
45		20+61.90, 33.5' RT 5203.9
46		20+19.42, 33.5' RT 5205.7
47		19+77.29, 33.5' RT 5206.9
48		18+74.02, 34.6' RT 5211.2
49		18+32.30, 33.5' RT 5213.2

NOTE: STATIONING IS AT END OF SAS AT EASEMENT

Isaacson & Arfman, Inc.
Civil Engineering Consultants
128 Monroe Street NE
Albuquerque, NM 87108
505-268-8628 | www.isacsn.com

CITY OF ALBUQUERQUE
PUBLIC WORKS DEPARTMENT
ENGINEERING DEVELOPMENT GROUP
ASPIRE SUBDIVISION, UNIT 1
ASPIRATION LANE (CONT.)
UTILITY PLAN & PROFILE

DESIGN REVIEW COMMITTEE	CITY ENGINEER APPROVAL	Mo./DAY/YR	Mo./DAY/YR
Approved by Albuquerque Design Review Committee and City Engineer June 28, 2021			
City Project No. 757580	Zone Map No. N-8-Z	Sheet 33	Of 37

AS-BUILT INFORMATION


DATE: 02/20/21
BY: [Signature]
CHECKED BY: [Signature]
DATE: 02/20/21

REVISIONS

NO.	DATE	BY	REMARKS
1	02/20/21	ANW	DESIGN
2	02/20/21	ANW	DESIGN

ENGINEER'S SEAL

ISACSON & ARFMAN, INC.
NEW MEXICO
17828
02/20/21

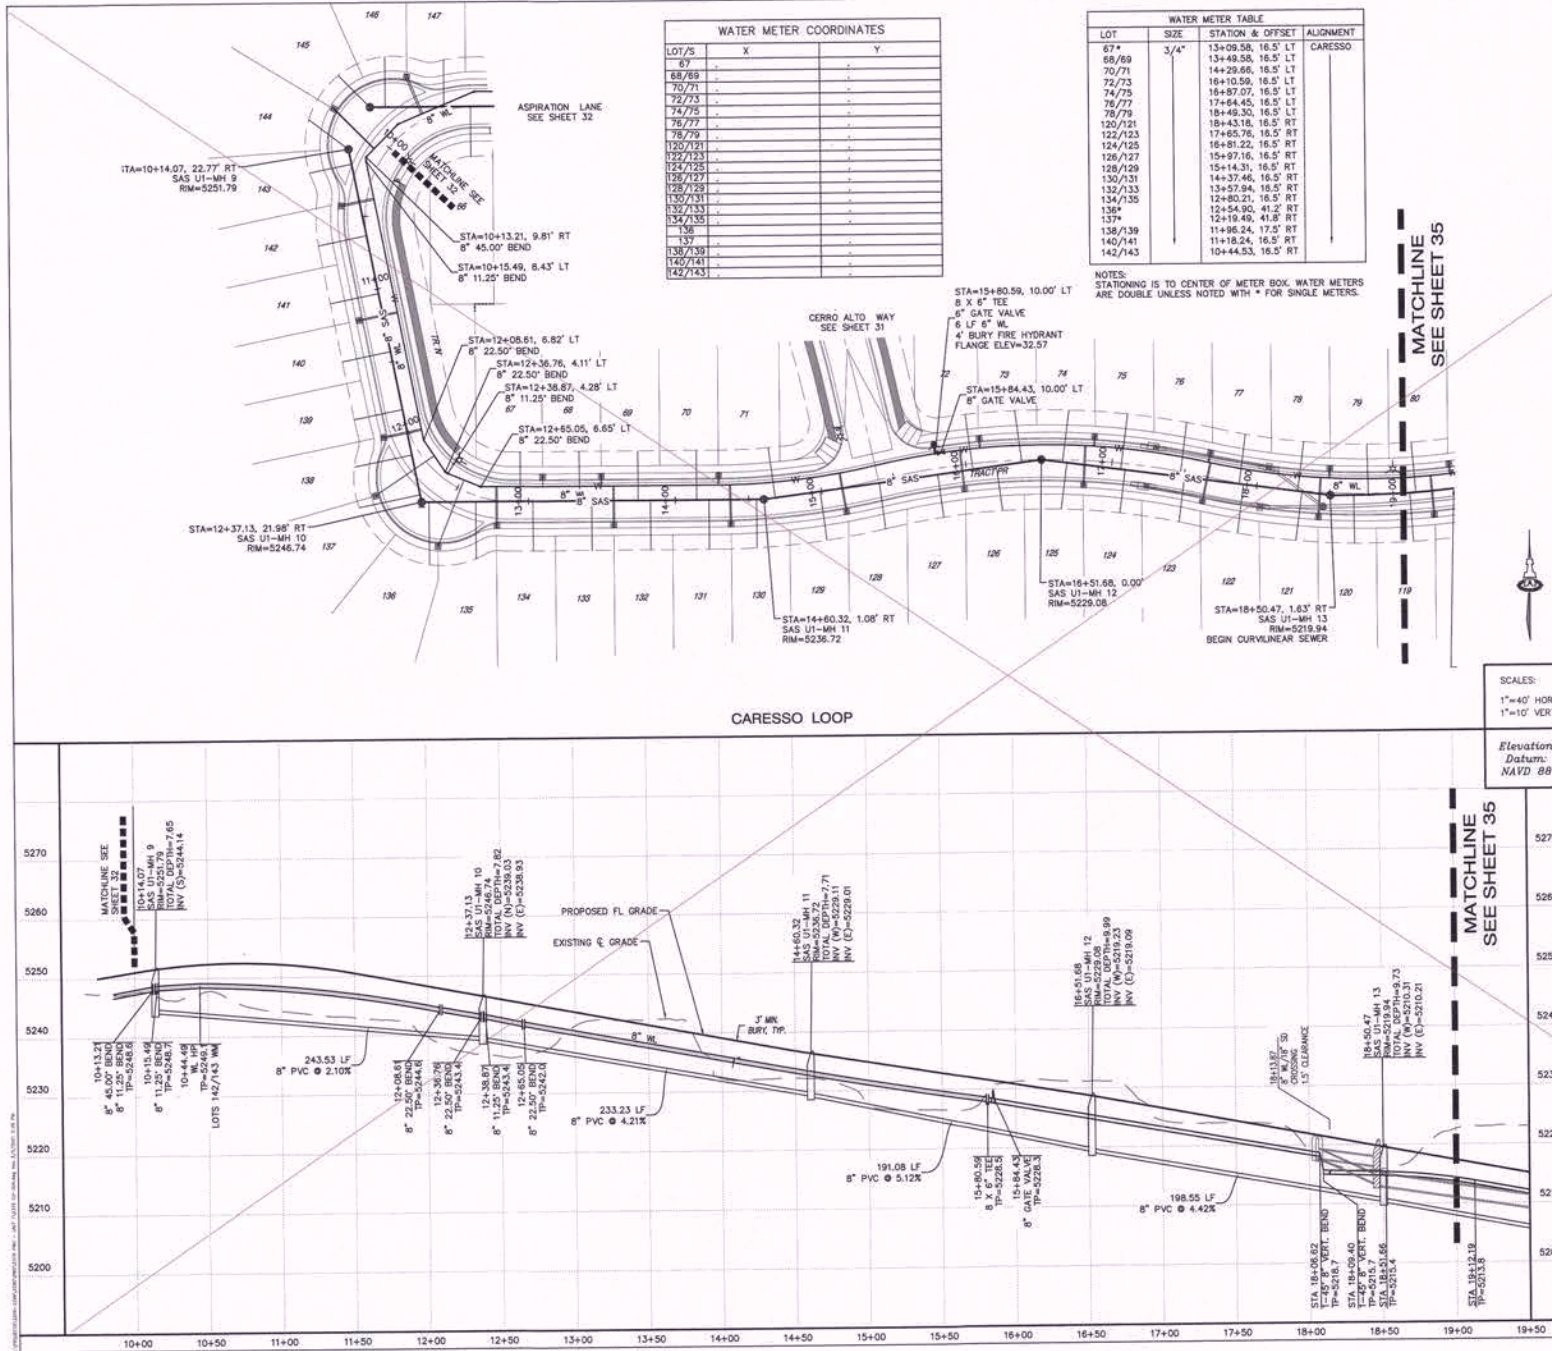

UTILITY NOTES

- CONSTRUCT 4" SAS SERVICES PER ABCWIA STD DWG #2125.
- CONSTRUCT SAS MANHOLES W/ FRAME & COVER PER ABCWIA STD DWG #2102 & #2109 (CONCENTRIC).
- WATERLINE CONNECTIONS PER ABCWIA STD DWG #2301.
- INSTALL NON-PRESSURE CONNECTIONS PER ABCWIA STD DWG #2301.
- INSTALL WATER VALVE BOX WITH RING AND COVER PER ABCWIA STD DWG #2326 & #2328.
- CONSTRUCT 3/4" WATER SERVICES AND WATER BOXES PER ABCWIA STD DWG #2361, #2362, #2366 & #2368.
- CONSTRUCT FIRE HYDRANTS PER DESIGNATED DEPTHS & LENGTHS PER ABCWIA STD DWG #2340.
- SEE SHEET 28 FOR WATER SHUT-OFF PLAN.
- SEE SHEET 28 FOR RESTRAINED JOINT LENGTHS FOR WATER LINE FITTINGS.
- SEE SHEET 29 FOR AS-BUILT COORDINATE TABLES.
- ALL WATERLINES SHALL BE C-900 UNLESS OTHERWISE NOTED.
- ALL SANITARY SEWER LINES SHALL BE SDR-35.
- TRACER WIRE AND APPURTENANCES SHALL BE INSTALLED PER ABCWIA STD DWGS 2190, 2191, 2302, 2327, 2365, 2342, 2379, 2740 & 2741. COST FOR TRACER WIRES & APPURTENANCES SHALL BE INCLUDED IN WATER & SEWER LINE PIPE PAY ITEMS.
- REMOVE & REPLACE ARTERIAL PAVING PER COA STD DWG #465.

SAS SERVICE TABLE

LOT #	SIZE	STATION & OFFSET	INV @ END
67	4"	12+94.58, 33.5' LT	5239.9
68		13+34.58, 33.5' LT	5237.9
69		14+14.58, 33.5' LT	5236.4
70		14+14.58, 33.5' LT	5234.4
71		14+66.35, 33.5' LT	5232.2
72		16+03.10, 33.5' LT	5228.9
73		16+34.82, 33.5' LT	5225.2
74		16+69.51, 33.5' LT	5223.7
75		17+07.20, 33.5' LT	5221.9
76		17+45.37, 33.5' LT	5220.4
77		17+86.35, 33.5' LT	5218.3
78		18+24.44, 33.5' LT	5216.3
79		18+75.55, 33.5' LT	5214.3
120		18+67.26, 33.5' RT	5214.6
121		18+28.75, 33.5' RT	5216.6
122		17+92.05, 33.5' RT	5218.3
123		17+52.55, 33.5' RT	5219.8
124		17+08.88, 33.5' RT	5221.8
125		16+65.77, 33.5' RT	5223.9
126		16+22.88, 33.5' RT	5225.6
127		15+79.89, 33.5' RT	5227.3
128		15+36.89, 33.5' RT	5228.9
129		14+98.61, 33.5' RT	5230.5
130		14+53.60, 33.5' RT	5232.2
131		14+22.93, 33.5' RT	5233.9
132		13+82.83, 33.5' RT	5235.7
133		13+42.93, 33.5' RT	5237.8
134		13+02.93, 33.5' RT	5239.4
135		12+72.66, 41.0' RT	5241.1
136		12+54.98, 59.5' RT	5242.3
137		12+19.27, 55.2' RT	5243.4
138		12+04.08, 43.6' RT	5243.7
139		11+83.24, 44.9' RT	5244.9
140		11+43.24, 33.5' RT	5246.8
141		11+03.24, 33.5' RT	5248.1
142		10+64.18, 33.5' RT	5248.8
143		10+31.38, 33.5' RT	5248.1
144		11+11.34, 33.5' RT	5247.9


Isaacson & Arfman, Inc.
Civil Engineering Consultants
128 Monroe Street NE
Albuquerque, NM 87108
505-268-8828 | www.isacivil.com

CITY OF ALBUQUERQUE
PUBLIC WORKS DEPARTMENT
ENGINEERING DEVELOPMENT GROUP
ASPIRE SUBDIVISION, UNIT 1
CARESSO LOOP
UTILITY PLAN & PROFILE

DESIGN REVIEW COMMITTEE CITY ENGINEER APPROVAL

Approved by Albuquerque Design Review Committee and City Engineer June 28, 2021

City Project No. **757580** Zone Map No. **N-8-Z** Sheet **34** of **37**

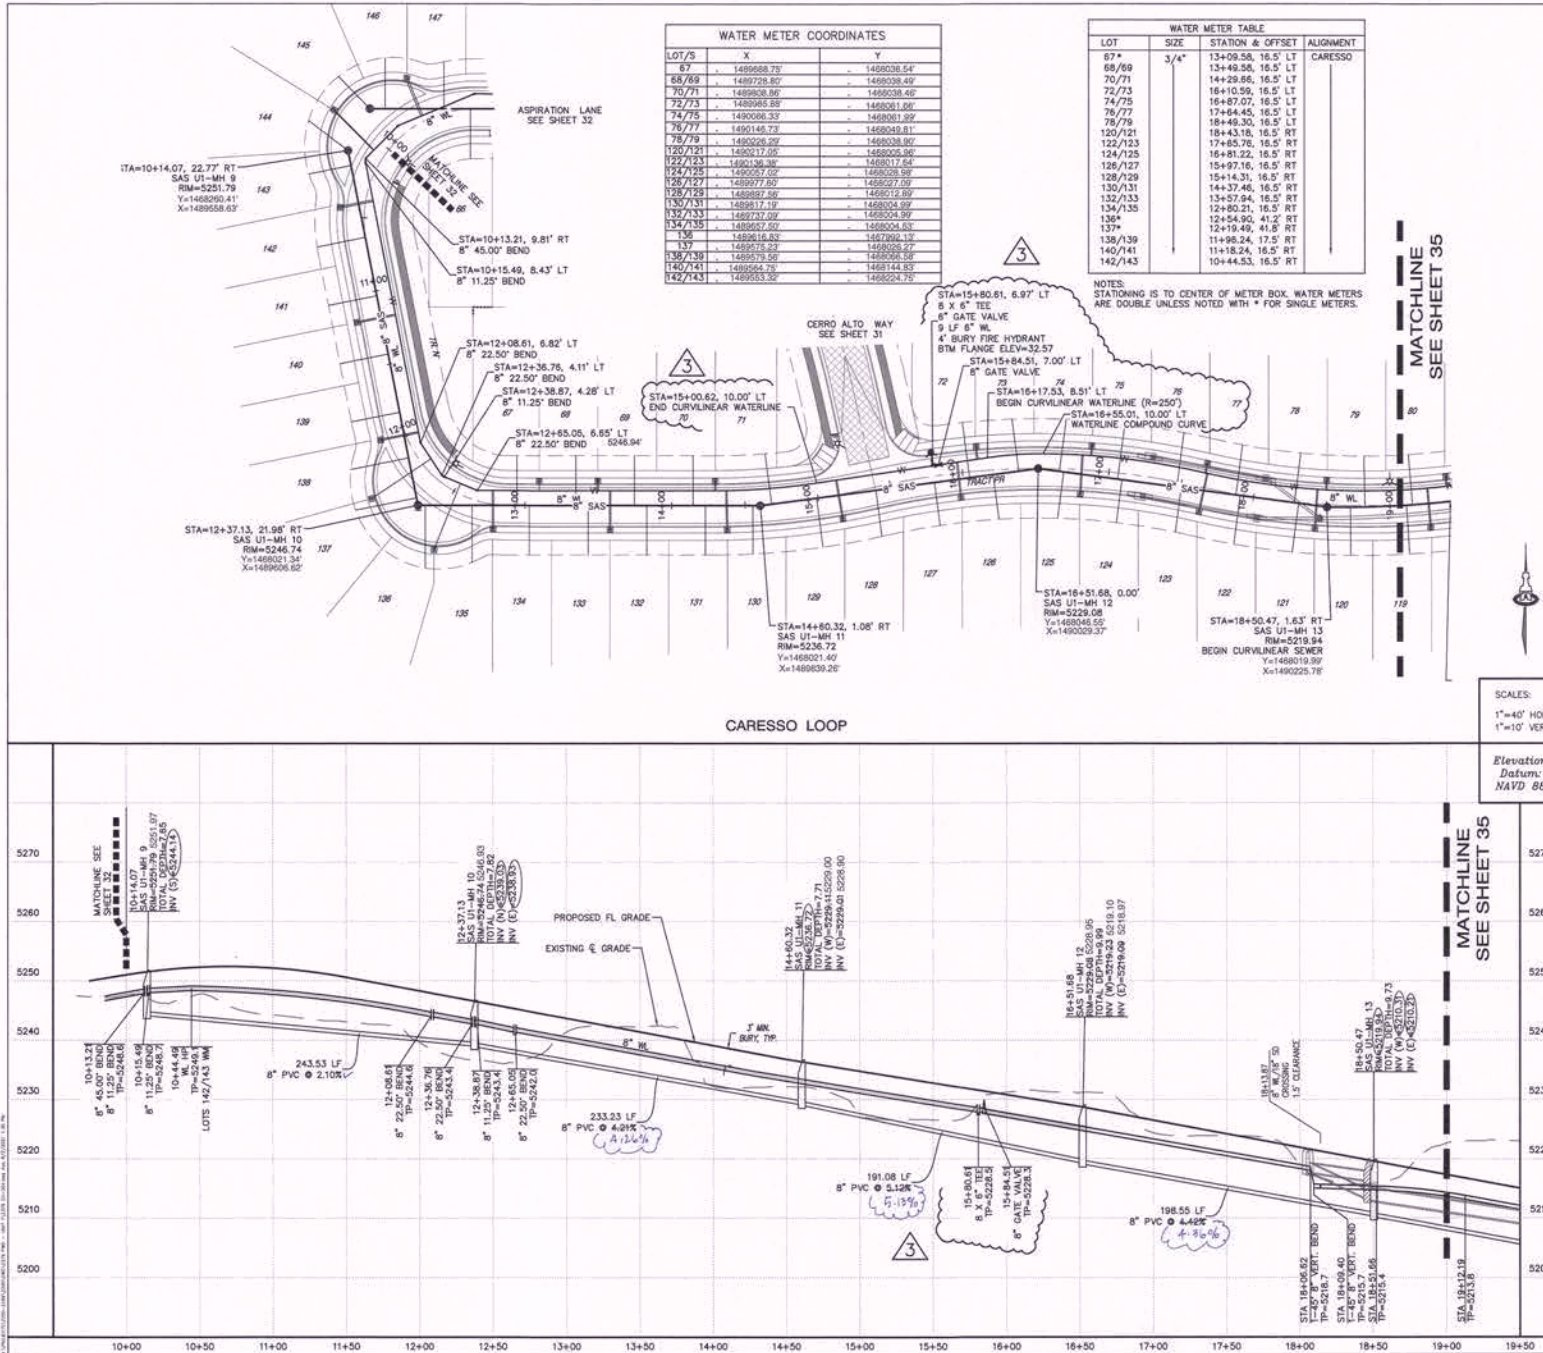

ENGINEER'S SEAL


Isaacson & Artman, Inc.
Civil Engineering Consultants

128 Monroe Street NE
Albuquerque, NM 87106
505-268-8828 | www.isaacsonartman.com

CITY OF ALBUQUERQUE
PUBLIC WORKS DEPARTMENT
ENGINEERING DEVELOPMENT GROUP
ASPIRE SUBDIVISION, UNIT 1
CARESSO LOOP
UTILITY PLAN & PROFILE

DESIGN REVIEW COMMITTEE CITY ENGINEER APPROVAL

City Project No. **757580** Zone Map No. **N-8-Z** Sheet **34** OF **37**

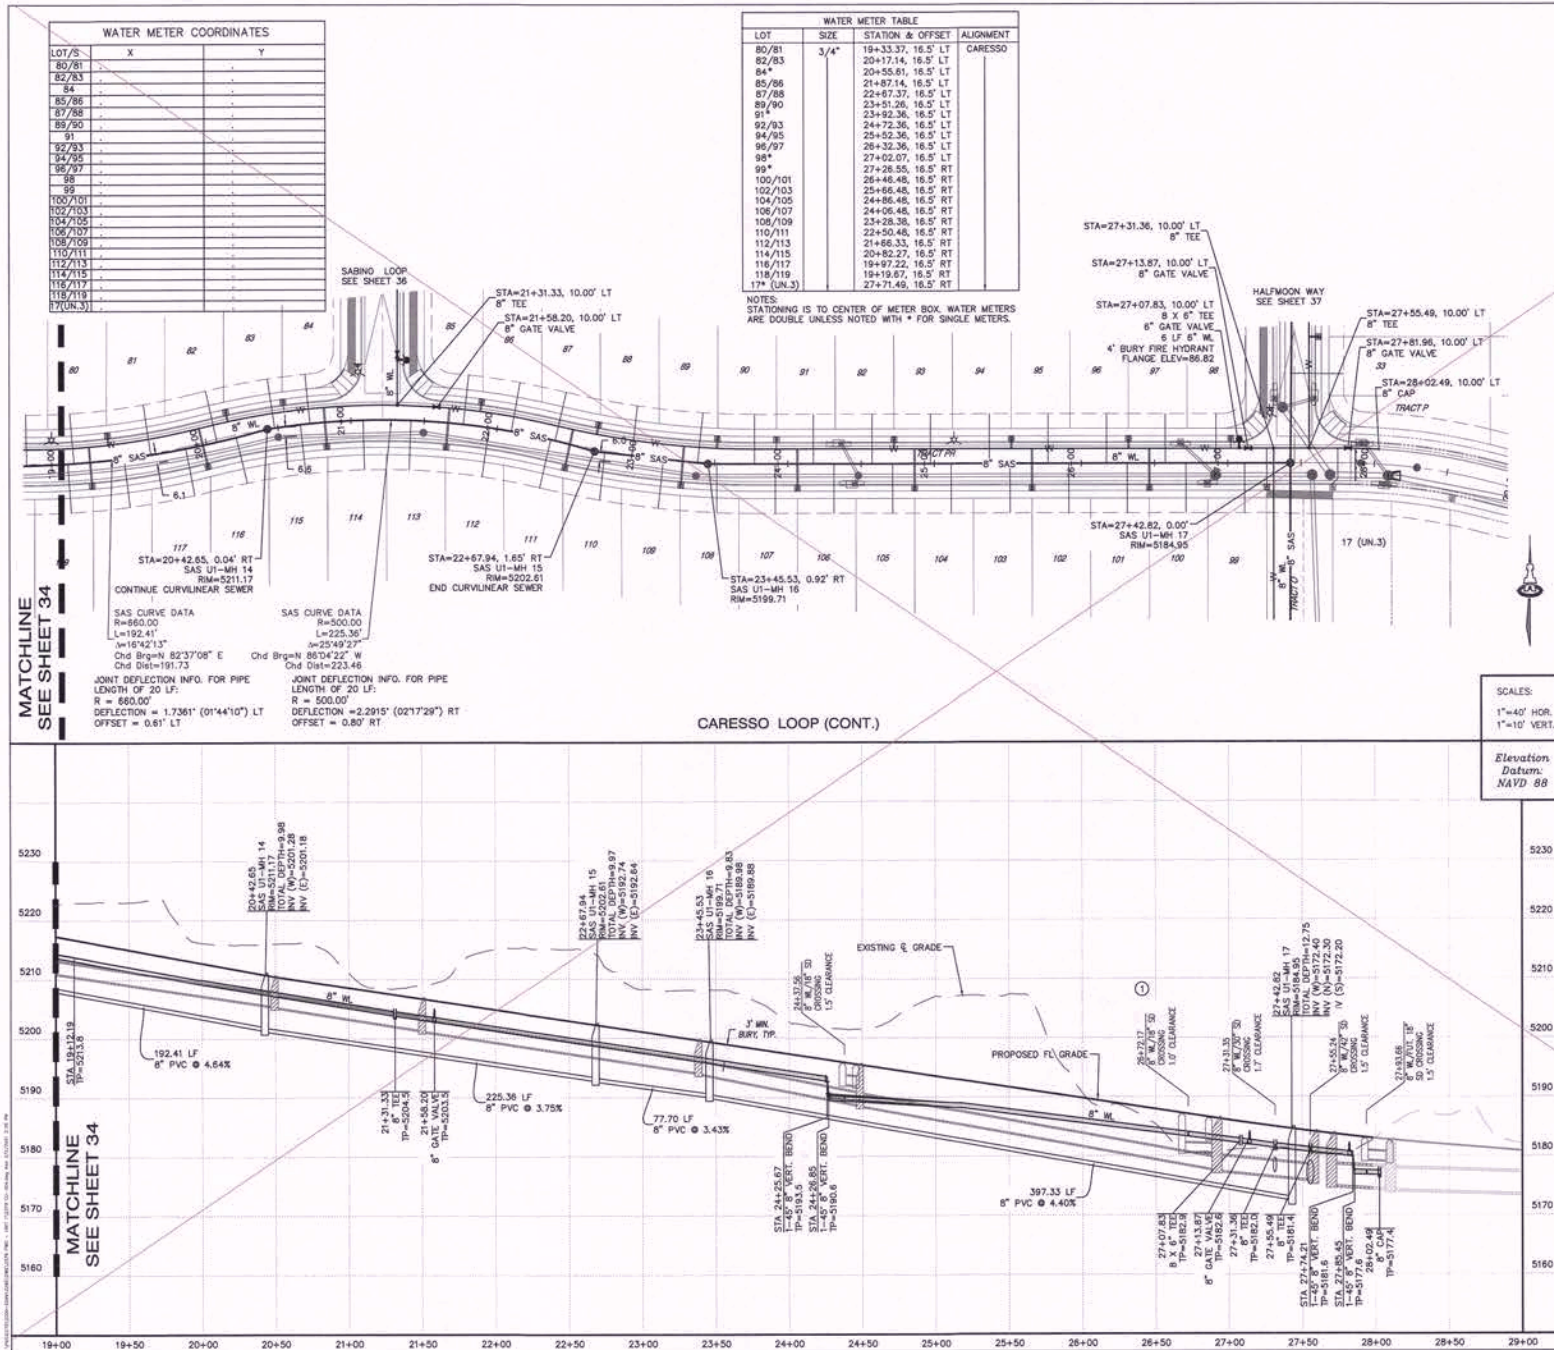

UTILITY NOTES

1. CONSTRUCT 4" SAS SERVICES FOR ALCMA STA DWG #1212.
2. CONSTRUCT SAS MANHOLES W/ FRAME & COVER PER ALCMA STD DWG #2102 & #2109 (CONCENTRIC).
3. WATERLINE CONNECTIONS FOR ALCMA STD DWG #301.
4. INSTALL NON-PRESSURE CONNECTIONS PER ALCMA STD DWG #2102.
5. INSTALL WATER VALVE BOX WITH RING AND COVER PER ALCMA STD DWG #2326 & #2328.
6. CONSTRUCT 3/4" WATER SERVICES AND METER BOXES PER ALCMA STD DWG #2102, #2362, #2363 & #2368.
7. CONSTRUCT FIRE HYDRANTS PER DESIGNATED DEPTHS & LENGTHS PER ALCMA STD DWG #2340.
8. SEE SHEET 28 FOR WATER SHUT-OFF PLAN.
9. SEE SHEET 28 FOR RESTRAINED JOINT LENGTHS FOR WATER FITTINGS.
10. SEE SHEET 29 FOR AS-BUILT COORDINATE TABLES.
11. ALL WATERLINES SHALL BE C-900 UNLESS OTHERWISE NOTED.
12. ALL SANITARY SEWER LINES SHALL BE SDR-35.
13. TRACER WIRE AND APPURTENANCES SHALL BE INSTALLED PER ALCMA STD DWGS 2102, 2191, 2302, 2322, 2365, 2366, 2374 & 2375. TRACER WIRE & APPURTENANCES SHALL BE INCLUDED IN WATER & SEWER LINE PAY.
14. REMOVE & REPLACE ARTERIAL PAVING PER CDA STD DWG #2465.

○ KEYED NOTES

1. INSTALL LEAN FILL AT CROSSINGS WHERE CLEARANCE IS LESS THAN 18" EXTENDING 5' EACH SIDE.

SAS SERVICE TABLE			
LOT #	SIZE	STATION & OFFSET	INV & ENDS
80	2"	19-47-06.7, 33.5' LT	5212.3
81		19-46-02.0, 33.5' LT	5210.7
82		20-07-35.6, 33.5' LT	5208.6
83		20-04-45.3, 33.5' LT	5207.0
84		20-07-18.4, 33.5' LT	5205.0
85		21-17-06.5, 33.5' LT	5203.0
86		22-09-06.0, 33.5' LT	5200.4
87		22-40-07.5, 33.5' LT	5199.2
88		23-49-38.8, 33.5' LT	5197.3
89		23-40-07.7, 33.5' LT	5195.5
90		23-77-29.6, 33.5' LT	5194.1
91		24-37-37.3, 33.5' LT	5192.5
92		24-57-37.3, 33.5' LT	5191.2
93		23-49-37.5, 33.5' LT	5188.6
94		23-47-37.3, 33.5' LT	5187.0
95		25-77-37.3, 33.5' LT	5186.6
96		26-37-37.3, 33.5' LT	5185.0
97		26-57-37.3, 33.5' LT	5183.5
98		26-92-02.7, 33.5' LT	5182.0
99		26-11-48.4, 33.5' RT	5180.4
100		26-71-48.4, 33.5' RT	5182.9
101		26-31-48.4, 33.5' RT	5184.5
102		26-11-48.4, 33.5' RT	5186.0
103		25-51-48.4, 33.5' RT	5187.4
104		24-41-48.4, 33.5' RT	5188.9
105		24-71-48.4, 33.5' RT	5190.5
106		24-31-48.4, 33.5' RT	5191.9
107		24-48.4, 33.5' RT	5193.3
108		23-52-99.2, 33.5' RT	5194.7
109		23-14-98.5, 33.5' RT	5196.3
110		22-78.8, 33.5' RT	5197.5
111		22-37-07.7, 33.5' RT	5198.9
112		21-94.8, 33.5' RT	5200.2
113		21-40-99.2, 33.5' RT	5202.5
114		20-08-66.3, 33.5' RT	5204.1
115		20-06-35.5, 33.5' RT	5205.7
116		20-22-13.1, 33.5' RT	5207.4
117		19-84.5, 33.5' RT	5209.1
118		19-58.4, 33.5' RT	5211.1
119		19-04.8, 33.5' RT	5212.8

NOTE: STATIONING IS AT END OF SAS AT EASEMENT



128 Monroe Street NE
Albuquerque, NM 87108
505-268-8828 | www.iacivil.com

CITY OF ALBUQUERQUE
PUBLIC WORKS DEPARTMENT
ENGINEERING DEVELOPMENT GROUP
ASPIRE SUBDIVISION, UNIT 1


CARESSO LOOP (CONT.)
UTILITY PLAN & PROFILE

Approved by Minneapolis
Design Review Committee and
City Engineer June 26, 2021

City Project No.	757580
------------------	--------

Zone Map No.	Sheet	Of
N-8-Z	35	37

LAST DESIGN UNIT		UNIT 1		UNIT 2		UNIT 299</	
------------------	--	--------	--	--------	--	--------	--	--------	--	--------	--	--------	--	--------	--	--------	--	--------	--	---------	--	---------	--	----------	--	----------	--	------------	--

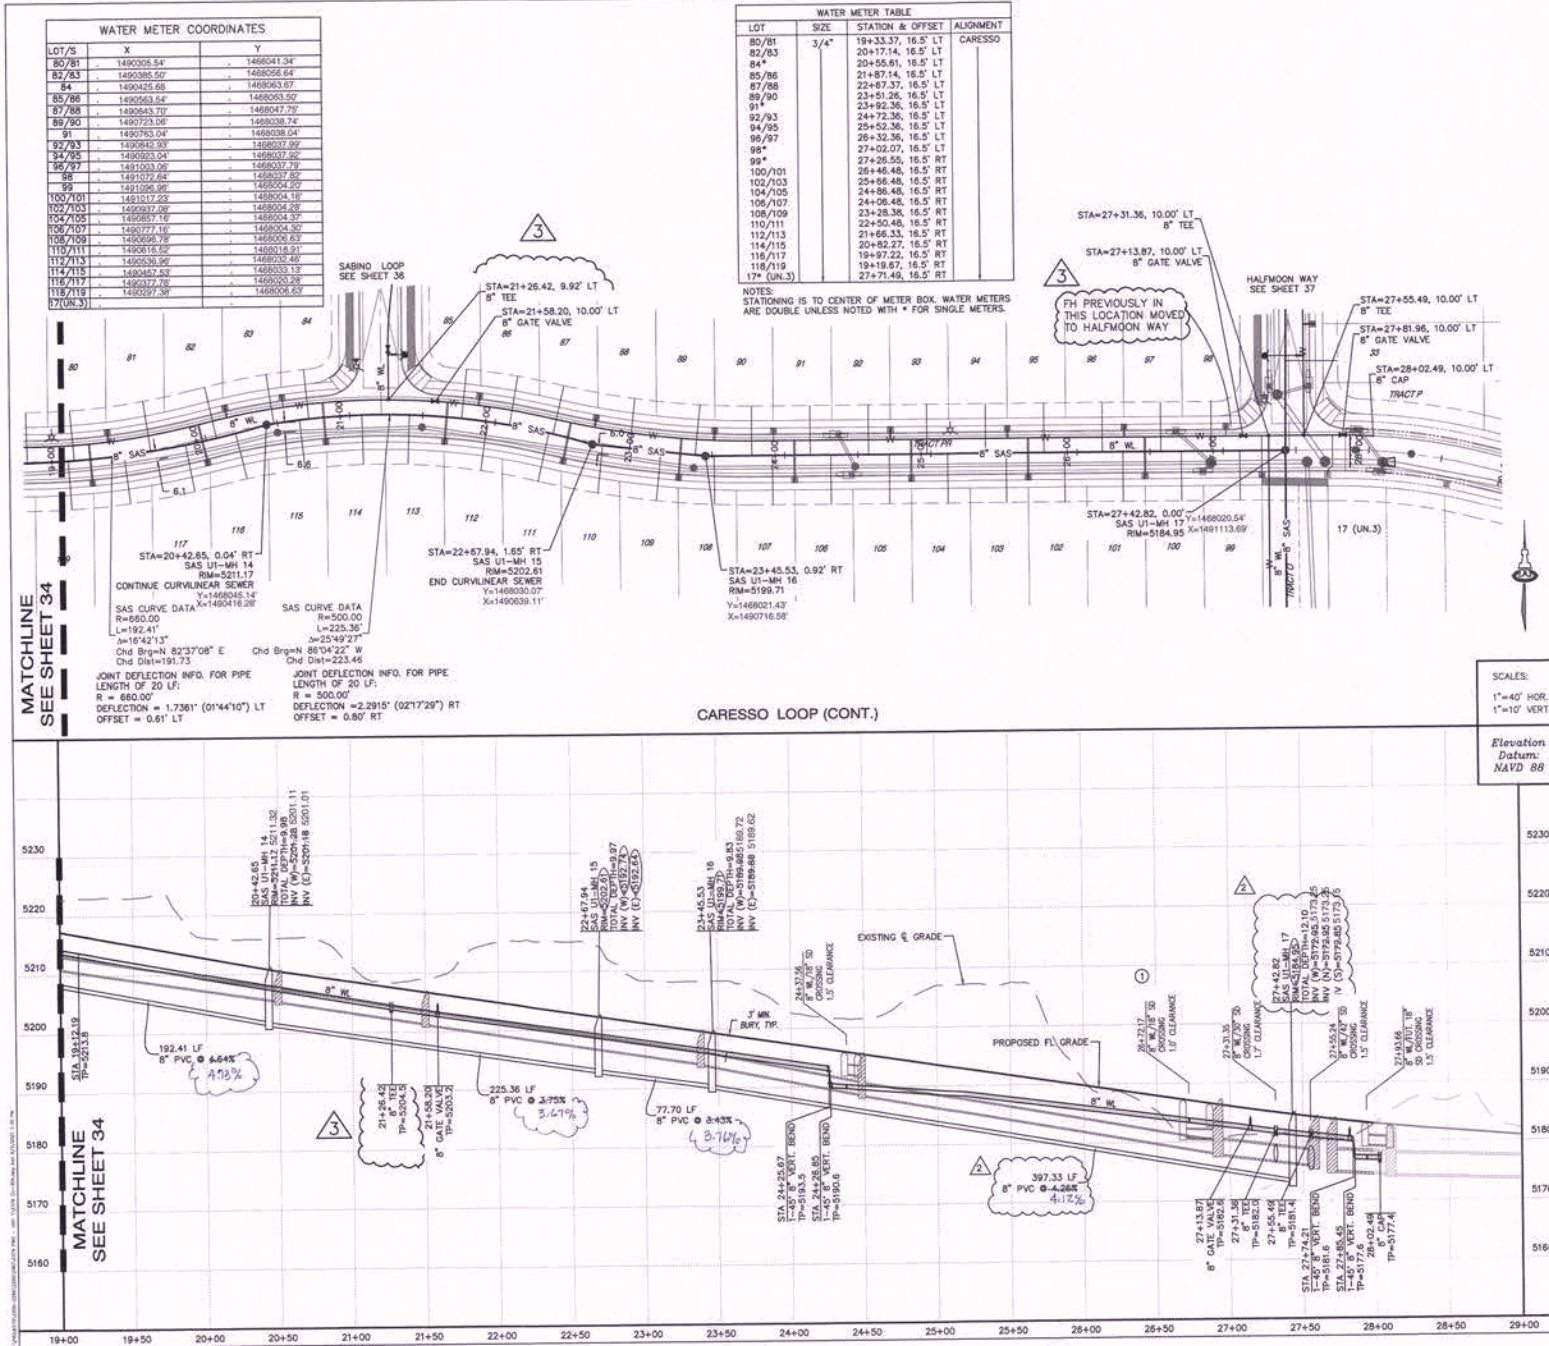

UTILITY NOTES

- CONSTRUCT 4" SAS SERVICES PER ABQWA STD DWG #212.
- CONSTRUCT SAS MANHOLES W/ FRAME & COVER PER ABQWA STD DWG #2102 & #2101 (CONCENTRIC).
- WATERLINE CONNECTIONS PER ABQWA STD DWG #2301.
- INSTALL NON-PRESSURE CONNECTIONS PER ABQWA STD DWG #2301.
- INSTALL WATER VALVE BOX WITH RING AND COVER PER ABQWA STD DWG #2326 & #2328.
- CONSTRUCT 3/4" WATER SERVICES AND METER BOXES PER ABQWA STD DWG #2301, #2362, #2364 & #2368.
- CONSTRUCT FIRE HYDRANTS PER DESIGNATED DEPTHS & LENGTHS PER ABQWA STD DWG #2340.
- SEE SHEET 28 FOR WATER SHUT-OFF PLAN.
- SEE SHEET 28 FOR RESTRAINED JOINT LENGTHS FOR WATER LINE FITTINGS.
- SEE SHEET 29 FOR AS-BUILT COORDINATE TABLES.
- ALL WATERLINES SHALL BE C-900 UNLESS OTHERWISE NOTED.
- ALL SANITARY SEWER LINES SHALL BE SDR-35.
- TRACER WIRE AND APPURTENANCES SHALL BE INSTALLED PER ABQWA STD DWG #2190, #2191, #2302, #2327, #2365, #2342, #2378, #2740 & #2741. COST FOR TRACER WIRES & APPURTENANCES SHALL BE INCLUDED IN WATER & SEWER LINE PIPE PAY ITEMS.
- REMOVE & REPLACE ARTERIAL PAVING PER CDA STD DWG #2465.

KEYED NOTES

- INSTALL LEAN FILL AT CROSSINGS WHERE CLEARANCE IS LESS THAN 18" EXTENDING 5' EACH SIDE.

SAS SERVICE TABLE

LOT #	SIZE	STATION & OFFSET	INV. @ END
80	4"	19+07.96, 33.5' LT	5212.3
81	4"	19+62.00, 33.5' LT	5210.7
82	4"	20+07.35, 33.5' LT	5209.6
83	4"	20+47.65, 33.5' LT	5206.7
84	4"	20+71.84, 33.5' LT	5205.0
85	4"	21+78.75, 33.5' LT	5201.7
86	4"	22+08.88, 33.5' LT	5199.2
87	4"	22+40.07, 33.5' LT	5197.3
88	4"	22+92.36, 33.5' LT	5195.5
89	4"	23+40.07, 33.5' LT	5193.5
90	4"	23+77.29, 33.5' LT	5191.4
91	4"	24+17.37, 33.5' LT	5192.5
92	4"	24+57.37, 33.5' LT	5191.2
93	4"	24+97.37, 33.5' LT	5189.6
94	4"	25+37.37, 33.5' LT	5188.0
95	4"	25+77.37, 33.5' LT	5186.6
96	4"	26+17.37, 33.5' LT	5185.1
97	4"	26+57.37, 33.5' LT	5183.5
98	4"	26+97.37, 33.5' LT	5182.0
99	4"	27+11.48, 33.5' RT	5181.3
100	4"	26+71.48, 33.5' RT	5182.9
101	4"	26+31.48, 33.5' RT	5184.5
102	4"	25+91.48, 33.5' RT	5186.0
103	4"	25+51.48, 33.5' RT	5187.4
104	4"	25+11.48, 33.5' RT	5188.8
105	4"	24+71.48, 33.5' RT	5190.5
106	4"	24+31.48, 33.5' RT	5191.9
107	4"	23+91.48, 33.5' RT	5193.5
108	4"	23+52.92, 33.5' RT	5194.7
109	4"	23+14.96, 33.5' RT	5196.3
110	4"	22+76.84, 33.5' RT	5197.6
111	4"	22+37.07, 33.5' RT	5198.2
112	4"	21+94.48, 33.5' RT	5199.2
113	4"	20+83.35, 33.5' RT	5200.9
114	4"	21+08.26, 33.5' RT	5204.1
115	4"	20+63.35, 33.5' RT	5205.6
116	4"	20+22.13, 33.5' RT	5207.4
117	4"	19+84.54, 33.5' RT	5209.1
118	4"	19+42.58, 33.5' RT	5211.1
119	4"	19+04.80, 33.5' RT	5212.8


NOTE: STATIONING IS AT END OF SAS AT EASEMENT

Isaacson & Arfman, Inc.
Civil Engineering Consultants


128 Monroe Street NE
Albuquerque, NM 87108
505-268-8828 | www.isaacson.com

CITY OF ALBUQUERQUE
PUBLIC WORKS DEPARTMENT
ENGINEERING DEVELOPMENT GROUP
ASPIRE SUBDIVISION, UNIT 1
CARESSO LOOP (CONT.)
UTILITY PLAN & PROFILE

DESIGN REVIEW COMMITTEE	CITY ENGINEER APPROVAL	City Project No.	Zone Map No.	Sheet	Of
		757580	N-9-2	35	37

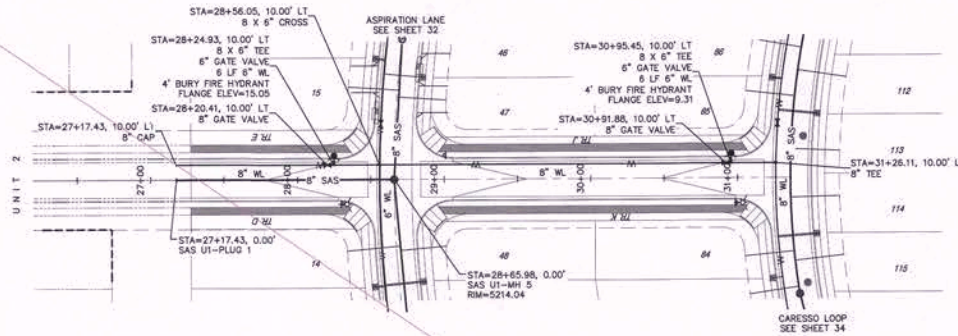

SABINO LOOP

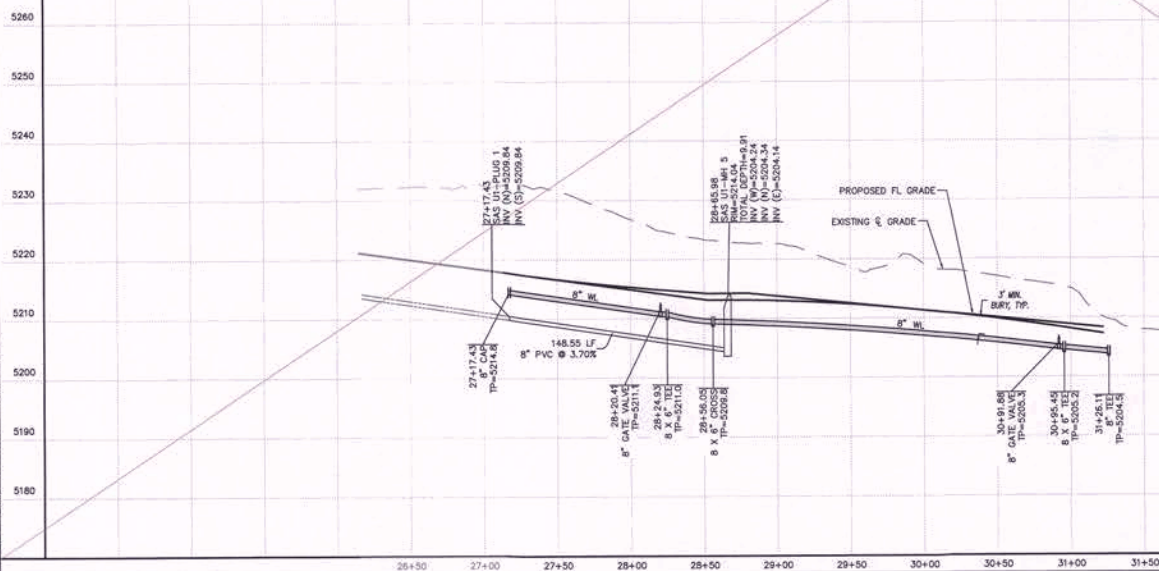

SCALES:
1"=40' HOR.
1"=10' VERT.

Elevation
Datum:
NAVD 88

Isaacson & Arfman, Inc.
Civil Engineering Consultants

128 Monroe Street NE
Albuquerque, NM 87108
505.268.8828 | www.iaacv.com

CITY OF ALBUQUERQUE
PUBLIC WORKS DEPARTMENT
ENGINEERING DEVELOPMENT GROUP
ASPIRE SUBDIVISION, UNIT 1

SABINO LOOP UTILITY PLAN & PROFILE

Approved by Milwaukee
Design Review Committee and
City Engineer June 23, 2021

City Project No.	757580	Zone Map No.	N-8-Z	Sheet	36	Of	37
------------------	--------	--------------	-------	-------	----	----	----

1. CONSTRUCT 4" GAS SERVICES PER AECMA SD 202.
2. CONSTRUCT GAS MANHOLES W/ FRAME & COVER PER AECMA SD 202 #212 & #2109 (CONCENTRIC).
3. WATERLINE CONNECTIONS PER AECMA SD 202 2301.
4. INSTALL NON-PRESSURE CONNECTIONS PER AECMA SD 202.
5. WATER VALVE WATER BOX WITH RING AND COVER PER AECMA SD 202 2328 & 2328.
6. CONSTRUCT 3/4" WATER SERVICES AND METER BOXES PER AECMA SD 202 2328, 2329, 2340 & 2349.
7. CONSTRUCT FIRE HYDRANTS PER DESIGNATED DEPTHS & LENGTHS PER AECMA SD 2340.
8. SEE SHEET 28 FOR WATER SHUT-OFF PLAN.
9. SEE SHEET 28 FOR RESTRAINED JOINT LENGTHS FOR WATER LINE FITTING.
10. SEE SHEET 29 FOR AS-BUILT COORDINATE TABLES.
11. ALL WATERLINES SHALL BE C-900 UNLESS OTHERWISE NOTED.
12. ALL SANITARY SEWER LINES SHALL BE SDR-35.
13. TRACER WIRE AND APPROPRIATENESS SHALL BE INSTALLED PER AECMA SD 2190, 2191, 2192, 2327, 2328, 2329, 2374 & 2375. TRACER WIRE SHALL BE INSTALLED AT DEPTHS & APPROPRIATENESS SHALL BE INCLUDED IN WATER & SEWER LINE PUMP AND RECORD.
14. REMOVE & REPLACE MATERIAL PAVING PER CDA SD 2465.

[illegible]

UTILITY NOTES

1. CONSTRUCT 4" SAS SERVICES PER ABCWJA STD DWG #2125.
2. CONSTRUCT SAS MANHOLES W/ FRAME & COVER PER ABCWJA STD DWG #2102 & #2109 (CONCENTRIC).
3. WATERLINE CONNECTIONS PER ABCWJA STD DWG 2301.
4. INSTALL NON-PRESSURE CONNECTIONS PER ABCWJA STD DWG 2301.
5. INSTALL WATER VALVE BOX WITH RING AND COVER PER ABCWJA STD DWG 2326 & 2328.
6. CONSTRUCT 3/4" WATER SERVICES AND METER BOXES PER ABCWJA STD DWG #2381, 2385, 2386 & 2388.
7. CONSTRUCT FIRE HYDRANTS PER DESIGNATED DEPTHS & LENGTHS PER ABCWJA STD DWG #2340.
8. SEE SHEET 26 FOR WATER SHUT-OFF PLAN.
9. SEE SHEET 26 FOR RESTRAINED JOINT LENGTHS FOR WATER LINE FITTINGS.
10. SEE SHEET 29 FOR AS-BUILT COORDINATE TABLES.
11. ALL WATERLINES SHALL BE C-900 UNLESS OTHERWISE NOTED.
12. ALL SANITARY SEWER LINES SHALL BE SDR-35.
13. TRACER WIRE AND APPURTENANCES SHALL BE INSTALLED PER ABCWJA STD DWGS 2190, 2191, 2302, 2327, 2385, 2342, 2379, 2740 & 2741. COST FOR TRACER WIRES & APPURTENANCES SHALL BE INCLUDED IN WATER & SEWER LINE PIPE PAY ITEMS.
14. REMOVE & REPLACE ARTERIAL PAVING PER COA STD DWG 2465.

AS-BUILT INFORMATION		SURVEY INFORMATION		ENGINEER'S SEAL		REVISIONS	
CONTRACT NO.	118	FIELD NOTES	1		NO.	DATE	REVISIONS
OWNER	SALLS	MARKS	1				
DESIGNER	ABCWJA	DATE	02/20/21				
CHECKED BY	ANW	DATE	02/20/21	DESIGNED BY	ANW	DATE	02/20/21
IN CHARGE	ANW	DATE	02/20/21	DRAWN BY	ANW	DATE	02/20/21

3

08/21

ADD WL AT PVS FOR VALVE GLIMMER

2

07/21

EXIST SAS MTD TO REMAIN/ANY. ADL

1

05/21

REVISED STORM DRAIN TABLES

NO.	DATE	REVISIONS
1	05/21	REMARKS

DESIGNED BY

ANW

DATE

02/20/21

DRAWN BY

ANW

DATE

02/20/21

LAST DOWNS

02/20/21

02/20/21


02/20/21

Sheet

36

Of


37

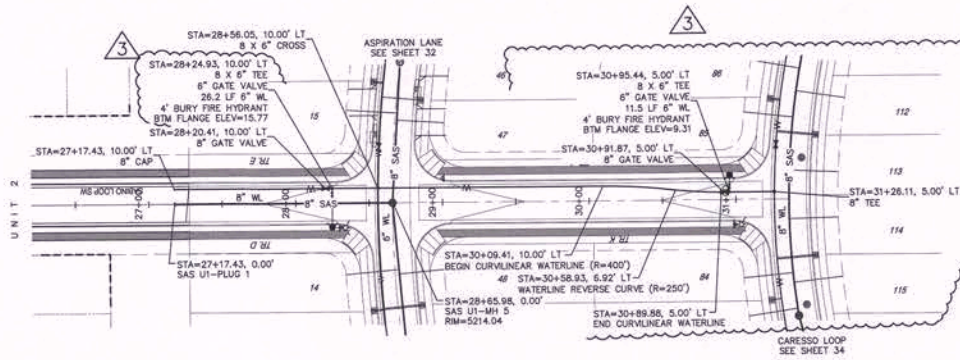

SABINO LOOP

SCALES:
1"=40' HOR.
1"=10' VERT.

Elevation
Datum:
NAVD 88

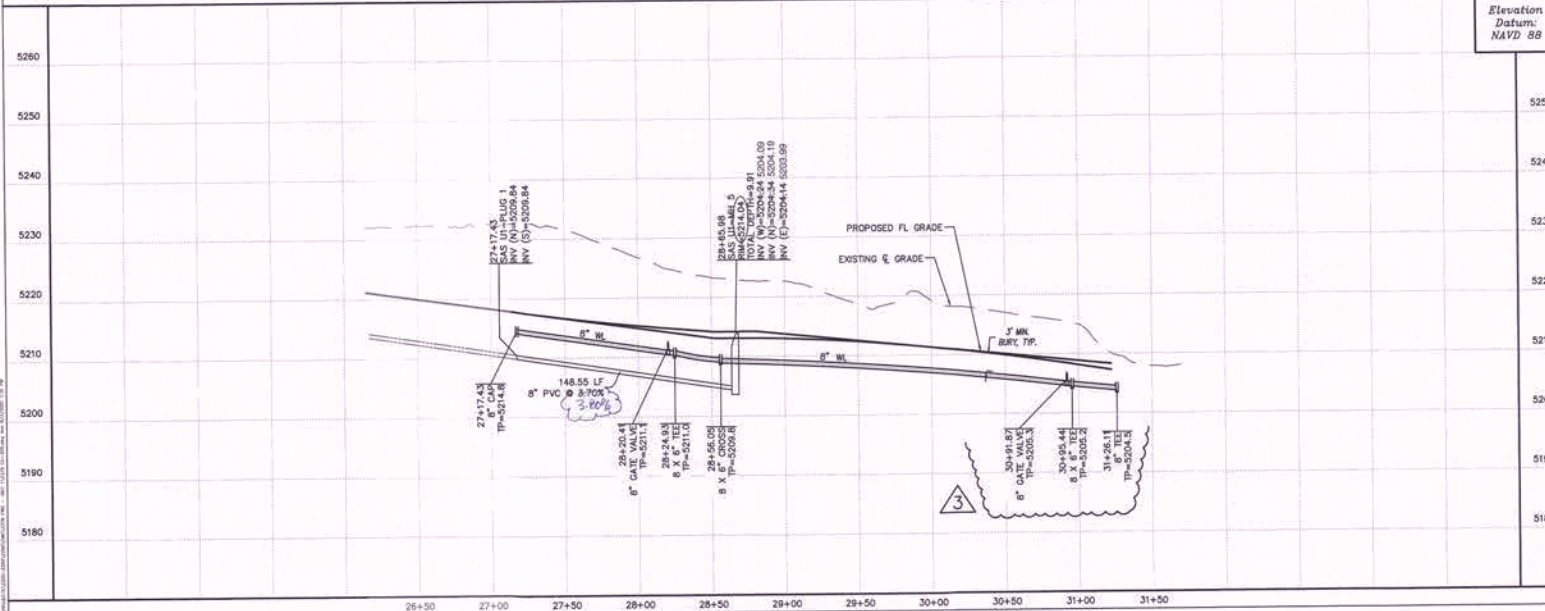

Isaacson & Arfman, Inc.
Civil Engineering Consultants


128 Monroe Street NE
Albuquerque, NM 87109
505-268-8828 | www.isacvil.com

CITY OF ALBUQUERQUE
PUBLIC WORKS DEPARTMENT
ENGINEERING DEVELOPMENT GROUP
ASPIRE SUBDIVISION, UNIT 1

SABINO LOOP
UTILITY PLAN & PROFILE

DESIGN REVIEW COMMITTEE	CITY ENGINEER APPROVAL	Mo./DAY/YR.	Mo./DAY/YR.
LAST DESIGN UPDATE			

City Project No. 757580 Zone Map No. N-8-Z Sheet 36 of 37

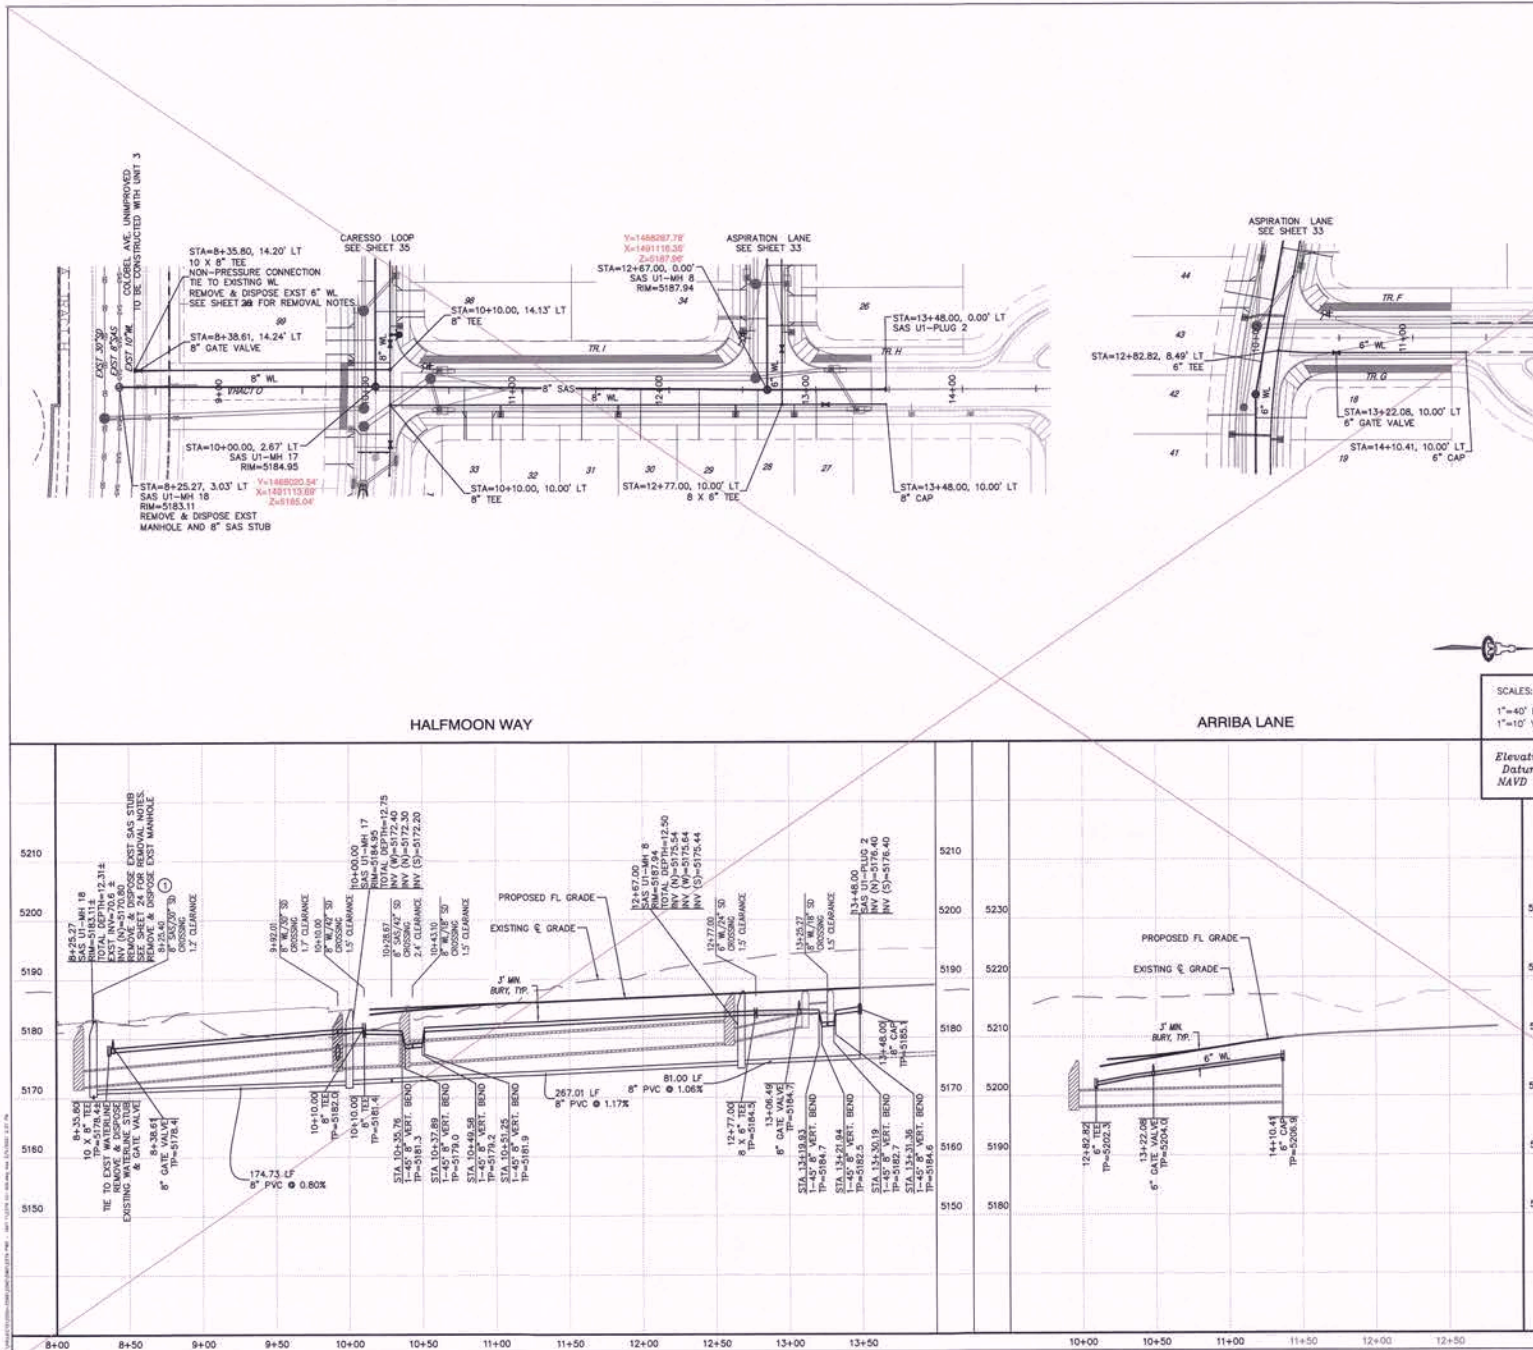

UTILITY NOTES

1. CONSTRUCT 4" SAS SERVICES PER ARBOWA STD DWG #2125.
2. CONSTRUCT SAS MANHOLES W/ FRAME & COVER PER ARBOWA STD DWG #2102 & #2109 (CONCENTRIC).
3. WATERLINE CONNECTIONS PER ARBOWA STD DWG 2301.
4. INSTALL NON-PRESSURE CONNECTIONS PER ARBOWA STD DWG 2301.
5. INSTALL WATER VALVE BOX WITH RING AND COVER PER ARBOWA STD DWG 2326 & 2328.
6. CONSTRUCT 3/4" WATER SERVICES AND METER BOXES PER ARBOWA STD DWG #2361, 2362, 2366 & 2368.
7. CONSTRUCT FIRE HYDRANTS PER DESIGNATED DEPTHS & LENGTHS PER ARBOWA STD DWG #2340.
8. SEE SHEET 28 FOR WATER SHUT-OFF PLAN.
9. SEE SHEET 28 FOR RESTRAINED JOINT LENGTHS FOR WATER LINE FITTINGS.
10. SEE SHEET 29 FOR AS-BUILT COORDINATE TABLES.
11. ALL WATERLINES SHALL BE C-900 UNLESS OTHERWISE NOTED.
12. ALL SANITARY SEWER LINES SHALL BE SDR-35.
13. TRACER WIRE AND APPURTENANCES SHALL BE INSTALLED PER ARBOWA STD DWG 2190, 2191, 2322, 2327, 2340, 2342, 2379, 2740 & 2741. COST FOR TRACER WIRES & APPURTENANCES SHALL BE INCLUDED IN WATER & SEWER LINE PIPE PAY ITEMS.
14. REMOVE & REPLACE ARTERIAL PAVING PER COA STD DWG 2465.

KEYED NOTES

1. INSTALL LEAN FILL AT CROSSINGS WHERE CLEARANCE IS LESS THAN 18' EXTENDING 5' EACH SIDE.

WATER METER COORDINATES

LOT/S	X	Y
27	1491133.16	1499306.42
28/29	1491133.09	1499306.14
30/31	1491133.04	1499306.32
32/33	1491133.09	1499306.54

WATER METER TABLE

LOT	SIZE	STATION & OFFSET	ALIGNMENT
27*	3/4"	12+85.27, 16.5' RT	HALFMOON
28/29		12+45.27, 16.5' RT	
30/31		11+65.27, 16.5' RT	
32/33		10+85.27, 16.5' RT	

NOTES:
STATIONING IS TO CENTER OF METER BOX.
WATER METERS ARE DOUBLE UNLESS NOTED WITH *
FOR SINGLE METERS.

SAS SERVICE TABLE

LOT #	SIZE	STATION & OFFSET	INV @ END
27	4"	13+00.27, 33.5' RT	5183.4
28		12+60.27, 33.5' RT	5182.0
29		12+20.27, 33.5' RT	5182.6
30		11+80.27, 33.5' RT	5182.1
31		11+40.27, 33.5' RT	5181.7
32		11+00.27, 33.5' RT	5181.3
33		10+60.27, 33.5' RT	5180.9

NOTE: STATIONING IS AT END OF SAS AT EASEMENT

Isaacson & Arfman, Inc.
Civil Engineering Consultants
128 Monroe Street NE
Albuquerque, NM 87109
505-268-8828 | www.isac.com

CITY OF ALBUQUERQUE
PUBLIC WORKS DEPARTMENT
ENGINEERING DEVELOPMENT GROUP
ASPIRE SUBDIVISION, UNIT 1
HALFMOON WAY & ARRIBA LANE
UTILITY PLAN & PROFILE

DESIGN REVIEW COMMITTEE	CITY ENGINEER APPROVAL	Ms./DAY/YR	Ms./DAY/YR
Approved by: Design Review Committee and City Engineer June 28, 2021			
City Project No. 757580	Zone Map No. N-8-Z	Sheet 37 Of 37	

AS-BUILT INFORMATION		BENCH MARKS		SURVEY INFORMATION		ENGINEER'S SEAL	
CONTRACTOR	DATE	AGRS MONUMENT AND BENCHMARK "1-N"	DATE	1 (CD-CRDSN SHEETS) NO. 10/2020	FIELD NOTES	1 (CD-CRDSN SHEETS) NO. 10/2020	1 (CD-CRDSN SHEETS) NO. 10/2020
PROJECT NO.	DATE	N=147074.879 E=1485701.82	DATE				
PROJECT NAME	DATE	G=0.999967446	DATE				
PROJECT LOCATION	DATE	Area=1077.27	DATE				
PROJECT DESCRIPTION	DATE	CELESTIAL ZONE	DATE				
PROJECT DRAWN BY	DATE	ELEVATION=5551.28	DATE				
PROJECT CHECKED BY	DATE	UNITS=NA1983	DATE				

B

EXIST SAS MH
BUILT 1.8' HIGHER
THAN AS-BUILT
ELEV SHOWN

B

A

NOT SUFFICIENT
CLEARANCE TO
CONSTRUCT 30" SD
BETWEEN 8" SAS
AND 10" WL.

A

PROPOSE TO CONSTRUCT
A 30' SEGMENT OF 24" RCP
CL III SD TO CLEAR EX.
SAS & WL. CONSTRUCT AN
REINFORCED CONCRETE
COLLAR AT THE JUNCTION
OF THE 30"/24" STORM
DRAINS.
CONTRACTOR WILL FILM
INSTALLATION.

HALFMOON WAY

ARRIBA LANE

UTILITY NOTES

1. CONSTRUCT 4" SAS SERVICES PER ABCIWA STD DWG #2125.
2. CONSTRUCT SAS MANHOLES W/ FRAME & COVER PER ABCIWA STD DWG #2102 & #2109 (CONCENTRIC).
3. WATERLINE CONNECTIONS PER ABCIWA STD DWG 2301.
4. INSTALL NON-PRESSURE CONNECTIONS PER ABCIWA STD DWG 2301.
5. INSTALL WATER VALVE BOX WITH RING AND COVER PER ABCIWA STD DWG 2326 & 2326B.
6. CONSTRUCT 3/4" WATER SERVICES AND METER BOXES PER ABCIWA STD DWG #2361, 2362, 2366 & 2366B.
7. CONSTRUCT FIRE HYDRANTS PER DESIGNATED DEPTHS & LENGTHS PER ABCIWA STD DWG #2345.
8. SEE SHEET 28 FOR WATER SHUT-OFF PLAN.
9. SEE SHEET 28 FOR RESTRAINED JOINT LENGTHS FOR WATER LINE FITTINGS.
10. SEE SHEET 29 FOR AS-BUILT COORDINATE TABLES.
11. ALL WATERLINES SHALL BE C-900 UNLESS OTHERWISE NOTED.
12. ALL SANITARY SEWER LINES SHALL BE SDR-35.
13. TRACER WIRE AND APPURTENANCES SHALL BE INSTALLED PER ABCIWA STD DWGS 2100, 2191, 2302, 2327, 2361, 2342, 2379, 2740 & 2741. COST FOR TRACER WIRES & APPURTENANCES SHALL BE INCLUDED IN WATER & SEWER LINE PIPE PAY ITEMS.
14. REMOVE & REPLACE ARTERIAL PAVING PER COA STD DWG 2465.

KEYED NOTES

1. INSTALL LEAN FILL AT CROSSINGS WHERE CLEARANCE IS LESS THAN 18" EXTENDING 5' EACH SIDE.

WATER METER COORDINATES

LOT/S	X	Y
27	-	-
28/29	-	-
30/31	-	-
32/33	-	-

WATER METER TABLE

LOT	SIZE	STATION & OFFSET	ALIGNMENT
27*	3/4"	12+85.27, 16.5' RT	HALFMOON
28/29	3/4"	12+45.27, 16.5' RT	
30/31	3/4"	11+65.27, 16.5' RT	
32/33	3/4"	10+65.27, 16.5' RT	

NOTES:
STATIONING IS TO CENTER OF METER BOX.
WATER METERS ARE DOUBLE UNLESS NOTED WITH *
FOR SINGLE METERS.

SAS SERVICE TABLE

LOT #	SIZE	STATION & OFFSET	INV @ END
27	4"	13+00.27, 33.5' RT	5183.4
28	4"	12+80.27, 33.5' RT	5182.9
29	4"	12+20.27, 33.5' RT	5182.6
30	4"	11+80.27, 33.5' RT	5182.1
31	4"	11+40.27, 33.5' RT	5181.7
32	4"	11+00.27, 33.5' RT	5181.3
33	4"	10+60.27, 33.5' RT	5180.9

NOTE: STATIONING IS AT END OF SAS AT EASEMENT

Isaacson & Artman, Inc.
Civil Engineering Consultants

128 Monroe Street NE
Albuquerque, NM 87108
505-268-8829 | www.isaacsonartman.com

CITY OF ALBUQUERQUE
PUBLIC WORKS DEPARTMENT
ENGINEERING DEVELOPMENT GROUP
ASPIRE SUBDIVISION, UNIT 1
HALFMOON WAY & ARRIBA LANE
UTILITY PLAN & PROFILE

DESIGN REVIEW COMMITTEE CITY ENGINEER APPROVAL

LAST DESIGN UPDATE

City Project No. 757580 Zone Map No. N-8-Z Sheet 37 of 37

