



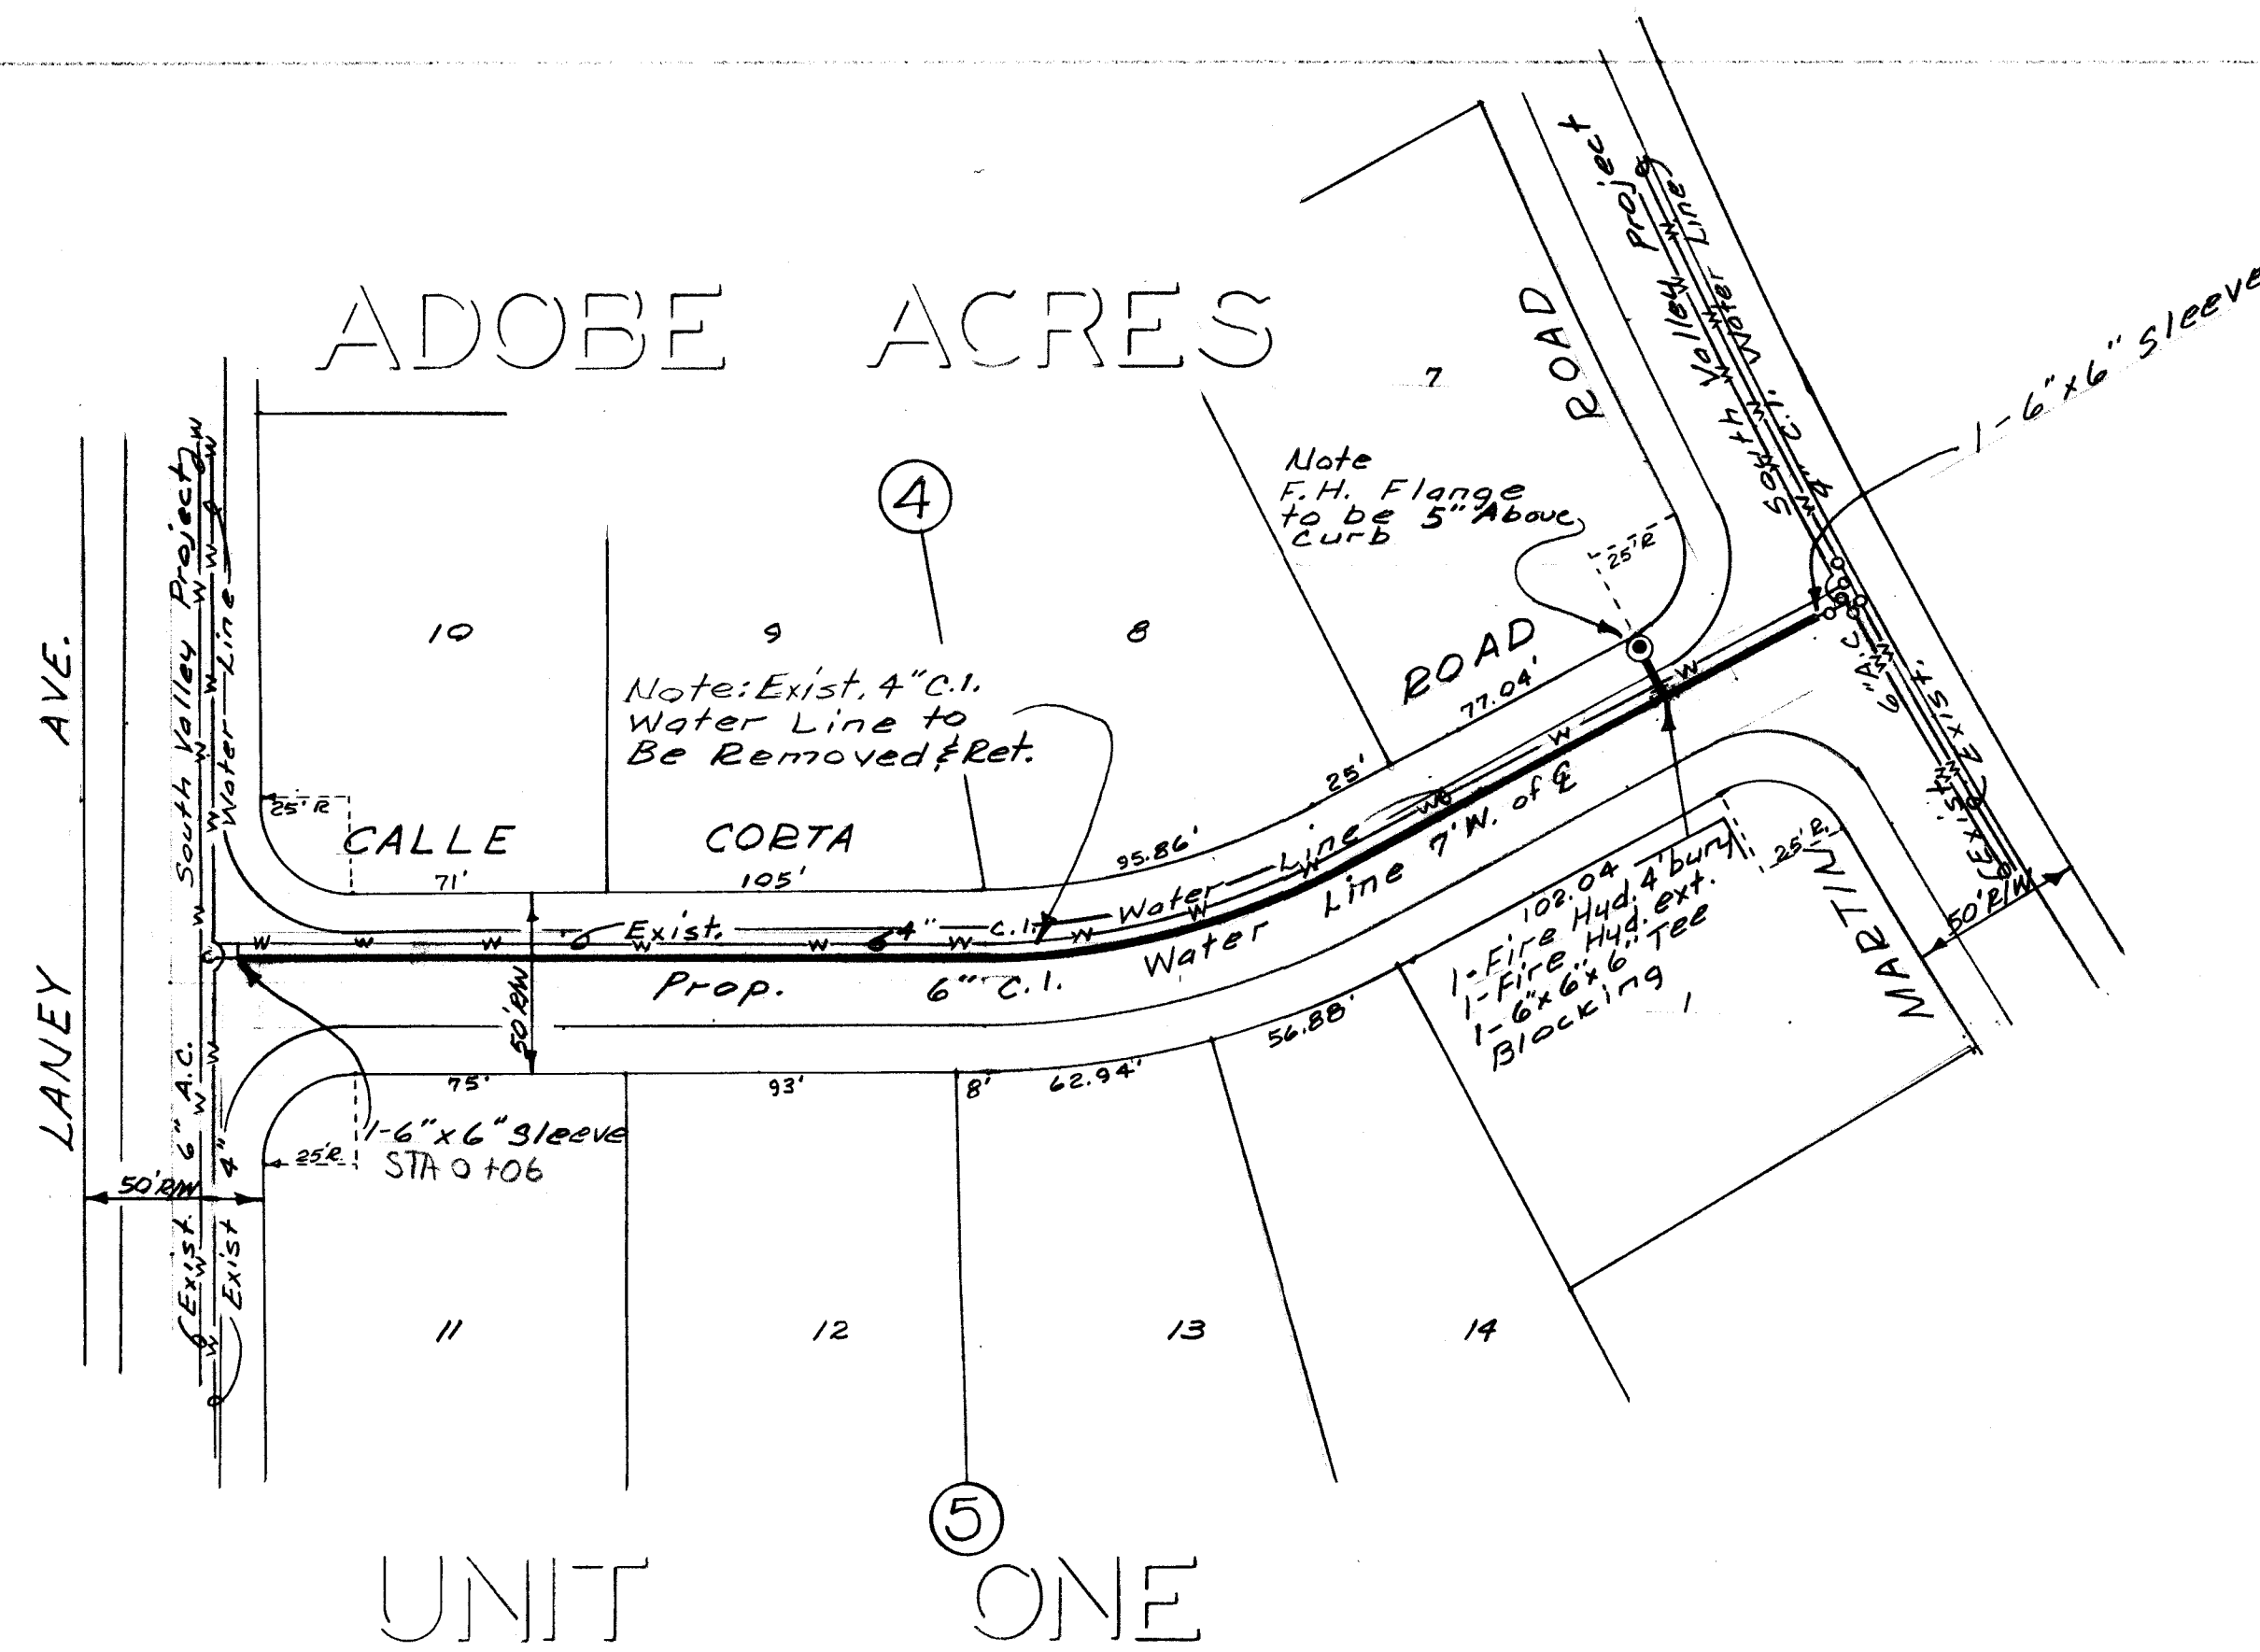

Scale 1" = 50' Horiz.
1" = 5' Vert.

4925

4920

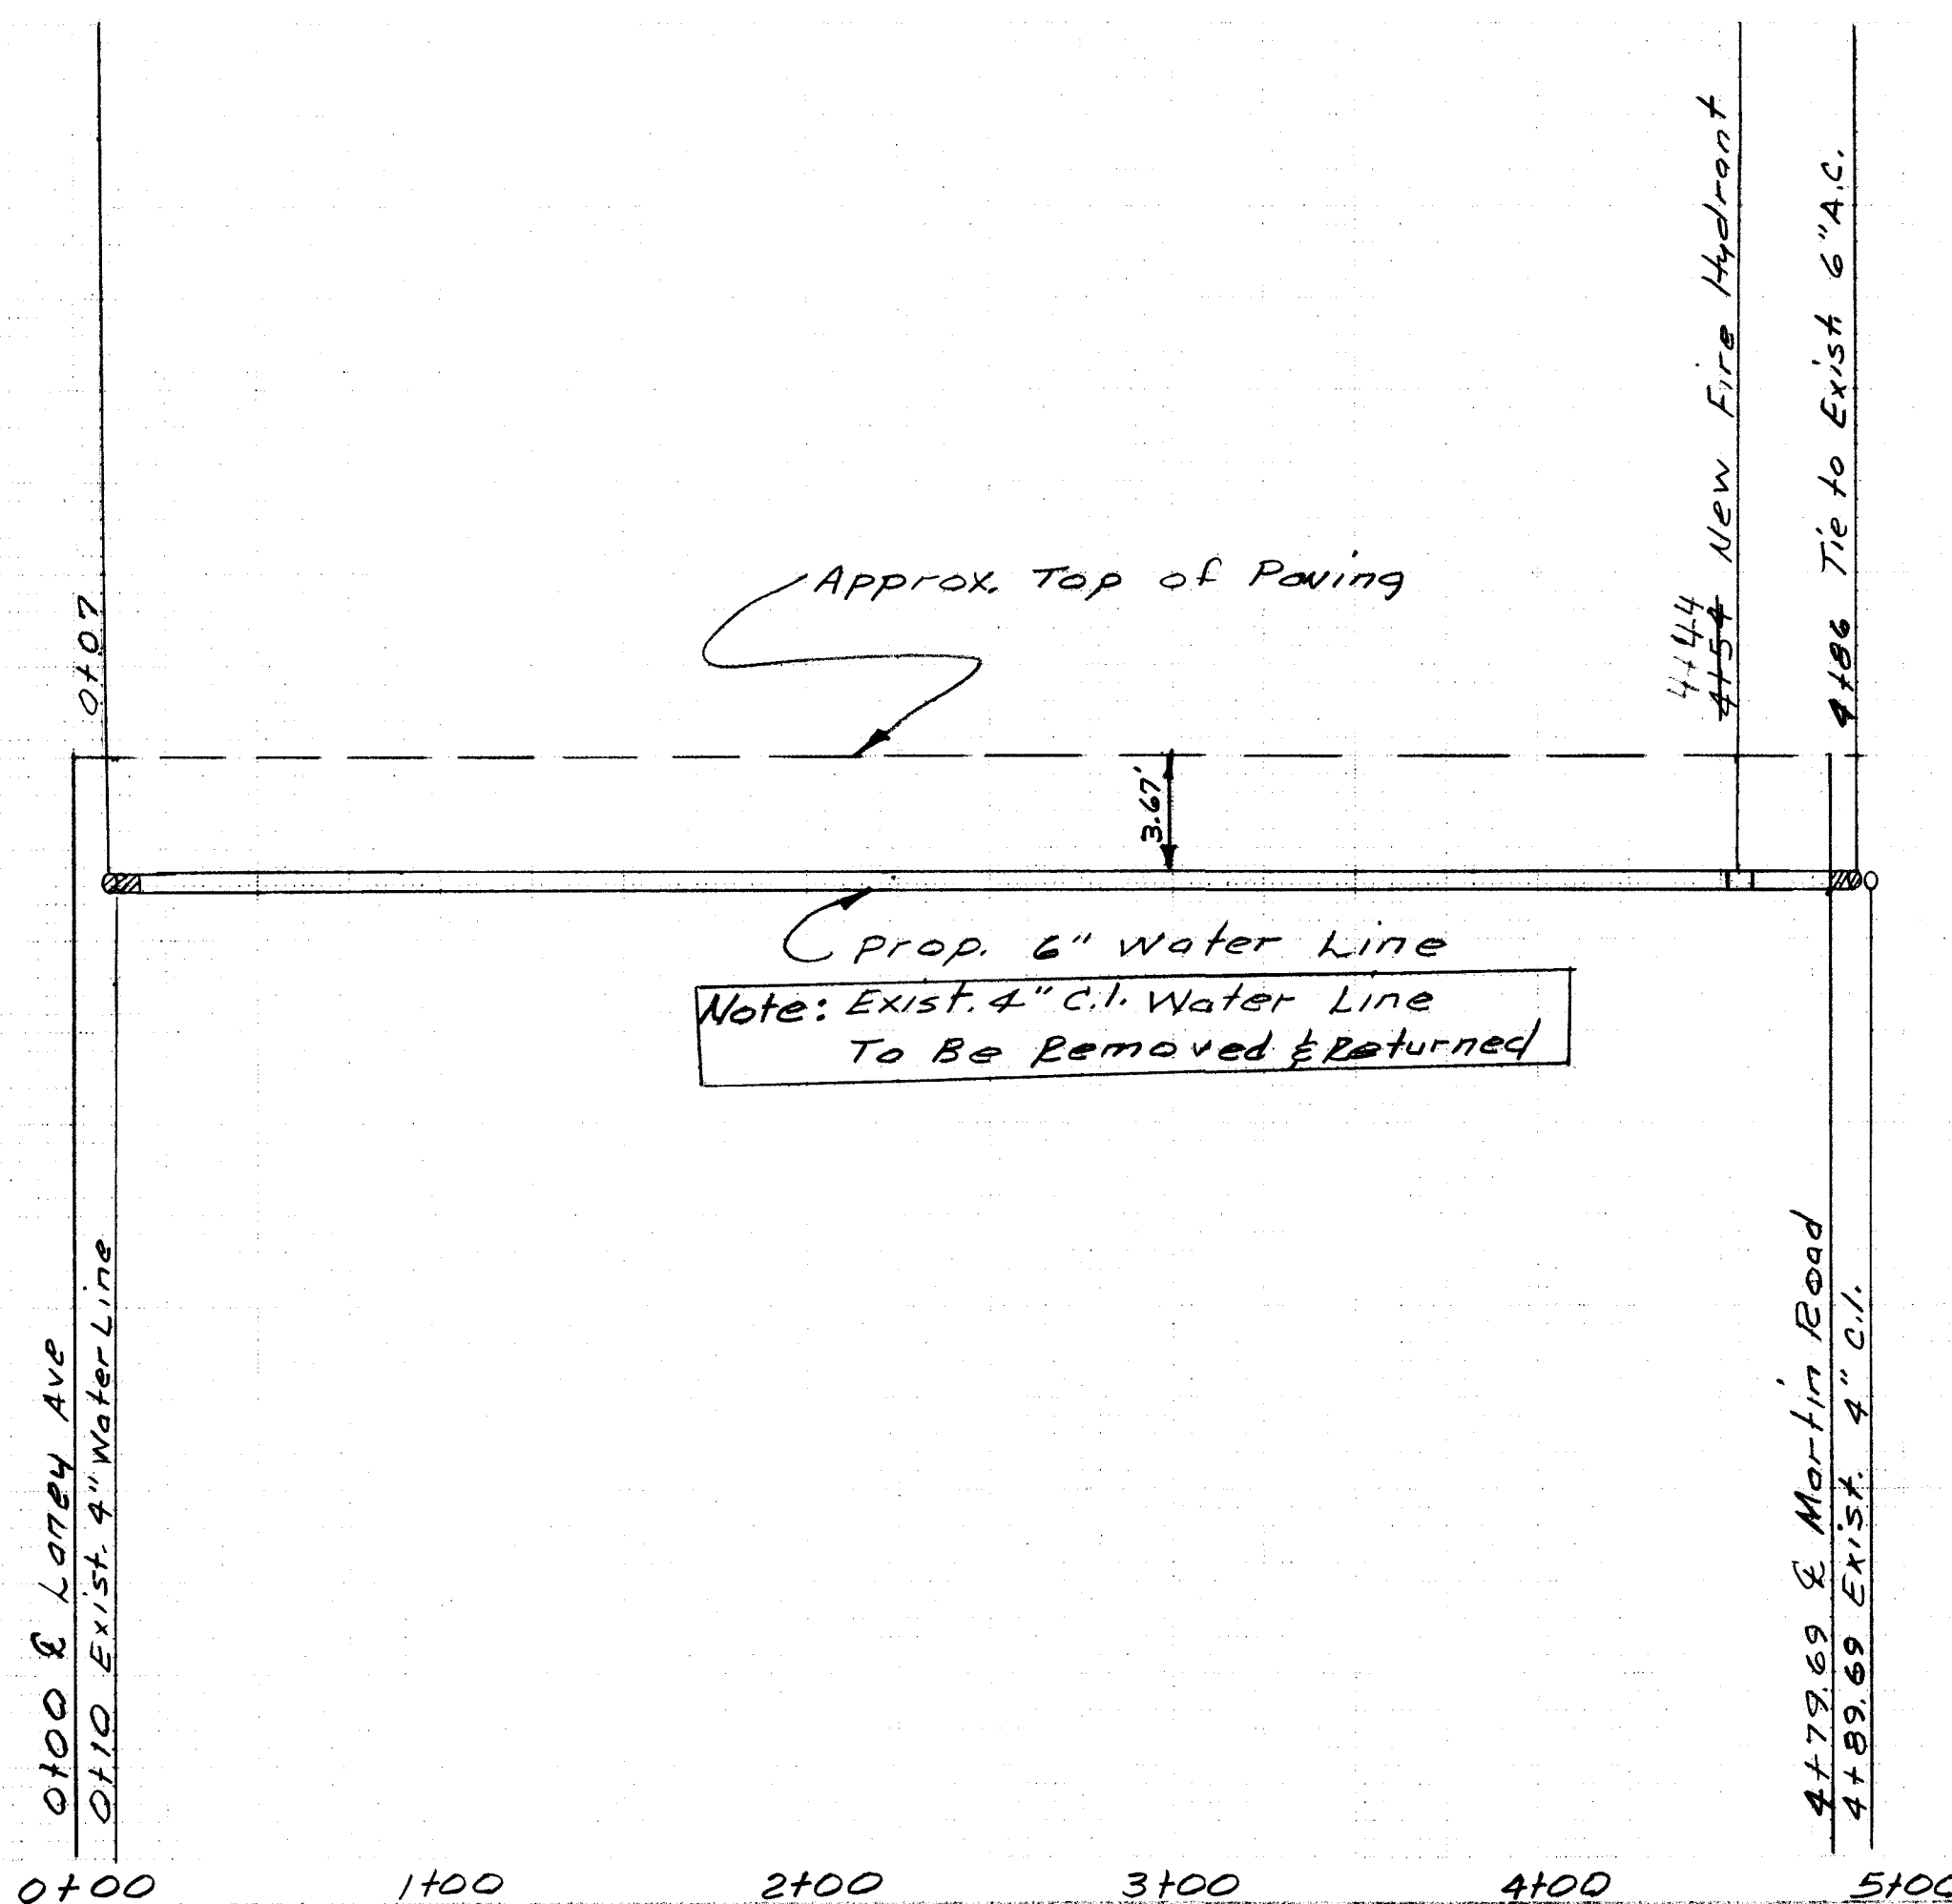

SCANNED BY LACON

73 075 91.78

APPROVAL OF AS BUILT DRAWINGS
ASST. CITY ENGINEER - FIELD
DATE 12-17-78

APPROVED FOR CONSTRUCTION
CITY ENGINEER
DATE 6-27-78

CITY OF ALBUQUERQUE PUBLIC WORKS DEPARTMENT ENGINEERING DIVISION					
TITLE: Water Line Replacement on Calle Corta Road, Between Laney and Martin Road in Adobe Acres Unit #1.					
APPROVALS	ENGINEER	DATE	APPROVALS	ENGINEER	DATE
City Engineer	6-7-78	Liquid Waste			
A.C.E. - Design	12 May 78	Traffic			
A.C.E. - Hydrology		Water			
DRAWING NO. W-75-78 SHEET 1 OF 1					

SURVEY INFORMATION		BENCH MARKS		AS BUILT INFORMATION	
NO.	BY	NO.	DATE	NO.	DATE
1		1		1	
2		2		2	
3		3		3	
100		100		100	