

SCANNED
BY PLAN

CONSTRUCTION PLANS

FOR

CENTRAL PARK PLACE

1 2 3 4 5 6 7 8 9 10 11 12 13 14 15
26-70223.8710611

UTILITY & PAVING IMPROVEMENTS

CITY OF ALBUQUERQUE
NEW MEXICO
JUNE 2005

Handwritten signature/initials

INDEX TO DRAWINGS


1. TITLE SHEET
2. PLAT
3. GRADING AND DRAINAGE PLAN (REFERENCE ONLY)
4. PAVING IMPROVEMENTS CENTRAL AVE.
5. STRIPING PLAN
6. MASTER UTILITY PLAN

APPROVED AS RECORD DRAWINGS
DESIGN REVIEW SECTION
CITY CONSTRUCTION ENGINEER
By Mike - Bryan Wolfe P.E.
DATE: 2/24/2006

SURVEYORS CERTIFICATION



I, Russ P. Hugg, New Mexico Professional Surveyor Number 9750,
Hereby Certify that the as-built information shown hereon is the
result of an actual field survey performed by me or under my
direct supervision and that the same is true and correct to the
best of my knowledge and belief.

Russ P. Hugg
NMPS No. 9750
11-17 2005

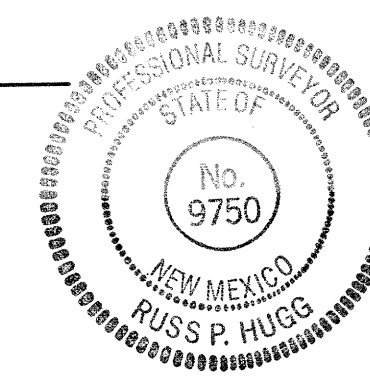

RECORD DRAWINGS

I, Patrick J. Conley of the firm of Smith Engineering Company, A Registered Professional Engineer in the State of New Mexico, do hereby state, to the best of my knowledge and belief, that the infrastructure installed as part of this project has been inspected by a qualified person under my direct supervision and has been constructed in general accordance with the plans and specifications, while someone from Smith Engineering Company was onsite, approved by the City Engineer and that the original design intent of the approved plans has been met, except as noted on the as-built construction drawings. The Certification is based on site inspections by me or personnel under my direction, and as-built survey information provided by Russ Hugg (Surveyor Name) NMPS number 9750 (PS#).

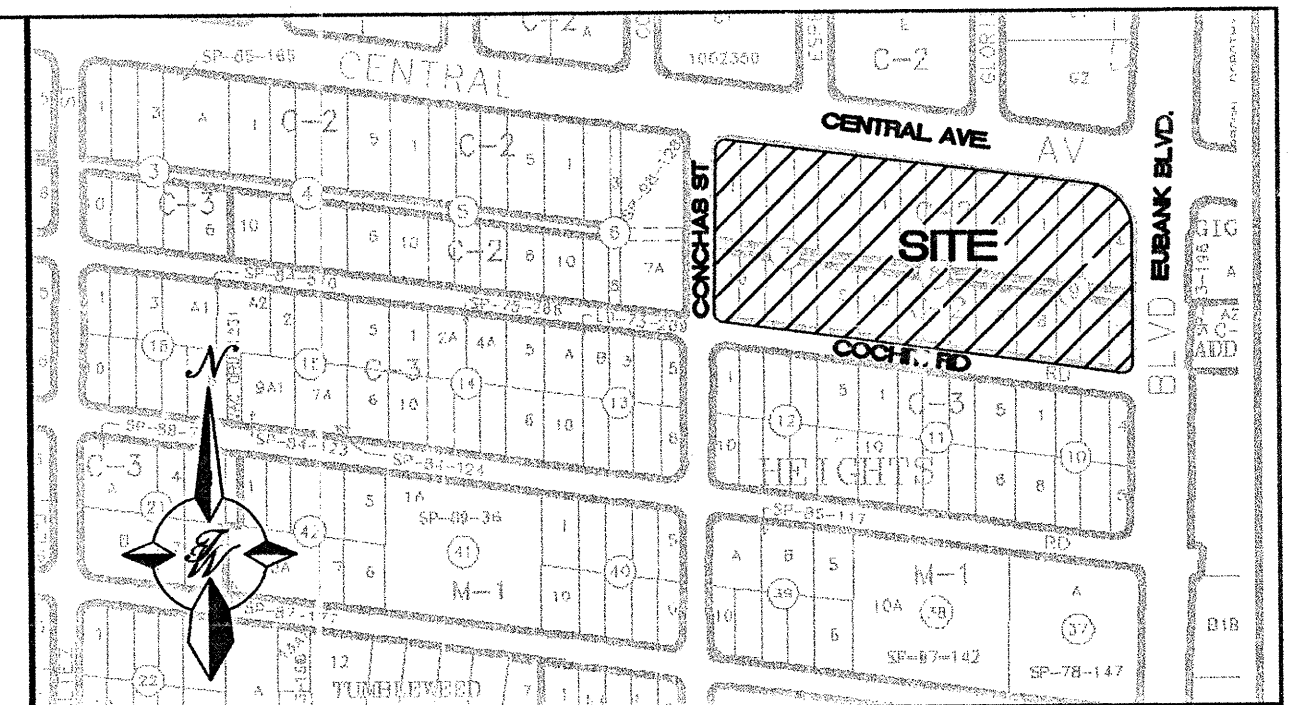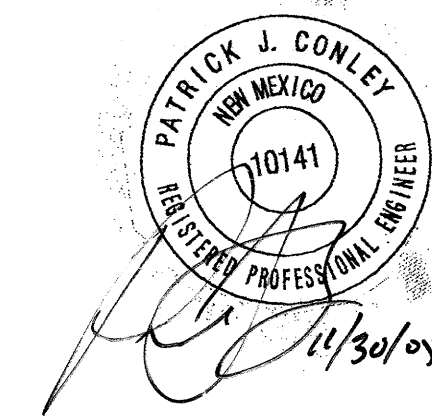

VICINITY MAP ZONE ATLAS L-20-Z

NO TO SCALE

NOTICE TO CONTRACTORS

1. ALL WORK DETAILED ON THESE PLANS TO BE PERFORMED UNDER CONTRACT SHALL, EXCEPT AS OTHERWISE STATED OR PROVIDED FOR HEREON, BE CONSTRUCTED IN ACCORDANCE WITH THE CITY OF ALBUQUERQUE STANDARD SPECIFICATIONS FOR PUBLIC WORKS CONSTRUCTION, 1986 EDITION (UPDATE #7)
2. TWO WORKING DAYS PRIOR TO ANY EXCAVATION, THE CONTRACTOR MUST CONTACT NEW MEXICO ONE CALL SYSTEM (260-1990) FOR LOCATION OF EXISTING UTILITIES.
3. ANY WORK AFFECTING AN ARTERIAL ROADWAY REQUIRES 24-HOUR CONSTRUCTION.
4. PRIOR TO CONSTRUCTION, THE CONTRACTOR SHALL EXCAVATE AND VERIFY THE HORIZONTAL AND VERTICAL LOCATIONS OF ALL OBSTRUCTIONS. SHOULD A CONFLICT EXIST, THE CONTRACTOR SHALL NOTIFY THE ENGINEER OR SURVEYOR IMMEDIATELY SO THAT THE CONFLICT CAN BE RESOLVED WITH A MINIMUM AMOUNT OF DELAY.
5. FIVE (5) WORKING DAYS PRIOR TO BEGINNING OF CONSTRUCTION, THE CONTRACTOR SHALL SUBMIT TO CONSTRUCTION COORDINATION DIVISION A DETAILED CONSTRUCTION SCHEDULE. TWO (2) WORKING DAYS PRIOR TO CONSTRUCTION, THE CONTRACTOR SHALL OBTAIN A BARRICADING PERMIT FROM THE CONSTRUCTION COORDINATION DIVISION. CONTRACTOR SHALL NOTIFY BARRICADE ENGINEER (924-3400) PRIOR TO OCCUPYING AN INTERSECTION. REFER TO STANDARD SPECIFICATIONS.
6. ALL STREET STRIPING ALTERED OR DESTROYED SHALL BE REPLACED WITH PLASTIC REFLECTORIZED PAVEMENT MARKINGS BY THE CONTRACTOR TO LOCATION AS EXISTING OR AS INDICATED BY THIS PLAN SET.
7. CONTRACTOR SHALL NOTIFY THE ENGINEER NOT LESS THAN SEVEN (7) DAYS PRIOR TO STARTING WORK IN ORDER THAT THE ENGINEER MAY TAKE NECESSARY MEASURES TO INSURE THE PRESERVATION OF SURVEY MONUMENTS. CONTRACTOR SHALL NOT DISTURB PERMANENT SURVEY MONUMENTS WITHOUT THE CONSENT OF THE ENGINEER AND SHALL NOTIFY THE ENGINEER AND BEAR THE EXPENSE OF REPLACING ANY THAT MAY BE DISTURBED WITHOUT PERMISSION. REPLACEMENT SHALL BE DONE ONLY BY THE CITY SURVEYOR. WHEN A CHANGE IS MADE IN THE FINISHED ELEVATIONS OF THE PAVEMENT OF ANY ROADWAY IN WHICH A PERMANENT SURVEY MONUMENT IS LOCATED, CONTRACTOR SHALL, AT HIS OWN EXPENSE, ADJUST THE MONUMENT COVER TO THE NEW GRADE UNLESS OTHERWISE SPECIFIED. REFER TO SECTION 4.4 OF THE GENERAL CONDITIONS OF THE STANDARD SPECIFICATIONS. ANY PERMANENT SURVEY MONUMENT LOCATED WITHIN 50' OF THIS PROJECT THAT IS NOT SHOWN ON THE PLAN AND IS DESTROYED DURING CONSTRUCTION WILL BE REPLACED AT THE DESIGNER'S EXPENSE.
8. FOR ALL STORM DRAIN CONSTRUCTION, R.C.P. PIPE JOINTS SHALL NOT BE GROUTED PRIOR TO FINAL INSPECTION. FINAL INSPECTION WILL DETERMINE JOINTS TO BE GROUTED FOR FINAL ACCEPTANCE OF THE CONSTRUCTION.
9. CONTRACTOR SHALL MAINTAIN A GRAFFITI-FREE WORK SITE. CONTRACTOR SHALL REMOVE ANY AND ALL GRAFFITI FROM EQUIPMENT, WHETHER PERMANENT OR TEMPORARY.


THE FOLLOWING NOTES ALSO APPLY WHEN CHECKED

- ☒ ALL UTILITIES AND UTILITY SERVICE LINES SHALL BE INSTALLED PRIOR TO PAVING.
- ☒ BACKFILL COMPACTION SHALL BE ACCORDING TO SPECIFIED STREET USE.
- ☐ TACK COAT REQUIREMENTS SHALL BE DETERMINED BY THE CITY ENGINEER.
- ☒ SIDEWALKS AND WHEELCHAIR RAMPS WITHIN THE CURB RETURNS SHALL BE CONSTRUCTED WHEREVER A NEW CURB RETURN IS CONSTRUCTED.
- ☐ IF CURB IS DERESSED FOR A DRIVEPAD, THE DRIVEPAD SHALL BE CONSTRUCTED PRIOR TO ACCEPTANCE OF CURB AND GUTTER.
- ☒ ALL STORM DRAINAGE FACILITIES SHALL BE COMPLETED PRIOR TO FINAL ACCEPTANCE.

DRB# 1003554


TIERRA WEST, LLC
8509 JEFFERSON NE
ALBUQUERQUE, NEW MEXICO 87113
(505)858-3100

REV	SHEETS	CITY ENGINEER	DATE	USER DEPT.	DATE	USER DEPT.	DATE
ENGINEERS STAMP & SIGNATURE		APPROVALS	ENGINEER	DATE	*****		
 6-16-05		DRC Chairman	<i>[Signature]</i>	7-12-05	APPROVED FOR CONSTRUCTION <i>[Signature]</i> 7-22-05 City Engineer Date		
		Transportation	<i>[Signature]</i>	6/17/05			
		Water/Wastewater	<i>[Signature]</i>	6/16/05			
		Hydrology	<i>[Signature]</i>	6/30/05			
		C.I.F.	<i>[Signature]</i>	7-12-05			
Cnstr. Mngmt.		<i>[Signature]</i>	7-12-05				
Constr. Coord.		<i>[Signature]</i>	7-12-05				
CITY PROJECT NO.		762281		SHEET			
							1 OF 6

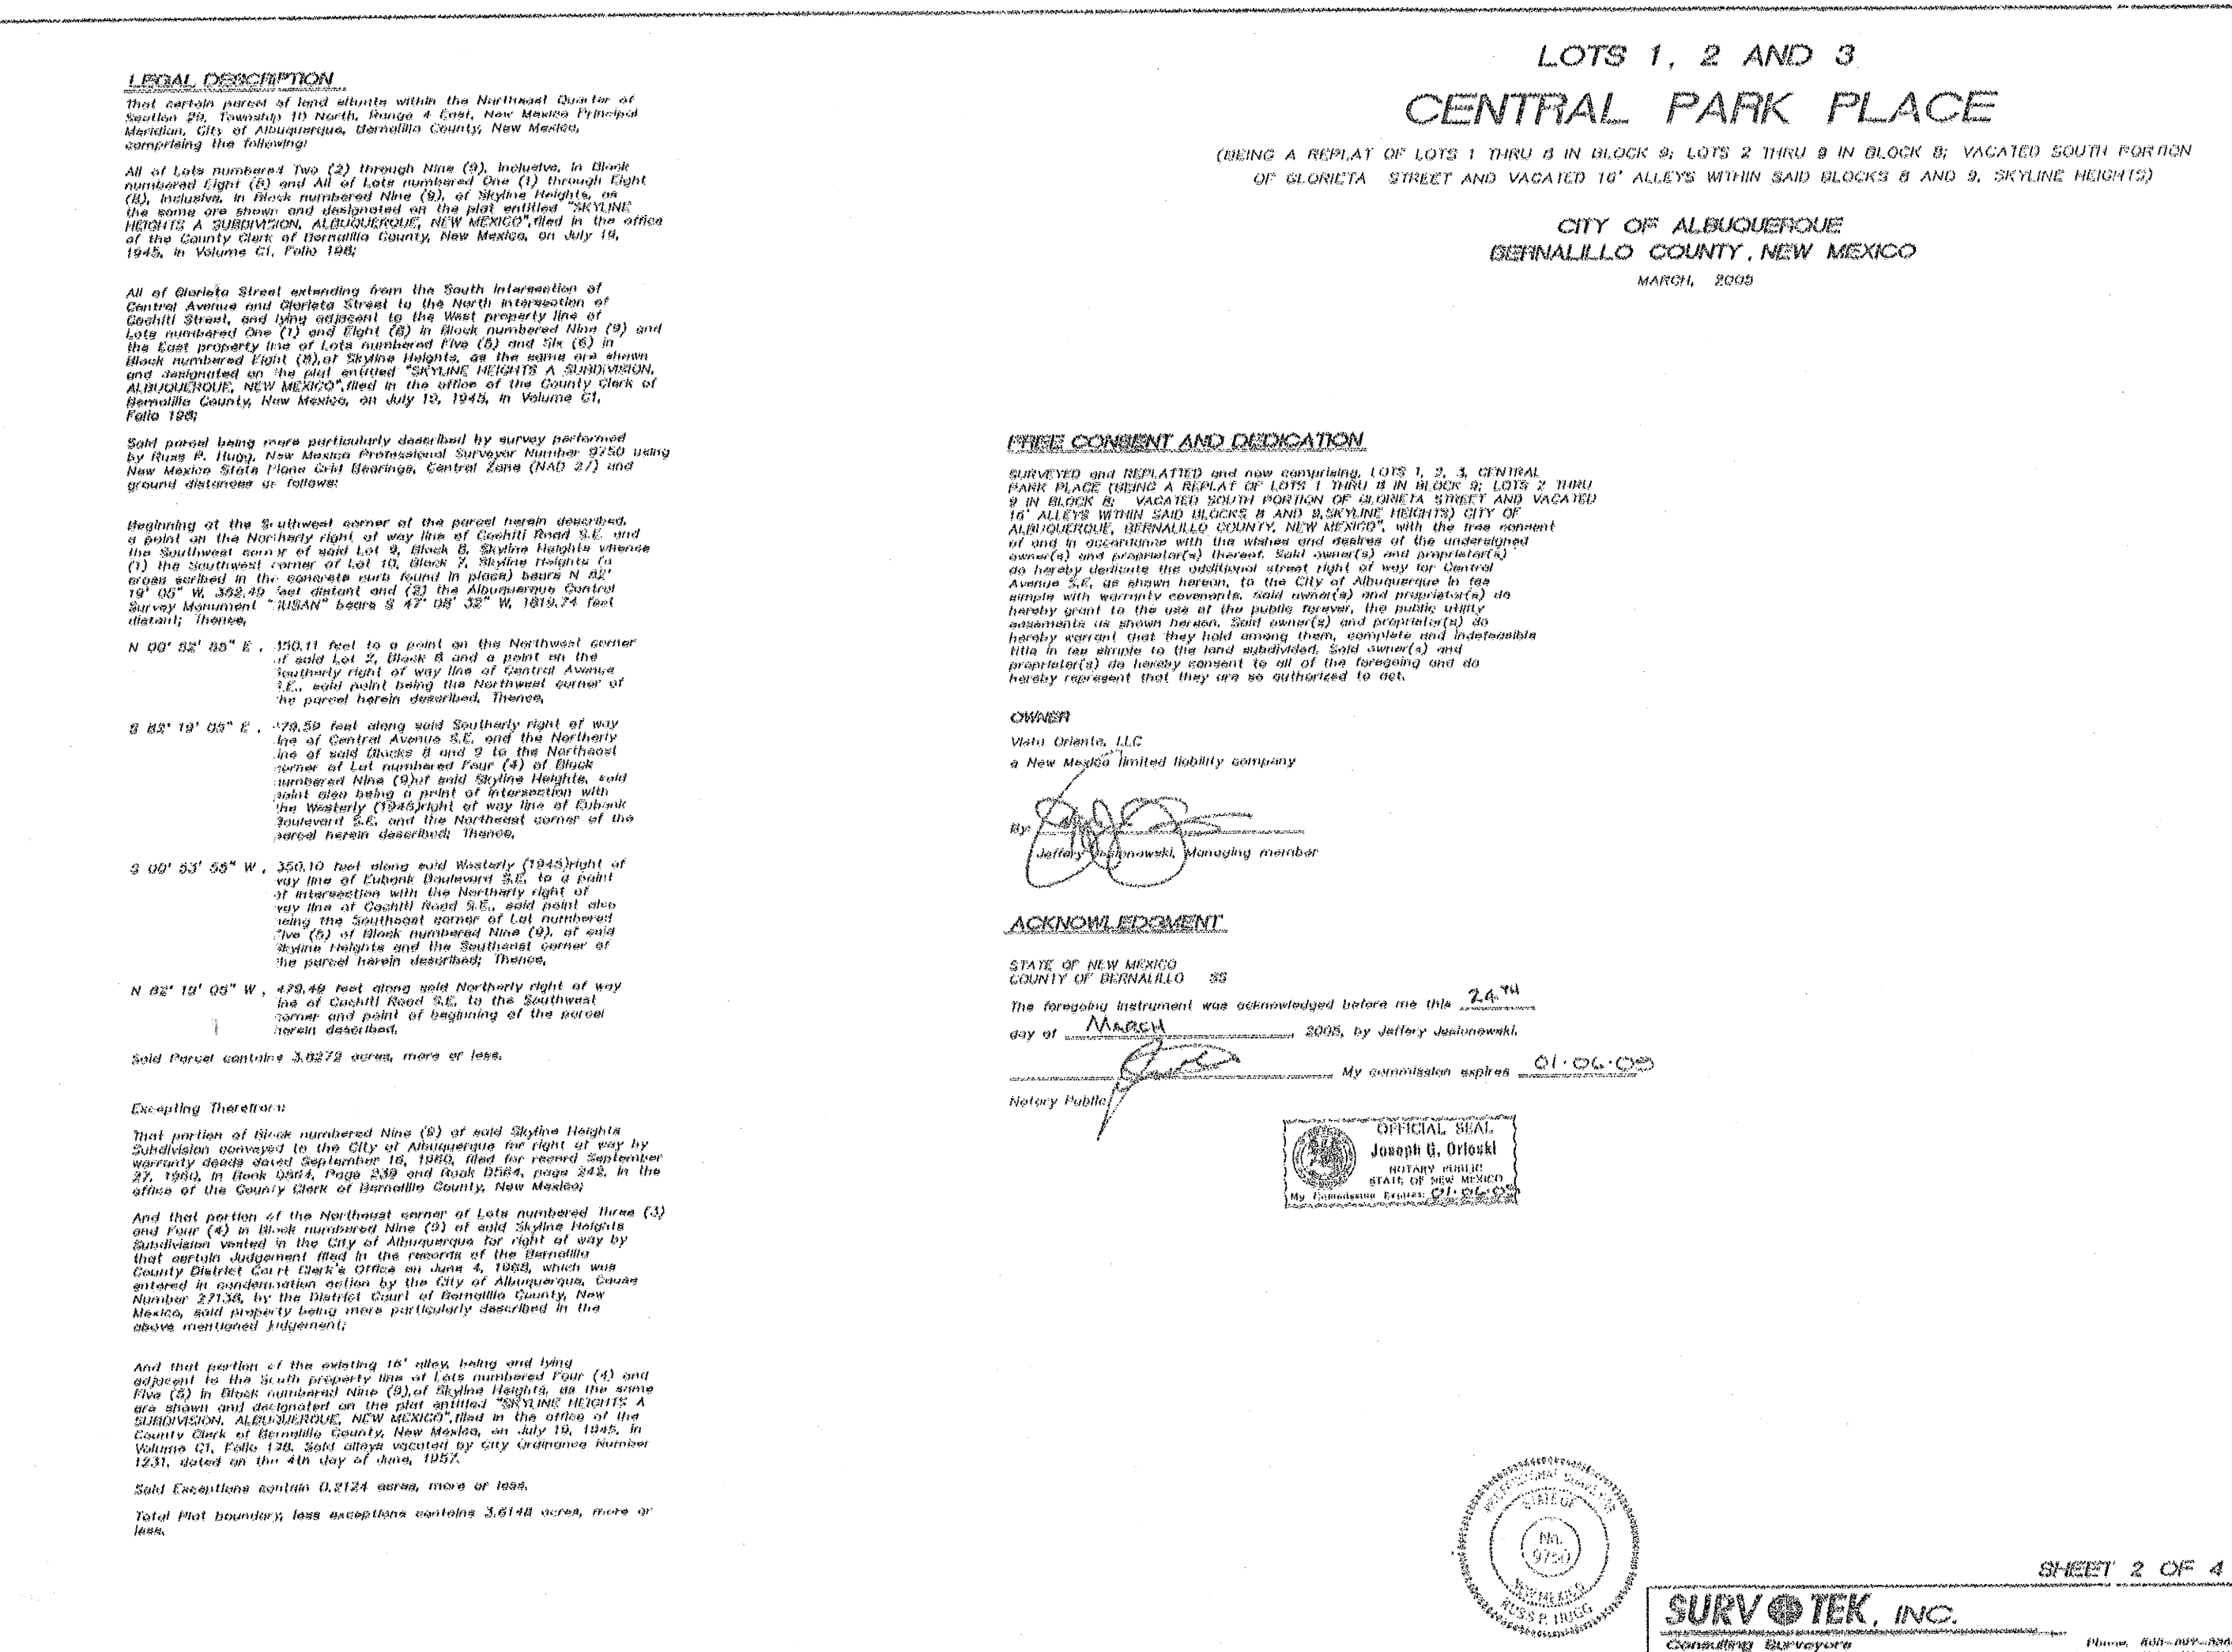


[illegible]

SCANNED BY PLN

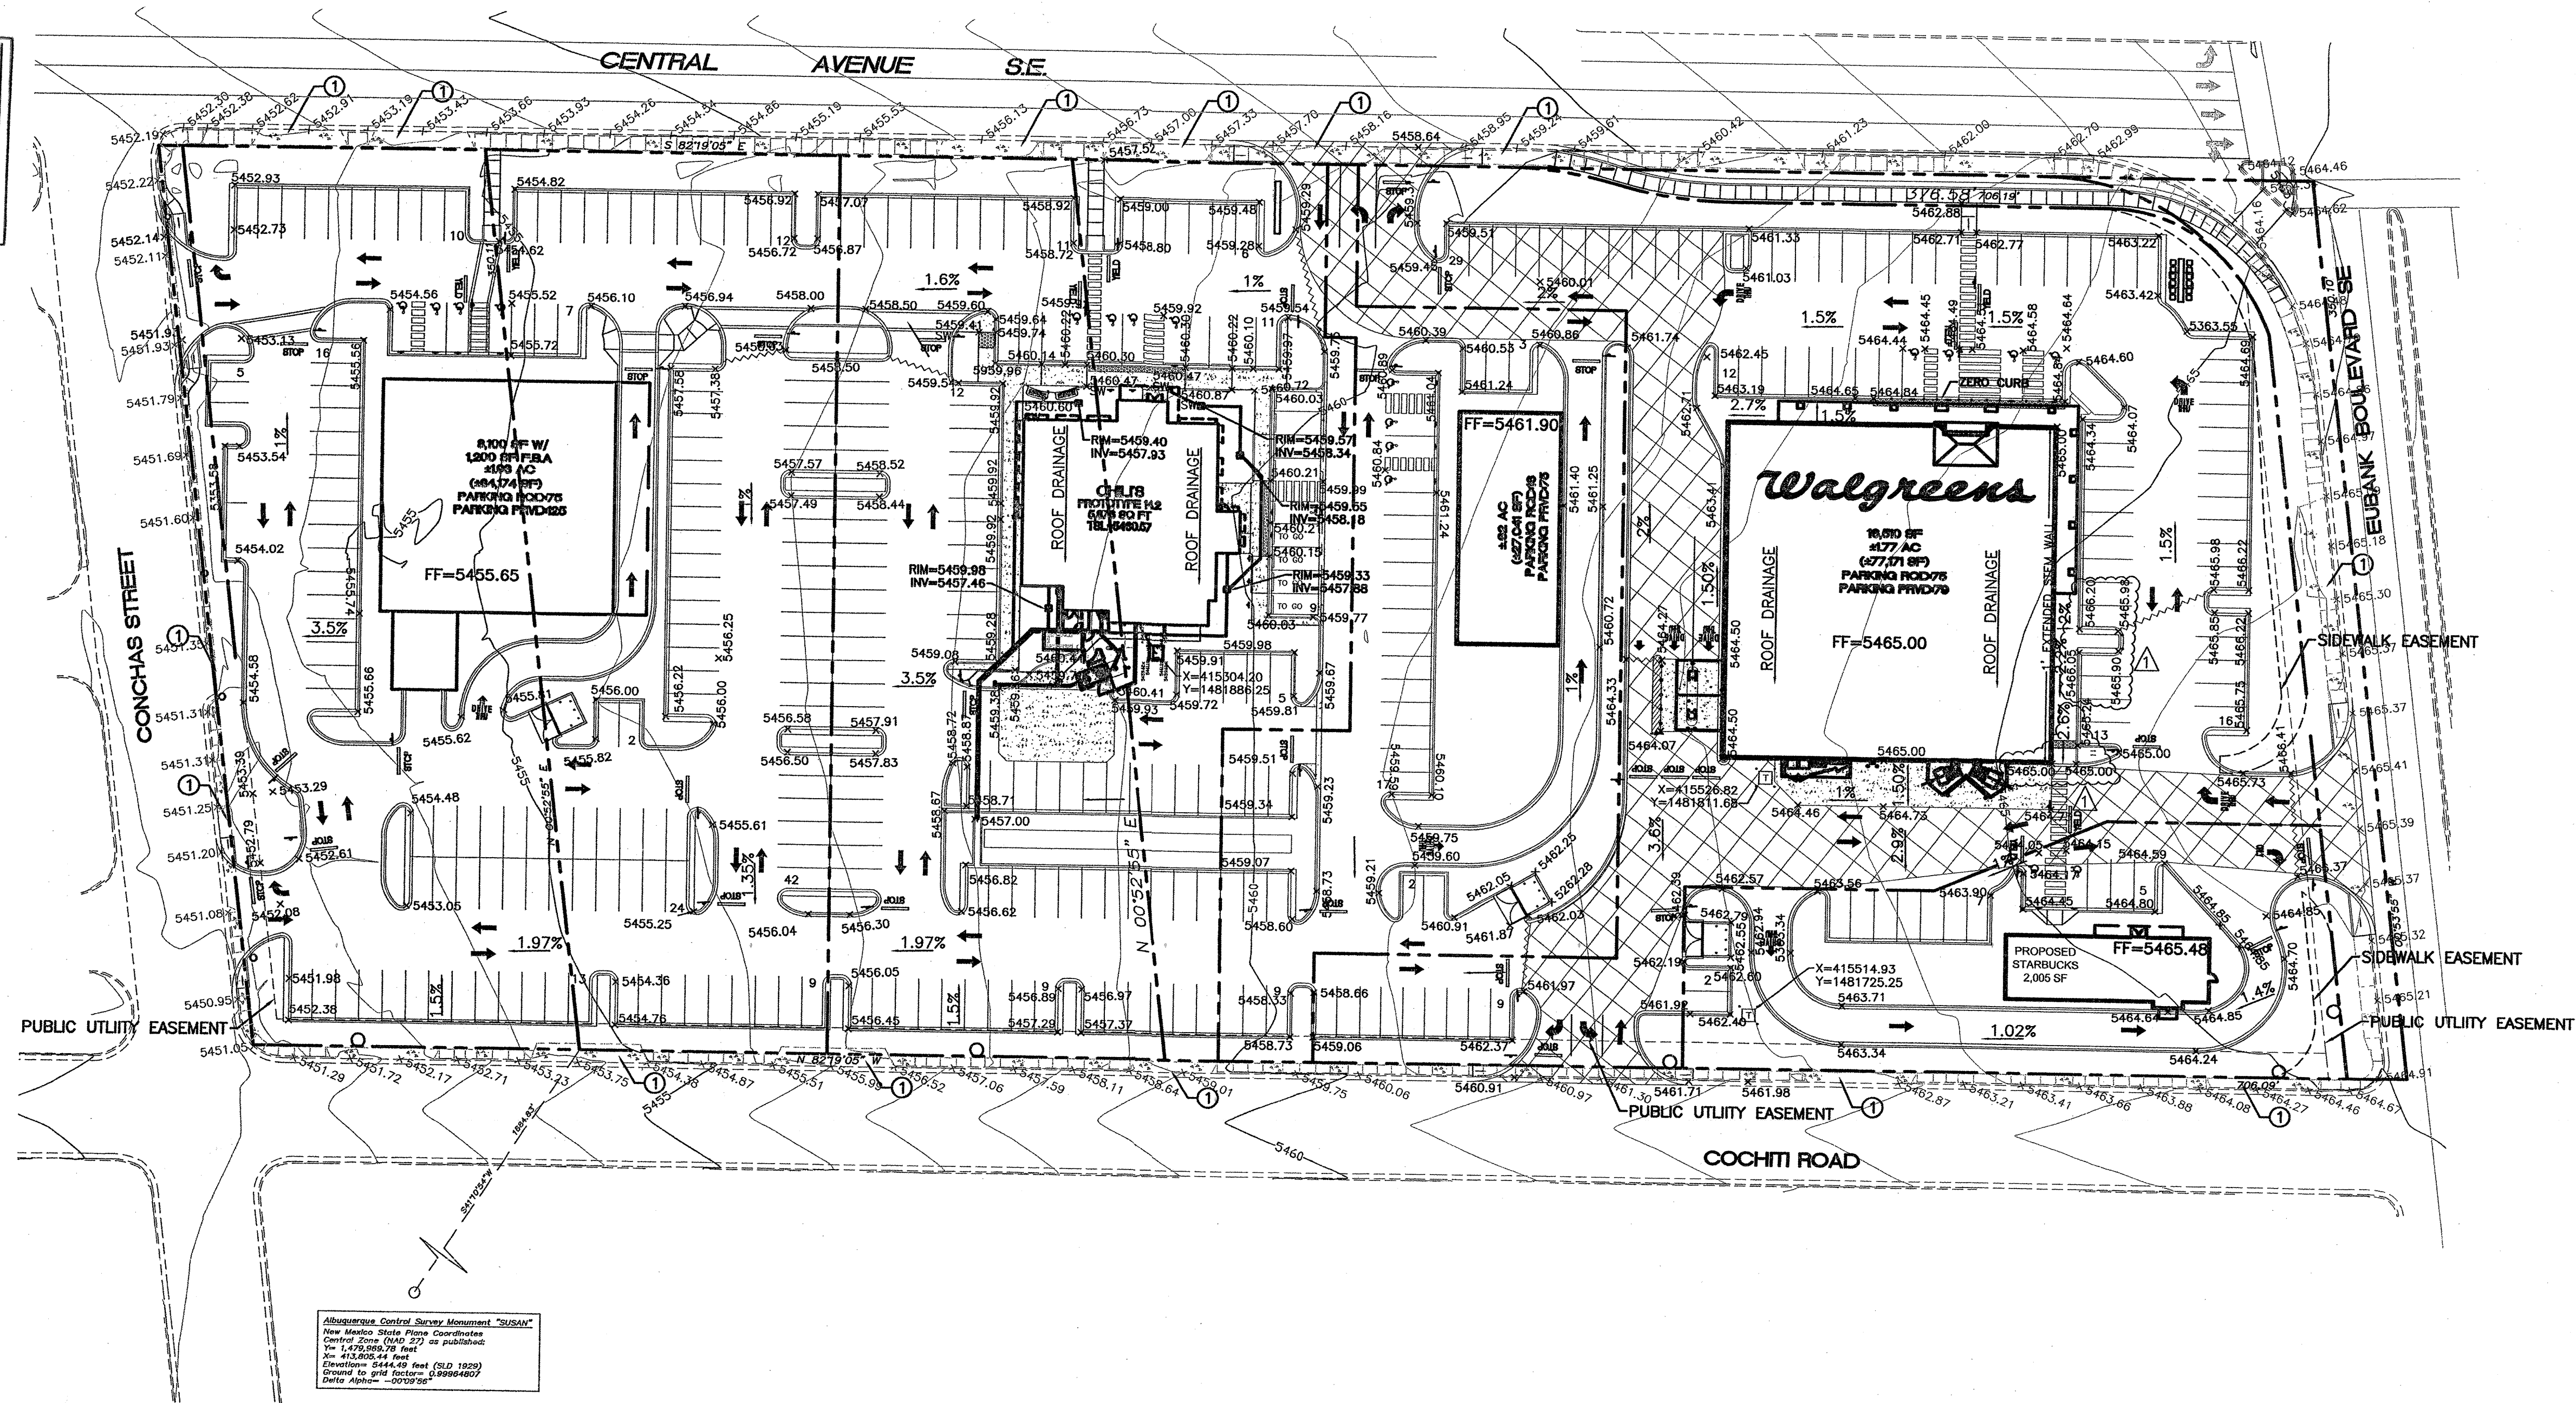

ALBUQUERQUE, Central, Survey Monument "SUBAN"
New Mexico State Plane Coordinates
Central Time Zone 100 277 as published
N= 415005.44 feet
E= 415005.44 feet
Datum to grid datum: 1985/1985
Datum to grid datum: 1985/1985
Datum to grid datum: 1985/1985

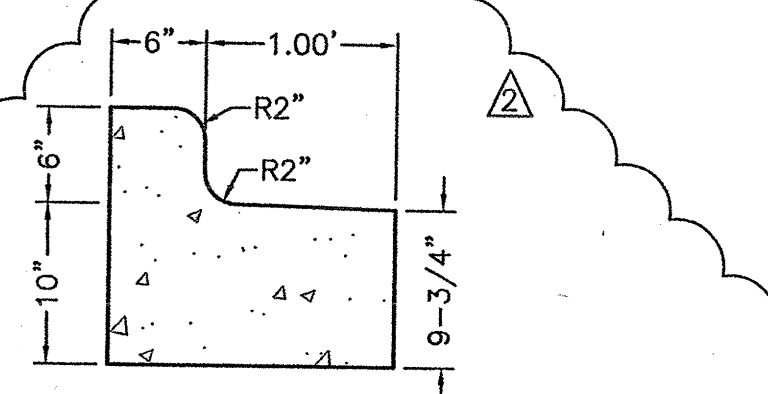


STANDARD CURB AND GUTTER
NOT TO SCALE

NOTICE TO CONTRACTORS

1. AN EXCAVATION/CONSTRUCTION PERMIT WILL BE REQUIRED BEFORE BEGINNING ANY WORK WITHIN CITY RIGHT-OF-WAY.
2. ALL WORK DETAILED ON THESE PLANS TO BE PERFORMED, EXCEPT AS OTHERWISE STATED OR PROVIDED HEREON, SHALL BE CONSTRUCTED IN ACCORDANCE WITH CITY OF ALBUQUERQUE INTERIM STANDARD SPECIFICATIONS FOR PUBLIC WORKS CONSTRUCTION, 1985.
3. TWO WORKING DAYS PRIOR TO ANY EXCAVATION, CONTRACTOR MUST CONTACT LINE LOCATING SERVICE, 765-1234, FOR LOCATION OF EXISTING UTILITIES.
4. PRIOR TO CONSTRUCTION, THE CONTRACTOR SHALL EXCAVATE AND VERIFY THE HORIZONTAL AND VERTICAL LOCATIONS OF ALL CONSTRUCTIONS. SHOULD A CONFLICT EXIST, THE CONTRACTOR SHALL NOTIFY THE ENGINEER SO THAT THE CONFLICT CAN BE RESOLVED WITH A MINIMUM AMOUNT OF DELAY.
5. BACKFILL COMPACTION SHALL BE ACCORDING TO TRAFFIC/STREET USE.
6. MAINTENANCE OF THESE FACILITIES SHALL BE THE RESPONSIBILITY OF THE OWNER OF THE PROPERTY SERVED.
7. WORK ON ARTERIAL STREETS SHALL BE PERFORMED ON A 24-HOUR BASIS.


APPROVAL	NAME	DATE
INSPECTOR		

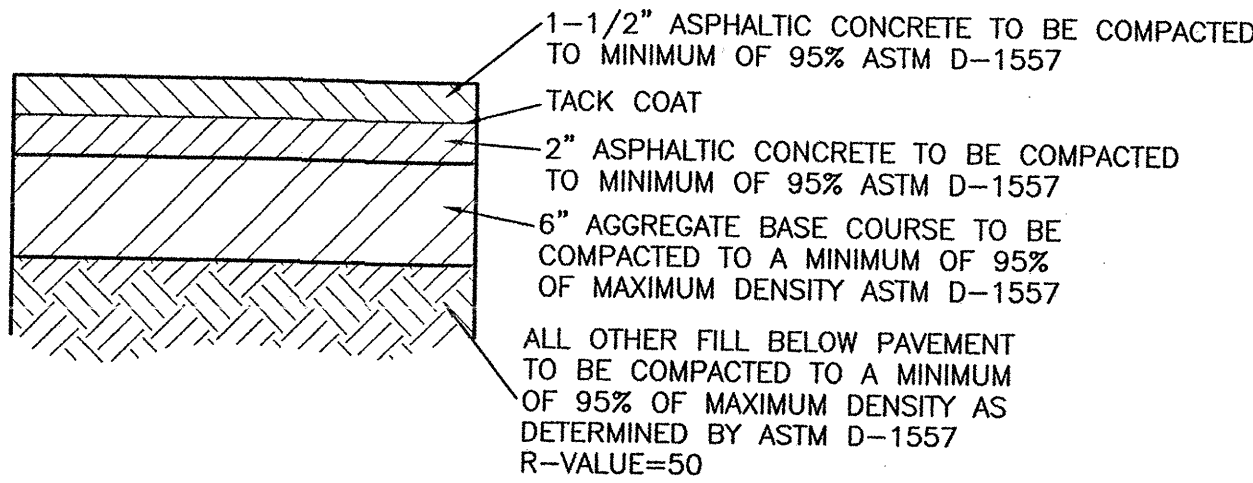



STANDARD TYPICAL PAVING SECTION
1" = 1'

EROSION CONTROL PLAN, NPDES PERMIT
AND POLLUTION PREVENTION NOTES

1. CONTRACTOR IS RESPONSIBLE FOR OBTAINING A TOPSOIL DISTURBANCE PERMIT PRIOR TO BEGINNING WORK.
2. CONTRACTOR IS RESPONSIBLE FOR CLEANING ALL SEDIMENT OUT OF EXISTING RIGHT-OF-WAY.
3. CONTRACTOR IS RESPONSIBLE FOR MAINTAINING ALL STORM RUN OFF ON SITE.
4. REPAIR OF DAMAGED FACILITIES AND CLEAN-UP OF SEDIMENT ACCUMULATION ON ADJACENT PROPERTIES AND IN PUBLIC FACILITIES IS THE RESPONSIBILITY OF THE CONTRACTOR.
5. ALL EXPOSED EARTH SURFACES MUST BE PROTECTED FROM WIND AND WATER EROSION PRIOR TO FINAL ACCEPTANCE OF ANY PROJECT.
6. ALL SITES OVER 1 ACRE DISTURBANCE REQUIRE FEDERAL NPDES PERMIT AND SWPPP.
7. ALL CURB WILL BE 6" MEDIAN CURB AND GUTTER UNLESS OTHER WISE SPECIFIED.
8. ALL WORK TO BE DONE PER CITY OF ALBUQUERQUE PUBLIC WORK SPECIFICATION LATEST EDITION.
9. PLEASE CONTACT RAINHART AND ASSOCIATES (505)-884-9110 FOR ALL SOILS AND PAD PREP INFORMATION.

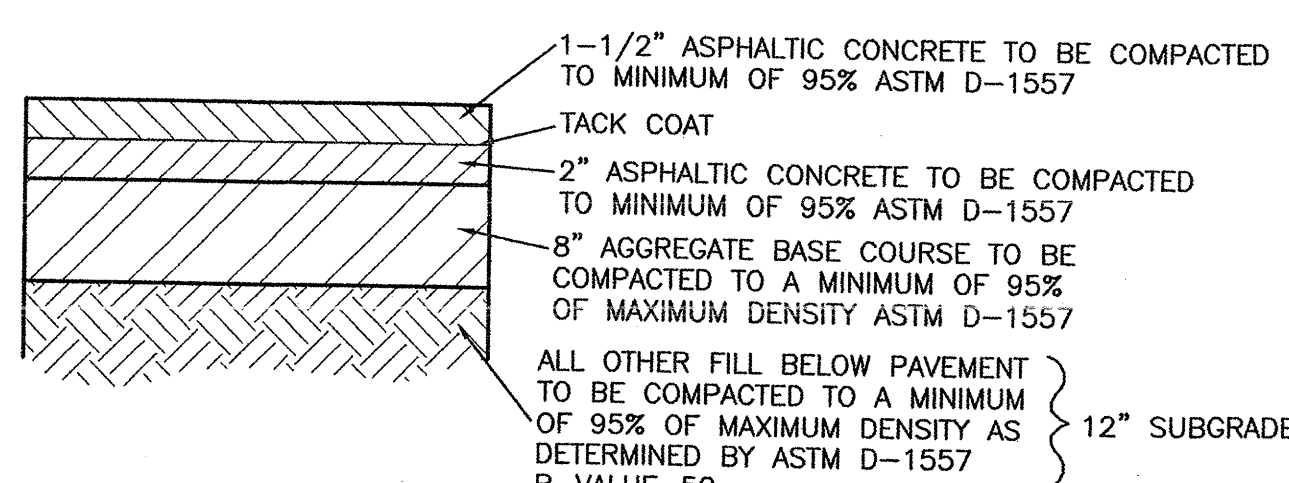

HEAVY DUTY TYPICAL PAVING SECTION
1" = 1'

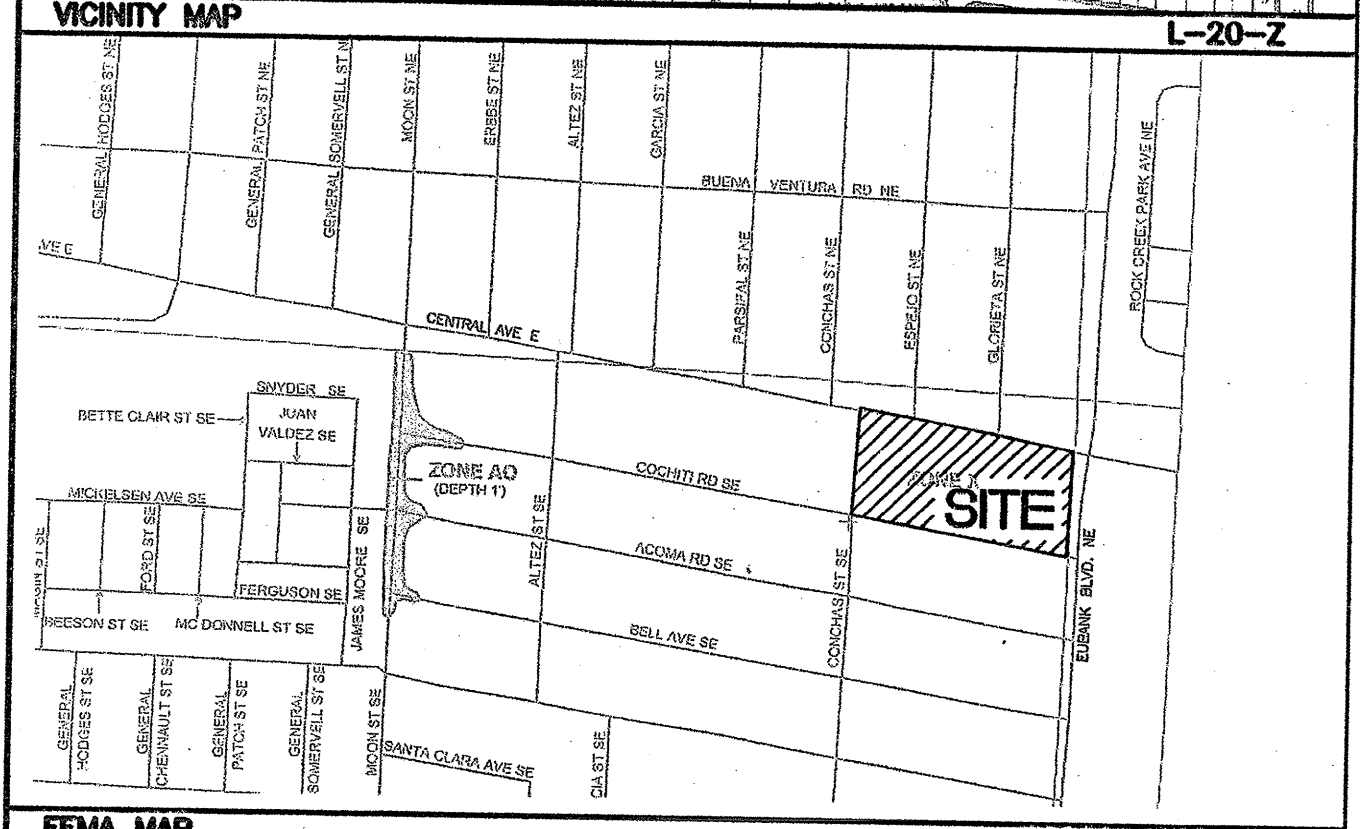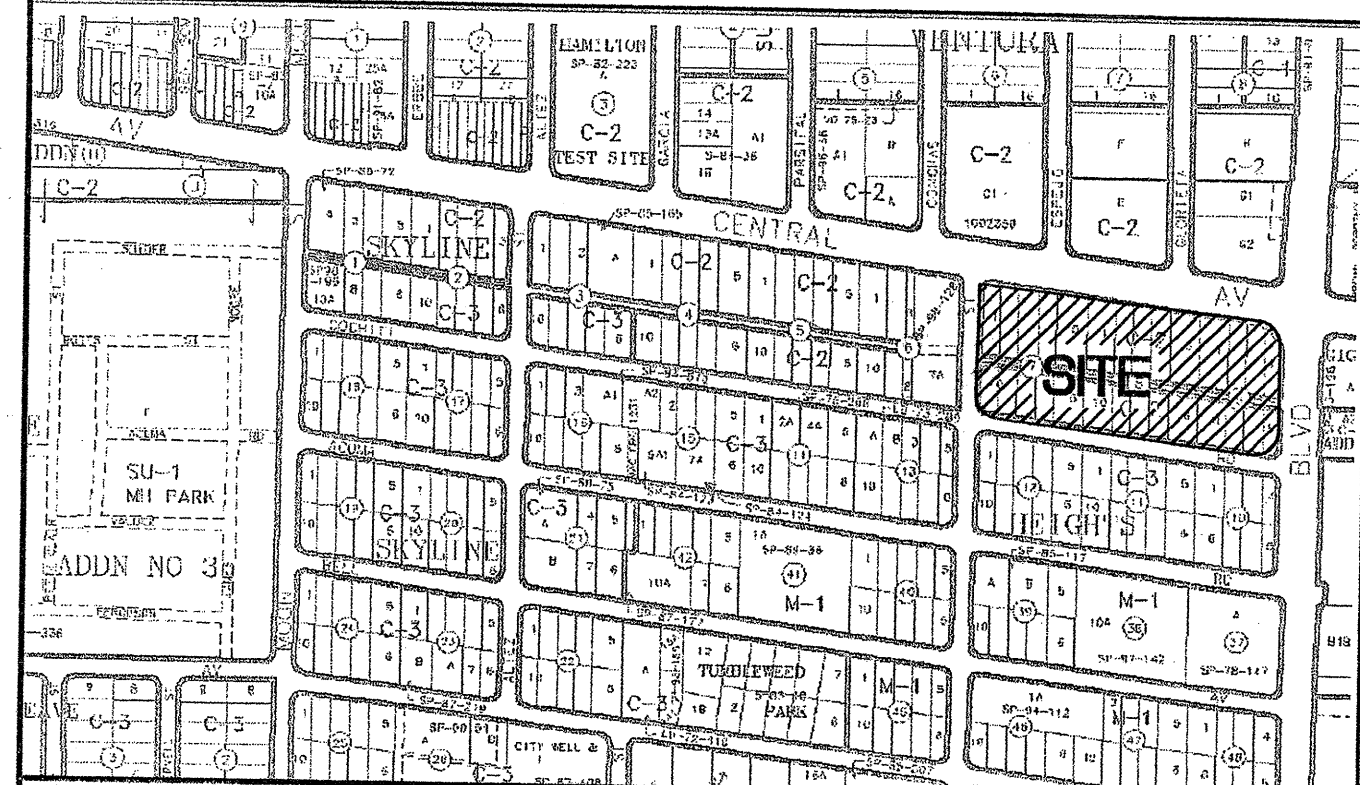

LEGEND

- EXISTING CURB & GUTTER
- PROPOSED CURB & GUTTER
- BOUNDARY LINE
- EXISTING BOUNDARY LINE
- EASEMENT
- PROPOSED SIDEWALK
- EXISTING SIDEWALK
- EXISTING CONTOUR
- EXISTING INDEX CONTOUR
- FLOW ARROW
- EXISTING SPOT ELEVATION
- PROPOSED SPOT ELEVATION
- RIGHT-OF-WAY
- LOT LINES
- LANE
- STRIPING
- HEAVY DUTY PAVING
- STANDARD PAVING

KEYED NOTES:

1. REMOVE AND DISPOSE OF EXISTING DRIVE PAD. REPLACE WITH NEW STANDARD CURB AND GUTTER. MATCH EXISTING FLOW LINE OF STREET.

NOTES:

1. OFFSITE IMPROVEMENTS MUST BE NEW OR REPAIRED TO AS NEW CONDITION ACCEPTABLE TO WALGREENS.
2. SETBACKS PER C-2 ZONING CODE.






CAUTION:

ALL EXISTING UTILITIES SHOWN WERE OBTAINED FROM RESEARCH, AS-BUILTS, SURVEYS OR INFORMATION PROVIDED BY OTHERS. IT SHALL BE THE SOLE RESPONSIBILITY OF THE CONTRACTOR TO CONDUCT ALL NECESSARY FIELD INVESTIGATIONS PRIOR TO AND INCLUDING ANY EXCAVATION, TO DETERMINE THE ACTUAL LOCATION OF UTILITIES AND OTHER IMPROVEMENTS. PRIOR TO STARTING THE WORK, ANY CHANGES FROM THIS PLAN SHALL BE COORDINATED WITH AND APPROVED BY THE ENGINEER.

1	07-22-05	CHANGED LOCATION OF LANDSCAPE ISLAND AND RAMP	SA
2	08-15-05	CHANGED CURB DETAIL PER JIM FROM WILGER REQUEST	SA
NO.	DATE	REMARKS	BY
REVISIONS			
ENGINEER'S SEAL		EUBANK AND CENTRAL WALGREENS STORE #09773	
DRAWN BY EMT		DATE 09-13-05	
241808-03-21-05K.dwg		SHEET #	
VINCENT P. CARRICA P.E. #16212		C-1	
TERRA WEST, LLC 8509 JEFFERSON NE ALBUQUERQUE, NEW MEXICO 87113 (505)858-3100		JOB # 240018	

SCANNED
BY PLN

NOTE:
STATIONING STARTS ON NW
PROPERTY CORNER AT 10+00

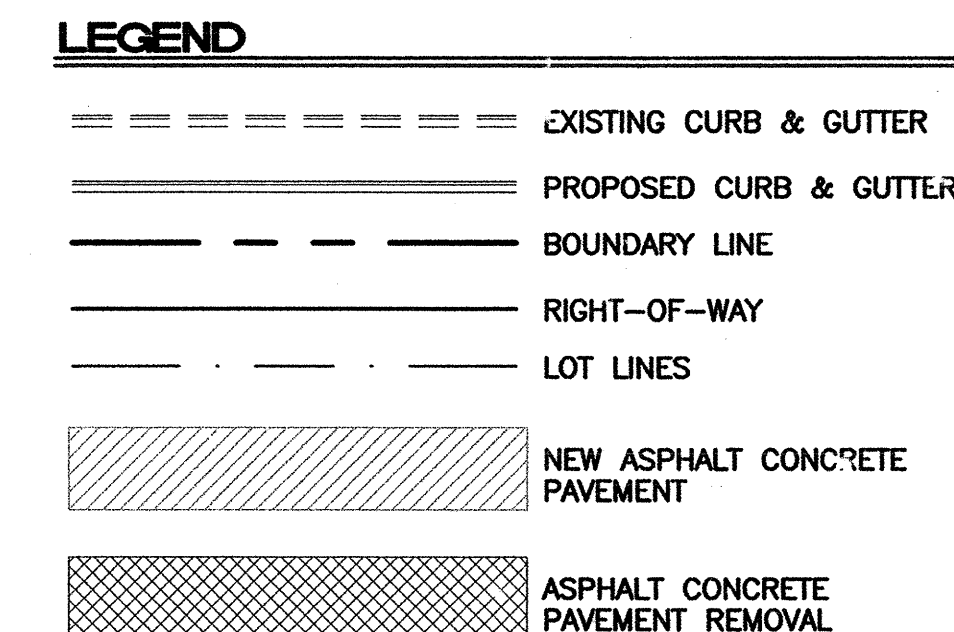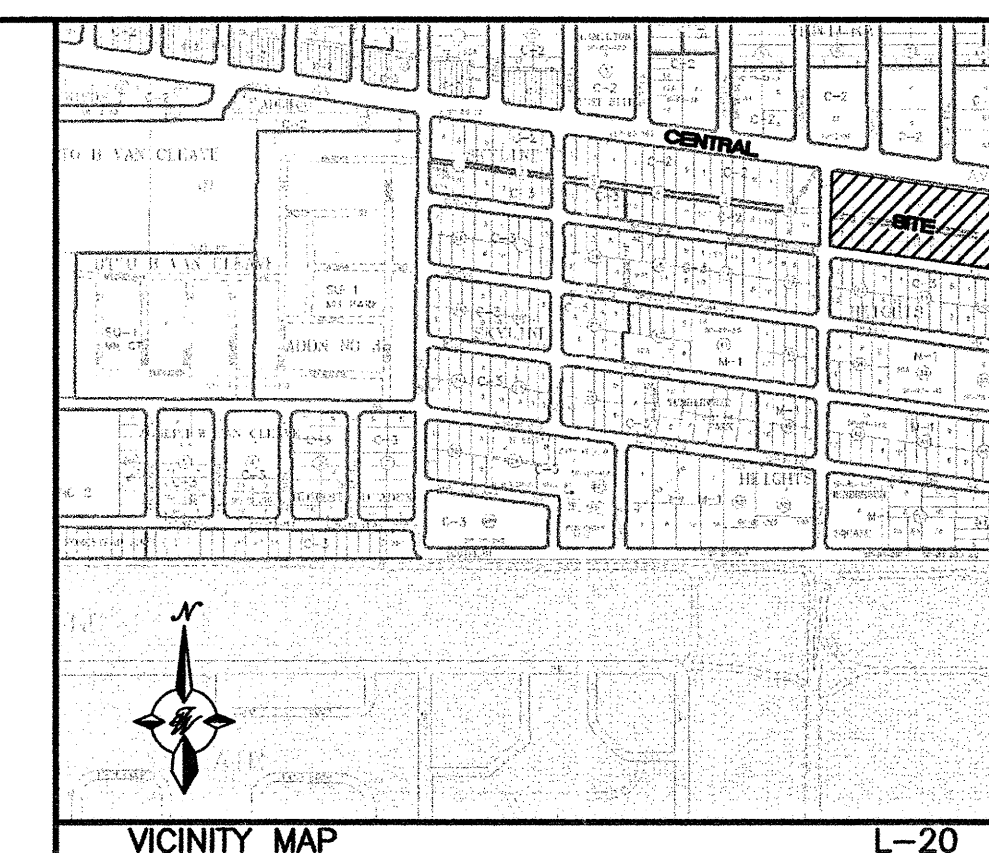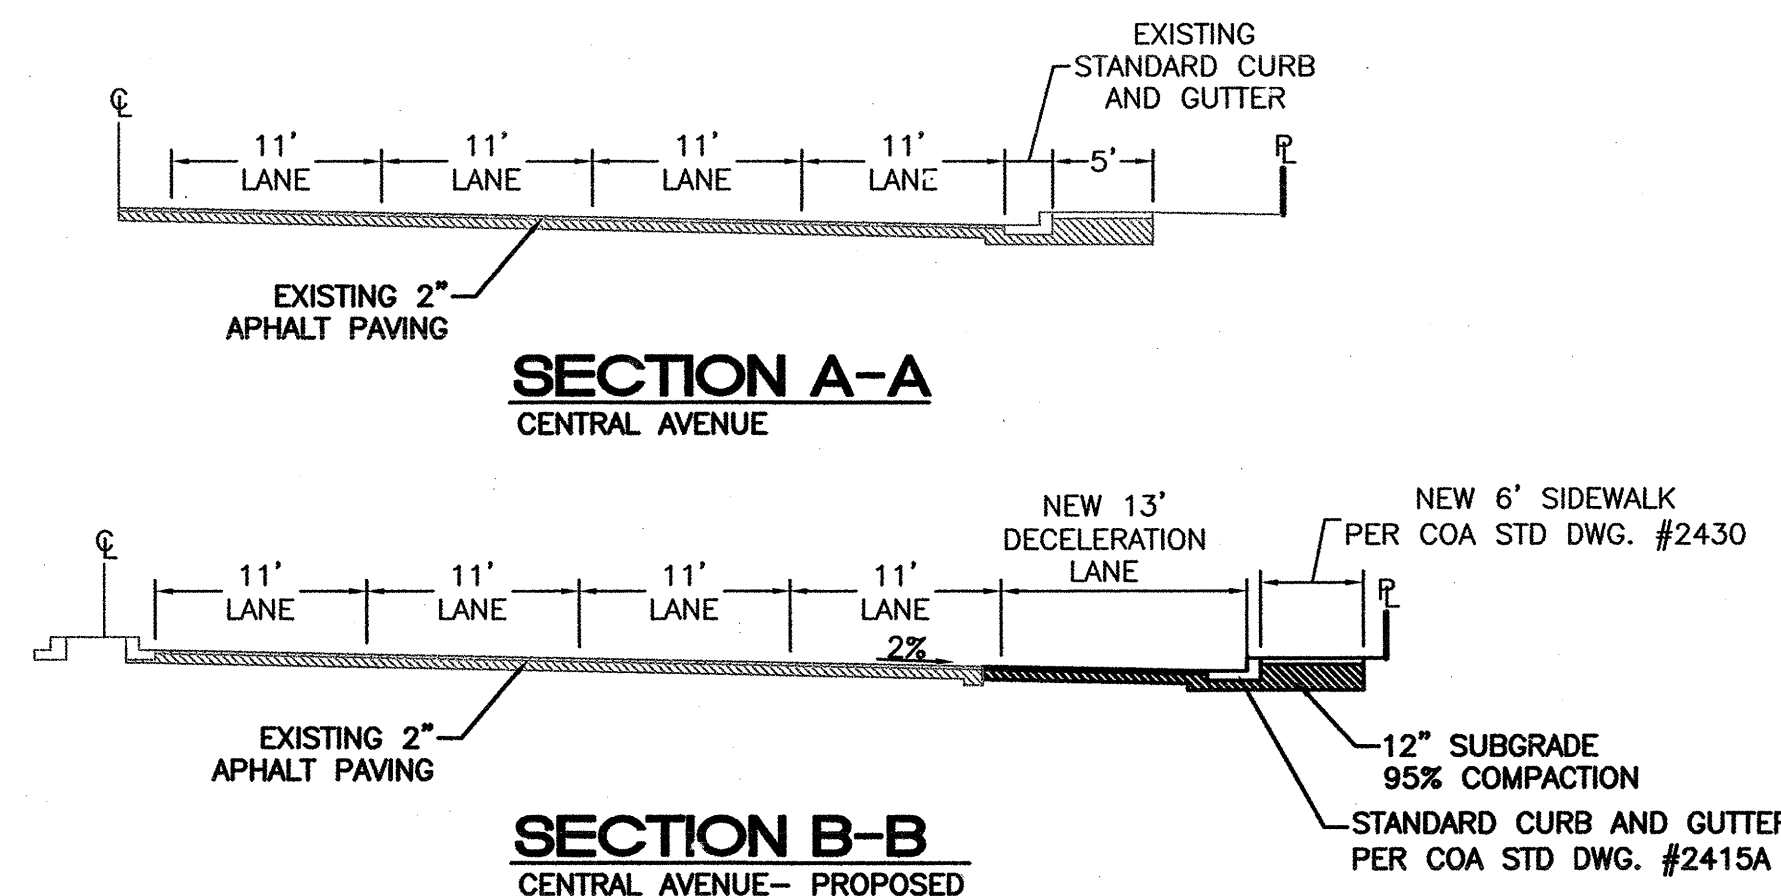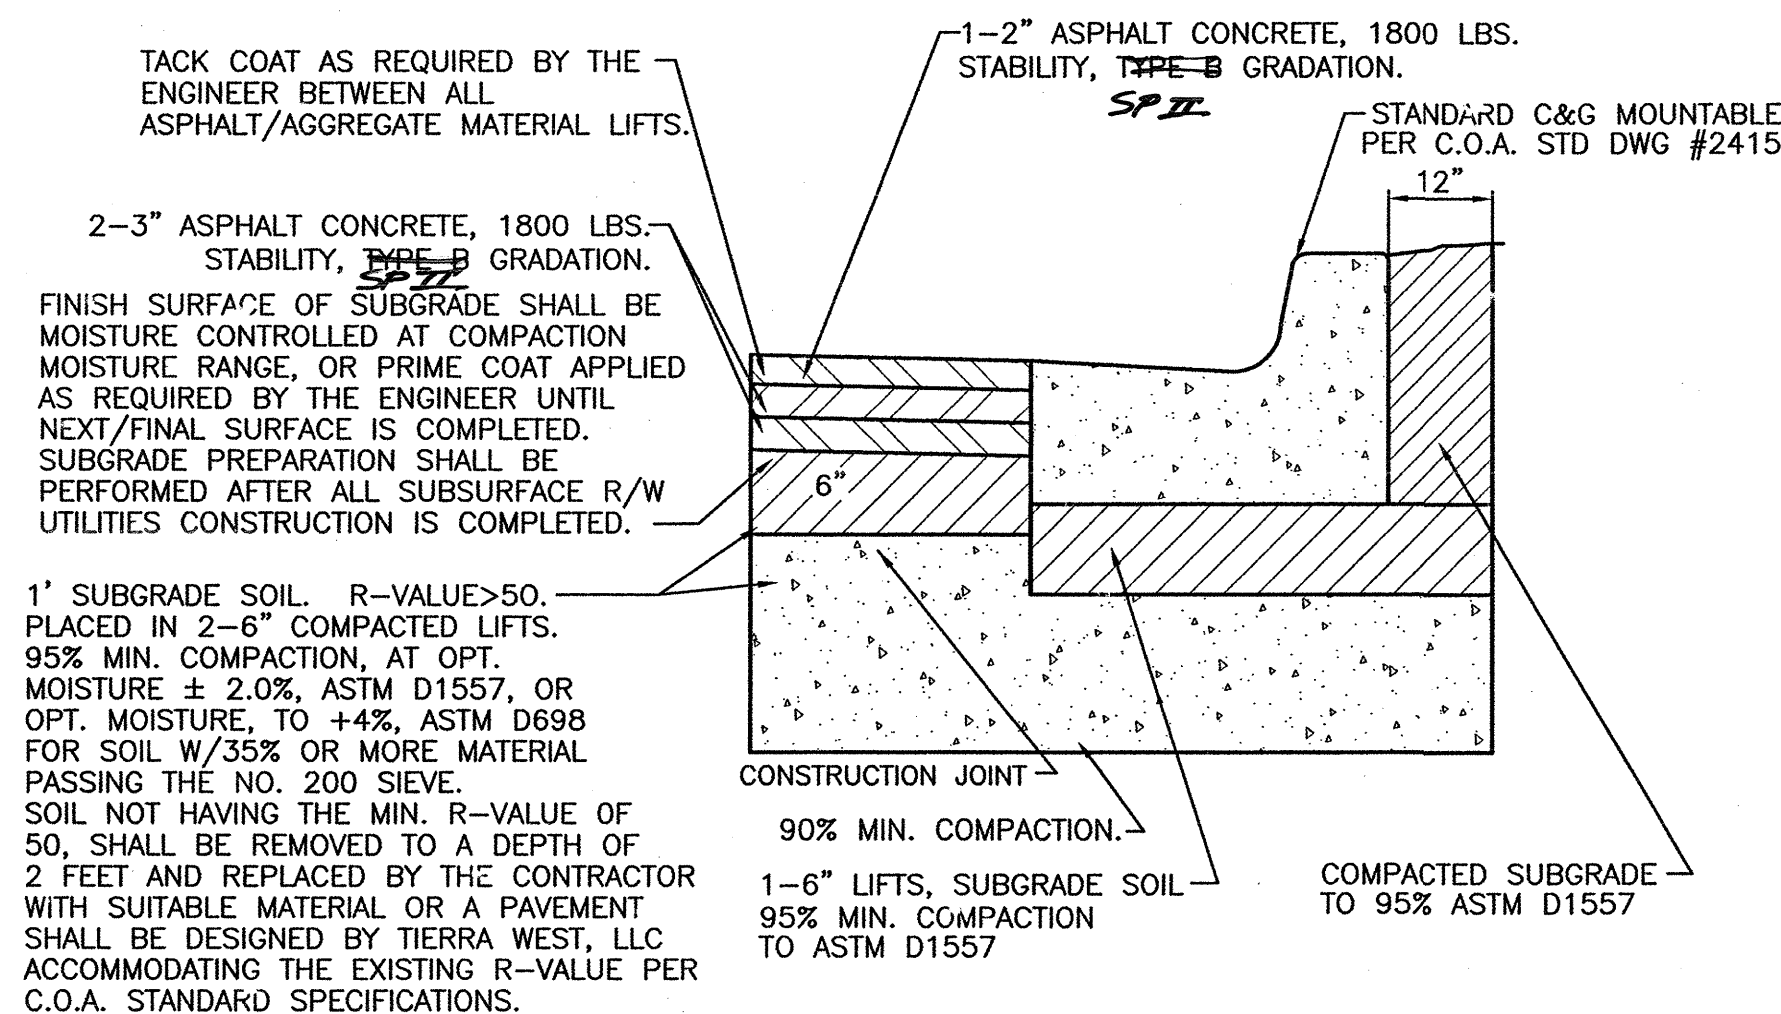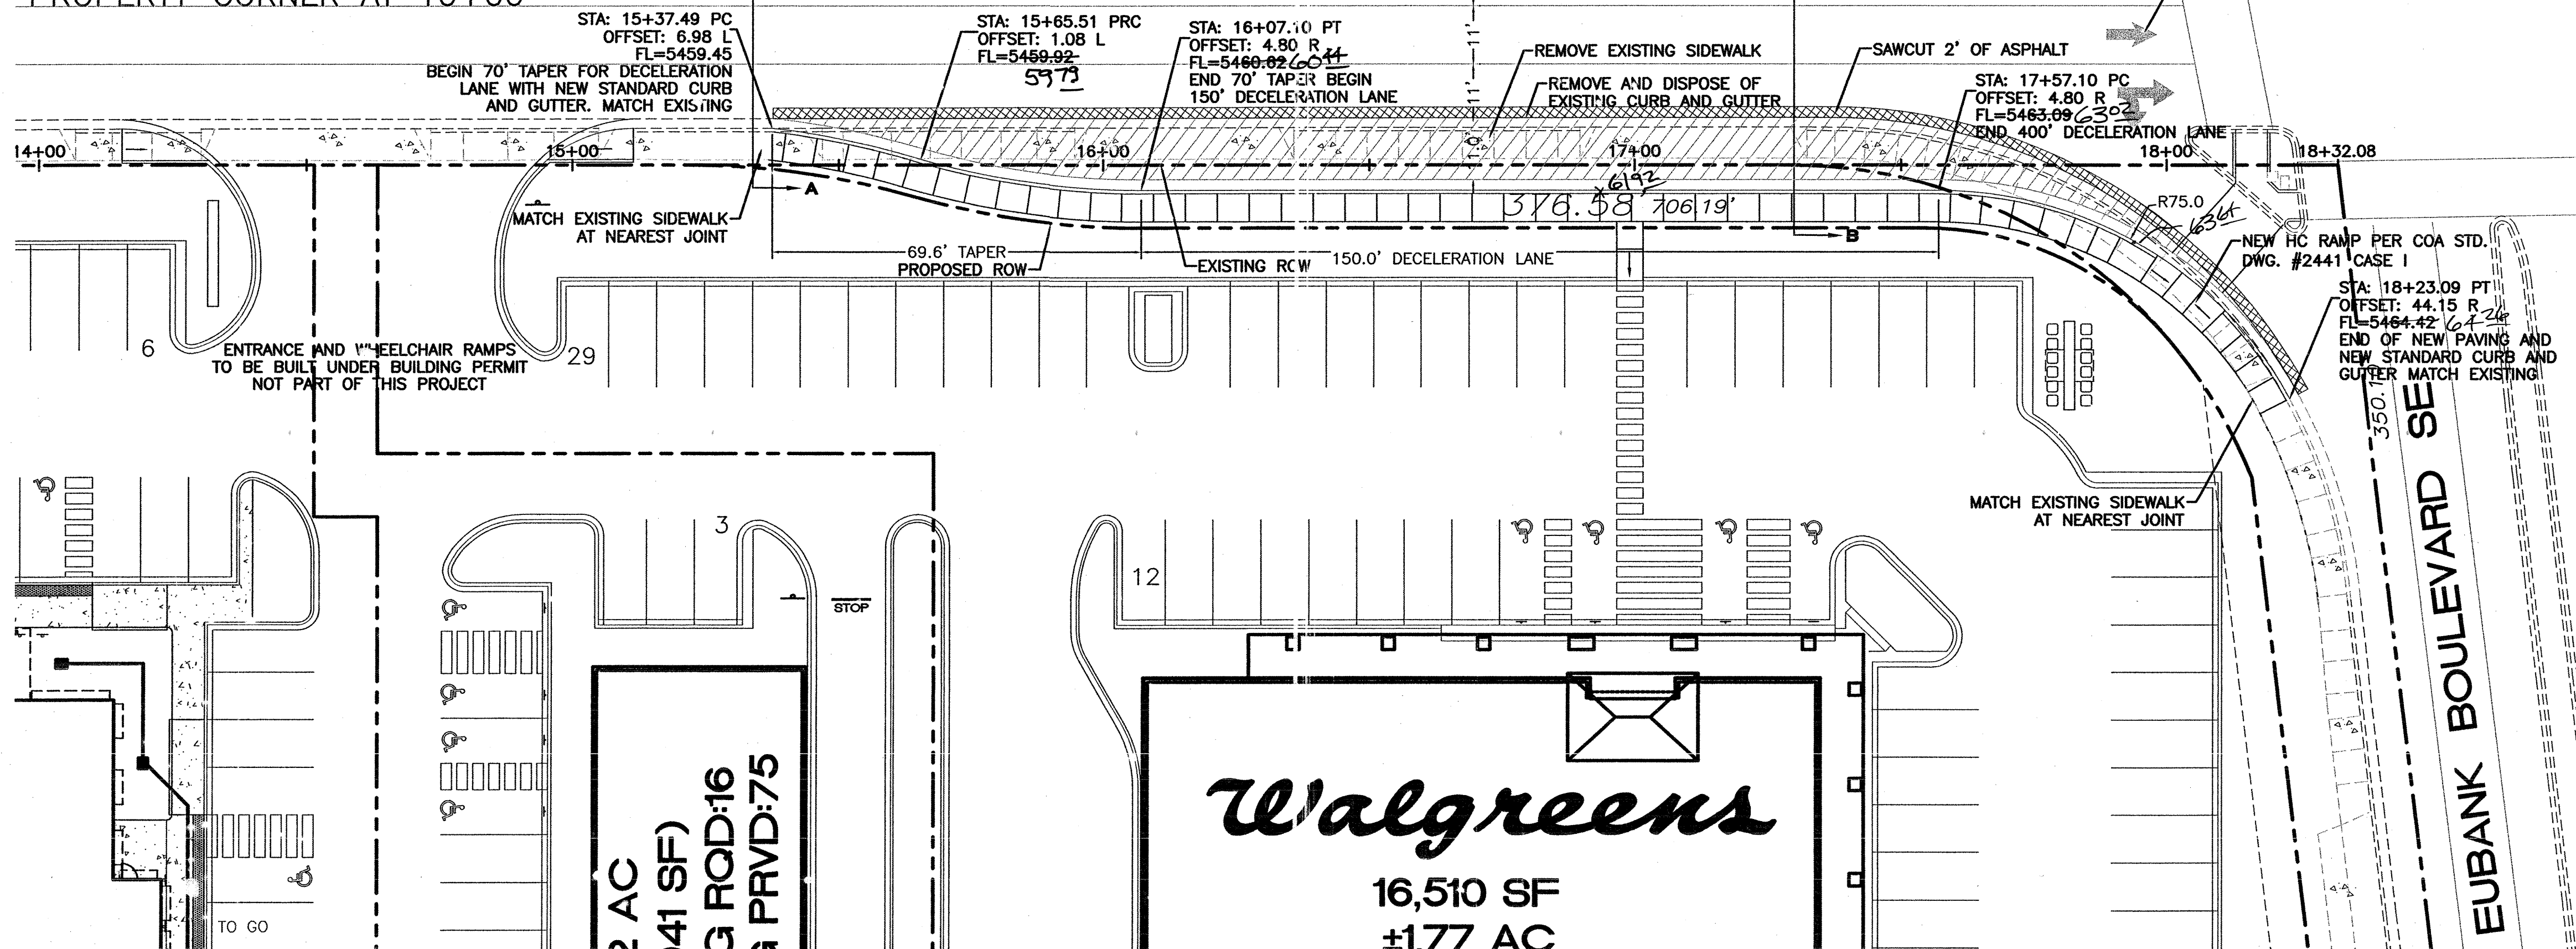


SURVEYORS CERTIFICATION

I, Russ P. Hugg, New Mexico Professional Surveyor Number 9750, Hereby Certify that the as-built information shown hereon is the result of an actual field survey performed by me or under my direct supervision and that the same is true and correct to the best of my knowledge and belief.

Russ P. Hugg
NMPS No. 9750
11-17 2005



GRAPHIC SCALE

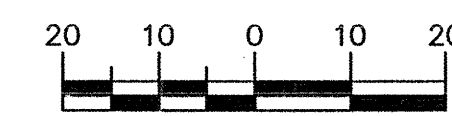

CAUTION:

ALL EXISTING UTILITIES SHOWN WERE OBTAINED FROM RESEARCH, AS-BUILTS, SURVEYS OR INFORMATION PROVIDED BY OTHERS. IT SHALL BE THE SOLE RESPONSIBILITY OF THE CONTRACTOR TO CONDUCT ALL NECESSARY FIELD INVESTIGATIONS PRIOR TO AND INCLUDING ANY EXCAVATION, TO DETERMINE THE ACTUAL LOCATION OF UTILITIES AND OTHER IMPROVEMENTS, PRIOR TO STARTING THE WORK. ANY CHANGES FROM THIS PLAN SHALL BE COORDINATED WITH AND APPROVED BY THE ENGINEER.

TIERRA WEST, LLC
8509 JEFFERSON NE
ALBUQUERQUE, NEW MEXICO 87113
(505)858-3100

CITY OF ALBUQUERQUE
PUBLIC WORKS DEPARTMENT
ENGINEERING GROUP


TITLE: **EUBANK AND CENTRAL
PAVING IMPROVEMENTS
CENTRAL AVE. RIGHT TURN LANE**

DESIGN REVIEW COMMITTEE	CITY ENGINEER APPROVAL	MO./DAY/YR.	MO./DAY/YR.
APPROVE JUL 1 2 2005	APPROVE JUL 2 2 2005 CITY ENGINEER		
DESIGN REVIEW COMMITTEE			

CITY PROJECT NO. **762281** ZONE MAP NO. **L-20** SHEET **4** OF **6**

AS BUILT INFORMATION		BENCH MARKS		SURVEY INFORMATION		ENGINEER'S SEAL		REVISIONS	
CONTRACTOR	SALES	DATE	BY	NO.	DATE	NO.	DATE	NO.	DATE
CONTRACTOR: SALES	SALES	DATE: 06-16-05	BY: SA	NO.	DATE: 06-16-05	NO.	DATE: 06-16-05	NO.	DATE: 06-16-05
DESIGNED BY: SA	DESIGNED BY: SA	DATE: 06-16-05	DESIGNED BY: SA	NO.	DATE: 06-16-05	NO.	DATE: 06-16-05	NO.	DATE: 06-16-05
DRAWN BY: ENT	DRAWN BY: ENT	DATE: 06-16-05	DRAWN BY: ENT	NO.	DATE: 06-16-05	NO.	DATE: 06-16-05	NO.	DATE: 06-16-05
CHECKED BY: RRB	CHECKED BY: RRB	DATE: 06-16-05	CHECKED BY: RRB	NO.	DATE: 06-16-05	NO.	DATE: 06-16-05	NO.	DATE: 06-16-05

SCANNED
BY PLN

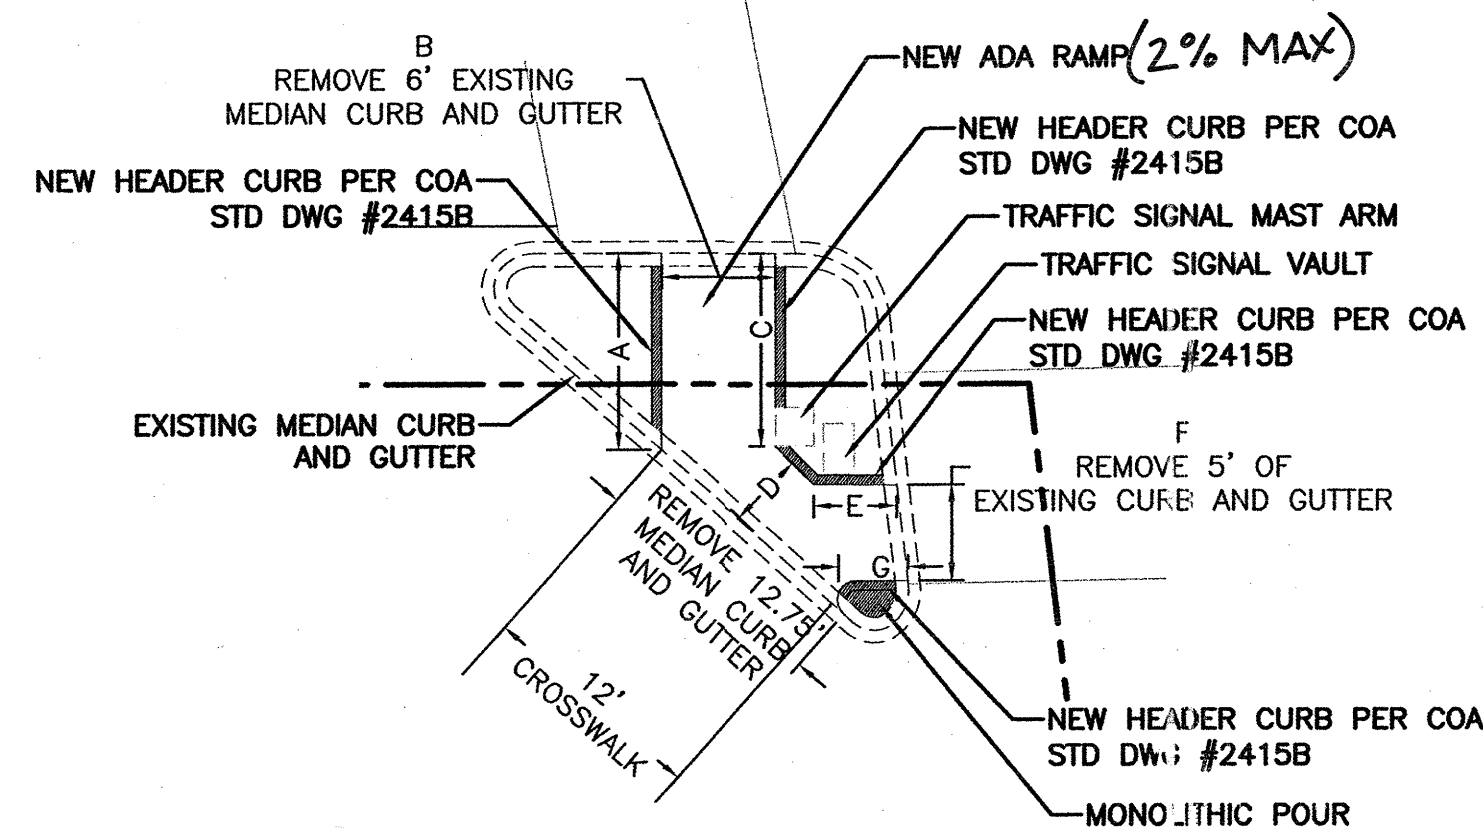

DIMENSION TABLE


LETTER	DISTANCE
A	= 10.2'
B	= 6'
C	= 10'
D	= 4'
E	= 4.3'
F	= 5'
G	= 3.6'

LEGEND

	BOUNDARY LINE
	EASEMENT
	EXISTING CURB AND GUTTER
	PROPOSED CURB
	PROPOSED SCREEN WALL
	PROPOSED SIDEWALK
	EXISTING BOUNDARY
	PROPOSED CROSSWALK
	PROPOSED BIKE RACK


GENERAL NOTE

1. STRIPING ERADICATION SHALL BE ACCOMPLISHED BY WATER BLASTING OR SURFACE PLANING OF THE ROADWAY TO A MINIMUM OF 0.25 INCHES AND A WIDTH TO EQUAL 2 TIMES THE WIDTH OF THE STRIPE OR MARKING TO BE REMOVED.

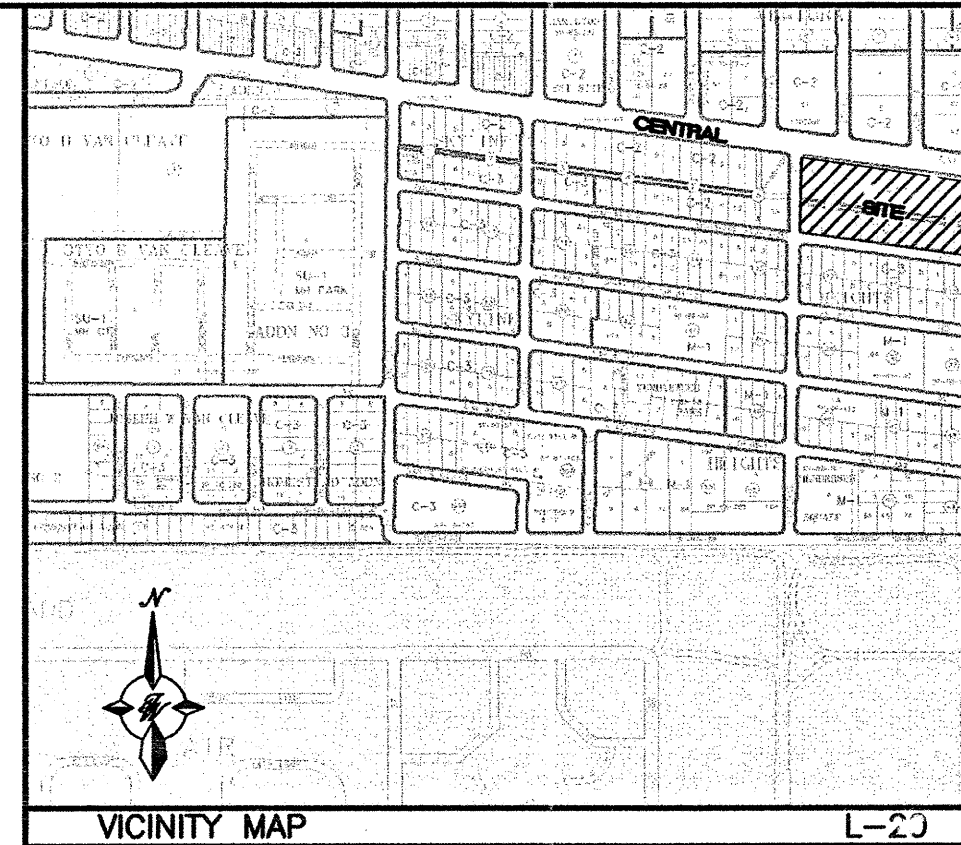

LEGAL DESCRIPTION

LOTS 1-10 BLK 7; LOTS 1-10 BLK 8;
LOTS 1-10 BLK 9; SKYLINE HEIGHTS

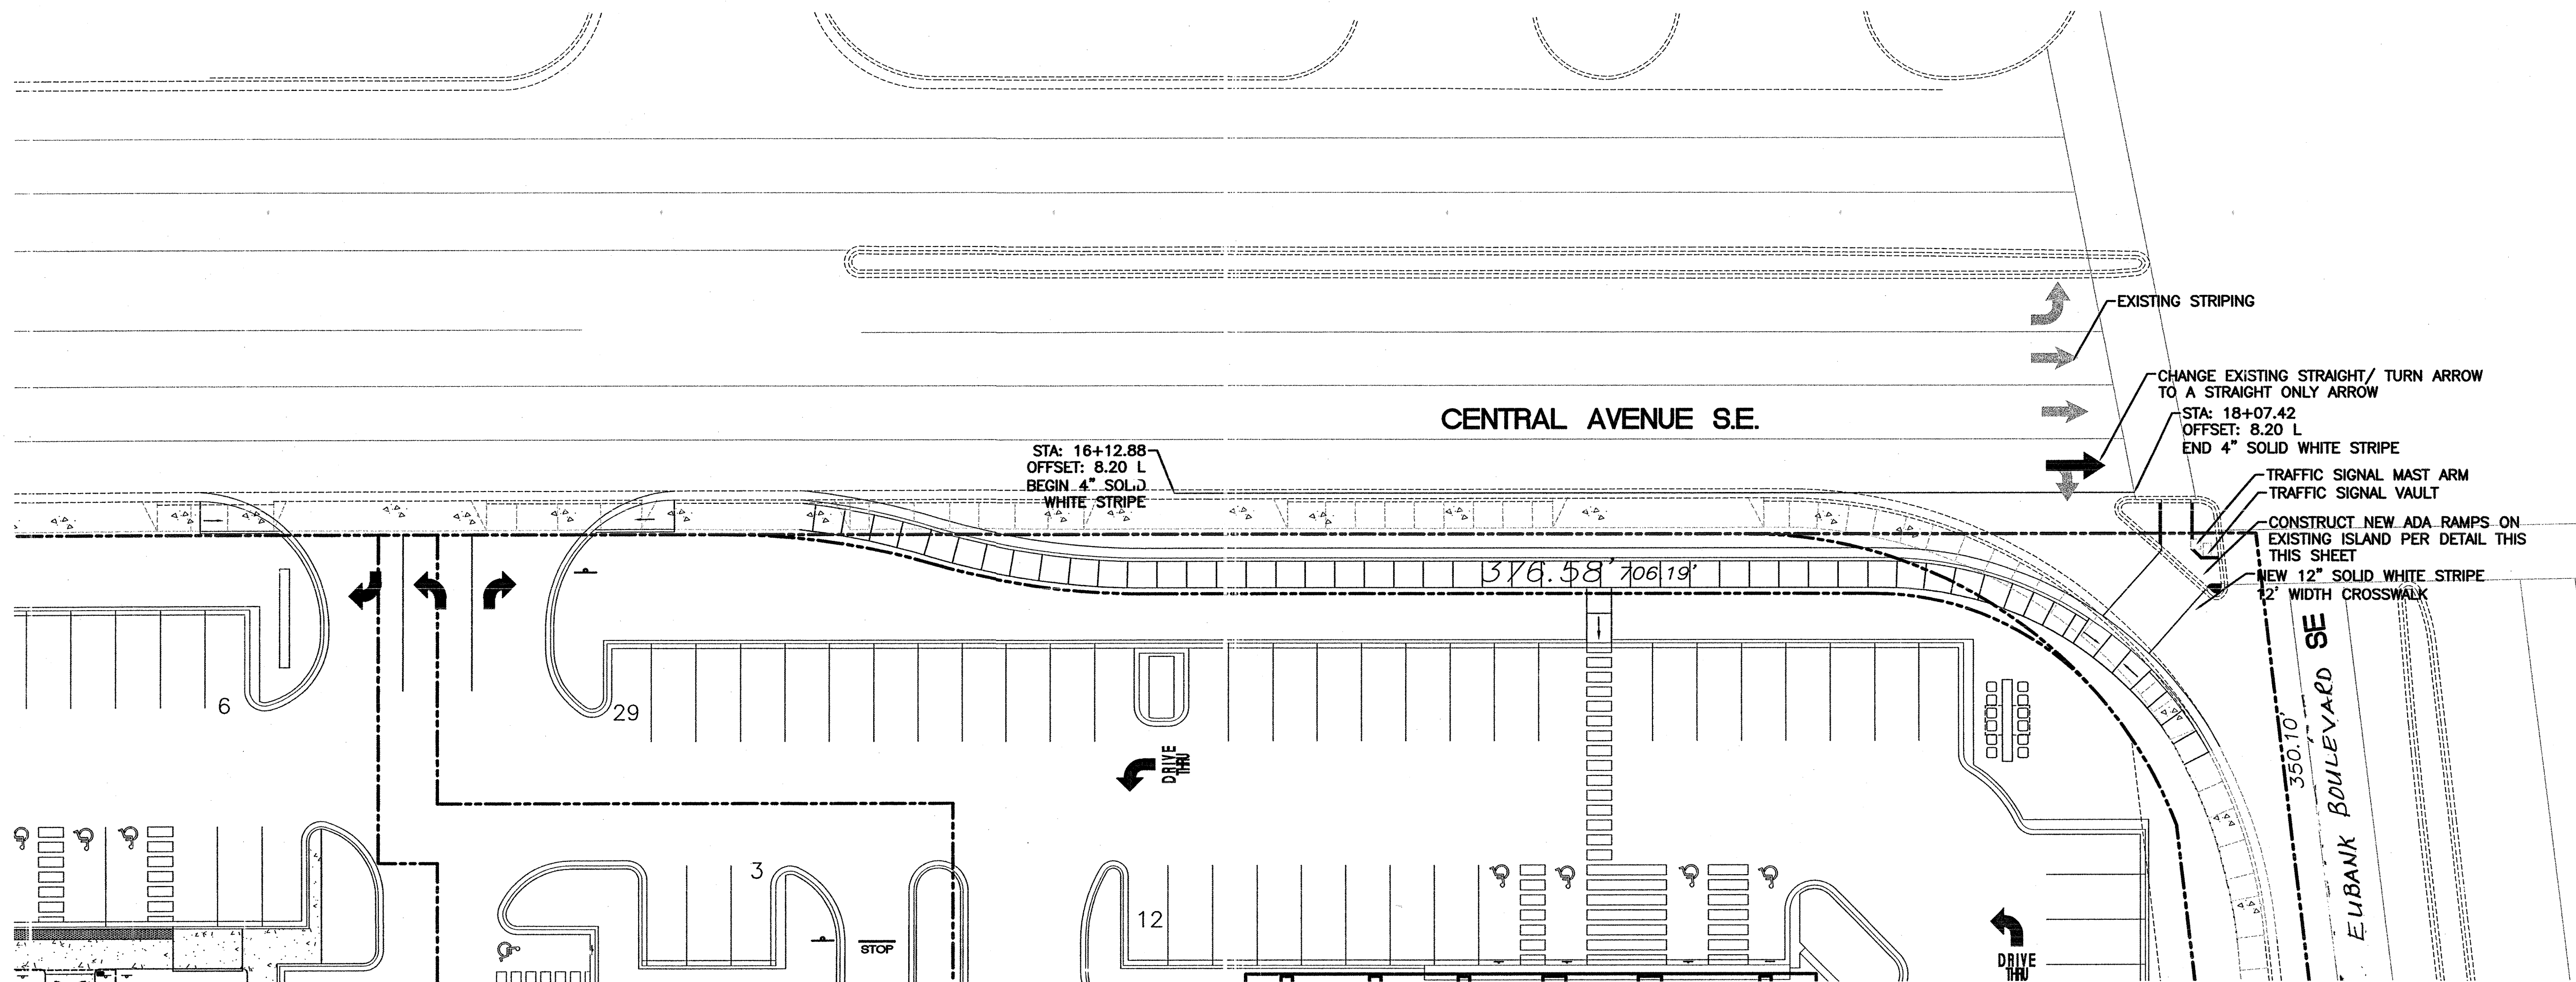


CAUTION:

ALL EXISTING UTILITIES SHOWN WERE OBTAINED FROM RESEARCH, AS-BUILTS, SURVEYS OR INFORMATION PROVIDED BY OTHERS. IT SHALL BE THE SOLE RESPONSIBILITY OF THE CONTRACTOR TO CONDUCT ALL NECESSARY FIELD INVESTIGATIONS PRIOR TO AND INCLUDING ANY EXCAVATION, TO DETERMINE THE ACTUAL LOCATION OF UTILITIES AND OTHER IMPROVEMENTS, PRIOR TO STARTING THE WORK. ANY CHANGES FROM THIS PLAN SHALL BE COORDINATED WITH AND APPROVED BY THE ENGINEER.

TIERRA WEST, LLC
8509 JEFFERSON NE
ALBUQUERQUE, NEW MEXICO 87113
(505)858-3100

CITY OF ALBUQUERQUE
PUBLIC WORKS DEPARTMENT
ENGINEERING GROUP

TITLE: **EUBANK AND CENTRAL
STRIPING PLAN**

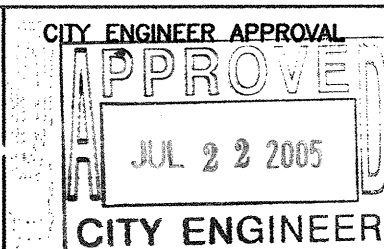

CITY PROJECT NO. **762281**


ZONE MAP NO. **L-20**

SHEET **5** OF **6**

AS BUILT INFORMATION		BENCH MARKS		SURVEY INFORMATION		ENGINEER'S SEAL	
CONTRACTOR	DATE	ALBUQUERQUE CONTROL SURVEY	DATE	NO.	BY	NO.	BY
SALE	DATE	MONUMENT "SUSAN"	DATE				
WORK	DATE	NM STATE PLANE COORDINATES	DATE				
STAKED BY	DATE	CENTRAL ZONE (AND 27) AS PUBLISHED	DATE				
INSPECTOR'S SIGNATURE	DATE	X= 413,805.44 FEET	DATE				
FIELD VERIFICATION BY	DATE	Y= 1,479,969.78 FEET	DATE				
REVISION BY	DATE	G-G= 0.99964807	DATE				
REVISION BY	DATE	Dd= -00'09"56"	DATE				
REVISION BY	DATE	ELEV=5414.48 (SLD 1929)	DATE				



REVISIONS	REMARKS	NO.	DATE	BY
DESIGN				
DESIGNED BY: SA			DATE: 06-16-05	
DRAWN BY: EMT			DATE: 06-16-05	
DRAWN NAME: 2418-STRIPING-05-05.dwg			JOB NO.: 24018	
CHECKED BY: RRB			DATE: 06-16-05	

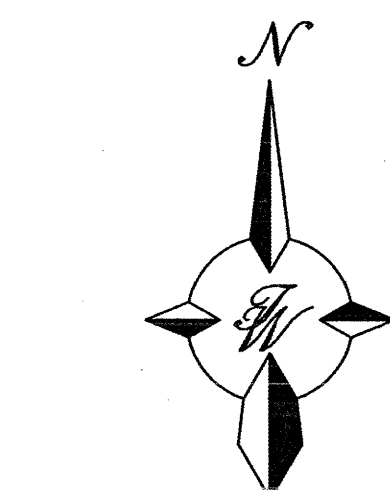


GRAPHIC SCALE

SCALE: 1"=20'


SCANNED
BY PLN

STATIONING STARTS ON NW PROPERTY CORNER AT 10+00

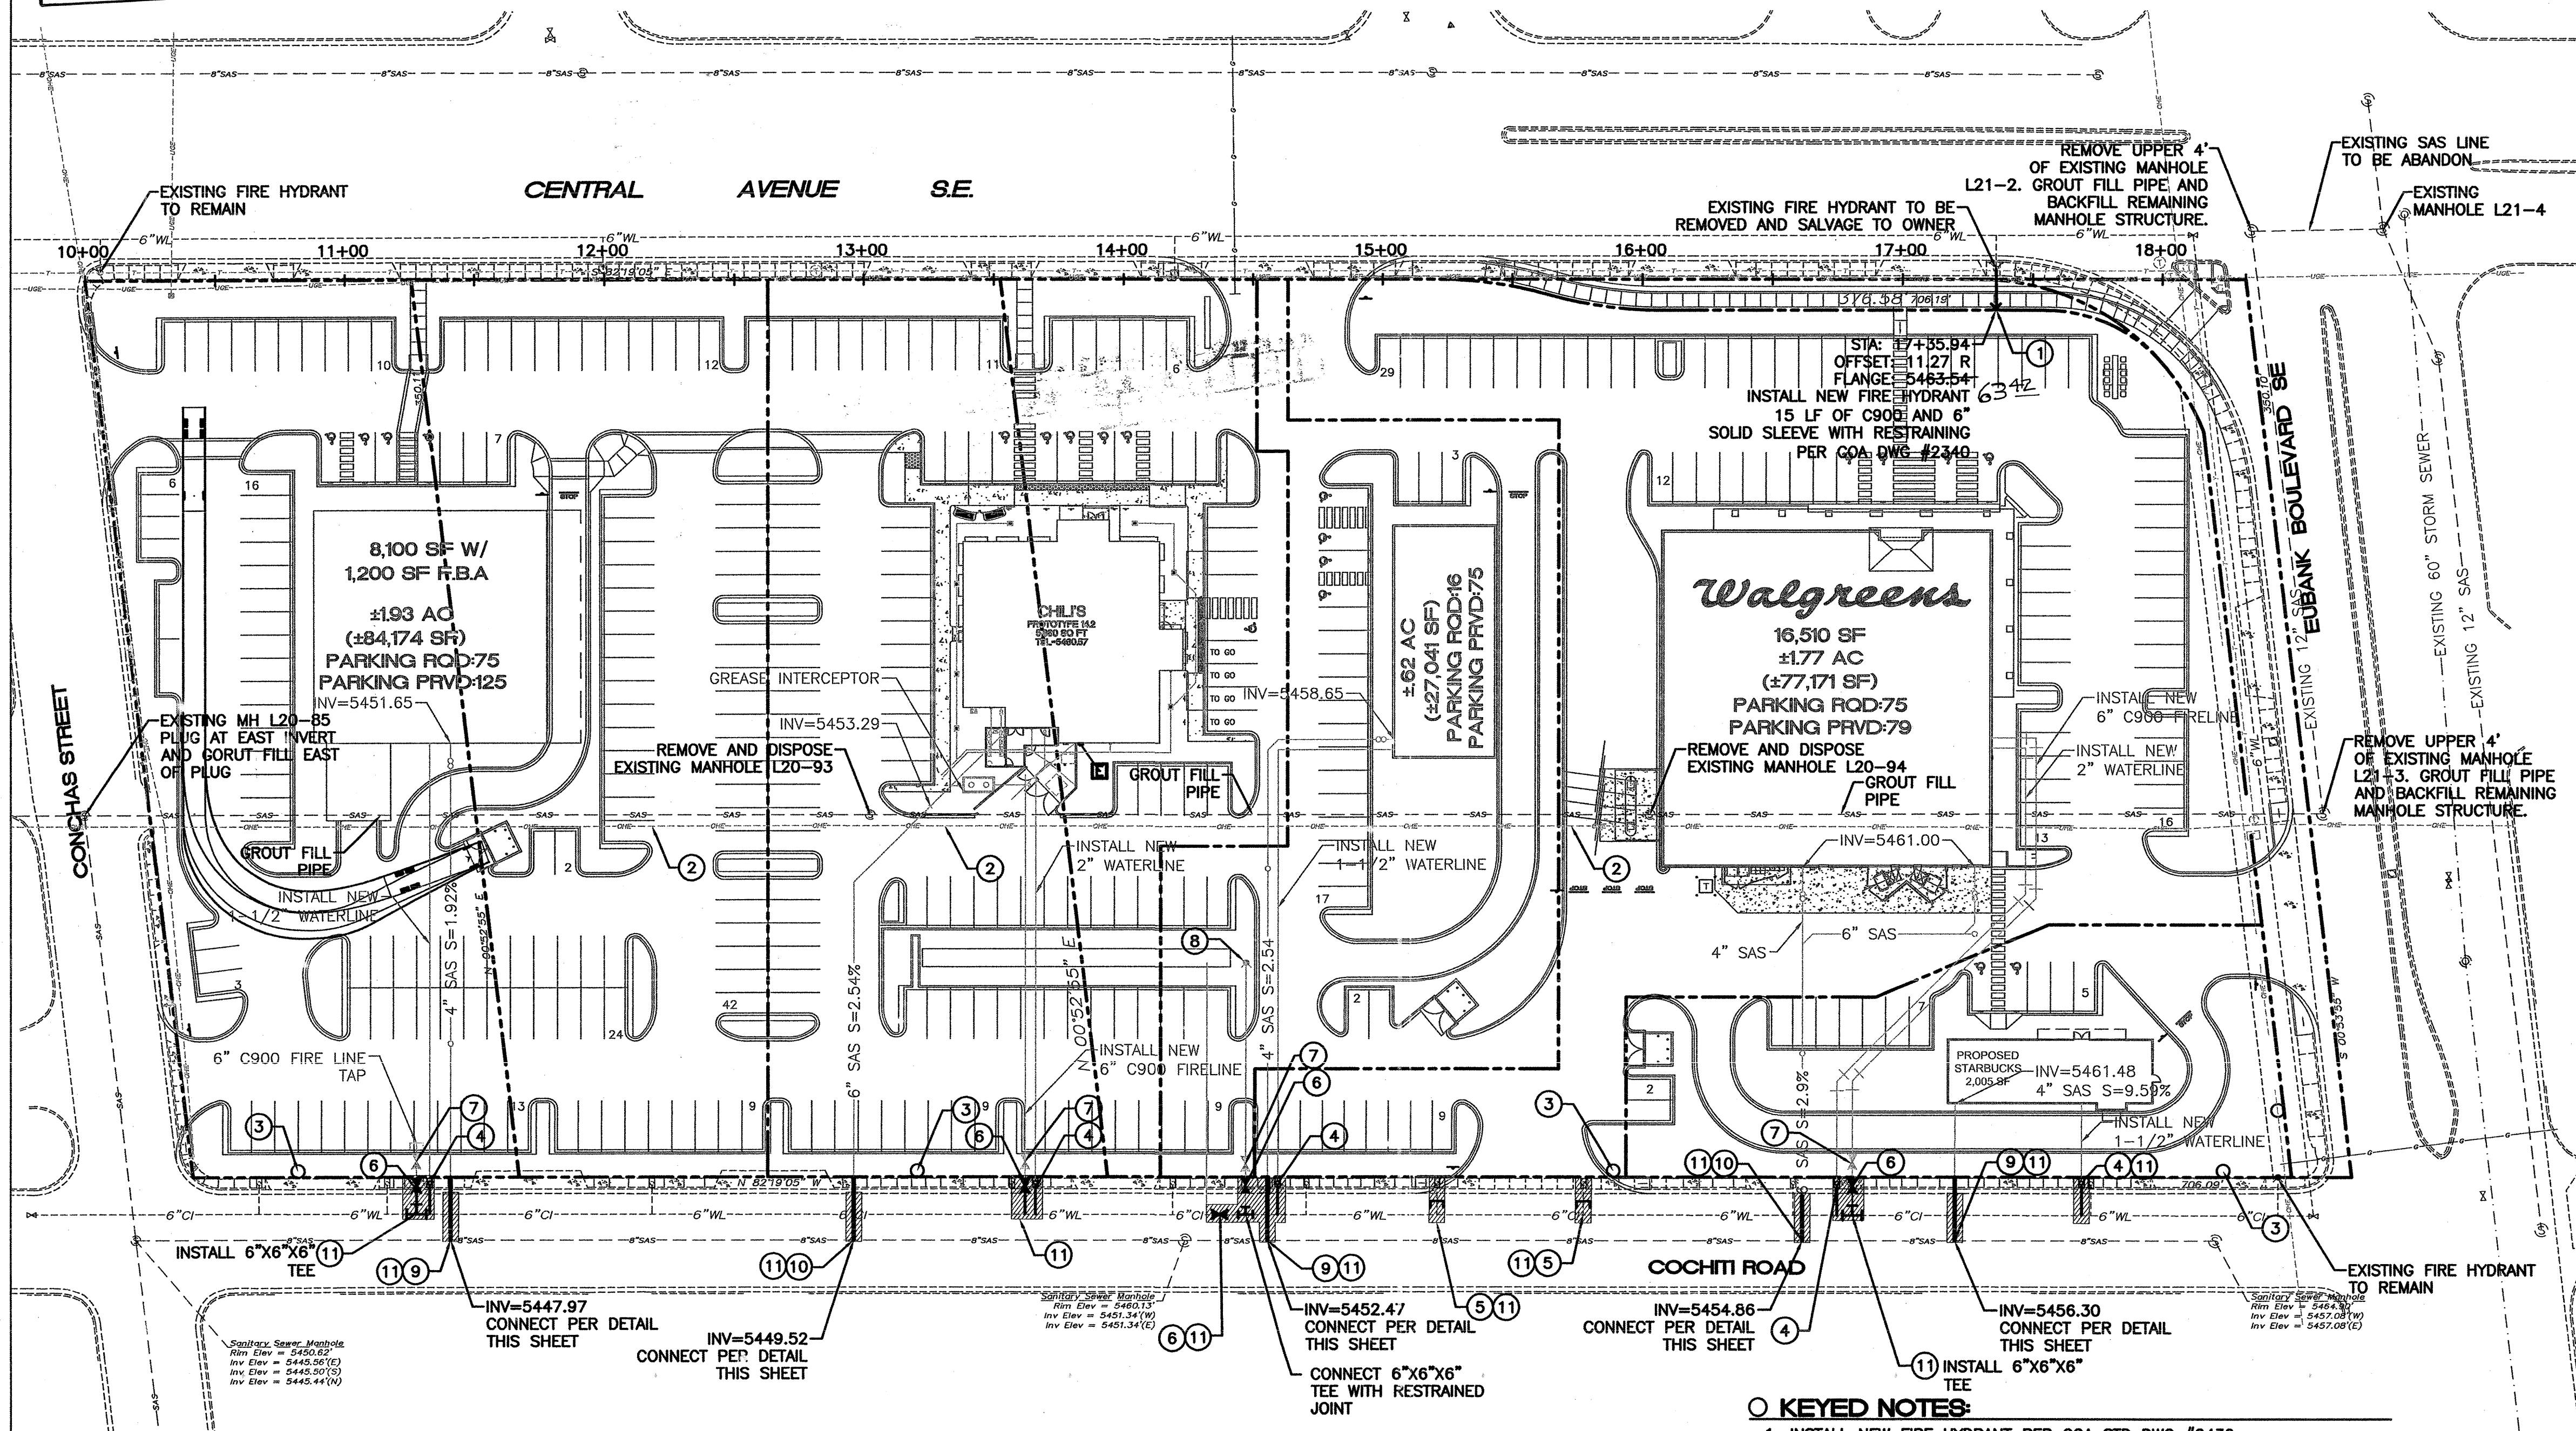

SURVEYORS CERTIFICATION

I, Russ P. Hugg, New Mexico Professional Surveyor Number 9750, Herby Certify that the as-built information shown hereon is the result of an actual field survey performed by me or under my direct supervision and that the same is true and correct to the best of my knowledge and belief.


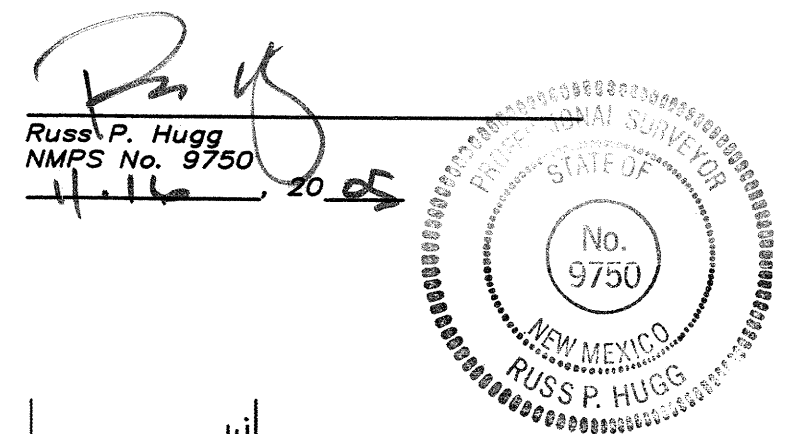


KEYED NOTES:

1. INSTALL NEW FIRE HYDRANT PER COA STD DWG #2430.
2. PNM TO REMOVE AND RELOCATE EXISTING POWER POLES AND CONDUCTORS.
3. RELOCATION OF EXISTING POWER POLES AND CONDUCTORS.
4. INSTALL 1-1/2" METER BOX AND SERVICE LINE PER COA STD DWG #2363.
5. DISPOSE OF EXISTING METER, BOX AND LID. SEVER AND CAP AT MAIN. TYPICAL AT ALL EXISTING WATER SERVICES. REPLACE SIDEWALK TO MATCH EXISTING.
6. PUBLIC 6" GATE VALVE.
7. PRIVATE 6" GATE VALVE TO BE BUILT WITH BUILDING PERMIT.
8. NEW PRIVATE FIRE HYDRANT TO BE BUILT WITH BUILDING PERMIT.
9. 4" SAS SERVICE.
10. 6" SAS SERVICE.
11. REMOVE AND REPLACE ARTERIAL PAVEMENT PER COA STD DWG #2465

GENERAL NOTES:


1. 4" MINIMUM BURY REQUIRED FOR ALL UTILITIES UNLESS OTHERWISE NOTED.
2. REFERENCE ARCHITECTURAL PLANS FOR WATER LINE RISER LOCATIONS.
3. CLEAN OUTS ARE TO BE BUILT PER UNIFORM PLUMBING CODE STANDARDS. CLEAN OUTS TO BE BUILT WITH BUILDING PERMIT.
4. ALL RESTRAINT JOINT IS PER CITY OF ALBUQUERQUE STANDARD DWG. 2340.
5. ALL PLUMBING PIPE MATERIAL TO BE USED PER UPC.
6. FIRE LINE AND DOMESTIC WATERLINE MUST HAVE BACKFLOW PREVENTORS PER UPC. IF BACKFLOW PREVENTOR IS INSTALLED EXTERIOR OF BUILDING A HOT BOX SHALL BE INSTALLED AND USED.
7. REMOVE AND REPLACE EXISTING ARTERIAL PAVING PER COA STD DWG #2465. TYPICAL AT ALL UTILITY CONNECTIONS IN R.O.W.
8. ALL EXCAVATION, TRENCHING AND SHORING ACTIVITIES MUST BE CARRIED-OUT IN ACCORDANCE WITH OSHA 29 CFR 1926.650 SUBPART P.
9. ALL WORK IN ROW TO BE PART OF WORK ORDER.

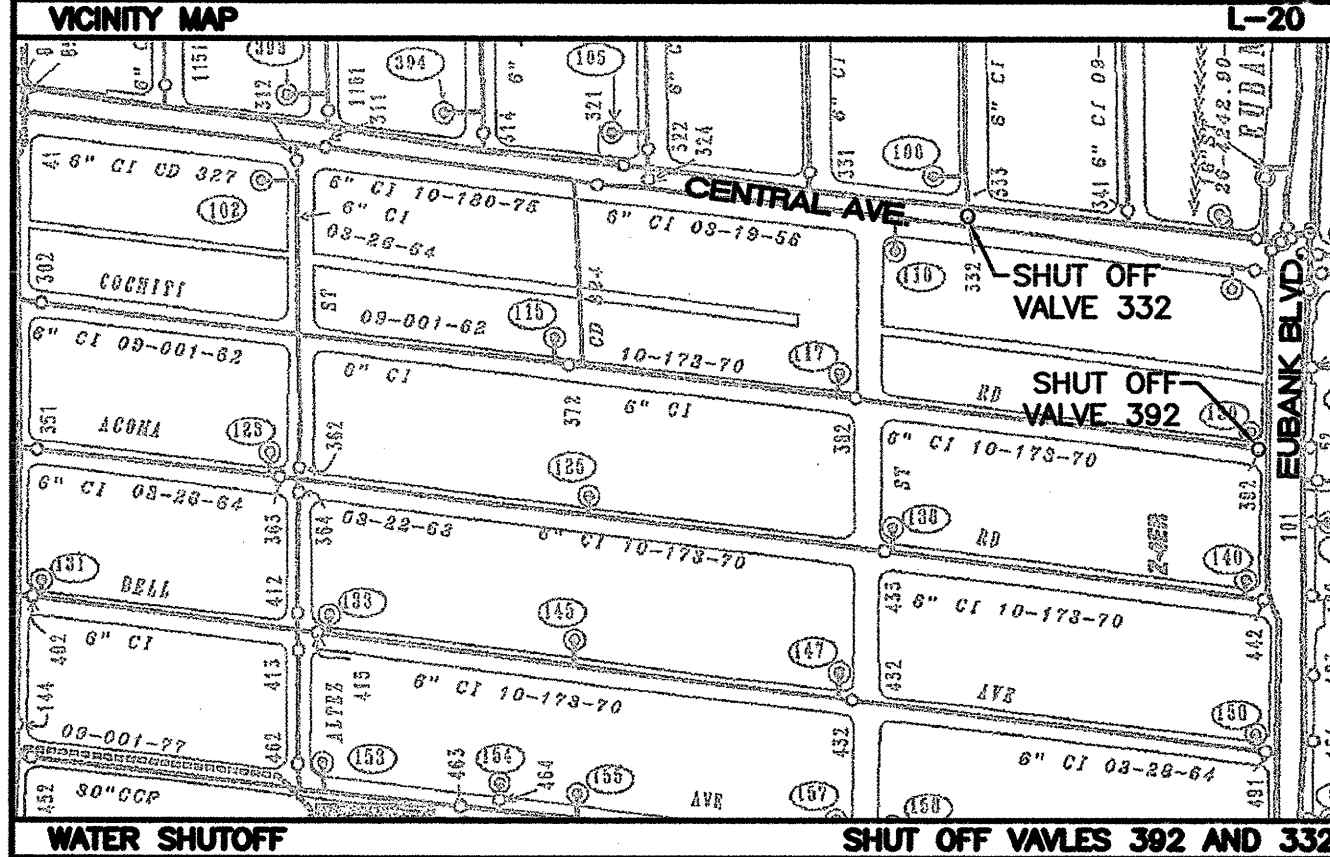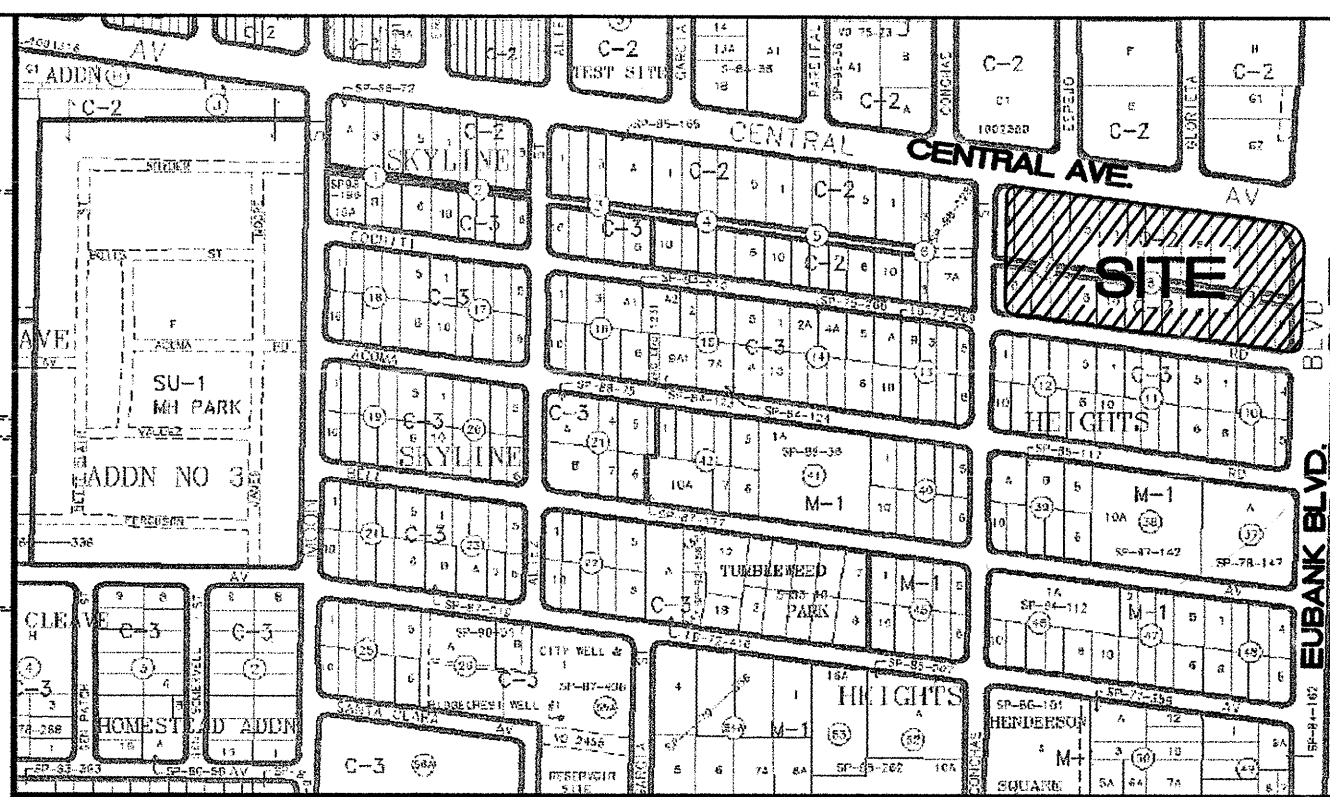


1. ONLY WATER SYSTEMS PERSONNEL ARE AUTHORIZED TO OPERATE VALVES.
2. NOTIFY CITY OF ALBUQUERQUE, WATER SYSTEMS DIVISION (PHONE 857-8200) SEVEN (7) WORKING DAYS IN ADVANCE OF NEEDING EXECUTION OF THE WATER SHUT OFF PLAN
3. APPROXIMATE SHUT OFF TIME WILL BE 24 HOURS.
4. SHUTOFF THE VALVES INDICATED IN THE PLAN ABOVE.

LEGEND

○	EXISTING SAS MANHOLE
---	EXISTING SANITARY SEWER LINE
---	PROPOSED SANITARY SEWER LINE
⊗	EXISTING METER
⊗	EXISTING VALVE W/BOX
⊗	EXISTING FIRE HYDRANT
---	EXISTING WATER LINE
⊗	PROPOSED METER
⊗	PROPOSED VALVE W/BOX
⊗	PROPOSED FIRE HYDRANT
---	PROPOSED WATER LINE
⊗	EXISTING STORM SEWER MANHOLE
---	EXISTING STORM SEWER INLET
---	EXISTING STORM SEWER LINE
---	PROPOSED STORM SEWER LINE
---	EXISTING CURB & GUTTER
---	PROPOSED CURB & GUTTER
---	BOUNDARY LINE
---	EASEMENT
---	PROPOSED SIDEWALK
---	EXISTING SIDEWALK
---	LANE
---	STRIPING

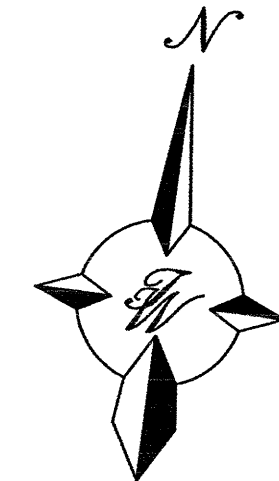

GRAPHIC SCALE

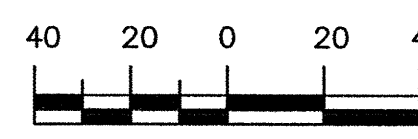

CAUTION:



EXISTING UTILITIES ARE NOT SHOWN. IT SHALL BE THE SOLE RESPONSIBILITY OF THE CONTRACTOR TO CONDUCT ALL NECESSARY FIELD INVESTIGATIONS PRIOR TO ANY EXCAVATION TO DETERMINE THE ACTUAL LOCATION OF UTILITIES & OTHER IMPROVEMENTS.

AS BUILT INFORMATION		BENCH MARKS		SURVEY INFORMATION		ENGINEER'S SEAL	
CONTRACTOR	SALLS Bros.	ALBUQUERQUE CONTROL SURVEY	MONUMENT "SUSAN"	FIELD NOTES	NO.	DATE	BY
WORK	STAKED BY SURV TEK	INSPECTOR'S	NM STATE PLANE COORDINATES	NO.	DATE	BY	REMARKS
DATE	09/10/05	FIELD	CENTRAL ZONE (NAD 83) AS PUBLISHED	NO.	DATE	BY	REVISIONS
DATE	11/11/05	VERIFICATION	X= 413,804.44 FEET	NO.	DATE	BY	DESIGN
DATE	11/09/05	CORRECTION	Y= 1,479,969.78 FEET	NO.	DATE	BY	DESIGNED BY: SA
DATE	11/09/05	MICRO-FILM INFORMATION	G-0= 0.99964807	NO.	DATE	BY	DRAWN BY: EMT
DATE	11/09/05	RECORDED BY	Do= -00'09" 56"	NO.	DATE	BY	DRAWN NAME: 2418-MUC-03-21-05
DATE	11/09/05	NO.	ELEV=5444.49 (SLD 1929)	NO.	DATE	BY	CHECKED BY: RRB

TERRA WEST, LLC 8509 JEFFERSON NE ALBUQUERQUE, NEW MEXICO 87113 (505)858-3100	
CITY OF ALBUQUERQUE PUBLIC WORKS DEPARTMENT ENGINEERING GROUP	
TITLE: EUBANK AND CENTRAL MASTER UTILITY PLAN	
DESIGN REVIEW COMMITTEE APPROVE JUL 13 2005 DESIGN REVIEW COMMITTEE	CITY ENGINEER APPROVAL APPROVE JUL 22 2005 CITY ENGINEER
CITY PROJECT NO. 762281	ZONE MAP NO. L-20
SHEET 6	OF 6

DATE: _____ APPROVED BY: _____
FIRE MARSHALL REVIEW

PLANS CHECKING OFFICE
224-3611
APPROVED/DISAPPROVED
HYDRANT(S) ONLY
FMO 6-21-05
SIGNATURE & DATE

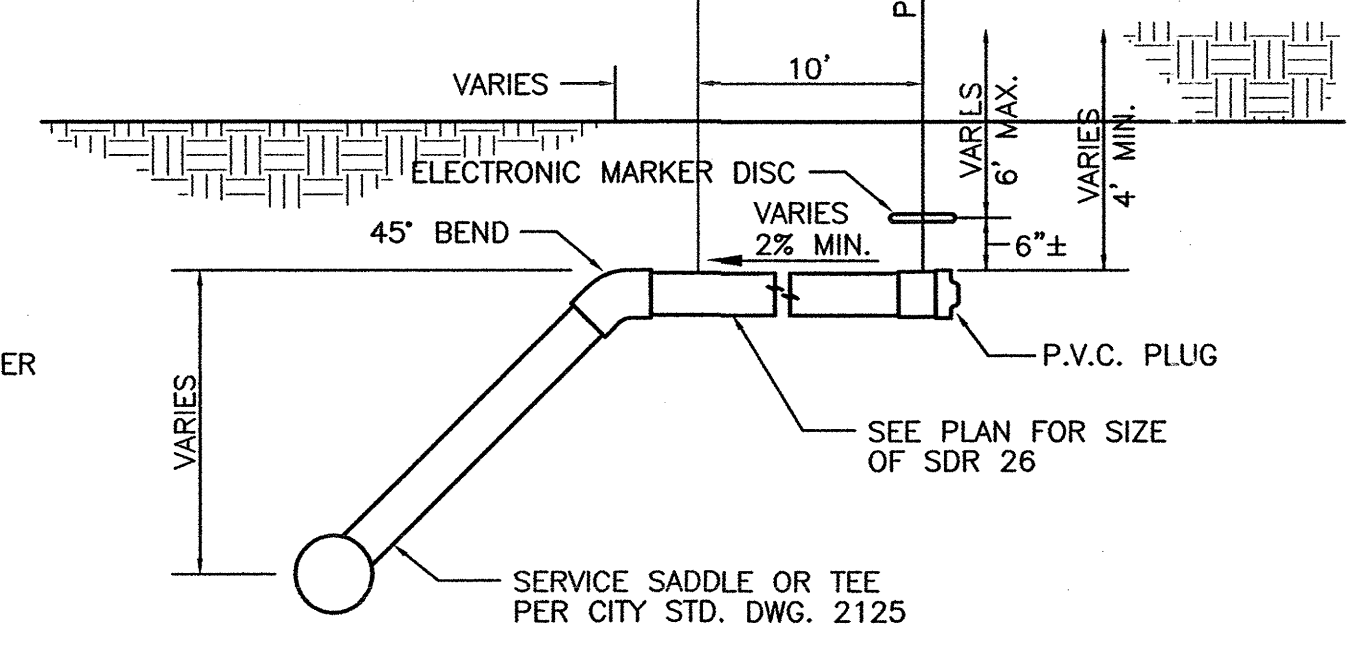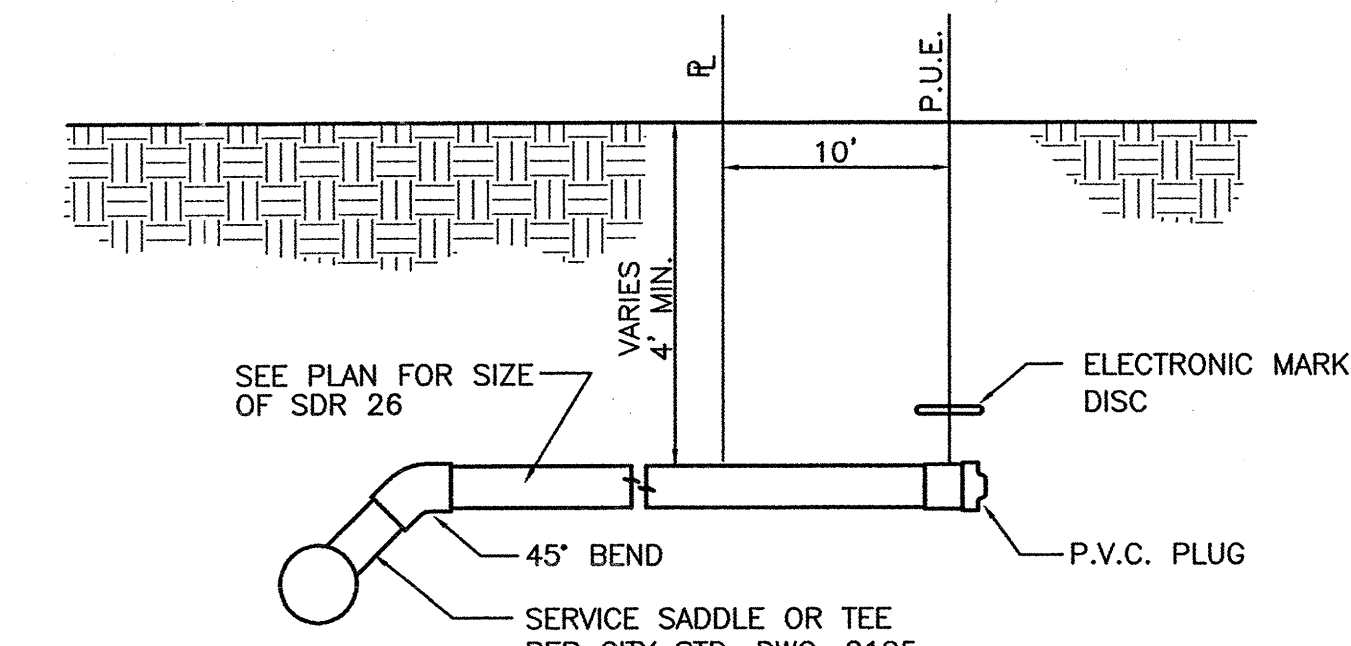

TYP. SANITARY SYSTEM
SERVICE CONNECTION
NTS

TYP. SANITARY SYSTEM
SERVICE CONNECTION
FOR DEEP SANITARY SEWERS
NTS