


765081

CITY OF ALBUQUERQUE
PRIVATE FIRE LINE INSTALLATION



VICINITY MAP


LEGAL DESCRIPTION OF PROPERTY AND ADDRESS:
Emerald Office Building
1121 4th Street N.W.
Lots 13 THRU 24, BLOCK 6 ROMERO ADDITION

NOTICE TO CONTRACTORS

1. An excavation/barricade permit will be required before beginning any work within City, County, or Village right-of-way. An approved copy of these plans must be submitted at the time of application for these permits.
2. All work detailed on these plans to be done, except as otherwise stated or provided hereon, will be constructed in accordance with "City of Albuquerque Interim Standard Specification for Public Works Construction, 1986," latest revision.
3. Two working days prior to any excavation, the contractor must contact New Mexico One Call System, Inc., 260-1990, for location of existing utilities.
4. Prior to construction, the contractor will excavate and verify the horizontal and vertical locations of all construction. Should a conflict exist, the contractor will notify the Construction Engineer so that the conflict can be resolved with a minimum amount of delay.
5. The contractor will be responsible for coordinating the water shutoff with the Water Division seven (7) working days prior to construction.
6. The contractor will be responsible for performing soil density tests as required by the City of Albuquerque.

APPROVALS FOR	NAME	DATE	TITLE OF PROJECT
DESIGN UTILITY DEVELOPMENT	William J. Bald	3/14/07	Emerald Office Private Fire Line Owner: Terry Corliss 821-5600 Contact: Terry Corliss 821-5600 Drawn By: TLC Plumbing & Utility (761-9696) Constructed By: TLC Plumbing & Utility Contact: Tom Kryfko 269-4157
CONSTRUCTION CONSTRUCTION ENGINEER	August W. ...	5/24/07	
ACCEPTANCE CONSTRUCTION INSPECTOR	June Cal...	5/24/07	PROJECT NO. 765081 SHEET 1 OF 3 ZONE ATLAS J-14 hydrant1.dwg


CITY OF ALBUQUERQUE
PRIVATE FIRE LINE INSTALLATION
SITE DETAIL

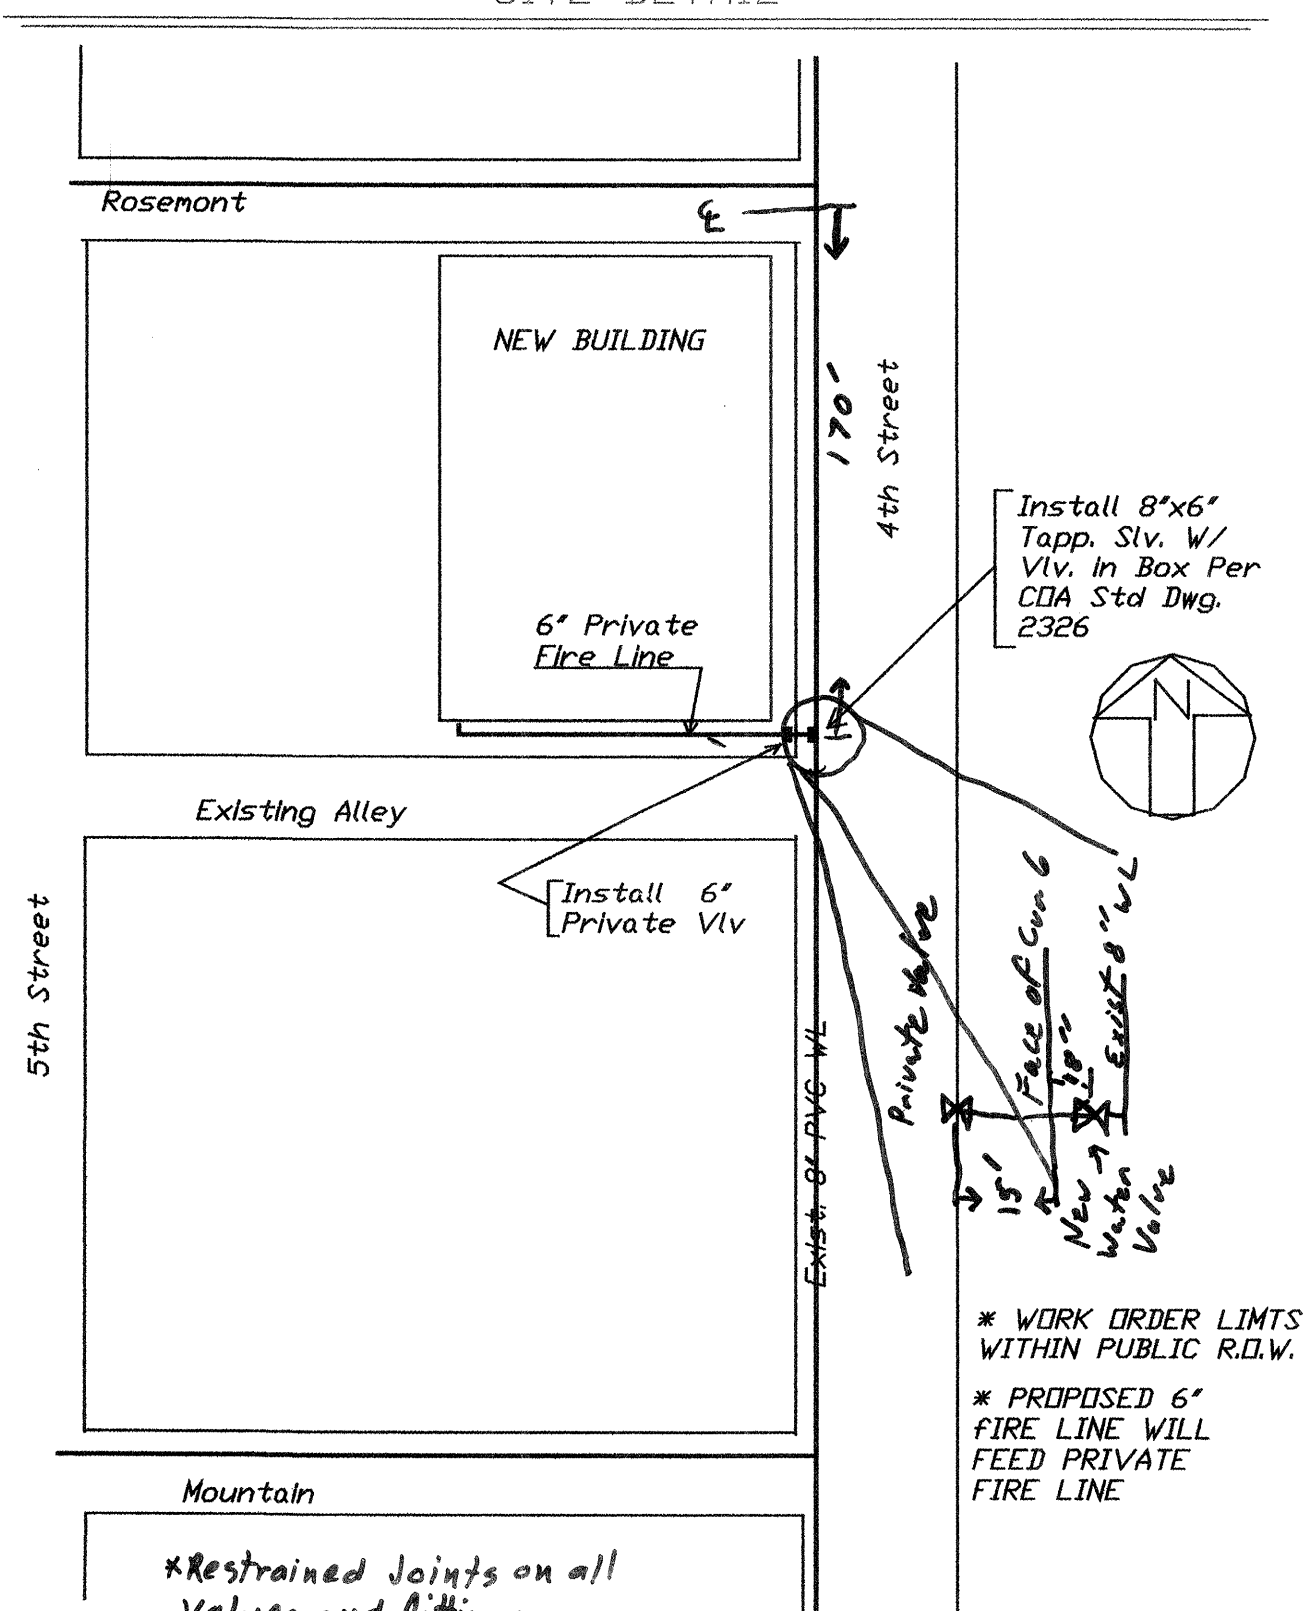

NEW BUILDING
6" Private Fire Line
Existing Alley
Mountain
5th Street
4th Street
Rosenmont
Install 8"x6" Tapp. Slv. W/ Viv. in Box Per CDA Std Dwg. 2326
Install 6" Private Viv
Private Valve
Face of Curb
New Valve
Existing Valve
* WORK ORDER LIMITS WITHIN PUBLIC R.O.W.
* PROPOSED 6" FIRE LINE WILL FEED PRIVATE FIRE LINE
* Restrained Joints on all Valves and Fittings.

PROJECT NO. 765081
SHEET 2 OF 3
ZONE ATLAS
J-14
TITLE:
Emerald Office Private Fire Line
hydrant2.dwg


CITY OF ALBUQUERQUE
PRIVATE FIRE LINE INSTALLATION
WATER SHUT OFF PLAN

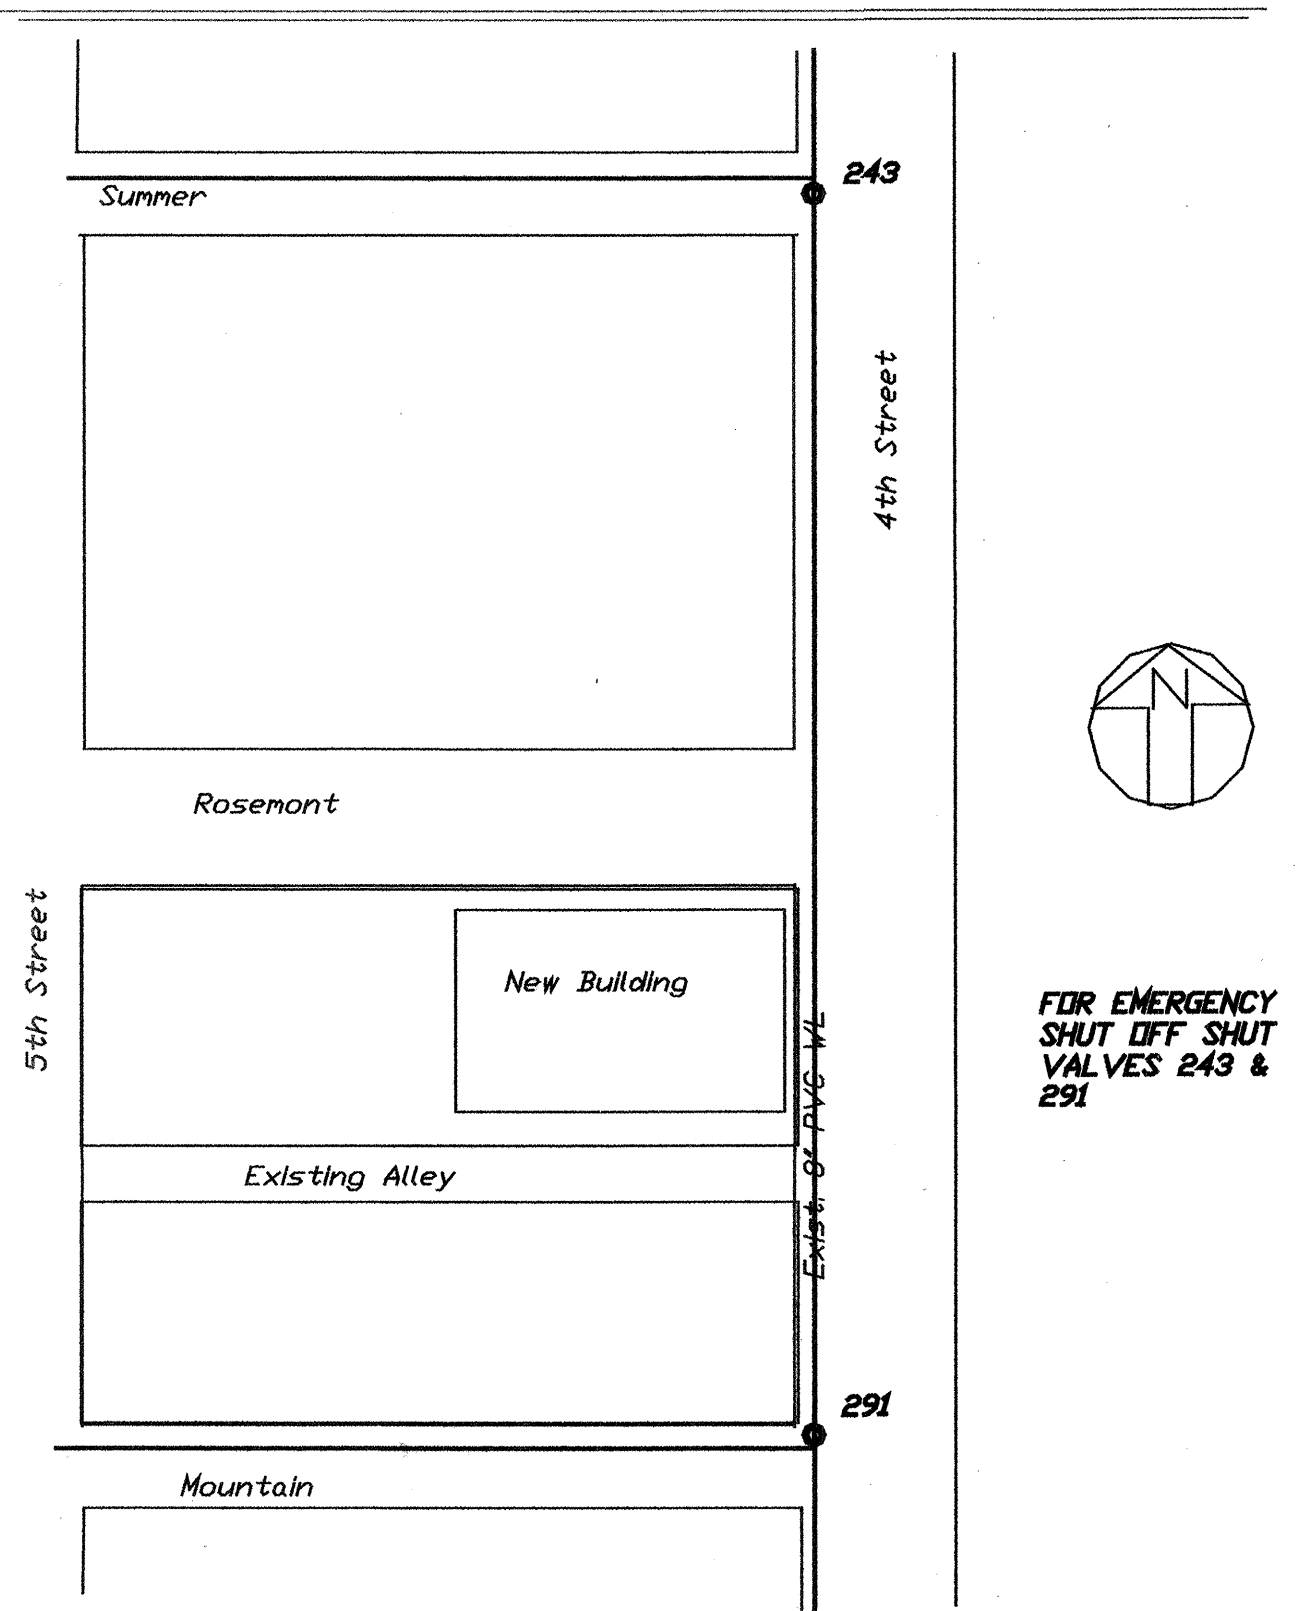

NEW BUILDING
Existing Alley
Mountain
5th Street
4th Street
Rosenmont
Summer
249
291
FOR EMERGENCY SHUT OFF SHUT VALVES 249 & 291

PROJECT NO. 765081
SHEET 3 OF 3
ZONE ATLAS
J-14
TITLE:
Emerald Office Private Fire Line
hydrant2.dwg


CITY OF ALBUQUERQUE
PUBLIC FIRE HYDRANT INSTALLATION
STANDARD DRAWING 2347-A

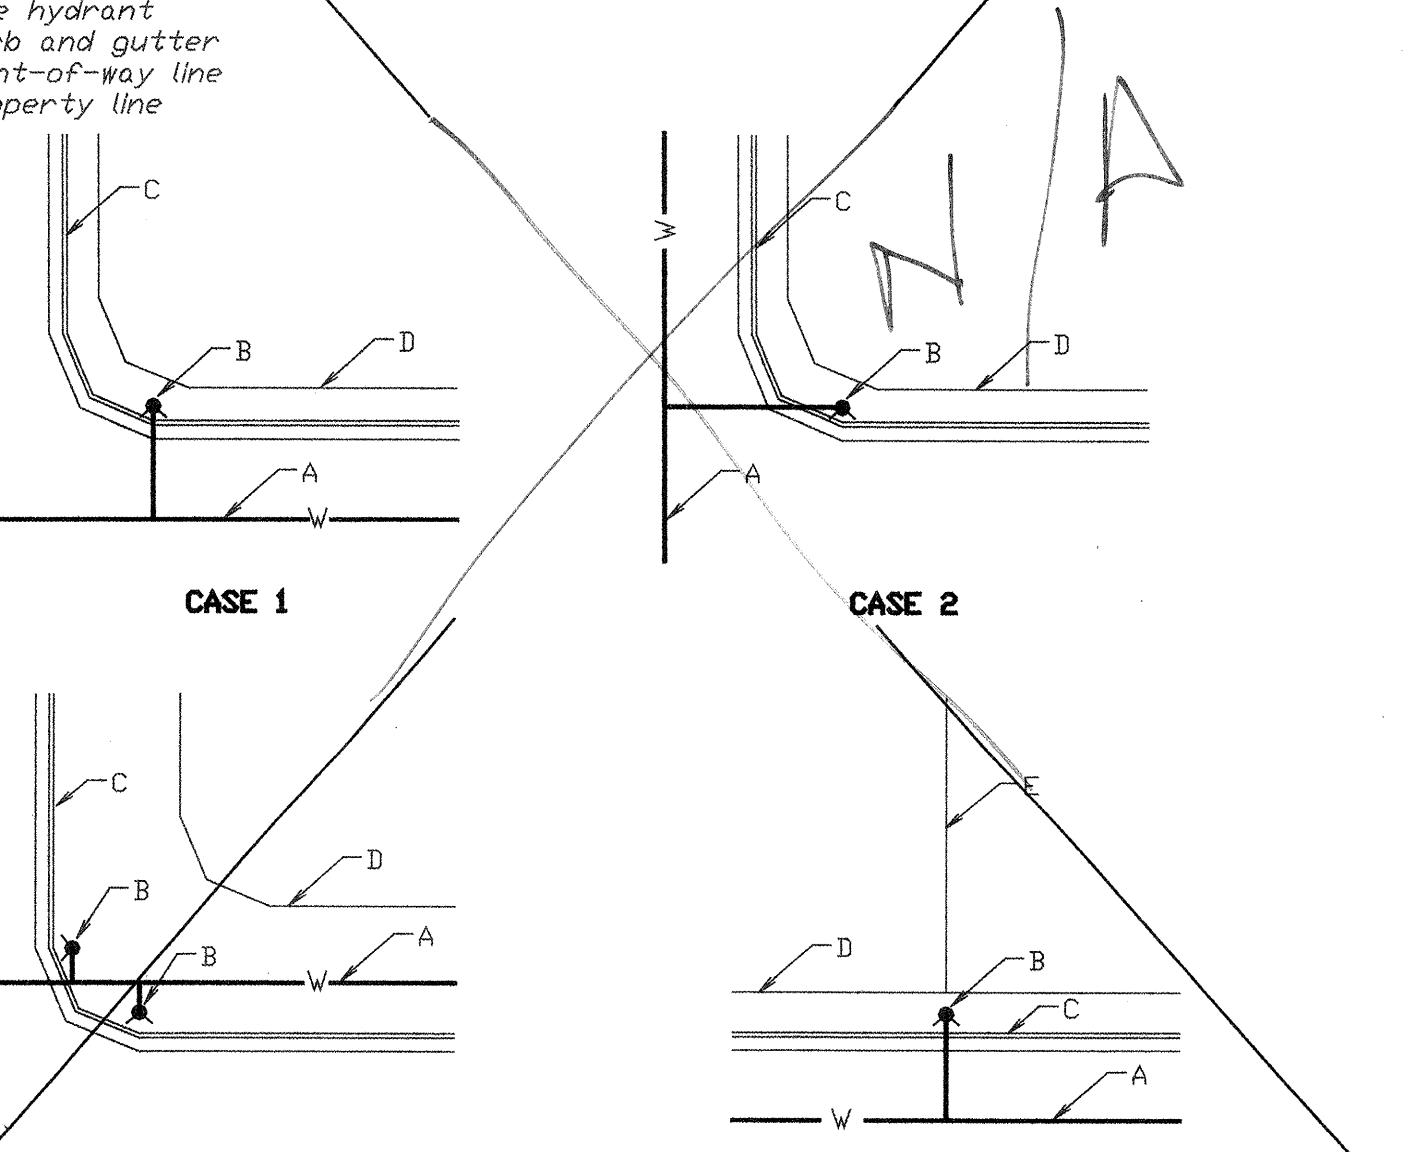

TYPICAL LOCATIONS

PROJECT NO. 765081
SHEET 1 OF 3
ZONE ATLAS
J-14
TITLE:
Emerald Office Private Fire Line
hydrant4.dwg

CITY OF ALBUQUERQUE
PUBLIC FIRE HYDRANT INSTALLATION
STANDARD DRAWING 2340-A

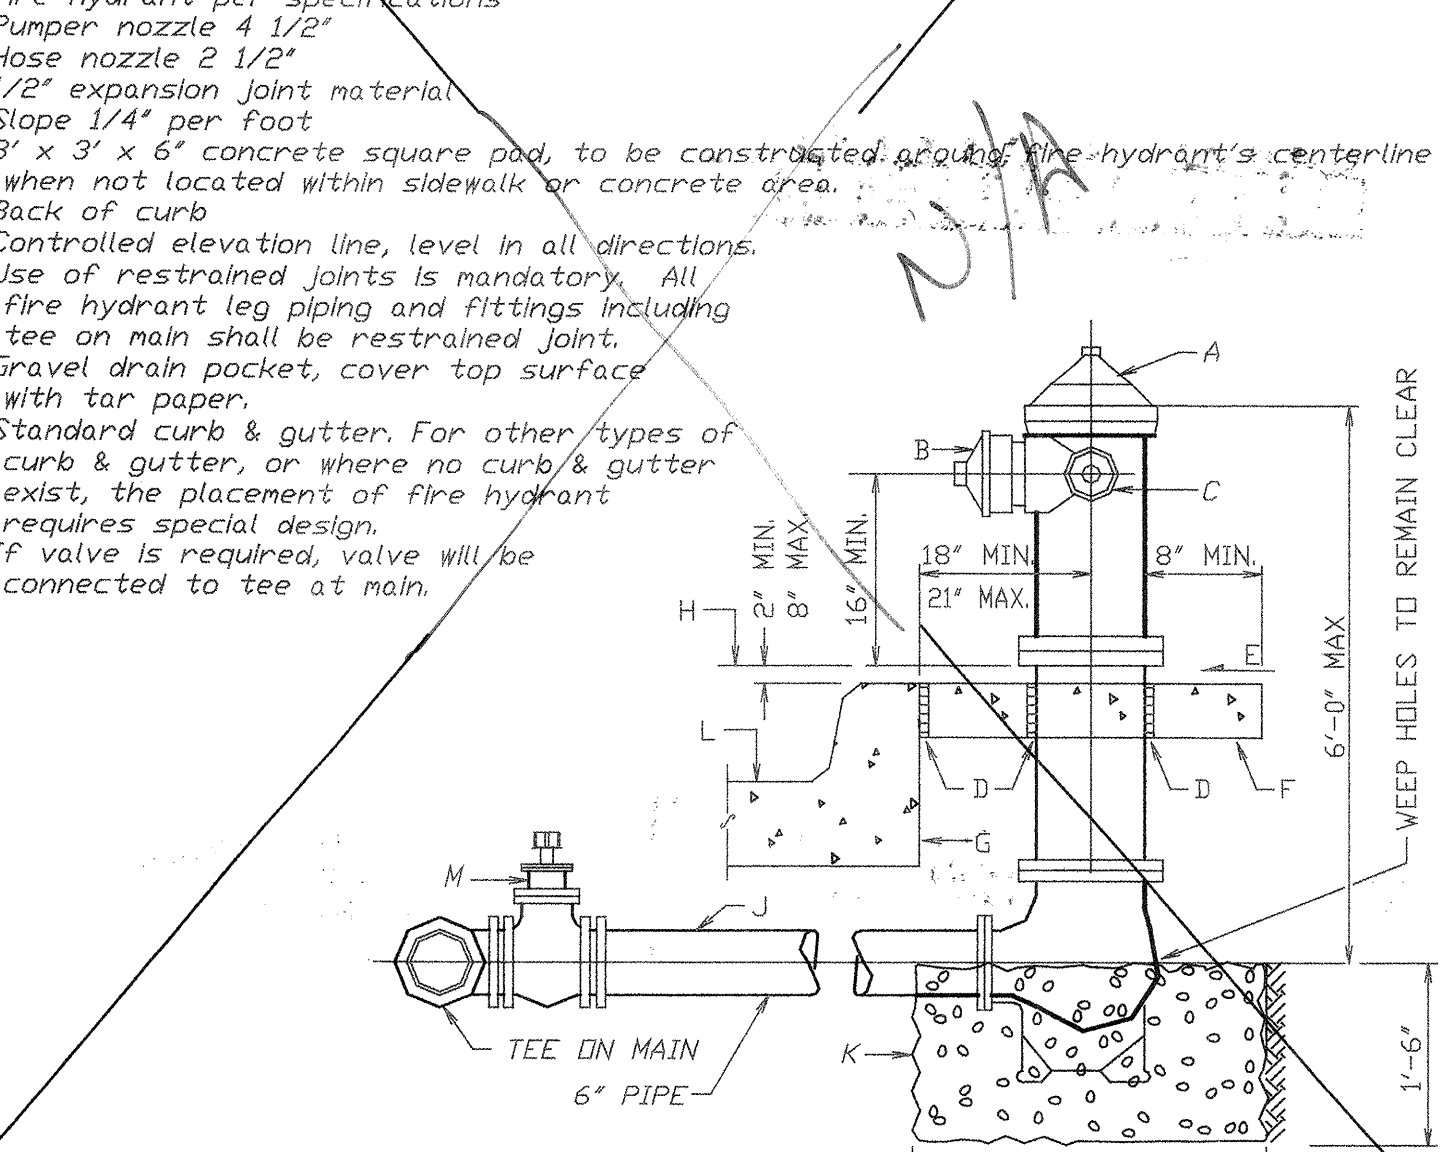

DETAIL OF FIRE HYDRANT SETTING

PROJECT NO. 765081
SHEET 2 OF 3
ZONE ATLAS
J-14
TITLE:
Emerald Office Private Fire Line
hydrant3.dwg

SCANNED BY
PLANNING

26-7650-81-071

APPROVED AS RECORD DRAWINGS
DESIGN REVIEW SECTION
CITY CONSTRUCTION ENGINEER
August W. ...
DATE: 5-24-07