

2400 MARIE PARK DR. NE
ALBUQUERQUE, NM

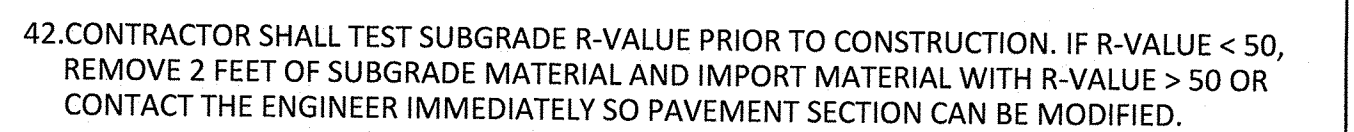
PREPARED FOR
JASON BUCHANAN
ALBUQUERQUE, NM

INDEX TO DRAWINGS

CERTIFICATE OF SUBSTANTIAL COMPLIANCE ON RECORD DRAWINGS

SCOTT M. MCGEE
NEW MEXICO
10519
PROFESSIONAL ENGINEER
9-18-17

RECORD DRAWING

[illegible]

