


SCANNED BY PLANNING

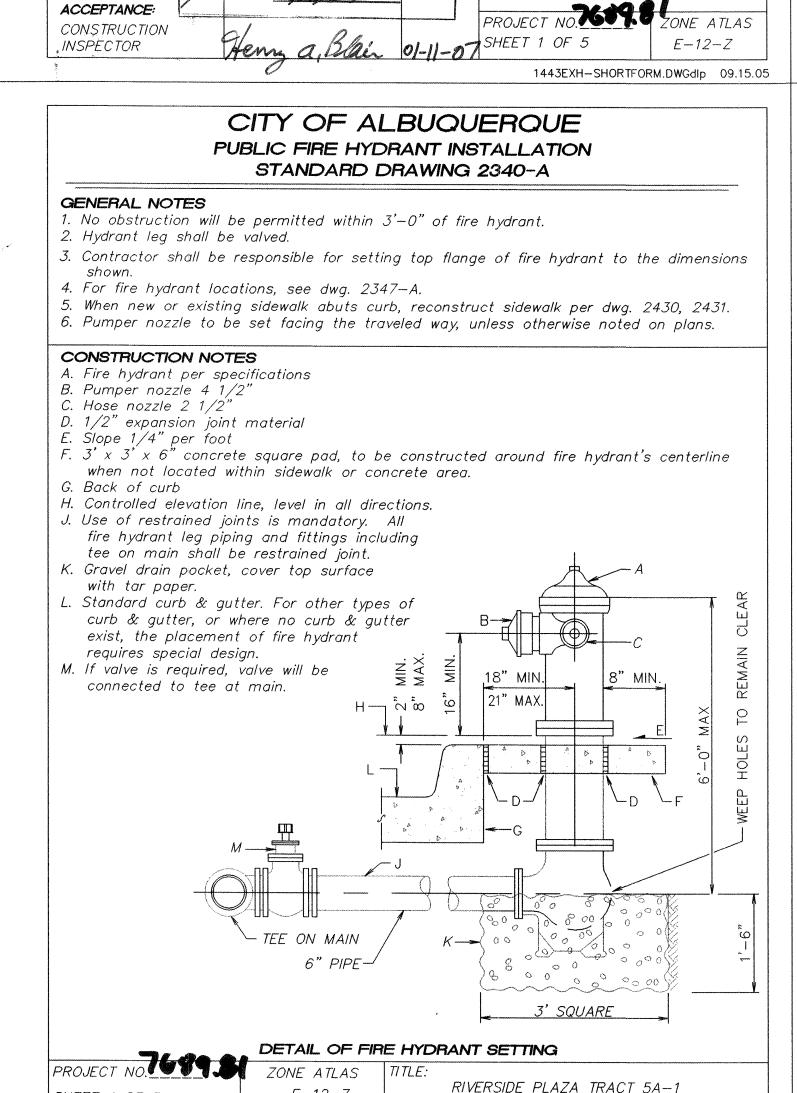

E - 12 - Z

1443EXH-SHORTFORM.DWGdlp 09.15.05

SHEET 4 OF 5

