[illegible]

MATCHLINE C

MATCHLINE D

MATCHLINE E

MATCHLINE D

UNSER BLVD

UNSER BLVD

OLD OURAY RD

EXISTING HOTBOX AND 4
CONCRETE BOLLARDS TO
REMAIN

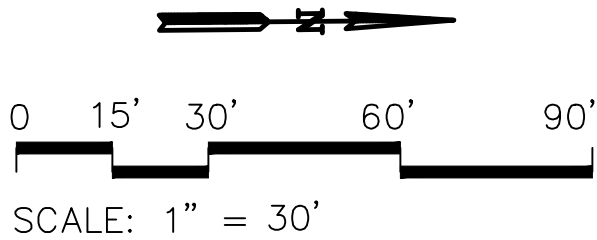
EXISTING ARROYO VENT
AND ASSOCIATED
EQUIPMENT TO REMAIN



EXISTING ISOLATION VALVE
IN VALVE BOX
INSTALL 2" METER AT
EXISTING METER YOLK IN
EXISTING METER BOX
EXISTING 2" COPPER
SERVICE LINE

FULL BOX FOR ELECTRICAL
SERVICE WIRE (TYP.)

FULL BOX FOR ELECTRICAL
SERVICE WIRE (TYP.)

AS-BUILT
9/28/2013



 <div>5604 Wilshire Ave NE Albuquerque, NM 87113 (505)822-8722</div>	
<div><div>CITY OF ALBUQUERQUE CAPITAL IMPLEMENTATION PROGRAM DEPARTMENT OF MUNICIPAL DEVELOPMENT</div></div>	
PROTOTYPE MEDIAN AND INTERSTATE LANDSCAPES FY-13B UNSER BLVD: LADERA DR. TO OURAY RD. (WORK ORDER #2) IRRIGATION PLAN-ASBUILT	
Design Review Committee	City Engineer Approval
Last Design Update	
City Project No. 770102	
Zone Map No. H9,G9	
Sheet 7 OF 8	

REVISIONS	
NO.	DATE

REMARKS	
NO.	DATE

DESIGNED BY	
ML	DATE
	06/18/13

DRAWN BY	
ML	DATE
	06/18/13

CHECKED BY	
LS	DATE
	06/18/13

SURVEY INFORMATION	
FIELD NOTES	DATE
NO.	BY

ARCHITECTURAL SEAL	

BENCH MARKS	

AS-BUILT INFORMATION	
CONTRACTOR	LEE LANDSCAPES, INC.
WORKED BY	
INSPECTED BY	
ACCEPTANCE BY	
DATE	
DATE	
DRAWINGS BY ML	
DATE 9/28/13	
MICRO-FILM INFORMATION	
RECORDED BY	
NO.	

