




PRESSURE COMPENSATING BUBBLER ASSEMBLIES, RAIN BIRD 1400 SERIES,
AS FOLLOWS: INSTALL PER C.O.A. DRAWING NUMBERS 2710, 2711, 2711-A AND 2712.

	MODEL NO.	GPM	PSI
■	1401	25	30
●	1402	50	30
▲	1404	10	30

A B IRRINET M AC 12 STATION CONTROLLER

A graphic scale bar is shown below the plan view, with markings for 0, 15', 30', 60', and 90'. Below the scale bar, the text "SCALE: 1" = 30'" is written. A north arrow is located above the scale bar, pointing towards the top right of the page.

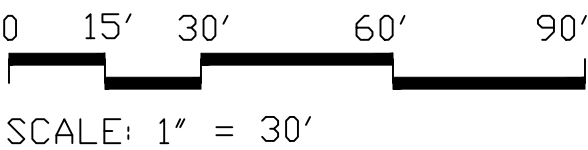

5604 Wilshire Ave NE
Albuquerque, NM 87113
(505)822-8722



CITY OF ALBUQUERQUE
CAPITAL IMPLEMENTATION PROGRAM
DEPARTMENT OF MUNICIPAL DEVELOPMENT

PROTOTYPE MEDIAN AND INTERSTATE LANDSCAPES FY-13B
UNSER BLVD: BANDELIER TO BLACK ARROYO (WORK ORDER #2)
IRRIGATION PLAN

Design Review Committee

City Engineer Approval

Last Design Update

Mo./Day/Yr

Mo./Day/Yr

City Project No. 770103

Zone Map No.
A-11-Z

Sheet 9 OF 9

SURVEY INFORMATION		BENCH MARKS		AS-BUILT INFORMATION	
NO.	FIELD NOTES		CONTRACTOR	LEE LANDSCAPES, INC.	DATE
	BY	DATE			
			WORK COMPLETED BY		DATE
			INSPECTOR'S ACCEPTANCE BY		DATE
			AS-BUILT VERIFICATION BY		DATE
			DRAWINGS CORRECTED BY	ML	DATE 9/2/13
			MICRO-FILM INFORMATION		
			RECORDED BY		DATE
			NO.		

[illegible]

PROGRAM DEVELOPMENT	
LANDSCAPES FY-13B	
YO (WORK ORDER #2)	
Mo./Day/Yr.	Mo./Day/Yr.
Sheet	9 OF 9