
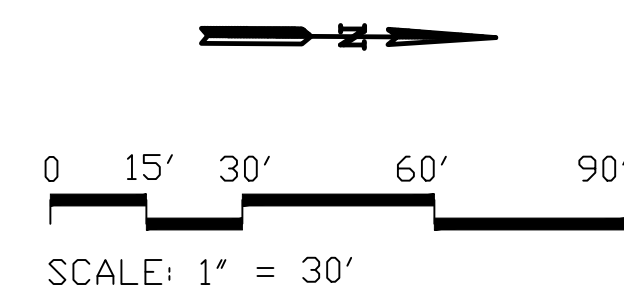



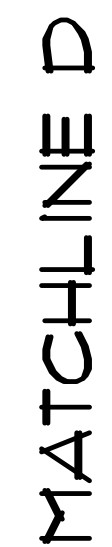
IRRIGATION NOTES:

1. INSTALL 6'X6'X8" CONCRETE PAD FOR RP AND ENCLOSURE.

AS-BUILT
2/24/2014

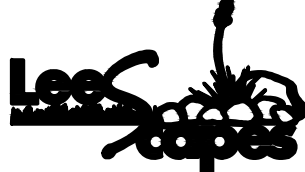

| | | | | | | | | |
|--|---|--|-----------------------------|--|--|------------------------|-------------|-------------|
|  | 5604 Wilshire Ave NE Albuquerque, NM 87113 (505)822-8722 | | | | | | | |
| | | | | | | | | |
| | | | | | | | | |
| <div style="float: right; width: 15%;"> DESIGNED BY ML DRAWN BY CHECKED BY LS </div> | | | | | | | | |
| <div style="text-align: center;">  <p>CITY OF ALBUQUERQUE CAPITAL IMPLEMENTATION PROGRAM DEPARTMENT OF MUNICIPAL DEVELOPMENT</p> </div> | | | | | | | | |
| <div style="text-align: center;"> <h3>PROTOTYPE MEDIAN AND INTERSTATE LANDSCAPES FY-13B WYOMING: OSUNA TO ACADEMY: WORK ORDER #5) IRRIGATION PLAN</h3> </div> | | | | | | | | |
| Design Review Committee | | | City Engineer Approval | | | Last Design Update | Mo./Day/Yr. | Mo./Day/Yr. |
| | | | | | | | | |
| | | | | | | | | |
| City Project No. 770106 | | | Zone Map No. F-19 | | | Sheet 1 OF 3 | | |




MATCHLINE

IRRIGATION NOTES:

1. INSTALL 6'X6'X8" CONCRETE PAD FOR RP AND ENCLOSURE.

AS-BUILT
2/24/2014

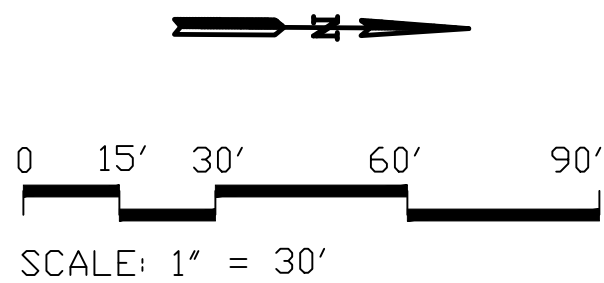


5604 Wilshire Ave NE
Albuquerque, NM 87113
(505)822-8722



CITY OF ALBUQUERQUE
CAPITAL IMPLEMENTATION PROGRAM
DEPARTMENT OF MUNICIPAL DEVELOPMENT

PROTOTYPE MEDIAN AND INTERSTATE LANDSCAPES FY-13B
WYOMING: OSUNA TO ACADEMY: WORK ORDER #5)
IRRIGATION PLAN

| | | | | |
|-------------------------|------------------------|--------------------|--------------|-------------|
| Design Review Committee | City Engineer Approval | Last Design Update | Mo./Day/Yr. | Mo./Day/Yr. |
| | | | | |
| | | | | |
| City Project No. 770106 | | Zone Map No. F-19 | Sheet 2 OF 3 | |

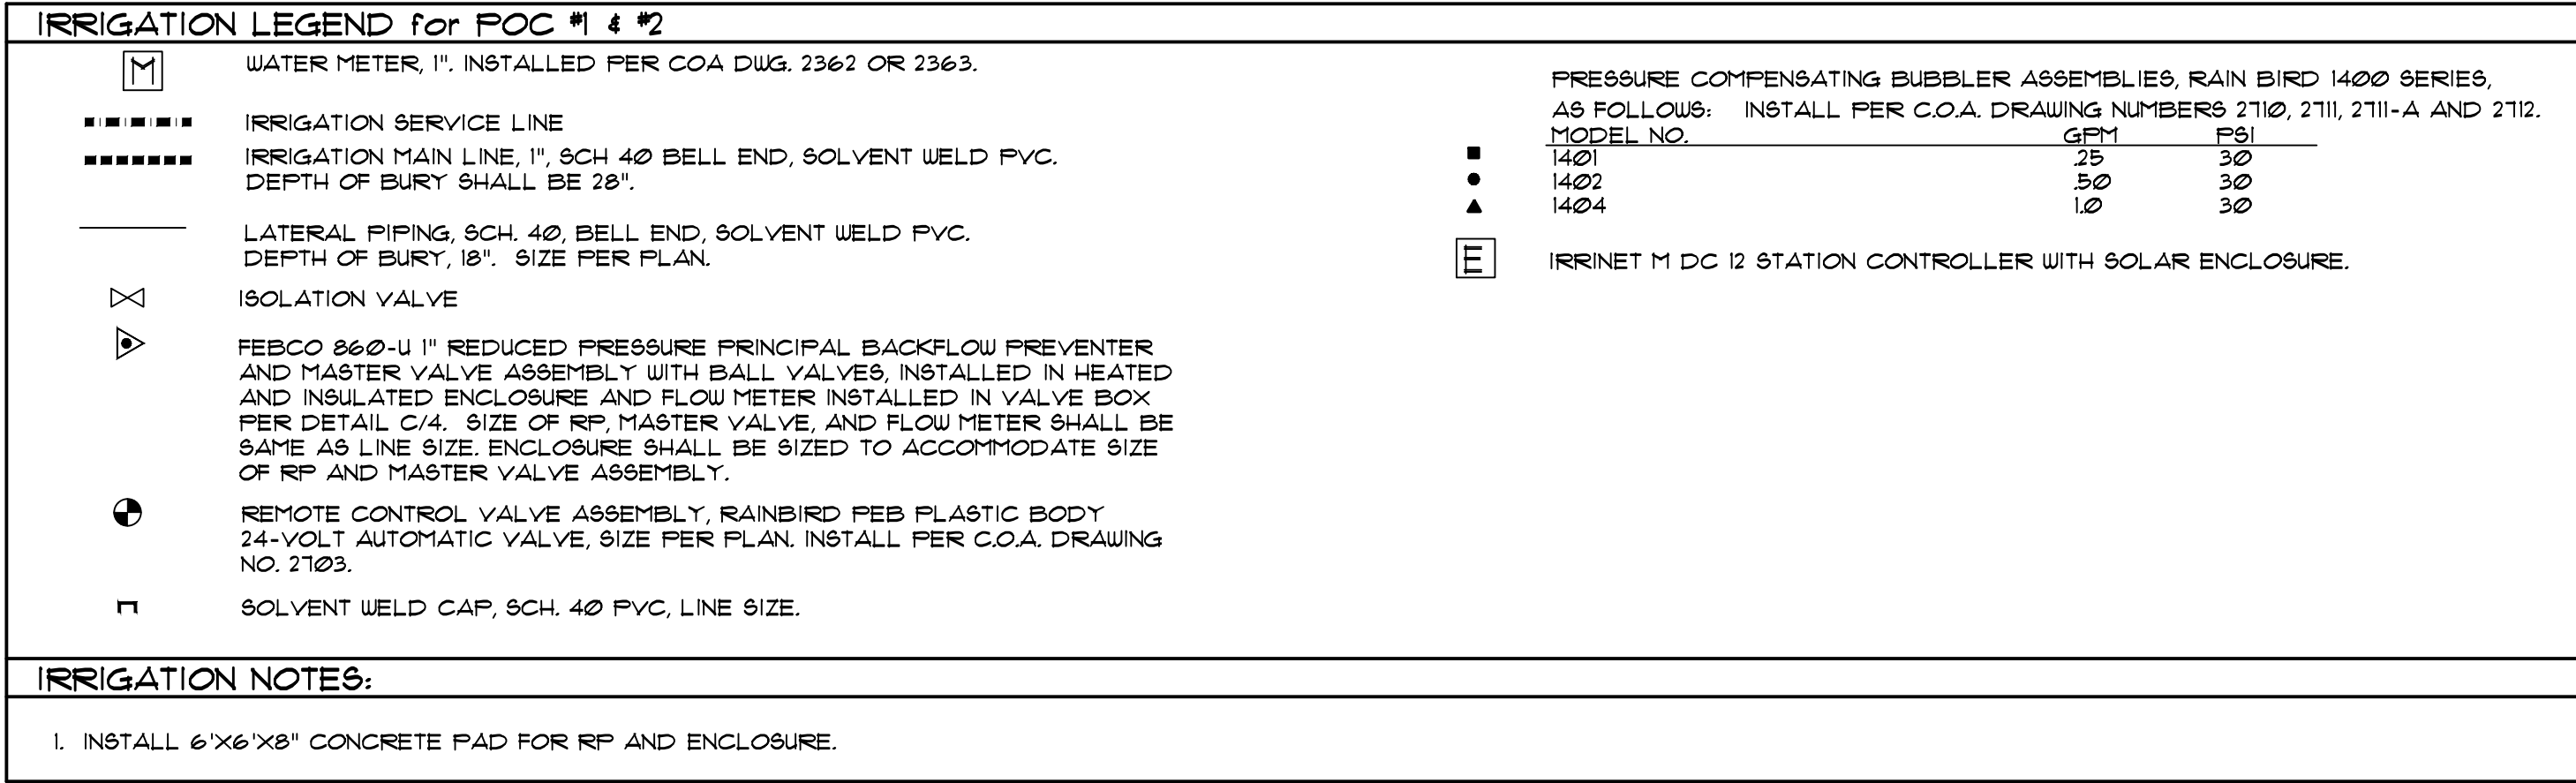[illegible]