


IRRIGATION LEGEND for POC #1			
	WATER METER, 15".	INSTALLED PER COA DUG. 2362 OR 2363.	
	IRRIGATION SERVICE LINE		
	IRRIGATION MAIN LINE, SCH. 40 BELL END, SOLVENT WELD PVC.	DEPTH OF BURY SHALL BE 28". SIZE PER PLAN.	
	LATERAL PIPING, SCH. 40, BELL END, SOLVENT WELD PVC.	DEPTH OF BURY, 18". SIZE PER PLAN.	
	MAIN LINE AND LATERAL SLEEVE PIPING, 2 SIZES LARGER THAN PIPE SIZE, CLASS 200, SDR-21, BELL-END, SOLVENT WELD PVC. SLEEVES ARE TO BE BORED.		
	24-VOLT IRRIGATION WIRE SLEEVE PIPING, 2", CLASS 200, SDR-21, BELL-END, SOLVENT WELD PVC. SLEEVES ARE TO BE BORED.		
	ISOLATION VALVE		
	FEBCO 860-U 15" REDUCED PRESSURE PRINCIPAL BACKFLOW PREVENTER AND MASTER VALVE ASSEMBLY WITH BALL VALVES, INSTALLED IN HEATED AND INSULATED ENCLOSURE AND FLOW METER INSTALLED IN VALVE BOX PER DETAIL C/4. SIZE OF RP, MASTER VALVE, AND FLOW METER SHALL BE SAME AS LINE SIZE. ENCLOSURE SHALL BE SIZED TO ACCOMMODATE SIZE OF RP AND MASTER VALVE ASSEMBLY.		
	REMOTE CONTROL VALVE ASSEMBLY, RAINBIRD FEB PLASTIC BODY 24-VOLT AUTOMATIC VALVE, SIZE PER PLAN. INSTALL PER COA DRAWING NO. 2103.		
	SOLVENT WELD CAP, SCH. 40 PVC, LINE SIZE.		
	PRESSURE COMPENSATING BUBBLER ASSEMBLIES, RAIN BIRD 1400 SERIES, AS FOLLOWS: INSTALL PER COA DRAWING NUMBERS 2110, 2111, 2111-A AND 2112.		
	MODEL NO.	GPM	PSI
	1401	25	30
	1402	50	30
	1404	10	30
	IRRINET M AC 12 STATION CONTROLLER		
	ELECTRICAL SERVICE		
	INLINE CHECK VALVE, SAME AS IRRIGATION LINE SIZE.		
	1" AIR RELEASE VALVE. INSTALL PER COA DRAWING NO. 2105.		

AS-BUILT
7/21/2014

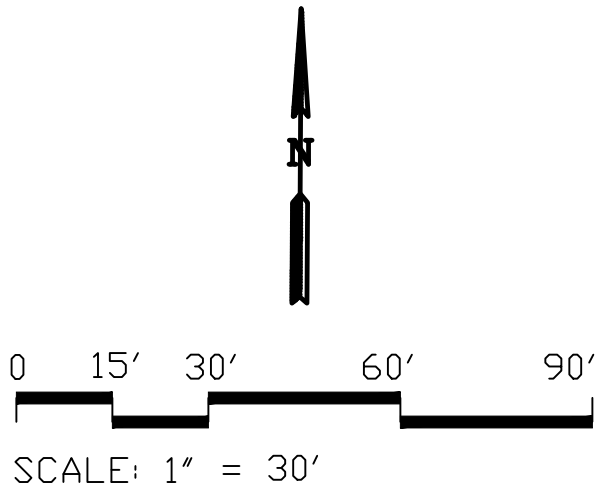

5604 Wilshire Ave NE
Albuquerque, NM 87113
(505)822-8722

CITY OF ALBUQUERQUE
CAPITAL IMPLEMENTATION PROGRAM
DEPARTMENT OF MUNICIPAL DEVELOPMENT

PROTOTYPE MEDIAN AND INTERSTATE LANDSCAPES FY-13B
MONTGOMERY: SAN PEDRO DR. TO LOUISIANA BLVD.
IRRIGATION PLAN: WORK ORDER #7

Design Review Committee	City Engineer Approval	Last Design Update	Mo./Day/Yr.	Mo./Day/Yr.
City Project No.	Zone Map No.	Sheet		
770108	G18	2 OF 2		

REVISIONS		ARCHITECTURAL SEAL		SURVEY INFORMATION		BENCH MARKS		AS-BUILT INFORMATION	
				FIELD NOTES				CONTRACTOR	
				NO.				LEE LANDSCAPES, INC.	
				BY				WORKED BY	
				DATE				DATE	
								INSPECTOR'S	
								ACCEPTANCE BY	
								DATE	
								DRAWINGS BY	
								DATE	
								DRAWINGS BY	
								DATE	