



UNSER MEDIANS - MONTANO TO DELLYNE

RECORD DRAWINGS
DATE: JUNE 8, 2016
PROJECT# 770307

A horizontal graphic scale bar with three segments. The first segment is labeled '0' at its left end and '30'' at its right end. The second segment is labeled '60'' at its right end. The segments alternate between white and black fill.



NORTH

Sheet 1 of 3

(A1) IRRIGATION PLAN
SCALE: 1"=30'-0"

A1 IRRIGATION PLAN

SCALE: 1"=30'-0"

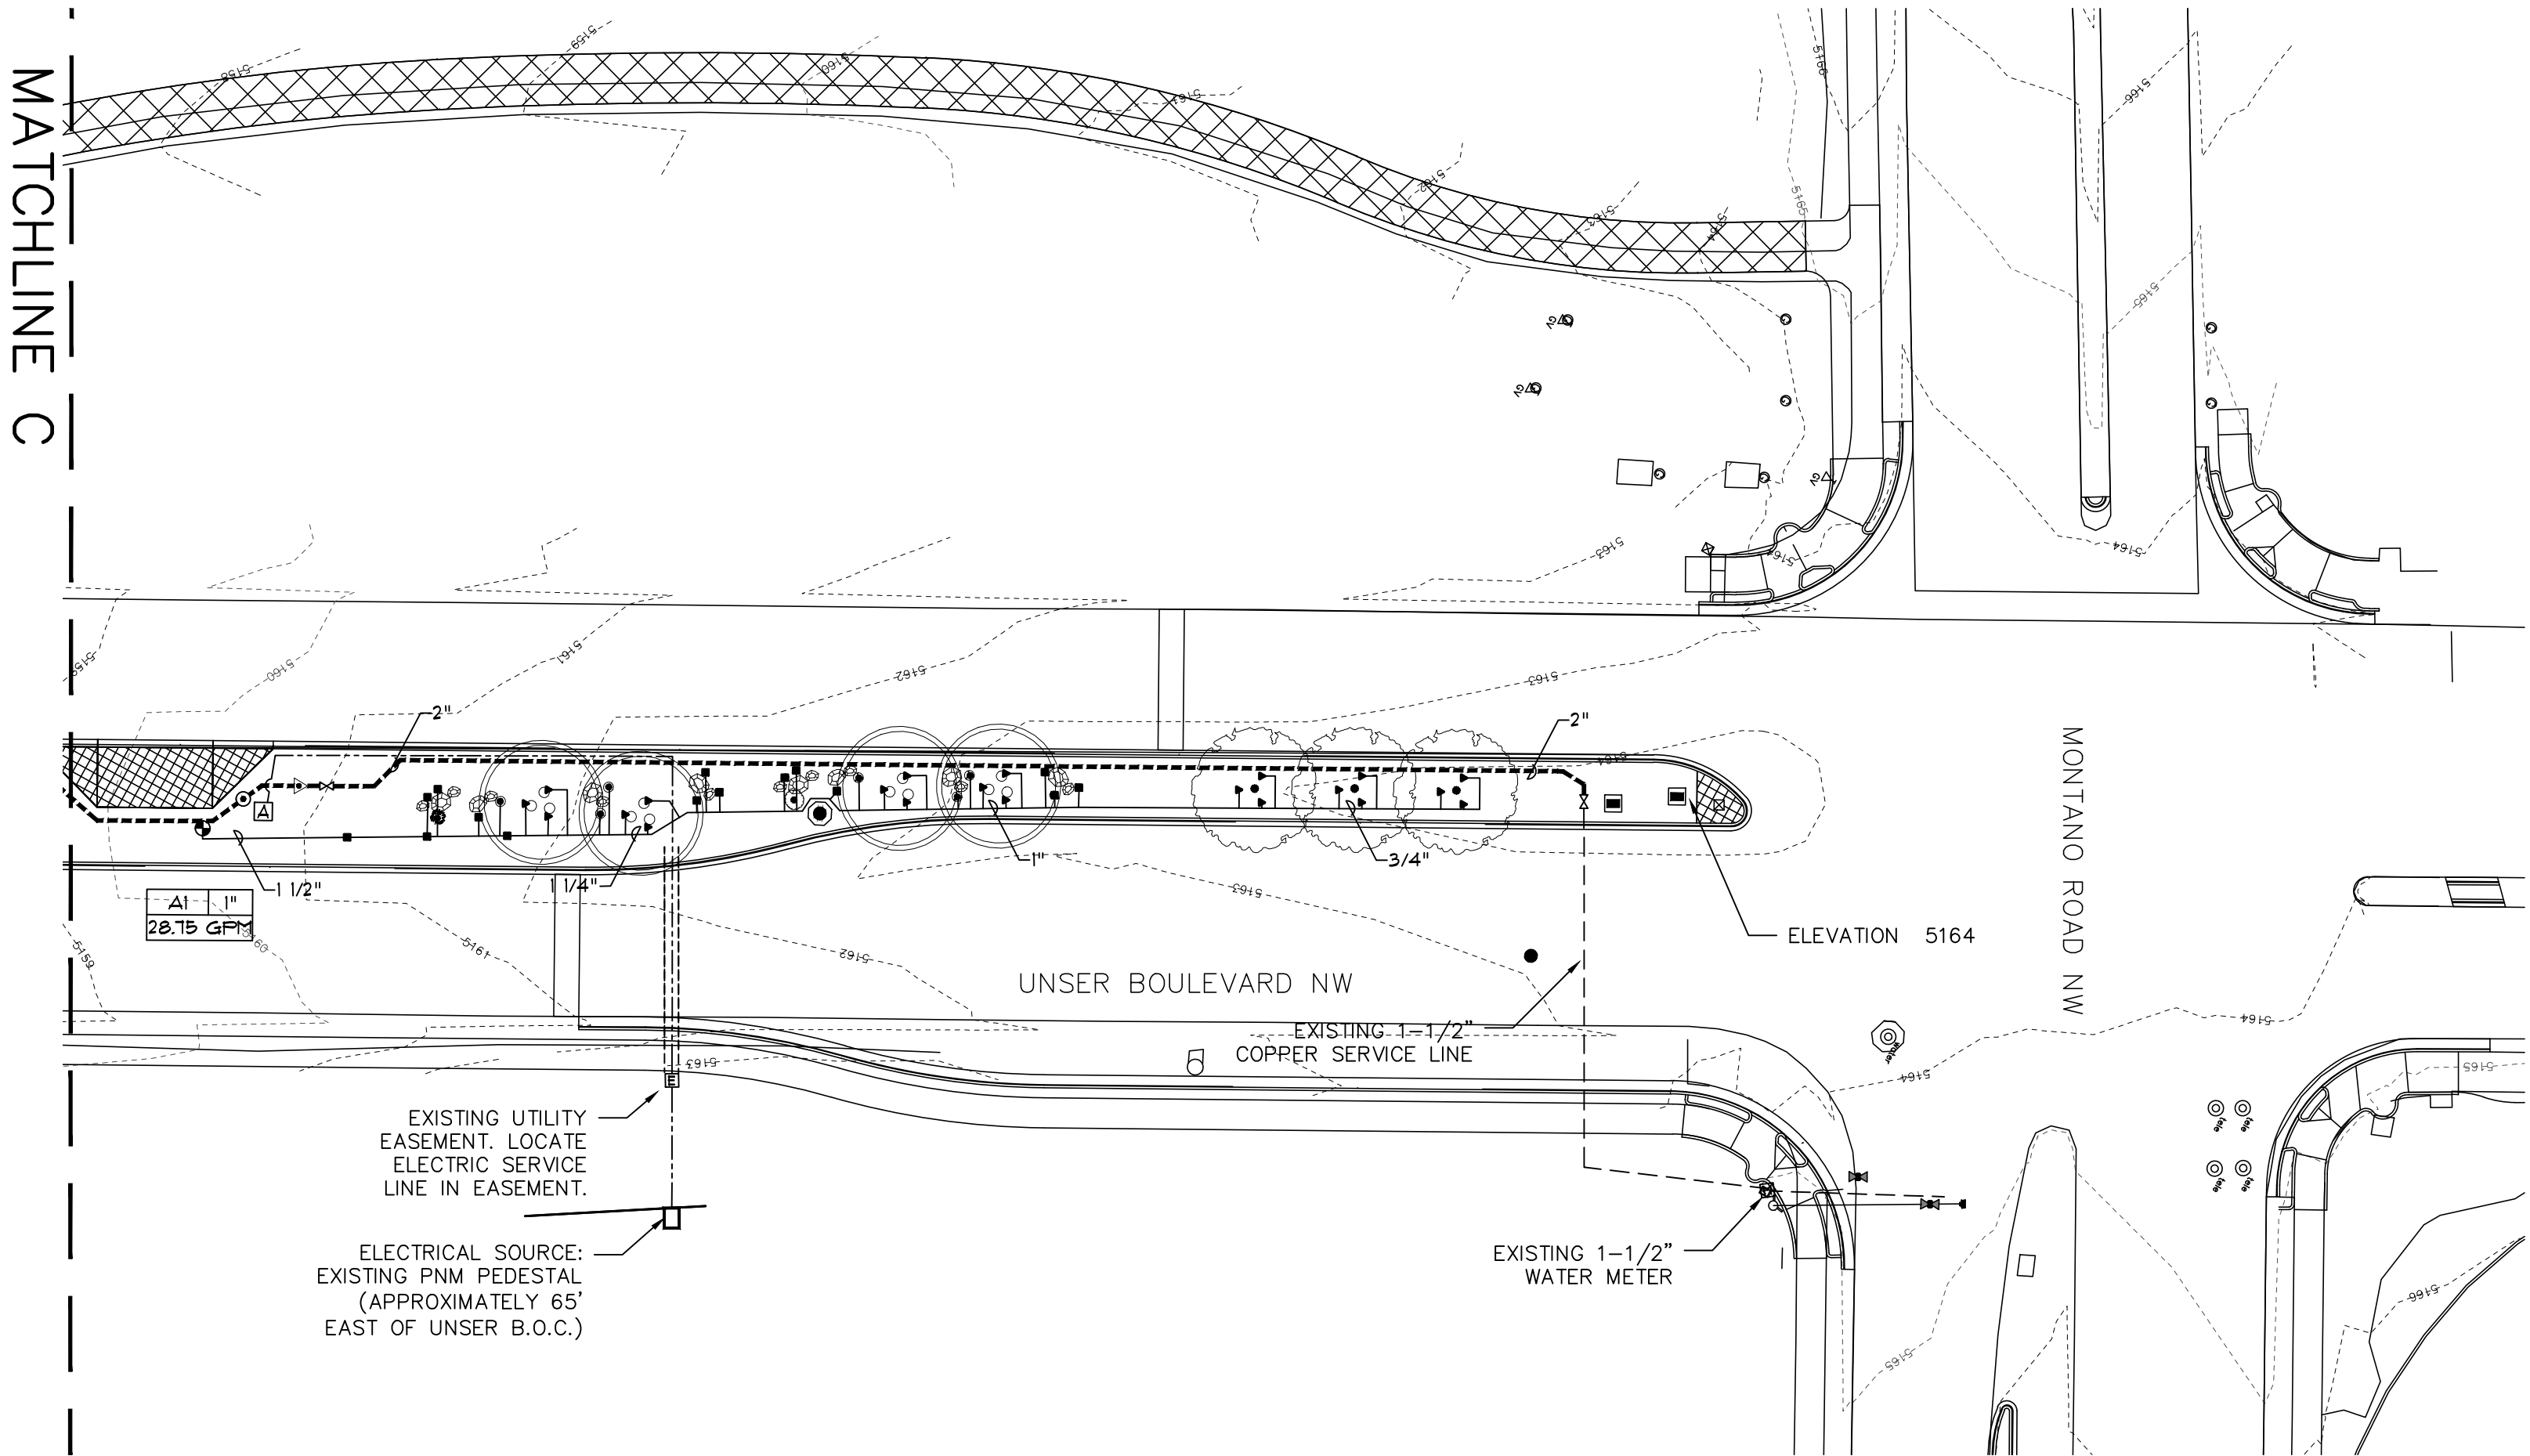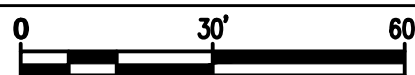

IRRIGATION LEGEND for POC #1	
	EXISTING WATER METER, 15".
	IRRIGATION SERVICE LINE, 28" DEPTH OF BURY.
	IRRIGATION MAIN LINE, SCH 40 BELL END, SOLVENT WELD PVC. DEPTH OF BURY SHALL BE 28" AT CONSTANT PRESSURE MAIN LINE, 18" DEPTH OF BURY AT NON-CONSTANT PRESSURE MAIN LINE. SIZE PER PLAN.
	LATERAL PIPING, SCH. 40, BELL END, SOLVENT WELD PVC. DEPTH OF BURY, 18". SIZE PER PLAN.
	MAIN LINE AND LATERAL SLEEVE PIPING, 2 SIZES LARGER THAN PIPE SIZE, CLASS 200, SDR-21, BELL-END, SOLVENT WELD PVC. SLEEVES ARE TO BE BORED.
	24-VOLT IRRIGATION WIRE SLEEVE PIPING, 2", CLASS 200, SDR-21, BELL-END, SOLVENT WELD PVC. SLEEVES ARE TO BE BORED.
	ISOLATION VALVE
	FEBCO 825-YA 15" REDUCED PRESSURE PRINCIPAL BACKFLOW PREVENTER AND MASTER VALVE ASSEMBLY WITH BALL VALVES, INSTALLED IN HEATED AND INSULATED ENCLOSURE AND FLOW METER INSTALLED IN VALVE BOX PER DETAIL C/4. SIZE OF RP, MASTER VALVE, AND FLOW METER SHALL BE SAME AS LINE SIZE. ENCLOSURE SHALL BE SIZED TO ACCOMMODATE SIZE OF RP AND MASTER VALVE ASSEMBLY.
	REMOTE CONTROL VALVE ASSEMBLY, RAINBIRD FEB PLASTIC BODY, 24-VOLT AUTOMATIC VALVE, SIZE PER PLAN. INSTALL PER C.O.A. DRAWING NO. 2103.
	1" AIR RELEASE VALVE. INSTALL PER C.O.A. DRAWING NO. 2105.
	SOLVENT WELD CAP, SCH. 40 PVC, LINE SIZE.
	PRESSURE COMPENSATING BUBBLER ASSEMBLIES, RAIN BIRD 1400 SERIES, AS FOLLOWS: INSTALL PER C.O.A. DRAWING NUMBERS 2110, 2111, 2111-A AND 2112.
	RAINBIRD ESP12LXMEF WITH GPRS CARTRIDGE #IQ3GUSA AND RADIO.
	ELECTRIC PEDESTAL AND METER
IRRIGATION NOTES	
1. LATERAL SHALL A MINIMUM OF 5' FROM THE TRUNK OF THE TREE. LATERALS MAY BE SHOWN CLOSER TO THE TRUNK FOR GRAPHIC CLARITY.	

AS-BUILT
6/8/2016

Lee Scapes
5604 Wilshire Ave NE
Albuquerque, NM 87113
(505)822-8722

CITY OF ALBUQUERQUE
CAPITAL IMPLEMENTATION PROGRAM
DEPARTMENT OF MUNICIPAL DEVELOPMENT

PROTOTYPE MEDIAN AND INTERSTATE LANDSCAPES FY-15A
UNSER: MONTANO TO DELLYNE-WORK ORDER #8
IRRIGATION PLAN

Design Review Committee	City Engineer Approval	Last Design Update	Mo./Day/Yr.	Mo./Day/Yr.
City Project No. 770307		Zone Map No. E10	Sheet 3 of 3	

REVISIONS		ARCHITECTURAL SEAL		SURVEY INFORMATION		BENCH MARKS		AS-BUILT INFORMATION	
				FIELD NOTES					
				NO.	BY	DATE		CONTRACTOR	LEE LANDSCAPES, INC.
								WORKED BY	DATE
								INSPECTOR'S	DATE
								ACCEPTANCE BY	DATE
								FIELD VERIFICATION BY	DATE
								DRAWINGS	DATE 6/8/16
								CORRECTED BY	ML
DESIGNED BY: ML				DATE	3/9/15			MICRO-FILM INFORMATION	
DRAWN BY: ML				DATE	3/9/15			RECORDED BY	
CHECKED BY: LS				DATE	3/9/15			DATE	
								NO.	

RECORD DRAWINGS
DATE: JUNE 8, 2016

PROJECT# 770307

UNSER MEDIANS - MONTANO TO DELLYNE

FOR PRICING ONLY
DATE: MARCH 3, 2016