

2006.8.11-07.1


SCANNED BY
PLANNING

CONSTRUCTION PLANS FOR PUBLIC INFRASTRUCTURE IMPROVEMENTS FOR THE HILTON AVENUE LOFTS AT HILTON AVE. + HENDRIX RD. NE ALBUQUERQUE, NM

CIVIL LEGEND: (PROPOSED ONLY)

	NEW
Property line	---
Building	---
Edge of pavement	---
Curb & gutter	---
Pavement striping	---
Fence	---
CMU or block wall	---
Utility easement	---
Underground electric line	--- EUG ---
Overhead electric line	--- EOH ---
Water line	--- W ---
Sanitary sewer line	--- SAS ---
Storm drain line	--- SD ---
Index contours	--- 25 ---
Intermediate contours	--- 24 ---
Power pole	○
Light pole	●
Electrical transformer	□
Water valve	+
Fire hydrant	■
Water meter	⊠
Post indicator valve	+
Siamese connection	+
Post hydrant	+
Backflow preventor	⊠
Sanitary sewer manhole	●
Sanitary sewer single cleanout	+
Sanitary sewer double cleanout	+
Storm drain manhole	●
Single storm drain inlet	+
Grading spot elevations	TC=25.00 FL=24.50

ABBREVIATIONS:	
Bottom of footing	BOF
Bottom of wall	BOW
Existing ground	EG
Finish grade	FG
Finish floor	FF
Flowline	FL
Invert	INV
Top of asphalt	TA
Top of curb	TC
Top of footing	TDF
Top of pavement	TP
Top of retaining wall	TDR
Top of sidewalk	TSW
Top of wall	TOW
Rim	RIM

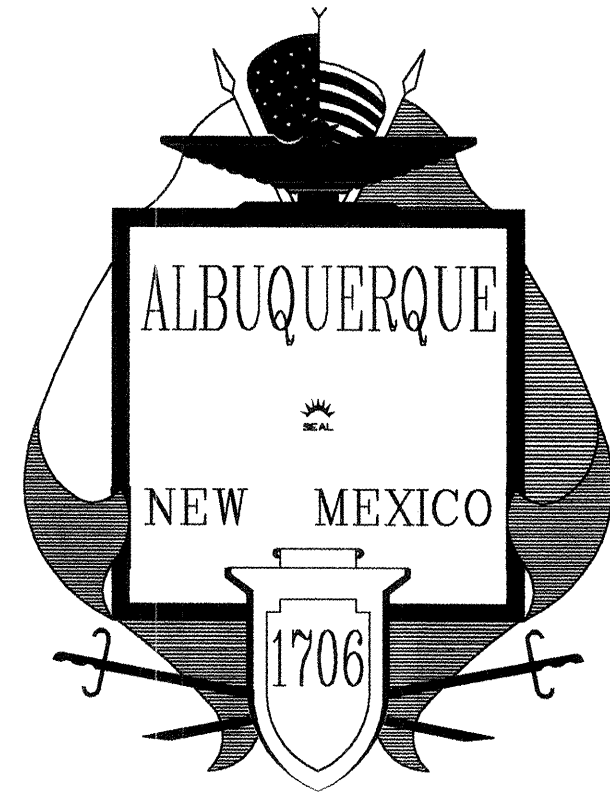


JANUARY 2006

INDEX OF DRAWINGS

SHEET NO.	DESCRIPTION
1 OF 6	TITLE SHEET, NOTES & VICINITY MAP
2 OF 6	FINAL PLAT
3 OF 6	FINAL PLAT
4 OF 6	GRADING PLAN
5 OF 6	PAVING PLAN
6 OF 6	UTILITY PLAN



AS INDICATED BY THE AS-BUILT INFORMATION SHOWN HEREON, THIS PROJECT APPEARS TO HAVE BEEN CONSTRUCTED IN SUBSTANTIAL COMPLIANCE WITH THE INTENT OF THE APPROVED WORK ORDER PLANS. COLLECTION OF THE AS-BUILT INFORMATION WAS PERFORMED BY SURVEYS SOUTHWEST ON 1/17/07, 4/12/07 & 4/13/07. THIS CERTIFICATION DOES NOT ADDRESS OR EVALUATE ADA ACCESSIBILITY ISSUES OR COMPLIANCE. THOSE RELYING ON THIS RECORD DOCUMENT ARE ADVISED TO OBTAIN INDEPENDENT VERIFICATION OF ITS ACCURACY BEFORE USING IT FOR ANY OTHER PURPOSE.

GUY C. JACKSON, NMPE 13289 DATE 5-15-07

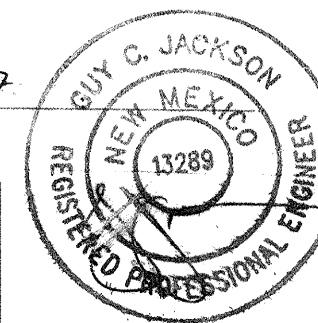

NOTICE TO CONTRACTORS (CONT.)

- CAUTION: THESE DRAWINGS DO NOT INCLUDE NECESSARY COMPONENTS FOR CONSTRUCTION SAFETY WHICH SHALL REMAIN THE RESPONSIBILITY OF THE CONTRACTOR. ALL EXCAVATION, TRENCHING AND SHORING ACTIVITIES MUST BE CARRIED-OUT IN ACCORDANCE WITH OSHA 29 CFR 1926, SUBPART P-EXCAVATIONS.
- ANY WORK OCCURRING WITHIN AN ARTERIAL ROADWAY REQUIRES TWENTY-FOUR HOUR CONSTRUCTION.
- CONTRACTOR SHALL MAINTAIN A GRAFFI-FREE WORK SITE. CONTRACTOR SHALL PROMPTLY REMOVE ANY AND ALL GRAFFITI FROM EQUIPMENT, WHETHER PERMANENT OR TEMPORARY.
- WHEN APPLICABLE, CONTRACTOR SHALL SECURE "TOPSOIL DISTURBANCE PERMIT" FROM THE CITY AND/OR FILE A NOTICE OF INTENT (N.O.I.) WITH THE EPA PRIOR TO BEGINNING CONSTRUCTION.
- THE WATER SYSTEM DIVISION (857-8200) WILL BE NOTIFIED BY THE CONTRACTOR SEVEN (7) WORKING DAYS IN ADVANCE OF ANY WORK WHICH MAY AFFECT THE EXISTING PUBLIC WATER FACILITIES. REFER TO SECTION 18 OF THE STANDARD SPECIFICATIONS.
- ELECTRONIC MARKER DISKS (EMD) WILL BE PLACED ACCORDING TO SECTION 170 OF THE CITY OF ALBUQUERQUE STANDARD SPECIFICATIONS FOR PUBLIC WORKS CONSTRUCTION, 1986 EDITION AS REVISED THROUGH UPDATE #7.
- ARTERIAL / COLLECTOR ROAD USAGE FEES OF \$0.01 PER SQUARE FOOT OF BARRICADED AREA PER DAY WILL BE ASSESSED ON ALL BARRICADE PERMITS FOR CLOSURES.
- CONTRACTOR SHALL WORK CONTINUOUSLY, 24-HOURS PER DAY, ON ALL ARTERIAL ROADWAYS WHEN TRAFFIC LANES ARE CLOSED TO TRAFFIC UNLESS WORK VIOLATES THE CITY'S NOISE ORDINANCE.
- IF THE CONTRACTOR IS NOT ALLOWED TO WORK AT NIGHT DUE TO NOISE ORDINANCE VIOLATIONS, THE CONTRACTOR SHALL OPEN ALL TRAFFIC LANES TO TRAFFIC WITH THE PROPER USE OF TRENCH PLATES DURING NON-WORKING HOURS, AND MUST WORK MINIMUM HOURS FROM 7:00A.M. TO 10:00P.M. MONDAY THROUGH SATURDAYS.
- ARTERIAL STREETS ARE AS INDICATED IN THE "LONG RANGE ROADWAY SYSTEM" MAP PUBLISHED BY THE MID-REGION COUNCIL OF GOVERNMENTS (MRCOG).
- FIVE (5) WORKING DAYS PRIOR TO BEGINNING CONSTRUCTION THE CONTRACTOR SHALL SUBMIT TO THE CONSTRUCTION CO-ORDINATION DIVISION A DETAILED CONSTRUCTION SCHEDULE. TWO (2) WORKING DAYS PRIOR TO CONSTRUCTION THE CONTRACTOR SHALL OBTAIN A BARRICADE PERMIT FROM THE CONSTRUCTION CO-ORDINATION DIVISION. CONTRACTOR SHALL NOTIFY BARRICADE ENGINEER (924-3400) PRIOR TO OCCUPYING AN INTERSECTION. CONTRACTOR MUST REFER TO SECTION 19 OF THE STANDARD SPECIFICATION FOR TRAFFIC CONTROL.

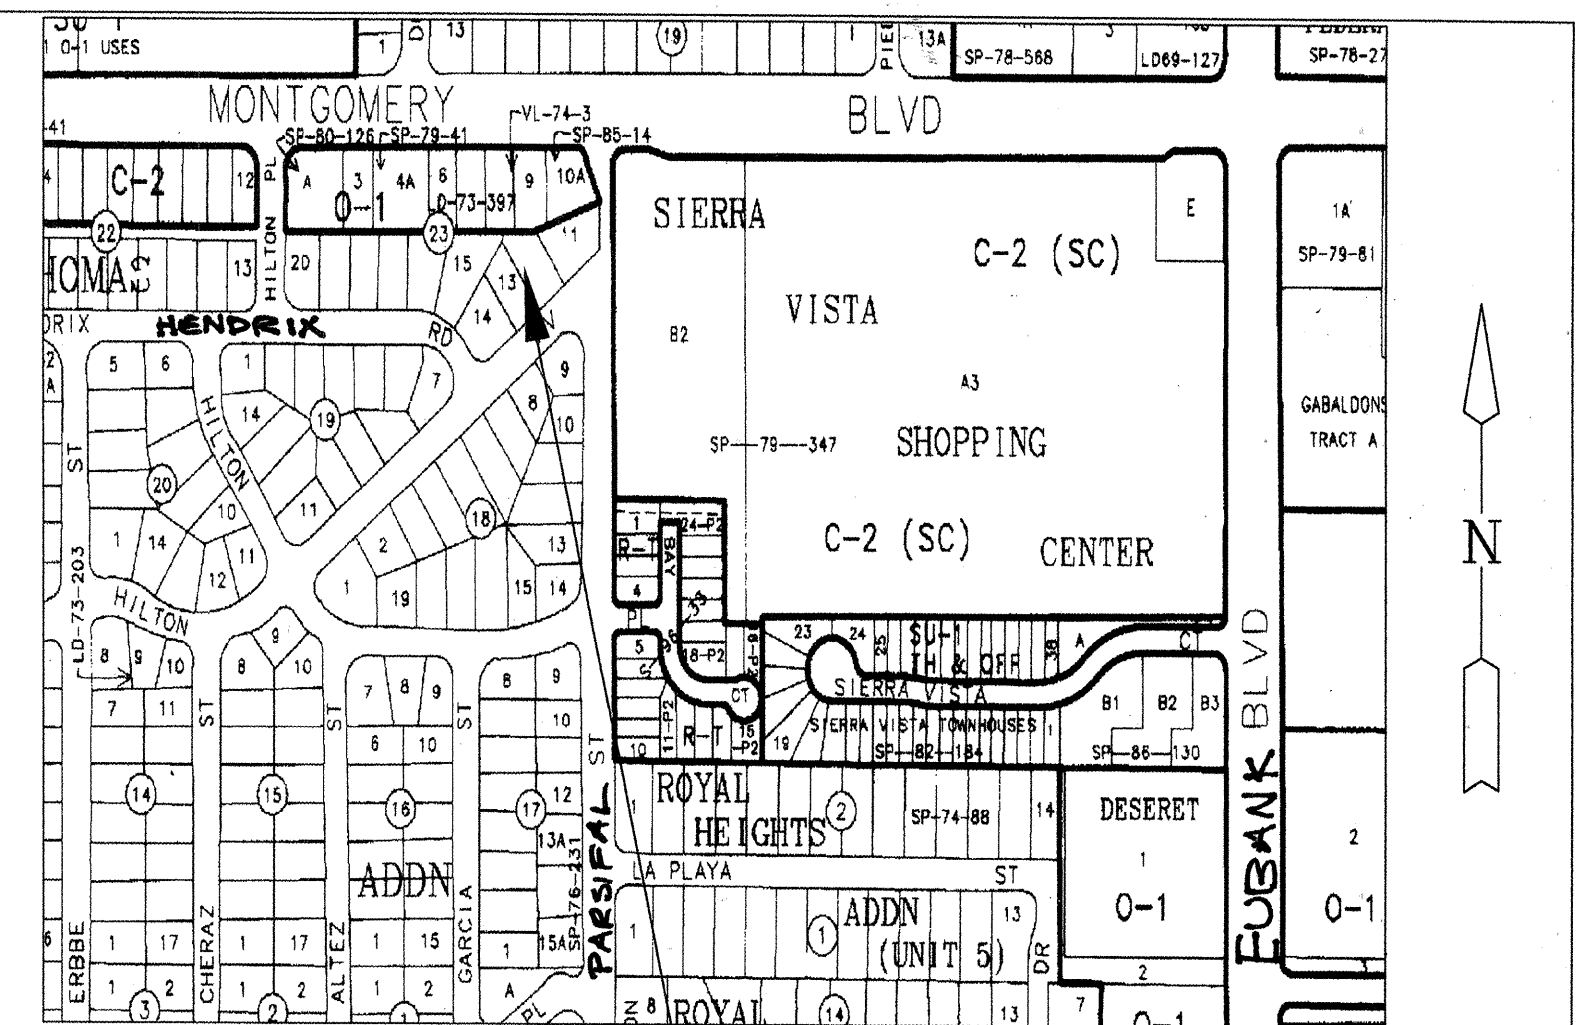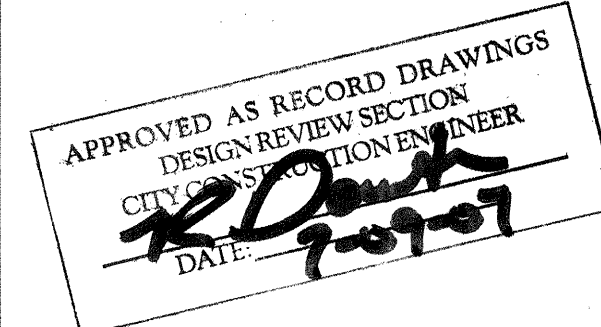

PROJECT LOCATION
VICINITY MAP
PUBLIC INFRASTRUCTURE IMPROVEMENTS FOR HILTON AVE. LOFTS

SCALE: N.T.S.
(ZONE ATLAS MAP NO. G-20)

NOTICE TO CONTRACTORS

- ALL WORK DETAILED ON THESE PLANS TO BE PERFORMED UNDER CONTRACT SHALL, EXCEPT AS OTHERWISE STATED OR PROVIDED FOR HEREON, BE CONSTRUCTED IN ACCORDANCE WITH THE CITY OF ALBUQUERQUE STANDARD SPECIFICATIONS--PUBLIC WORKS CONSTRUCTION--1986--UPDATE NO. 7.
- TWO (2) WORKING DAYS PRIOR TO ANY EXCAVATION, CONTRACTOR MUST CONTACT NEW MEXICO ONE CALL SYSTEM, 260-1990, (ALBUQUERQUE AREA) 1-800-321-ALERT (2537) (STATEWIDE) FOR LOCATION OF EXISTING UTILITIES.
- IF ANY UTILITY LINES, PIPELINES, OR UNDERGROUND UTILITY LINES ARE SHOWN ON THESE DRAWINGS, THEY ARE SHOWN IN AN APPROXIMATE MANNER ONLY, AND SUCH LINES MAY EXIST WHERE NONE ARE SHOWN. IF ANY SUCH EXISTING LINES ARE SHOWN, THE LOCATION IS BASED UPON INFORMATION PROVIDED BY THE OWNER OF SAID UTILITY, AND THE INFORMATION MAY BE INCOMPLETE, OR MAY BE OBSOLETE BY THE TIME CONSTRUCTION COMMENCES. THE ENGINEER HAS CONDUCTED ONLY PRELIMINARY INVESTIGATION OF THE LOCATION, DEPTH, SIZE, OR TYPE OF EXISTING UTILITY LINES, PIPELINES, OR UNDERGROUND UTILITY LINES. THIS INVESTIGATION IS NOT CONCLUSIVE, AND MAY NOT BE COMPLETE. THEREFORE, MAKES NO REPRESENTATION PERTAINING THERETO, AND ASSUMES NO RESPONSIBILITY OR LIABILITY THEREFOR. THE CONTRACTOR SHALL INFORM ITSELF OF THE LOCATION OF ANY UTILITY LINE, PIPELINE, OR UNDERGROUND UTILITY LINE IN OR NEAR THE AREA OF THE WORK OF THE WORK IN ADVANCE OF AND DURING EXCAVATION WORK. THE CONTRACTOR IS FULLY RESPONSIBLE FOR ANY AND ALL DAMAGE CAUSED BY ITS FAILURE TO LOCATE, IDENTIFY AND PRESERVE ANY AND ALL EXISTING UTILITIES, PIPELINES, AND UNDERGROUND UTILITY LINES. IN PLANNING AND CONDUCTING EXCAVATION, THE CONTRACTOR SHALL COMPLY WITH STATE STATUTES, MUNICIPAL AND LOCAL ORDINANCES, RULES AND REGULATIONS, IF ANY, PERTAINING TO THE LOCATION OF THESE LINES AND FACILITIES.
- SHOULD A CONFLICT EXIST BETWEEN THESE PLANS AND ACTUAL FIELD CONDITIONS, THE CONTRACTOR SHALL PROMPTLY NOTIFY THE ENGINEER IN WRITING SO THAT THE CONFLICT CAN BE RESOLVED WITH A MINIMUM AMOUNT OF DELAY FOR ALL PARTIES.
- THE CONTRACTOR SHALL MAINTAIN ACCESS TO ADJACENT PROPERTIES DURING CONSTRUCTION.
- ALL WORK ON THIS PROJECT SHALL BE PERFORMED IN ACCORDANCE WITH APPLICABLE FEDERAL, STATE AND LOCAL LAWS, RULES AND REGULATIONS CONCERNING SAFETY AND HEALTH.
- ALL UTILITIES AND UTILITY SERVICE LINES SHALL BE INSTALLED PRIOR TO PAVING.
- BACKFILL COMPACTION SHALL BE ACCORDING TO SPECIFIED STREET USE.
- TACK COAT REQUIREMENTS SHALL BE DETERMINED DURING CONSTRUCTION BY THE PROJECT ENGINEER.
- SIDEWALKS AND WHEELCHAIR RAMPS WITHIN THE CURB RETURNS SHALL BE CONSTRUCTED WHEREVER A NEW CURB RETURN IS CONSTRUCTED.
- IF CURB IS DEPRESSIONED FOR A DRIVEPAD OR A HANDICAP RAMP, THE DRIVEPAD OR RAMP SHALL BE CONSTRUCTED PRIOR TO ACCEPTANCE OF THE CURB AND GUTTER.
- ALL STORM DRAINAGE FACILITIES SHALL BE COMPLETED PRIOR TO FINAL ACCEPTANCE.
- CONTRACTOR SHALL COORDINATE WITH THE WATER SYSTEM DIVISION FOR THE EXECUTION OF THE VALVE SHUT OFF PLAN, NOT LESS THAN SEVEN (7) WORKING DAYS IN ADVANCE OF ANY WORK THAT MAY AFFECT THE EXISTING PUBLIC WATER UTILITIES. ONLY WATER SYSTEM DIVISION PERSONNEL SHALL OPERATE EXISTING VALVES. REFER TO SECTION 18 OF THE SPECIFICATIONS. THE WATER SYSTEM DIVISION PHONE NUMBER IS 857-8200.
- CONTRACTOR SHALL NOTIFY THE CITY SURVEYOR NOT LESS THAN SEVEN (7) DAYS PRIOR TO STARTING WORK IN ORDER THAT THE CITY SURVEYOR MAY TAKE NECESSARY MEASURES TO INSURE THE PRESERVATION OF SURVEY MONUMENTS. CONTRACTOR SHALL NOT DISTURB PERMANENT SURVEY MONUMENTS WITHOUT THE CONSENT OF THE CITY SURVEYOR AND SHALL NOTIFY THE CITY SURVEYOR AND BEAR THE EXPENSE OF REPLACING ANY THAT MAY BE DISTURBED WITHOUT PERMISSION. REPLACEMENT SHALL BE DONE ONLY BY THE CITY SURVEYOR. WHEN A CHANGE IS MADE IN THE FINISHED ELEVATION OF THE PAVEMENT OF ANY ROADWAY IN WHICH A PERMANENT SURVEY MONUMENT IS LOCATED, CONTRACTOR SHALL, AT HIS OWN EXPENSE, ADJUST THE MONUMENT COVER TO THE NEW GRADE UNLESS OTHERWISE SPECIFIED. REFER TO SECTION 4.4 OF THE SPECIFICATIONS.
- ALL STREET STRIPING ALTERED OR DESTROYED SHALL BE REPLACED WITH PLASTIC REFLECTORIZED STRIPING BY CONTRACTOR TO EXISTING LOCATION OR AS INDICATED BY THIS PLAN SET.

THE FOLLOWING NOTES ALSO APPLY WHEN CHECKED

- ☒ ALL UTILITIES AND UTILITY SERVICE LINES SHALL BE INSTALLED PRIOR TO PAVING.
- ☒ BACKFILL COMPACTION SHALL BE ACCORDING TO SPECIFIED STREET USE.
- ☒ TACK COAT REQUIREMENTS SHALL BE DETERMINED BY THE ENGINEER.
- ☐ SIDEWALKS AND WHEELCHAIR RAMPS WITHIN THE CURB RETURNS SHALL BE CONSTRUCTED WHEREVER A NEW CURB RETURN IS CONSTRUCTED.
- ☐ IF CURB IS DEPRESSIONED FOR A DRIVEPAD, THE DRIVEPAD SHALL BE CONSTRUCTED PRIOR TO ACCEPTANCE OF CURB AND GUTTER.
- ☒ ALL STORM DRAINAGE FACILITIES SHALL BE COMPLETED PRIOR TO FINAL ACCEPTANCE.
- ☒ THE REQUESTER OR DEVELOPER SHALL BE RESPONSIBLE FOR REPAIR OR REPLACEMENT OF ALL CURB AND GUTTER OR SIDEWALK DAMAGED AFTER APPROVAL BY THE CITY ENGINEER OF WORK COMPLETED BY THE CONTRACTOR.

REV.	SHEET	CITY ENGINEER	DATE	USER DEPARTMENT	DATE	USER DEPARTMENT	DATE	
ENGINEERS STAMP & SIGNATURE		APPROVALS	ENGINEER	DATE	*****			
		DRC Chairman		7-13-06	APPROVED FOR CONSTRUCTION			
		Transportation		2/7/06				
		Water/Wastewater		2/1/06				
		Hydrology		4/1/06				
		Parks						
		Const. Mngmt.						
City Project No.		770681		Sheet		1	Of	6

SCANNED BY
PLANNING


STATION 12+20A
X = 413,732.05
Y = 1,502,913.48
GROUND TO GRID = 0.9996443
DELTA ALPHA = -00°09'58"
NEW MEXICO STATE PLANE
COORDINATE SYSTEM
CENTRAL ZONE
NAD 1927

STATION MARY
X = 420,899.36
Y = 1,503,491.87
GROUND TO GRID = 0.99962648
DELTA ALPHA = -00°09'08"
NEW MEXICO STATE PLANE
COORDINATE SYSTEM
CENTRAL ZONE
NAD 1927

LOT 8, BLOCK 23, THOMAS ADDITION
FILED: AUGUST 07, 1973, VOL. 88, FOLIO 134

LOT 9, BLOCK 23, THOMAS ADDITION
FILED: AUGUST 07, 1973, VOL. 88, FOLIO 134


LOT 10-A, BLOCK 23, THOMAS ADDITION
FILED: JANUARY 16, 1985, VOL. C26, FOLIO 34

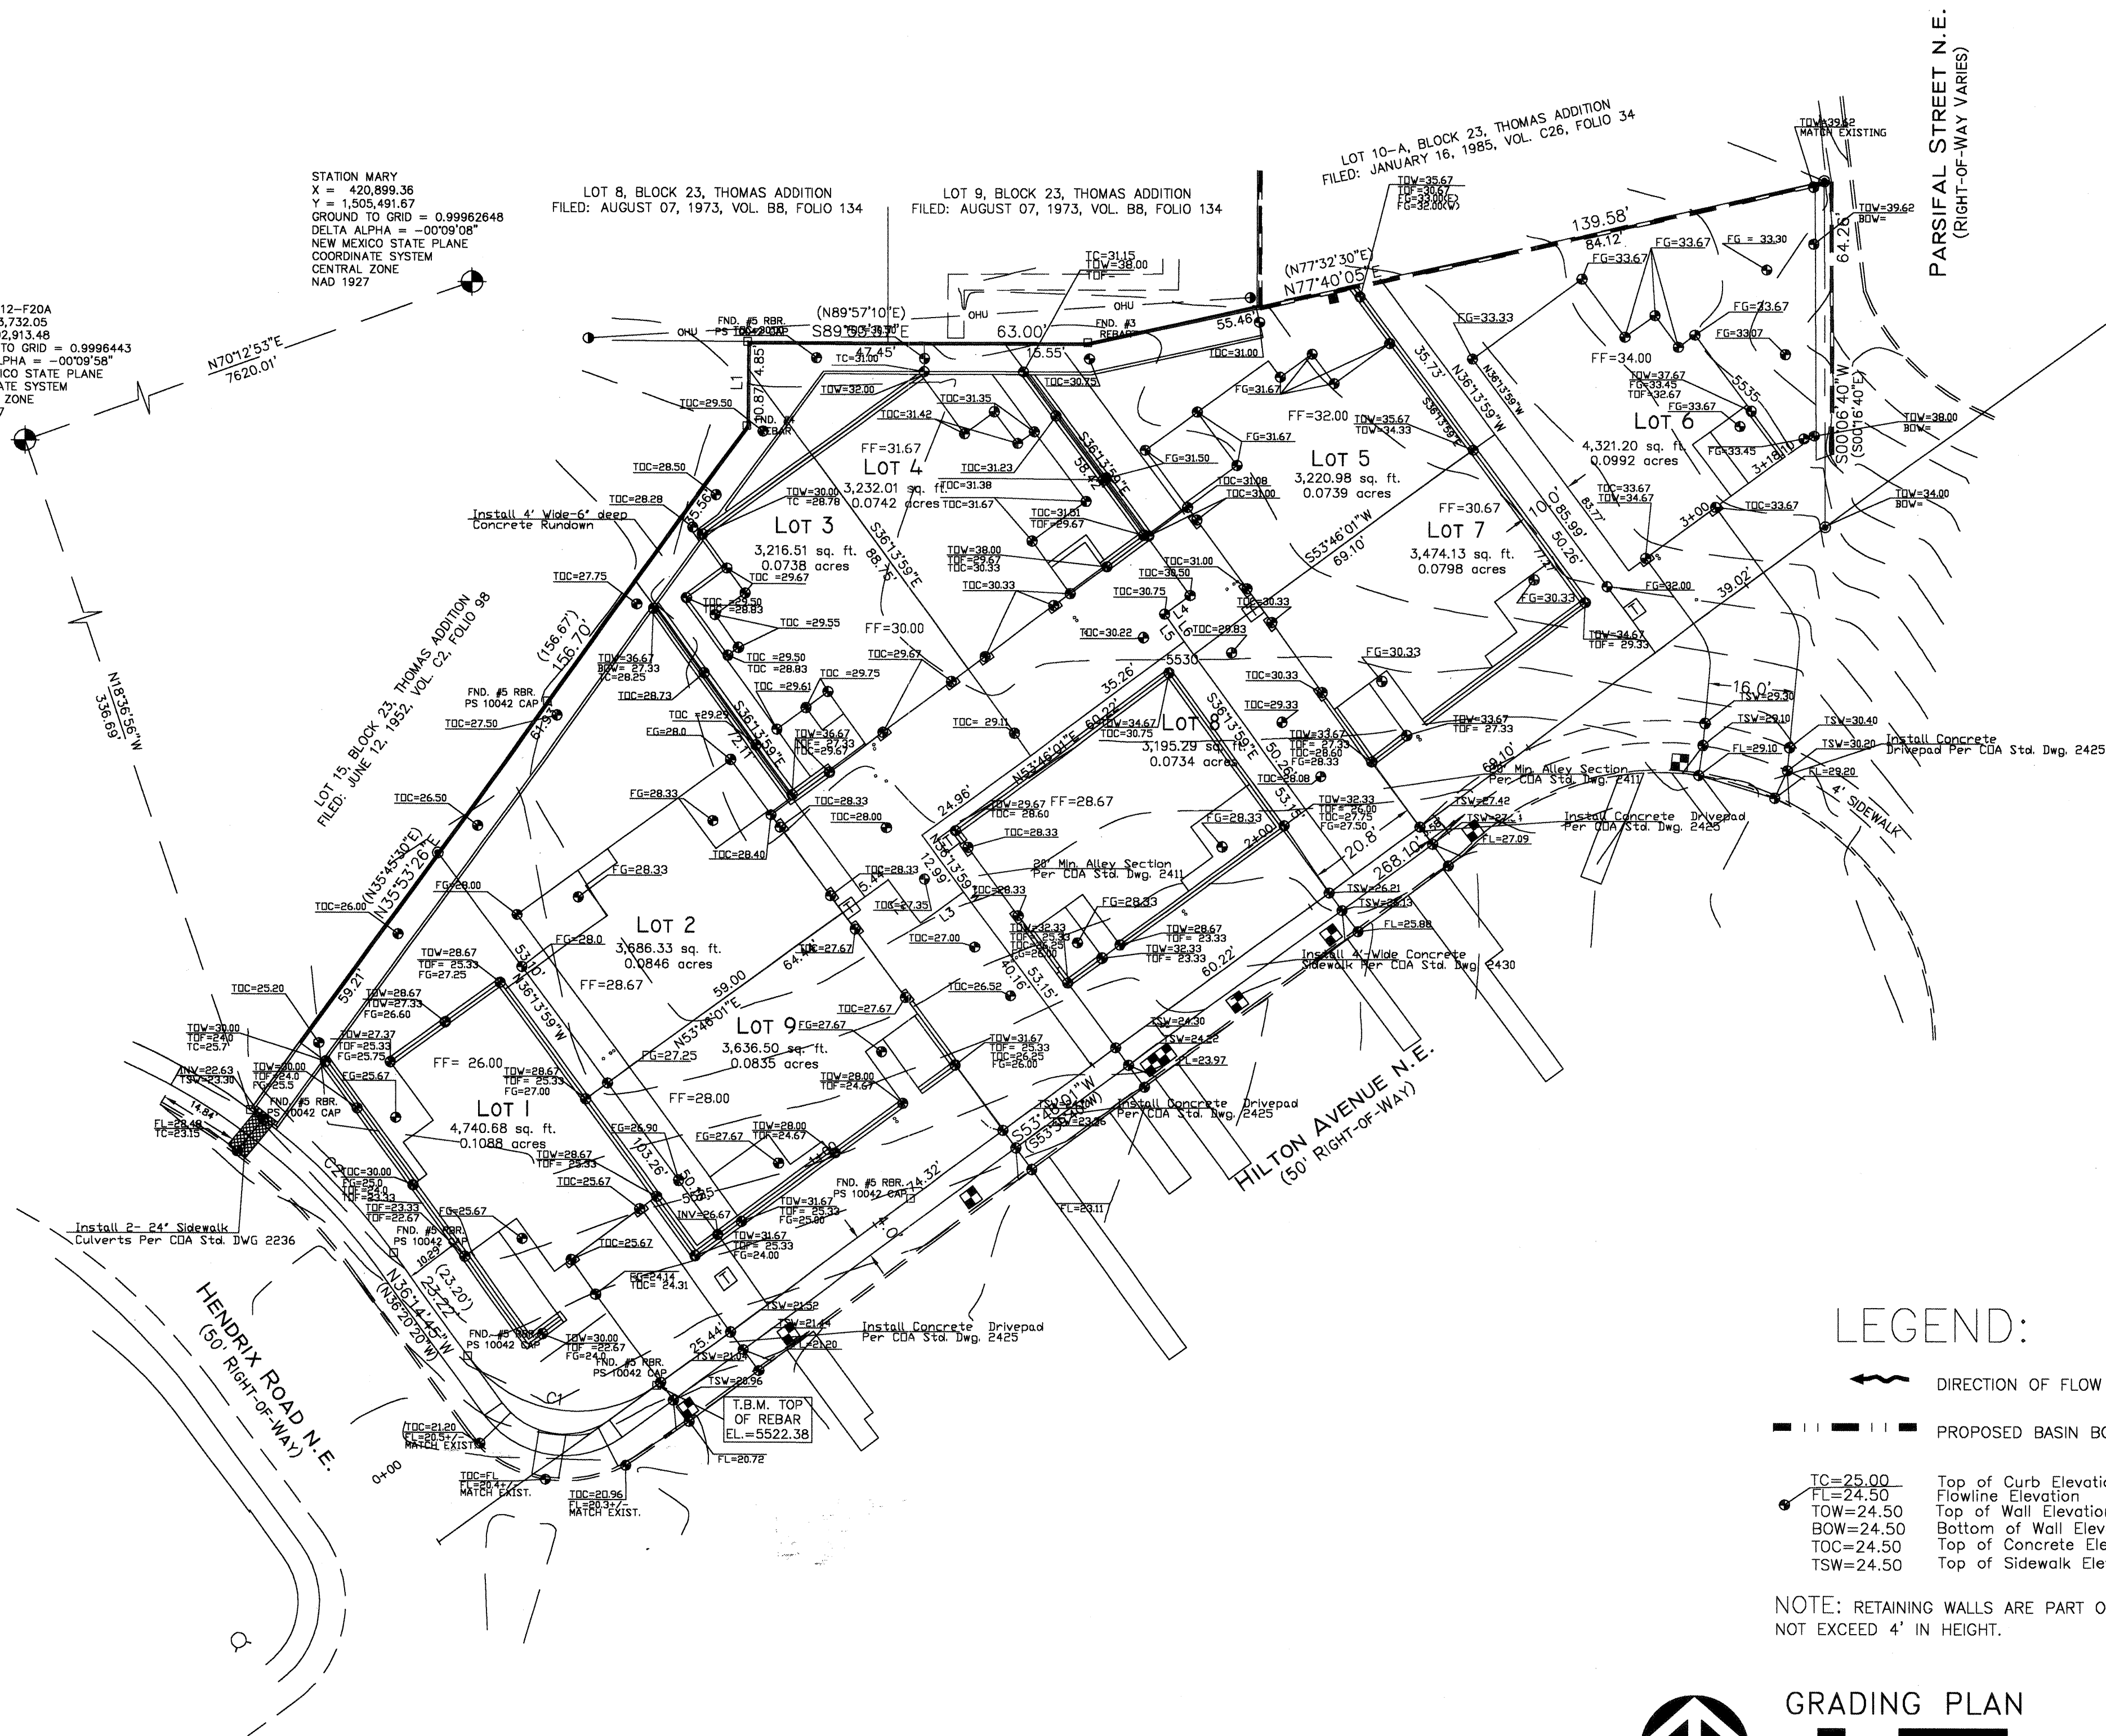

LEGEND:

- DIRECTION OF FLOW
- PROPOSED BASIN BOUNDARY
- TC=25.00 Top of Curb Elevation
- FL=24.50 Flowline Elevation
- TOW=24.50 Top of Wall Elevation
- BOW=24.50 Bottom of Wall Elevation
- TCC=24.50 Top of Concrete Elevation
- TSW=24.50 Top of Sidewalk Elevation

NOTE: RETAINING WALLS ARE PART OF THE BUILDING STEM WALLS AND WILL NOT EXCEED 4' IN HEIGHT.

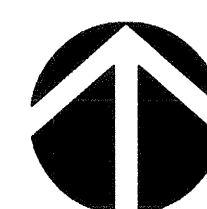

GRADING PLAN

0 10' 20' 40' 80'
SCALE: 1"=20'

GENERAL NOTES:

- See sheet CG.0 for complete list of general notes and symbol/linetype legend that apply to all sheets.
- Surface features associated with underground utilities are shown on paving plans for clarity. See applicable utility plans for construction notes and details.
- Contractor shall field verify site for existing conditions (spoils, borrow areas, etc.) prior to bidding earthwork quantities.
- Contractor to reference Architectural specifications and soils report for recommendations on building pad earthwork, concrete and asphalt sections.
- Contractor to reference C1.1 for site dimensions.
- Contractor to follow recommendations of Geotechnical Report prepared by Vinyard & Associates (dated 8/9/05) for all earthwork operations. Contractor to contact Vinyard & Associates for acceptable compaction methods for all backfill and compaction operations when earthwork operations abuts neighboring structures.


AS-BUILT INFORMATION		BENCH MARKS		SURVEY INFORMATION		ENGINEER'S SEAL	
CONTRACTOR	DATE	DATE	DATE	NO.	BY	NO.	BY
WILLIAM LTD CO.	5/07	DATE	DATE				
WORK	DATE	DATE	DATE				
SPREAD BY	DATE	DATE	DATE				
ACCEPTANCE BY	DATE	DATE	DATE				
FIELD	DATE	DATE	DATE				
DRAWINGS	DATE	DATE	DATE				
CORRECTED BY	DATE	DATE	DATE				
RECORDED BY	DATE	DATE	DATE				
NO.	DATE	DATE	DATE				



CITY OF ALBUQUERQUE PUBLIC WORKS DEPARTMENT ENGINEERING DEVELOPMENT GROUP	
TITLE: GRADING PLAN - FOR INFORMATION ONLY HILTON AVE. LOFTS	
DESIGN REVIEW COMMITTEE	CITY ENGINEER APPROVAL
CITY PROJECT NO. 770681	ZONE MAP NO. G-20
SHEET 4	OF 4

07-10-2005
10:00 AM

PLAT OF
LOTS 1 THROUGH 9
HILTON AVENUE LOFTS
SECTION 5, T. 10 N., R. 4 E., N.M.P.M.
CITY OF ALBUQUERQUE
BERNALILLO COUNTY, NEW MEXICO
AUGUST 2005
SHEET 3 OF 3

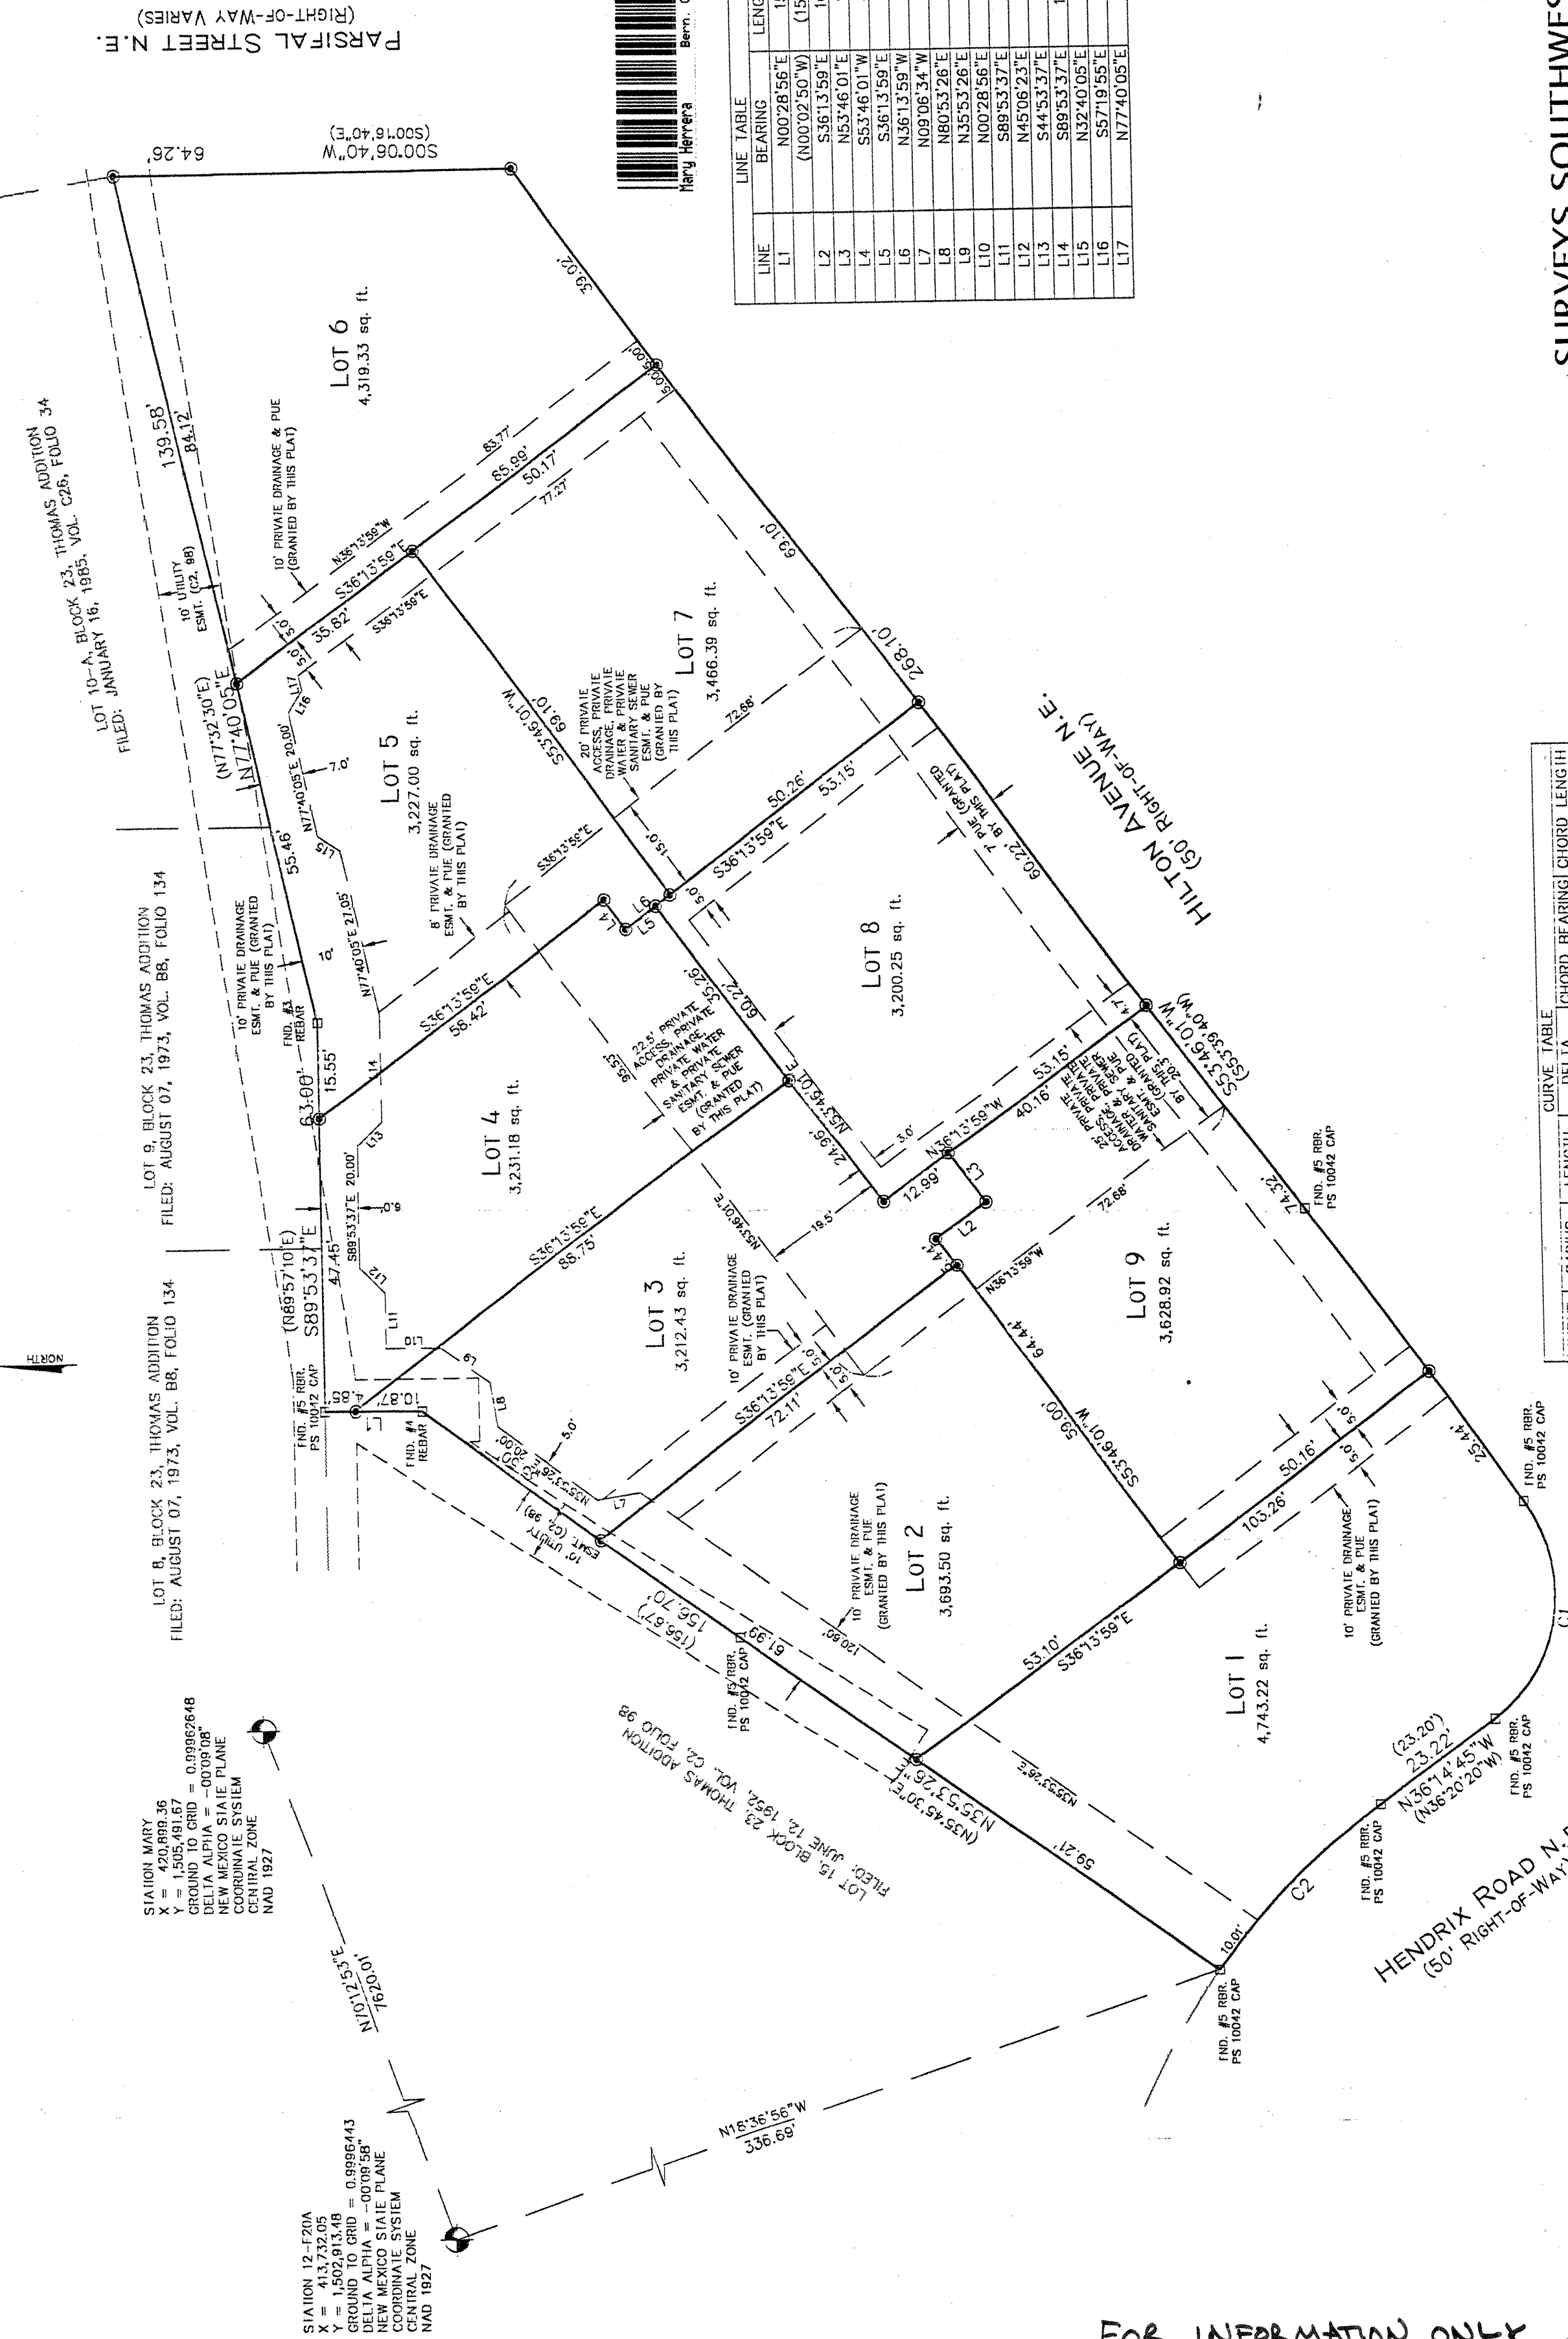


28651724
Page 3 of 3
12/6/2005 02:42P
Bert. Co. Plat R 17.98 B-2865 P-385

LINE	BEARING	LENGTH
L1	N00°28'55"E	15.72
L2	(N00°02'50"W) (15.95)	10.04
L3	S36°13'59"E	5.87
L4	N36°14'01"W	5.87
L5	S36°13'59"E	6.11
L6	N36°13'59"E	9.09
L7	N09°06'34"W	7.07
L8	N80°53'26"E	7.07
L9	N35°53'26"E	8.98
L10	N35°53'26"E	8.98
L11	S89°53'37"E	8.76
L12	N45°06'23"E	5.66
L13	S44°53'37"E	5.66
L14	S89°53'37"E	17.39
L15	N32°40'05"E	4.24
L16	S32°40'05"E	4.24
L17	N77°40'05"E	2.46

CURVE	RADIUS	LENGTH	CHORD	BEARING	CHORD LENGTH
C1	25.00	39.27	80.00	N81°14'43"W	35.36
C2	119.80	37.48	175.52	N45°19'11"W	37.34

SURVEYS SOUTHWEST LTD.
333 LOMAS BLVD., N.E.
ALBUQUERQUE, NEW MEXICO
87102
PHONE: (505) 998-0303
FAX: (505) 998-0306
TION R4E SEC. 5

FOR INFORMATION ONLY

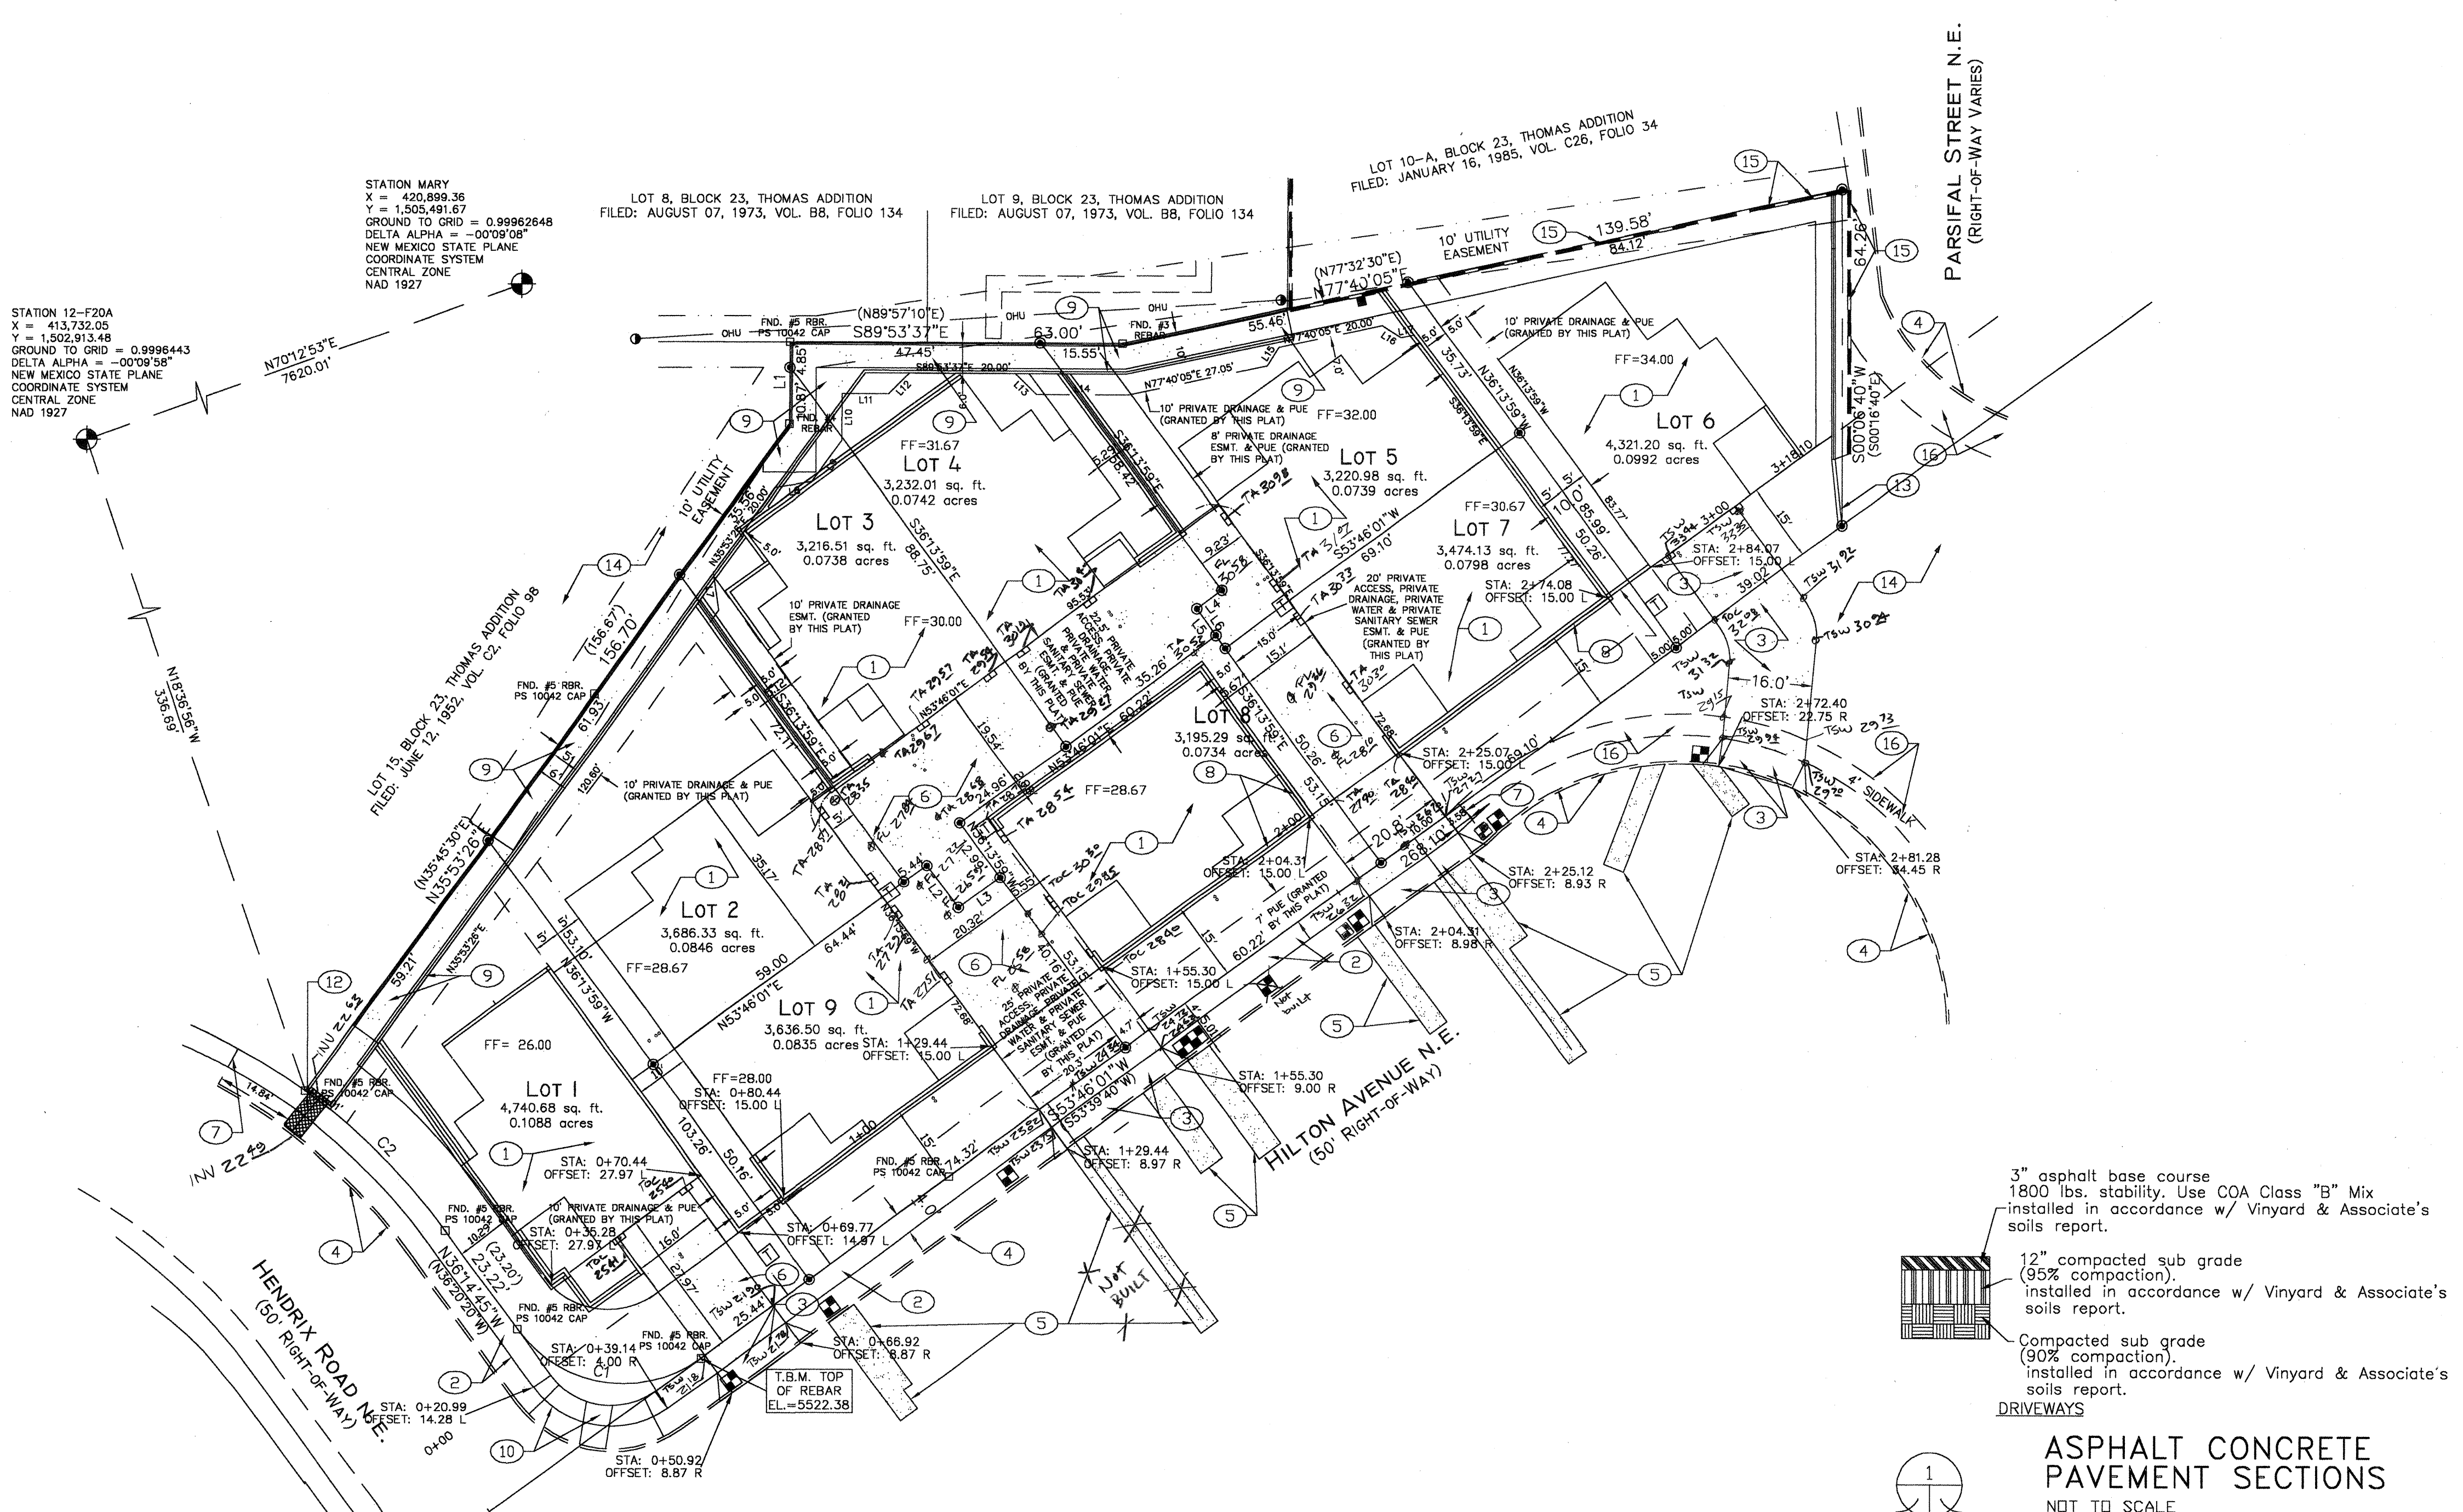

STATION 12-F20A
X = 413,732.05
Y = 1,502,913.48
GROUND TO GRID = 0.9996443
DELTA ALPHA = -00'09.58"
NEW MEXICO STATE PLANE
COORDINATE SYSTEM
CENTRAL ZONE
NAD 1927

STATION MARY
X = 420,899.36
Y = 1,505,491.67
GROUND TO GRID = 0.99962648
DELTA ALPHA = -00'09.08"
NEW MEXICO STATE PLANE
COORDINATE SYSTEM
CENTRAL ZONE
NAD 1927

LOT 8, BLOCK 23, THOMAS ADDITION
FILED: AUGUST 07, 1973, VOL. 88, FOLIO 134

LOT 9, BLOCK 23, THOMAS ADDITION
FILED: AUGUST 07, 1973, VOL. 88, FOLIO 134

LOT 10-A, BLOCK 23, THOMAS ADDITION
FILED: JANUARY 16, 1985, VOL. C26, FOLIO 34

AS INDICATED BY THE AS-BUILT INFORMATION SHOWN HEREON,
THIS PROJECT APPEARS TO HAVE BEEN CONSTRUCTED IN
SUBSTANTIAL COMPLIANCE WITH THE INTENT OF THE APPROVED
WORK ORDER PLANS.
COLLECTION OF THE AS-BUILT INFORMATION WAS PERFORMED BY
SURVEYS SOUTHWEST ON 1/17/07, 4/12/07 & 4/13/07. THIS
CERTIFICATION DOES NOT ADDRESS OR EVALUATE ADA
ACCESSIBILITY ISSUES OR COMPLIANCE. THOSE RELYING ON THIS
RECORD DOCUMENT ARE ADVISED TO OBTAIN INDEPENDENT
VERIFICATION OF ITS ACCURACY BEFORE USING IT FOR ANY OTHER
PURPOSE.

GUY C. JACKSON, NMPE 13289
DATE 5-15-07
GUY C. JACKSON, NMPE 13289
REGISTERED PROFESSIONAL ENGINEER
NEW MEXICO
13289


3" asphalt base course
1800 lbs. stability. Use COA Class "B" Mix
installed in accordance w/ Vinyard & Associate's
soils report.

12" compacted sub grade
(95% compaction).
installed in accordance w/ Vinyard & Associate's
soils report.


Compacted sub grade
(90% compaction).
installed in accordance w/ Vinyard & Associate's
soils report.

DRIVEWAYS

ASPHALT CONCRETE
PAVEMENT SECTIONS
NOT TO SCALE

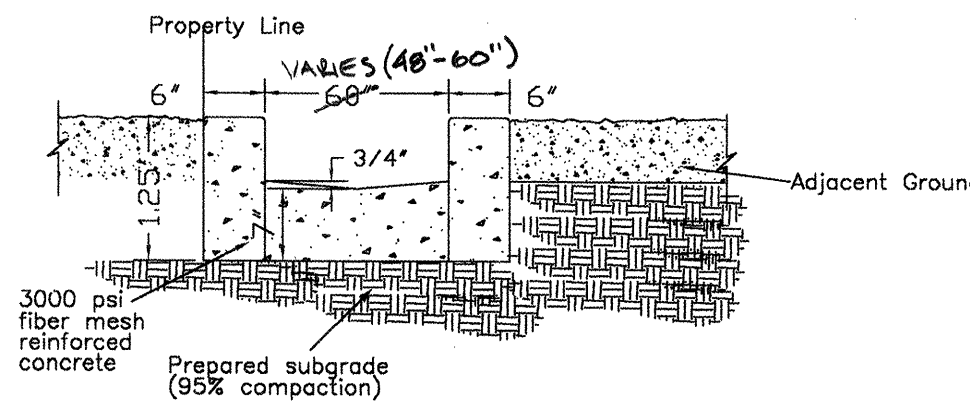

72" CONCRETE RUNDOWN
NOT TO SCALE

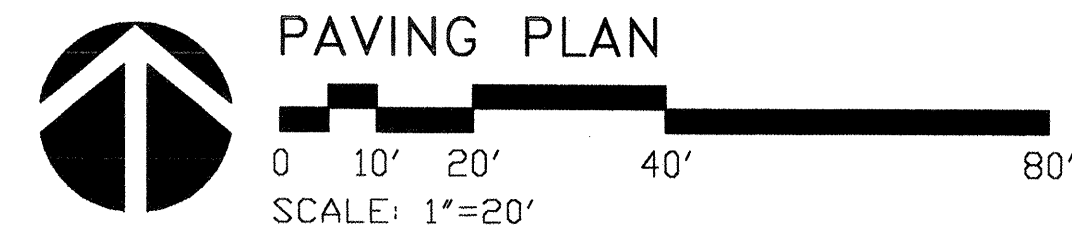


SITE PLAN GENERAL NOTES:			
A.	See cover sheet for reference to COA standard specifications that apply to all sheets.	AS-BUILT INFORMATION	CONTRACTOR NAILMAN L. TD. LO. DATE 5/07
B.	Surface features associated with underground utilities are shown on paving plans for clarity.	BENCH MARKS	WORKS BY SURVEYS SW DATE 11/06
C.	Curve and line labels are referenced from the flowline of curb or the face of sidewalk.	SURVEY INFORMATION	INSPECTORS ACCEPTANCE BY GJA, LLC DATE 5/07
D.	Proof roll building and all parking areas. Notify Engineer or Architect of any unacceptable areas.	FIELD NOTES	VERIFICATION BY GJA, LLC DATE 5/07
E.	Edge of new pavement to be flush with existing pavement.	ENGINEER'S SEAL	DESIGNED BY GJA DATE 12-05
F.	All sidewalk curb and gutter street paving, curb cuts, driveway approaches, handicap ramps, etc., constructed outside the property line in the right-of-way shall conform to all City of Albuquerque Public Works specifications and requirements.		DRAWN BY GJA DATE 12-05
G.	For areas outside the property lines repair and/or replace all damage done to existing elements (sidewalks, paving, landscaping, etc.) as required by owner and/or governing authority.		CHECKED BY GJA DATE 12-05
H.	See building permit plans for on-site construction.		

SITE PLAN KEYED NOTES:			
1.	Proposed residence. Not in Contract.		
2.	Construct 4'-wide concrete sidewalk per COA STD. DWG 2430. See Sheet C-4 for spot elevations.		
3.	Construct concrete driveway per COA STD. DWG 2425.		
4.	Protect existing concrete curb & gutter to remain.		
5.	Sawcut, remove and replace existing asphalt per COA STD. DWG 2465.		
6.	Private asphalt driveway to be built under building permit per Detail 1 this sheet. Not in contract.		
7.	End of new concrete sidewalk limits.		
8.	New retaining wall with garden wall. See building permit structural plans for details. not in contract.		
9.	Construct concrete rundown channel per detail 2 shown on this sheet. SEE SHEET C-4 FOR SPOT ELEVATIONS		
10.	Construct handicap ramp per details shown on COA STD DWG 2441-Case II. Construct ramp w/ truncated domes.		
11.	Not used.		
12.	Construct 2-24" sidewalk culvert per COA STD. DWG 2236. Invert In =22.63, Invert out =22.49		
13.	New retaining wall with Architectural steel grill fencing. See Structural and Architectural plans.		
14.	Protect adjacent property during construction.		
15.	Protect existing retaining walls to remain.		
16.	Protect existing sidewalk to remain.		

CITY OF ALBUQUERQUE PUBLIC WORKS DEPARTMENT ENGINEERING DEVELOPMENT GROUP			
TITLE: PAVING PLAN HILTON AVE. LOFTS			
DESIGN REVIEW COMMITTEE	CITY ENGINEER APPROVAL	MO./DAY/YR.	MO./DAY/YR.
APPROVE	CITY ENGINEER		
REVIEW COMMITTEE			
CITY PROJECT NO.	ZONE MAP NO.	SHEET	OF
770681	G-20	5	6
		C5	

X:\XXXX\XXXX\X.dwg

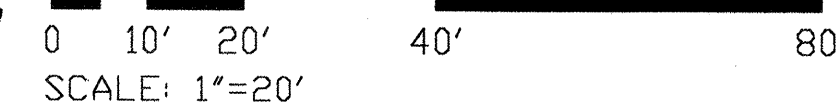

SHEET 6 OF 6
C6