
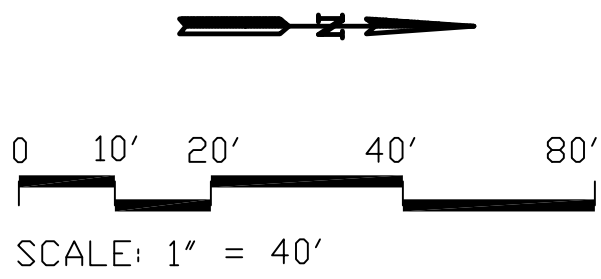
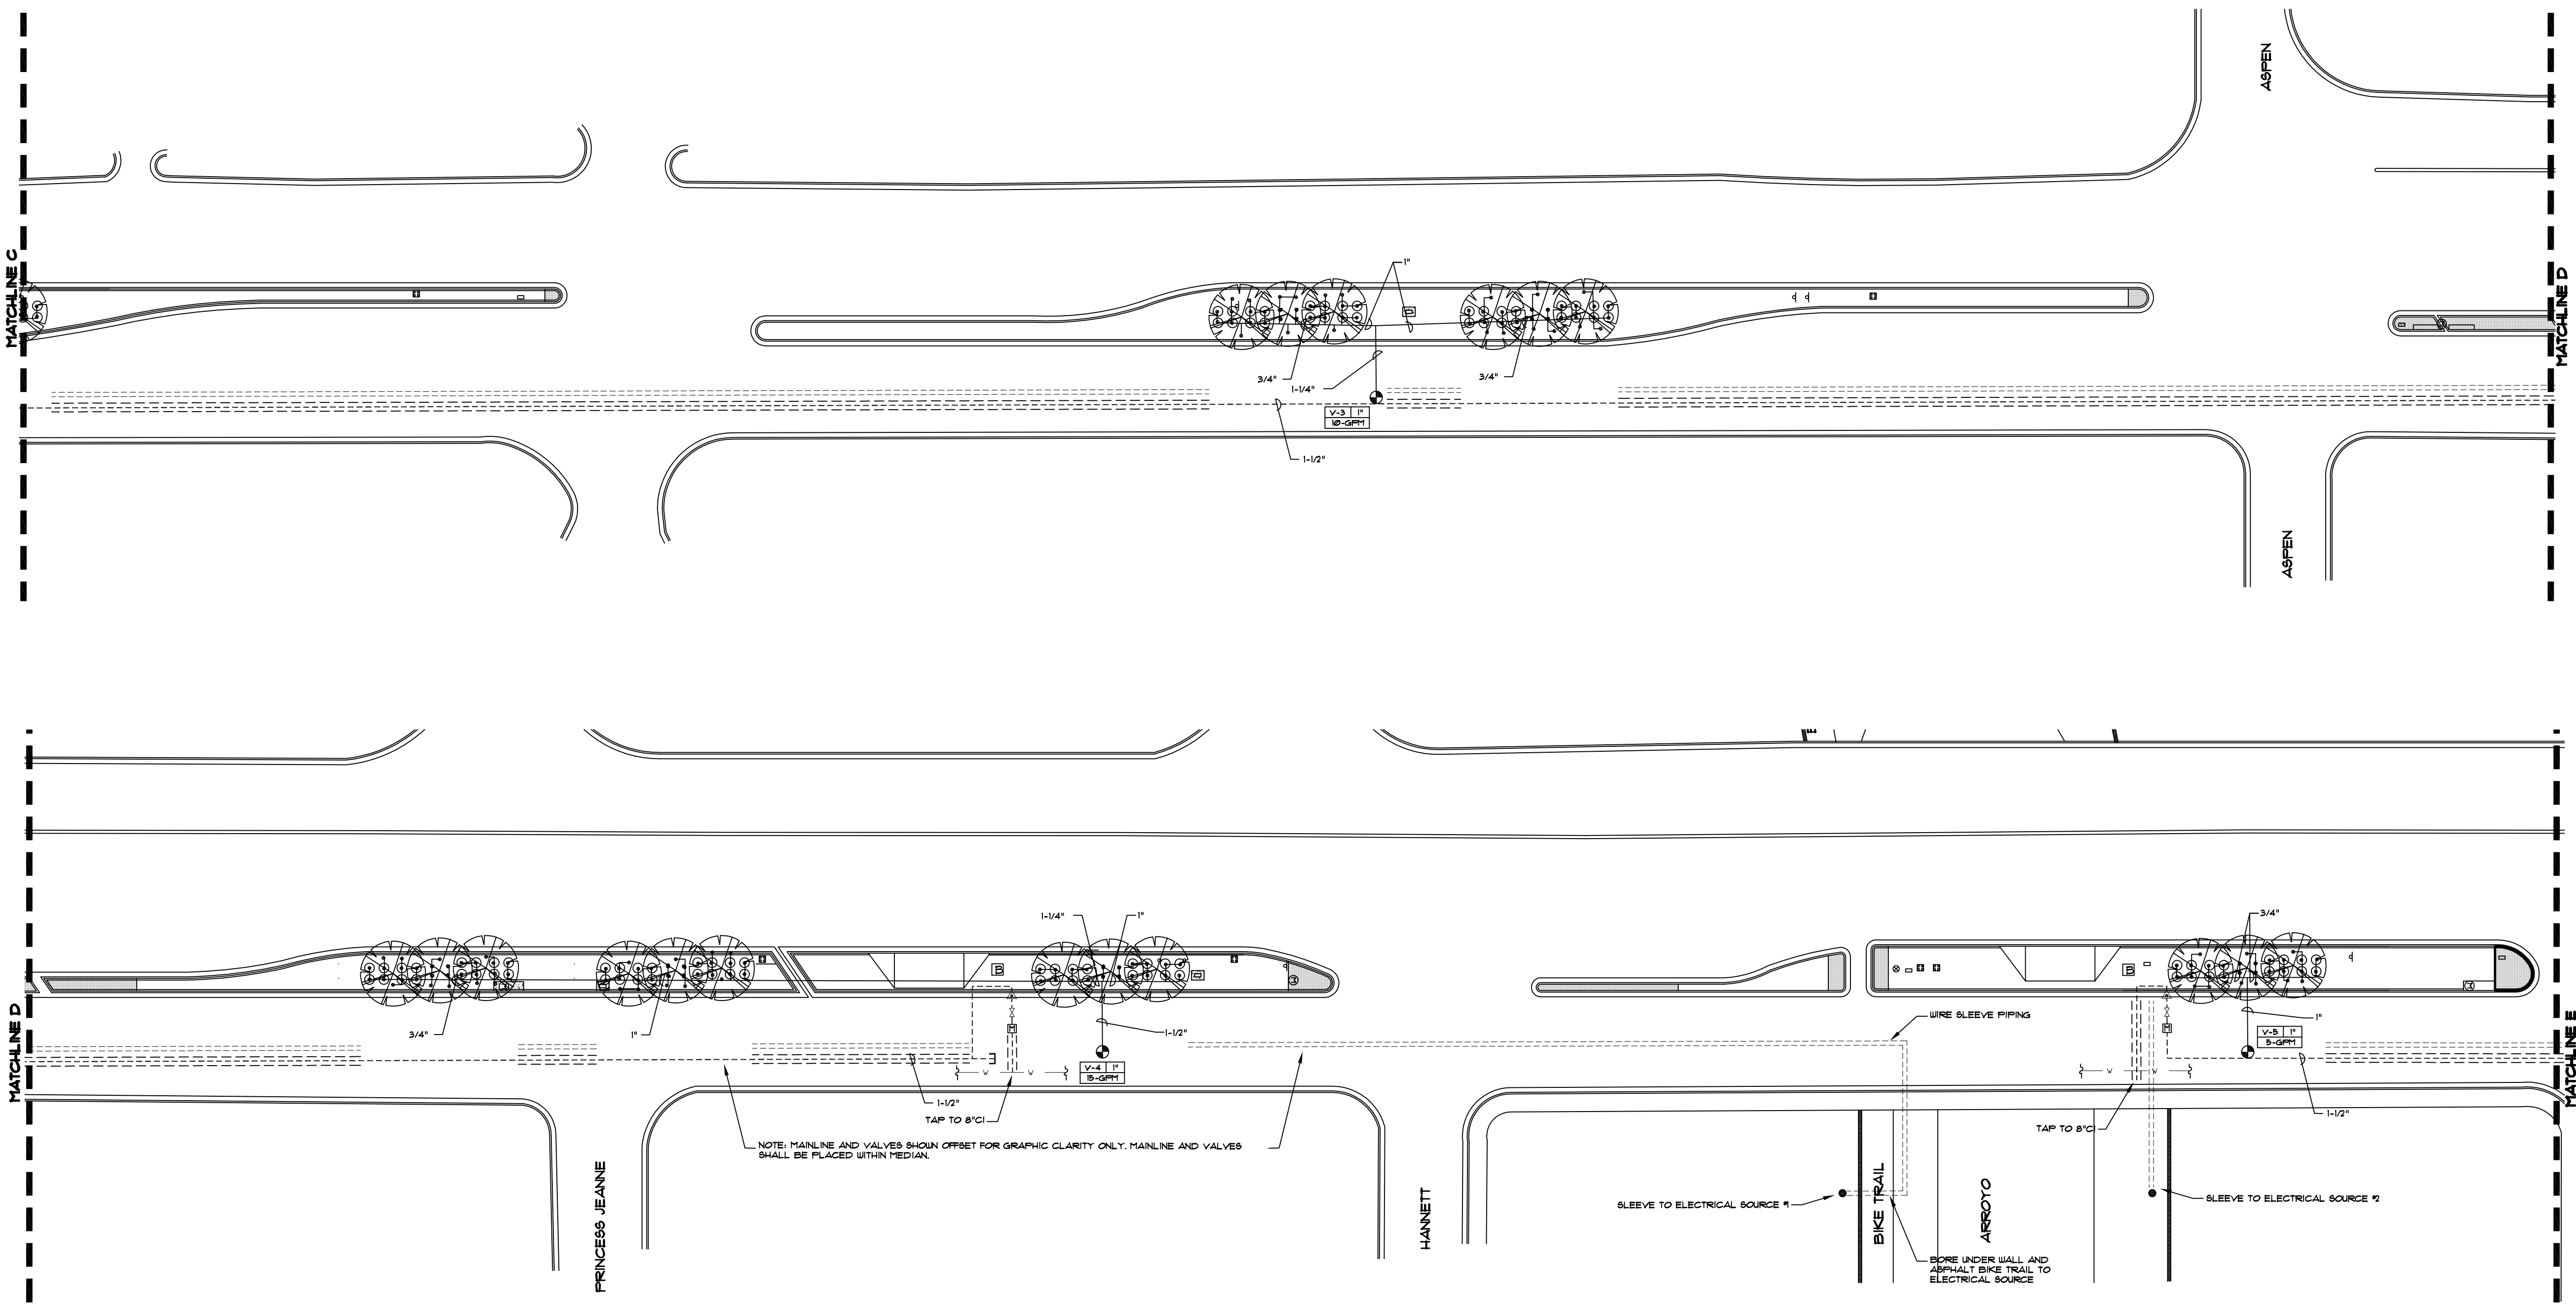


ARCHITECTURAL SEAL

[illegible]

	CITY OF ALBUQUERQUE CAPITAL IMPLEMENTATION PROGRAM DEPARTMENT OF MUNICIPAL DEVELOPMENT			
PROTOTYPE MEDIAN AND INTERSTATE LANDSCAPES FY06--A WYOMING BLVD. INDIAN SCHOOL TO I-40 PLANTING PLAN: WORK ORDER #9				
Design Review Committee	City Engineer Approval	Last Design Update	Mo./Day/Yr.	Mo./Day/Yr.
City Project No.		Zone Map No.	Sheet	
771507		J-19	1 OF 3	





IRRIGATION LEGEND

WATER METER, 15". INSTALLED PER COA DUG, 2362 OR 2363.

IRRIGATION MAIN LINE, 1.5", SCH 40 BELL END, SOLVENT WELD PVC. DEPTH OF BURY SHALL BE 28".

LATERAL PIPING, SCH. 40, BELL END, SOLVENT WELD PVC. DEPTH OF BURY, 18". SIZE PER PLAN.

MAIN LINE AND LATERAL SLEEVE PIPING, 2 SIZES LARGER THAN PIPE SIZE, CLASS 200, SDR-21, BELL-END, SOLVENT WELD PVC.

24-VOLT IRRIGATION WIRE SLEEVE PIPING, 2", CLASS 200, SDR-21, BELL-END, SOLVENT WELD PVC.

ISOLATION VALVE ASSEMBLY, 15". INSTALL PER C.O.A. DRAWING NO. 2107.

FEBCO 8251A-15" REDUCED PRESSURE PRINCIPAL BACKFLOW PREVENTER AND MASTER VALVE ASSEMBLY WITH BALL VALVES, INSTALLED IN HEATED AND INSULATED ENCLOSURE AND MASTER METER INSTALLED IN VALVE BOX PER DETAIL C/4. SIZE OF RP, MASTER VALVE, AND MASTER METER SHALL BE SAME AS LINE SIZE. ENCLOSURE SHALL BE SIZED TO ACCOMMODATE SIZE OF RP AND MASTER VALVE ASSEMBLY.

REMOTE CONTROL VALVE ASSEMBLY, RAINBIRD FEB PLASTIC BODY 24-VOLT AUTOMATIC VALVE, SIZE PER PLAN. INSTALL PER C.O.A. DRAWING NO. 2103. (SIMILAR - SEE IRRIGATION NOTES #25 AND #26, SHEET 2.)

SOLVENT WELD CAP, SCH. 40 PVC, LINE SIZE.

PRESSURE COMPENSATING BUBBLER ASSEMBLIES, RAIN BIRD 1400 SERIES, AS FOLLOWS: INSTALL PER C.O.A. DRAWING NUMBERS 2110, 2111, 2111-A AND 2112.

MODEL NO. GFM F91
1401 30

SCORPIO AC CONTROLLER

AS-BUILT
1/23/2008

MORROW REARDON
WILKINSON MILLER, LTD.,
LANDSCAPE ARCHITECTS

210 La Veta NE, Albuquerque, NM 87108
505.288.2206 FAX 505.265.9657
mrw@mrwm.com

CITY OF ALBUQUERQUE
CAPITAL IMPLEMENTATION PROGRAM
DEPARTMENT OF MUNICIPAL DEVELOPMENT

PROTOTYPE MEDIAN AND INTERSTATE LANDSCAPES FY06-A
WYOMING BLVD. INDIAN SCHOOL TO I-40
PLANTING PLAN: WORK ORDER #9

Design Review Committee

City Engineer Approval

Mo./Day/Yr.


Mo./Day/Yr.

City Project No.
771507


Zone Map No.
J-19

Sheet
2 OF 3

REVISIONS		ARCHITECTURAL SEAL		SURVEY INFORMATION		BENCH MARKS		AS-BUILT INFORMATION	
NO.		DATE		FIELD NOTES		CONTRACTOR		CONTRACTOR	
BY		DATE		NO.		WORKED BY		LEE LANDSCAPES, INC.	
REMARKS		DATE		BY		INSPECTOR'S		DATE	
NO.		DATE		NO.		ACCEPTANCE BY		DATE	
DATE		DATE		DATE		DATE		DATE	
DRAWN BY		DATE		DRAWN BY		DATE		DATE	
CHECKED BY		DATE		CHECKED BY		DATE		DATE	
DATE		DATE		DATE		DATE		DATE	
DATE		DATE		DATE		DATE		DATE	
DATE		DATE		DATE		DATE			

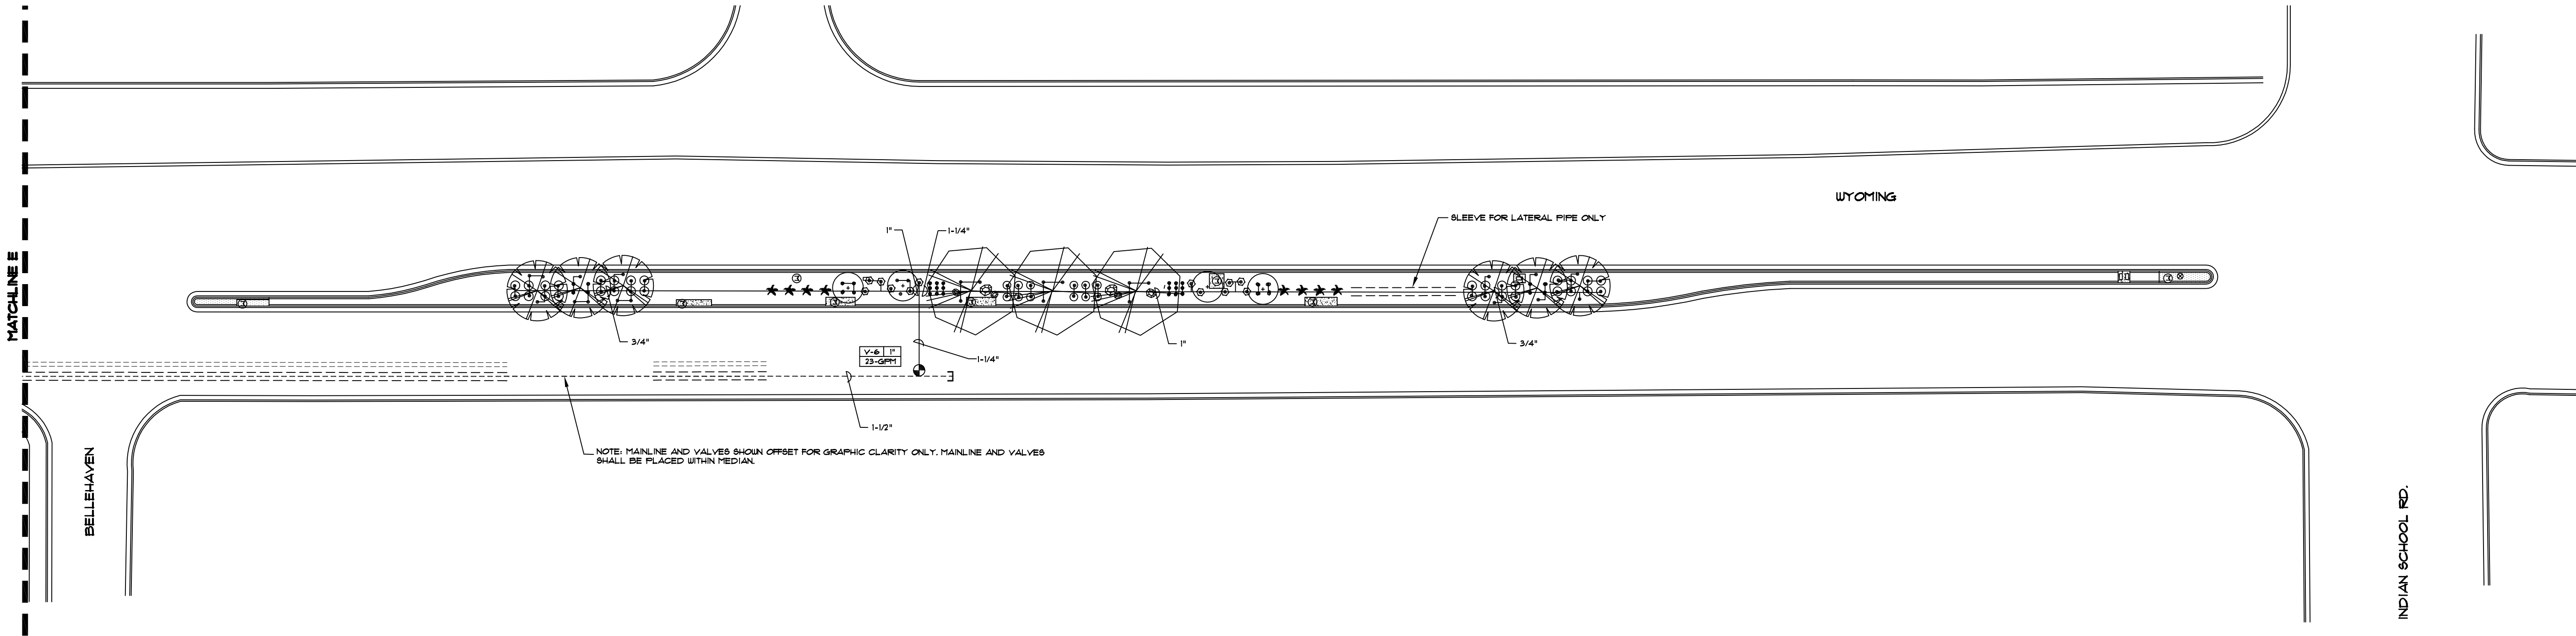

IRRIGATION LEGEND	
	WATER METER, 1.5", INSTALLED PER COA DIAG. 2362 OR 2363.
	IRRIGATION MAIN LINE, 1.5", SCH 40 BELL END, SOLVENT WELD PVC. DEPTH OF BURY SHALL BE 20".
	LATERAL PIPING, SCH. 40, BELL END, SOLVENT WELD PVC. DEPTH OF BURY, 18". SIZE PER PLAN.
	MAIN LINE AND LATERAL SLEEVE PIPING, 2 SIZES LARGER THAN PIPE SIZE, CLASS 200, SDR-21, BELL-END, SOLVENT WELD PVC.
	24-VOLT IRRIGATION WIRE SLEEVE PIPING, 2", CLASS 200, SDR-21, BELL-END, SOLVENT WELD PVC.
	ISOLATION VALVE ASSEMBLY, 1.5". INSTALL PER C.O.A. DRAWING NO. 2101.
	FEBCO 825YA-15" REDUCED PRESSURE PRINCIPAL BACKFLOW PREVENTER AND MASTER VALVE ASSEMBLY WITH BALL VALVES, INSTALLED IN HEATED AND INSULATED ENCLOSURE AND MASTER METER INSTALLED IN VALVE BOX PER DETAIL C14. SIZE OF RP MASTER VALVE, AND MASTER METER SHALL BE SAME AS LINE SIZE ENCLOSURE SHALL BE SIZED TO ACCOMMODATE SIZE OF RP AND MASTER VALVE ASSEMBLY.
	REMOTE CONTROL VALVE ASSEMBLY, RAINBIRD PEB PLASTIC BODY 24-VOLT AUTOMATIC VALVE, SIZE PER PLAN, INSTALL PER C.O.A. DRAWING NO. 2103. (SIMILAR - SEE IRRIGATION NOTES #25 AND #26, SHEET 2.)
	SOLVENT WELD CAP, SCH. 40 PVC, LINE SIZE.
	PRESSURE COMPENSATING BUBBLER ASSEMBLIES, RAIN BIRD 1400 SERIES, AS FOLLOWS: INSTALL PER C.O.A. DRAWING NUMBERS 2110, 2111, 2111-A AND 2112. MODEL NO. GPM FS1 1401 25 30
	SCORPIO AC CONTROLLER.

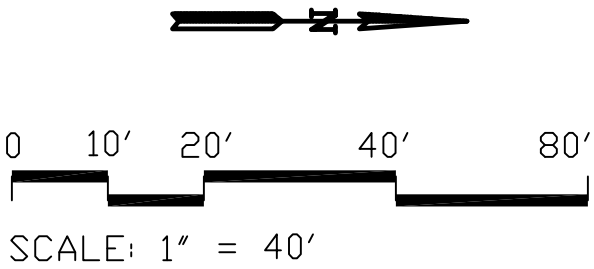


AS-BUILT
1/23/2008





**MORROW REARDON
WILKINSON MILLER, LTD.,
LANDSCAPE ARCHITECTS**
210 La Veta NE, Albuquerque, NM 87108
505.268.2206 FAX 505.265.9657
mrw@mrwnm.com

		CITY OF ALBUQUERQUE CAPITAL IMPLEMENTATION PROGRAM DEPARTMENT OF MUNICIPAL DEVELOPMENT	
PROTOTYPE MEDIAN AND INTERSTATE LANDSCAPES FY06-A WYOMING BLVD. INDIAN SCHOOL TO I-40 PLANTING PLAN: WORK ORDER #9			
Design Review Committee	City Engineer Approval	Last Design Update	Mo./Day/Yr.
City Project No. 771507	Zone Map No. J-19	Sheet 3 OF 3	

REVISIONS		ARCHITECTURAL SEAL		SURVEY INFORMATION		BENCH MARKS		AS-BUILT INFORMATION	
				FIELD NOTES				CONTRACTOR	LEE LANDSCAPES, INC.
				NO.	BY	DATE		WORKED BY	
								INSPECTOR'S	
								ACCEPTANCE BY	
								DATE	
								VERIFICATION BY	
								DATE	
								DRAWINGS	
								NO.	
								DATE	
								1/23/08	
								DESIGNED BY	
								NO.	
								DATE	
								1/23/08	
								RECORDED BY	
								DATE	
								NO.	
								DATE	
								1/23/08	