



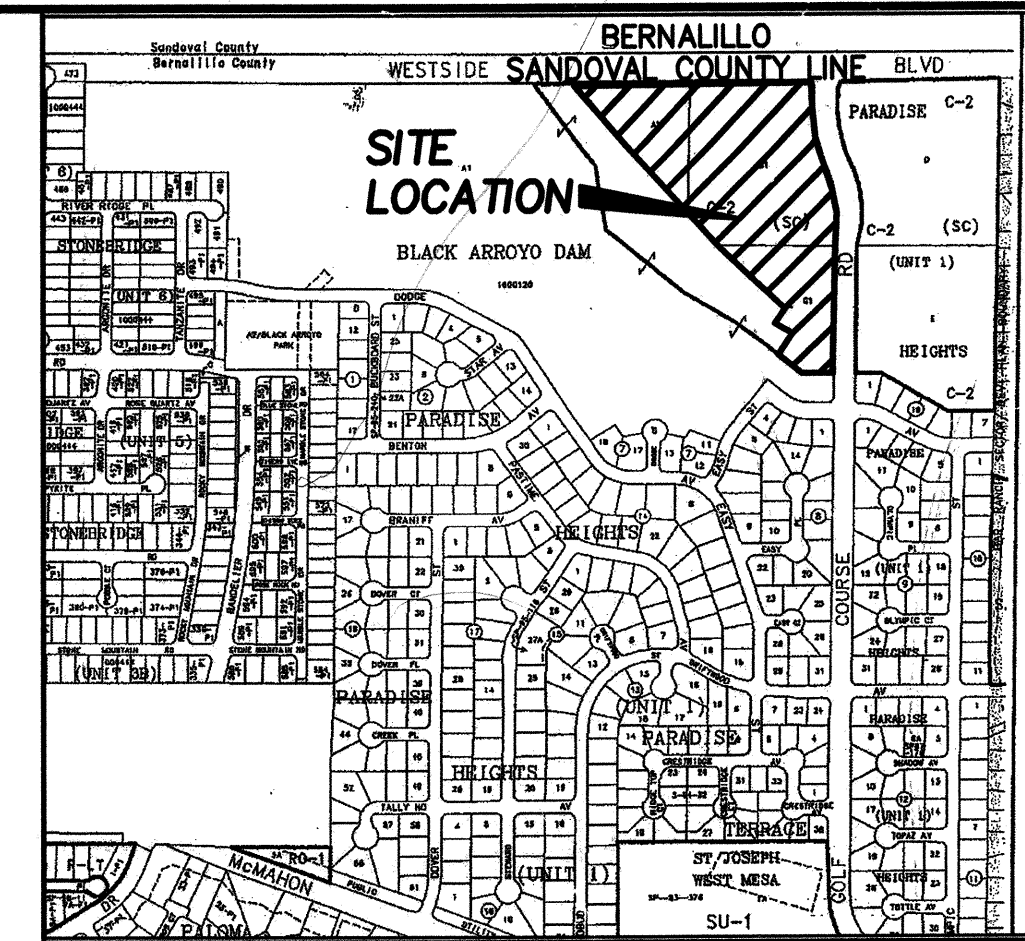

CITY OF ALBUQUERQUE PUBLIC WORKS DEPARTMENT

CONSTRUCTION PLANS FOR

VJW STORAGE INC. INFRASTRUCTURE IMPROVEMENTS

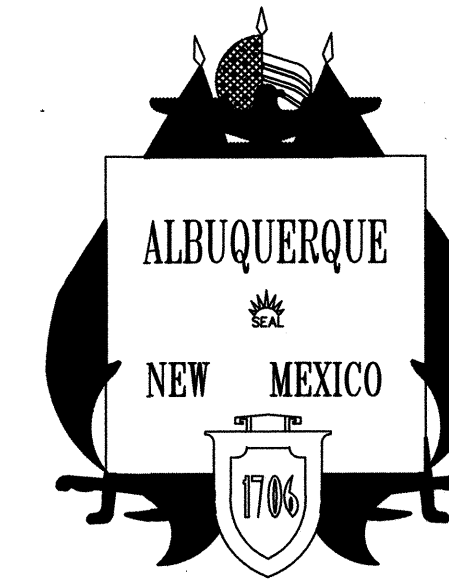

VICINITY MAP
ZONE ATLAS MAP NO. A-12

INDEX

DESCRIPTION	SHEET NO.
COVER SHEET	1
PLAT	2
PLAT	3
GENERAL NOTES	4
OVERALL GRADING AND DRAINAGE PLAN	5
OVERALL MASTER PAVING PLAN	6
WESTSIDE BOULEVARD & GOLF COURSE ROAD ENTRANCE PLAN & PROFILE	7
TYPICAL SECTION & MISCELLANEOUS DETAILS	8
ACCESS ROAD PLAN & PROFILE	9
8" SANITARY SEWER PLAN & PROFILE	10
WESTSIDE BLVD. PLAN & PROFILE STA 69+70.98 TO STA 79+06.91	11
DRAINAGE IMPROVEMENTS	12
WESTSIDE BLVD. MEDIAN GEOMETRICS	13
PERMANENT SIGNING & STRIPPING STA 69+00 TO 86+75.99	14
TRANSPORTATION DETAILS	15
STORM DRAIN DETAILS	16
RCP CHANNEL PENETRATION NEW CHANNEL CONSTRUCTION: SKEW < 45°	17
FOR INFORMATION ONLY OVERALL CONCEPTUAL UTILITY PLAN	18
FOR INFORMATION ONLY OVERALL CONCEPTUAL UTILITY PLAN	19
FOR INFORMATION ONLY OVERALL CONCEPTUAL UTILITY PLAN	20
FOR INFORMATION ONLY MISCELLANEOUS DETAILS	21
FOR INFORMATION ONLY MISCELLANEOUS DETAILS	22

CERTIFICATE OF SUBSTANTIAL COMPLIANCE OF PLANS

"I, Benjamin M. Aragon, a duly qualified Registered Professional Land Surveyor under the laws of the State of New Mexico, do hereby certify that the 'as-built' information shown on these drawings was obtained from field construction and 'as-built' information shown on these drawings was added by me or under my supervision, and that this 'as-built' information is true and correct to the best of my knowledge and belief."

Benjamin M. Aragon
Benjamin M. Aragon, P.S. NM 15268



8-20-08
Date

CERTIFICATE OF SUBSTANTIAL COMPLIANCE OF PLANS

I, Mario Juarez-Infante of the firm Wilson & Company, a Registered Professional Engineer in the State of New Mexico, NMPE number 15340, do hereby certify, to the best of my knowledge and belief, that the infrastructure installed as part of this project has been inspected by me or by a qualified person under my direct supervision and has been constructed in accordance with the plans and specifications approved by the City Engineer and the original design intent of the approved plans has been met, except as noted by me on the as-built construction drawings. This Certification is based on site inspections by me or personnel under my direction and survey information provided by Timothy A. Smith, NMPS Number 7719.

Mario Juarez-Infante
Mario Juarez-Infante, PE



8/20/08
Date

APPROVED FOR CONSTRUCTION


John P. Kelly
JOHN P. KELLY, P.E.
EXECUTIVE ENGINEER
ALBUQUERQUE METROPOLITAN ARROYO FLOOD CONTROL AUTHORITY

DRB NO. 1004976

RECORD DRAWING
DATE 8/20/08

APPROVED AS RECORD DRAWINGS
DESIGN REVIEW SECTION
CITY CONSTRUCTION ENGINEER
Patricia A. ...
DATE: 11-24-2008


WILSON & COMPANY
4900 LANG AVE N.E.
SUITE 100
ALBUQUERQUE, NEW MEXICO 87109
(505) 348-4000
FAX (505) 348-4072
www.wilsonco.com

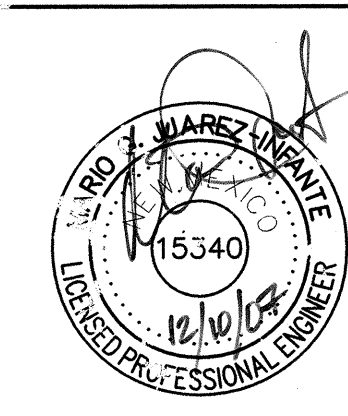

REV	SHEETS	CITY ENGINEER	DATE	USER DEPARTMENT	DATE	USER DEPARTMENT	DATE
EX	ENGINEERS	STAMP & SIGNATURE	APPROVALS	ENGINEER	DATE	*****	*****
			DRG Chairman	<i>W. Woodfall</i>	4/21/08	APPROVED FOR CONSTRUCTION	
			Transportation	<i>N/A</i>	3/26/08		
			Water/Wastewater	<i>N/A</i>	2-12-08		
			Hydrology	<i>Bradley A. Bishop</i>	12/10/07		
			Parks				
			Constr. Mngmt.				
			Constr. Coord.				
City Project No.						7718.83	Sheet 1 of 22

Detail Easements Granted by this Plat

Amended Plat of
Tracts A-1-A, B-1-A, B-1-B & C-1-A
Being a Replat of
Tracts A-1, B-1 & C-1
Black Arroyo Dam
Town of Alameda Grant
Projected Section 1
T.11N., R.2E. N.M.P.M.
City of Albuquerque
Bernalillo County, New Mexico
February 2007

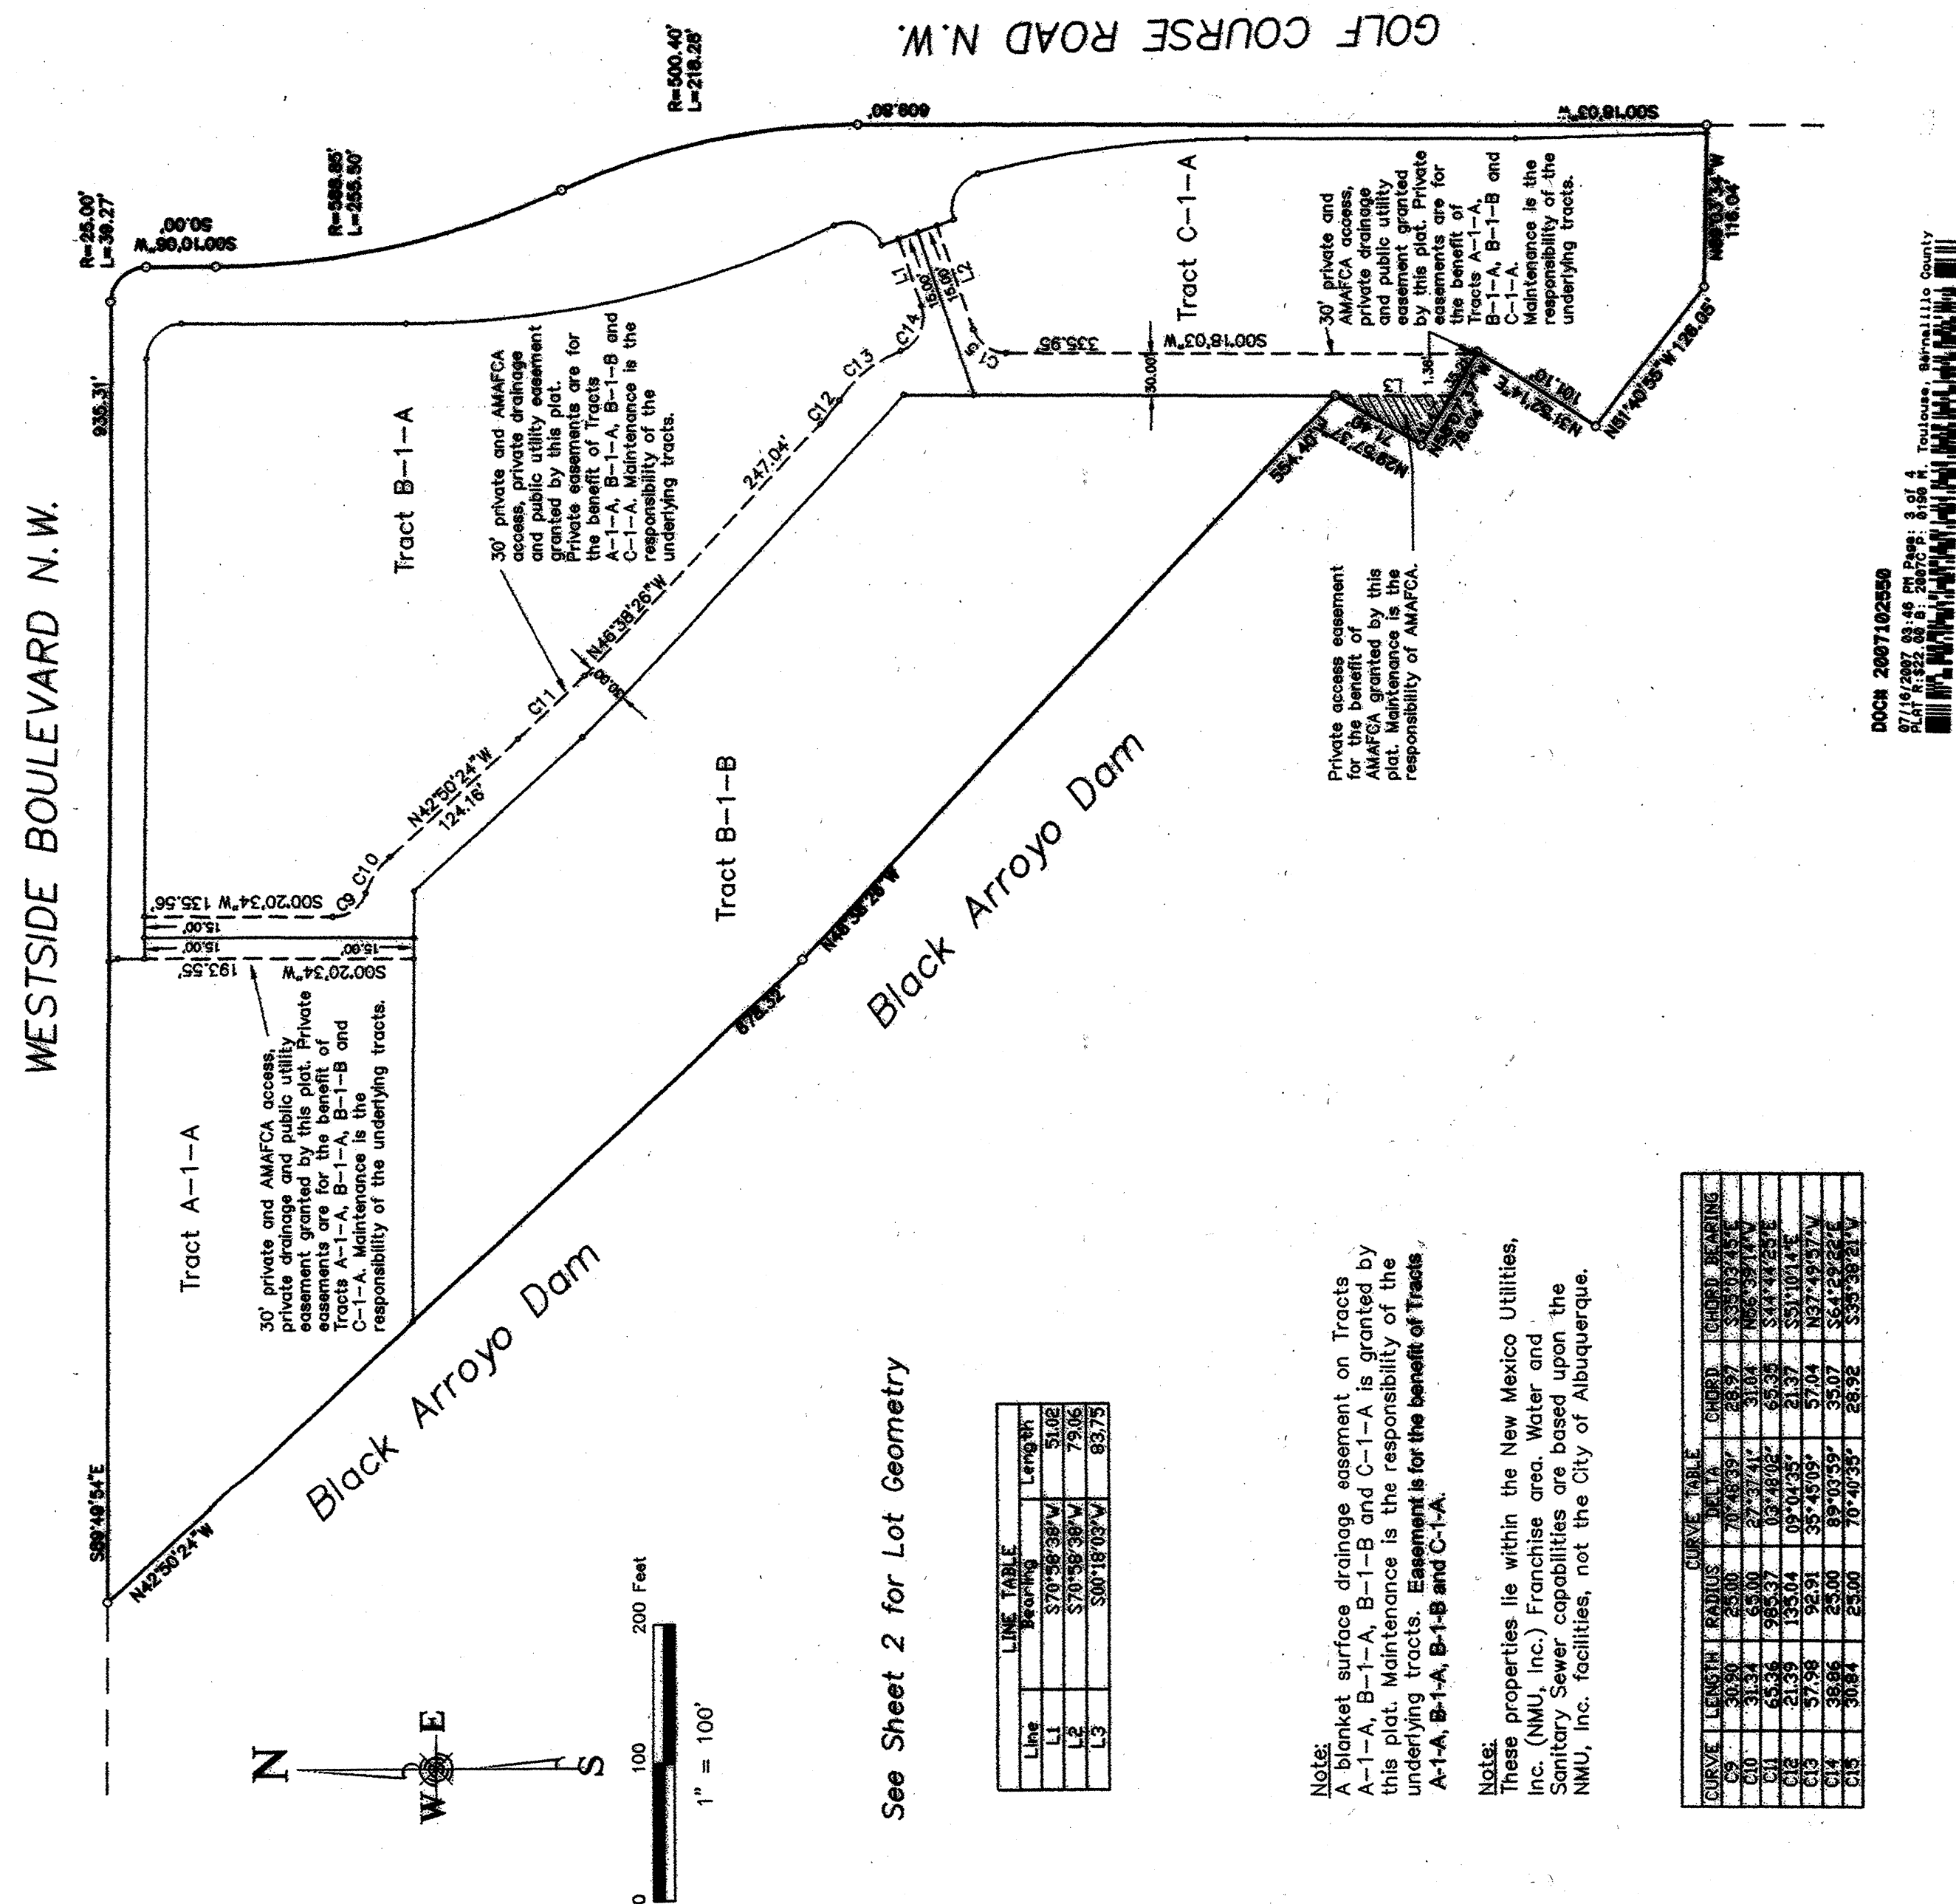


Forstbauer Surveying, L.L.C.
4116 Lomas Boulevard NE
Albuquerque, New Mexico 871
(505) 268-2112 Fax 268-2032

Sheet 3 of 4

Flood Plain Location

Amended Plat of
Tracts A-1-A, B-1-A, B-1-B & C-1-A
Being a Replat of
Tracts A-1, B-1 & C-1
Black Arroyo Dam
Town of Alameda Grant
Projected Section 1
T.11N., R.2E. N.M.P.M.
City of Albuquerque
Bernalillo County, New Mexico
February 2007

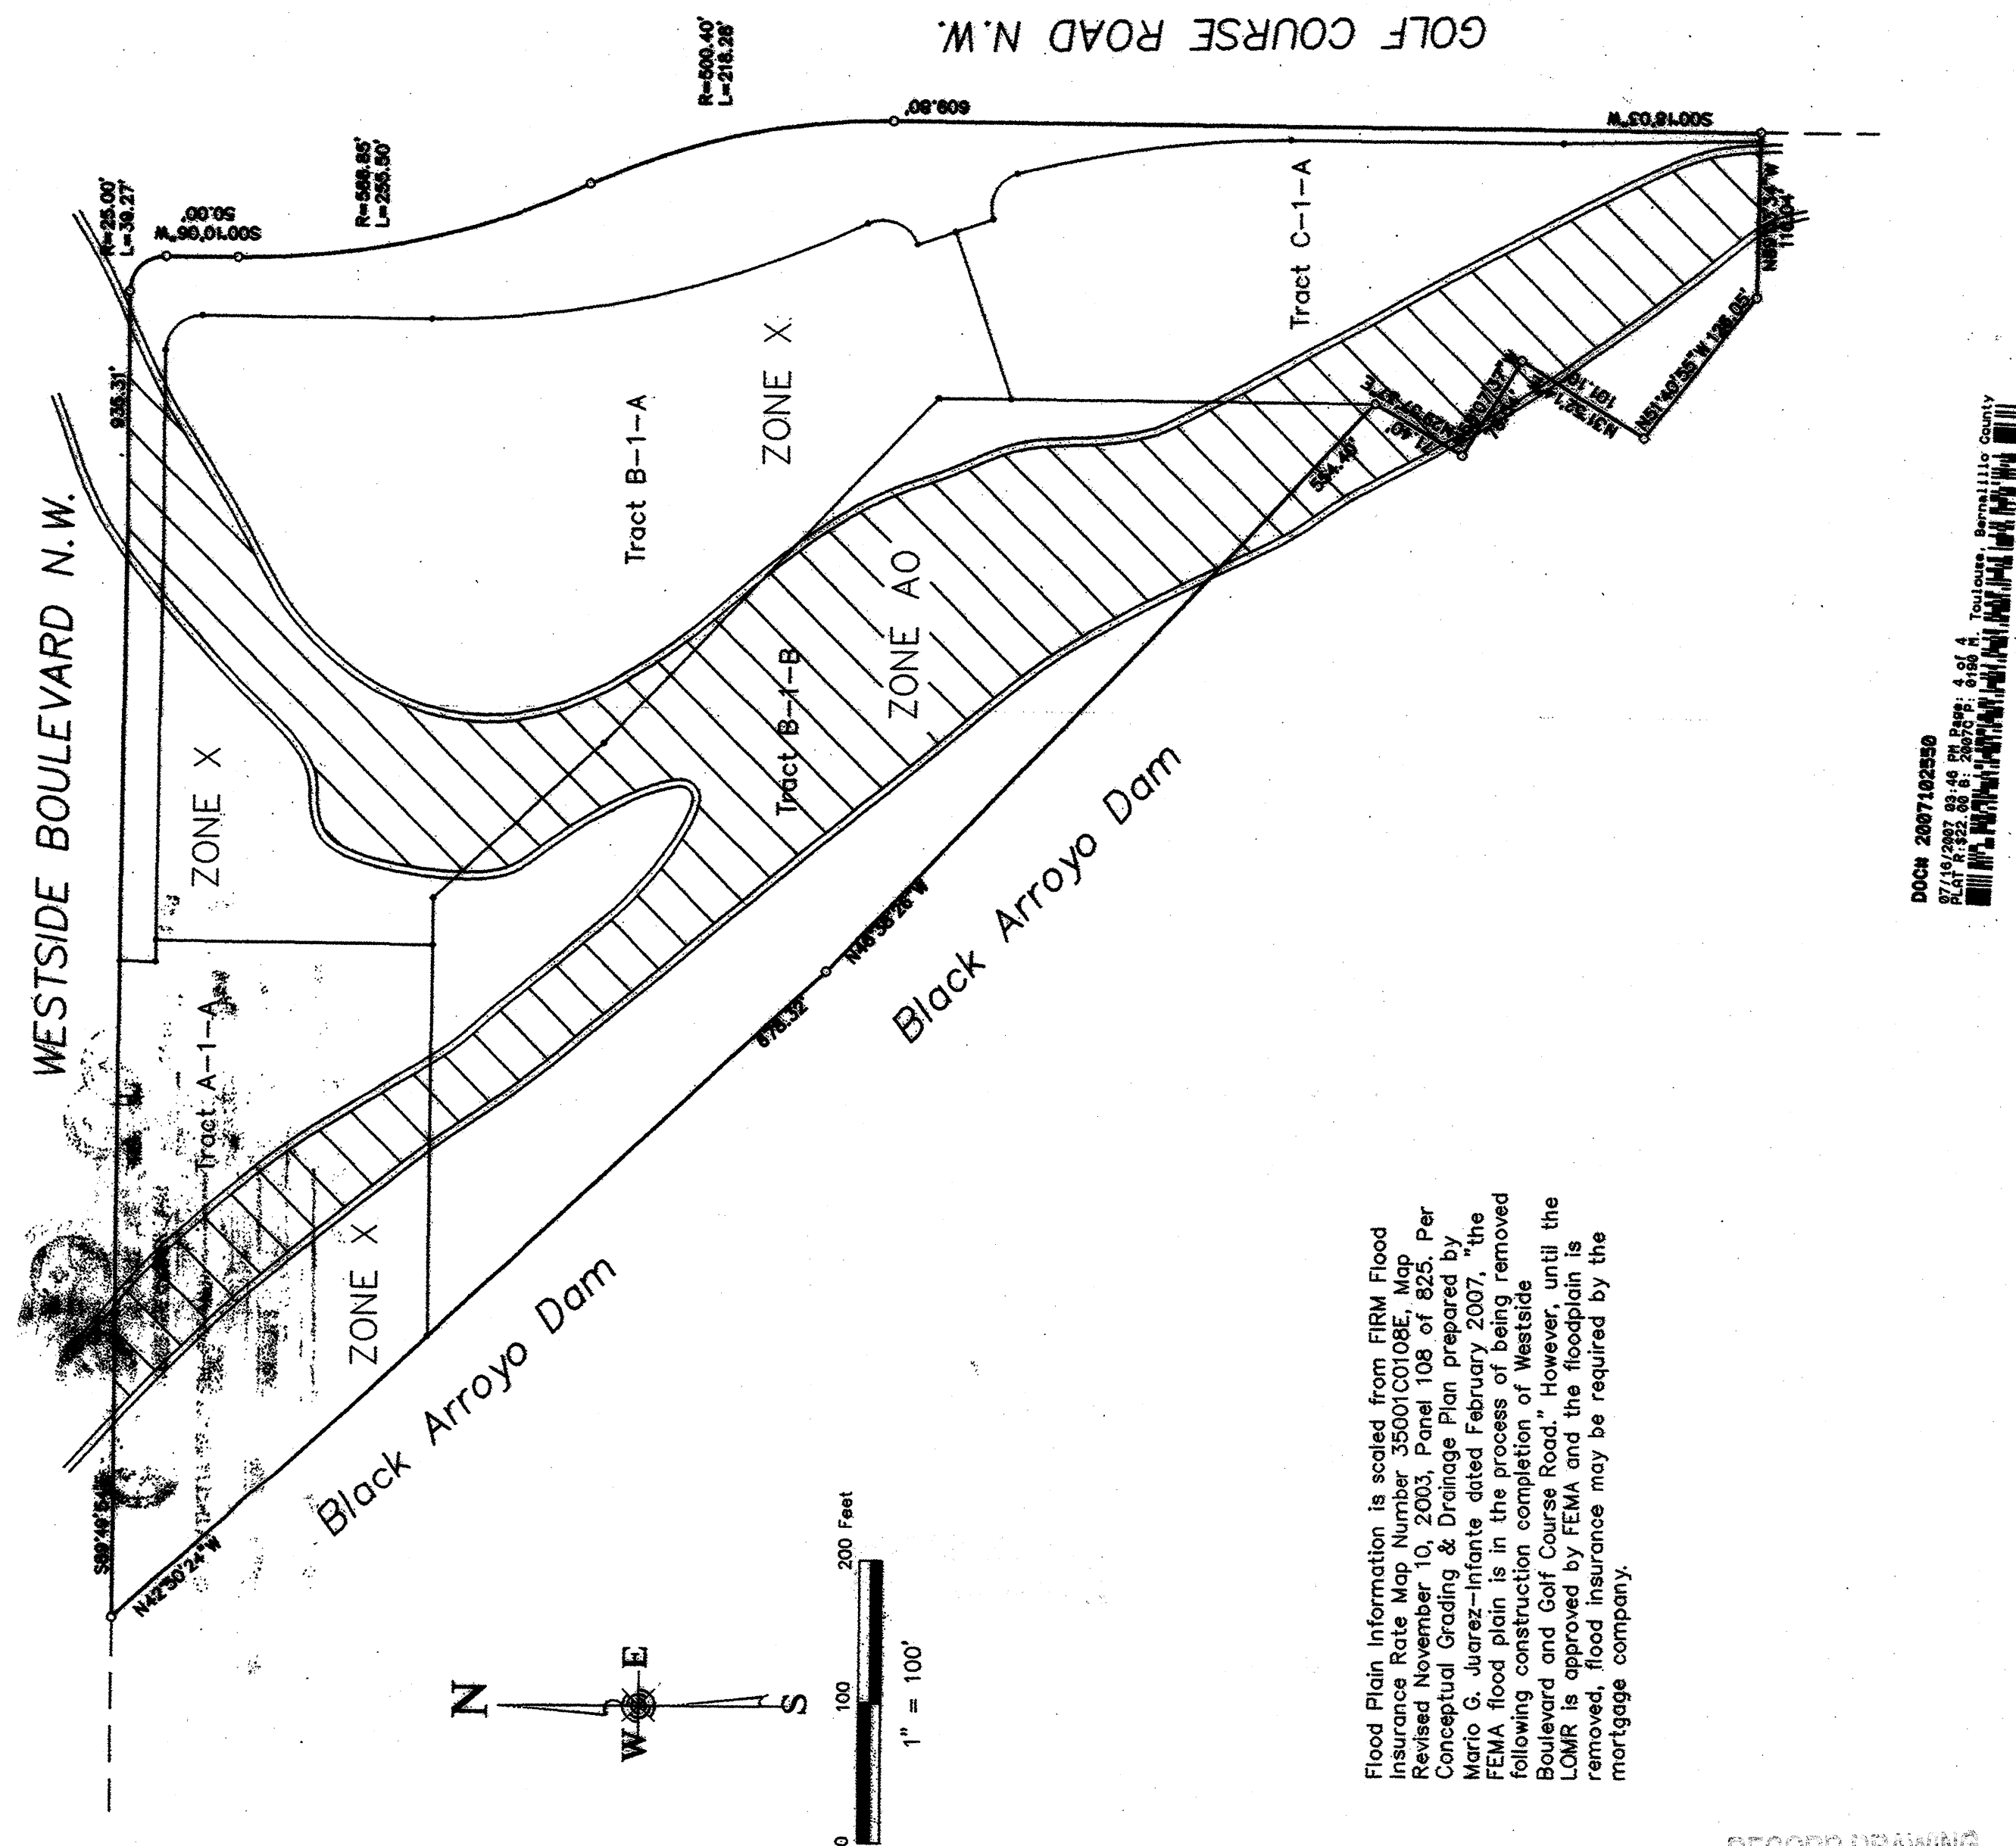

Forstbauer Surveying, L.L.C.
4116 Lomas Boulevard NE
Albuquerque, New Mexico 87110
(505) 268-2112 Fax 268-2032

Chart 1 - 5 1

Flood Plain Information is scaled from FIRM Flood Insurance Rate Map Number 35001C0108E, Map Revised November 10, 2003, Panel 108 of 825. Per Conceptual Grading & Drainage Plan prepared by Mario G. Juarez-Infante dated February 2007, "the FEMA flood plain is in the process of being removed following construction completion of Westside Boulevard and Golf Course Road." However, until the LOMR is approved by FEMA and the floodplain is removed, flood insurance may be required by the mortgage company.

RECORD DRAWING
DATE 8/20/08

GENERAL NOTES:

1. ALL WORK DETAILED ON THESE PLANS (EXCEPT FOR WATER & WASTEWATER, SEE GENERAL NOTE 6) TO BE PERFORMED UNDER THIS CONTRACT SHALL, EXCEPT AS OTHERWISE STATED OR PROVIDED HEREIN, BE CONSTRUCTED IN ACCORDANCE WITH THE CITY OF ALBUQUERQUE STANDARD SPECIFICATIONS FOR PUBLIC WORKS CONSTRUCTION, 2003 EDITION AS AMENDED THROUGH UPDATE NO. 7, THE NEW MEXICO STATE HIGHWAY & TRANSPORTATION DEPARTMENT STANDARD SPECIFICATIONS FOR HIGHWAY & BRIDGE CONSTRUCTION 1994 EDITION, & THE NEW MEXICO UTILITIES, INC. SPECIFICATIONS FOR WATER & WASTEWATER FACILITIES, AS REVISED ON 12/31/2003.
2. CONTRACTOR SHALL NOTIFY THE PROJECT ENGINEER NOT LESS THAN SEVEN (7) DAYS PRIOR TO STARTING WORK IN ORDER THAT THE ENGINEER MAY TAKE NECESSARY MEASURES TO INSURE THE PRESERVATION OF SURVEY MONUMENTS. CONTRACTOR SHALL NOT DISTURB PERMANENT SURVEY MONUMENTS WITHOUT THE CONSENT OF THE ENGINEER, AND SHALL BEAR THE EXPENSE OF REPLACING ANY THAT MAY BE DISTURBED WITHOUT PERMISSION. REPLACEMENT SHALL BE DONE ONLY BY THE CITY SURVEY SECTION. WHEN A CHANGE IS MADE IN ANY ROADWAY IN WHICH A PERMANENT SURVEY MONUMENT IS LOCATED, CONTRACTOR SHALL, AT HIS OWN EXPENSE, ADJUST THE MONUMENT COVER TO THE NEW GRADE UNLESS OTHERWISE SPECIFIED. REFER TO SECTION 4.4 OF GENERAL CONDITIONS OF THE CITY OF ALBUQUERQUE STANDARD SPECIFICATIONS FOR PUBLIC WORKS CONSTRUCTION.
3. FIVE (5) WORKING DAYS PRIOR TO BEGINNING CONSTRUCTION, THE CONTRACTOR SHALL SUBMIT TO THE CONSTRUCTION COORDINATION DIVISION A DETAILED CONSTRUCTION SCHEDULE. TWO (2) WORKING DAYS PRIOR TO CONSTRUCTION, THE CONTRACTOR SHALL OBTAIN A BARRICADING PERMIT FROM THE CONSTRUCTION COORDINATION DIVISION. CONTRACTOR SHALL NOTIFY BARRICADE ENGINEER (924-3400) PRIOR TO OCCUPYING AN INTERSECTION. SEE SECTION 19 OF THE SPECIFICATIONS.
4. TWO (2) WORKING DAYS PRIOR TO ANY EXCAVATION, CONTRACTOR MUST CONTACT NEW MEXICO ONE CALL SYSTEM, INC., (260-1990) FOR LOCATION OF EXISTING UTILITIES.
5. PRIOR TO CONSTRUCTION, THE CONTRACTOR SHALL EXCAVATE AND VERIFY THE HORIZONTAL AND VERTICAL LOCATIONS OF ALL OBSTRUCTIONS AND EXISTING PAVEMENT. SHOULD A CONFLICT EXIST, THE CONTRACTOR SHALL NOTIFY THE ENGINEER OR SURVEYOR SO THAT THE CONFLICT CAN BE RESOLVED WITH A MINIMUM OF DELAY.
6. ALL UTILITY WORK SHALL BE CONSTRUCTED IN ACCORDANCE WITH NEW MEXICO UTILITIES, INC., SPECIFICATIONS FOR WATER AND WASTE WATER FACILITIES (MOST RECENT REVISIONS).
7. THE CONTRACTOR SHALL NOTIFY NEW MEXICO UTILITIES (898-2661) THREE (3) WORKING DAYS PRIOR TO BEGINNING THE CONSTRUCTION OF THE UTILITIES.
8. THE PUBLIC WATER LINE MUST BE A MINIMUM OF 18" ABOVE THE SEWER LINE AT ALL CROSSINGS.
9. THE CONTRACTOR SHALL FURNISH ELECTRO MAGNETIC DISK'S ON ALL WATER AND SEWER SERVICE STUBS, CAPS, AND PLUGS.
10. ALL DRY UTILITIES AND WET UTILITY SERVICE LINES SHALL BE INSTALLED PRIOR TO PAVING.
11. UTILITY CROSSINGS: SERVICE LINE UTILITY CROSSINGS, WHICH HAVE MORE THAN ONE LINE WITH A TWO-FOOT 3-DIMENSIONAL PRISM, SHALL BE PAID FOR AS ONE CROSSING. SERVICE LINE IS DEFINED AS A 4" DIAMETER OR SMALLER LINE. TRUNK UTILITY LINE CROSSINGS, WHICH HAVE MORE THAN ONE LINE WITHIN A TWO-FOOT 3-DIMENSIONAL PRISM, SHALL BE PAID FOR AS ONE CROSSING. TRUNK LINE IS DEFINED AS GREATER THAN 4" DIAMETER LINE.
12. TACK COAT REQUIREMENTS SHALL BE DETERMINED BY THE PROJECT ENGINEER.
13. SIDEWALKS AND WHEELCHAIR RAMPS WITHIN THE CURB RETURNS SHALL BE CONSTRUCTED WHEREVER A NEW CURB RETURN IS CONSTRUCTED.
14. IF CURB IS DEPRESSED FOR A DRIVEPAD OR A HANDICAP RAMP, THE DRIVEPAD OR RAMP SHALL BE CONSTRUCTED PRIOR TO ACCEPTANCE OF THE CURB AND GUTTER.
15. ALL STREET STRIPING ALTERED OR DESTROYED SHALL BE REPLACED BY CONTRACTOR WITH PLASTIC REFLECTORIZED PAVEMENT MARKINGS IN EXISTING STRIPING LOCATIONS UNLESS OTHERWISE INDICATED BY THIS PLAN SET.
16. ANY WORK AFFECTING AN ARTERIAL ROADWAY REQUIRES 24 HOUR CONSTRUCTION.
17. THE CONTRACTOR SHALL BE RESPONSIBLE FOR REPAIR, OR REMOVAL AND REPLACEMENT, OF ANY PAVEMENT, PAVEMENT MARKINGS, CURB AND GUTTER, DRIVEPADS, SIDEWALK, WHEELCHAIR RAMP OR ANY OTHER EXISTING IMPROVEMENTS DAMAGED BY THE CONTRACTOR'S OPERATIONS.
18. FOR STORM DRAIN CONSTRUCTION, RCP PIPE SHALL NOT BE GROUTED PRIOR TO FINAL INSPECTION. FINAL INSPECTION WILL DETERMINE JOINTS TO BE GROUTED FOR FINAL ACCEPTANCE OF THE CONSTRUCTION.
19. MAINTENANCE OF AS-BUILT PLANS: THE CONTRACTOR SHALL MAINTAIN AN UP TO DATE SET OF OF AS-BUILT PLANS FOR THE PROJECT. THESE PLANS SHALL BE KEPT CURRENT, WITHIN TWO WEEKS, AT ALL TIMES AND SHALL BE SUBJECT TO REVIEW BY AMAFCA AND THE PROJECT ENGINEER THROUGHOUT THE PROJECT, AND WILL BE REVIEWED FOR ACCURACY AND COMPLETENESS AT LEAST ONCE EVERY 30 DAYS. THE FINAL AS-BUILT PLANS SHALL BE SUBMITTED TO AMAFCA AND THE PROJECT ENGINEER PRIOR TO FINAL PAYMENT. FAILURE TO MAINTAIN AN UP TO DATE SET OF AS-BUILT PLANS SHALL BE SUBJECT TO A \$100/DAY FINE FOR EACH WORK DAY NOT REFLECTED ON PLANS. PAY DEDUCTION SHALL BE DEDUCTED FROM UNIT BID ITEM FOR CONSTRUCTION AS-BUILTS

20. **CLEANING OF EXISTING STRUCTURES:**
THE CONTRACTOR SHALL CLEAN ALL EXISTING STRUCTURES THAT ARE TO REMAIN OPERATIONAL PRIOR TO INITIATING STRUCTURE EXTENSION WORK. STRUCTURES SHALL BE CLEAN AT THE TIME OF FINAL PROJECT ACCEPTANCE. THE CATTLE GUARD AT IRVING/LYON BLVD. INTERSECTION SHALL BE CLEAN AT ALL TIMES. THIS WORK SHALL BE CONSIDERED AS INCIDENTAL TO THE COMPLETION OF THE PROJECT AND NO SEPARATE MEASUREMENT OR PAYMENT SHALL BE MADE THEREFORE.
21. **ACCESS TO LOCAL BUSINESSES AND RESIDENCES:**
THE CONTRACTOR SHALL PROVIDE INGRESS AND EGRESS TO LOCAL BUSINESSES AND RESIDENCES FOR THE DURATION OF THE PROJECT. THE CONTRACTOR SHALL ADVISE OF AND SCHEDULE ACCESS CLOSURES AT LEAST 48 HOURS IN ADVANCE WITH THE PROPERTY OWNERS AND THE CITY OF ALBUQUERQUE AND BERNALILLO COUNTY. THE COST FOR THIS WORK WILL BE CONSIDERED INCIDENTAL TO THE PROJECT AND NO DIRECT PAYMENT WILL BE MADE THEREFORE.
22. FIVE (5) WORKING DAYS PRIOR TO THE START OF CONSTRUCTION THE CONTRACTOR SHALL SUBMIT TO AMAFCA AND THE PROJECT ENGINEER A DETAILED CONSTRUCTION SCHEDULE. CONSTRUCTION SCHEDULE SHALL CONFORM TO THE CRITICAL PATH METHODOLOGY AND SHALL CLEARLY ILLUSTRATE ACTIVITY TASKS, A LOGICAL NETWORK SEQUENCE: EARLY START, EARLY FINISH, LATE START, LATE FINISH, FREE FLOAT TIME, TOTAL FLOAT TIME, AND INDEPENDENT FLOAT TIME FOR INDIVIDUAL TASKS; TASK SUMMARIES, AND OVERALL PROJECT. CPM SCHEDULE SHALL BE UPDATED AND SUBMITTED WITH EACH PAY APPLICATION OR AT LEAST EVERY 30 DAYS (MINIMUM). FAILURE TO SUBMIT PERIODICALLY (30 DAYS MIN.) REVISED CPM SCHEDULE AS REQUIRED SHALL BE SUBJECT TO A \$250.00 FINE FOR EACH CALENDAR DAY LATE. PAY DEDUCTION SHALL BE DEDUCTED FROM UNIT BID ITEM FOR CONSTRUCTION SCHEDULE.
23. THE CONTRACTOR WILL BE RESPONSIBLE FOR COORDINATING THE EXECUTION OF THE WATER VALVE SHUTOFF PLAN WITH NEW MEXICO UTILITIES. ALL WATER VALVES TO BE SHUT OFF WILL BE TESTED AT LEAST FORTY-EIGHT (48) HOURS PRIOR TO SHUT OFF. VALVES ARE TO BE OPERATED BY N.M. UTILITIES PERSONNEL ONLY. CONTRACTOR SHALL NOTIFY NEW MEXICO UTILITIES AT 898-2661 FORTY-EIGHT (48) HOURS PRIOR TO WATERLINE CONSTRUCTION.
24. THE CONTRACTOR SHALL NOTIFY THE LOCAL FIRE DEPARTMENT AT LEAST TWO (2) WORKING DAYS PRIOR TO EITHER TAKING FIRE HYDRANTS OUT OF SERVICE OR RETURNING THEM TO SERVICE.
25. VIDEO RECORDINGS OF THE CONSTRUCTION AREA, STRUCTURES, AND AREAS ADJACENT TO THE LIMITS OF CONSTRUCTION SHALL BE MADE AND MAINTAINED. SPECIAL ATTENTION SHALL BE GIVEN TO THE STRUCTURES IMMEDIATELY PARALLEL AND ADJACENT TO LYON BOULEVARD, LOCATED ON THE EAST AND WEST SIDES, AND BETWEEN IRVING BOULEVARD AND PARADISE BOULEVARD. SPECIAL ATTENTION SHALL ALSO BE PAID TO ITEMS SUCH AS STRUCTURES AND PROPERTIES ABUTTING THE PROJECT LIMITS, WATERCOURSES, AND OTHER AREAS SUBJECT TO DAMAGE OR EROSION, AND AS DIRECTED BY THE PROJECT ENGINEER.
- THE VIDEO RECORDINGS WILL BE USED TO DETERMINE ANY IMPACTS ON STRUCTURES AND AREAS DUE TO THE CONTRACTOR'S OPERATIONS. THE TERM VIDEOTAPE IS USED INTERCHANGEABLY TO DESCRIBE VHS AND DVD VIDEO RECORDING.
26. VIBRATION MONITORING SHALL BE PERFORMED IN AND AROUND ALL STRUCTURES AS DEFINED IN SECTION 101, ABBREVIATIONS, DEFINITIONS, AND TERMS; AS INDICATED IN THE CONTRACT, AND AS DIRECTED BY THE PROJECT ENGINEER.
- VIBRATION MONITORING SHALL BE PERFORMED TO DETERMINE IF VIBRATIONS POTENTIALLY DAMAGING TO THE ADJACENT STRUCTURES, PARALLEL TO LYON BOULEVARD ON THE EAST AND WEST SIDES, ARE CREATED AS A RESULT OF CONSTRUCTION ACTIVITY RELATED TO THE INSTALLATION OF THE STORM DRAIN. REFER TO FIGURE 1 FOR PARTICULAR LOTS AFFECTED. FIGURE 1 DOES NOT REPRESENT ANY AFFECTED RESIDENTS. CONTRACTOR SHALL EMPLOY THE SERVICES OF A NEW MEXICO LICENSED PROFESSIONAL, QUALIFIED TO IDENTIFY VIBRATION MONITORING LIMITS AS IDENTIFIED IN THE PROJECT SPECIFICATIONS.
27. THE CONTRACTOR SHALL BE REQUIRED TO OBTAIN, AT THEIR EXPENSE, A TOPSOIL DISTURBANCE PERMIT FOR THE PROJECT.
28. CONTRACTOR SHALL CONTACT COA TRAFFIC OPS & COORDINATE A "PRE-STRIPING" MEETING ON-SITE, PRIOR TO REPLACEMENT OF ALL PERMANENT STRIPING & MARKINGS.
29. SUCCESSFUL BIDDER WILL BE PROVIDED AN ELECTRONIC ACAD FILE FOR LAYING OUT ROADWAY PAVING, CURB & GUTTER, TEMPORARY ASPHALT CURB, & SIDEWALKS.
30. CAUTION: THESE DRAWINGS DO NOT INCLUDE NECESSARY COMPONENTS FOR CONSTRUCTION SAFETY WHICH SHALL REMAIN THE RESPONSIBILITY OF THE CONTRACTOR. ALL WORK ON THIS PROJECT SHALL BE PERFORMED IN ACCORDANCE WITH APPLICABLE FEDERAL, STATED AND LOCAL LAWS, RULES AND REGULATIONS CONCERNING SAFETY AND HEALTH. ALL EXCAVATION, TRENCHING AND SHORING ACTIVITIES MUST BE CARRIED-OUT IN ACCORDANCE WITH OSHA 29 CFR 1926, SUBPART P-EXCAVATIONS.
31. WHEN ABUTTING NEW PAVEMENT TO EXISTING PAVEMENT, SAW CUT EXISTING PAVEMENT IN A STRAIGHT LINE AS REQUIRED TO REMOVE ANY BROKEN OR CRACKED PAVEMENT. PRIOR TO LAYING NEW PAVEMENT, THE EXPOSED EXISTING ASPHALT EDGE SHALL BE TACK-COATED.
32. CONTRACTOR WILL BE RESPONSIBLE FOR PROVIDING & MAINTAINING ALL CONSTRUCTION SIGNING UNTIL PROJECT HAS BEEN ACCEPTED BY THE CITY OF ALBUQUERQUE.
33. PRIVATE ACCESS: DEVELOPER SHALL BE RESPONSIBLE FOR PROVIDING AND MAINTAINING ALL SIGNING AND STRIPING (PAVEMENT MARKINGS) WITHIN PRIVATE DEVELOPMENT / ACCESS.

LIST OF INCIDENTALS:

1. UTILITY REPAIR COSTS (EXCLUDES UTILITY CROSSINGS, GENERAL NOTE 11)
2. EARTHWORK HAUL.
3. DESIGN, INSTALLATION, AND REMOVAL OF SHIELDING FOR CONSTRUCTION EQUIPMENT OR MATERIAL WITH IN CONSTRUCTION CLEAR ZONE.
4. HAULING OF SALVAGEABLE MATERIALS.
5. HAULING OF REMOVALS & DISPOSED MATERIAL.
6. WARPING OF SLOPES.
7. CLEANING OF EXISTING STRUCTURES.
8. CONSTRUCTION WATER.
9. UTILITY VERIFICATION, LINE SPOTTING, POT HOLING, AND EXPLORATION.
10. EXISTING SERVICE LINE DISCONNECT AND RECONNECT.
11. OTHER: AS OUTLINED ON THE GENERAL NOTES SHEET.

AMAFCA NOTES

1. AMAFCA Field Engineer shall be notified 48-hours prior to any work within the AMAFCA R/W Tel at 884-2215.
2. No work will be performed int the AMAFCA R/W between May 15 and October 15 without written permission from AMAFCA.
3. All subgrade, backfill and embankment shall be compacted to 95% (modified proctor) within the AMAFCA R/W. Testing reports shall be provided to AMAFCA Field Engineer.
4. AMAFCA Field Engineer will be notified 48 hours prior to final inspection of any facilities within the AMAFCA R/W.
5. All disturbed ground areas shall be revegetated in accordance with City of Albuquerque Standard Specifications for Public Works Construction, Section 1012 Native Grass Seeding, as currently updated.
6. Any existing survey control monuments that are moved or destroyed as a result of the construction shall be replaced by a registered surveyor at the owner's expense.
7. Owner's contractor shall provide liability insurance naming AMAFCA as additional insured in the amount of \$2,000,000.00 . Proof of insurance shall be provided to AMAFCA prior to construction.


Approved For Construction Within
AMAFCA Right-of-way:

Lynn M. Mayan 2-20-08
For AMAFCA DATE

THE FOLLOWING NOTES ALSO APPLY WHEN CHECKED:

- ☒ ALL UTILITIES AND UTILITY SERVICE LINES SHALL BE INSTALLED PRIOR TO PAVING.
- ☒ BACKFILL COMPACTION SHALL BE ACCORDING TO SPECIFIED STREET USE.
- ☒ TACK COAT REQUIREMENTS SHALL BE DETERMINED BY THE ENGINEER.
- ☒ SIDEWALKS AND WHEELCHAIR RAMPS WITHIN THE CURB RETURNS SHALL BE CONSTRUCTED WHEREVER A NEW CURB RETURN IS CONSTRUCTED.
- ☒ IF CURB IS DEPRESSED FOR A DRIVEPAD, THE DRIVEPAD SHALL BE CONSTRUCTED PRIOR TO ACCEPTANCE OF CURB AND GUTTER.
- ☒ ALL STORM DRAINAGE FACILITIES SHALL BE COMPLETED PRIOR TO FINAL ACCEPTANCE.
- ☒ FOR STORM DRAIN CONSTRUCTION, RCP PIPE JOINTS SHALL NOT BE GROUTED PRIOR TO FINAL INSPECTION. FINAL INSPECTION WILL DETERMINE JOINTS TO BE GROUTED FOR FINAL ACCEPTANCE OF THE CONSTRUCTION.

UTILITY CONTACTS			
COMPANY	PHONE	MOBILE	CONTACT
NEW MEXICO UTILITIES	505.898.2661		A.S. WARNER
PNM - ELECTRIC	505.241.3421	505.934.8798	ART CHAVEZ
PNM - GAS	505.241.7771		JOE DUNLOP
QWEST	505.245.8530		ROSARIO KNIFFIN
NM ONE CALL	505.260.1990		
COMCAST	505.761.6235		ROBERT MARTINEZ

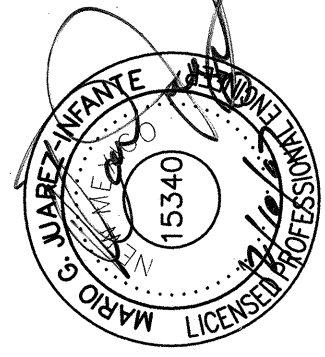
AS-BUILT INFORMATION		BENCH MARKS		SURVEY INFORMATION		ENGINEER'S SEAL		REVISIONS	
CONTRACTOR	DATE	ACCS BRASS TABLET STAMPED "BLACK 2 1977"	DATE	NO.	BY			WILSON & COMPANY, ENGINEERS & ARCHITECTS	DESIGNED BY DRAWN BY CHECKED BY
WORK	DATE	GEOGRAPHIC POSITION (NAD 1927)	DATE	1	WCI				
INSPECTOR'S	DATE	N.M. STATE PLANE COORDINATES (CENTRAL ZONE)	DATE	2	WCI				
FIELD	DATE	X= 372,920.43 Y= 1,530,241.52	DATE	3	WCI				
VERIFICATION BY	DATE	GROUND-TO-GRID FACTOR= 0.9996692	DATE	4	WCI				
CONNECTED BY	DATE	SLD 1929 ELEVATION= 5213.926	DATE	5	WCI				
MICRO-FILM INFORMATION	DATE		DATE	6	WCI				
				7	WCI				

RECORD DRAWING
DATE 8/20/08

WILSON & COMPANY
4900 LANG AVE N.E.
SUITE 200
ALBUQUERQUE, NEW MEXICO 87109
(505) 348-4000
FAX (505) 348-4072
www.wilsonco.com

CITY OF ALBUQUERQUE PUBLIC WORKS DEPARTMENT ENGINEERING GROUP			
VJW INC. STORAGE GENERAL NOTES			
Design Review Committee APPROVED APR 21 2008 DESIGN REVIEW COMMITTEE	City Engineer Approval APPROVED MAY 16 2008 DESIGN REVIEW COMMITTEE	Last Design Update	Mo./Day/Yr.
City Project No.	Zone Map No.	Sheet	Of
7718.83	A-12 & A-13	4	22

WCEA #0660003900

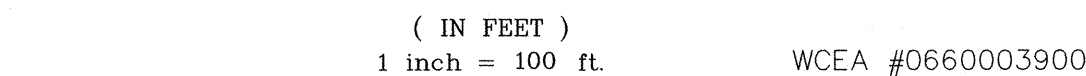

ΔMAECA R/W

ZONE ATLAS MAP NO. A-12

REFERENCE: SCS BERNALILLO COUNTY SOIL SURVEY

ACS BRASS TABLET STAMPED "BLACK 2 1977"

7718.83	A-12
---------	------



FAX (505) 348-4072
www.wilsonco.com

A-12


Of

22

SCANNED BY
PLANNING

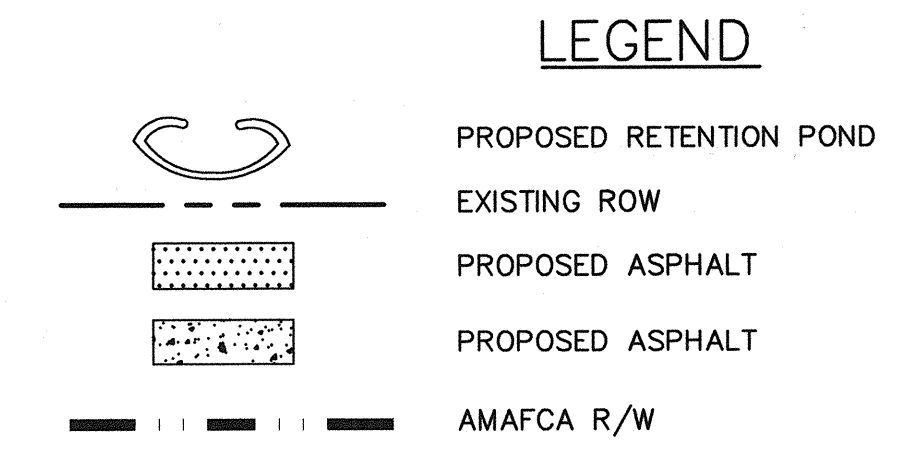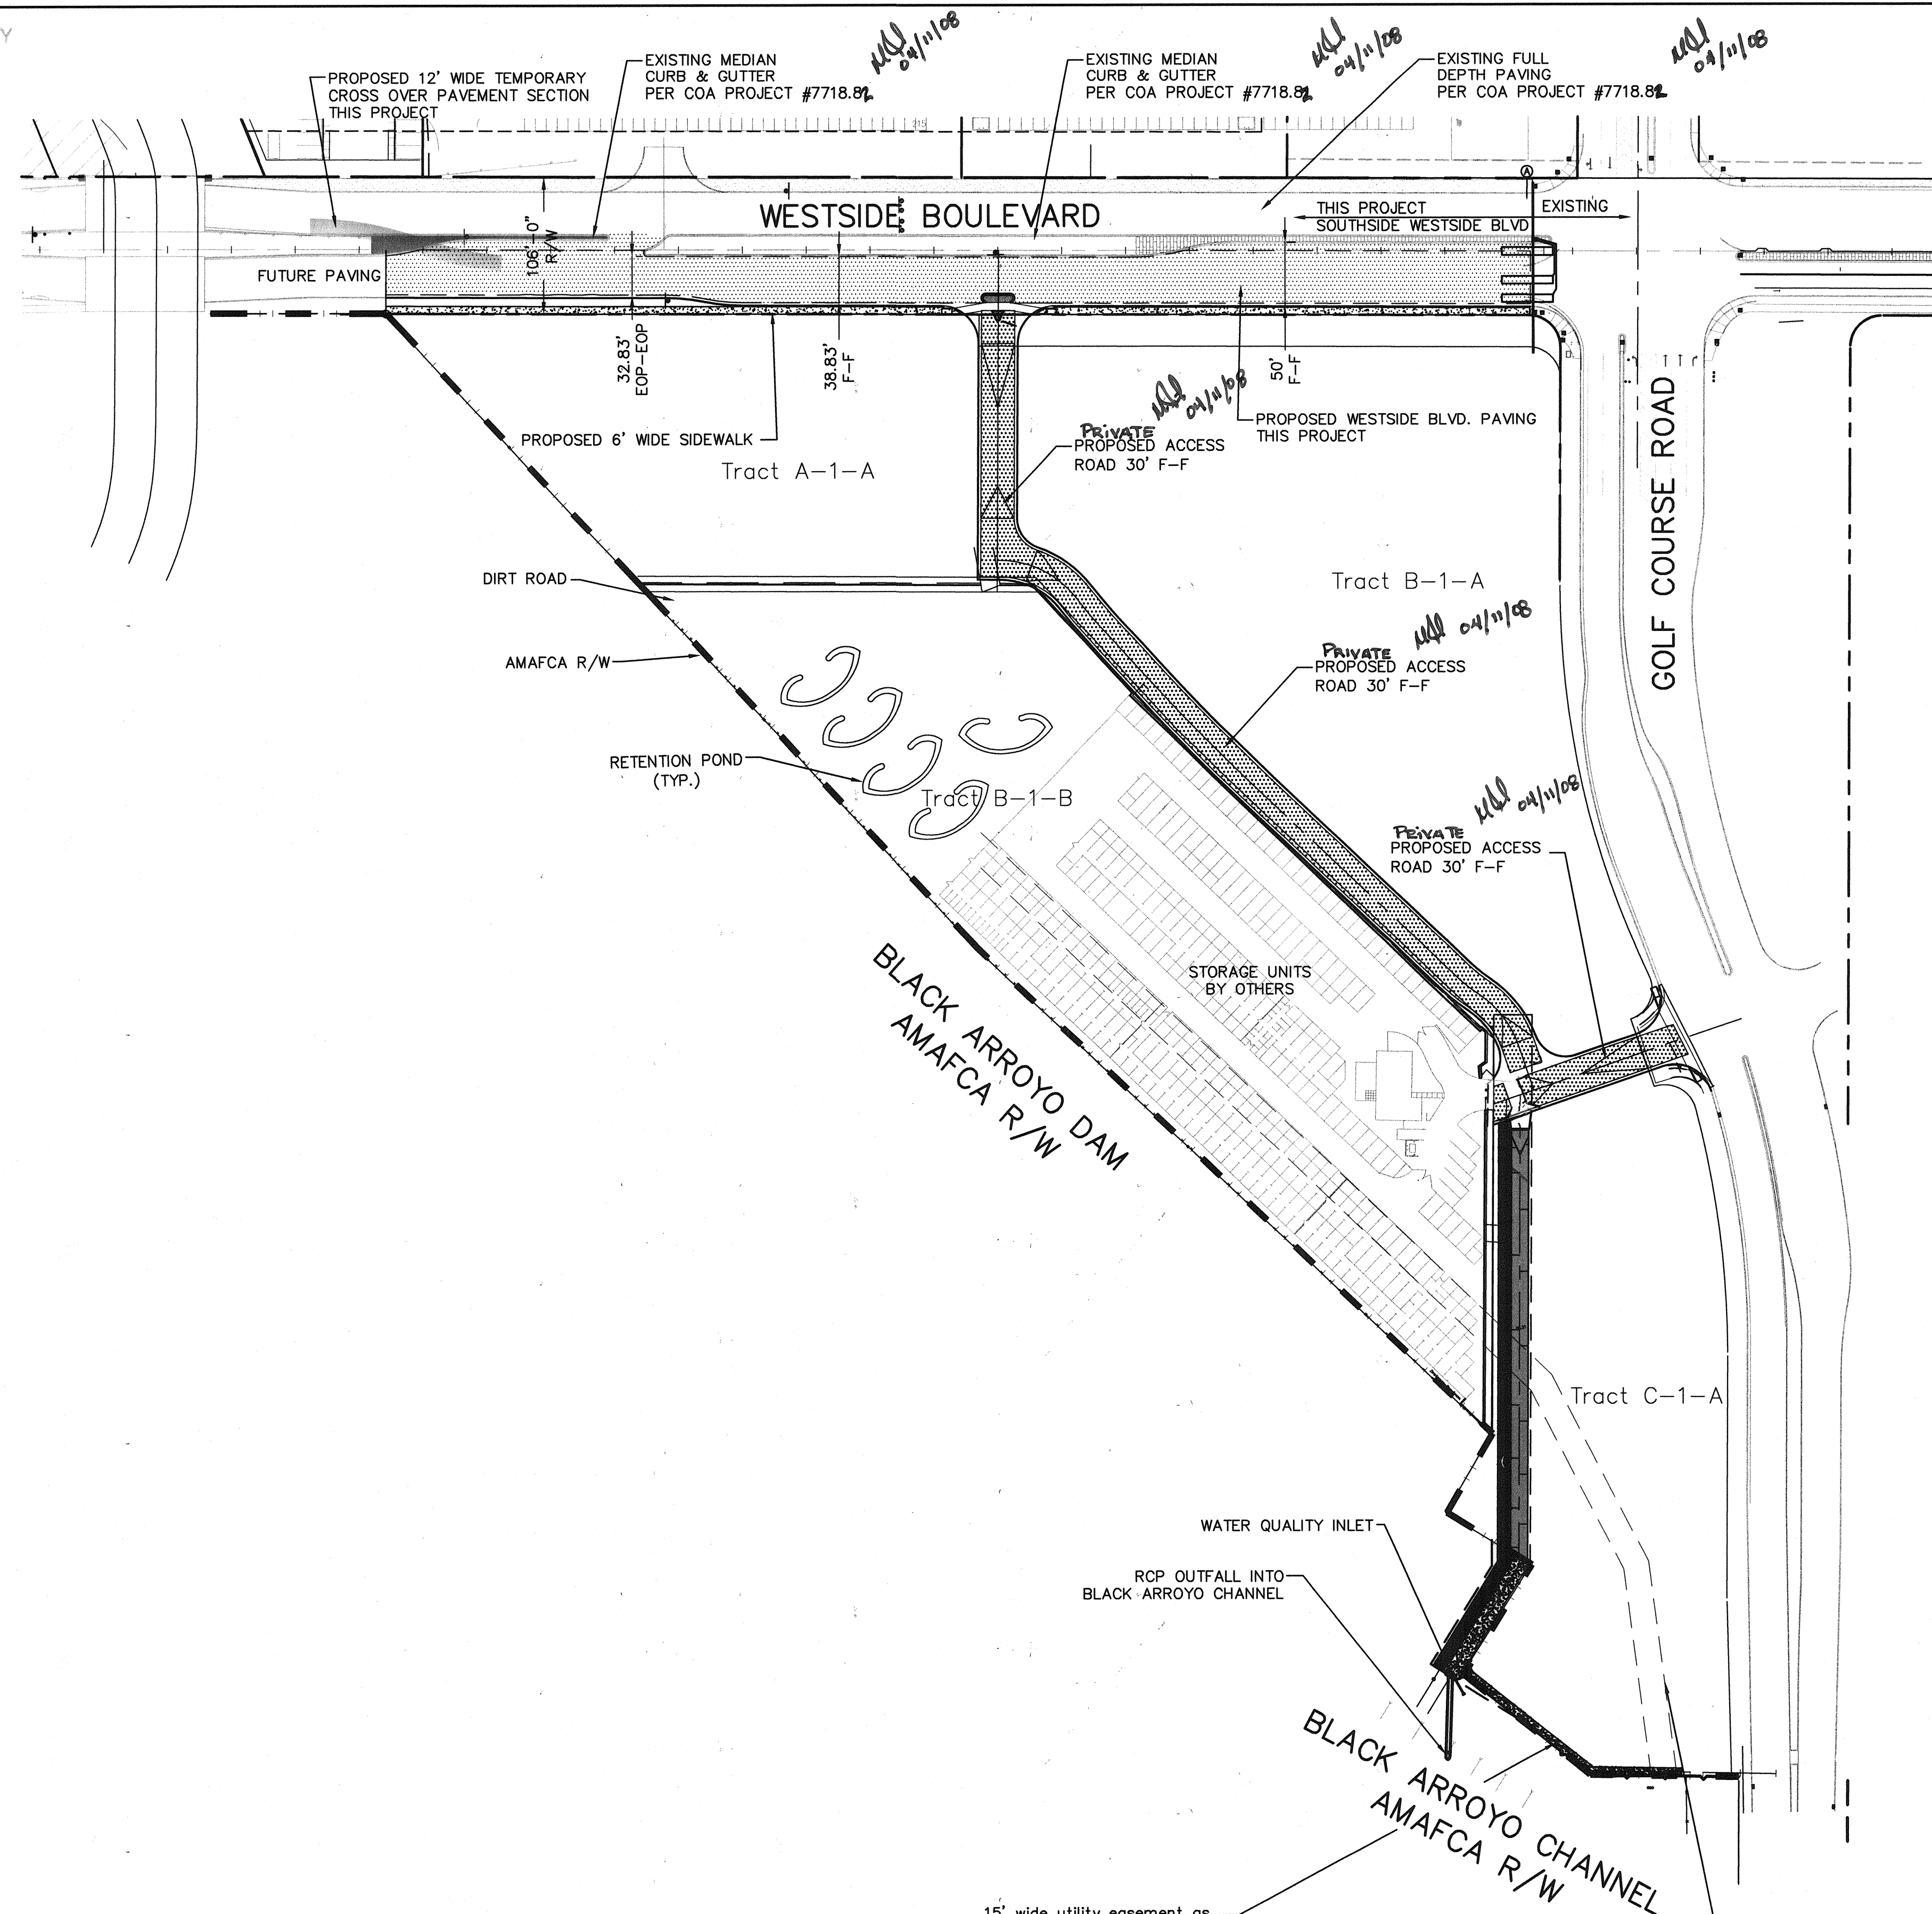

NOTE: SEE SHEET 5 OF 22 FOR DETAILS
OF RIP-RAP AND CONCRETE SWALES


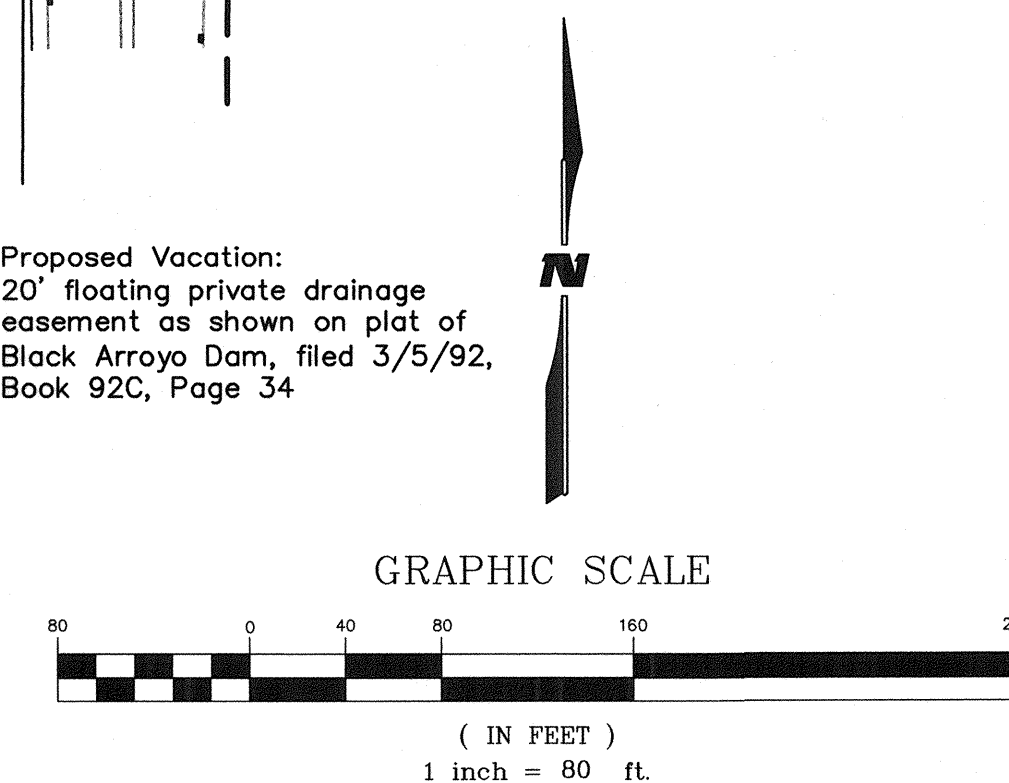



RECORD DRAWING
DATE 8/20/08




WILSON & COMPANY
4900 LANG AVE N.E.
SUITE 200
ALBUQUERQUE, NEW MEXICO
87109
(505) 348-4000
FAX (505) 348-4072
www.wilsonco.com

CITY OF ALBUQUERQUE PUBLIC WORKS DEPARTMENT ENGINEERING GROUP			
VJW STORAGE INC OVERALL MASTER PAVING PLAN			
Design Review Committee APR 21 2008 DESIGN REVIEW COMMITTEE	City Engineer Approval MAY 13 2008 DESIGN REVIEW COMMITTEE	Last Design Update Mo./Day/Yr.	Mo./Day/Yr.
City Project No. 7718.83	Zone Map No. A-12	Sheet 6	Of 22

AS-BUILT INFORMATION		BENCH MARKS		SURVEY INFORMATION		ENGINEER'S SEAL		REVISIONS		DESIGNED BY		DRAWN BY		CHECKED BY	
CONTRACTOR UNIVERSAL CONSTRUCTORS ELIZABETH GONZALEZ	DATE 4/08	DATE 4/08	DATE 4/08	NO.	BY	DATE	DATE	NO.	DATE	DATE	DATE	DATE	DATE	DATE	DATE
WORK W.C.I.	W.C.I.	W.C.I.	W.C.I.	1	W.C.I.	4/1/08	4/1/08	1	W.C.I.	4/1/08	4/1/08	4/1/08	4/1/08	4/1/08	4/1/08
FIELD W.C.I.	W.C.I.	W.C.I.	W.C.I.	2	W.C.I.	4/1/08	4/1/08	2	W.C.I.	4/1/08	4/1/08	4/1/08	4/1/08	4/1/08	4/1/08
REVISION W.C.I.	W.C.I.	W.C.I.	W.C.I.	3	W.C.I.	4/1/08	4/1/08	3	W.C.I.	4/1/08	4/1/08	4/1/08	4/1/08	4/1/08	4/1/08
DATE 8/08	DATE 8/08	DATE 8/08	DATE 8/08	4	W.C.I.	4/1/08	4/1/08	4	W.C.I.	4/1/08	4/1/08	4/1/08	4/1/08	4/1/08	4/1/08
DATE 8/08	DATE 8/08	DATE 8/08	DATE 8/08	5	W.C.I.	4/1/08	4/1/08	5	W.C.I.	4/1/08	4/1/08	4/1/08	4/1/08	4/1/08	4/1/08
DATE 8/08	DATE 8/08	DATE 8/08	DATE 8/08	6	W.C.I.	4/1/08	4/1/08	6	W.C.I.	4/1/08	4/1/08	4/1/08	4/1/08	4/1/08	4/1/08
DATE 8/08	DATE 8/08	DATE 8/08	DATE 8/08	7	W.C.I.	4/1/08	4/1/08	7	W.C.I.	4/1/08	4/1/08	4/1/08	4/1/08	4/1/08	4/1/08




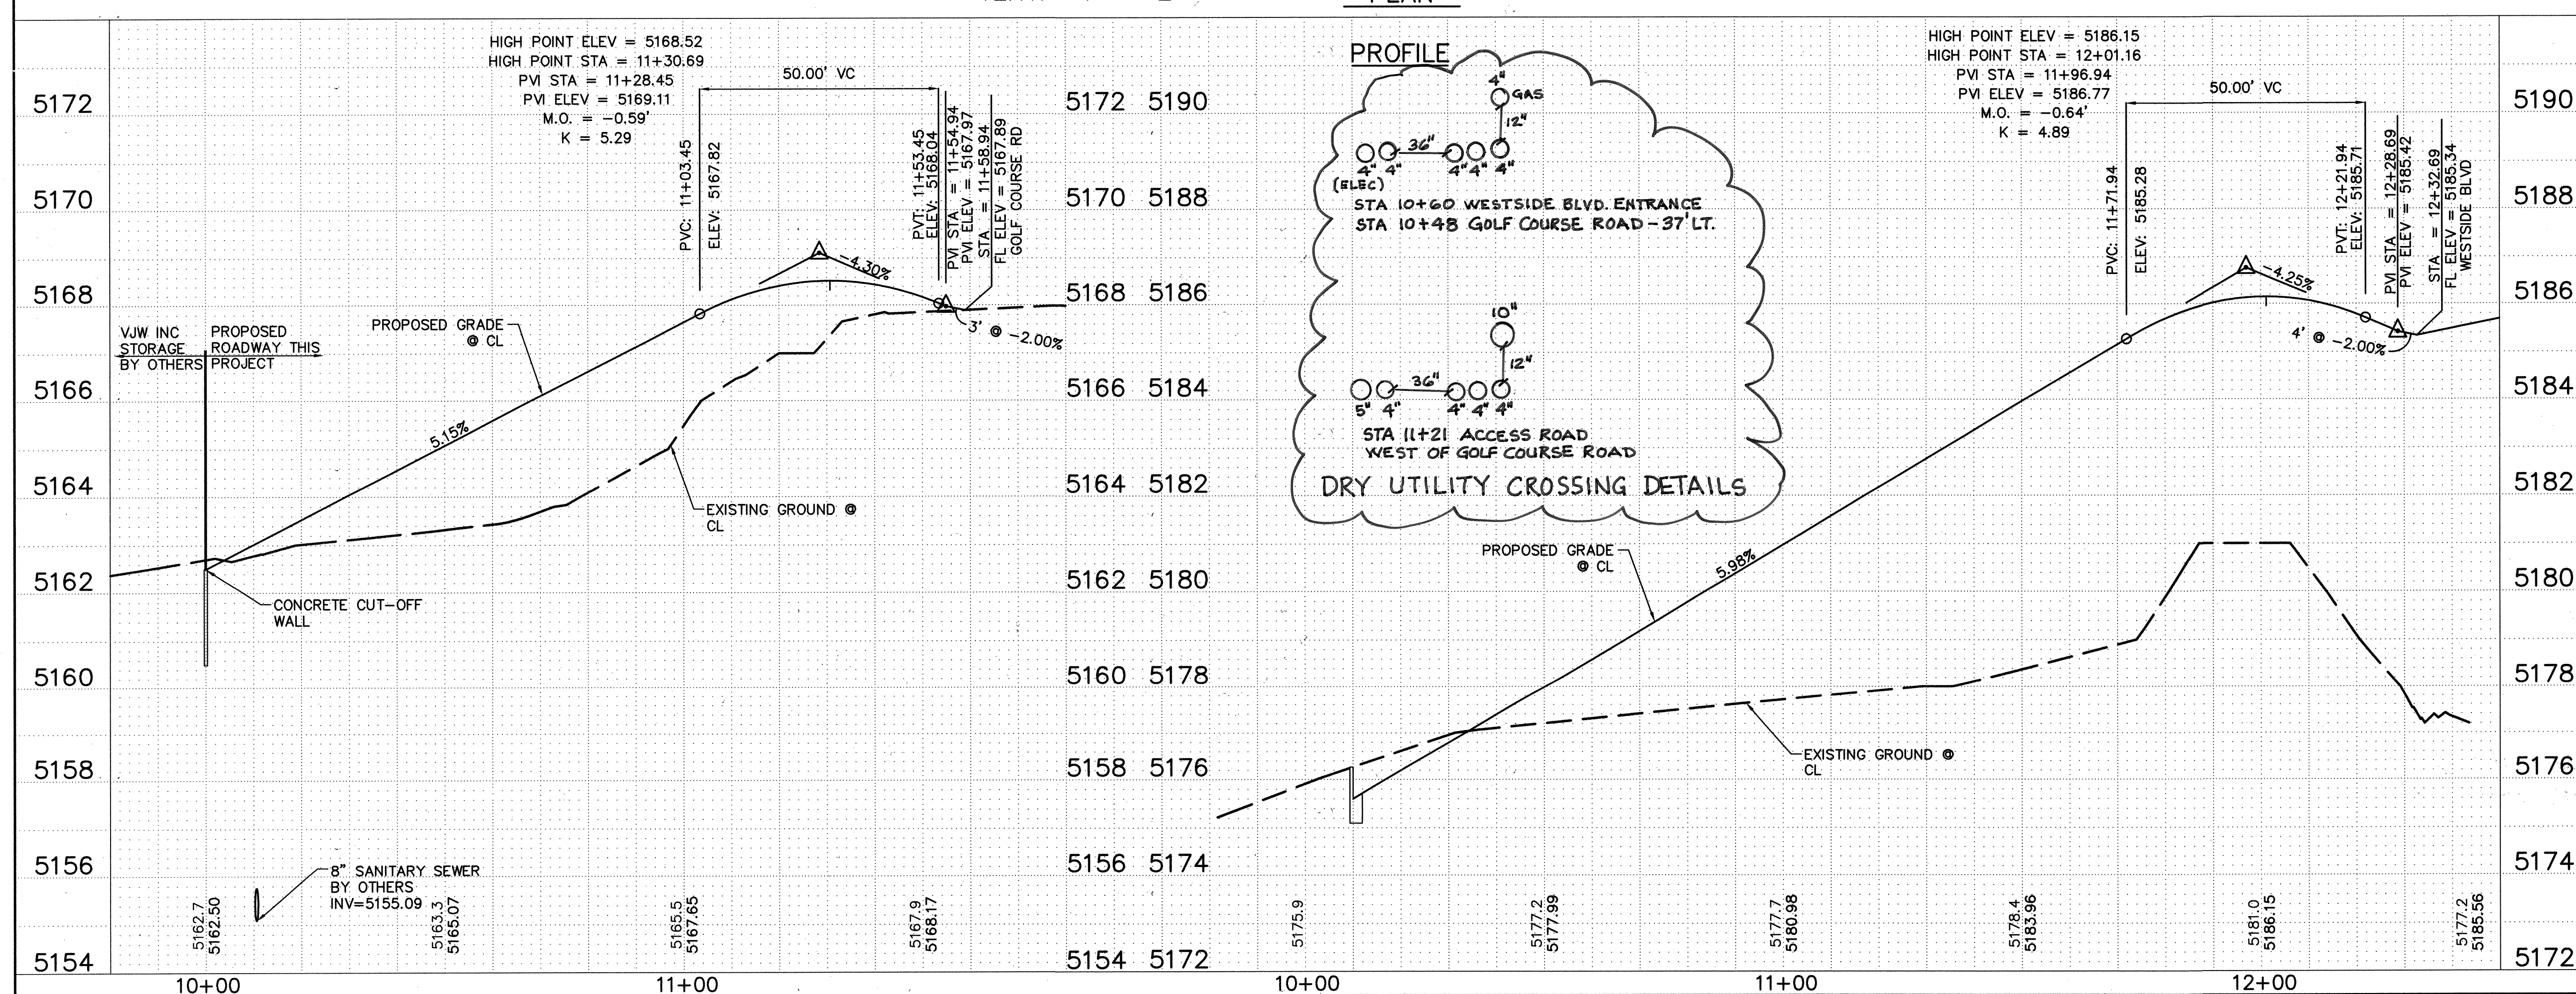
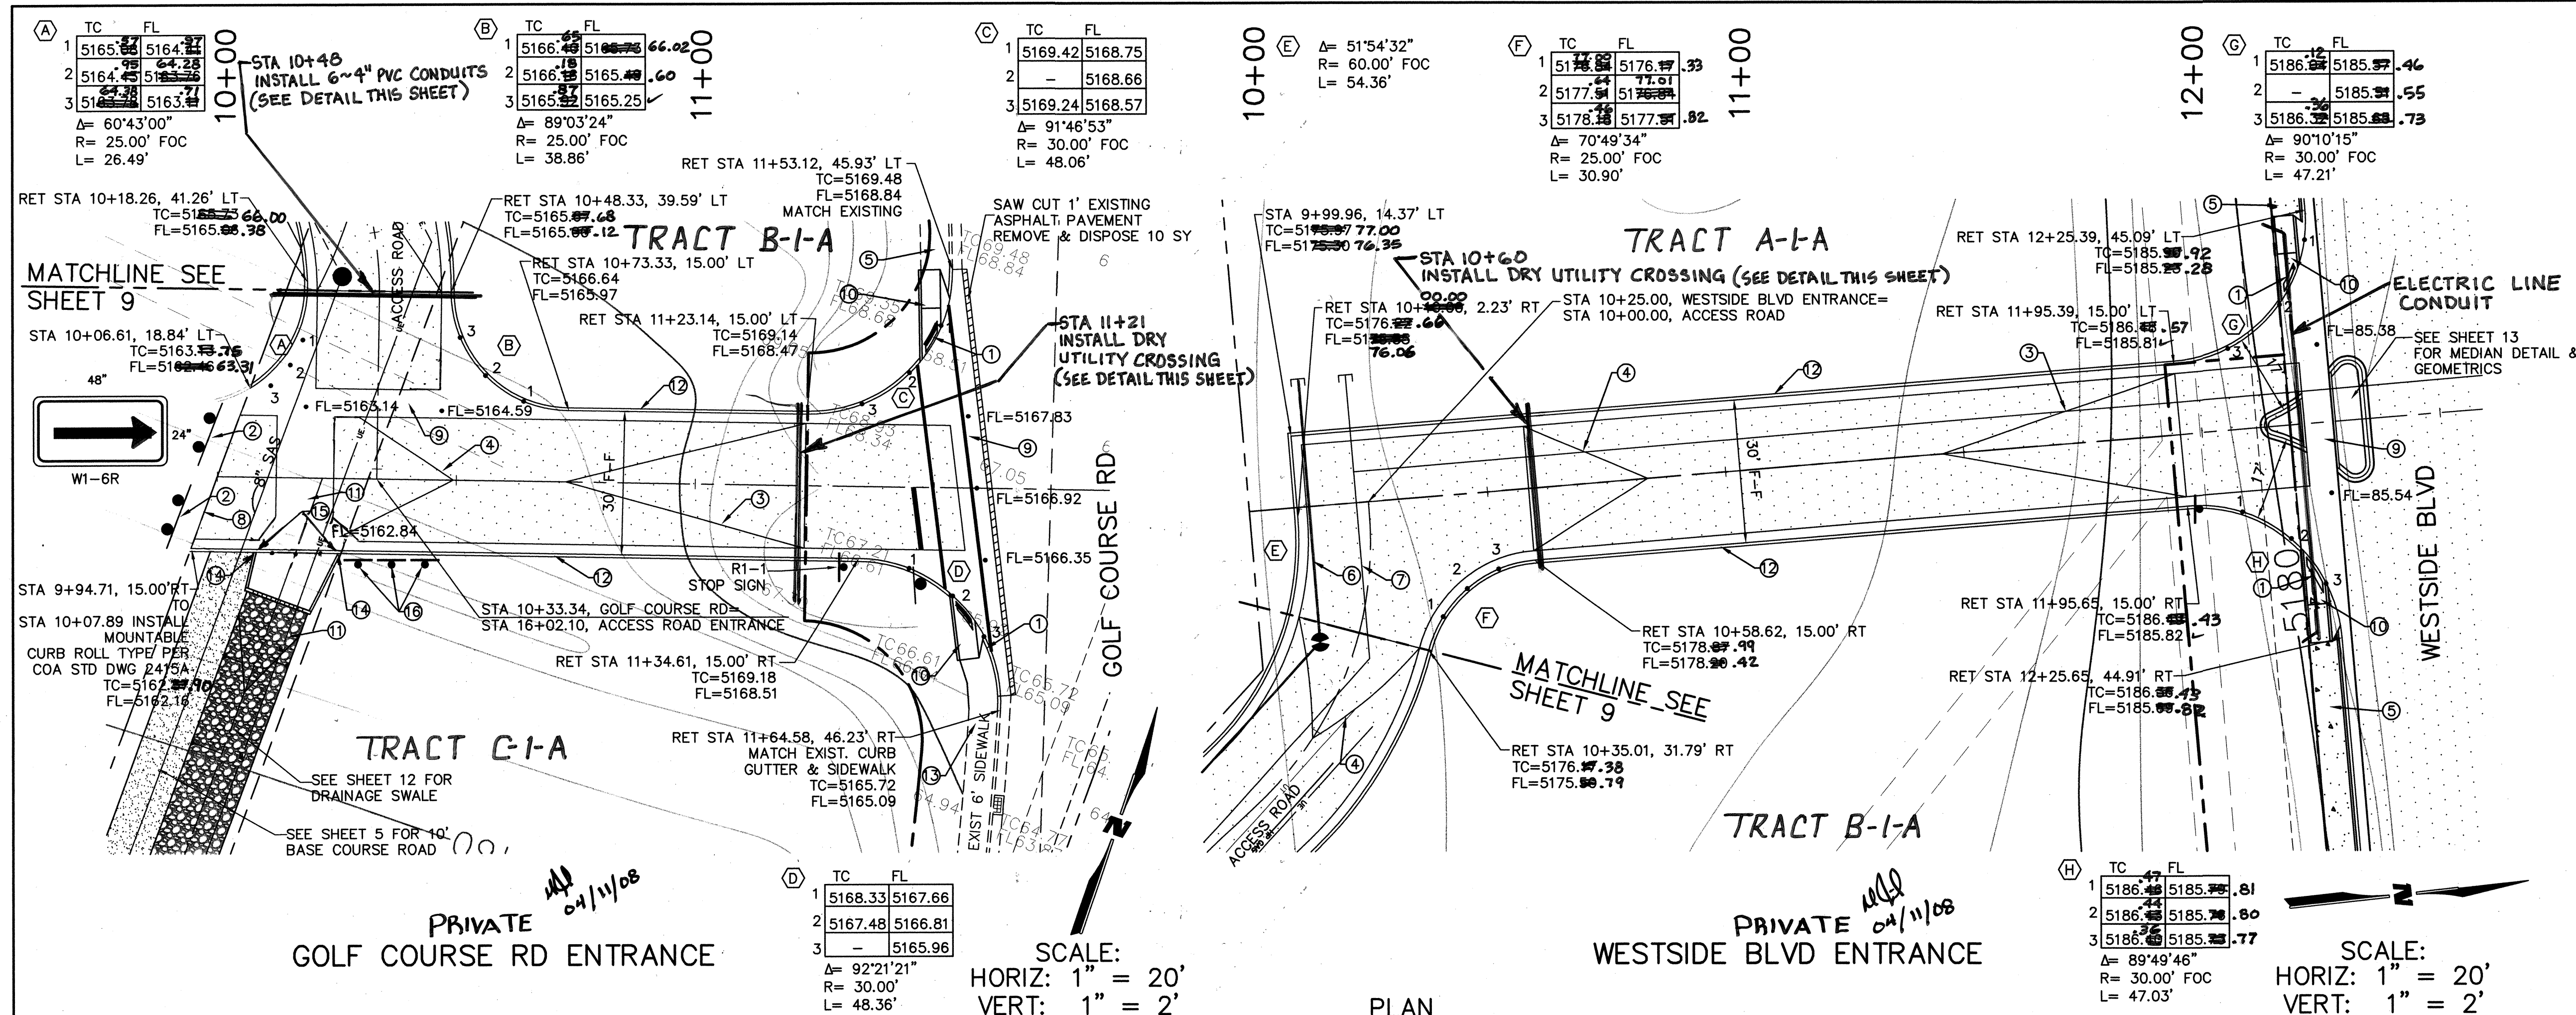


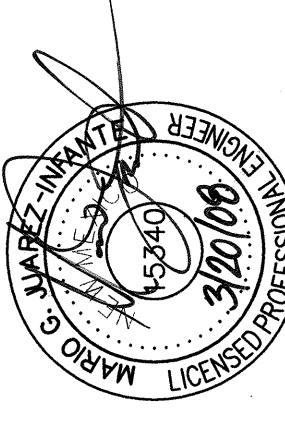LEGEND					
EXISTING INTERMEDIATE CONTOUR EXISTING INDEX CONTOUR EXISTING PROPERTY LINE ● EXISTING SAS NEW ASPHALT PAVING REMOVE AND DISPOSE AS-BUILT INFORMATION UNIVERSAL CONSTRUCTION CORPORATION CONTRACTOR'S NAME: WCI DATE: 4/08 INSPECTOR'S NAME: WCI DATE: 8/08 FIELD VERIFICATION BY: WCI DATE: 8/08 CORRECTED BY: WCI DATE: 8/08 MICRO-FILM INFORMATION RECORDED BY: NO.					
BENCH MARKS					
ACS BRASS TABLE STAMPED "BLACK 2 1977"					
GEOGRAPHIC POSITION (NAD 1927)					
N.M. STATE PLANE COORDINATES (CENTRAL ZONE)					
X= 372,920.43 Y= 1,530,241.52					
GROUND-TO-GRID FACTOR= 0.9996692					
$\Delta = -001'4.43''$					
SLD 1929 ELEVATION= 5213.926					
NO.					
○ KEY NOTES					
1 DETECTABLE WARNING SURFACE SEE SHEET 15					
2 TYPE III BARRICADES (2) PER COA STD DWG 2803 WITH W1-6R					
3 50' CROWN TRANSITION PER COA STD DWG 2401					
4 25' CROWN TRANSITION PER COA STD DWG 2401					
5 6' SIDEWALK PER COA STD DWG 2430					
6 FUTURE SANITARY SEWER BY OTHERS					
7 FUTURE WATERLINE BY OTHERS					
8 CONCRETE CUT-OFF WALL PER COA STD DWG 2415B					
9 6' CONCRETE VALLEY GUTTER SEE SHEET 8					
10 WHEELCHAIR RAMP PER COA STD DWG 2426 MATCH EXISTING SIDEWALK					
11 12' CONCRETE VALLEY GUTTER PER COA STD DWG 2422					
12 STANDARD CURB & GUTTER PER COA STD DWG 2415A					
13 REMOVE, DISPOSE AND REPLACE EXISTING SIDEWALK TO NEAREST JOINT SEE KEY NOTE 5					
14 TIE STANDARD CURB & GUTTER TO HEADER CURB SEE DETAIL SHEET 16					
15 DERESSED CURB PER COA STD DWG 2415A					
16 DIRECTIONAL SIGN SEE SHEET 14					
ENGINEER'S SEAL					
					
SURVEY INFORMATION					
FIELD NOTES					
DATE					
BY					
NO.					
1					
2					
3					
4					
5					
6					
7					
REMARKS					
BY					
NO. DATE					
REVISIONS					
WILSON & COMPANY, ENGINEERS & ARCHITECTS					
DESIGNED BY MJJ JAN 2008					
DRAWN BY STAFF JAN 2008					
CHECKED BY MJJ JAN 2008					
RECORD DRAWING					
DATE 8/20/08					
CITY OF ALBUQUERQUE					
PUBLIC WORKS DEPARTMENT					
ENGINEERING GROUP					
VJW INC. STORAGE					
WESTSIDE BLVD & GOLF COURSE RD ENTRANCE					
PLAN & PROFILE					
Design Review Committee					
City Engineer Approval					
APPROVED MAY 16 2008 DESIGN REVIEW COMMITTEE					
Last Design Update					
Mo./Day/Yr.					
Mo./Day/Yr.					
Sheet 7 Of 22					

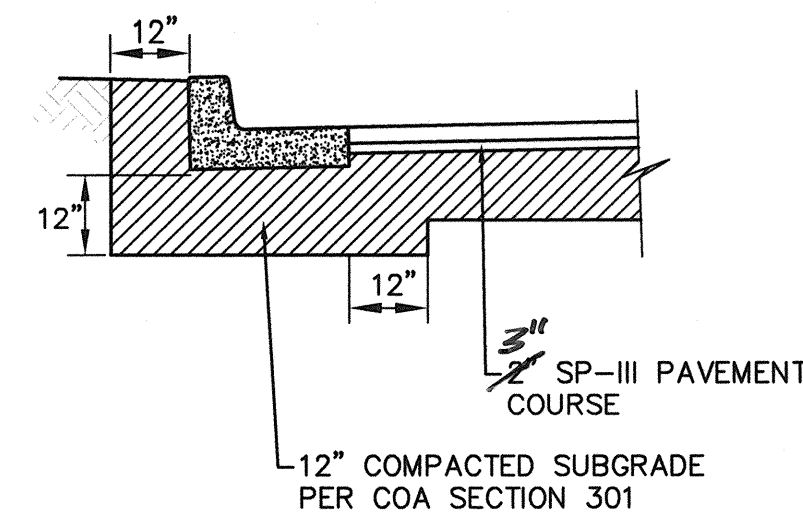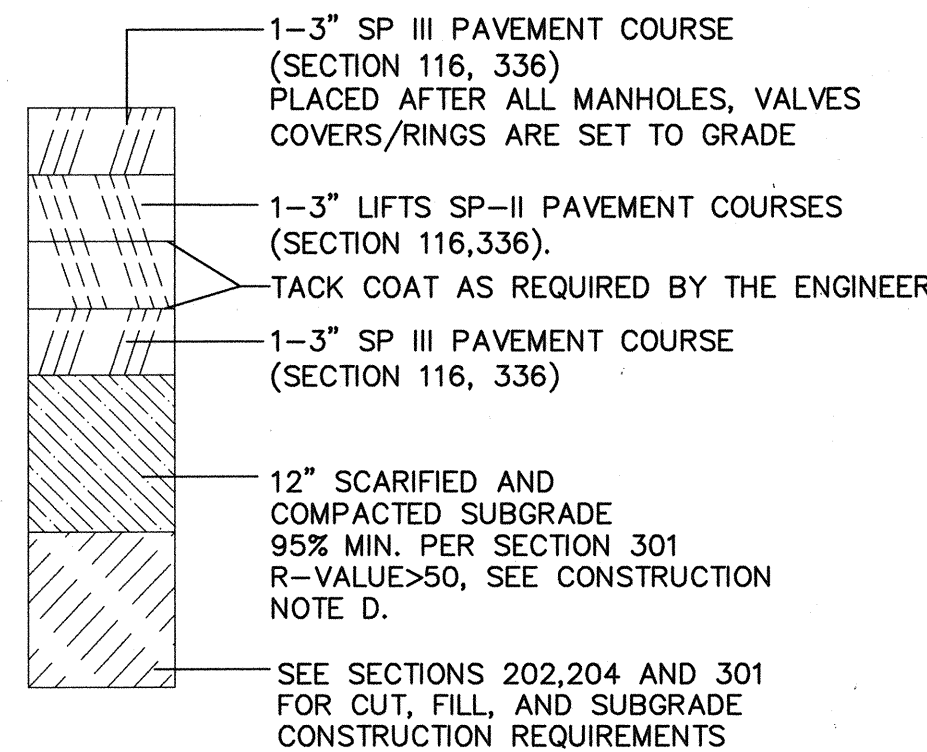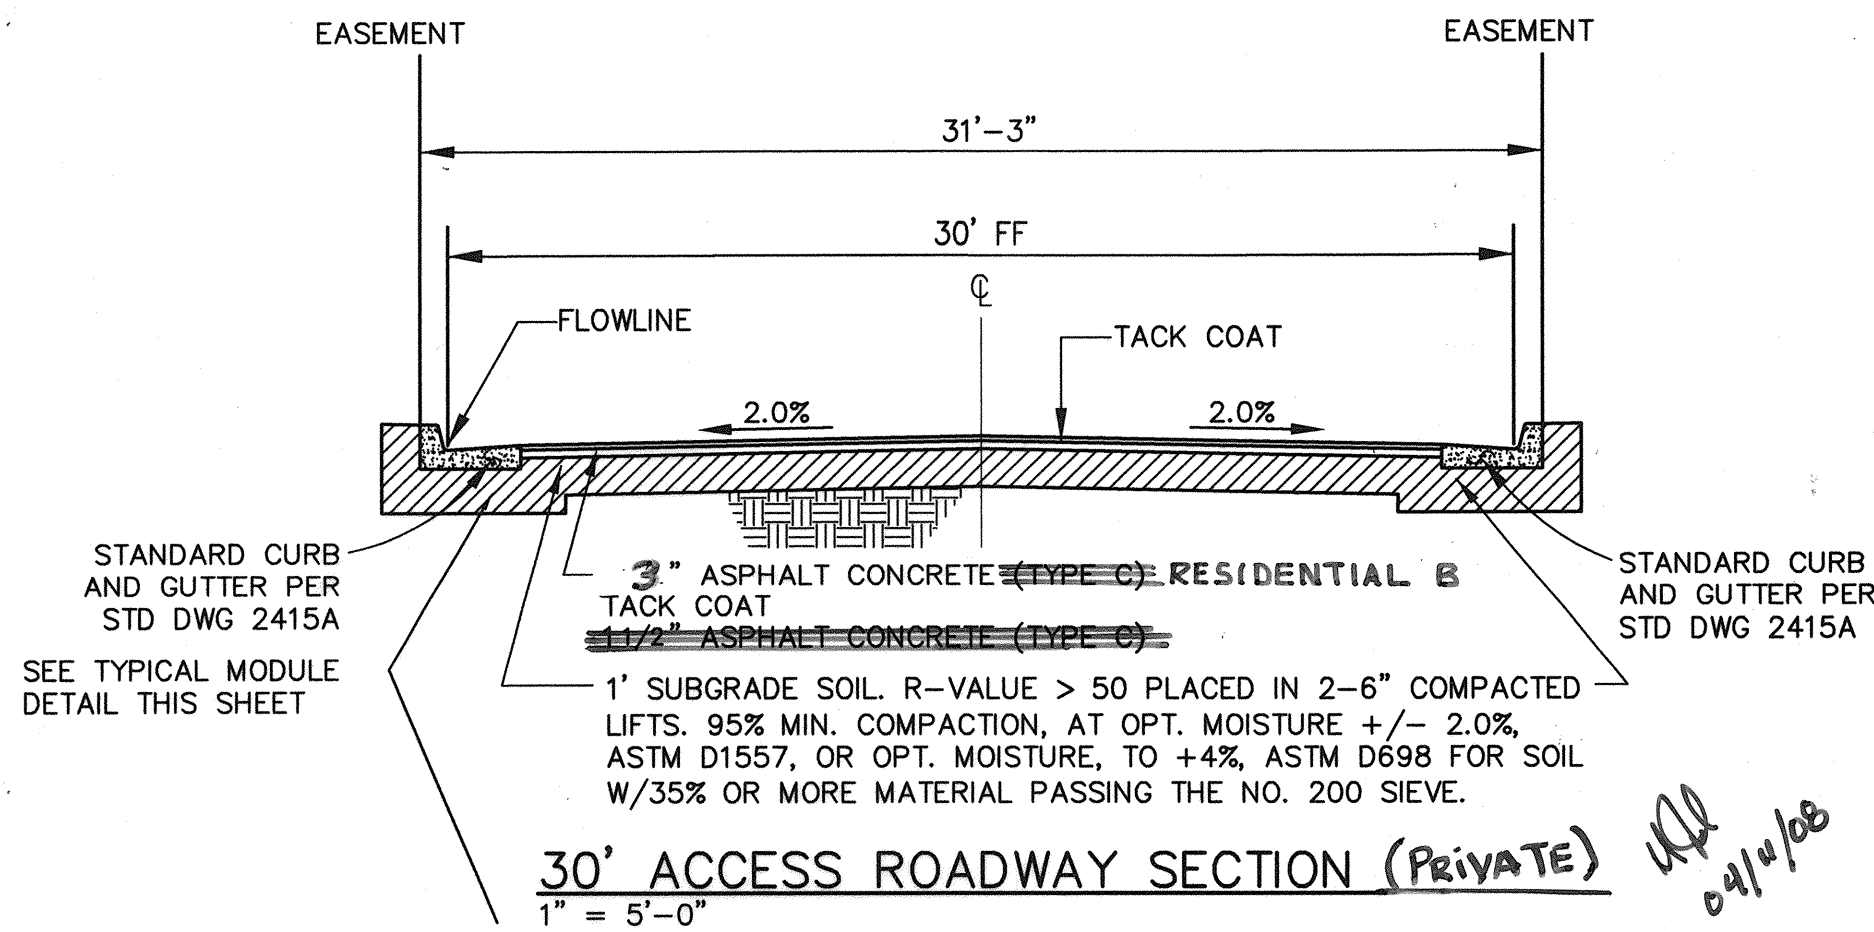

GENERAL NOTES:
1. STATIONS & OFFSETS REFERENCE FACE OF CURB.

CONSTRUCTION NOTES:
A. PAVING TO BE CONSTRUCTED AS DETAILED PER COA STD. DWG. 2407, EXCEPT PAVING SECTIONS SHALL CONSIST OF COMPONENTS SHOWN.
B. EARTH WORK FOR THE PROJECT SHALL BE PERFORMED AS DETAILED IN SECTION 200, COA STANDARD SPECIFICATIONS FOR PUBLIC WORKS CONSTRUCTION.
C. PRIOR TO PLACING BASE COURSE AND ASPHALTIC CONCRETE, AN APPROVED SOIL STERILANT SHALL BE APPLIED PER MANUFACTURER'S RECOMMENDATIONS.
D. TESTING SHALL BE PERFORMED ON THE SUBGRADE SOILS DURING CONSTRUCTION, PER SECTION 301 STANDARD SPECIFICATIONS FOR PUBLIC WORKS CONSTRUCTION, BUT NOT LESS THAN EVERY 250 SY OF SUBGRADE PREP. TO CONFIRM R-VALUE OF 50 OR GREATER. *IF DURING CONSTRUCTION SUBGRADE SOILS WITH R-VALUE LESS THAN 50 ARE ENCOUNTERED THE AREA WITH THIS SOIL SHALL BE OVER EXCAVATED 2 FEET BELOW FINISHED SUBGRADE AND IMPORTED SUBGRADE SOIL. R-VALUE > 50 PLACED IN 4-6" COMPACTED LIFTS. 95% MIN. COMPACTION, AT OPT. MOISTURE +/- 2.0%, ASTM D1557, OR OPT. MOISTURE, TO +4%, ASTM D698 FOR SOIL W/35% OR MORE MATERIAL PASSING THE NO. 200 SIEVE SHALL BE INSTALLED.

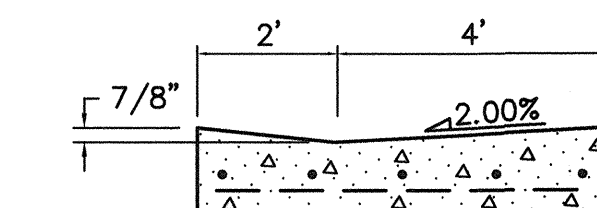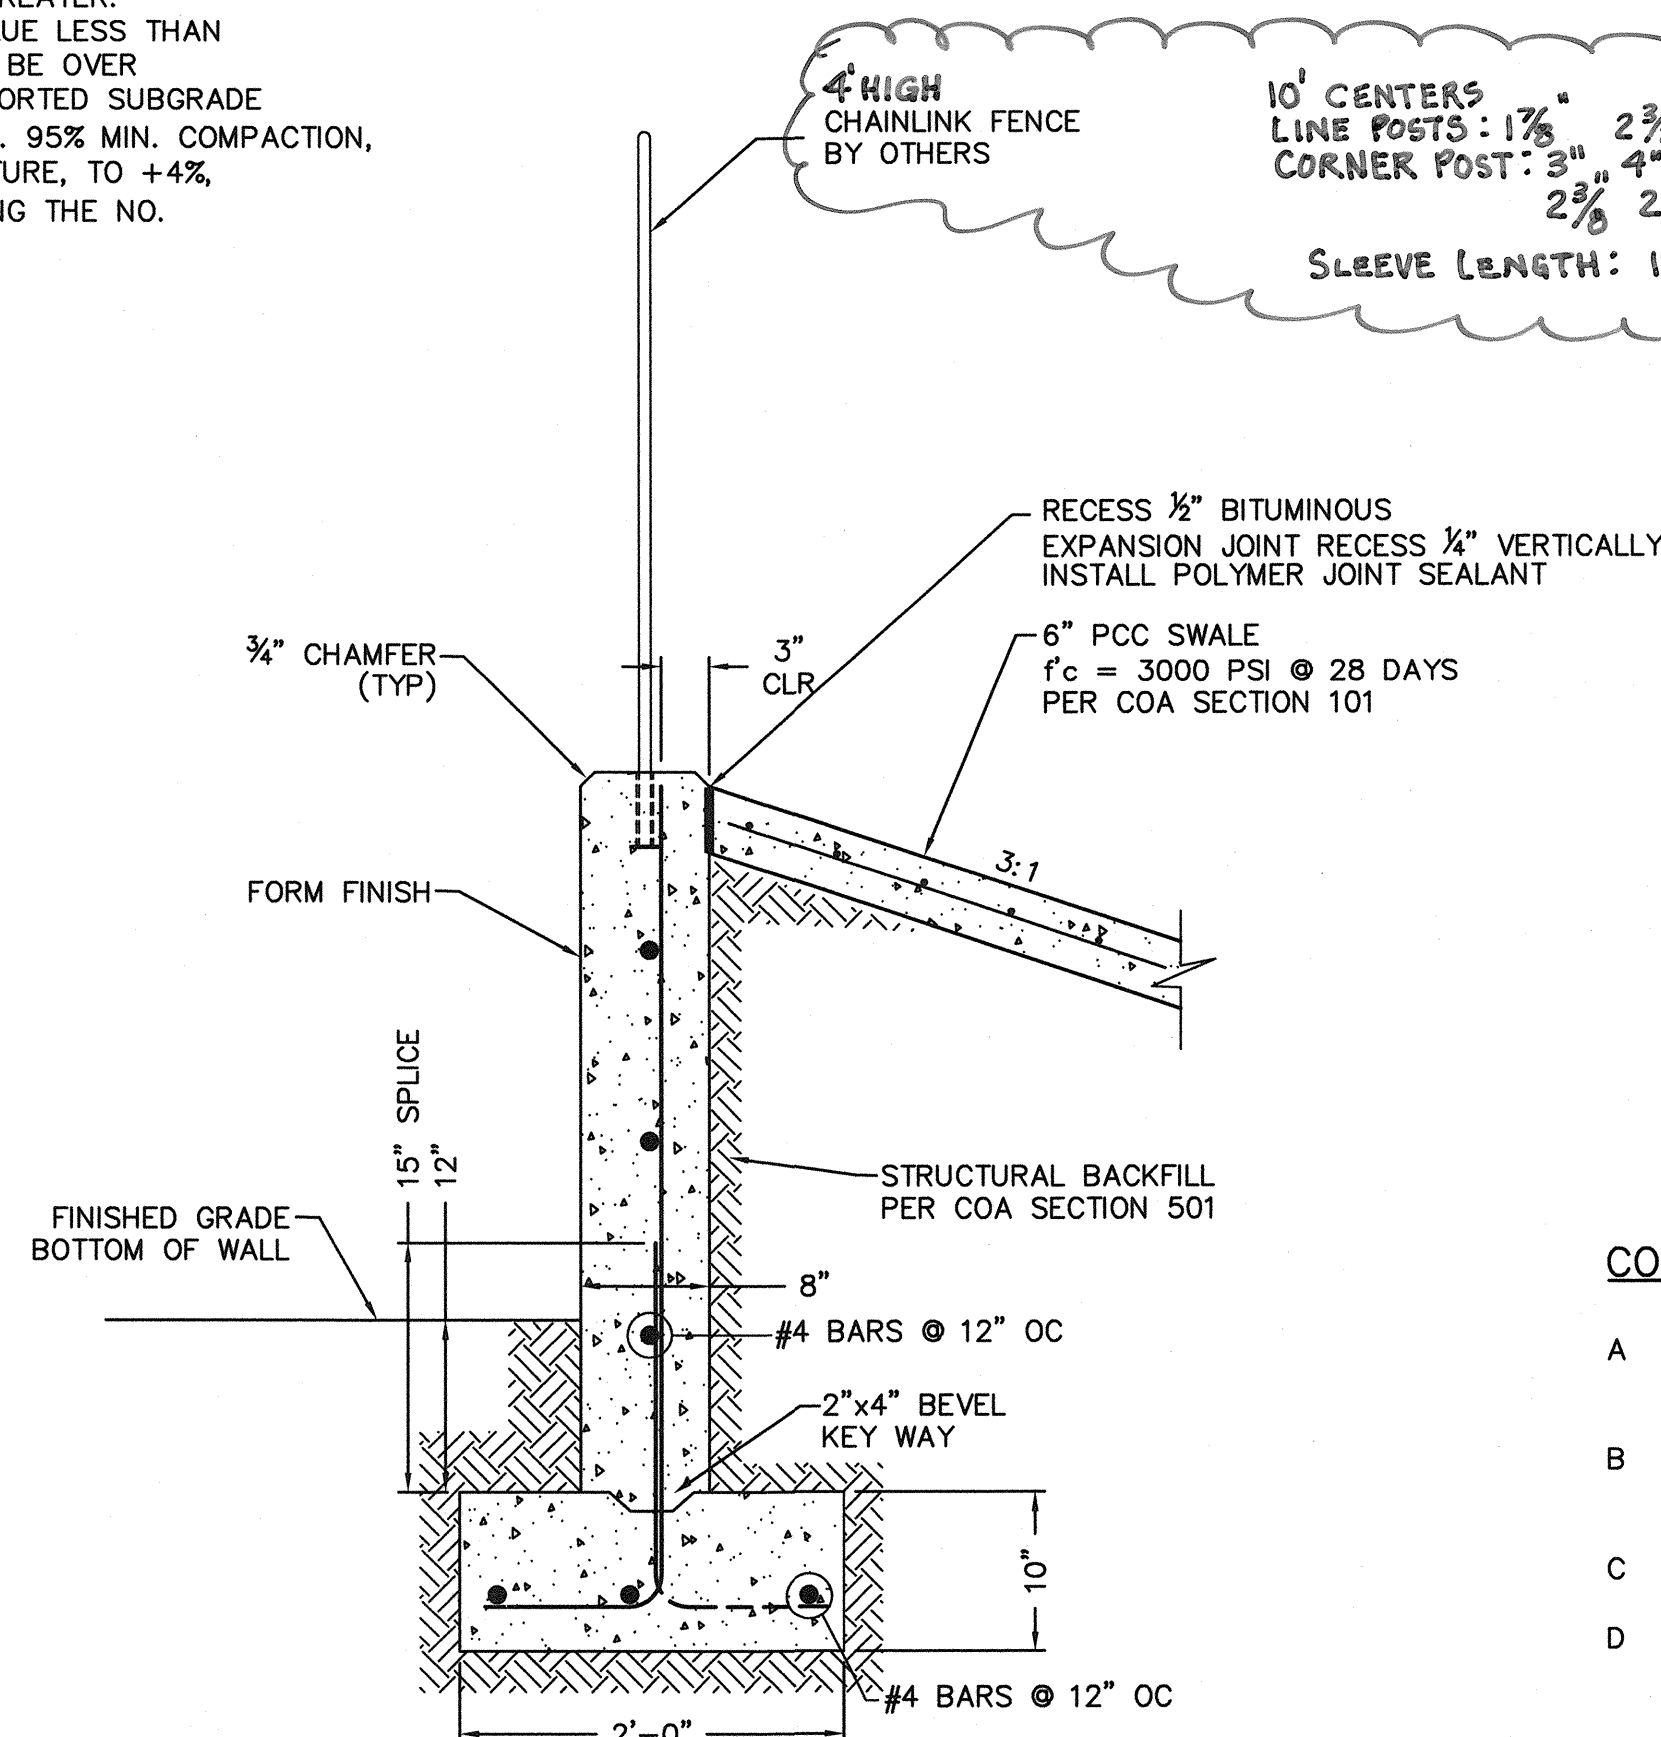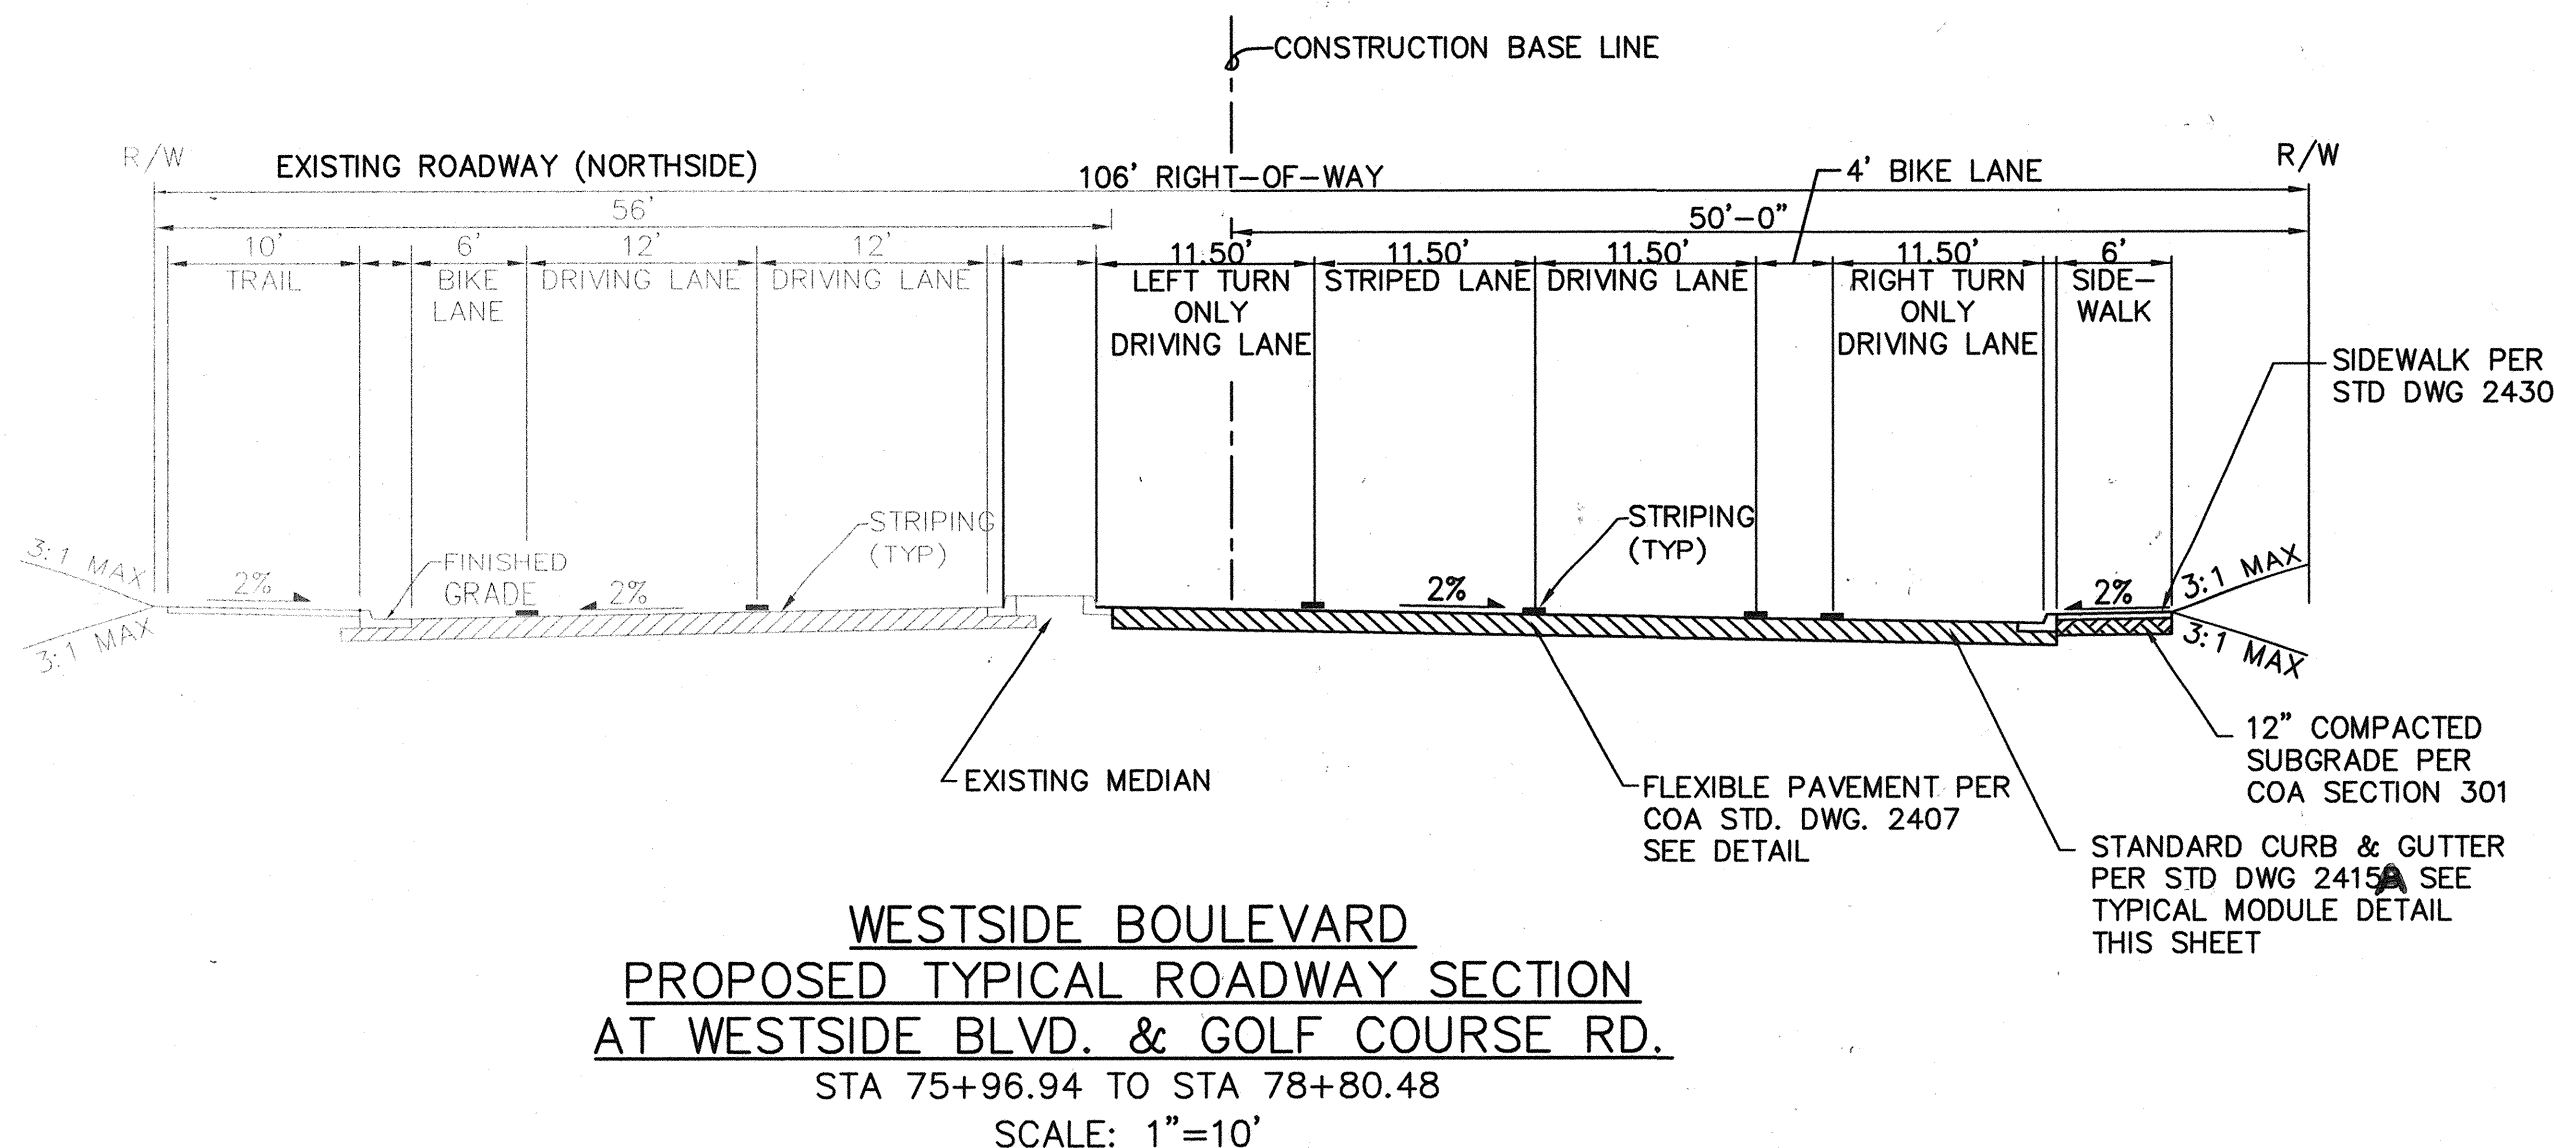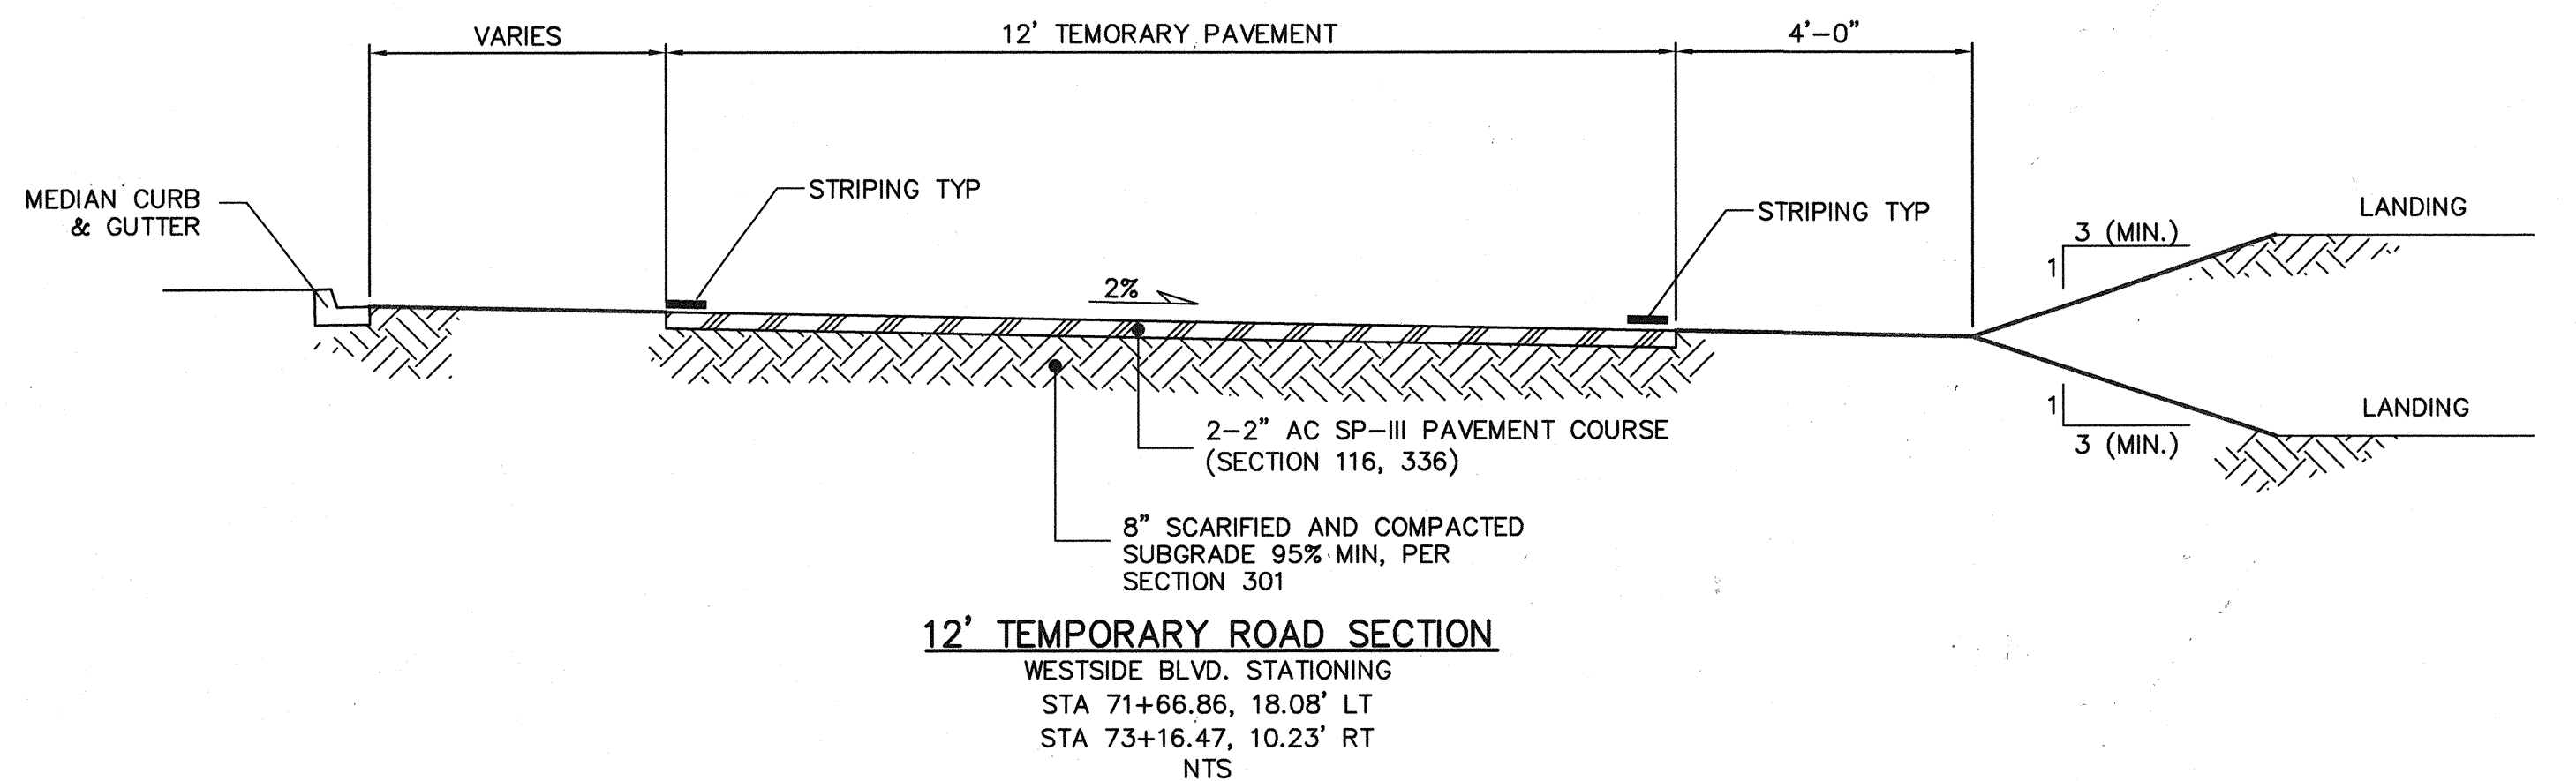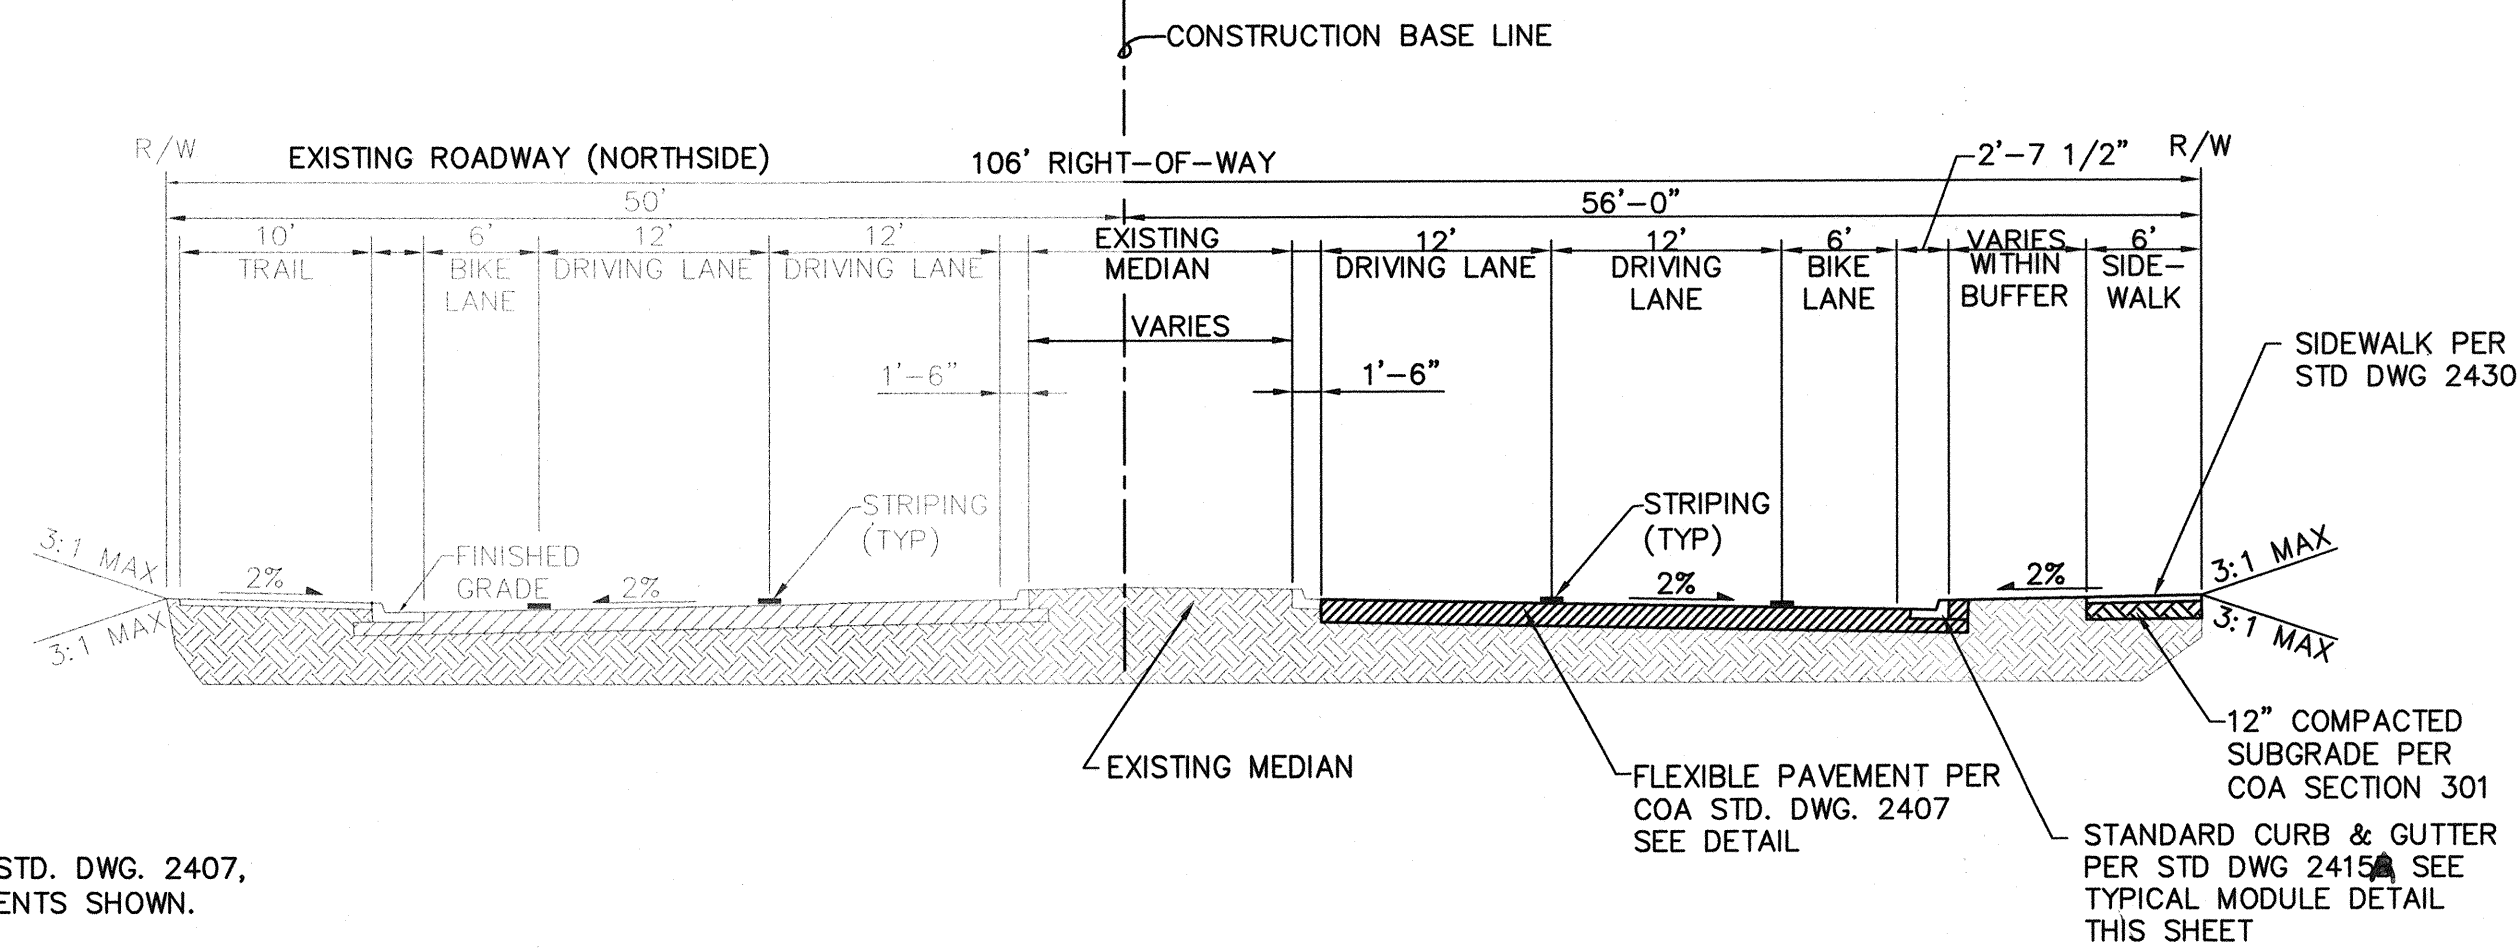

CONSTRUCTION NOTES:



- A. INSTALL VERTICAL CONSTRUCTION JOINTS AT 10'-0" O.C.
B. INSTALL VERTICAL EXPANSION JOINTS AT 30'-0" O.C.
C. DO NOT GROUT FILL SNAP TIE HOLES.
D. PROVIDE FENCE SLEEVE POST PER CHAIN LINK FENCE MANUFACTURER REQUIREMENTS. ALIGN FENCE POSTS WITH VERTICAL WALL JOINTS.

CITY OF ALBUQUERQUE PUBLIC WORKS DEPARTMENT ENGINEERING GROUP			
VJW STORAGE INC TYPICAL SECTION & MISCELLANEOUS DETAILS			
DESIGN REVIEW COMMITTEE	CITY ENGINEER APPROVAL	Mo./Day/Yr.	Mo./Day/Yr.
APR 21 2008 DESIGN REVIEW COMMITTEE	MAY 16 2008 DESIGN REVIEW COMMITTEE		
City Project No.	Zone Map No.	Sheet	Of
7718.83	A-12	8	22

RECORD DRAWING
DATE 8/20/08

WILSON & COMPANY
4900 LANG AVE. N.E.
SUITE 200
ALBUQUERQUE, NEW MEXICO
87109
(505) 348-4000
FAX (505) 348-4072
www.wilsonco.com

WCEA #0660003900

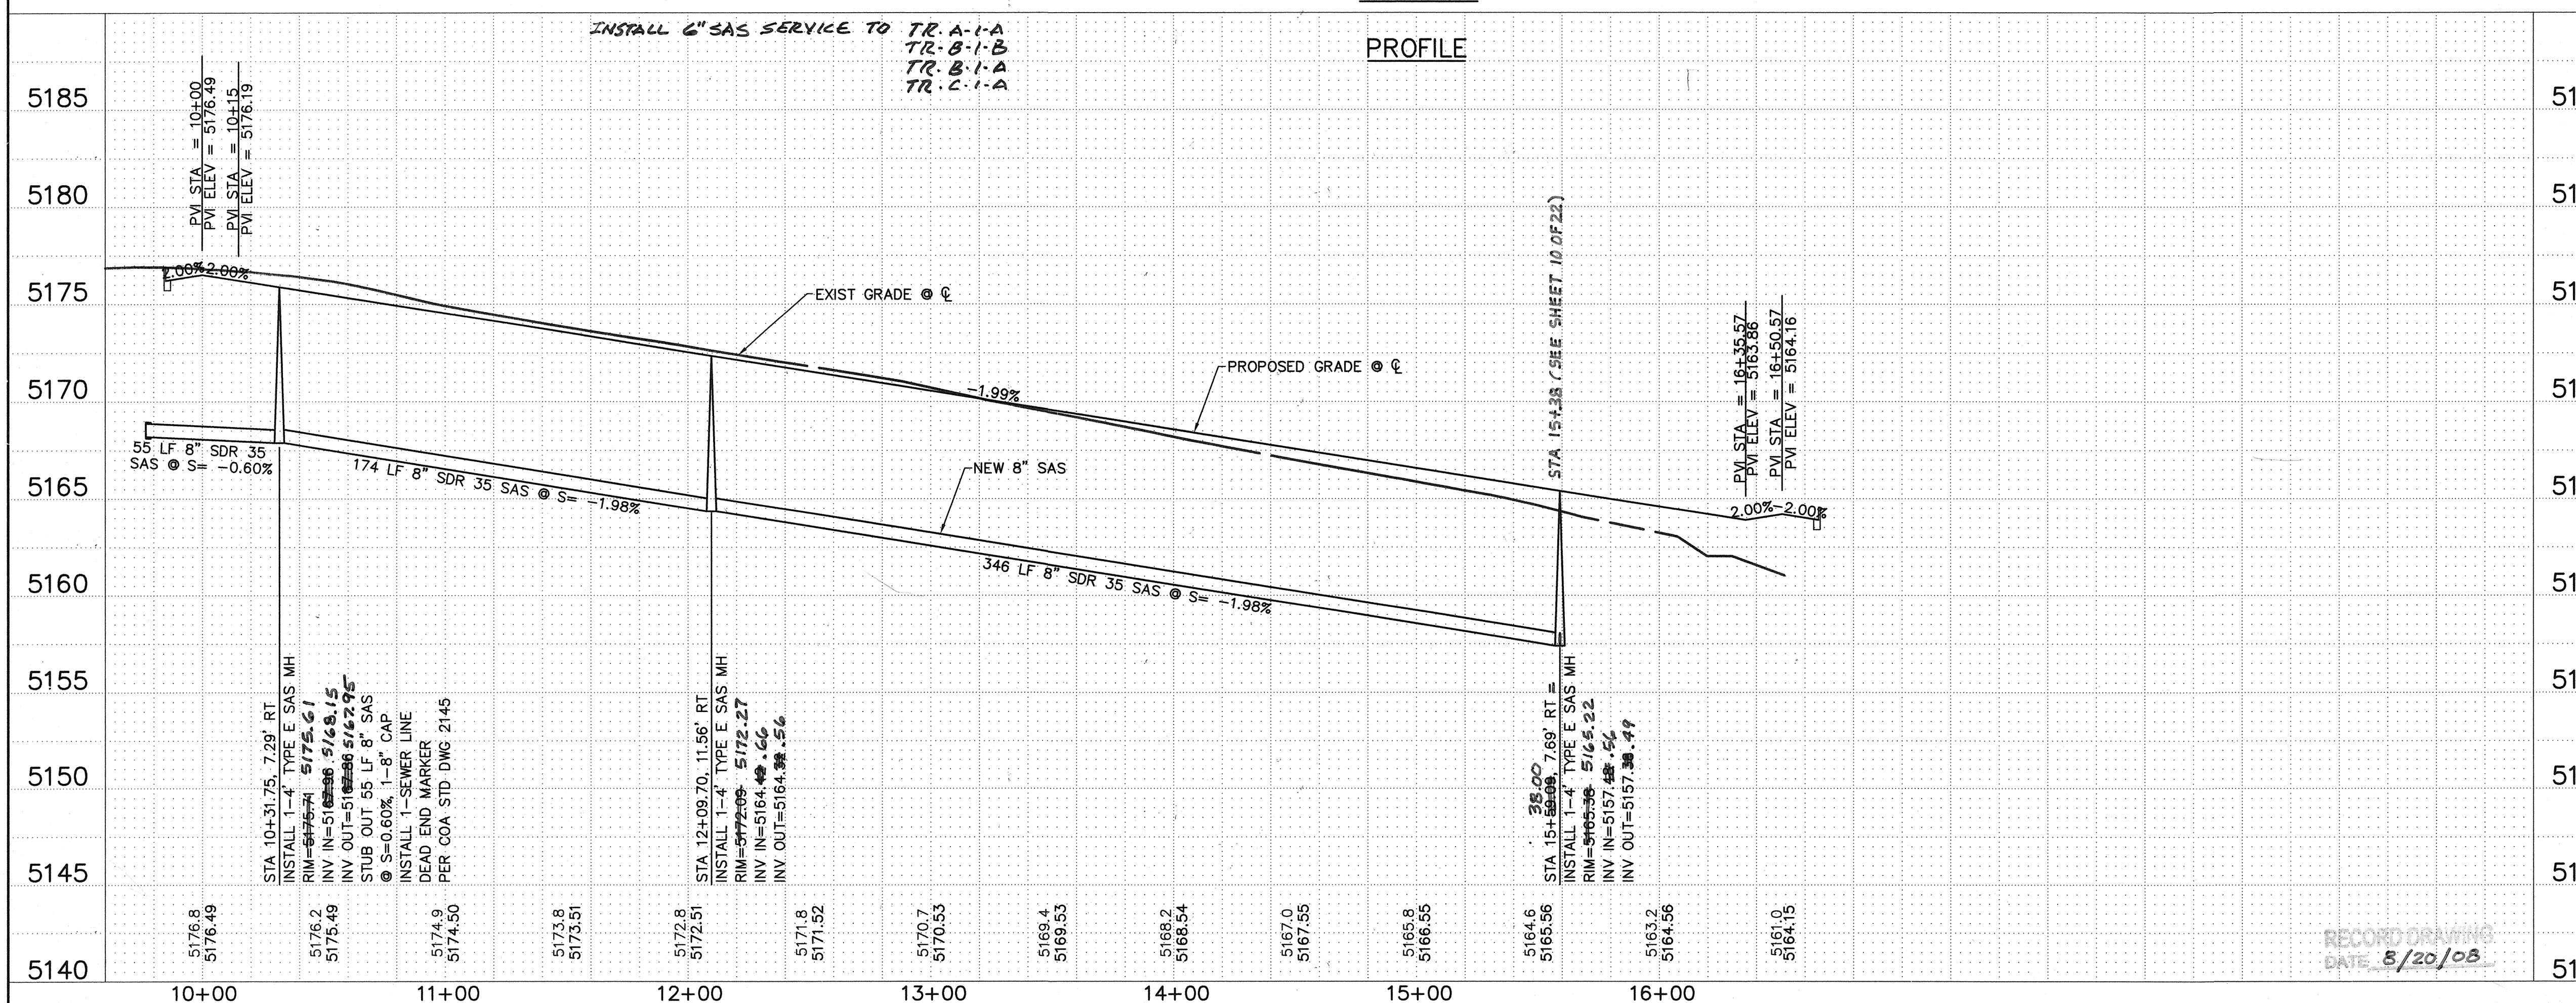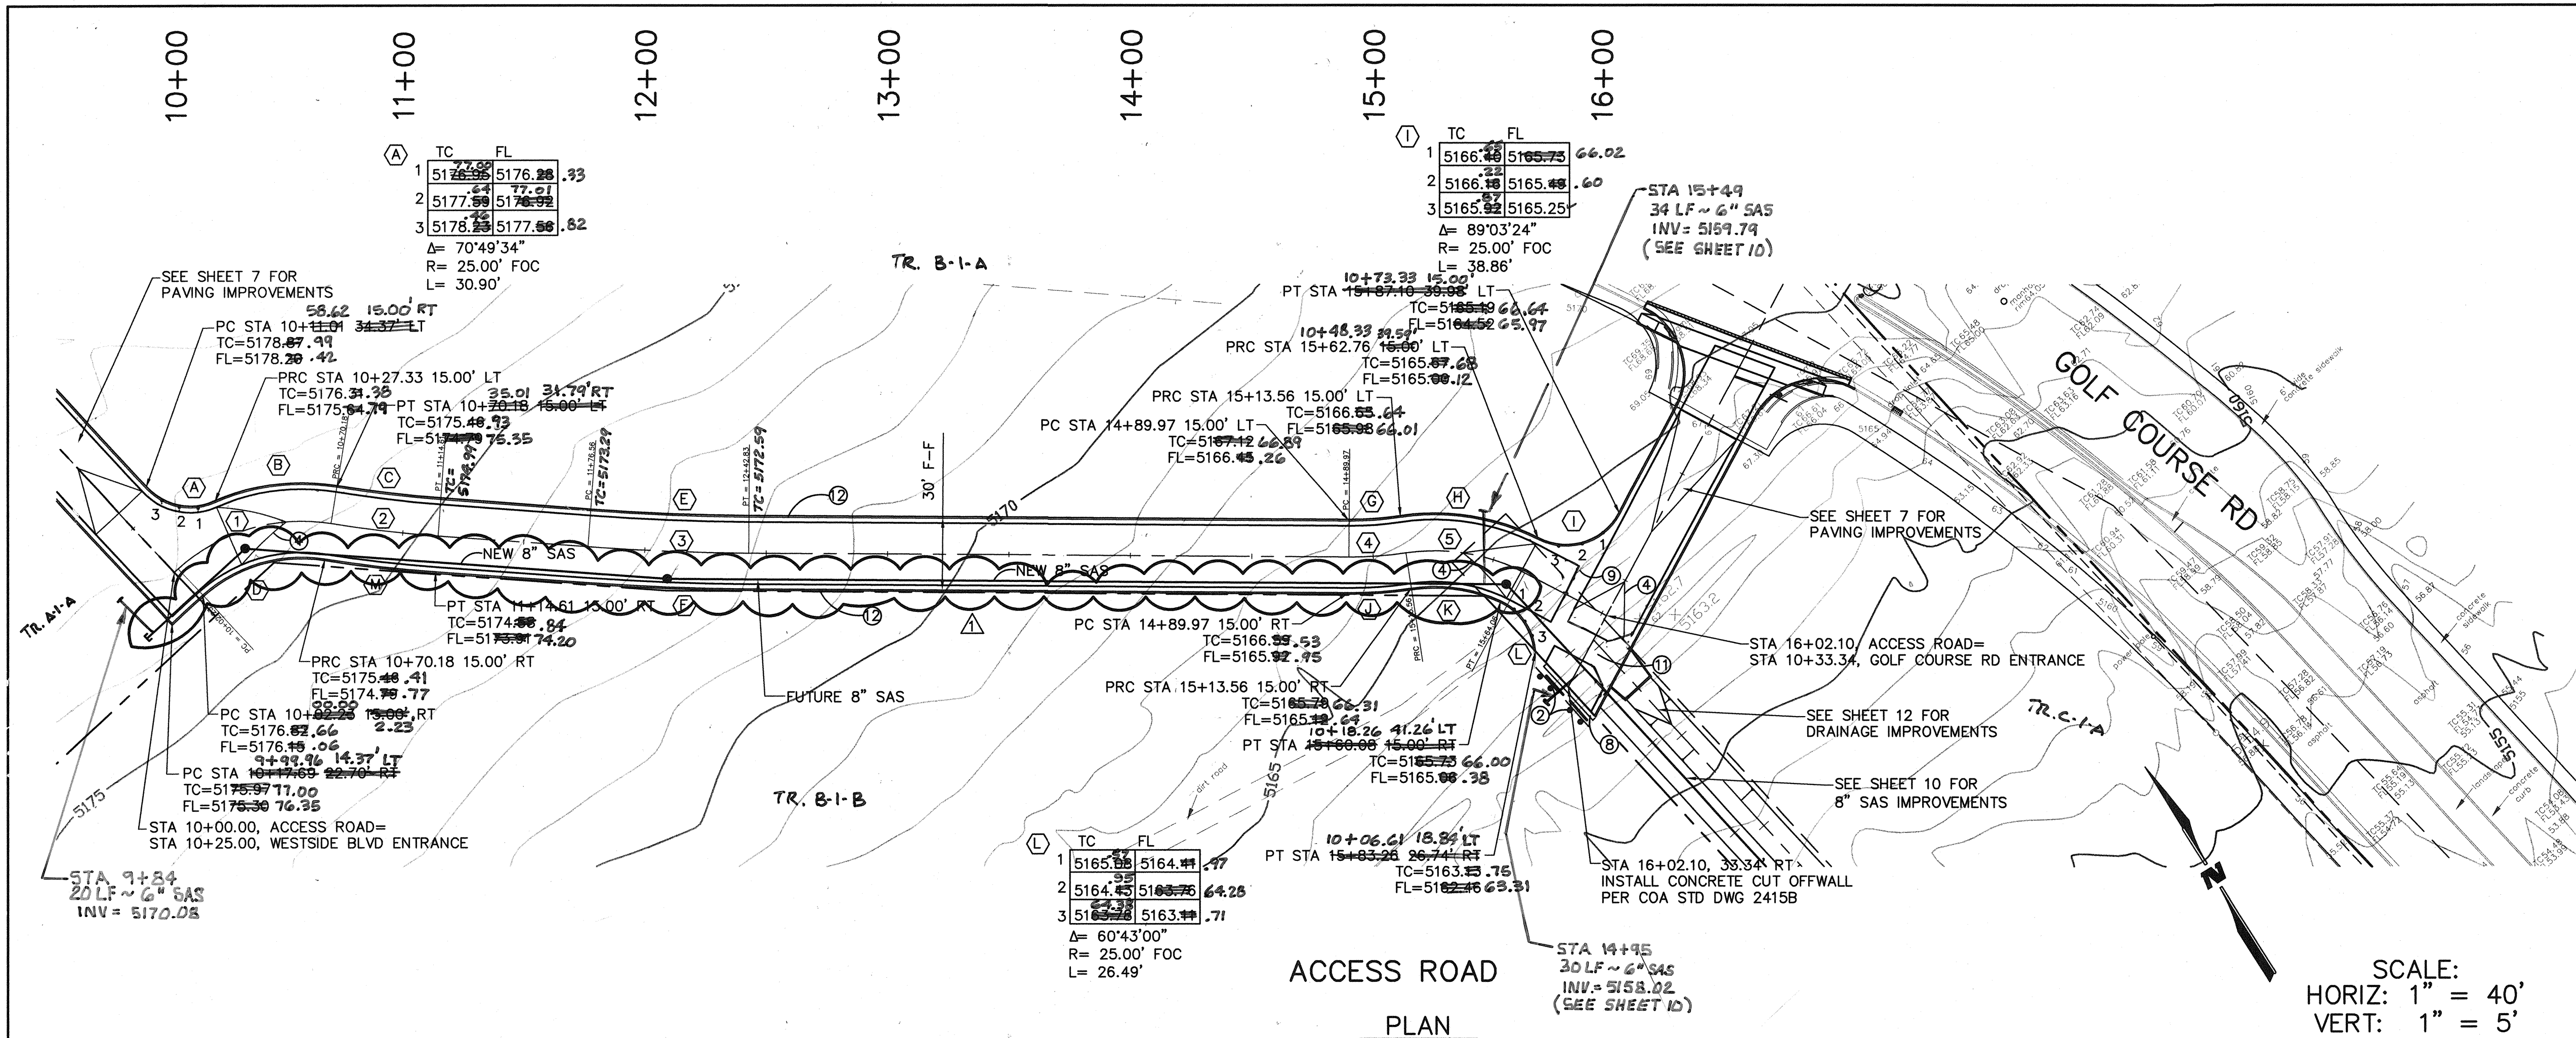

KEY NOTES

- 1 DETECTABLE WARNING SURFACE SEE SHEET 15
- 2 TYPE III BARRICADES PER COA STD DWG 2803
- 3 50' CROWN TRANSITION PER COA STD DWG 2401
- 4 25' CROWN TRANSITION PER COA STD DWG 2401
- 5 6' SIDEWALK PER COA STD DWG 2430
- 6 WHEELCHAIR RAMP CASE I PER COA STD DWG 2441
- 7 WHEELCHAIR RAMP CASE II PER COA STD DWG 2441
- 8 CONCRETE CUT-OFF WALL PER COA STD DWG 2415B
- 9 6' CONCRETE VALLEY GUTTER PER COA STD DWG 2420
- 10 WHEELCHAIR RAMP PER COA STD DWG 2426
- 11 12' CONCRETE VALLEY GUTTER PER COA STD DWG 2422
- 12 STANDARD CURB & GUTTER PER COA STD DWG 2415A

CURVE DATA-CL

1 CURVE DATA	2 CURVE DATA
Δ=51°54'32"	Δ=05°05'30"
R=75.00'	R=500.00'
L=67.95'	L=44.43'
T=36.51'	T=22.23'

3 CURVE DATA	4 CURVE DATA
Δ=03°48'02"	Δ=36°41'25"
R=99.00'	R=78.85'
L=66.27'	L=50.48'
T=33.15'	T=26.15'

CURVE DATA-RETURNS

5 CURVE DATA	6 CURVE DATA
Δ=09°04'21"	Δ=05°05'30"
R=149.00'	R=485.00'
L=23.59'	L=43.10'
T=11.82'	T=21.56'

7 CURVE DATA	8 CURVE DATA
Δ=32°44'06"	Δ=03°48'03"
R=60.00'	R=98.40'
L=51.42'	L=65.27'
T=26.43'	T=32.65'

9 CURVE DATA	10 CURVE DATA
Δ=03°48'02"	Δ=09°04'21"
R=101.00'	R=134.00'
L=67.26'	L=21.22'
T=33.64'	T=10.63'

11 CURVE DATA	12 CURVE DATA
Δ=35°44'49"	Δ=09°04'21"
R=93.85'	R=164.00'
L=58.55'	L=25.97'
T=30.26'	T=13.01'

13 CURVE DATA	14 CURVE DATA
Δ=36°41'25"	Δ=60°43'00"
R=63.85'	R=25.00'
L=40.89'	L=26.49'
T=21.17'	T=14.64'

15 CURVE DATA	16 CURVE DATA
Δ=05°05'30"	Δ=05°05'30"
R=515.00'	R=515.00'
L=45.77'	L=45.77'
T=22.90'	T=22.90'

ENGINEER'S SEAL

MADE IN U.S.A. 15340 5/11/08

WILSON & COMPANY, ENGINEERS & ARCHITECTS

DESIGNED BY: MUJ
DRAWN BY: STAFF
CHECKED BY: MUJ


**CITY OF ALBUQUERQUE
PUBLIC WORKS DEPARTMENT
ENGINEERING GROUP**

**VJW INC. STORAGE
ACCESS ROAD PAVING
PLAN & PROFILE**

Design Review Committee: APPROVED MAY 27 2008
City Engineer Approval: APPROVED MAY 27 2008

City Project No: 7718.83
Zone Map No: A-12


Sheet 9 of 22

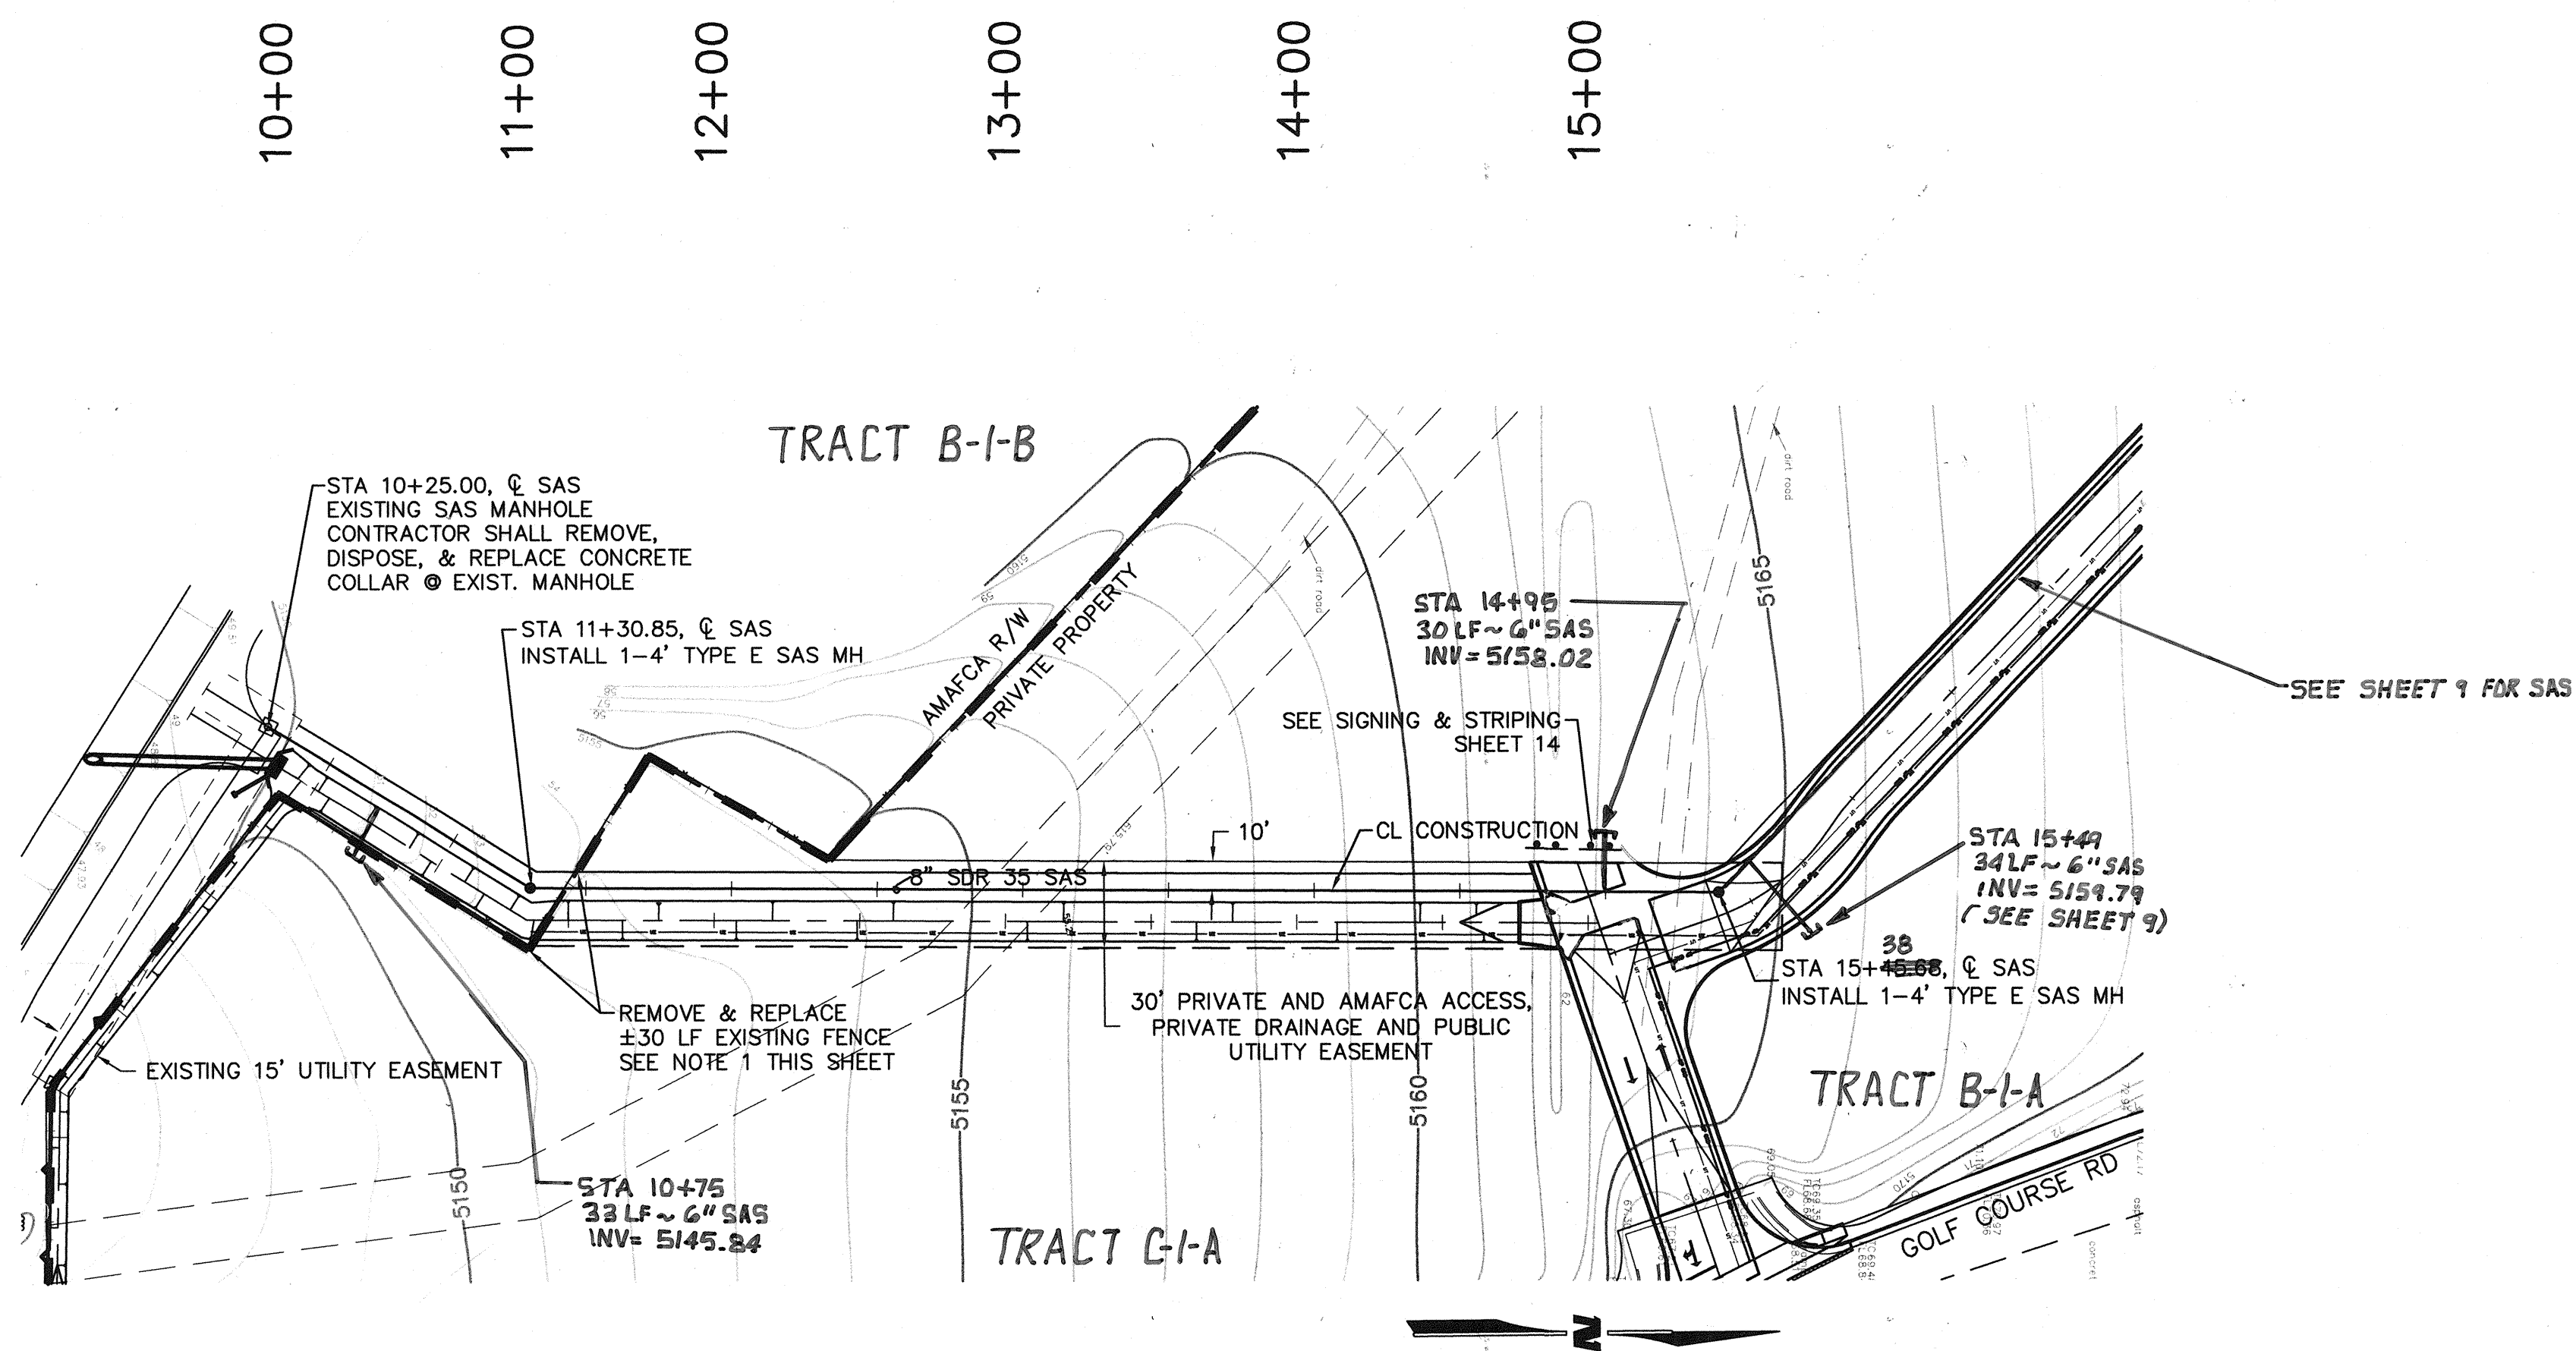

8" SANITARY SEWER

SCALE:
HORIZ: 1" = 50'
VERT: 1" = 10'

PLAN

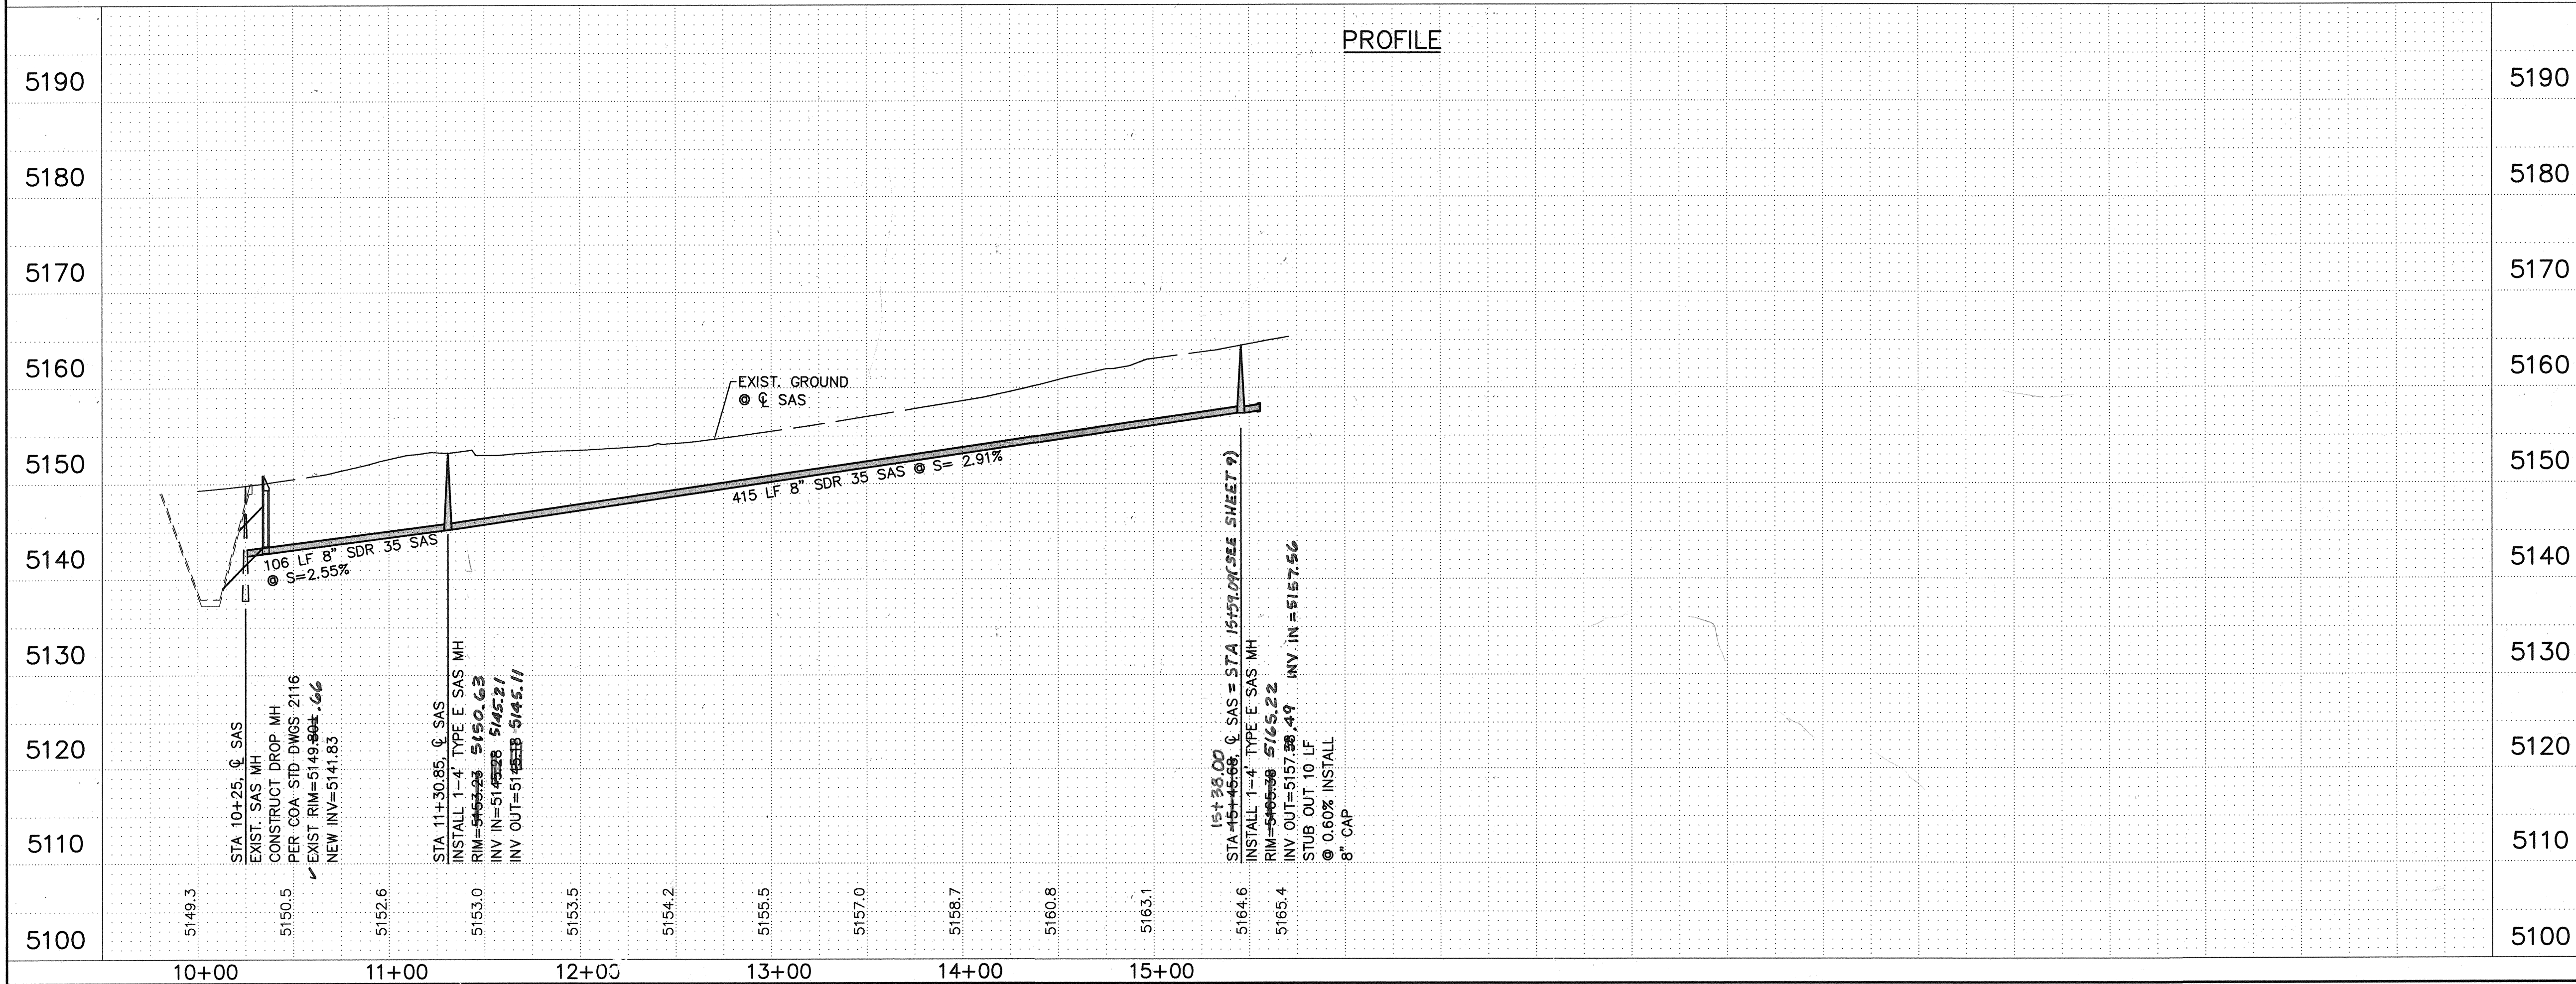

LEGEND

NOTES:

1. REMOVAL & PLACEMENT OF NEW FENCING SHALL BE "BARBLESS" BARBED WIRE WITH TWISTED STRANDS AT THE DIRECTION OF AMAFCA. CONTACT KURT WAGENER @ 505-884-2215.

SURVEY INFORMATION			BENCH MARKS		AS-BUILT INFORMATION	
FIELD NOTES						
NO.	BY	DATE			CONTRACTOR	UNIVERSAL CONSTRUCTORS
1	WCI	4/7/68	ACS BRASS TABLET STAMPED "BLACK 2 1977"		WORK STARTED BY	WCI DATE 4/6/68
2	WCI	4/18/68	GEOGRAPHIC POSITION (NAD 1927)		INSPECTOR RECEIVED BY	WCI DATE 4/6/68
3	WCI	4/31/68	N.M. STATE PLANE COORDINATES (CENTRAL ZONE)		FIELD VERIFICATION BY	WCI DATE 4/6/68
4	WCI	4/30/68	X = 372,920.43 Y = 1,530,241.52		CORRECTED BY	WCI DATE 4/6/68
5	WCI	9/28/68	GROUND-TO-GRID FACTOR = 0.9996692		MICRO-FILM INFORMATION	
6	WCI	6/17/68	$\Delta = -00'014.3"$		RECORDED BY	DATE
7	WCI	6/19/68	SLD 1929 ELEVATION = 5213.926		NO.	

ENGINEER'S SEAL

[illegible]

RECORD DRAWING
DATE 8/20/08

Mark Jensen 4/16/08
NMUI DATE

CITY OF ALBUQUERQUE
PUBLIC WORKS DEPARTMENT
ENGINEERING GROUP

VJW STORAGE
8" SANITARY SEWER
PLAN & PROFILE

Design Review Committee

APPROVED

APR 21 2008

DESIGN
REVIEW COMMITTEE



City Engineer Approval

MAY 16 2008

DESIGN
REVIEW COMMITTEE

Last Design Update

City Project No.	Zone Map No.	Sheet	Of
7718.83	A-12	10	22

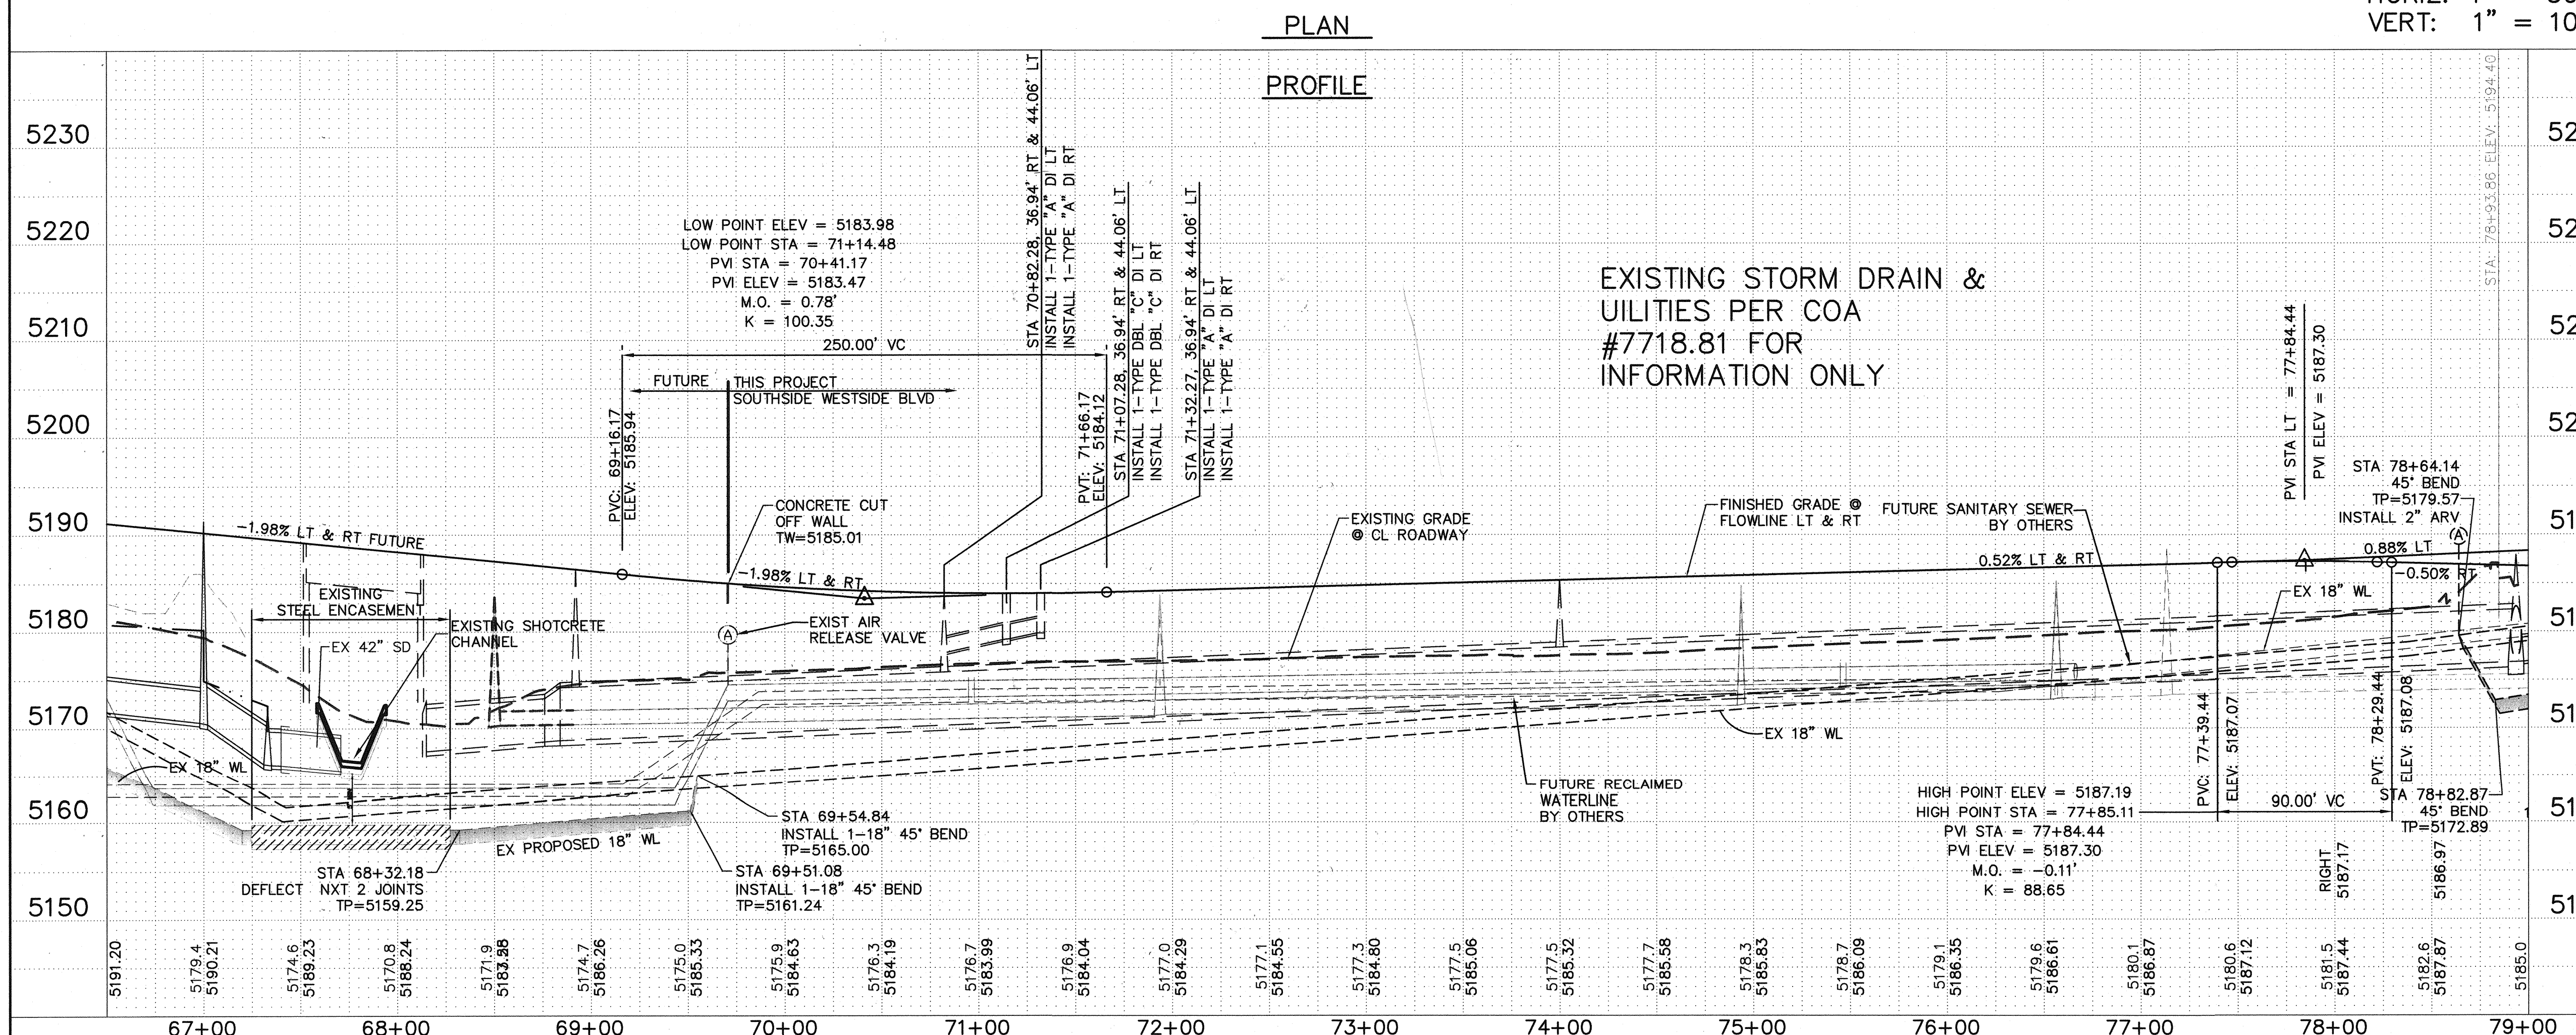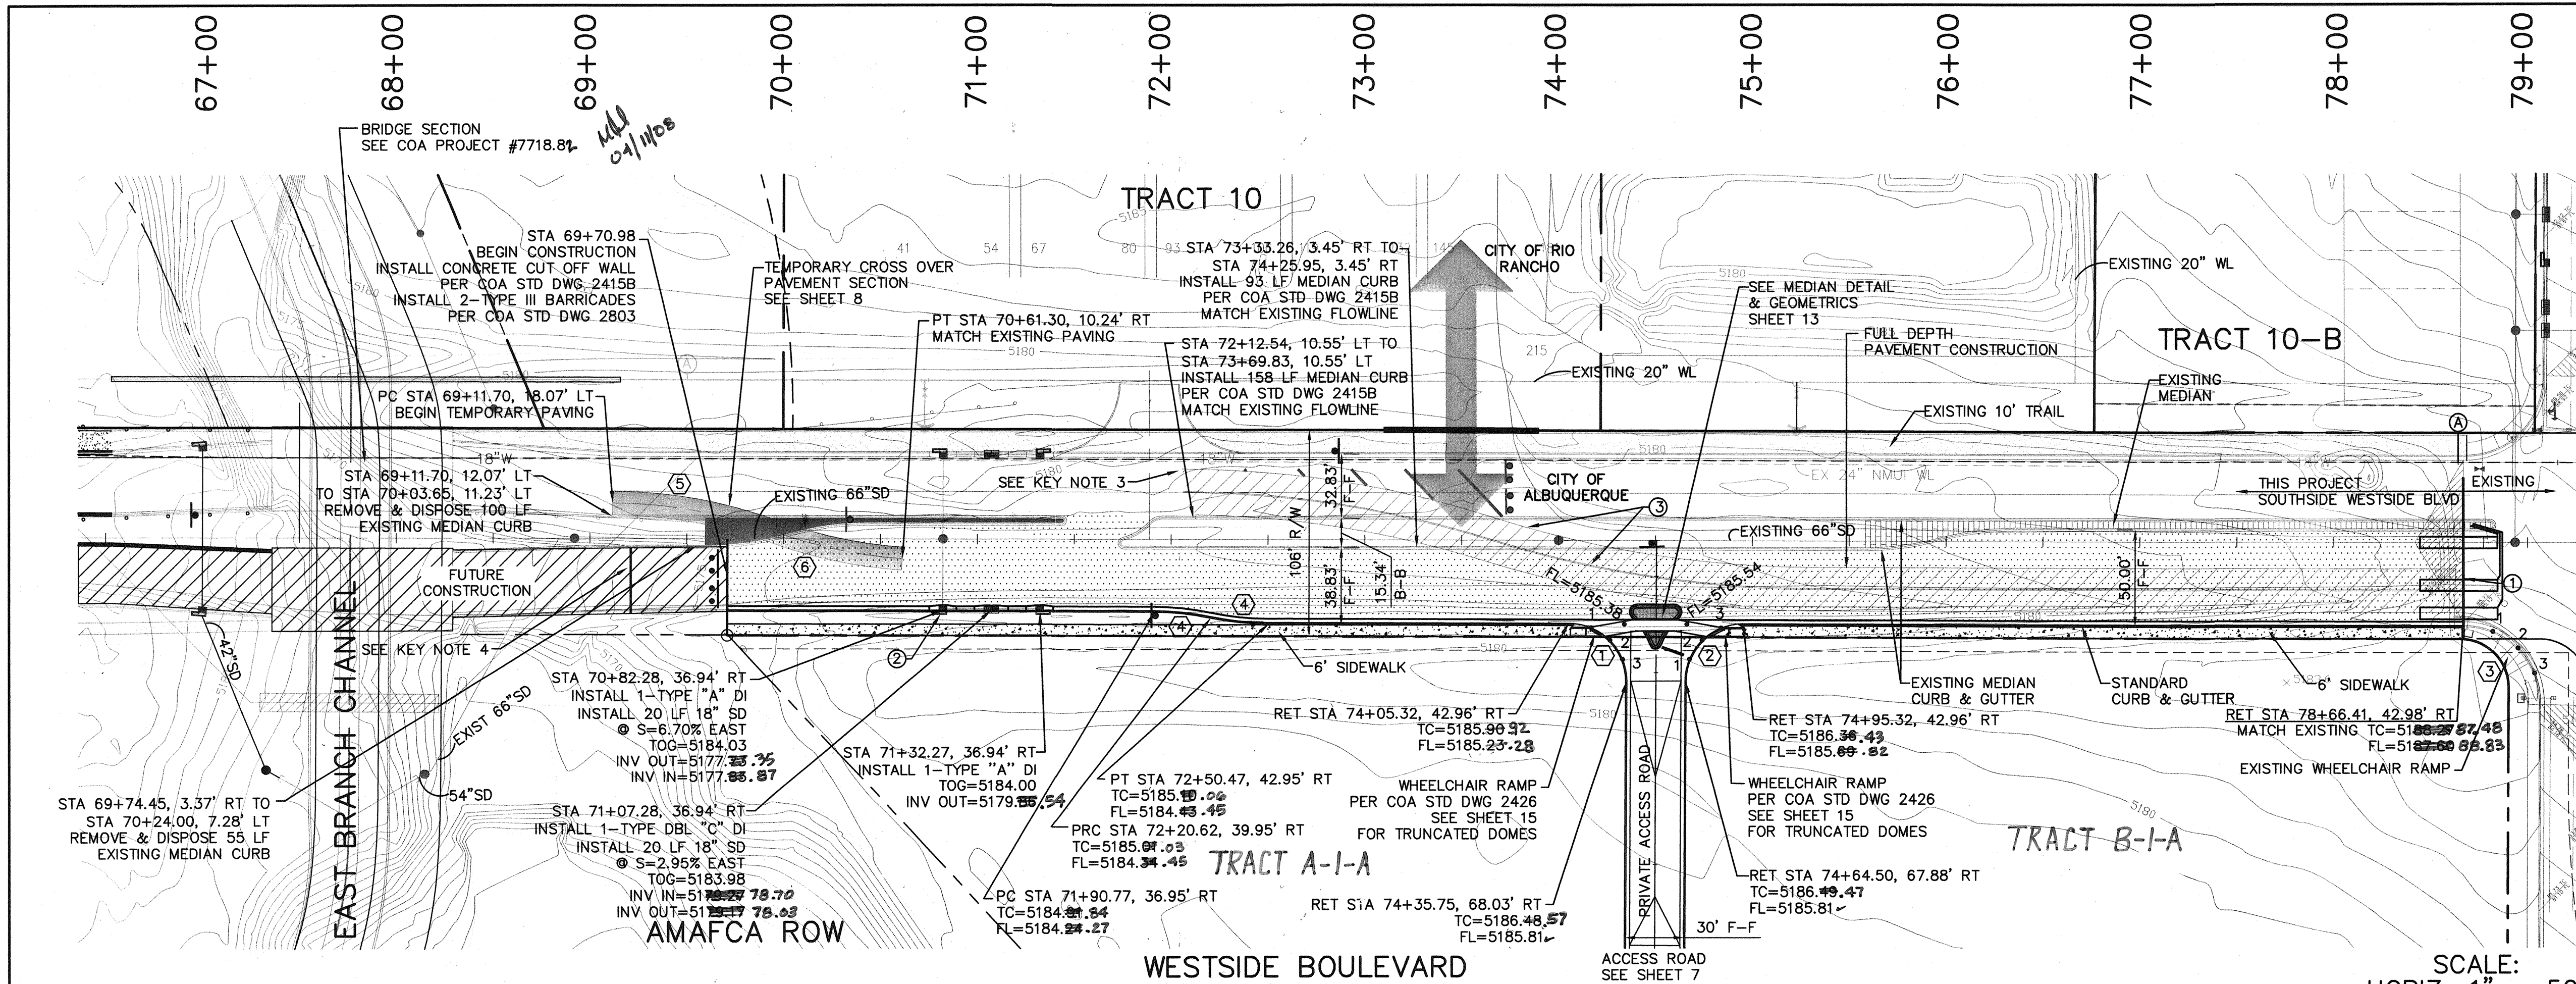

LEGEND (EXISTING)

- EXISTING LOT LINE
- EXISTING CURB & GUTTER
- EXISTING BUILDING
- EXISTING FENCE
- EXISTING EDGE OF PAVEMENT
- EXISTING INDEX CONTOUR
- EXISTING INTERMEDIATE CONTOUR
- EXISTING ROW

LEGEND (PROPOSED)

- PROPOSED ROADWAY CENTERLINE
- PROPOSED CURB & GUTTER
- PROPOSED 10'-0" TRAIL
- PROPOSED COLORED, STAMPED PCC
- PROPOSED 6'-0" PCC SIDEWALK
- PROPOSED WHEEL CHAIR RAMP
- RESEEDING LIMITS
- INNER CONVERT
- FUTURE CONSTRUCTION
- FULL DEPTH PAVEMENT CONSTRUCTION

CURVE DATA

STATION	TC	FL
1	5186.12	5185.99
2	5185.99	5185.99
3	5185.99	5185.99

Δ = 90°10'15"
R = 30.00' FOC
L = 47.21'


TEMPORARY PAVING CL CURVE DATA

STATION	TC	FL
1	5187.25	5187.05
2	5187.05	5186.92
3	5186.92	5185.99

Δ = 19°35'32"
R = 249.67'
L = 85.38'
T = 43.11'

KEY NOTES

- SAWCUT NEAT LINE TO FULL DEPTH. REMOVE & DISPOSE EXISTING ASPHALT PAVEMENT. APPLY TACK COAT TO JOINT PRIOR TO ABUTTING NEW PAVEMENT.
- REMOVE EXISTING RCP PLUG FOR LATERAL STORM DRAIN EXTENSION.
- EXISTING TEMPORARY PAVING TO BE REMOVED AND DISPOSED. ALL TEMPORARY STRIPING REMOVAL SHALL BE COINCIDENTAL TO REMOVAL. REPLACE MEDIAN CURB & GUTTER TO CLOSE MEDIAN.
- STA 69+20.98, 4.10' RT INSTALL 33 LF CONCRETE BARRIER. A 6" REFLECTORIZED STRIPE SHALL BE PLACED ON THE EAST FACE OF BARRIER. AREA WEST OF CONCRETE WALL BARRIER IS ROUGH GRADED TO SUBGRADE.

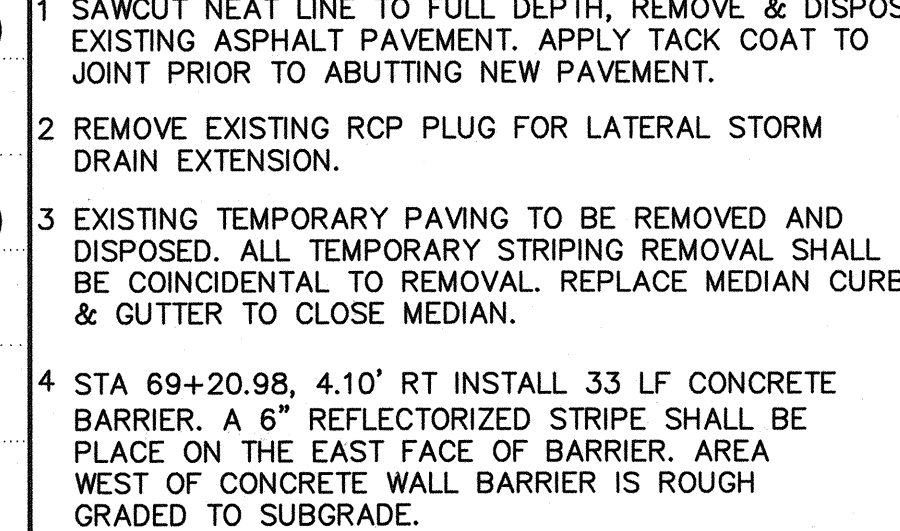


RECORD DRAWING
DATE: 8/20/08

**CITY OF ALBUQUERQUE
PUBLIC WORKS DEPARTMENT
ENGINEERING GROUP**


**VJW INC. STORAGE
WESTSIDE BLVD. PLAN & PROFILE
STA 69+70.98 TO STA 79+06.91**

Design Review Committee: APPROVED APR 21 2008
City Engineer Approval: APPROVED MAY 16 2008


AS-BUILT INFORMATION		BENCH MARKS		SURVEY INFORMATION		ENGINEER'S SEAL	
CONTRACTOR	DATE	US&GS BRASS TABLET	STAMPED	NO.	FIELD NOTES	NO.	DATE
WILSON & COMPANY	8/20/08	TRANS, 1969", LOCATED 6 MILES SOUTHWEST OF DOWNTOWN ALBUQUERQUE IN THE RIGHT-OF-WAY OF A PLAINS ELECTRIC CO-OP TRANSMISSION LINE		1	WCI	1	WCI
				2	WCI	2	WCI
				3	WCI	3	WCI
				4	WCI	4	WCI
				5	WCI	5	WCI
				6	WCI	6	WCI
				7	WCI	7	WCI

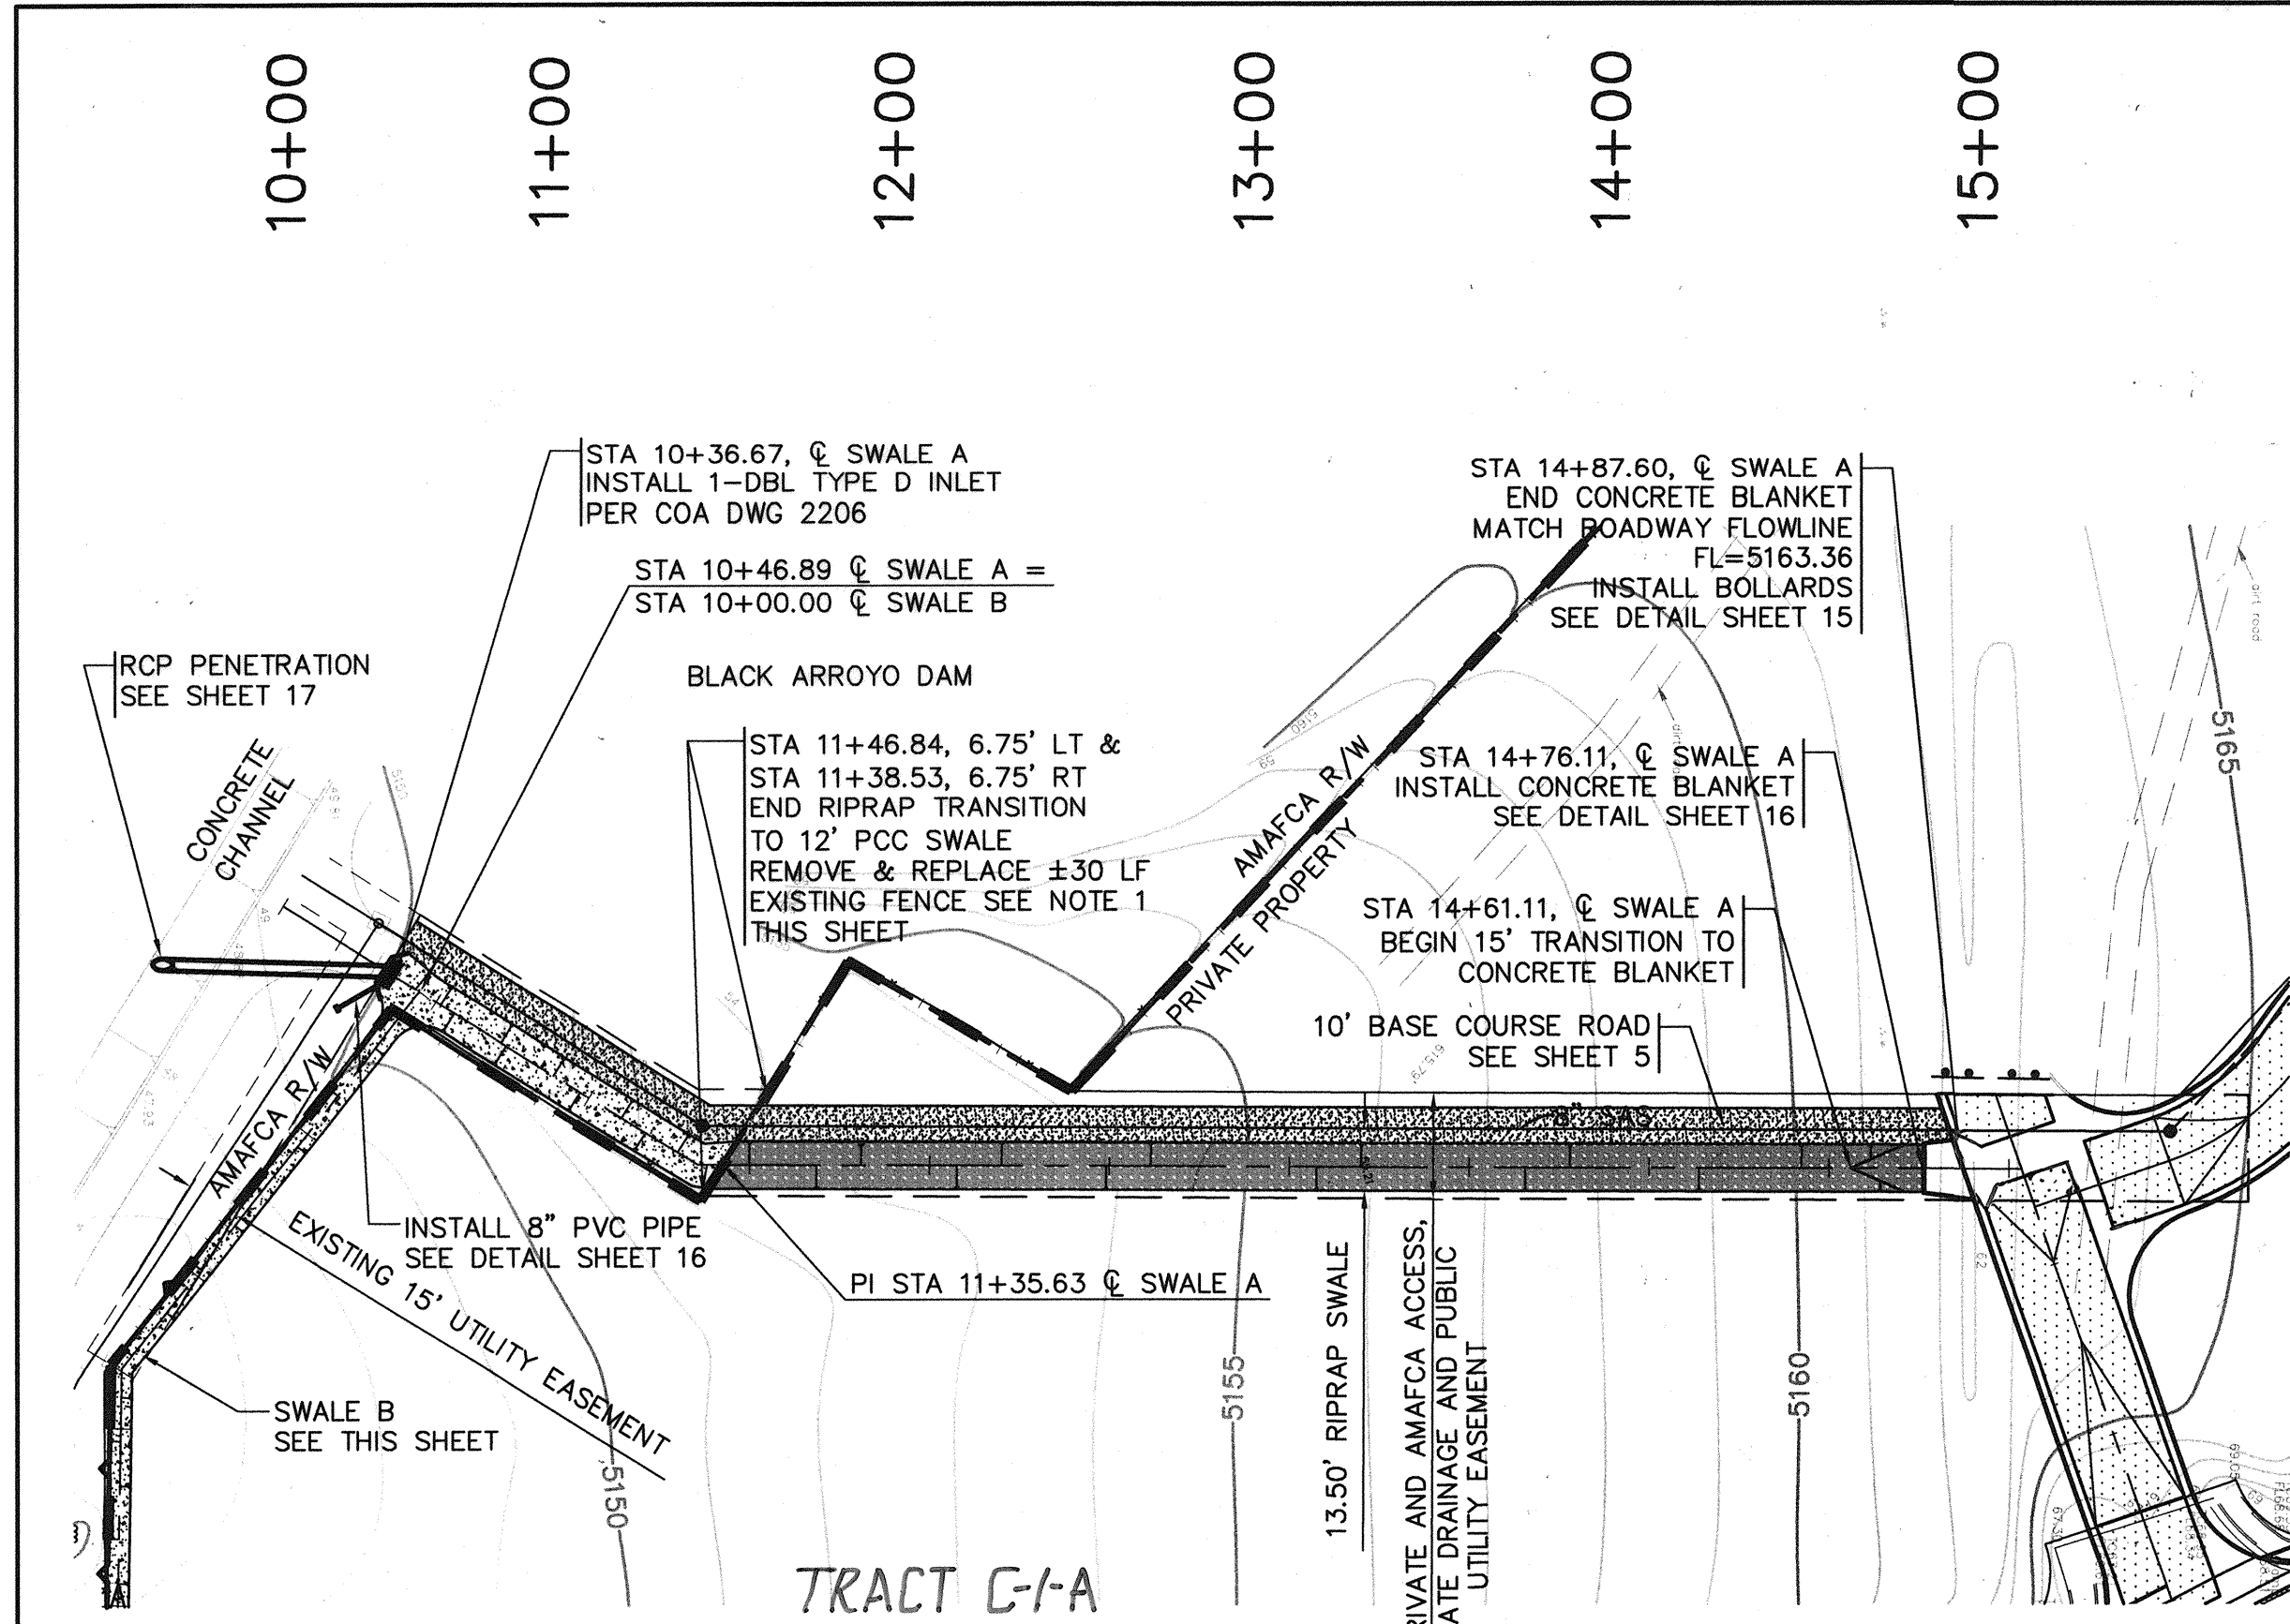

===== PROPOSED CURB & GUTTER
 PROPOSED COLORED, STAMPED PCC

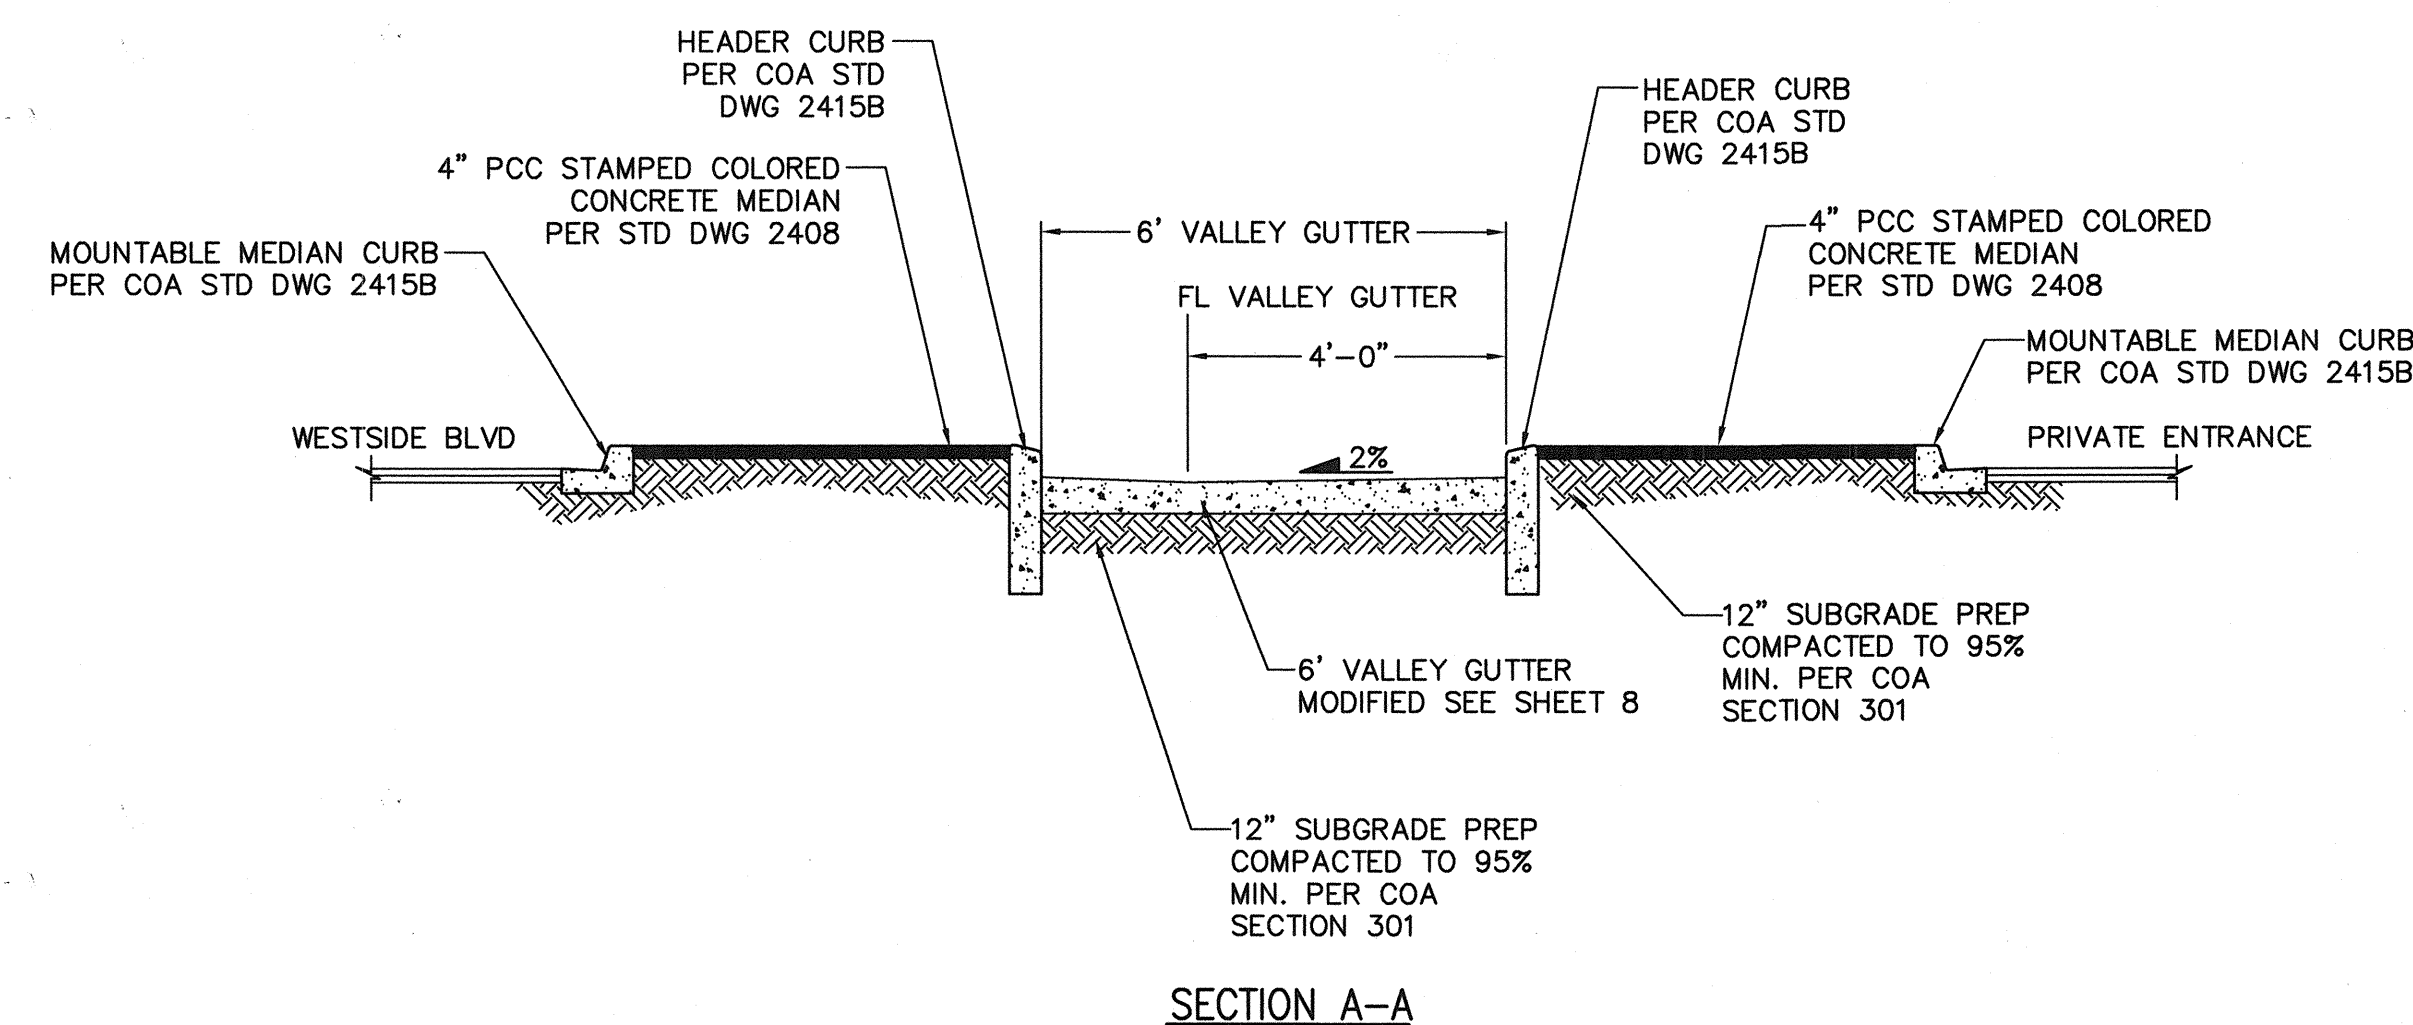


SECTION A-A

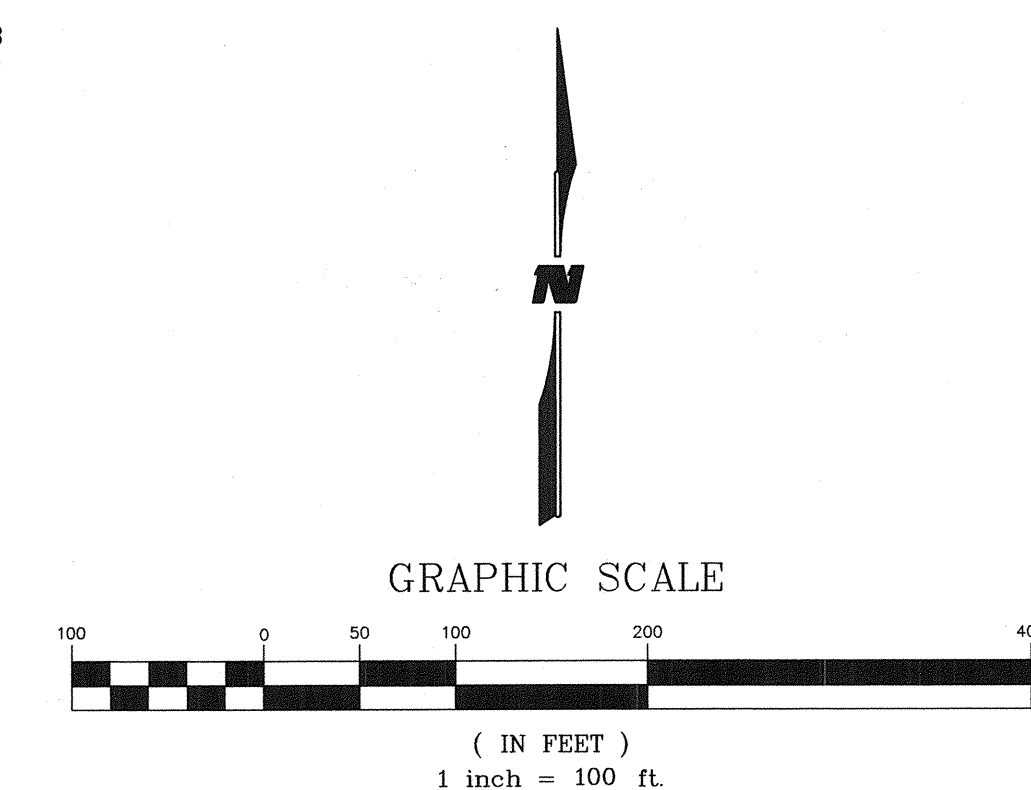


		ENGINEER'S SEAL		SURVEY INFORMATION		BENCH MARKS		AS-BUILT INFORMATION	
				FIELD NOTES				UNIVERSAL CONSTRUCTORS PYTHON CONSTRUCTION	
				NO.	BY	DATE	ACS BRASS TABLET STAMPED "BLACK 2 1977"	CONTRACTOR DRAWN BY	DATE
				1	WCI	4/17/08	GEOGRAPHIC POSITION (NAD 1927)	INSPECTOR'S VERIFICATION BY	DATE
				2	WCI	4/18/08	N.M. STATE PLANE COORDINATES (CENTRAL ZONE)	FIELD VERIFICATION BY	DATE
				3	WCI	4/22/08	X= 372,920.43 Y= 1,530,241.52	CONTRACTOR CORRECTED BY	DATE
				4	WCI	4/27/08	GROUND-TO-GRID FACTOR= 0.9996692	MICRO-FILM INFORMATION	
				5	WCI	5/29/08	$\Delta = -00'14.43"$	RECORDED BY	DATE
				6	WCI	6/17/08	SLD 1929 ELEVATION= 5213.926		
				7	WCI	6/18/08		NO.	

RECORD DRAWING
DATE: 8/20/08

**WILSON
& COMPANY**
4900 LANG AVE N.E.
SUITE 200
ALBUQUERQUE, NEW MEXICO
87109
(505) 348-4000
FAX (505) 348-4072
www.wilsonco.com

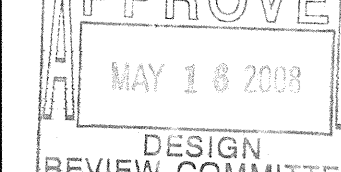
CITY OF ALBUQUERQUE PUBLIC WORKS DEPARTMENT ENGINEERING GROUP															
VJW STORAGE INC WESTSIDE BLVD. MEDIAN GEOMETRICS															
Design Review Committee 	City Engineer Approval 	Last Design Update	<table border="1"> <tr> <th>Mo./Day/Yr.</th> <th>Mo./Day/Yr.</th> </tr> <tr><td> </td><td> </td></tr> <tr><td> </td><td> </td></tr> <tr><td> </td><td> </td></tr> <tr><td> </td><td> </td></tr> <tr><td> </td><td> </td></tr> </table>	Mo./Day/Yr.	Mo./Day/Yr.										
Mo./Day/Yr.	Mo./Day/Yr.														
City Project No. 7718.83	Zone Map No. A-12	Sheet 13	Of 22												

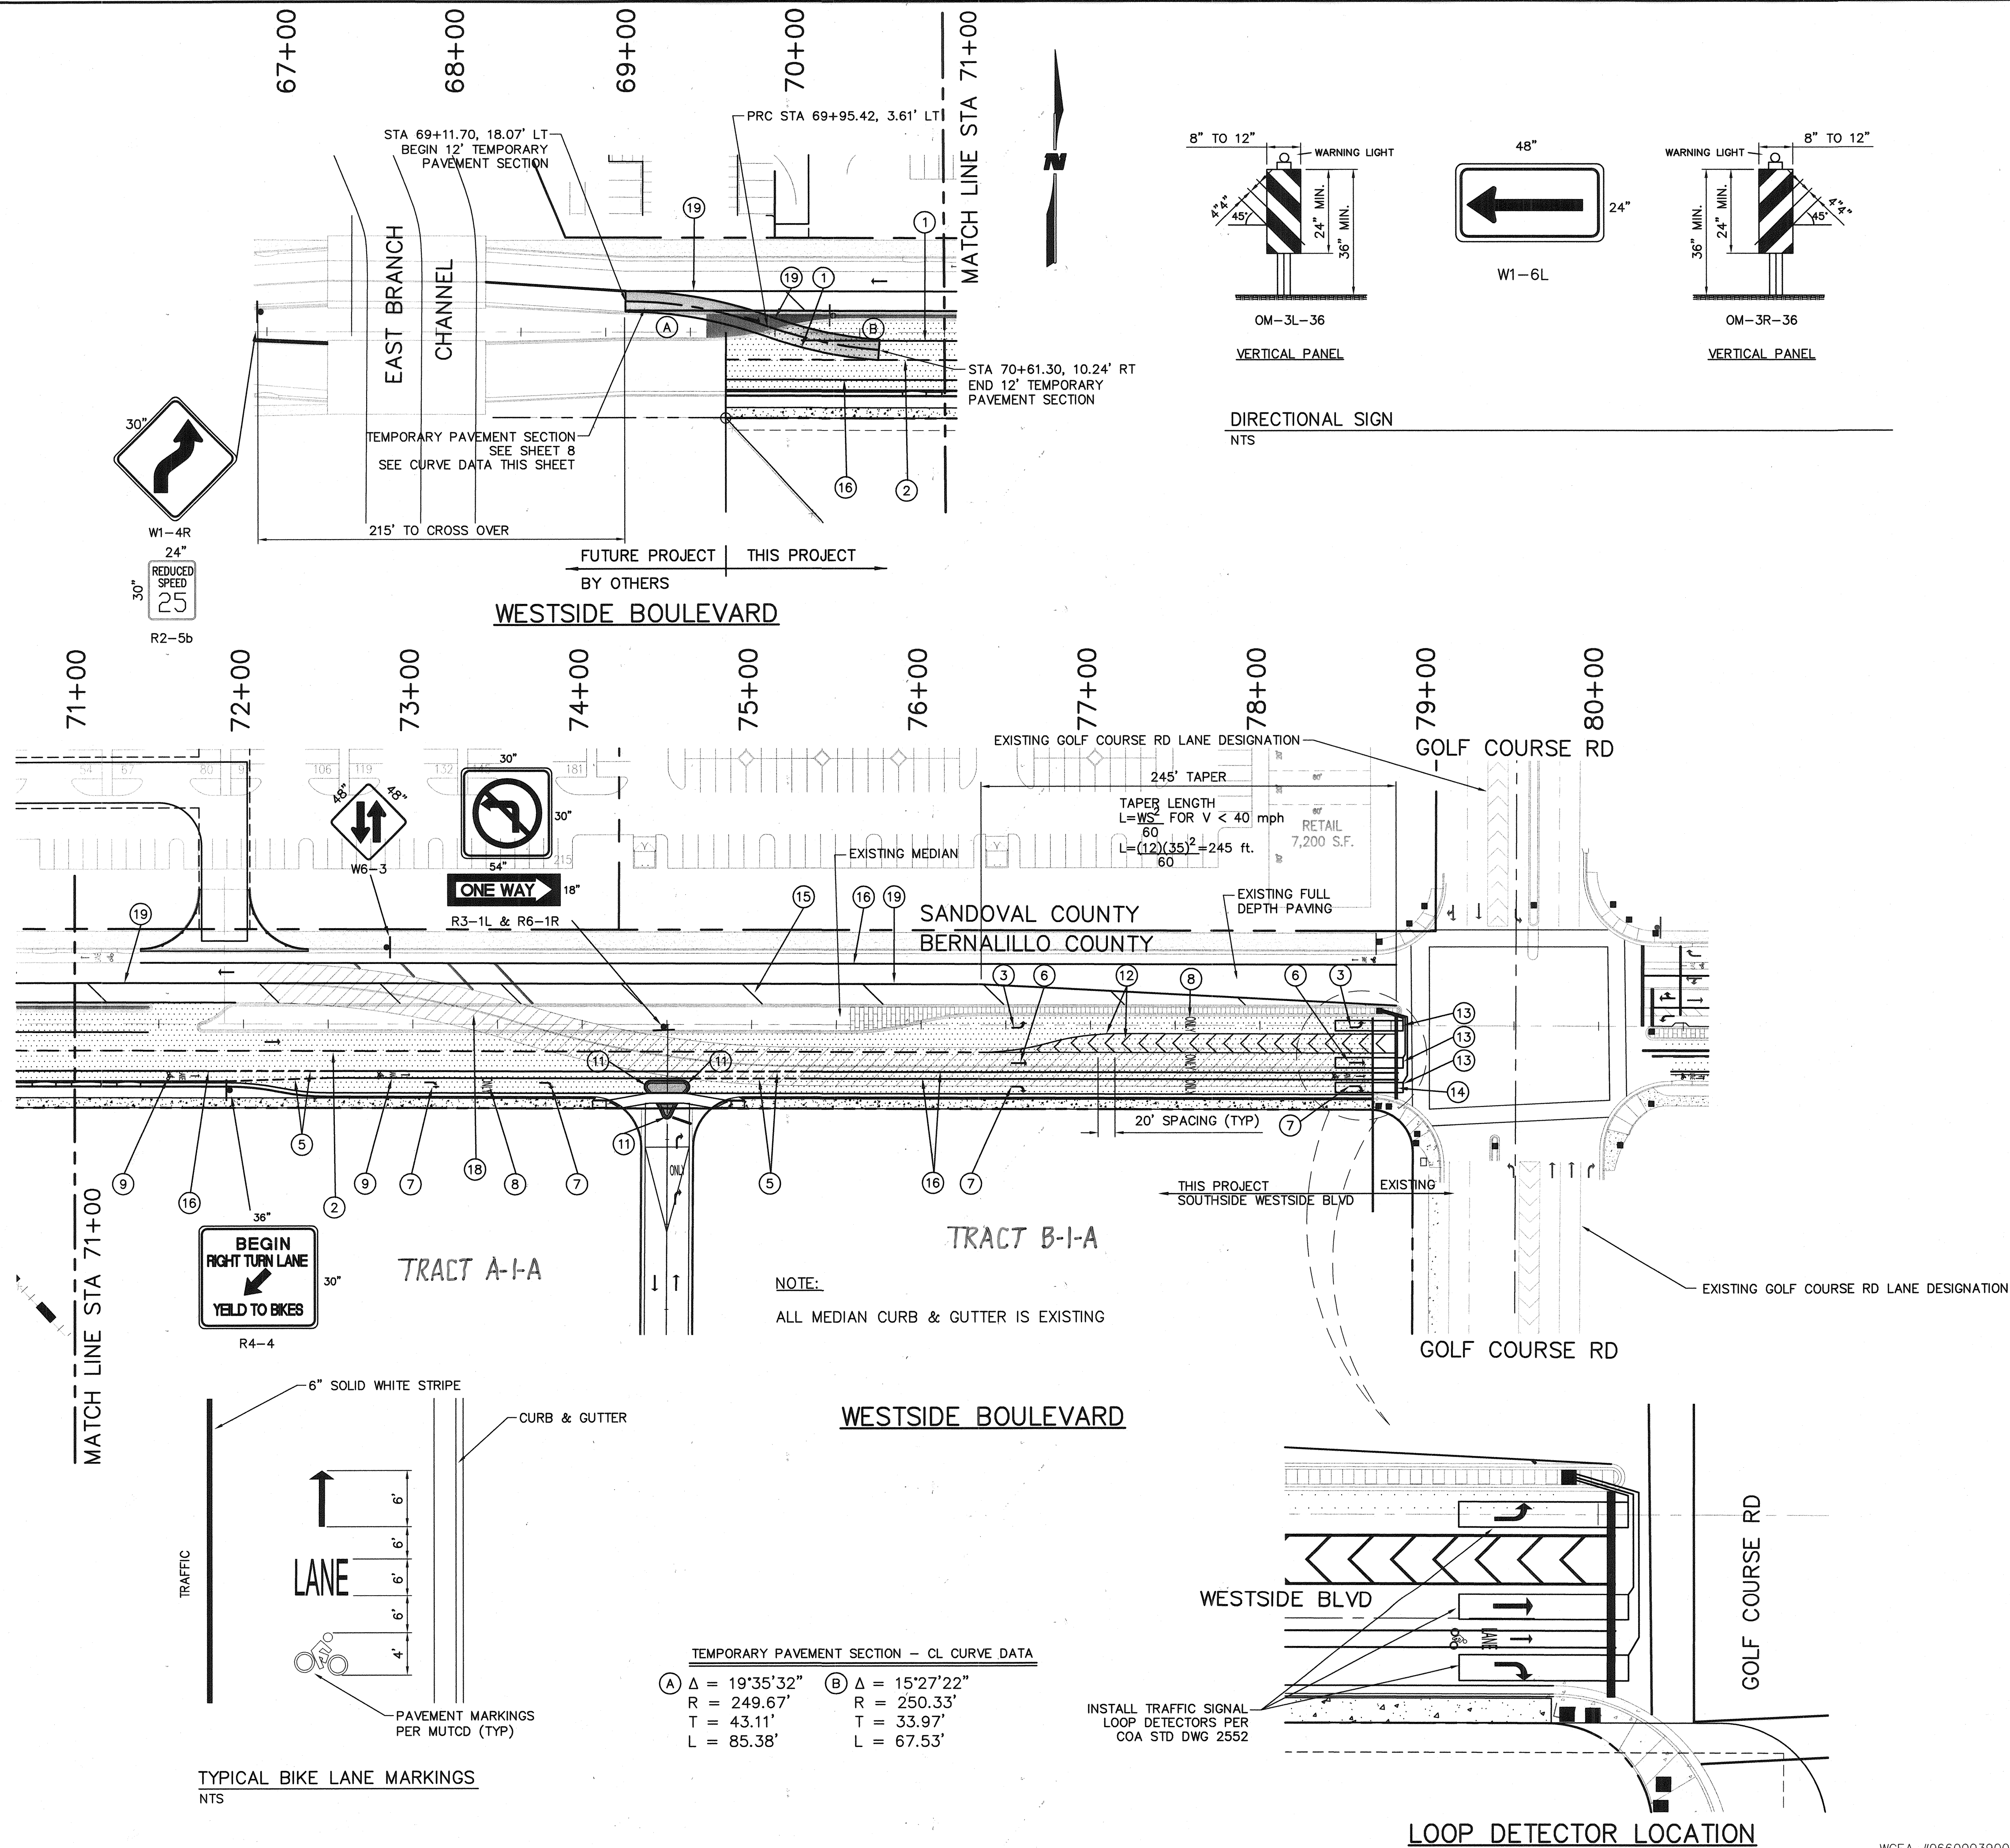

- GENERAL NOTES:**
- PERMANENT SIGNING & STRIPING SHALL CONFORM TO THE MUTCD MILLENNIUM EDITION, 2000.
 - ALL TYPE III BARRICADES SHALL BE REMOVED.
 - ALL STRIPING ERADICATED SHALL BE ACCOMPLISHED WITH WATER BLASTING SURFACE PLAINING TO A MAXIMUM DEPTH OF 0.25 INCHES AND FOR A WIDTH EQUAL TO 2 TIMES THE WIDTH OF THE STRIPE OR MARKINGS.

- LEGEND**
- PROPOSED ROADWAY CENTERLINE
 - PROPOSED CURB & GUTTER
 - PROPOSED ROW
 - PROPOSED CABEZON BOUNDARY
 - PROPOSED 10'-0" TRAIL
 - PROPOSED COLORED, STAMPED PCC
 - PROPOSED 6'-0" SIDEWALK
 - PROPOSED WHEEL CHAIR RAMPS @ RETURN
 - PROPOSED STREET SIGN EXISTING PULL BOX

- KEYED NOTES:**
- 4" SOLID WHITE PREFORMED THERMO PLASTIC
 - 4" BROKEN WHITE PREFORMED THERMO PLASTIC (10' STRIPE, 30" GAP)
 - 8" PREFORMED THERMO PLASTIC LEFT ARROW
 - 4" SOLID DOUBLE YELLOW PREFORMED THERMO PLASTIC
 - 6" DASHED, 3' STRIPE 7" GAP
 - 8" PREFORMED THERMO PLASTIC THRU ARROW
 - 8" PREFORMED THERMO PLASTIC RIGHT ARROW
 - 8" PREFORMED THERMO PLASTIC WORD "ONLY"
 - BIKE LANE PAVEMENT MARKINGS SEE DETAILS THIS SHEET
 - SOLID WHITE PREFORMED THERMO PLASTIC ARROW
 - MEDIAN NOSE PAINTED SOLID YELLOW
 - 8" SOLID WHITE PREFORMED THERMO PLASTIC STRIPE
 - 40'x6' TRAFFIC SIGNAL LOOP DETECTION PER COA STD DWG 2552
 - 12" SOLID WHITE PREFORMED THERMO PLASTIC STRIPE
 - 12" SOLID YELLOW PREFORMED THERMO PLASTIC STRIPE 45' @ 50' SPACING
 - 6" SOLID WHITE PREFORMED THERMO PLASTIC
 - 4" SOLID YELLOW PREFORMED THERMO PLASTIC @ 20' SPACING
 - REMOVE & DISPOSE EXISTING TEMPORARY ASPHALT PAVING & STRIPING
 - 4" SOLID YELLOW PREFORMED THERMO PLASTIC

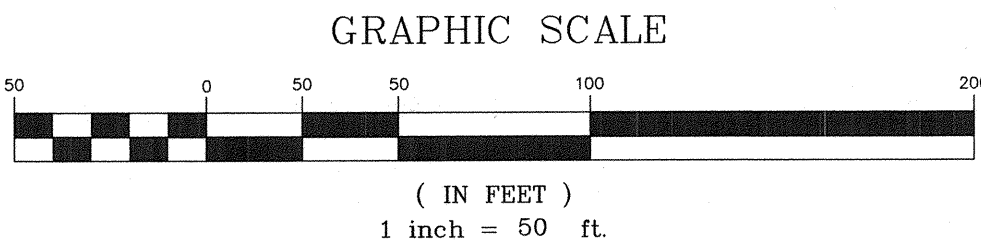


RECORD DRAWING
DATE 8/20/08

WILSON & COMPANY
4900 LANG AVE N.E.
SUITE 200
ALBUQUERQUE, NEW MEXICO 87109
(505) 348-4000
FAX (505) 348-4072
www.wilsonco.com


CITY OF ALBUQUERQUE PUBLIC WORKS DEPARTMENT ENGINEERING GROUP	
VJW STORAGE INC PERMANENT SIGNING & STRIPING STA 69+70.98 TO STA 79+06.91	
Design Review Committee APR 21 2008	City Engineer Approval MAY 16 2008
City Project No. 7718.83	Zone Map No. A-12
Sheet 14	Of 22

AS-BUILT INFORMATION		BENCH MARKS		SURVEY INFORMATION		ENGINEER'S SEAL	
CONTRACTOR	DATE	NO.	BY	NO.	BY	NO.	DATE
WCI	4/8/08	1	WCI	1	WCI	1	WCI
WCI	4/8/08	2	WCI	2	WCI	2	WCI
WCI	4/8/08	3	WCI	3	WCI	3	WCI
WCI	4/8/08	4	WCI	4	WCI	4	WCI
WCI	4/8/08	5	WCI	5	WCI	5	WCI
WCI	4/8/08	6	WCI	6	WCI	6	WCI
WCI	4/8/08	7	WCI	7	WCI	7	WCI

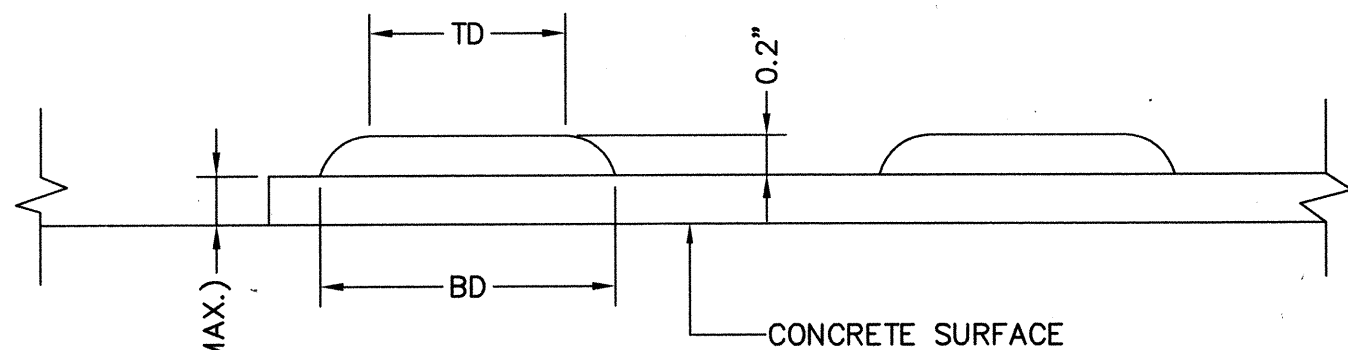

DOME SECTION

BD - BASE DIAMETER
0.9" MIN. TO 1.4" MAX
TD - TOP DIAMETER
50% OF BD MIN TO 65% OF BD MAX

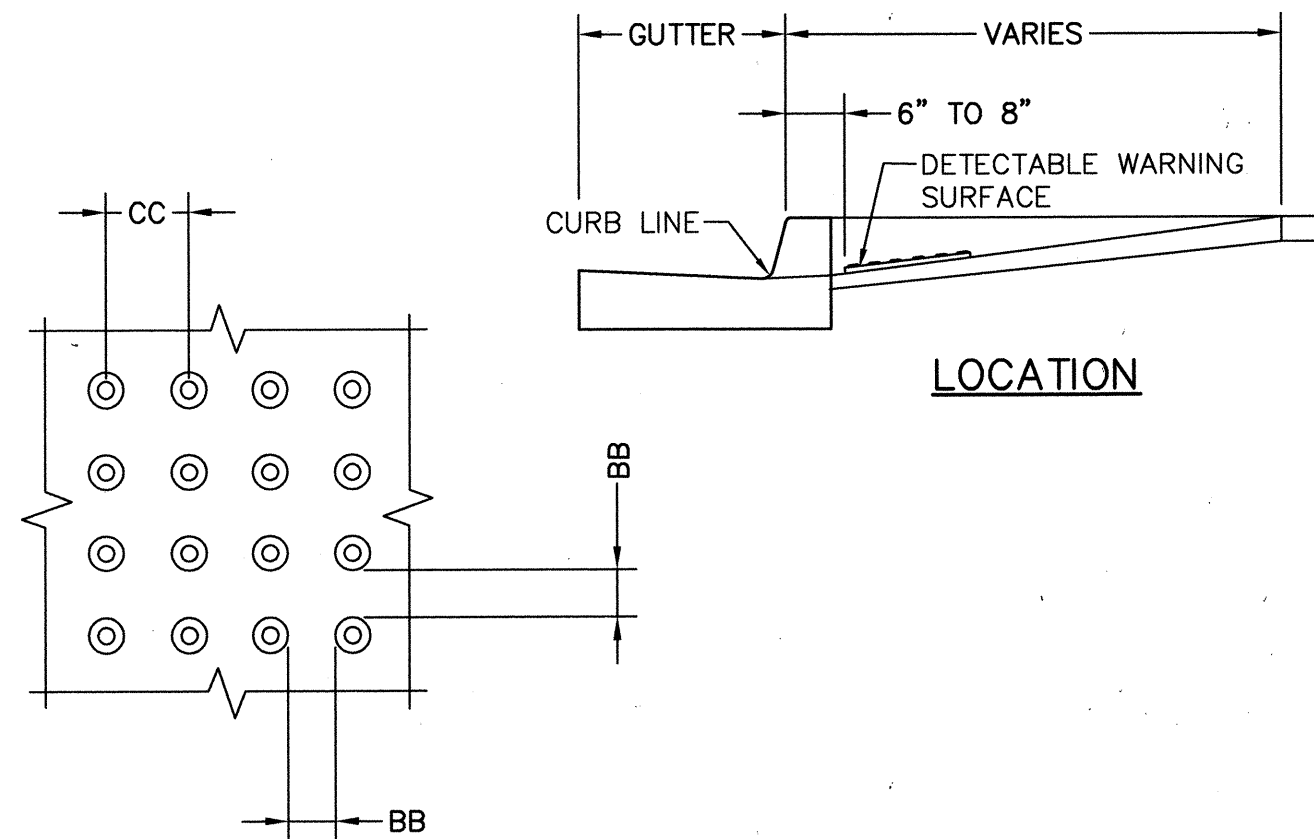

DOME SPACING

CC - CENTER TO CENTER SPACING
1.6" MIN. TO 2.4" MAX
BB - BASE TO BASE SPACING
0.55" MIN

DOME SPACING

DETECTABLE WARNING SURFACES SHALL EXTEND 24" MIN. IN THE DIRECTION OF TRAVEL AND FULL WIDTH OF THE CURB RAMP, LANDING, OR TRANSITION. DOMES SHALL BE ALIGNED ON A SQUARE GRID IN THE PREDOMINANT DIRECTION OF THE CROSS WALK TO PERMIT WHEELS TO ROLL BETWEEN DOMES.

DEFINITIONS:

DETECTABLE WARNINGS - A SURFACE FEATURE BUILT IN OR APPLIED TO WALKING SURFACES OR OTHER ELEMENTS TO WARN OF HAZARDS ON A CIRCULATION PATH TO AID PERSONS WITH VISUAL IMPAIRMENTS.

DESIGN PER ADA GUIDELINES

SUBMIT TO CITY OF ALBUQUERQUE CONSTRUCTION ENGINEER FOR EVALUATION PRIOR TO CONSTRUCTION

CURB LINE - A LINE AT THE FACE OF THE CURB THAT MARKS THE TRANSITION BETWEEN THE SIDEWALK AND THE GUTTER OR ROADWAY



LOCATION:

- DETECTABLE WARNING SURFACES SHALL BE PROVIDED WHERE A CURB RAMP OR LANDING CONNECTS TO A CROSSWALK AND OR PEDESTRIAN ROUTE CROSSING A ROADWAY.
- DETECTABLE WARNING SURFACES SHALL BE LOCATED SO THAT THE EDGE NEAREST THE CURB LINE IS 6" (150 MM) MINIMUM AND 8" (205 MM) MAXIMUM FROM THE CURB LINE.
- MEDIAN AND REFUGEISLANDS SHALL HAVE DETECTABLE WARNINGS. DETECTABLE WARNINGS AT CUT THROUGH ISLAND SHALL BE SEPERATED BY A 24" (610 MM) MINIMUM LENGTH OF WALKWAY WITHOUT WARNINGS

EXCEPTION: DETECTABLE WARNINGS SHALL NOT BE REQUIRED ON CUT THROUGH ISLANDS WHERE THE CROSSINGS ARE CONTROLLED BY SIGNALS AND ARE TIMED FOR FULL CROSSING ON MEDIANS LESS THEN 7' WIDE

NOTES:

- DETAILS SPECIFIED ON THIS PLAN APPLY TO ALL CONSTRUCTION OR RECONSTRUCTION OF STREETS, CURBS, OR SIDEWALKS BY ALL PUBLIC AGENCIES AND BY ALL PRIVATE ORGANIZATIONS CONSTRUCTING FACILITIES FOR PUBLIC USE.
- SIDEWALK RAMP ARE TO BE LOCATED AS SPECIFIED ON THE PLANS OR AS DIRECTED BY THE ENGINEER.
- THE TOP OF THE JOINT FILLER FOR ALL RAMP TYPES SHALL BE FLUSH WITH THE ADJACENT CONCRETE.
- ALL PRODUCTS USED FOR THE DETECTABLE WARNING SURFACES SHALL BE ON THE DEPARTMENT'S APPROVED PRODUCT LIST.
- PRODUCTS SHALL BE CAST-IN-TACT AND RED IN COLOR.

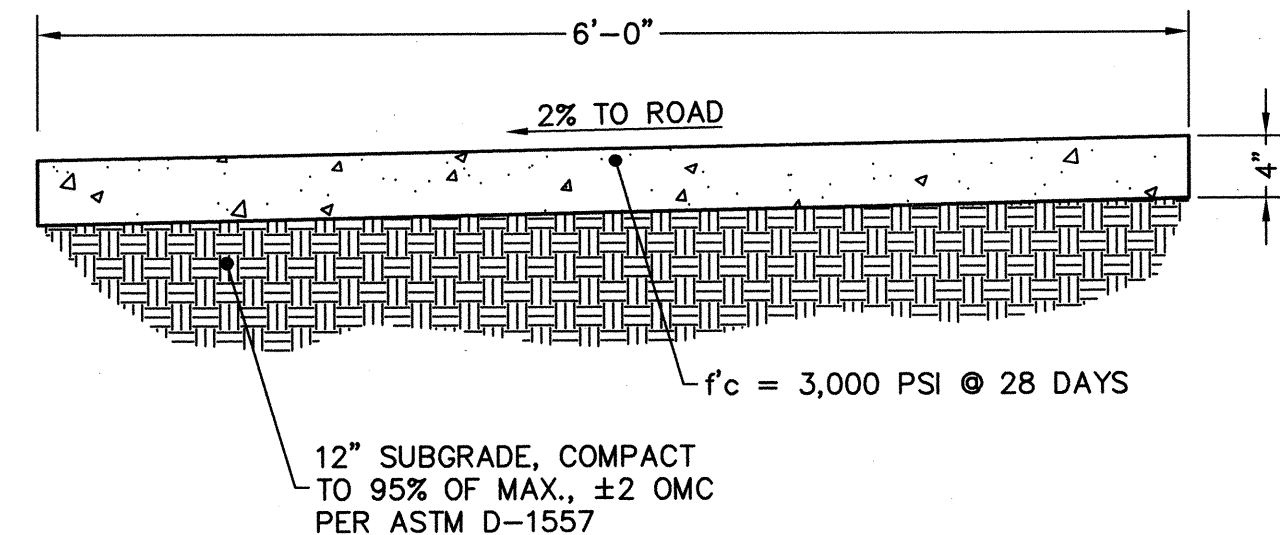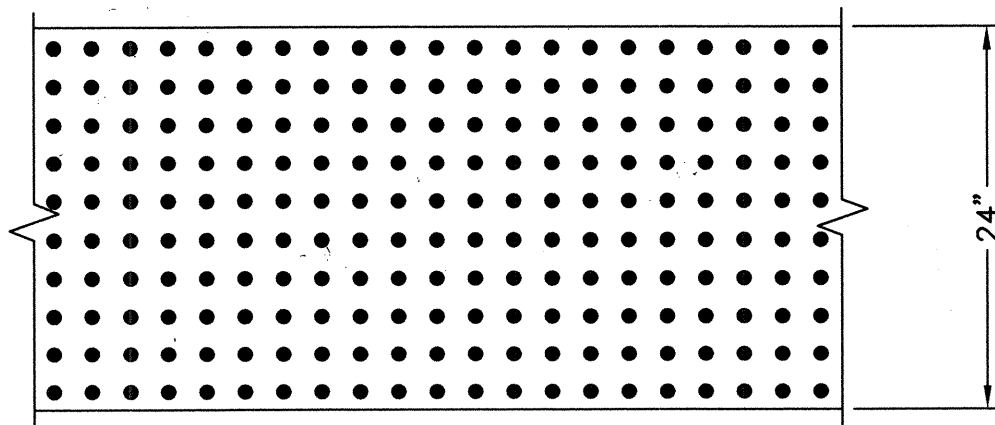


TYPICAL SIDEWALK DETAIL

SCALE: 1"=1'-0"

CONSTRUCTION NOTES:

- INSTALL CONTRACTION JOINTS @ 5'-0" O.C.
- INSTALL 1/2" BITUMINOUS EXPANSION JOINT @ 30'-0" O.C.
- SURFACE TEXTURE OF SIDEWALK SURFACE SHALL BE OBTAINED BY LIGHT BROOMING.
- INSTALL 1/2" BITUMINOUS EXPANSION JOINT BETWEEN 4" PCC SIDEWALK AND ALL ADJOINING HARD SURFACES.

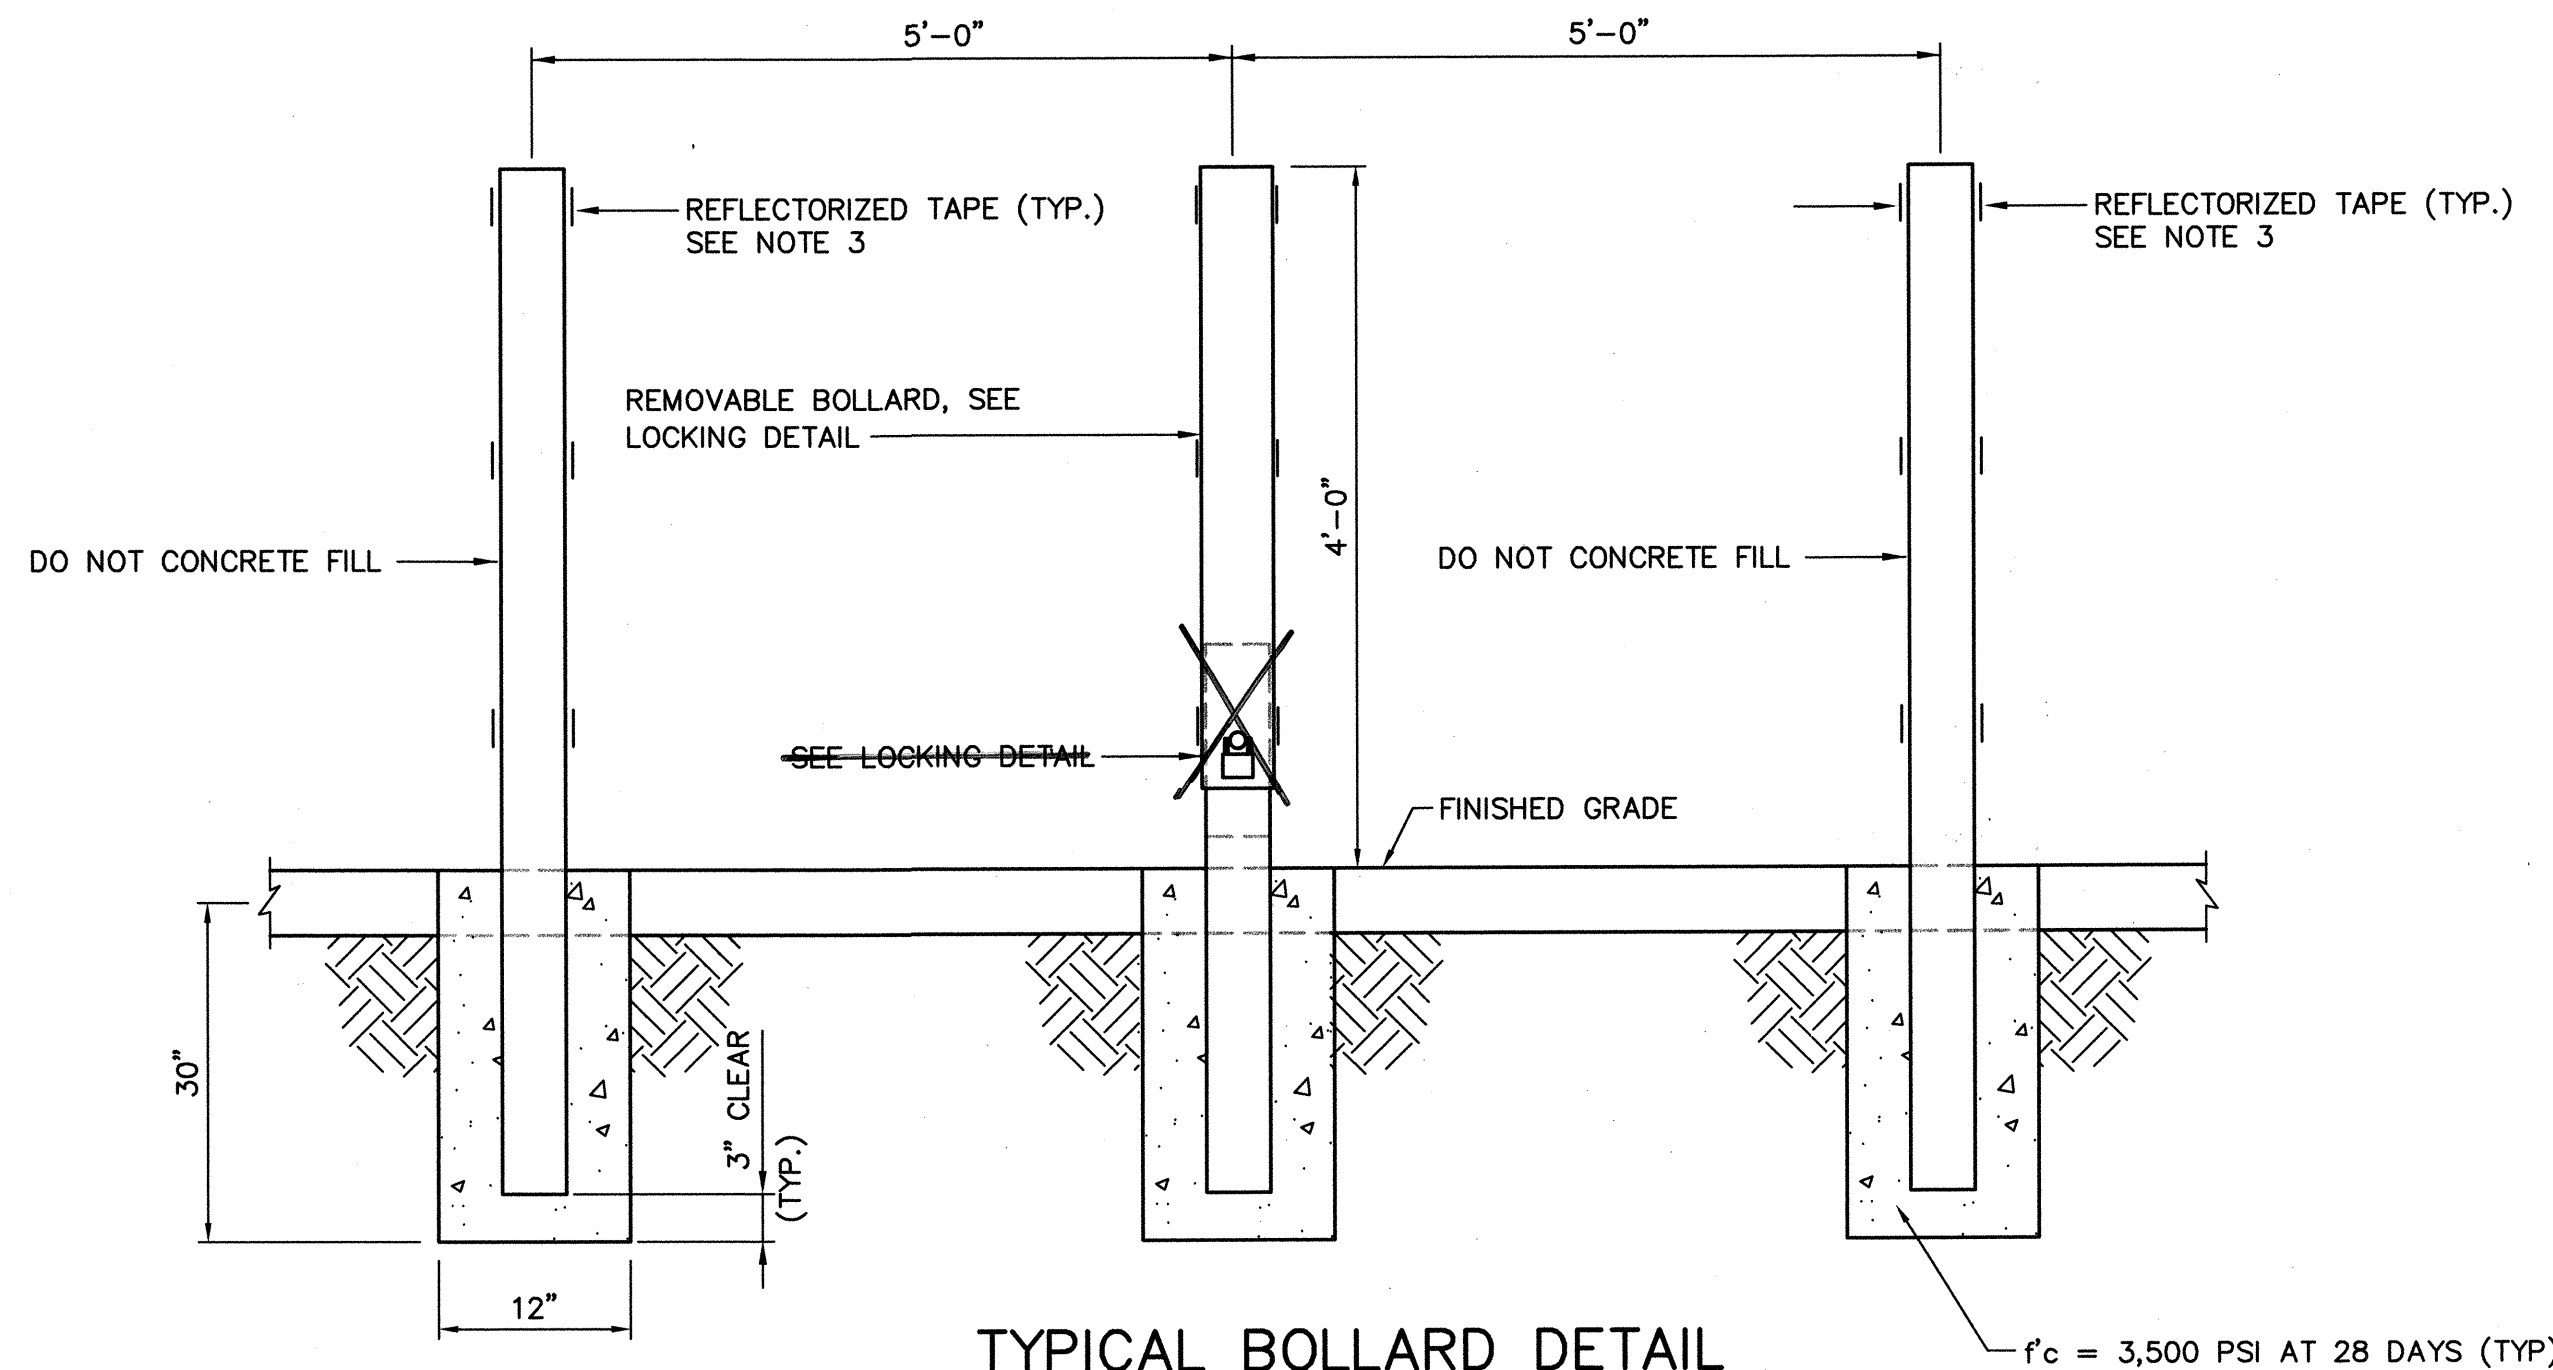


TYPICAL BOLLARD DETAIL

NTS

NOTE:

- IF OPENING IS LESS THAN 12 FEET, A SINGLE REMOVABLE BOLLARD MAY BE USED.
- CLEAN AND PAINT ALL BOLLARDS WITH 1 COAT PRIMER AND 2 COATS SAFETY YELLOW.
- 2" WIDE REFLECTIVE TAPE, AS APPROVED BY ENGINEER, LOCATE AROUND AS SHOWN.
- PLACE BOLLARDS 2' BEHIND FACE OF CURB.

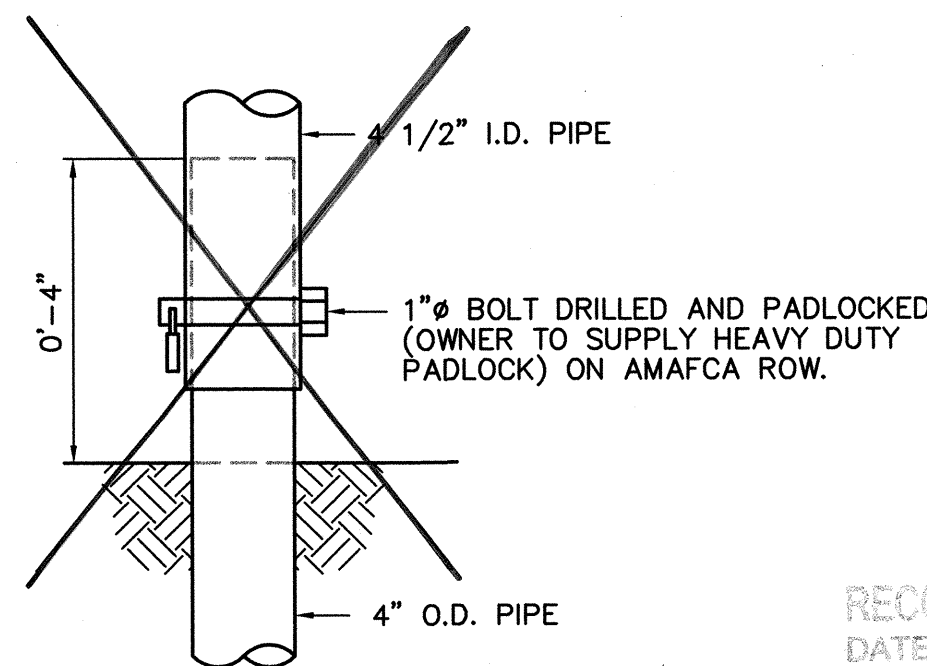

LOCKING DETAIL

NTS

NEW CONSTRUCTION - GENERAL NOTES:

- THESE DRAWINGS PROVIDE GUIDANCE FOR COMPLIANCE WITH THE CURRENT AMERICANS WITH DISABILITIES ACT (ADA) AND STATE CODE. THESE STANDARDS SHALL APPLY TO ALL NEW AND ALTERED SIDEWALKS.
- ANY DESIGN DEVIATION FROM THESE STANDARDS SHALL BE APPROVED BY THE NMDOT ADA COMPLIANCE COMMITTEE.
- SURFACES SHALL BE STABLE, FIRM, AND SLIP RESISTANT, SIDEWALK AND CURB RAMP SURFACES SHALL PROVIDE CONSISTENT SLOPES WITHIN EACH SECTION.
- ALL BROOM FINISHES SHALL BE PERPENDICULAR TO THE DIRECTION OF PEDESTRIAN TRAVEL.
- A VERTICAL CHANGE OF 1/4 INCH (9mm) OR LESS IS ALLOWED. IF BETWEEN 1/4 INCH AND 1/2 INCH (6mm AND 13mm), THEN IT NEEDS TO BE BEVELED 2:1. CHANGES GREATER THAN 1/2 INCH SHALL BE RAMPED.
- OPENING OR CRACKS IN SIDEWALK SURFACES SHALL NOT EXCEED 1/2 INCH (13mm). ELONGATED OPENING SHOULD BE PLACED SO THAT THE LONG DIMENSION IS PERPENDICULAR OR DIAGONAL TO THE DOMINANT DIRECTION OF TRAVEL.

SIDEWALKS

- SIDEWALKS, CURB AND GUTTER CONSTRUCTION SHALL BE IN ACCORDANCE WITH SERIAL BSCG-001. (SWCG-001).
- THE LEAST POSSIBLE SLOPES SHALL BE USED FOR SIDEWALKS, SIDEWALK RUNNING SLOPE SHALL NOT EXCEED 5% (20:1). AT LOCATIONS WHERE THE RIGHT-OF-WAY IS RESTRICTIVE, THE SIDEWALK RUNNING SLOPE MAY FOLLOW THE ROAD PROFILE.
- SIDEWALK CROSS SLOPE SHALL NOT EXCEED 2% (50:1).
- SIDEWALKS SHALL HAVE A MINIMUM WIDTH OF 60", EXCLUDING THE CURB. EXCEPTION: A 36" WIDE SIDEWALK MAY BE USED WHERE THE RIGHT-OF-WAY IS RESTRICTED, WHERE THE SIDEWALK IS LESS THAN 60" WIDE. A PASSING SPACE SHALL BE PROVIDED EVERY 20 LINEAR FEET, WHEREVER FEASIBLE. PASSING SPACES SHALL BE A MINIMUM OF 60"x60" WITH 45 DEGREE TRANSITION TAPERS, 5% (20:1) MAXIMUM RUNNING SLOPES, AND 2% (50:1) MAXIMUM CROSS SLOPES.
- ANY SIGN POSTS, UTILITY POLES, FIRE HYDRANTS, TRAFFIC SIGNAL STANDARDS, LIGHT POLES, ETC. IN THE SIDEWALK SHALL NOT REDUCE THE CLEAR WIDTH TO LESS THAN 32" FOR MORE THAN 24" LENGTH.

CURB RAMP

- THE LEAST POSSIBLE CURB RAMP SLOPE SHALL BE USED, FOR COMPLIANCE WITH NMDOT PEDESTRIAN ACCESS DETAILS, CURB RAMP RUNNING SLOPE SHALL NOT EXCEED 6.7% (15:1). WHERE EXISTING TERRAIN IS STEEP, CURB RAMP NEED NOT EXCEED 15 FEET IN LENGTH.
- PROVIDE A FLUSH TRANSITION BETWEEN RAMP, SIDEWALKS, GUTTER, AND EDGE OF PAVEMENT, FREE OF DRAINAGE LIP. ABRUPT GRADE CHANGES, DROP-OFFS, OR ANY SURFACE IRREGULARITIES. A 5% (20:1) OR FLATTER TRANSITION TAPER SHALL BE PROVIDED FROM THE STREET TO THE GUTTER FOR CURB RAMP LOCATION (THIS MAY REQUIRE SPECIAL TREATMENT OF THE EDGE OF O.G.F.C.) WHEN DIAGONAL (NOT IN LINE WITH CROSSWALKS) RAMP ARE NECESSARY. A 2% (50:1) TRANSITION OR "LOWER LANDING" SHALL BE PROVIDED. THE GUTTER RUNNING SLOPE (FLOW LINE) SHALL NOT EXCEED 2% MEASURED ALONG THE BOTTOM OF THE RAMP.

- CURB RAMP SHALL BE LOCATED TO PROVIDE THE MOST DIRECT ROUTE OF TRAVEL ACROSS THE TRAFFIC LANES.
- TWO DIRECTIONAL (IN LINE WITH THE CROSSWALKS) RAMP PER CORNER ARE USED IN ORDER TO PROVIDE SHORT AND DIRECT CROSSINGS FOR THE USER.
- SIGN POSTS, UTILITY POLES, FIRE HYDRANTS, TRAFFIC SIGNAL STANDARDS, IN THE CURB RAMP INCLUDING SIDE FLARES AND LANDINGS.
- IN ORDER TO BETTER ACCOMMODATE CONDITIONS IN THE FIELD, THE CONTRACTOR SHALL OBTAIN FINAL APPROVAL OF CURB RAMP LOCATION FROM THE PROJECT MANAGER AND THE DISTRICT TRAFFIC ENGINEER. WHEN NECESSITATED BY EXISTING PHYSICAL CONDITIONS, ALTERNATE CURB RAMP MUST BE SUBMITTED TO THE PROJECT MANAGER FOR APPROVAL BY THE DISTRICT TRAFFIC ENGINEER.

LANDINGS

- LANDING SHALL BE A MINIMUM OF 60"x 60". SLOPES SHALL NOT EXCEED 2% (50:1) IN ALL DIRECTIONS.

CROSSWALKS

- ACCESSIBLE PEDESTRIAN CROSSING SHALL BE WITHIN THE MARKED CROSSWALK.

DETECTABLE WARNINGS

- DETECTABLE WARNINGS ARE REQUIRED AT ALL STREET INTERSECTIONS, SIGNALIZED DRIVEWAYS, COMMERCIAL DRIVEWAYS 30' WIDE OR GREATER, AND MARKED MID-BLOCK CROSSWALKS.

ALTERATIONS TO EXISTING FACILITIES - GENERAL NOTES:


ADDITIONS OR ALTERATIONS TO ANY FACILITY SHALL CONFORM TO THE REQUIREMENTS FOR THE NEW CONSTRUCTION STANDARDS WITHIN THE NMDOT PEDESTRIAN ACCESS DETAILS. ADDITIONS OR ALTERATIONS SHALL NOT BE MADE TO AN EXISTING FACILITY WITH WILL CAUSE THE EXISTING FACILITY TO BE IN VIOLATION OF ANY PROVISION OF THE NMDOT PEDESTRIAN ACCESS DETAILS. WHERE IT IS TECHNICALLY INFEASIBLE TO COMPLY WITH NEW CONSTRUCTION STANDARDS FOR THE NMDOT PEDESTRIAN ACCESS DETAILS THE FOLLOWING OPTIONS MAY BE USED:

- WHERE IT IS NOT FEASIBLE TO INSTALL TWO CURB RAMP PER CORNER. A SINGLE DIAGONAL CURB RAMP MAY BE USED AFTER RECEIVING APPROVAL FROM THE NMDOT ADA COMPLIANCE COMMITTEE.
- WHERE RIGHT-OF-WAY IS RESTRICTED. CURB RAMP LANDING MAY BE 4' X 4'.
- DEFINITION OF TECHNICALLY INFEASIBLE: IN THE CONTEXT OF THESE DRAWINGS, WITHIN A ROADWAY OR IMMEDIATE ROADSIDE ENVIRONMENT. MEANS WITH RESPECT TO AN ALTERATION OF A FACILITY, THAT IT HAS LITTLE LIKELIHOOD OR BEING ACCOMPLISHED BECAUSE EXISTING SITE CONDITIONS WOULD REQUIRE SUBSTANTIALLY ALTERING EXISTING DRAINAGE PATTERNS: TRAFFIC FLOW OR SAFETY; OR BECAUSE OTHER EXISTING PHYSICAL INFRASTRUCTURE OR SITE CONSTRAINTS PROHIBIT MODIFICATION OR ADDITION OF ELEMENTS, SPACE OR FEATURES WITH ARE IN FULL AND STRICT COMPLIANCE THE MINIMUM REQUIREMENTS FOR NEW CONSTRUCTION AND WHICH ARE NECESSARY TO PROVIDE ACCESSIBILITY.
- WHERE RIGHT-OF-WAY IS RESTRICTED. CURB RAMP SLOPES MAY BE 12:1.

AS-BUILT INFORMATION	
CONTRACTOR	WCI
DATE	4/10/08
DESIGNED BY	WCI
CHECKED BY	WCI
DATE	8/08
DESIGNED BY	WCI
CHECKED BY	WCI
DATE	8/08
DESIGNED BY	WCI
CHECKED BY	WCI
DATE	8/08
DESIGNED BY	WCI
CHECKED BY	WCI
DATE	8/08

BENCH MARKS	
CONTRACTOR	WCI
DATE	4/10/08
DESIGNED BY	WCI
CHECKED BY	WCI
DATE	8/08
DESIGNED BY	WCI
CHECKED BY	WCI
DATE	8/08
DESIGNED BY	WCI
CHECKED BY	WCI
DATE	8/08

SURVEY INFORMATION	
DATE	4/10/08
BY	WCI
NO.	1
DATE	4/10/08
BY	WCI
NO.	2
DATE	4/10/08
BY	WCI
NO.	3
DATE	4/10/08
BY	WCI
NO.	4
DATE	4/10/08
BY	WCI
NO.	5
DATE	4/10/08
BY	WCI
NO.	6
DATE	4/10/08
BY	WCI
NO.	7

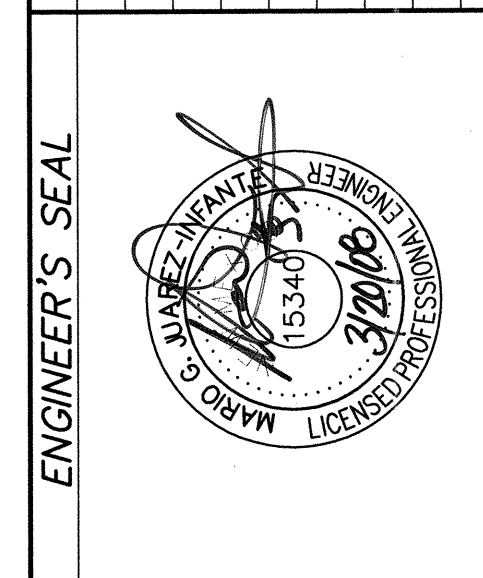

ENGINEER'S SEAL	
NO.	1
DATE	4/10/08
BY	WCI
NO.	2
DATE	4/10/08
BY	WCI
NO.	3
DATE	4/10/08
BY	WCI
NO.	4
DATE	4/10/08
BY	WCI
NO.	5
DATE	4/10/08
BY	WCI
NO.	6
DATE	4/10/08
BY	WCI
NO.	7
DATE	4/10/08
BY	WCI


CITY OF ALBUQUERQUE PUBLIC WORKS DEPARTMENT ENGINEERING GROUP			
VJW STORAGE INC TRANSPORTATION DETAILS			
Design Review Committee APPROVED APR 21 2008 DESIGN REVIEW COMMITTEE	City Engineer Approval APPROVED MAY 1 2008 DESIGN REVIEW COMMITTEE	Mo./Day/Yr.	Mo./Day/Yr.
City Project No. 7718.83	Zone Map No. A-12	Sheet 15	Of 22

RECORD DRAWING
DATE 8/20/08

WILSON & COMPANY
4900 LANG AVE N.E.
SUITE 200
ALBUQUERQUE, NEW MEXICO 87109
(505) 348-4000
FAX (505) 348-4072
www.wilsonco.com

WCEA #0660003900

ENGINEER'S SEAL		BENCH MARKS		SURVEY INFORMATION		AS-BUILT INFORMATION UNIVERSAL CONSTRUCTORS PYTHON CONSTRUCTION	
		FIELD NOTES		DATE		CONTRACTOR	
				NO.		BY	
				1	WCI	4/17/08	WORKMANSHIP INSPECTOR'S DATE 4/08
				2	WCI	4/18/08	ACCEPTANCE BY DATE 8/08
		REMARKS	BY	3	WCI	4/18/08	VERIFICATION BY DATE 8/08
		REVISONS		4	WCI	4/18/08	DRAWINGS COMPLETED BY DATE 8/08
WILSON & COMPANY, ENGINEERS & ARCHITECTS				5	WCI	5/28/08	MICRO-FILM INFORMATION
DESIGNED BY	MJJ	JAN. 2008		6	WCI	6/11/08	RECORDED BY DATE
DRAWN BY	STAFF	JAN. 2008		7	WCI	6/19/08	NO.
CHECKED BY	MJJ	JAN. 2008		ACS BRASS TABLET STAMPED "BLACK 2 1977"			
				GEOGRAPHIC POSITION (NAD 1927)			
				N.M. STATE PLANE COORDINATES (CENTRAL ZONE)			
				X= 372,920.43 Y= 1,530,241.52			
				GROUND- TO- GRID FACTOR= 0.9996692			
				Δ= -001'4".43"			
				SLD 1929 ELEVATION= 5213.926			

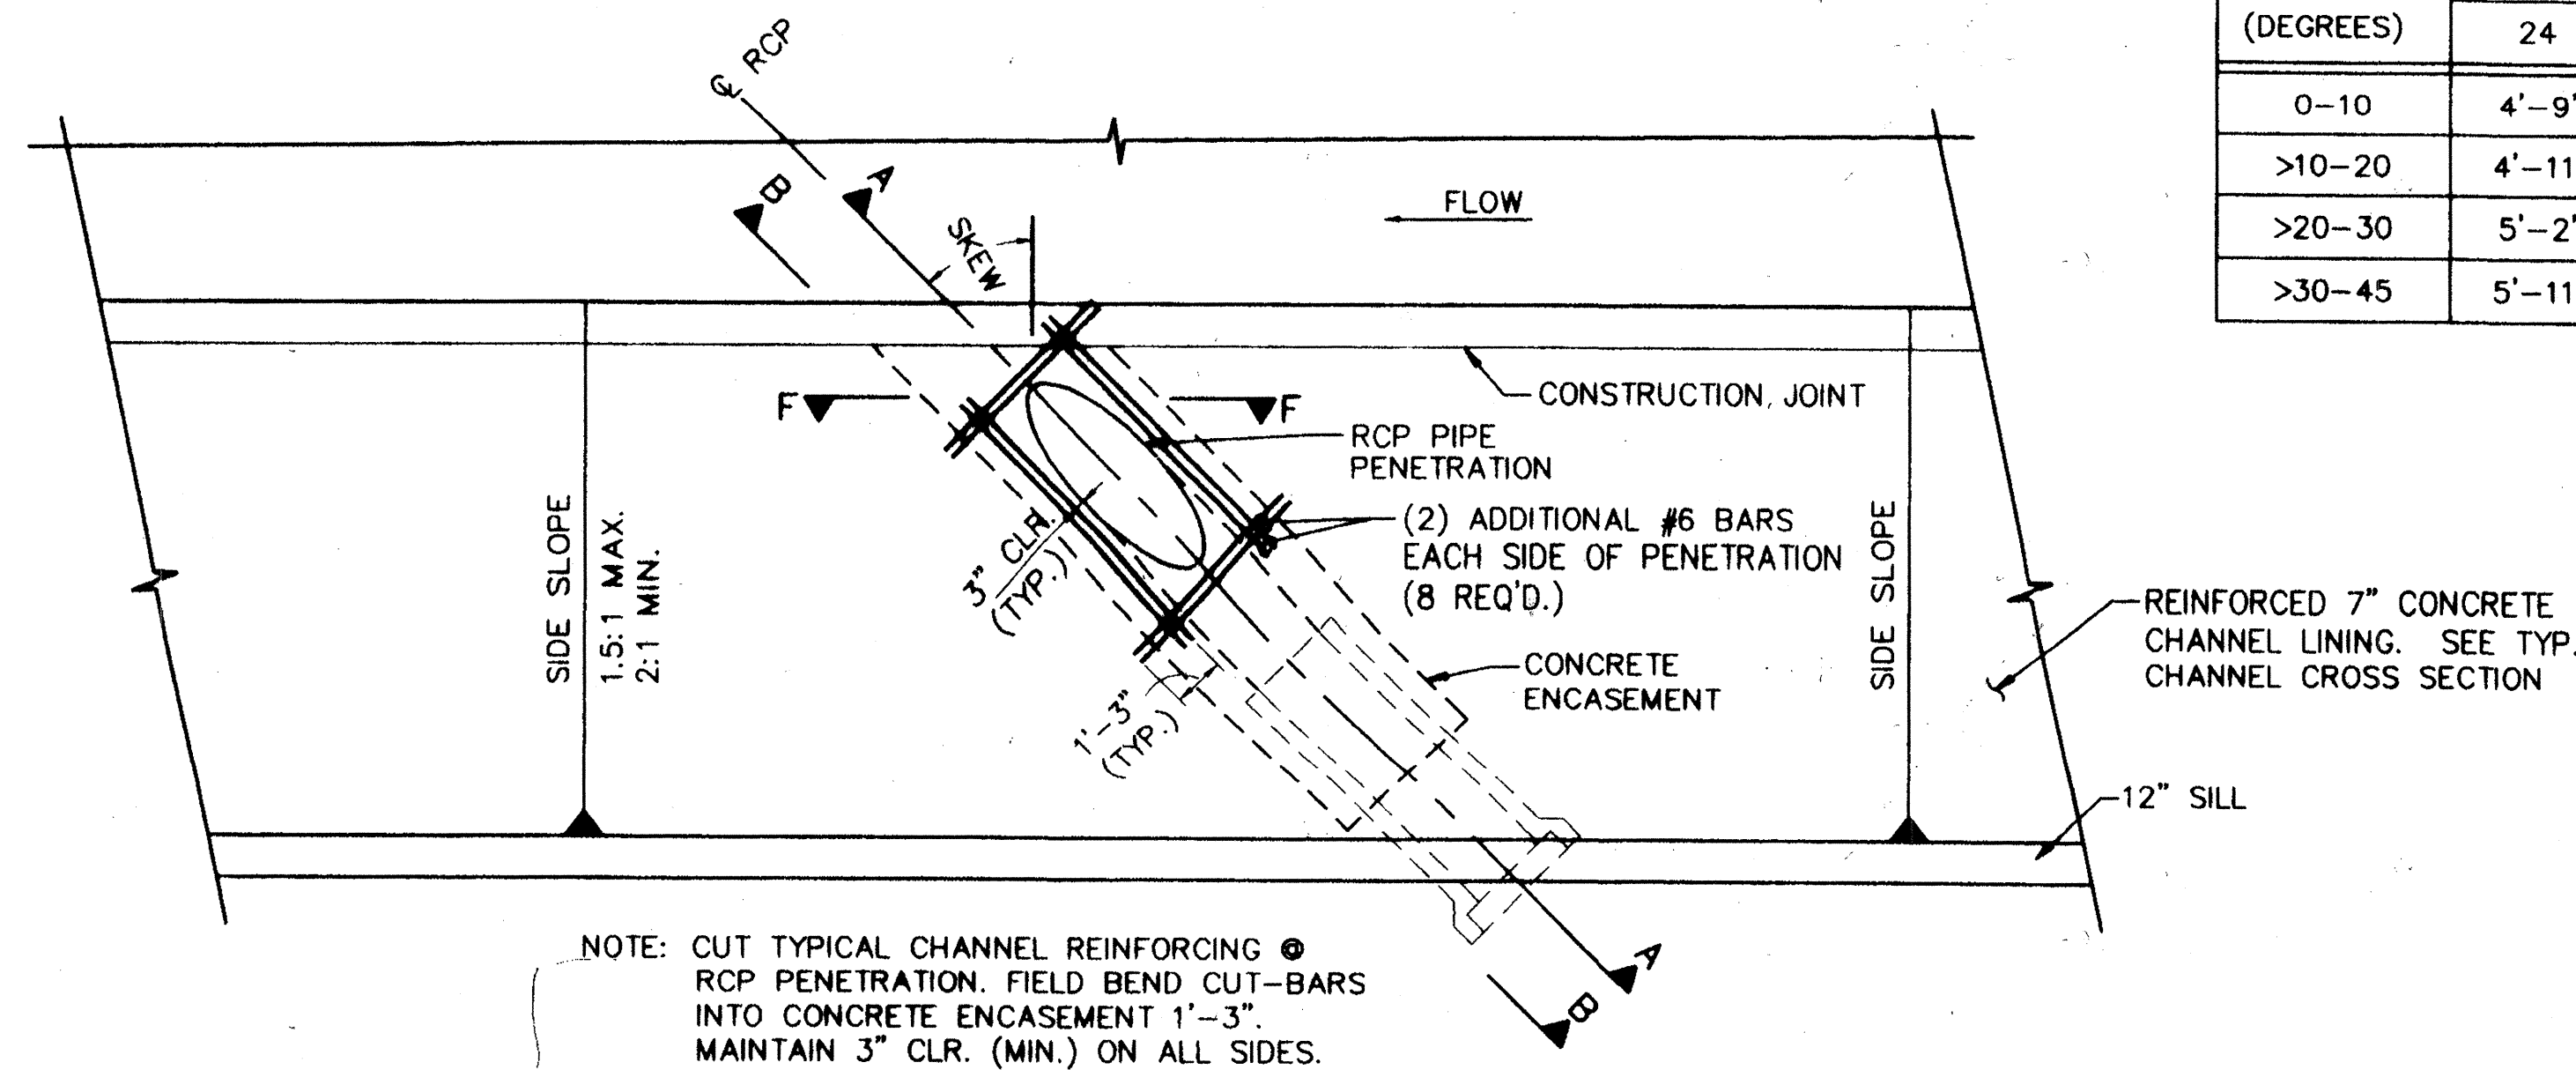

PIPE PENETRATION (PLAN VIEW)

SCALE: 1/4" = 1'-0"



SKEW ANGLE (DEGREES)	DIMENSION "A" FOR 1.5:1 SIDE SLOPE							
	PIPE DIAMETER (INCHES)							
0-10	4'-9"	5'-6"	6'-3"	7'-0"	7'-10"	8'-7"	9'-4"	10'-10"
>10-20	4'-11"	5'-8"	6'-5"	7'-3"	8'-1"	8'-11"	9'-8"	11'-3"
>20-30	5'-2"	6'-0"	6'-11"	7'-9"	8'-7"	9'-6"	10'-4"	12'-1"
>30-45	5'-11"	7'-0"	8'-1"	9'-2"	10'-2"	11'-3"	12'-4"	14'-5"

SKEW ANGLE (DEGREES)	DIMENSION "A" FOR 2:1 SIDE SLOPE							
	PIPE DIAMETER (INCHES)							
0-10	5'-9"	6'-9"	7'-10"	8'-10"	9'-10"	10'-10"	11'-11"	13'-11"
>10-20	5'-11"	7'-0"	8'-1"	9'-2"	10'-3"	11'-3"	12'-4"	14'-6"
>20-30	6'-4"	7'-6"	8'-7"	9'-9"	10'-11"	12'-1"	13'-3"	15'-7"
>30-45	7'-4"	8'-9"	10'-2"	11'-7"	13'-0"	14'-5"	15'-10"	18'-9"

DIMENSION "B"							
PIPE DIAMETER (INCHES)							
24	30	36	42	48	54	60	72
10"	11"	1'-1"	1'-2"	1'-3"	1'-4"	1'-6"	1'-8"


GENERAL NOTES:

1. THE PIPE PENETRATION DETAILED HEREIN SHALL BE PAID FOR UNDER LUMP SUM AND SHALL BE COMPENSATION FOR THE PENETRATION COMPLETE AND IN PLACE. INCLUDED IN THIS WORK (BUT NOT LIMITED TO) IS GRADING, SUBGRADE PREPARATION, REINFORCED CONCRETE, CONSTRUCTION JOINTS, CONCRETE PLACEMENT AND FINISHING. NOTE THE MEASUREMENT FOR 7" CHANNEL LINING IS CONTINUOUS AND UNINTERRUPTED AT THE PENETRATION LOCATION.
2. ALL CULVERT PIPE PLACED UNDER THE CHANNEL LINING OR WITHIN AMAFCA RIGHT-OF-WAY SHALL BE RCP CLASS III.

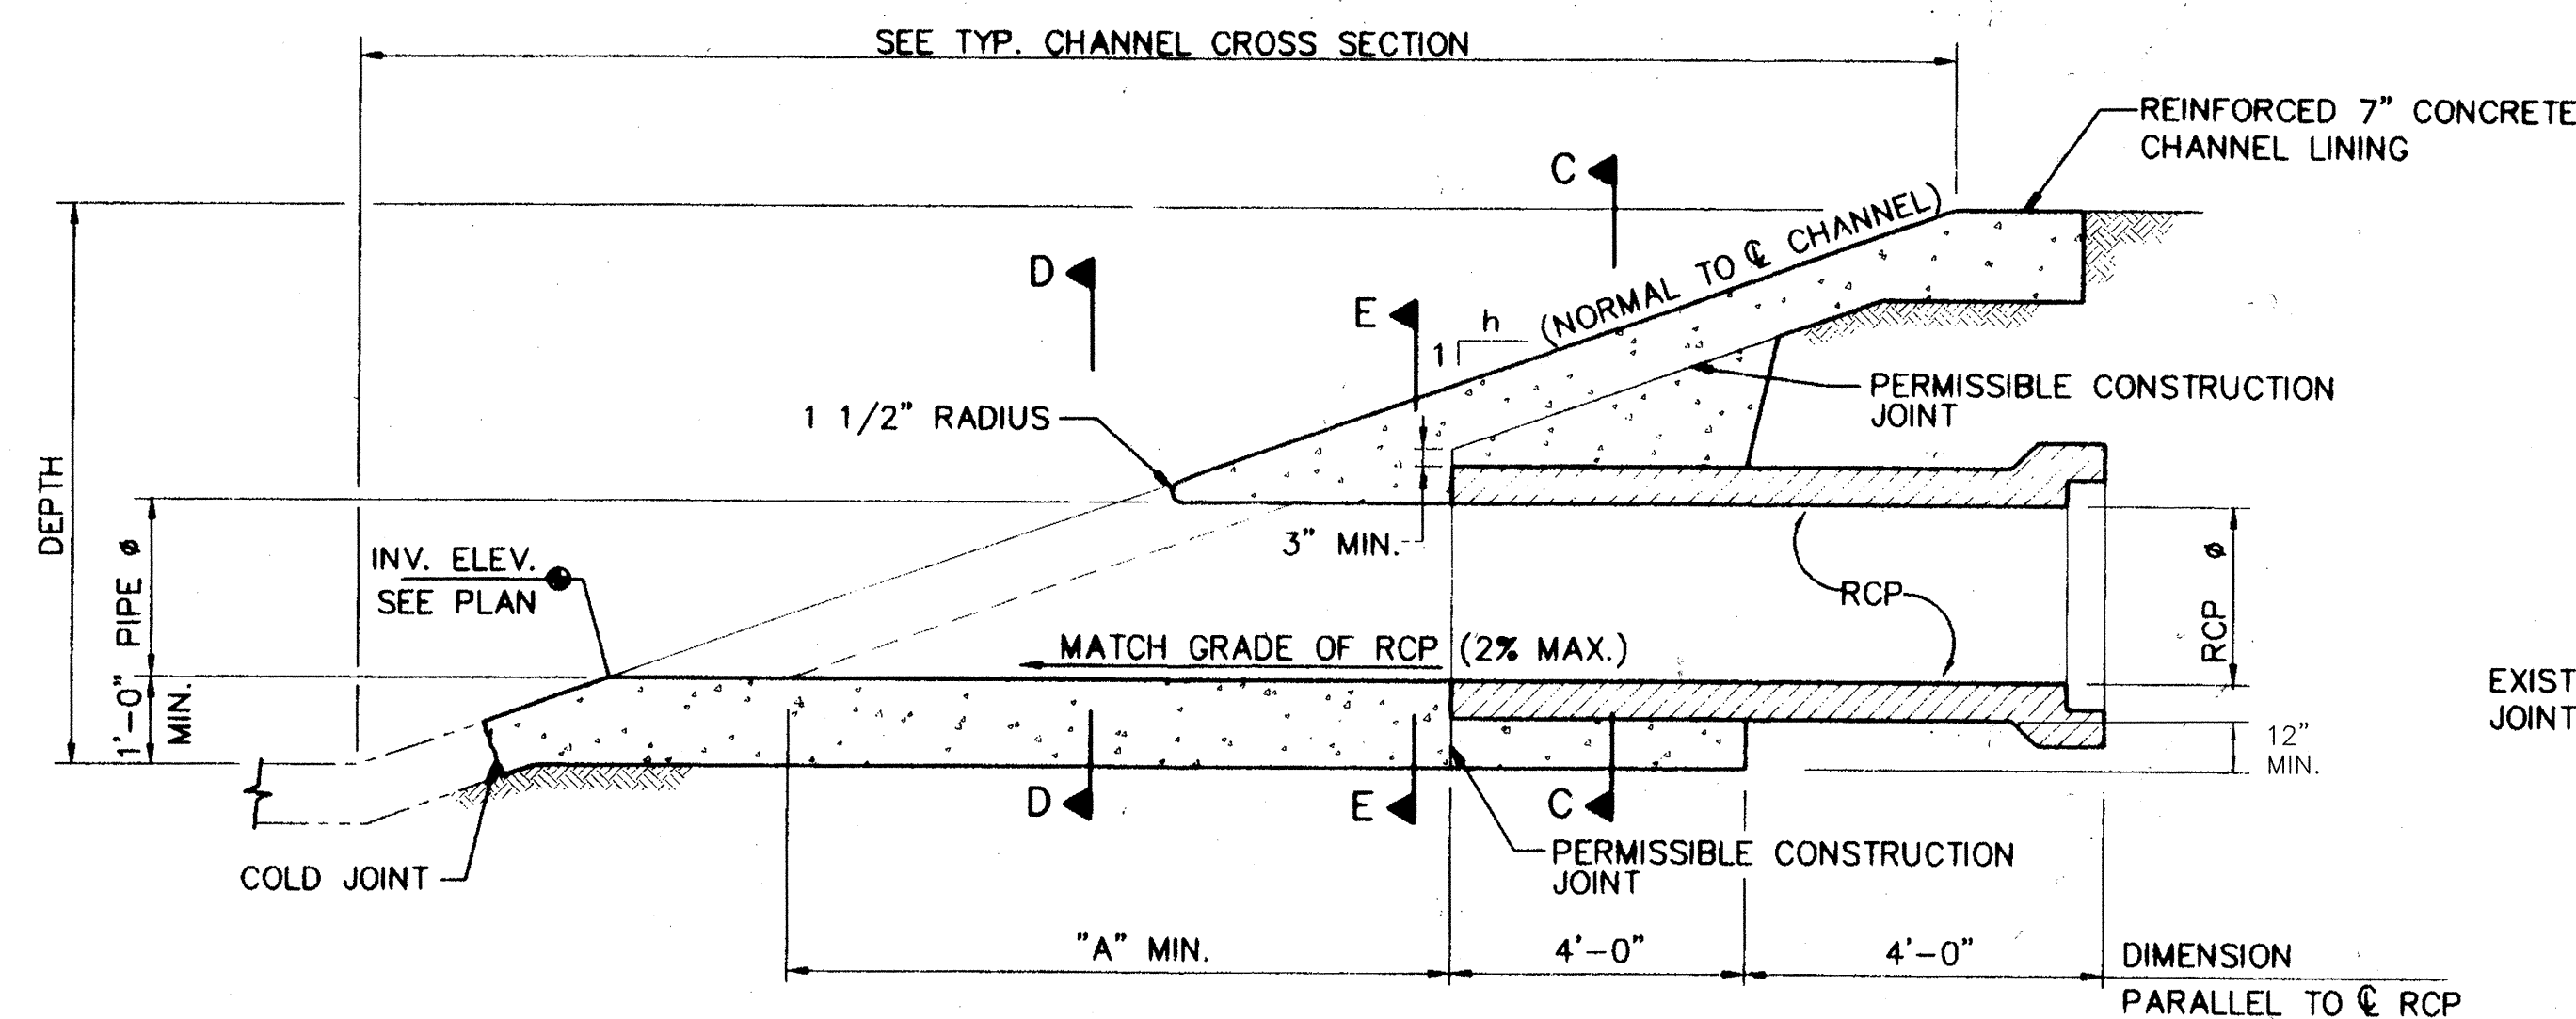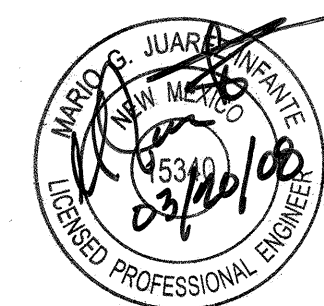


SECTION A-A

NO SCALE

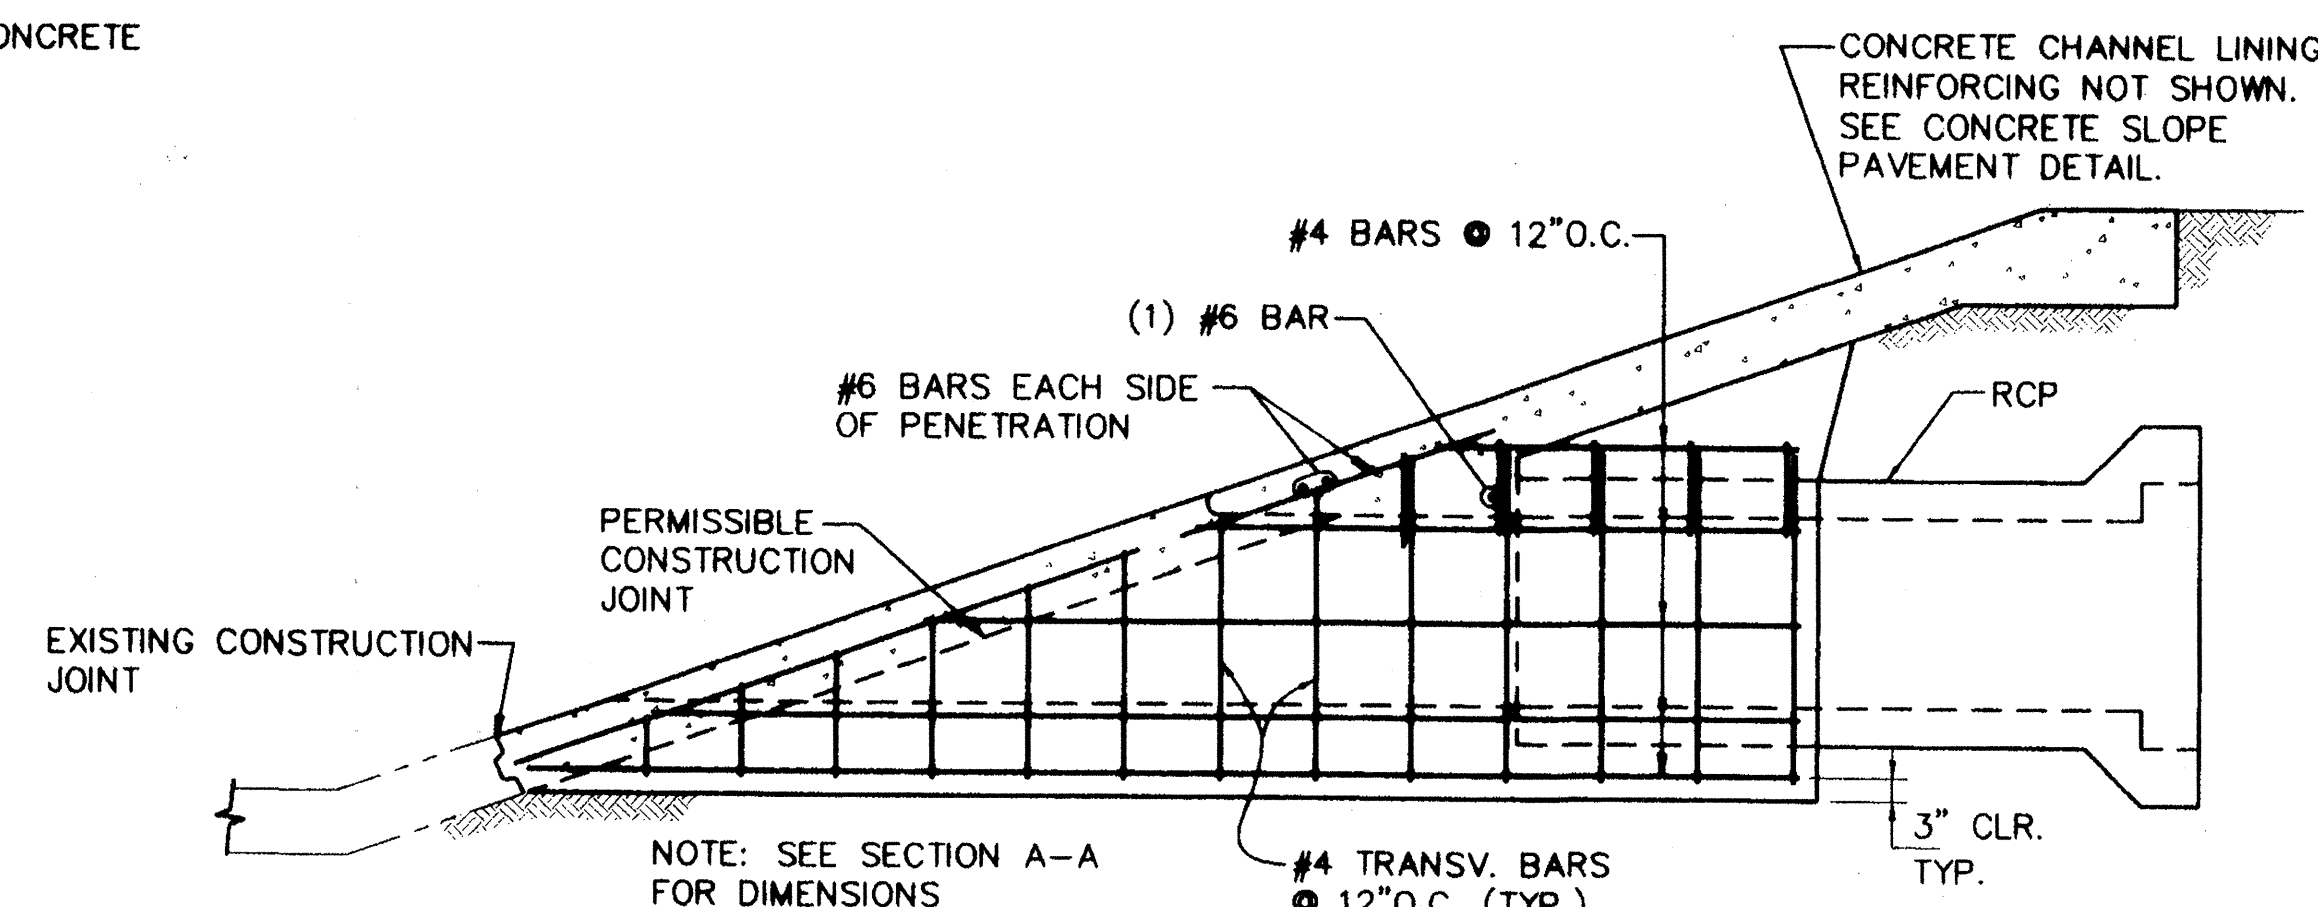


SECTION B-B

NO SCALE

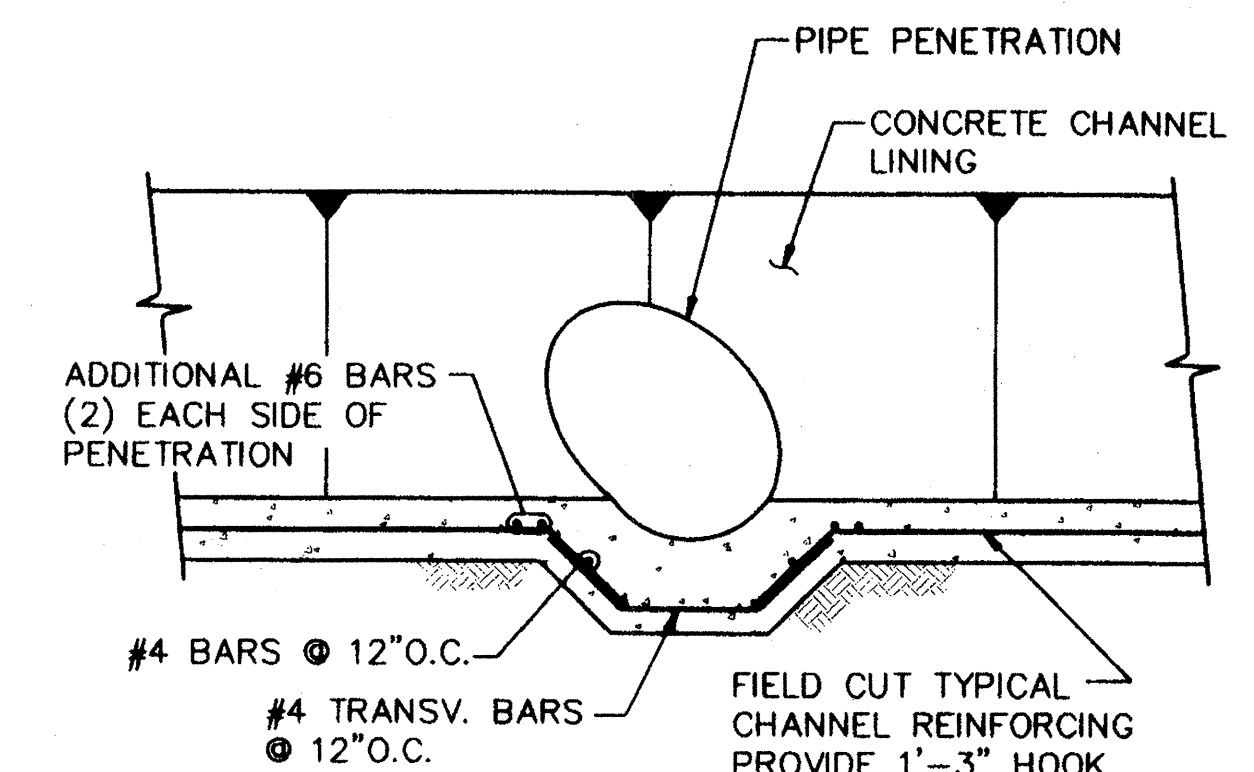


SECTION F-F

NO SCALE

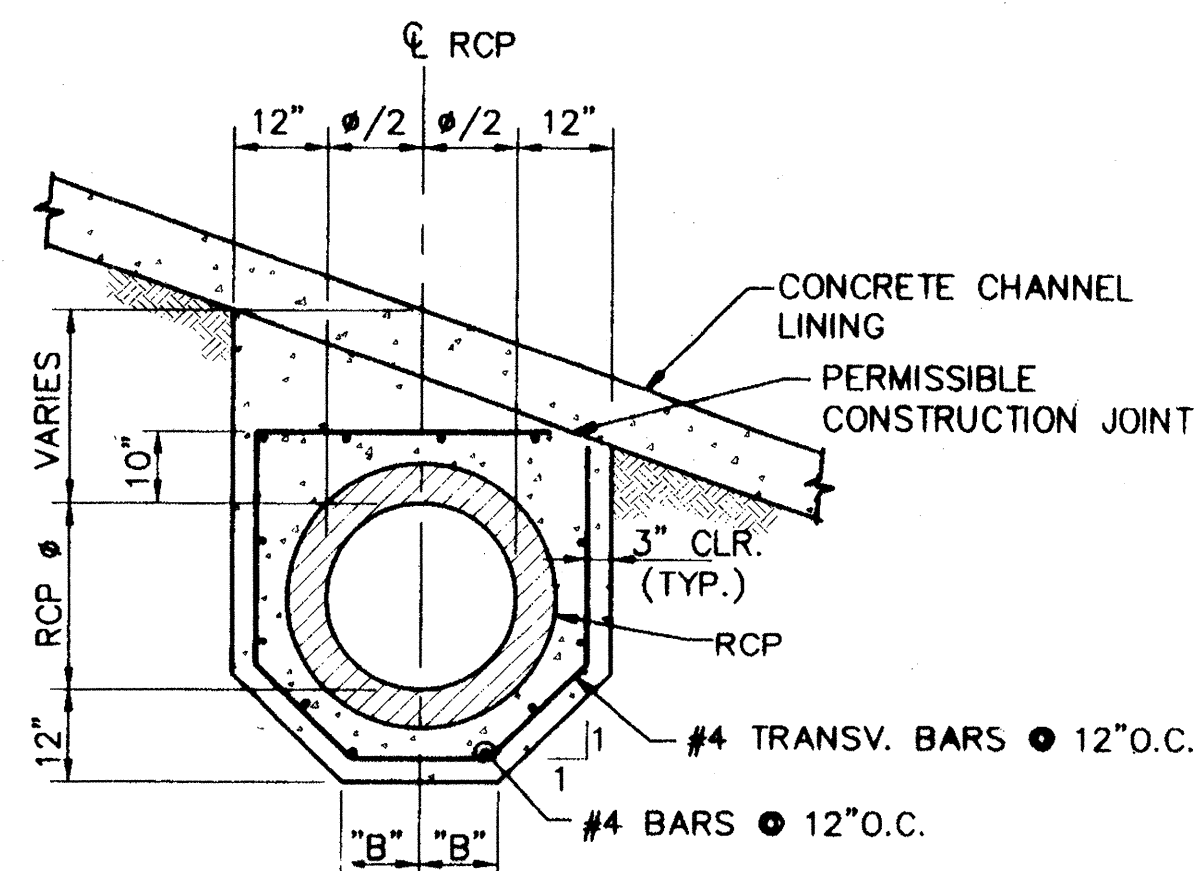


SECTION C-C

NO SCALE

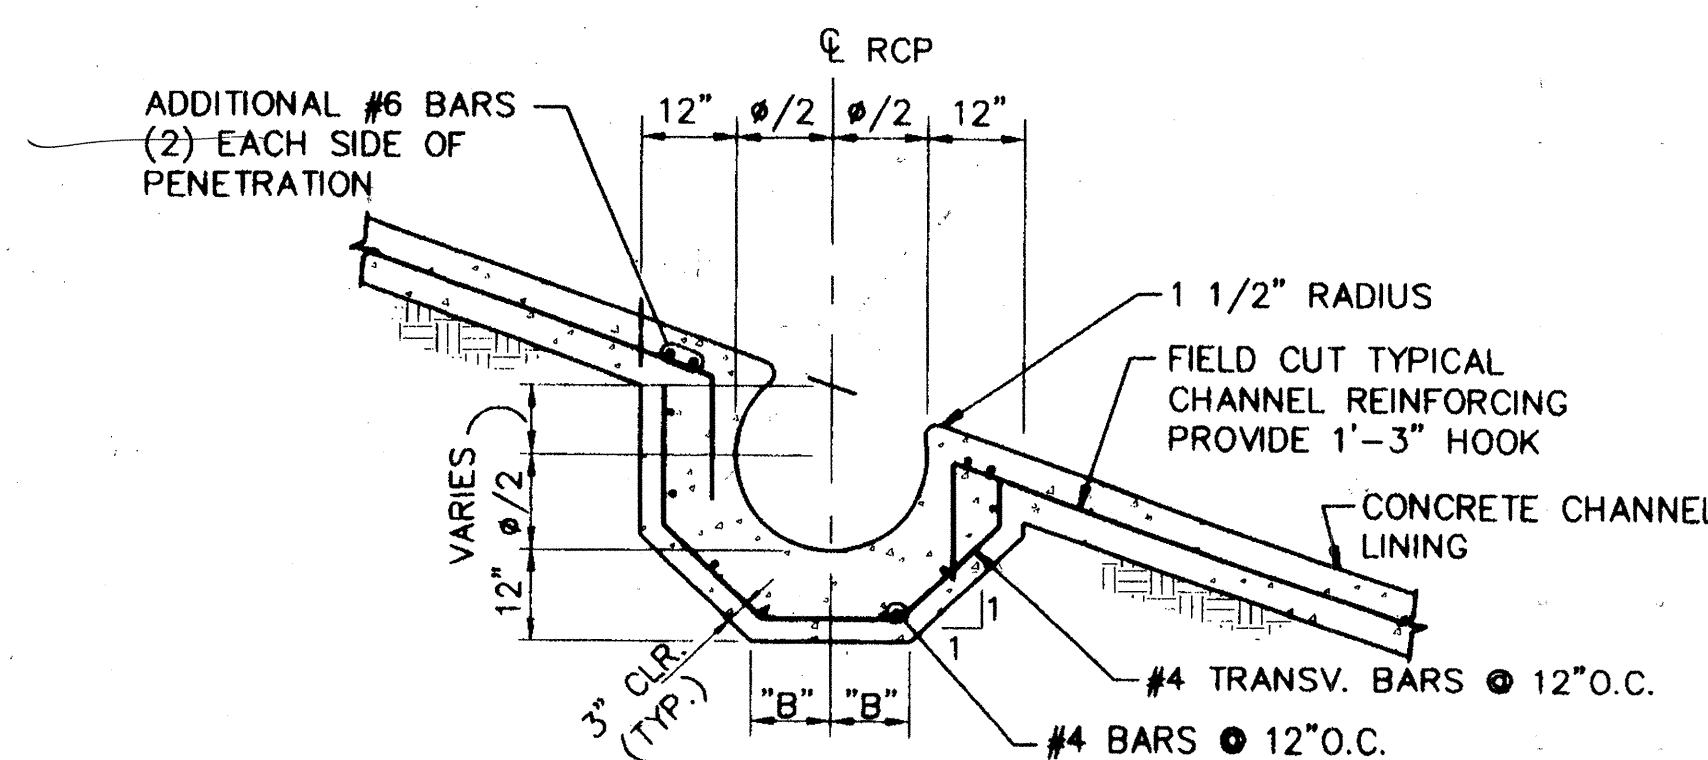

SECTION D-D


NO SCALE

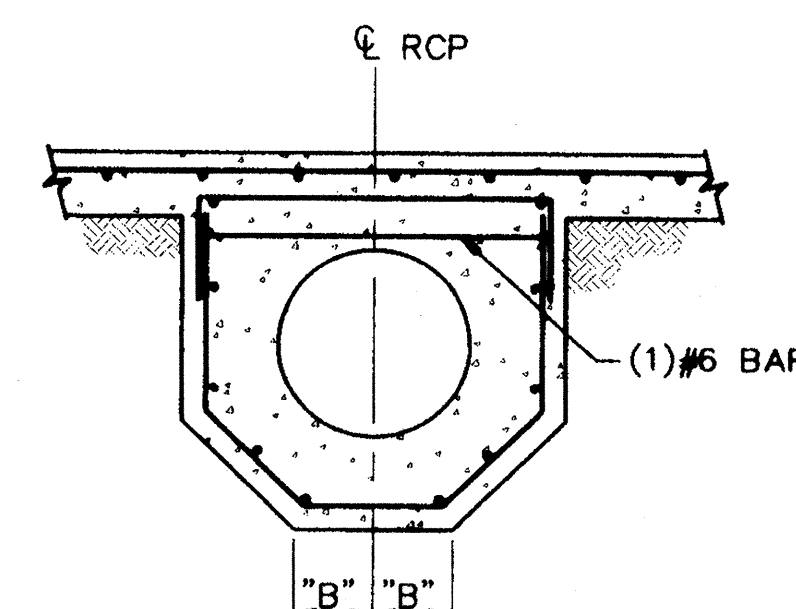


SECTION E-E

NO SCALE

RECORD DRAWING
DATE: 8/20/08

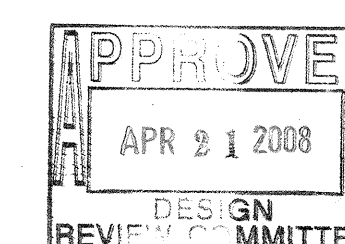

 ALBUQUERQUE METROPOLITAN ARROYO FLOOD CONTROL AUTHORITY			
VJW STORAGE INC			
RCP CHANNEL PENETRATION NEW CHANNEL CONSTRUCTION: SKEW < 45°			
DRAWING NO.	7718 83	MAP NO.	SHEET 17 OF 22

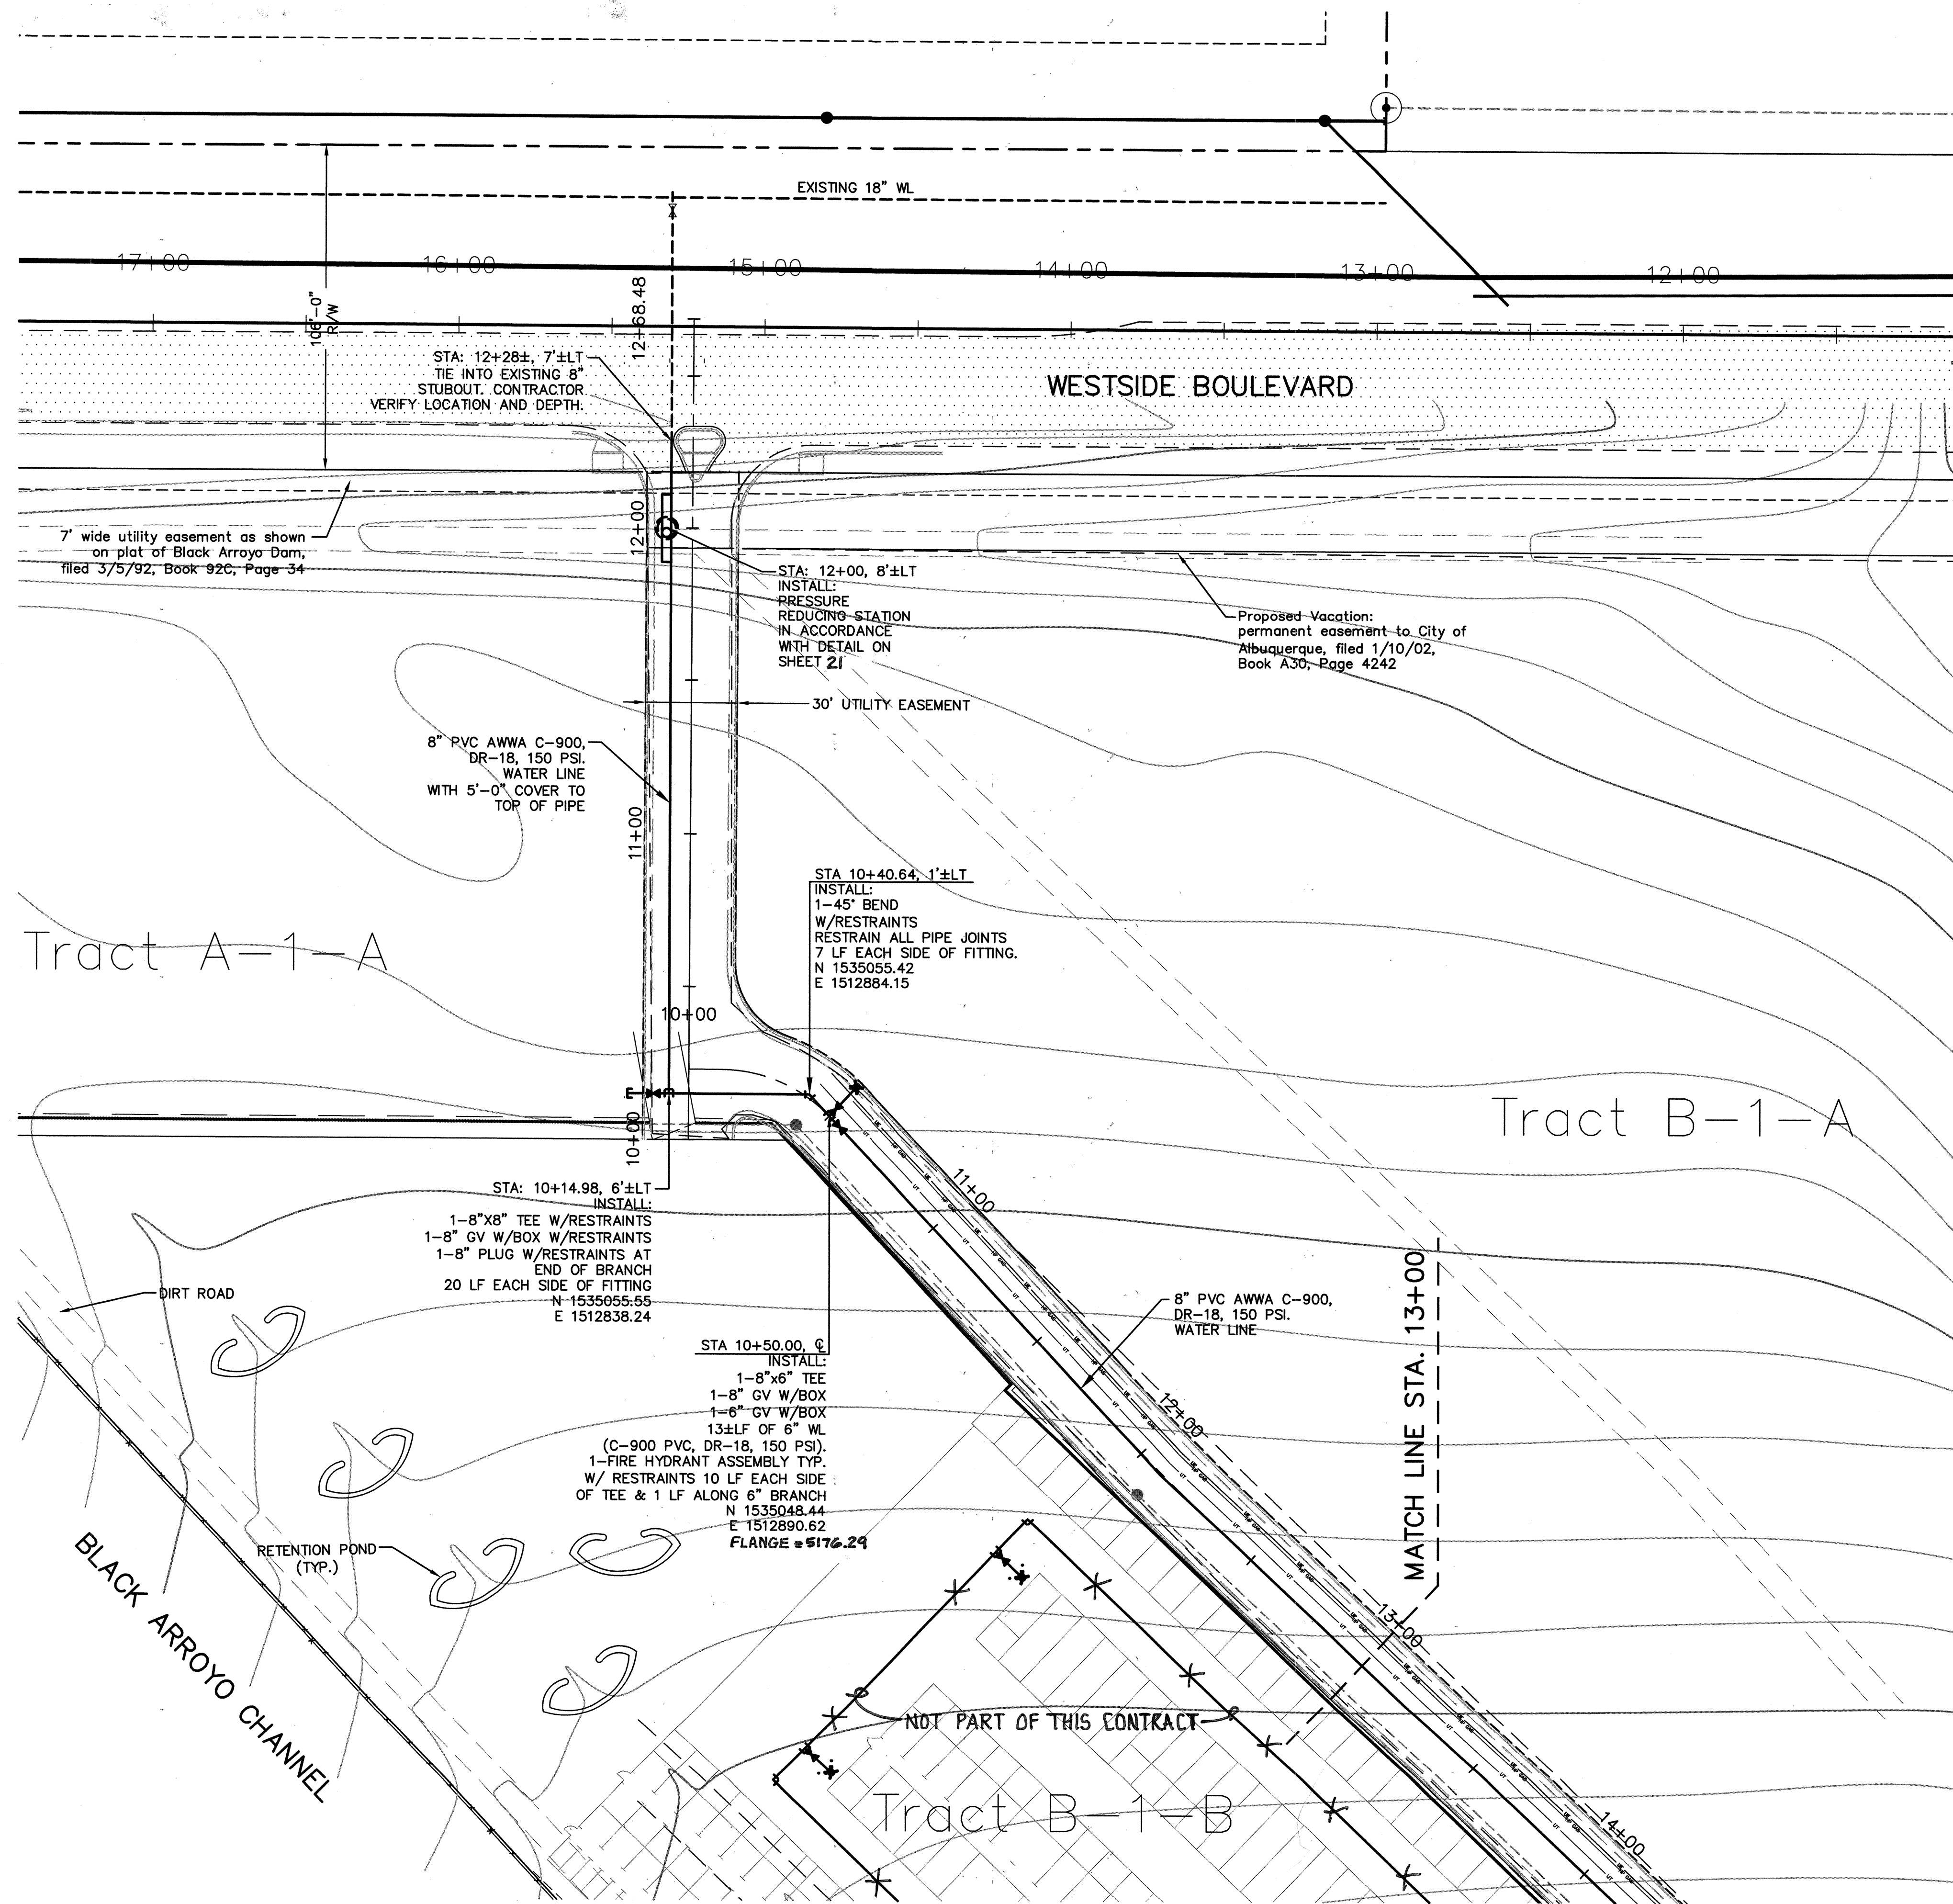


LEGEND

TBM TEMPORARY BENCHMARK
FF FINISH FLOOR
FG FINISH GRADE
FL FLOWLINE
TA TOP OF ASPHALT
TCP TOP OF CONCRETE
TC TOP OF CURB
TP TOP OF EARTH PAD
TS TOP OF SIDEWALK
TW TOP OF WALL
FH FIRE HYDRANT
WM WATER METER
WV WATER VALVE
MH MANHOLE
CB CATCH BASIN GRATE
GM GAS METER
LP LIGHT POLE
PP POWER POLE
GW GUY WIRE
PED ELEC. OR TEL. PEDESTAL
RD ROOF DRAINAGE POINT

— FEMA FLOORPLAN BOUNDARY
— DRAINAGE BASIN BOUNDARY
.... EROSION SETBACK LINE
— EXISTING CONTOUR
— PROPOSED CONTOUR
XX.XX EXISTING SPOT ELEVATION
● 69.9 PROPOSED SPOT ELEVATION
XX.XX RECORD SPOT ELEVATION
→ FLOW DIRECTION
— PROPOSED RETENTION POND
— EXISTING ROW
— PROPOSED ASPHALT
X EXISTING GATE VALVE
X PROPOSED GATE VALVE
M PROPOSED METER


SITE
LOCATION

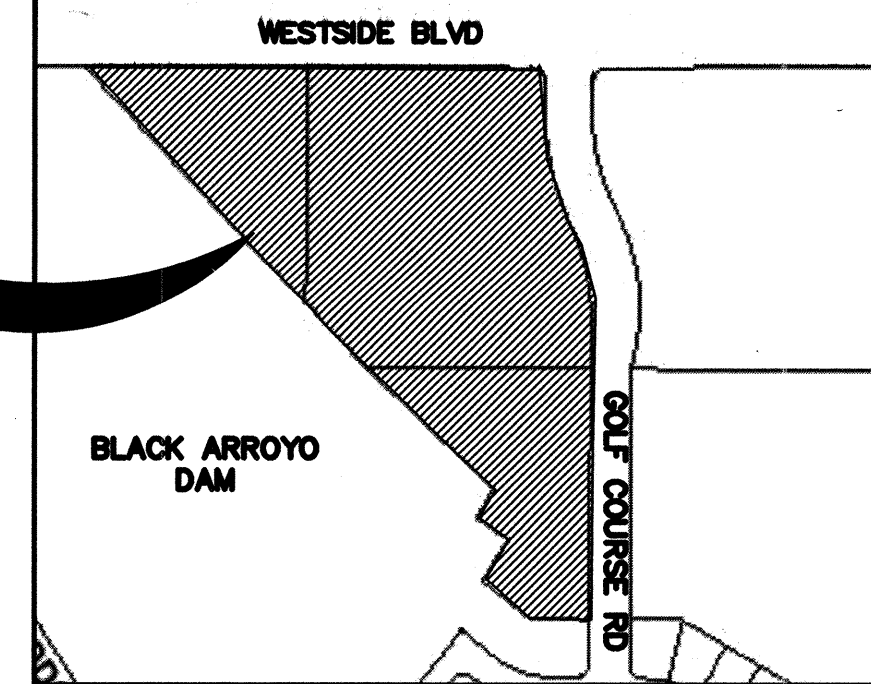

LOCATION MAP
ZONE ATLAS MAP NO. A-12



GRAPHIC SCALE

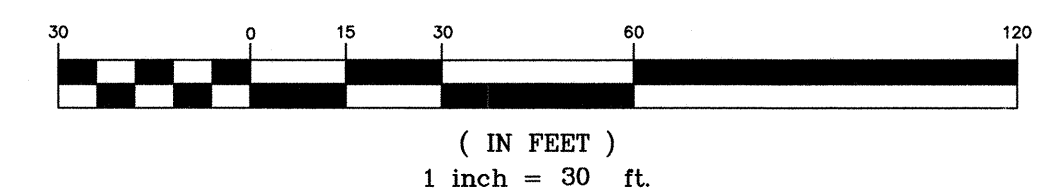


LEGAL DESCRIPTION

TRACTS 2-A, B-2 & C-2 & F-1 BLACK ARROYO DAM

BENCH MARK

ACS 5-A12 ELEVATION 5140.43 (NGVD) 1929)

WILSON & COMPANY
4900 LANG AVENUE NE
SUITE 200
ALBUQUERQUE, NEW MEXICO
87109
(505) 348-4000
FAX (505) 348-4072
www.wilsonco.com

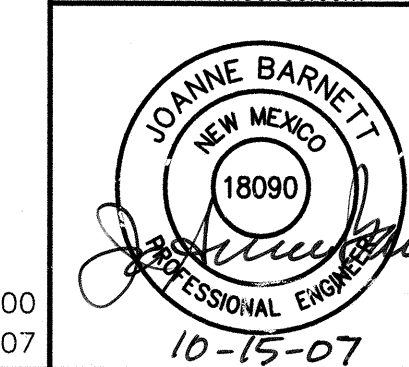


CITY OF ALBUQUERQUE
PUBLIC WORKS DEPARTMENT
ENGINEERING GROUP
VJW INC. STORAGE
OVERALL
UTILITY PLAN

Design Review Committee	City Engineer Approval	Last Design Update	Mo./Day/Yr.	Mo./Day/Yr.
APPROVED APR 2 2008 DESIGN REVIEW COMMITTEE	APPROVED DESIGN REVIEW COMMITTEE			
City Project No. 7718.83	Zone Map No. A-12	Sheet 18	Of 22	


RECORD DRAWING
DATE 8/20/08

WCEA #0660003900
FEBRUARY 2007

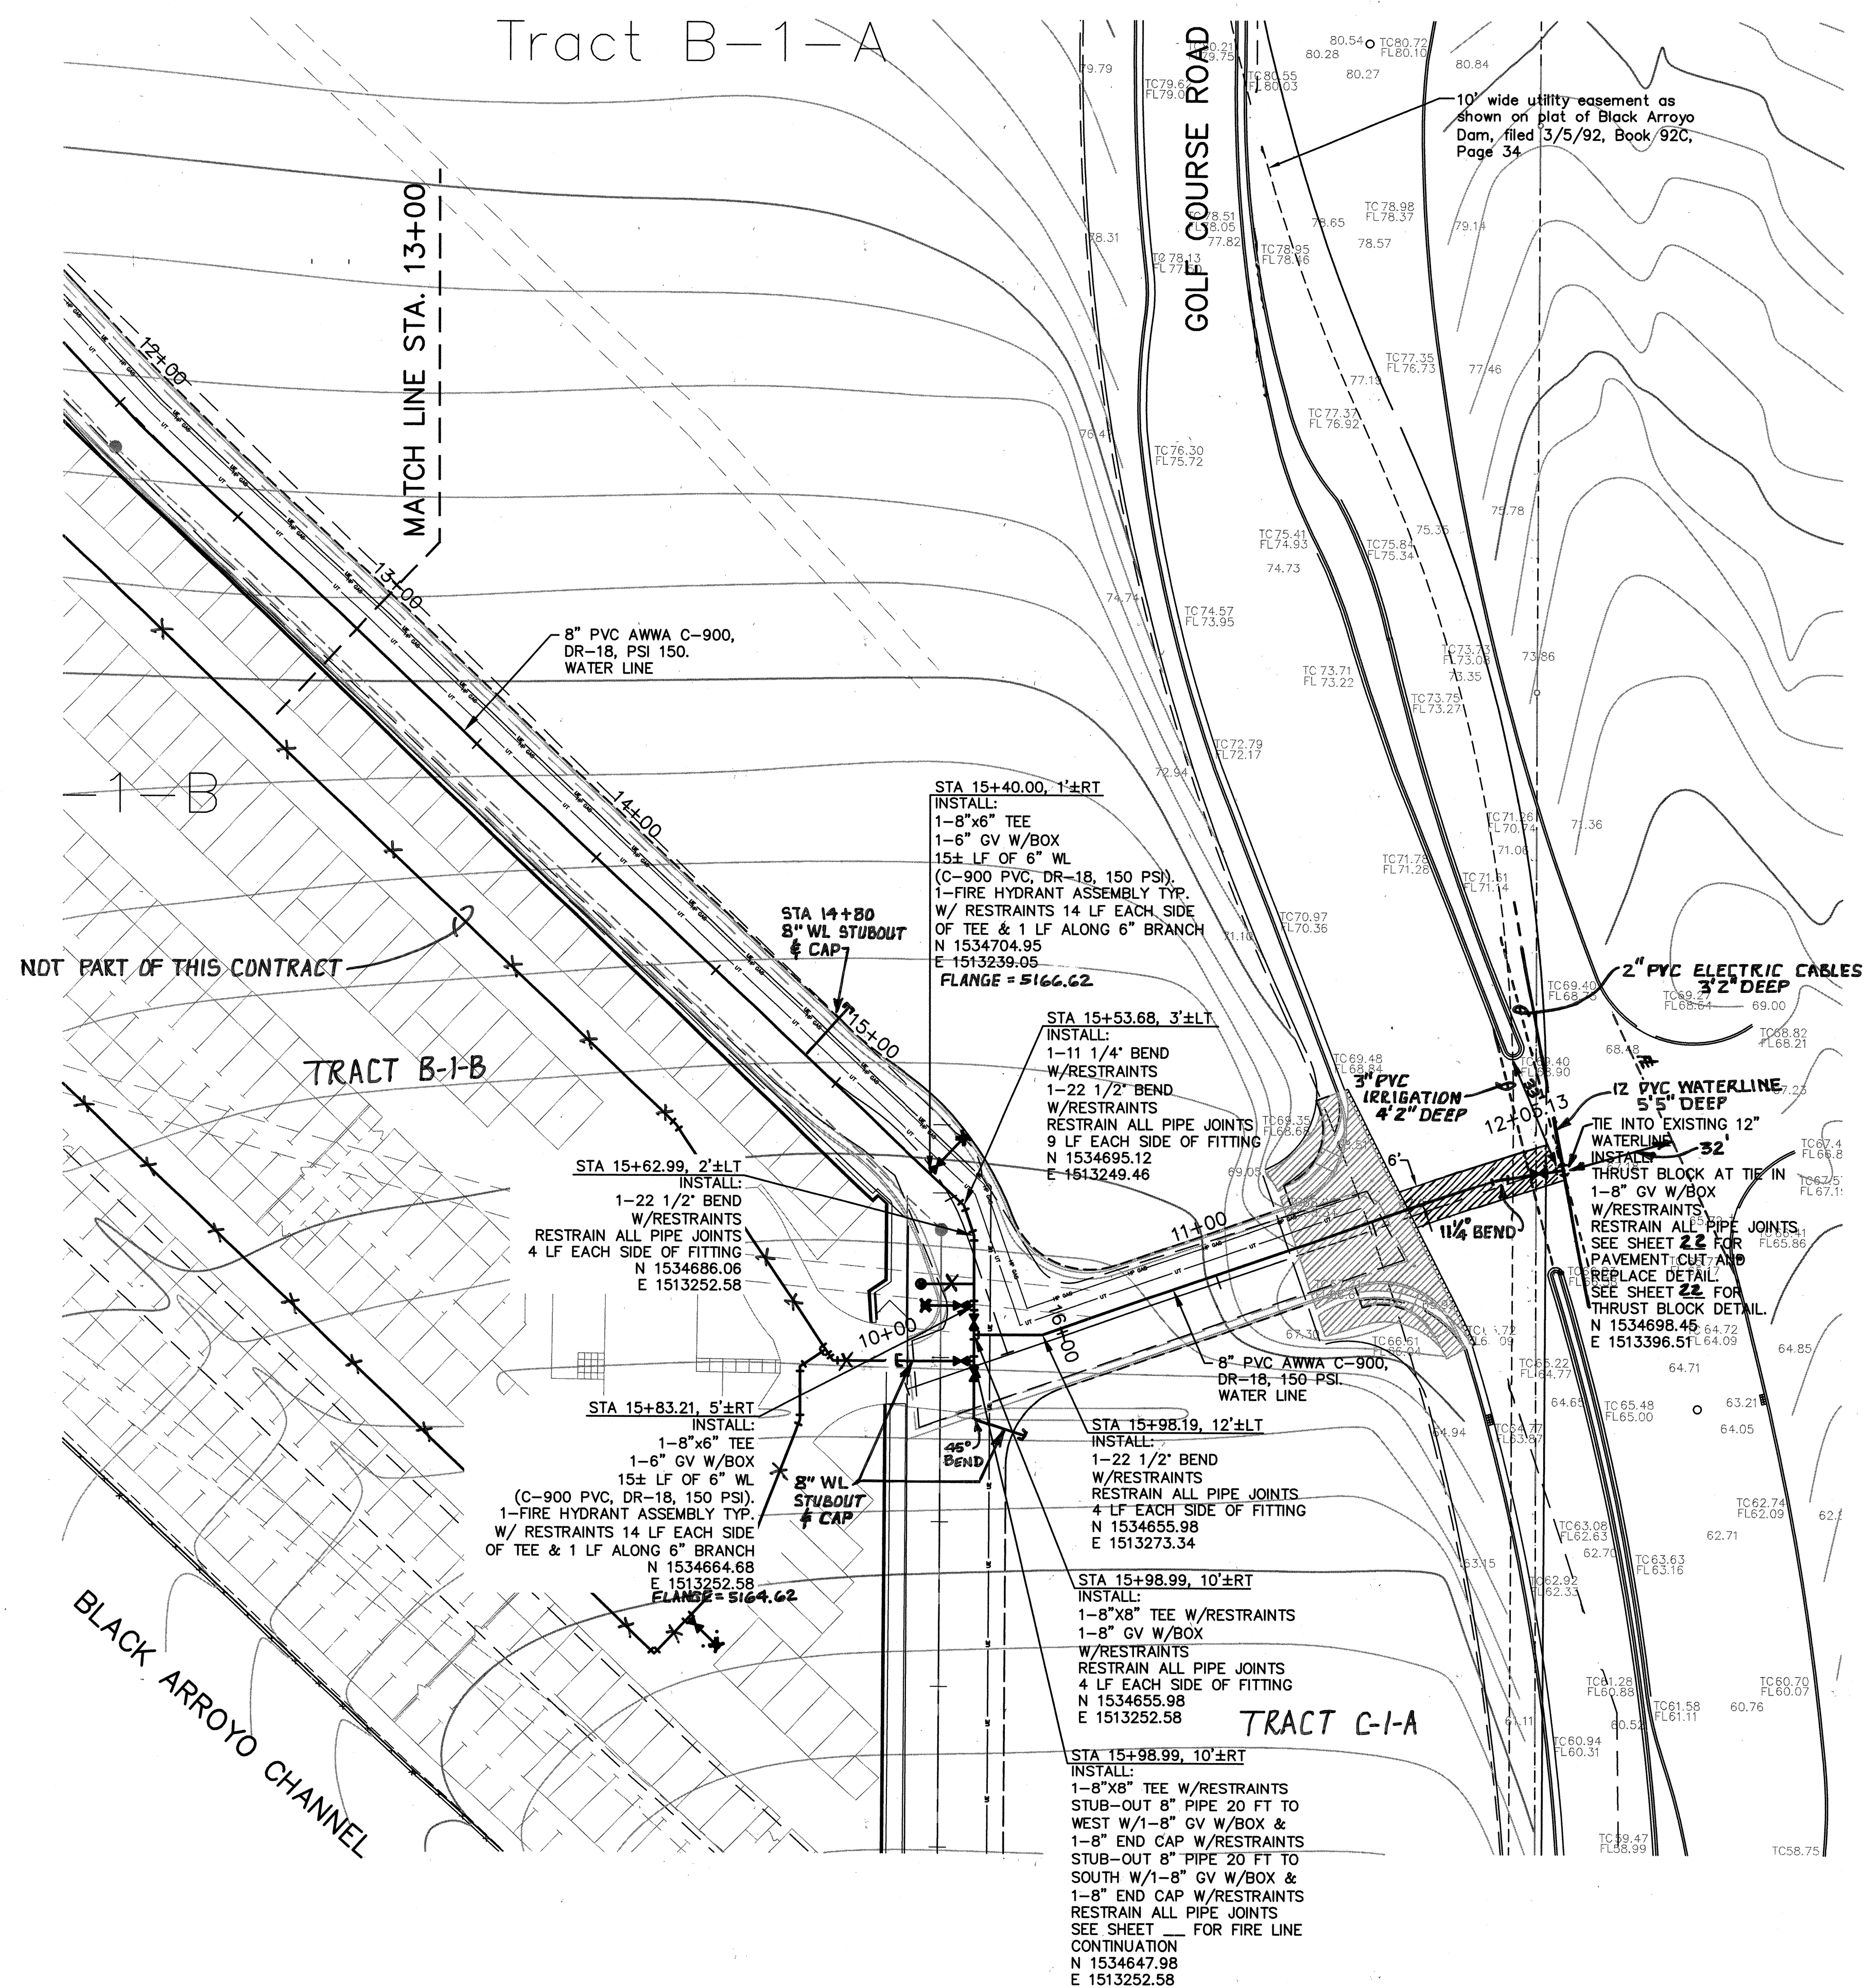

LEGEND

- | | |
|-----|------------------------|
| TBM | TEMPORARY BENCHMARK |
| FF | FINISH FLOOR |
| FG | FINISH GRADE |
| FL | FLOWLINE |
| TA | TOP OF ASPHALT |
| TOP | TOP OF CONCRETE |
| TC | TOP OF CURB |
| TF | TOP OF EARTH PAD |
| TS | TOP OF SIDEWALK |
| TW | TOP OF WALL |
| FH | FIRE HYDRANT |
| WM | WATER METER |
| WV | WATER VALVE |
| MH | MANHOLE |
| CB | CATCH BASIN GRATE |
| GM | GAS METER |
| LP | LIGHT POLE |
| PP | POWER POLE |
| GW | GUY WIRE |
| PED | ELEC. OR TEL. PEDESTAL |
| RD | ROOF DRAINAGE POINT |
-
- | | |
|---------------------------|-------------------------|
| | FEMA FLOORPLAN BOUNDARY |
| | DRAINAGE BASIN BOUNDARY |
| | EROSION SETBACK LINE |
| | EXISTING CONTOUR |
| | PROPOSED CONTOUR |
| XX.XX | EXISTING SPOT ELEVATION |
| ● 69.9 | PROPOSED SPOT ELEVATION |
| XX.XX
XX.XX | RECORD SPOT ELEVATION |
| | FLOW DIRECTION |
| | PROPOSED RETENTION POND |
| | EXISTING ROW |
| | PROPOSED ASPHALT |
| | EXISTING GATE VALVE |
| | PROPOSED GATE VALVE |
| | PROPOSED METER |

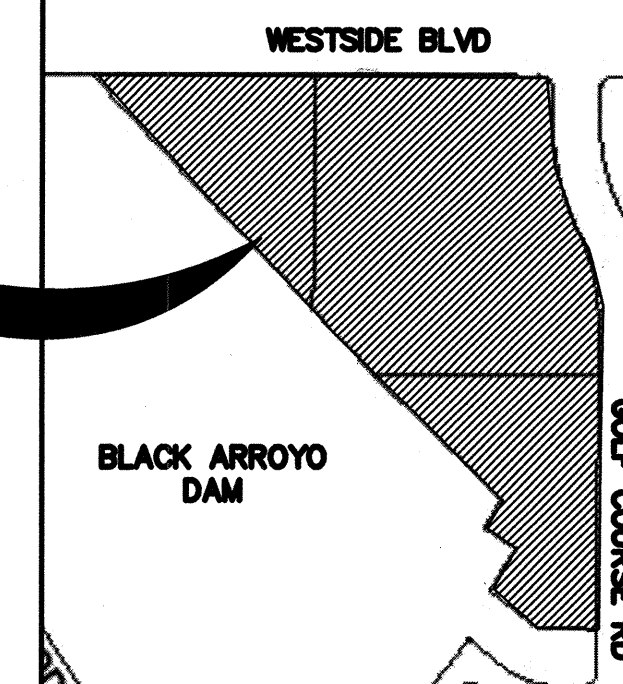


LOCATION MAP

ZONE ATLAS MAP NO. A-12



GRAPHIC SCALE

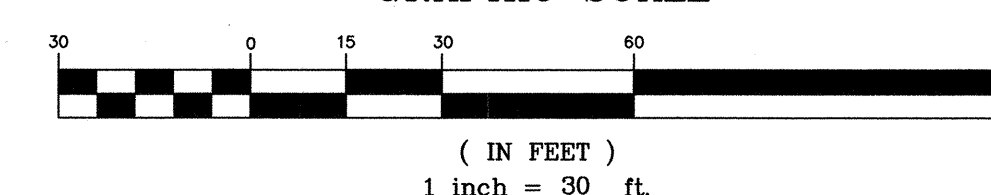



LEGAL DESCRIPTION

TRACTS 2-A, B-2 & C-2 & F-1 BLACK ARROYO DAM

BENCH MARK

ACS 5-A12 BENCH MARK
ELEVATION 5140.43 (NGVD) 1929)

 WILSON & COMPANY 4900 LANE AVENUE NE SUITE 200 ALBUQUERQUE, NEW MEXICO 87109 (505) 348-4000 FAX (505) 348-4072 www.wilnco.com	 CITY OF ALBUQUERQUE PUBLIC WORKS DEPARTMENT ENGINEERING GROUP VJW INC. STORAGE <i>OVERALL</i> UTILITY PLAN																		
 <i>Joanne Barnett</i> PROFESSIONAL ENGINEER	<table border="1" style="width: 100%; border-collapse: collapse;"> <tr> <td style="width: 50%; padding: 5px;"> Design Review Committee  </td> <td style="width: 50%; padding: 5px;"> City Engineer Approval  </td> </tr> <tr> <td style="width: 50%; padding: 5px;"> City Project No. 7718-83 </td> <td style="width: 50%; padding: 5px;"> Zone Map No. A-12 </td> </tr> <tr> <td colspan="2" style="padding: 5px;"> Last Design Update <table border="1" style="width: 100%; border-collapse: collapse;"> <thead> <tr> <th style="width: 50%;">Mo./Day/Yr.</th> <th style="width: 50%;">Mo./Day/Yr.</th> </tr> </thead> <tbody> <tr><td> </td><td> </td></tr> <tr><td> </td><td> </td></tr> <tr><td> </td><td> </td></tr> <tr><td> </td><td> </td></tr> </tbody> </table> </td> </tr> <tr> <td colspan="2" style="padding: 5px;"> Sheet 19 of 22 </td> </tr> </table>	Design Review Committee 	City Engineer Approval 	City Project No. 7718-83	Zone Map No. A-12	Last Design Update <table border="1" style="width: 100%; border-collapse: collapse;"> <thead> <tr> <th style="width: 50%;">Mo./Day/Yr.</th> <th style="width: 50%;">Mo./Day/Yr.</th> </tr> </thead> <tbody> <tr><td> </td><td> </td></tr> <tr><td> </td><td> </td></tr> <tr><td> </td><td> </td></tr> <tr><td> </td><td> </td></tr> </tbody> </table>		Mo./Day/Yr.	Mo./Day/Yr.									Sheet 19 of 22	
Design Review Committee 	City Engineer Approval 																		
City Project No. 7718-83	Zone Map No. A-12																		
Last Design Update <table border="1" style="width: 100%; border-collapse: collapse;"> <thead> <tr> <th style="width: 50%;">Mo./Day/Yr.</th> <th style="width: 50%;">Mo./Day/Yr.</th> </tr> </thead> <tbody> <tr><td> </td><td> </td></tr> <tr><td> </td><td> </td></tr> <tr><td> </td><td> </td></tr> <tr><td> </td><td> </td></tr> </tbody> </table>		Mo./Day/Yr.	Mo./Day/Yr.																
Mo./Day/Yr.	Mo./Day/Yr.																		
Sheet 19 of 22																			

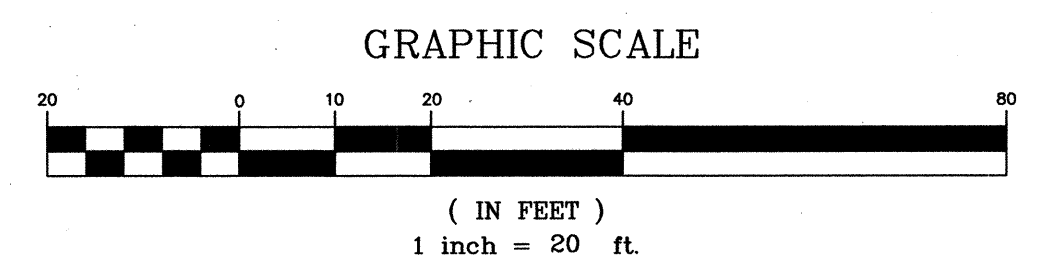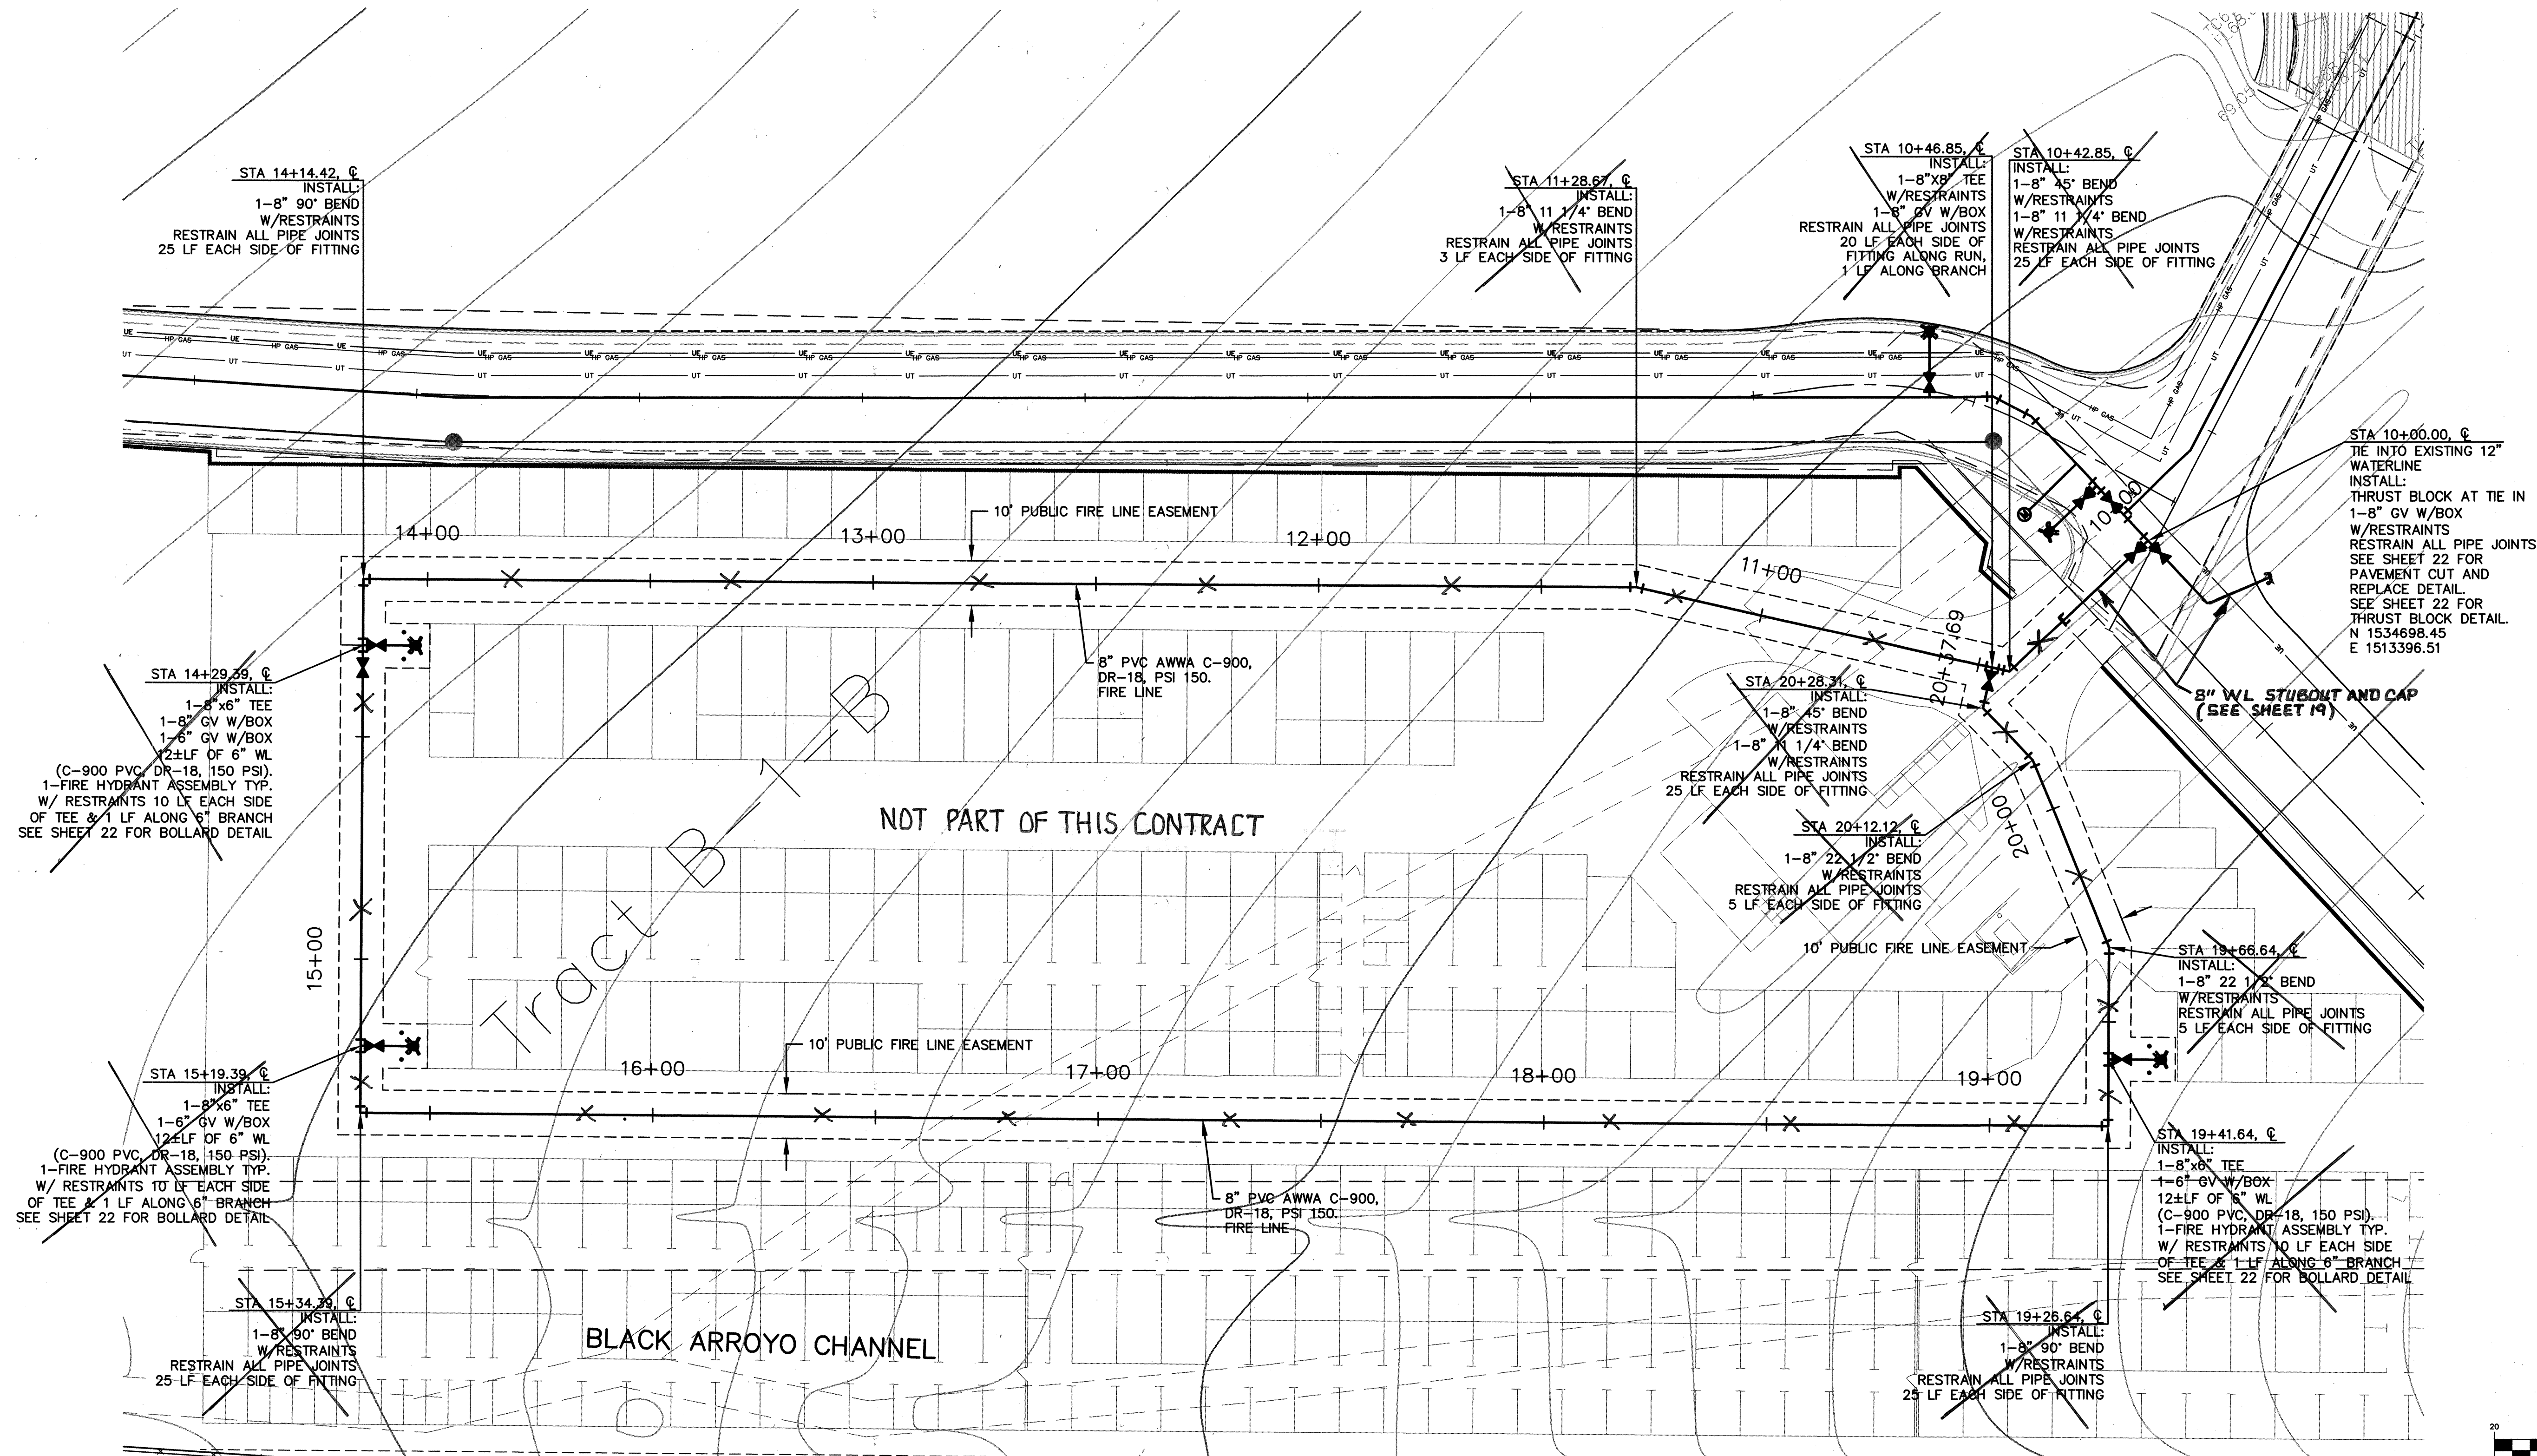

WILSON & COMPANY 4900 LANG AVENUE NE SUITE 200 ALBUQUERQUE, NEW MEXICO 87109 (505) 348-4000 FAX (505) 348-4072 www.wilsonco.com		CITY OF ALBUQUERQUE PUBLIC WORKS DEPARTMENT ENGINEERING GROUP VJW INC. STORAGE OVERALL UTILITY PLAN	
Design Review Committee APPROVED DESIGN REVIEW COMMITTEE	City Engineer Approval APPROVED DESIGN REVIEW COMMITTEE	Mo./Day/Yr. _____	Mo./Day/Yr. _____
City Project No. 7718.83	Zone Map No. A-12	Sheet 20	Of 22

- 1" SDR9 200psi copper tube size poly.
- 1" Flare x 3/4" yoke adapter Ball valve w/locking wing.
- Water Meter provided by NMUI.
- Expansion connection to be provided by NMUI.
- Straight yoke outlet piece, 3/4" meter connection x 3/4" M.I.P.
- Gate Valve 3/4" F.I.P. x 3/4" F.I.P.
- Dual check backflow preventer, 3/4" M.I.P. x 3/4" F.I.P.
- Boss nipple 3/4" M.I.P. x 3/4" M.I.P. x 6" long.
- Yoke bar.

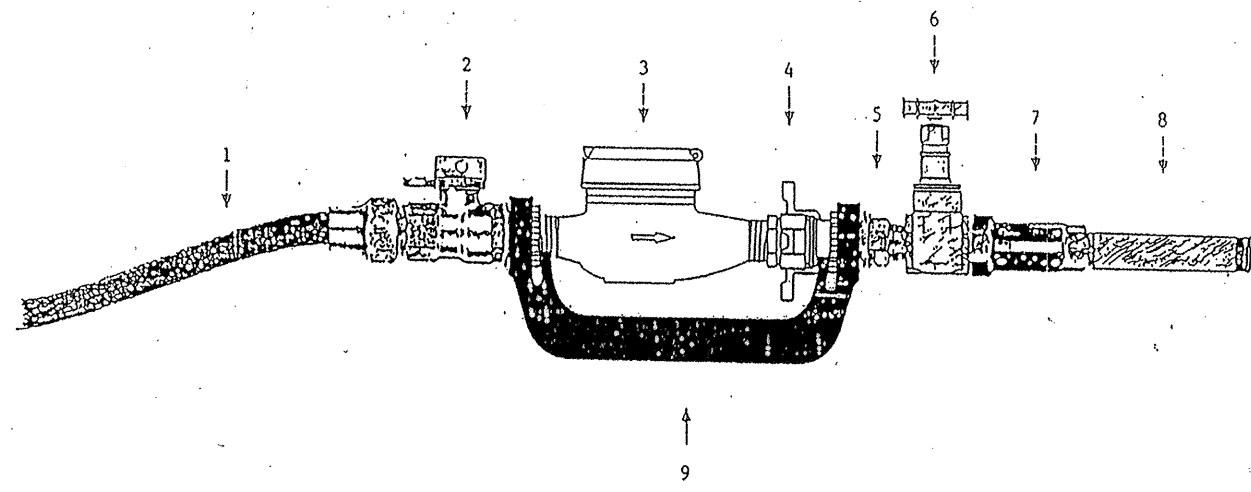


Exhibit "A"

1-1/2" and 2" Meter Set

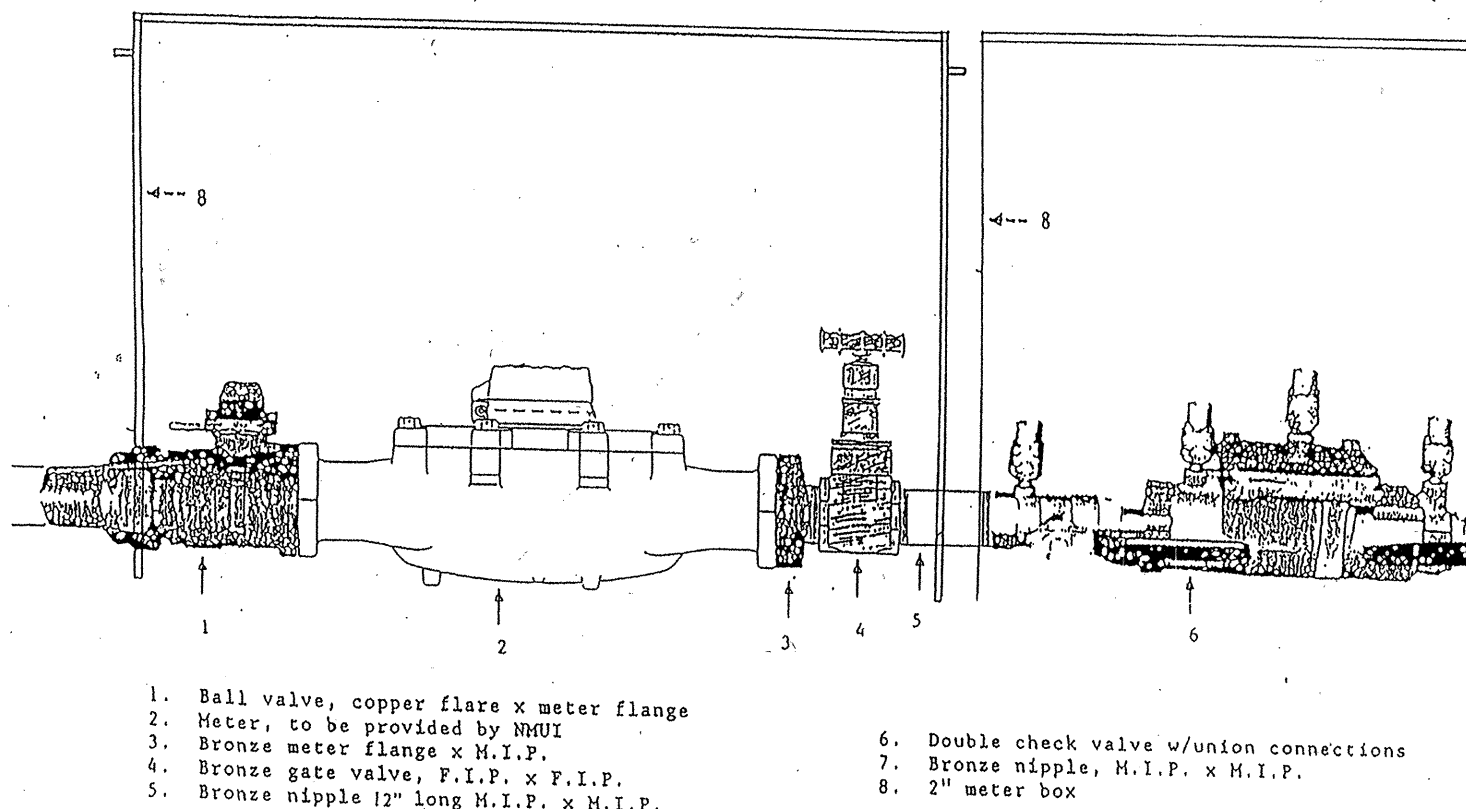


EXHIBIT "A1"

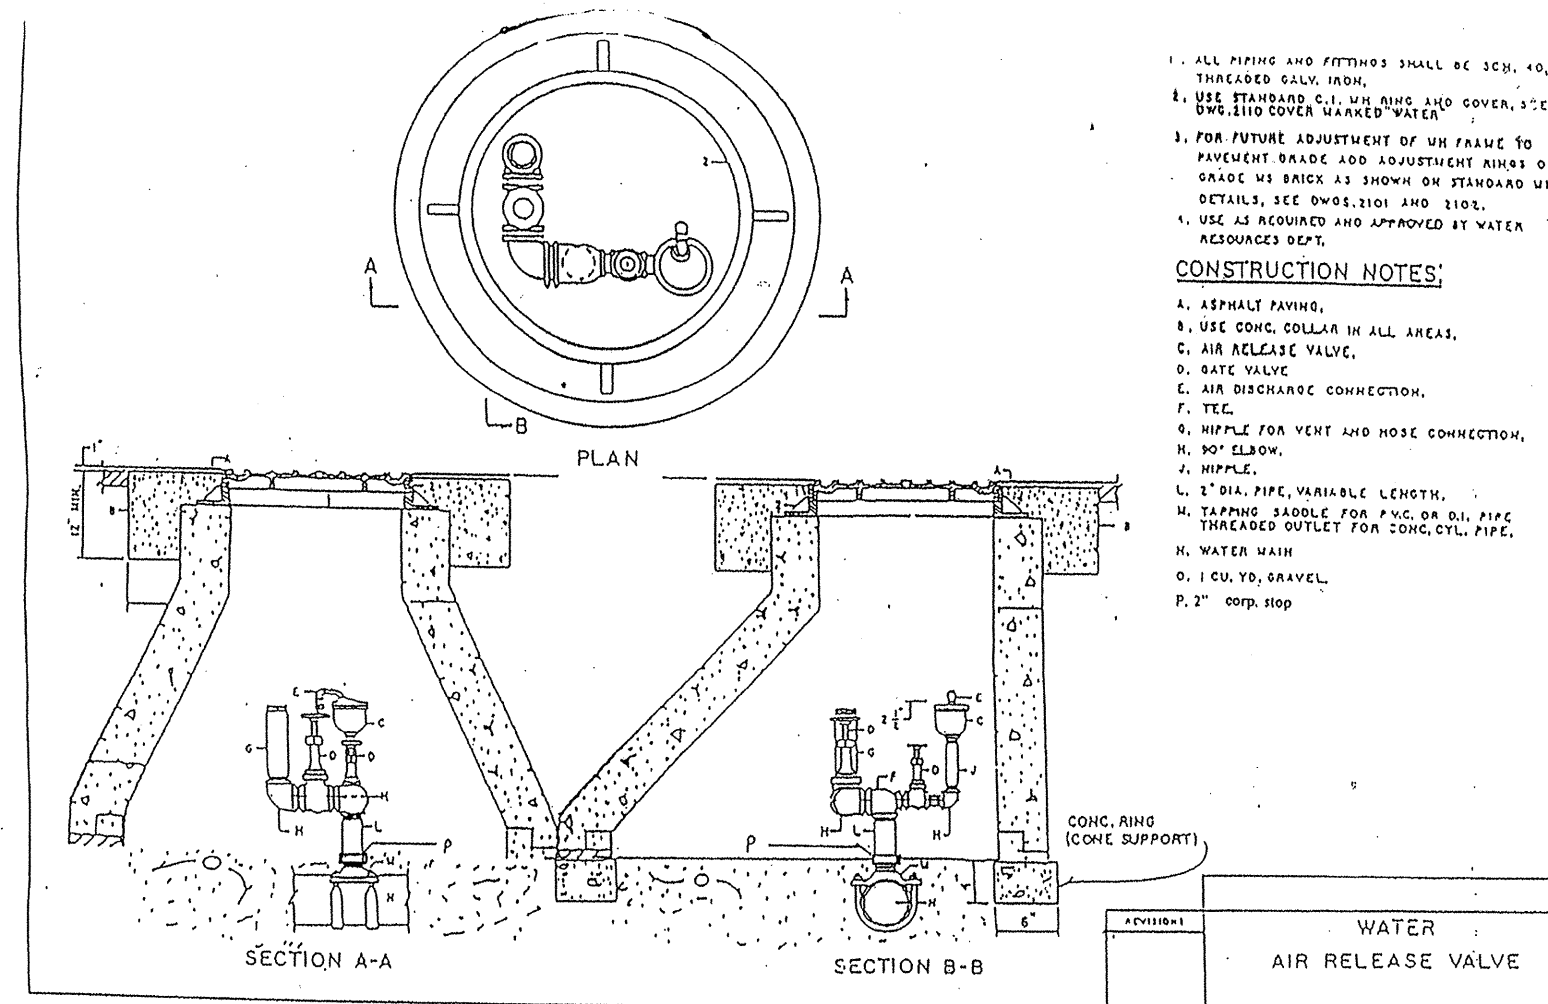


EXHIBIT "B"

NEW MEXICO UTILITIES INC. STANDARDS AND SPECIFICATIONS

THE CITY OF ALBUQUERQUE'S "STANDARD SPECIFICATIONS FOR PUBLIC WORKS CONSTRUCTION" TO BE FOLLOWED WITH THE EXCEPTIONS AND/OR ADDITIONS CONTAINED HEREIN.

ALL MATERIALS AND APPLICATIONS THEREOF SHALL BE SUBJECT TO APPROVAL BY NEW MEXICO UTILITIES, INC.

MATERIAL

- (1.1) MAINLINE PIPE MATERIAL SHALL BE P.V.C. UNLESS OTHERWISE SPECIFIED BY NMUI.
- (1.2) P.V.C. PIPE SHALL MEET THE SAME ASTM AND AWWA SPECIFICATIONS AS REQUIRED BY THE CITY OF ALBUQUERQUE.
- (1.3) PIPE SHALL BE 4" MINIMUM COVER OVER THE TOP OF THE PIPE, EXCEPT AS NOTED IN THE PLANS.
- (2.1) ALL WATER MAINS SHALL HAVE 4 FT. MINIMUM COVER OVER THE TOP OF THE PIPE, EXCEPT AS NOTED IN THE PLANS.
- (2.2) DEAD END LINES, I.E., CUL DE SAC, NOT EQUIPPED WITH A FIRE HYDRANT WILL REQUIRE A FLUSH LINE AS APPROVED BY THE ENGINEER AND NMUI.
- (2.3) FITTING RESTRAINT ON P.V.C. PIPE SHALL BE CONCRETE BLOCKING OR "MEGALUGS" (OR APPROVED EQUAL), EXCEPT VERTICAL BENDS WHICH SHALL REQUIRE BOTH BLOCKING AND "MEGALUGS", UNLESS OTHERWISE NOTED ON THE CONSTRUCTION PLANS.
- (2.4) ALL MECHANICAL RESTRAINED JOINTS SHALL CONFORM TO THE RECOMMENDATIONS OF THE PIPE MANUFACTURER OR THE ENGINEER.
- (2.5) A VISUAL INSPECTION OF ALL BLOCKING, "MEGALUGS", AND JOINT RESTRAINTS ARE REQUIRED.
- (2.6) NO FLANGED FITTINGS ALLOWED UNDERGROUND, UNLESS THEY ARE BEING USED FOR A PRESSURIZED TAP.
- (3.1) BUTTERFLY VALVES SHALL BE EQUIPPED WITH A 2-INCH OPERATING NUT.
- (3.2) THE DISTANCE FROM THE TOP OF THE OPERATING FEET AND 18 INCHES.
- (3.3) VALVES ARE REQUIRED ON ALL FIRE HYDRANT LEGS.
- (3.4) BRASS GATE VALVES SHALL BE EITHER OHIO BRASS OR MILWAUKEE, SERIES 100.
- (3.5) ALL VALVES WILL BE MECHANICALLY RESTRAINED AND BLOCKED.

VALVE CANS

- (4.1) VALVE CANS SHALL BE 5 1/4 INCHES CAST IRON SLIP TYPE VALVE CANS SUCH AS TYLER SERIES 6855, OR EQUAL.
- (4.2) VALVE CANS MUST HAVE A CONCRETE COLLAR POURED TO THE TOP OF THE FINAL ASPHALT GRADE.

FIRE HYDRANTS

- (5.1) WATERLOUS & U.S. PIPE HYDRANTS WILL NOT BE ACCEPTED.
- (5.2) AN ISOLATION VALVE IS REQUIRED ON ALL FIRE HYDRANT LEGS.
- (5.3) ALL VALVES MUST BE RESTRAINED TO THE TEE AT THE MAIN, BOTH LONG SIDE AND SHORT.
- (5.4) ALL VALVES ON FIRE HYDRANT LEGS REGARDLESS OF THE LOCATION MUST BE RESTRAINED.
- (5.5) NO SERVICE TAPS ARE ALLOWED ON FIRE HYDRANT LEGS PAST THE ISOLATION VALVE.
- (5.6) FIRE HYDRANTS ARE TO BE RESTRAINED WITH "MEGALUGS" (OR APPROVED EQUAL) AND CONCRETE BLOCKING.

TESTING

- (6.1) THE HYDROSTATIC TEST SHALL BE PERFORMED AT A TEST PRESSURE OF 200 P.S.I. FOR TWO HOURS.
- (6.2) INSPECTORS MUST HAVE A 48-HOUR ADVANCE NOTICE.

AIR RELEASE

- (7.1) AIR RELEASE VALVES SHALL BE CONTAINED WITHIN A MANHOLE. SEE "EXHIBIT E".
- (7.2) THE SIZE AND TYPE OF AIR RELEASE VALVE SHALL BE DETERMINED BY THE ENGINEER.
- (7.3) PIPE SIZING AND LENGTHS MAY VARY TO ACCOMMODATE ADEQUATE ACCESSIBILITY FOR SERVICING.

BACKFLOW PREVENTION

- (8.1) ALL FIRE LINES FOR SPRINKLER SYSTEMS WILL REQUIRE AN APPROVED DOUBLE CHECK ASSEMBLY THAT MEETS OR EXCEEDS AWWA C506.
- (8.2) ALL POSSIBLE HAZARDOUS SITUATIONS REQUIRING MANUFACTURING, LABORATORIES, ETC., WILL REQUIRE AN R.P.Z. (REDUCED PRESSURE ZONE) DEVICE THAT MEETS OR EXCEEDS AWWA C506.
- (8.3) ALL BACKFLOW PREVENTION DEVICES WILL REQUIRE RESILIENT SEAT ISOLATION VALVES BOTH UPSTREAM AND DOWNSTREAM OF THE DEVICES.
- (8.4) THE BACKFLOW PREVENTION DEVICE SHALL BE LOCATED IN AN ACCESSIBLE AREA WITH PROPER DRAINAGE FACILITIES FOR THE RELIEF LINE AS APPROVED BY THE ENGINEER AND NMUI.
- (8.5) BRASS GATE VALVES SHALL BE EITHER OHIO BRASS OR MILWAUKEE, SERIES 100.
- (8.6) WATER SERVICES 3/4" - 1" WILL REQUIRE DUAL CHECK VALVE ASSEMBLIES AS APPROVED BY NMUI.
- (8.7) WATER SERVICES 1 1/2" AND UP WILL REQUIRE DUAL CHECK VALVE ASSEMBLIES AS APPROVED BY NMUI.

FITTINGS

- (1.1) A TYPICAL SERVICE SET WITH FITTINGS FOR A 3/4 INCH THROUGH 1 INCH METER SET IS DETAILED IN "EXHIBIT A".
- (1.2) A TYPICAL SERVICE SET WITH FITTINGS FOR A 1 1/2" AND 2" METER SET IS DETAILED IN "EXHIBIT A1".
- (1.3) METER VALVES SHALL BE BRONZE YOKES BALL VALVES, 1" COPPER FLARE BY 3/4" METER FOR A 3/4" SERVICE, 1" C.F. BY 1" METER FOR A 1" SERVICE, 1 1/2" C.F. BY 1 1/2" METER FLANGE FOR A 1 1/2" SERVICE, 2" C.F. BY 2" METER FLANGE FOR A 2" SERVICE.
- (1.4) BRASS GATE VALVES SHALL BE EITHER OHIO BRASS OR MILWAUKEE, SERIES 100.
- (1.5) WATER SERVICES 3/4" - 1" WILL REQUIRE DUAL CHECK VALVE ASSEMBLIES AS APPROVED BY NMUI.
- (1.6) WATER SERVICES 1 1/2" AND UP WILL REQUIRE DUAL CHECK VALVE ASSEMBLIES AS APPROVED BY NMUI.
- (1.7) SERVICE FITTINGS INCLUDING THE CORPORATION STOP SHALL BE COPPER FLARE NUT. PACK JOINT FITTINGS ARE NOT ACCEPTABLE.

SERVICE LINES

- (2.1) SERVICE LINES FOR A 3/4 INCH SERVICE SHALL BE 1 INCH IN DIAMETER.
- (2.2) SERVICE LINES SHALL HAVE A MINIMUM OF 3 FEET OF COVER.
- (2.3) P.E. TUBING SHALL BE P.E. 3408 SDR 200 PSI C.T.S. AND MEET AWWA C901.
- (2.4) "NU-MEX" P.E. TUBING IS NOT ACCEPTABLE.
- (2.5) SERVICE LINES MUST BE FLARED AT BOTH ENDS.
- (2.6) NO SPICES ARE ALLOWED IN THE SERVICE LINE.

METER BOXES

- (3.1) 3/4 AND 1-INCH METER BOX AND LID ARE DETAILED IN "EXHIBIT B" (OR APPROVED EQUAL) FOR A SINGLE SERVICE AND FOR A DOUBLE SERVICE.
- (3.2) 1 1/2-INCH AND 2-INCH METER BOXES ARE DETAILED IN "EXHIBIT C".
- (3.4) FOR A TYPICAL 3/4-INCH METER BOX INSTALLATION THE BOX SHALL BE LOCATED 12 INCHES BACK OF CURB. SEE "EXHIBIT D".
- (3.5) WS SHOULD BE SCRIBED IN FRONT OF THE BOX.

IRRIGATION

- (4.1) ALL APPLICATIONS OTHER THAN SINGLE-FAMILY RESIDENTIAL HOUSING WILL REQUIRE A SEPARATE WATER SERVICE FOR IRRIGATION USE.

WASTE WATER

- (1.1) MAINLINE PIPE MATERIAL SHALL BE SDR 35 P.V.C. UNLESS OTHERWISE SPECIFIED BY NMUI.
- (1.2) P.V.C. PIPE SHALL MEET THE SAME A.S.T.M. SPECIFICATIONS AS REQUIRED BY THE CITY OF ALBUQUERQUE.
- (1.3) MANHOLES SHALL REQUIRE STEPS.
- (1.4) STEPS SHOULD BE PLACED ON THE UP STREAMSIDE OF THE MANHOLE.
- (1.5) MANHOLE COVERS SHALL BE IMPRINTED "SANITARY SEWER".
- (1.6) MANHOLE RING AND COVER MUST HAVE A CONCRETE COLLAR POURED TO THE TOP OF FINAL ASPHALT GRADE.

TESTING

- (2.1) NO AIR TESTING SHALL BE PERFORMED, UNTIL THE COMMON UTILITY DITCH IS EXCAVATED.
- (2.2) INSPECTORS MUST HAVE A 48-HOUR ADVANCE NOTICE.

SERVICES

- (1.1) A TYPICAL RESIDENTIAL SERVICE LATERAL SHALL BE 4-INCH DIAMETER SDR26 AND SHALL MEET THE REQUIREMENTS AND DESIGNATIONS OF ASTM D3034.
- (1.2) SERVICE LATERALS FOR COMMERCIAL APPLICATION SHALL BE 6-INCH DIAMETER S.D.R.35 P.V.C. AND MEET THE SAME REQUIREMENTS FOR MAINLINE MATERIAL.
- (2.1) SERVICE CONNECTIONS TO THE MAINLINE MAY BE MADE WITH EITHER SADDLE TEES OR IN-LINE TEES OR WYES.
- (2.2) SADDLE TEES SHALL REQUIRE PROTRUSIONS TO INSURE PROPER ALIGNMENT AND PREVENT ROTATION.
- (2.3) FITTINGS SHALL REQUIRE NMUI APPROVAL AND BE COMPATIBLE WITH THE MAINLINE AND SERVICE LINE.
- (2.4) NO CAN-TEX ADAPTERS ALLOWED. COUPLINGS MUST BE SOLID SLIP TYPE.

INSTALLATION

- (3.1) THE DEPTH OF THE SERVICE LATERAL AT ITS TERMINUS SHALL NOT BE GREATER THAN 10 FEET. WHERE REQUIRED, RISERS SHALL BE USED.

GREASE TRAPS

- (4.1) ON ALL FOOD SERVICE OPERATIONS, A GREASE TRAP WILL BE REQUIRED BEFORE CONNECTION TO NMUI'S SEWER FACILITIES. THE TRAP WILL REQUIRE THE INSPECTION AND APPROVAL OF NMUI.

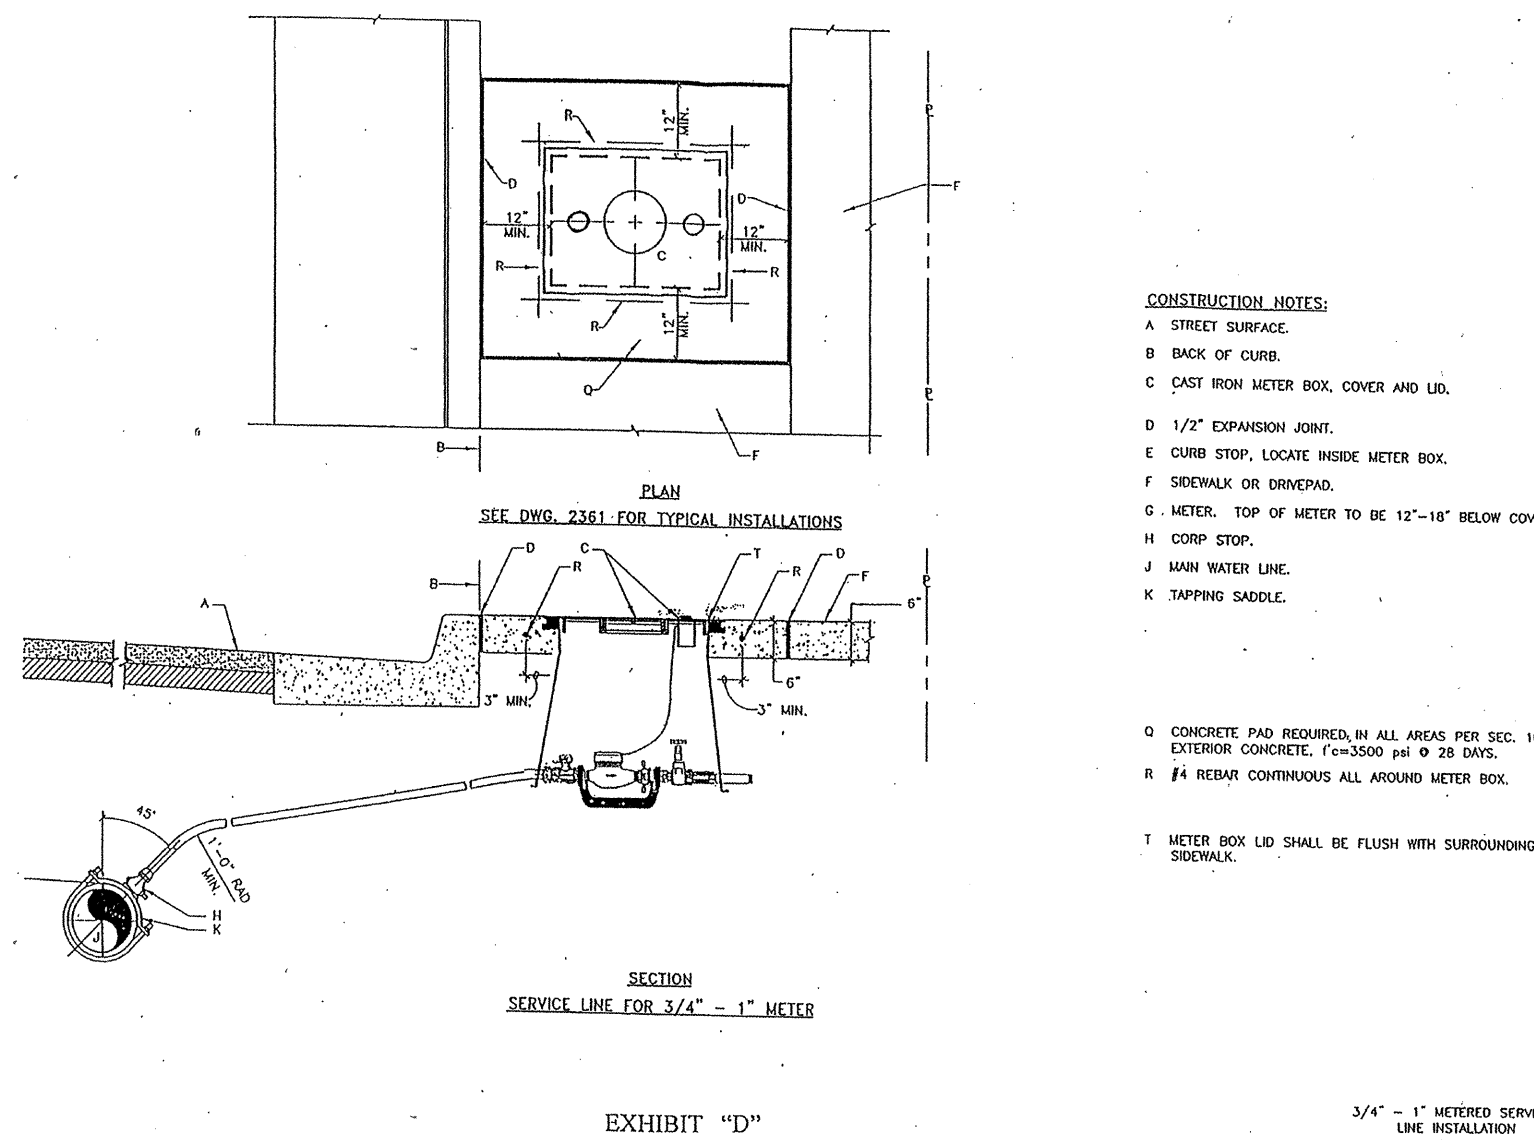


EXHIBIT "D"

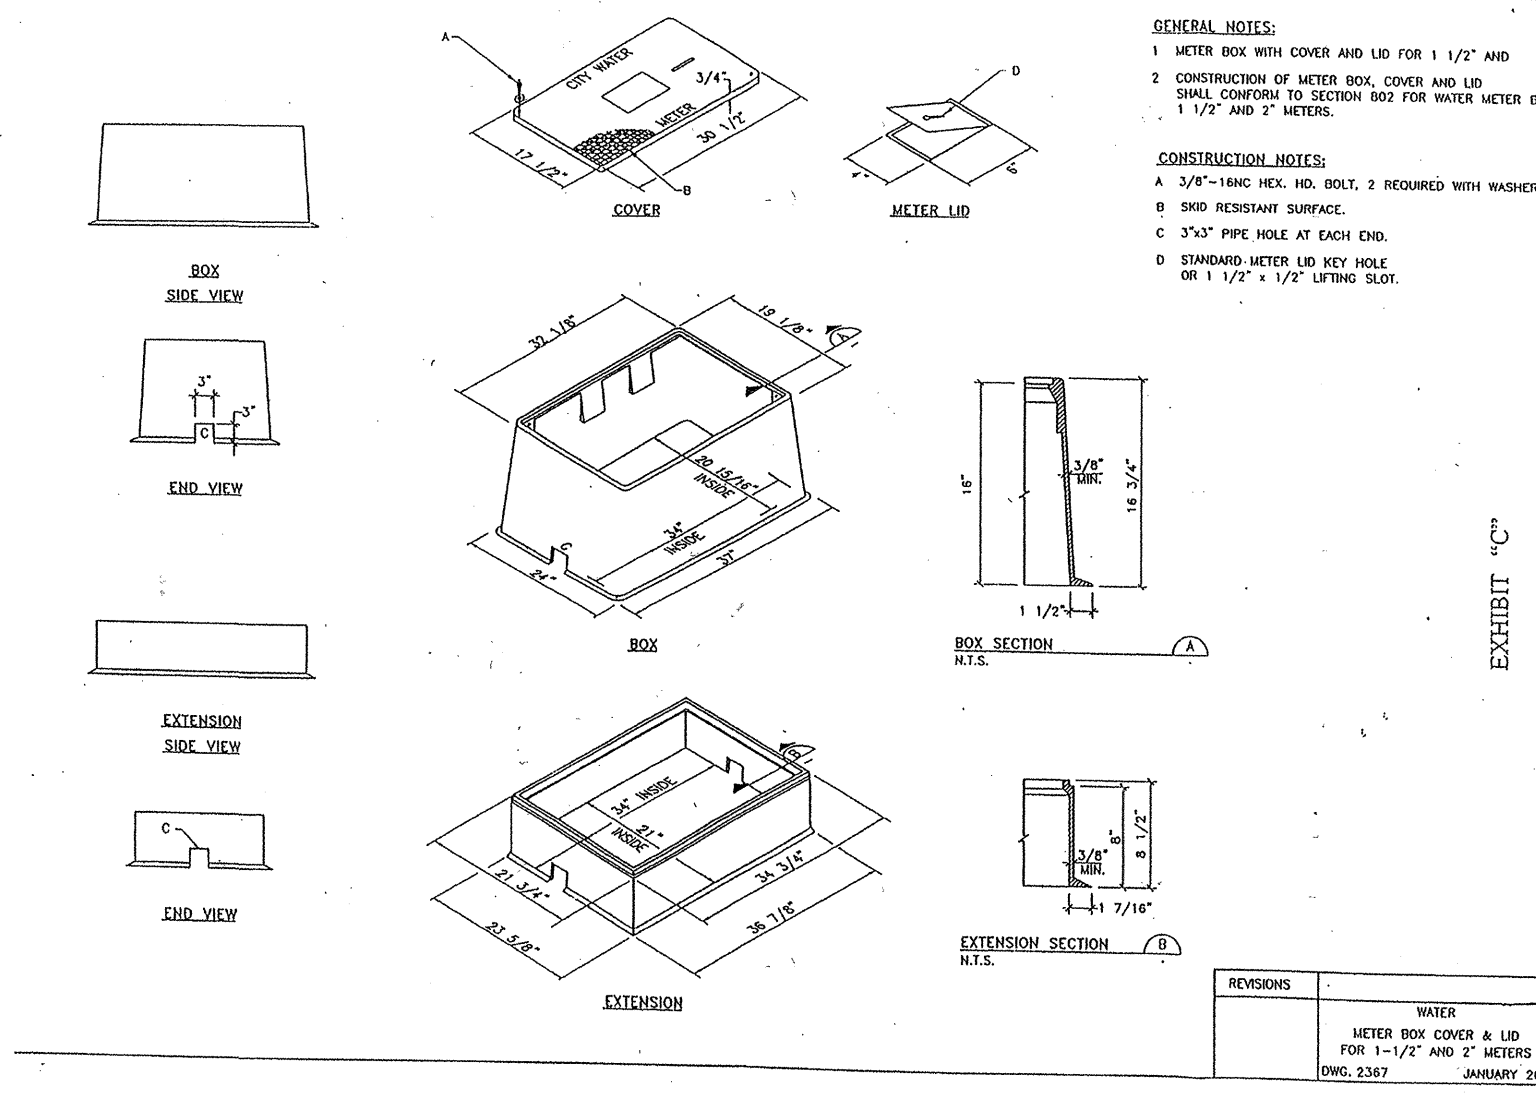


EXHIBIT "C"

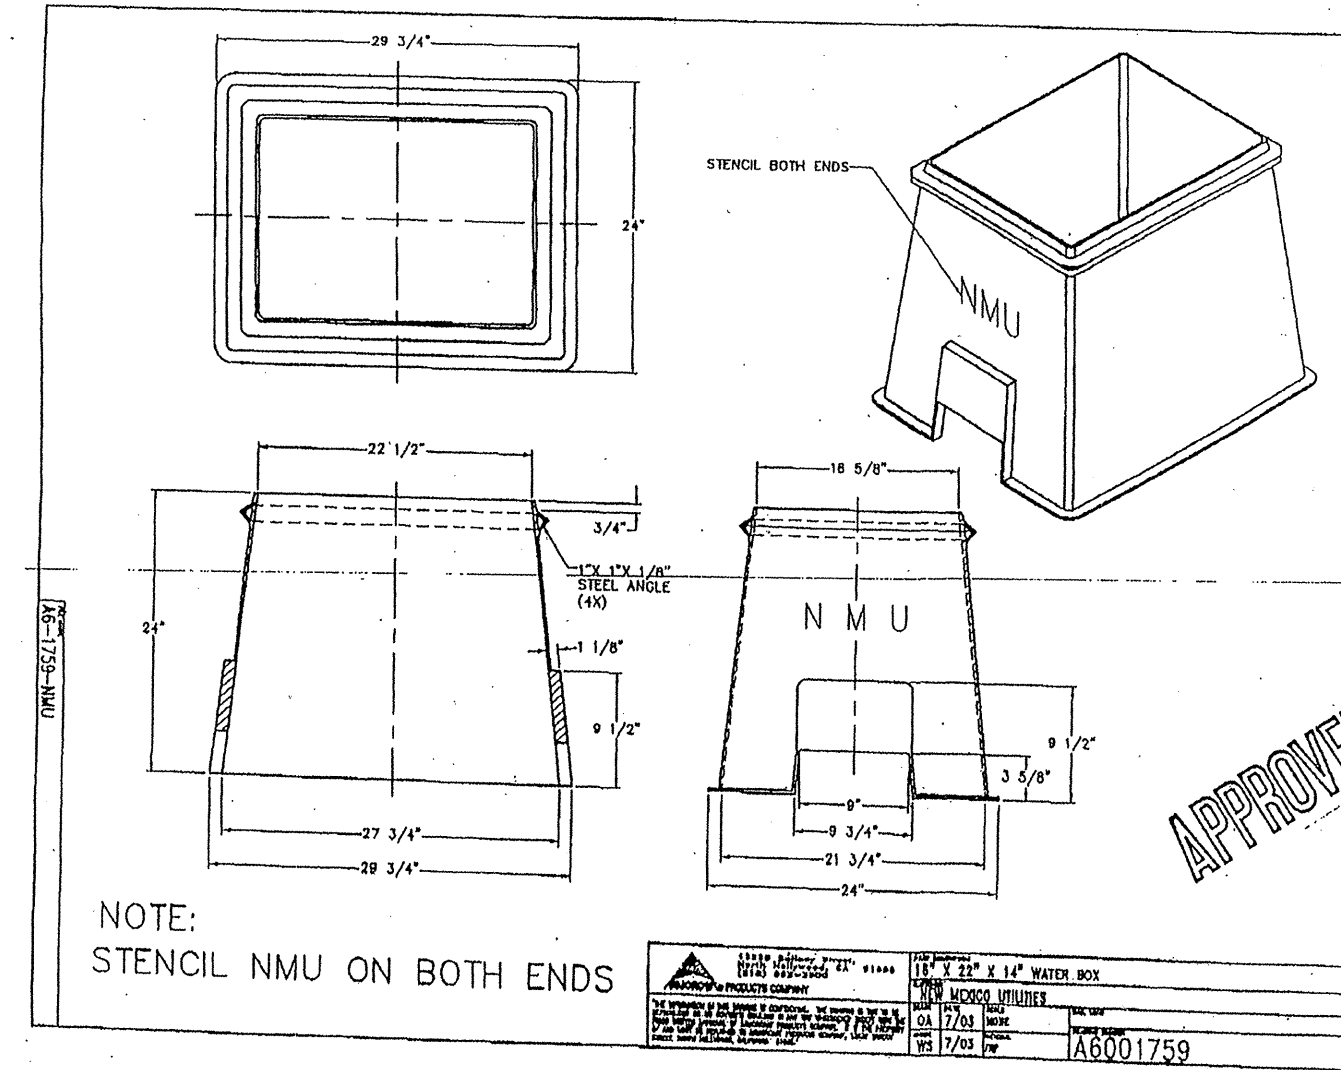


EXHIBIT "B"


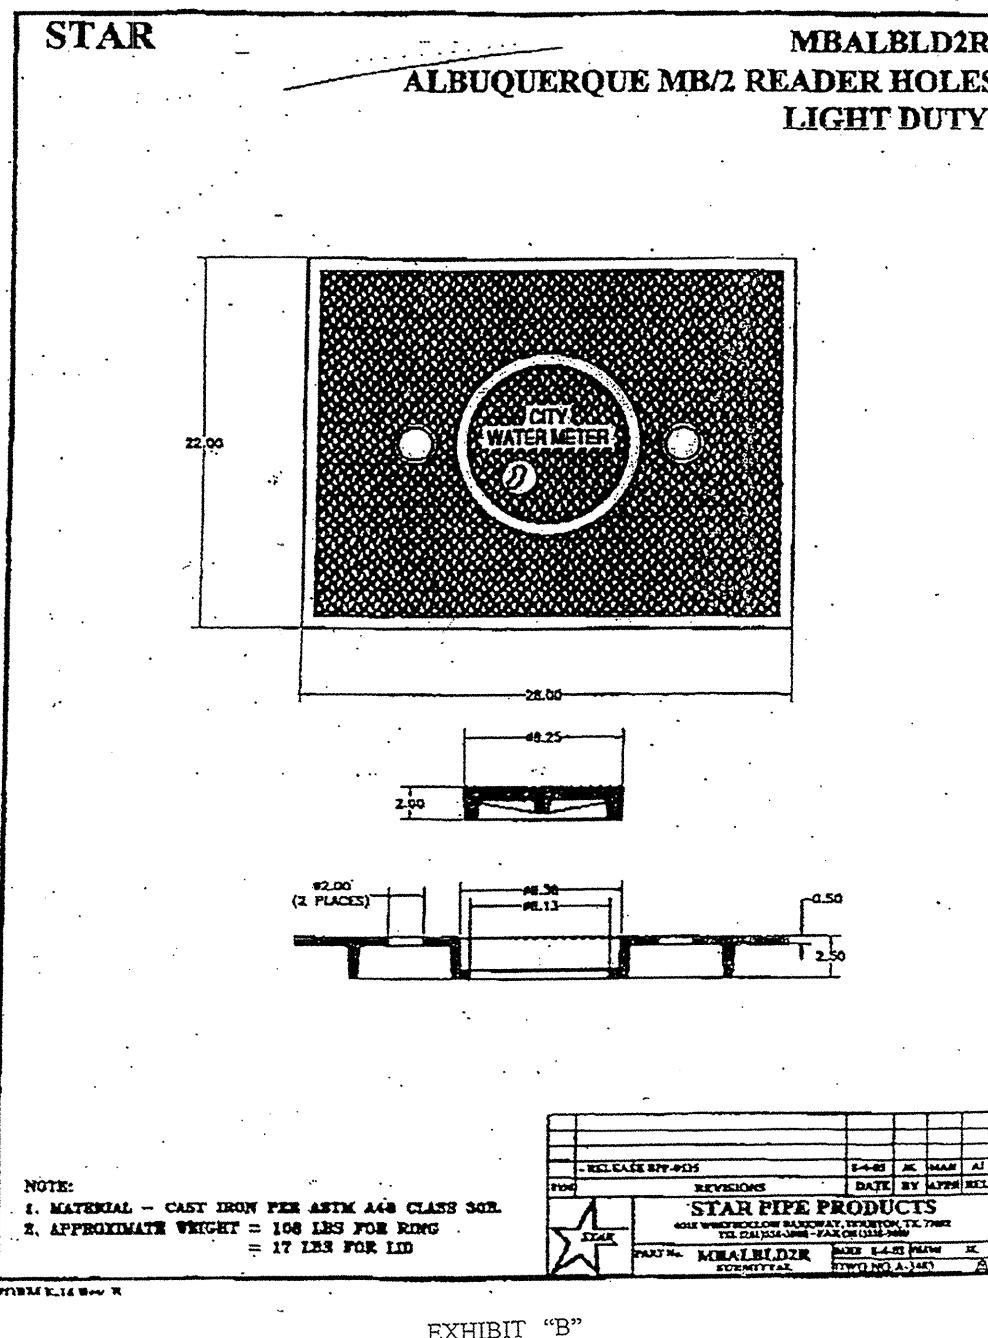


EXHIBIT "B"

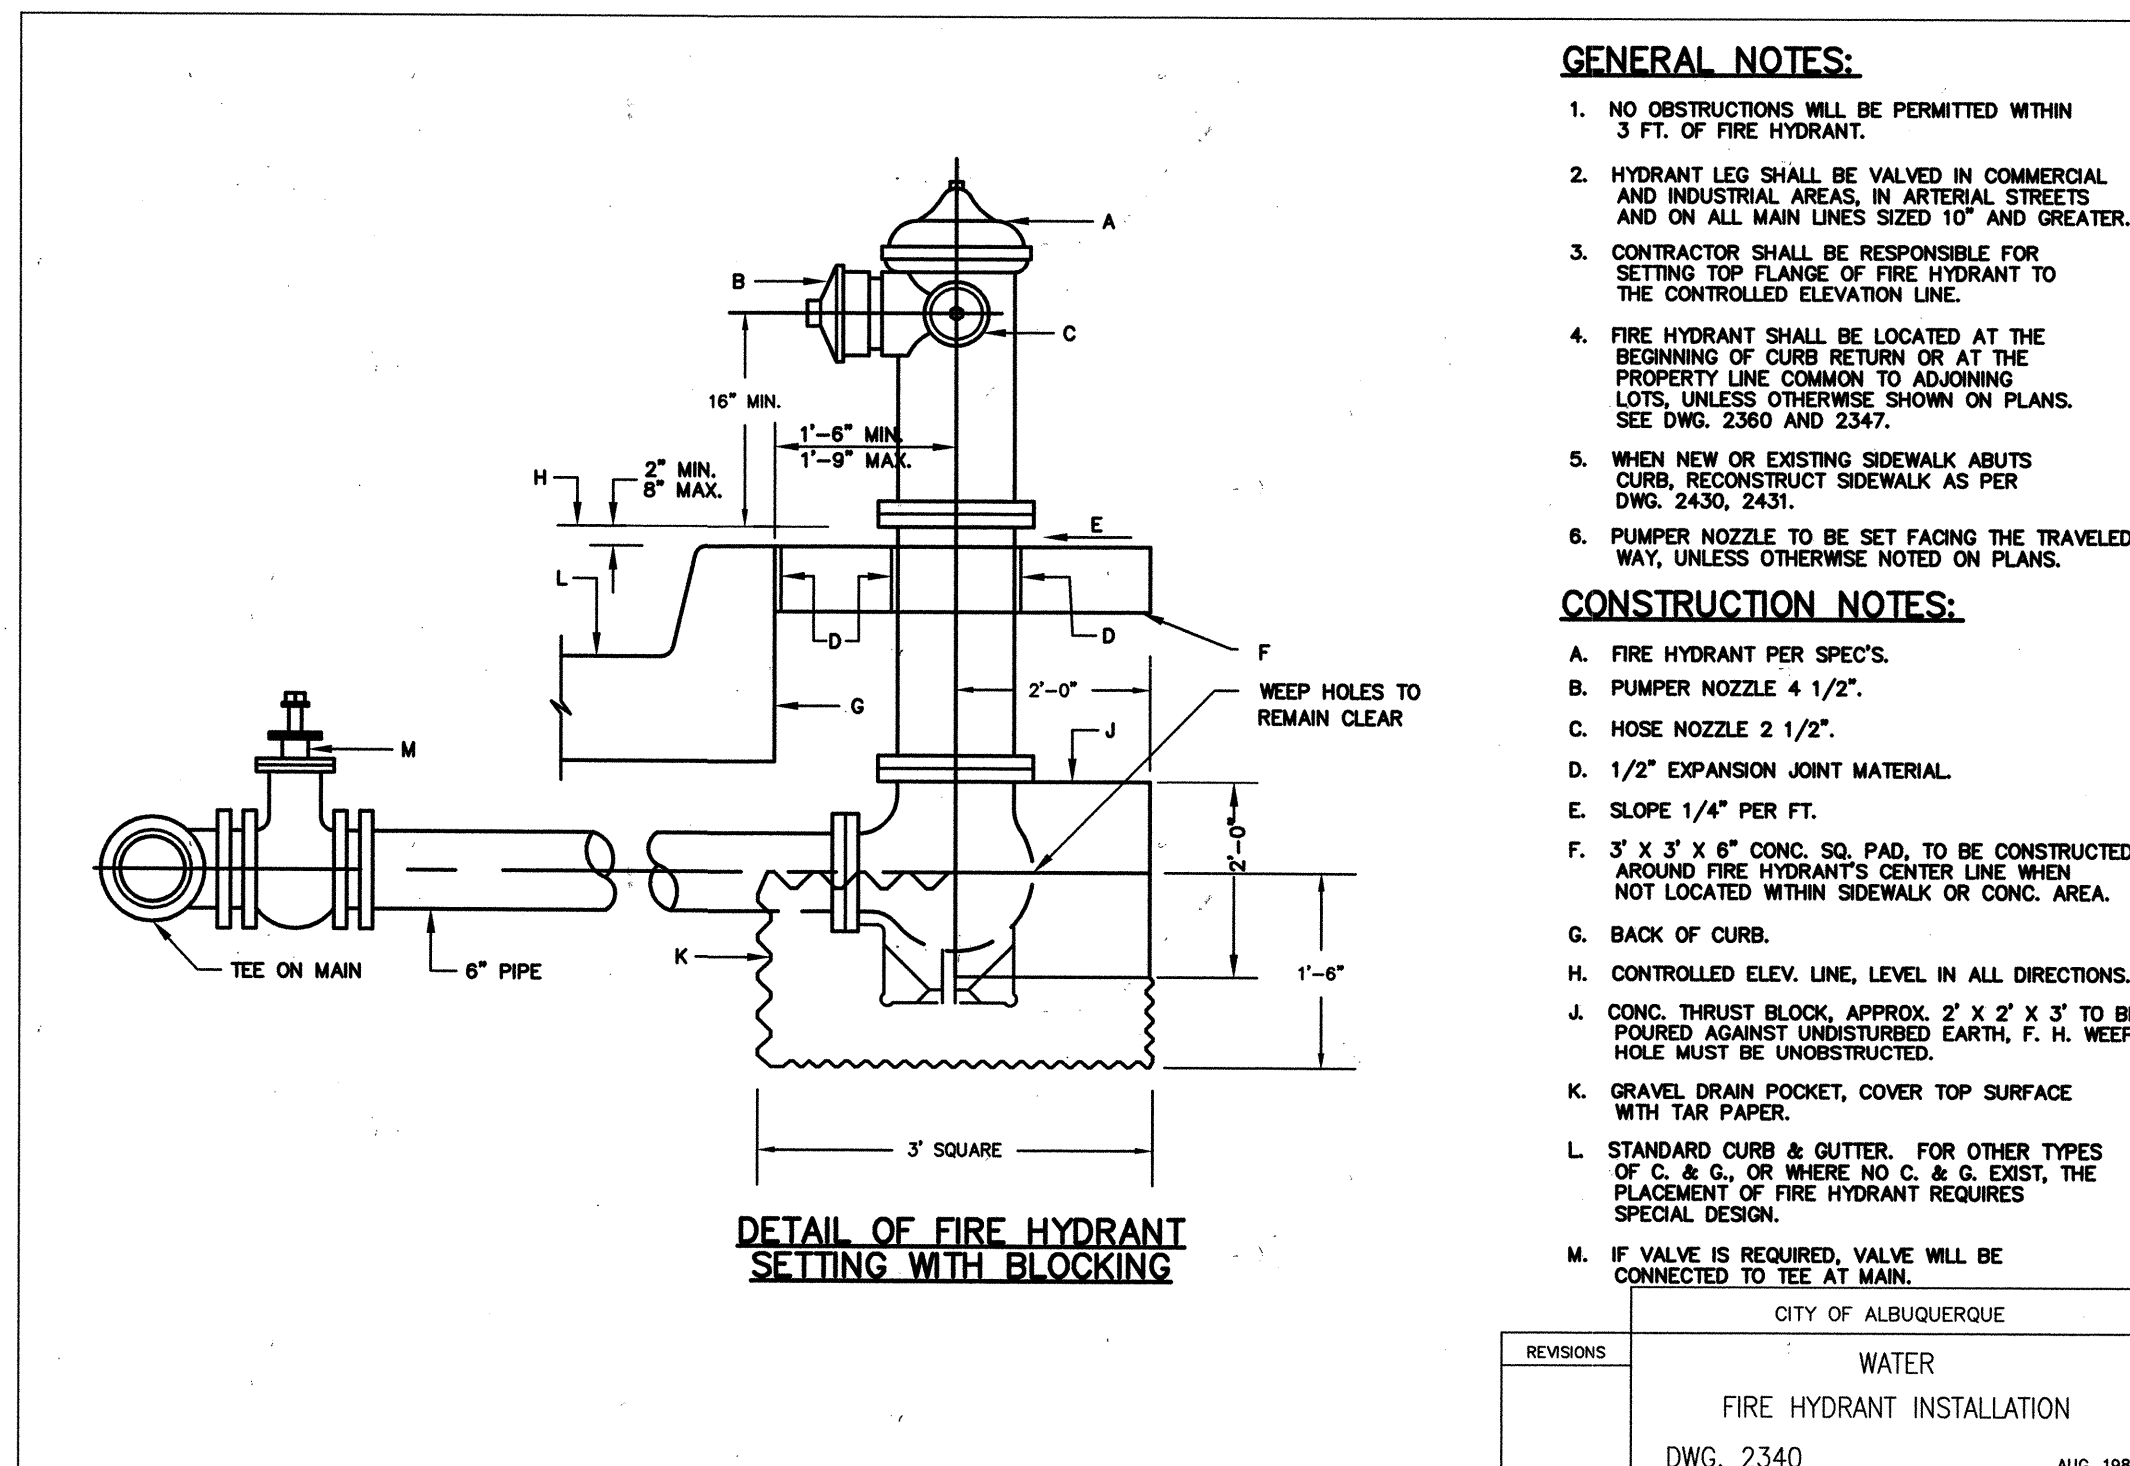


GENERAL NOTES:

1. NO OBSTRUCTIONS WILL BE PERMITTED WITHIN 3 FT. OF FIRE HYDRANT.
2. HYDRANT LEG SHALL BE VALVED IN COMMERCIAL AND INDUSTRIAL AREAS, IN ARTERIAL STREETS AND ON ALL MAIN LINES SIZED 10" AND GREATER.
3. CONTRACTOR SHALL BE RESPONSIBLE FOR SETTING TOP FLANGE OF FIRE HYDRANT TO THE CONTROLLED ELEVATION LINE.
4. FIRE HYDRANT SHALL BE LOCATED AT THE BEGINNING OF CURB RETURN OR AT THE PROPERTY LINE COMMON TO ADJOINING LOTS, UNLESS OTHERWISE SHOWN ON PLANS. SEE DWG. 2360 AND 2347.
5. WHEN NEW OR EXISTING SIDEWALK ABUTS CURB, RECONSTRUCT SIDEWALK AS PER DWG. 2430, 2431.
6. PUMPER NOZZLE TO BE SET FACING THE TRAVELED WAY, UNLESS OTHERWISE NOTED ON PLANS.

CONSTRUCTION NOTES:

- A. FIRE HYDRANT PER SPECS.
- B. PUMPER NOZZLE 4 1/2".
- C. HOSE NOZZLE 2 1/2".
- D. 1/2" EXPANSION JOINT MATERIAL.
- E. SLOPE 1/4" PER FT.
- F. 3' X 3' X 6" CONC. SO. PAD. TO BE CONSTRUCTED AROUND FIRE HYDRANT'S CENTER LINE WHEN NOT LOCATED WITHIN SIDEWALK OR CONC. AREA.
- G. BACK OF CURB.
- H. CONTROLLED ELEV. LINE, LEVEL IN ALL DIRECTIONS.
- J. CONC. THRUST BLOCK, APPROX. 2' X 2' X 3' TO BE POURED AGAINST UNDISTURBED EARTH. F. H. WEEP HOLE MUST BE UNOBTSTRUCTED.
- K. GRAVEL DRAIN POCKET, COVER TOP SURFACE WITH TAR PAPER.
- L. STANDARD CURB & GUTTER. FOR OTHER TYPES OF C. & G. OR WHERE NO C. & G. EXIST, THE PLACEMENT OF FIRE HYDRANT REQUIRES SPECIAL DESIGN.
- M. IF VALVE IS REQUIRED, VALVE WILL BE CONNECTED TO TEE AT MAIN.

REVISIONS	CITY OF ALBUQUERQUE
1	WATER
2	FIRE HYDRANT INSTALLATION
DWG. 2340	AUG. 1996

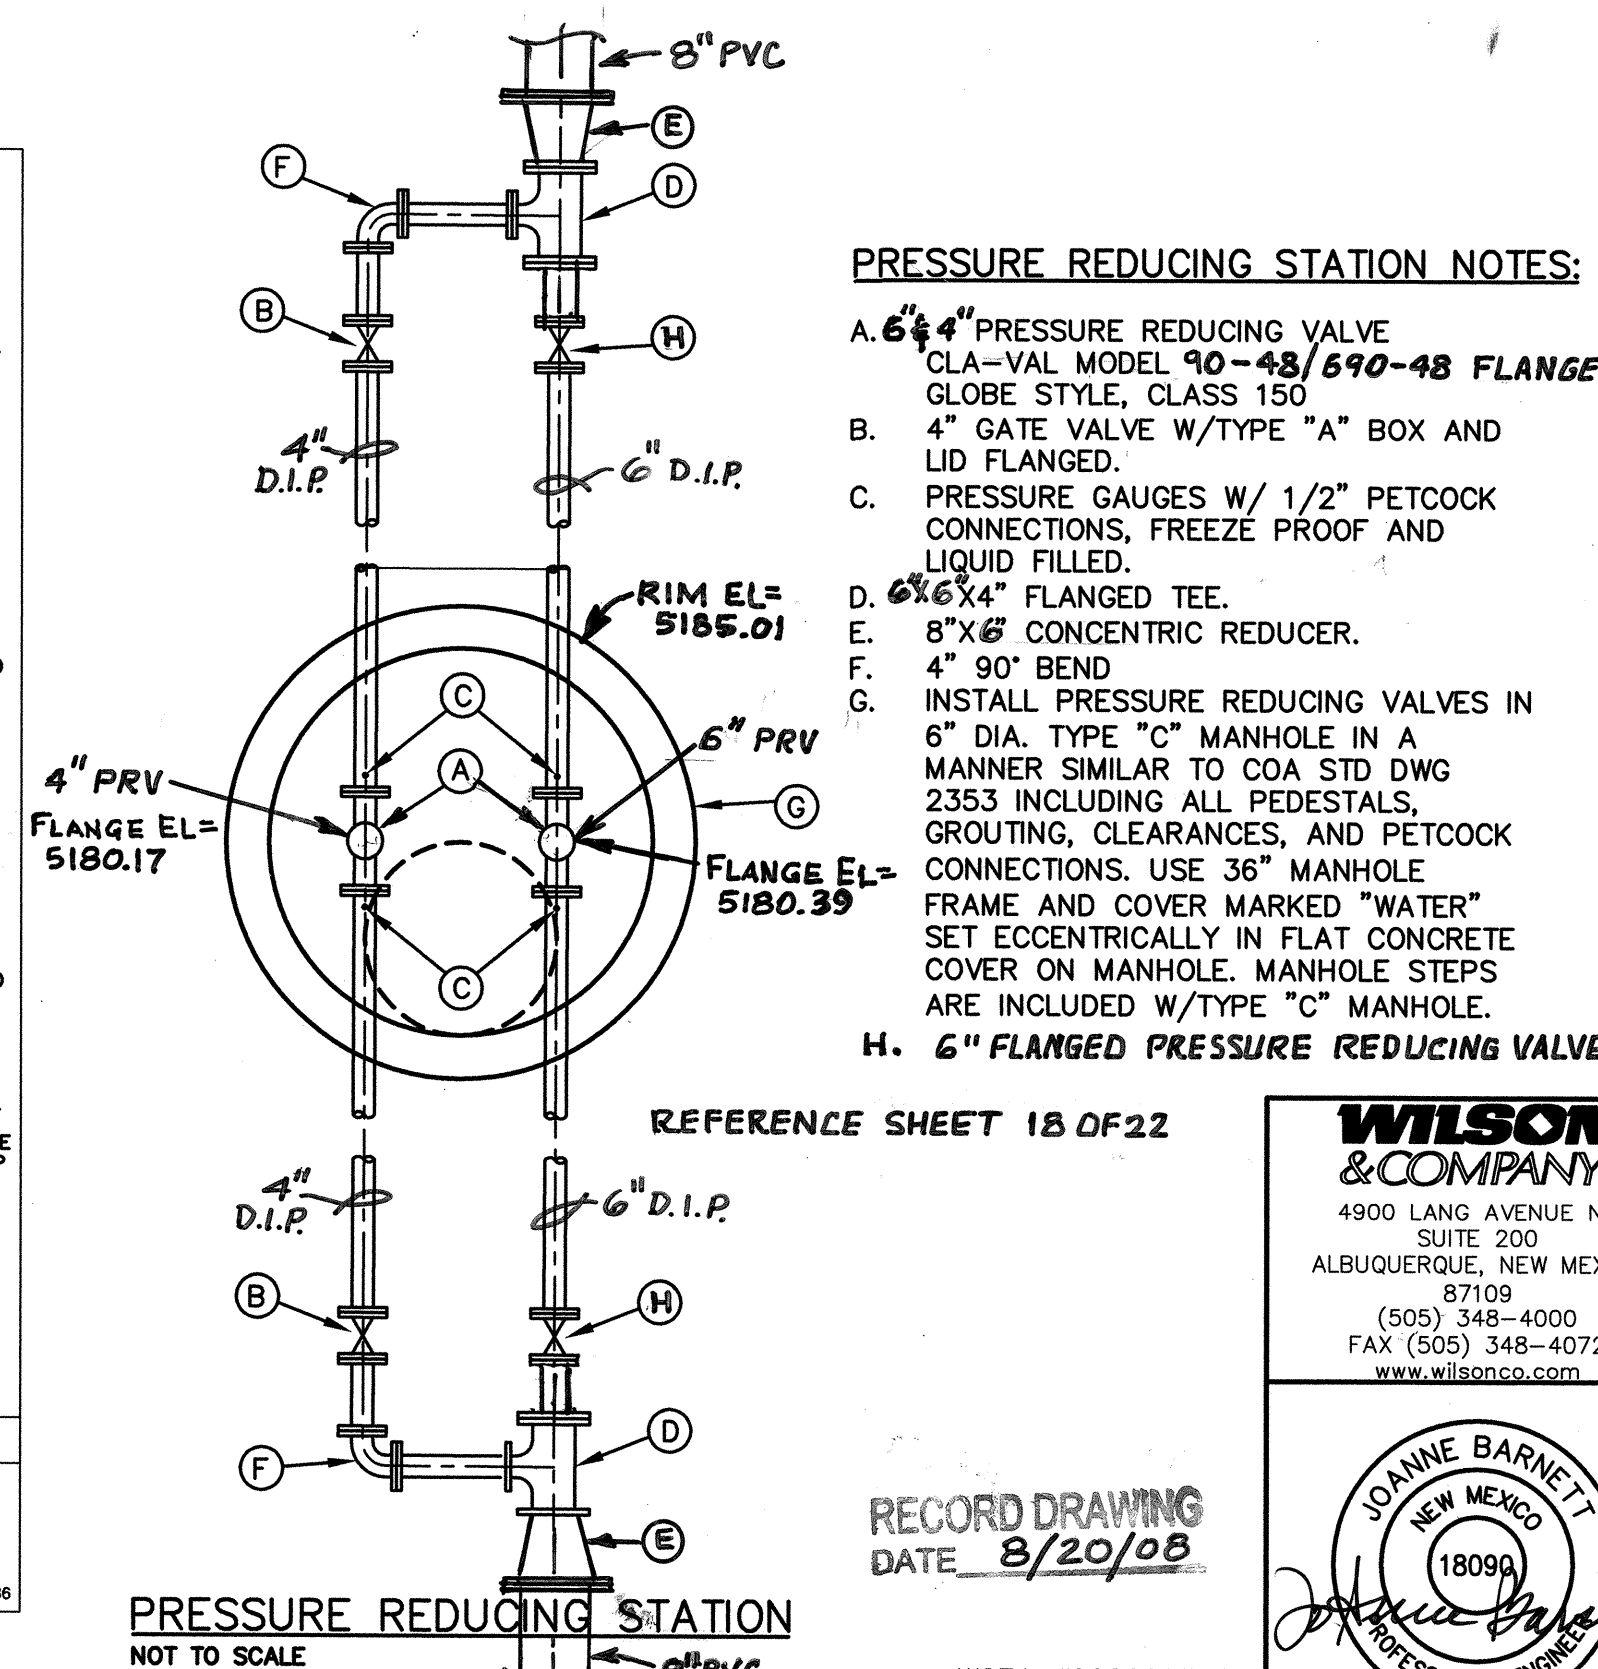

PRESSURE REDUCING STATION NOTES:

- A. 4" PRESSURE REDUCING VALVE, CLASS 150, GLOBE STYLE, CLASS 150.
- B. 4" GATE VALVE W/TYPE "A" BOX AND LID FLANGED.
- C. PRESSURE GAUGES W/ 1/2" PETCOCK CONNECTIONS, FREEZE PROOF AND LIQUID FILLED.
- D. 6"X4" FLANGED TEE.
- E. 8"X6" CONCENTRIC REDUCER.
- F. 4" 90° BEND.
- G. INSTALL PRESSURE REDUCING VALVES IN A MANNER SIMILAR TO COA STD DWG 2353 INCLUDING ALL PEDESTALS, GROUTING, CLEARANCES, AND PETCOCK CONNECTIONS. USE 36" MANHOLE FRAME AND COVER MARKED "WATER" SET ECCENTRICALLY IN FLAT CONCRETE COVER ON MANHOLE. MANHOLE STEPS ARE INCLUDED W/TYPE "C" MANHOLE.
- H. 6" FLANGED PRESSURE REDUCING VALVE.

REFERENCE SHEET 18 OF 22


RECORD DRAWING
DATE 8/20/08

WCEA #0660003900
FEBRUARY 2007

WILSON & COMPANY
4900 LANG AVENUE NE
SUITE 200
ALBUQUERQUE, NEW MEXICO 87109
(505) 348-4000
FAX (505) 348-4072
www.wilsonco.com

JOANNE BARNETT
NEW MEXICO
18099
PROFESSIONAL ENGINEER
10-15-07

CITY OF ALBUQUERQUE PUBLIC WORKS DEPARTMENT ENGINEERING GROUP	
VJW INC. STORAGE MISCELLANEOUS DETAILS	
Design Review Committee	City Engineer Approval
APPROVED DESIGN REVIEW COMMITTEE	APPROVED DESIGN REVIEW COMMITTEE
City Project No. 7718,83	Zone Map No. A-12
Sheet 21	Of 22

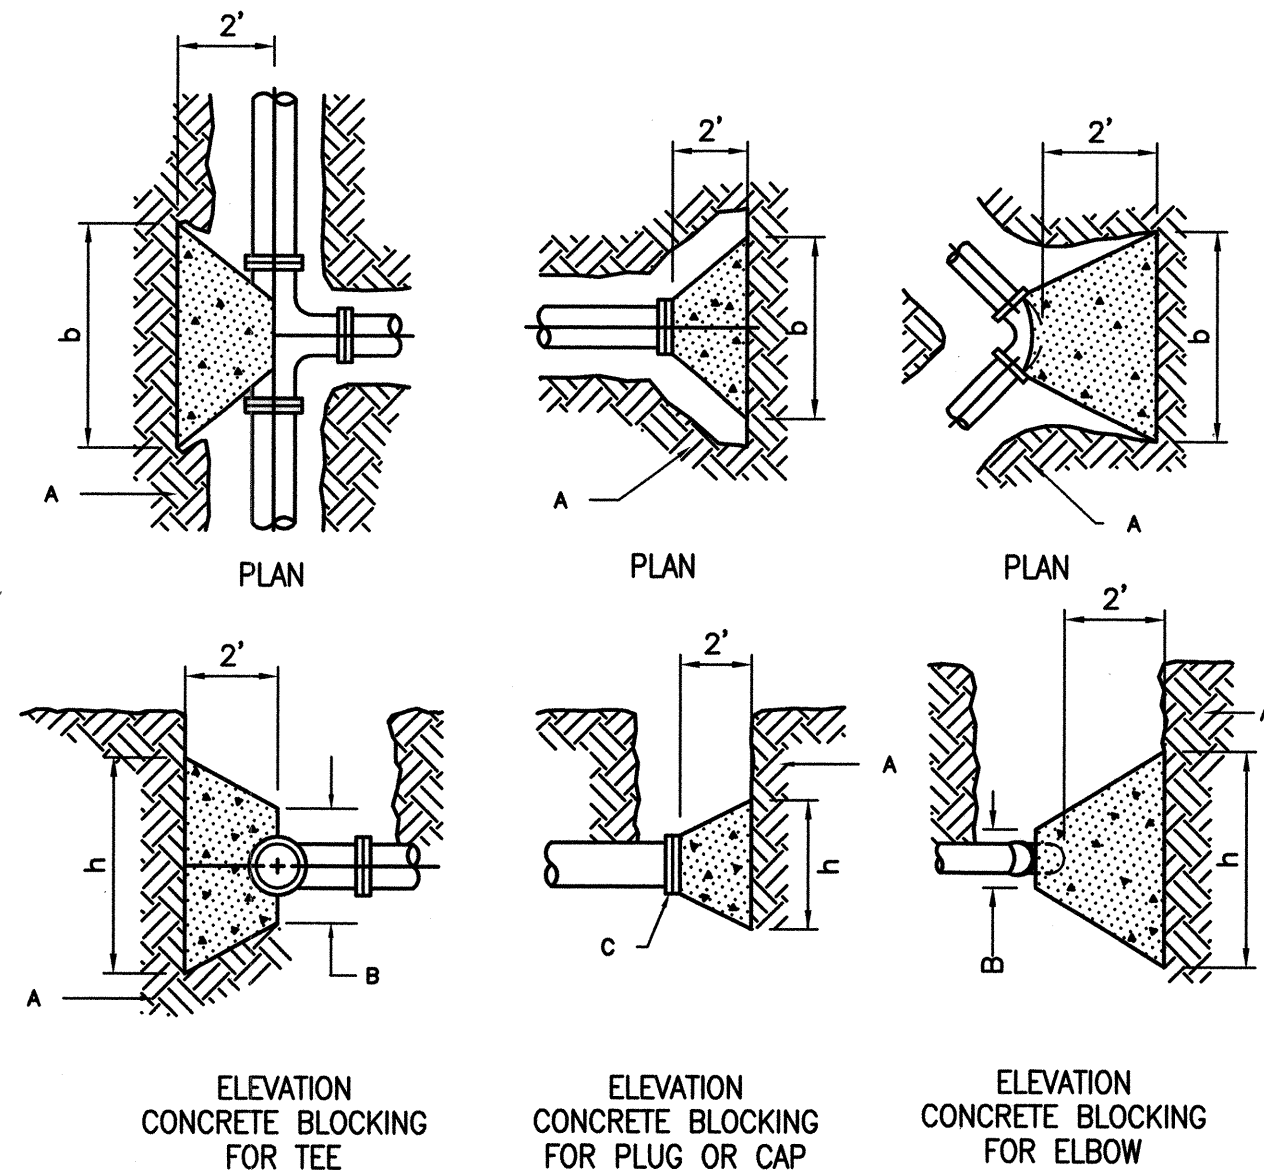

GENERAL NOTES:

1. THE ENGINEER SHALL PROVIDE DESIGN FOR ALL JOINTS GREATER THAN 14".

PIPE SIZE	ELBOW ANGLE	ELBOW (b) DIM.	TEE OR PLUG (b) DIM.	TEE OR PLUG (b) DIM.
4"	90°	2"	2"	2"
4"	22 1/2°	1 1/4"	2"	2"
6"	90°	2"	2"	2"
6"	22 1/2°	1 1/4"	2"	2"
8"	90°	3"	3"	3"
8"	22 1/2°	1 1/4"	2"	2"
10"	90°	3"-6"	3"-6"	3"-6"
10"	22 1/2°	1 1/4"	2"	2"
12"	90°	4"	4"	4"
12"	22 1/2°	1 1/4"	2"	2"
14"	90°	5"	5"	5"
14"	22 1/2°	1 1/4"	3"	3"

CONSTRUCTION NOTES:

- A. UNDISTURBED EARTH.
- B. O.D. OF PIPE + 8".
- C. O.D. OF CAP OR PLUG, MIN. 12" X 12".

THRUST BLOCKING DETAIL

SCALE: 1" = 1'

PRESSURE PIPE RESTRAINED JOINT LENGTH REQUIREMENTS

TEST PRESSURE @ 150 PSI

LENGTHS OF PIPE TO BE RESTRAINED (APPLIES TO UNWRAPPED DUCTILE IRON AND PVC, ONLY)									
FITTING TYPE					VERTICAL DOWNHILL				
PIPE SIZE	90° BEND	45° BEND	22 1/2° BEND	TEE (b)	TEE HYDRANT TEE (c)	HEAD END OR VALVE (d)	45° BEND	22 1/2° BEND	11 1/4° BEND
4" (1)	18"	7"	4"	1'	NOT APPLICABLE	30"	18"	7"	4"
6" (1)	28"	12"	6"	1'	NOT APPLICABLE	30"	28"	12"	6"
8" (1)	32"	13"	6"	1'	NOT APPLICABLE	30"	32"	13"	6"
10" (1)	38"	16"	8"	1'	NOT APPLICABLE	30"	38"	16"	8"
12" (1)	45"	18"	8"	1'	NOT APPLICABLE	30"	45"	18"	8"
14" (2)	39"	16"	8"	1'	NOT APPLICABLE	30"	39"	16"	8"
16" (2)	44"	18"	8"	1'	NOT APPLICABLE	30"	44"	18"	8"
18" (2)	48"	20"	10"	1'	NOT APPLICABLE	30"	48"	20"	10"
20" (2)	53"	22"	11"	1'	NOT APPLICABLE	30"	53"	22"	11"
24" (2)	62"	28"	12"	1'	NOT APPLICABLE	30"	62"	28"	12"

- (1) ASSUMES MINIMUM DEPTH OF BURY = 3 FT.
- (2) ASSUMES MINIMUM DEPTH OF BURY = 4 FT.
- (3) ASSUMES MINIMUM FULL PIPE JOINT LENGTH ON EITHER SIDE OF TEE RUN (L) IS 20 FT.
- (4) ASSUMES MINIMUM FULL PIPE JOINT LENGTH ON EITHER SIDE OF TEE RUN (L) IS 20 FT.
- (5) ASSUMES MINIMUM FULL PIPE JOINT LENGTH ON EITHER SIDE OF TEE RUN (L) IS 20 FT.
- (6) ASSUMES TEE RUN PIPE DIAMETER IS EQUAL TO PIPE SIZE AND BRANCH PIPE DIAMETER IS 8 INCHES.
- (7) RESTRAINED LENGTH FOR VALVES SHALL BE PROVIDED ON BOTH SIDES OF VALVE.
- (8) WHERE POSSIBLE, CONTRACTOR SHALL INSTALL FULL 20-FT JOINT OF PIPE ON EITHER SIDE OF ALL MECHANICAL JOINT VALVES, FITTINGS, AND APPURTENANCES. FOR ALL CIRCUMSTANCES WHERE A 20-FT JOINT CAN BE UTILIZED AND THE CONTRACTOR ELECTS TO USE A SHORTER PIPE JOINT, CONTRACTOR SHALL PROVIDE, AT CONTRACTOR'S SOLE EXPENSE, ALL NECESSARY JOINT RESTRAINTS REQUIRED BY TABLE ABOVE.

THRUST RESTRAINT NOTE:

ALL BURIED VALVES, FITTINGS, AND APPURTENANCES SHALL BE MECHANICAL JOINT-TYPE UTILIZING "MEGA-LUG"® STYLE MECHANICAL JOINT RESTRAINTS IN CONJUNCTION WITH "MEGA-LUG"® PIPE BELL-HARNESS RESTRAINTS WHEN ADEQUATE RESTRAINED LENGTH CAN BE OBTAINED. IN THE EVENT ADEQUATE RESTRAINED LENGTH CANNOT BE OBTAINED, CONTRACTOR SHALL IMMEDIATELY CONTACT ENGINEER FOR DETERMINATION OF APPROPRIATE ACTION TO BE TAKEN. THE EBAA IRON "RESTRAINED LENGTH CALCULATION" PROGRAM (VERSION 4.0) HAS BEEN USED TO DETERMINE MINIMUM RESTRAINED LENGTHS SHOWN IN TABLE ABOVE. THE FOLLOWING GENERAL ASSUMPTIONS APPLY TO ALL CALCULATIONS:

TRENCH TYPE: 3
SOIL TYPE: SM (SILTY SANDS, SAND SILT MIXTURE)
SAFETY FACTOR: 1.5 TO 1

TYPICAL BURY DEPTHS:

4" THROUGH 12" DIAMETER PIPE: 3 FT

14" THROUGH 24" DIAMETER PIPE: 4 FT

TYPICAL BURY DEPTHS FOR VERTICAL OFFSETS:


4" THROUGH 12" DIAMETER PIPE: 3 FT TO TOP OF UPPER BRANCH

8 FT TO TOP OF LOWER BRANCH

14" THROUGH 24" DIAMETER PIPE: 4 FT TO TOP OF UPPER BRANCH

7 FT TO TOP OF LOWER BRANCH

CONTRACTOR MAY SUBMIT SUBSTITUTE REDUCED RESTRAINED JOINT LENGTHS IF SOIL AND DEPTH OF BURY CONDITIONS WARRANT. CONTRACTOR SHALL PROVIDE SOIL TEST RESULTS AND APPROPRIATE CALCULATIONS TO SUPPORT THE LENGTH REDUCTION. SOIL TESTING AND CALCULATIONS SHALL BE PERFORMED AT CONTRACTOR'S SOLE EXPENSE.

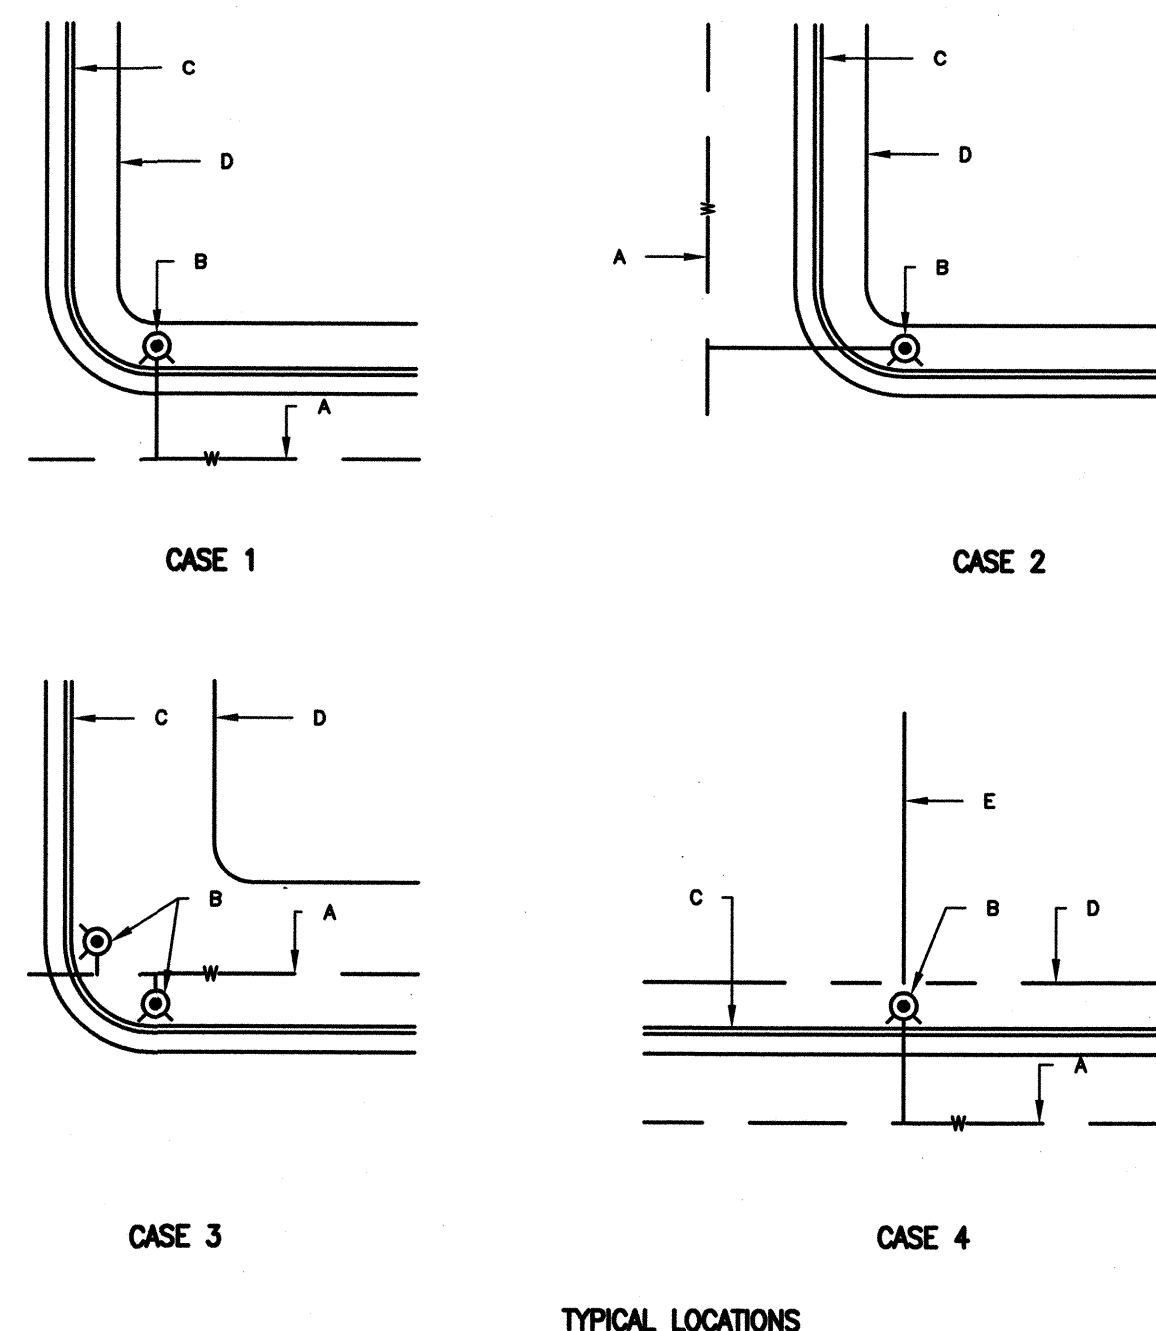


GENERAL NOTES:

1. NORMALLY FIRE HYDRANTS ARE LOCATED AT END OF CURB RETURN. HYDRANTS WILL NOT BE LOCATED WITHIN THE CURB RETURN AREA. FIRE HYDRANTS TO BE LOCATED WITHIN THE BLOCK LENGTH WILL BE INSTALLED AT A PROPERTY LINE (CASE 4).
2. A MINIMUM CLEARANCE OF 5' WILL BE PROVIDED BETWEEN A FIRE HYDRANT AND A PERMANENT OBSTRUCTION (UTILITY POLE, LIGHT STANDARD, TRAFFIC SIGNAL, ETC.).
3. FOR INSTALLATION OF FIRE HYDRANT SEE DWG. 2340.
4. SEE DWG. 2431 FOR SIDEWALK CONFIGURATION WHEN FIRE HYDRANT IS LOCATED IN SIDEWALK.

CONSTRUCTION NOTES:

- A. WATER MAIN.
- B. FIRE HYDRANT.
- C. CURB AND GUTTER.
- D. RIGHT-OF-WAY LINE.
- E. PROPERTY LINE.

REVISIONS	CITY OF ALBUQUERQUE
	WATER
	DETAILS ON TYPICAL
	FIRE HYDRANT LOCATIONS
	DWG. 2347
	AUG. 1986

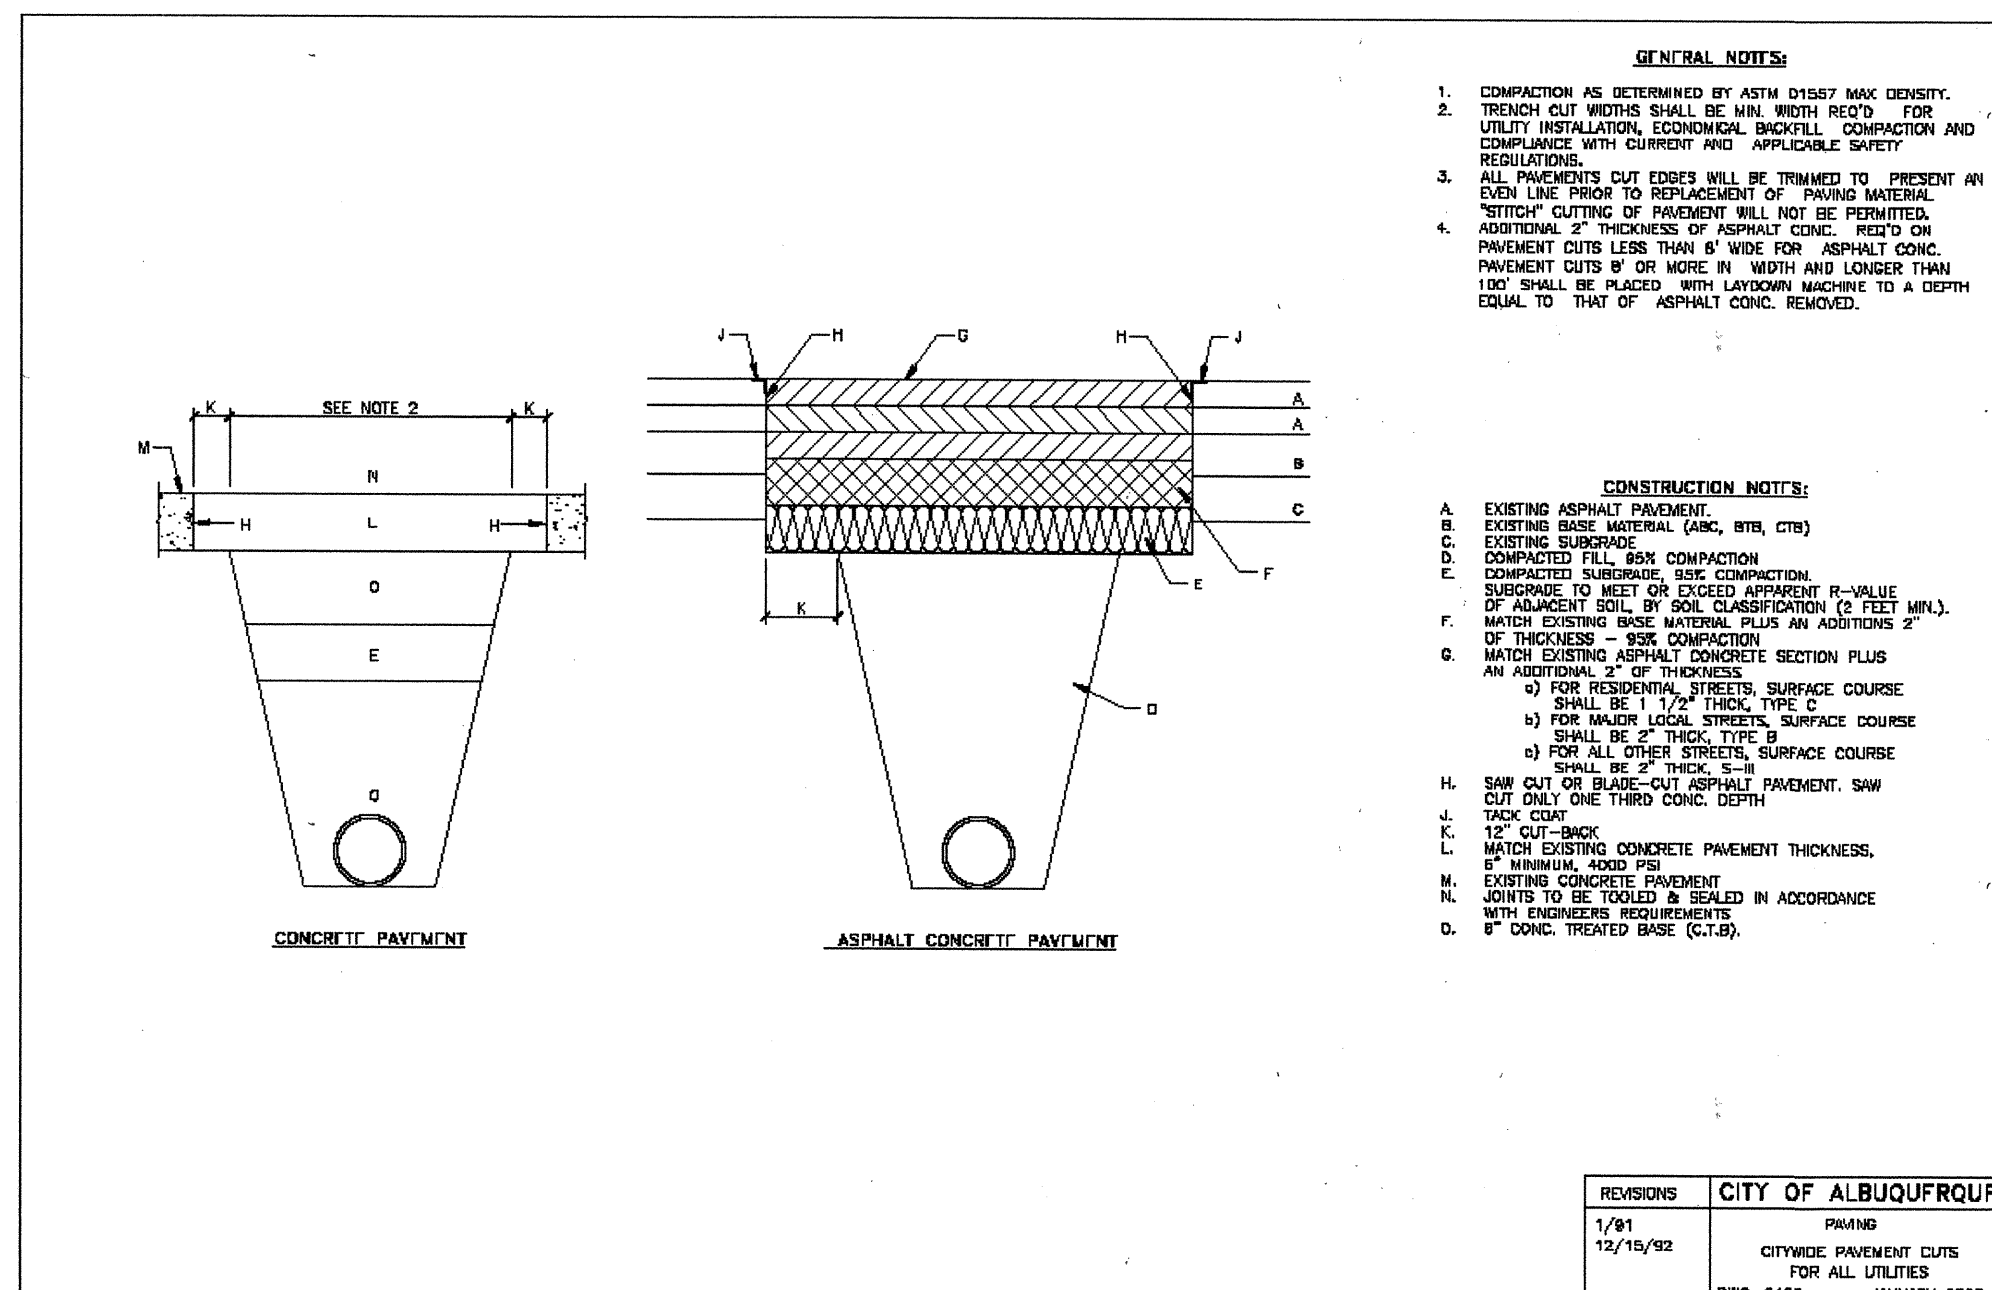


GENERAL NOTES:

1. COMPACTION AS DETERMINED BY ASTM D1557 MAX DENSITY.
2. TRENCH CUT WIDTHS SHALL BE 18" MIN. WIDTH FOR UTILITY INSTALLATION, ECONOMICALLY BACKFILL COMPACTION AND REGULATION.
3. ALL PAVEMENT CUT EDGES WILL BE TRIMMED TO PRESENT AN EVEN LINE PRIOR TO REPLACEMENT OF PAVING MATERIAL.
4. "NOTICE" CUTTING OF PAVEMENT WILL NOT BE PERMITTED. ADDITIONAL 2" THICKNESS OF ASPHALT CONC. MUST BE PLACED ON PAVEMENT CUTS LESS THAN 6" WIDE FOR ASPHALT CONC. PAVEMENT CUTS 6" OR MORE IN WIDTH AND LONGER THAN 180" SHALL BE PLACED WITH LANSOM MACHINE TO A DEPTH EQUAL TO THAT OF ASPHALT CONC. REMOVED.

CONSTRUCTION NOTES:


- A. EXISTING ASPHALT PAVEMENT.
- B. EXISTING BASE MATERIAL (LIME, BIT, CTR).
- C. EXISTING SURFACE.
- D. COMPACTED FILL AND COMPACTION.
- E. COMPACTION SURROUNDING PIPE CONNECTION.
- F. MATCH EXISTING BASE MATERIAL PLUS AN ADDITIONAL 2" OF THICKNESS - SEE COMPACTION.
- G. MATCH EXISTING ASPHALT CONCRETE SECTION PLUS AN ADDITIONAL 2" OF THICKNESS.
- H. FOR RESURFACING STREET, SURFACE COURSE SHALL BE 1 1/2" THICK TYPE C.
- I. FOR MAJOR LOCAL STREET, SURFACE COURSE SHALL BE 2" THICK TYPE B.
- J. SAW CUT FOR BLACK-OUT ASPHALT PAVEMENT. SAW TACK COAT.
- K. MATCH EXISTING CONCRETE PAVEMENT THICKNESS.
- L. IF MINOR ROAD.
- M. EXISTING CONCRETE PAVEMENT.
- N. JOINTS TO BE TOoled & sealed IN ACCORDANCE WITH ENGINEERING REQUIREMENTS.
- O. IF CONC. TREATED BASE (CUB).

REVISIONS	CITY OF ALBUQUERQUE
1/91	PAVING
12/15/92	CITYWIDE PAVEMENT CUTS FOR ALL UTILITIES
	DWG. 2486 JANUARY 2003

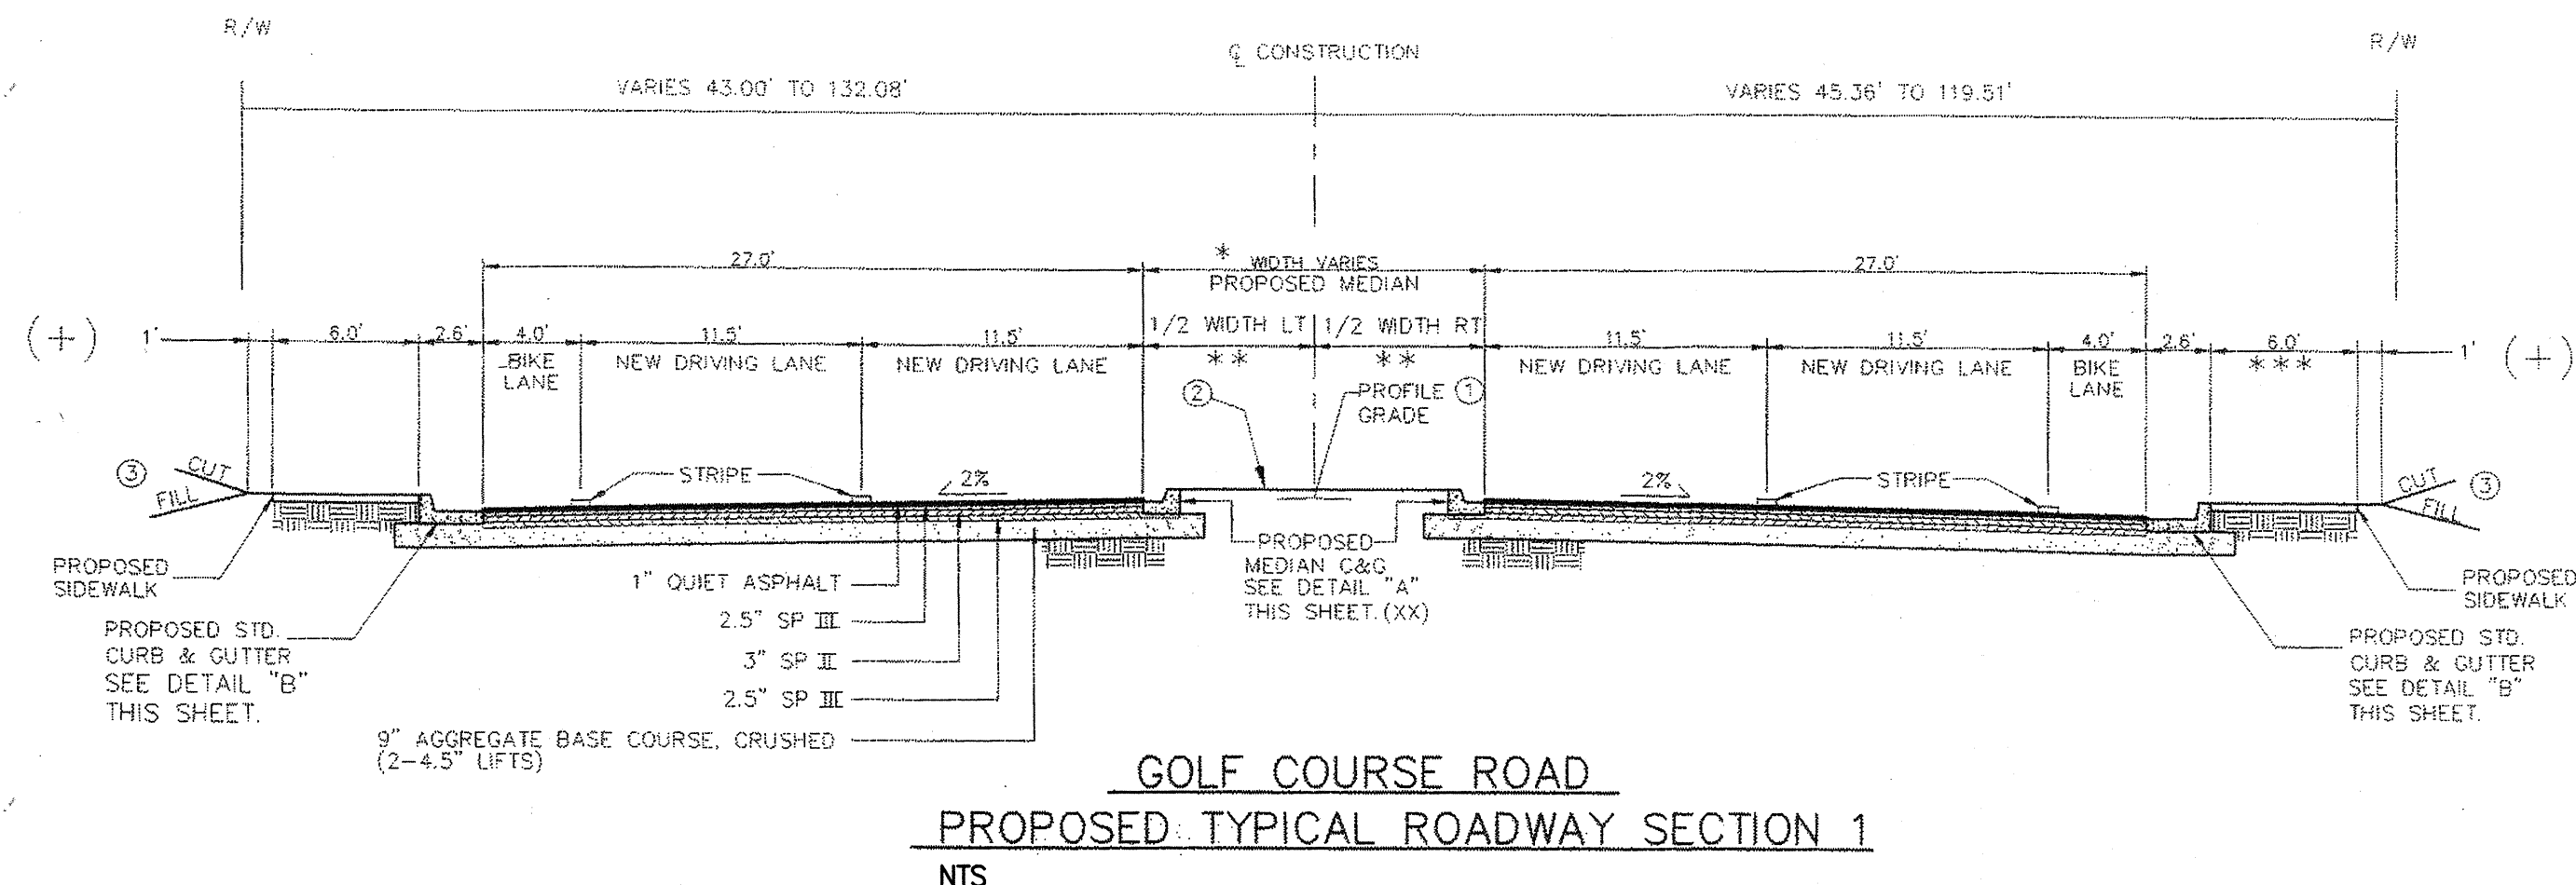

GOLF COURSE ROAD PROPOSED TYPICAL ROADWAY SECTION 1

NOTE: PAVEMENT CUT AND REPLACE ON GOLF COURSE ROAD. SAW CUT ASPHALT AND MATCH EXISTING PAVEMENT FOR PAVEMENT REPLACEMENT.

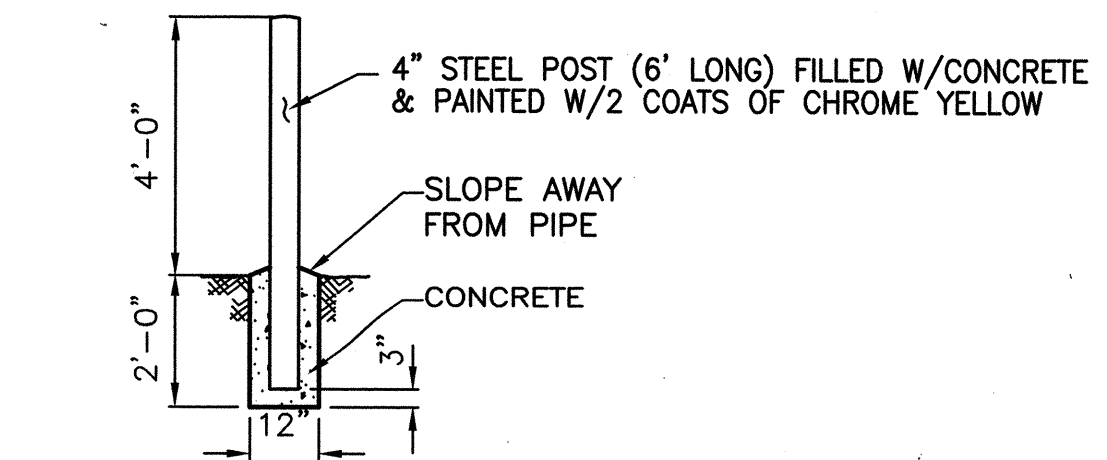

BOLLARD DETAIL

NOT TO SCALE

WILSON & COMPANY 4900 LANG AVENUE NE SUITE 200 ALBUQUERQUE, NEW MEXICO 87109 (505) 348-4000 FAX (505) 348-4072 www.wilsoncs.com		CITY OF ALBUQUERQUE PUBLIC WORKS DEPARTMENT ENGINEERING GROUP VJW INC. STORAGE MISCELLANEOUS DETAILS	
Design Review Committee APPROVED APR 21 2008 DESIGN REVIEW COMMITTEE	City Engineer Approval APPROVED MAY 19 2008 DESIGN REVIEW COMMITTEE	Last Design Update Mo./Day/Yr. _____	Mo./Day/Yr. _____
City Project No. 7718.83	Zone Map No. A-12	Sheet 22	Of 22