



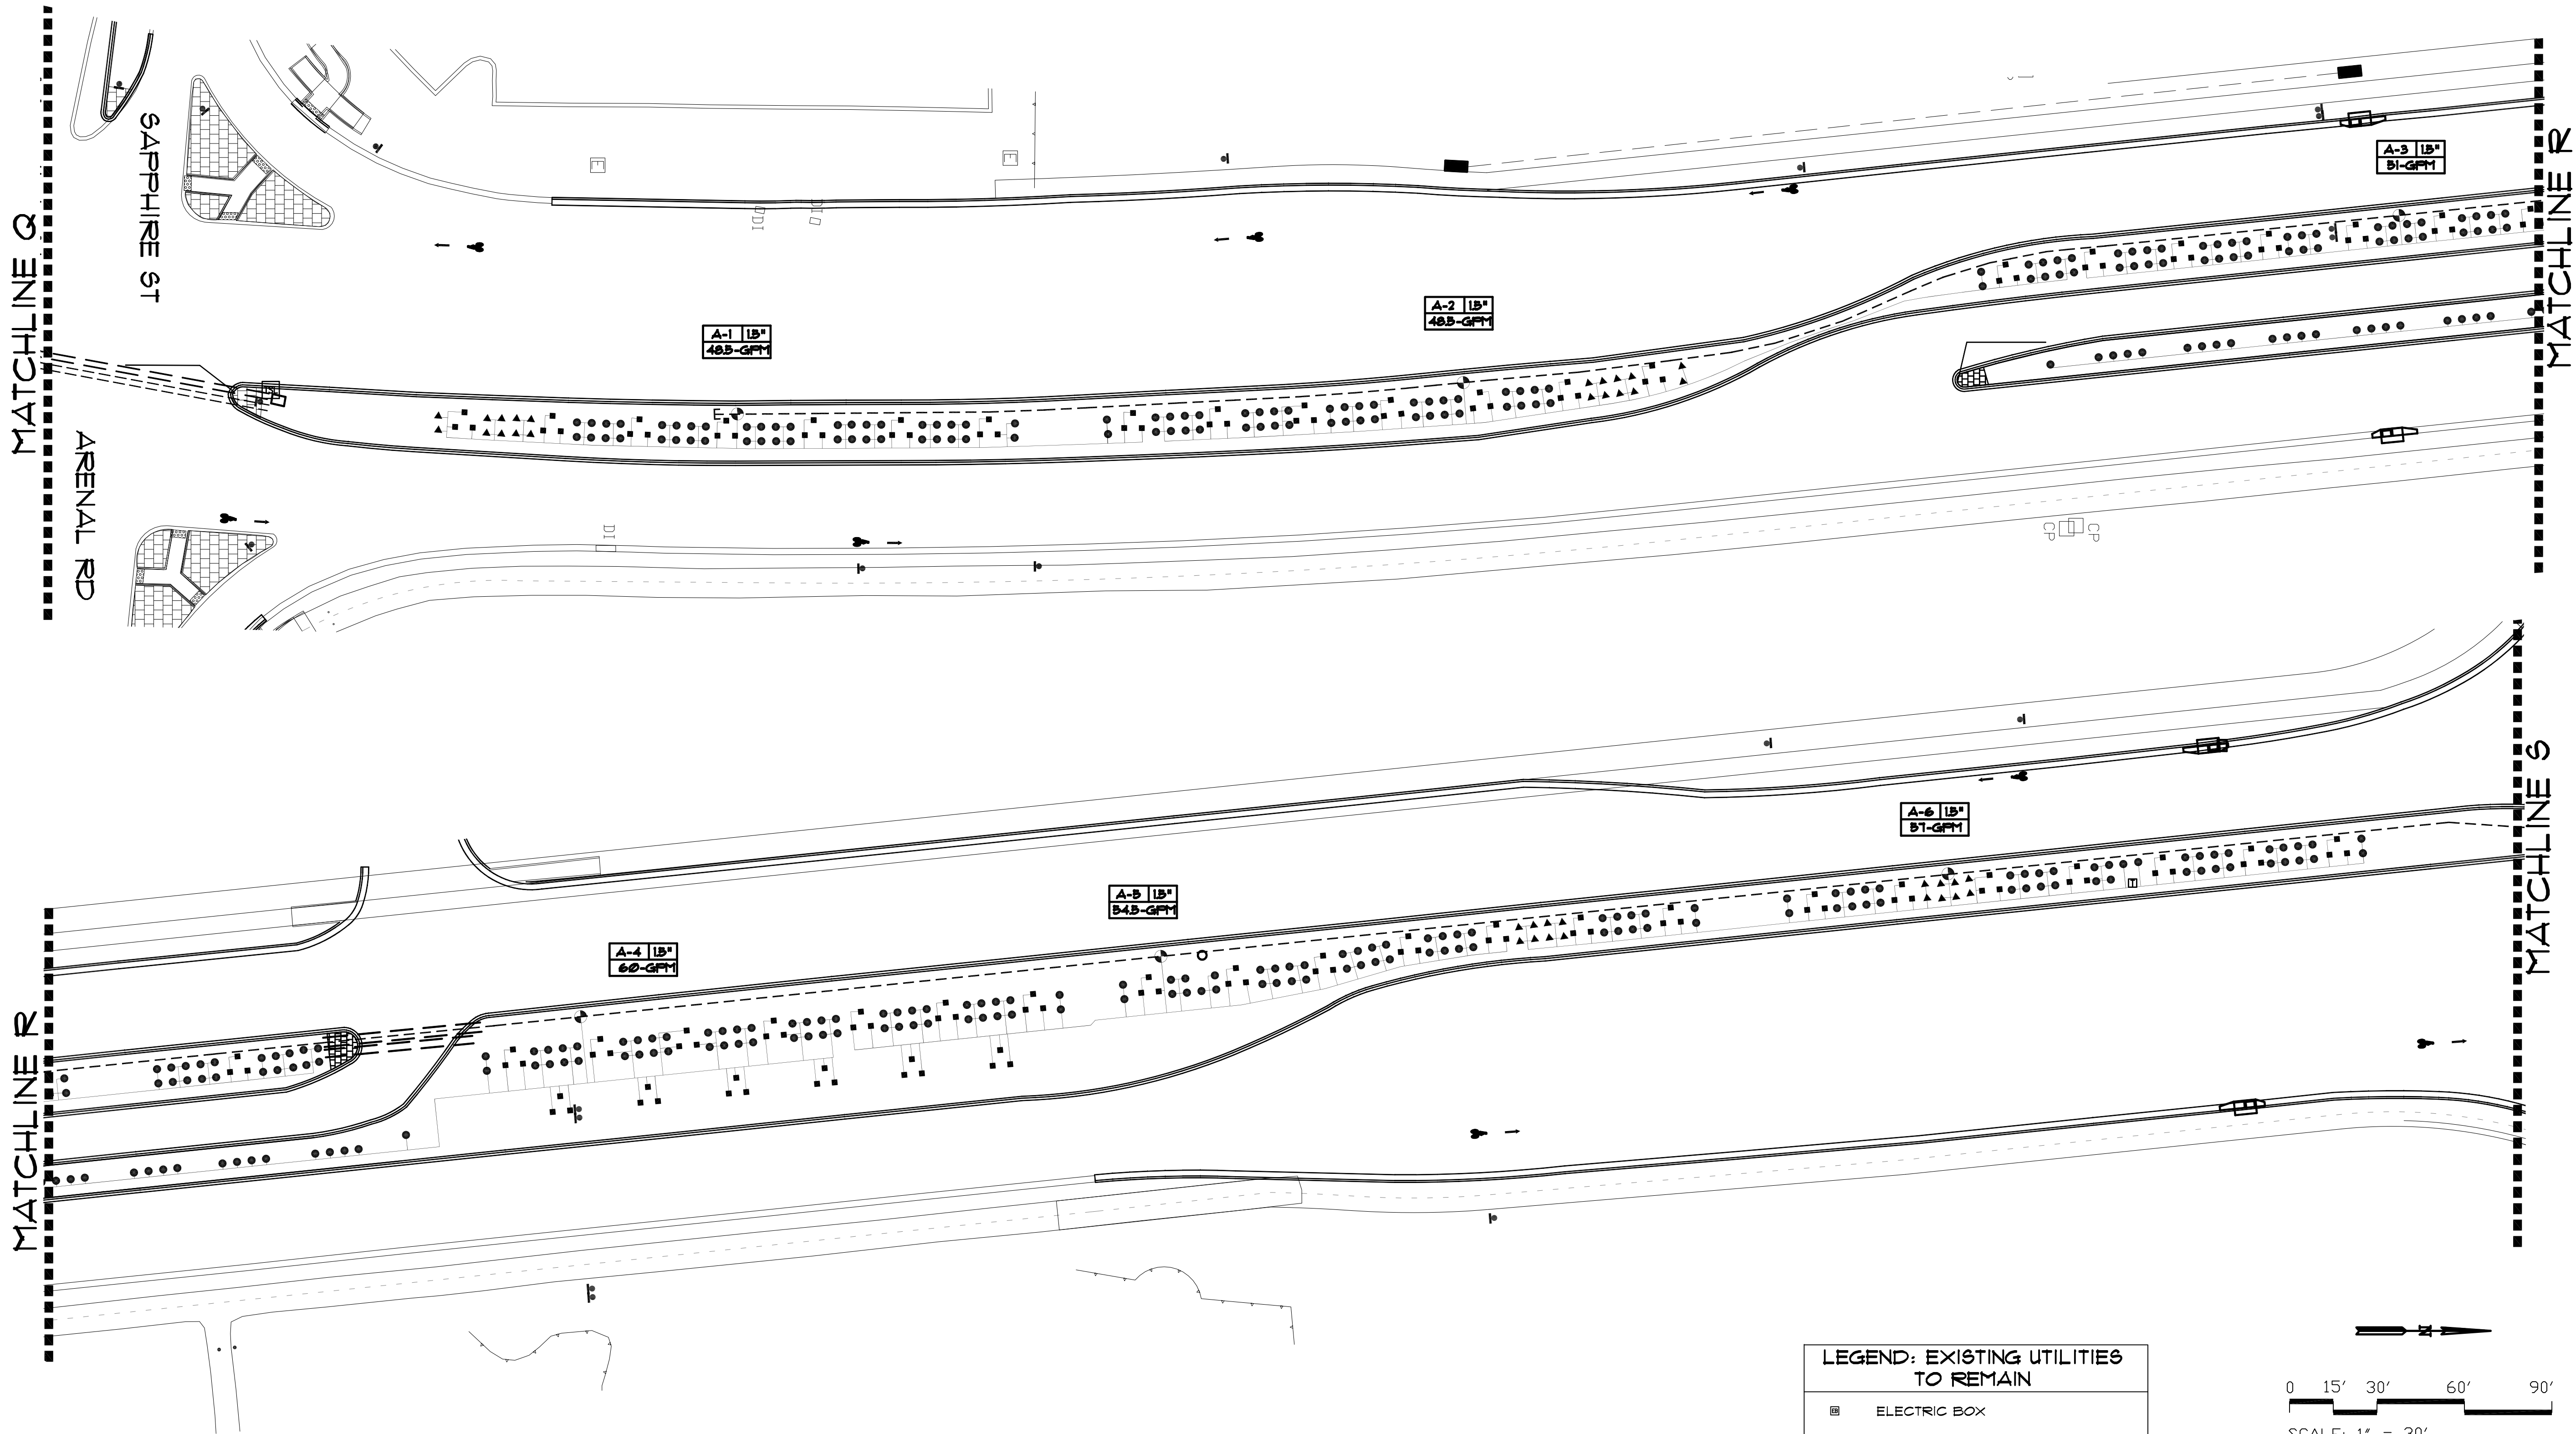

LEGEND: EXISTING UTILITIES TO REMAIN

- ELECTRIC BOX
- TRAFFIC CONTROL BOX
- TRAFFIC SIGNAL LIGHT
- TELEPHONE RISER
- WATER METER
- WATER VALVE
- DROP INLET
- MANHOLE (STORM)
- MANHOLE (SANITARY)
- MANHOLE (ELECTRIC)
- MANHOLE (TELEPHONE)
- MANHOLE (UNDETERMINED)
- TRAFFIC SIGNAL BOX
- 6" PVC IRRIGATION PIPE SLEEVE
- 2" PVC IRRIGATION WIRE SLEEVE

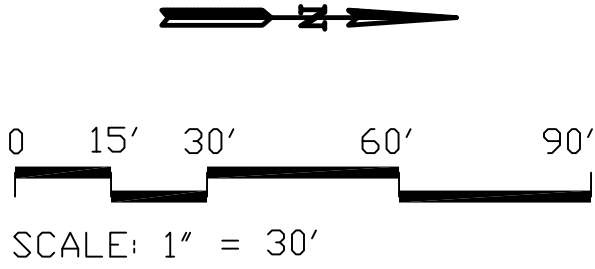

SEQUOIA LANDSCAPING
810 RANKIN RD. NE, ALBUQUERQUE, NM. 87107
(505) 911-2767 FAX: (505) 715-4703

**MORROW
REARDON
WILKINSON, LTD.,
LANDSCAPE ARCHITECTS**
210 La Veta NE, Albuquerque, NM 87108
505.268.2266 FAX 505.265.9637
mlw@mllwlln.com

CITY OF ALBUQUERQUE
CAPITAL IMPLEMENTATION PROGRAM
DEPARTMENT OF MUNICIPAL DEVELOPMENT

**PROTOTYPE MEDIAN AND INTERSTATE LANDSCAPES FY-11A
UNSER BLVD: SAN YGNACIO RD TO DENNIS CHAVEZ BLVD
IRRIGATION PLAN**

Design Review Committee	City Engineer Approval	Last Design Update	Mo./Day/Yr.	Mo./Day/Yr.
City Project No. 772302	Zone Map No. L-10, M-10, N-10, N-9, P-9	Sheet 1 OF 2		

REVISIONS		ARCHITECTURAL SEAL		SURVEY INFORMATION		BENCH MARKS		AS-BUILT INFORMATION	
				FIELD NOTES					
				NO. BY DATE					
								CONTRACTOR SEQUOIA LANDSCAPING	
								WORKED BY SEQUOIA LANDSCAPING	
								INSPECTION DATE: 6-27-11	
								ACCEPTANCE BY ROBERT RAMIREZ	
								DATE: 6-27-11	
								VERIFICATION BY ROBERT RAMIREZ	
								DATE: 6-27-11	
								DRAWINGS BY KANAKA MOYA	
								DATE: 9-6-11	
								MICRO-FILM INFORMATION	
								RECORDED BY	
								DATE	
								NO.	

