

MATCHLINE I

MATCHLINE J

MATCHLINE J

MATCHLINE K

LEGEND: EXISTING UTILITIES TO REMAIN

ELECTRIC BOX

TRAFFIC CONTROL BOX

TRAFFIC SIGNAL LIGHT

TELEPHONE RISER

WATER METER

WATER VALVE

DROP INLET

MANHOLE (STORM)

MANHOLE (SANITARY)

MANHOLE (ELECTRIC)


MANHOLE (TELEPHONE)

MANHOLE (UNDETERMINED)

TRAFFIC SIGNAL BOX

6" PVC IRRIGATION PIPE SLEEVE

2" PVC IRRIGATION WIRE SLEEVE

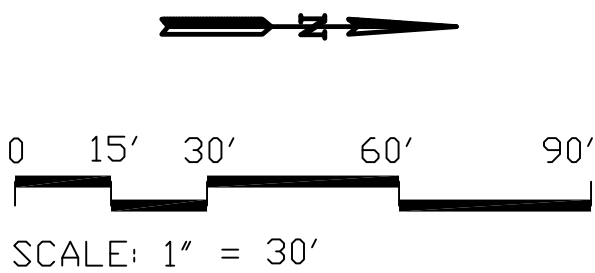

MORROW
REARDON
WILKINSON, LTD.
LANDSCAPE ARCHITECTS

210 La Veta NE, Albuquerque, NM 87108
505.268.2266 FAX 505.265.9637
mlw@mllwllc.com

CITY OF ALBUQUERQUE
CAPITAL IMPLEMENTATION PROGRAM
DEPARTMENT OF MUNICIPAL DEVELOPMENT

PROTOTYPE MEDIAN AND INTERSTATE LANDSCAPES FY-11A
UNSER BLVD: SAN YGNACIO RD TO DENNIS CHAVEZ BLVD
IRRIGATION PLAN

Design Review Committee

City Engineer Approval

Last Design Update

Mo./Day/Yr.

Mo./Day/Yr.

Mo./Day/Yr.

Mo./Day/Yr.


City Project No.
772302

Zone Map No.
L-10, M-10, N-10,
N-9, P-9

Sheet
1 OF 3

SEQUOIA LANDSCAPING
810 RANKIN RD. NE, ALBUQUERQUE, NM. 87107
(505) 911-2161 FAX: (505) 715-4103

SURVEY INFORMATION		BENCH MARKS		AS-BUILT INFORMATION	
NO.	FIELD NOTES	NO.	DATE	CONTRACTOR	DATE
				WORKED BY: SEQUOIA LANDSCAPING	DATE: 9-1-11
				INSPECTION BY: ROBERT RAMIREZ	DATE: 9-1-11
				ACCEPTANCE BY: ROBERT RAMIREZ	DATE: 9-1-11
				VERIFICATION BY: ROBERT RAMIREZ	DATE: 11-2-11
				DRAWINGS BY: RANKIN WILSON	DATE: 11-2-11
				CHECKED BY: RANKIN WILSON	DATE: 11-2-11
				MICRO-FILM INFORMATION	
				RECORDED BY	DATE
				NO.	

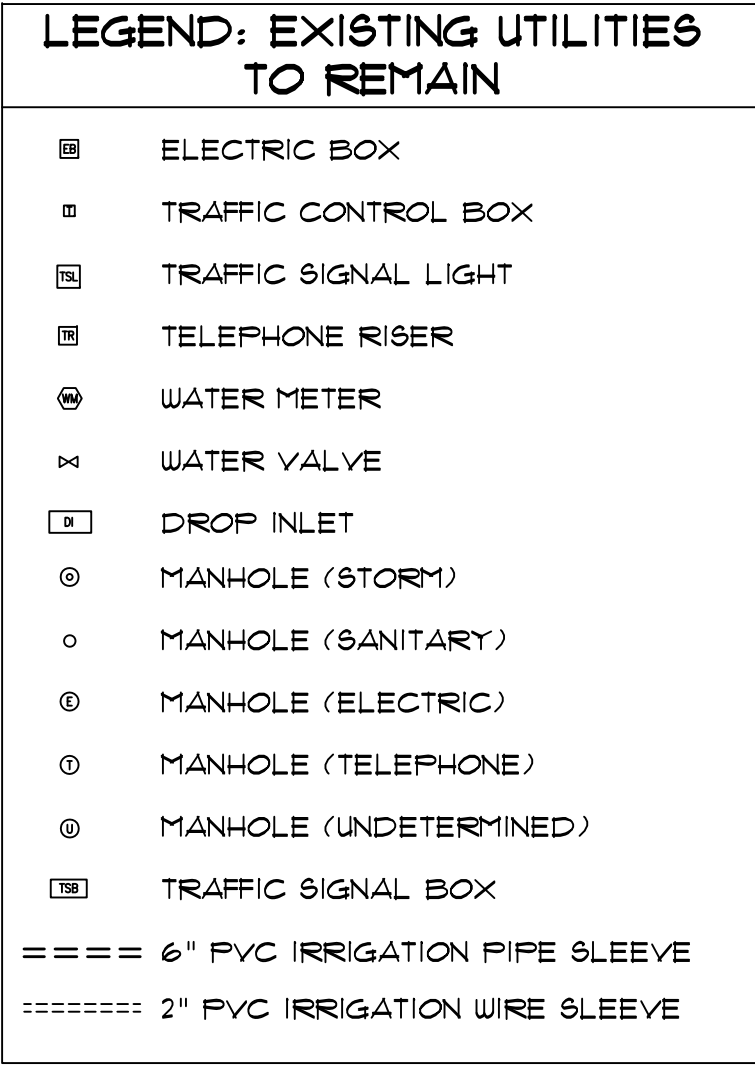

 **MORROW
REARDON
WILKINSON, LTD.,
LANDSCAPE ARCHITECTS**

210 La Veta NE, Albuquerque, NM 87108
505.268.2266 FAX 505.265.9637
mfw@mfwnm.com

Design Review Committee 	City Engineer Approval	Last Design Update	Mo./Day/Yr.	Mo./Day/Yr.
City Project No. 772302	Zone Map No. L-10, M-10, N-10, N-9, P-9	Sheet 2 OF 3		

City Project No. 772302	Zone Map No. L-10, M-10, N-10, N-9, P-9	Sheet 2 OF 3
-----------------------------------	---	------------------------

