


AC GRIP - (TP A) - 4001 (10) 07
G2043 JUL 1-25 TO CENTRAL AVENUE
(GUN CLUB AND ARENAL INTERSECTION


IMPROVEMENTS) (SEGMENT III OF IV)

CN: G2043

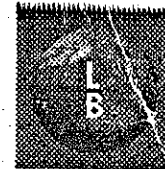

STA. 12+70.54, 25.50' LT.
BUILD 1-CDI TYPE II-B, H=3.00'
CONNECT TO MH#22 W/ 1-24"x34' SDCP
GR.=4928.85, INV.=4925.85

STA. 14+47.03, 16.50' LT.
BUILD 1-CDI TYPE I-B, H=3.00'
CONNECT TO MH#23 W/ 1-24"x20' SDCP
GR.=4925.90, INV.=4922.90

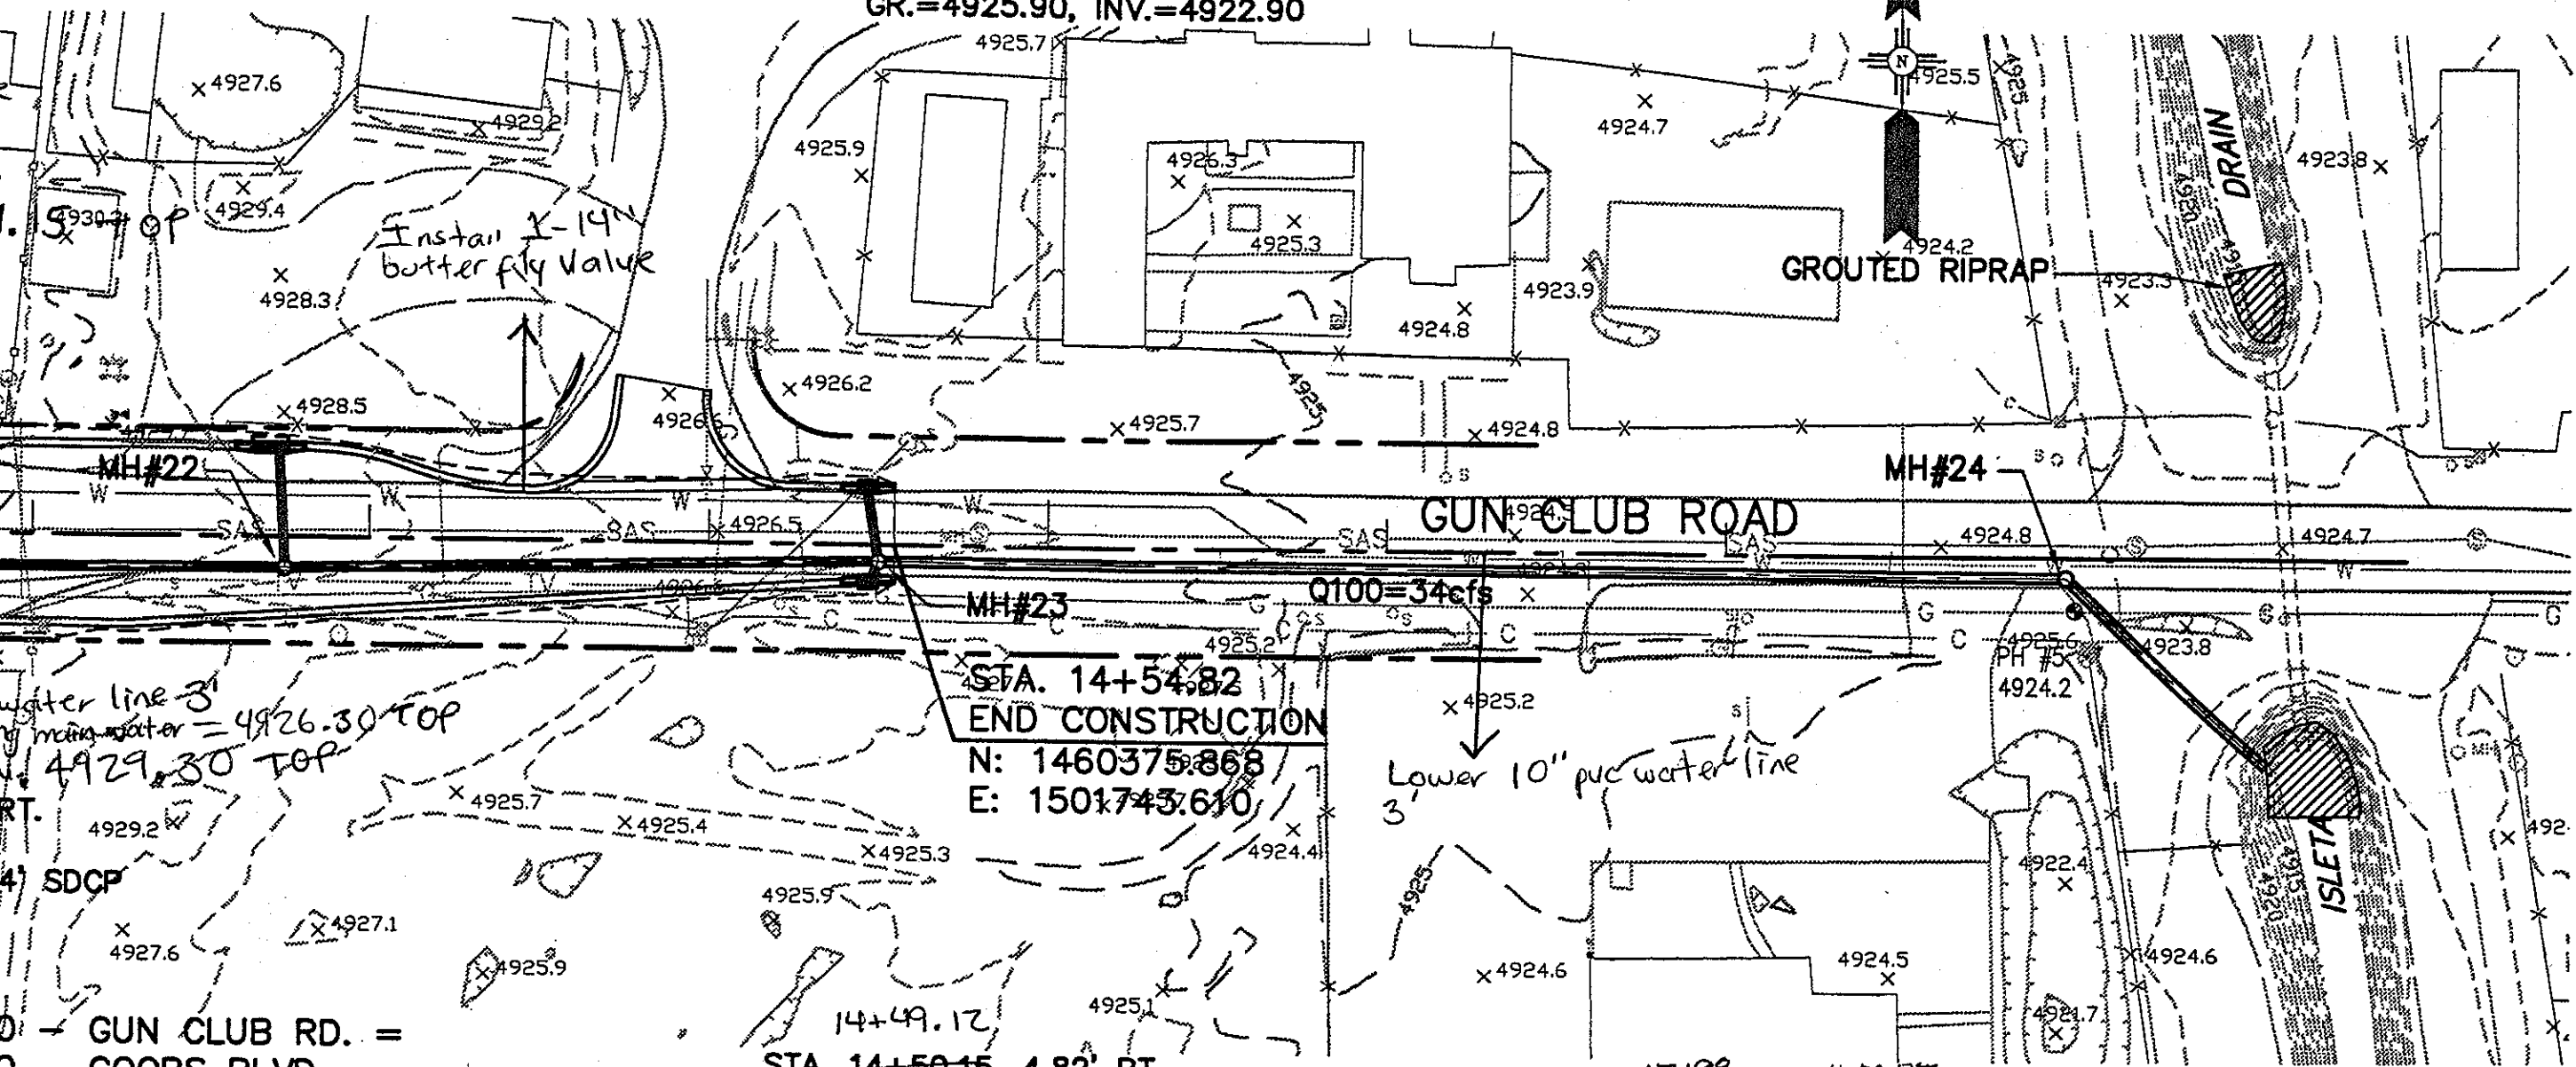

42
00 STA. 12+75.00, 9.00' RT.
BUILD 1-72" MANHOLE #22
H=6.17' CONNECT TO MH #23
W/ 1-30"x176' SDCP


14+49.12
STA. 14+50.15, 4.82' RT.
BUILD 1-72" MANHOLE #23
H=6.03' CONNECT TO MH #24
W/ 1-30"x350' SDCP

STA. 14+47.01, 11.02' RT.
BUILD 1-CDI TYPE I-B, H=3.00'
CONNECT TO MH#23 W/ 1-24"x6' SDCP
GR.=4926.01, INV.=4923.01

17+98 4.00 RT.
STA. 18+00.15, 5.87' RT.
BUILD 1-72" TEMPORARY TREATMENT
MANHOLE #24 W/ SNOUT, H=10.53'
CONNECT TO ISLETA DRAIN, 59.47' RT.
OF STA. 18+59.44. W/ 1-24"x80'
SDCP & GROUTED RIPRAP. SEE
DETAILS SHT. 10-1 & 10-17

COORS / GUNCLUB
STA. 5+00 TO STA. 20+00
PLAN: SCALE: 1"=50'
CONTOUR INTERVAL = 1'
PROFILE: SCALE: 1"=50' (HORIZ.)
1"=5' (VERT.)

STORM DRAIN

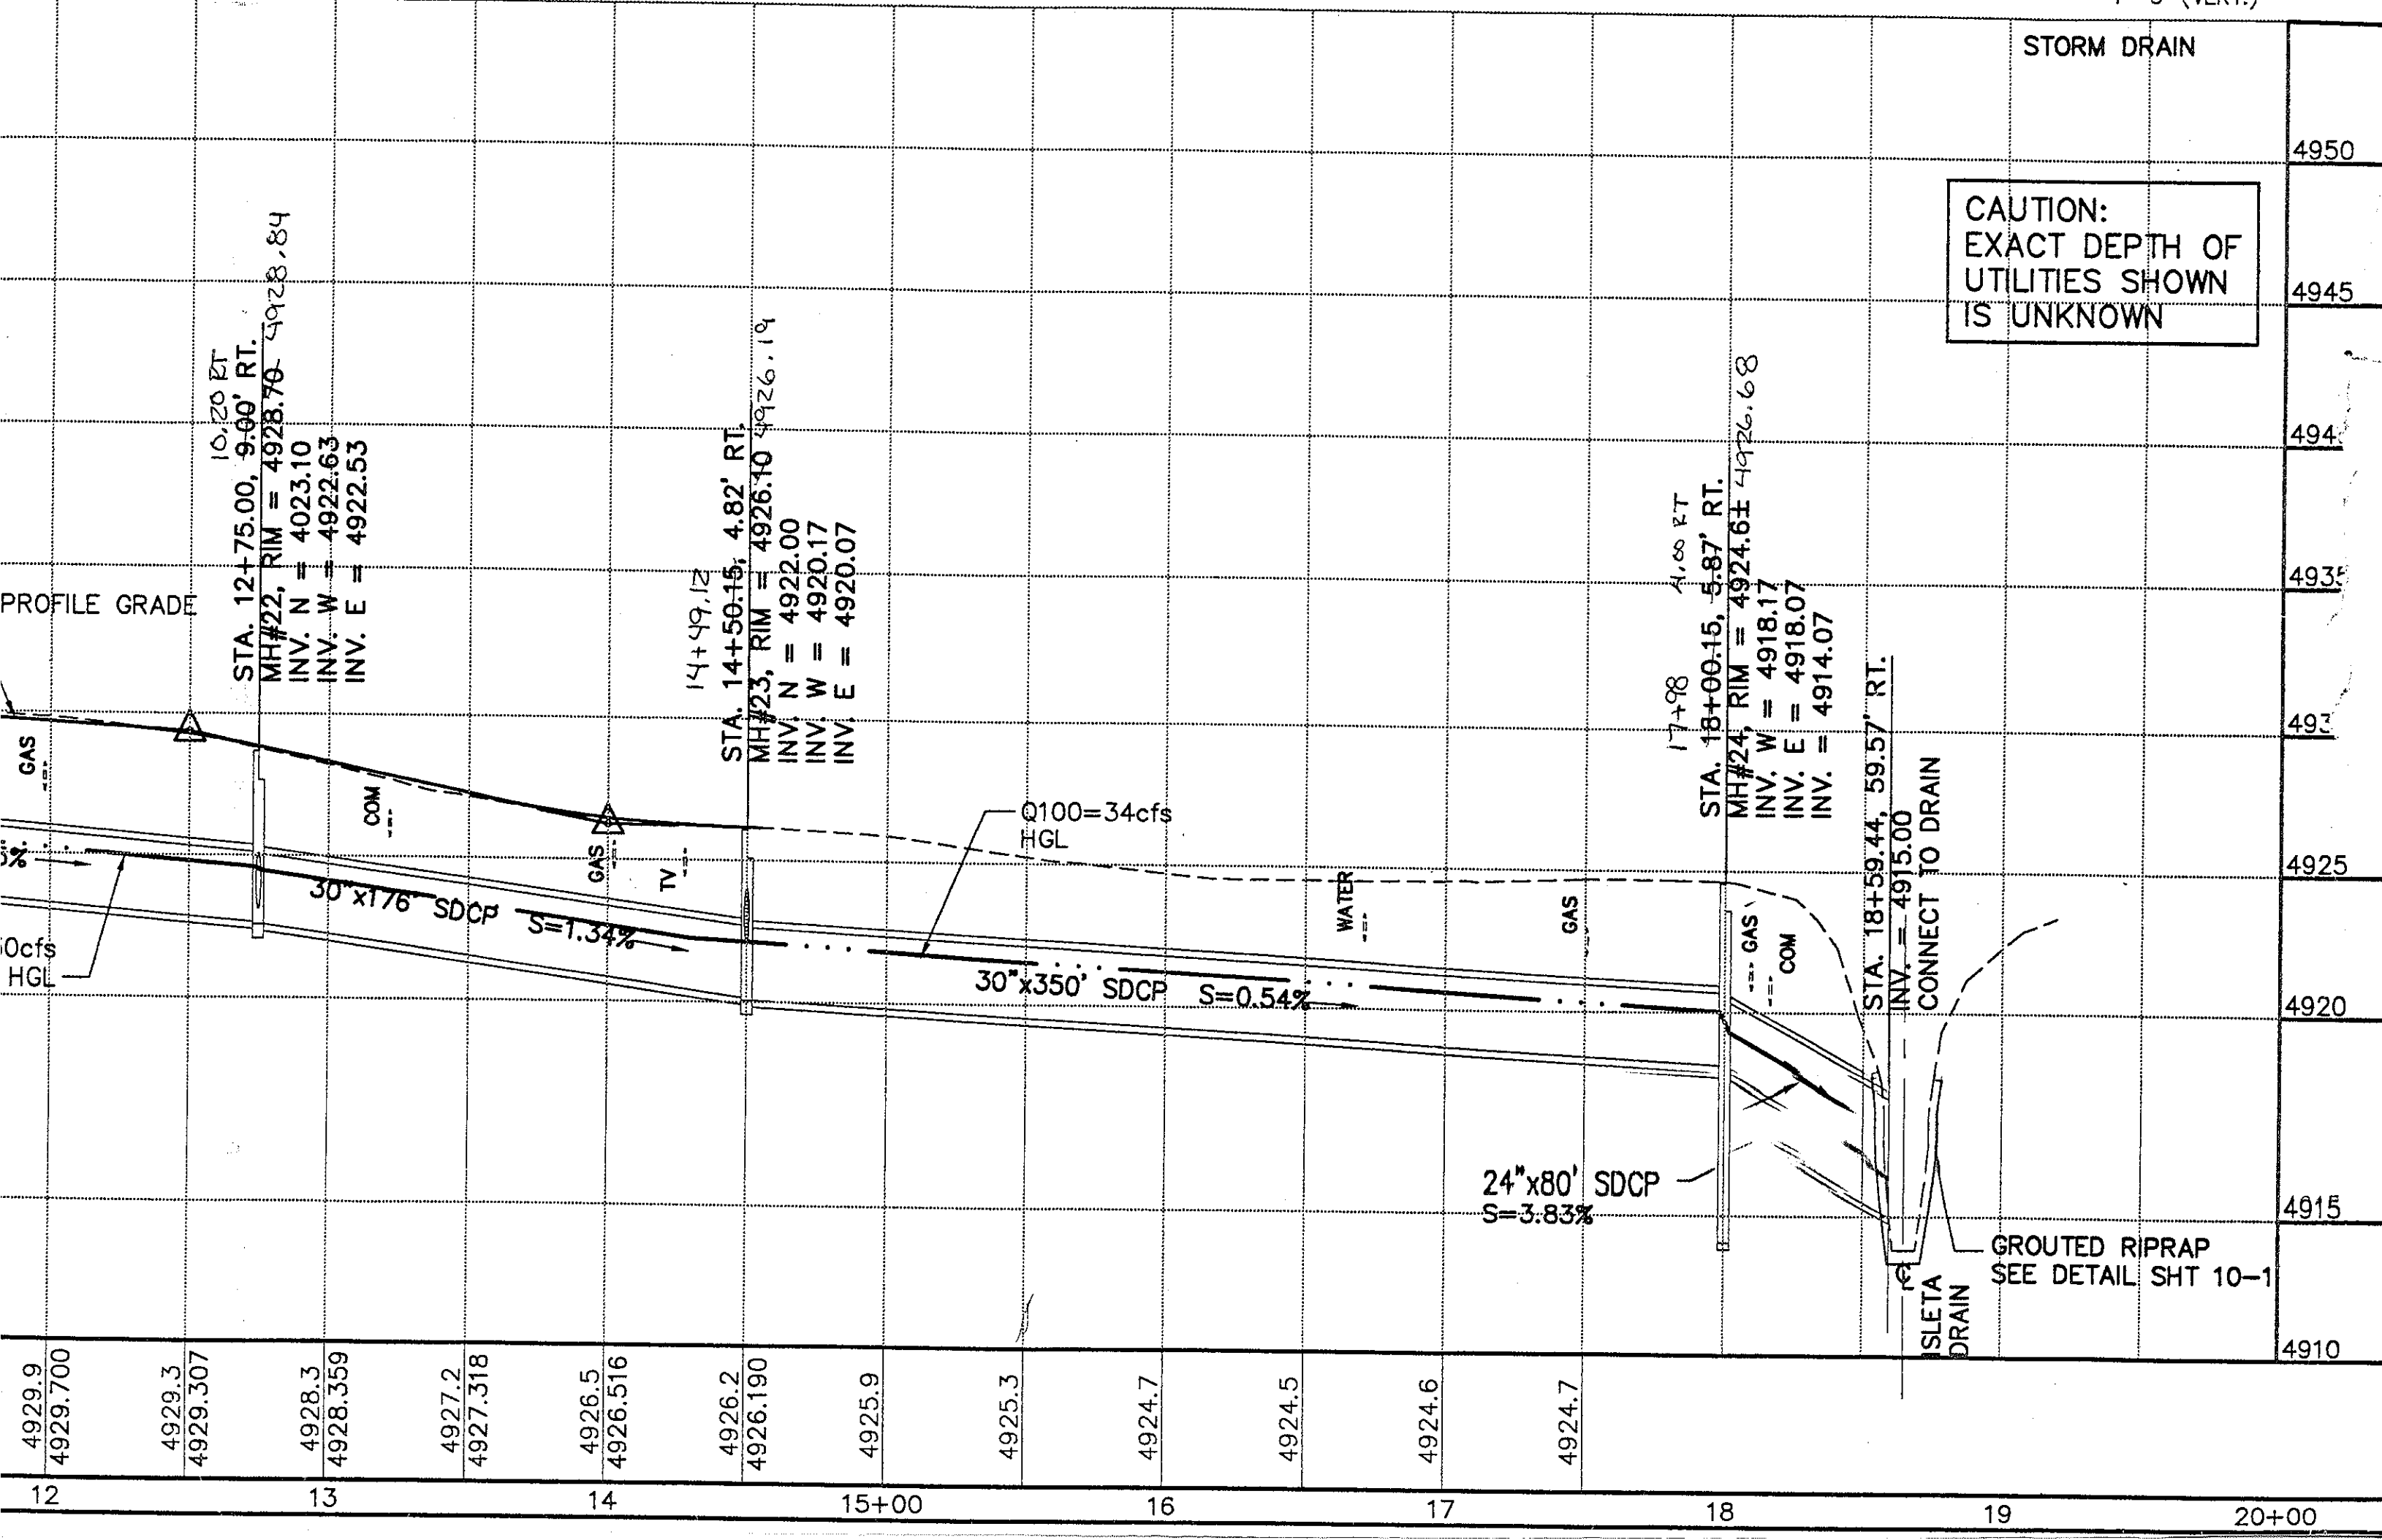

5+00

STA. 7+30.00, 21.17' LT.
BUILD 1-MDI, TYPE I URBAN, H=3.00'
CONNECT TO MH #20 W/ 1-24"x30' SDCP
GR.=4931.38, INV.=4928.38

STA. 8+95.15, 16.45' LT.
BUILD 1-CDI TYPE II-B, H=3'-0"
CONNECT TO MH#21 W/ 1-24"x24' SDCP
GR.=4931.23, INV.=4928.23

STA. 12+70.54,
BUILD 1-CDI TY
CONNECT TO MH
GR.=4928.85, II

STA. 6+78.81
BEGIN CONSTRUCTION

N: 1460377.188
E: 1500967.600

APPROX. EXISTING ROW

GUN CLUB ROAD

WV NOT FOUND

DESIGN CL

APPROX. EXISTING ROW

STA. 6+76.00, 9.87' RT.
BUILD 30"x54' SDCP
CONNECT TO MANHOLE #20
CAP WEST END

STA. 7+31.30, 9.87' RT.
BUILD 1-48" MANHOLE #20
H=4.10' CONNECT TO MH #21
W/ 1-24"x166' SDCP

STA. 7+30.00, 23.17' RT.
BUILD 1-MDI, TYPE I URBAN, H=3.00'
CONNECT TO MH #20 W/ 1-24"x12' SDCP
GR.=4931.50, INV.=4928.50

STA. 8+95.17, 9.87' RT.
BUILD 1-48" MANHOLE #21
H=5.00' CONNECT TO MH #15
W/ 1-24"x136' SDCP

STA. 8+95.17, 25.50' RT.
BUILD 1-CDI TYPE II-B, H=3.00'
CONNECT TO MH#21 W/ 1-24"x14' SDCP
GR.=4930.95, INV.=4927.95

STA. 10+31.16, 9.78' RT.
CONNECT MH #15 TO
MH #22 W/ 1-30"x244' SDCP

STA. 10+00.00 - GUN CLUB RD.
STA. 10+00.00 - COORS BLVD.

N: 1460376.642
E: 1501288.790

STA. 12+75.00, 9
BUILD 1-72" MAN
H=6.17' CONNECT
W/ 1-30"x176' S

NO.	DESCRIPTION	DATE	BY
1	STORM DRAIN REVISIONS	4/18/06	CFS
REVISIONS (OR CHANGE NOTICES)			

