

SCANNED BY
PLANNING

2 3 4 5 6 7 8 9 10 11 12 13 14 15
26-7754-78-20110



CONSTRUCTION PLANS FOR TRACT 11 AT MESA DEL SOL, GSA INFRASTRUCTURE ALBUQUERQUE, NEW MEXICO

CERTIFICATE OF SUBSTANTIAL COMPLIANCE ON PLANS

I, Steven K. Morrow, of the firm Brasher and Lorenz, Inc., a Registered Professional Engineer in the State of New Mexico, do hereby certify, to the best of my knowledge and belief, that the infrastructure installed as part of this project has been inspected by me or by a qualified person under my direct supervision and has been constructed in accordance with the plans and specifications approved by the City Engineer and that the original design intent of the approved plans has been met, except as noted by me on the as-built construction drawings. This Certification is based on site inspections by me or personnel under my direction and survey information provided by Will Plotner, Jr. NMPS 14271.

Steven K. Morrow
Steven K. Morrow, NMPE 13679

1-15-10
Date

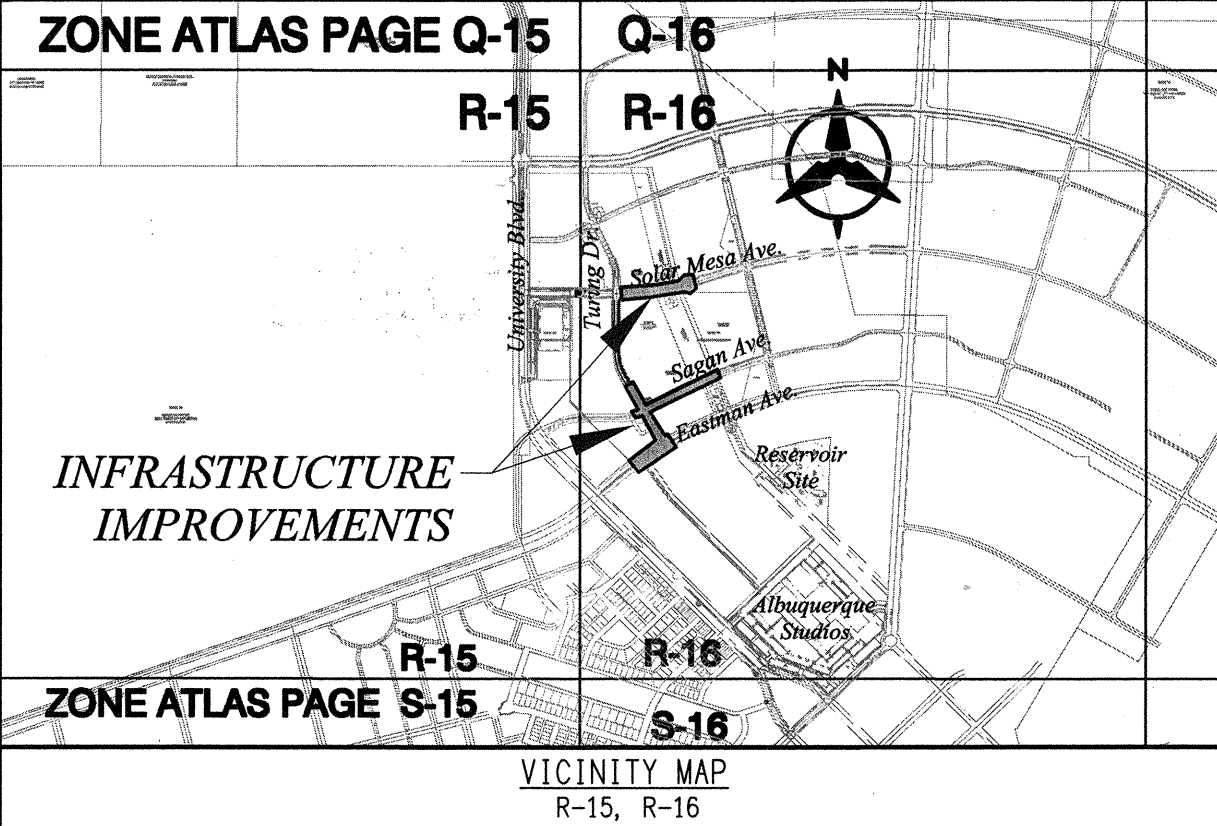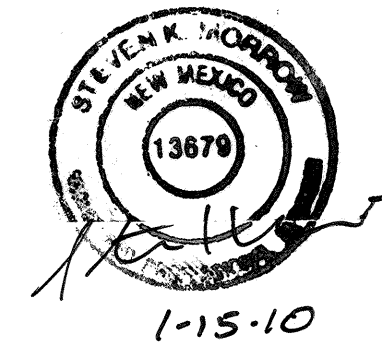

NOTICE TO CONTRACTORS

1. AN EXCAVATION/CONSTRUCTION PERMIT WILL BE REQUIRED BEFORE BEGINNING ANY WORK WITHIN THE CITY RIGHT-OF-WAY.
2. ALL WORK DETAILED ON THESE PLANS TO BE PERFORMED UNDER CONTRACT SHALL, EXCEPT AS OTHERWISE STATED OR PROVIDED FOR HEREON, BE CONSTRUCTED IN ACCORDANCE WITH THE CITY OF ALBUQUERQUE STANDARD SPECIFICATIONS FOR PUBLIC WORKS CONSTRUCTION, 1986 EDITION AS REVISED THROUGH UPDATE #7, INCLUDING AMENDMENT 1 TO UPDATE #7.
3. TWO WORKING DAYS PRIOR TO ANY EXCAVATION, THE CONTRACTOR MUST CONTACT NEW MEXICO ONE CALL SYSTEM (505-260-1990) FOR LOCATION OF EXISTING UTILITIES.
4. PRIOR TO CONSTRUCTION, THE CONTRACTOR SHALL EXCAVATE AND VERIFY THE HORIZONTAL AND VERTICAL LOCATIONS OF ALL OBSTRUCTIONS, SHOULD A CONFLICT EXIST, THE CONTRACTOR SHALL NOTIFY THE ENGINEER IMMEDIATELY SO THAT THE CONFLICT CAN BE RESOLVED WITH A MINIMUM AMOUNT OF DELAY.
5. SEVEN (7) WORKING DAYS PRIOR TO BEGINNING CONSTRUCTION, THE CONTRACTOR SHALL SUBMIT TO CONSTRUCTION COORDINATION DIVISION A DETAILED CONSTRUCTION SCHEDULE. TWO (2) WORKING DAYS PRIOR TO THE START OF CONSTRUCTION, THE CONTRACTOR SHALL OBTAIN A BARRICADING PERMIT FROM THE CONSTRUCTION COORDINATION DIVISION, CONTRACTOR SHALL NOTIFY THE CONSTRUCTION COORDINATION ENGINEER (505-924-3400) PRIOR TO OCCUPYING AN INTERSECTION. REFER TO SECTION 19 OF THE GENERAL CONDITIONS OF THE STANDARD SPECIFICATIONS.
6. ALL WORK EFFECTING ARTERIAL ROADWAYS REQUIRES TWENTY-FOUR HOUR CONSTRUCTION.
7. ALL STREET STRIPING ALTERED OR DESTROYED SHALL BE REPLACED WITH PLASTIC REFLECTORIZED PAVEMENT MARKING BY CONTRACTOR TO THE SAME LOCATION AS WAS EXISTING, OR AS INDICATED BY THIS PLAN SET.
8. CONTRACTOR SHALL NOTIFY THE ENGINEER NOT LESS THAN SEVEN (7) DAYS PRIOR TO STARTING WORK IN ORDER THAT THE CITY SURVEYOR MAY TAKE NECESSARY MEASURES TO INSURE THE PRESERVATION OF SURVEY MONUMENTS. CONTRACTOR SHALL NOT DISTURB PERMANENT SURVEY MONUMENTS WITHOUT THE CONSENT OF THE CITY SURVEYOR AND SHALL NOTIFY THE CITY SURVEYOR AND BEAR THE EXPENSE OF REPLACING ANY THAT MAY BE DISTURBED WITHOUT PERMISSION. REPLACEMENT SHALL BE DONE ONLY BY THE CITY SURVEYOR. WHEN A CHANGE IS MADE IN THE FINISHED ELEVATIONS OF THE PAVEMENT OF ANY ROADWAY IN WHICH A PERMANENT SURVEY MONUMENT IS LOCATED, CONTRACTOR SHALL, AT HIS OWN EXPENSE, ADJUST THE MONUMENT COVER TO THE NEW GRADE UNLESS OTHERWISE SPECIFIED. REFER TO SECTION 4.4 OF THE GENERAL CONDITIONS OF THE STANDARD SPECIFICATIONS.
9. CONTRACTOR SHALL RECORD DATA ON ALL UTILITY LINES AND ACCESSORIES AS REQUIRED BY THE CITY OF ALBUQUERQUE FOR THE PREPARATION OF "AS CONSTRUCTED" DRAWINGS. CONTRACTOR SHALL NOT COVER UTILITY LINES AND ACCESSORIES UNTIL ALL DATA HAS BEEN RECORDED.
10. CONTRACTOR SHALL MAINTAIN A GRAFFITI-FREE WORK SITE. CONTRACTOR SHALL PROMPTLY REMOVE ANY GRAFFITI FROM ALL EQUIPMENT, WHETHER PERMANENT OR TEMPORARY.
11. CONTRACTOR SHALL COORDINATE WITH THE WATER AUTHORITY (505-768-2500) SEVEN (7) WORKING DAYS IN ADVANCE OF ANY WORK THAT MAY AFFECT EXISTING PUBLIC WATER OR SEWER UTILITIES. EXISTING VALVES TO BE OPERATED BY WATER AUTHORITY PERSONNEL ONLY. CONTRACTOR SHALL CONTACT THE WATER AUTHORITY SEVEN (7) WORKING DAYS PRIOR TO NEEDING VALVES TURNED ON OR OFF.

THE FOLLOWING NOTES ALSO APPLY WHEN CHECKED

- ☒ ALL UTILITIES AND UTILITY SERVICE LINES SHALL BE INSTALLED PRIOR TO PAVING.
- ☒ BACKFILL COMPACTION SHALL BE ACCORDING TO SPECIFIED STREET USE.
- ☒ SIDEWALKS AND WHEELCHAIR RAMPS WITHIN THE CURB RETURNS SHALL BE CONSTRUCTED WHEREVER A NEW CURB RETURN IS CONSTRUCTED.
- ☒ IF CURB IS DEPRESSED FOR A DRIVEPAD, THE DRIVEPAD SHALL BE CONSTRUCTED PRIOR TO ACCEPTANCE OF CURB AND GUTTER.
- ☒ ALL STORM DRAINAGE FACILITIES SHALL BE COMPLETED PRIOR TO FINAL ACCEPTANCE.
- ☒ THE REQUESTOR OR DEVELOPER SHALL BE RESPONSIBLE FOR REPAIR OR REPLACEMENT OF ALL CURB AND GUTTER OR SIDEWALK DAMAGED AFTER APPROVAL BY THE CITY ENGINEER OF WORK COMPLETED BY THE CONTRACTOR.

INDEX

SHEET NO.	DESCRIPTION
1	TITLE SHEET
2A - 2D	FINAL PLAT (FOR INFORMATION ONLY)
3A - 3C	OVERALL GRADING PLAN (FOR INFORMATION ONLY)
4	OVERALL PAVING PLAN/ SIGNAGE PLAN
5 - 7	PAVING PLAN AND PROFILE SHEETS
8	OVERALL UTILITY PLAN
9 - 11	UTILITY PLAN AND PROFILE SHEETS
12	MISCELLANEOUS PAVING DETAILS AND STREET CROSS-SECTIONS SHEET
13	POND GRADING DETAILS

PAVING PLANS

SHEET NO.	DESCRIPTION
5	EASTMAN AVENUE
6	TURING DRIVE
7	SOLAR MESA AVENUE

UTILITY PLANS

SHEET NO.	DESCRIPTION
9	TURING DRIVE
10	SAGAN AVENUE
11	SOLAR MESA AVENUE

SURVEYOR'S CERTIFICATION

I, WILL PLOTNER JR., A DULY QUALIFIED, REGISTERED, PROFESSIONAL LAND SURVEYOR UNDER THE LAWS OF THE STATE OF NEW MEXICO, DO HEREBY CERTIFY THAT THE 'AS-BUILT' INFORMATION SHOWN ON THESE DRAWINGS WAS OBTAINED FROM FIELD CONSTRUCTION AND 'AS-BUILT' SURVEYS PERFORMED BY ME OR UNDER MY SUPERVISION, THAT THE 'AS-BUILT' INFORMATION SHOWN ON THESE DRAWINGS WAS ADDED BY ME OR UNDER MY SUPERVISION, AND THAT THIS 'AS-BUILT' INFORMATION IS TRUE AND CORRECT TO THE BEST OF MY KNOWLEDGE AND BELIEF. CARTESIAN SURVEYS IS NOT RESPONSIBLE FOR ANY OF THE DESIGN CONCEPTS, CALCULATIONS, ENGINEERING, OR INTENT OF THE RECORD DRAWINGS.

Will Plotner Jr.
WILL PLOTNER JR., NMPS 14271

ROUGH GRADING OF EASTMAN AVENUE, TURING DRIVE AND SOLAR MESA AVENUE DONE BY SEPARATE PROJECT AND HAS BEEN GRADED TO FINISHED PAVEMENT GRADE.

CONSTRUCTION NOTES:

1. THE CONTRACTOR SHALL ABIDE BY ALL LOCAL, STATE, AND FEDERAL LAWS, RULES AND REGULATIONS WHICH APPLY TO THE CONSTRUCTION OF THESE IMPROVEMENTS.
2. PRIOR TO CONSTRUCTION, CONTRACTOR SHALL EXCAVATE AND VERIFY THE HORIZONTAL AND VERTICAL LOCATIONS OF ALL POTENTIAL OBSTRUCTIONS. SHOULD A CONFLICT EXIST, THE CONTRACTOR SHALL NOTIFY THE ENGINEER OR CONSTRUCTION OBSERVER SO THAT THE CONFLICT CAN BE RESOLVED WITH A MINIMUM AMOUNT OF DELAY.
3. ALL ELECTRICAL, TELEPHONE, CABLE TV, GAS AND OTHER UTILITY LINES, CABLES AND APPURTENANCES ENCOUNTERED DURING CONSTRUCTION THAT REQUIRE RELOCATION, SHALL BE COORDINATED WITH THAT UTILITY. THE CONTRACTOR SHALL BE RESPONSIBLE FOR COORDINATION OF ALL NECESSARY UTILITY ADJUSTMENTS. NO ADDITIONAL COMPENSATION WILL BE ALLOWED FOR DELAYS OR INCONVENIENCES CAUSED BY UTILITY COMPANY WORK CREWS. THE CONTRACTOR MAY BE REQUIRED TO RESCHEDULE HIS ACTIVITIES TO ALLOW UTILITY CREWS TO PERFORM THEIR REQUIRED WORK.
4. DISPOSAL SITE FOR ALL EXCESS EXCAVATION MATERIAL, AND UNSUITABLE MATERIAL SHALL BE OBTAINED BY THE CONTRACTOR IN COMPLIANCE WITH APPLICABLE ENVIRONMENTAL REGULATIONS AND APPROVED BY THE CONSTRUCTION OBSERVER. ALL COSTS INCURRED IN OBTAINING A DISPOSAL SITE AND HAUL THERETO SHALL BE CONSIDERED INCIDENTAL TO THE PROJECT AND NO SEPARATE MEASUREMENT OR PAYMENT SHALL BE MADE. LOCATION OF DISPOSAL SITE WILL BE IDENTIFIED BY MESA DEL SOL.
5. THE CONTRACTOR IS RESPONSIBLE FOR PROTECTING THE EXISTING UTILITY LINES WITHIN THE CONSTRUCTION AREA. ANY DAMAGE TO EXISTING FACILITIES CAUSED BY CONSTRUCTION ACTIVITY SHALL BE REPAIRED OR REPLACED AT THE CONTRACTOR'S EXPENSE AND APPROVED BY THE CONSTRUCTION OBSERVER.
6. CONSTRUCTION ACTIVITY SHALL BE LIMITED TO THE PROPERTY AND/OR PROJECT LIMITS. ANY DAMAGE TO ADJACENT PROPERTIES RESULTING FROM THE CONSTRUCTION PROCESS IS THE RESPONSIBILITY OF THE CONTRACTOR. ANY COSTS INCURRED FOR REPAIRS SHALL BE THE COST OF THE CONTRACTOR.
7. OVERNIGHT PARKING OF CONSTRUCTION EQUIPMENT SHALL NOT OBSTRUCT DRIVEWAYS OR DESIGNATED TRAFFIC LANES. THE CONTRACTOR SHALL NOT STORE ANY EQUIPMENT OR MATERIAL WITHIN THE PUBLIC RIGHT-OF-WAY. CONTRACTOR SHALL COORDINATE THE LOCATIONS OF ANY STAGING AREA WITH MESA DEL SOL.
8. THE CONTRACTOR SHALL OBTAIN ALL THE NECESSARY PERMITS FOR THE PROJECT PRIOR TO COMMENCING CONSTRUCTION (I.E. BARRICADING, SURFACE DISTURBANCE).
9. THE CONTRACTOR SHALL BE RESPONSIBLE TO REPLACE AT HIS EXPENSE ANY AND ALL PROPERTY CORNERS DESTROYED DURING CONSTRUCTION. ALL PROPERTY CORNERS MUST BE RESET BY A REGISTERED LAND SURVEYOR.
10. ALL PERMANENT PAVEMENT MARKING AND TRAFFIC SIGNING SHALL BE FURNISHED BY THE CONTRACTOR PER PLAN.
11. THE CONTRACTOR SHALL FOLLOW THE COA STANDARD CONSTRUCTION, TRAFFIC CONTROL AND SIGNING PLAN PROVIDED IN THE COA STANDARD SPECIFICATIONS. THE CONTRACTOR SHALL COORDINATE WITH THE CITY OF ALBUQUERQUE, TRAFFIC ENGINEERING DEPARTMENT, PRIOR TO BEGINNING ANY CONSTRUCTION WORK ON OR ADJACENT TO EXISTING STREETS.
12. ALL BARRICADES AND CONSTRUCTION SIGNING SHALL CONFORM TO APPLICABLE SECTIONS OF THE 'MANUAL OF UNIFORM TRAFFIC CONTROL DEVICES' (MUTCD), U.S. DEPARTMENT OF TRANSPORTATION, LATEST EDITION.
13. THE CONTRACTOR SHALL MAINTAIN ALL CONSTRUCTION BARRICADES AND SIGNING AT ALL TIMES. THE CONTRACTOR SHALL VERIFY THE PROPER LOCATION OF ALL BARRICADING AT THE END AND BEGINNING OF EACH DAY AS PER STANDARD SPECIFICATIONS.
14. ALL SAW CUT PAVEMENT SHALL HAVE A UNIFORM EDGE AND BE SPRAYED WITH TACK.
15. WHEN ABUTTING NEW CURB AND GUTTER TO EXISTING PAVEMENT, A 1' WIDE SECTION OF EXISTING PAVEMENT ADJACENT TO THE CURB AND GUTTER SHALL BE SAW CUT, REMOVED, AND REPLACED AS PER THE COA STANDARD SPECIFICATIONS.
16. THE CONTRACTOR SHALL ASSUME RESPONSIBILITY FOR ANY DAMAGE TO EXISTING PAVEMENTS, PAVEMENT MARKINGS, CURB & GUTTER, DRIVE PADS, WHEELCHAIR RAMPS, AND SIDEWALK DURING CONSTRUCTION, APART FROM THOSE SECTIONS INDICATED FOR REMOVAL ON THE PLANS AND SHALL REPAIR OR REPLACE PER COA STANDARDS, AT HIS OWN EXPENSE.
17. RCP SHALL BE INSTALLED SO THAT THE JOINT GAP AT THE HOME POSITION SHALL CONFORM TO THE APPROVED MANUFACTURER'S RECOMMENDATIONS. MANUFACTURER'S RECOMMENDED JOINT GAP TOLERANCES FOR EACH PIPE SIZE AND TYPE SHALL BE SUBMITTED TO THE ENGINEER FOR APPROVAL PRIOR TO PLACEMENT OF PIPE. RCP JOINTS SHALL NOT BE GROUTED UNLESS DIRECTED BY THE ENGINEER AFTER CITY APPROVAL.
18. ALL EXCAVATION, TRENCHING, AND SHORING ACTIVITIES MUST BE CARRIED OUT IN ACCORDANCE WITH OSHA 29 CFR 1926.650 SUBPART P.
19. CONTRACTOR SHALL BE RESPONSIBLE FOR PROVIDING AND MAINTAINING ALL CONSTRUCTION SIGNING UNTIL PROJECT HAS BEEN ACCEPTED BY THE COA.
20. DEVELOPER SHALL BE RESPONSIBLE FOR PROVIDING AND MAINTAINING ALL PAVEMENT MARKING AND SIGNING WITH PRIVATE STREETS AND DEVELOPMENT.
21. CONTRACTOR IS RESPONSIBLE FOR SWPPP PREPARATION AND IMPLEMENTATION. CONTRACTOR SHALL COORDINATE SWPPP WITH ALL EXISTING SWPPPS INCLUDING THE MASTER OVERALL SWPPP. (CONTACT GRANT MORRISON, AT INSPECTION PLUS: 505-242-9609).
22. THE SURFACE AND SUBSURFACE SOILS WITHIN THE BOUNDARIES OF THIS PROJECT MAY BE USED ONLY FOR PURPOSES OF BEDDING OF UNDERGROUND UTILITIES, FOUNDATION, AND BACKFILL. UNDER NO CIRCUMSTANCES SHALL THE CONTRACTOR, OR ANY OF ITS SUBCONTRACTORS, BE ALLOWED TO USE ANY SOIL FROM WITHIN THE PROJECT BOUNDARIES AS AN ADMIXTURE TO ANY CONSTRUCTION MATERIAL, SUCH AS, BUT NOT LIMITED TO, THE BATCHING OF ASPHALT, CONCRETE, MASONRY, OR GROUT. UNDER NO CIRCUMSTANCES SHALL THE CONTRACTOR OR ANY OF ITS SUBCONTRACTORS BE ALLOWED TO REMOVE ANY SOIL FROM THE PROPERTY WITHIN THE BOUNDARIES OF THIS PROJECT, IN ANY AMOUNT WHATEVER, FOR TRANSPORT BY ANY MEANS TO ANY LOCATION OUTSIDE THOSE PROPERTY BOUNDARIES.
23. CONTRACTOR SHALL RECYCLE ALL EXISTING ASPHALT PAVEMENT REMOVED AS PART OF THIS PROJECT. CONTRACTOR SHALL PROVIDE TO MESA DEL SOL THE NAME AND ADDRESS OF THE ENTITY WHICH THE CONTRACTOR HAS CHOSEN TO PROCESS AND RECYCLE EXISTING ASPHALT PAVEMENT.
24. EXISTING DRY UTILITIES ARE PRESENT ON THE EAST & WEST SIDE OF TURING DRIVE. CONTRACTOR TO HAVE ALL EXISTING UTILITIES, WITHIN THE PROJECT LIMITS, SPOTTED THROUGH NEW MEXICO ONE-CALL (SEE NOTICE TO CONTRACTOR NOTE #3).

APPROVED AS RECORD DRAWINGS
DESIGN REVIEW SECTION
CITY ENGINEER
Anthony Davis
DATE: 05/18/10






DRB #1006000

Δ	13R.2	R Davis	10-29-09	City of chm	10-29-09				
Δ		N/A - FIELD CHANGE	9-10-09						
Δ	6.11	N/A - FIELD CHANGE	8-13-09						
Δ	13R	N/A - FIELD CHANGE	8-10-09						
REV.	SHEETS	CITY ENGINEER	DATE	USER DEPARTMENT	DATE	USER DEPARTMENT	DATE		
ENGINEERS STAMP & SIGNATURE			APPROVALS	ENGINEER	DATE	*****			
			DRC Chairman	A. Woodall	7-11-09	APPROVED FOR CONSTRUCTION			
			Transportation		6-18-09				
			Water/Wastewater		6-10-09				
			Hydrology	City of chm	6-23-09				
			Parks						
			Const. Coord.			City Engineer			
			City Project No.			Sheet Of			
				775478		1 13			

DESCRIPTION - SOUTH BOUNDARY

A certain parcel of land situated within Section 22, Township 19 North, Range 3 East, New Mexico County, Albuquerque, New Mexico, and comprising all of Tracts 1, 2, 3, 2221, 22

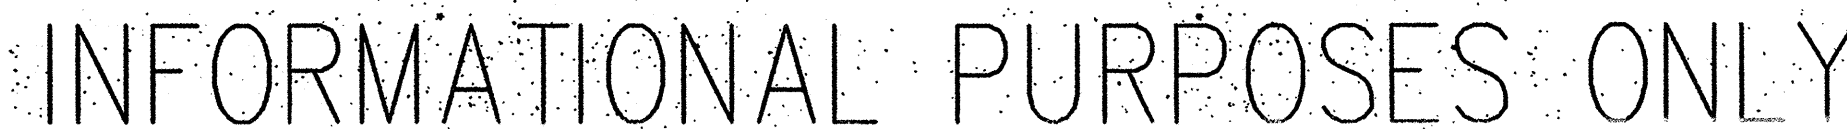

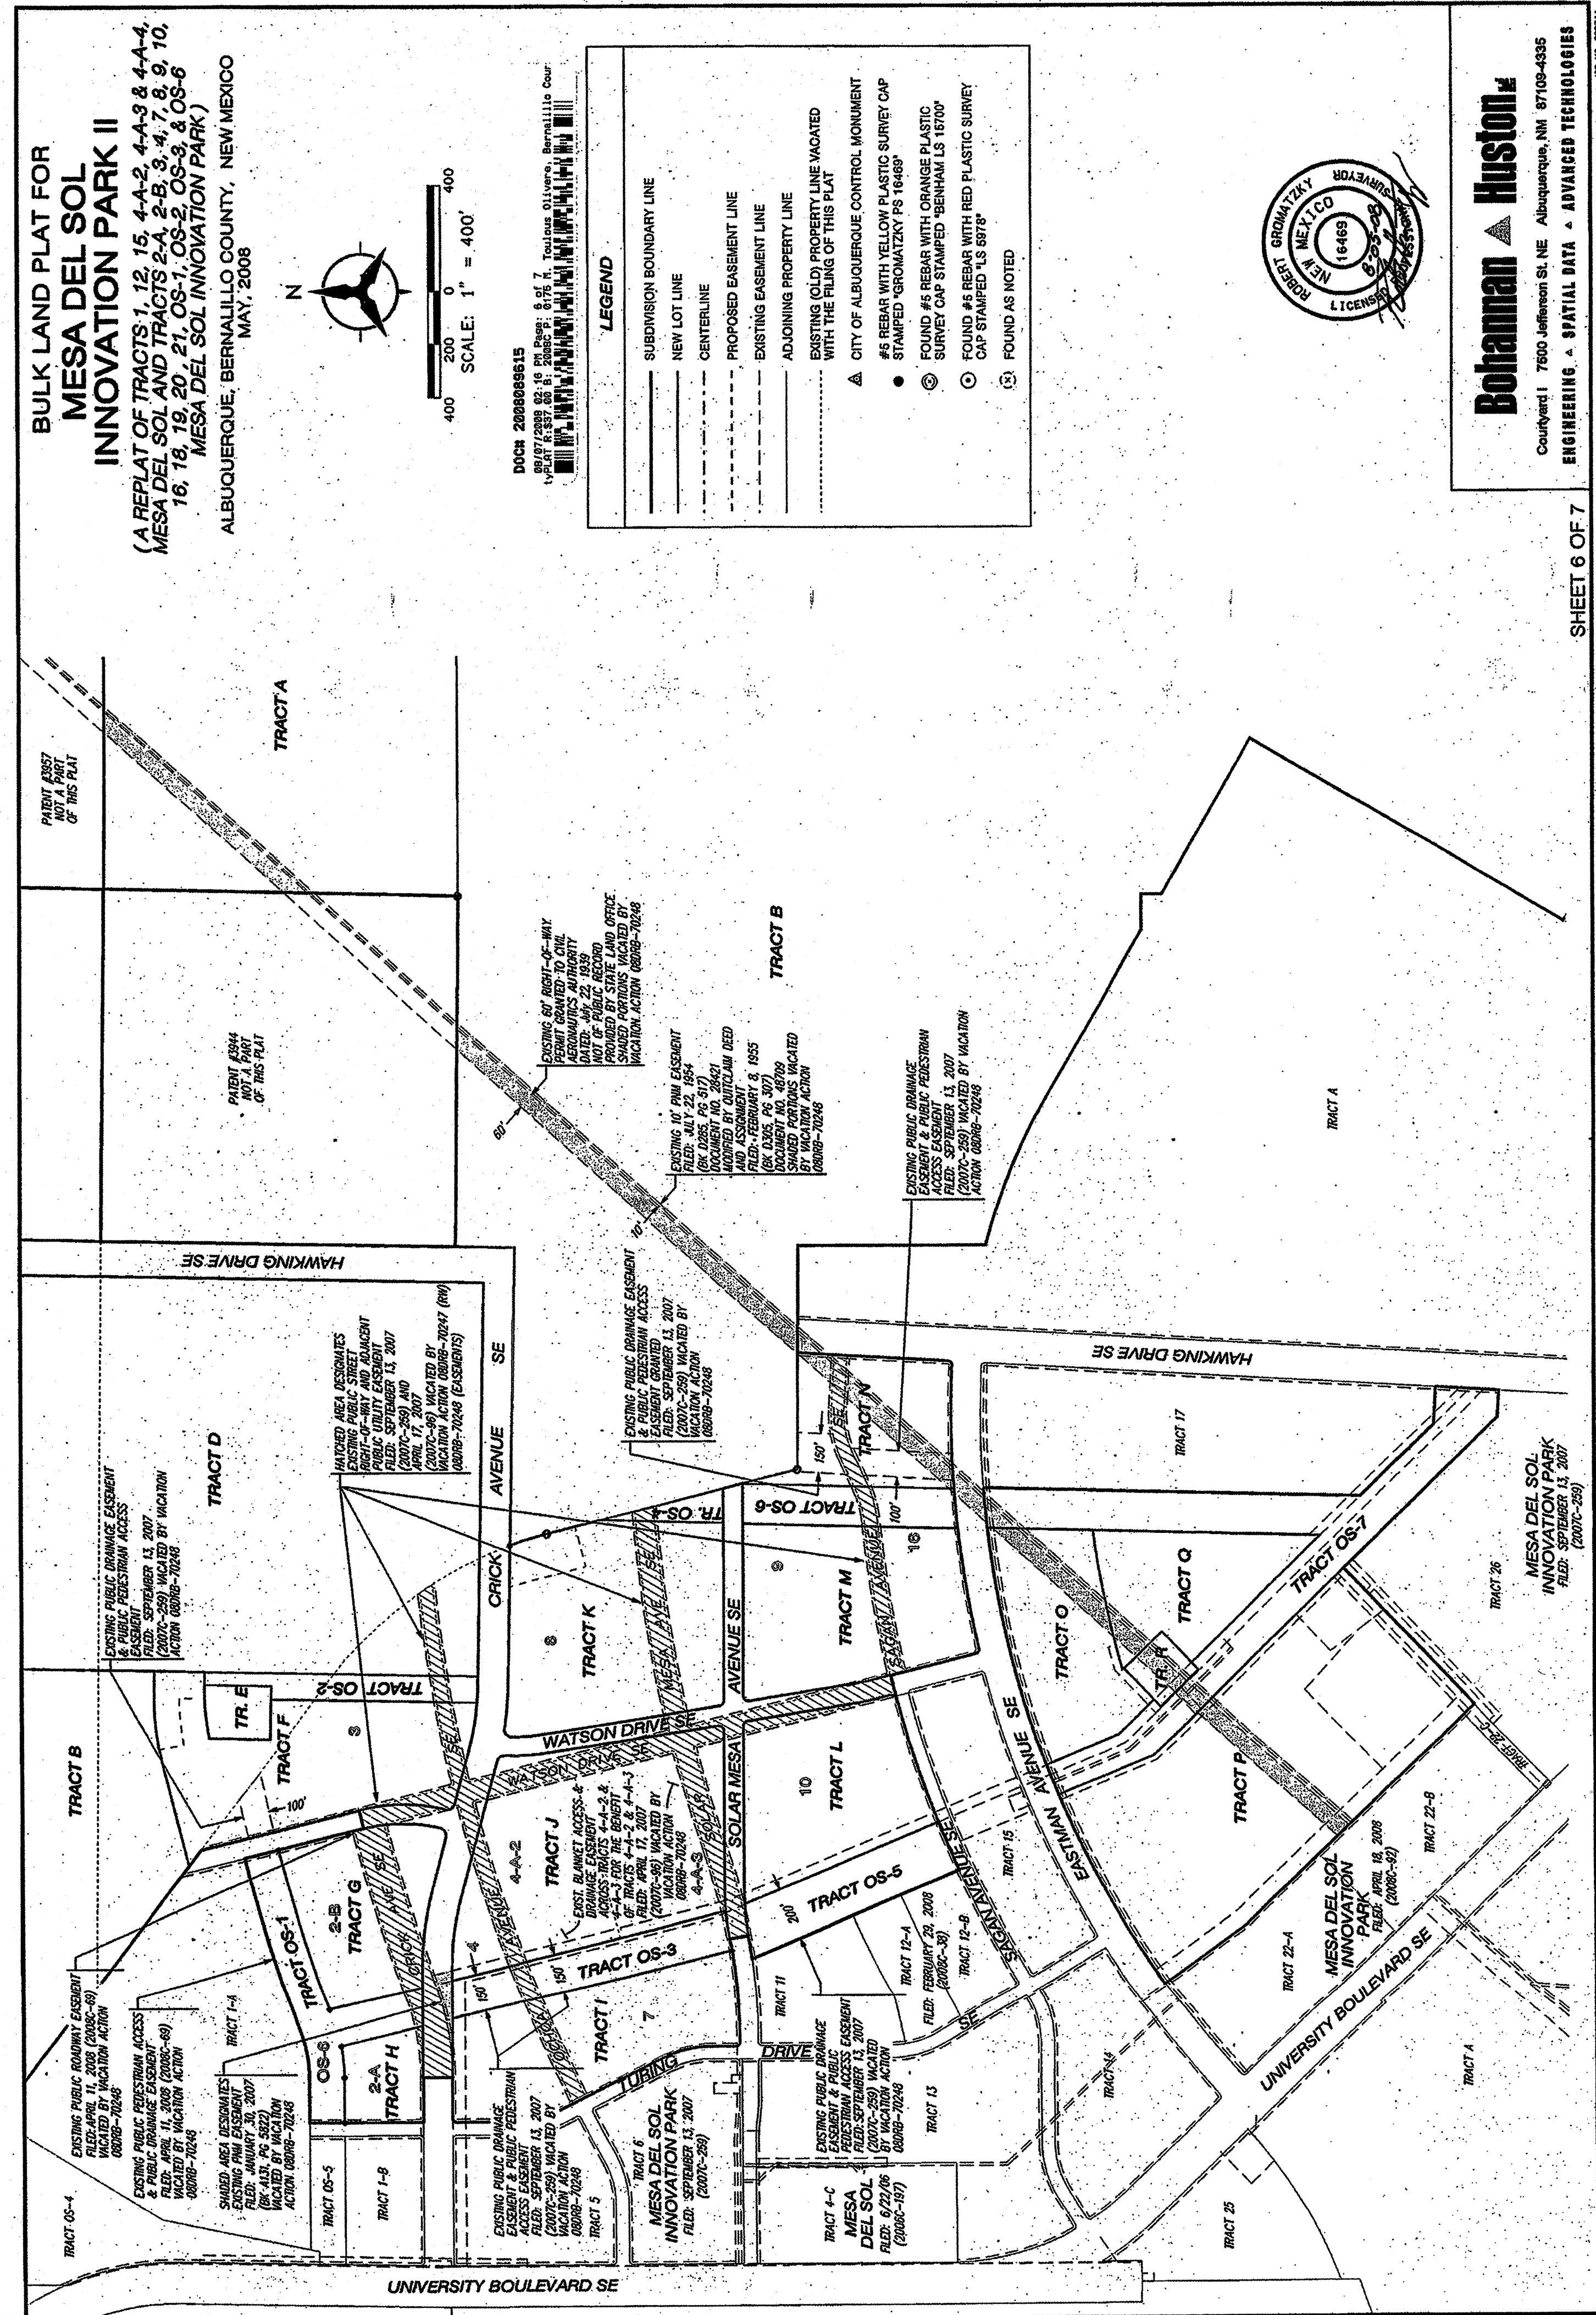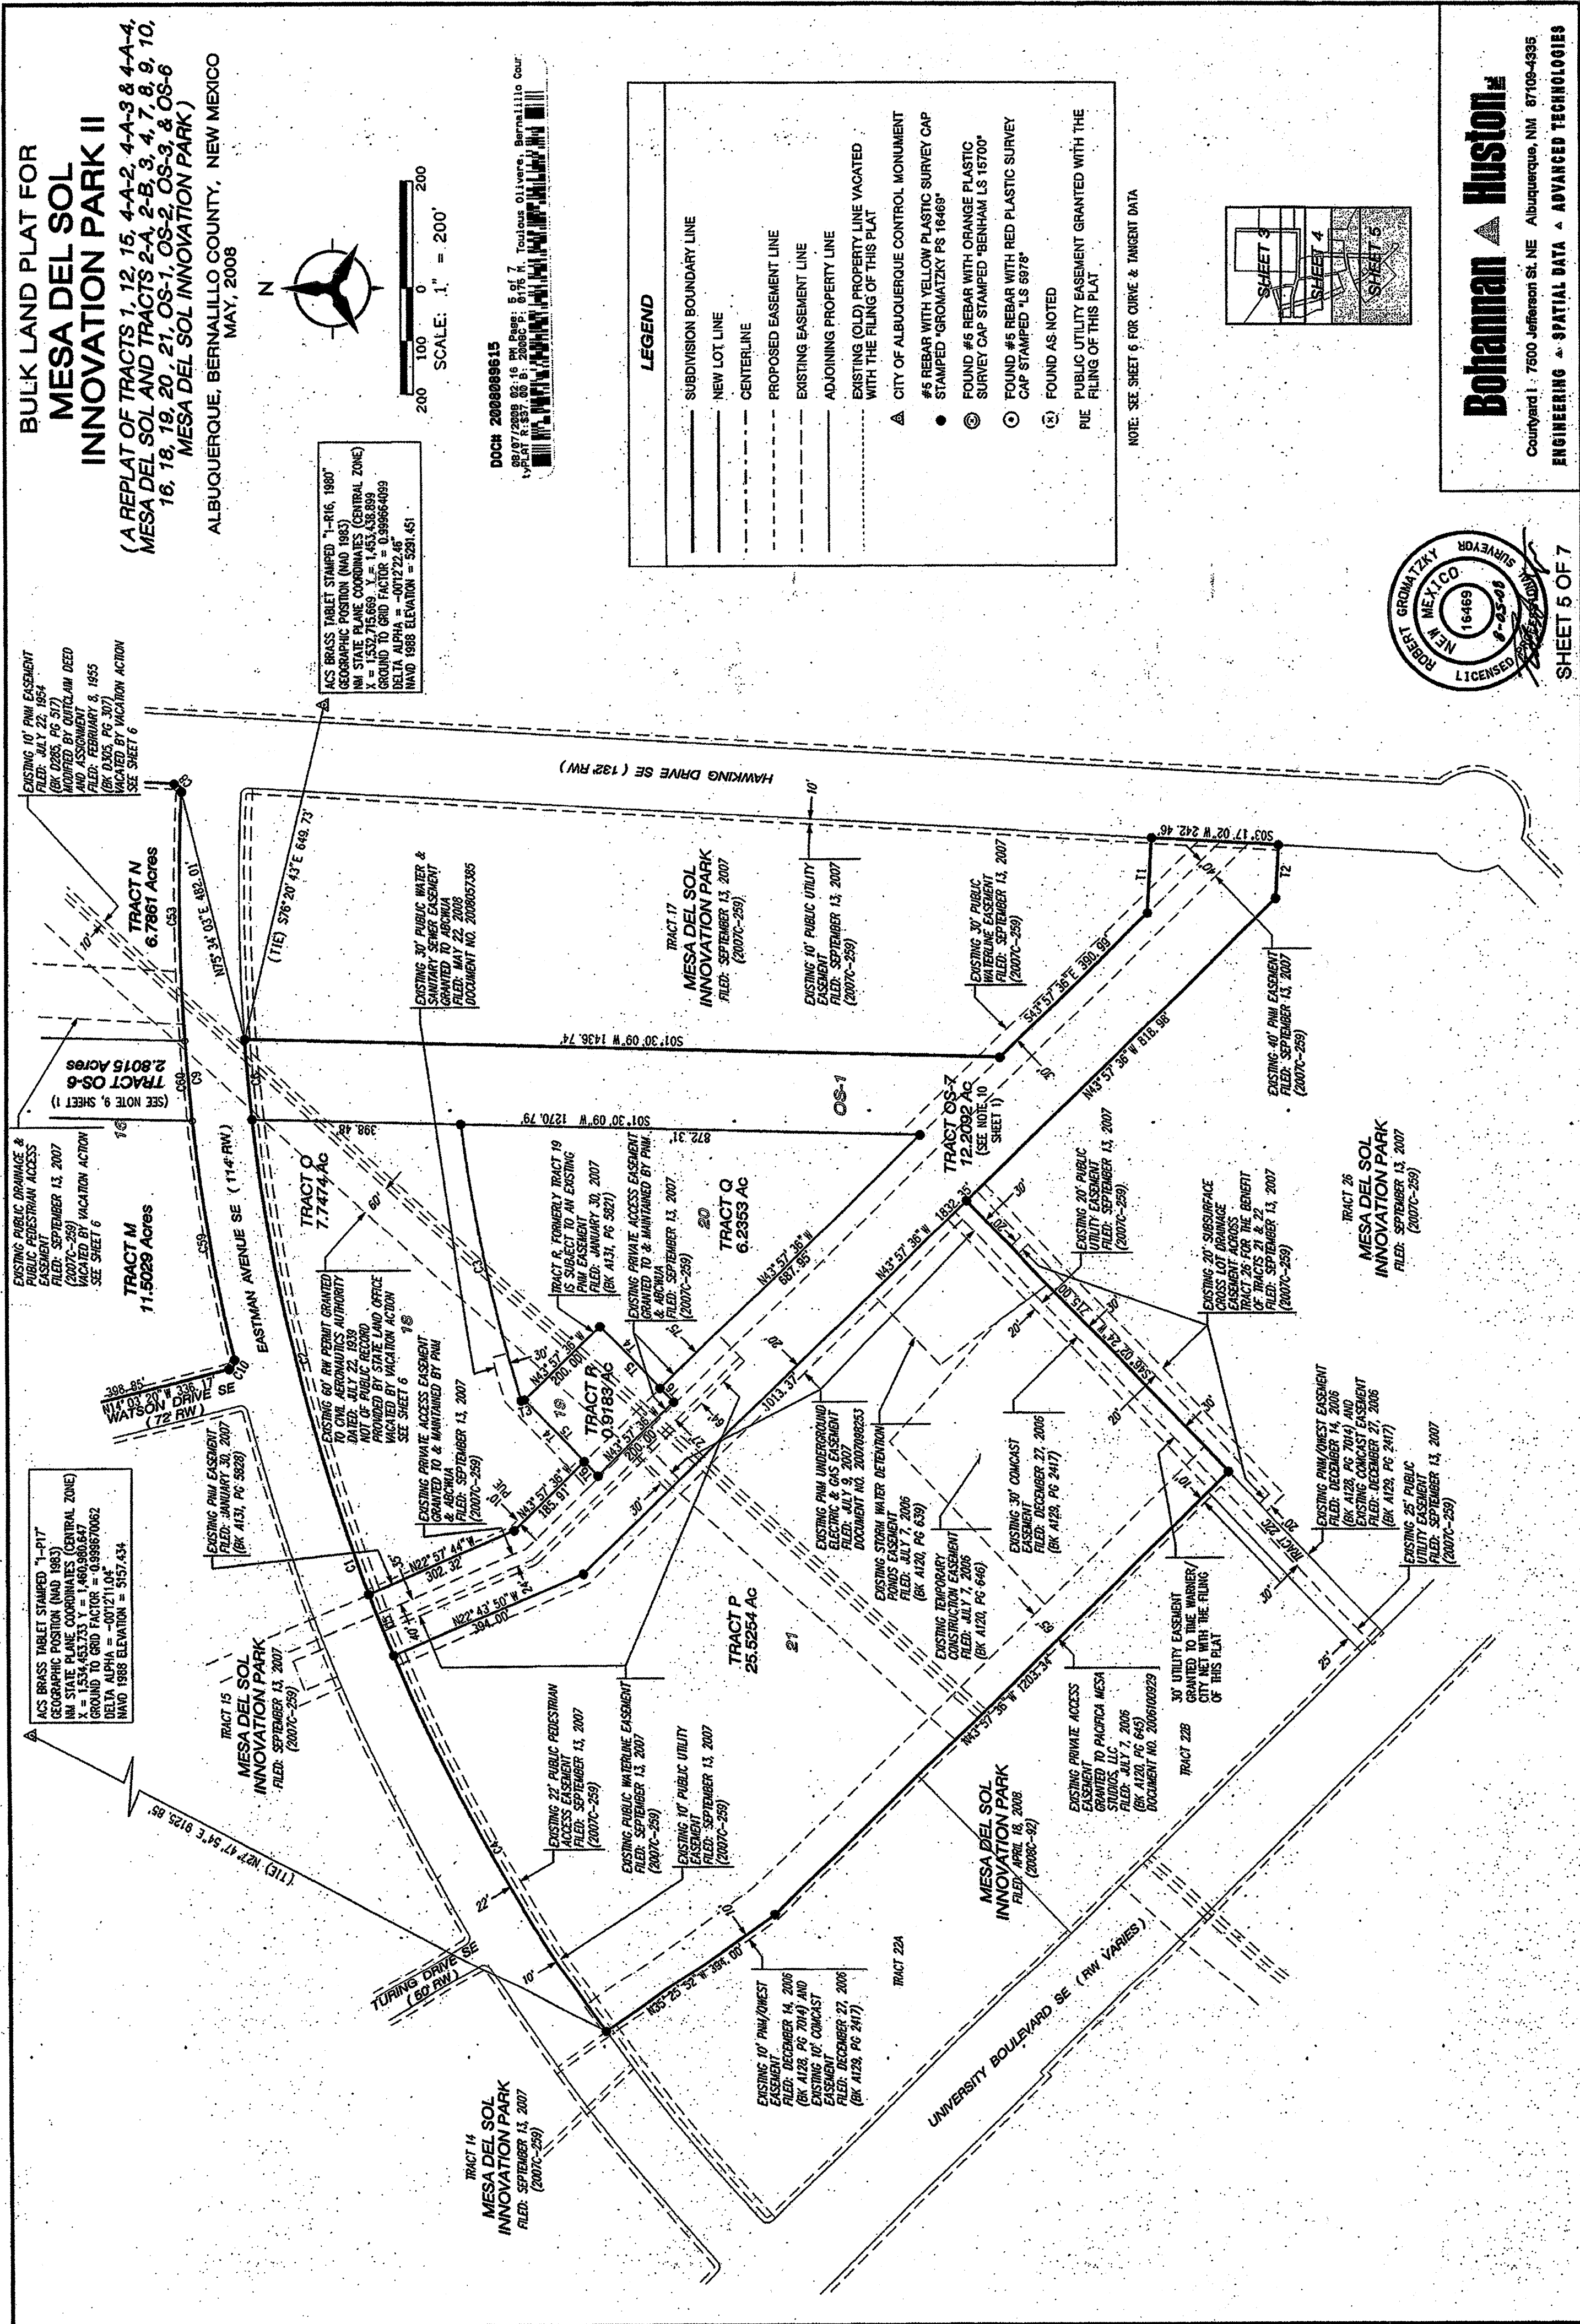

BASIN ID	AREA (sq)	WSL ELV	POND TOP ELEV	POND BOTTOM ELEV	POND VOLUME ac-ft
A	9.2	5296.0	5300.0	5292.0	0.5
C	9.3	5296.0	5298.1	5292.0	0.5
D	9.84	5296.0	5300.0	5292.0	0.5
E	20.14	5295.5	5296.0	5295.0	1.0
J	55.8	5294.0	5296.0	5293.0	8.2
G	4.34	5295.0	5297.5	5291.0	0.5
I	5.47	5292.0	5294.0	5288.0	0.3
K	25.99	5291.0	5293.0	5285.5	1.9
L	16.71	5293.0	5295.5	5286.5	0.8
M	1.33	5299.0	5302.0	5290.0	0.2
N	8.95	5297.0	5301.0	5291.0	0.9
O	5.74	5293.0	5296.0	5289.0	0.3
P	21.06	5297.0	5300.0	5293.0	1.2
Q	3.22	5296.0	5299.0	5293.0	0.2
S	3.19	5291.0	5293.5	5287.0	0.2
T	16.95	5294.0	5295.5	5292.5	0.8



N.T.S.
*CONTRACTOR TO GRADE 8" BELOW TOP OF PAVEMENT ELEVATION
AND TIE BACK TO PROPOSED GRADE AT BACK OF CURB.




N.T.S.

*NOTE: SECTION TAKEN AT "GRADE TO DAYLIGHT"
AREAS OF ROAD AND POND.



PROJECT BENCH MARKS:

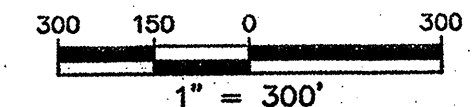


LEGEND


- 100' 200' 300' 400' 500' 600' 700' 800'
- EXISTING CURB & GUTTER
- PROPOSED MOUNTABLE CURB & GUTTER
- PROPOSED STANDARD CURB & GUTTER
- 5470 —
- EXISTING CONTOUR W/ INDEX ELEVATION
- 5470 —
- PROPOSED CONTOUR W/ INDEX ELEVATION
- FLOW ARROW
- PROPOSED SLOPE
- GRADE TO DAYLIGHT

[illegible]

 Bohannon & Huston INC.		Date		Designed By: B.L. Drawn By: Lail Checked By: CJS						
		No.								
Courtyard 7500 Jefferson St NE Albuquerque, NM 87109-4335 ENGINEERING & SPATIAL DATA & ADVANCED TECHNOLOGIES										
 CITY OF ALBUQUERQUE PUBLIC WORKS DEPARTMENT										
MESA DEL SOL INNOVATION PARK OVERALL ROADWAY ROUGH GRADING PLAN										
Design Review Committee	City Engineer Approval	Date	Mo./Day/Yr.	Mo./Day/Yr.						
<i>For Information</i> <i>X only</i>		Last Design Update	<table border="1" style="width: 100%; border-collapse: collapse;"> <tr><td> </td></tr> <tr><td> </td></tr> <tr><td> </td></tr> <tr><td> </td></tr> <tr><td> </td></tr> <tr><td> </td></tr> </table>							
City Project No. 775474	Zone Map No. R-15, R-16	Sheet 3	Of 4							

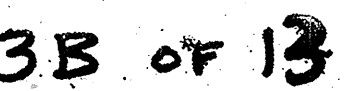



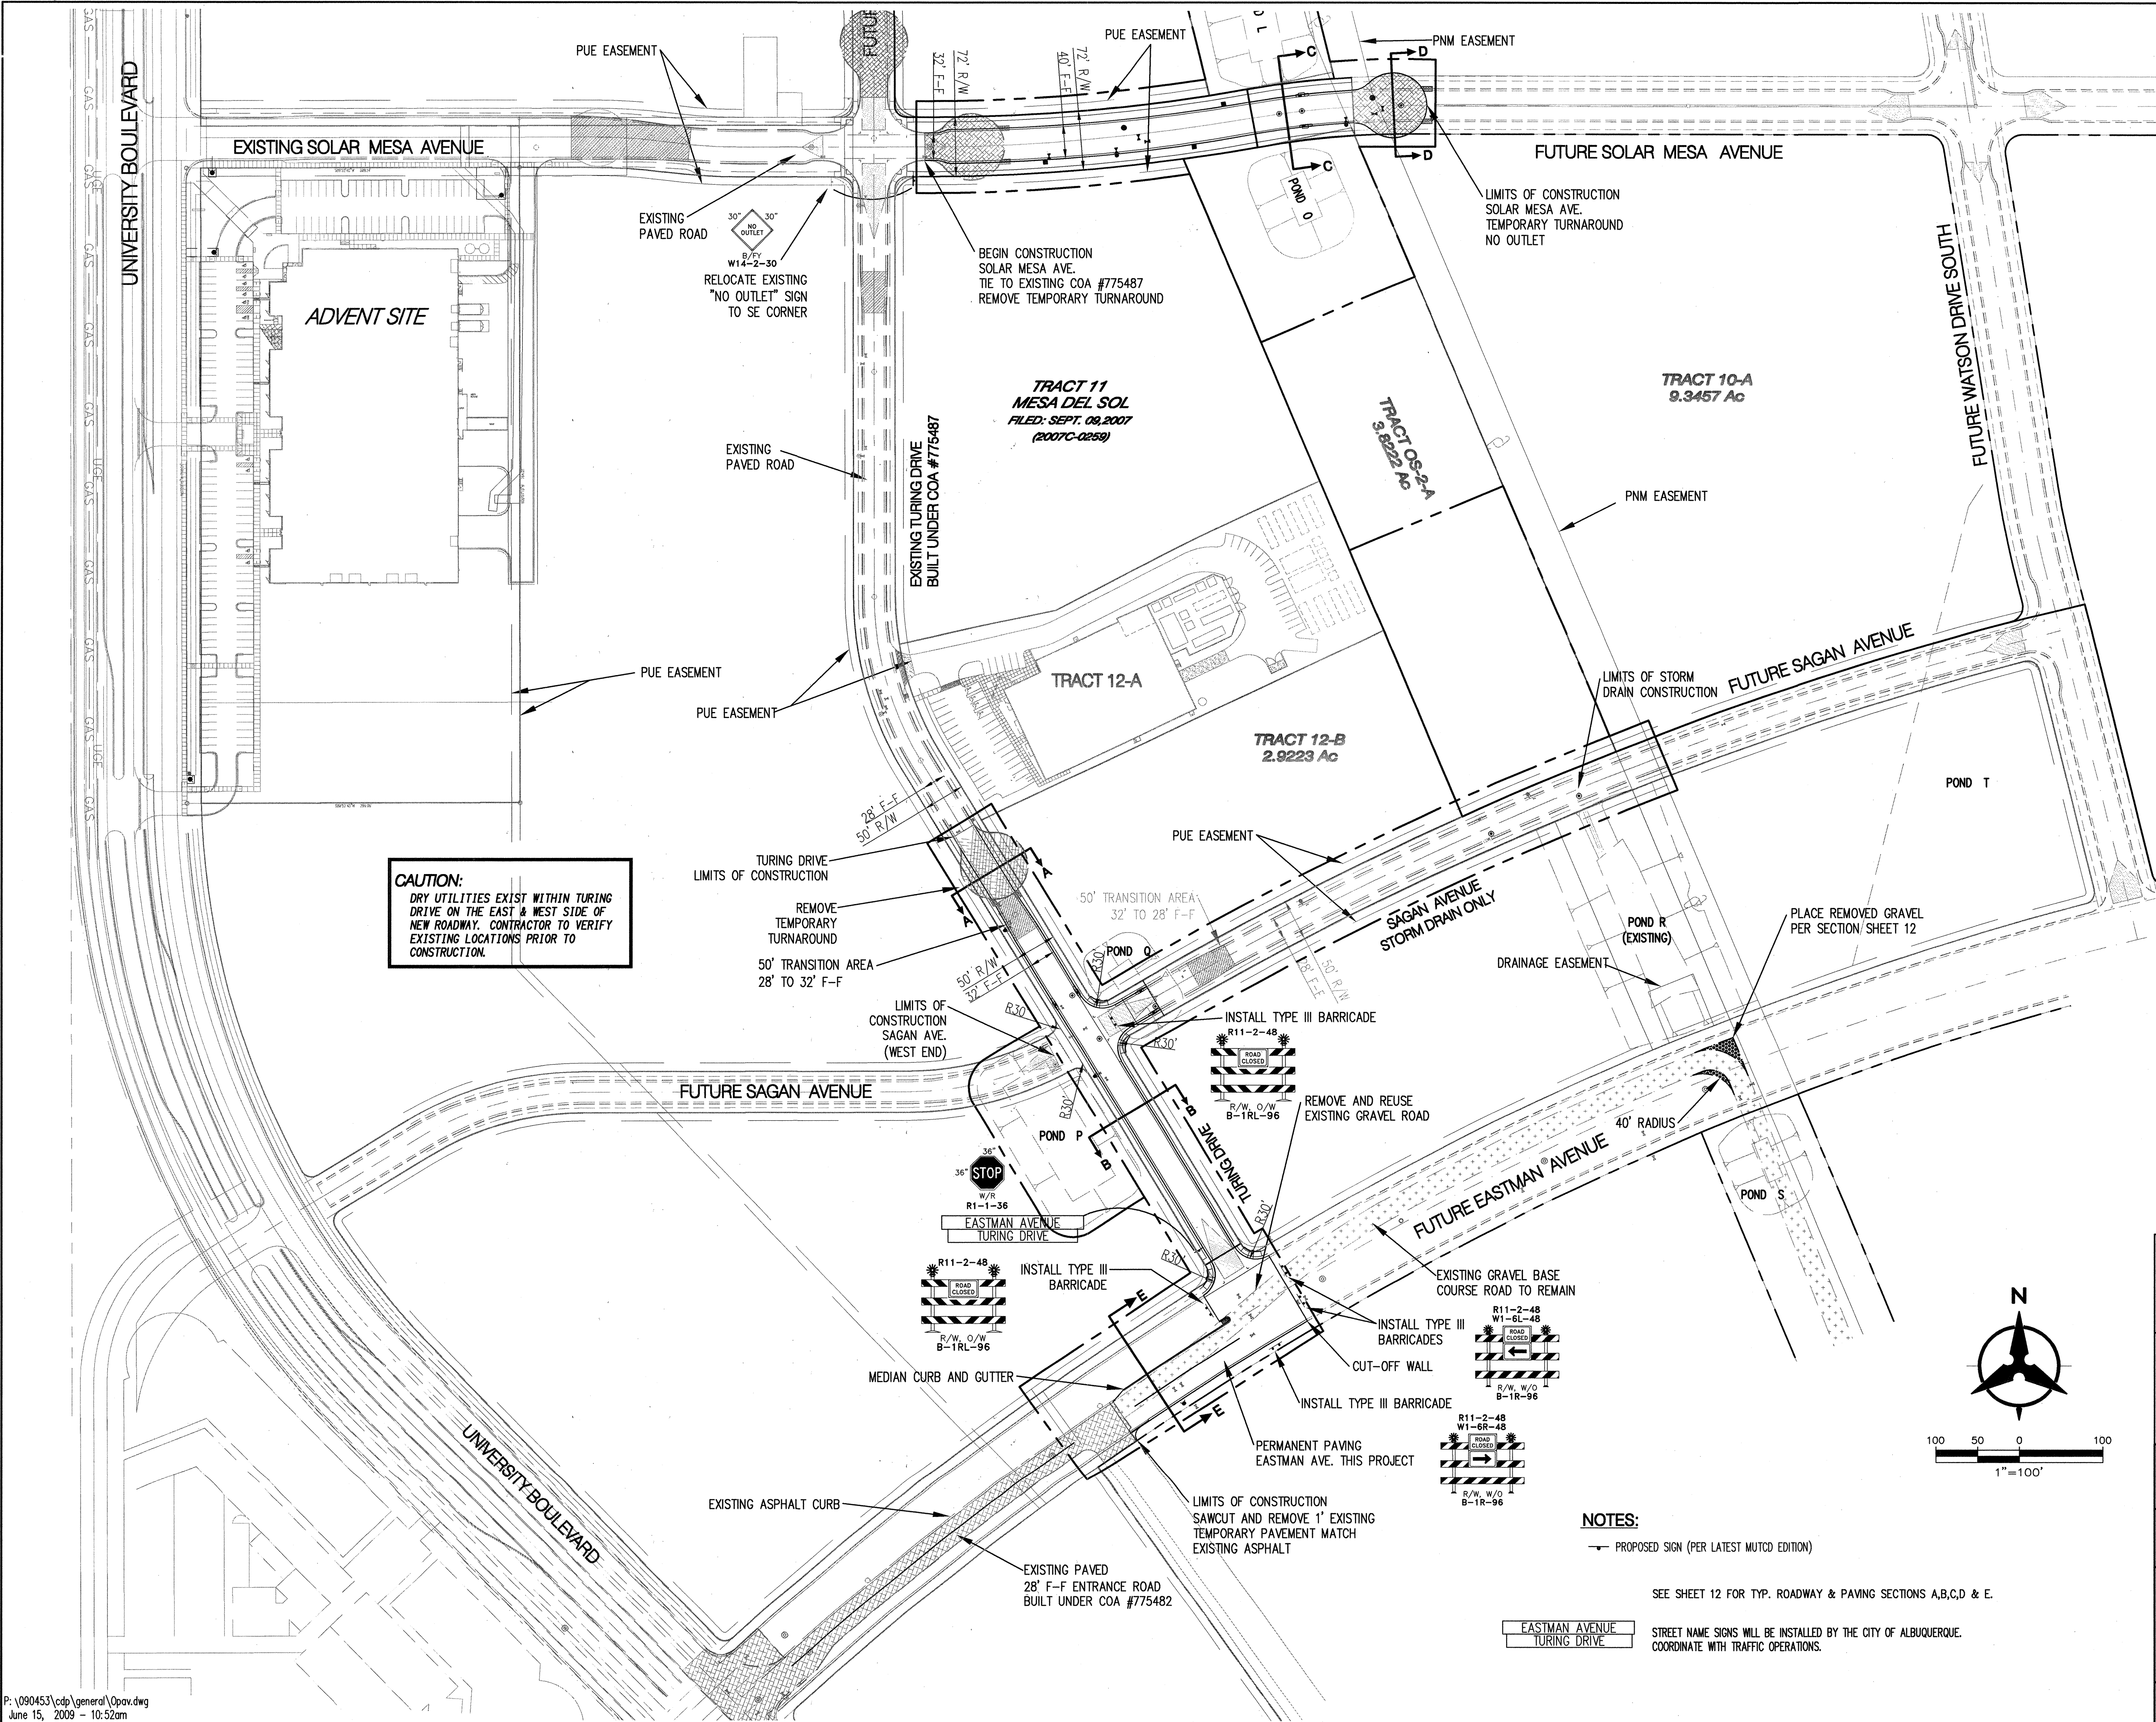

- GENERAL NOTES**
1. THE CONTRACTOR SHALL FIELD VERIFY ALL EXISTING UTILITY LOCATIONS AND NOTIFY THE ENGINEER IMMEDIATELY OF ANY DISCREPANCIES.
 2. ALL CURVE DATA AND DIMENSIONS REFER TO FACE OF CURB UNLESS OTHERWISE SPECIFIED.
 3. GRADE ELEVATIONS, WHERE NOTED, ARE FOR FLOWLINE OF CURB UNLESS OTHERWISE SPECIFIED.
 4. CONTRACTOR IS RESPONSIBLE FOR REPAIR AND/OR REPLACEMENT OF ALL UTILITY CONDUITS AND EXISTING LINES.
 5. ANY ADDITIONAL GRADING REQUIRED TO MATCH PROPOSED STREET GRADES SHALL BE INCIDENTAL TO PAVING ITEMS.
 6. CONTRACTOR SHALL PARK EQUIPMENT AND VEHICLES AS NOT TO INTERFERE WITH NORMAL ACTIVITIES OF RESIDENTS OR OTHER CONTRACTORS ON SITE.
 7. ANY DAMAGE TO THE EXISTING FACILITIES, (C&G), PAVEMENT, CONDUITS, LANDSCAPING, UTILITY LINES, ETC.) DURING CONSTRUCTION SHALL BE REPLACED AT THE CONTRACTORS' EXPENSE.
 8. WHEELCHAIR RAMPS SHALL BE CONSTRUCTED PRIOR TO ACCEPTANCE OF CURB & GUTTER.
 9. FOR CURB RETURN & QUARTER POINT ELEV INFO REFER TO INDIVIDUAL PAVING SHEETS.
 10. MH RIMS & CATCH BASIN INLET ELEVATIONS ARE APPROXIMATE. CONTRACTOR SHALL FIELD VERIFY AND ADJUST TO FINAL PAVEMENT ELEVATIONS.
 11. CONTRACTOR SHALL FIELD VERIFY ALL EXISTING UTILITIES AND TRANSMISSION GAS LINES. CONTRACTOR SHALL COORDINATE RELOCATION OF UTILITY LINES WITH UTILITY COMPANIES AS REQUIRED.
 12. STREET LIGHT LAYOUT AND DESIGN WILL BE BY SEPARATE WORK ORDER.

- LEGEND**
- PROPOSED R/W LINE
 - PROPERTY LINE
 - PROPOSED STANDARD CURB & GUTTER
 - PROPOSED MOUNTABLE CURB & GUTTER
 - EASEMENT
 - PROPOSED STORM DRAIN MANHOLE
 - PROPOSED STORM DRAIN INLET
 - PROPOSED FIRE HYDRANT
 - PROPOSED MAIN VALVE
 - PROPOSED SAS MANHOLE
 - PROPOSED CURB RAMP
 - DENOTES CROWN TRANSITION
 - DENOTES ROADWAY WIDTH TRANSITION
 - DENOTES EXISTING BASE COURSE ROAD

NOTES:


PROPOSED SIGN (PER LATEST MUTCD EDITION)

SEE SHEET 12 FOR TYP. ROADWAY & PAVING SECTIONS A,B,C,D & E.

STREET NAME SIGNS WILL BE INSTALLED BY THE CITY OF ALBUQUERQUE. COORDINATE WITH TRAFFIC OPERATIONS.



ENGINEER'S SEAL										SURVEY INFORMATION		BENCH MARKS		AS-BUILT INFORMATION			
 6-17-09										FIELD NOTES		DATE		DATE		DATE	
										BY							
										NO.		ACS BRASS TABLE STAMPED "1-R16, 1984"		CONTRACTOR <u>Franklin's</u>		DATE <u>6-1/09</u>	
												GEOGRAPHIC POSITION (NAD 83)		INSPECTOR'S		DATE <u>6-1/09</u>	
												N.M. STATE PLANE COORDINATES (CENTRAL ZONE)		ACCEPTANCE BY <u>Booth + Lewis</u>		DATE <u>6-1/09</u>	
										No. Date		X = 1,532,715.669 Y = 1,453,438.899		RECORDATION BY <u>Christian Shultz</u>		DATE <u>6-1/09</u>	
										REVISIONS		GROUND-TO-GRID FACTOR = 0.999664099		DRAWINGS		DATE <u>6-1/09</u>	
										DESIGN		$\Delta\alpha = -00^{\circ}12'22.46''$		CORRECTED BY <u>Christian Shultz</u>		DATE <u>6-1/09</u>	
										Designed By: <u>CJS</u>		NAVD 1988 ELEVATION = 5291.451		MICROFILM INFORMATION		RECORDED BY	
										Drawn By: <u>LJM</u>				NO.		DATE	
										Checked By: <u>CJS</u>							
										DATE: 06/03/09							
										DATE: 06/03/09							
										DATE: 06/03/09							

ERQUE MENT														
INFRASTRUCTURE														
D														
Mo./Day/Yr.					Mo./Day/Yr.									
Sheet					Of									
16					4					13				

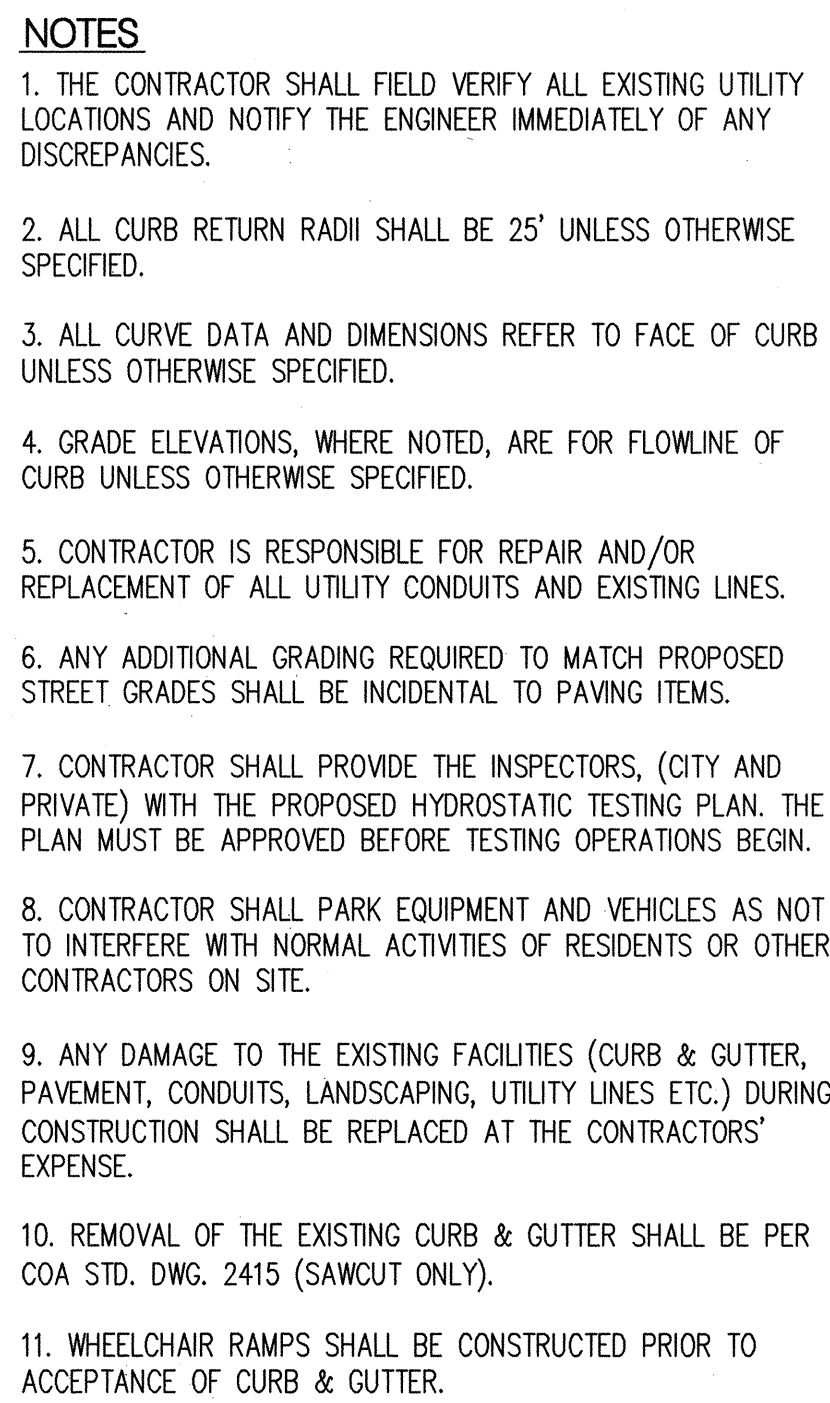

FLOWLINE POINT TABLE			
○	EASTING	NORTHING	ELEVATION
1	1530772.12	1453443.75	5303.10
2	1530775.28	1453460.49	5302.33
3	1530786.25	1453467.94	5302.37
4	1530880.13	1453529.64	5301.25
5	1530975.81	1453588.49	5299.73
11	1530928.91	1453668.85	5299.59
12	1530851.92	1453618.24	5300.81
13	1530870.61	1453587.50	5304.66
14	1530878.80	1453592.65	5301.63
15	1530882.91	1453591.65	5301.60
16	1530881.92	1453587.53	5303.53
17	1530818.71	1453547.18	5302.63
18	1530756.26	1453505.60	5304.47
19	1530743.22	1453490.65	5303.34

Certification
THE CHANGES SHOWN HEREON ARE BASED UPON A
FIELD SURVEY CONDUCTED BY ME OR UNDER MY
SUPERVISION AND REFLECT THE LOCATIONS
(VERTICALLY AND HORIZONTALLY) TO THE BEST OF
MY KNOWLEDGE AND BELIEF.

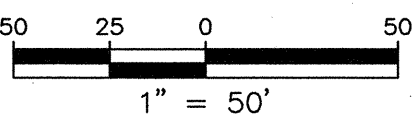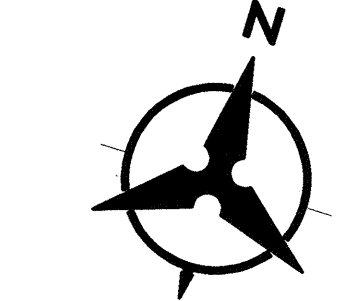


SURVEY INFORMATION		BENCH MARKS		AS-BUILT INFORMATION	
FIELD NOTES					
NO.	BY	DATE		CONTRACTOR	DATE
			ACS BRASS TABLET STAMPED "1-R16, 1984"	Franklin's Inc.	10/1/10
			GEOGRAPHIC POSITION (NAD 83)	MADE BY	DATE
			N.M. STATE PLANE COORDINATES (CENTRAL ZONE)	RECEIVED BY	DATE
			X = 1,532,715.669 Y = 1,453,438.899	FIELD SKETCH BY	DATE
			GROUND-TO-GRID FACTOR = 0.999664099	ADJUSTED BY	DATE
			Δm = -00'12'22.46"	RECORDED BY	DATE
			NAD 1988 ELEVATION = 5291.451	NO.	
				MICROFILM INFORMATION	
				DATE	1/10

							ENGINEER'S SEAL
							6-17-09
No.	Date					By	
REVISIONS							
DESIGN							
Designed By:			CJS	DATE:		04/07/09	
Drawn By:			Lsl	DATE:		04/07/09	
Checked By:			CJS	DATE:		04/07/09	

ERQUE MENT	
INFRASTRUCTURE	
E	
Mo./Day/Yr.	Mo./Day/Yr.

6	Sheet	Of	5	13
---	-------	----	---	----

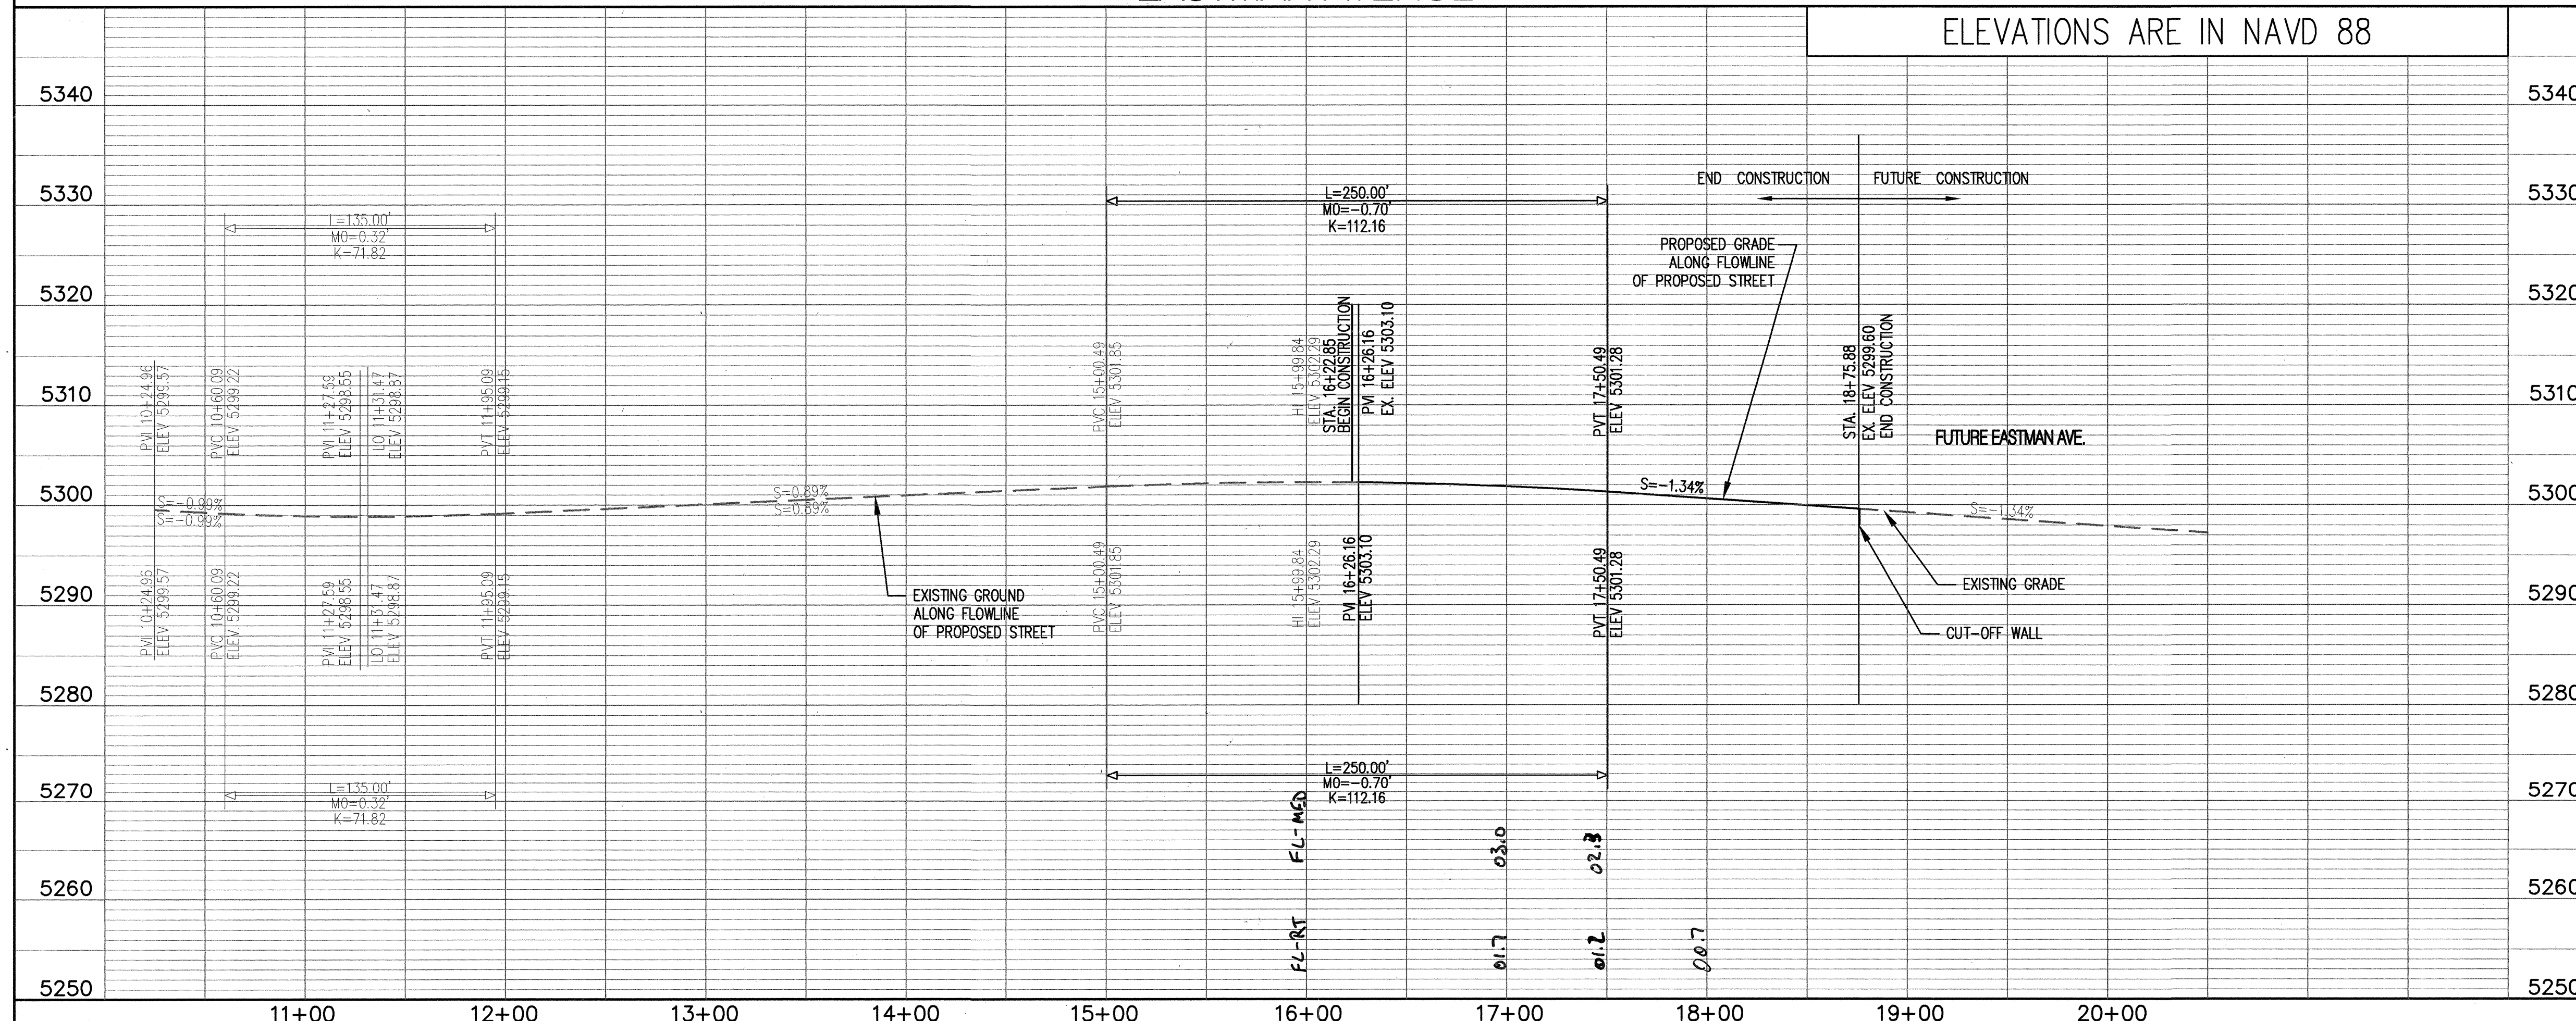

P:\090453\cdp\pnp\Pnp01-Eastman.dwg
June 17, 2009 - 10:30am

SCALE: $1'' = 50'$ (HORIZ.)
 $1'' = 10'$ (VERT.)

Mesa del Sol

Bohannon  Huston INC.
Courtyard I 7600 Jefferson St. NE Albuquerque, NM 87109-4335
ENGINEERING ▲ SPATIAL DATA ▲ ADVANCED TECHNOLOGIES


CITY OF ALBUQUERQUE
PUBLIC WORKS DEPARTMENT

TRACT 11 AT MESA DEL SOL, GSA INFRASTRUCTURE
EASTMAN AVENUE
PAVING PLAN AND PROFILE

Design Review Committee

APPROVED

JUL 01 2009

DESIGN
REVIEW COMMITTEE

City Engineer Approval


APPROVED


JUL 21 2009

CITY ENGINEER

Don't Decide Yet

City Project No.	Zone Map No.	Sheet	Of
775478	R15 - R16	5	13

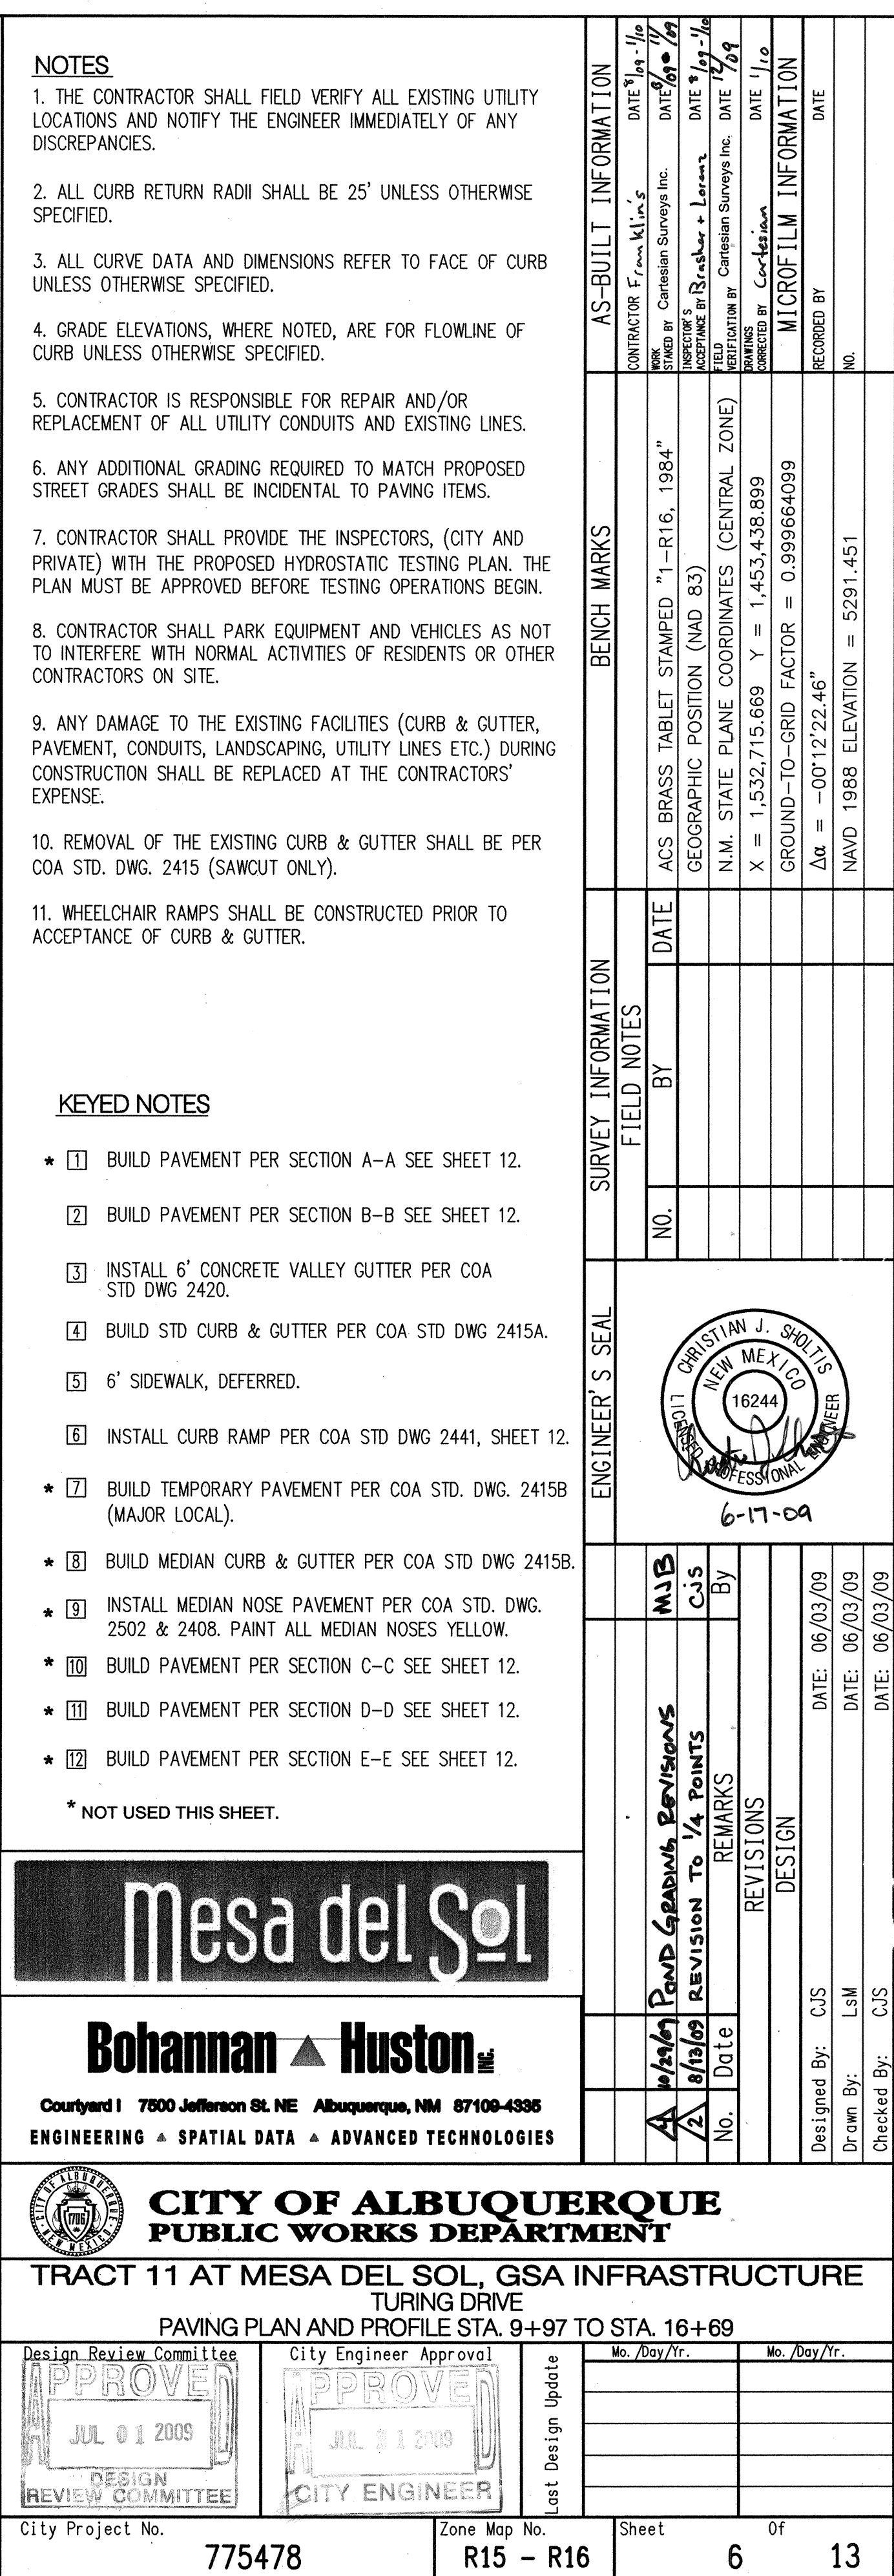

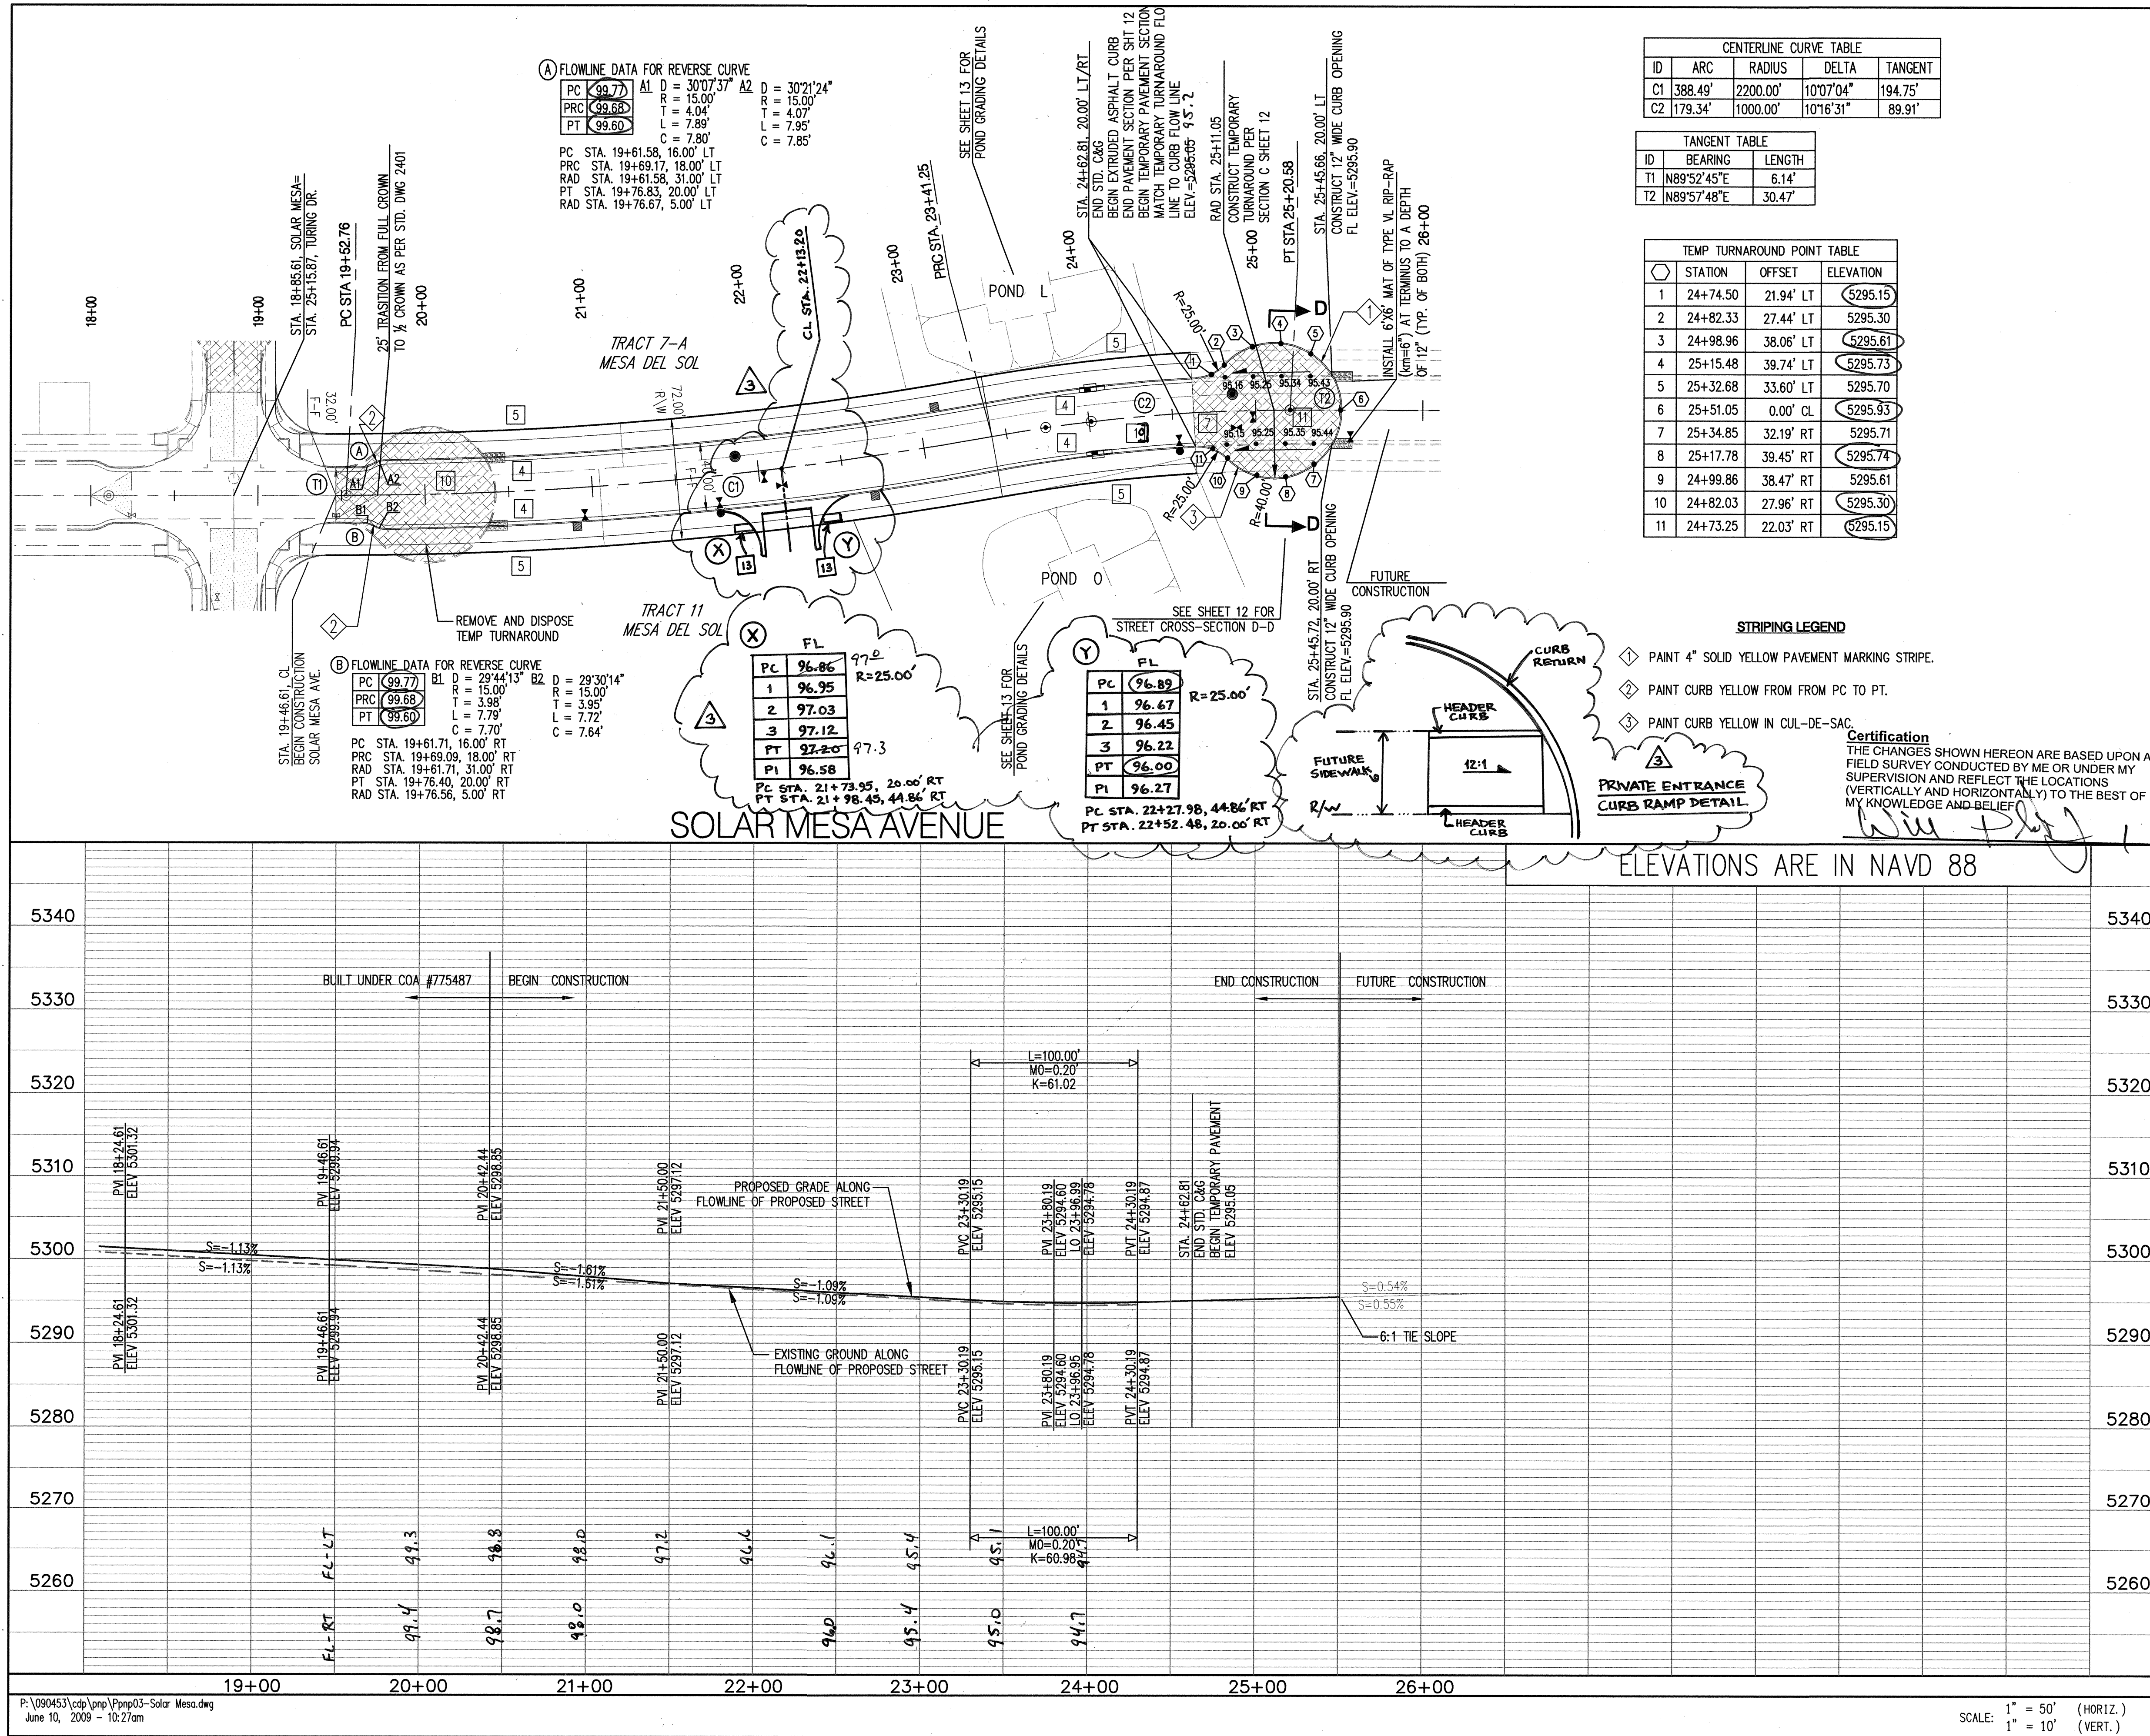

NOTES

- THE CONTRACTOR SHALL FIELD VERIFY ALL EXISTING UTILITY LOCATIONS AND NOTIFY THE ENGINEER IMMEDIATELY OF ANY DISCREPANCIES.
- ALL CURB RETURN RADI SHALL BE 25' UNLESS OTHERWISE SPECIFIED.
- ALL CURVE DATA AND DIMENSIONS REFER TO FACE OF CURB UNLESS OTHERWISE SPECIFIED.
- GRADE ELEVATIONS, WHERE NOTED, ARE FOR FLOWLINE OF CURB UNLESS OTHERWISE SPECIFIED.
- CONTRACTOR IS RESPONSIBLE FOR REPAIR AND/OR REPLACEMENT OF ALL UTILITY CONDUITS AND EXISTING LINES.
- ANY ADDITIONAL GRADING REQUIRED TO MATCH PROPOSED STREET GRADES SHALL BE INCIDENTAL TO PAVING ITEMS.
- CONTRACTOR SHALL PROVIDE THE INSPECTORS, (CITY AND PRIVATE) WITH THE PROPOSED HYDROSTATIC TESTING PLAN. THE PLAN MUST BE APPROVED BEFORE TESTING OPERATIONS BEGIN.
- CONTRACTOR SHALL PARK EQUIPMENT AND VEHICLES AS NOT TO INTERFERE WITH NORMAL ACTIVITIES OF RESIDENTS OR OTHER CONTRACTORS ON SITE.
- ANY DAMAGE TO THE EXISTING FACILITIES (CURB & GUTTER, PAVEMENT, CONDUITS, LANDSCAPING, UTILITY LINES ETC.) DURING CONSTRUCTION SHALL BE REPLACED AT THE CONTRACTORS' EXPENSE.
- REMOVAL OF THE EXISTING CURB & GUTTER SHALL BE PER COA STD. DWG. 2415 (SAW CUT ONLY).
- WHEELCHAIR RAMPS SHALL BE CONSTRUCTED PRIOR TO ACCEPTANCE OF CURB & GUTTER.

KEYED NOTES

- BUILD PAVEMENT PER SECTION A-A SEE SHEET 12.
- BUILD PAVEMENT PER SECTION B-B SEE SHEET 12.
- INSTALL 6" CONCRETE VALLEY GUTTER PER COA STD DWG 2420.
- BUILD STD CURB & GUTTER PER COA STD DWG 2415A.
- 6" SIDEWALK, DEFERRED.
- INSTALL CURB RAMP PER COA STD DWG 2441, SHEET 12.
- BUILD TEMPORARY PAVEMENT PER COA STD. DWG. 2415B (MAJOR LOCAL).
- BUILD MEDIAN CURB & GUTTER PER COA STD DWG 2415B.
- INSTALL MEDIAN NOSE PAVEMENT PER COA STD. DWG. 2502 & 2408. PAINT ALL MEDIAN NOSES YELLOW.
- BUILD PAVEMENT PER SECTION C-C SEE SHEET 12.
- BUILD PAVEMENT PER SECTION D-D SEE SHEET 12.
- BUILD PAVEMENT PER SECTION E-E SEE SHEET 12.
- BUILD PRIVATE ENTRANCE CURB RAMP. NOT USED THIS SHEET. (PER DETAIL THIS SHEET)

DESIGNER'S SEAL

Bohannon & Huston

Courtyard 1 7500 Jefferson St. NE Albuquerque, NM 87109-4395
ENGINEERING • SPATIAL DATA • ADVANCED TECHNOLOGIES

CITY OF ALBUQUERQUE
PUBLIC WORKS DEPARTMENT

TRACT 11 AT MESA DEL SOL, GSA INFRASTRUCTURE
SOLAR MESA AVENUE
PAVING PLAN AND PROFILE STA. 19+50 TO STA. 25+50


APPROVED
JUL 01 2009
DESIGN REVIEW COMMITTEE

APPROVED
JUL 31 2009
CITY ENGINEER

REVISIONS

No.	Date	By	Remarks
1	06/03/09	CJS	DESIGN
2	06/03/09	Lsm	REVISIONS
3	06/03/09	CJS	REVISIONS

City Project No. **775478** Zone Map No. **R15 - R16** Sheet **7** Of **13**

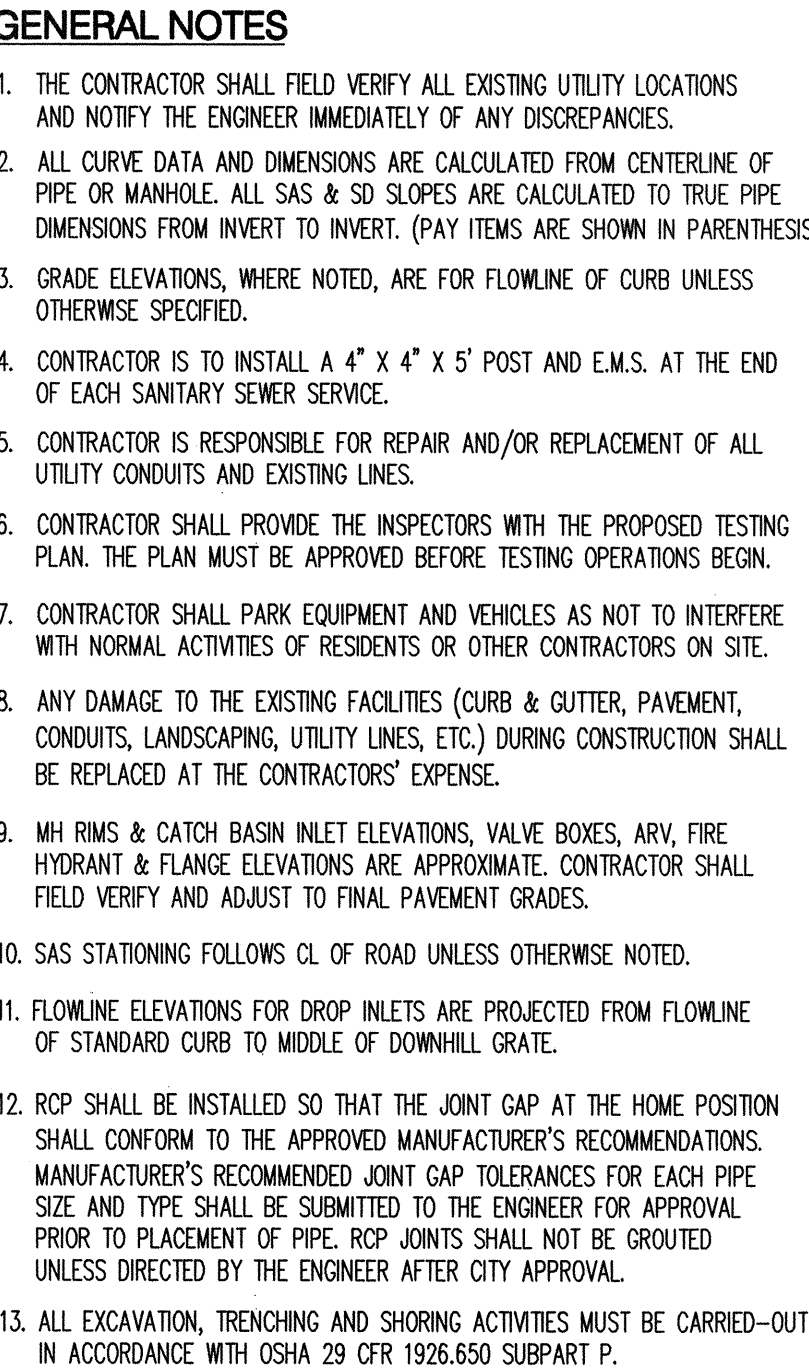

<u>LEGEND</u>	
_____	PROPERTY LINE
_____	NEW EASEMENT
SAS _____	EXISTING SANITARY SEWER
W _____	EXISTING WATER LINE
_____	EXISTING STORM DRAIN
	EXISTING WATER METER
	EXISTING CAP
	EXISTING VALVE
	EXISTING FIRE HYDRANT
	EXISTING SANITARY SEWER MANHOLE
(O) _____	EXISTING STORM DRAIN
SAS _____	PROPOSED SANITARY SEWER
WL _____	PROPOSED WATER LINE
	PROPOSED VALVE
	PROPOSED HYDRANT
	PROPOSED CAP
	PROPOSED WATER METER
● _____	PROPOSED SANITARY SEWER MANHOLE
○ _____	PROPOSED STORM DRAIN

ENGINEER'S SEAL		SURVEY INFORMATION		BENCH MARKS		AS-BUILT INFORMATION	
		FIELD NOTES		ACS BRASS TABLET STAMPED "1-R16, 1984" GEOGRAPHIC POSITION (NAD 83) N.M. STATE PLANE COORDINATES (CENTRAL ZONE) X = 1,532,715.669 Y = 1,453,438.899 GROUND-TO-GRID FACTOR = 0.999664099 $\Delta\alpha = -00^{\circ}12'22.46"$		CONTRACTOR Frank & Sons DRAWN BY C. Sholtis DATE 12/09 MICROFILM INFORMATION RECORDED BY DATE NO.	
		NO.	BY				
No.	Date	REMARKS	By				
REVISIONS							
DESIGN							
Designed By: CJS				DATE: 06/03/09			
Drawn By: LSH				DATE: 06/03/09			
Checked By: CJS				DATE: 06/03/09			


ROQUE MENT

INFRASTRUCTURE

Mo./Day/Yr.

Mo./Day/Yr.

Sheet 8 Of 13

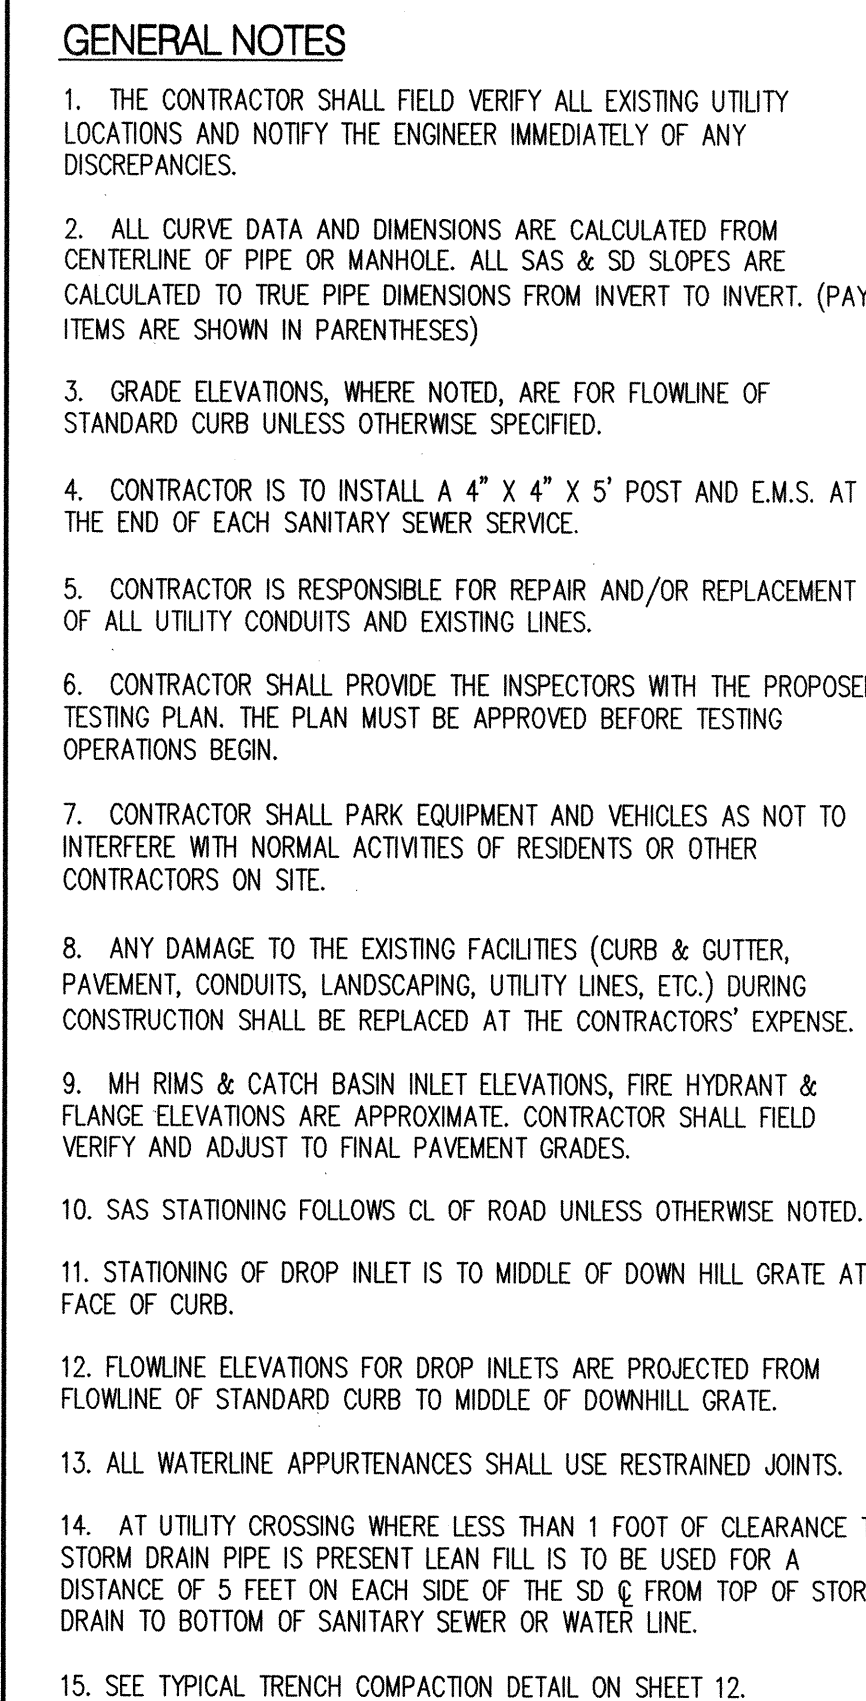

Certification
THE CHANGES SHOWN HEREON ARE BASED UPON A
FIELD SURVEY CONDUCTED BY ME OR UNDER MY
SUPERVISION AND REFLECT THE LOCATIONS
(VERTICALLY AND HORIZONTALLY) TO THE BEST OF
MY KNOWLEDGE AND BELIEF.

Wm. F. J.
IN NAVD 88


LEGEND

- | | |
|---|--------------------------|
|  | DOUBLE WATER METER |
|  | SINGLE WATER METER |
|  | WATER LINE SHUTOFF VALVE |
|  | WATER LINE TEE |
|  | SAS LATERAL |
|  | SAS MANHOLE |
|  | STORM DRAIN MANHOLE |
|  | STORM DRAIN INLET |
|  | PROPOSED FIRE HYDRANT |
|  | EXISTING WATER VALVE |

Mesa del Sol


Bohannon Huston

Courtyard | 7500 Jefferson St. NE Albuquerque, NM 87109-4335
ENGINEERING ▲ SPATIAL DATA ▲ ADVANCED TECHNOLOGIES

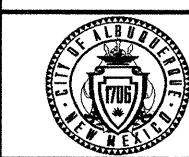

CITY OF ALBUQUERQUE
PUBLIC WORKS DEPARTMENT

TRACT 11 AT MESA DEL SOL, GSA INFRASTRUCTURE
TURING DRIVE
UTILITY PLAN AND PROFILE STA. 10+00 TO STA. 21+00

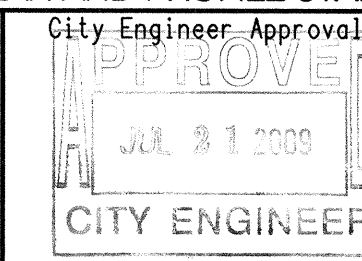

City Project No.


Zone Map No.

775478

R15 - R16

Sheet 9 of 13

SCALE: $1'' = 50'$ (HORIZ.)
 $1'' = 10'$ (VERT.)

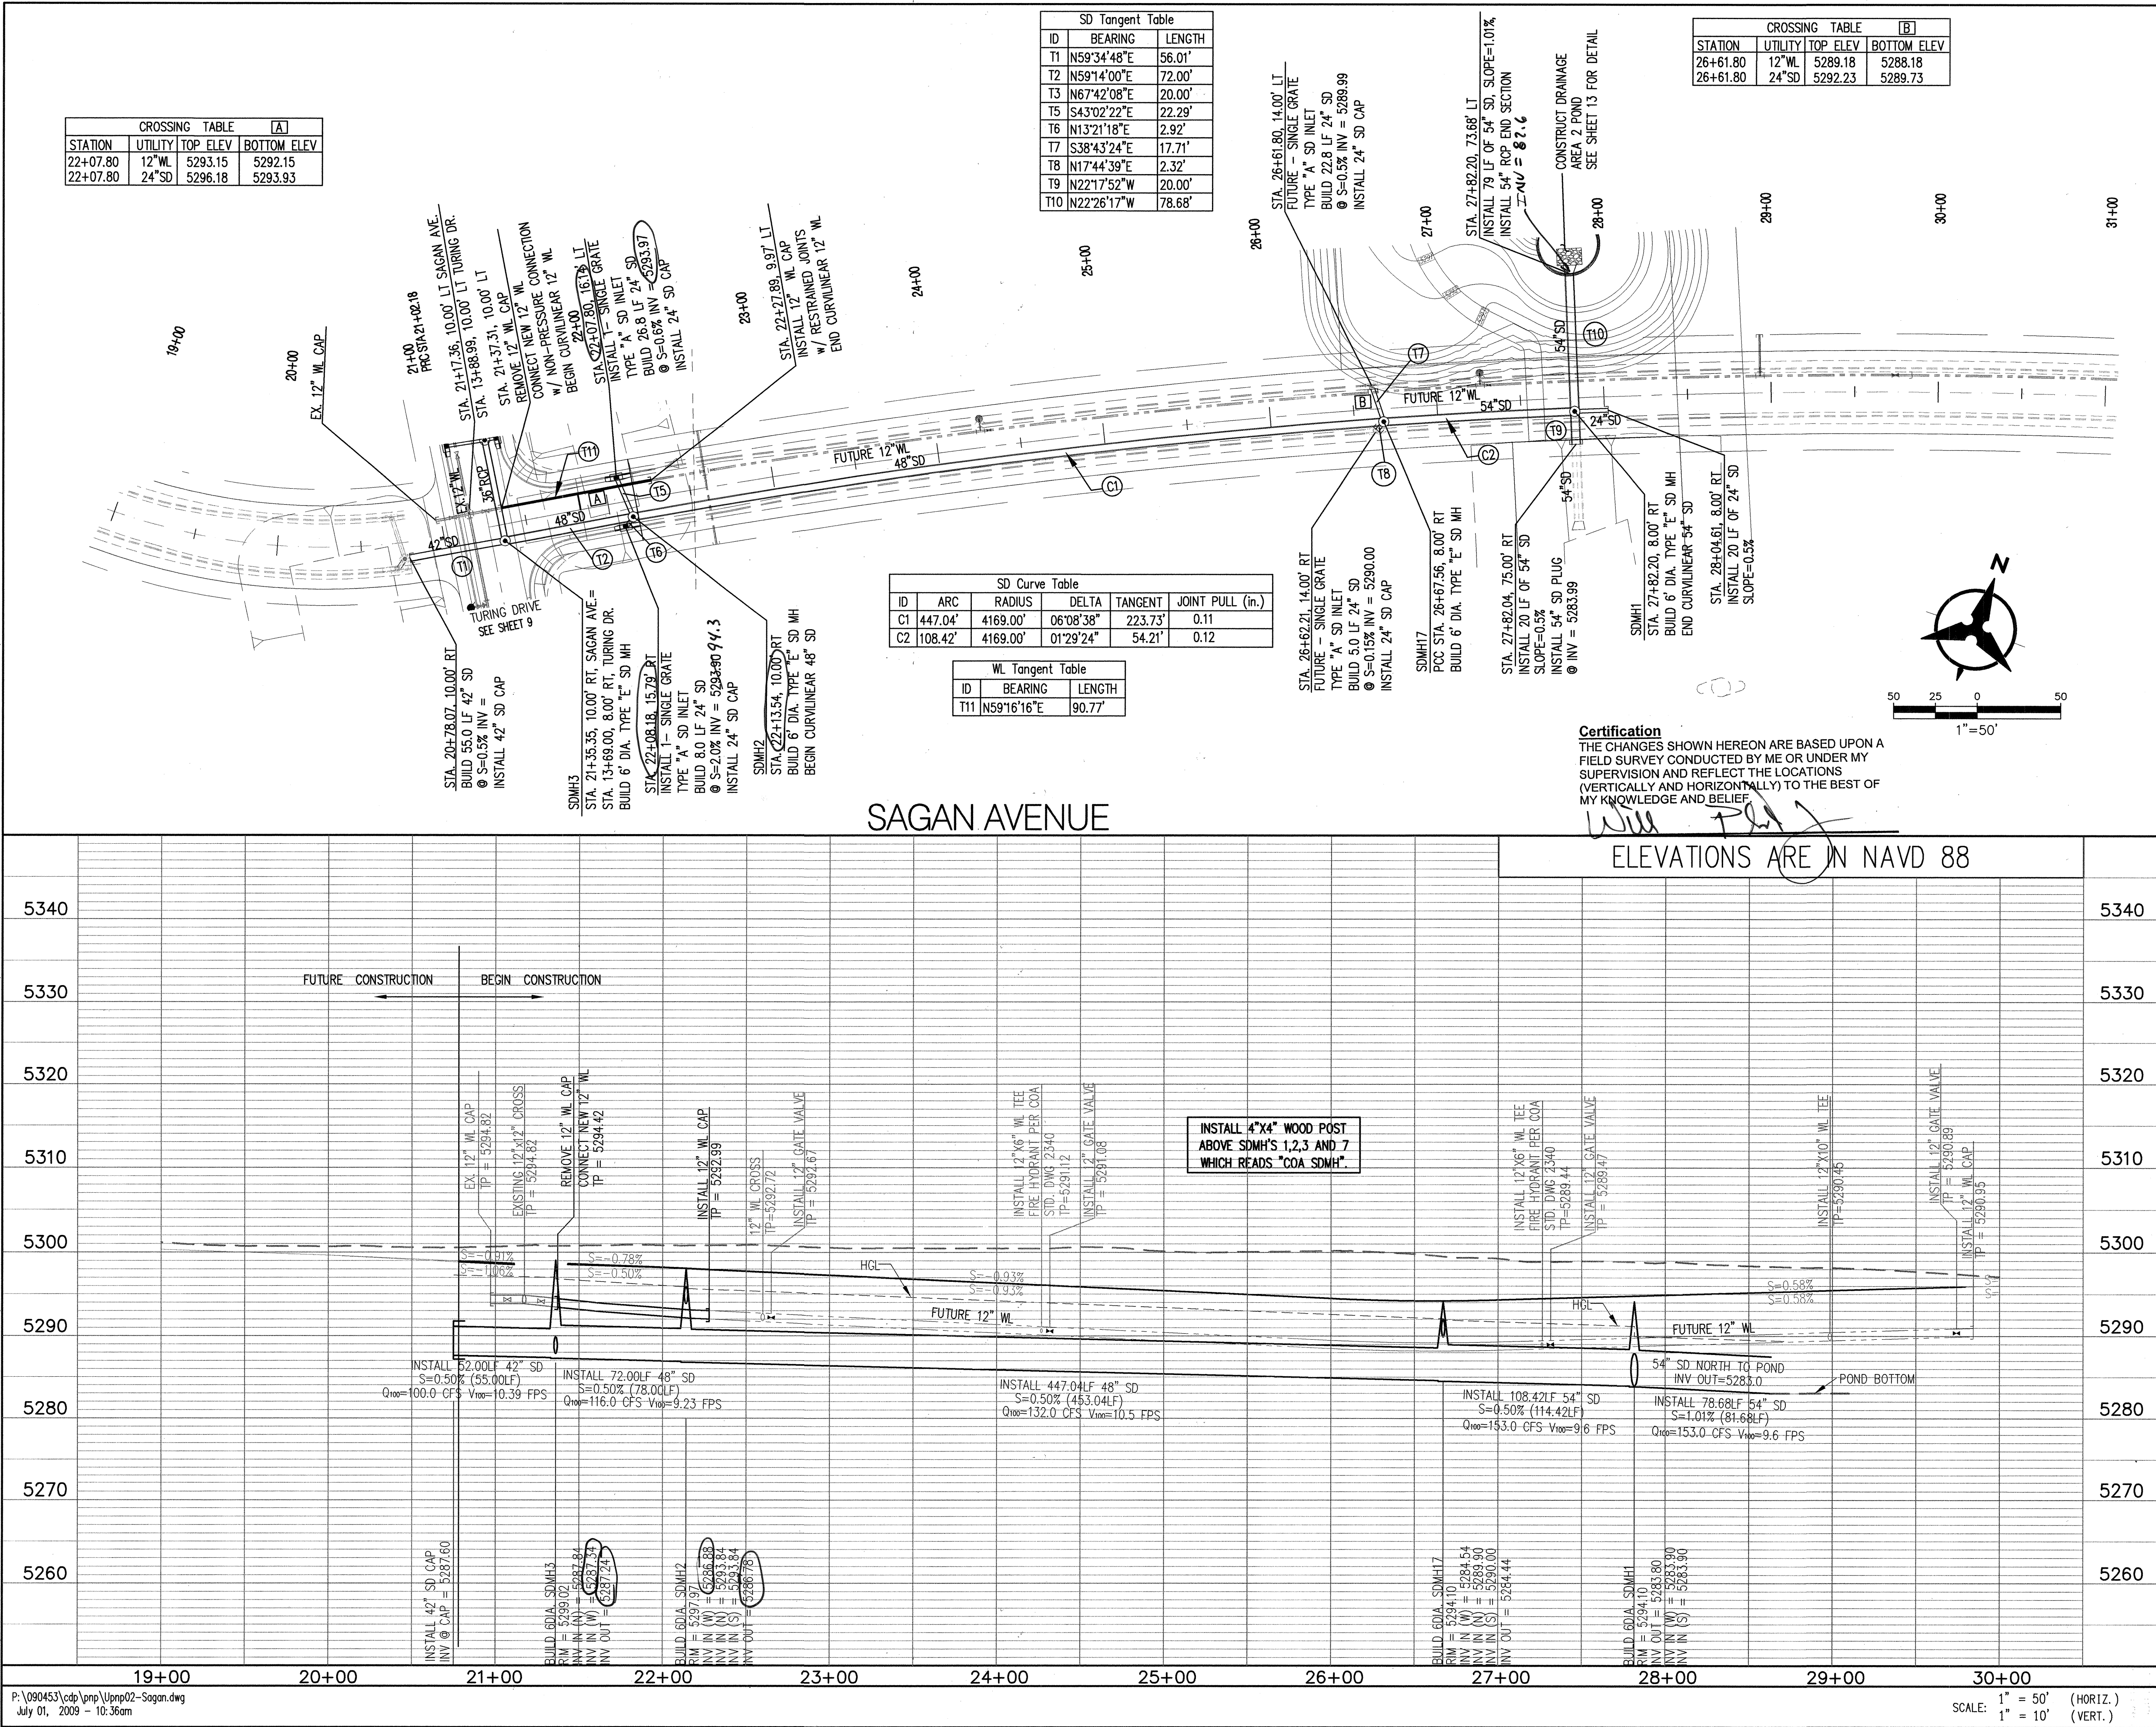

AS-BUILT INFORMATION

CONTRACTOR: *Bohannon & Huston*
DATE: *6/17/09*
DRAWN BY: *CJS*
CHECKED BY: *CJS*
DATE: *06/03/09*

BENCH MARKS

ACS BRASS TABLE STAMPED "I-R16, 1984"
GEOGRAPHIC POSITION (NAD 83)
N.M. STATE PLANE COORDINATES (CENTRAL ZONE)
X = 1,532,715.669 Y = 1,453,438.899
GROUND-TO-GRID FACTOR = 0.999664099
NAVD 1988 ELEVATION = 5291.451

SURVEY INFORMATION

DATE: *6/17/09*
BY: *CJS*
NO. *16244*

ENGINEER'S SEAL


CHRISTIAN J. SHULTS
PEER MEXICO
16244
PROFESSIONAL ENGINEER
6-17-09








REVISIONS

No.	Date	By	Remarks
1	06/03/09	CJS	DESIGN






Mesa del Sol
Bohannon & Huston
Engineering & Spatial Data & Advanced Technologies
City of Albuquerque Public Works Department
TRACT 11 AT MESA DEL SOL, GSA INFRASTRUCTURE
SAGAN AVENUE
UTILITY PLAN AND PROFILE

Design Review Committee APPROVED JUL 01 2009
City Engineer APPROVED JUL 9 2009
City Project No. 775478
Zone Map No. R15 - R16
Sheet 10 of 13

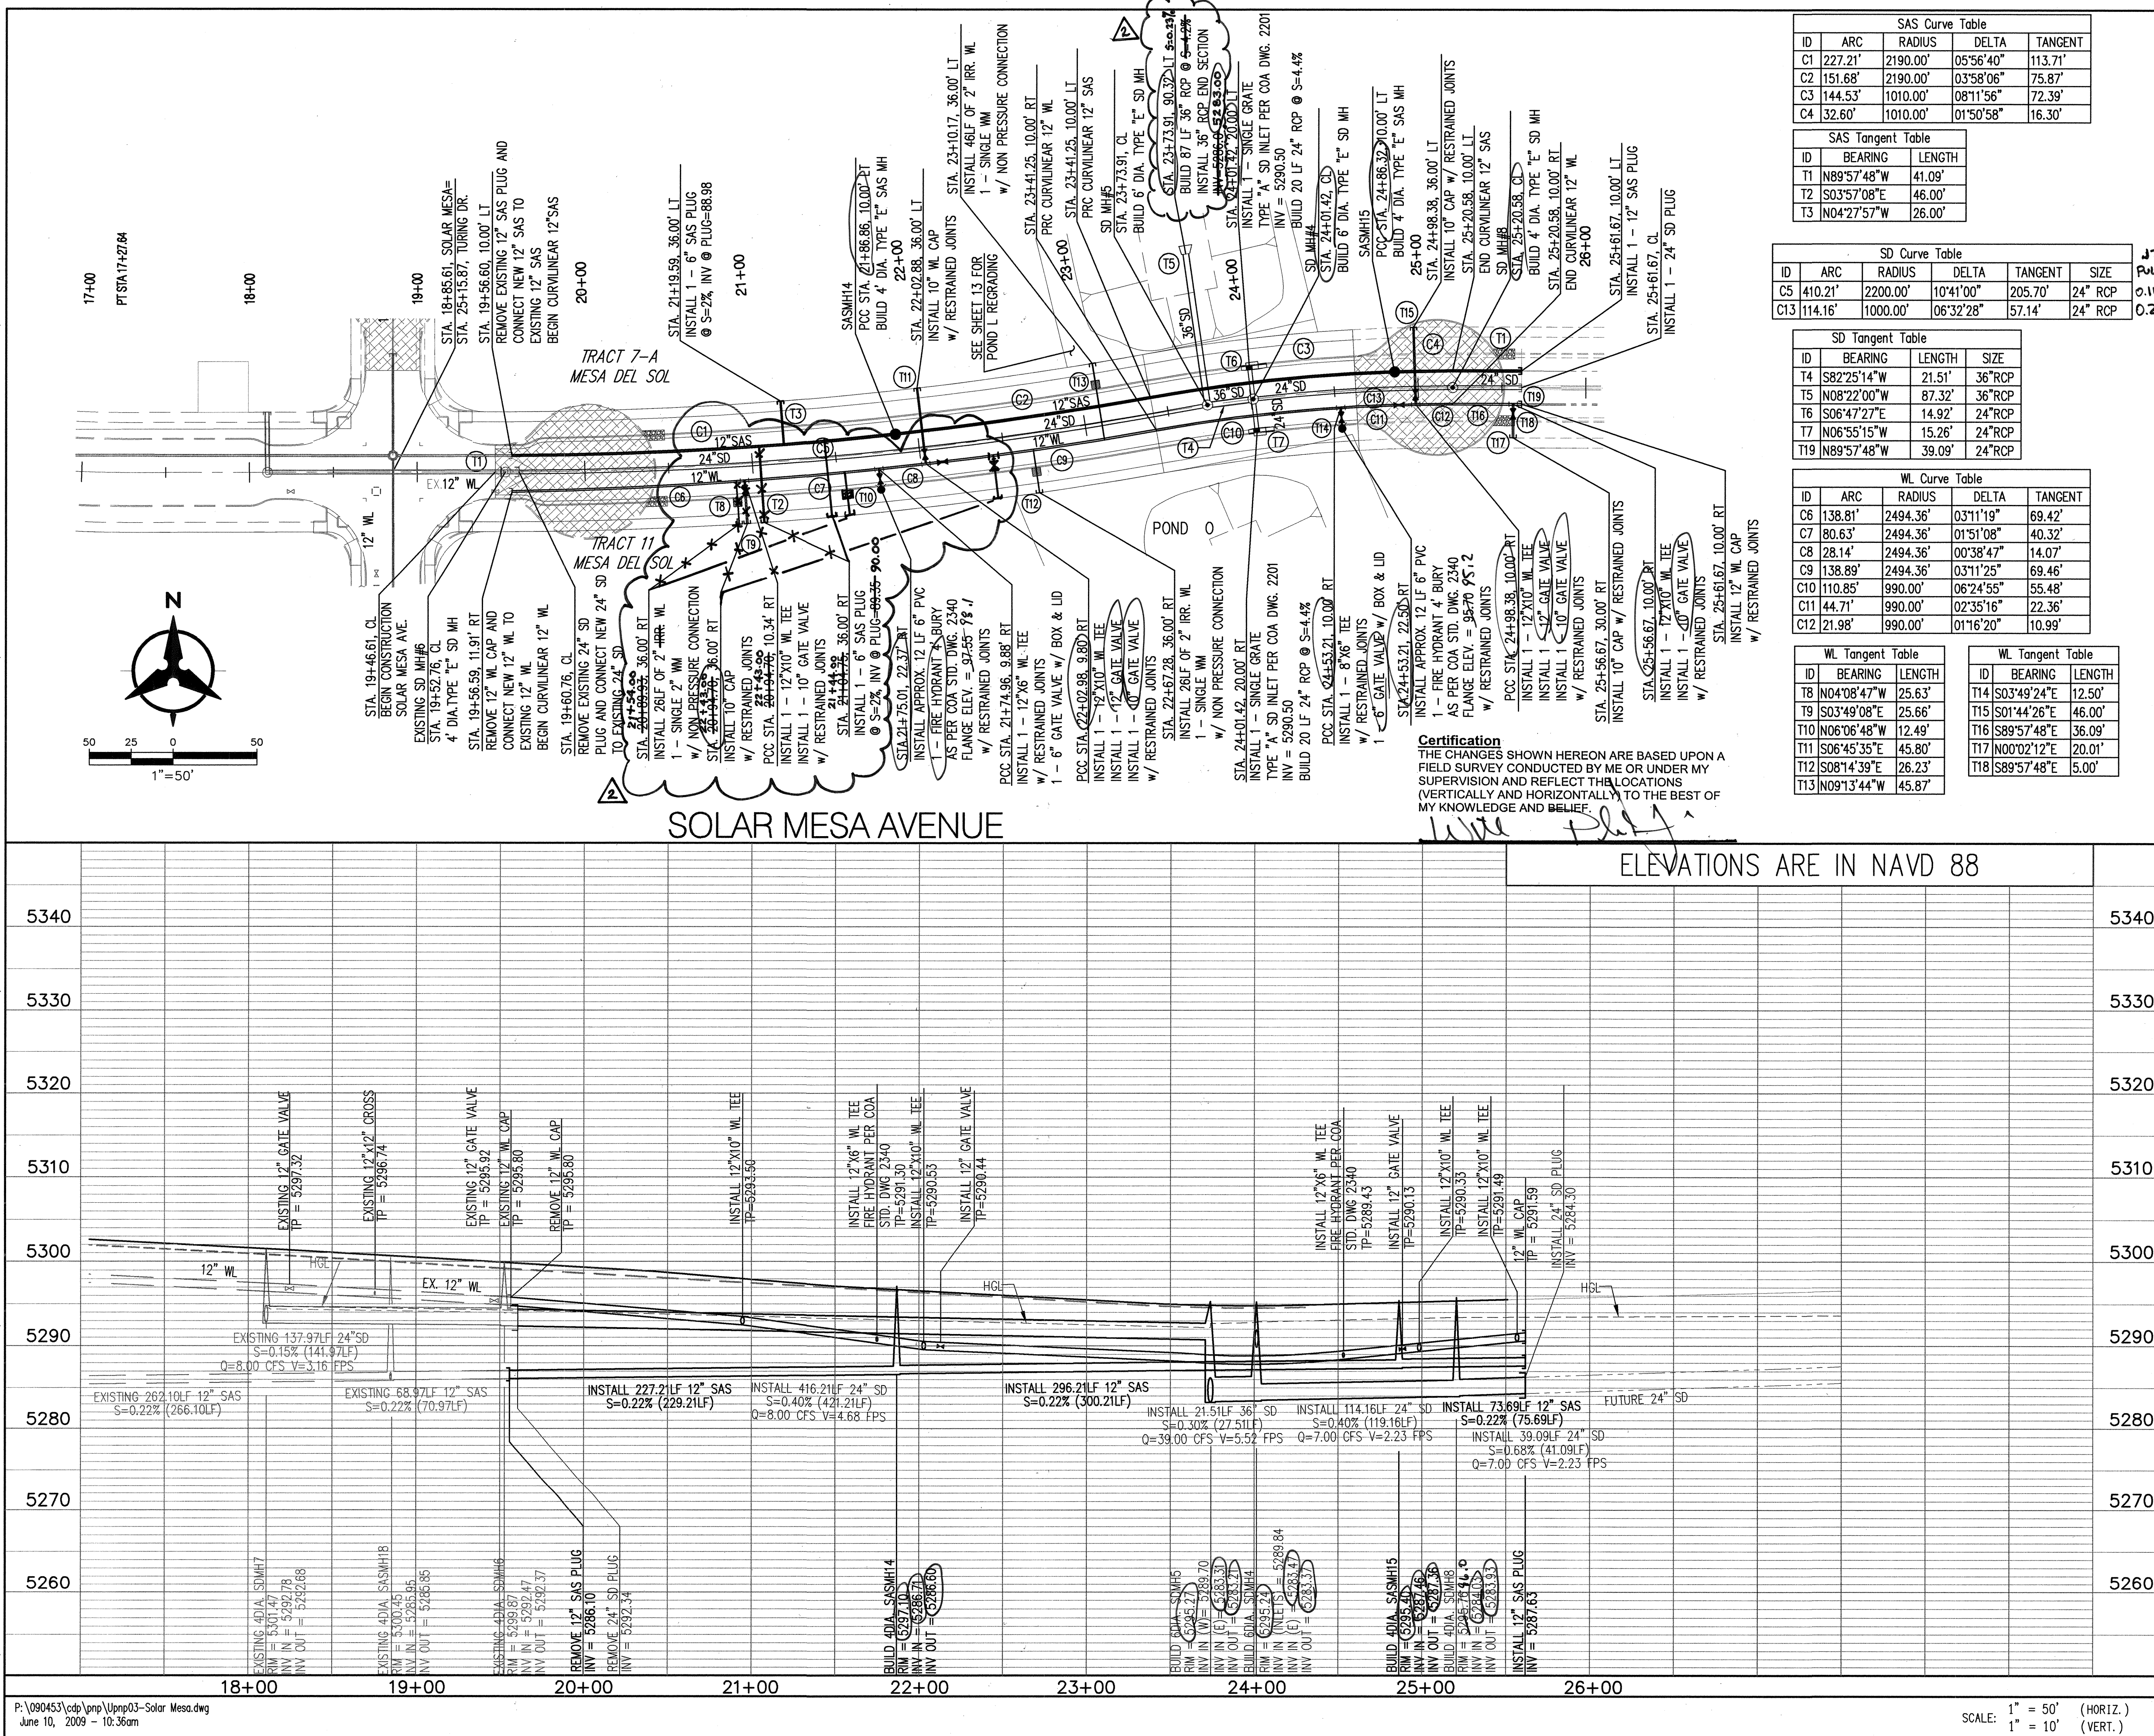

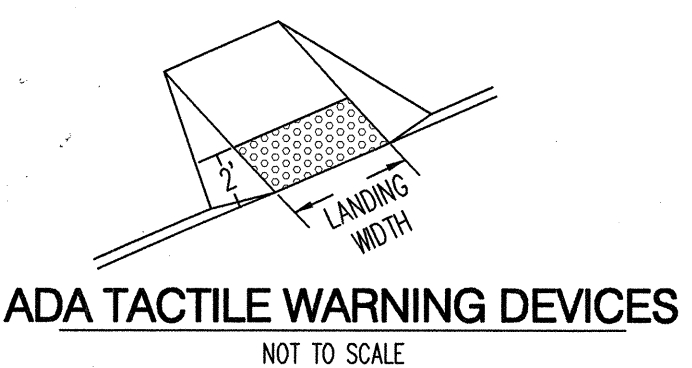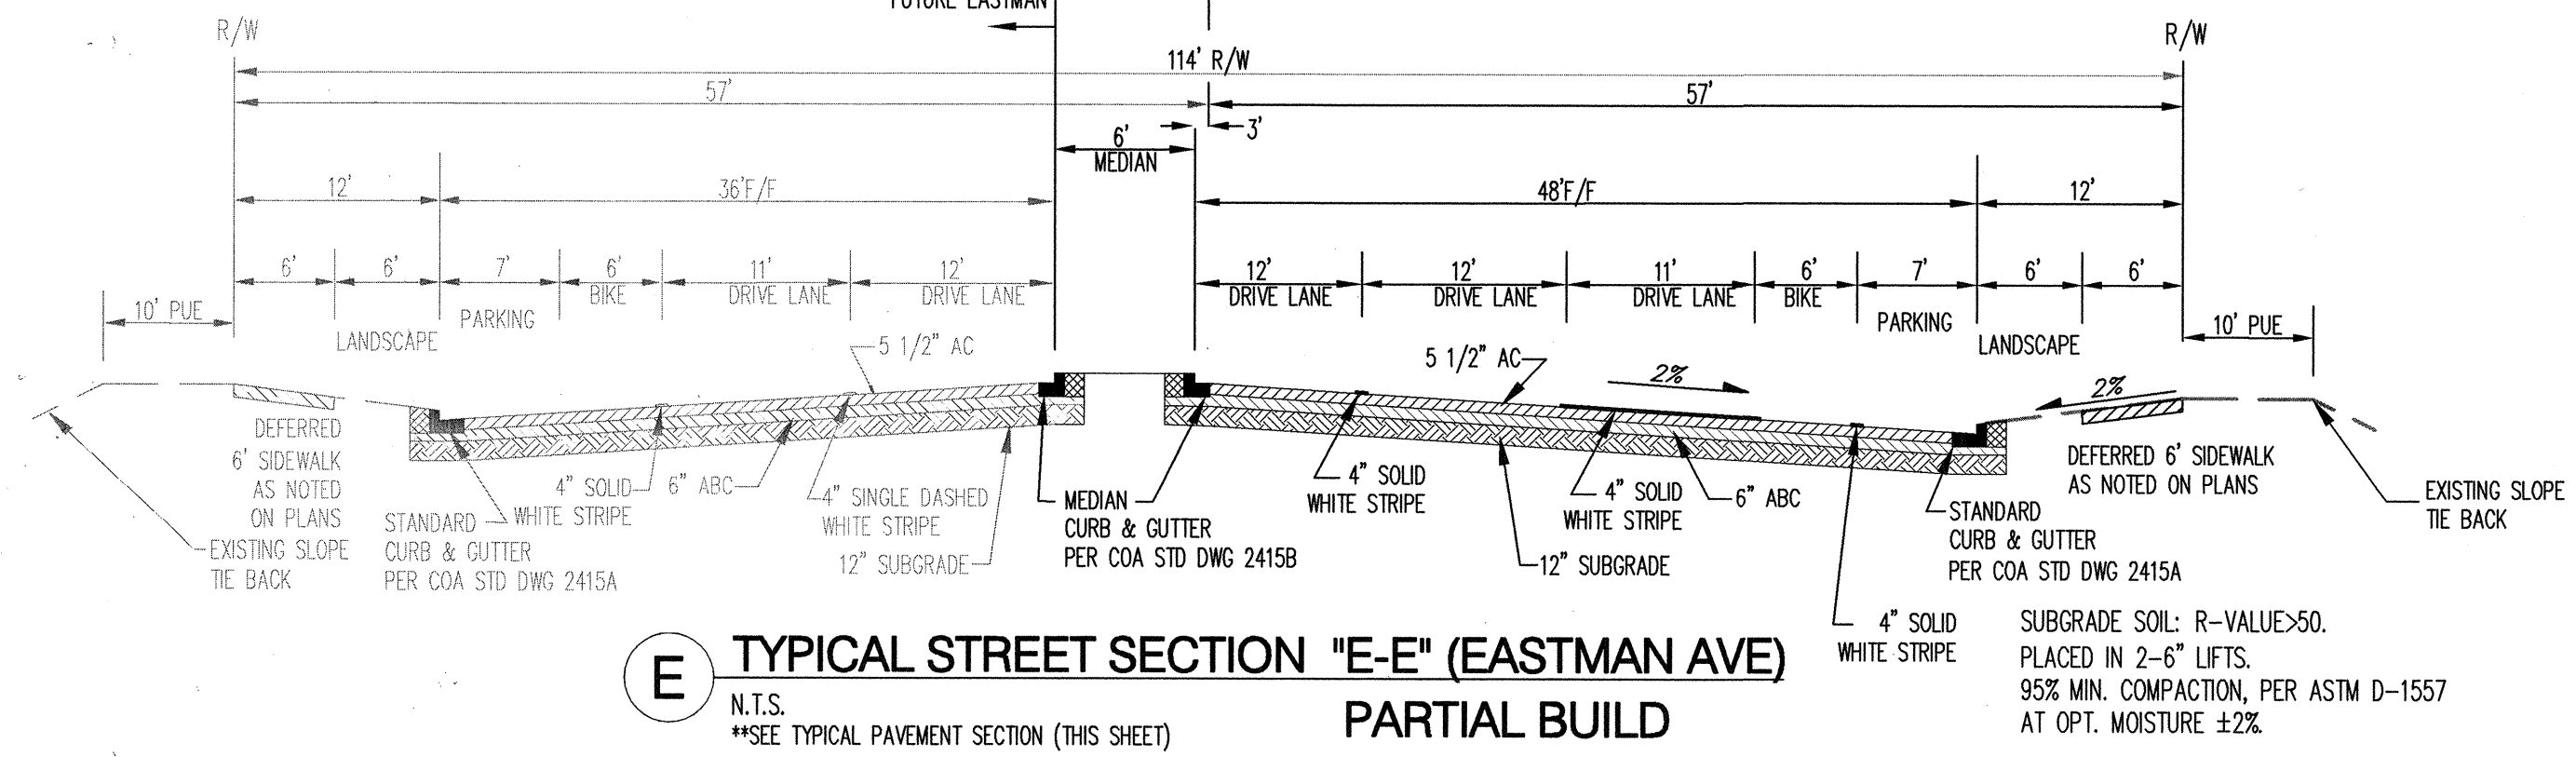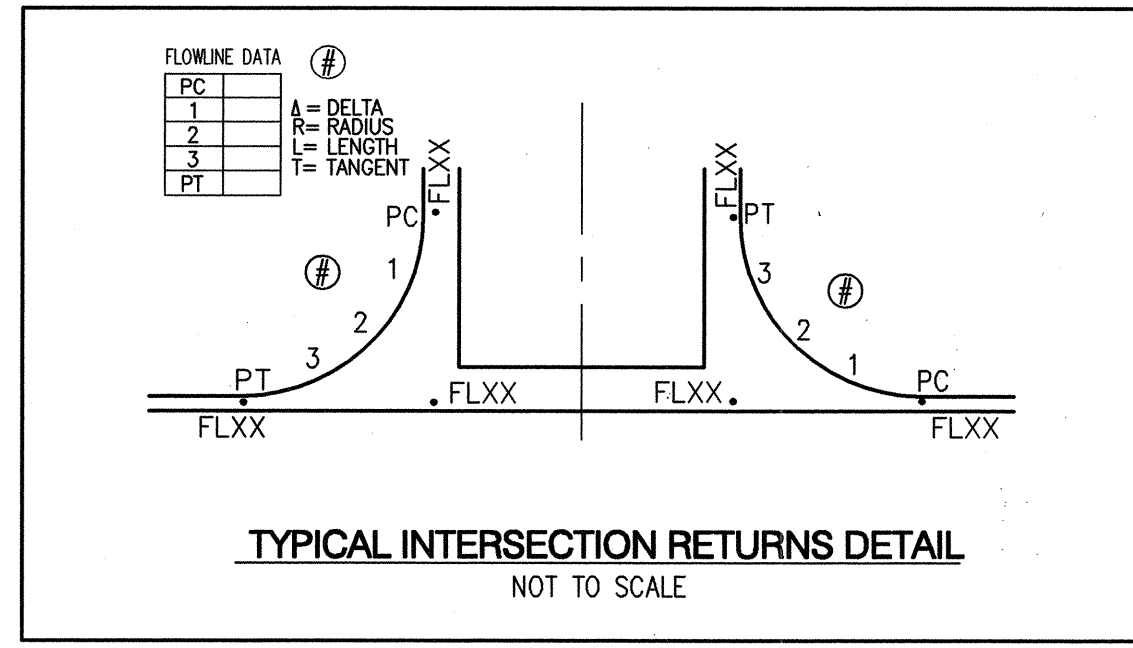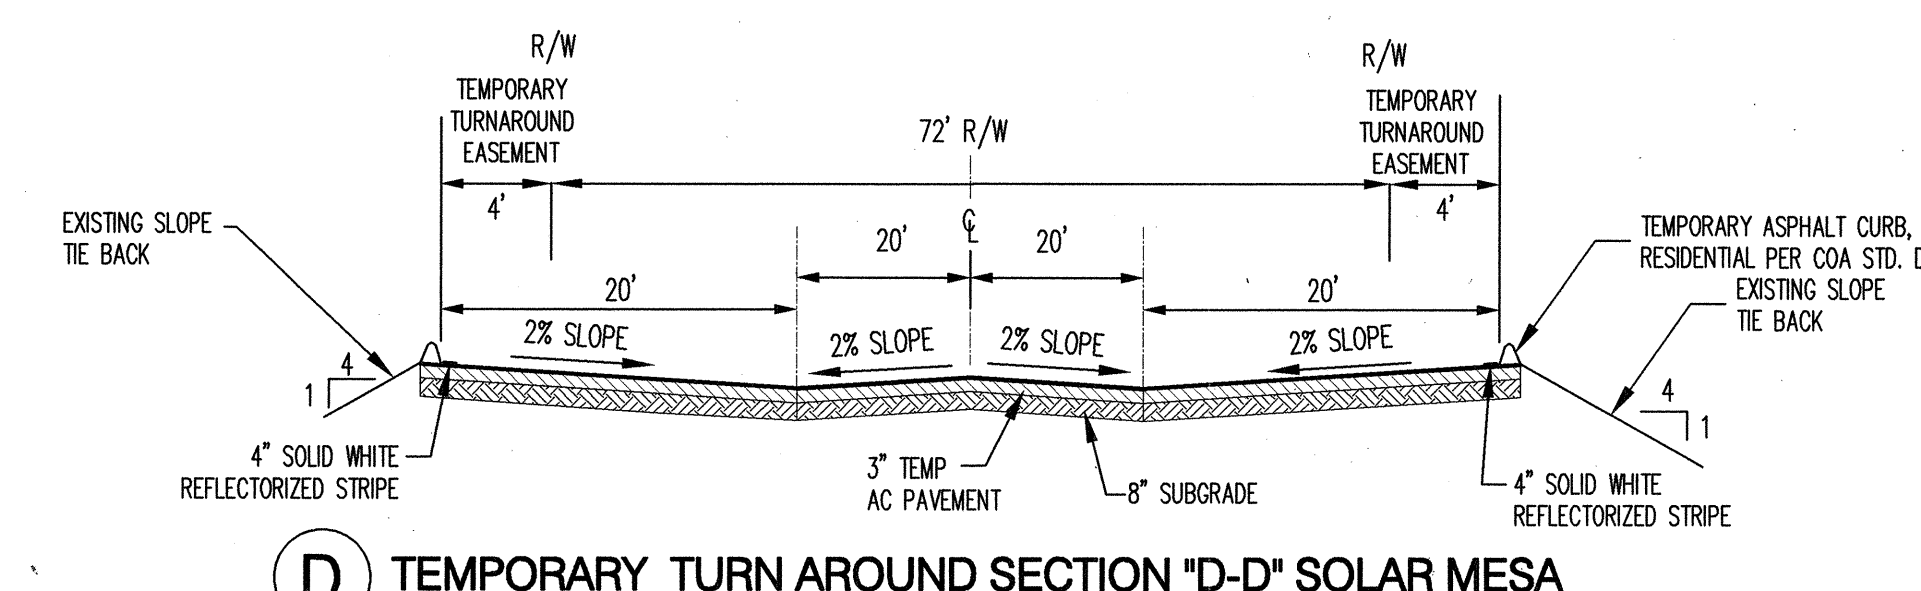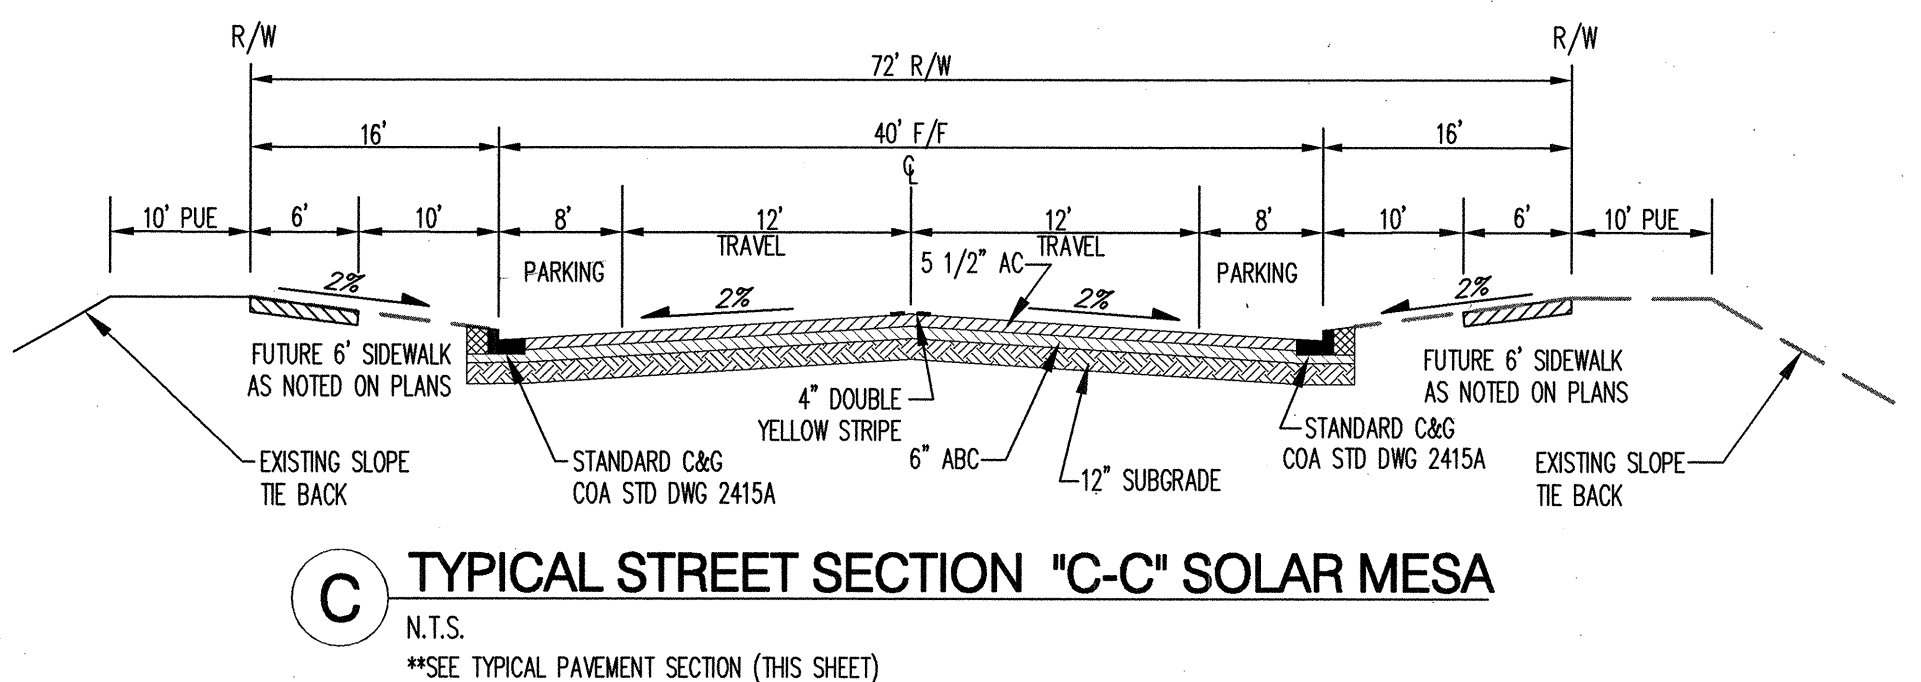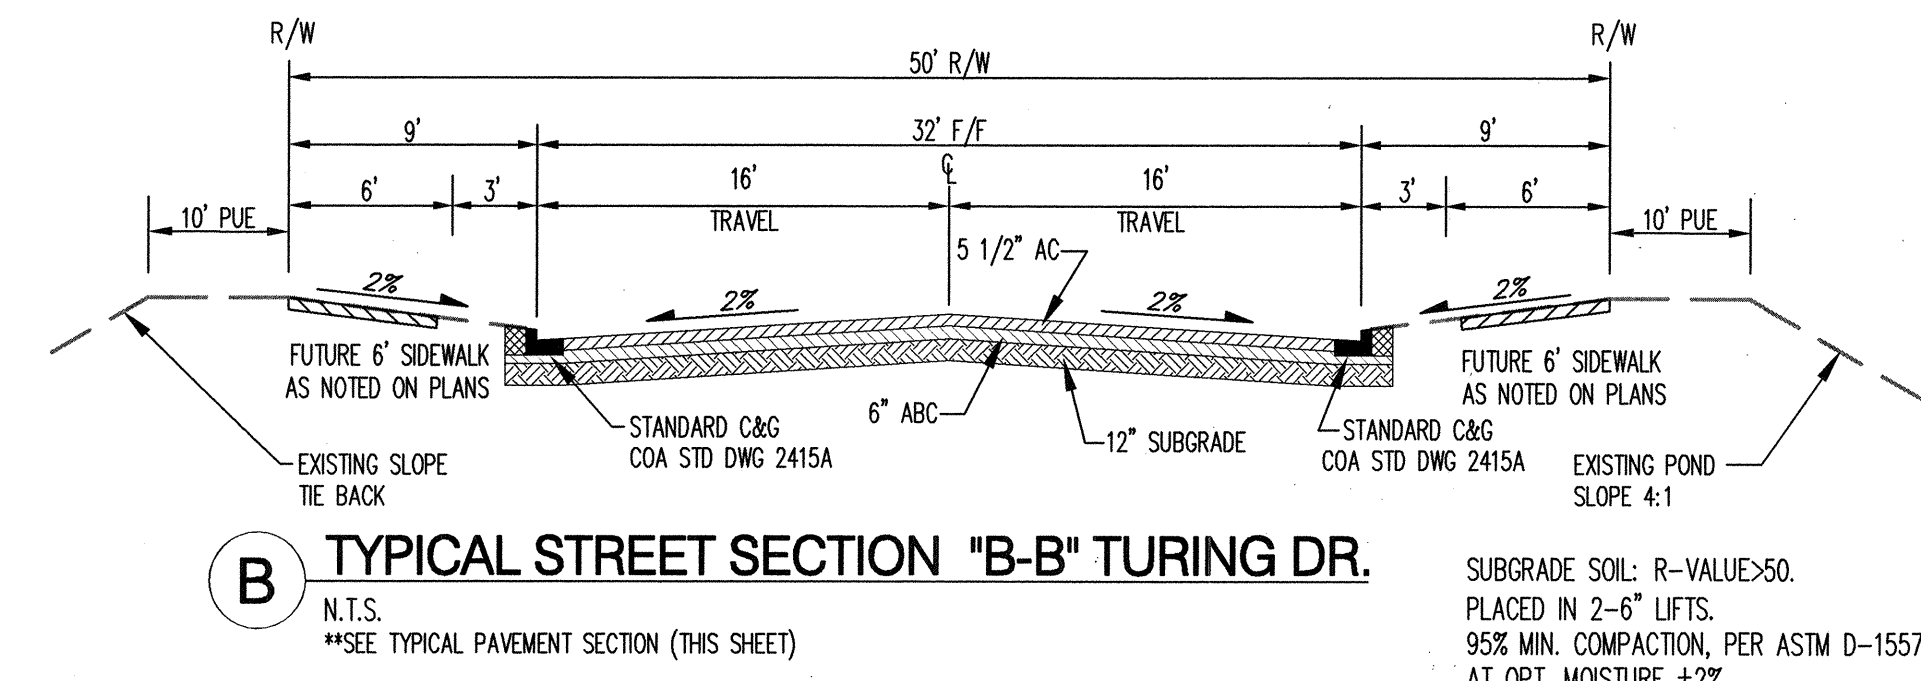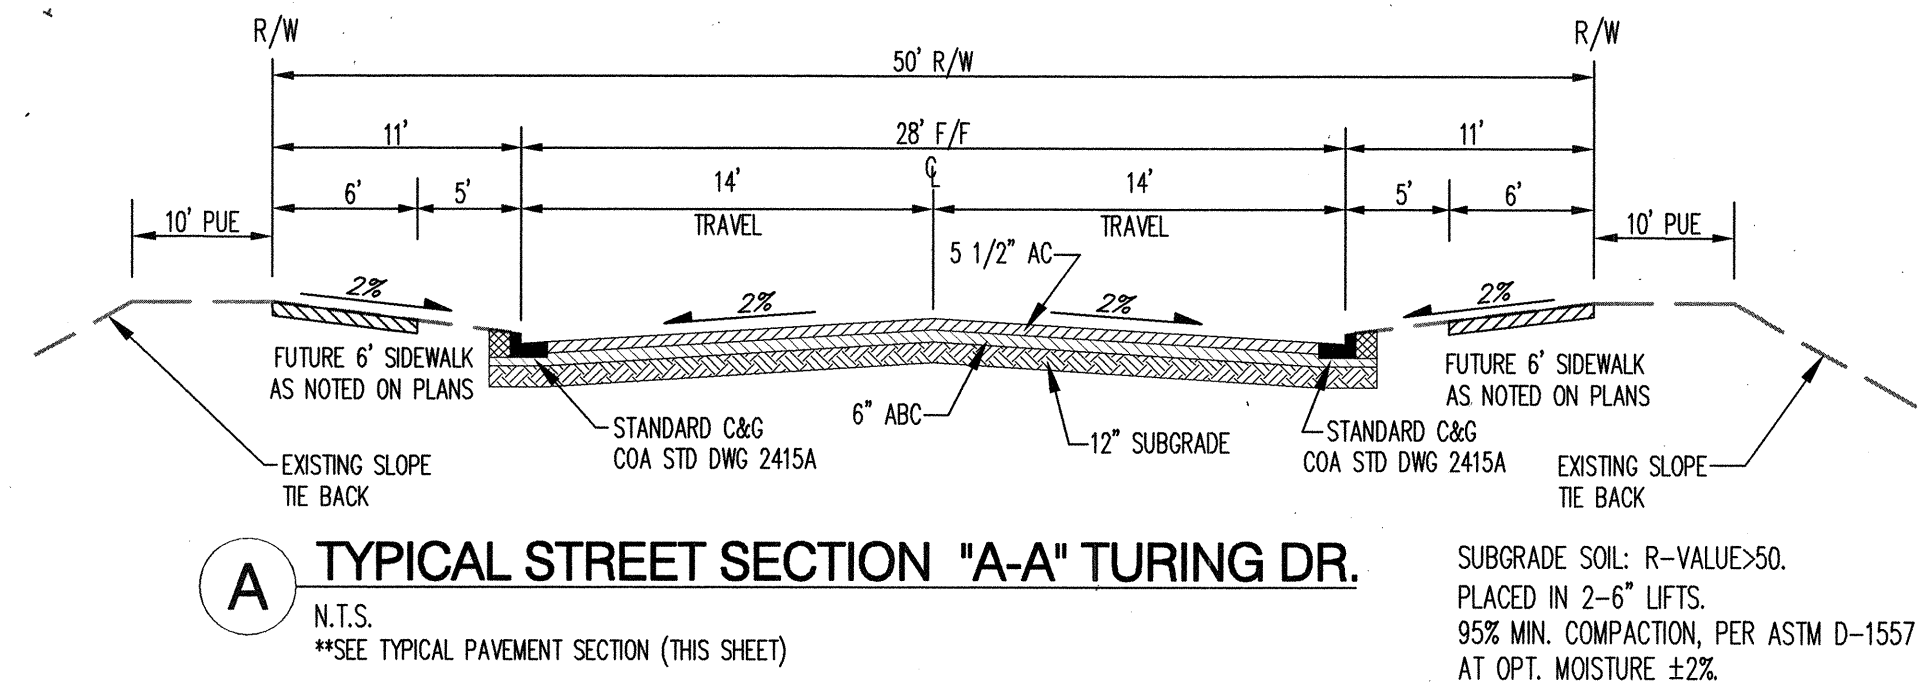

CONTRACTOR SHALL INSTALL ADA TACTILE WARNING DEVICES ON NEW CURB RAMP. THE WARNING DEVICES SHALL BE CAST-IN-PLACE WITH TRUNCATED DOME TACTILE CUES. THE COLOR MUST BE COLONIAL RED. CONTACT THE CITY OF ALBUQUERQUE ENGINEER FOR AN APPROVED LIST OF VENDORS AND PRODUCTS. DESIGN PER ADA GUIDELINES. SUBMIT SPECIFICATIONS TO COA CONSTRUCTION ENGINEER FOR EVALUATION PRIOR TO CONSTRUCTION.

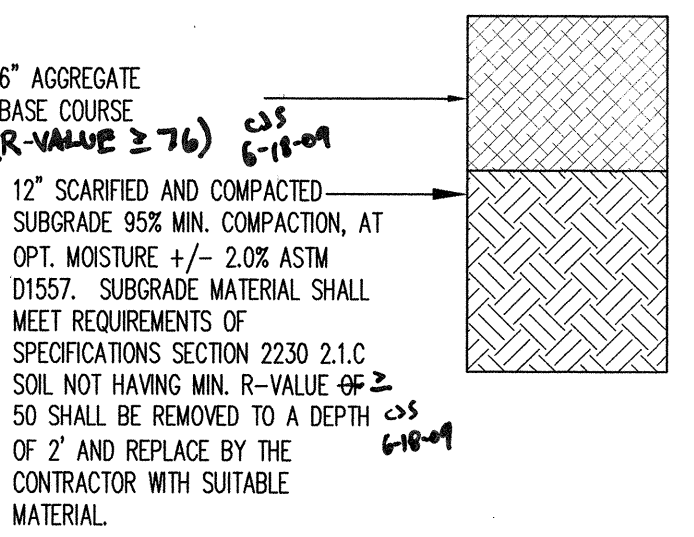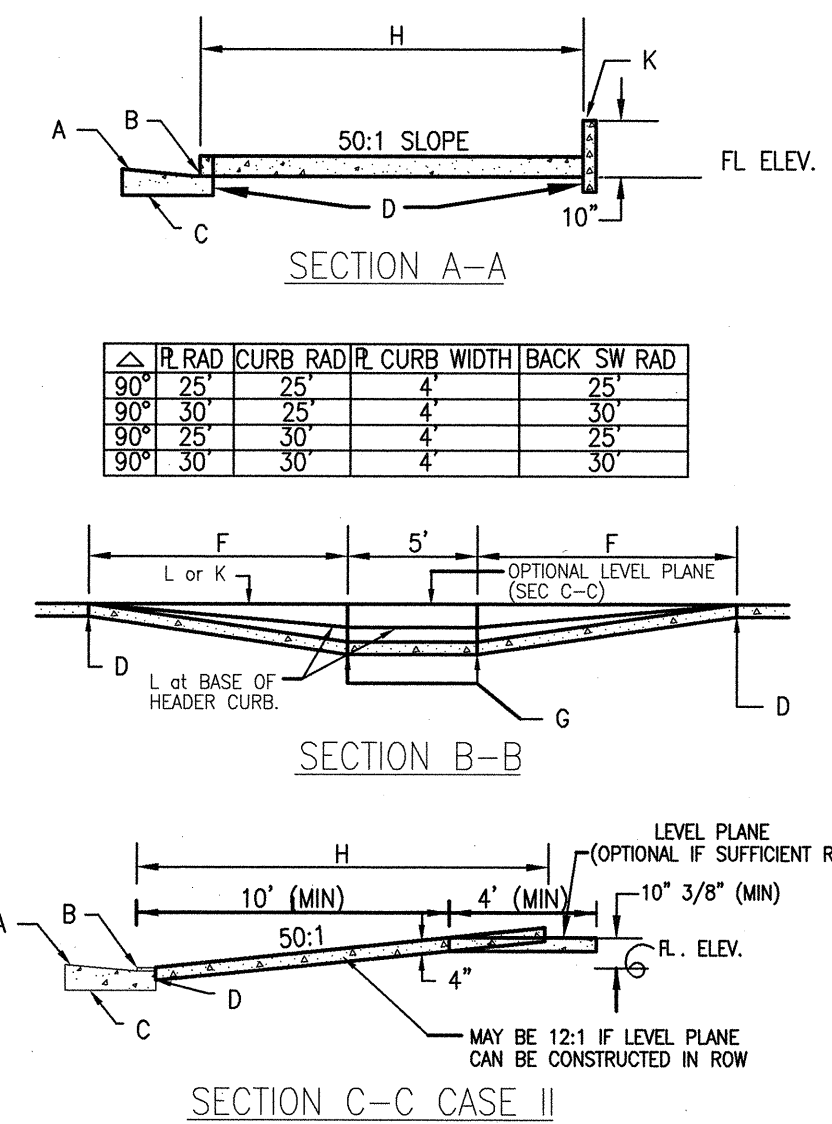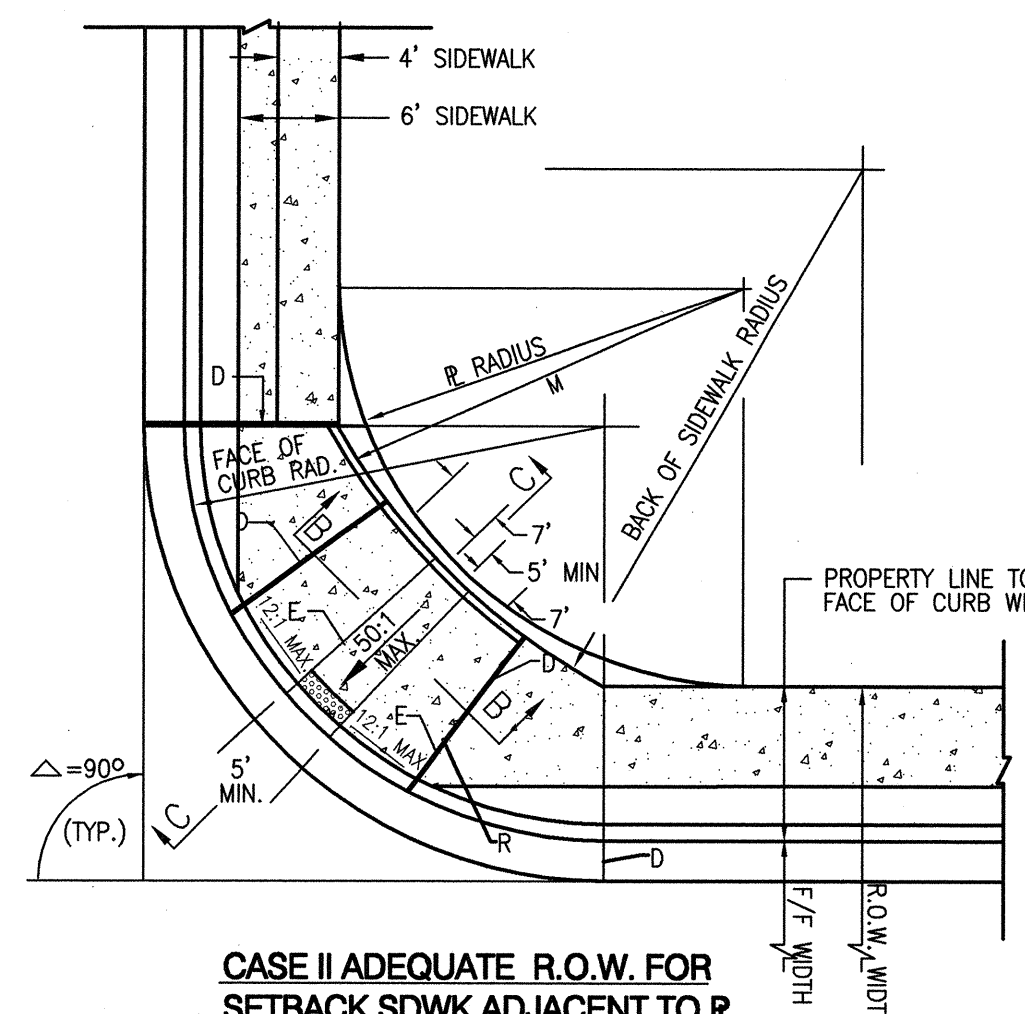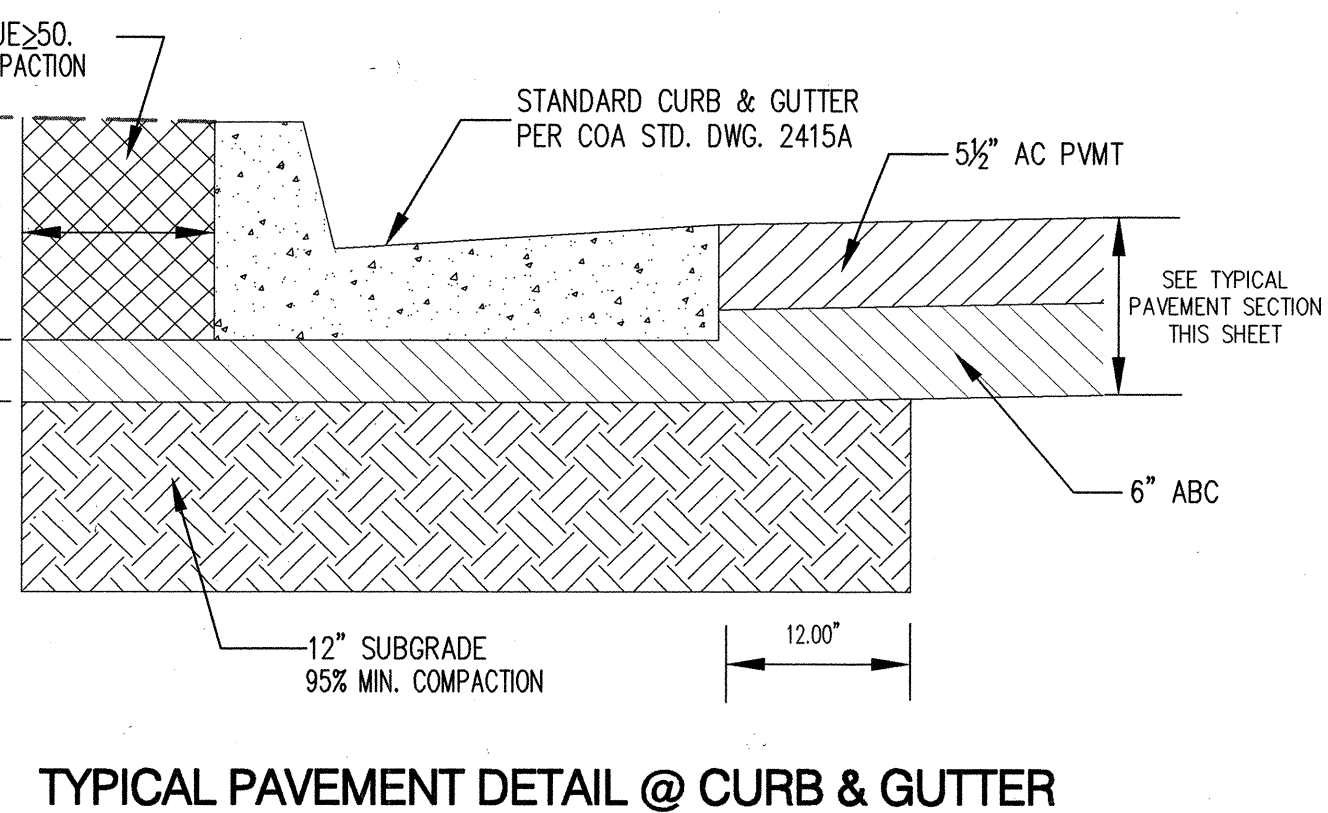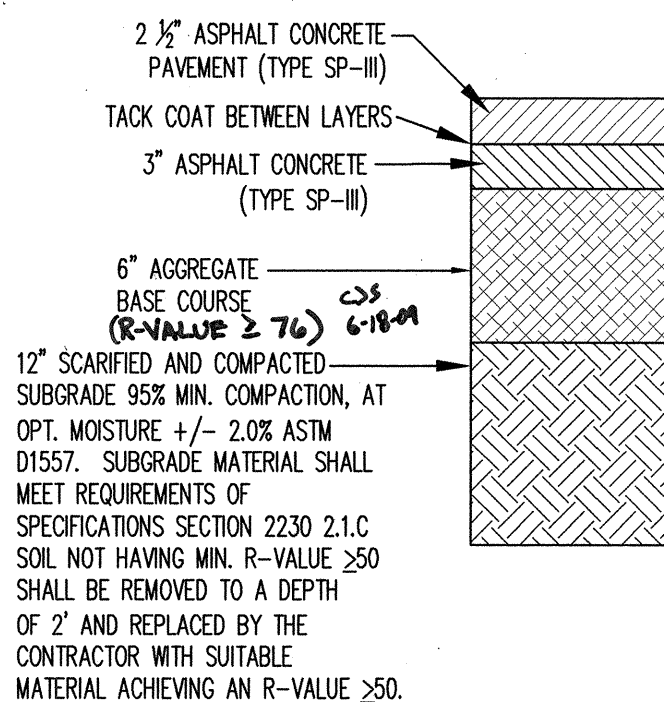


- GENERAL NOTES:**
- CURB ACCESS RAMPS ARE NORMALLY TO BE LOCATED AT THE CENTER OF THE RETURN OR AS DIRECTED BY THE CITY TRAFFIC ENGINEER.
 - SURFACE TEXTURE OF CURB ACCESS RAMPS SHALL BE OBTAINED BY HEAVY BROOMING (TEXTURE DEPTH .035"), TRANSVERSE TO THE SLOPE OF THE RAMP.
 - GUTTER FLOW-LINE PROFILE SHALL BE MAINTAINED THROUGH THE AREA OF THE RAMP. DRAINAGE CATCH BASIN STRUCTURES SHALL NOT BE PLACED IN LINE WITH RAMPS.
 - WIDTH OF SIDEWALK AND RAMP MUST BE MAINTAINED AT A MINIMUM OF 5'-0" THROUGH ENTIRE RAMP LENGTH.
- CONSTRUCTION NOTES:**
- SLOPE OF GUTTER DEPENDENT ON REQUIREMENTS FOR VALLEY GUTTER.
 - 1/4" LIP ABOVE FLOW LINE (VERTICAL). SEE STD. DWG. 2415
 - CURB & GUTTER (SEE STD. DWG. 2415 - GUTTER AT THE CURB ACCESS RAMP).
 - 1/2" EXPANSION JOINT.
 - PARALLEL LINES - TOP AND BOTTOM OF RAMP.
 - 12:1 SLOPE AT FACE OF CURB (SEE STD. DWG. 2418)
 - CONTRACTION (DUMMY) JOINT.
 - VARIABLE.
 - HEADER CURB, SEE DWG. 2415.
 - BACK OF SIDEWALK.
 - BACK OF SIDEWALK RADIUS TO BE ESTABLISHED SO AS TO MAINTAIN A 5'-0" RAMP WIDTH (MINIMUM) OR MORE THROUGHOUT. SEE STD. DWG. 2440 (NOTE 5) IF LESS THAN 5'-0" IS AVAILABLE DUE TO UNLIMITED UNRESOLVABLE CONSTRAINTS.
 - 4 1/2" MAX.
 - ANY PRIVATE LANDSCAPING AND OR IRRIGATION SHALL BE RESTORED TO ORIGINAL CONDITION. SHOULD ANY PRIVATE IMPROVEMENT NEED TO BE REMOVED, OWNER MUST BE NOTIFIED.
 - 12:1 SLOPE MAXIMUM ON RAMP.

Mesa del Sol
Bohannon & Huston
Court yard | 7500 Jefferson St. NE | Albuquerque, NM 87109-4335
ENGINEERING • SPATIAL DATA • ADVANCED TECHNOLOGIES

**CITY OF ALBUQUERQUE
PUBLIC WORKS DEPARTMENT**
TRACT 11 AT MESA DEL SOL, GSA INFRASTRUCTURE
MISCELLANEOUS PAVING DETAILS AND
STREET CROSS-SECTIONS

Design Review Committee	City Engineer Approval	Mo./Day/Yr.	Mo./Day/Yr.
APPROVED JUL 01 2009 DESIGN REVIEW COMMITTEE	APPROVED JUL 21 2009 CITY ENGINEER		

City Project No. **775478** Zone Map No. **R-15, R-16** Sheet **12** Of **13**

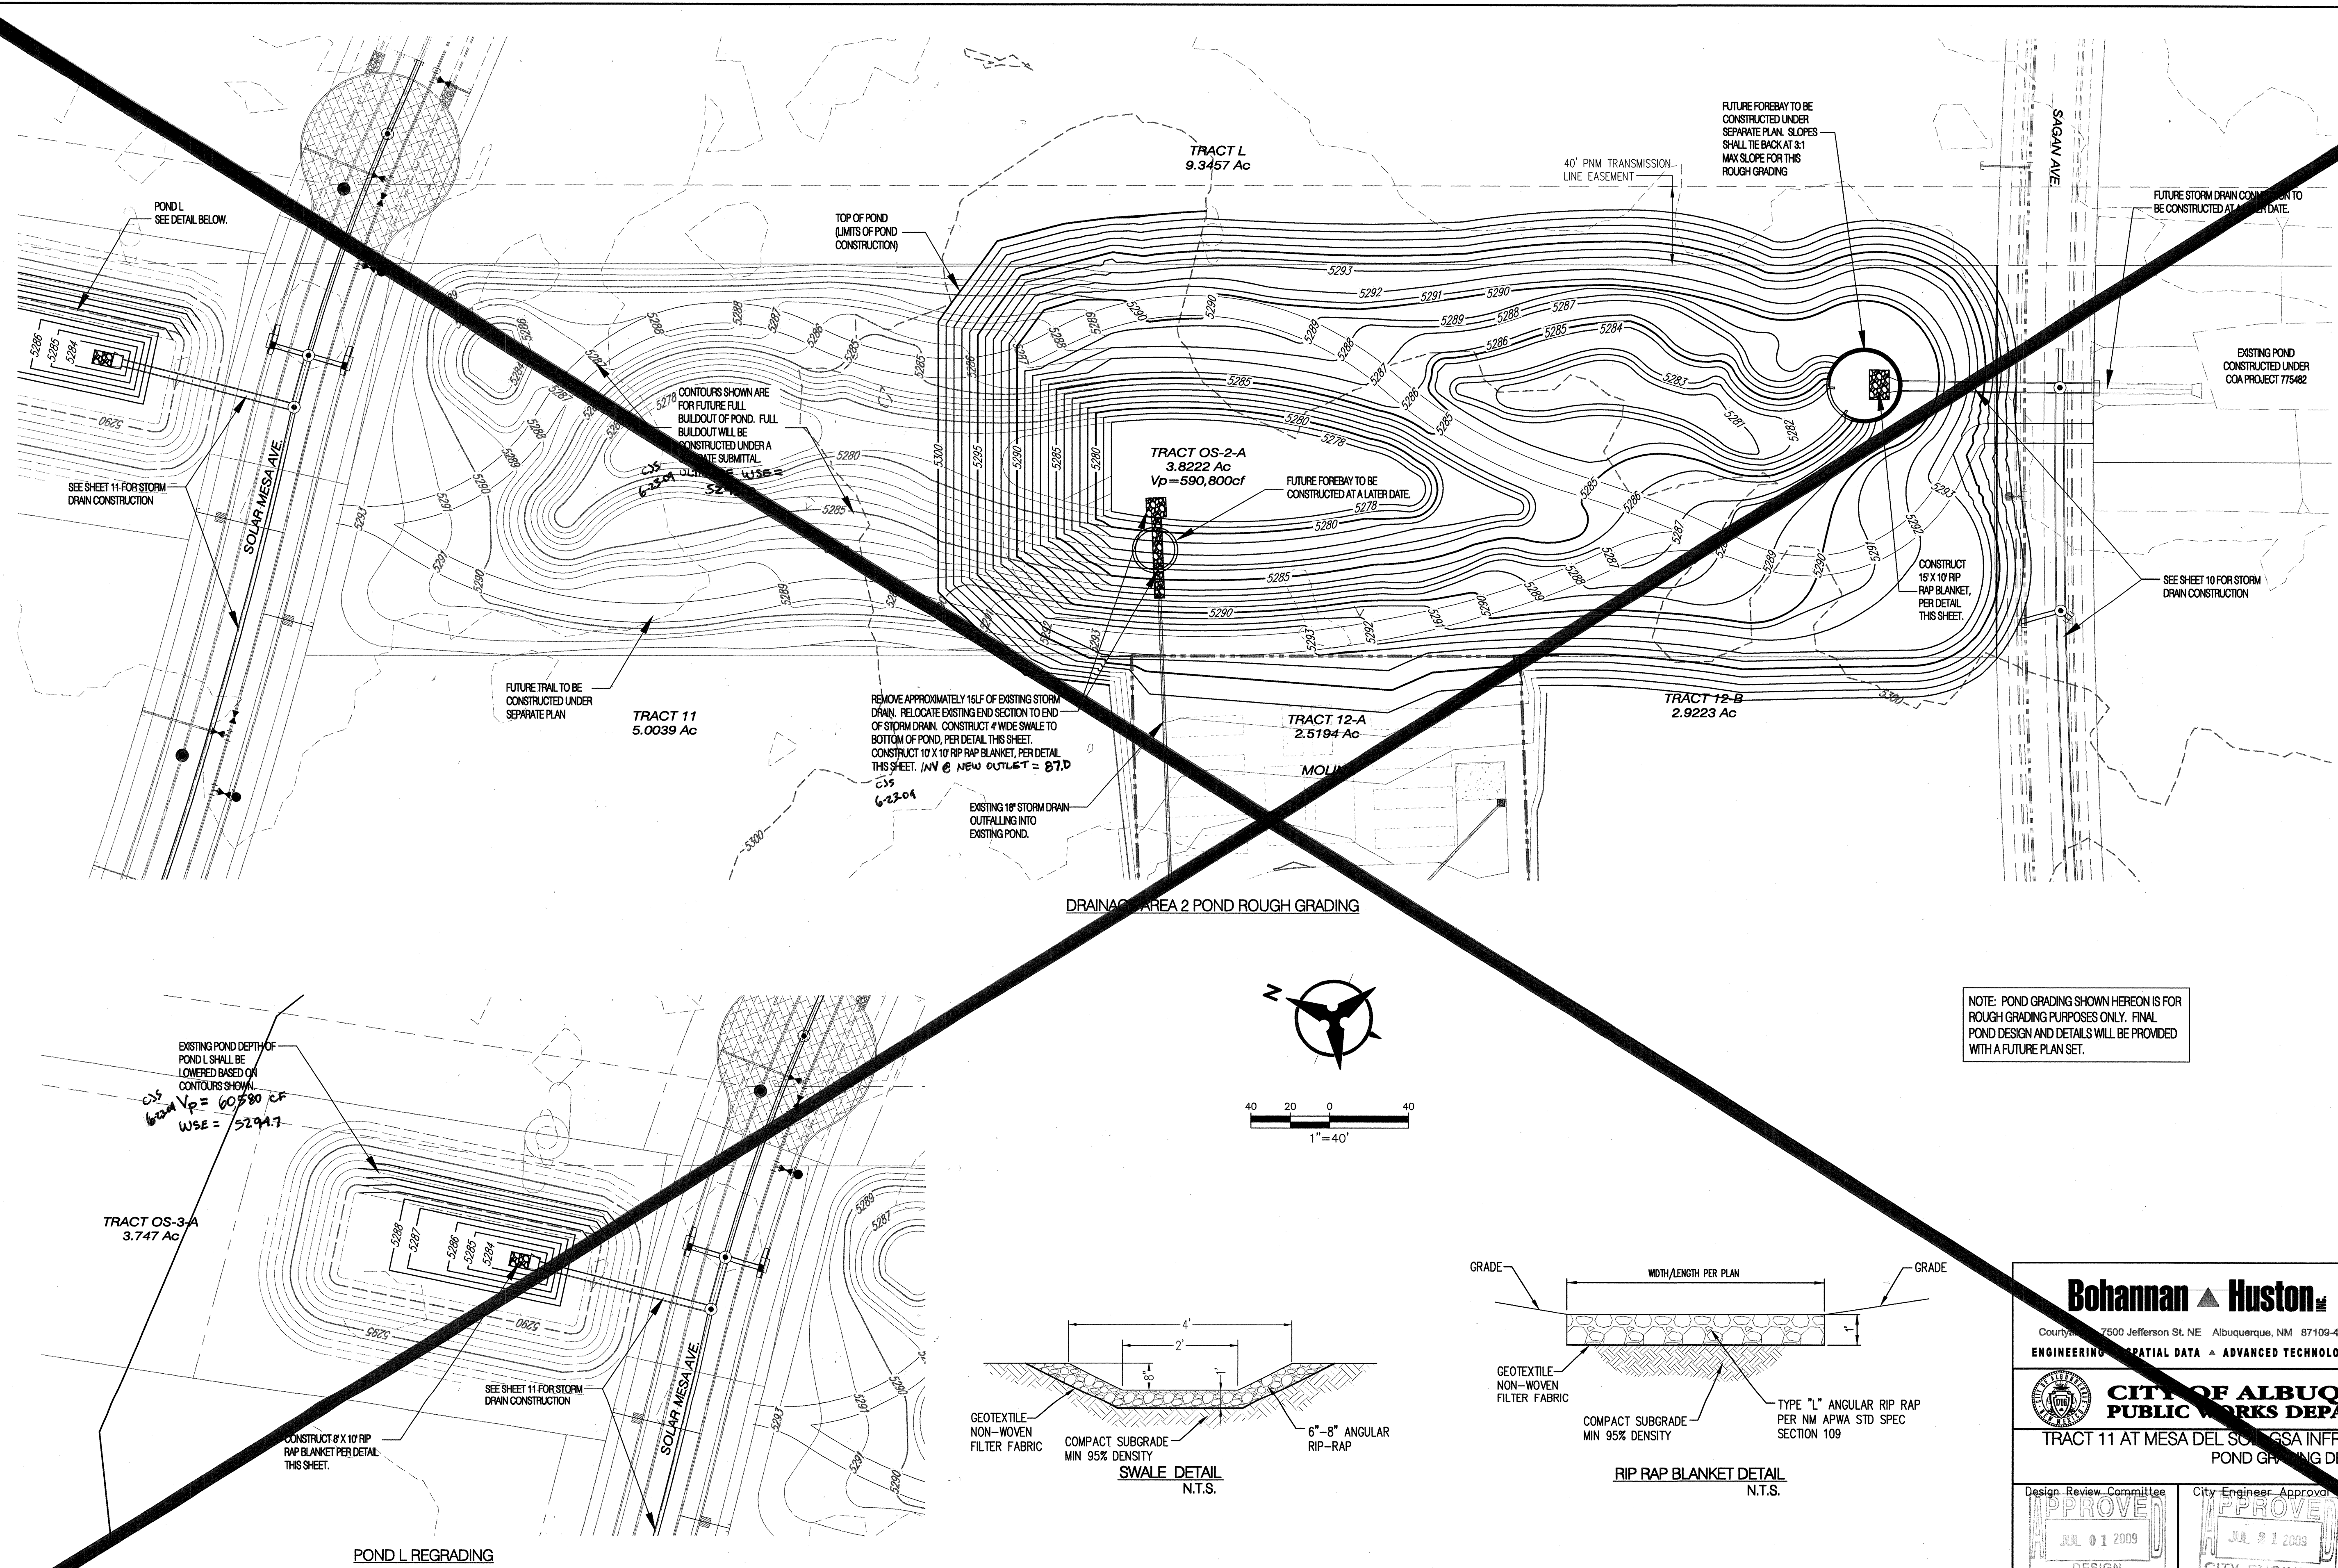

AS-BUILT INFORMATION		BENCH MARKS		SURVEY INFORMATION		ENGINEER'S SEAL		REVISIONS		DESIGN	
CONTRACTOR	DATE	ACS BRASS TABLE STAMPED "1-R16, 1984"	DATE	NO.	BY	DATE	DATE	NO.	DATE	NO.	DATE
INSPECTOR'S	DATE	GEOGRAPHIC POSITION (NAD 83)	DATE								
FIELD	DATE	N.M. STATE PLANE COORDINATES (CENTRAL ZONE)	DATE								
VERIFICATION BY	DATE	X = 1,532,715.669 Y = 1,453,438.899	DATE								
CORRECTED BY	DATE	GROUND-TO-GRID FACTOR = 0.999664099	DATE								
MICROFILM INFORMATION	DATE	Δα = -00°12'22.46"	DATE								
	NO.	NAVD 1988 ELEVATION = 5291.451	NO.								

8/10/09 DELETE THIS SHEET, SEE SHEET 13R.

REMARKS

DESIGN

DATE: 05/20/09

DATE: 05/20/09

DATE: 05/20/09

DESIGNED BY: MJB

DRAWN BY: MJB

CHECKED BY: CJS

Bohannon & Huston

County: 7500 Jefferson St. NE Albuquerque, NM 87109-4335

ENGINEERING SPATIAL DATA ADVANCED TECHNOLOGIES

CITY OF ALBUQUERQUE

PUBLIC WORKS DEPARTMENT

TRACT 11 AT MESA DEL SOL GSA INFRASTRUCTURE

POND GRADING DETAILS


Design Review Committee APPROVED JUL 01 2009

City Engineer APPROVED JUL 21 2009





City Project No. 775478

Zone Map No. R-15, R-16


Sheet 13

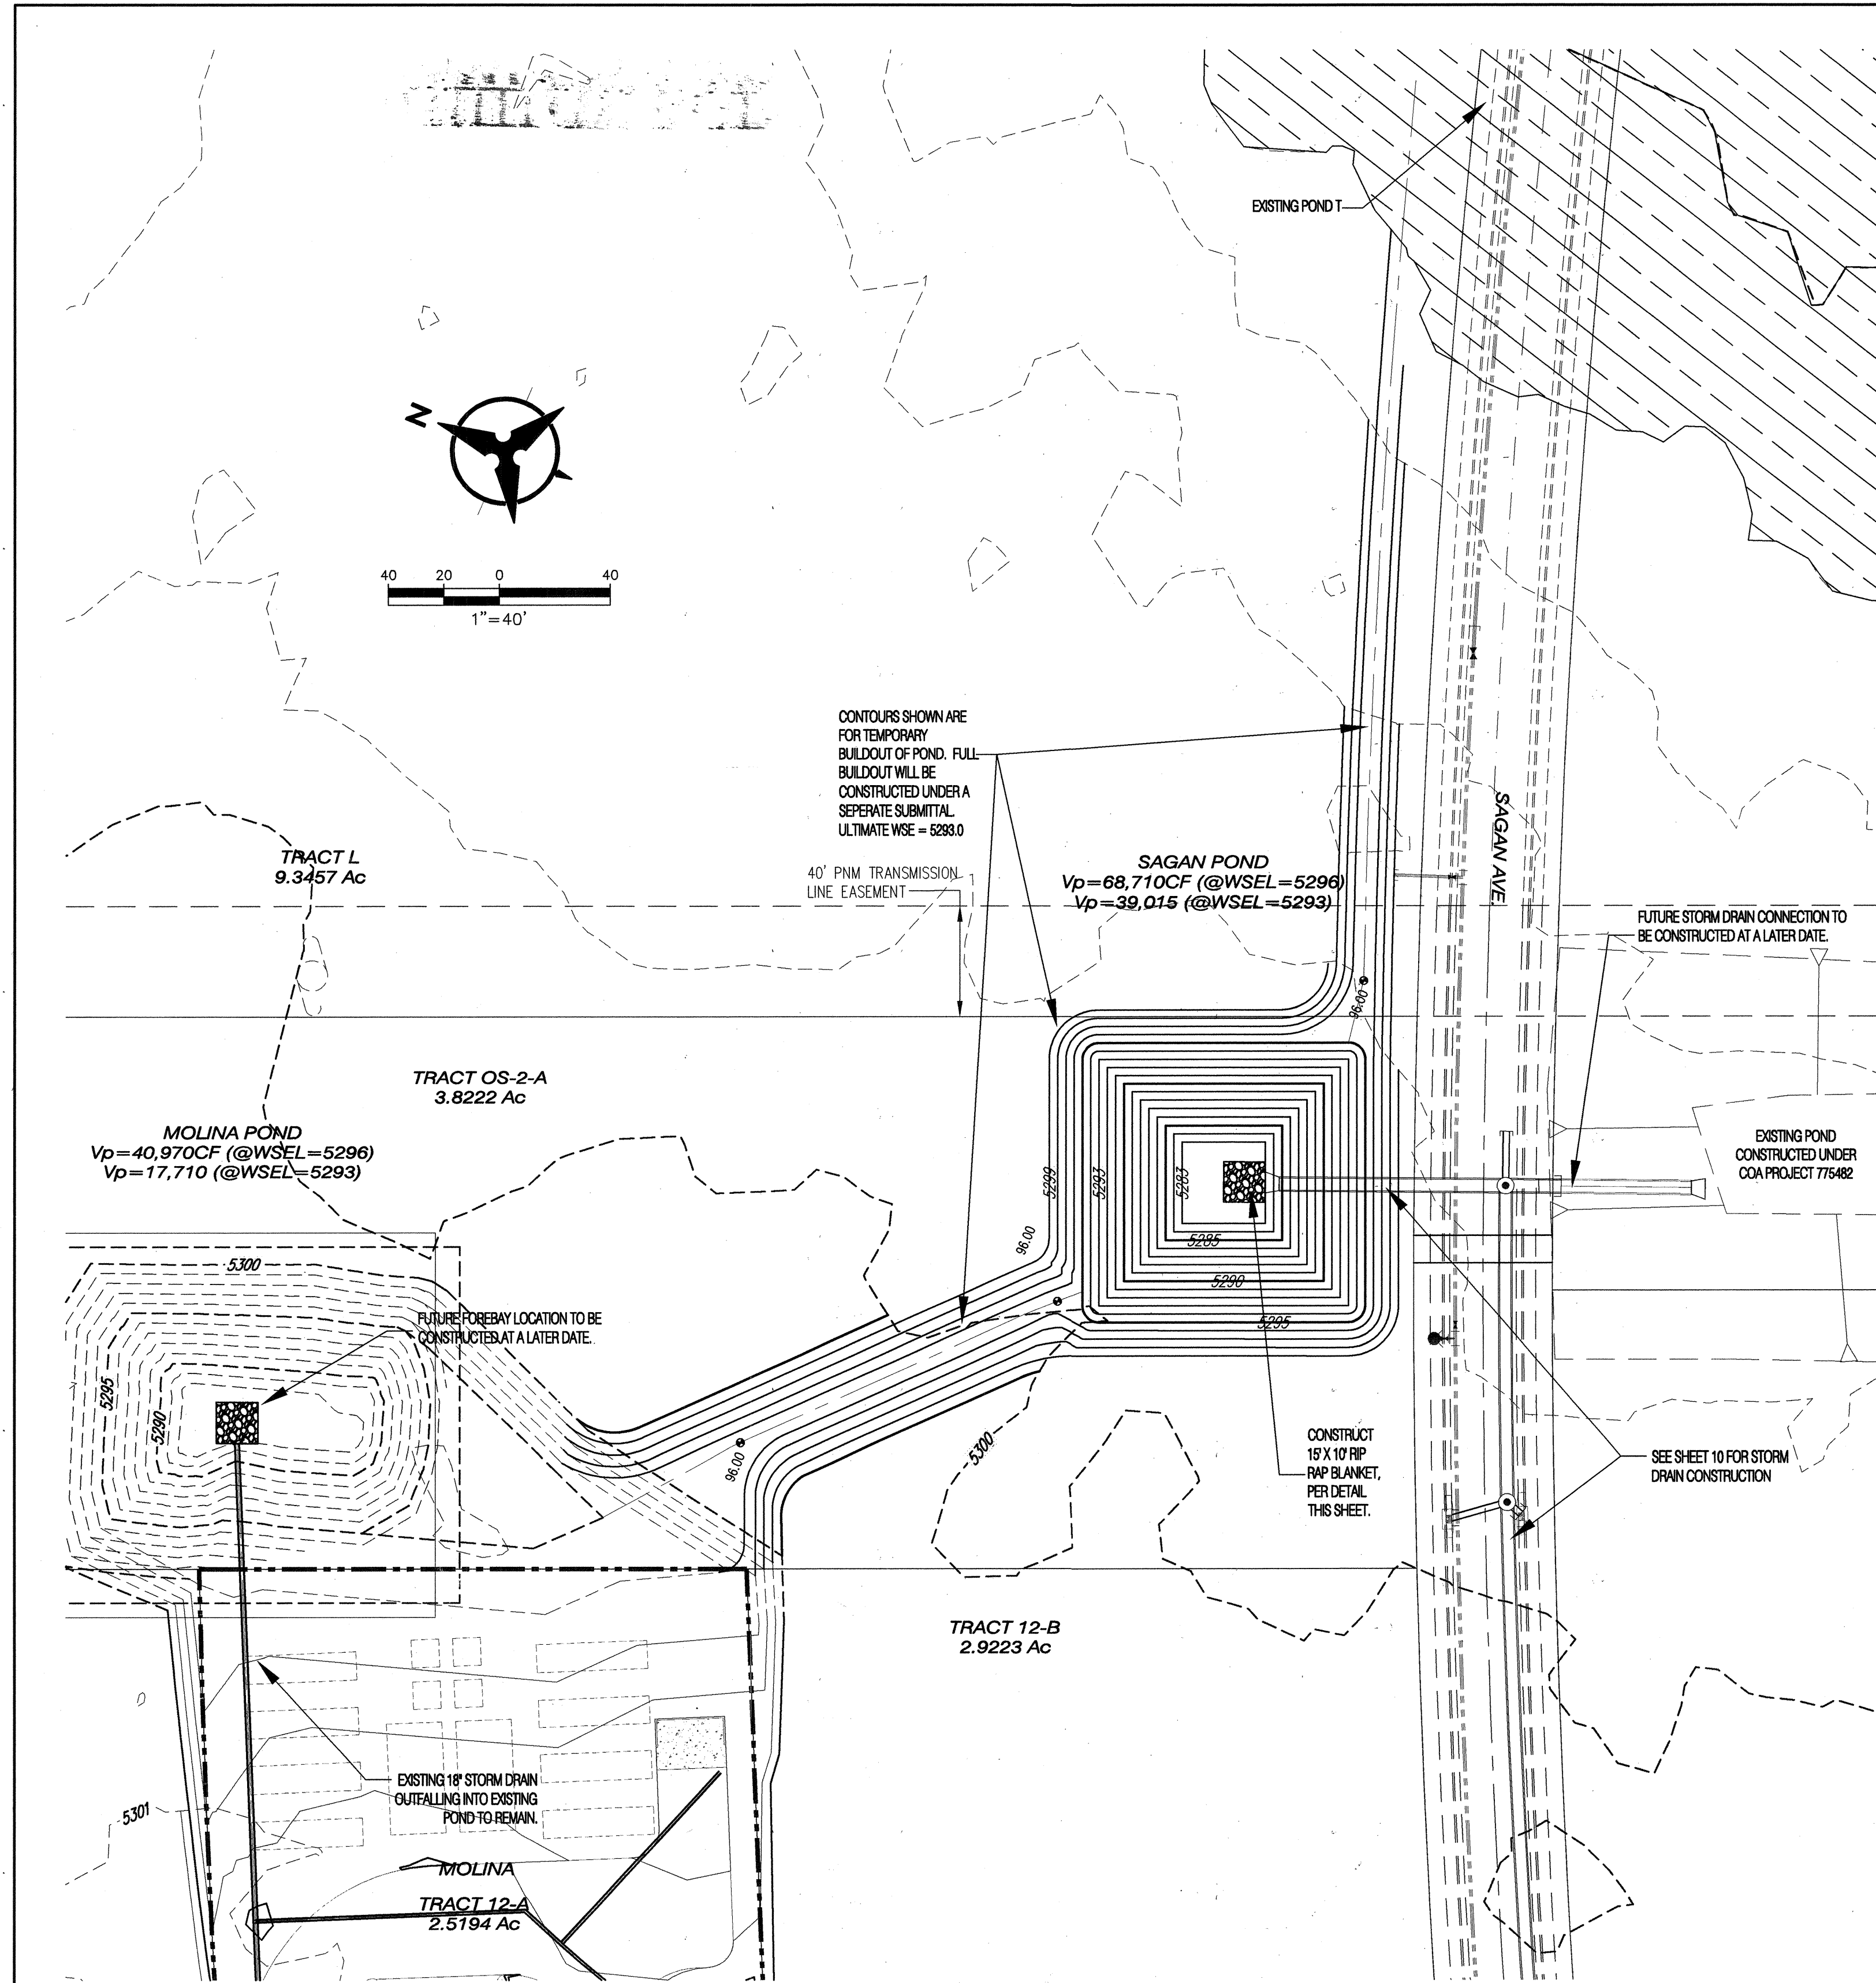

SAGAN POND GRADING DETAILS

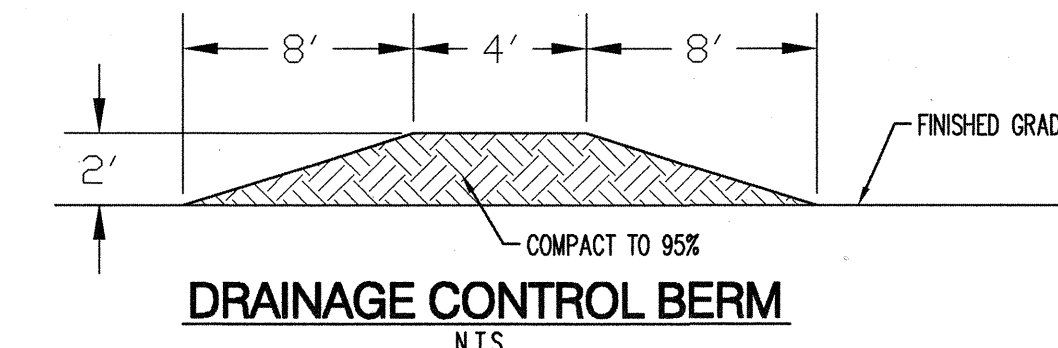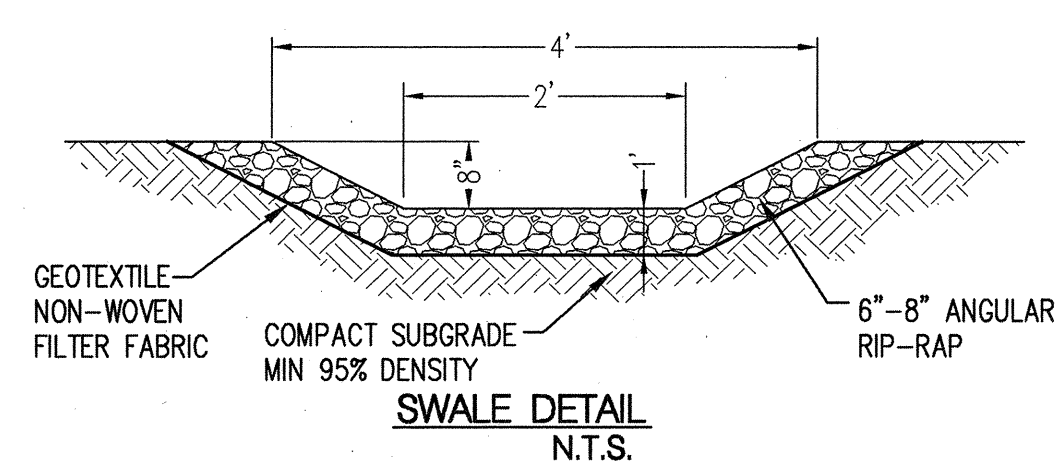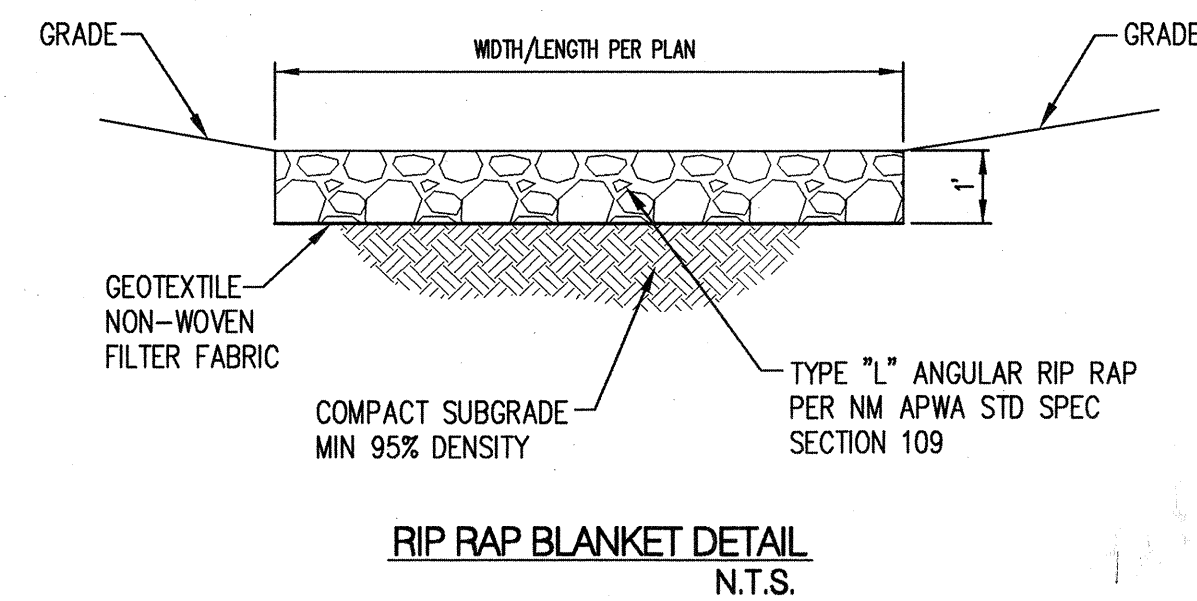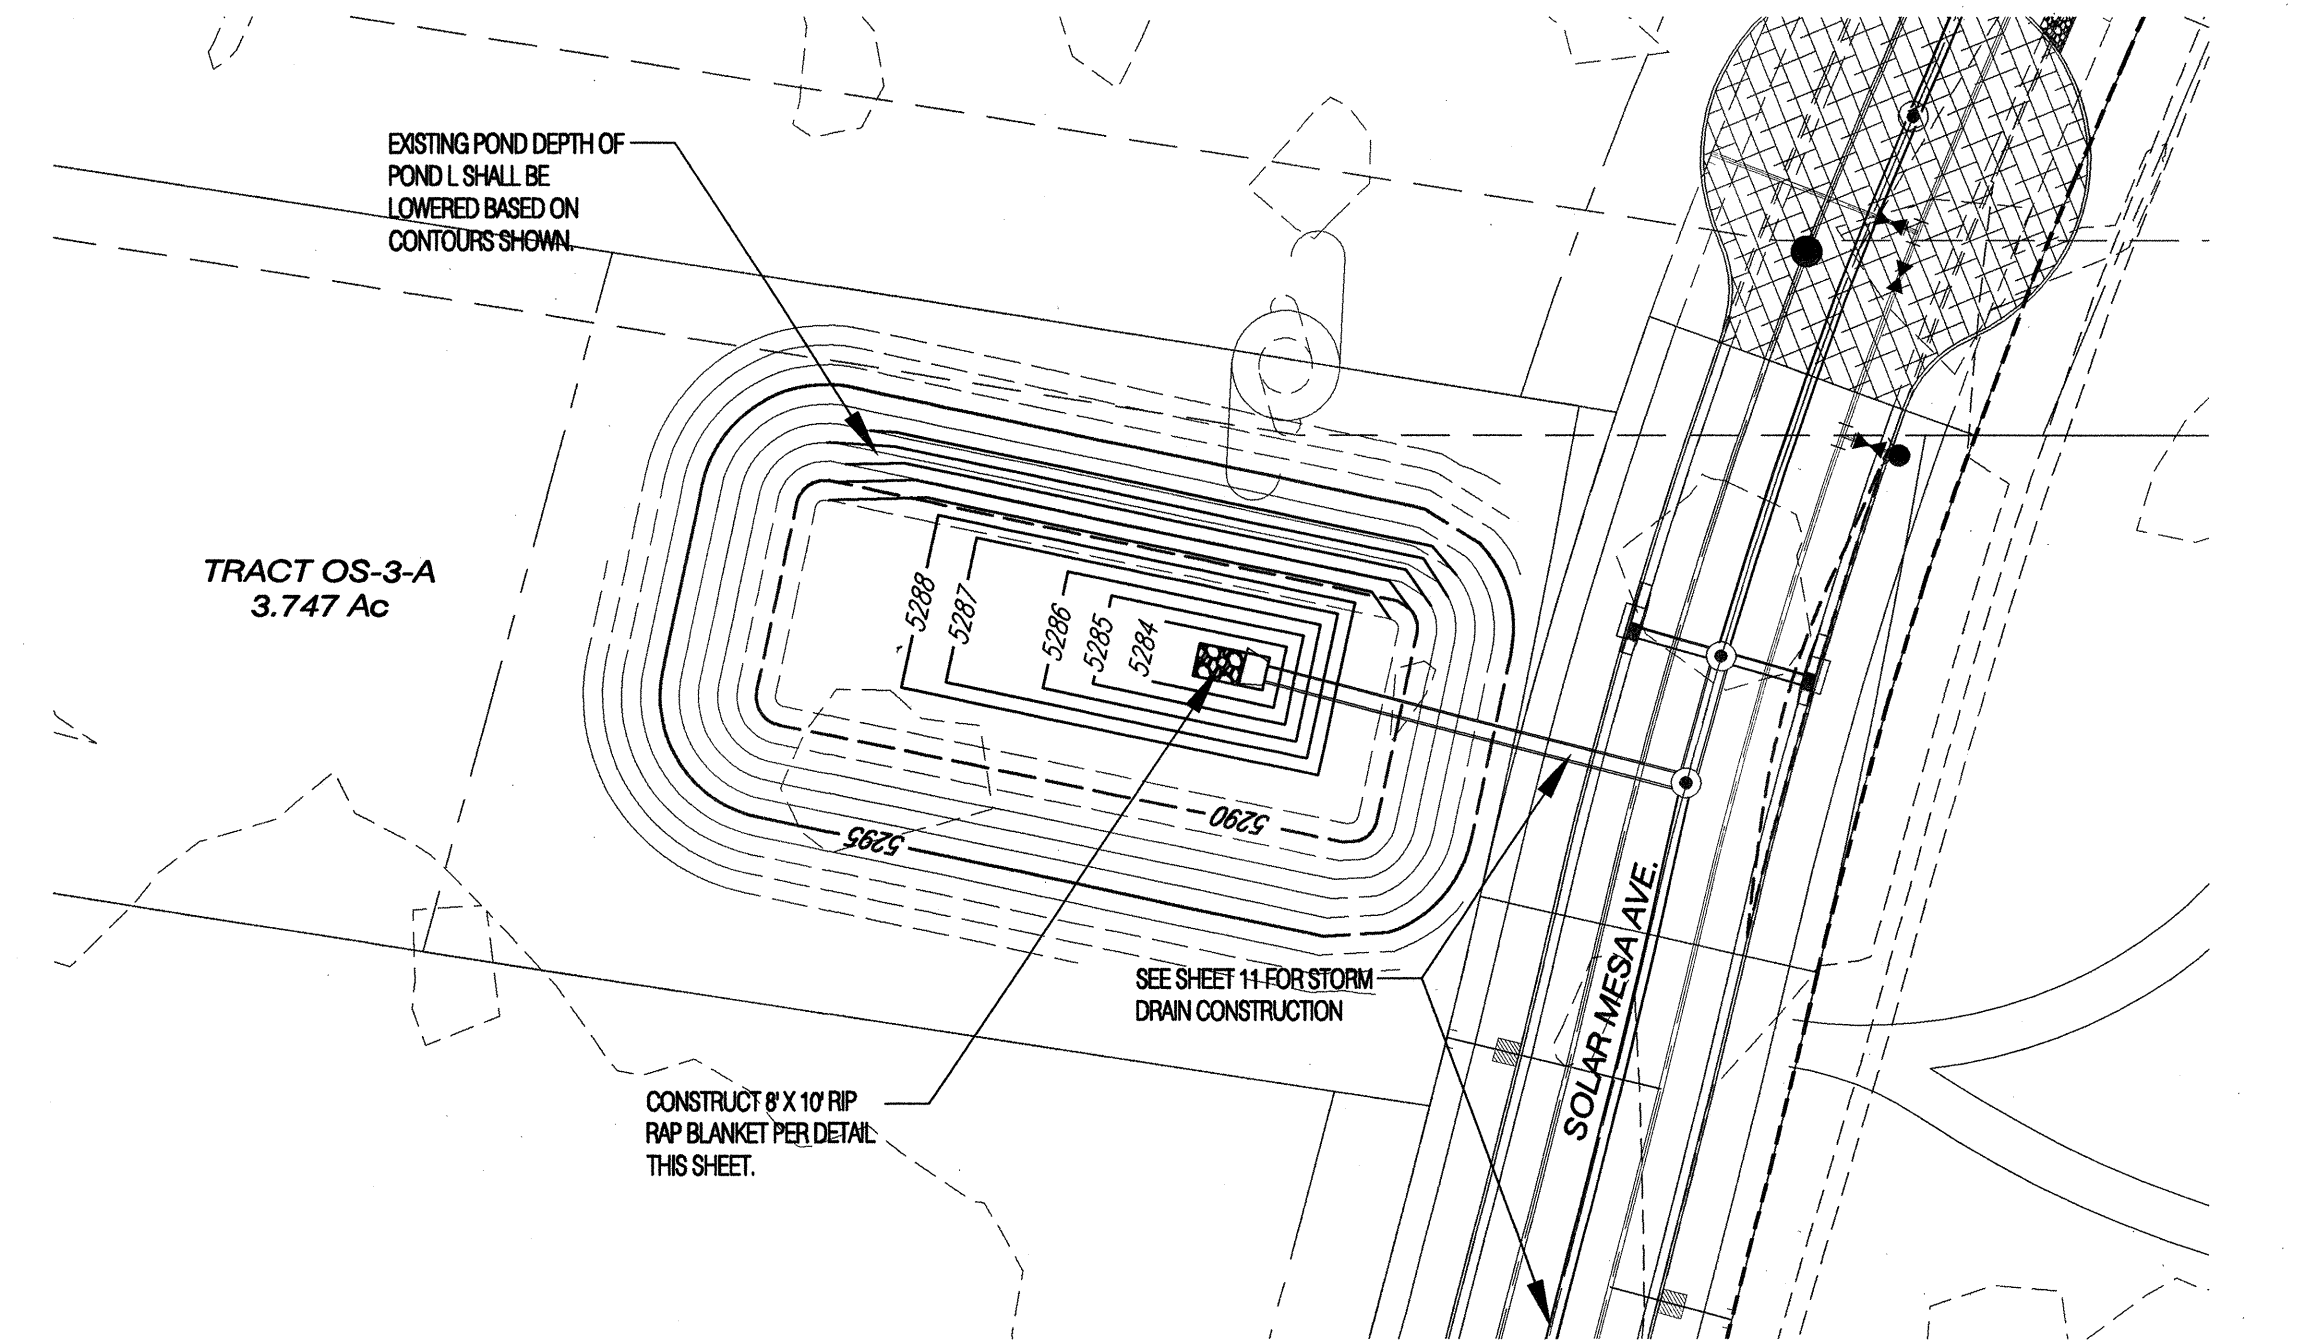

NOTE: POND GRADING SHOWN HEREON IS FOR ROUGH GRADING PURPOSES ONLY. FINAL POND DESIGN AND DETAILS WILL BE PROVIDED WITH A FUTURE PLAN SET.

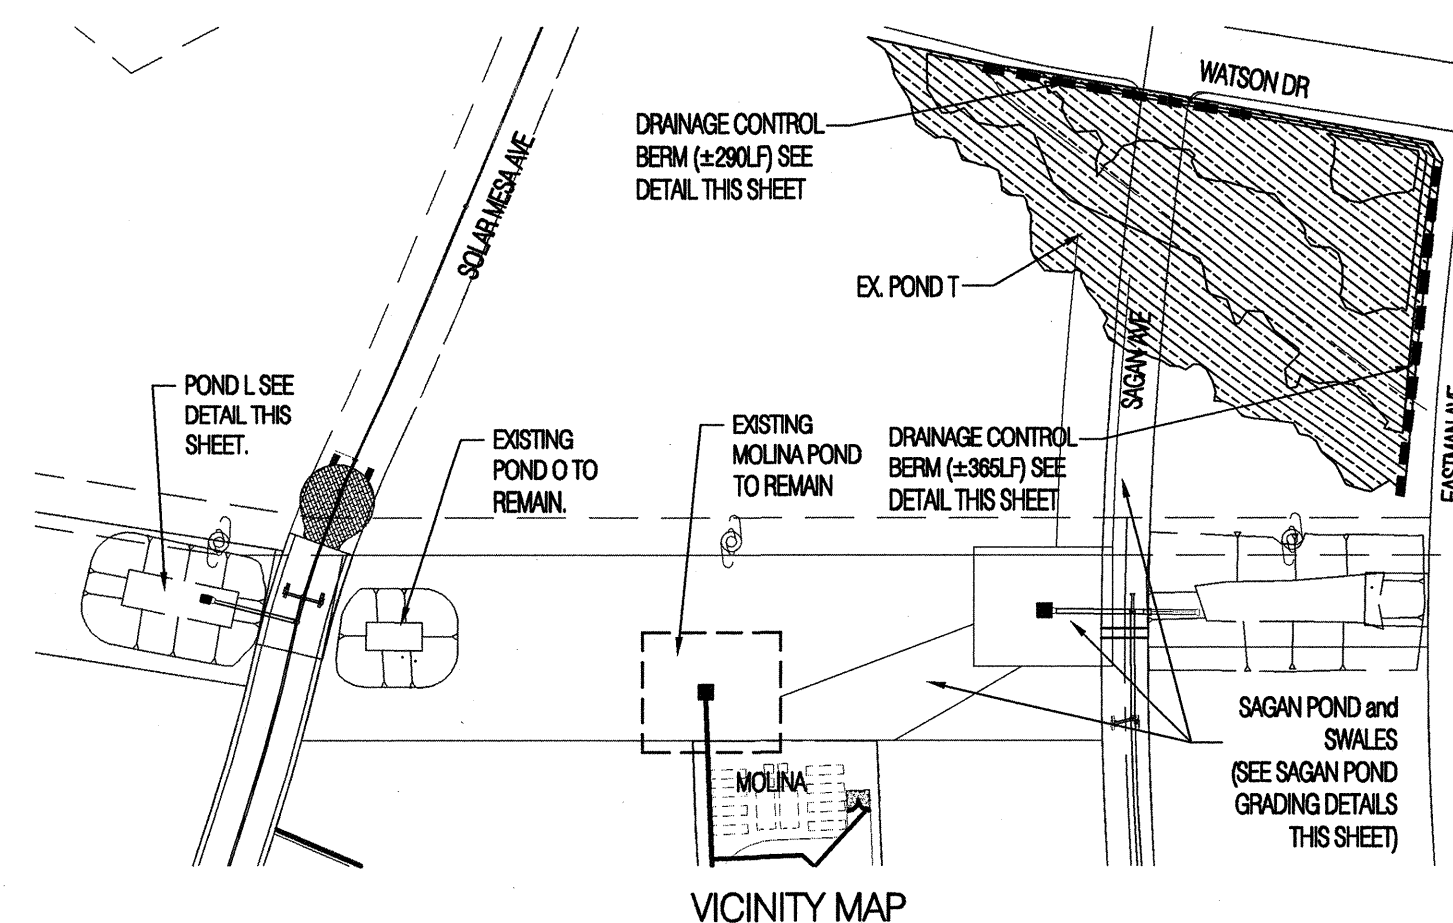

AS-BUILT INFORMATION		BENCH MARKS		SURVEY INFORMATION		ENGINEER'S SEAL		REVISIONS		DESIGN		DATE	
CONTRACTOR	DATE	ACS BRASS TABLET STAMPED "1-R16, 1984"	DATE	NO.	BY	18187	18187	1	DATE	2	DATE	3	DATE
INSPECTOR	DATE	GEOGRAPHIC POSITION (NAD 83)	DATE										
FIELD	DATE	N.M. STATE PLANE COORDINATES (CENTRAL ZONE)	DATE										
VERIFICATION	DATE	X = 1,532,715.669 Y = 1,453,438.899	DATE										
CORRECTION	DATE	GROUND-TO-GRID FACTOR = 0.999664099	DATE										
MICROFILM INFORMATION	DATE	Δα = -0012'22.46"	DATE										
	NO.	NAVD 1988 ELEVATION = 5291.451											

Bohannon & Huston
Courtyard I 7500 Jefferson St. NE Albuquerque, NM 87109-4335
ENGINEERING • SPATIAL DATA • ADVANCED TECHNOLOGIES

CITY OF ALBUQUERQUE
PUBLIC WORKS DEPARTMENT

TRACT 11 AT MESA DEL SOL, GSA INFRASTRUCTURE
POND GRADING DETAILS

Design Review Committee	City Engineer Approval	Mo./Day/Yr.	Mo./Day/Yr.
APPROVED OCT 29 2009 DESIGN REVIEW COMMITTEE	APPROVED OCT 29 2009 CITY ENGINEER		

City Project No. 775478 Zone Map No. R-15, R-16 Sheet 13R2 Of 13